


SHEET NO.	DESCRIPTION
1	TITLE SHEET
2	SIGNAL INTERCONNECT CABLE LOCATION MAP
INTERCONNECT CABLE RUNS	
3-8	I-25 FROM CANDELARIA TO GRANT LINE
9	CARLISLE AND SAN PEDRO FROM MONTGOMERY TO GRANT LINE
10	LOUISIANA AND PENNSYLVANIA FROM MONTGOMERY TO GRANT LINE
11-12	GRANT LINE FROM CARLISLE TO WYOMING
13-15	COMANCHE FROM SAN PEDRO TO WYOMING
16-18	MONTGOMERY FROM WYOMING TO JUAN TABO
19	COMANCHE FROM MORRIS TO JUAN TABO
20	MENAU FROM WYOMING TO MOON
21	MENAU FROM EUBANK TO MORRIS
22	EUBANK FROM MENAU TO CANDELARIA
23-24	CONSTITUTION FROM WYOMING TO EUBANK
25-27	INDIAN SCHOOL FROM GIRARD TO SAN MATEO
28	CONSTITUTION FROM GIRARD TO CARLISLE
29-30	CARLISLE FROM CONSTITUTION TO MENAU
31-32	MENAU FROM CARLISLE TO SAN MATEO
33	UNIVERSITY FROM CENTRAL TO LAS LOMAS
34-36	SUMMARY OF QUANTITIES
37	TYPICAL DETAILS
38-39	CONSTRUCTION BARRACADING TYPICAL DETAILS

CITY OF ALBUQUERQUE  
PUBLIC WORKS DEPARTMENT  
Albuquerque, New Mexico



TRAFFIC SIGNAL COMPUTER  
SYSTEM EXPANSION

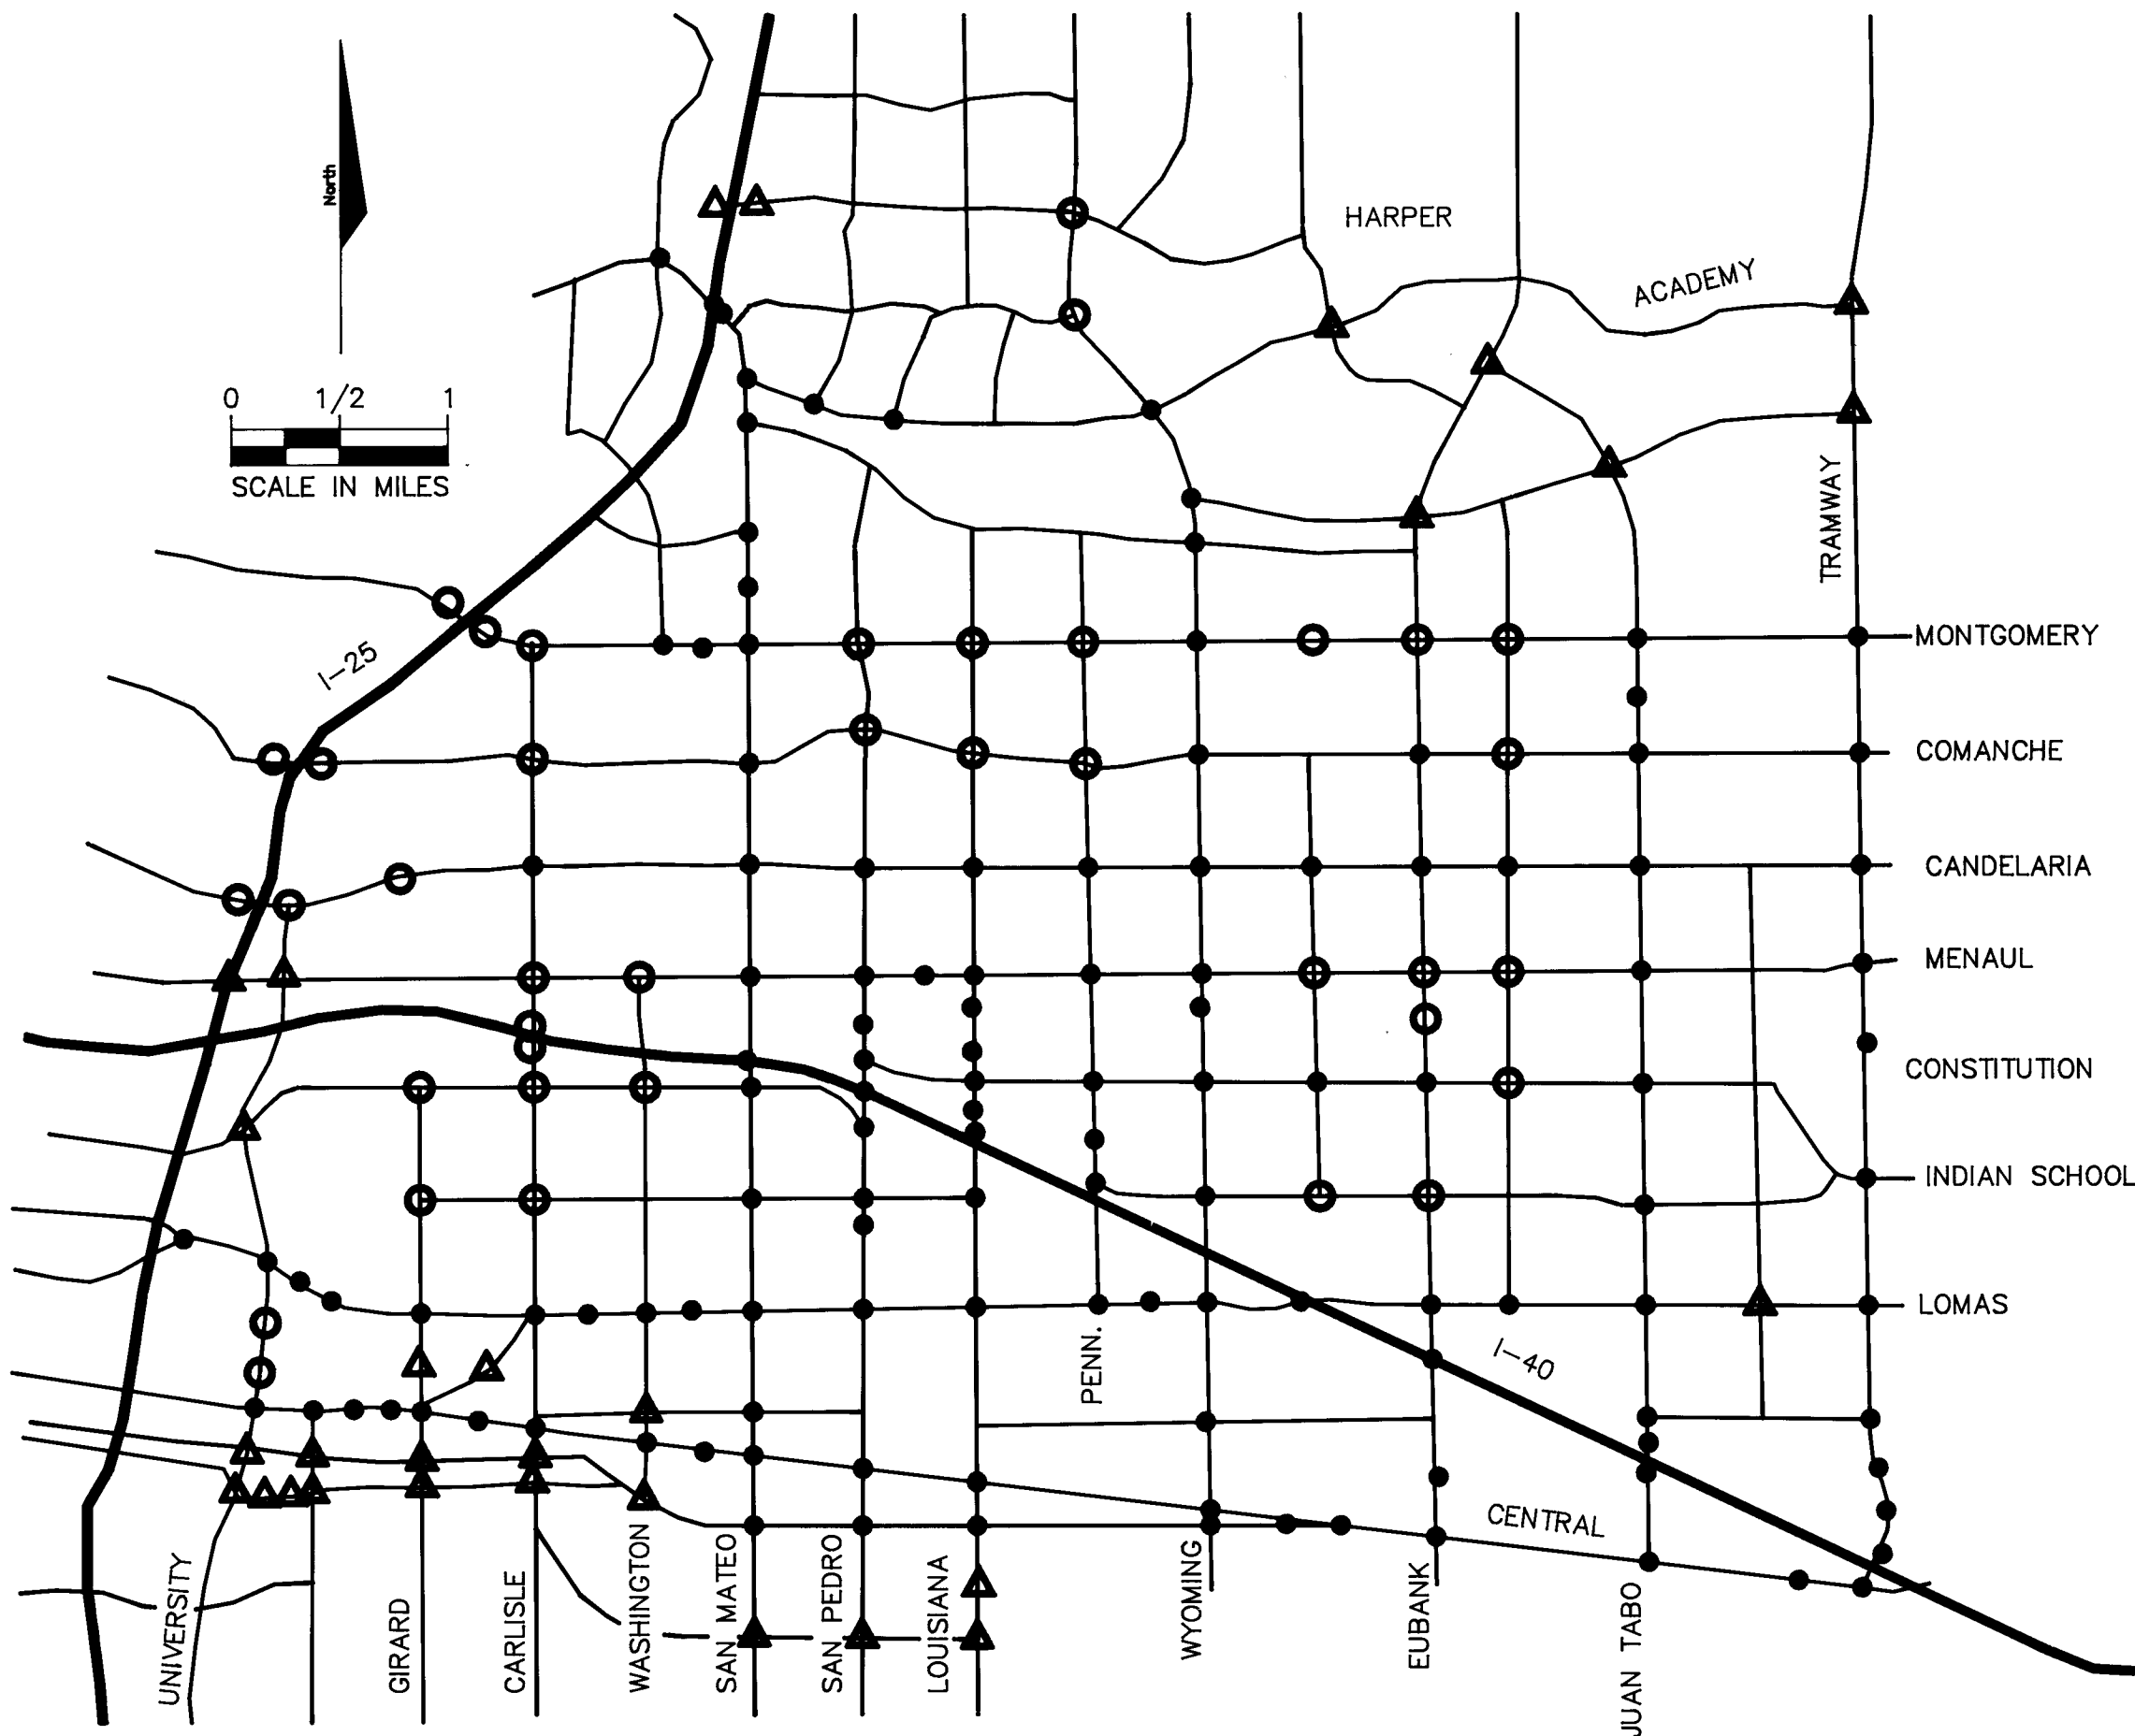

STUDY AREA

- EXPANSION SIGNALS
- SYSTEM SIGNALS
- ▲ OTHER SIGNALS

GENERAL NOTES

ALL WORK DETAILED ON THESE PLANS TO BE PERFORMED UNDER THIS CONTRACT SHALL, EXCEPT AS OTHERWISE STATED OR PROVIDED FOR IN THE SUPPLEMENTAL SPECIFICATIONS OF THE CONTRACT, BE CONSTRUCTED IN ACCORDANCE WITH THE CITY OF ALBUQUERQUE STANDARD SPECIFICATIONS FOR PUBLIC WORKS CONSTRUCTION - 1986 EDITION, HEREIN AFTER CALLED SS-1986.

ALL WORK ON THESE PLANS TO BE PERFORMED UNDER THIS CONTRACT SHALL CONFORM TO THE CURRENT NATIONAL ELECTRIC CODE, STANDARDS OF THE NATIONAL BOARD OF FIRE UNDERWRITERS FOR ELECTRICAL WIRING AND APPARATUS.

THE CONTRACTOR SHALL FURNISH, ERECT AND MAINTAIN BARRICADES, WARNING SIGNS, FLAGMEN, AND PILOT CARS IN ACCORDANCE WITH THE MANUAL ON UNIFORM TRAFFIC CONTROL DEVICES (MUTCD); SECTION 19 OF SS-1986; AND AS SHOWN ON THE PLANS OR DIRECTED BY THE ENGINEER.

COORDINATION WITH PUBLIC AND PRIVATE UTILITIES SHALL BE IN ACCORDANCE WITH SECTION 18 OF SS-1986. TWO (2) WORKING DAYS PRIOR TO ANY EXCAVATION CONTRACTOR SHALL CONTACT ALBUQUERQUE COUNCIL ONE CALL CENTER, TELEPHONE 765-1234, FOR LOCATING OF EXISTING UTILITIES.

DISPOSAL OF ALL WASTE MATERIAL SHALL BE THE RESPONSIBILITY OF THE CONTRACTOR AS SPECIFIED IN SECTION 6.14 OF SS-1986.

LOCATIONS OF CONDUIT, PULL BOXES, MANHOLES AND SPLICE CABINETS ARE SCHEMATIC AND MAY BE ADJUSTED WITH THE APPROVAL OF THE ENGINEER.

THE CONTRACTOR IS WARNED THAT EXISTING CONDUIT MAY CONTAIN AC POWER AND EXTREME CAUTION SHALL BE EXERCISED IN INTERCEPTING OR INSTALLING CABLE IN EXISTING CONDUIT.

LOCATIONS OF CONDUIT, PULL BOXES, MANHOLES, AND SPLICE CABNETS ARE SCHEMATIC, ACTUAL LOCATIONS WILL BE DETERMINED IN THE FIELD BY THE ENGINEER.

THE CONTRACTOR IS WARNED THAT EXISTING CONDUIT MAY CONTAIN AC POWER AND EXTREME CAUTION SHALL BE EXERCISED IN INTERCEPTING OR INSTALLING CABLE IN EXISTING CONDUIT.

PAVEMENT REMOVAL AND REPLACEMENT SHALL BE IN ACCORDANCE WITH CITY OF ALBUQUERQUE DRAWING 2465.

CURB, GUTTER, AND SIDEWALK WILL BE REPLACED IN KIND.

CONTRACTOR SHALL REPLACE LANDSCAPING SPRINKLERS AND OTHER IMPROVEMENTS IN KIND OR BETTER.

RECORD SET

THIS SET HAS BEEN REVISED TO SHOW THOSE CHANGES DURING THE CONSTRUCTION PROCESS REPORTED TO KIMLEY-HORN AND ASSOCIATES, INC. AND CONSIDERED TO BE SIGNIFICANT. THIS DRAWING IS NOT GUARANTEED TO BE "AS BUILT" BUT IS BASED ON THE AVAILABLE INFORMATION.

DATE 10/31/09 BY [Signature]

"NO CHANGE"

C of A PWD Maps & Records

26 3386 01 93

APPROVAL OF A PROFESSIONAL ENGINEER  
[Signature]  
8-10-93



OWNERSHIP OF DOCUMENTS


THIS DOCUMENT, AND THE IDEAS AND DESIGNS INCORPORATED HEREIN, AS AN INSTRUMENT OF PROFESSIONAL SERVICE, IS THE PROPERTY OF KIMLEY-HORN AND ASSOCIATES, INC. AND IS NOT TO BE USED, IN WHOLE OR IN PART, FOR ANY OTHER PROJECT WITHOUT THE WRITTEN AUTHORIZATION OF KIMLEY-HORN AND ASSOCIATES, INC.

CONSTRUCTION SAFETY

THESE DRAWINGS DO NOT INCLUDE NECESSARY COMPONENTS FOR CONSTRUCTION SAFETY WHICH SHALL REMAIN THE CONTRACTOR'S RESPONSIBILITY.


REV.	SHEET	CITY ENGINEER	DATE	USER DEPT.	DATE	USER DEPT.	DATE
APPROVAL OF REVISIONS							

	<div><div>Kimley-Horn</div><div>KIMLEY-HORN and ASSOC. INC. DALLAS, TEXAS In Association With EDWIN L. BECK, P.E., CONSULTANT ALBUQUERQUE, N.M.</div></div>	APPROVED FOR CONSTRUCTION  1/20/08
	PROJECT NUMBER 3386	SHEET 1 OF 39

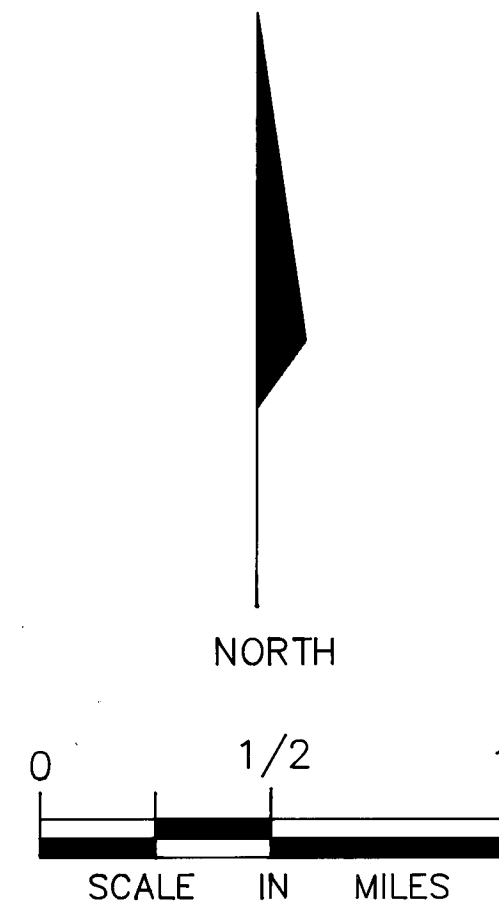

TO BE INSTALLED USING CITY FORCES AND MATERIALS (SEE PLANS)

TO BE INSTALLED USING CITY FORCES AND MATERIALS

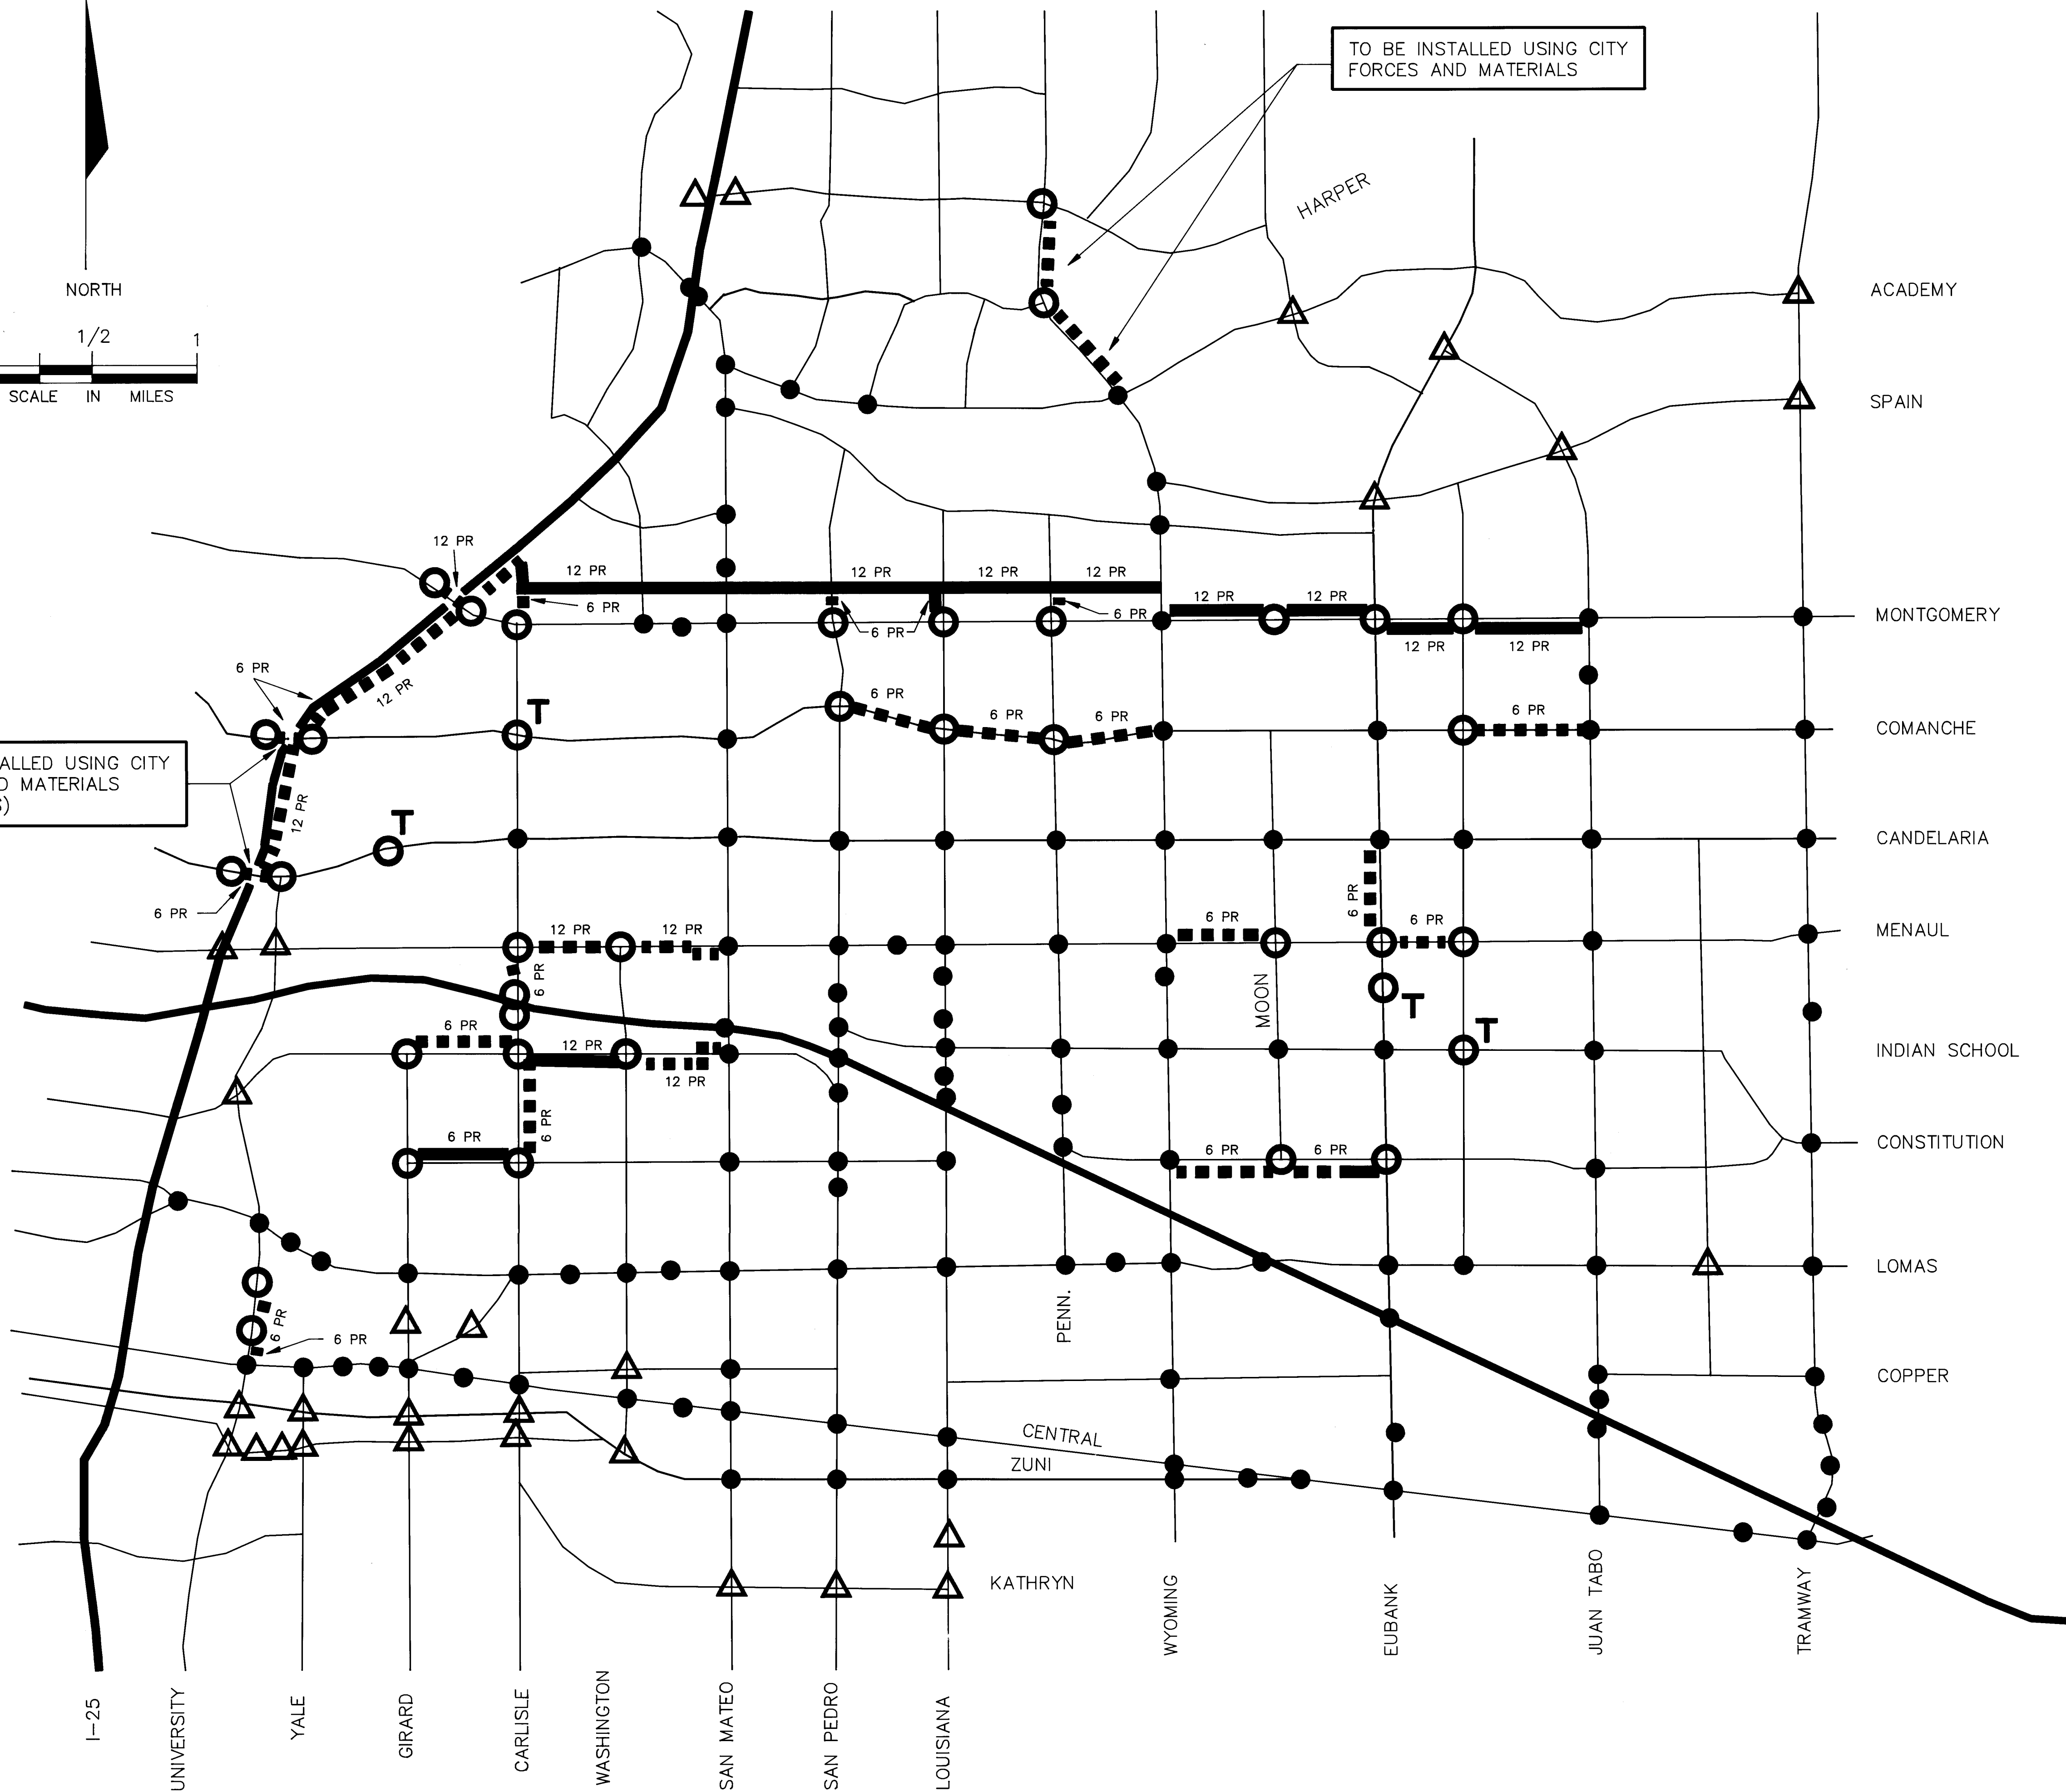

## LEGEND

- - EXPANSION SIGNALS
- - SYSTEM SIGNALS
- △ - OTHER SIGNALS
- - CONDUIT CABLE RUNS
- - AERIAL CABLE RUNS
- T - TELEPHONE CABLE DROP LOCATION
- 12 PR - NO. PAIR OF CABLE TO BE INSTALLED

AS BUILT INFORMATION		BENCH MARKS		SURVEY INFORMATION		ENGINEER'S SEAL		REVISIONS		APPROVALS		
CONTRACTOR	DATE	NO.	DATE	FIELD NOTES	BY	DATE	NO.	DATE	DESIGNED BY	DATE	APPROVED	DATE
CONTRACTOR: JET Can Inc	DATE: 8/8								DESIGNED BY: JWC	DATE: 8/14/87	APPROVED: JWC	DATE: 1/24/88
STANDARD: 604	DATE: 11/88								DRAWN BY: JWC	DATE: 8/25/87	APPROVED: JWC	DATE: 1/25/88
INSPECTED BY: T. J. T. J.	DATE: 11/88								CHECKED BY: HAW	DATE: 8/31/87	APPROVED: JWC	DATE: 1/25/88
FIELD NOTES: E. L. Beck	DATE: 11/88											
DRAWING NO. 3386	DATE: 11/88											
CORRECTED BY: E. L. Beck	DATE: 11/88											
MICRO-FILM INFORMATION	DATE: 11/88											
RECORDED BY	DATE											
NO.												

**RECORD DRAWING**

THIS DRAWING HAS BEEN REVISED TO SHOW THOSE CHANGES DURING THE CONSTRUCTION PROCESS REPORTED TO KIMLEY-HORN AND ASSOCIATES, INC. AND CONSIDERED TO BE SIGNIFICANT. THIS DRAWING IS NOT GUARANTEED TO BE "AS BUILT" BUT IS BASED ON THE AVAILABLE INFORMATION.

DATE: 10/31/87 BY: JWC

"NO CHANGE"

C of A PWD Maps & Records

1 2 3 4 5 6 7 8 9 10 11 12

26 3386 293

**KIMLEY-HORN and ASSOC. INC.**

DALLAS, TEXAS

In Association With

EDWIN L. BECK, P.E., CONSULTANT

ALBUQUERQUE, N.M.

CITY OF ALBUQUERQUE  
PUBLIC WORKS DEPARTMENT  
ENGINEERING GROUP

TITLE: **SIGNAL SYSTEM EXPANSION  
SIGNAL INTERCONNECT CABLE  
LOCATION MAP**

APPROVALS	ENGINEER	DATE	APPROVALS	ENGINEER	DATE
City Engineer	JWC	1/24/88	Liquid Waste	JWC	1/24/88
A.C.E. Design	JWC	1/25/88	Traffic	JWC	1/25/88
A.C. E.-Hydrology	JWC	1/25/88	Water	JWC	1/25/88


DRAWING NO. **3386** MAP NO. SHEET **2** OF **39**









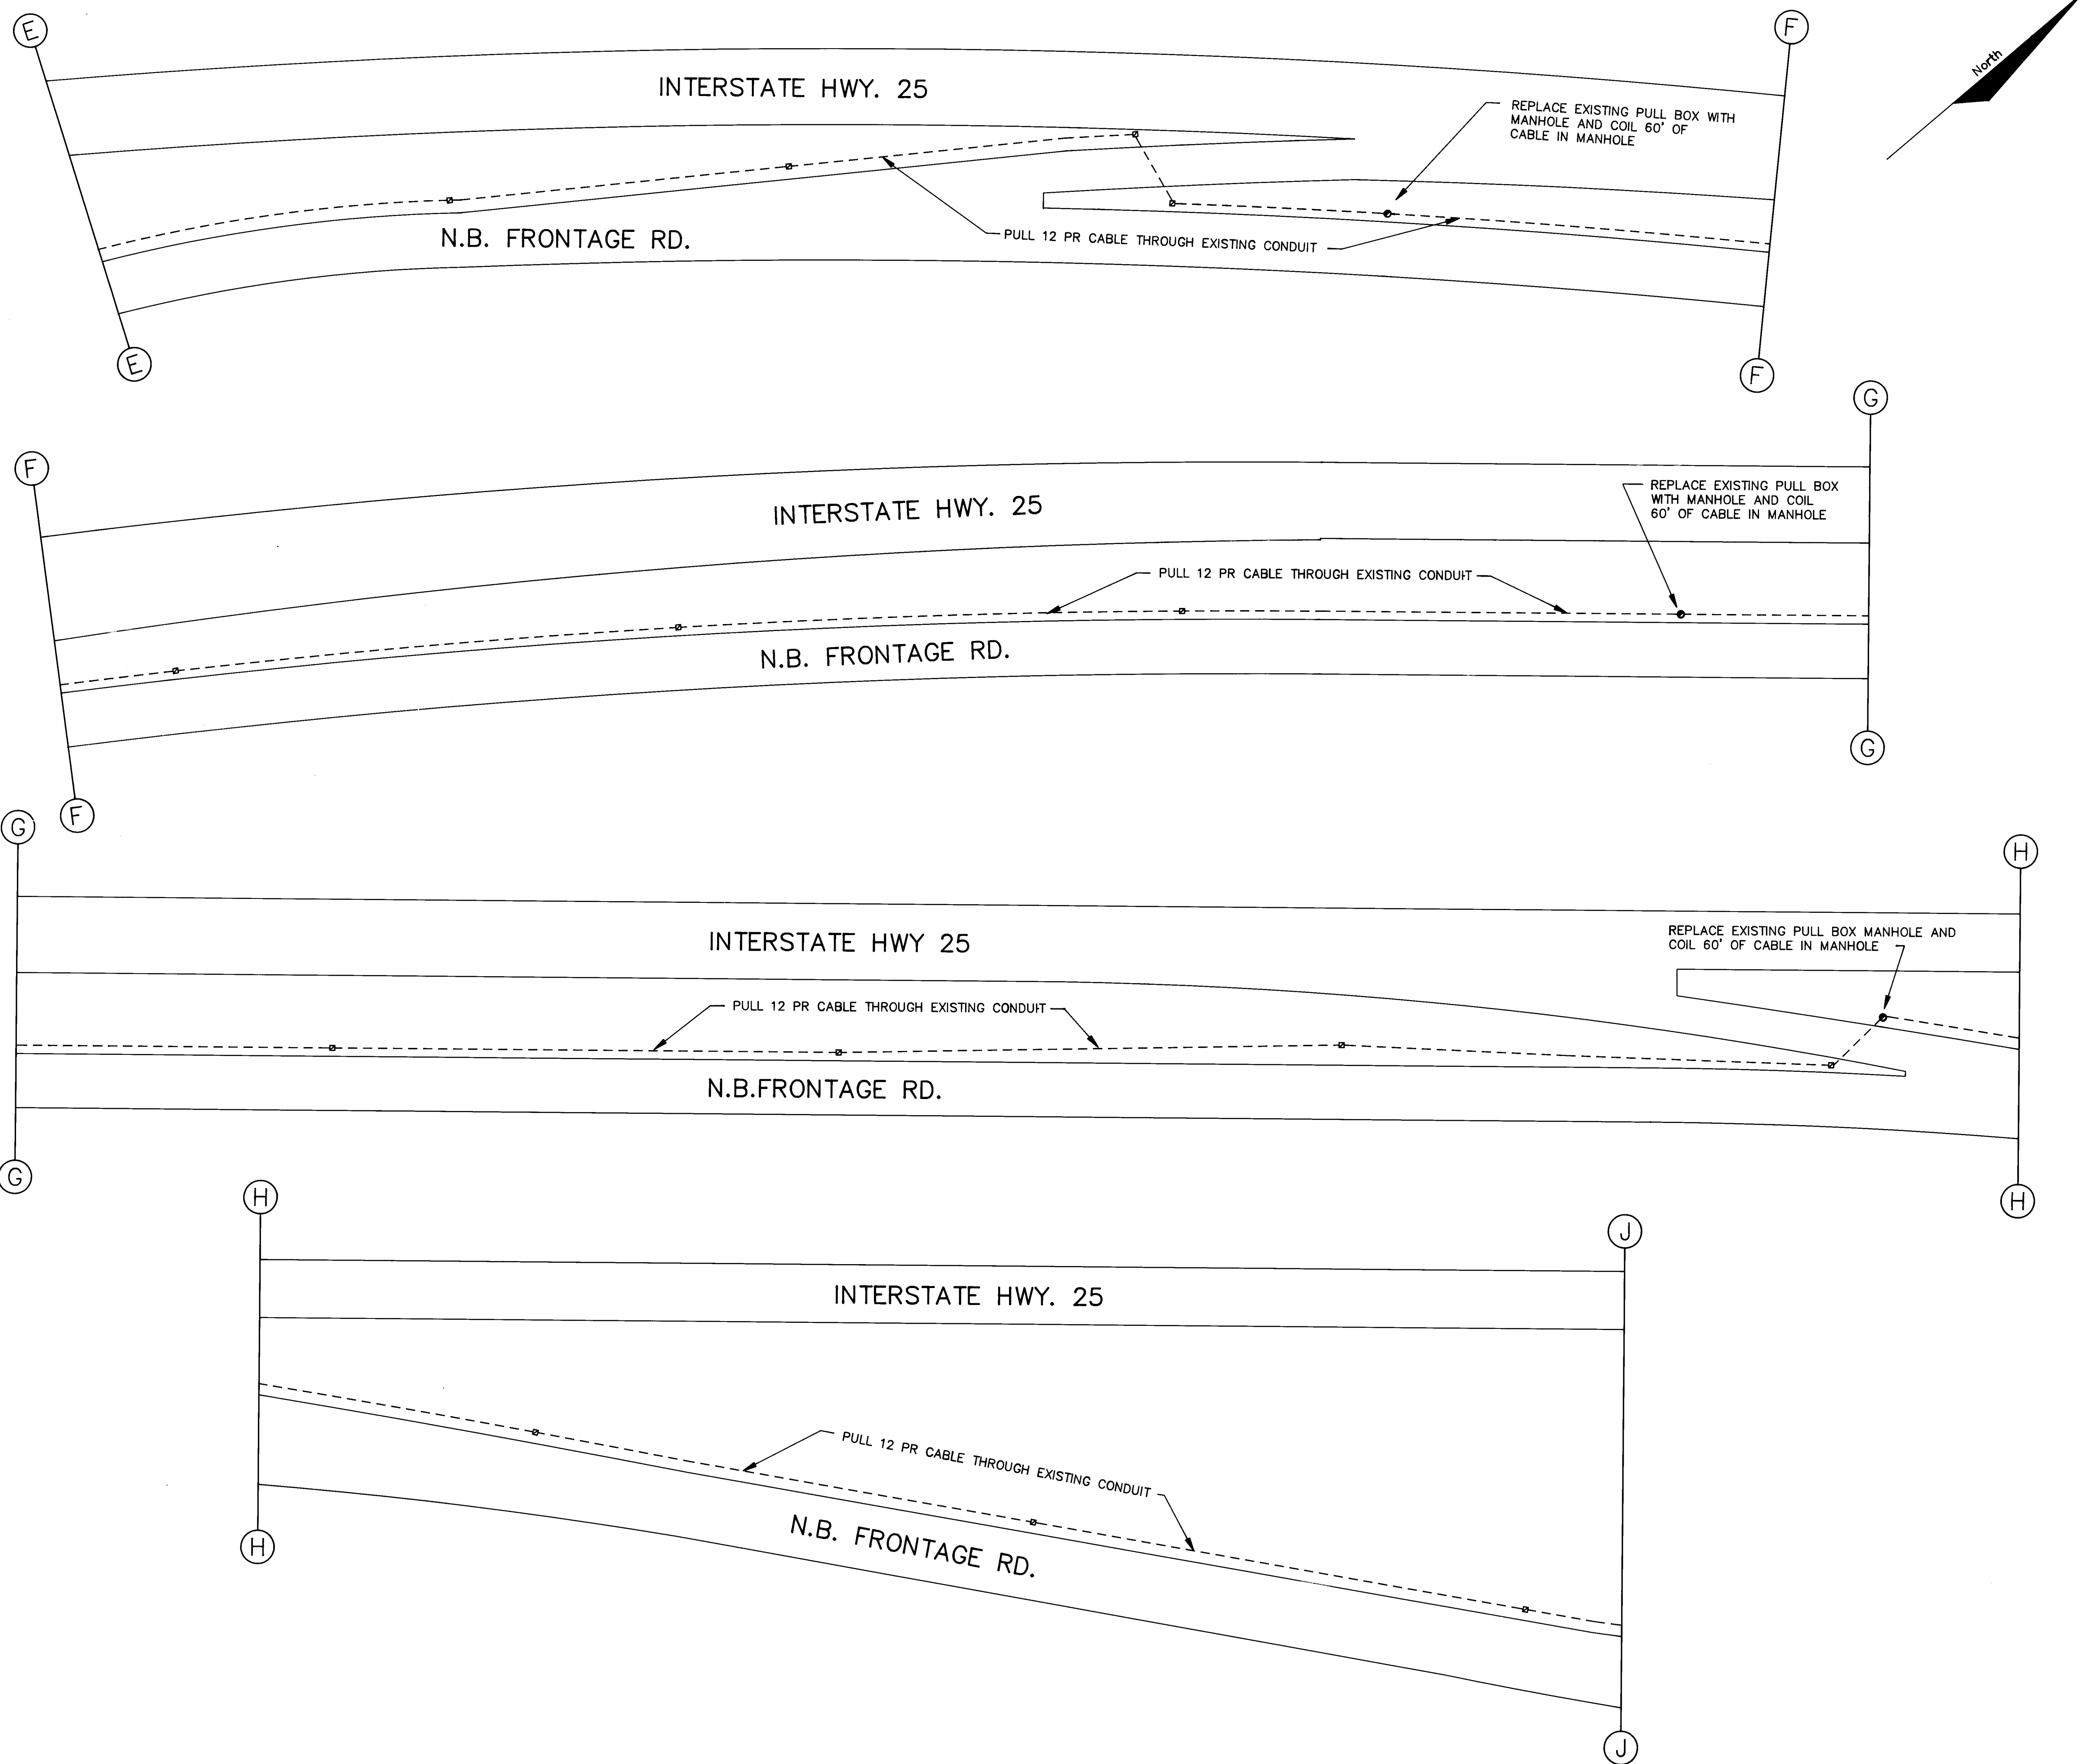

LEGEND	
EXISTING	PROPOSED
	CONTROLLER CABINET
	SPLICE CABINET
	PULL BOX
	MAN HOLE
	POLE
	PEDESTAL SIGNAL POLE
	MAST ARM POLE
	STREET LIGHT POLE
	CONDUIT
	AERIAL CABLE

AS BUILT INFORMATION		BENCH MARKS		SURVEY INFORMATION		ENGINEER'S SEAL	
CONTRACTOR	WORK	NO.	BY	DATE	NO.	BY	DATE
JEET CON INC	BY						
DATE	DATE						
8/8	8/8						
ACCEPTANCE BY	VERIFICATION BY						
DATE	DATE						
11/82	11/82						
DRAWINGS	RECORDS						
BY E BECK	DATE						
11/82							
MICRO-FILM INFORMATION	RECORDED BY						
DATE	NO.						

**RECORD DRAWING**

THIS DRAWING HAS BEEN REVISED TO SHOW THOSE CHANGES DURING THE CONSTRUCTION PROCESS REPORTED TO KIMLEY-HORN AND ASSOCIATES, INC. AND CONSIDERED TO BE SIGNIFICANT. THIS DRAWING IS NOT GUARANTEED TO BE "AS BUILT" BUT IS BASED ON THE AVAILABLE INFORMATION.

DATE 10/3/89 BY John Bauer

NO. 3386 OF 39

SCALE:  
1"=50' (RUNS)  
1"=20' (INSERTS)


**KIMLEY-HORN and ASSOC. INC.**  
DALLAS, TEXAS  
In Association With  
EDWIN L. BECK, P.E., CONSULTANT  
ALBUQUERQUE, N.M.

CITY OF ALBUQUERQUE  
PUBLIC WORKS DEPARTMENT  
ENGINEERING GROUP

TITLE: TRAFFIC SIGNAL INTERCONNECT  
INTERSTATE HIGHWAY 25  
FROM CANELARIA ROAD TO MONTGOMERY BLVD.

APPROVALS	ENGINEER	DATE	APPROVALS	ENGINEER	DATE
City Engineer	<u>RWH</u>	<u>1/21/88</u>	Liquid Waste	<u>FWO</u>	<u>1/28</u>
A.C.E. Design	<u>RWH</u>	<u>1/21/88</u>	Traffic	<u>EL</u>	<u>1/28/88</u>
A.C. E.-Hydrology	<u>N/A</u>	<u>-</u>	Water	<u>FWO</u>	<u>1/28</u>
			Traffic Engineering	<u>ELC</u>	<u>1/27/88</u>

DRAWING NO. 3386 MAP NO. SHEET 6 OF 39

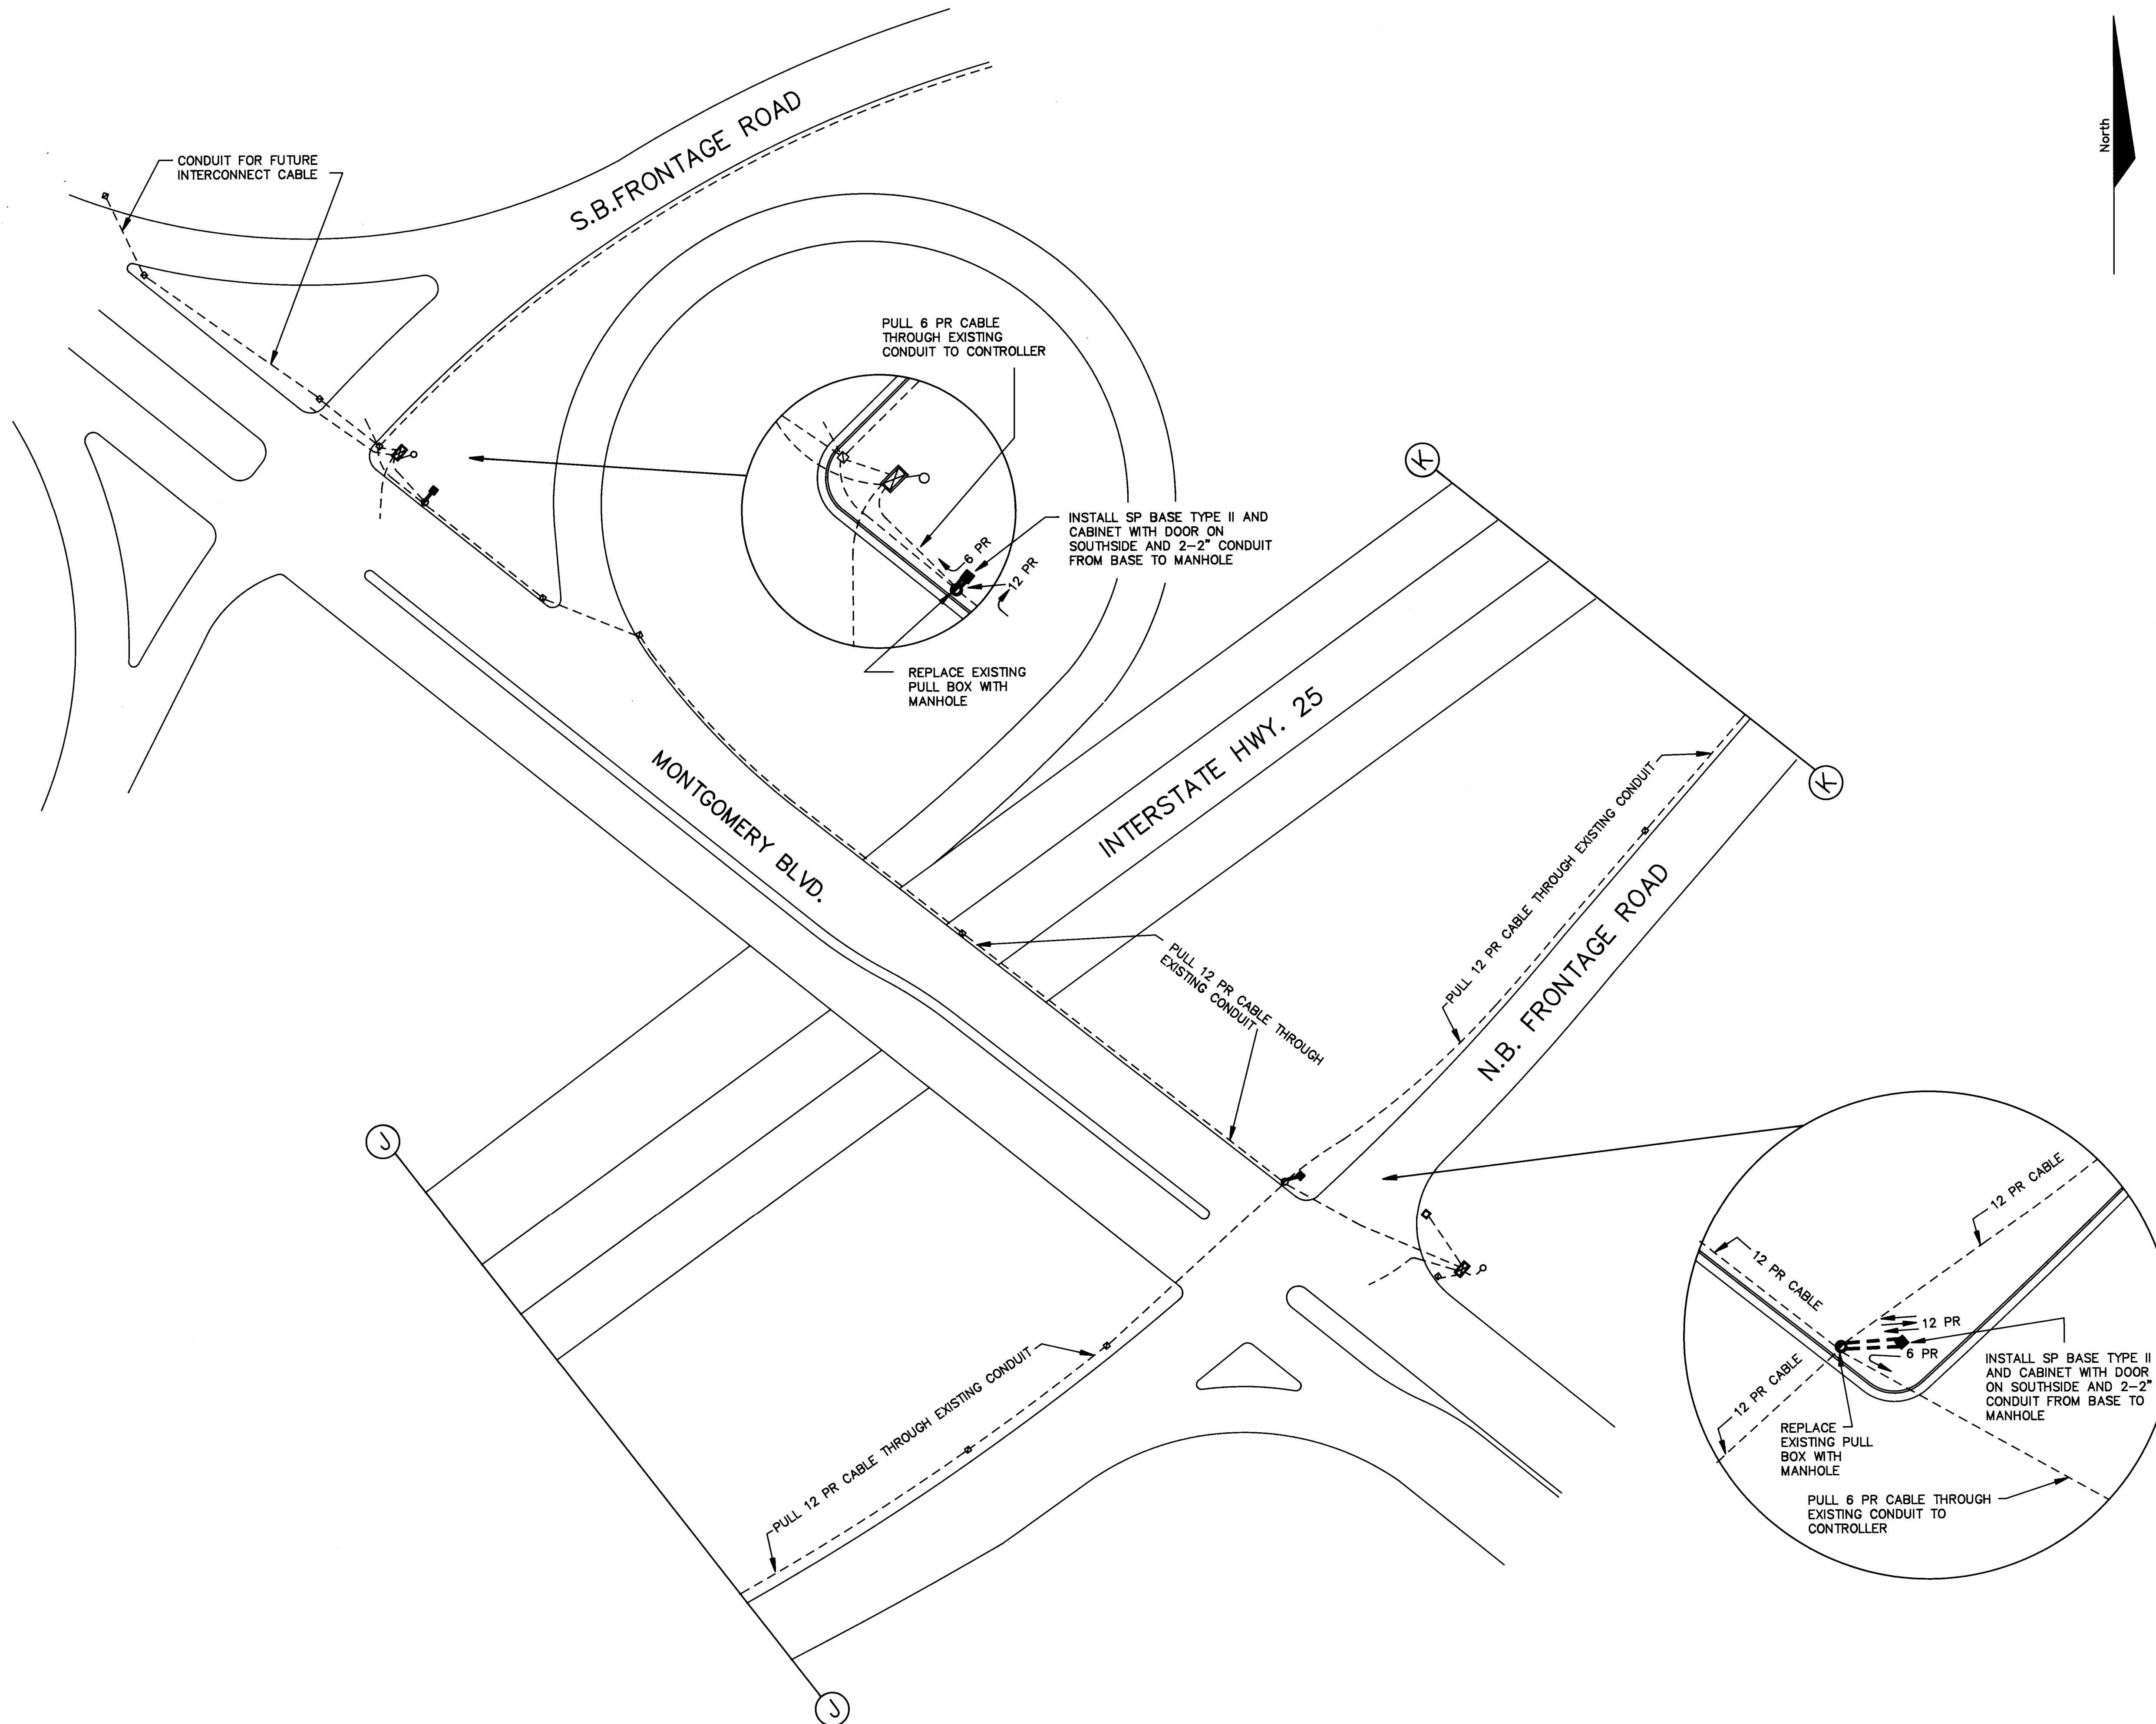

North

# LEGEND

EXISTING		PROPOSED	
	CONTROLLER CABINET		
	SPLICE CABINET		
	PULL BOX		
	MAN HOLE		
	POLE		
	PEDESTAL SIGNAL POLE		
	MAST ARM POLE		
	STREET LIGHT POLE		
	CONDUIT		
	AERIAL CABLE		

AS BUILT INFORMATION	
CONTRACTOR	DATE
STATIONED BY	DATE
INSPECTOR'S	DATE
FIELD	DATE
APPROVED BY	DATE
CHECKED BY	DATE
RECORDED BY	DATE
NO.	

BENCH MARKS	
NO.	DATE

SURVEY INFORMATION	
NO.	DATE

ENGINEER'S SEAL	
NO.	DATE

## RECORD DRAWING

THIS DRAWING HAS BEEN REVISED TO SHOW THOSE CHANGES DURING THE CONSTRUCTION PROCESS REPORTED TO KIMLEY-HORN AND ASSOCIATES, INC. AND CONSIDERED TO BE SIGNIFICANT. THIS DRAWING IS NOT GUARANTEED TO BE "AS BUILT" BUT IS BASED ON THE AVAILABLE INFORMATION.

DATE 10/31/89 BY [Signature]

"NO CHANGE"  
C of A PWD Maps & Records  
26 3386 0793

SCALE:  
1"=50' (RUNS)  
1"=20' (INSERTS)

**KIMLEY-HORN**  
KIMLEY-HORN AND ASSOC. INC.  
DALLAS, TEXAS  
In Association With  
EDWIN L. BECK, P.E., CONSULTANT  
ALBUQUERQUE, N.M.

CITY OF ALBUQUERQUE  
PUBLIC WORKS DEPARTMENT  
ENGINEERING GROUP


TITLE: TRAFFIC SIGNAL INTERCONNECT  
INTERSTATE HIGHWAY 25  
FROM CANDELARIA ROAD TO MONTGOMERY BLVD.

APPROVALS	ENGINEER	DATE	APPROVALS	ENGINEER	DATE
City Engineer	[Signature]	1/88	Liquid Waste	[Signature]	1/88
A.C.E. Design	[Signature]	1/88	Traffic	[Signature]	1/88
A.C. E.-Hydrology	[Signature]	1/88	Water	[Signature]	1/88


DRAWING NO. 3386 MAP NO. SHEET 7 OF 39





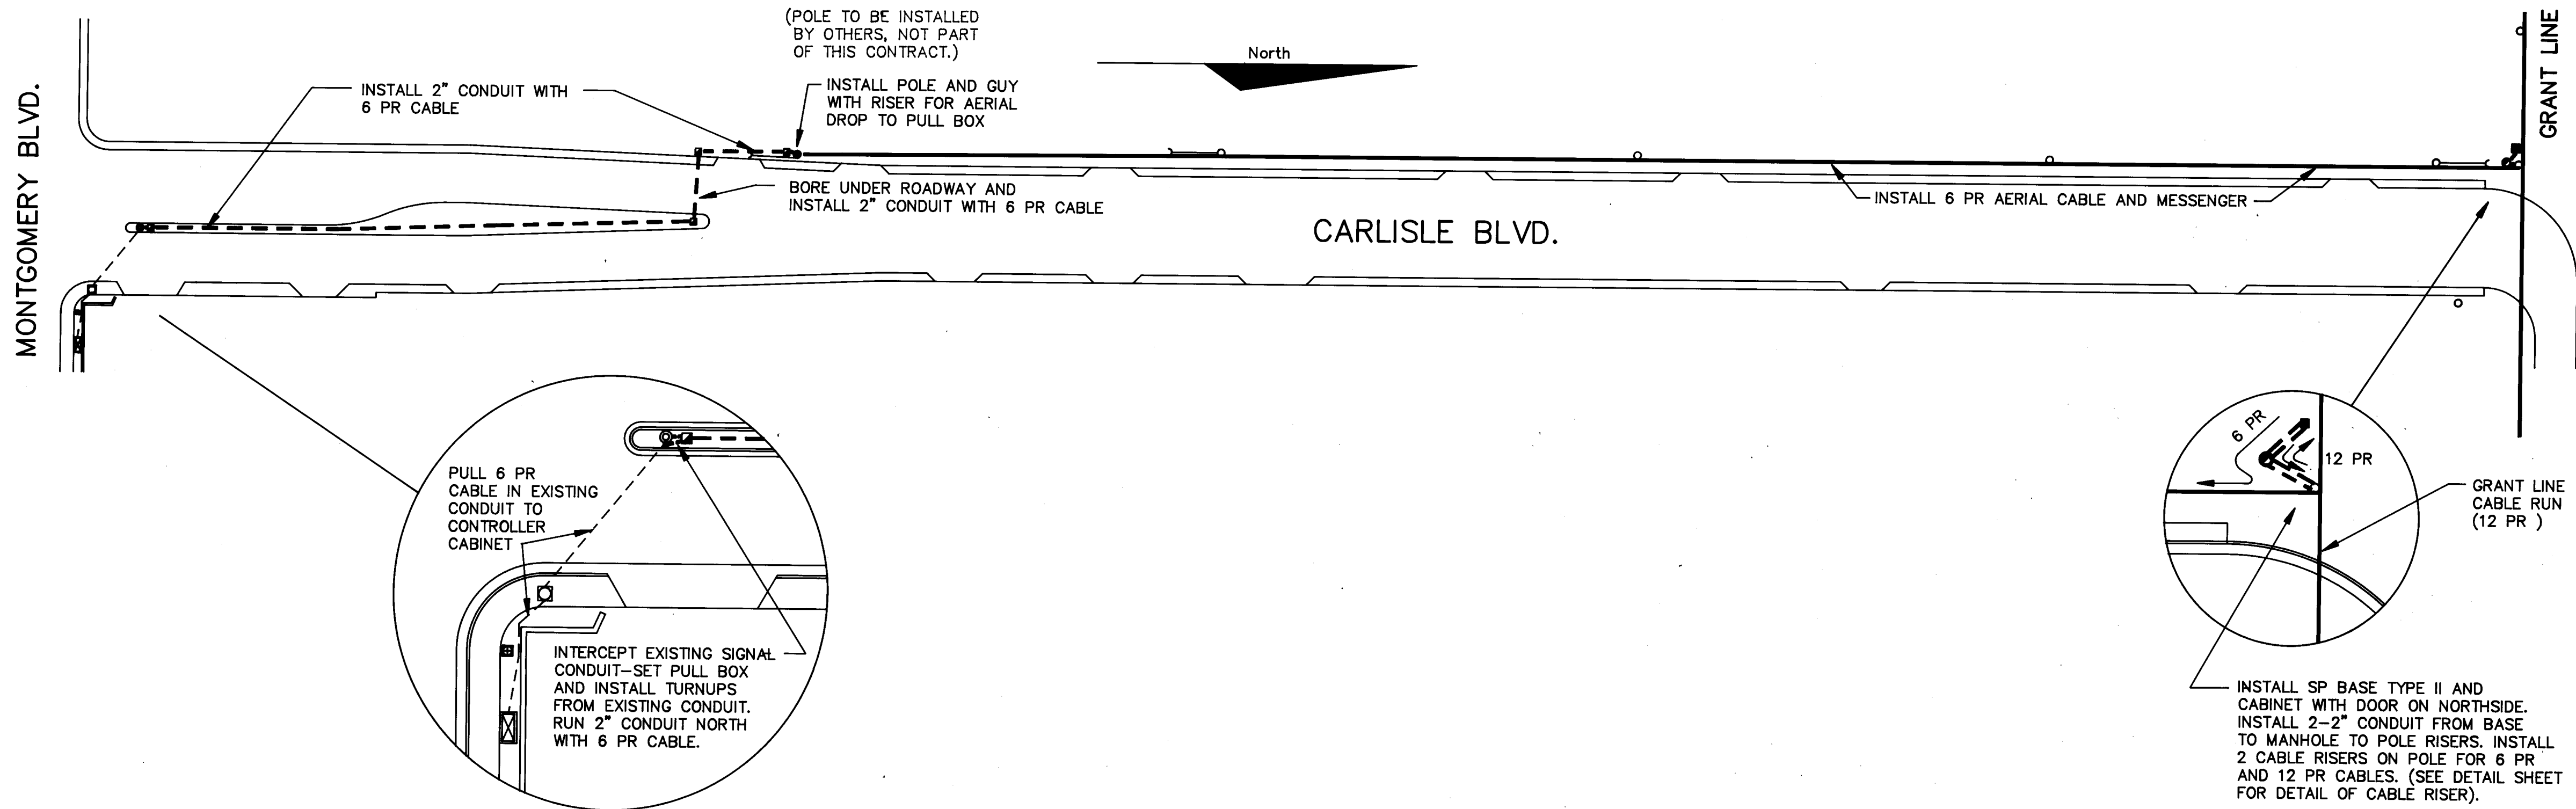


CARLISLE BLVD. FROM MONTGOMERY BLVD. TO GRANT LINE

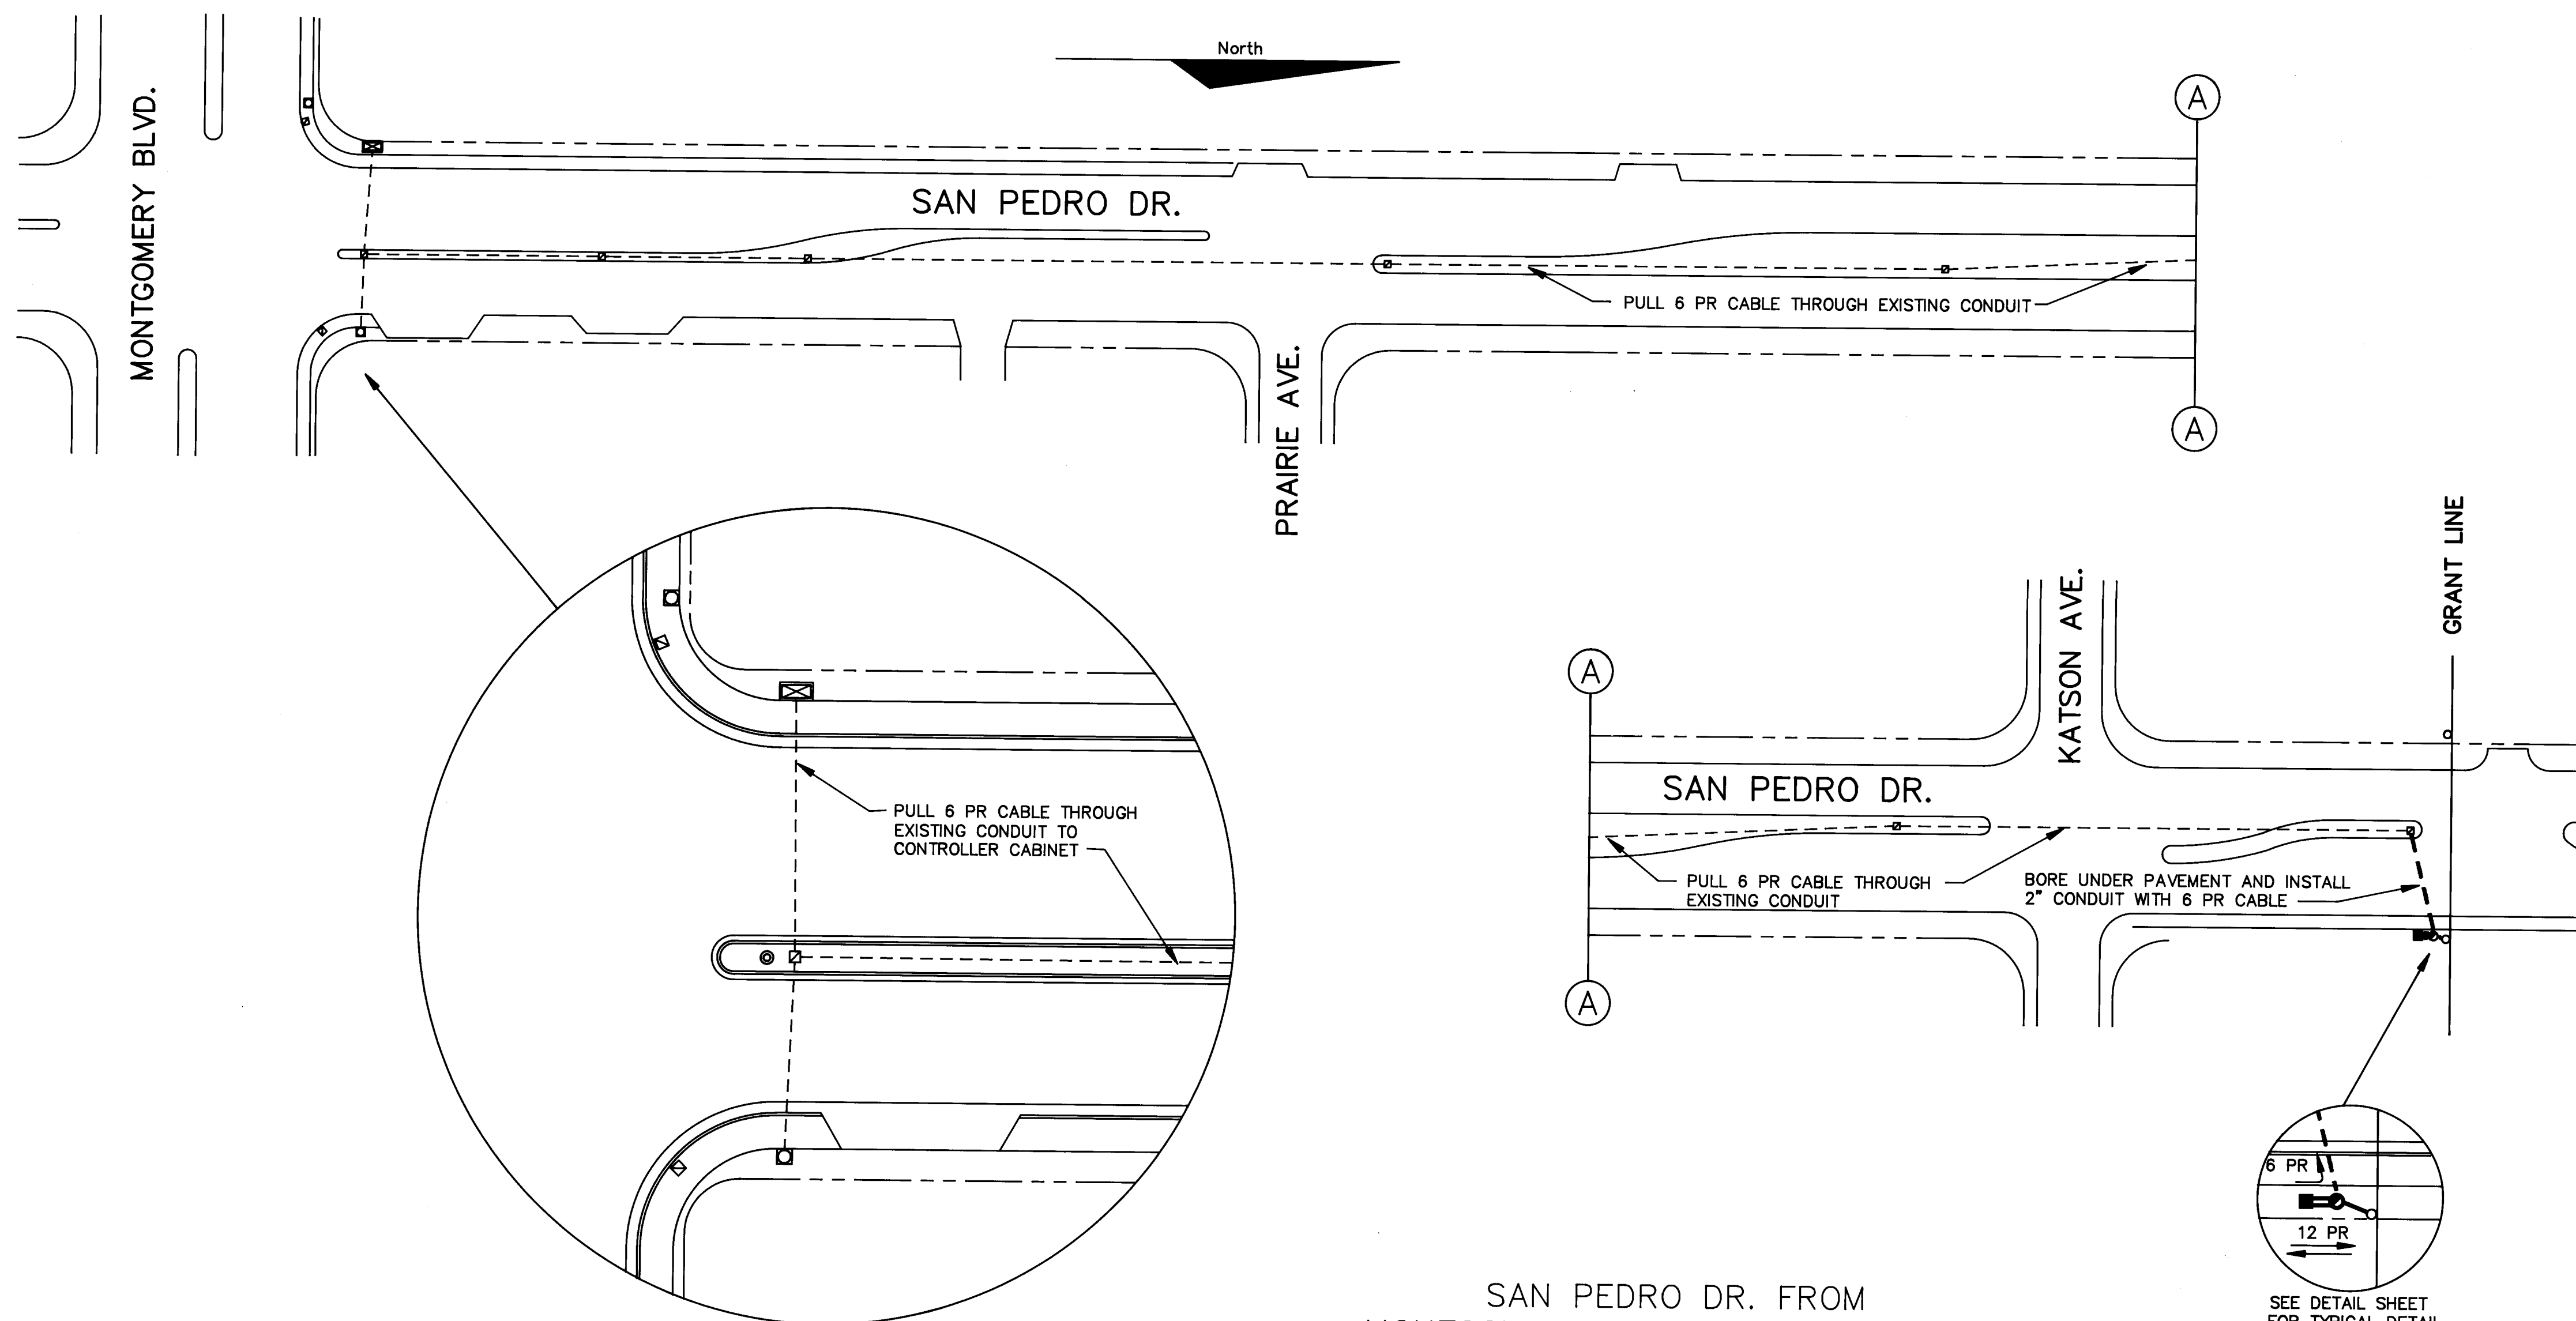

SAN PEDRO DR. FROM MONTGOMERY BLVD. TO GRANT LINE

LEGEND	
EXISTING	PROPOSED

AS BUILT INFORMATION	
CONTRACTOR	DATE
WORK	DATE
REVISIONS	DATE
APPROVALS	DATE
DESIGNED BY	DATE
DRAWN BY	DATE
CHECKED BY	DATE
RECORDED BY	DATE
NO.	NO.

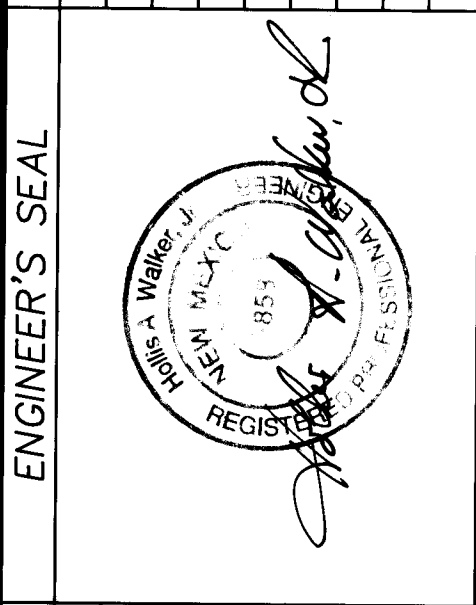

**RECORD DRAWING**

THIS DRAWING HAS BEEN REVISED TO SHOW THOSE CHANGES DURING THE CONSTRUCTION PROCESS REPORTED TO KIMLEY-HORN AND ASSOCIATES, INC. AND CONSIDERED TO BE SIGNIFICANT. THIS DRAWING IS NOT GUARANTEED TO BE "AS BUILT" BUT IS BASED ON THE AVAILABLE INFORMATION.

DATE 10/7/89 BY *James D. ...*

"NO CHANGE"

26 33860993

SCALE:

1"=50' (RUNS)

1"=20' (INSERTS)

**KIMLEY-HORN and ASSOC. INC.**

DALLAS, TEXAS


In Association With

EDWIN L. BECK, P.E., CONSULTANT



ALBUQUERQUE, N.M.

CITY OF ALBUQUERQUE PUBLIC WORKS DEPARTMENT ENGINEERING GROUP			
TITLE: TRAFFIC SIGNAL INTERCONNECT CARLISLE BLVD. AND SAN PEDRO DR. FROM MONTGOMERY BLVD. TO GRANT LINE			
APPROVALS	ENGINEER	DATE	APPROVALS
City Engineer	<i>[Signature]</i>	10/7/89	Liquid Waste
A.C.E. Design	<i>[Signature]</i>	10/7/89	Traffic
A.C. E.-Hydrology	<i>[Signature]</i>	10/7/89	Water
DRAWING NO. 3386		MAP NO. SHEET 9 OF 39	



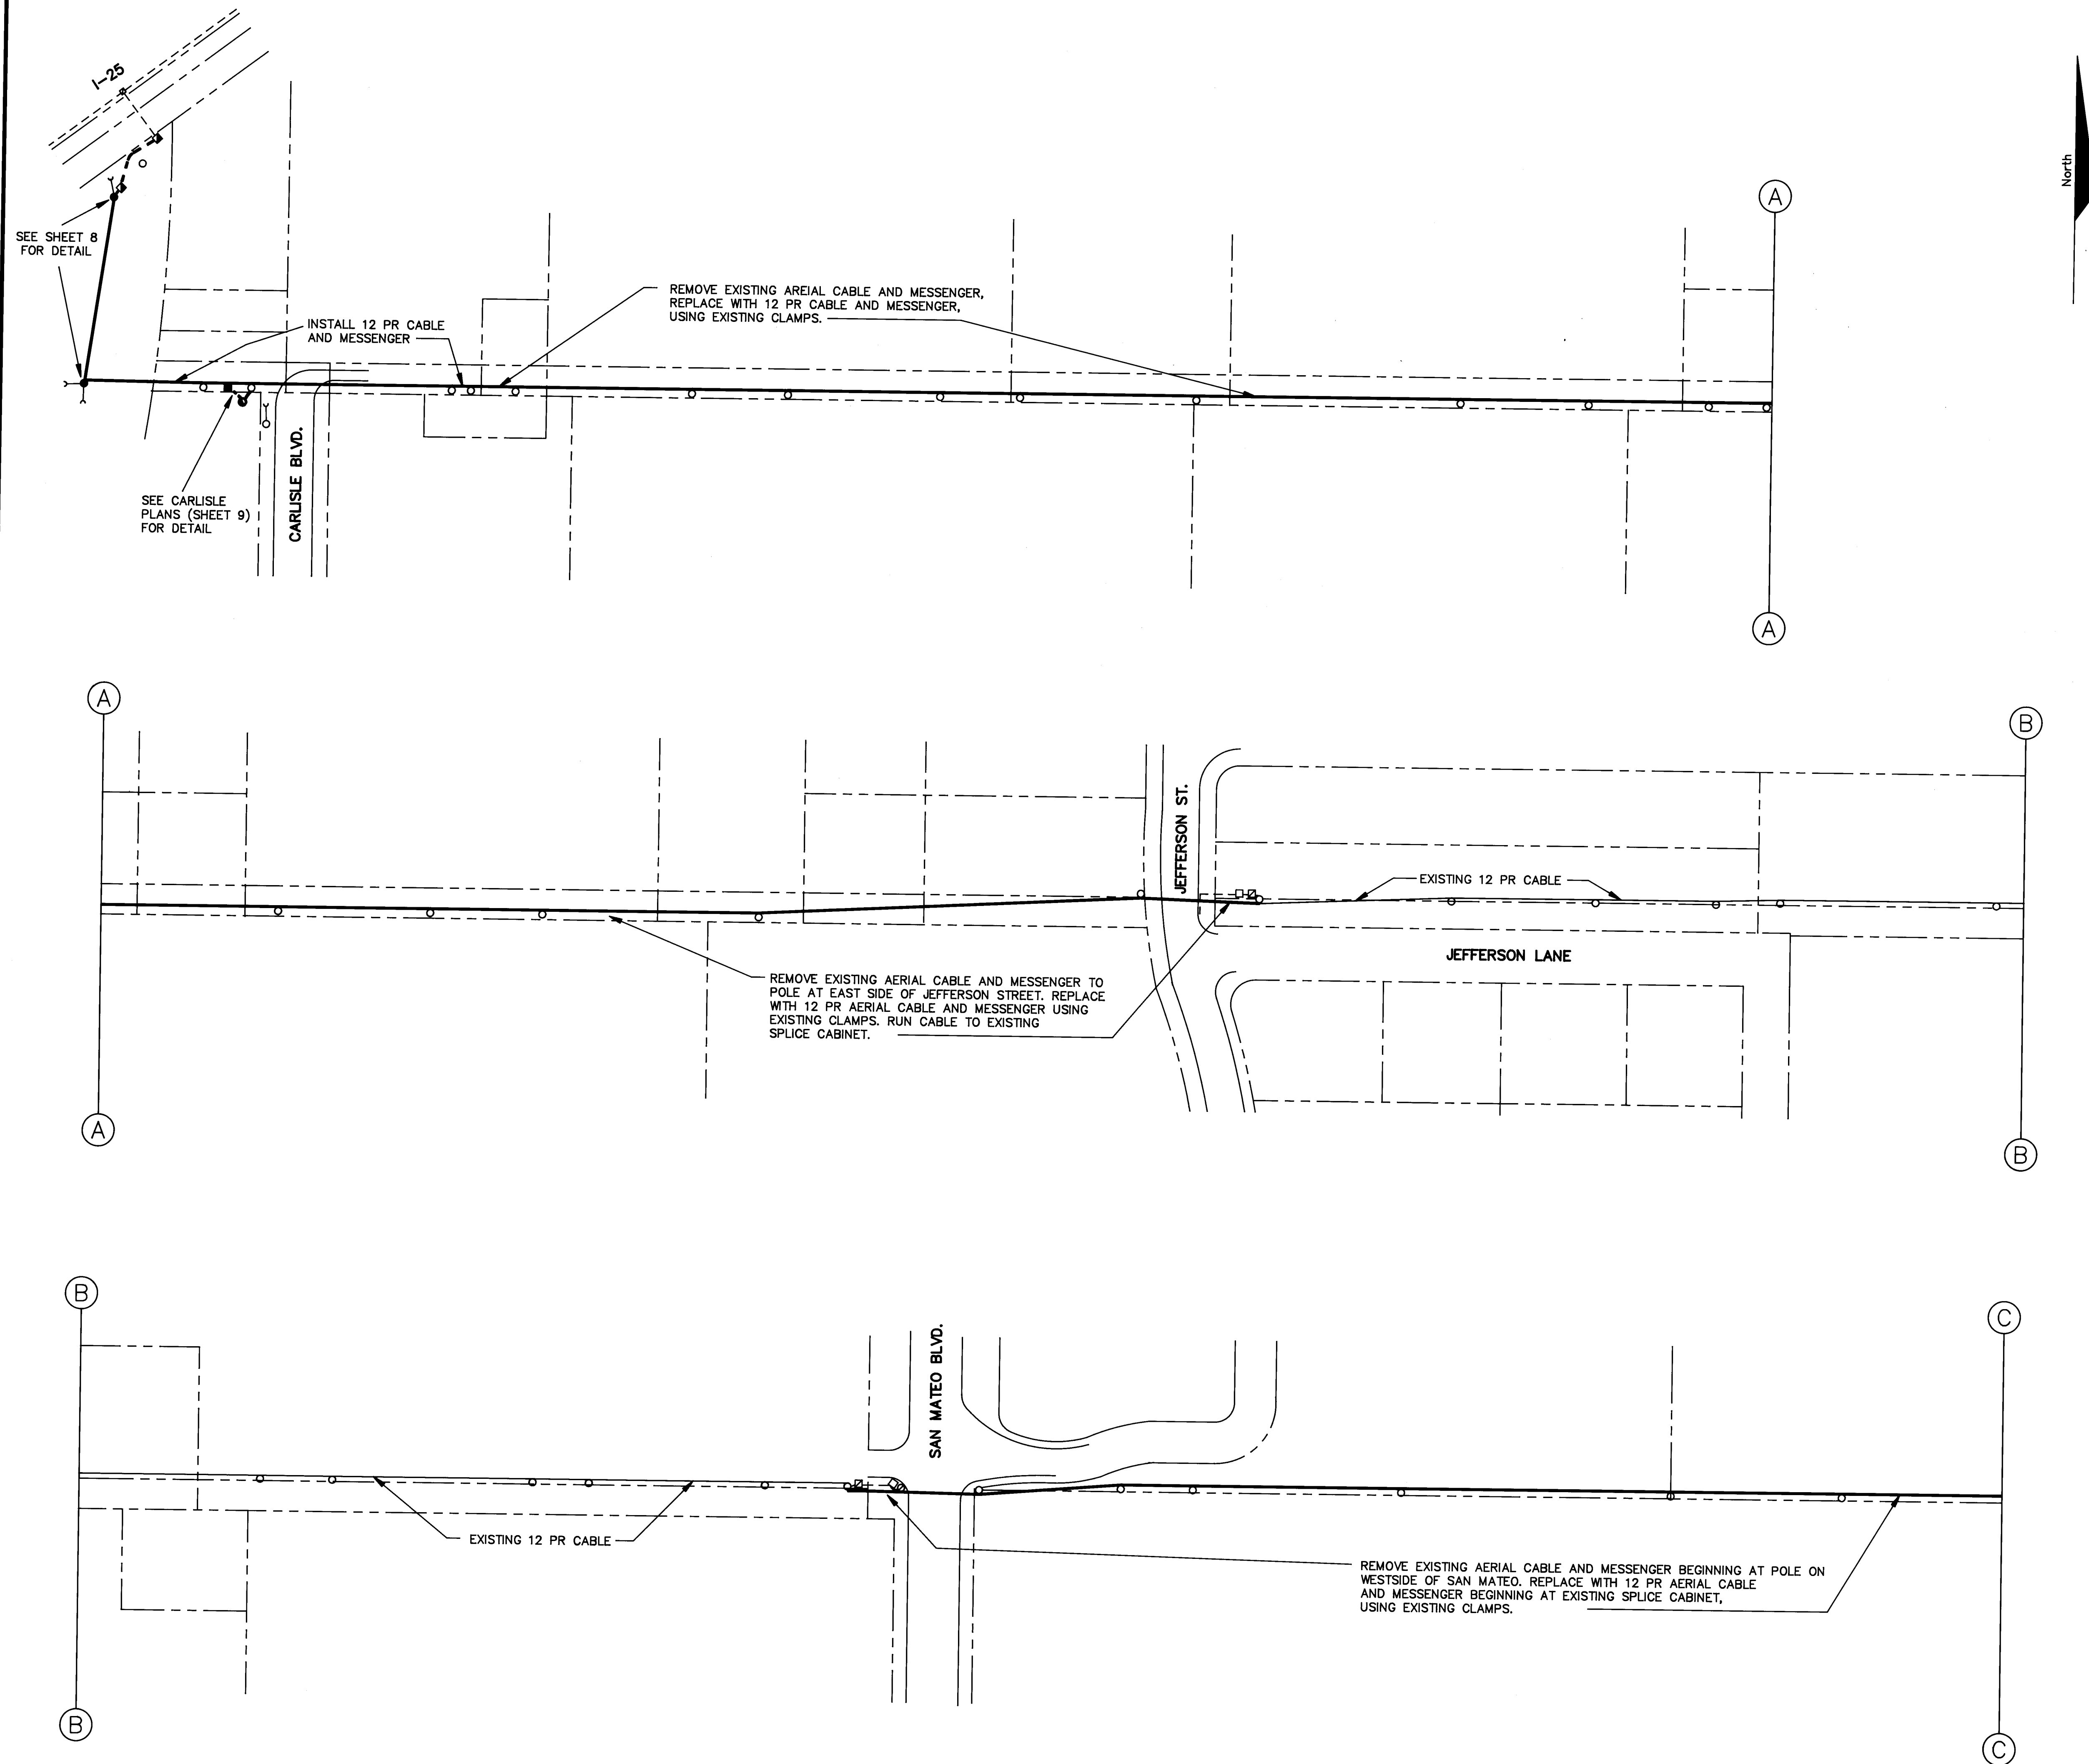

LEGEND						EXISTING		PROPOSED	
<input checked="" type="checkbox"/>	CONTROLLER CABINET							<input checked="" type="checkbox"/>	
<input type="checkbox"/>	SPICE CABINET							<input type="checkbox"/>	
<input checked="" type="checkbox"/>	PULL BOX							<input type="checkbox"/>	
<input type="checkbox"/>	MAN HOLE							<input type="checkbox"/>	
<input type="checkbox"/>	POLE							<input type="checkbox"/>	
<input checked="" type="checkbox"/>	PEDESTAL SIGNAL POLE							<input type="checkbox"/>	
<input type="checkbox"/>	MAST ARM POLE							<input type="checkbox"/>	
<input checked="" type="checkbox"/>	STREET LIGHT POLE							<input type="checkbox"/>	
- - - - -	CONDUIT							- - - - -	
_____	AERIAL CABLE							_____	
_____	ROW							_____	
								BENCH MARKS	
								SURVEY INFORMATION	
								FIELD NOTES	
								NO.	
								BY	
								DATE	
								REMARKS	
								DESIGN REVISIONS	
								NO.	
								DATE	
								DESIGNED BY RWF, JDC	DATE 8/14/87
								DRAWN BY RWF, JWC, EJR	DATE 8/25/87
								CHECKED BY HAW	DATE 8/31/87
CITY OF ALBUQUERQUE PUBLIC WORKS DEPARTMENT ENGINEERING GROUP									
TITLE: TRAFFIC SIGNAL INTERCONNECT GRANT LINE FROM CARLISLE BLVD. TO WYOMING BLVD.									
APPROVALS	ENGINEER	DATE	APPROVALS	ENGINEER	DATE				
City Engineer			Liquid Waste						
A.C.E. Design			Traffic						
A.C. E.-Hydrology			Water						
DRAWING NO. 3386			MAP NO.		SHEET 11 OF 39				

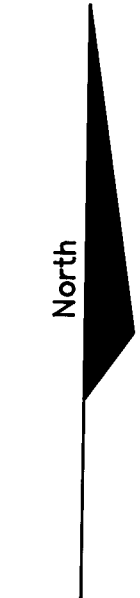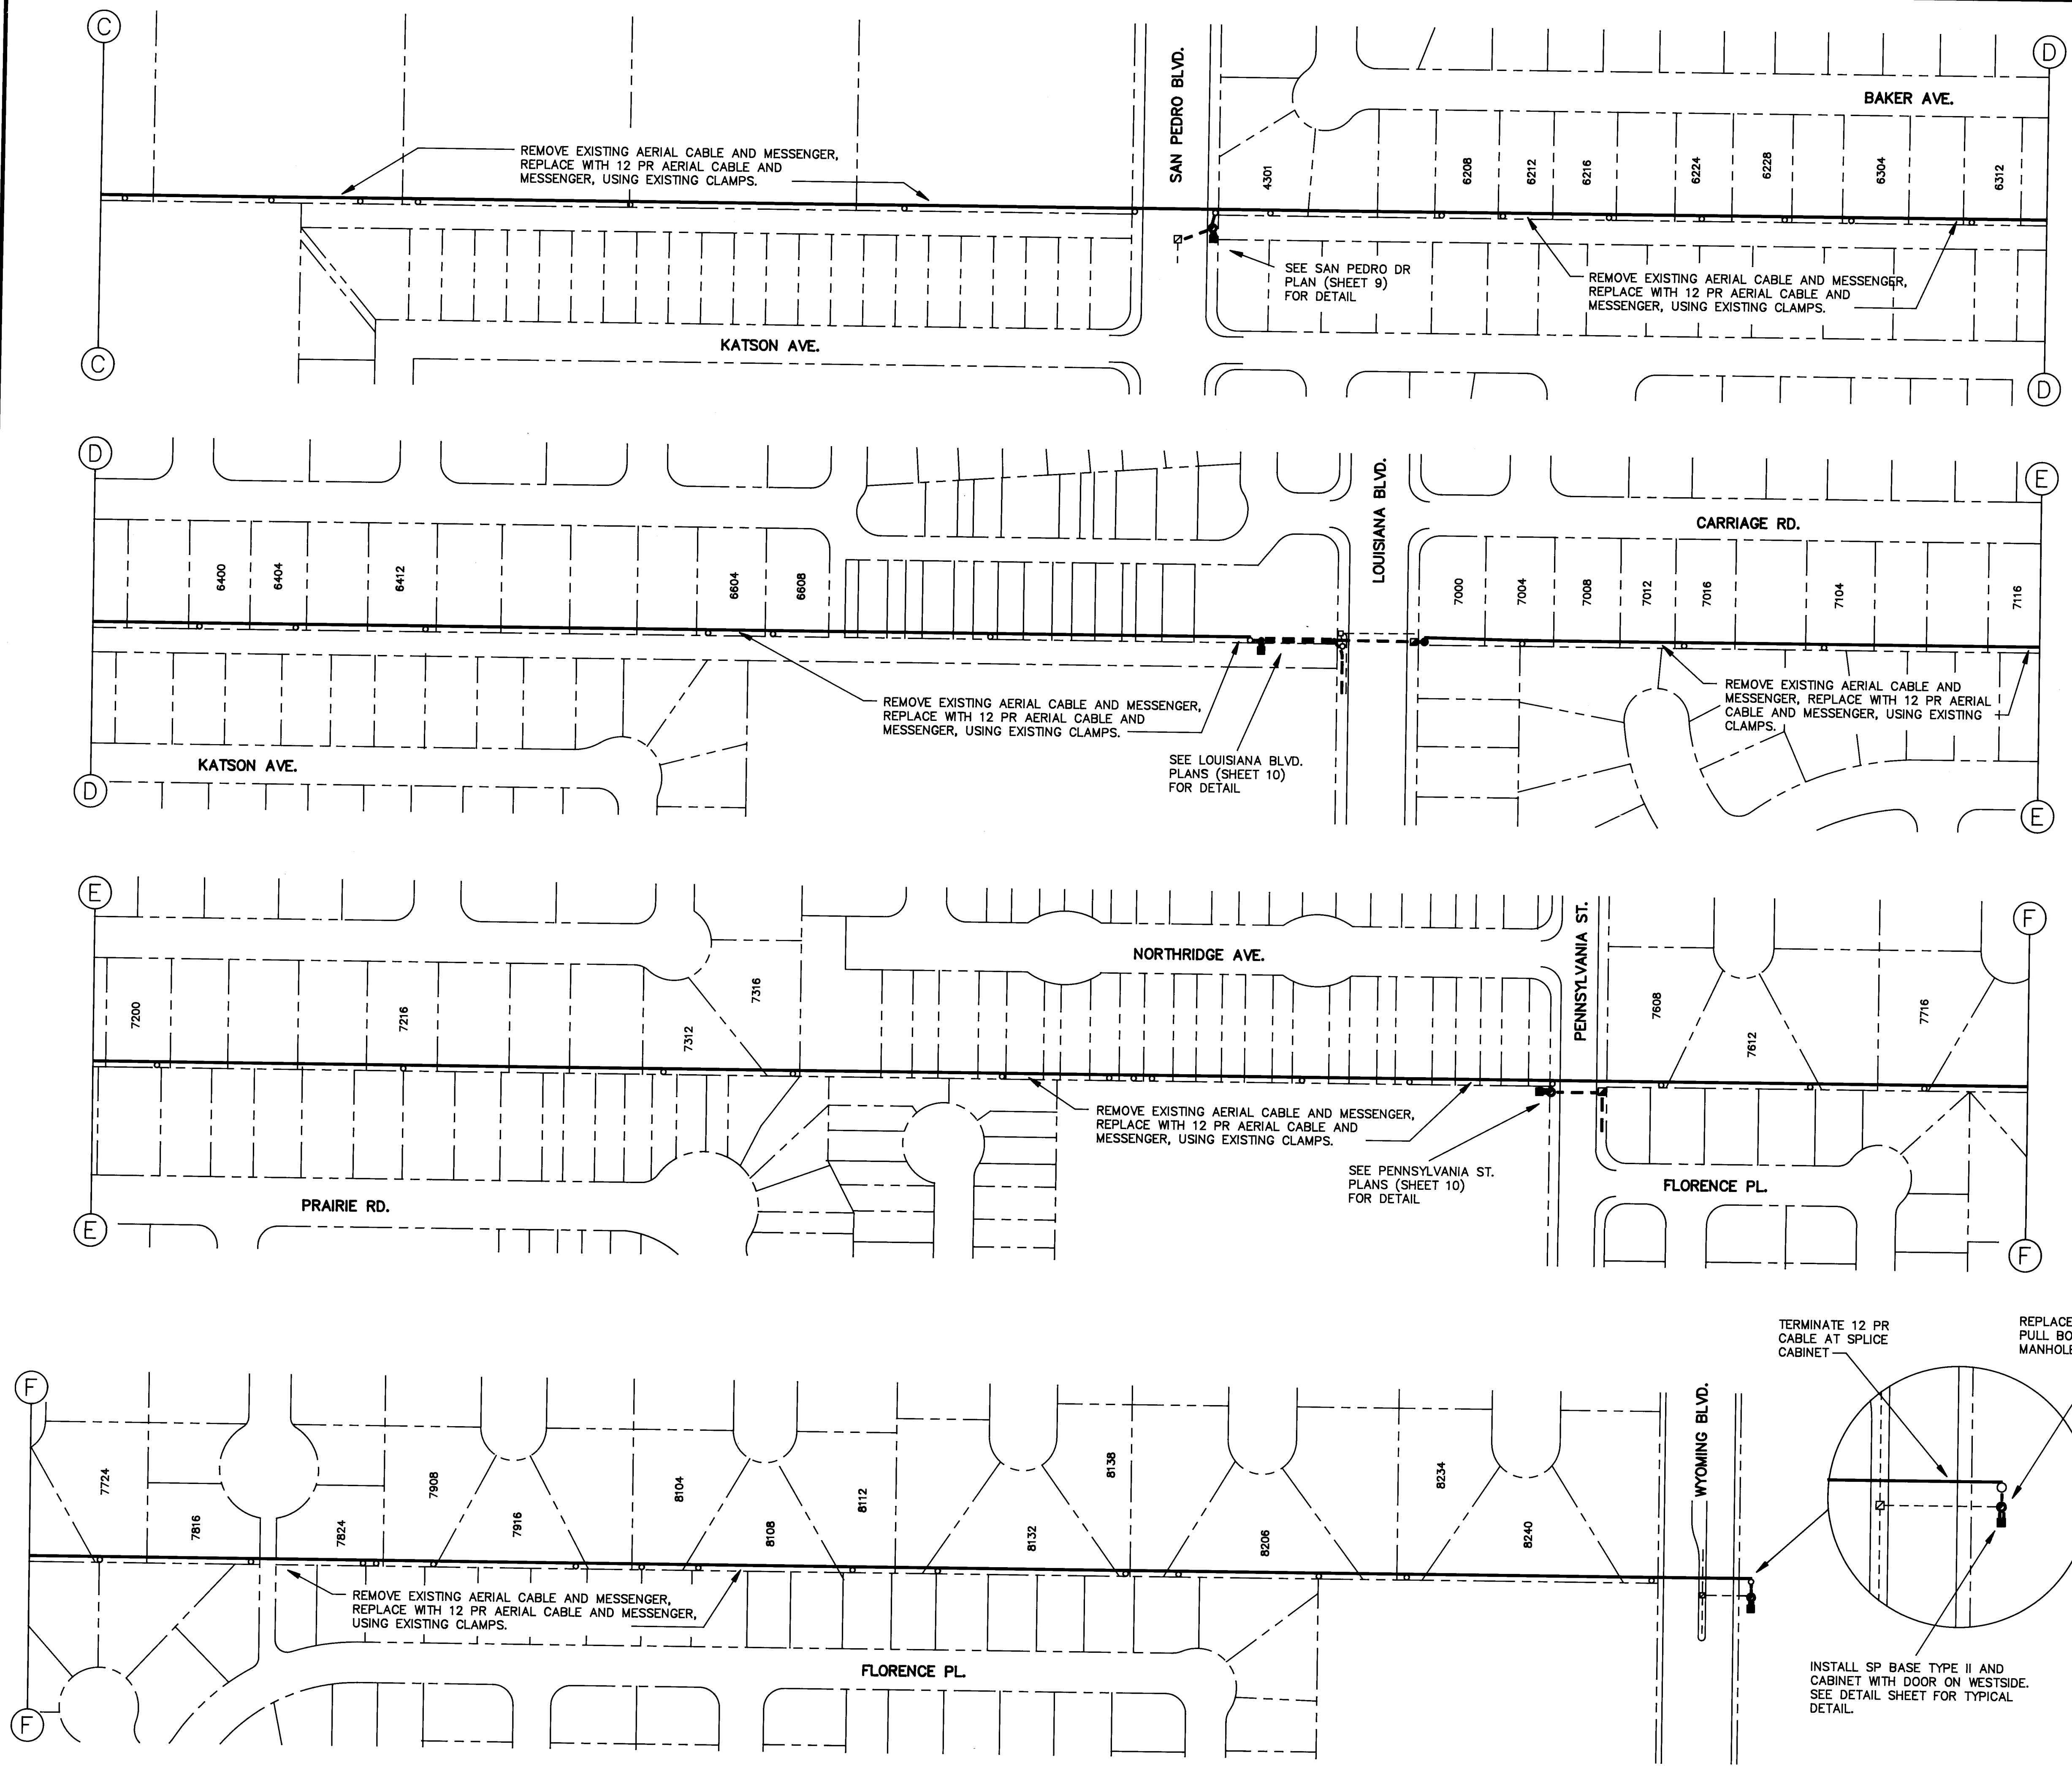

LEGEND	
EXISTING	PROPOSED
CONTROLLER CABINET	CONTROLLER CABINET
SPLICE CABINET	SPLICE CABINET
PULL BOX	PULL BOX
MAN HOLE	MAN HOLE
POLE	POLE
PEDESTAL SIGNAL POLE	PEDESTAL SIGNAL POLE
MAST ARM POLE	MAST ARM POLE
STREET LIGHT POLE	STREET LIGHT POLE
CONDUIT	CONDUIT
AERIAL CABLE	AERIAL CABLE
ROW	ROW

AS BUILT INFORMATION	
CONTRACTOR	DATE
TEC CON	12/2

BENCH MARKS	
NO.	DATE

SURVEY INFORMATION	
FIELD NOTES	DATE

ENGINEER'S SEAL	
NO.	DATE

REVISIONS	
NO.	DATE

DESIGN	
DESIGNED BY	DATE
RWF, JDC	8/14/87

DRAWN BY	
RWF, JWC, EJR	DATE
	8/25/87

CHECKED BY	
HAW	DATE
	8/31/87

**RECORD DRAWING**

THIS DRAWING HAS BEEN REVISED TO SHOW THOSE CHANGES DURING THE CONSTRUCTION PROCESS REPORTED TO KIMLEY-HORN AND ASSOCIATES, INC. AND CONSIDERED TO BE SIGNIFICANT. THIS DRAWING IS NOT GUARANTEED TO BE "AS BUILT" BUT IS BASED ON THE AVAILABLE INFORMATION.

DATE 10/11/09 BY *[Signature]*

**"NO CHANGE"**

26 33861293

SCALE:  
1"=100' (RUNS)  
1"=40' (INSERT)

**KIMLEY-HORN**

KIMLEY-HORN and ASSOC. INC.  
DALLAS, TEXAS  
In Association With  
EDWIN L. BECK, P.E., CONSULTANT  
ALBUQUERQUE, N.M.


CITY OF ALBUQUERQUE  
PUBLIC WORKS DEPARTMENT  
ENGINEERING GROUP

TITLE: TRAFFIC SIGNAL INTERCONNECT  
GRANT LINE  
FROM CARLISLE BLVD. TO WYOMING BLVD.

APPROVALS	ENGINEER	DATE	APPROVALS	ENGINEER	DATE
City Engineer	<i>[Signature]</i>	12/11/09	Liquid Waste	PEBO	1/28/09
A.C.E. Design	<i>[Signature]</i>	"	Traffic	PEBO	1/28/09
A.C. E.-Hydrology	<i>[Signature]</i>	"	Water	PEBO	1/28/09

DRAWING NO. 3386 MAP NO. SHEET 12 OF 39



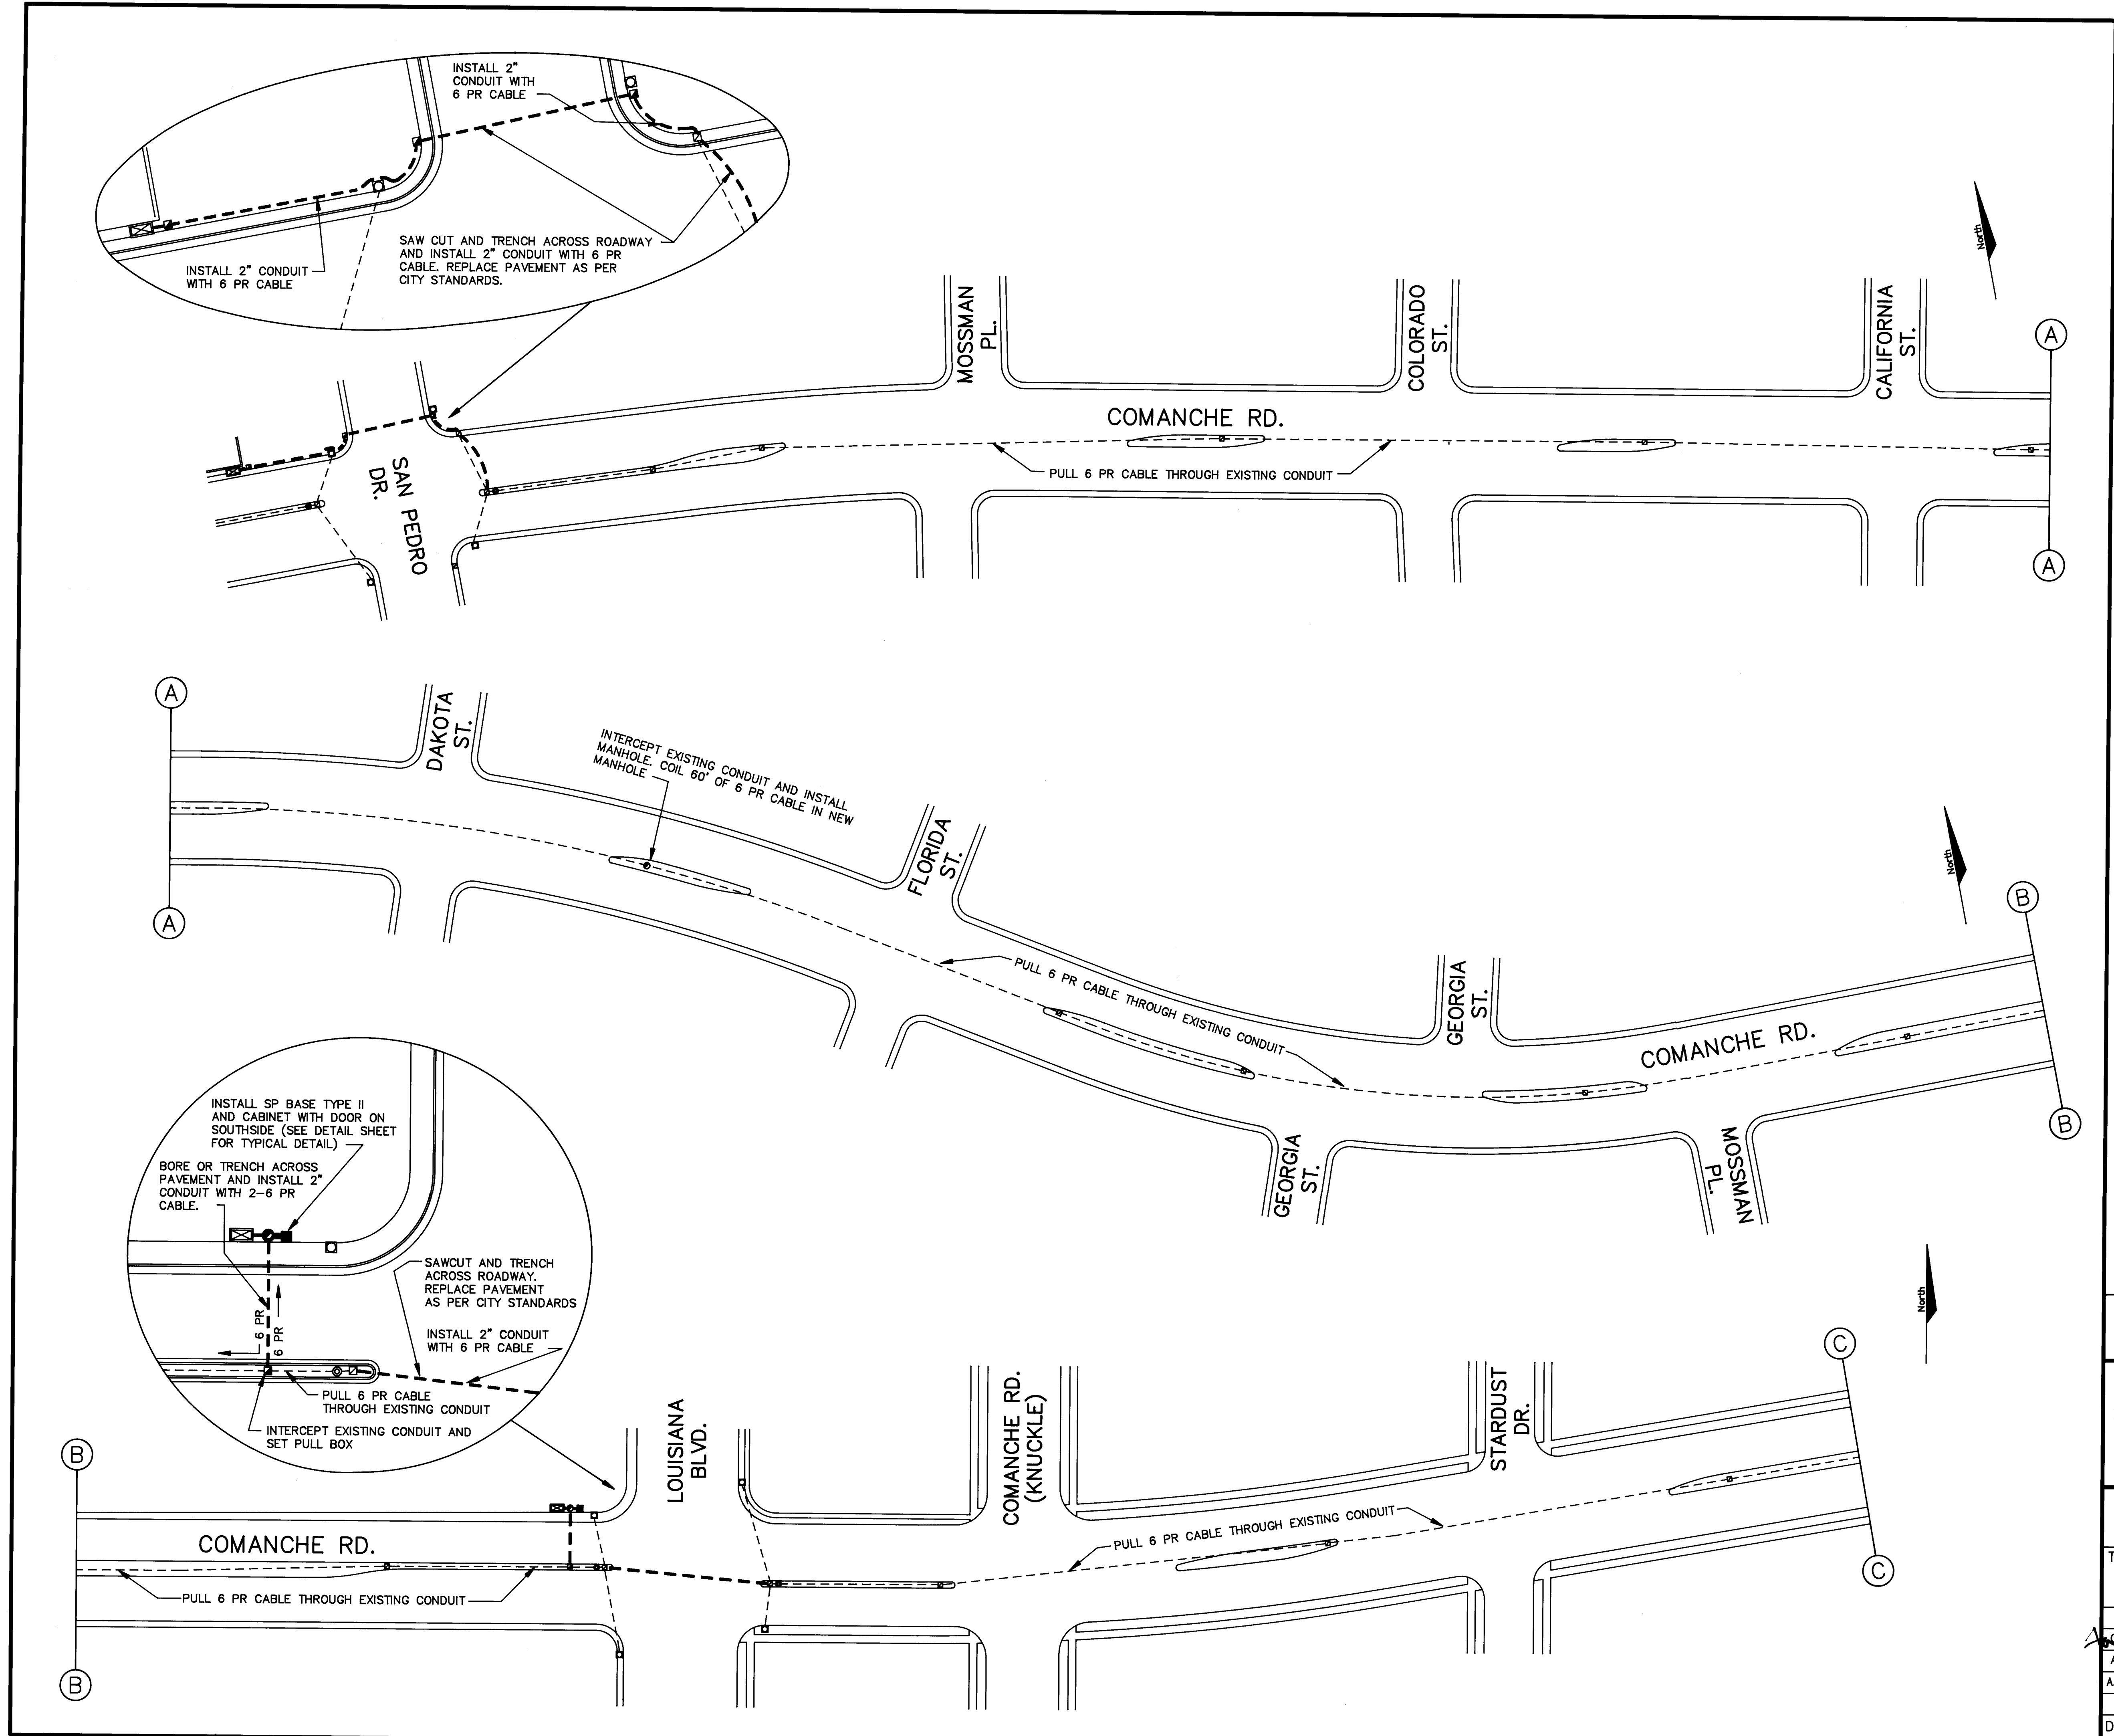

**LEGEND**

EXISTING	PROPOSED
CONTROLLER CABINET	SPLICE CABINET
PULL BOX	MAN HOLE
POLE	PEDESTAL SIGNAL POLE
MAST ARM POLE	STREET LIGHT POLE
CONDUIT	AERIAL CABLE
ROW	

**AS BUILT INFORMATION**

CONTRACTOR	DATE

**BENCH MARKS**

NO.	DATE

**SURVEY INFORMATION**

NO.	DATE

**RECORD DRAWING**

THIS DRAWING HAS BEEN REVISED TO SHOW THOSE CHANGES DURING THE CONSTRUCTION PROCESS REPORTED TO KIMLEY-HORN AND ASSOCIATES, INC. AND CONSIDERED TO BE SIGNIFICANT. THIS DRAWING IS NOT GUARANTEED TO BE "AS BUILT" BUT IS BASED ON THE AVAILABLE INFORMATION.

DATE 10/14/87 BY J. D. B. [Signature]

**"NO CHANGE"**

26 33861393

SCALE:  
1"=50' (RUNS)  
1"=20' (INSERTS)

**KIMLEY-HORN and ASSOC. INC.**  
DALLAS, TEXAS  
In Association With  
EDWIN L. BECK, P.E., CONSULTANT  
ALBUQUERQUE, N.M.

**CITY OF ALBUQUERQUE  
PUBLIC WORKS DEPARTMENT  
ENGINEERING GROUP**

TITLE: TRAFFIC SIGNAL INTERCONNECT  
COMANCHE ROAD  
FROM SAN PEDRO DR. TO WYOMING BLVD.

APPROVALS	ENGINEER	DATE	APPROVALS	ENGINEER	DATE
City Engineer	[Signature]	10/14/87	Liquid Waste	[Signature]	10/14/87
A.C.E. Design	[Signature]	10/14/87	Traffic	[Signature]	10/14/87
A.C.E.-Hydrology	[Signature]	10/14/87	Water	[Signature]	10/14/87


DRAWING NO. 3386 MAP NO. SHEET 13 OF 39










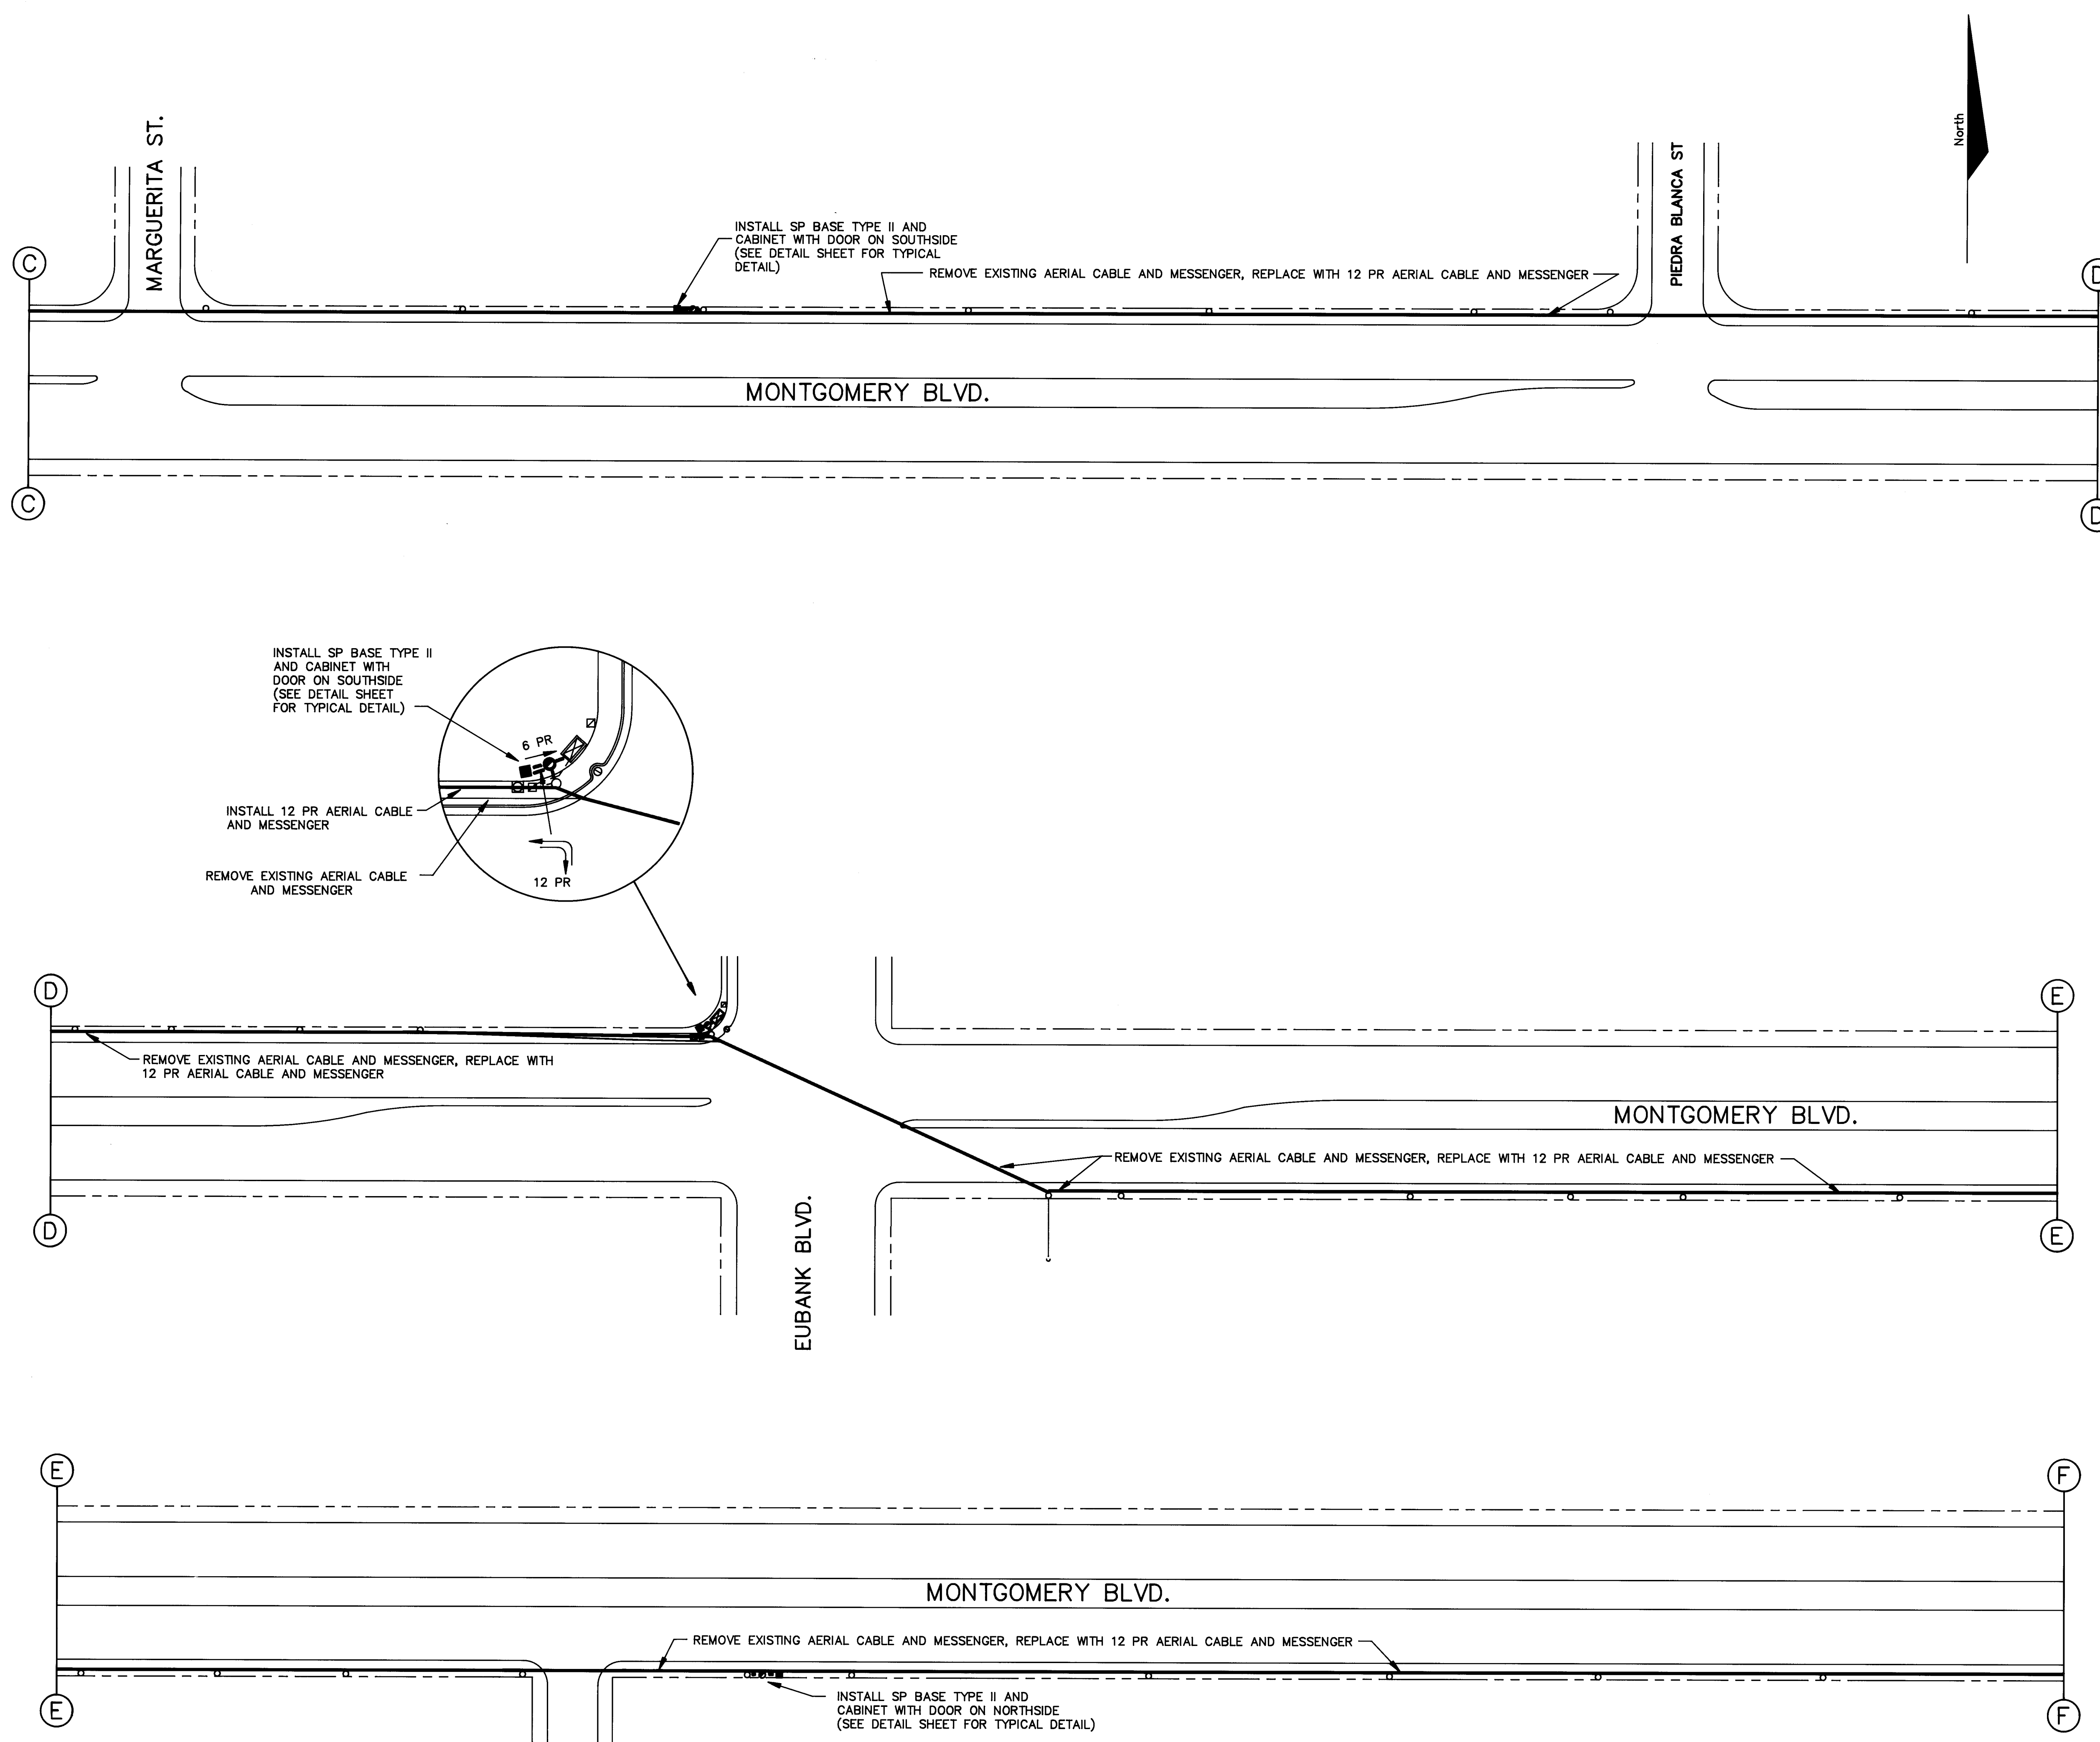

<b>LEGEND</b>			
EXISTING		PROPOSED	
<input checked="" type="checkbox"/>	CONTROLLER CABINET	<input checked="" type="checkbox"/>	
<input type="checkbox"/>	SPLICE CABINET	<input type="checkbox"/>	
<input checked="" type="checkbox"/>	PULL BOX	<input checked="" type="checkbox"/>	
<input checked="" type="radio"/>	MAN HOLE	<input checked="" type="radio"/>	
<input type="radio"/>	POLE	<input type="radio"/>	
<input checked="" type="radio"/>	PEDESTAL SIGNAL POLE	<input checked="" type="radio"/>	
<input checked="" type="checkbox"/>	MAST ARM POLE	<input checked="" type="checkbox"/>	
<input checked="" type="radio"/>	STREET LIGHT POLE	<input checked="" type="radio"/>	
----- CONDUIT -----			
_____ AERIAL CABLE _____			
---- ROW ----			
		<b>BENCH MARKS</b>	
		<b>SURVEY INFORMATION</b>	
		FIELD NOTES BY DATE NO.	
		<b>ENGINEER'S SEAL</b>	
<div style="border: 1px solid black; padding: 5px; margin-bottom: 5px;"> <b>RECORD DRAWING</b>             THIS DRAWING HAS BEEN REVISED TO SHOW THOSE CHANGES DURING THE CONSTRUCTION PROCESS REPORTED TO KIMLEY-HORN AND ASSOCIATES, INC. AND CONSIDERED TO BE SIGNIFICANT. THIS DRAWING IS NOT GUARANTEED TO BE "AS BUILT" BUT IS BASED ON THE AVAILABLE INFORMATION.             DATE <u>10/31/89</u> BY <u>Juan Tabo</u> </div> <p style="margin-left: 40px;">"NO CHANGE" C of A #ND Maps &amp; Records 26 33861793</p> <p style="text-align: center;"><b>SCALE:</b> 1"=50' (RUNS) 1"=20' (INSERTS)</p> <div style="border: 1px solid black; width: fit-content; margin: auto; padding: 2px; font-weight: bold;">Kimley-Horn</div> <p style="text-align: center;"><b>KIMLEY—HORN and ASSOC. INC.</b> DALLAS, TEXAS In Association With <b>EDWIN L. BECK, P.E., CONSULTANT</b> ALBUQUERQUE, N.M.</p>		<b>REMARKS</b>	
		<b>DESIGNED BY</b>	RWF JDC
		<b>DRAWN BY</b>	RWF JMC EJR
		<b>CHECKED BY</b>	HAW
<b>CITY OF ALBUQUERQUE</b> <b>PUBLIC WORKS DEPARTMENT</b> <b>ENGINEERING GROUP</b>			
TITLE: <b>TRAFFIC SIGNAL INTERCONNECT MONTGOMERY BLVD. FROM WYOMING BLVD. TO JUAN TABO ROAD</b>			
APPROVALS	ENGINEER	DATE	APPROVALS      ENGINEER      DATE
A City Engineer	[Signature]	1/10/88	Liquid Waste [Signature] 1/10/88
A.C.E. Design	[Signature]	" "	Traffic [Signature] 1/25/88
A.C. E.—Hydrology	[Signature]	" "	Water [Signature] 1/25/88
			Traffic Operations [Signature] 1/25/88
DRAWING NO.        33861793		MAP NO.	SHEET        17     OF        39

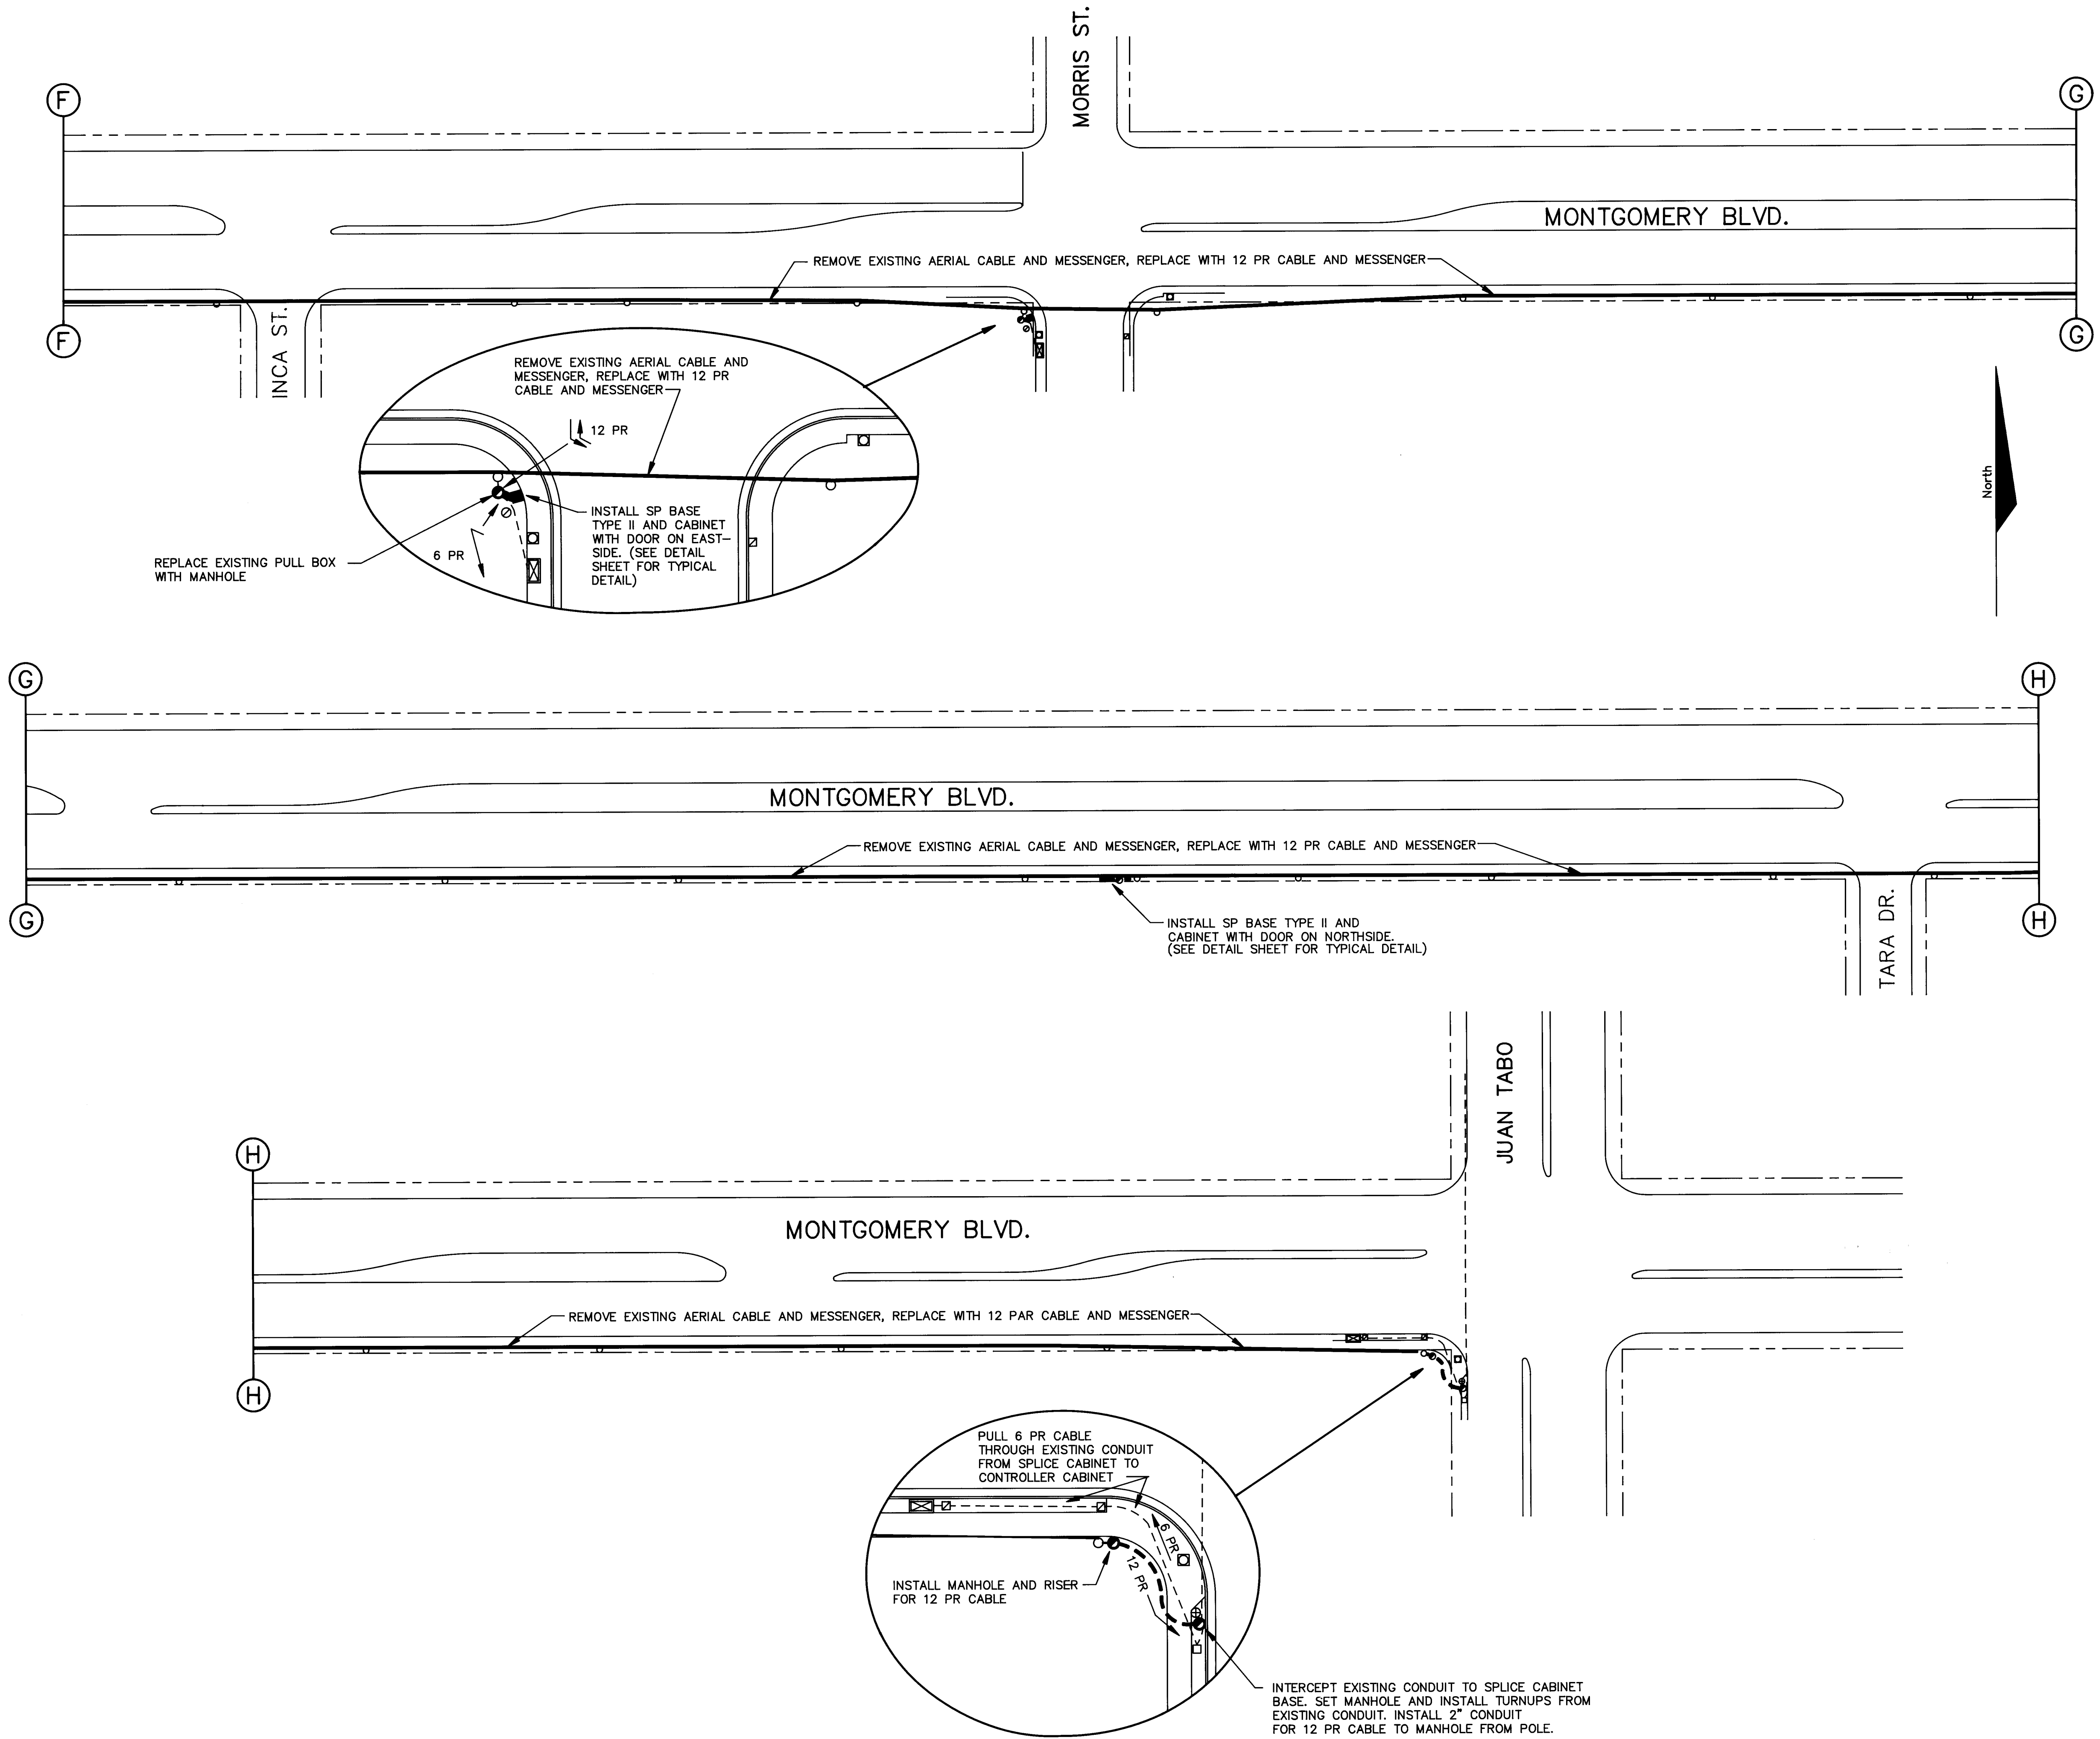

**LEGEND**

**EXISTING**

CONTROLLER CABINET

SPLICE CABINET

PULL BOX

MAN HOLE

POLE

PEDESTAL SIGNAL POLE

MAST ARM POLE

STREET LIGHT POLE

CONDUIT

AERIAL CABLE

ROW

**PROPOSED**

CONTROLLER CABINET

SPLICE CABINET

PULL BOX

MAN HOLE

POLE

PEDESTAL SIGNAL POLE

MAST ARM POLE

STREET LIGHT POLE

CONDUIT

AERIAL CABLE

ROW

**AS BUILT INFORMATION**

CONTRACTOR JET CO. 1/22

DATE 8/8

INSPECTED BY C.O.A.

DATE 11/88

FIELD BY T.B. 7/2

DATE 11/88

DRAWING BY S.B. 2/20/2012

DATE 11/88

CORRECTED BY E.BECK

DATE 11/88

RECORDED BY

DATE

NO.

**SURVEY INFORMATION**

FIELD NOTES

BY

DATE

NO.

**ENGINEER'S SEAL**

**RECORD DRAWING**

THIS DRAWING HAS BEEN REVISED TO SHOW THOSE CHANGES DURING THE CONSTRUCTION PROCESS REPORTED TO KIMLEY-HORN AND ASSOCIATES, INC. AND CONSIDERED TO BE SIGNIFICANT. THIS DRAWING IS NOT GUARANTEED TO BE "AS BUILT" BUT IS BASED ON THE AVAILABLE INFORMATION.

DATE 10/31/09 BY *Edwin L. Beck*

**"NO CHANGE"**

26 33861893

**SCALE:**

1"=50' (RUNS)

1"=20' (INSERTS)

KIMLEY-HORN and ASSOC. INC.

DALLAS, TEXAS

In Association With

EDWIN L. BECK, P.E., CONSULTANT

ALBUQUERQUE, N.M.

**REVISIONS**

DESIGN

REMARKS

NO.

DATE

DESIGNED BY RWF, JDC

DATE 8/14/87

DRAWN BY JWC, EJR, RWF

DATE 8/25/87

CHECKED BY HAW

DATE 8/31/87

**CITY OF ALBUQUERQUE**

**PUBLIC WORKS DEPARTMENT**

**ENGINEERING GROUP**

**TITLE:**

**TRAFFIC SIGNAL INTERCONNECT**

**MONTGOMERY BLVD.**

**FROM WYOMING BLVD. TO JUAN TABO ROAD**

**APPROVALS**

**ENGINEER**

**DATE**

**APPROVALS**

**ENGINEER**

**DATE**

City Engineer *RWF* *11/21* Liquid Waste *RWF* *1/25/11*

A.C.E. Design *RWF* *11/21* Traffic *RWF* *1/25/11*

A.C. E.-Hydrology *N/A* Water *RWF* *1/25/11*

*Traffic Operations* *ASB* *1/25/11*

**DRAWING NO.**

**3386**


**MAP NO.**

**SHEET**

**18**

**OF**

**39**

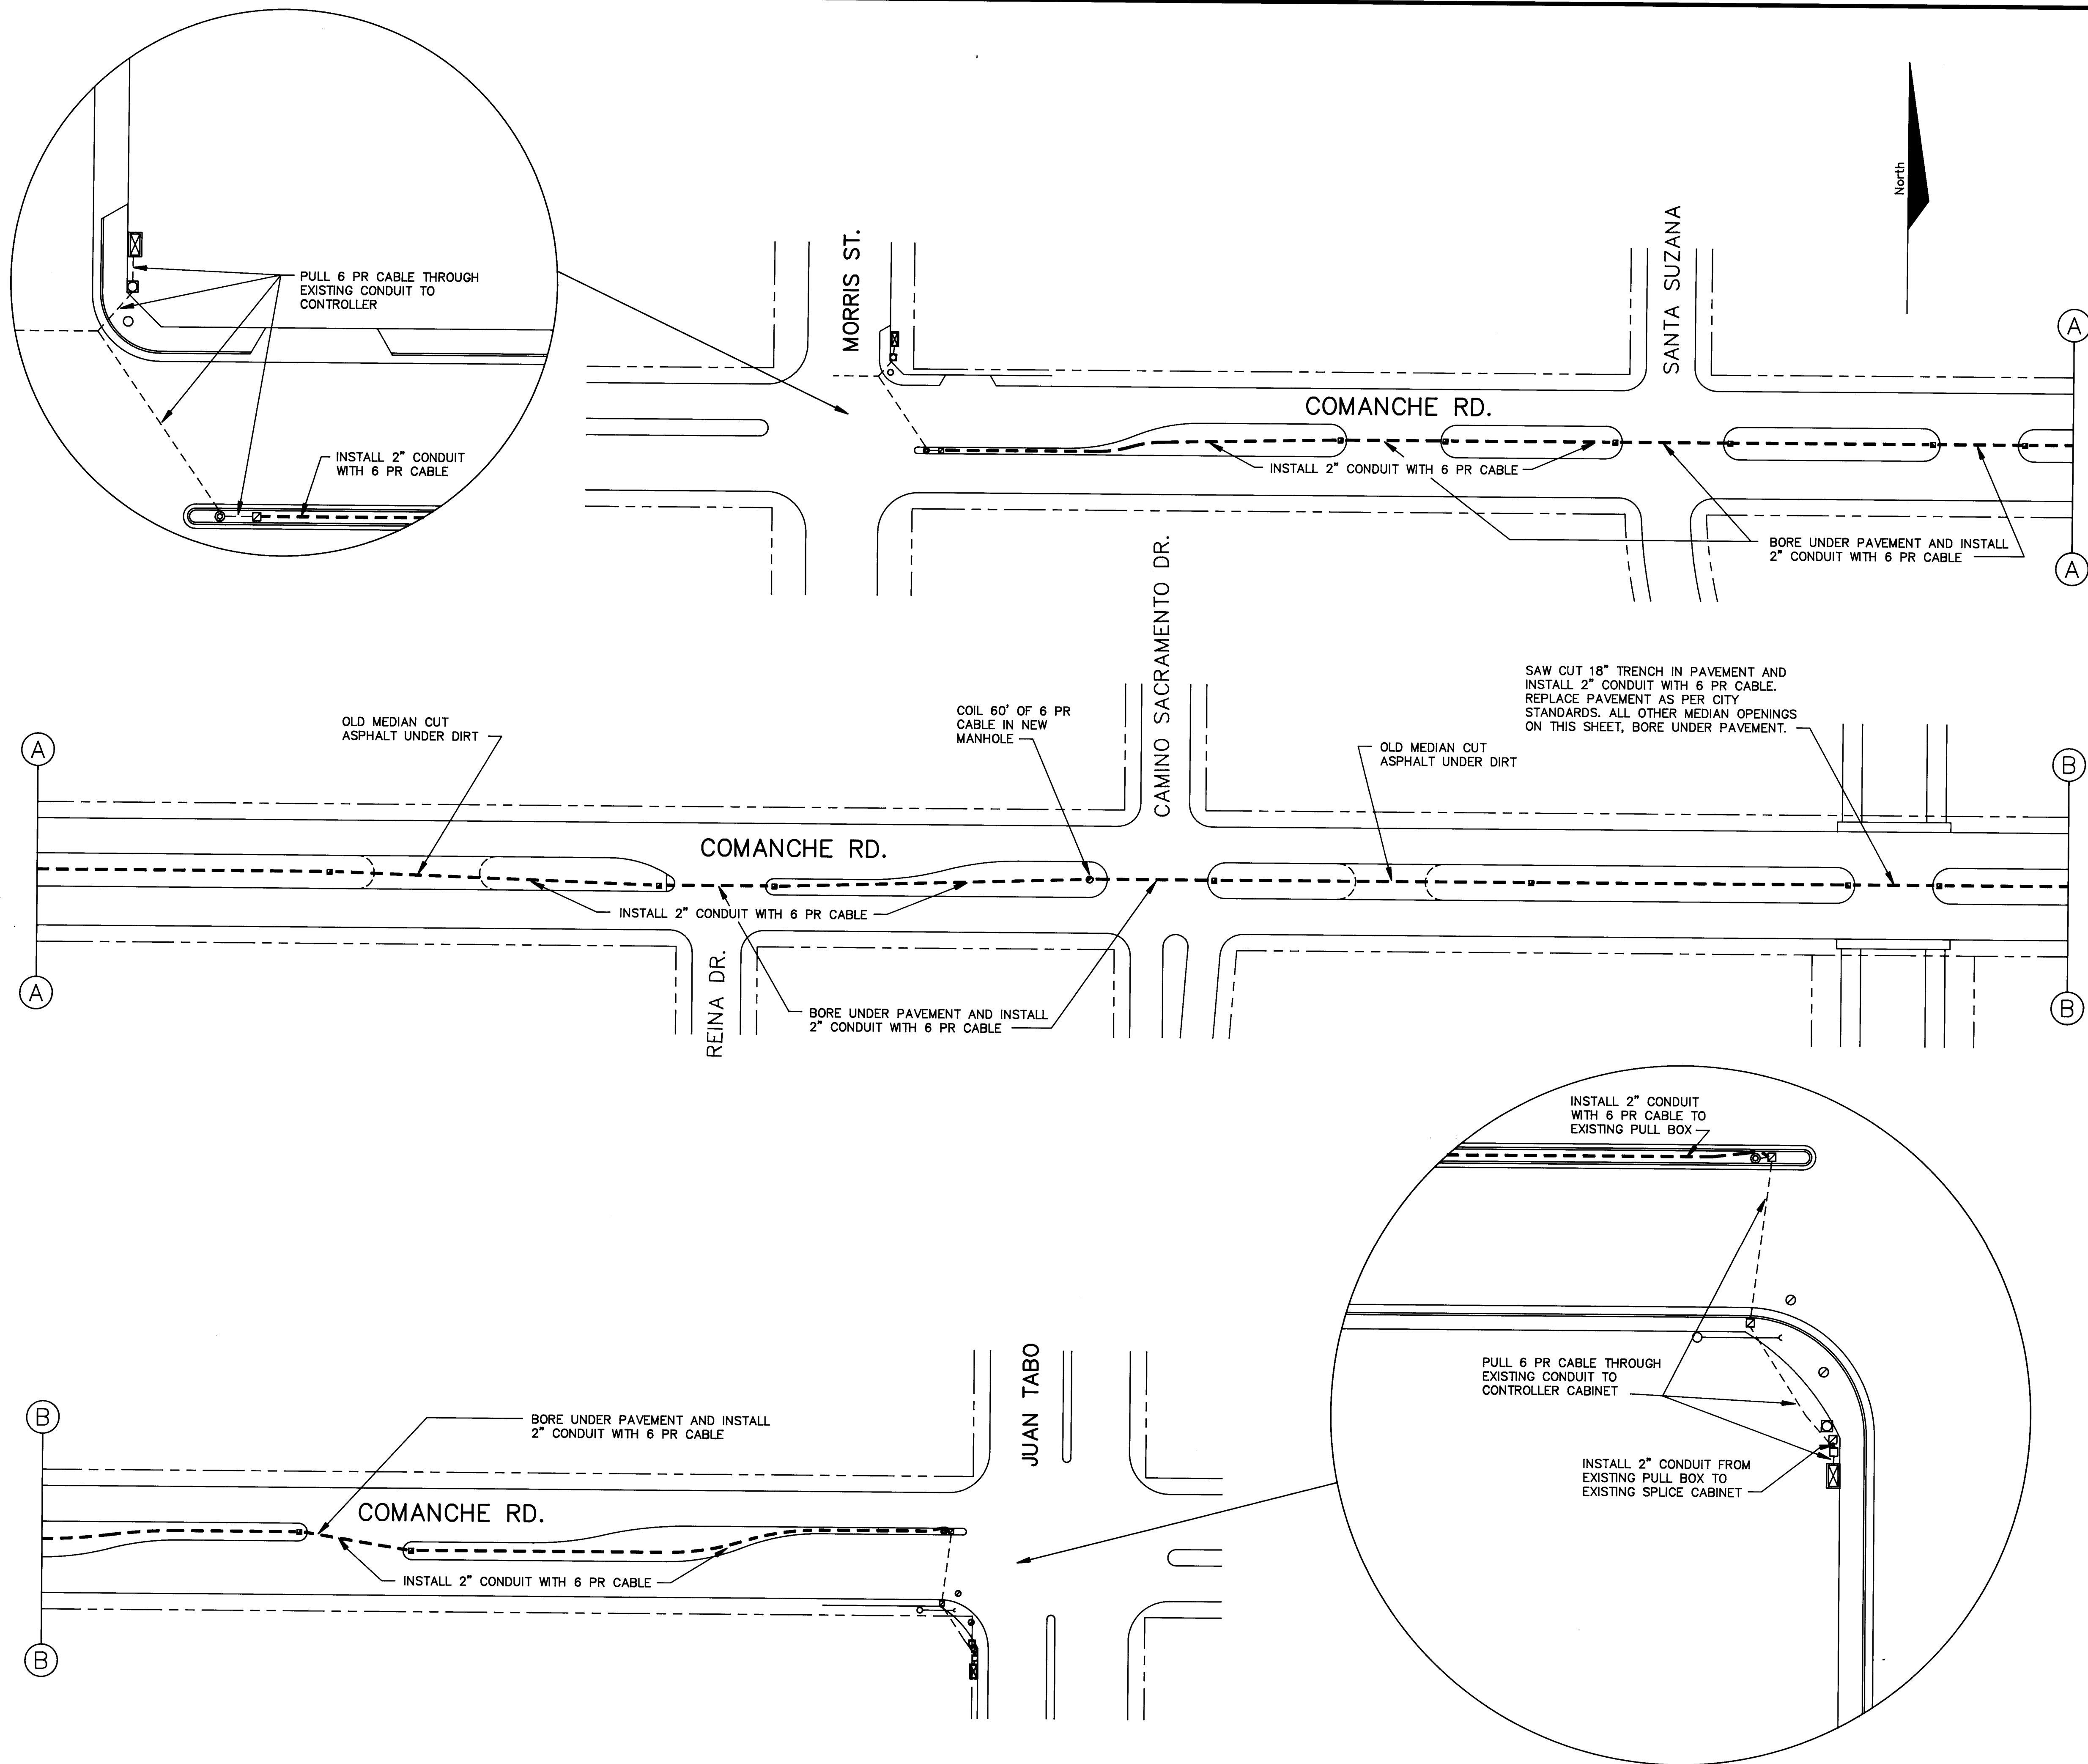

LEGEND

EXISTING

PROPOSED

CONTROLLER CABINET

SPLICE CABINET

PULL BOX

MAN HOLE

POLE

PEDESTAL SIGNAL POLE

MAST ARM POLE

STREET LIGHT POLE

CONDUIT

AERIAL CABLE

ROW

AS BUILT INFORMATION

CONTRACTOR JET CON

WORK ORDER NO. COA-

ISSUED BY DATE 8/87

REVISIONS

ACCEPTANCE BY DATE 11/87

VERIFICATION BY DATE 11/87

DESIGNED BY DATE 11/87

DRAWN BY DATE 11/87

RECORDED BY DATE

NO.

SURVEY INFORMATION

FIELD NOTES

NO.

BY

DATE

ENGINEER'S SEAL

REVISIONS

DESIGN

NO.

DATE

DESIGNED BY RWF, JDC

DATE 8/14/87

DRAWN BY RWF, JWC, EJR

DATE 8/25/87

CHECKED BY HAW

DATE 8/31/87

RECORD DRAWING

THIS DRAWING HAS BEEN REVISED TO SHOW THOSE CHANGES DURING THE CONSTRUCTION PROCESS REPORTED TO KIMLEY-HORN AND ASSOCIATES, INC. AND CONSIDERED TO BE SIGNIFICANT. THIS DRAWING IS NOT GUARANTEED TO BE "AS BUILT" BUT IS BASED ON THE AVAILABLE INFORMATION.

DATE 10/31/89 BY Jambauer

"NO CHANGES"

26 33861993

SCALE:

1"=50' (RUNS)

1"=20' (INSERTS)

KIMLEY-HORN and ASSOC. INC.

DALLAS, TEXAS

In Association With

EDWIN L. BECK, P.E., CONSULTANT

ALBUQUERQUE, N.M.

CITY OF ALBUQUERQUE

MUNICIPAL DEVELOPMENT DEPARTMENT

ENGINEERING DIVISION

TITLE:

TRAFFIC SIGNAL INTERCONNECT

COMANCHE ROAD

FROM MORRIS ST. TO JUAN TABO ROAD

APPROVALS

ENGINEER

DATE

APPROVALS

ENGINEER

DATE

City Engineer

10/2/89

10/2/89

A.C.E. Design

10/2/89

10/2/89

A.C. E.-Hydrology

10/2/89

10/2/89

DRAWING NO.


3386

MAP NO.

SHEET 19 OF 39






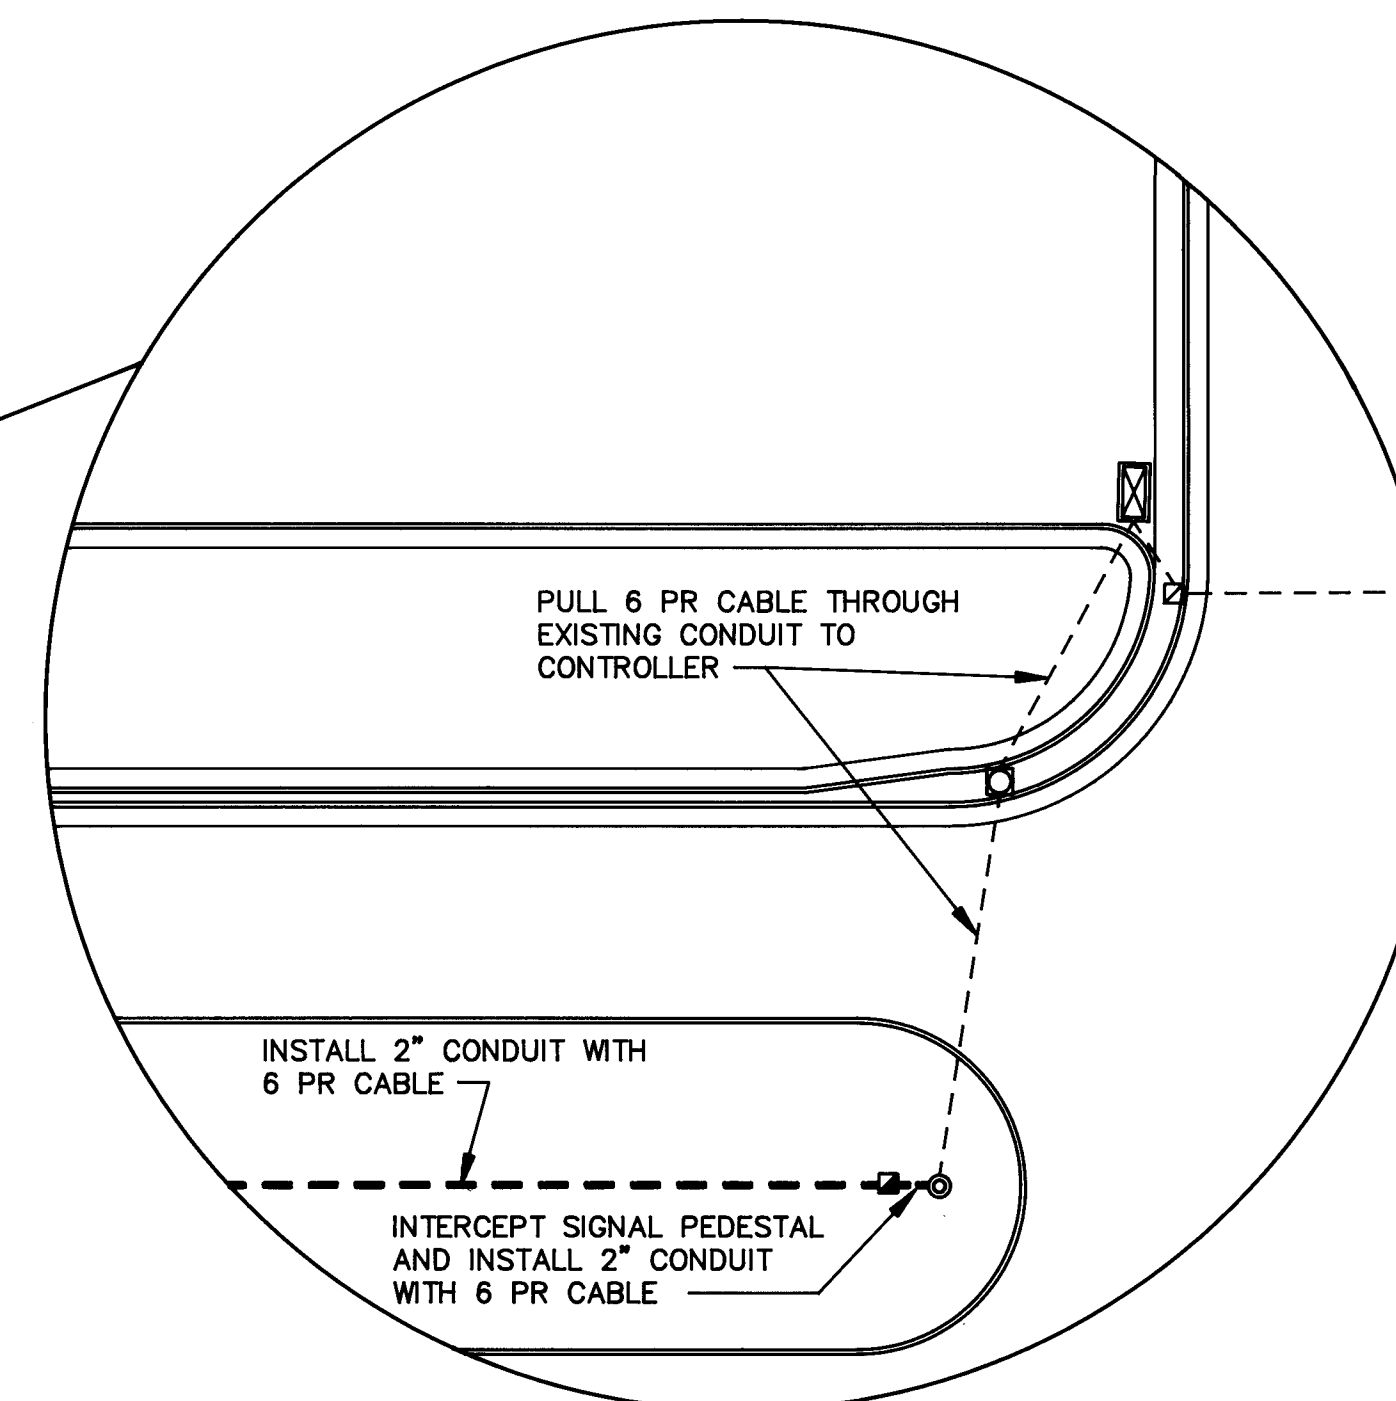

North

<b>LEGEND</b>			
EXISTING		PROPOSED	
<input checked="" type="checkbox"/>	CONTROLLER CABINET	<input checked="" type="checkbox"/>	
<input type="checkbox"/>	SPLICE CABINET	<input type="checkbox"/>	
<input checked="" type="checkbox"/>	PULL BOX	<input checked="" type="checkbox"/>	
<input checked="" type="radio"/>	MAN HOLE	<input checked="" type="radio"/>	
<input type="radio"/>	POLE	<input type="radio"/>	
<input checked="" type="radio"/>	PEDESTAL SIGNAL POLE	<input checked="" type="radio"/>	
<input checked="" type="checkbox"/>	MAST ARM POLE	<input checked="" type="checkbox"/>	
<input checked="" type="plus"/>	STREET LIGHT POLE	<input checked="" type="plus"/>	
- - - - -	CONDUIT	- - - - -	
_____	AERIAL CABLE	_____	
-----	ROW	-----	
<div style="height: 100px;"></div> BENCH MARKS		AS BUILT INFORMATION CONTRACTOR JET CON INC. WORK STARTED BY COA DATE 8-8 INSPECTOR'S FIELD VERIFICATION BY TDB/TJZ DATE 11/88 CHECKED BY EDEC CORRECTED BY EDEC DATE 11/88 MICRO-FILM INFORMATION RECORDED BY NO.	
		SURVEY INFORMATION	
		FIELD NOTES	DATE
		N.O.	BY
		ENGINEER'S SEAL <div style="float: right; text-align: center;"> <p>Edwin L. Beck, P.E.</p> </div>	
<div style="border: 1px solid black; padding: 5px;"> <b>RECORD DRAWING</b>            THIS DRAWING HAS BEEN REVISED TO SHOW THOSE CHANGES DURING THE CONSTRUCTION PROCESS REPORTED TO KIMLEY-HORN AND ASSOCIATES, INC. AND CONSIDERED TO BE SIGNIFICANT. THIS DRAWING IS NOT GUARANTEED TO BE "AS BUILT" BUT IS BASED ON THE AVAILABLE INFORMATION.            DATE 10/31/89 BY [Signature]         </div>			
CITY OF ALBUQUERQUE PUBLIC WORKS DEPARTMENT <b>"NO CHANGE"</b> 26 33862193		REMARKS	
		DESIGN	
KIMLEY-HORN and ASSOC. INC. DALLAS, TEXAS In Association With EDWIN L. BECK, P.E., CONSULTANT ALBUQUERQUE, N.M.		No.	Date
		DESIGNED BY RWF, JDC      DATE 8/14/87 DRAWN BY RWF, JWC, EJH    DATE 8/23/87 CHECKED BY HWL                 DATE 8/31/87	
TITLE:			
TRAFFIC SIGNAL INTERCONNECT MENAUD BLVD. FROM EUBANK BLVD. TO MORRIS ST.			
APPROVALS	ENGINEER	DATE	CHECKED
City Engineer	[Signature]	11/21/88	[Signature]
A.C.E. Design	[Signature]	" "	[Signature]
A.C. E.-Hydrology	[Signature]	" "	[Signature]
Traffic Operation		12/1/88	[Signature]
DRAWING NO.	MAP NO.		SHEET
3386			21 OF 39

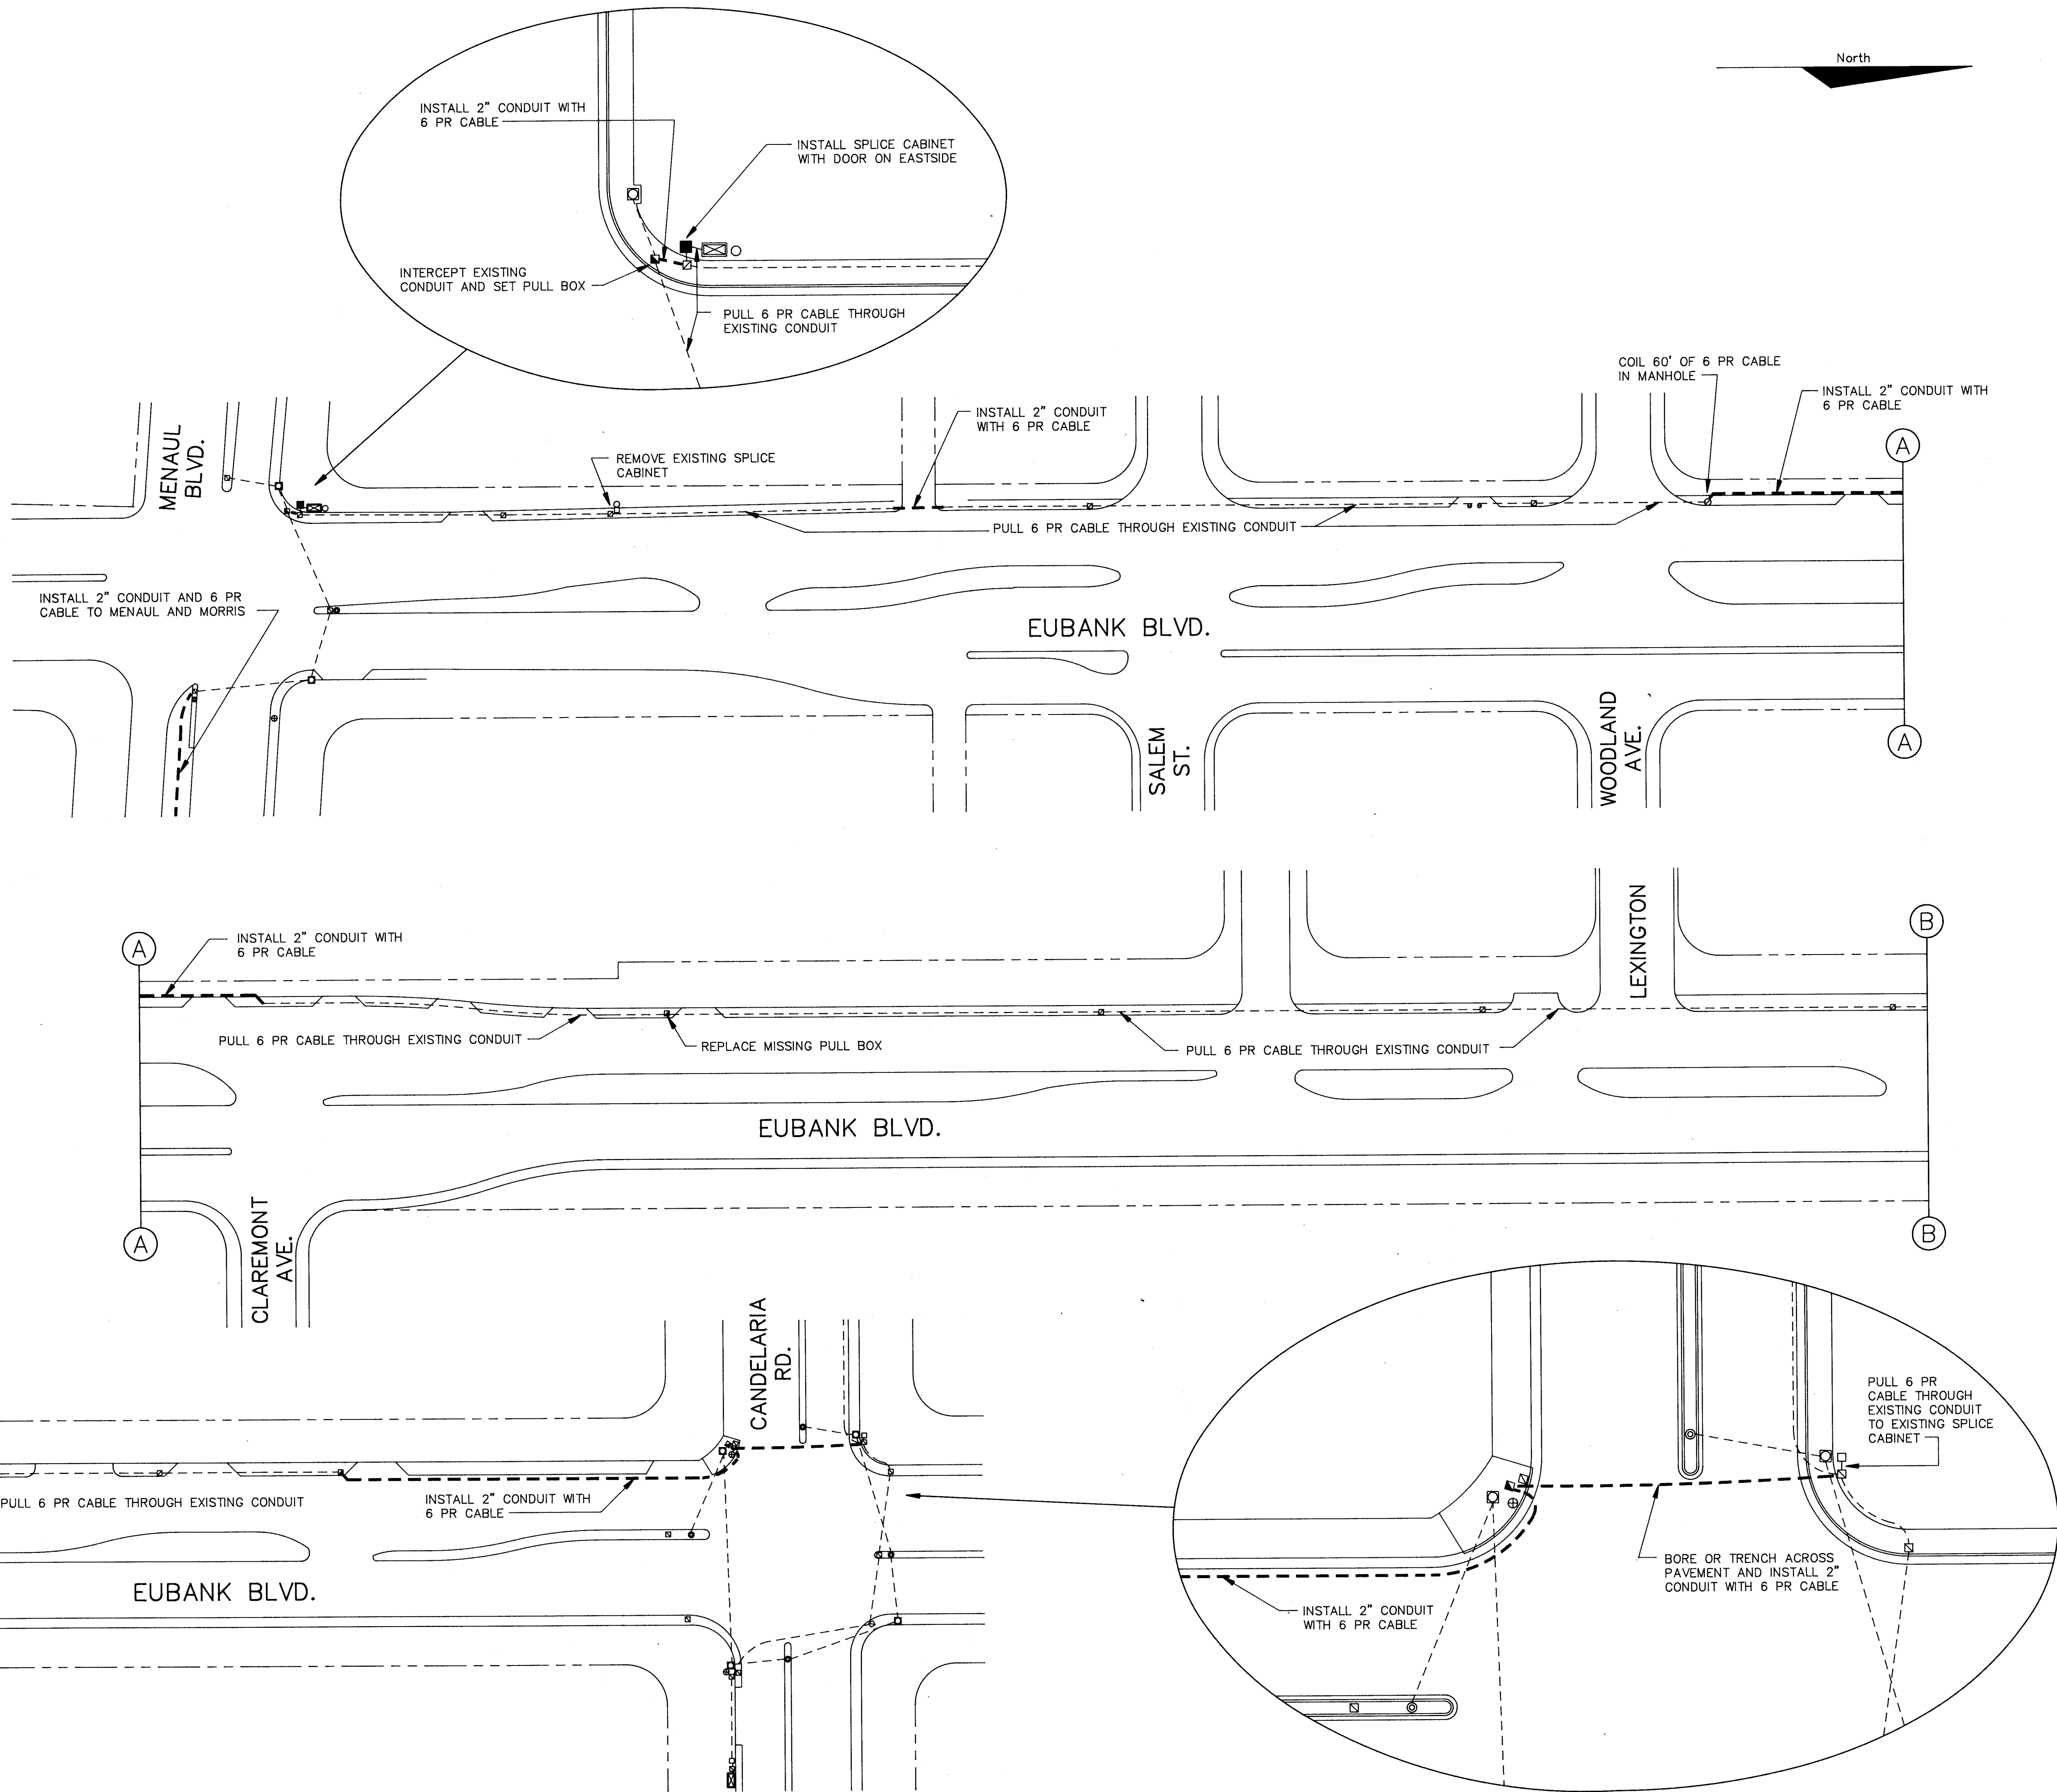

### LEGEND

EXISTING		PROPOSED
	CONTROLLER CABINET	
	SPLICE CABINET	
	PULL BOX	
	MAN HOLE	
	POLE	
	PEDESTAL SIGNAL POLE	
	MAST ARM POLE	
	STREET LIGHT POLE	
	CONDUIT	
	AERIAL CABLE	
	ROW	

### RECORD DRAWING

THIS DRAWING HAS BEEN REVISED TO SHOW THOSE CHANGES DURING THE CONSTRUCTION PROCESS REPORTED TO KIMLEY-HORN AND ASSOCIATES, INC. AND CONSIDERED TO BE SIGNIFICANT. THIS DRAWING IS NOT GUARANTEED TO BE "AS BUILT" BUT IS BASED ON THE AVAILABLE INFORMATION.

DATE 11/17/00 BY [Signature]

C of A PWD Maps & Records  
26 33862293

SCALE:  
1"=50' (RUNS)  
1"=20' (INSERTS)

**KIMLEY-HORN and ASSOC. INC.**  
DALLAS, TEXAS  
In Association With  
**EDWIN L. BECK, P.E., CONSULTANT**  
ALBUQUERQUE, N.M.

REVISIONS		REMARKS	DESIGN
NO.	DATE		
1	10/24/98	RECORD DRAWING	JWC

DESIGNED BY	DATE	CHECKED BY	DATE
RWF, JDC	8/14/87	RWF, JWC, EJH	8/25/87
		HAW	8/31/87

**CITY OF ALBUQUERQUE**  
**PUBLIC WORKS DEPARTMENT**  
**ENGINEERING GROUP**


TITLE: **TRAFFIC SIGNAL INTERCONNECT  
EUBANK BLVD.  
FROM MENAUL BLVD. TO CANDELARIA RD.**

APPROVALS	ENGINEER	DATE	APPROVALS	ENGINEER	DATE
City Engineer			Liquid Waste		
A.C.E. Design			Traffic		
A.C. E.-Hydrology			Water		

DRAWING NO. **3386**

MAP NO.

SHEET **22** OF **39**

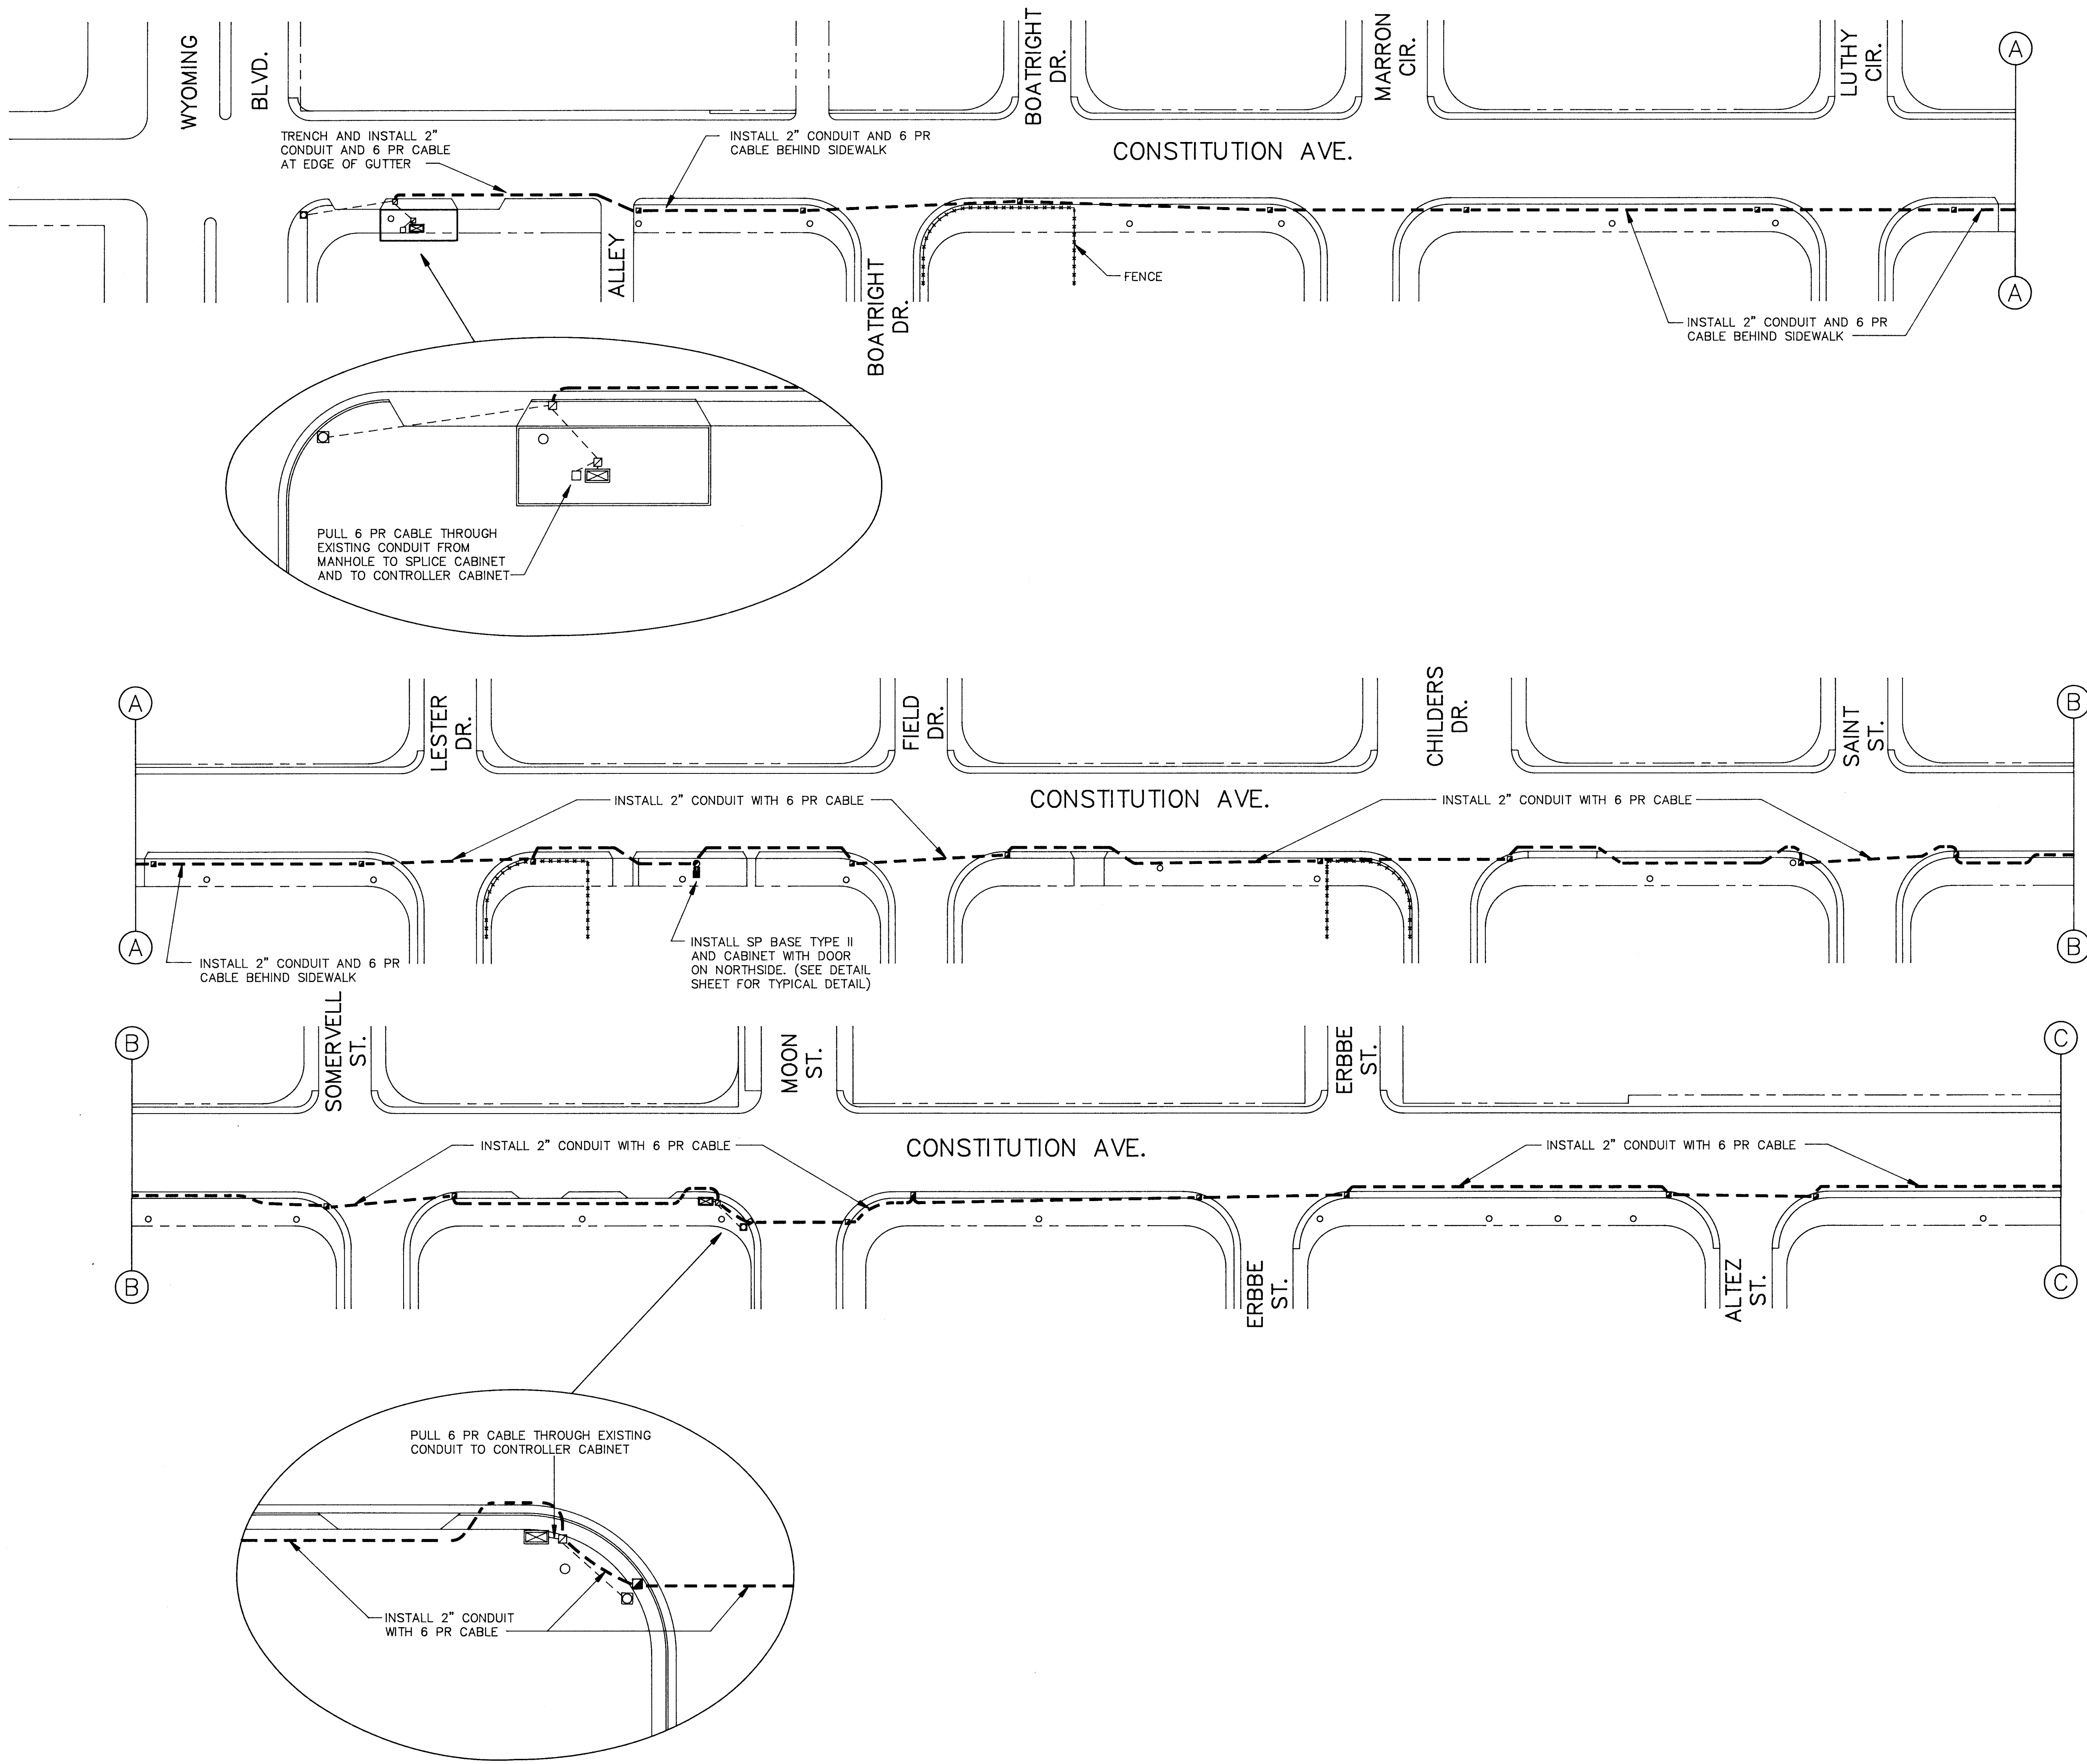

LEGEND	
EXISTING	PROPOSED
CONTROLLER CABINET	CONTROLLER CABINET
SPLICE CABINET	SPLICE CABINET
PULL BOX	PULL BOX
MAN HOLE	MAN HOLE
POLE	POLE
PEDESTAL SIGNAL POLE	PEDESTAL SIGNAL POLE
MAST ARM POLE	MAST ARM POLE
STREET LIGHT POLE	STREET LIGHT POLE
CONDUIT	CONDUIT
AERIAL CABLE	AERIAL CABLE
ROW	ROW

NOTES:  
BORE OR JACK UNDER DRIVEWAYS.  
BORE, JACK, OR TRENCH AT STREETS.

RECORD DRAWING

THIS DRAWING HAS BEEN REVISED TO SHOW THOSE CHANGES DURING THE CONSTRUCTION PROCESS REPORTED TO KIMLEY-HORN AND ASSOCIATES, INC. AND CONSIDERED TO BE SIGNIFICANT. THIS DRAWING IS NOT GUARANTEED TO BE "AS BUILT" BUT IS BASED ON THE AVAILABLE INFORMATION.

DATE 11/17/88 BY *W. Beck*

SCALE:  
1"=50' (RUNS)  
1"=20' (INSERTS)

KIMLEY-HORN and ASSOC. INC.  
DALLAS, TEXAS  
In Association With  
EDWIN L. BECK, P.E., CONSULTANT  
ALBUQUERQUE, N.M.


CITY OF ALBUQUERQUE  
PUBLIC WORKS DEPARTMENT  
ENGINEERING GROUP

TITLE: TRAFFIC SIGNAL INTERCONNECT  
CONSTITUTION AVENUE  
FROM WYOMING BLVD. TO EUBANK BLVD.

APPROVALS	ENGINEER	DATE	APPROVALS	ENGINEER	DATE
City Engineer			Liquid Waste		
A.C.E. Design			Traffic		
A.C. E.-Hydrology			Water		


DRAWING NO. 3386 MAP NO. SHEET 23 OF 39

ENGINEER'S SEAL										SURVEY INFORMATION		BENCH MARKS		AS BUILT INFORMATION			
										FIELD NOTES				CONTRACTOR <u>JET CON INC</u>			
										NO.	BY	DATE	WORK STARTED BY <u>COA</u> DATE <u>8/8</u> ACCEPTANCE BY <u>TDP/TJZ</u> DATE <u>11/88</u> FIELD DRAWINGS CORRECTED BY <u>E BECK</u> DATE <u>11/88</u> MICRO-FILM INFORMATION RECORDED BY DATE NO.				

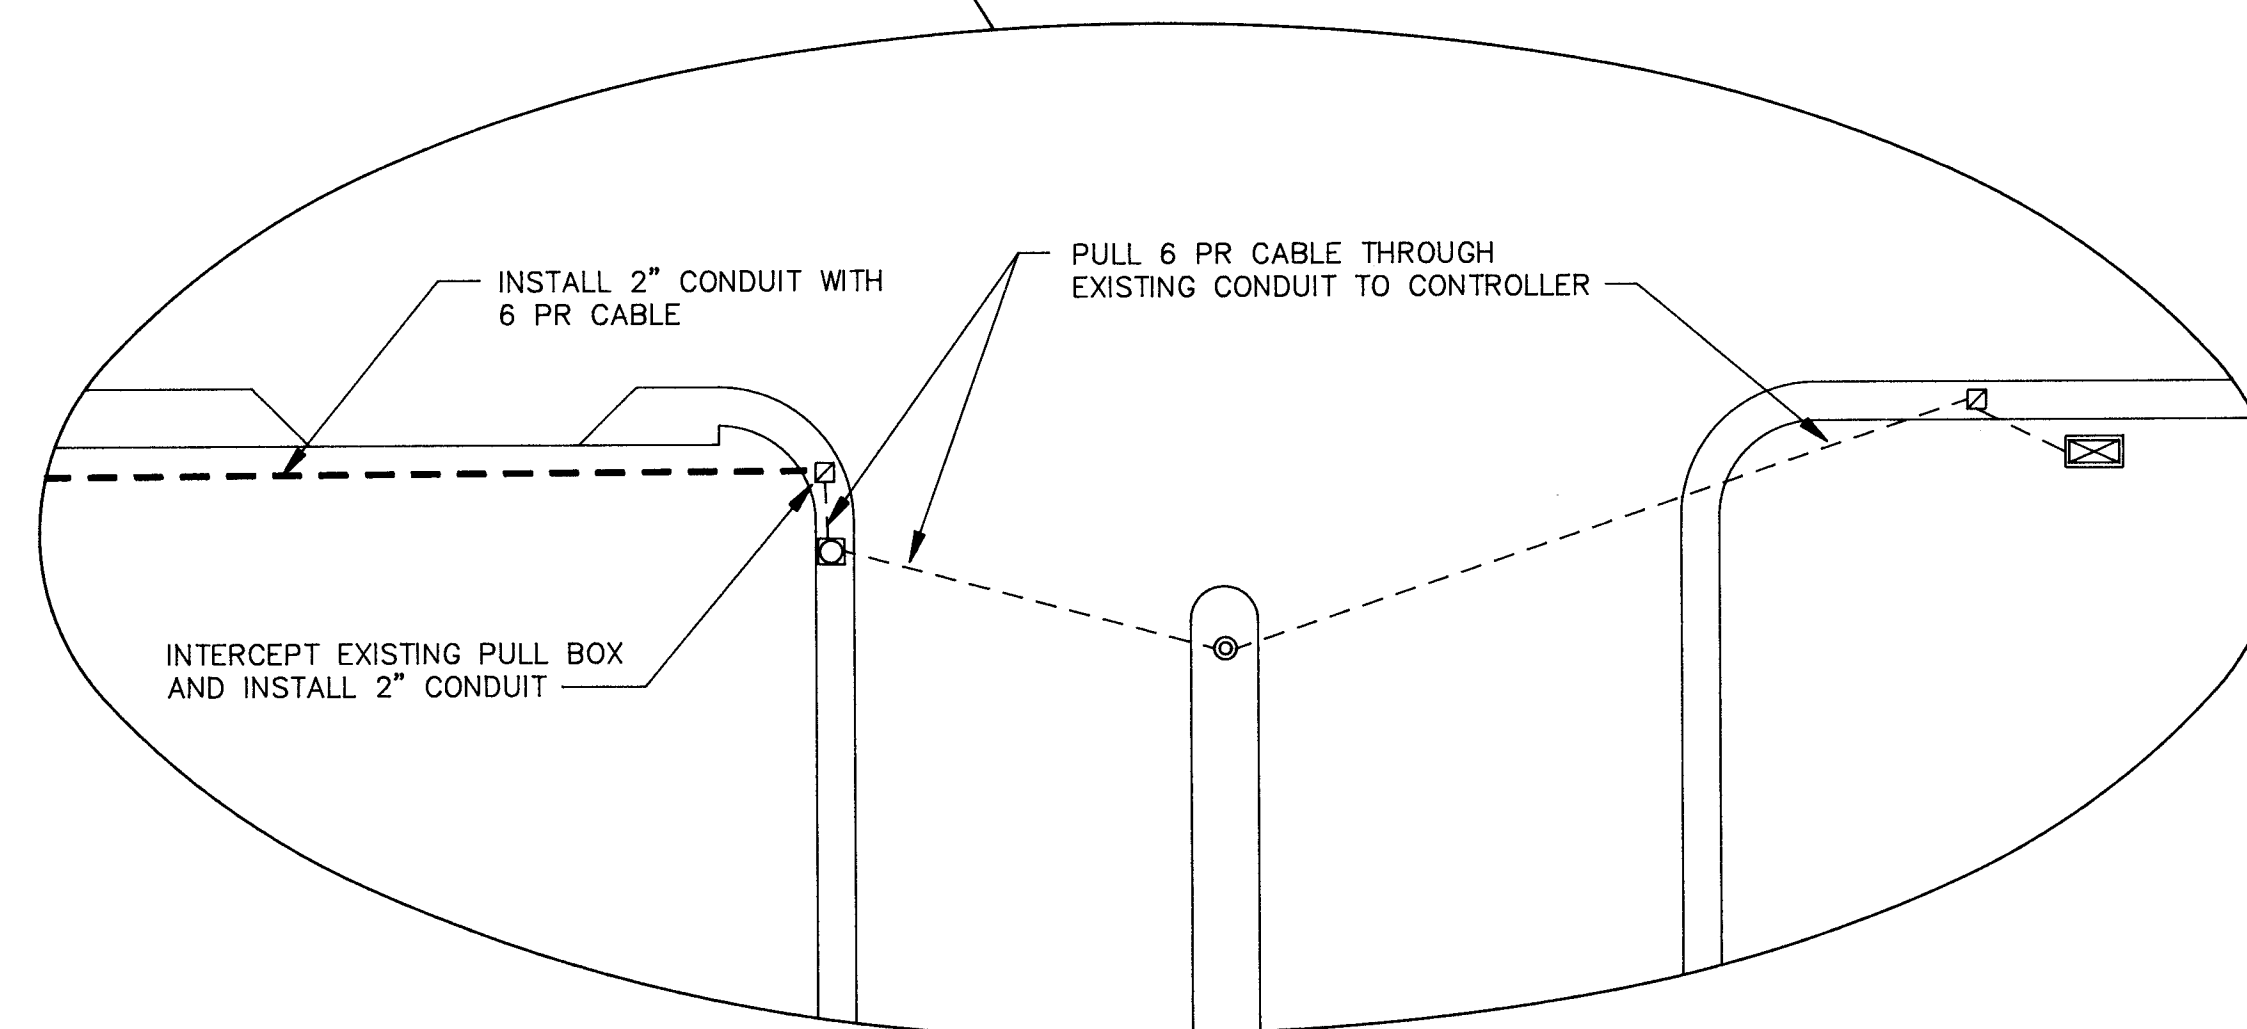

SHEET 24 OF 39



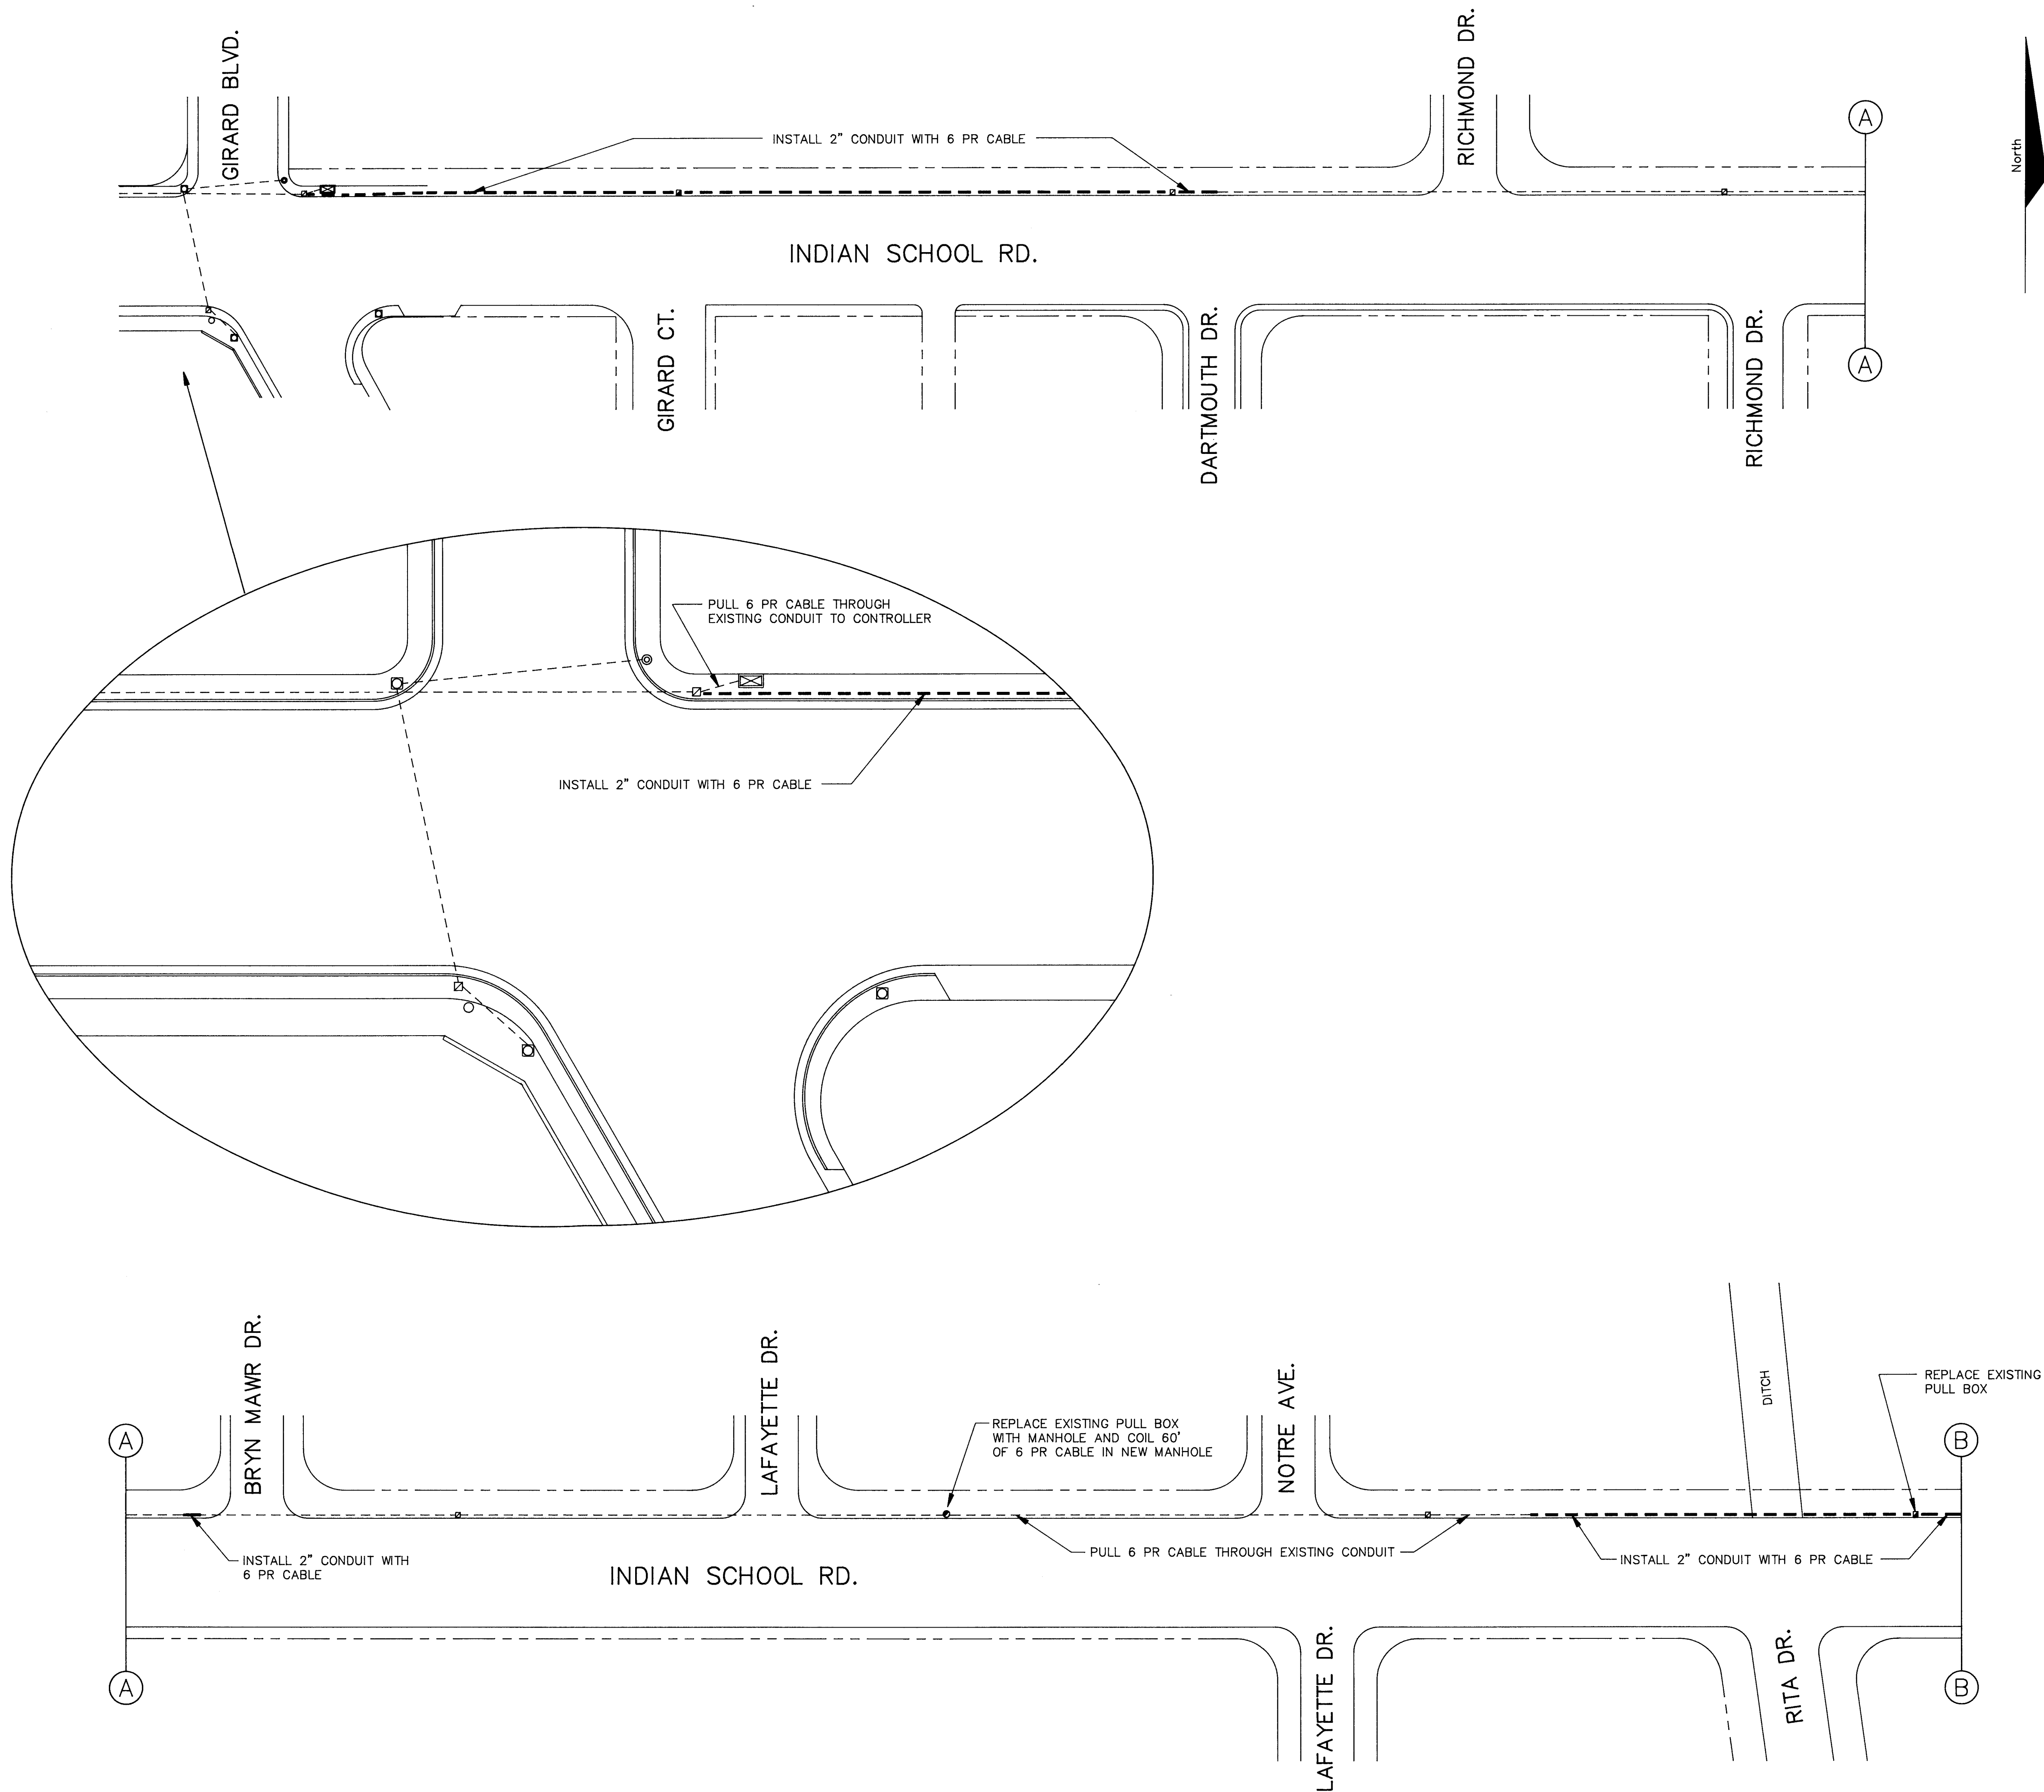

LEGEND

EXISTING

PROPOSED

☒

CONTROLLER CABINET

☐

SPLICE CABINET

☒

PULL BOX

☐

MAN HOLE

☒

POLE

☐

PEDESTAL SIGNAL POLE

☒

MAST ARM POLE

☐

STREET LIGHT POLE

☒

CONDUIT

☐

AERIAL CABLE

☒

ROW

AS BUILT INFORMATION

CONTRACTOR **JET CON INC**

WORK BY **COA**

DATE **8/8**

INSPECTOR'S **DATE 11/88**

ACCEPTANCE BY **DATE 11/88**

VERIFICATION BY **DATE 11/88**

CORRECTED BY **DATE 11/88**

MICRO-FILM INFORMATION

RECORDED BY

NO.

SURVEY INFORMATION

FIELD NOTES

NO.

BY

DATE

ENGINEER'S SEAL

NO.

DATE

RECORD DRAWING

REVISIONS

DESIGN

DESIGNED BY **RWF, JDC**

DATE **8/14/87**

DRAWN BY **RWF, JMC, EJR**

DATE **8/25/87**

CHECKED BY **HAW**

DATE **8/31/87**

RECORD DRAWING

THIS DRAWING HAS BEEN REVISED TO SHOW THOSE CHANGES DURING THE CONSTRUCTION PROCESS REPORTED TO KIMLEY-HORN AND ASSOCIATES, INC. AND CONSIDERED TO BE SIGNIFICANT. THIS DRAWING IS NOT GUARANTEED TO BE "AS BUILT" BUT IS BASED ON THE AVAILABLE INFORMATION.

DATE **11/17/88** BY **JW**

SCALE:

1"=50' (RUNS)

1"=20' (INSERTS)

**Kimley-Horn**

**KIMLEY-HORN and ASSOC. INC.**

DALLAS, TEXAS

In Association With

**EDWIN L. BECK, P.E., CONSULTANT**

ALBUQUERQUE, N.M.

CITY OF ALBUQUERQUE

PUBLIC WORKS DEPARTMENT

ENGINEERING GROUP

TITLE:

TRAFFIC SIGNAL INTERCONNECT

INDIAN SCHOOL ROAD

FROM GIRARD BLVD. TO SAN MATEO BLVD.

APPROVALS

ENGINEER

DATE

APPROVALS

ENGINEER

DATE

City Engineer

Liquid Waste

A.C.E. Design

Traffic

A.C. E.-Hydrology

Water

DRAWING NO.

**3386**


MAP NO.

SHEET

**25**

OF

**39**

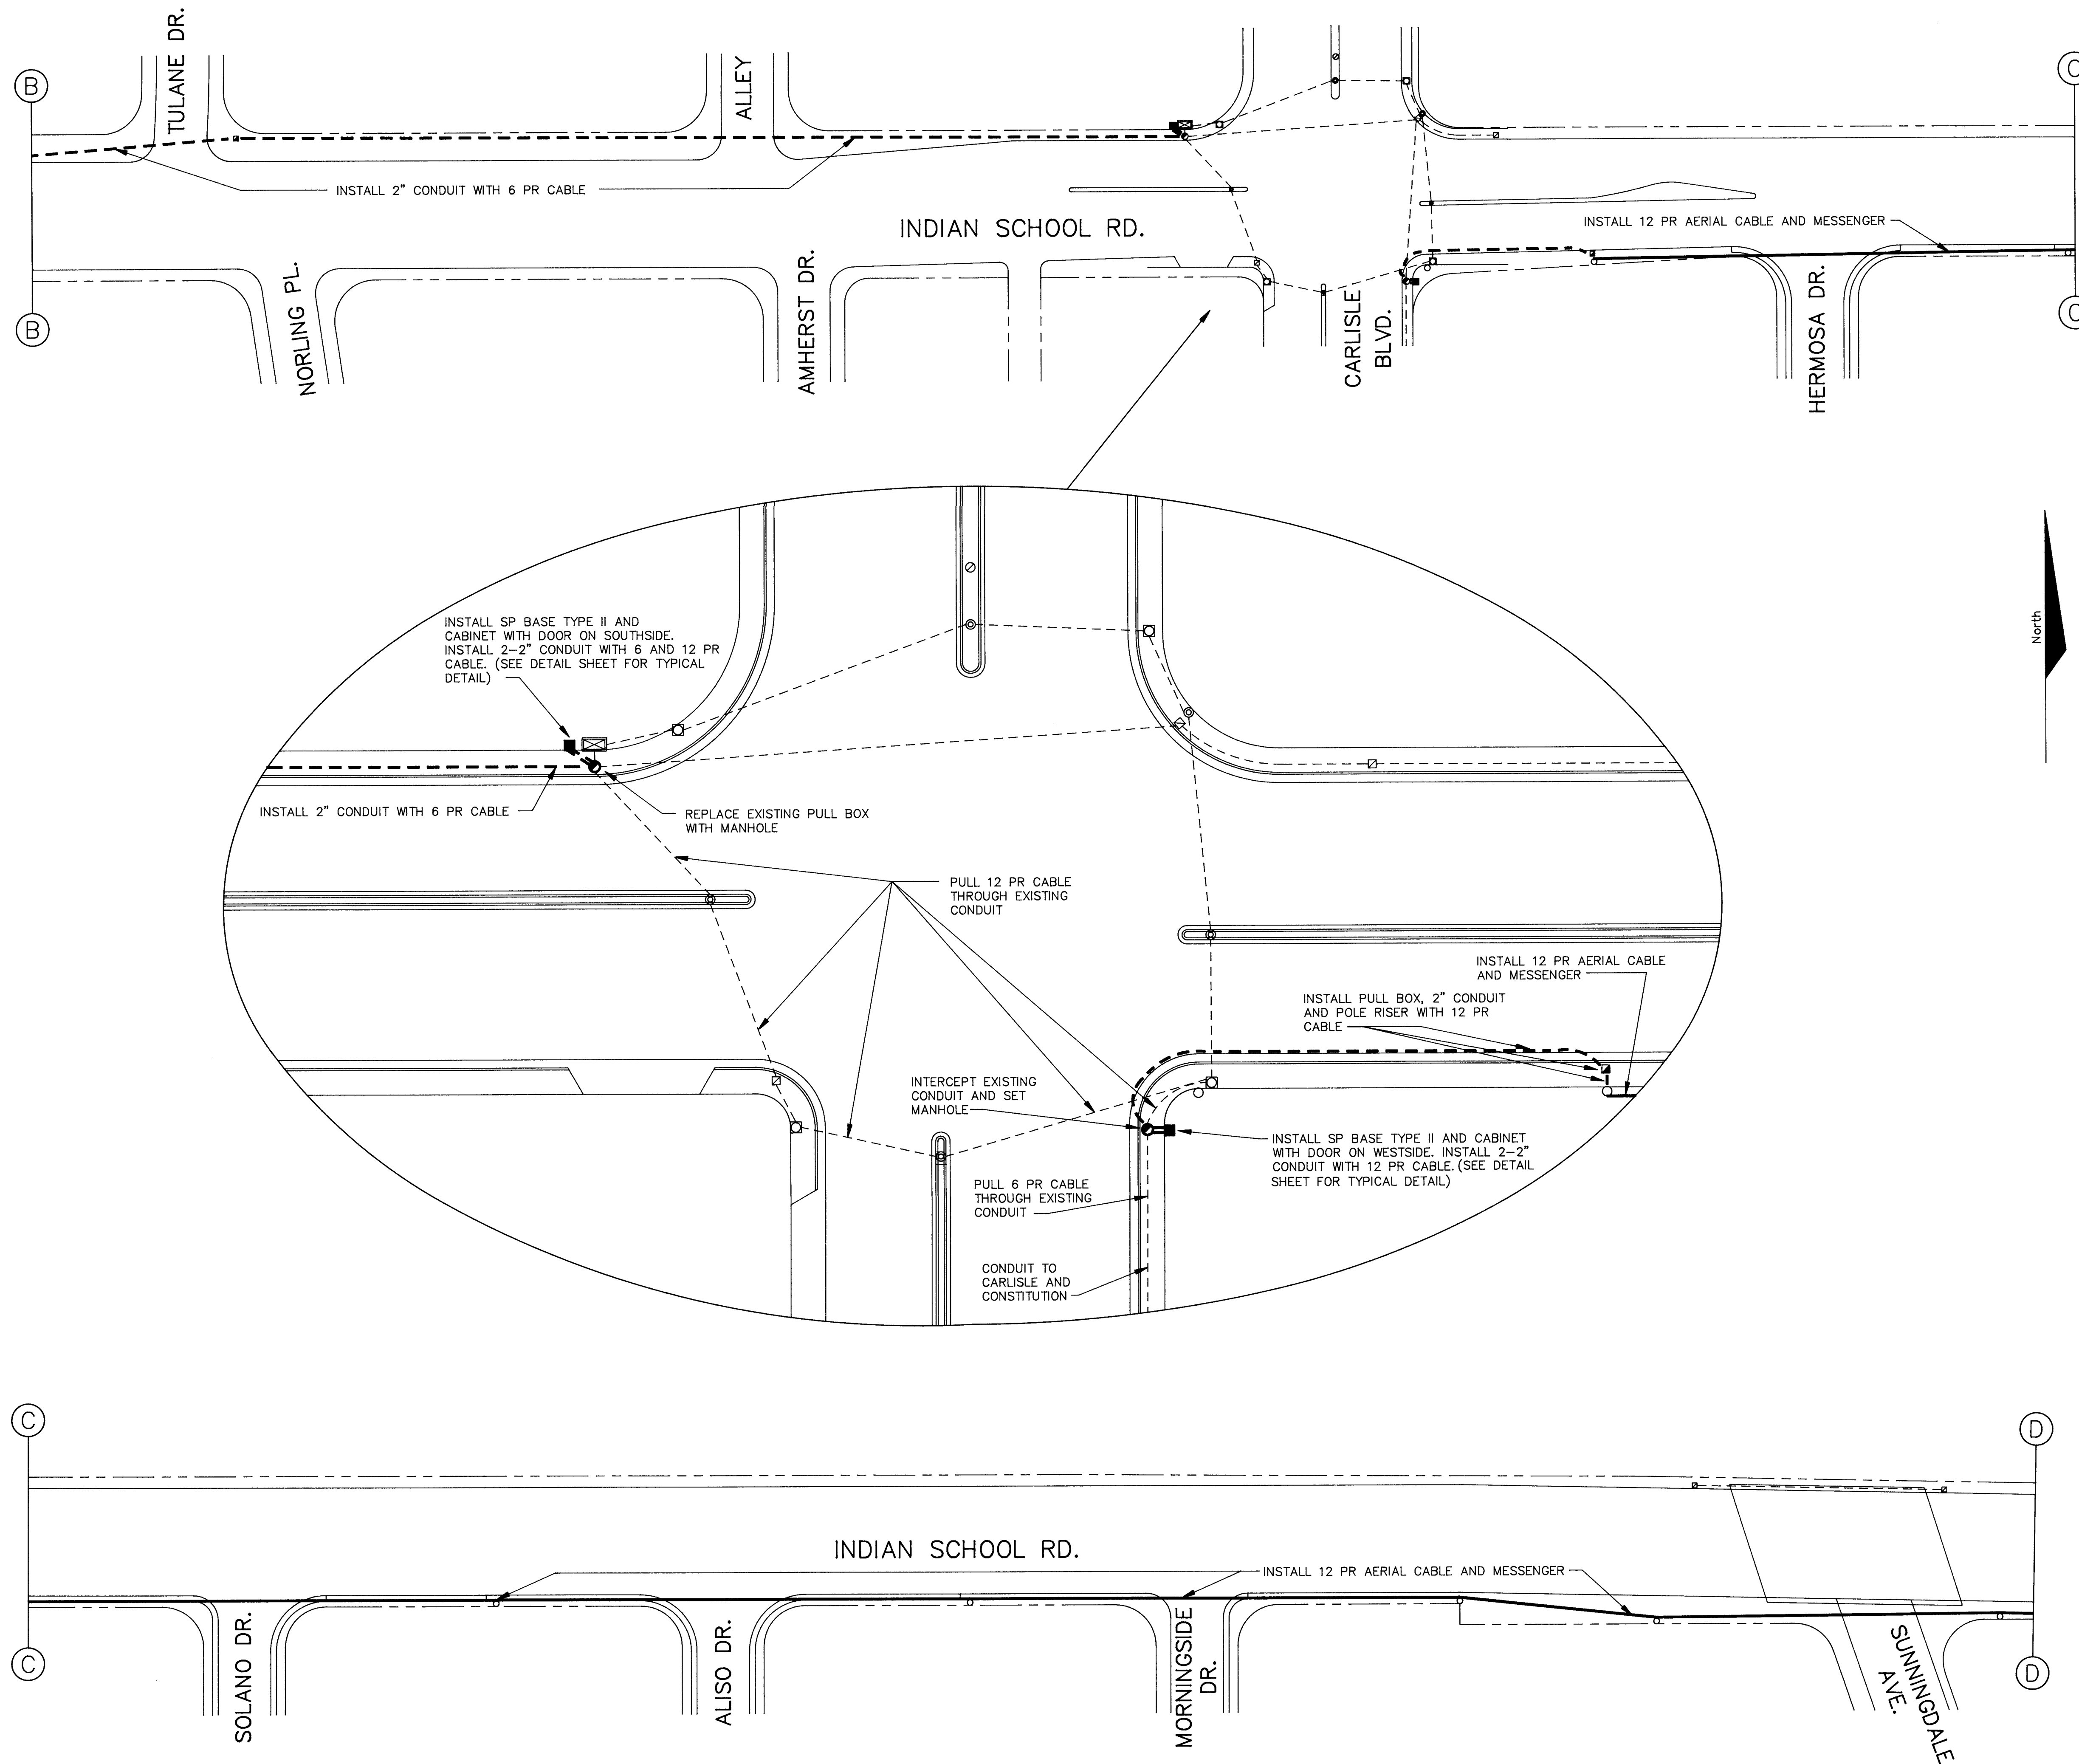

LEGEND	
EXISTING	PROPOSED
CONTROLLER CABINET	SPLICE CABINET
PULL BOX	MAN HOLE
POLE	PEDESTAL SIGNAL POLE
MAST ARM POLE	STREET LIGHT POLE
CONDUIT	AERIAL CABLE
ROW	

NOTE:  
OVERHEAD STREET LIGHTING WIRE TO BE ADJUSTED BY PMM PRIOR TO AERIAL CABLE INSTALLATION ON INDIAN SCHOOL RD. FROM CARLISLE TO WASHINGTON.

RECORD DRAWING  
THIS DRAWING HAS BEEN REVISED TO SHOW THOSE CHANGES DURING THE CONSTRUCTION PROCESS REPORTED TO KIMLEY-HORN AND ASSOCIATES, INC. AND CONSIDERED TO BE SIGNIFICANT. THIS DRAWING IS NOT GUARANTEED TO BE "AS BUILT" BUT IS BASED ON THE AVAILABLE INFORMATION.  
DATE 11/17/88 BY JWC

26 33862693

SCALE:  
1"=50' (RUNS)  
1"=20' (INSERTS)

KIMLEY-HORN and ASSOC. INC.  
DALLAS, TEXAS  
In Association With  
EDWIN L. BECK, P.E., CONSULTANT  
ALBUQUERQUE, N.M.

CITY OF ALBUQUERQUE  
PUBLIC WORKS DEPARTMENT  
ENGINEERING GROUP

TITLE: TRAFFIC SIGNAL INTERCONNECT  
INDIAN SCHOOL ROAD  
FROM GIRARD BLVD. TO SAN MATEO BLVD.

APPROVALS	ENGINEER	DATE	APPROVALS	ENGINEER	DATE
City Engineer			Liquid Waste		
A.C.E. Design			Traffic		
A.C. E.-Hydrology			Water		

DRAWING NO. 3386 MAP NO. SHEET 26 OF 39


AS BUILT INFORMATION		BENCH MARKS		SURVEY INFORMATION		ENGINEER'S SEAL	
CONTRACTOR	JET CON	DATE	88	FIELD NOTES	NO.	DATE	NO.
WORK ORDER	COA	DATE	11/88	BY			
ACCEPTANCE BY	TC/ET/2	DATE	11/88				
FIELD DRAWINGS	BY E. BECK	DATE	11/88				
CORRECTED BY	E. BECK	DATE	11/88				
MICRO-FILM INFORMATION		DATE					
RECORDED BY		NO.					









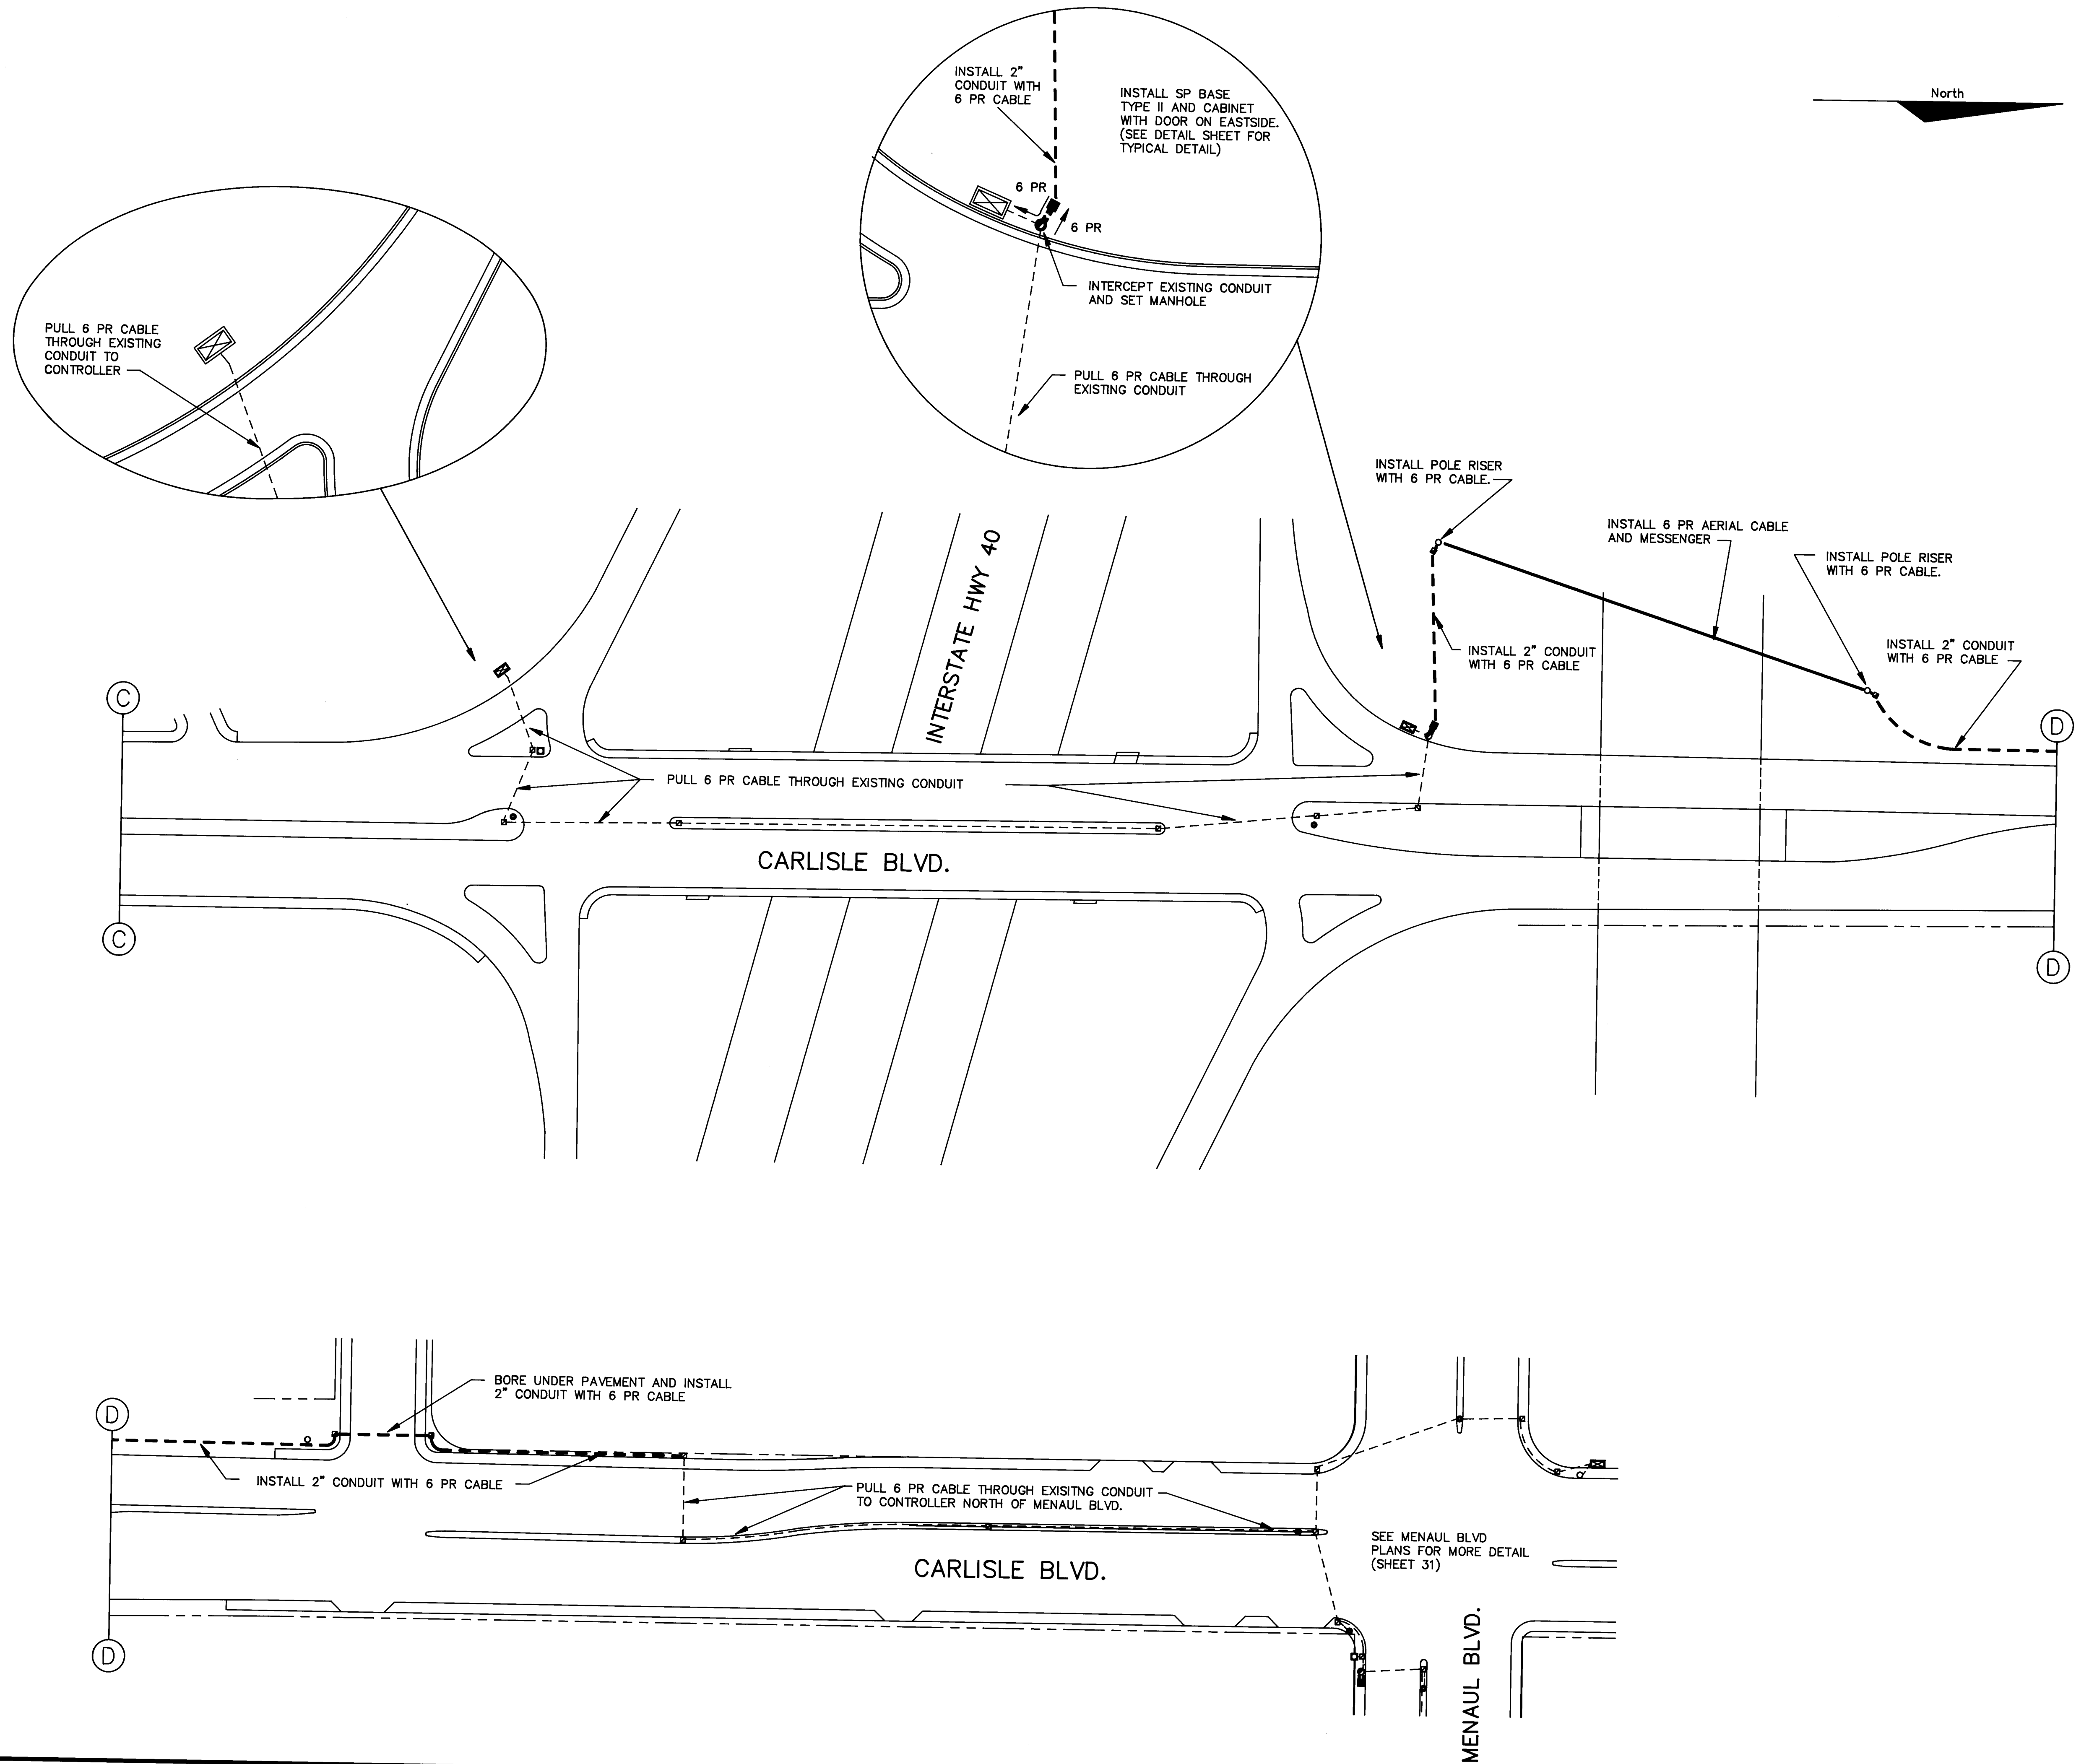

LEGEND		EXISTING		PROPOSED	
<input checked="" type="checkbox"/>	CONTROLLER CABINET	<input checked="" type="checkbox"/>	CONTROLLER CABINET	<input checked="" type="checkbox"/>	CONTROLLER CABINET
<input type="checkbox"/>	SPLICE CABINET	<input type="checkbox"/>	SPLICE CABINET	<input type="checkbox"/>	SPLICE CABINET
<input checked="" type="checkbox"/>	PULL BOX	<input checked="" type="checkbox"/>	PULL BOX	<input checked="" type="checkbox"/>	PULL BOX
<input checked="" type="checkbox"/>	MAN HOLE	<input checked="" type="checkbox"/>	MAN HOLE	<input checked="" type="checkbox"/>	MAN HOLE
<input checked="" type="checkbox"/>	POLE	<input checked="" type="checkbox"/>	POLE	<input checked="" type="checkbox"/>	POLE
<input checked="" type="checkbox"/>	PEDESTAL SIGNAL POLE	<input checked="" type="checkbox"/>	PEDESTAL SIGNAL POLE	<input checked="" type="checkbox"/>	PEDESTAL SIGNAL POLE
<input checked="" type="checkbox"/>	MAST ARM POLE	<input checked="" type="checkbox"/>	MAST ARM POLE	<input checked="" type="checkbox"/>	MAST ARM POLE
<input checked="" type="checkbox"/>	STREET LIGHT POLE	<input checked="" type="checkbox"/>	STREET LIGHT POLE	<input checked="" type="checkbox"/>	STREET LIGHT POLE
<input checked="" type="checkbox"/>	CONDUIT	<input checked="" type="checkbox"/>	CONDUIT	<input checked="" type="checkbox"/>	CONDUIT
<input checked="" type="checkbox"/>	AERIAL CABLE	<input checked="" type="checkbox"/>	AERIAL CABLE	<input checked="" type="checkbox"/>	AERIAL CABLE
<input checked="" type="checkbox"/>	ROW	<input checked="" type="checkbox"/>	ROW	<input checked="" type="checkbox"/>	ROW

AS BUILT INFORMATION		BENCH MARKS		SURVEY INFORMATION		ENGINEER'S SEAL	
CONTRACTOR	DATE	NO.	DATE	NO.	DATE	NO.	DATE
WORK	DATE	NO.	DATE	NO.	DATE	NO.	DATE
DESIGNED BY	DATE	NO.	DATE	NO.	DATE	NO.	DATE
DRAWN BY	DATE	NO.	DATE	NO.	DATE	NO.	DATE
CHECKED BY	DATE	NO.	DATE	NO.	DATE	NO.	DATE
RECORDED BY	DATE	NO.	DATE	NO.	DATE	NO.	DATE

24 33861093

SCALE:  
1"=50' (RUNS)  
1"=20' (INSERTS)


**KIMLEY-HORN**  
KIMLEY-HORN and ASSOC. INC.  
DALLAS, TEXAS  
In Association With  
EDWIN L. BECK, P.E., CONSULTANT  
ALBUQUERQUE, N.M.

CITY OF ALBUQUERQUE  
PUBLIC WORKS DEPARTMENT  
ENGINEERING GROUP

TITLE:  
TRAFFIC SIGNAL INTERCONNECT  
CARLISLE BLVD.  
FROM CONSTITUTION BLVD. TO MENAU BLVD.

APPROVALS	ENGINEER	DATE	APPROVALS	ENGINEER	DATE
City Engineer			Liquid Waste		
A.C.E. Design			Traffic		
A.C. E.-Hydrology			Water		

DRAWING NO. 3386 MAP NO. SHEET 30 OF 39

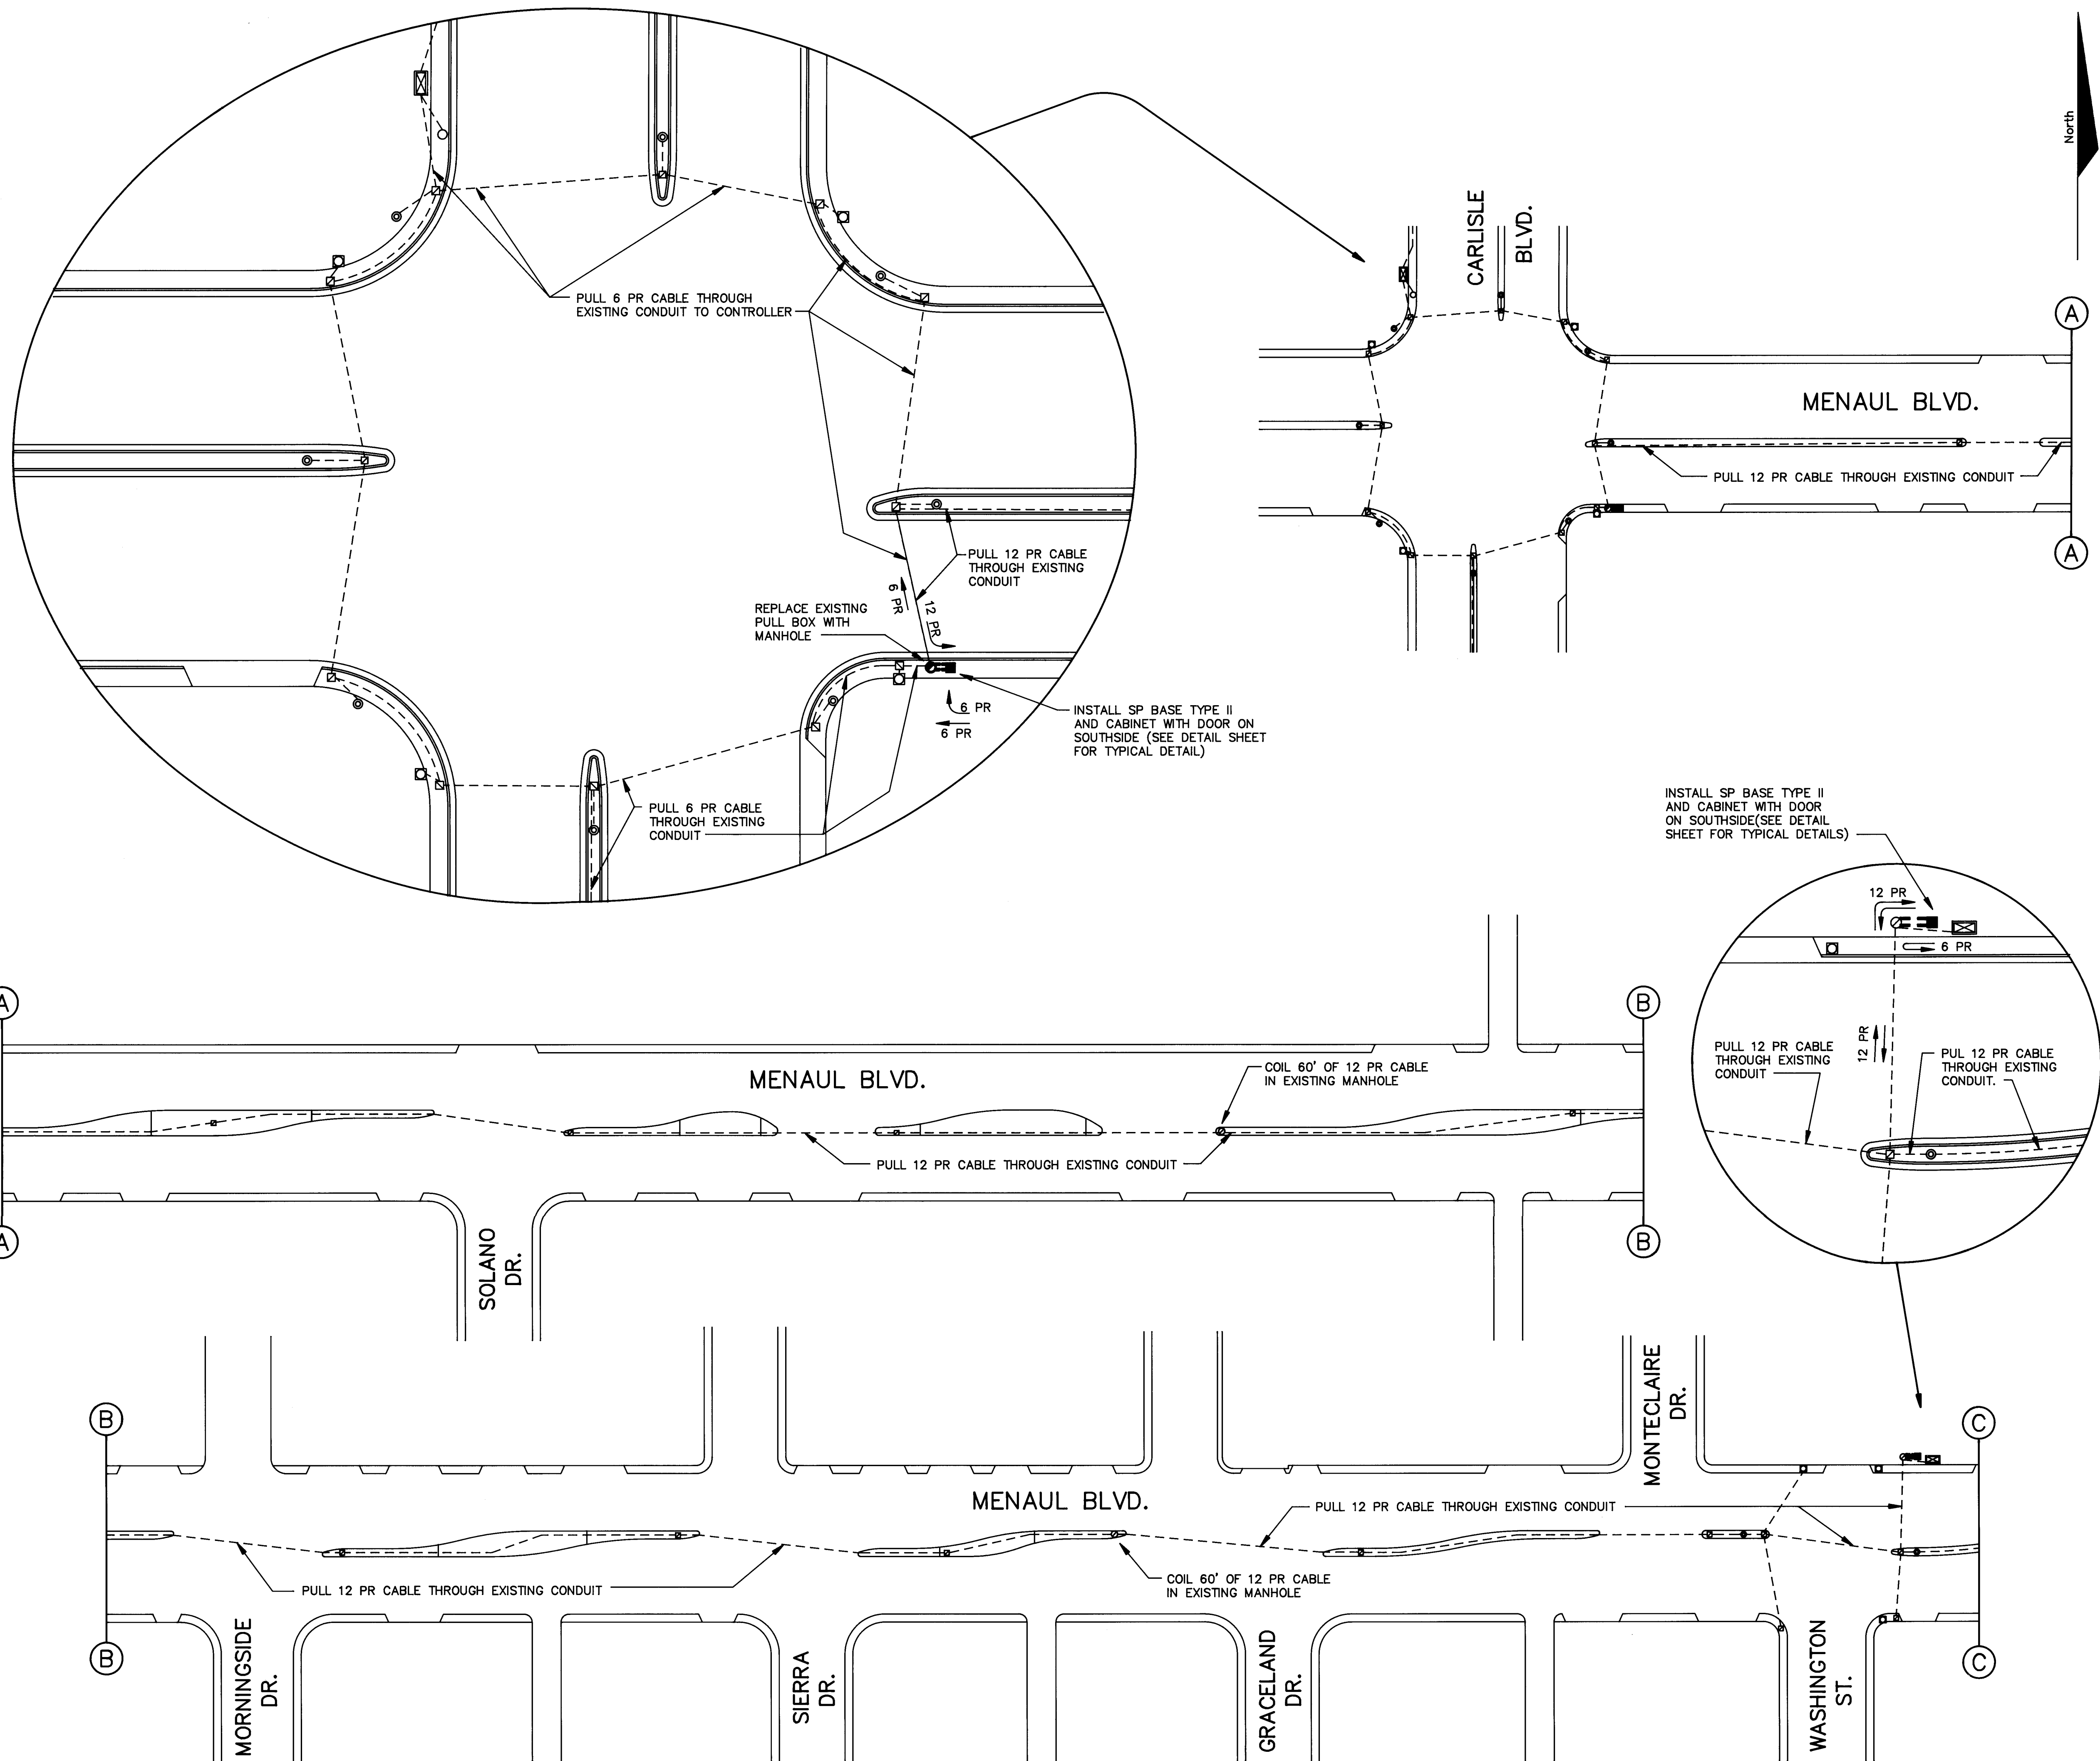

LEGEND

EXISTING

PROPOSED

CONTROLLER CABINET

SPLICE CABINET

PULL BOX

MAN HOLE

POLE

PEDESTAL SIGNAL POLE

MAST ARM POLE

STREET LIGHT POLE

CONDUIT

AERIAL CABLE

ROW

CONTROLLER CABINET

SPLICE CABINET

PULL BOX

MAN HOLE

POLE

PEDESTAL SIGNAL POLE

MAST ARM POLE

STREET LIGHT POLE

CONDUIT

AERIAL CABLE

ROW

AS BUILT INFORMATION

CONTRACTOR JET Co. Inc.

DESIGNED BY COA

DATE 11/1/87

INSPECTED BY J. Beck

DATE 11/1/87

FIELD CHECK BY J. Beck

DATE 11/1/87

RECORDED BY

DATE

BENCH MARKS

NO.

DATE

SURVEY INFORMATION

FIELD NOTES

BY

NO.

ENGINEER'S SEAL

REVISIONS

NO.

DATE

REMARKS

DESIGNED BY RWF, JDC

DATE 8/14/87

DRAWN BY RWF, JWC, EJR

DATE 8/25/87

CHECKED BY HAW

DATE 8/31/87

SCALE:

1"=50' (RUNS)

1"=20' (INSERTS)

KIMLEY-HORN and ASSOC. INC.

DALLAS, TEXAS

In Association With

EDWIN L. BECK, P.E., CONSULTANT

ALBUQUERQUE, N.M.

CITY OF ALBUQUERQUE

PUBLIC WORKS DEPARTMENT

ENGINEERING GROUP

TITLE:

TRAFFIC SIGNAL INTERCONNECT

MENAU BLVD.

FROM CARLISLE BLVD. TO SAN MATEO BLVD.

APPROVALS

ENGINEER

DATE

APPROVALS

ENGINEER

DATE

City Engineer

Liquid Waste

A.C.E. Design

Traffic

A.C. E.-Hydrology

Water

DRAWING NO.

3386

MAP NO.

SHEET



31

OF



39







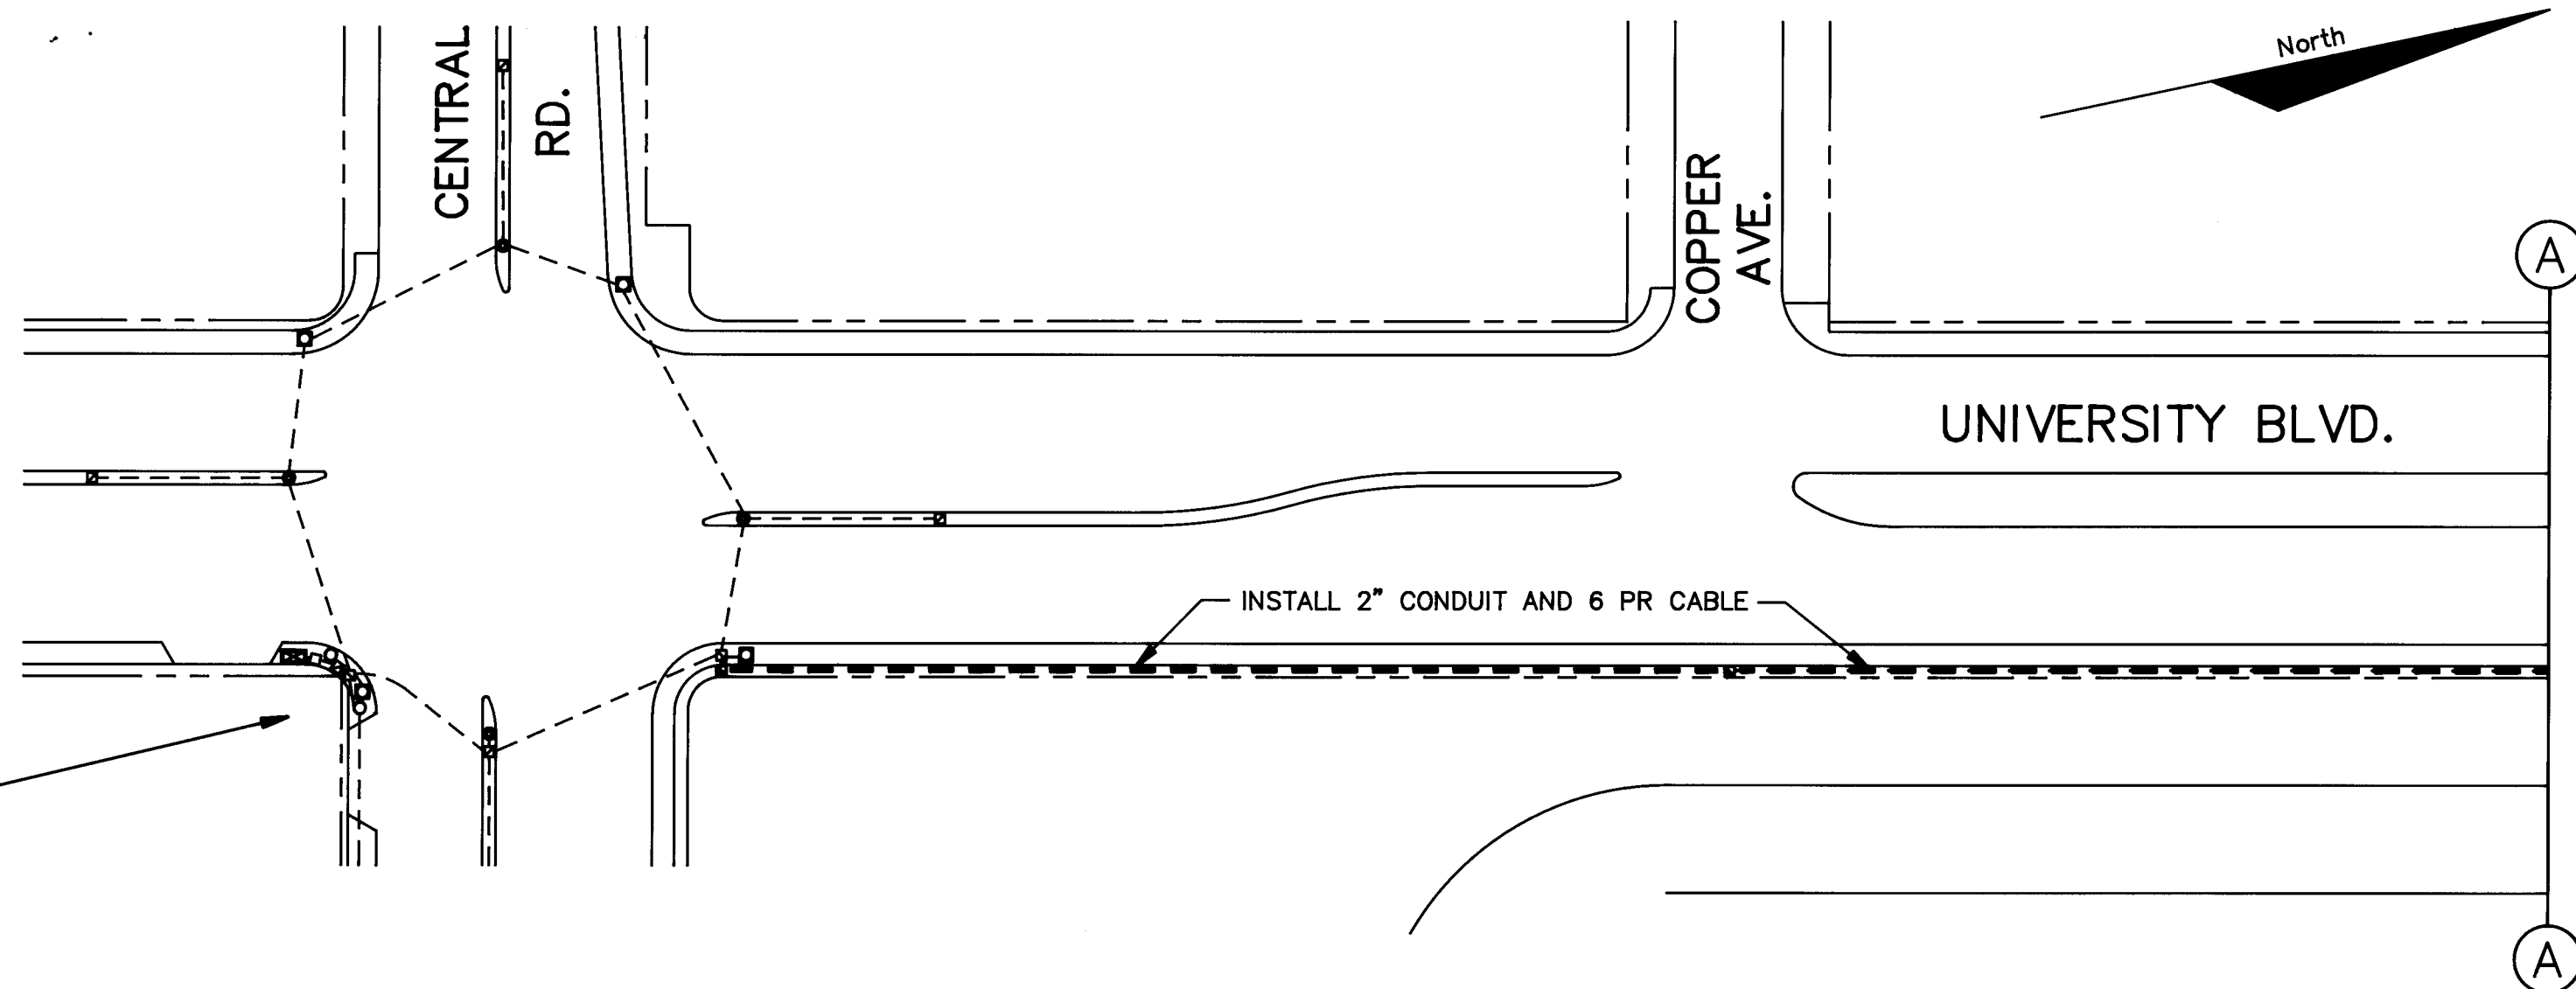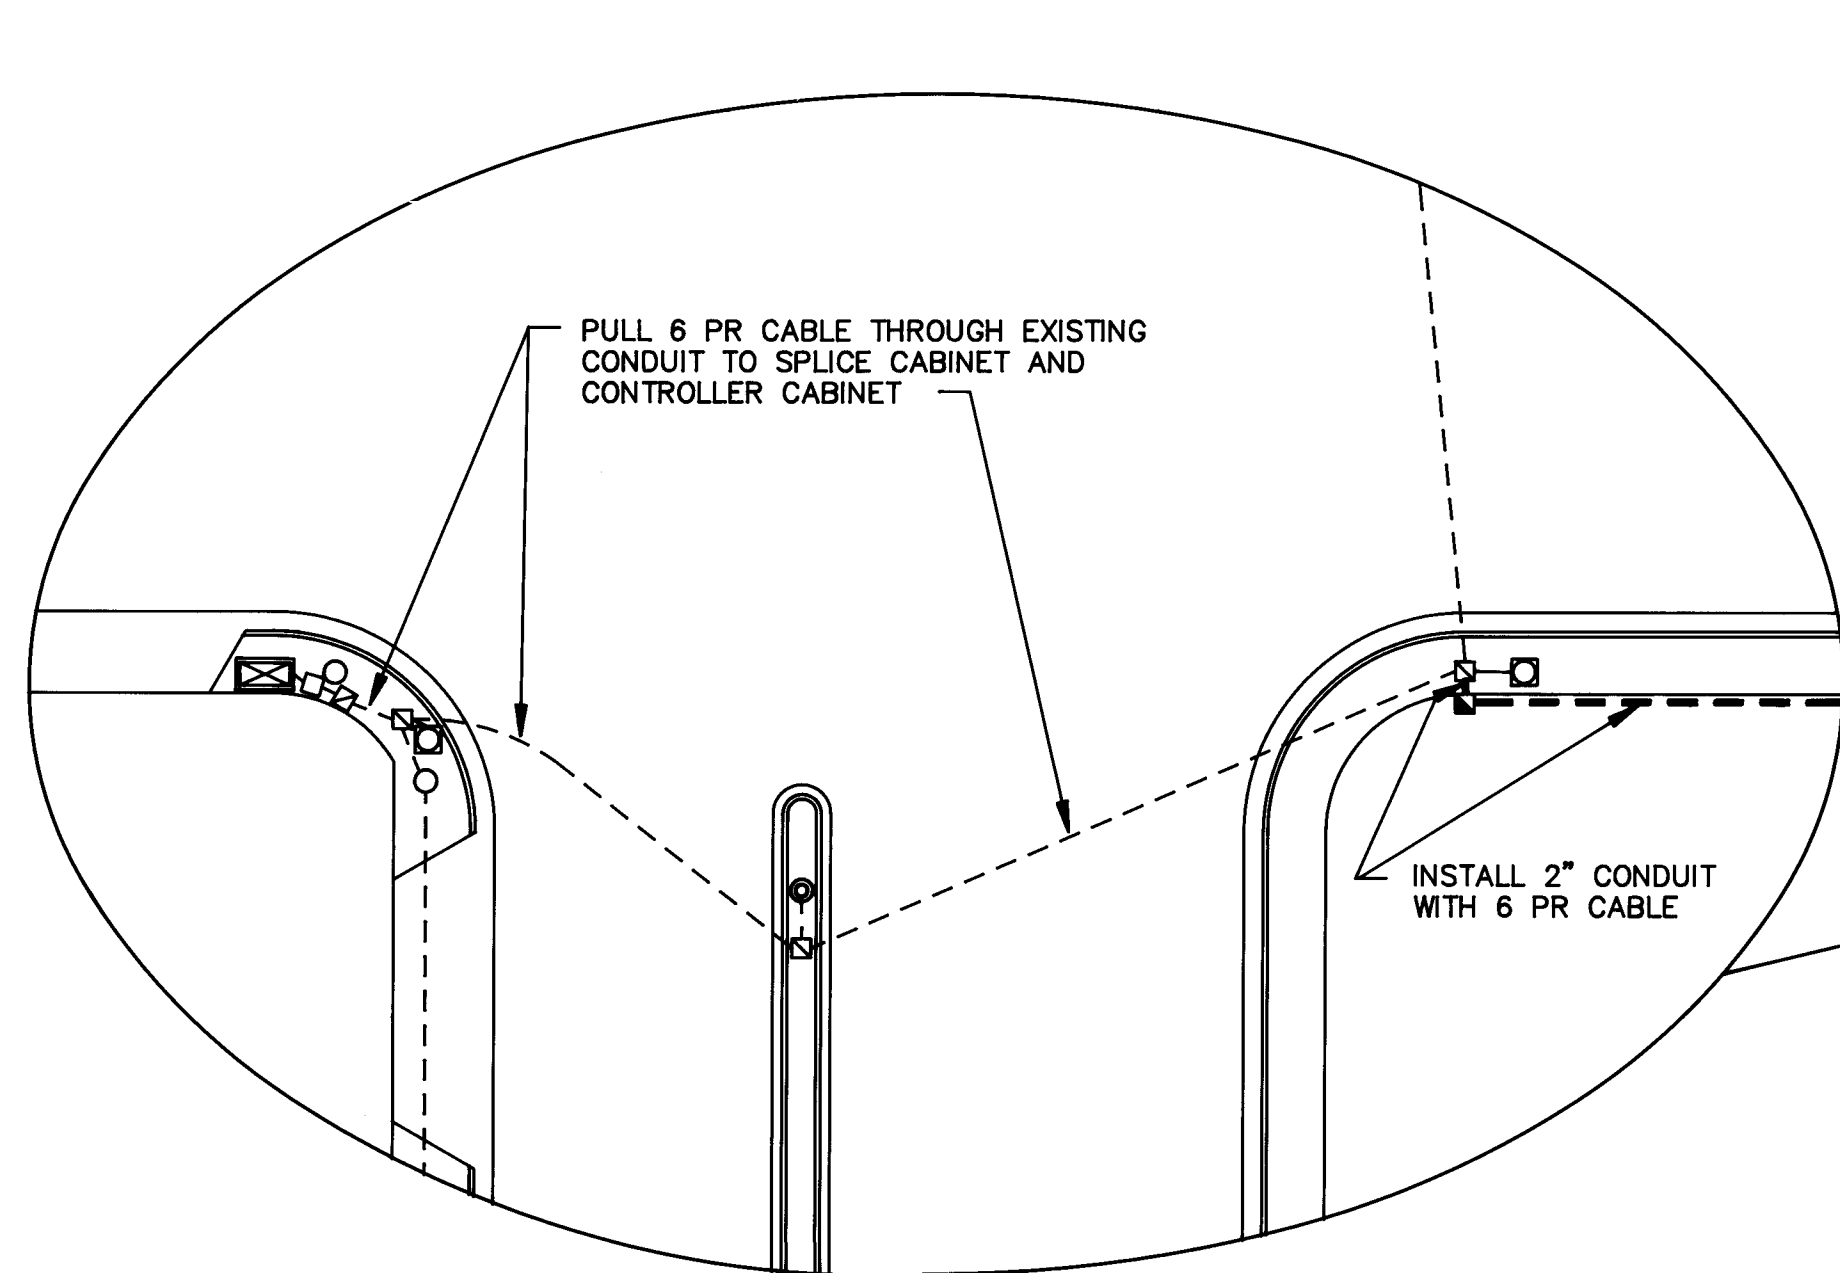

NOTE:  
CONTRACTOR SHALL CONTACT UNIVERSITY OF  
NEW MEXICO (FLOYD WILLIAMS PHYSICAL PLANT  
277-2421) BEFORE INSTALLING CONDUIT AT  
LOCATIONS ON THIS SHEET.

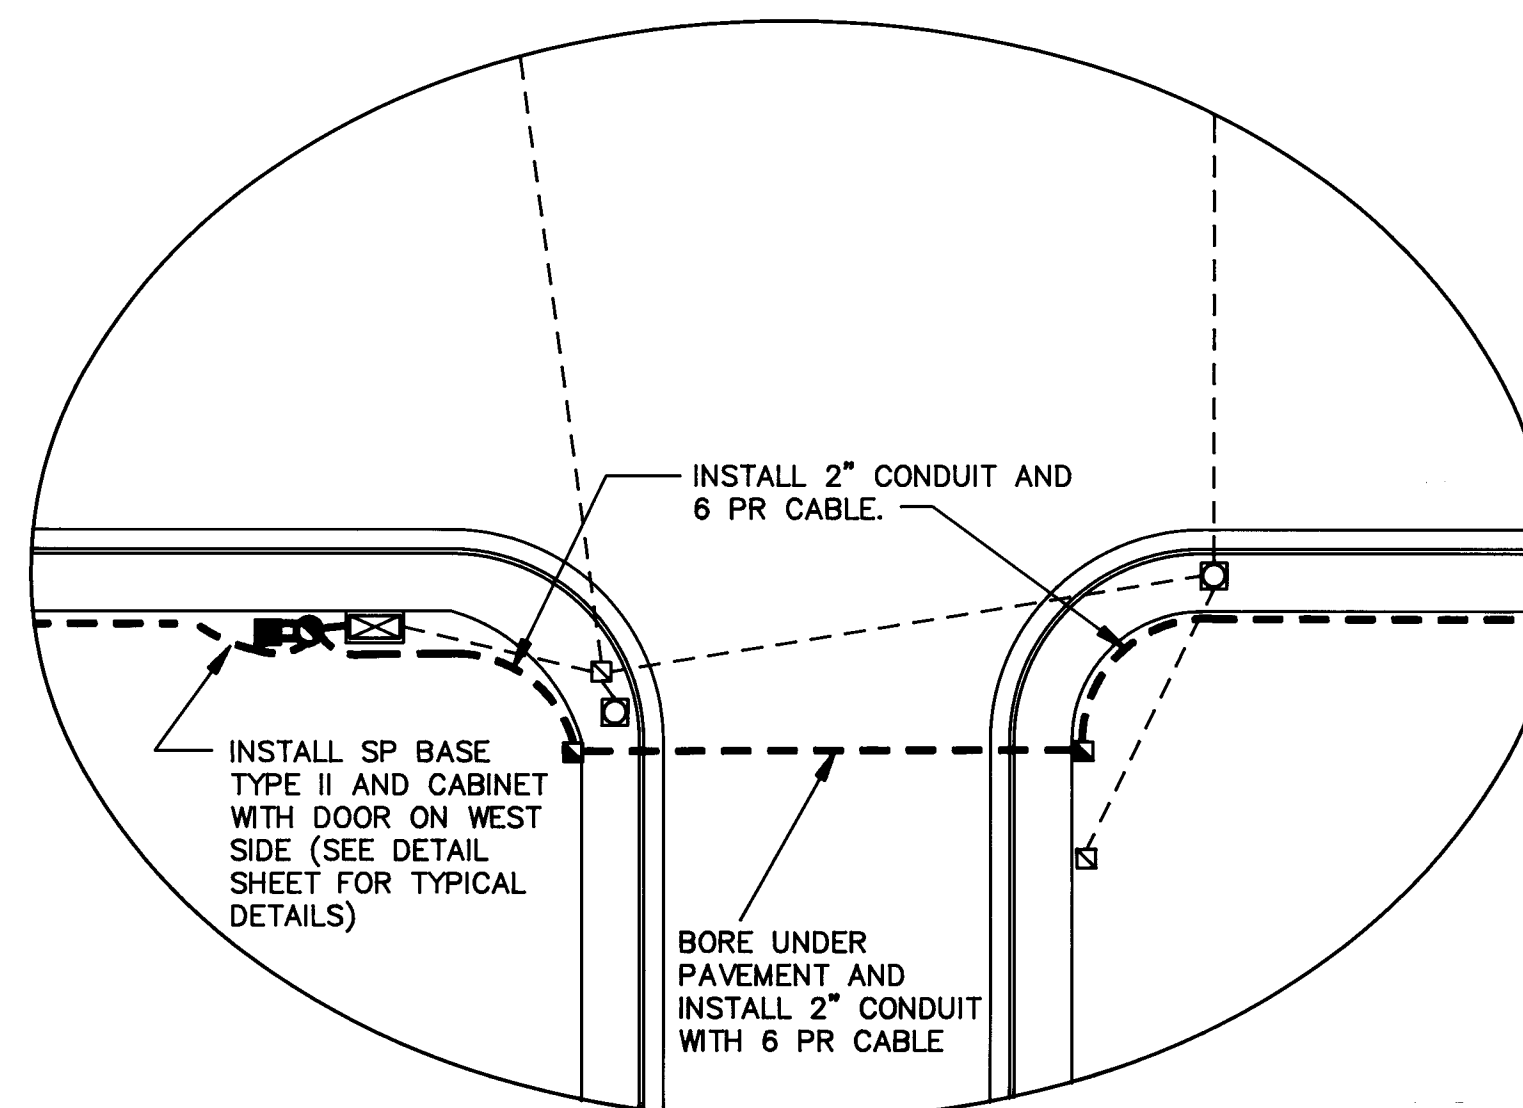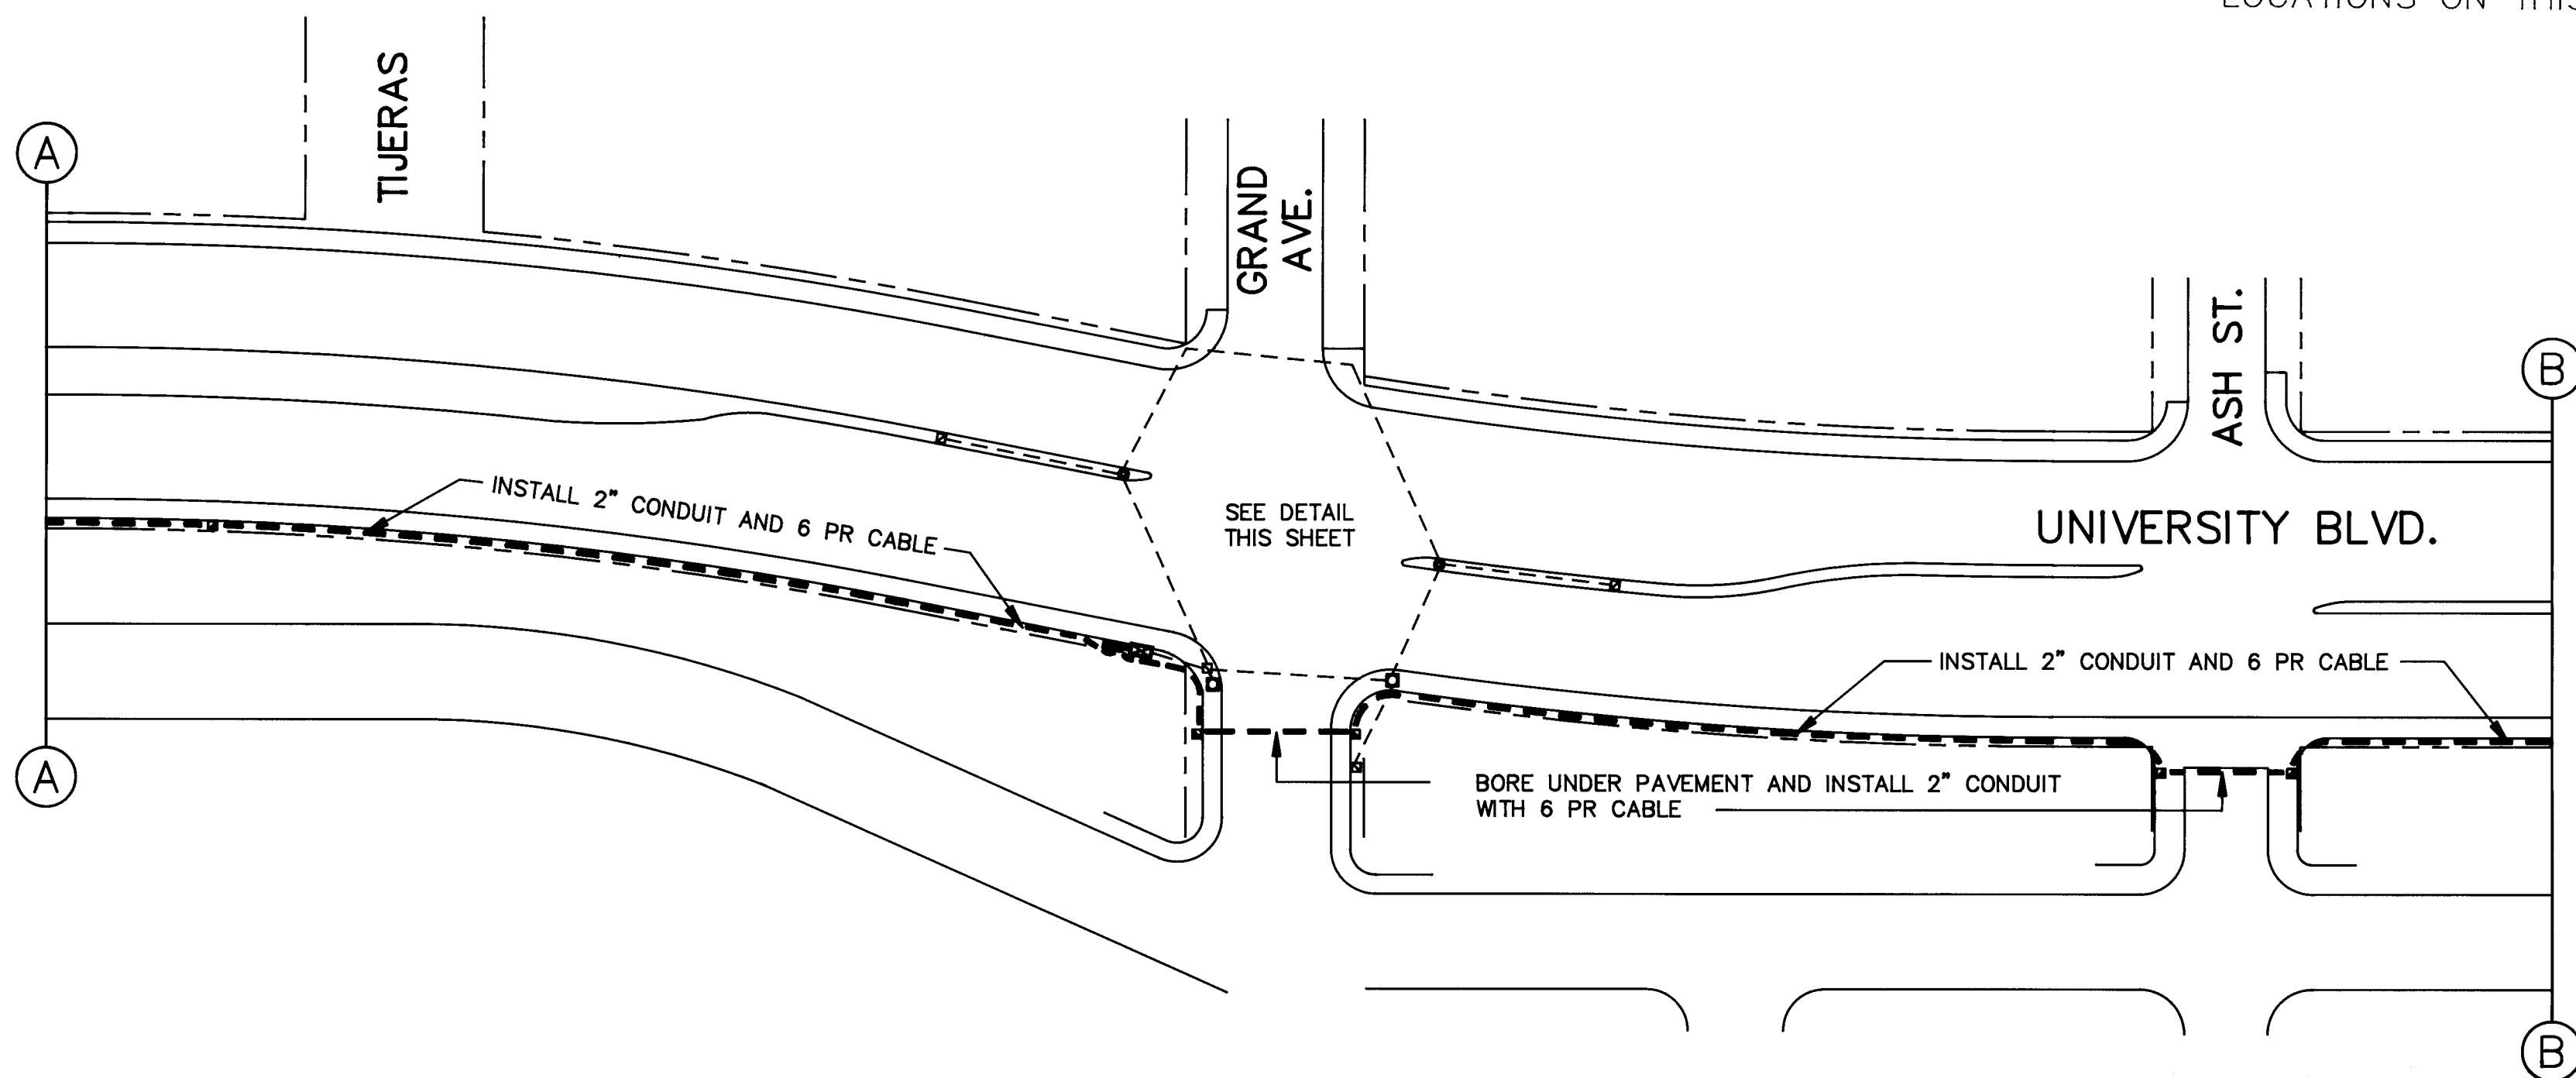

UNIVERSITY BLVD AND GRAND AVE DETAIL

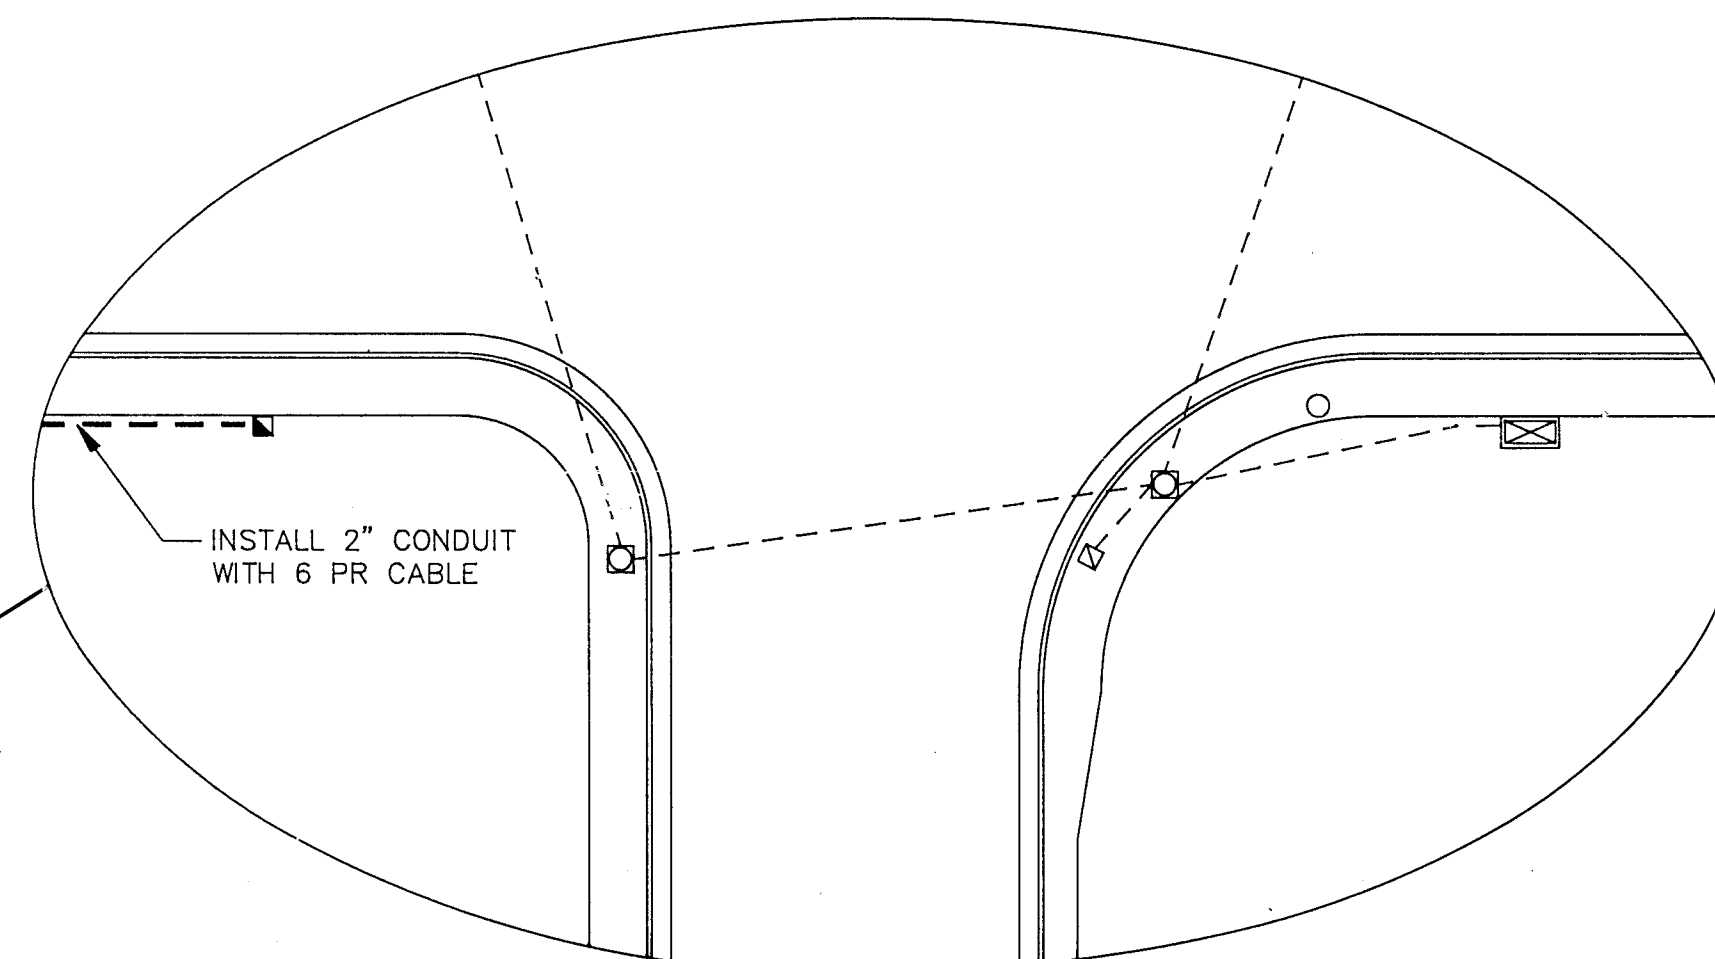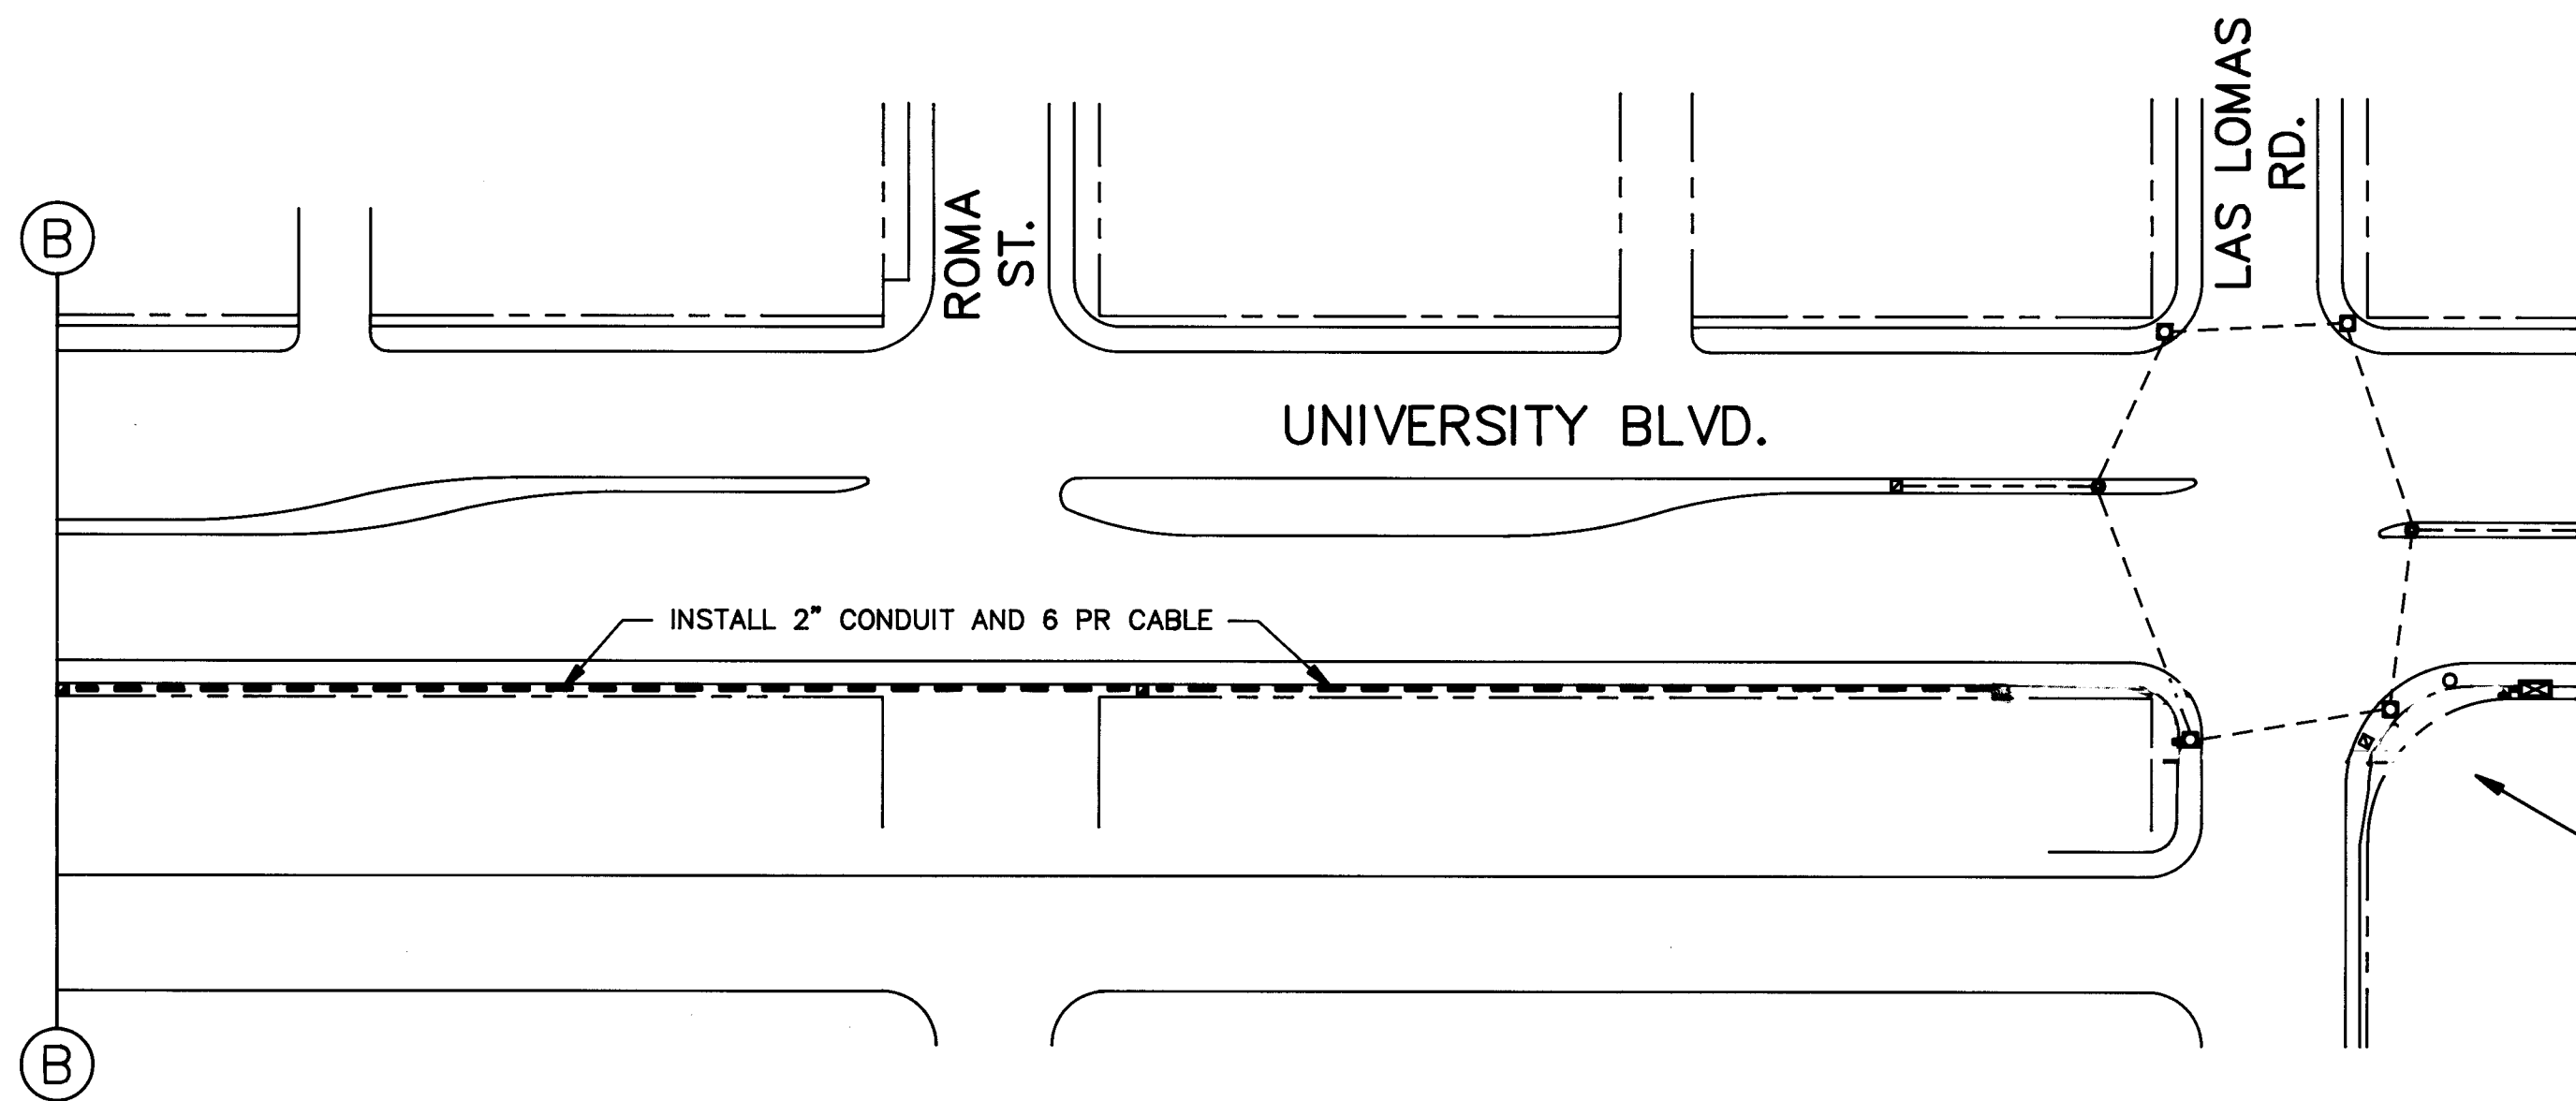

LEGEND	
EXISTING	PROPOSED

AS BUILT INFORMATION	
CONTRACTOR	DATE
INSPECTOR	DATE
VERIFIED BY	DATE
CORRECTED BY	DATE
RECORDED BY	DATE

BENCH MARKS	
NO.	DATE

SURVEY INFORMATION	
FIELD NOTES	DATE
BY	
NO.	

ENGINEER'S SEAL	
NO.	DATE

REVISIONS	
NO.	DATE

DESIGNED BY	
RWF, JDC	DATE
DRAWN BY	
RWF, JWC, EUR	DATE
CHECKED BY	
HAW	DATE

RECORD DRAWING	
THIS DRAWING HAS BEEN REVISED TO SHOW THOSE CHANGES DURING THE CONSTRUCTION PROCESS REPORTED TO KIMLEY-HORN AND ASSOCIATES, INC. AND CONSIDERED TO BE SIGNIFICANT. THIS DRAWING IS NOT GUARANTEED TO BE "AS BUILT" BUT IS BASED ON THE AVAILABLE INFORMATION.	
DATE	BY

"NO CHANGE"	
26	33863393

SCALE:	
1"=50' (RUNS)	
1"=20' (INSERTS)	

KIMLEY-HORN and ASSOC. INC.	
DALLAS, TEXAS	
In Association With	
EDWIN L. BECK, P.E., CONSULTANT	
ALBUQUERQUE, N.M.	

CITY OF ALBUQUERQUE	
PUBLIC WORKS DEPARTMENT	
ENGINEERING GROUP	

TITLE:	
TRAFFIC SIGNAL INTERCONNECT	
UNIVERSITY BLVD.	
FROM CENTRAL RD. TO LAS LOMAS RD.	

APPROVALS	ENGINEER	DATE	APPROVALS	ENGINEER	DATE
City Engineer	RWF	1/1/87	Liquid Waste	RWF	1/1/87
A.C.E. Design	RWF	1/1/87	Traffic	RWF	1/1/87
A.C. E.-Hydrology	RWF	1/1/87	Water	RWF	1/1/87

DRAWING NO.	MAP NO.	SHEET	OF
3386		33	39

## SUMMARY OF QUANTITIES


\* - TO BE INSTALLED USING CITY FORCES AND MATERIALS.

[illegible]

SUMMARY OF QUANTITIES

ITEM	UNITS	LOCATION							SHEET TOTAL
		COMANCHE FROM SAN PEDRO TO WYOMING (SHEETS 13-15)	MONTGOMERY FROM WYOMING TO JUAN TABO (SHEETS 16-18)	COMANCHE FROM MORRIS TO JUAN TABO (SHEET 19)	MENAU FROM WYOMING TO MOON (SHEET 20)	MENAU FROM EUBANK TO MORRIS (SHEET 21)	EUBANK FROM MENAU TO CANDELARIA (SHEET 22)	CONSTITUTION FROM WYOMING TO EUBANK (SHEETS 23-24)	
CABLE									
6 PR IN EXISTING CONDUIT	LIN. FT.	8200	115	185	330	260	2720	160	1197
12 PR IN EXISTING CONDUIT	LIN. FT.		10						10
6 PR IN PROPOSED CONDUIT	LIN. FT.	670	15	2630	2550	2585	180	4540	13,170
12 PR IN PROPOSED CONDUIT	LIN. FT.		450						450
REMOVE EXISTING CABLE AND MESSENGER	LIN. FT.		10,695						10,695
AERIAL 6 PR, WITH INTEGRAL MESSENGER	LIN. FT.							1350	1350
AERIAL 12 PR, WITH INTEGRAL MESSENGER	LIN. FT.		10,695						10,695
2" CONDUIT									
TRENCHING IN DIRT	LIN. FT.	140	85	2145	2420	2175	65	3575	10,605
TRENCHING IN ASPHALT	LIN. FT.								
TRENCHING IN CONCRETE	LIN. FT.								
TRENCHING IN SIDEWALK	LIN. FT.	10	5		10		20	45	90
TRENCHING, BORING, OR JACKING 2" CONDUIT UNDER PAVEMENT OR SIDEWALK	LIN. FT.	400		485	130	410	95	820	2340
PULL BOX	EACH	5		15	10	11	4	27	72
MANHOLE	EACH	5	9	1	2	1	1	5	24
SPLICE CABINET	EACH								0
SPLICE CABINET AND FOUNDATION	EACH	2	7		1			4	14
POLE RISER WITH WEATHERHEAD	EACH		8					2	10
POLE	EACH							1	1
POLE AND GUY(S)	EACH							1	1
PEDESTAL BASE FOUNDATION	EACH								
DRILL THROUGH WINGWALL FOR CONDUIT	NO. HOLES				2				2

\* - TO BE INSTALLED USING CITY FORCES AND MATERIALS.

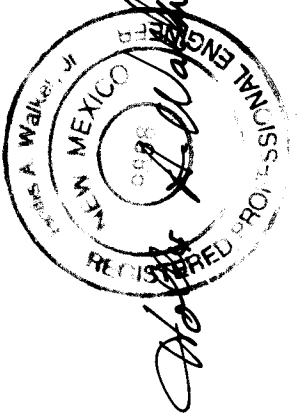AS BUILT INFORMATION		BENCH MARKS		SURVEY INFORMATION		ENGINEER'S SEAL	
CONTRACTOR	WORK ORDER NO.	DATE	NO.	BY	DATE		REMARKS
JET CON	00-1	11/11/88					
VERIFICATION BY	DATE	VERIFICATION BY	DATE	VERIFICATION BY	DATE	DESIGNED BY	DATE
E BECK	11/11/88	E BECK	11/11/88	E BECK	11/11/88	RWF, JWC, EJR	8/14/87
MICRO-FILM INFORMATION		RECORDED BY		DATE		DRAWN BY	DATE
						RWF, JWC, EJR	8/25/87
						CHECKED BY	DATE
						HAW	8/31/87


RECORD DRAWING

THIS DRAWING HAS BEEN REVISED TO SHOW THOSE CHANGES DURING THE CONSTRUCTION PROCESS REPORTED TO KIMLEY-HORN AND ASSOCIATES, INC. AND CONSIDERED TO BE SIGNIFICANT. THIS DRAWING IS NOT GUARANTEED TO BE "AS BUILT" BUT IS BASED ON THE AVAILABLE INFORMATION.

DATE 10/31/89 BY *Jan B...*

"NO CHANGE"

26 33863593

  
KIMLEY-HORN and ASSOC. INC.  
DALLAS, TEXAS  
In Association With  
EDWIN L. BECK, P.E., CONSULTANT  
ALBUQUERQUE, N.M.

CITY OF ALBUQUERQUE PUBLIC WORKS DEPARTMENT ENGINEERING GROUP					
TITLE: SUMMARY OF QUANTITIES					
APPROVALS	ENGINEER	DATE	APPROVALS	ENGINEER	DATE
City Engineer	<i>[Signature]</i>	11/11/88	Liquid Waste	<i>[Signature]</i>	11/11/88
A.C.E. Design	<i>[Signature]</i>	"	Traffic	<i>[Signature]</i>	11/11/88
A.C. E.-Hydrology	<i>[Signature]</i>	"	Water	<i>[Signature]</i>	11/11/88
			Traffic Operation	<i>[Signature]</i>	11/11/88
DRAWING NO.	3386		MAP NO.	SHEET 35 OF 39	

