

• L E G E N D •

MATERIALS

CONCRETE
RIP-RAP

LINES

SUBDIVISION BOUNDARY
PROPERTY LINE (PLAN)
PROPERTY LINE (SECTION)
CENTERLINE
EASEMENT LINE
MATCH LINE
SECTION CUT LINE

EARTHWORK

CONTOUR LINE
SPOT ELEVATION
PROJECT / PHASE BOUNDARY
SWALE
DIRECTION OF FLOW

MISCELLANEOUS UTILITIES

GAS LINE
UNDERGROUND TELEPHONE
UNDERGROUND ELECTRICAL
STORM DRAIN
STORM DRAIN MANHOLE
STORM DRAIN INLET

SANITARY SEWER

SANITARY SEWER LINE
SANITARY SEWER MANHOLE
SAS SERVICE CONNECTIONS
SAS CAP OR PLUG
ENCASEMENT

WATER

WATER LINE
WATER SERVICE CONNECTIONS
GATE VALVE
FIRE HYDRANT
BUTTERFLY VALVE
REDUCER
WATER PRESSURE ZONE BOUNDARY

WATER FITTINGS

CAPS AND PLUGS
ELBOW
CROSS
TEE


MISCELLANEOUS

CHAINLINK FENCE
FIELD FENCE
COMMON YARD WALL
RETAINING WALL
POWER OR TELEPHONE POLE

RECORD DRAWING

CONSTRUCTION PLANS
for

**VINEYARD ESTATES
DETENTION POND AND
BARSTOW STREET STORM DRAIN**
ALBUQUERQUE, NEW MEXICO
JULY, 1991

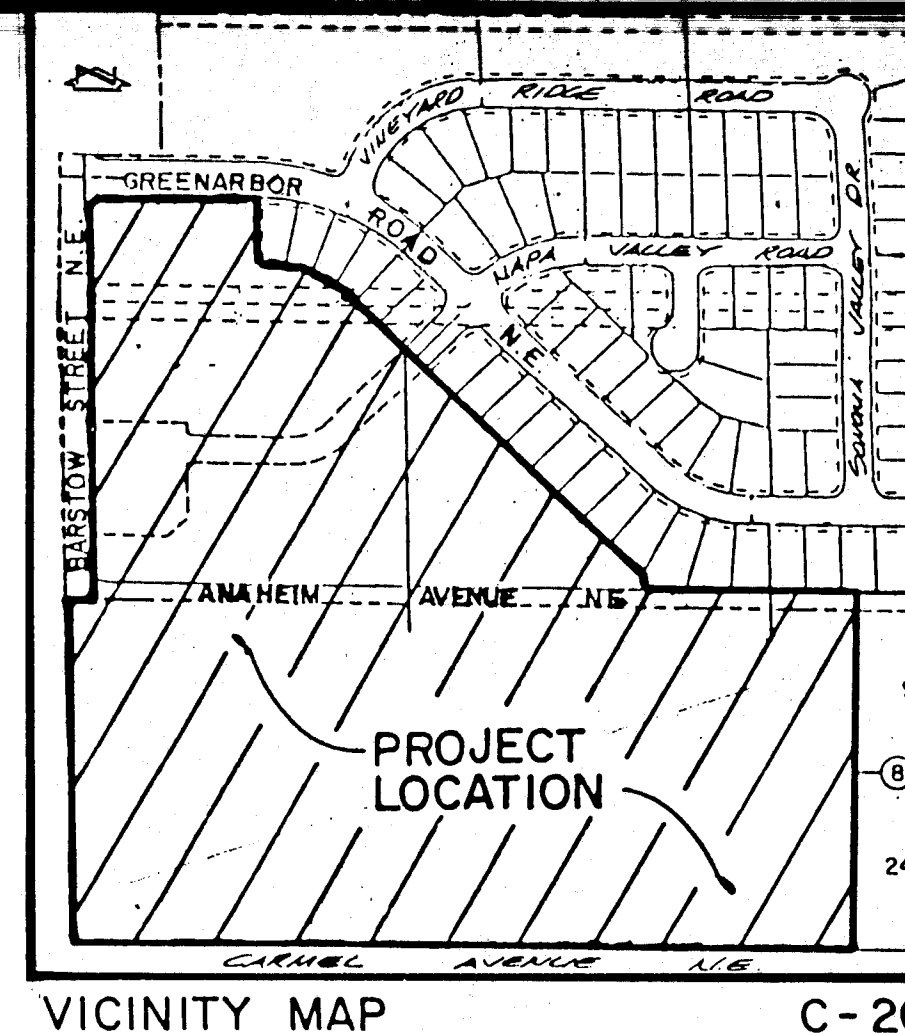

GENERAL NOTES:


- ALL WORK DETAILED ON THESE PLANS TO BE PERFORMED UNDER CONTRACT SHALL, EXCEPT AS OTHERWISE STATED OR PROVIDED FOR HEREON, BE CONSTRUCTED IN ACCORDANCE WITH THE CITY OF ALBUQUERQUE STANDARD SPECIFICATIONS - PUBLIC WORKS CONSTRUCTION - 1986.
- TWO (2) WORKING DAYS PRIOR TO ANY EXCAVATION, CONTRACTOR MUST CONTACT NEW MEXICO ONE CALL SYSTEM, 260-1990, FOR LOCATION OF EXISTING UTILITIES.
- IF ANY UTILITY LINES, PIPELINES, OR UNDERGROUND UTILITY LINES ARE SHOWN ON THESE DRAWINGS, THEY ARE SHOWN IN AN APPROXIMATE MANNER ONLY, AND SUCH LINES MAY EXIST WHERE NONE ARE SHOWN. IF ANY SUCH EXISTING LINES ARE SHOWN, THE LOCATION IS BASED UPON INFORMATION PROVIDED BY THE OWNER OF SAID UTILITY, AND THE INFORMATION MAY BE INCOMPLETE, OR MAY BE OBSOLETE BY THE TIME CONSTRUCTION COMMENCES. THE ENGINEER HAS CONDUCTED ONLY PRELIMINARY INVESTIGATION OF THE LOCATION, DEPTH, SIZE, AND TYPE OF EXISTING UTILITY LINES, PIPELINES, OR UNDERGROUND UTILITY LINES. THIS INVESTIGATION IS NOT CONCLUSIVE, AND MAY NOT BE COMPLETE, THEREFORE, MAKES NO REPRESENTATION PERTAINING THERETO, AND ASSUMES NO RESPONSIBILITY OR LIABILITY THEREFOR. THE CONTRACTOR SHALL INFORM ITSELF OF THE LOCATION OF ANY UTILITY LINE, PIPELINE, OR UNDERGROUND UTILITY LINE IN OR NEAR THE AREA OF THE WORK IN ADVANCE OF AND DURING EXCAVATION WORK. THE CONTRACTOR IS FULLY RESPONSIBLE FOR ANY AND ALL DAMAGE CAUSED BY ITS FAILURE TO LOCATE, IDENTIFY AND PRESERVE ANY AND ALL EXISTING UTILITIES, PIPELINES, AND UNDERGROUND UTILITY LINES. IN PLANNING AND CONDUCTING EXCAVATION, THE CONTRACTOR SHALL COMPLY WITH STATE STATUTES, MUNICIPAL AND LOCAL ORDINANCES, RULES AND REGULATIONS, IF ANY, PERTAINING TO THE LOCATION OF THESE LINES AND FACILITIES.
- SHOULD A CONFLICT EXIST BETWEEN THESE PLANS AND ACTUAL FIELD CONDITIONS, THE CONTRACTOR SHALL PROMPTLY NOTIFY THE ENGINEER IN WRITING SO THAT THE CONFLICT CAN BE RESOLVED WITH A MINIMUM AMOUNT OF DELAY FOR ALL PARTIES.
- THE CONTRACTOR SHALL MAINTAIN ACCESS TO ADJACENT PROPERTIES DURING CONSTRUCTION.
- ALL WORK ON THIS PROJECT SHALL BE PERFORMED IN ACCORDANCE WITH APPLICABLE FEDERAL, STATE AND LOCAL LAWS, RULES AND REGULATIONS CONCERNING SAFETY AND HEALTH.
- CONTRACTOR SHALL COMPLY WITH SECTION 19 OF THE "STANDARD SPECIFICATIONS".
- ALL UTILITIES AND UTILITY SERVICE LINES SHALL BE INSTALLED PRIOR TO PAVING.
- BACKFILL COMPACTION SHALL BE ACCORDING TO SPECIFIED STREET USE.
- TACK COAT REQUIREMENTS SHALL BE DETERMINED DURING CONSTRUCTION BY THE PROJECT ENGINEER.
- SIDEWALKS AND WHEELCHAIR RAMPS WITHIN THE CURB RETURNS SHALL BE CONSTRUCTED WHEREVER A NEW CURB RETURN IS CONSTRUCTED.
- IF CURB IS DEPRESSED FOR A DRIVEPAD OR A HANDICAP RAMP, THE DRIVEPAD OR RAMP SHALL BE CONSTRUCTED PRIOR TO ACCEPTANCE OF THE CURB AND GUTTER.
- ALL STORM DRAINAGE FACILITIES SHALL BE COMPLETED PRIOR TO FINAL ACCEPTANCE.
- CONTRACTOR SHALL COORDINATE WITH THE WATER SYSTEM DIVISION FOR THE EXECUTION OF THE VALVE SHUT OFF PLAN, NOT LESS THAN THREE (3) WORKING DAYS IN ADVANCE OF ANY WORK THAT MAY AFFECT THE EXISTING PUBLIC WATER UTILITIES.
- CONTRACTOR SHALL NOTIFY THE ENGINEER NOT LESS THAN SEVEN (7) DAYS PRIOR TO STARTING WORK IN ORDER THAT THE ENGINEER MAY TAKE NECESSARY MEASURES TO INSURE THE PRESERVATION OF SURVEY MONUMENTS. CONTRACTOR SHALL NOT DISTURB PERMANENT SURVEY MONUMENTS WITHOUT THE CONSENT OF THE ENGINEER AND SHALL NOTIFY THE ENGINEER AND BEAR THE EXPENSE OF REPLACING ANY THAT MAY BE DISTURBED WITHOUT PERMISSION. REPLACEMENT SHALL BE DONE ONLY BY THE ENGINEER. WHEN A CHANGE IS MADE IN THE FINISHED ELEVATION OF THE PAVEMENT OF ANY ROADWAY IN WHICH A PERMANENT SURVEY MONUMENT IS LOCATED, CONTRACTOR SHALL, AT HIS OWN EXPENSE, ADJUST THE MONUMENT COVER TO THE NEW GRADE UNLESS OTHERWISE SPECIFIED.
- THREE (3) WORKING DAYS PRIOR TO BEGINNING CONSTRUCTION THE CONTRACTOR SHALL SUBMIT TO THE CONSTRUCTION CO-ORDINATION DIVISION A DETAILED CONSTRUCTION SCHEDULE. TWO (2) WORKING DAYS PRIOR TO CONSTRUCTION THE CONTRACTOR SHALL OBTAIN A BARRICADING PERMIT FROM THE CONSTRUCTION CO-ORDINATION DIVISION. CONTRACTOR SHALL NOTIFY BARRICADE ENGINEER (768-2551) PRIOR TO OCCUPYING AN INTERSECTION.
- ALL STREET STRIPING ALTERED OR DESTROYED SHALL BE REPLACED IN KIND BY CONTRACTOR TO LOCATION AND IN KIND AS EXISTING OR AS INDICATED BY THIS PLAN SET.

INDEX OF DRAWINGS

SHEET NO.	DESCRIPTION
1.	Cover Sheet, Index of Drawings, Legend, General Notes, Vicinity Map
2.	Plat
3.	Plan and Profile Sta. 7+92 (Back) to Sta. 5+85.86 (AHD)
4.	Plan and Profile Sta. 5+85.36 to Sta. 13+06
5.	Drainage Plan, Calculations & Sections
6.	Outlet Structure Sections & Details Waterline Lowering Section/Valve Shutoff Plan

RECORD DRAWING

I, Jeffrey G. Mortensen, Registered Professional Engineer in the State of New Mexico, do hereby certify that this "as-built" information was obtained by me or under my supervision and represents the "as-built" conditions of this project, and is true and correct to the best of my knowledge and belief. All vertical and horizontal dimensions should be field verified prior to use on future projects.

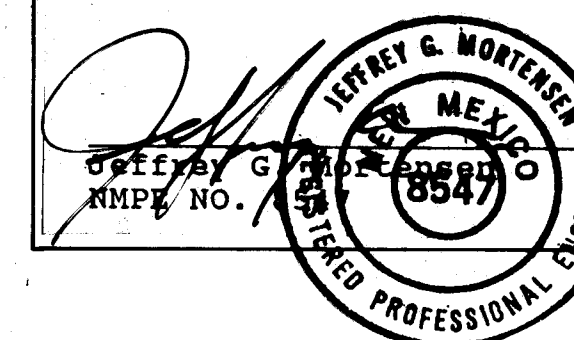


Date 01-09-91

1 2 3 4 5 6 7 8 9 10 11 12 13 14 15
26 33 91 91 01 92

APPROVAL OF AS-BUILT DRAWINGS
CHIEF CONSTRUCTION ENGINEER
DATE 3/1/91

REV	SHEETS	CITY ENGINEER	DATE	USER DEPARTMENT	DATE	USER DEPARTMENT	DATE
1-6							

APPROVAL OF REVISIONS

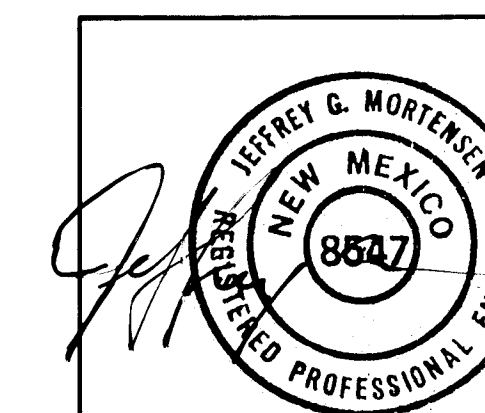

JEFF MORTENSEN & ASSOCIATES, INC.
6000-B MIDWAY PARK BLVD. NE
ALBUQUERQUE, NEW MEXICO 87113
ENGINEERS D (505) 348-4255

3391.91

APPROVED FOR CONSTRUCTION
DATE 10-15-91
SHEET 1 OF 6

CAUTION:


THESE DRAWINGS DO NOT INCLUDE NECESSARY COMPONENTS FOR CONSTRUCTION SAFETY WHICH SHALL REMAIN THE RESPONSIBILITY OF THE CONTRACTOR.

J.M.A. JOB NO. 900554

07-18-91

8926039

PLAT OF
TRACTS B-1, B-2 and B-3
VINEYARD ESTATES
ALBUQUERQUE, NEW MEXICO
DECEMBER, 1988

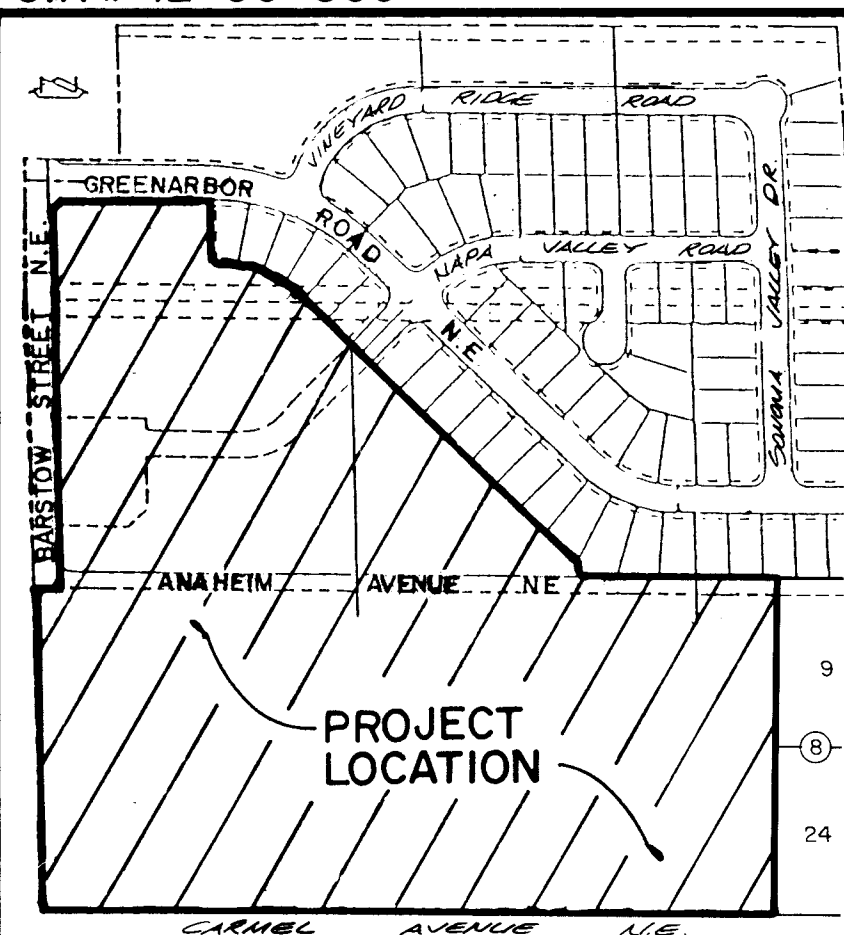

VICINITY MAP

C-20

N.T.S.

NOTICE OF SUBDIVISION CONDITIONS

A variance or waiver from certain subdivision requirements has been granted by the City and the Albuquerque Metropolitan Arroyo Flood Control Authority in connection with this plat.

Future subdivision of Tracts B-1 and B-2, Vineyard Estates, within this plat, zoning site development plan approvals, and development permits may be conditioned upon dedication of rights-of-way and easements, and/or upon infrastructure improvements by the owner for water, sanitary sewer, streets, drainage, grading and parks in accordance with current resolutions, ordinances and policies in effect at the time for any specific proposal.

The City (and AMAFCA with reference to drainage) may require and/or permit easements to be added, modified or removed when future plats or site development plans are approved.

By its approval the City makes no representation or warranties as to availability of utilities, or final approval of all requirements including (but not limited to) the following items: water and sanitary sewer availability; future street dedications and/or improvements; park and open space requirements; drainage requirements and/or improvements; and excavation, filling or grading requirements. Any person intending development of lands within this subdivision is cautioned to investigate the status of these items.

Bernalillo County, New Mexico Filing Data:

N-7304 Pg 114 3-21-1

Notes:

1. A field survey was performed on November 18, 19 and 21, 1988; corners were found or set as shown.
2. No street mileage was created.
3. All distances are ground distances.
4. Site located within Projected Section 17, T11N, R4E, N.M.P.M.
5. Bearings are grid bearings per plat of "Vineyard Estates" filed March 31, 1988, Book C36, Page 43.
6. The purpose of this plat is to:
 - a. incorporate public right-of-way within former Anaheim Ave. N.E. vacated by V-88-37
 - b. reserve road easement for future public street right-of-way dedication
 - c. grant necessary easements as shown and
 - d. eliminate interior property lines to create three tracts of land.

DESCRIPTION

A certain tract of land located within the Corporate Limits of the City of Albuquerque, New Mexico, comprising Tract B, Vineyard Estates, as shown on the plat filed in the Office of the County Clerk of Bernalillo County, New Mexico on March 31, 1988, Book C36, Page 43, Lots 1 - 8, inclusive, and 25 - 32, inclusive, Block 8, and portions of Carmel Avenue N.E. and Barstow Street N.E., North Albuquerque Acres, Tract 3, Unit 3, as shown on the plat filed in the Office of the County Clerk of Bernalillo County, New Mexico, on September 10, 1931, Book D, Page 121, including public right-of-way within former Anaheim Avenue N.E. vacated by V-88-37, and being more particularly described as follows:

Beginning at the northwest corner of the parcel herein described, being the northwest corner of said Tract B, and also being a point on the east right-of-way line of Barstow Street N.E.; thence along the arc of a curve to the right with DELTA = 90°00'00", R = 30.00 feet, L = 47.12 feet, Chord Bearing = N 45°09'48" E, and Chord Length = 42.43 feet to a point on the south right-of-way line of Green Harbor Road N.E.; thence S 89°50'12" E a distance of 260.09 feet along said right-of-way line; thence S 00°09'48" W a distance of 120.00 feet; thence S 89°50'12" E a distance of 7.99 feet; thence along the arc of a curve to the right with DELTA = 45°10'22", R = 245.00 feet, L = 193.16 feet, Chord Bearing = S 67°15'01" E, and Chord Length = 188.20 feet; thence S 44°39'50" E a distance of 657.08 feet; thence S 00°20'10" W a distance of 29.52 feet to the southeast corner of said Tract B, also being a point on the north right-of-way line of former Anaheim Avenue N.E.; thence S 89°39'50" E a distance of 349.87 feet along said former right-of-way line; thence S 00°14'35" W a distance of 557.61 feet to the southeast corner of the parcel herein described, also being a point on the centerline of Carmel Avenue N.E.; thence N 89°39'41" W a distance of 1324.06 feet along said centerline to the southwest corner of the parcel herein described, also being the point of intersection of the centerline of Carmel Avenue N.E. with the centerline of Barstow Street N.E.; thence N 00°09'48" E a distance of 527.55 feet along the Barstow Street N.E. centerline; thence S 89°39'50" E a distance of 40.00 feet to a point on the east right-of-way line of Barstow Street N.E.; thence N 00°09'48" E a distance of 685.00 feet to the point of beginning and containing 26.5430 acres more or less.

CERTIFICATION

I, William P. Pettit, a registered Professional Surveyor under the laws of the State of New Mexico, do hereby certify that this plat was prepared by me or under my supervision; shows all easements noted in a title report prepared by NONE PROVIDED; meets the minimum requirements of monumentation and surveys of the Albuquerque Subdivision Ordinance, and is true and correct to the best of my knowledge and belief.

William P. Pettit
William P. Pettit, N.M.P.S. No. 3243

ACKNOWLEDGEMENT

STATE OF NEW MEXICO)
COUNTY OF BERNALILLO)

The foregoing instrument was acknowledged before me on this 28th day of February, 1989.

Charles W. White
Notary Public

DEDICATION AND FREE CONSENT

The undersigned owners of the land shown hereon do hereby consent to the subdivision of said land in the manner shown on this plat and do hereby dedicate the public street right-of-way and grant the easements as shown hereon including the rights of ingress and egress and the right to trim interfering trees.

Charles W. White
CHARLES WHITE, DEPUTY SUPERINTENDENT FOR GENERAL SERVICES, A.P.S.

ACKNOWLEDGEMENT

STATE OF NEW MEXICO)
COUNTY OF BERNALILLO)



OFFICIAL SEAL
CHARLES G. CALA, JR.
NOTARY PUBLIC - STATE OF NEW MEXICO
My Commission Expires 5-6-89

The foregoing instrument was acknowledged before me this 28th day of February, 1989.

Charles W. White
Notary Public


APPROVALS: D.R.B. 88-239

Jack Cleard 3-29-89
Planning Director, City of Albuquerque, N.M. Date
William Salas 3-7-89
Utility Development, City of Albuquerque, N.M. Date
Paul J. Aguirre 3/6/89
City Engineer, City of Albuquerque Date
Paul J. Aguirre 3/7/89
A.M.A.F.C.A., City of Albuquerque Date
Paul W. Hamner 3/7/89
Traffic Engineer, City of Albuquerque, N.M. Date
James M. Stettin 3/7/89
Parks and Recreation, City of Albuquerque, N.M. Date
David H. Hincio 3-1-89
Property Manager, City of Albuquerque, N.M. Date
Stanley Ruyar 1-13-89
Public Service Company of New Mexico Date
Joe Dunlap 1-13-89
Gas Company of New Mexico Date
Greg Hunt 1-11-89
U.S. West Date
Karin Samallo 1-16-89
Jones Interchange Date

8926039

PLAT OF
TRACTS B-1, B-2 and B-3
VINEYARD ESTATES
ALBUQUERQUE, NEW MEXICO
DECEMBER, 1988

RECORD DRAWING

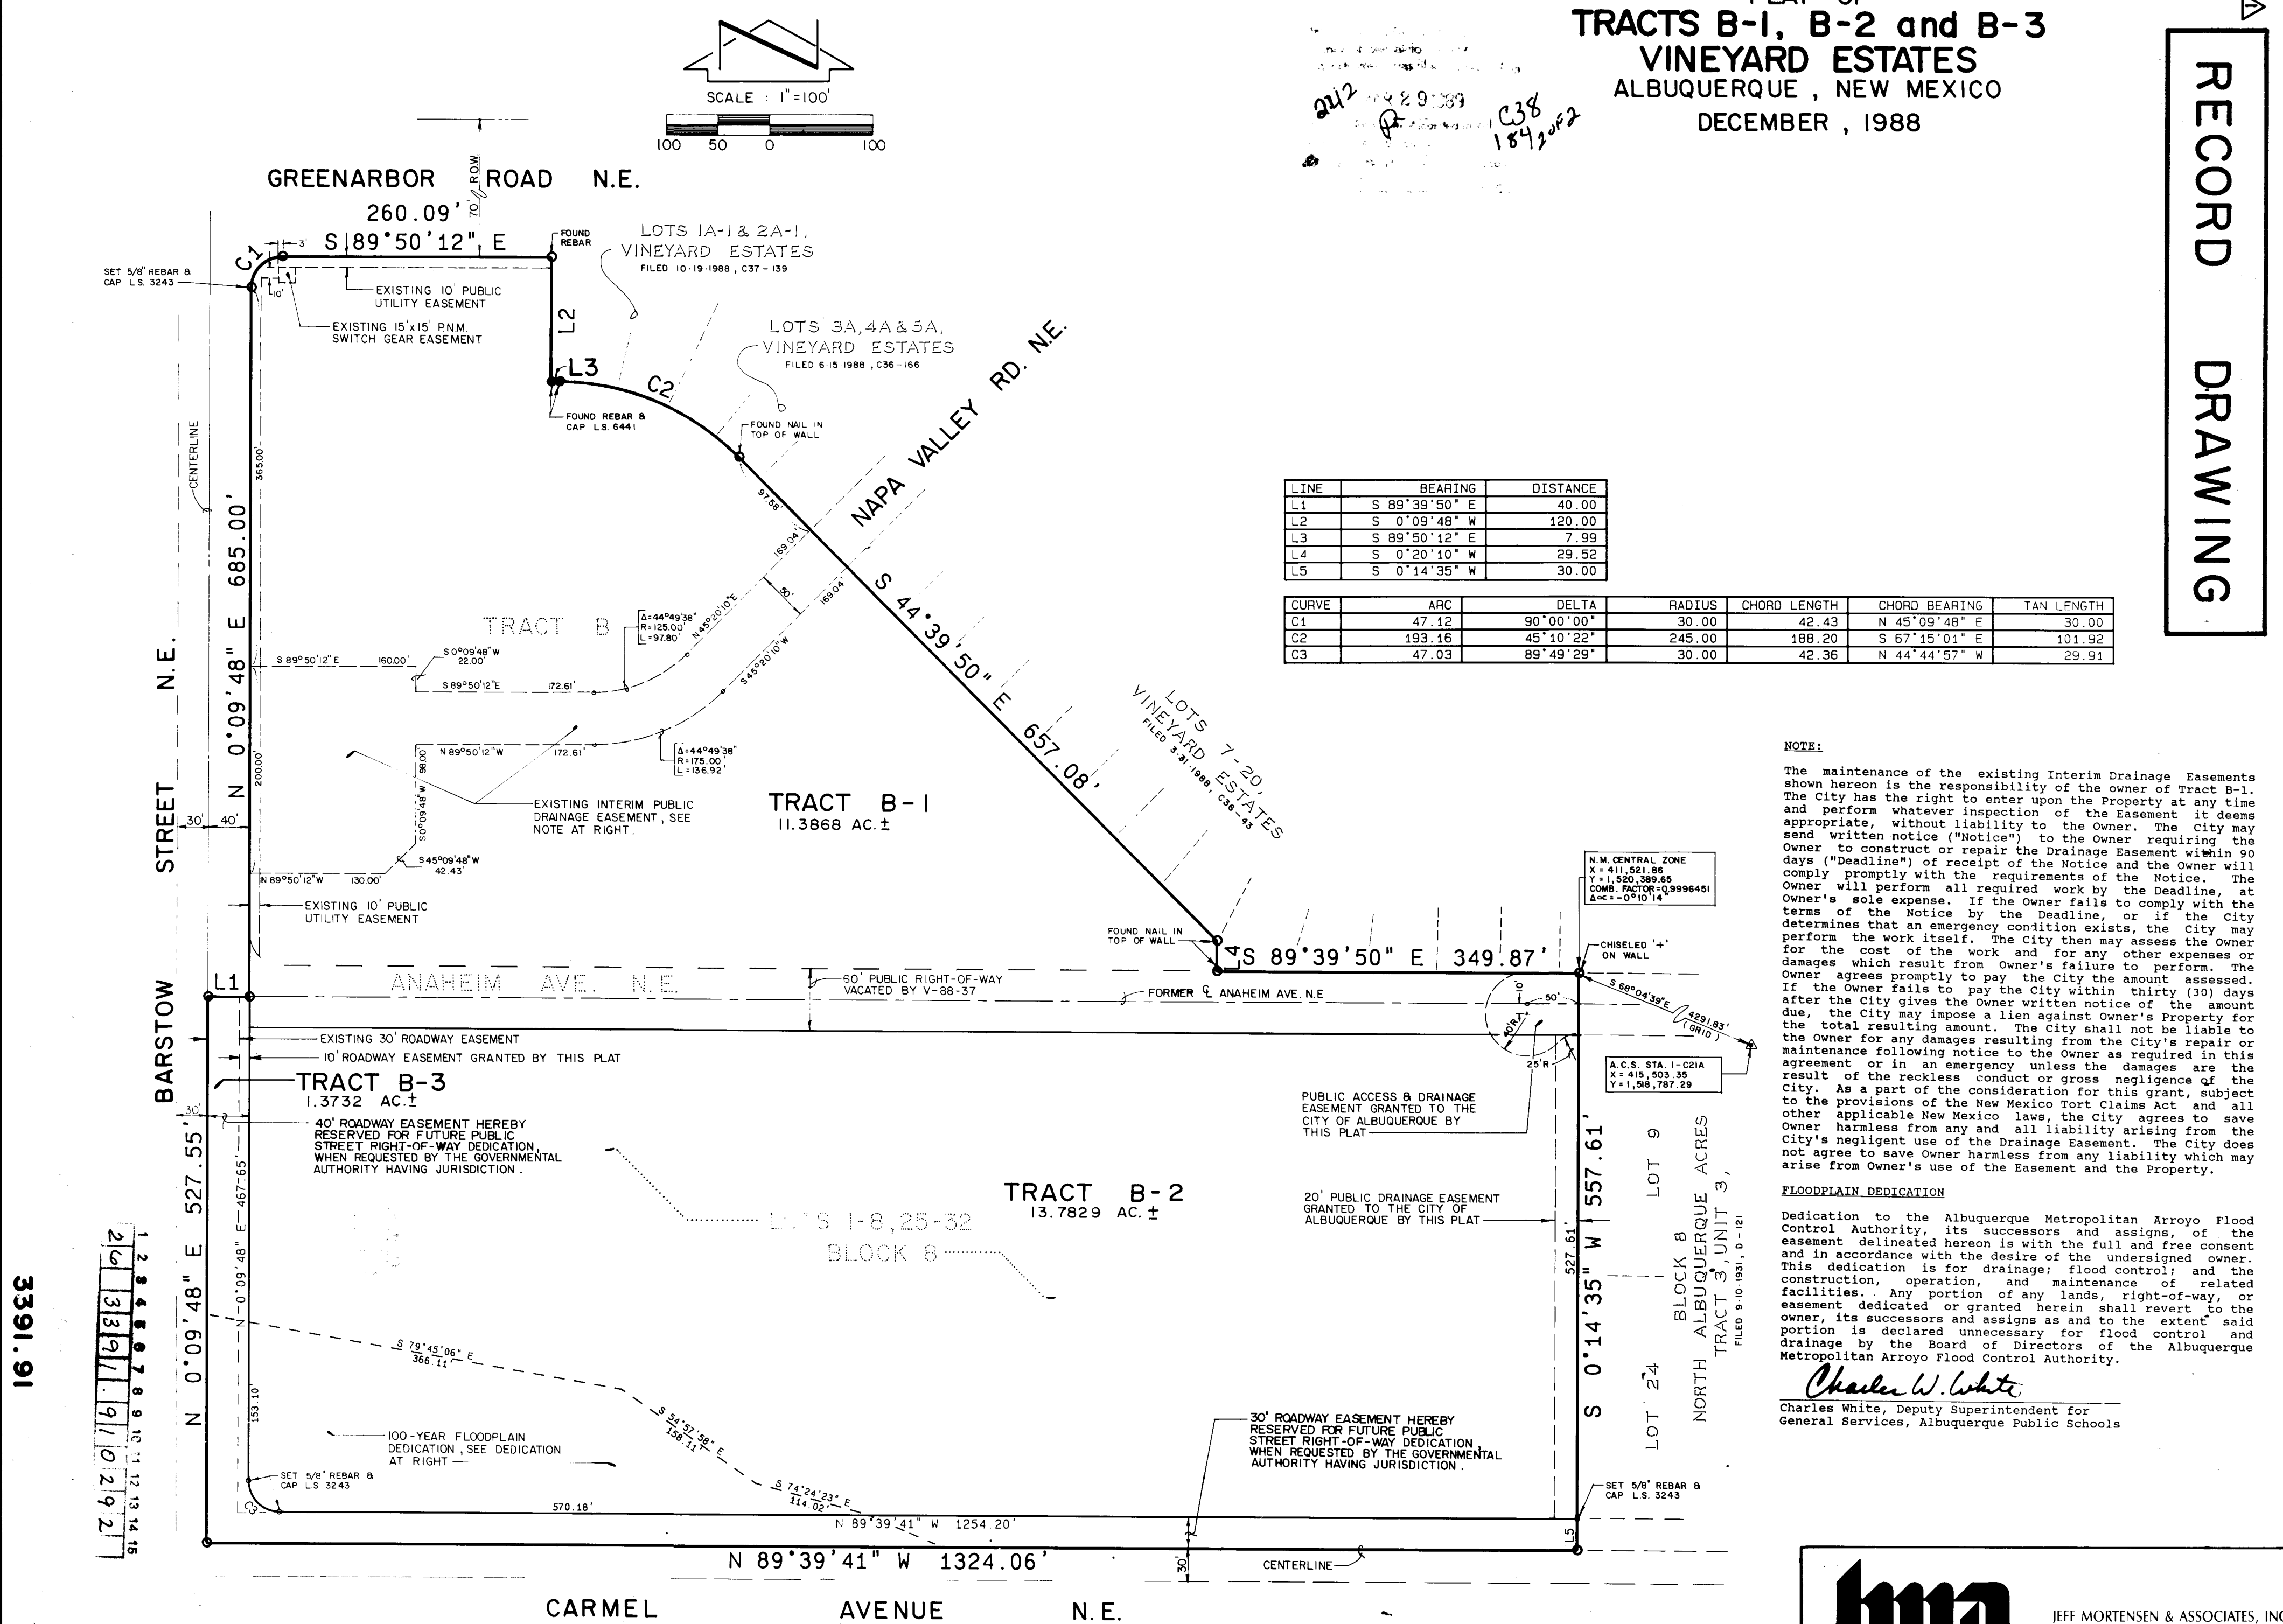



RECORD DRAWING

RECORD DRAWING

I, Jeffrey G. Mortensen, Registered Professional Engineer in the State of New Mexico, do hereby certify that this "as-built" information was obtained by me or under my supervision and represents the "as-built" conditions of this project, and is true and correct to the best of my knowledge and belief. All vertical and horizontal dimensions should be field verified prior to use on future projects.


Jeffrey G. Mortensen
NMPE NO. 8547
Date 09-92

REGISTERED PROFESSIONAL ENGINEER
NEW MEXICO
8547

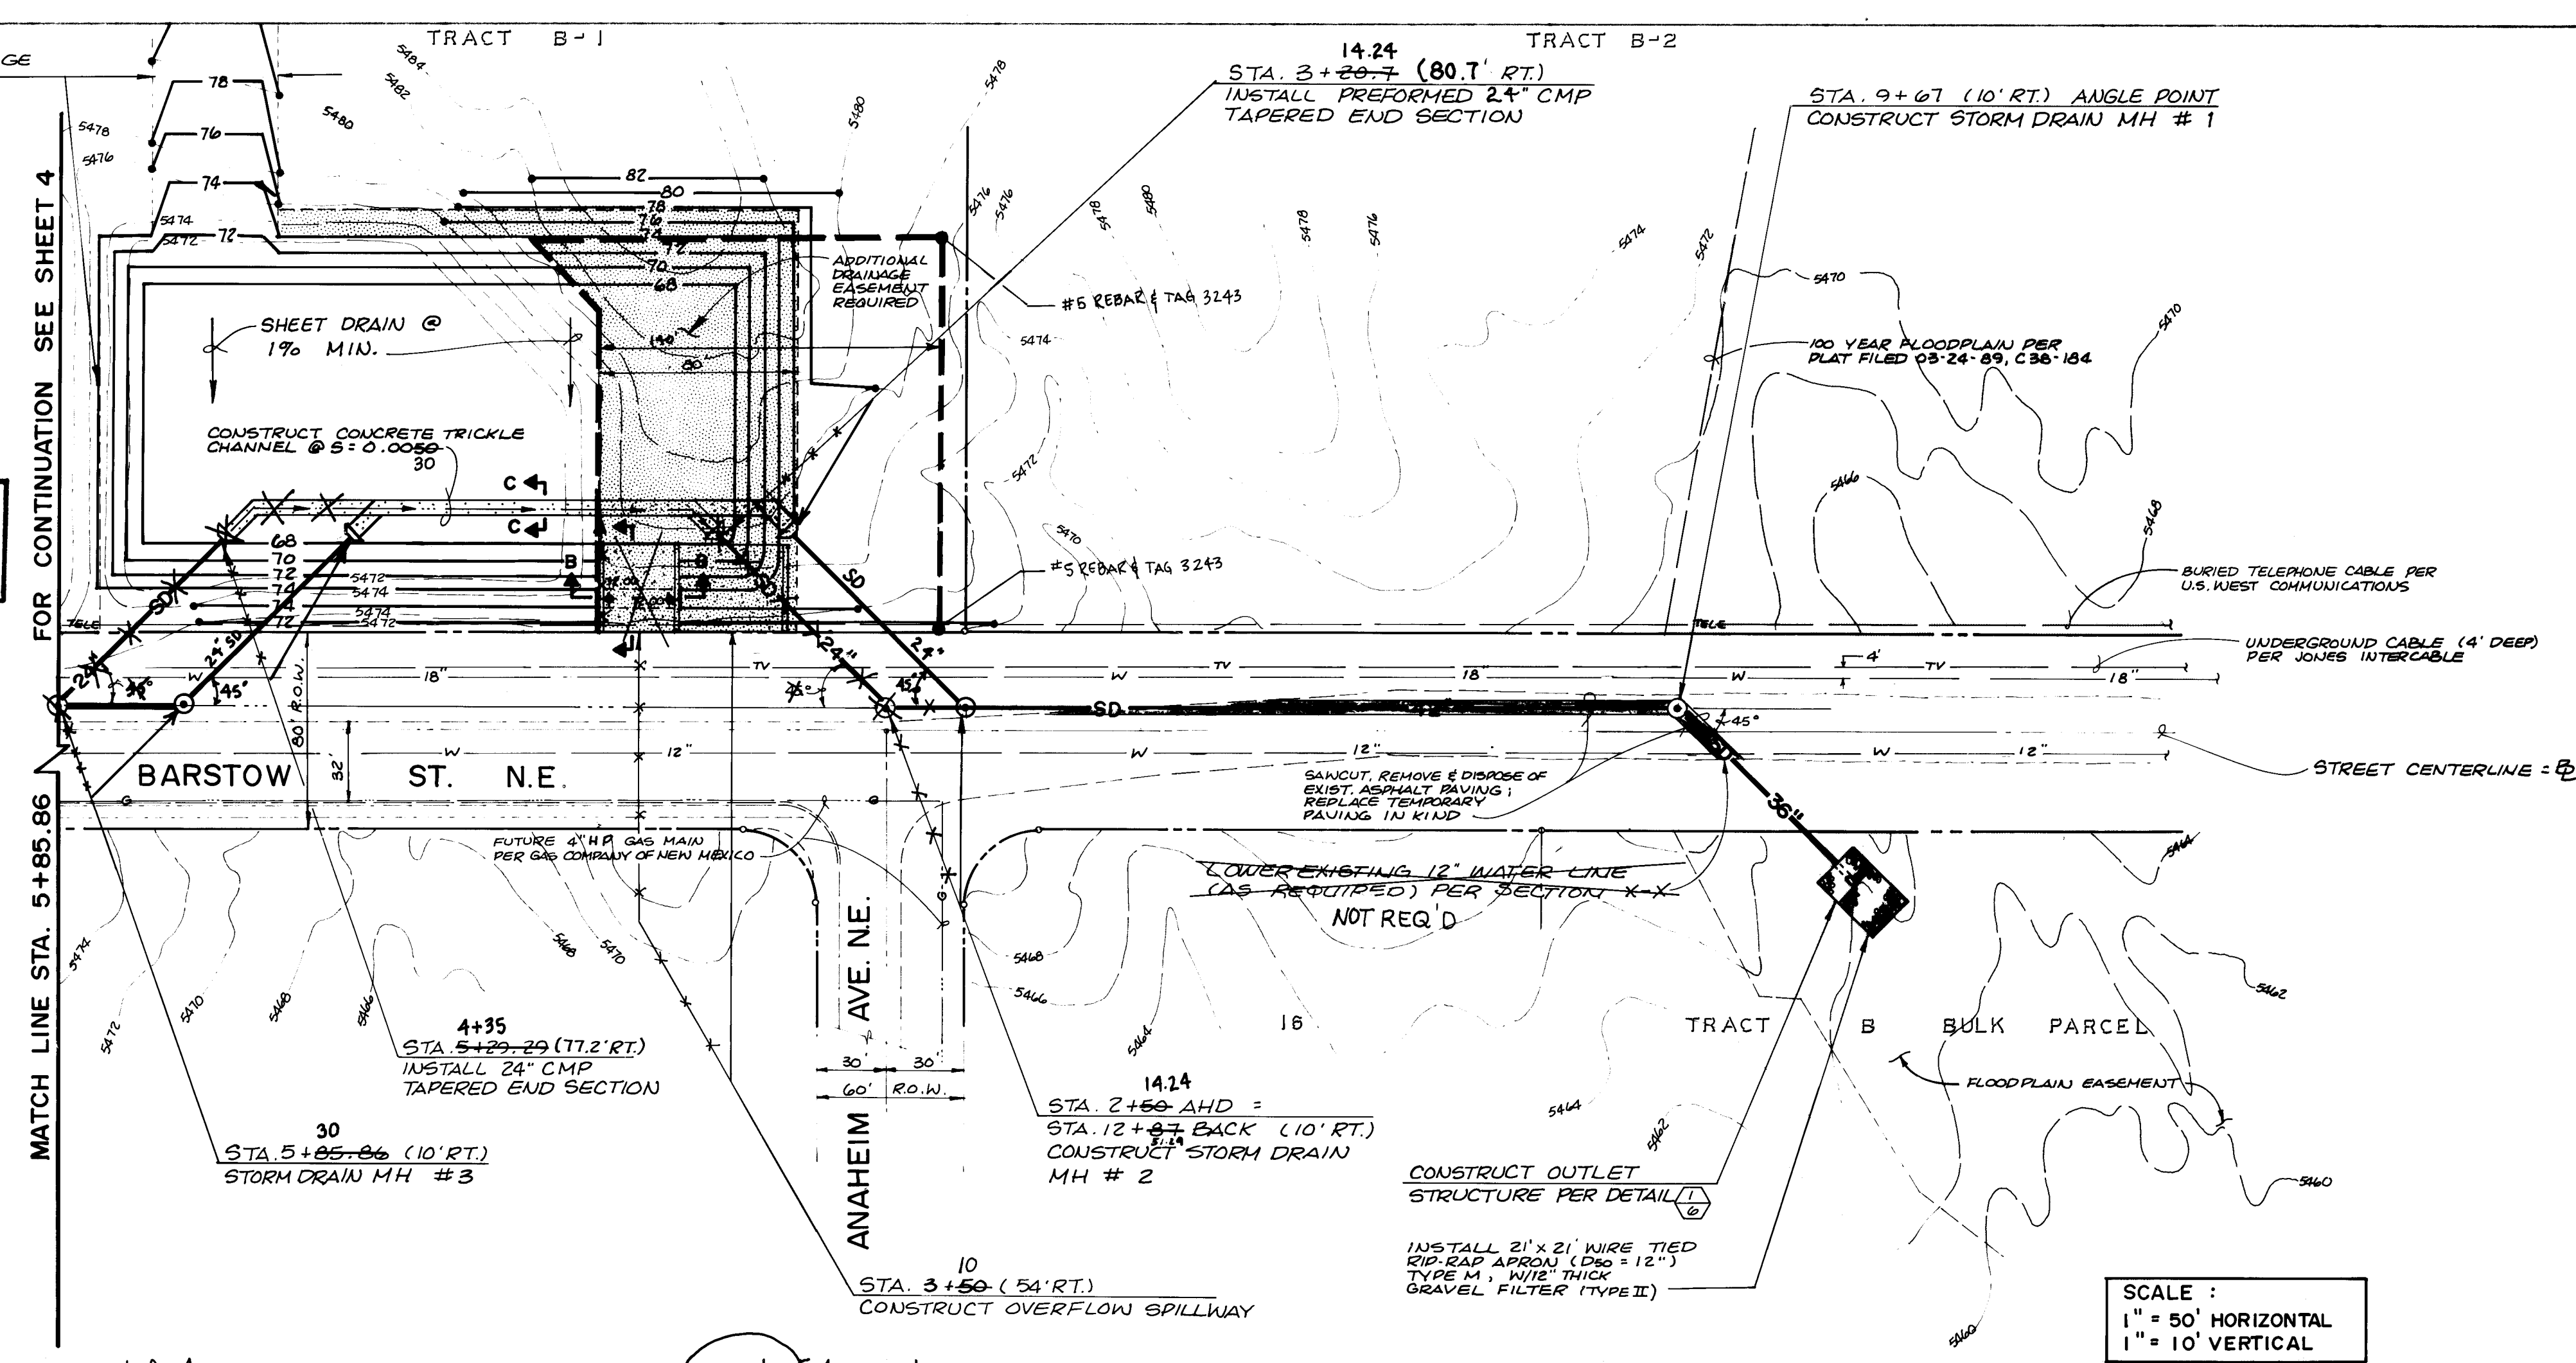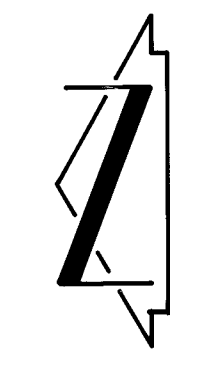

SCALE :
1" = 50' HORIZONTAL
1" = 10' VERTICAL

RECORD DRAWING

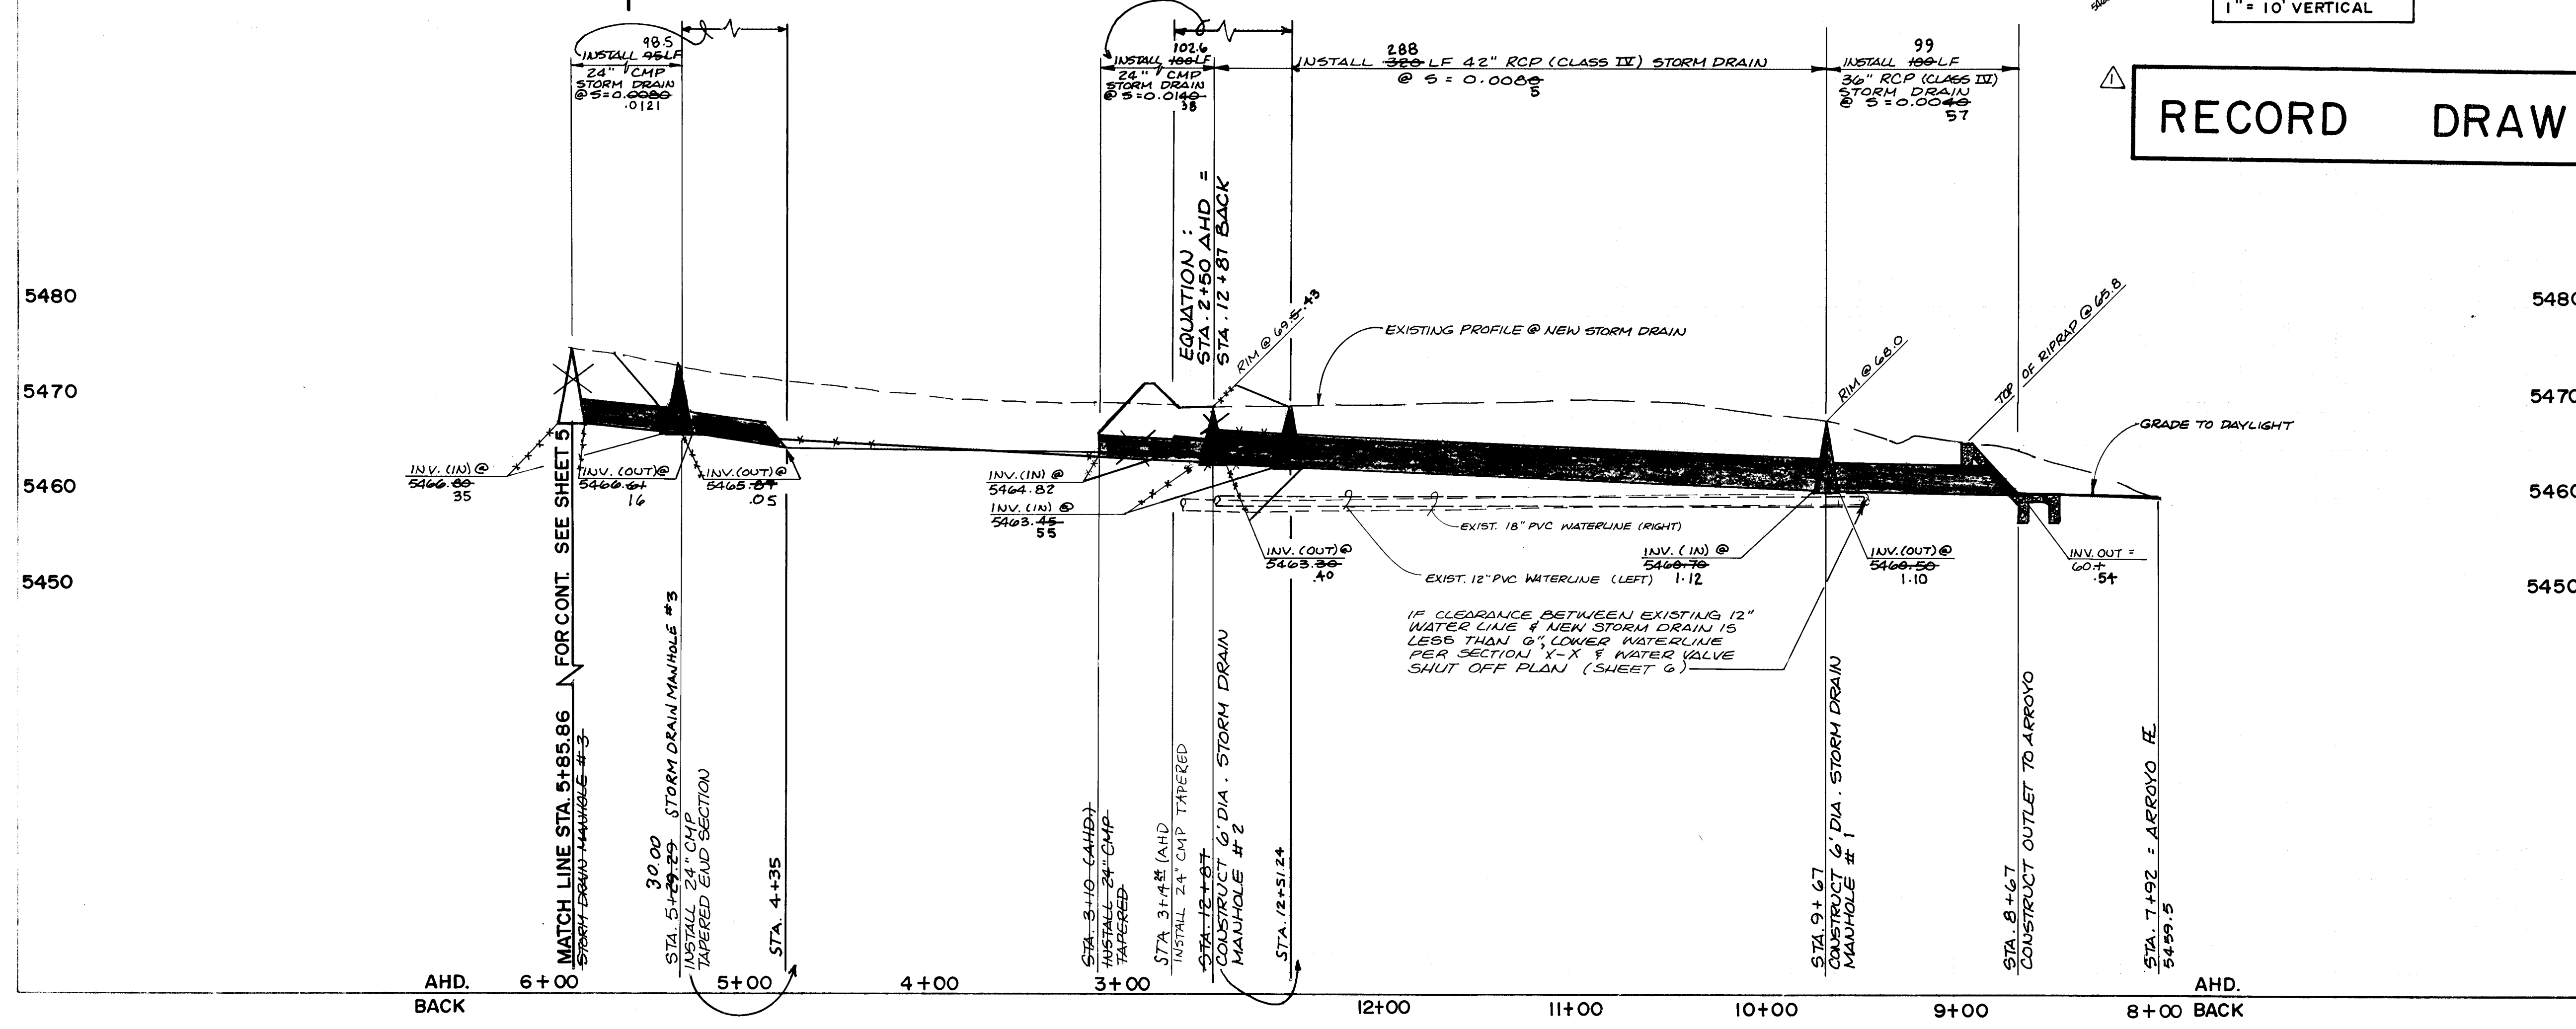


AS BUILT INFORMATION		BENCH MARKS		FIELD NOTES		REVISIONS		ENGINEER'S SEAL	
DATE	07-12-91	DATE	07-12-91	DATE	07-12-91	DATE	07-12-91	DATE	07-12-91
BY	JMA	BY	JMA	BY	JMA	BY	JMA	BY	JMA
NO	N/A	NO	N/A	NO	N/A	NO	N/A	NO	N/A
A STANDARD BRASS TABLET STAMPED "LOUISIANA LOT 32"		A STANDARD BRASS TABLET STAMPED "LOUISIANA LOT 32"		A STANDARD BRASS TABLET STAMPED "LOUISIANA LOT 32"		A STANDARD BRASS TABLET STAMPED "LOUISIANA LOT 32"		A STANDARD BRASS TABLET STAMPED "LOUISIANA LOT 32"	
BULK 10' SET IN TOP OF A CONCRETE POST FLUSH WITH THE		BULK 10' SET IN TOP OF A CONCRETE POST FLUSH WITH THE		BULK 10' SET IN TOP OF A CONCRETE POST FLUSH WITH THE		BULK 10' SET IN TOP OF A CONCRETE POST FLUSH WITH THE		BULK 10' SET IN TOP OF A CONCRETE POST FLUSH WITH THE	
GROUND & LOCATED IN THE NORTHWEST QUADRANT OF THE		GROUND & LOCATED IN THE NORTHWEST QUADRANT OF THE		GROUND & LOCATED IN THE NORTHWEST QUADRANT OF THE		GROUND & LOCATED IN THE NORTHWEST QUADRANT OF THE		GROUND & LOCATED IN THE NORTHWEST QUADRANT OF THE	
INTERSECTION OF LOUISIANA BLVD. N.E. AND LOS ANGELES		INTERSECTION OF LOUISIANA BLVD. N.E. AND LOS ANGELES		INTERSECTION OF LOUISIANA BLVD. N.E. AND LOS ANGELES		INTERSECTION OF LOUISIANA BLVD. N.E. AND LOS ANGELES		INTERSECTION OF LOUISIANA BLVD. N.E. AND LOS ANGELES	
DRAWINGS BY M.A.S.		DRAWINGS BY M.A.S.		DRAWINGS BY M.A.S.		DRAWINGS BY M.A.S.		DRAWINGS BY M.A.S.	
DATE 12/91		DATE 12/91		DATE 12/91		DATE 12/91		DATE 12/91	
A CHAINLINK FENCE AROUND THE F.A.A. AIR TRAFFIC		A CHAINLINK FENCE AROUND THE F.A.A. AIR TRAFFIC		A CHAINLINK FENCE AROUND THE F.A.A. AIR TRAFFIC		A CHAINLINK FENCE AROUND THE F.A.A. AIR TRAFFIC		A CHAINLINK FENCE AROUND THE F.A.A. AIR TRAFFIC	
CONTROL CENTER		CONTROL CENTER		CONTROL CENTER		CONTROL CENTER		CONTROL CENTER	
ELEVATION = 5318.195 FEET (M.S.L.D.)		ELEVATION = 5318.195 FEET (M.S.L.D.)		ELEVATION = 5318.195 FEET (M.S.L.D.)		ELEVATION = 5318.195 FEET (M.S.L.D.)		ELEVATION = 5318.195 FEET (M.S.L.D.)	

CITY OF ALBUQUERQUE
PUBLIC WORKS DEPARTMENT
ENGINEERING GROUP


TITLE: VINEYARD ESTATES DETENTION POND 8
BARSTOW STREET STORM DRAIN
STA. 7+92 (BACK) TO STA. 5+85.86 (AHD.)

APPROVALS	ENGINEER	DATE	APPROVALS	ENGINEER	DATE
DRG. CHAIRMAN	Paul H. Hume	10-10-91	WATER	W. Hume	7-18-91
TRANSPORTATION	Paul H. Hume	8-08-91	WASTE WATER	W. Hume	7-18-91
HYDROLOGY	Paul H. Hume	8-08-91	AMAFCA	W. Hume	7-18-91

PROJECT NO. 3391.91 MAP NO. C-20 SHEET 3 OF 6

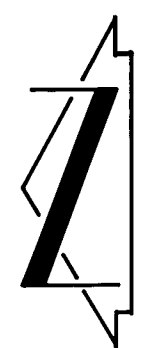


RECORD DRAWING

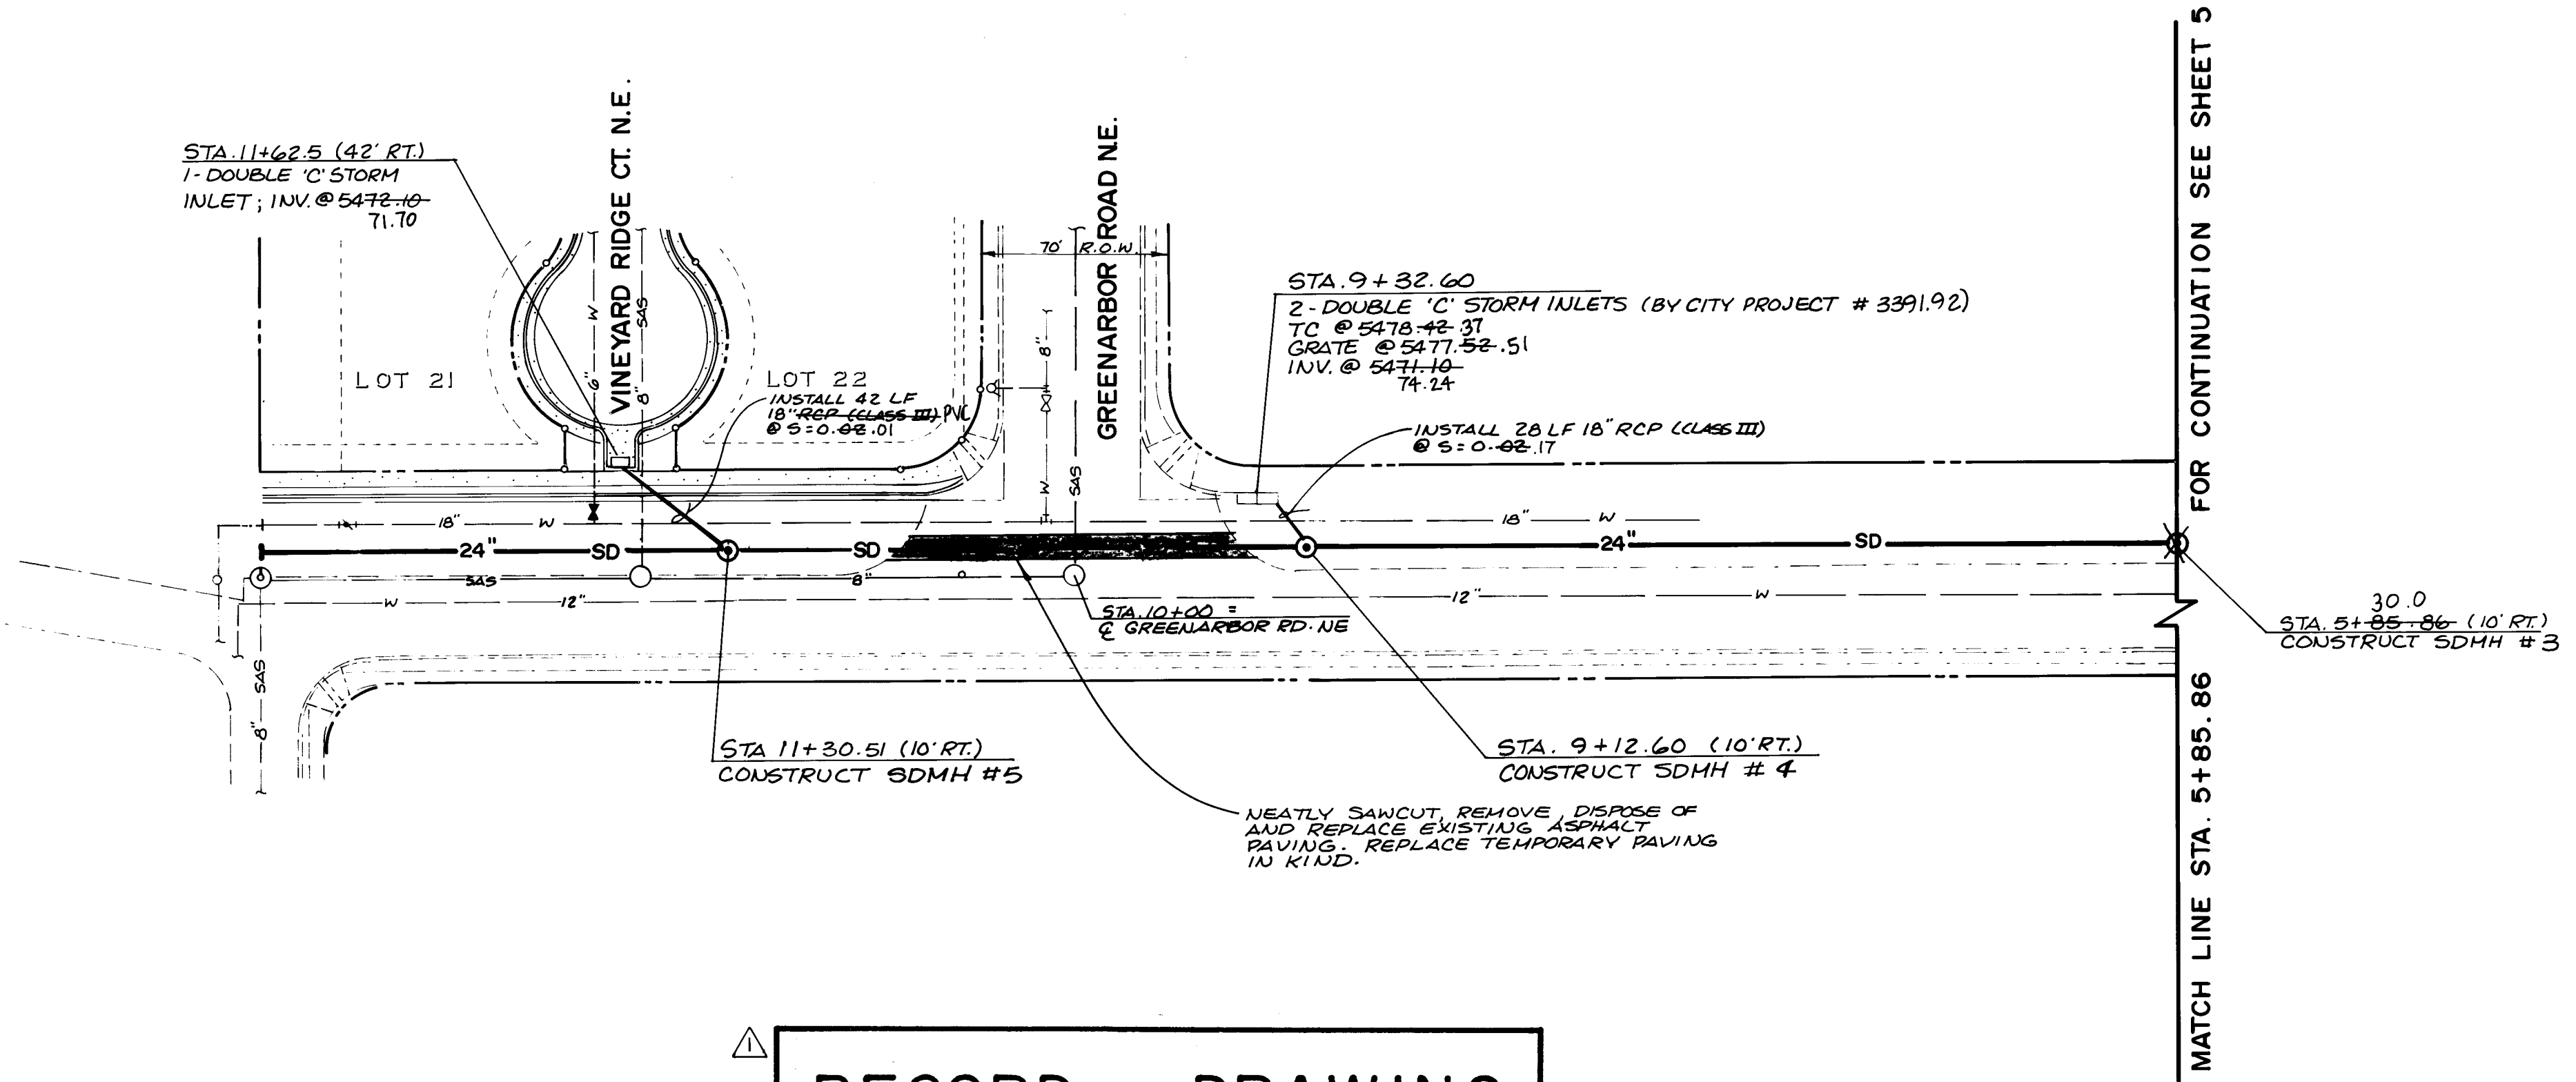

RECORD DRAWING

BARSTOW STREET N.E.

SCALE :
1" = 50' HORIZONTAL
1" = 10' VERTICAL

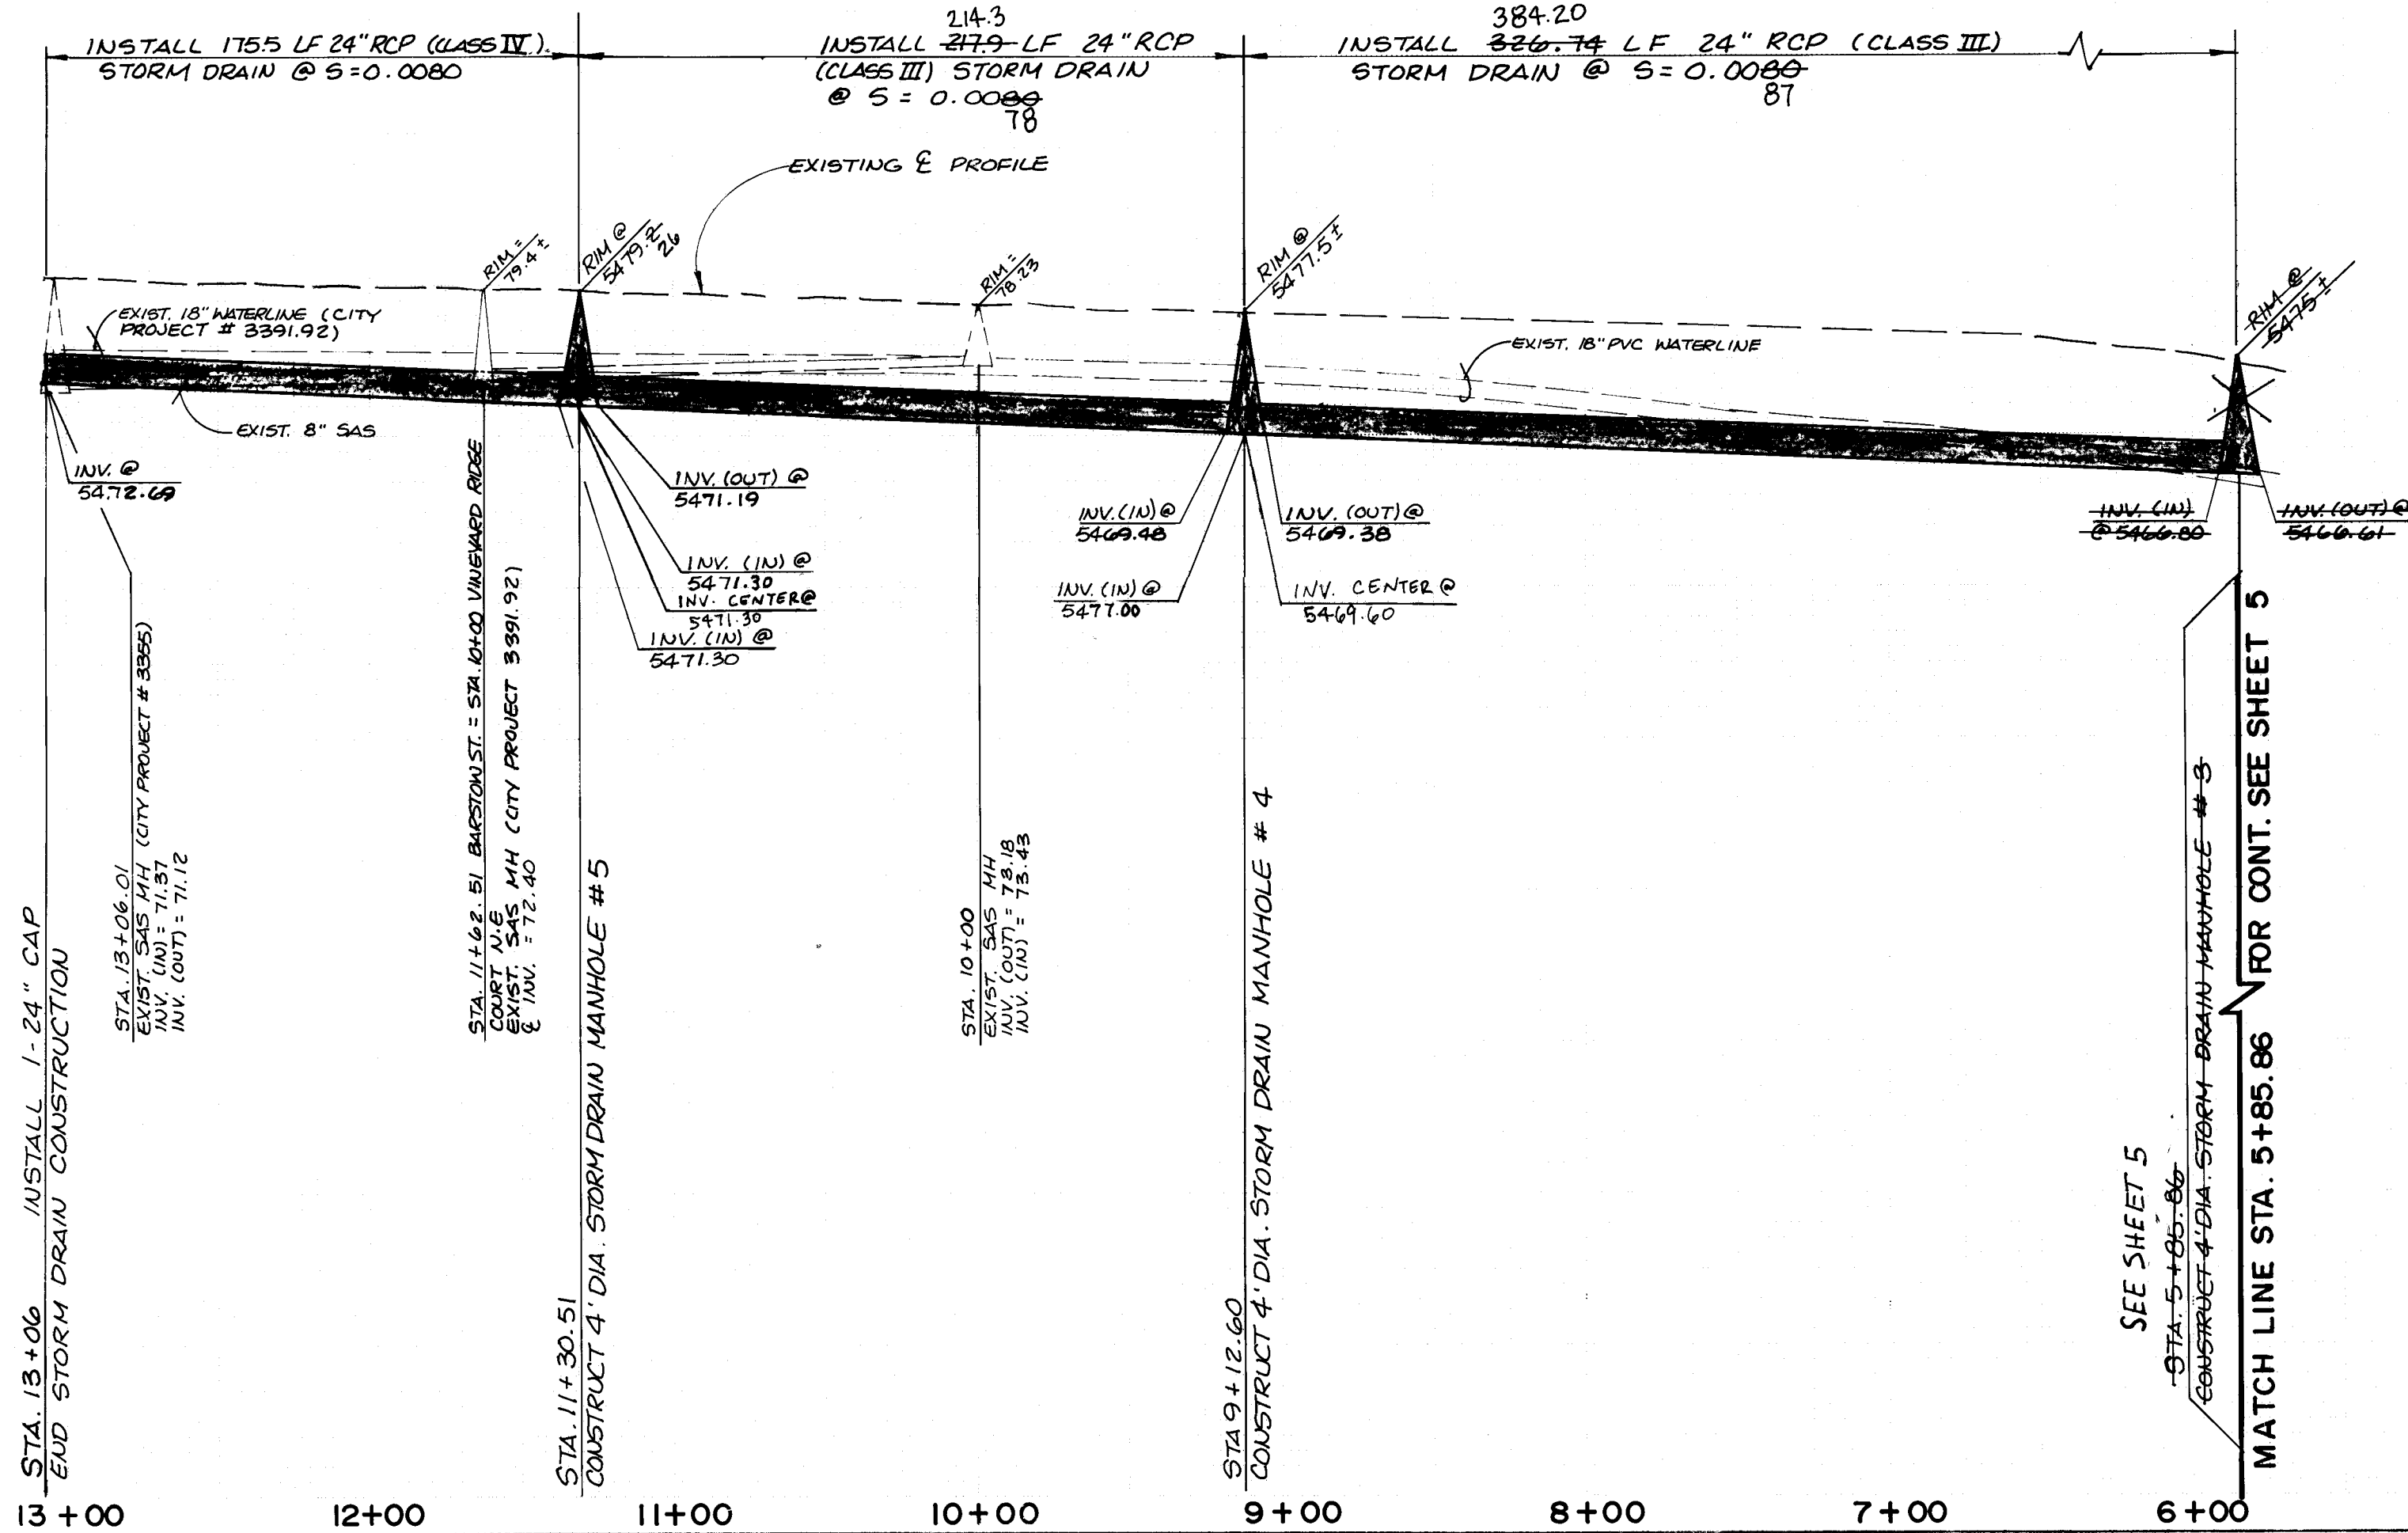

RECORD DRAWING

I, Jeffrey G. Mortensen, Registered Professional Engineer in the State of New Mexico, do hereby certify that this "as-built" information was obtained by me or under my supervision and represents the "as-built" conditions of this project, and is true and correct to the best of my knowledge and belief. All vertical and horizontal dimensions should be field verified prior to use on future projects.

Jeffrey G. Mortensen
Professional Engineer
New Mexico
8547
01-09-92
Date

26 33.91 1991 01 09 12

CITY OF ALBUQUERQUE PUBLIC WORKS DEPARTMENT ENGINEERING GROUP									
TITLE: VINEYARD ESTATES DETENTION POND & BARSTOW STREET STORM DRAIN STA. 5+85.36 TO STA. 13+06									
APPROVAL	ENGINEER	DATE	APPROVAL	DATE	APPROVAL	DATE	APPROVAL	DATE	APPROVAL
D.R.C. Chairman	Robert Rhee	10-10-91	Water		Millen	9-18-91			
Transportation	Robert Rhee	8-08-91	Waste Water						
Hydrology	Robert Rhee	8-08-91	AMAFCA		C. J. Rhee	11-11-91			
PROJECT NO. 3391.91		MAP NO. C-20		SHEET 4		OF 6			

SURVEY INFORMATION		BENCH MARKS		AS BUILT INFORMATION	
NO.	DATE	FILE	DATE	FILE	DATE
1	01-12-91	JMA	01-12-91	JMA	01-12-91
2	01-12-91	JMA	01-12-91	JMA	01-12-91
3	01-12-91	JMA	01-12-91	JMA	01-12-91
ENGINEER'S SEAL		REVISIONS		DATE	
NO.	DATE	BY	DATE	DATE	DATE
1	07-18-91	JMA	07-18-91	07-18-91	07-18-91
2	07-18-91	JMA	07-18-91	07-18-91	07-18-91
3	07-18-91	JMA	07-18-91	07-18-91	07-18-91
RECORD DRAWING

PROJECT NO.	3391.91	MAP NO.	C- 20	SHEET	OF	5	6
-------------	---------	---------	-------	-------	----	---	---

[illegible]

②

⚠ RECORD DRAWING






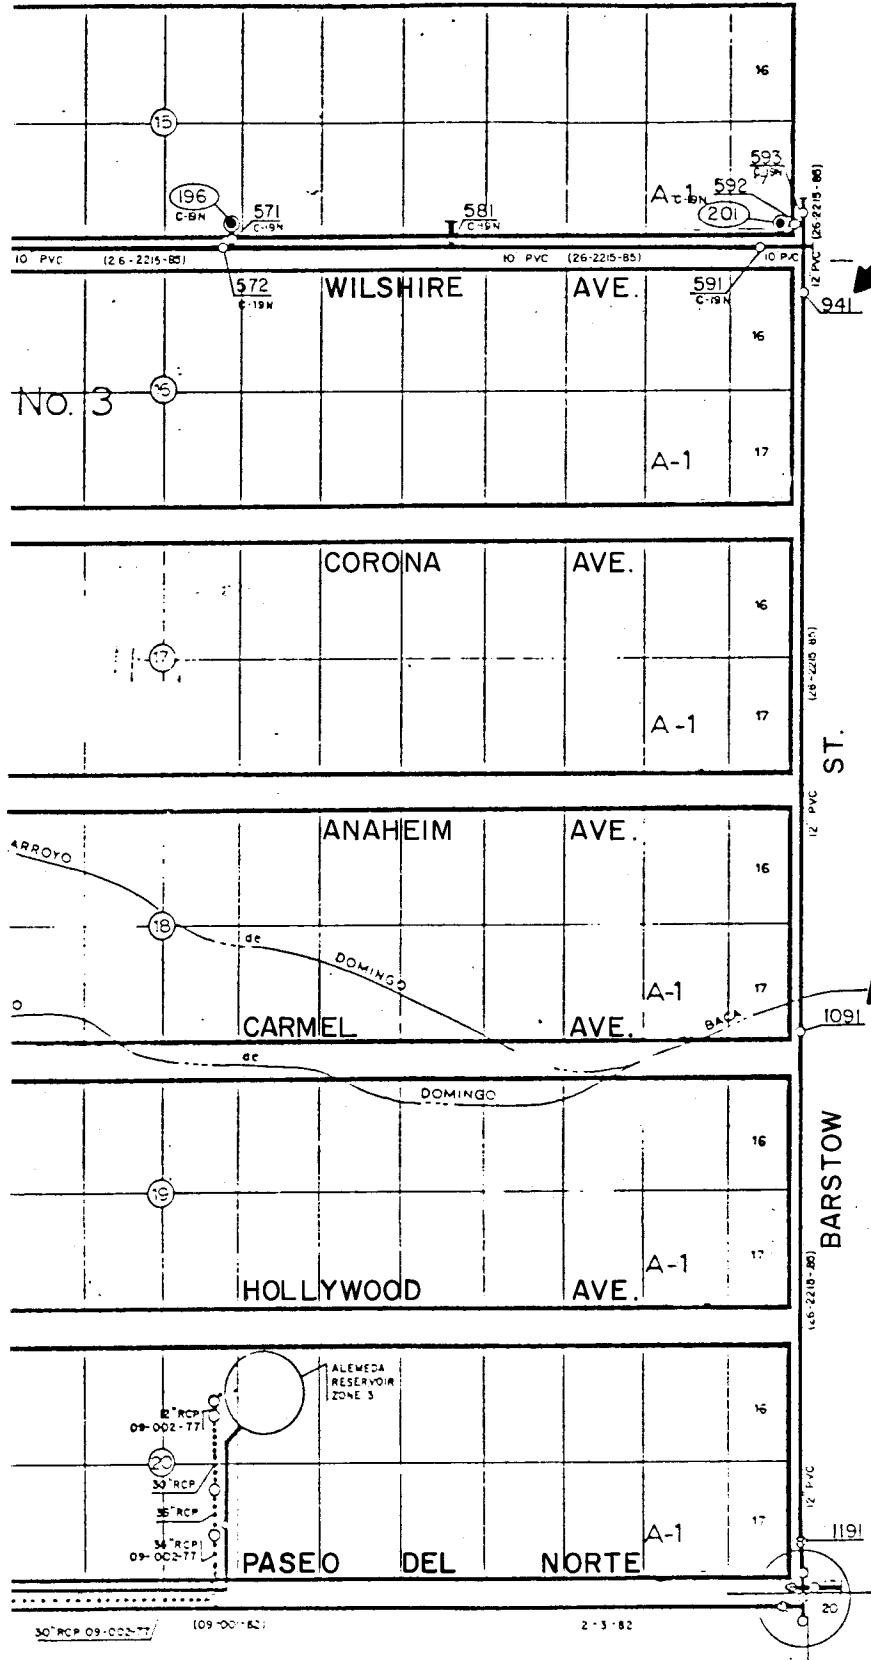


WATER VALVE SHUTOFF PLAN NOTES:

1. AS A MINIMUM, THE FOLLOWING VALVES SHALL BE CLOSED TO EFFECT THE WATERLINE LOWERING (SECTION X-X):
941 AND 1091
2. THE CONTRACTOR SHALL NOTIFY WATER SYSTEMS, THREE (3) WORKING DAYS IN ADVANCE OF ANY WORK THAT MAY AFFECT EXISTING WATERLINE; ALL SHUTOFFS SHALL BE PERFORMED BY THE WATER SYSTEM DIVISION PERSONNEL (857-8200).
3. THE CONTRACTOR SHALL PROVIDE ALL RESTRAINTS AND THRUST BLOCKS NECESSARY TO EFFECT THE NECESSARY SHUTOFFS AND CONNECTIONS.
4. EXISTING WATER VALVE AND WATERLINE INFORMATION OBTAINED FROM CITY OF ALBUQUERQUE WATER DISTRIBUTION SYSTEM SECTIONAL MAPS, MAP C19S.

VALVE SHUTOFF PLAN

SCALE: 1" = 400' ±

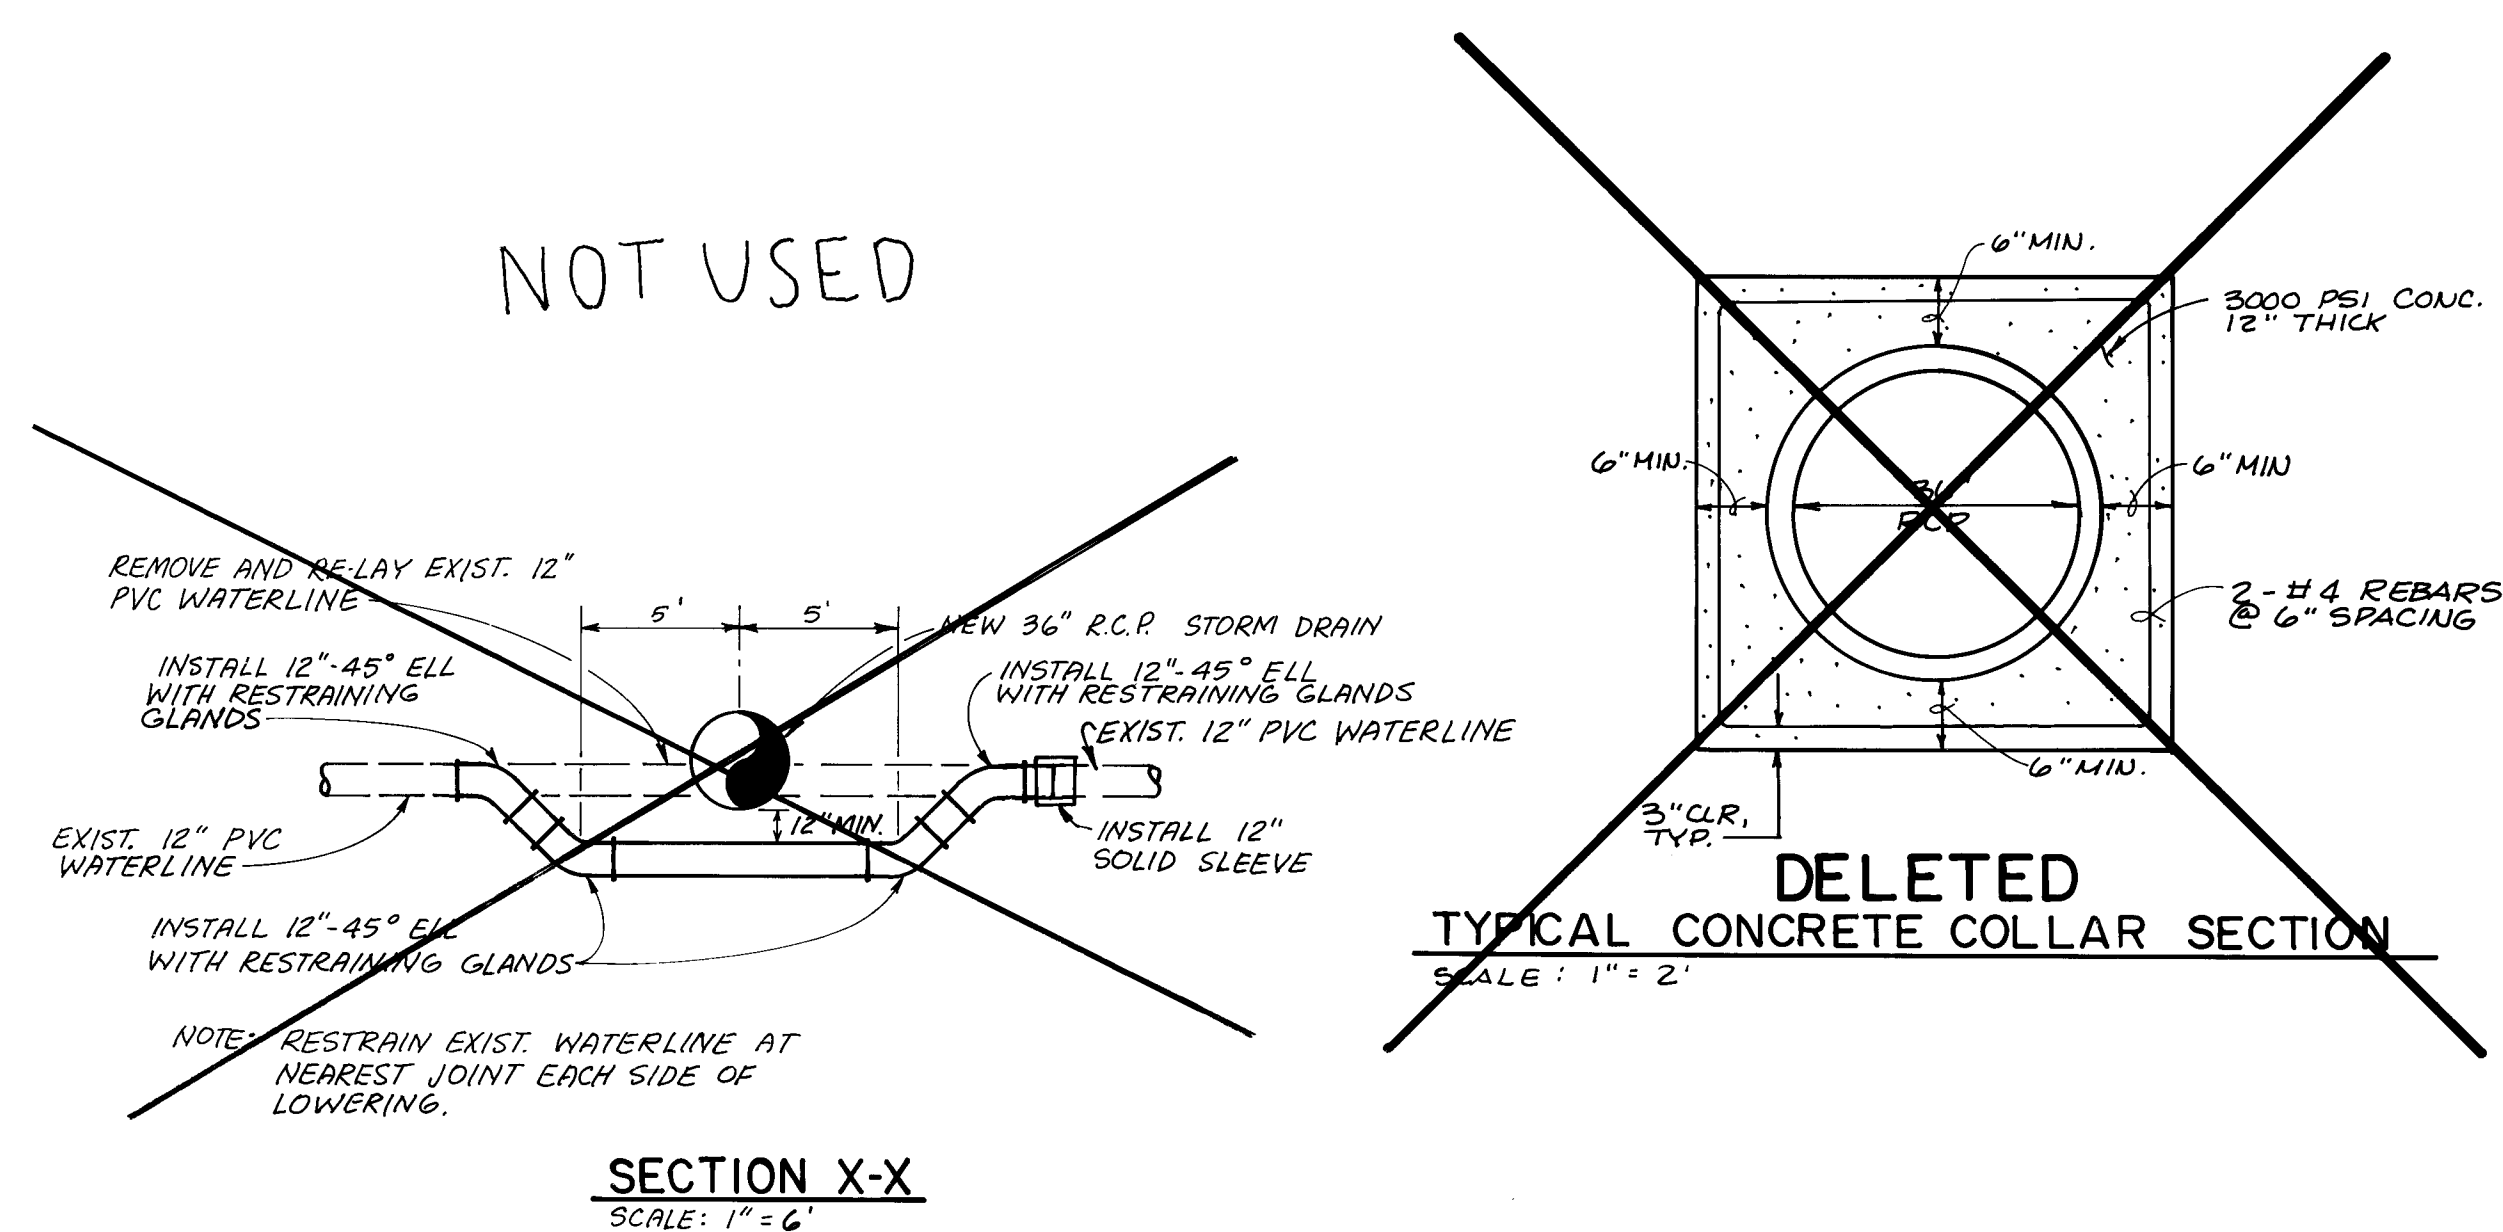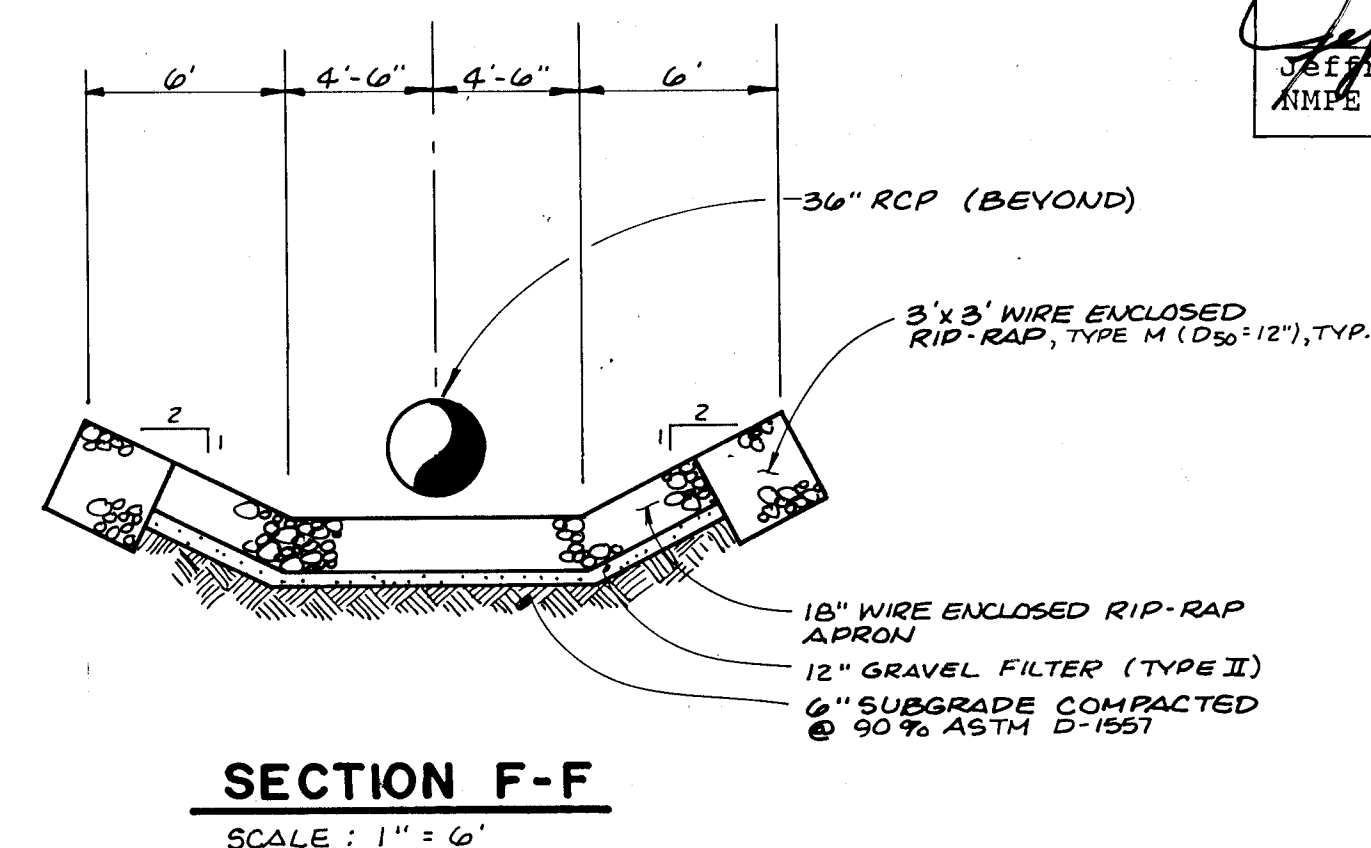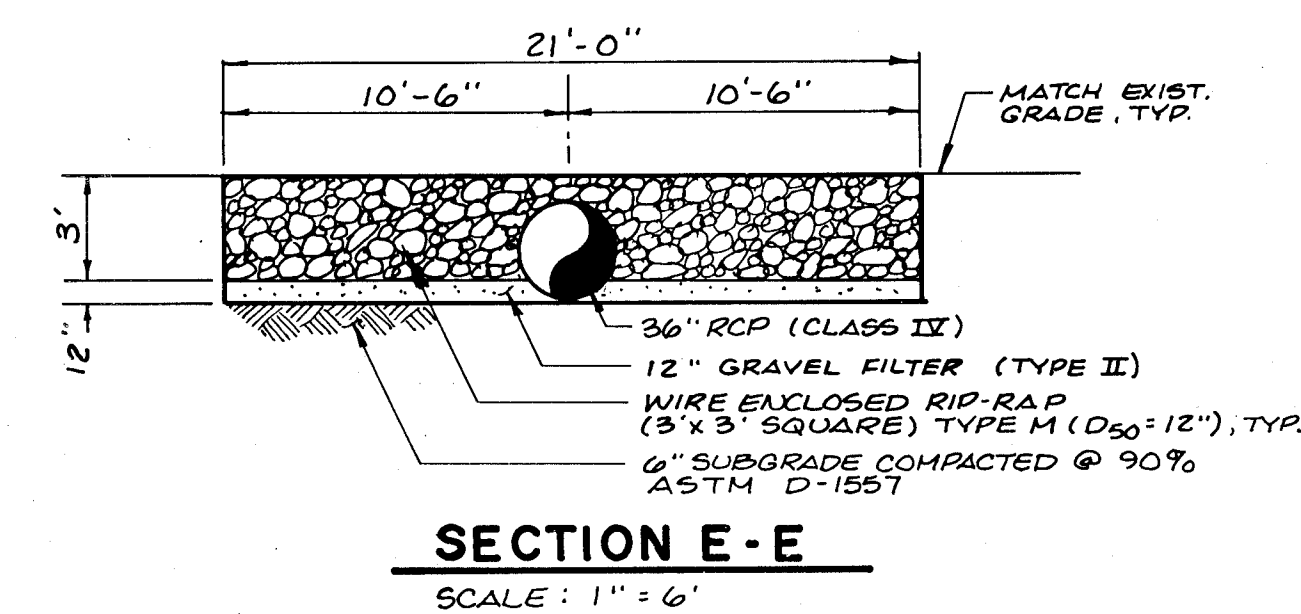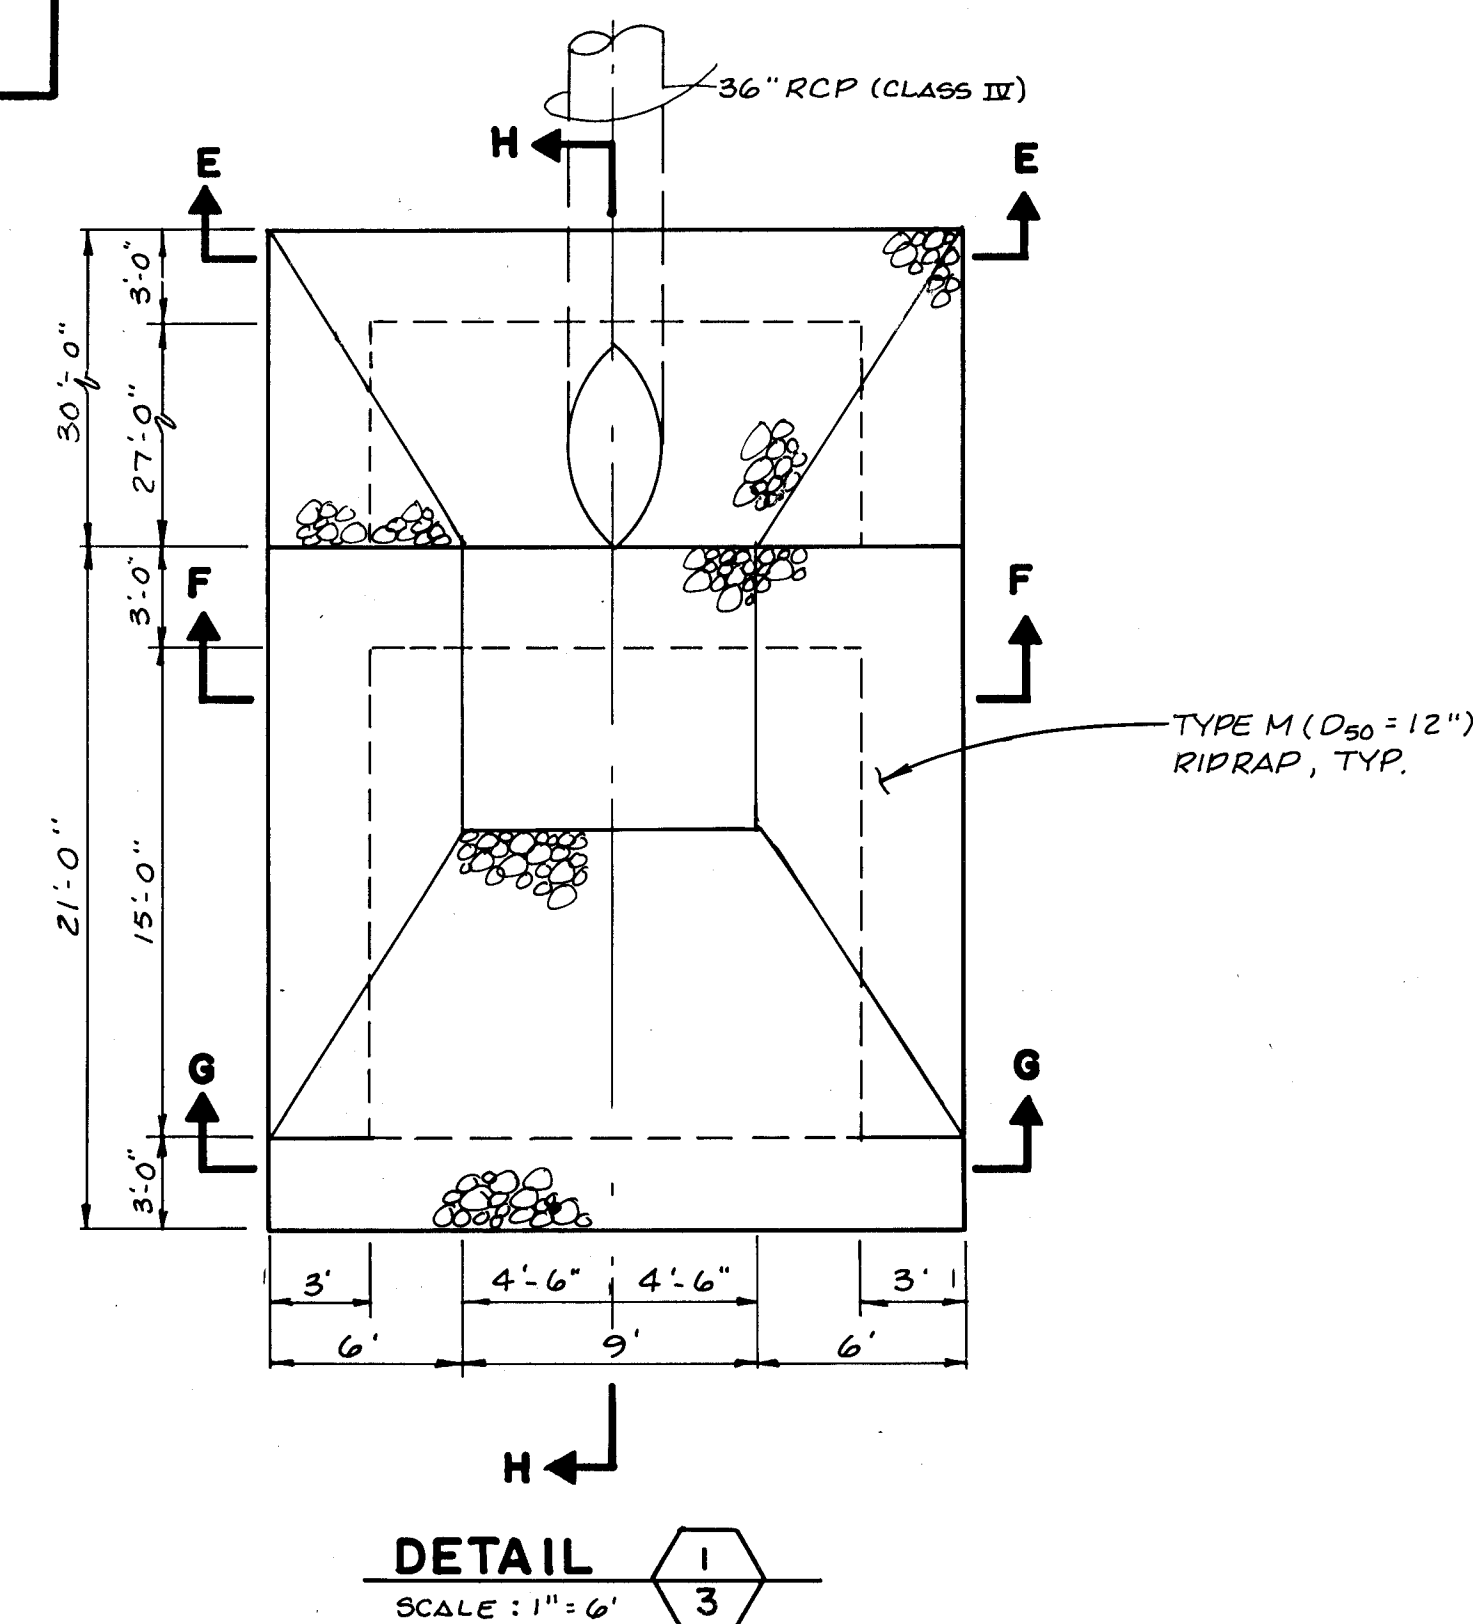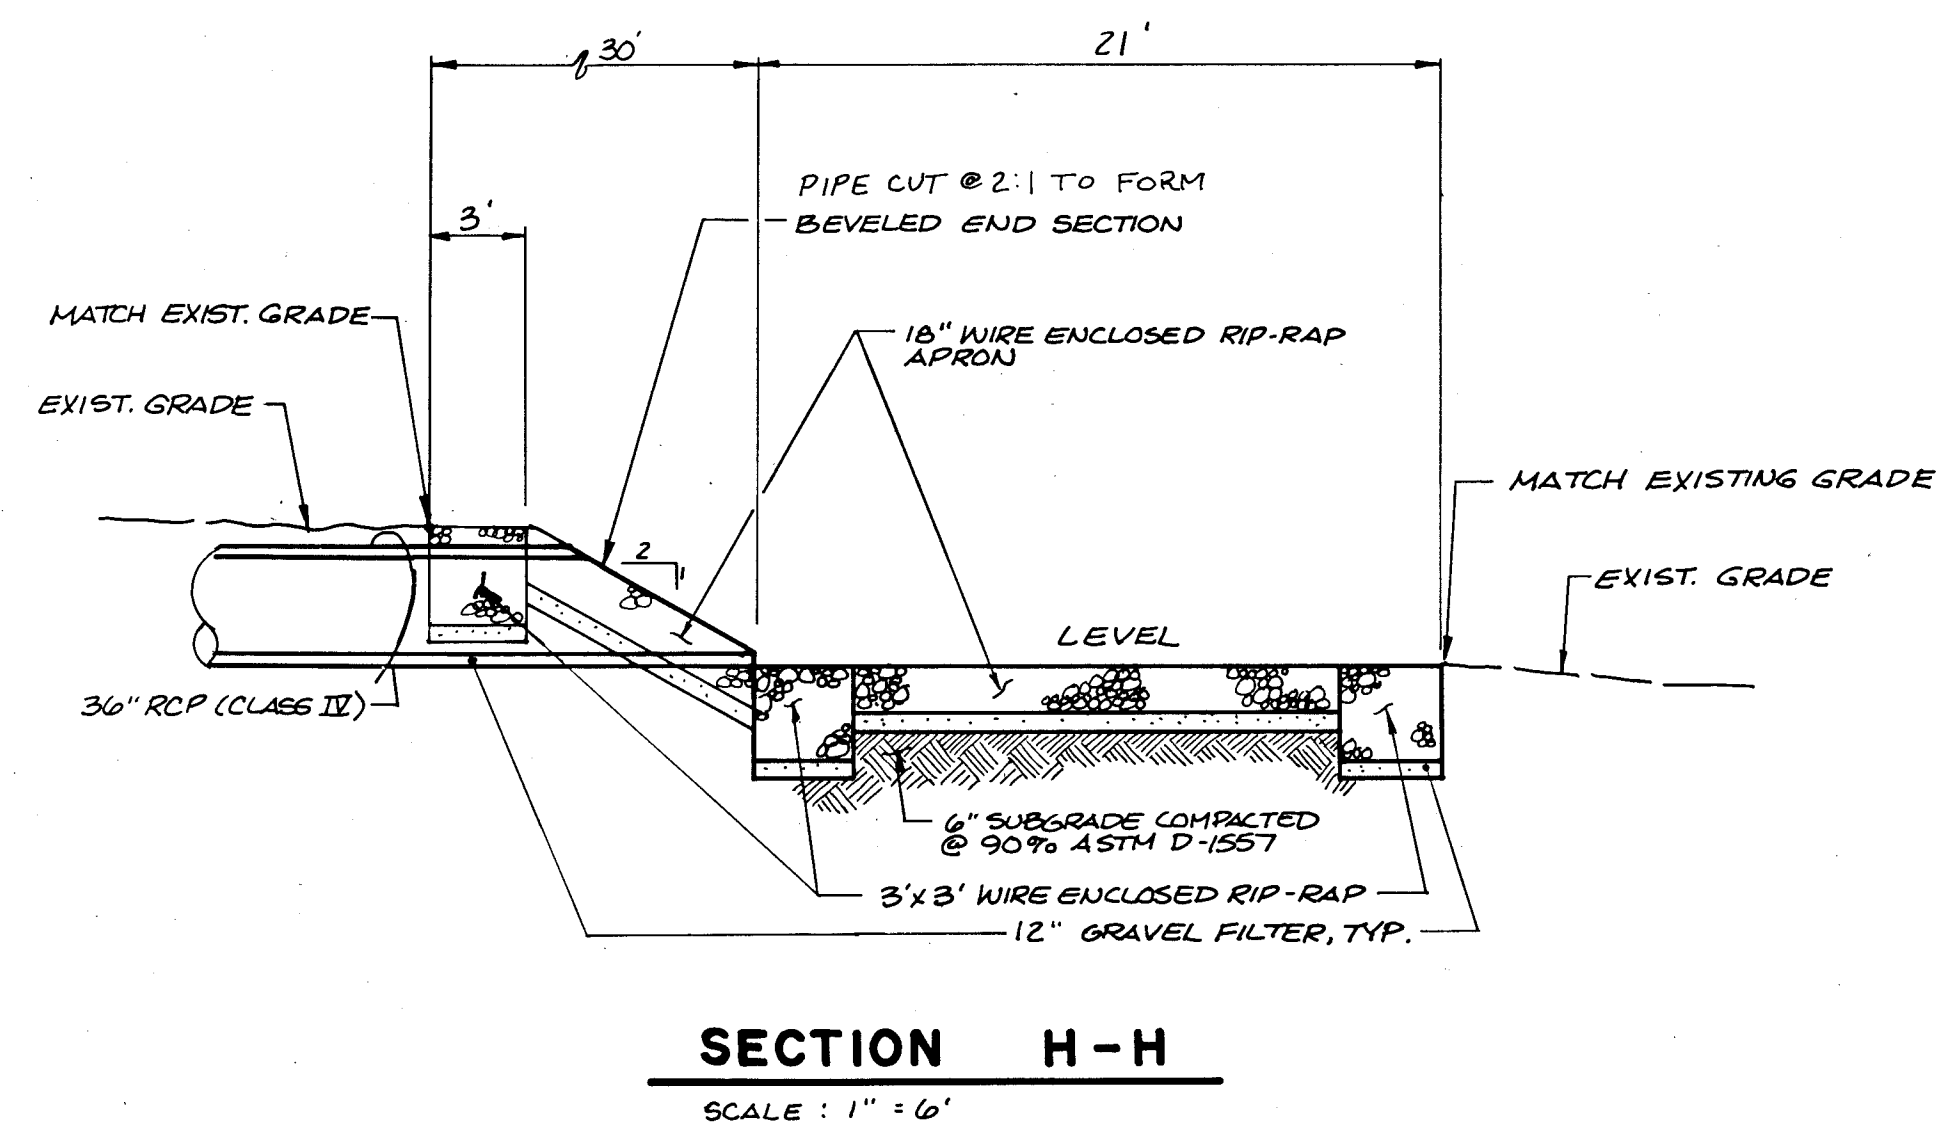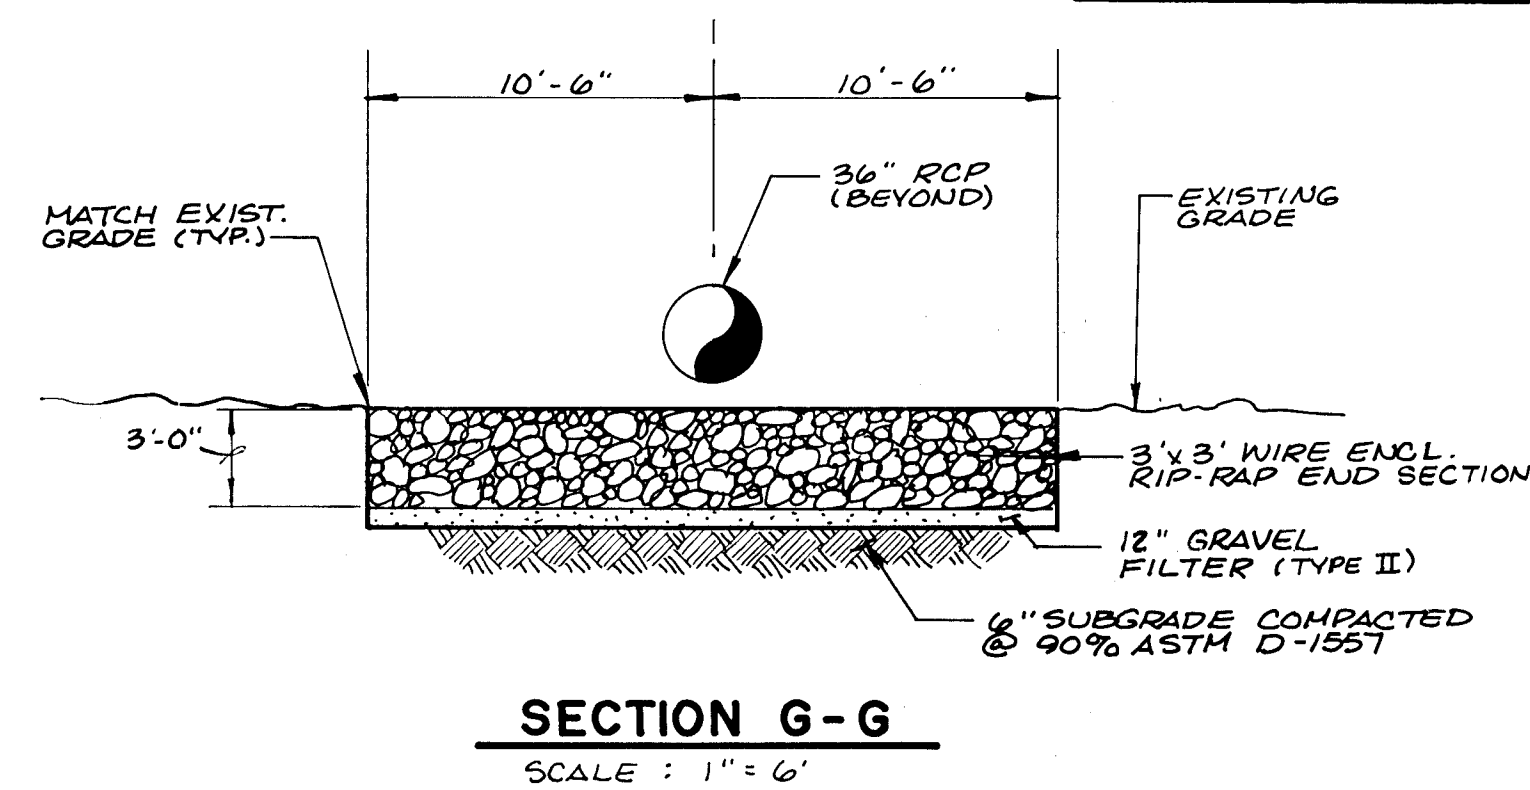

U. S. Standard Sieve Size	Percent Weight By Passing Type I	Square Mesh Sieves Type II
3"	-	90 - 100
1-1/2"	-	-
3/4"	-	20 - 90
3/8"	100	-
#4	95 - 100	0 - 20
#16	45 - 80	-
#50	10 - 30	-
#100	2 - 10	-
#200	0 - 2	0 - 3

Δ	12/91	AS-BUILT	M&S	ENGINEER'S SEAL	SURVEY INFORMATION	BENCH MARKS	AS BUILT INFORMATION
					FIELD NOTES	A STANDARD BRASS TABLET STAMPED "I-CIP U.S.A. LOT 32 BLK 10" SET IN TOP OF A CONC. PIST FLUSH W/ THE GROUND & LOCATED IN THE NORTHEAST QUADRANT OF THE INTERSECTION OF LOUISIANA BLVD N.E. & LOS ANGELES DR N.E. 50' NORTH OF THE NORTHWEST CORNER OF A CHALKLINE ENKEE AROUND THE F.A.A. AIR TRAFFIC CONTROL CENTER.	CONTRACTOR CCM
			NO.		DATE	WORK STARTED BY JMA	DATE 10/91
			N/A		JMA	INSPECTORS FIELD VERIFICATION BY M&S	DATE 12/91
		REMARKS	BY			CORRECTION BY M&S	DATE 12/91
		REVISONS				CORRECTED BY M&S	DATE 12/91
		DESIGN				MICRO-FILM INFORMATION	
		DESIGNED BY J.G.M.	DATE 07-91		RECORDED BY NO	DATE	
		DRAWN BY S.G.H.	DATE 07-91			ELEVATION = 5310.195 FEET (M.S.L.D.)	
		CHECKED BY J.G.M.	DATE 07-91				

07-18-91

RECORD DRAWING

I, Jeffrey G. Mortensen, Registered Professional Engineer in the State of New Mexico, do hereby certify that this "as-built" information was obtained by me or under my supervision and represents the "as-built" conditions of this project, and is true and correct to the best of my knowledge and belief. All vertical and horizontal dimensions should be carefully verified prior to use on future projects.


 01-09-92
 Date

26 3391.910692

CITY OF ALBUQUERQUE PUBLIC WORKS DEPARTMENT ENGINEERING GROUP	
TITLE:	VINEYARD ESTATES DETENTION POND & BARSTOW STREET STORM DRAIN OUTLET STRUCTURE SECTIONS AND DETAILS, WATERLINE LOWERING SECTION / VALVE SHUTOFF PLAN

WATERLINE LOWERING SECTION / VALVE SHUTOFF PLAN						
APPROVALS		ENGINEER	DATE	APPROVALS	ENGINEER	DATE
DRC Chairman	<i>Roger L. Jones</i>		10-10-91	Water	<i>M. Olsen</i>	9-18-91
Transportation	<i>R. L. Jones</i>		8-08-91	Waste Water	<i>M. Olsen</i>	"
Hydrology	<i>G. L. Jones</i>		8-08-91	AMAFCA	<i>C. L. Jones</i>	10/11/91

DRAWING NO.	3391.91	MAP NO.	C - 20	SHEET	6	OF	6
-------------	---------	---------	--------	-------	---	----	---