
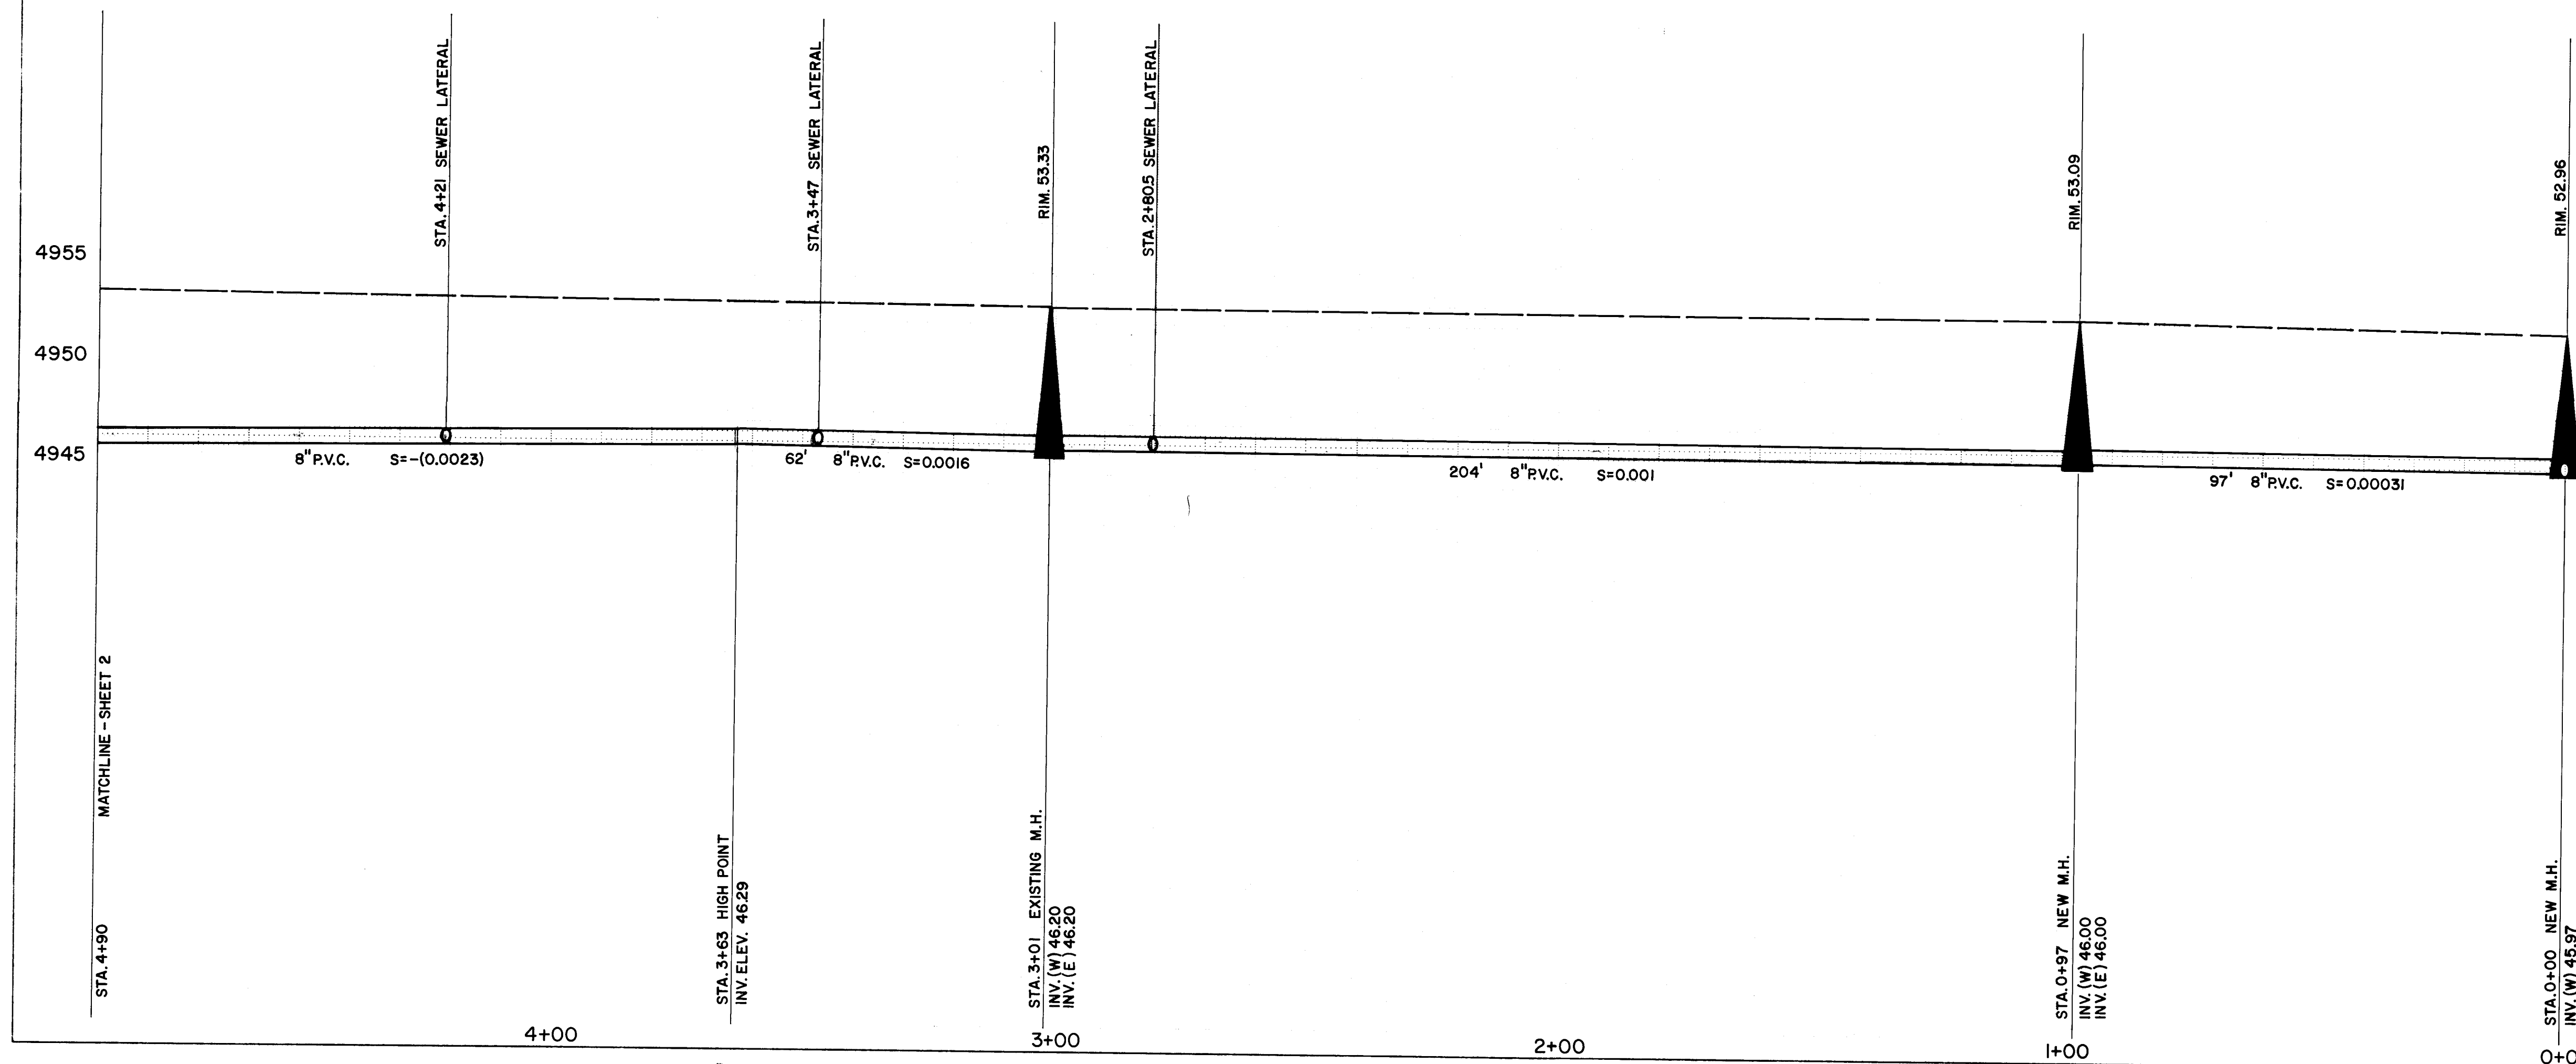


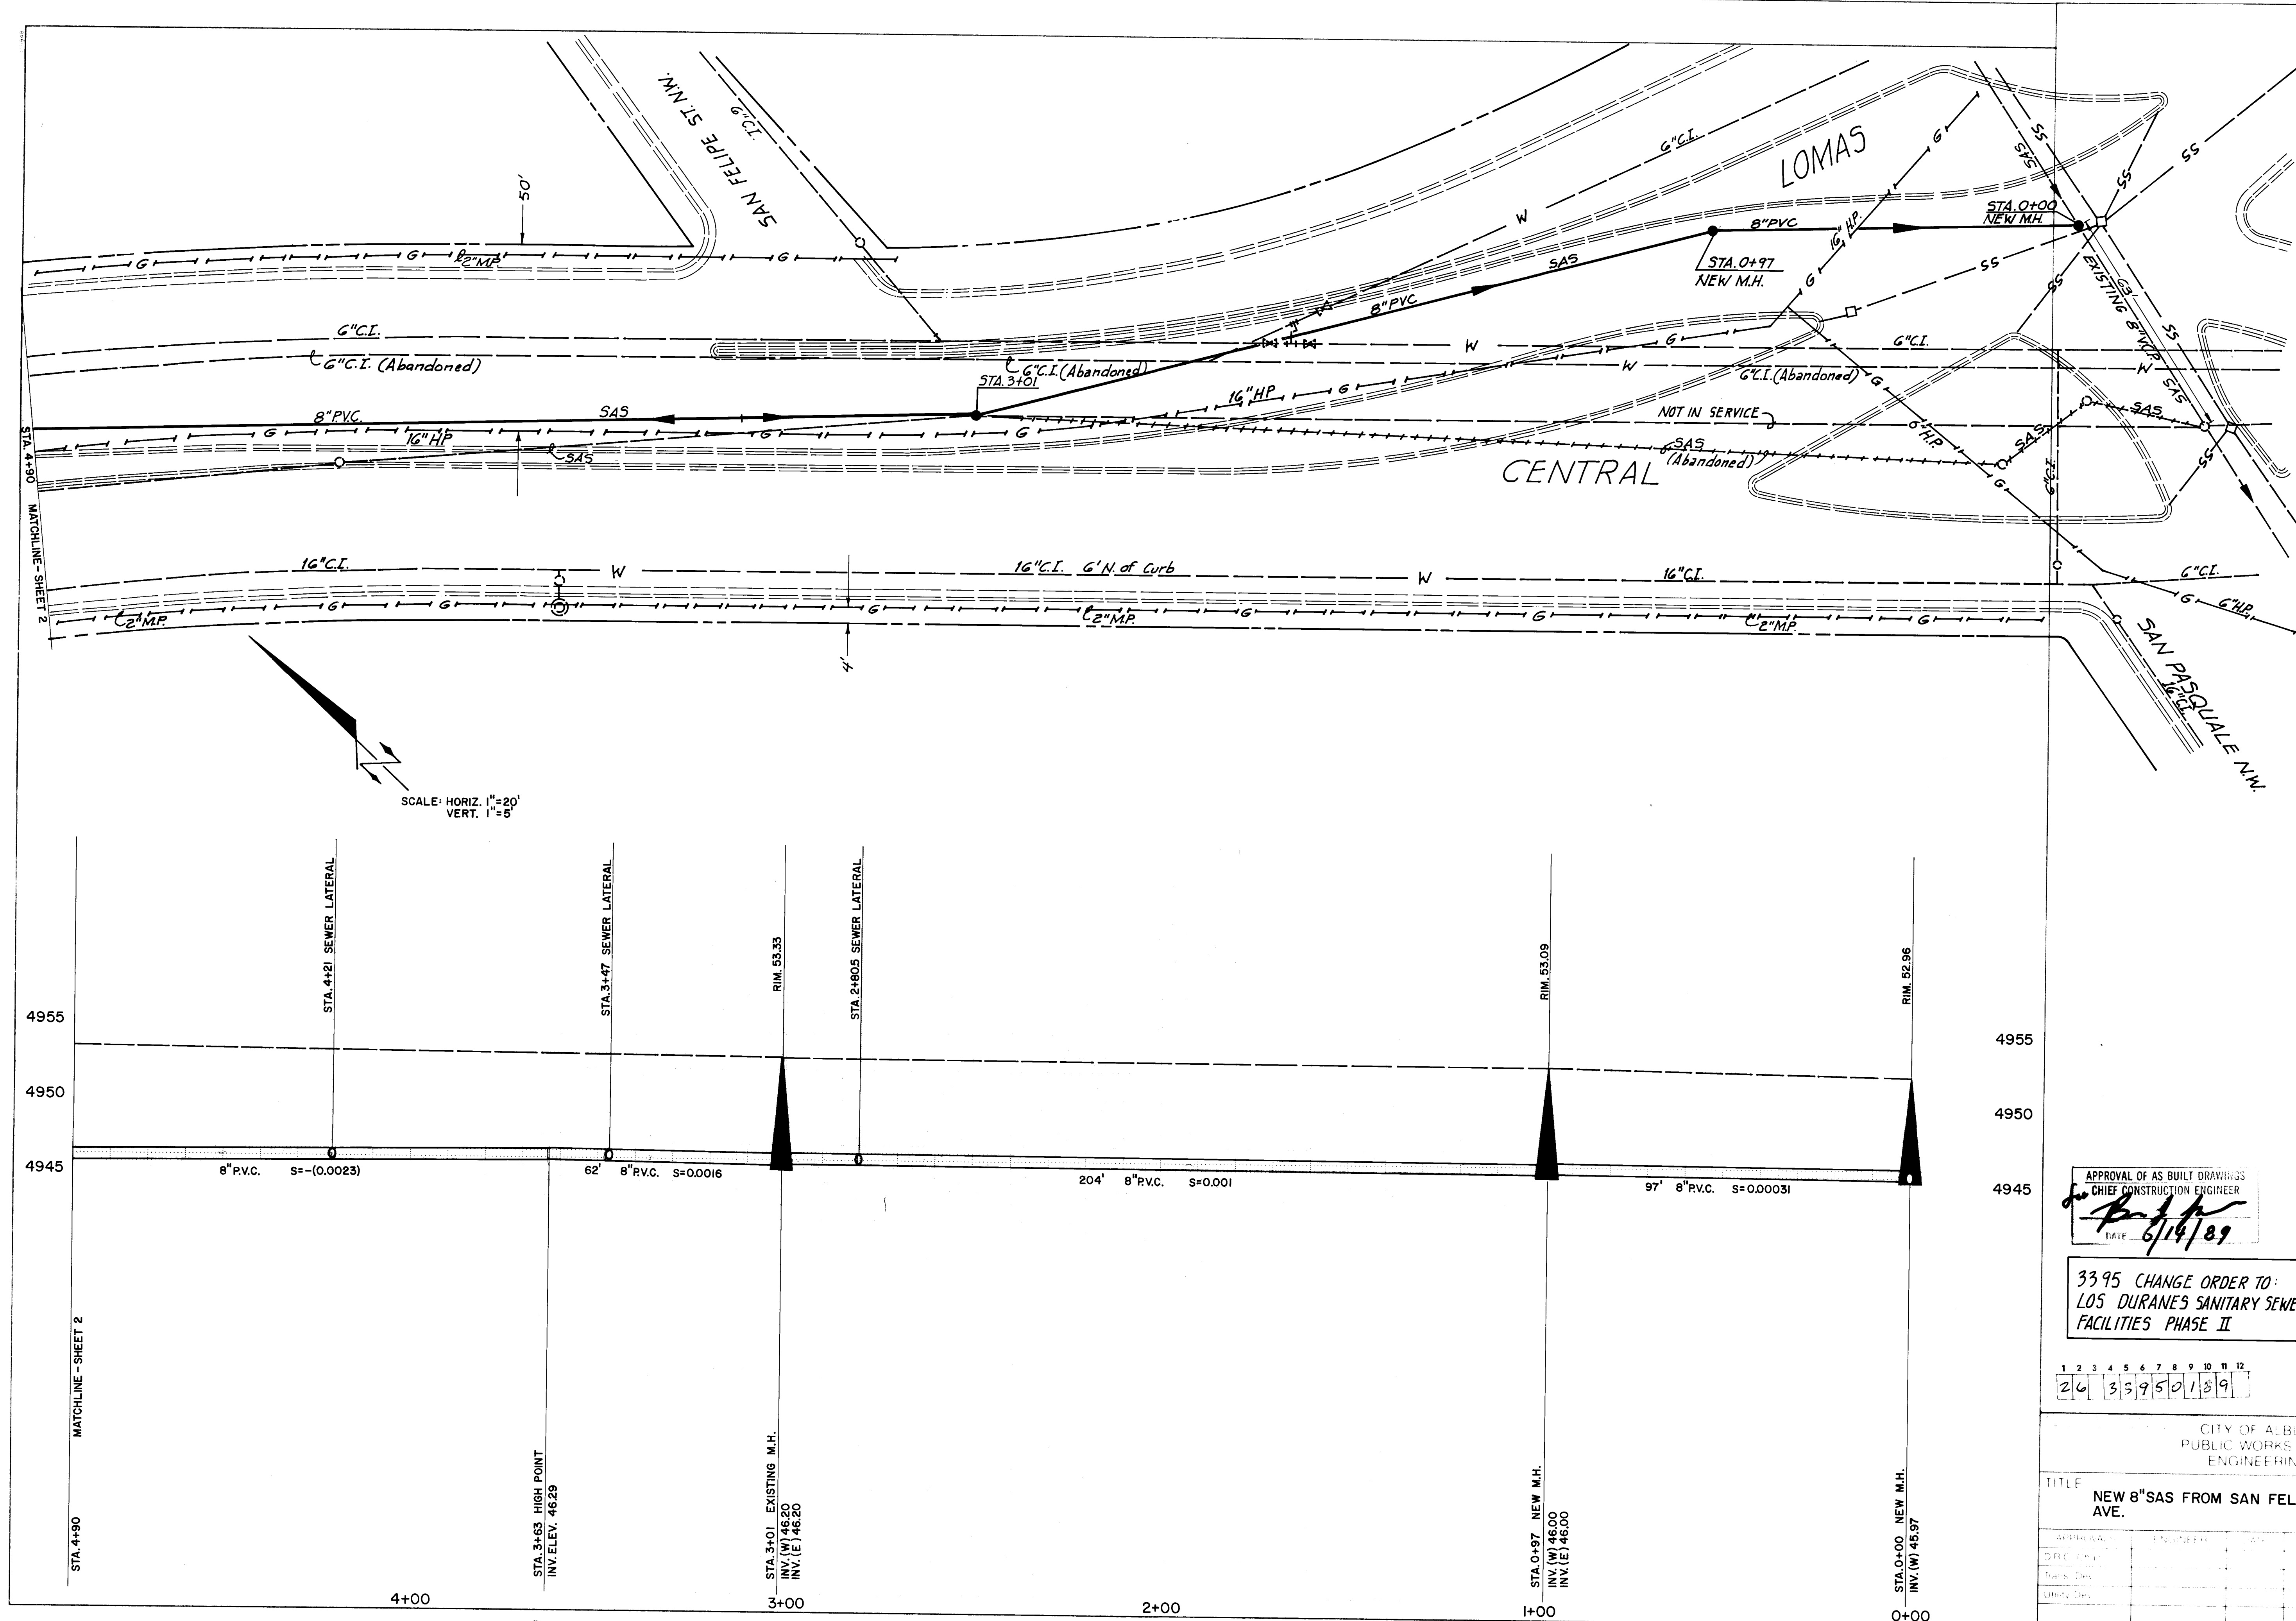



APPROVAL OF AS BUILT DRAWINGS
CHIEF CONSTRUCTION ENGINEER
DATE 6/14/09

3395 CHANGE ORDER TO:
LOS DURANES SANITARY SEWER
FACILITIES PHASE II

1	2	3	4	5	6	7	8	9	10	11	12
26	3	5	9	5	0	1	8	9			

CITY OF ALBUQUERQUE PUBLIC WORKS DEPARTMENT ENGINEERING GROUP	
TITLE NEW 8" SAS FROM SAN FELIPE TO LOMAS ON CENTRAL AVE.	
APPROVAL DATE	DATE
DESIGNED BY F. GOMEZ	DATE 12/02/08
CHECKED BY E. N.	DATE 12/02/08
DRAWING NO. 3395	
MAP NO. J-13	SHEET 1 OF 2

AS BUILT INFORMATION	BENCH MARKS	SURVEY INFORMATION	ENGINEER'S SEAL
DATE 12/02/08	DATE 12/02/08	FIELD NOTES DATE 12/02/08	NO.
REVISIONS			
NO. DATE			
REMARKS			
DESIGN			
DATE			
DATE			

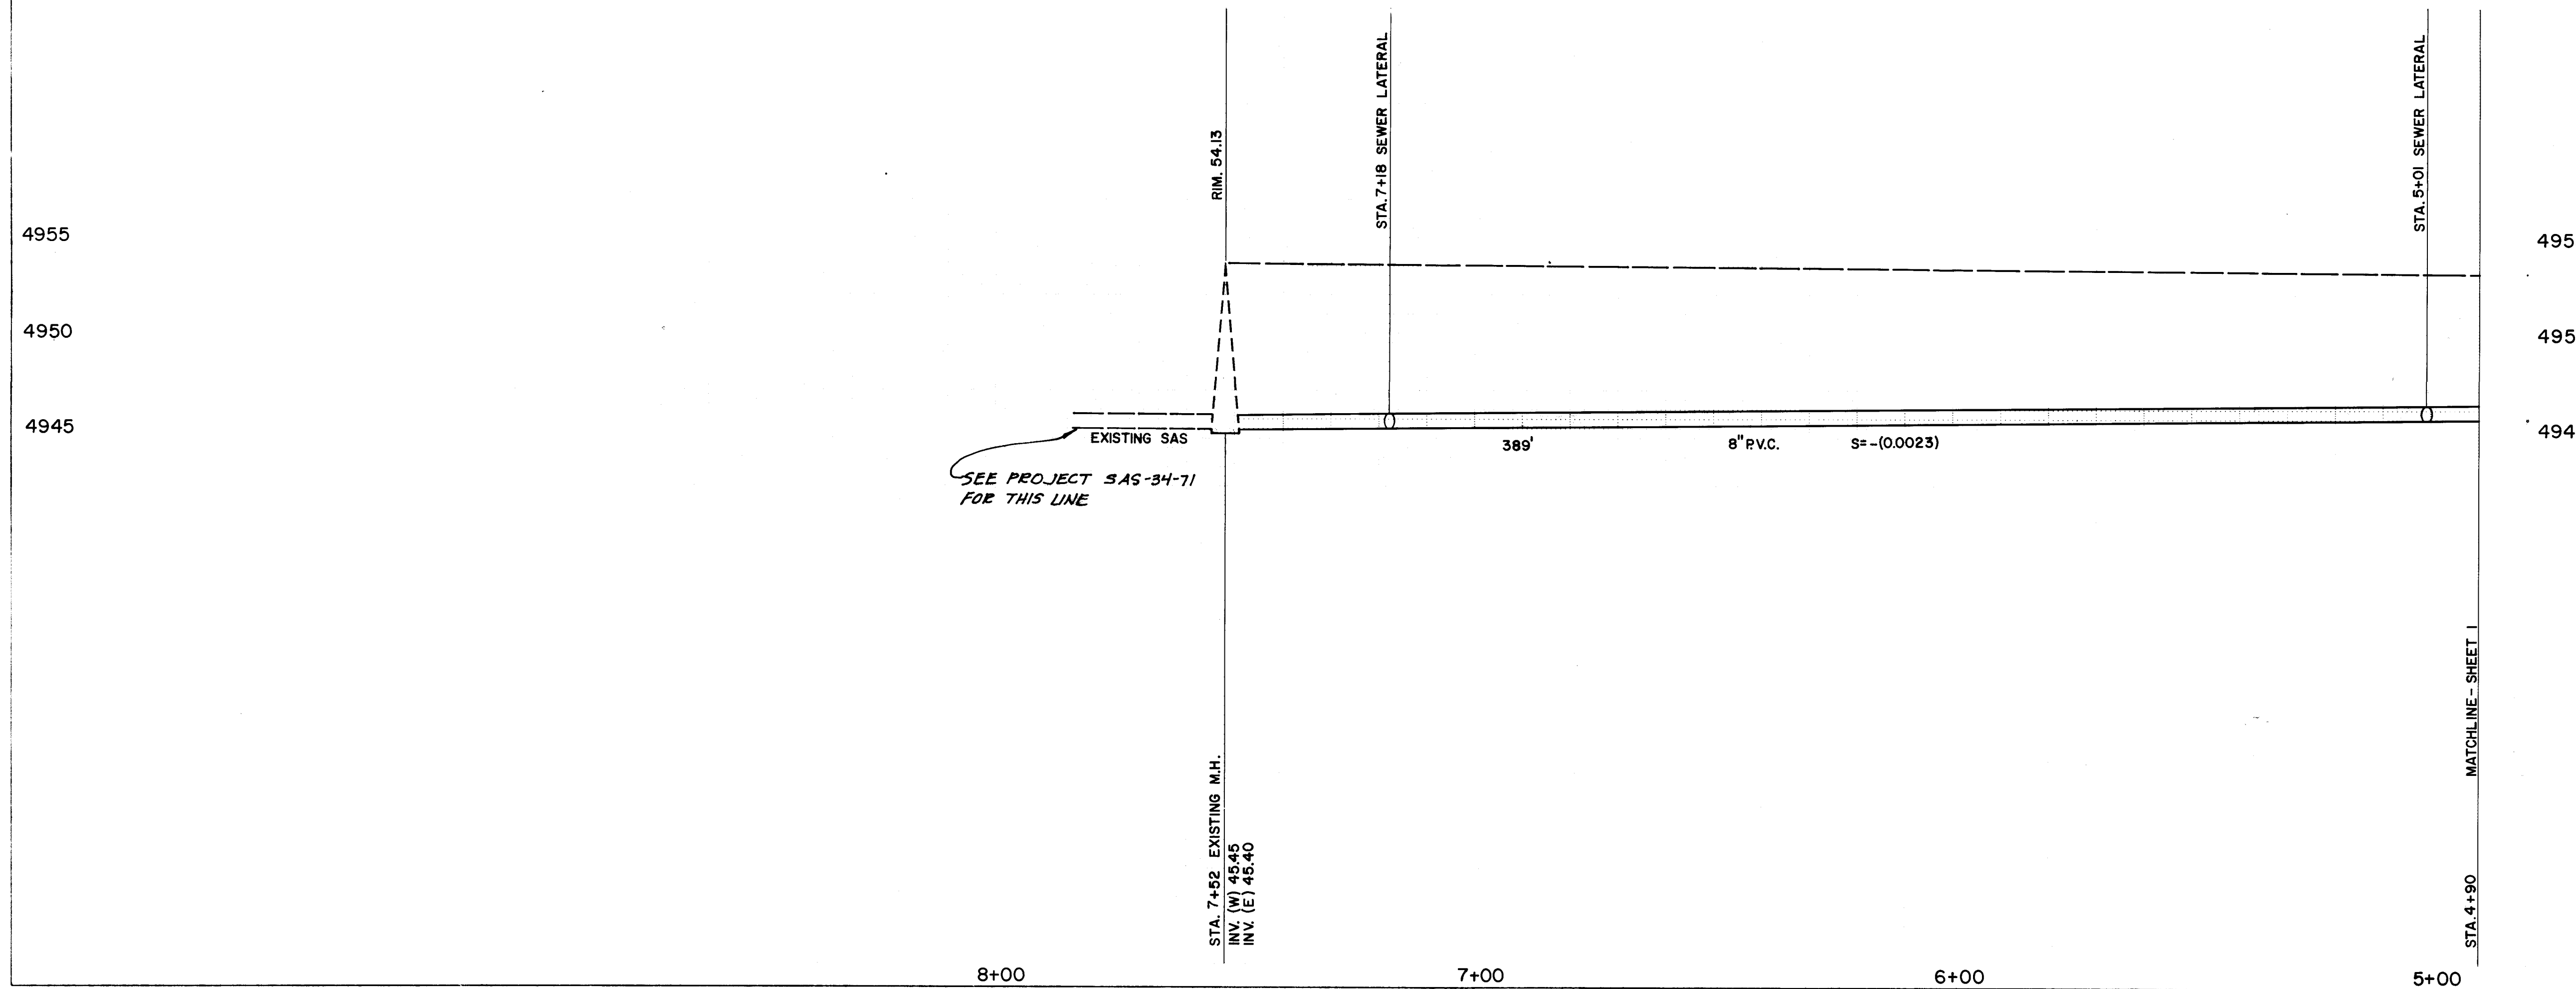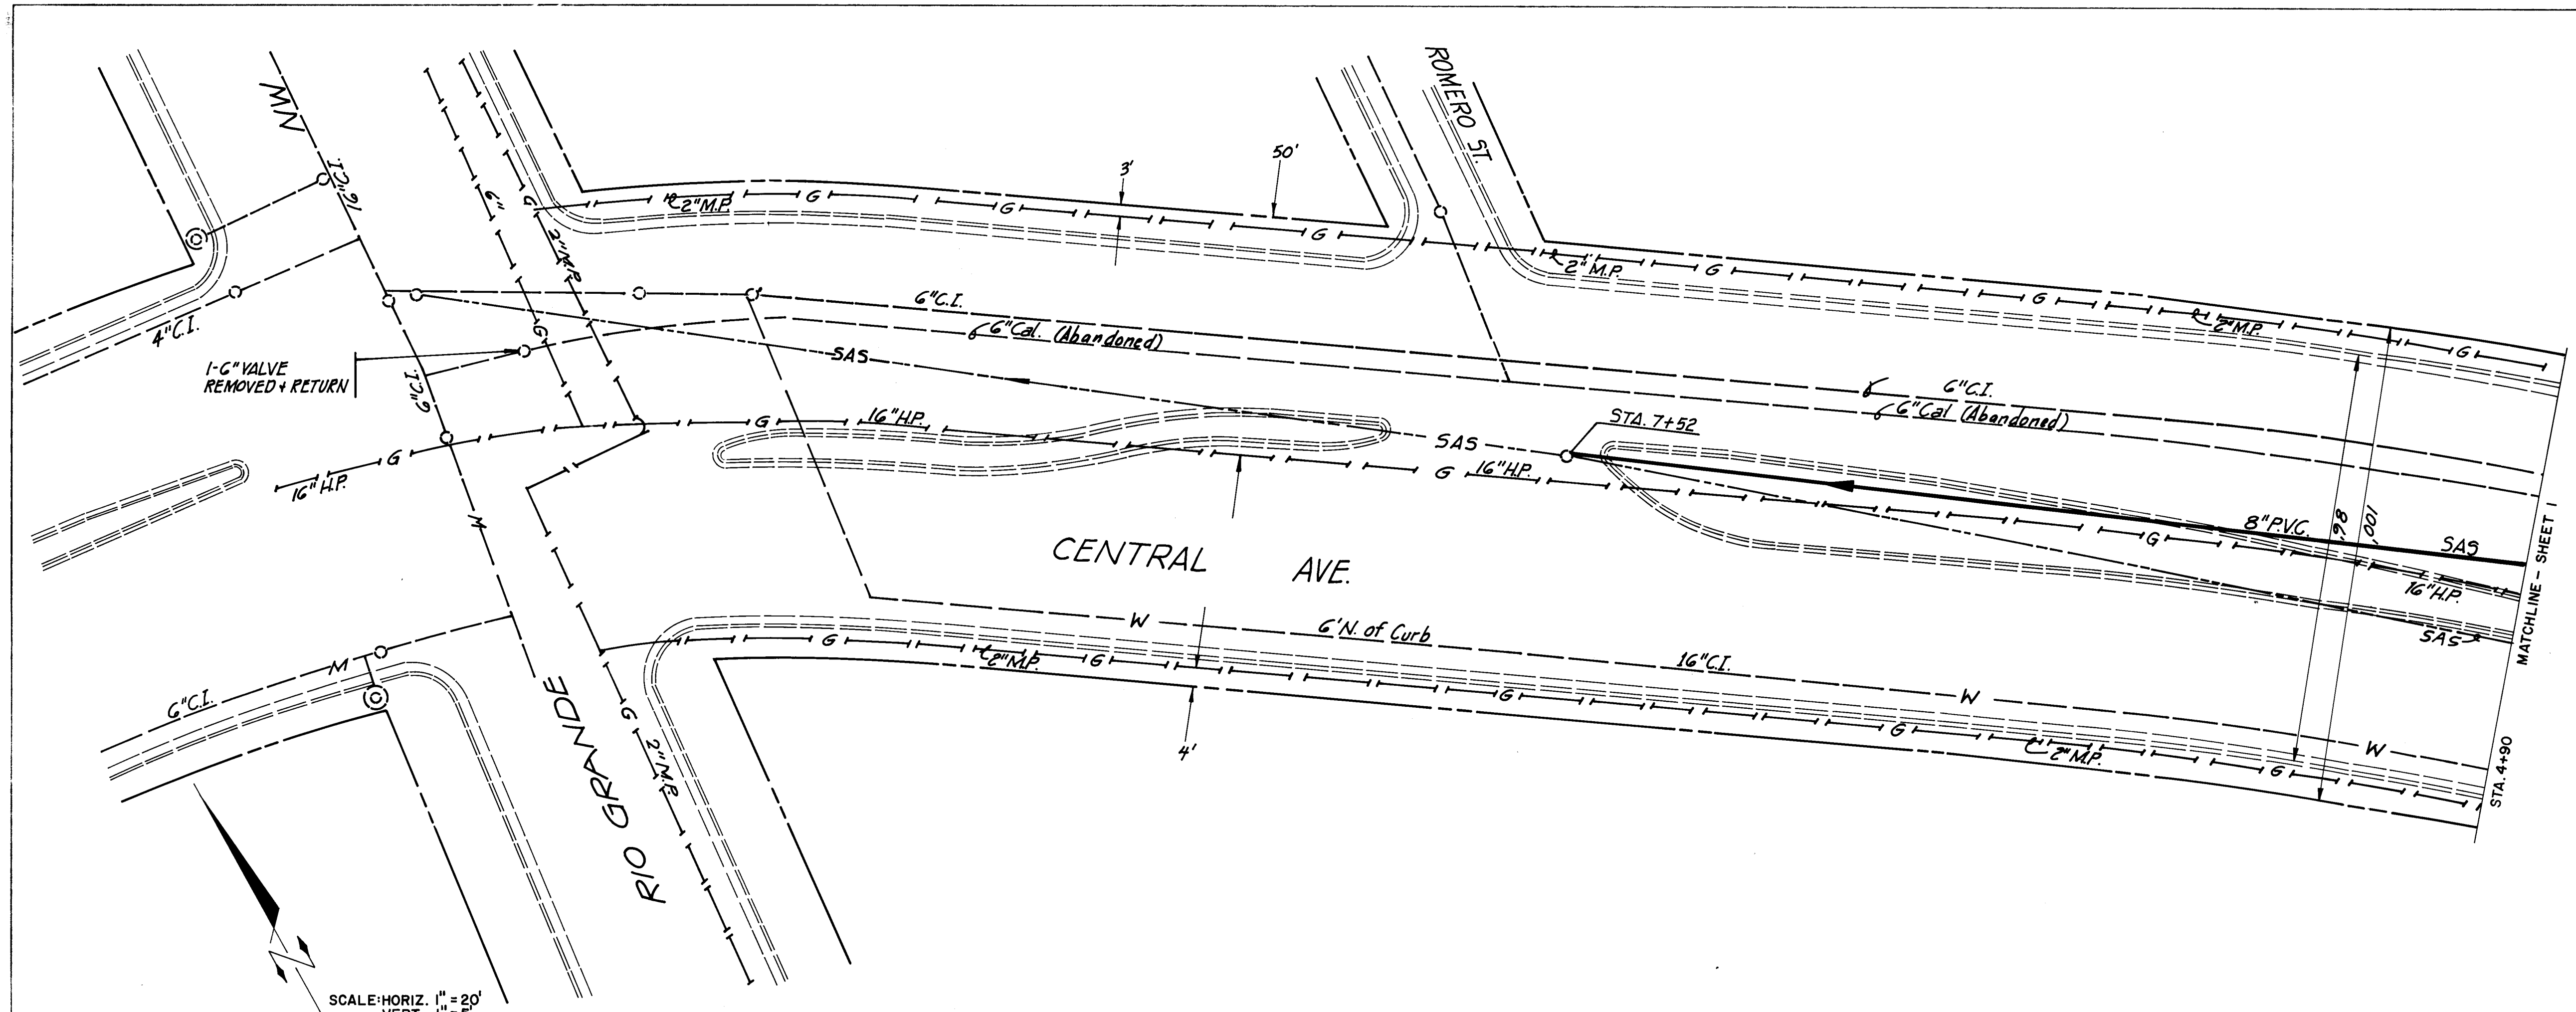

1	2	3	4	5	6	7	8	9	10	11	12
1	2	3	4	5	6	7	8	9	10	11	12

CITY OF ALBUQUERQUE
PUBLIC WORKS DEPARTMENT
ENGINEERING

TITLE
NEW 8" SAS FROM SAN FELIPE TO LOMAS ON CENTRAL AVE.

DRAWING NO. 3395

MAP NO. J-13

SHEET 2 OF 2

120288 Revised from as built information

REVISIONS

NO. DATE

BY

DESIGN

F. GOMEZ

E.N.

F. GOMEZ

AS BUILT INFORMATION

ALSO UNDERGROUND

LIBRARY

DATE

EN.

INFORMATION

BENCH MARKS

SURVEY INFORMATION

FIELD NOTES

NO. BY DATE

ENGINEER'S SEAL

120288 Revised from as built information

REVISIONS

NO. DATE

BY

DESIGN

F. GOMEZ

E.N.

F. GOMEZ