

LEGEND

MATERIALS

CONCRETE	
RIP-RAP	

LINES

RIGHT-OF-WAY	
PROPERTY LINE (PLAN)	
RIGHT-OF-WAY (SECTION)	
CENTERLINE	
EASEMENT LINE	
MATCHLINE	
SECTION CUT LINE	

EARTHWORK

	EXISTING	NEW
CONTOUR LINE		
SPOT ELEVATION		
PROJECT/PHASE BOUNDARY		
SWALE/DIRECT. OF FLOW		

MISCELLANEOUS UTILITIES

GAS LINE		
UNDERGROUND TELEPHONE		
UNDERGROUND ELECTRICAL		
STORM DRAIN		
STORM DRAIN MANHOLE		
STORM DRAIN INLET		

SANITARY SEWER (SAS)

SANITARY LINE		
SANITARY MANHOLE		
SERVICE CONNECTIONS		
CAP OR PLUG		
ENCASEMENT		

WATER

CAPS AND PLUGS		
SERVICE CONNECTIONS		
GATE VALVE		
FIRE HYDRANT		
BUTTERFLY VALVE		
REDUCER		
PRESSURE ZONE BOUNDARY		
ELBOW		
CROSS		
TEE		


MISCELLANEOUS

EDGE OF ASPHALT		
FIELD FENCE		
CHAINLINK FENCE		
YARD/BLOCK WALL		
RETAINING WALL		
POWER OR TELE. POLE		
TREE		
TRAFFIC SIGN		

PAVING IMPROVEMENTS
AT HIDALGO CIR. &
FORTUNA RD. N.W.

INDEX OF DRAWINGS



- 1 OF 3 TITLE SHEET
- 2 OF 3 PLAN & PROFILE
ON FORTUNA RD. N.W.
- 3 OF 3 PLAN & PROFILE
ON HIDALGO CIR. N.W.

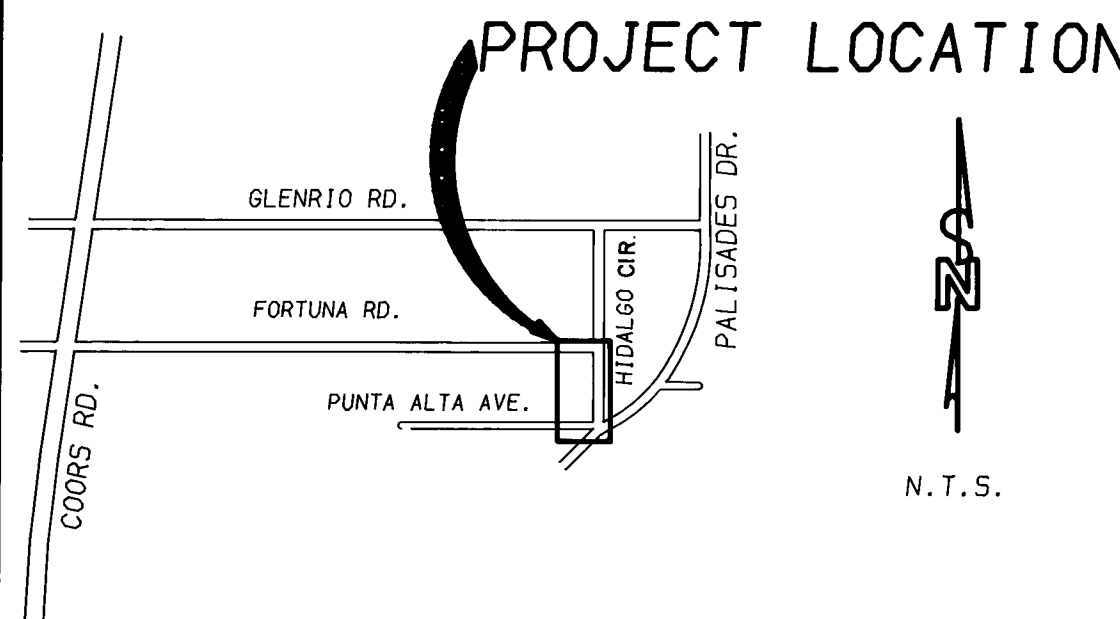


VICINITY MAP ZONE ATLAS J-11

CONSTRUCTION NOTES

- ALL WORK DETAILED ON THESE PLANS TO BE PERFORMED UNDER THIS CONTRACT SHALL, EXCEPT AS OTHERWISE STATED OR PROVIDED FOR HEREON, BE CONSTRUCTED IN ACCORDANCE WITH THE CITY OF ALBUQUERQUE STANDARD SPECIFICATIONS FOR PUBLIC WORKS CONSTRUCTION 1986.
- TWO (2) WORKING DAYS PRIOR TO ANY EXCAVATION, THE CONTRACTOR MUST CONTACT NEW MEXICO ONE CALL SYSTEM 260-1990, FOR LOCATION OF EXISTING UTILITIES.
- PRIOR TO CONSTRUCTION, THE CONTRACTOR SHALL EXCAVATE AND VERIFY THE HORIZONTAL AND VERTICAL LOCATIONS OF ALL OBSTRUCTIONS. SHOULD A CONFLICT EXIST, THE CONTRACTOR SHALL NOTIFY THE ENGINEER OR SURVEYOR SO THAT THE CONFLICT CAN BE RESOLVED WITH MINIMUM AMOUNT OF DELAY.
- TWO (2) WORKING DAYS PRIOR TO BEGINNING CONSTRUCTION, CONTRACTOR SHALL OBTAIN A BARRICADING PLAN AND PERMIT THROUGH CONSTRUCTION COORDINATION DIVISION AT 768-2552.
- BACKFILL COMPACTION SHALL BE ACCORDING TO SPECIFIED STREET USE . (RESIDENTIAL)
- TACK COAT REQUIREMENTS SHALL BE DETERMINED BY THE CITY ENGINEER.

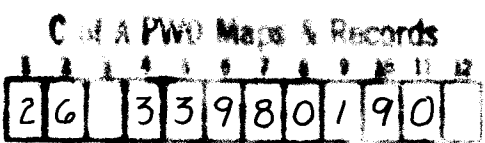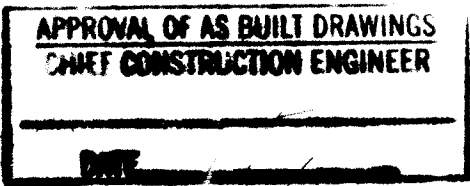

	CITY OF ALBUQUERQUE		APPROVED FOR CONSTRUCTION CITY ENGINEER 5-16-98	
	DRAWING NO. 3398	MAP NO. J-11	SHEET 1 OF 3	

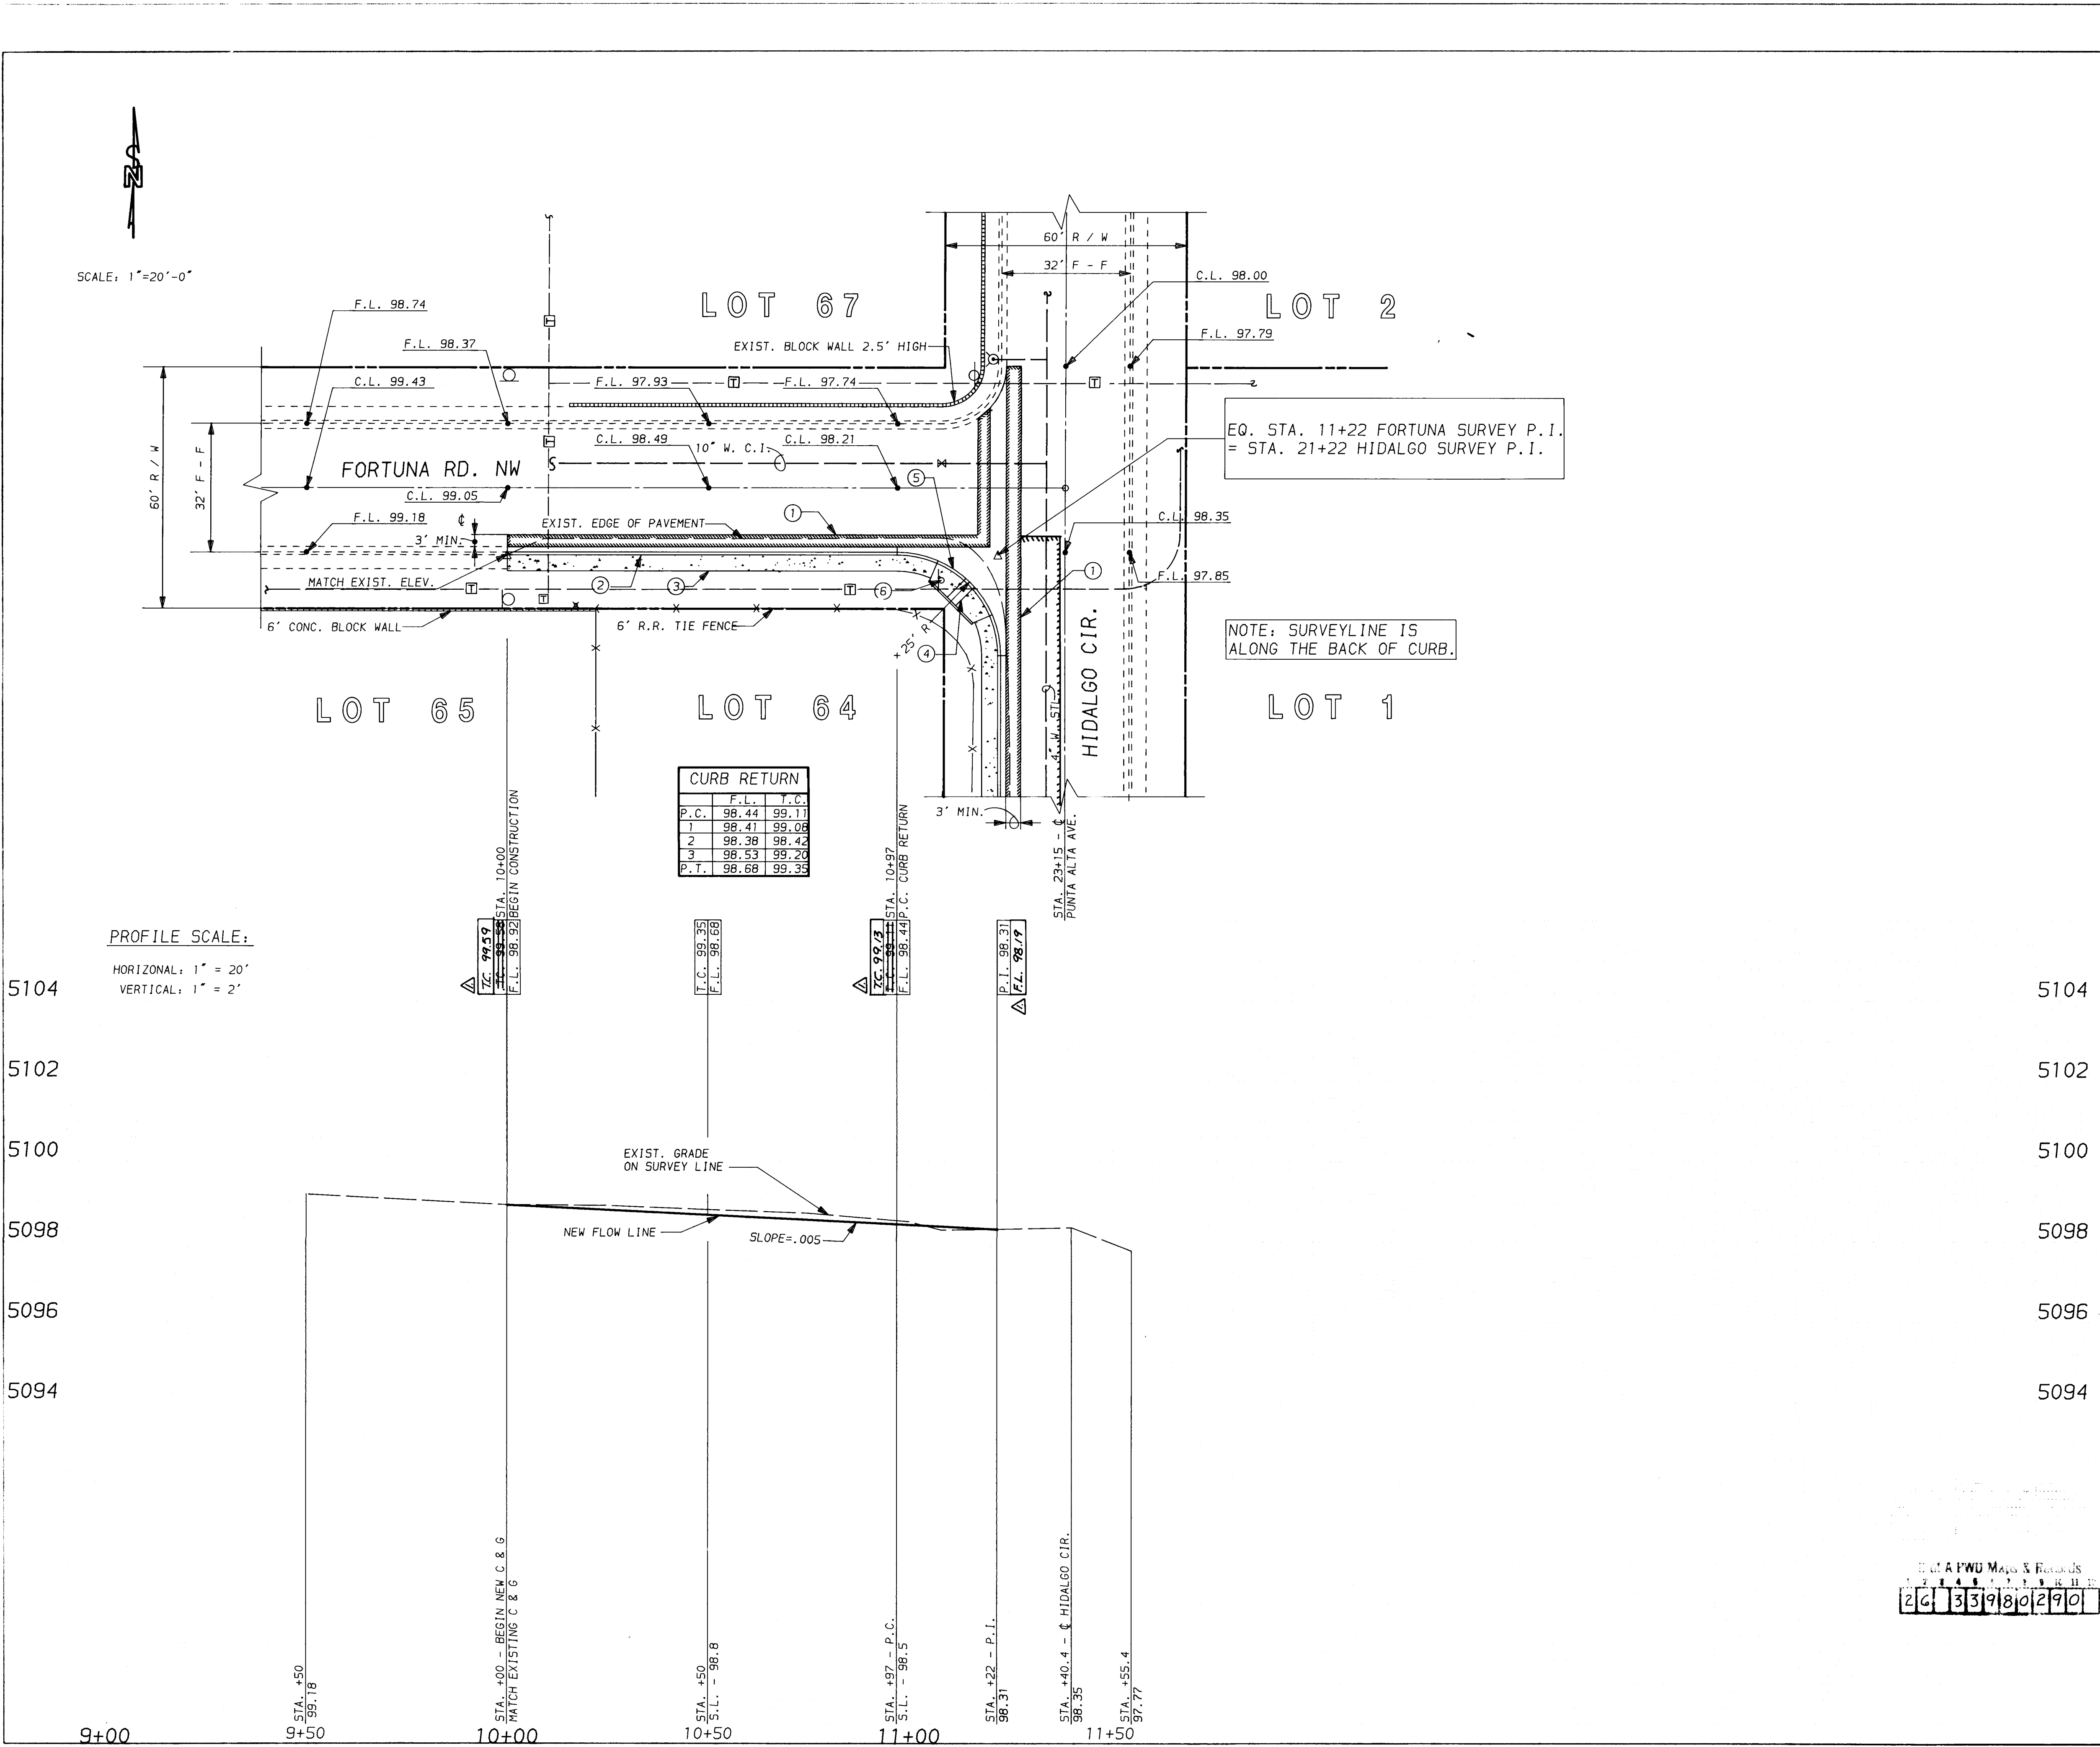

- KEYED NOTES**
- ① REMOVE AND REPLACE EXISTING RESIDENTIAL PAVEMENT PER C.O.A. STD. DWG. NO. 2465.
 - ② CONSTRUCT NEW P.C.C. STD. CURB AND GUTTER PER C.O.A. STD. DWG. NO. 2415.
 - ③ CONSTRUCT NEW 4' WIDE 4" P.C.C. SIDEWALK PER C.O.A. STD. DWG. NO. 2430.
 - ④ CONSTRUCT NEW HANDICAPPED RAMP PER C.O.A. STD. DWG. NO. 2441, CASE 1.
 - ⑤ CONSTRUCT NEW VALLEY GUTTER PER C.O.A. STD. DWG. NO. 2420.
 - ⑥ REINSTALL EXISTING SIGN PER M.U.T.C.D. 1988 ADDITION.

- LEGEND**
- 98.51 EXISTING ELEVATION
 - 98.31 NEW ELEVATION
 - x EXISTING DOWN GUY CABLE
 - φ EXISTING LIGHT POLE
 - Δ SURVEY TRAVERSE POINT

CITY OF ALBUQUERQUE
PUBLIC WORKS DEPARTMENT
ENGINEERING GROUP

TITLE
PLAN AND PROFILE
ON FORTUNA RD. N.W.

APPROVALS	ENGINEER	DATE	APPROVALS	ENGINEER	DATE
DRC Chairman	<i>Raul Rios</i>	3/15/90	Water	<i>R.W. Kane</i>	3/15/90
Transportation	<i>Debra Hume</i>	3/15/90	Waste Water	<i>R.W. Kane</i>	3/15/90
Hydrology	<i>Steve Hume</i>	3/15/90			

DRAWING NO. 3398 MAP NO. J-11 SHEET 2 OF 3

AS BUILT INFORMATION		BENCH MARKS		SURVEY INFORMATION		ENGINEER'S SEAL	
DATE	NO.	DATE	NO.	NO.	BY	NO.	BY
DATE 7/18/90	NO. C.C.M.	DATE 7/18/90	NO. C.C.M.	NO. 05-54	BY P. AQUAR		
DATE 7/18/90		DATE 7/18/90		DATE 7/18/90		DATE 7/18/90	
DATE 7/18/90		DATE 7/18/90		DATE 7/18/90		DATE 7/18/90	

