



CITY OF ALBUQUERQUE NEW MEXICO

PUBLIC WORKS DEPARTMENT


LIQUID WASTE DIVISION

PLANS FOR CONSTRUCTION OF

SOILS AMENDMENT FACILITY ACCESS ROAD AND SITE IMPROVEMENTS

PHASE II B-3, CONTRACT 2

OCTOBER 1987

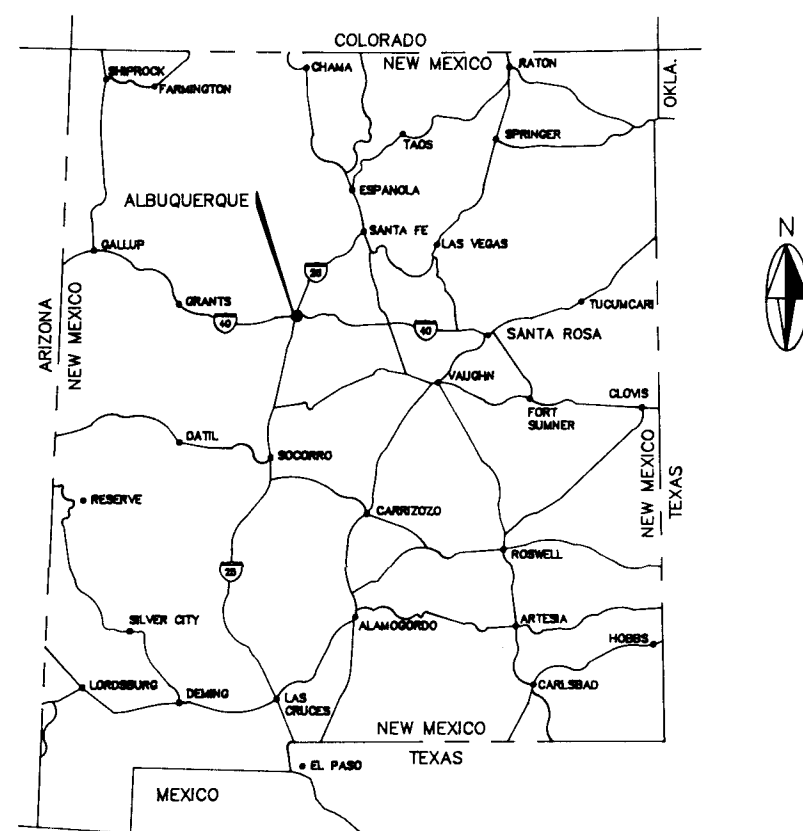

LOCATION MAP

APPROVED FOR CONSTRUCTION

Gene Leyn

GENE LEYNDECKER, P.E.
CHIEF UTILITY ENGINEER
PUBLIC WORKS DEPT.

DATE 10/20/87


INDEX TO DRAWINGS

NO.	SHEET
1.	TITLE SHEET
2.	VICINITY MAP
3.	TYPICAL SECTIONS & GENERAL NOTES
4-21.	PLAN & PROFILE
22.	CONCRETE PAVEMENT JOINT DETAILS
23.	SITE GRADING PLAN
24-25.	FENCING DETAILS
26.	TRAFFIC CONTROL DETAILS
27.	PERMANENT SIGNING PLAN

C of A PWD Maps & Records
1 2 3 4 5 6 7 8 9 10 11 12
26 34060192


RECORD DRAWING	
DATE: MARCH 1992	DRAFTED BY: D. SALAZAR
THESE RECORD DRAWINGS HAVE BEEN PREPARED, IN PART, ON THE BASIS OF INFORMATION COMPILED AND FURNISHED BY OTHERS. THE ENGINEER WILL NOT BE RESPONSIBLE FOR ANY ERRORS OR OMISSIONS WHICH HAVE BEEN INCORPORATED INTO THIS DOCUMENT AS A RESULT.	

NO.			DATE	REMARKS	BY
REVISIONS					
 CITY OF ALBUQUERQUE, NEW MEXICO SOLIDS HANDLING FACILITIES PHASE II B-3, CONTRACT 2					
 MOLZEN-CORBIN STANLEY CONSULTANTS A JOINT VENTURE					
					

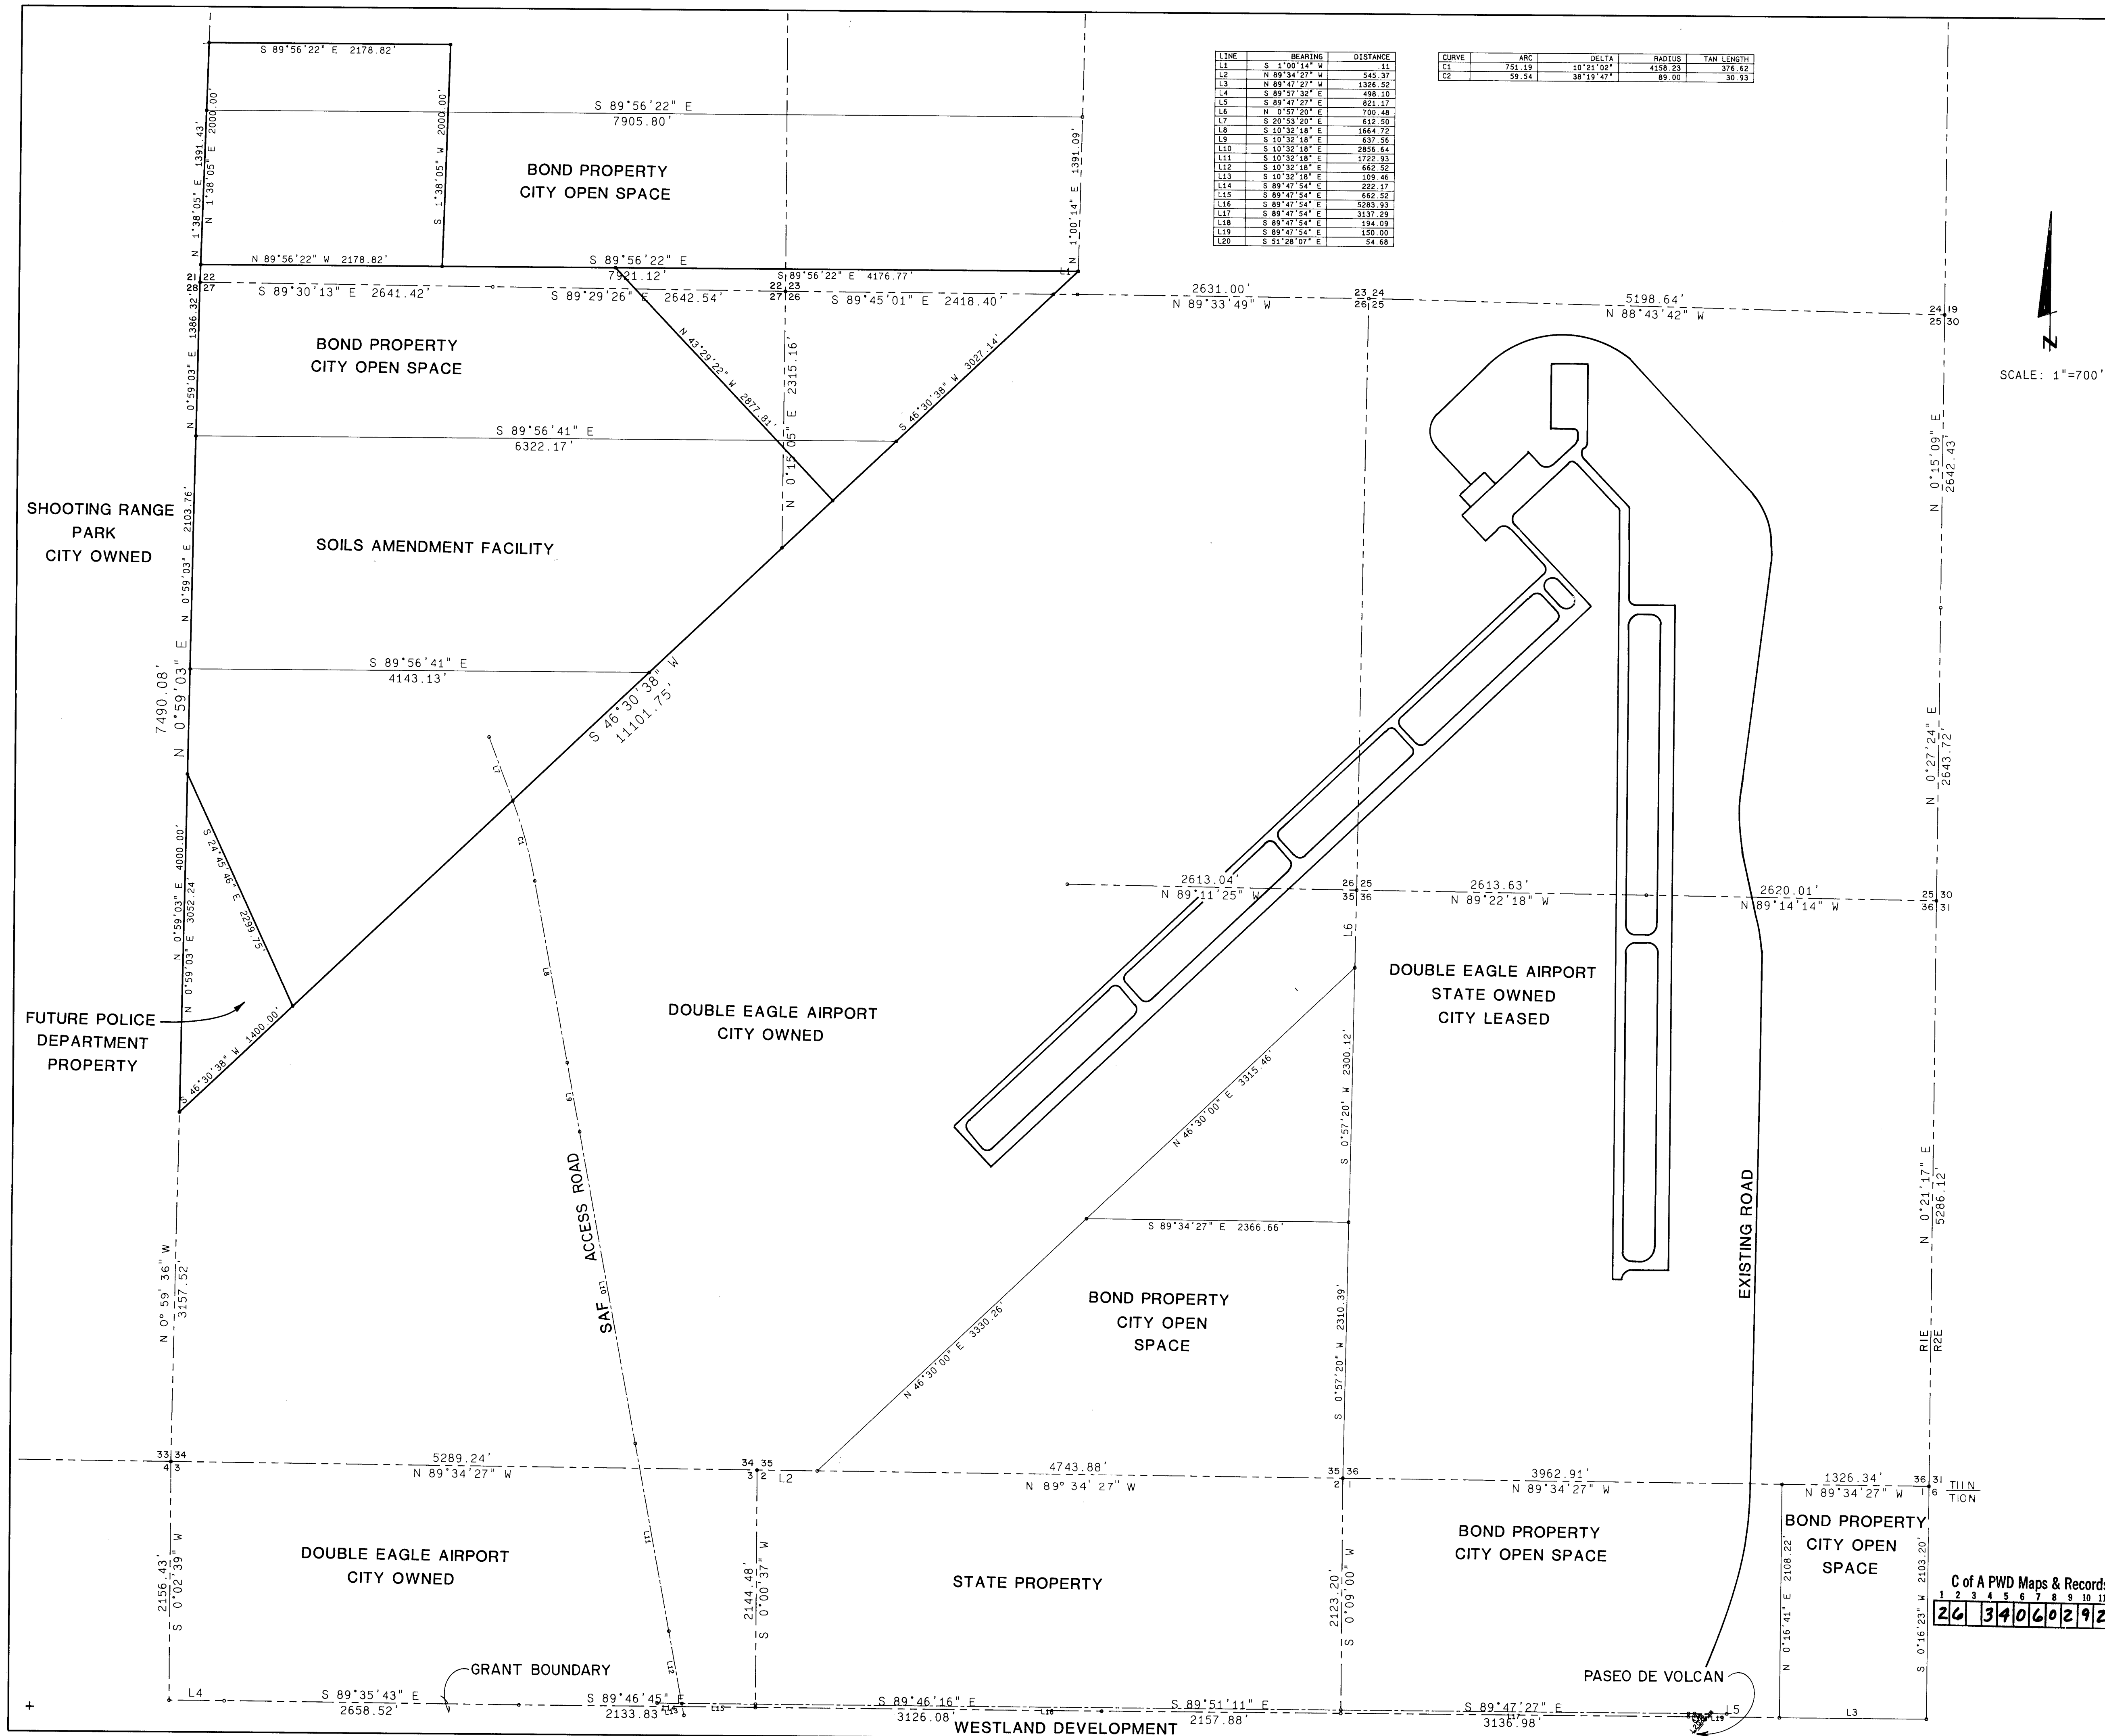

LINE	BEARING	DISTANCE
L1	S 1°00'14" W	411
L2	N 89°34'27" W	545.37
L3	N 89°47'27" W	1386.52
L4	S 89°57'32" E	498.10
L5	S 89°47'27" E	821.17
L6	N 0°57'20" E	700.48
L7	S 20°53'20" E	612.50
L8	S 10°32'18" E	1664.72
L9	S 10°32'18" E	637.56
L10	S 10°32'18" E	2856.64
L11	S 10°32'18" E	1722.93
L12	S 10°32'18" E	662.52
L13	S 10°32'18" E	109.46
L14	S 89°47'54" E	222.17
L15	S 89°47'54" E	662.52
L16	S 89°47'54" E	5283.93
L17	S 89°47'54" E	3137.29
L18	S 89°47'54" E	194.09
L19	S 89°47'54" E	150.00
L20	S 51°28'07" E	54.68

CURVE	ARC	DELTA	RADIUS	TAN LENGTH
C1	751.19	10°21'02"	4358.23	376.62
C2	59.54	38°19'47"	89.00	30.93

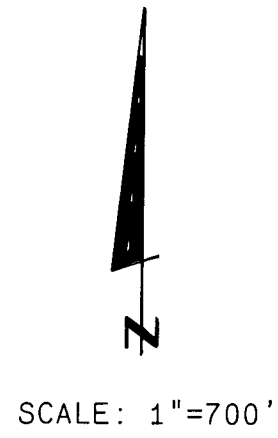

AS BUILT INFORMATION			BENCH MARKS			SURVEY INFORMATION			ENGINEER'S SEAL		
CONTRACTOR	DATE		NO.	BY	DATE		NO.	DATE	REVISIONS	BY	DATE
INSPECTOR'S	DATE										
FIELD	DATE										
MICRO-FILM INFORMATION											
DATE											
RECORDED BY	DATE										
NO.											

RECORD DRAWING

DATE: MARCH 1992 DRAFTED BY: D. SALAZAR

THESE RECORD DRAWINGS HAVE BEEN PREPARED, IN PART, ON THE BASIS OF INFORMATION COMPILED AND FURNISHED BY OTHERS. THE ENGINEER WILL NOT BE RESPONSIBLE FOR ANY ERRORS OR OMISSIONS WHICH HAVE BEEN INCORPORATED INTO THIS DOCUMENT AS A RESULT.

ORIGINAL DESIGN SURVEY NOTES WILL BE PROVIDED BY ENGINEER.

CITY OF ALBUQUERQUE, NEW MEXICO

SOLIDS HANDLING FACILITIES

PHASE II B-3, CONTRACT 2

MOLZEN-CORBIN

STANLEY CONSULTANTS

A JOINT VENTURE

CITY OF ALBUQUERQUE

PUBLIC WORKS DEPARTMENT

LIQUID WASTE DIVISION

TITLE: SOILS AMENDMENT FACILITY

VICINITY MAP


APPROVALS	ENGINEER	DATE	APPROVALS	ENGINEER	DATE
City Engineer			Liquid Waste		
A.C.E.-Design			Traffic		
A.C.E.-Hydrology			Water		

DRAWING NO. 3406

MAP NO.

SHEET 2 OF 27

C of A PWD Maps & Records											
1	2	3	4	5	6	7	8	9	10	11	12
26	34	06	02	92							

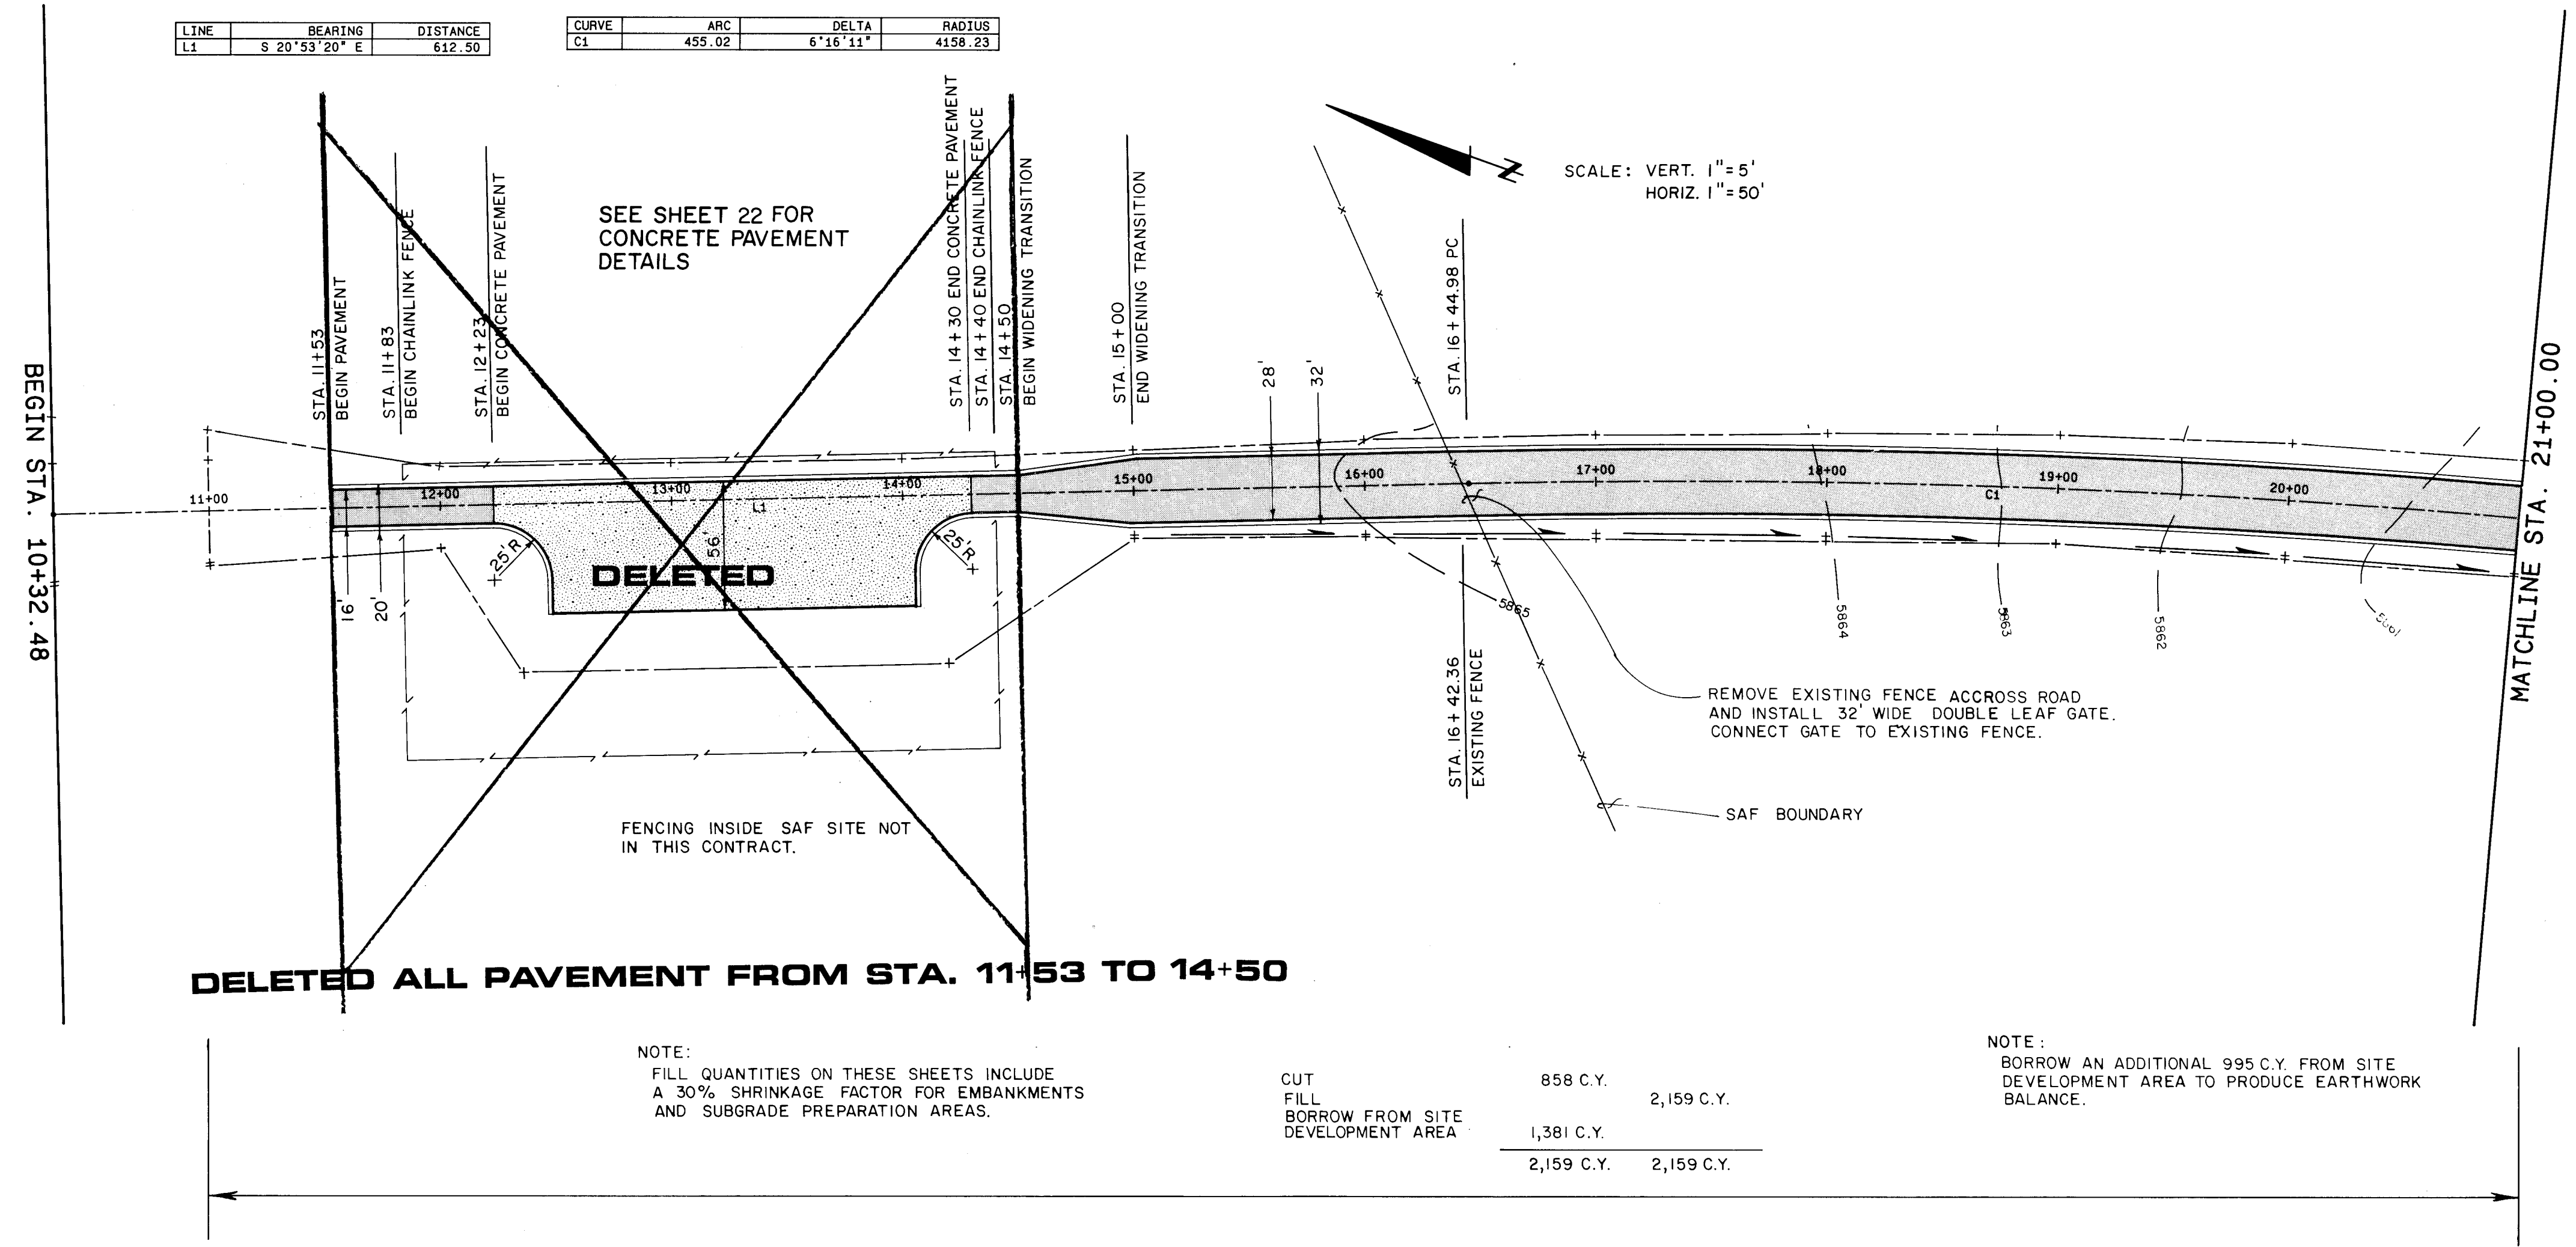

LINE	BEARING	DISTANCE
L1	S 20°53'20" E	612.50

CURVE	ARC	DELTA	RADIUS
C1	455.02	6°16'11"	4158.23

SEE SHEET 22 FOR
CONCRETE PAVEMENT
DETAILS


SCALE: VERT. 1"=5'
HORIZ. 1"=50'

DELETED ALL PAVEMENT FROM STA. 11+53 TO 14+50

NOTE:
FILL QUANTITIES ON THESE SHEETS INCLUDE
A 30% SHRINKAGE FACTOR FOR EMBANKMENTS
AND SUBGRADE PREPARATION AREAS.

CUT	858 C.Y.
FILL	2,159 C.Y.
BORROW FROM SITE	1,381 C.Y.
DEVELOPMENT AREA	2,159 C.Y.

NOTE:
BORROW AN ADDITIONAL 995 C.Y. FROM SITE
DEVELOPMENT AREA TO PRODUCE EARTHWORK
BALANCE.

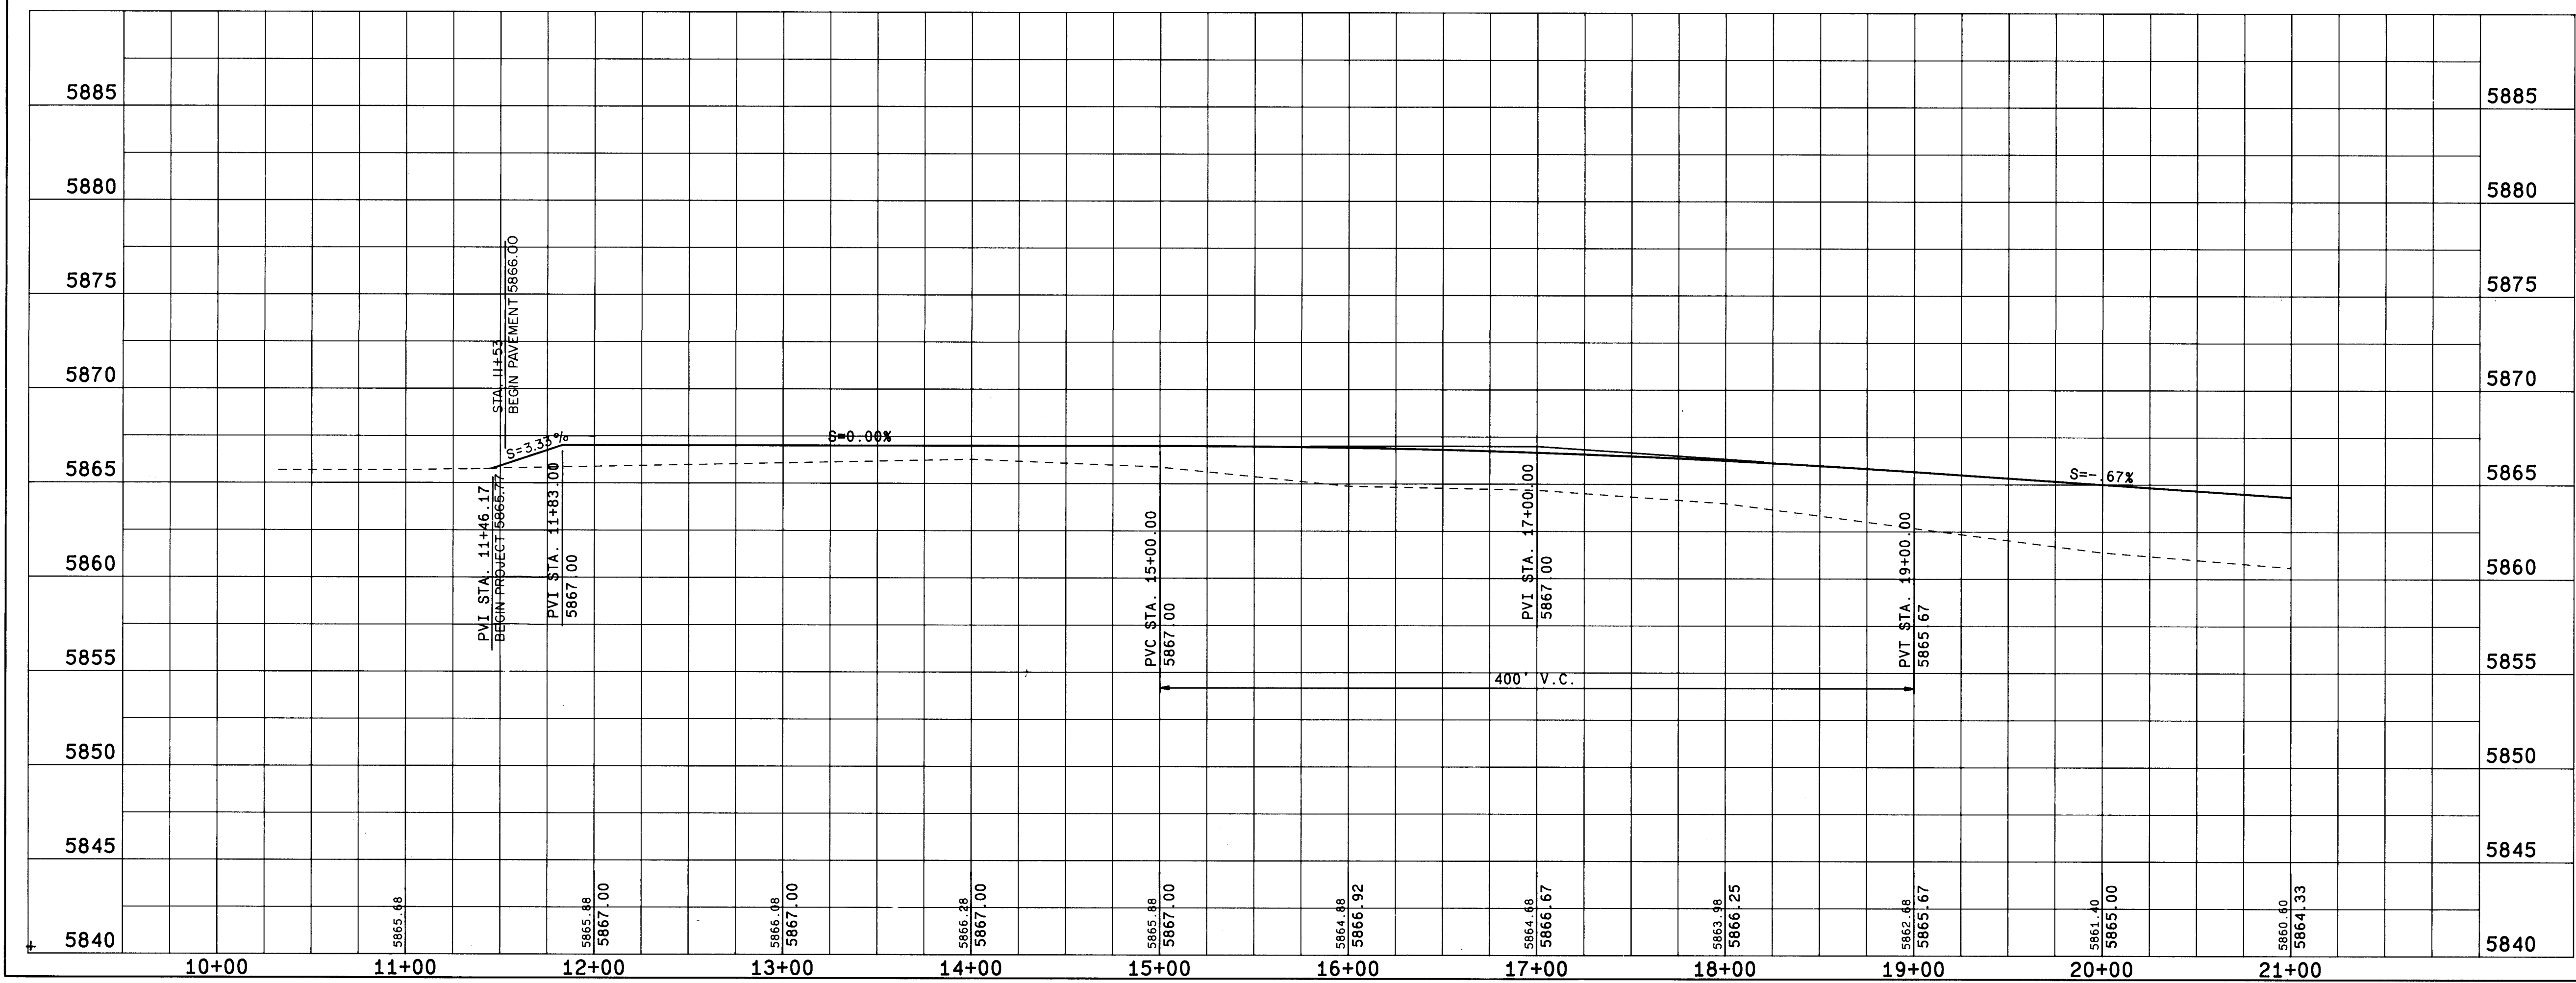

LEGEND

EXISTING CONTOUR	---
DIRT ROAD	---
EXISTING FENCE	---
FENCE TO BE REMOVED	---
EXISTING CM PIPE	---
EXISTING FLOW LINE	---
NEW ASPHALT PAVEMENT	---
NEW CONCRETE PAVEMENT	---
NEW FLOW LINE	---
NEW CM PIPE	---
NEW BARB WIRE FENCE	---
NEW CHAIN LINK FENCE	---
LIMITS OF GRADING	---
ROAD CENTERLINE	---


AS BUILT INFORMATION	
CONTRACTOR	WORKED BY
INSPECTOR'S	DATE
ACCEPTANCE BY	DATE
VERIFICATION BY	DATE
CHANGED BY	DATE
APPROVED BY	DATE
RECORDED BY	DATE
NO.	

BENCH MARKS	
HORIZONTAL CONTROL - B-56 STATION IS LOCATED 7 MILES N.W. OF DOWN-	
TOWN ALBUQUERQUE ON THE HIGHEST OF THE VOLCANIC MOUNDS ON THE	
WEST MESA. STANDARD USC&GS TABLE STAMPED "VULCAN 1956 & 1969".	
CEMENTED IN VOLCANIC ROCK.	
VERTICAL CONTROL - USC&GS K-227, SW 1/4, SEC 26, T11N, R1E.	
ELEV. 5847.02' MSL.	

SURVEY INFORMATION	
FIELD NOTES	DATE
BY	
NO.	


ENGINEER'S SEAL	
REMARKS	BY
DESIGN	
NO.	DATE
DESIGNED BY	DATE
DRAWN BY	DATE
CHECKED BY	DATE

CITY OF ALBUQUERQUE, NEW MEXICO					
SOLIDS HANDLING FACILITIES					
PHASE II B-3, CONTRACT 2					
MOLZEN-CORBIN					
STANLEY CONSULTANTS					
A JOINT VENTURE					
CITY OF ALBUQUERQUE					
PUBLIC WORKS DEPARTMENT					
LIQUID WASTE DIVISION					
TITLE: PLAN AND PROFILE					
SAF ACCESS ROAD					
APPROVALS	ENGINEER	DATE	APPROVALS	ENGINEER	DATE
City Engineer			Liquid Waste		
A.C.E.-Design			Traffic		
A.C.E.-Hydrology			Water		
DRAWING NO. 3406					
MAP NO.					
SHEET 4 OF 27					

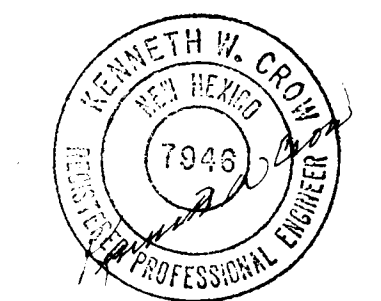

C of A PWD Maps & Records
1 2 3 4 5 6 7 8 9 10 11 12
26 34 06 04 92


RECORD DRAWING	
DATE:	DRAFTED BY:
MARCH, 1992	D. SALAZAR
THESE RECORD DRAWINGS HAVE BEEN PREPARED, IN PART, ON THE BASIS OF INFORMATION COMPILED AND FURNISHED BY OTHERS. THE ENGINEER WILL NOT BE RESPONSIBLE FOR ANY ERRORS OR OMISSIONS WHICH HAVE BEEN INCORPORATED INTO THIS DOCUMENT AS A RESULT.	

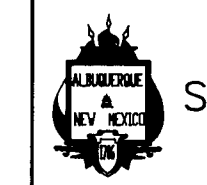


CITY OF ALBUQUERQUE, NEW MEXICO
SOLIDS HANDLING FACILITIES
PHASE II B-3, CONTRACT 2



MOLZEN-CORBIN
STANLEY CONSULTANTS
A JOINT VENTURE

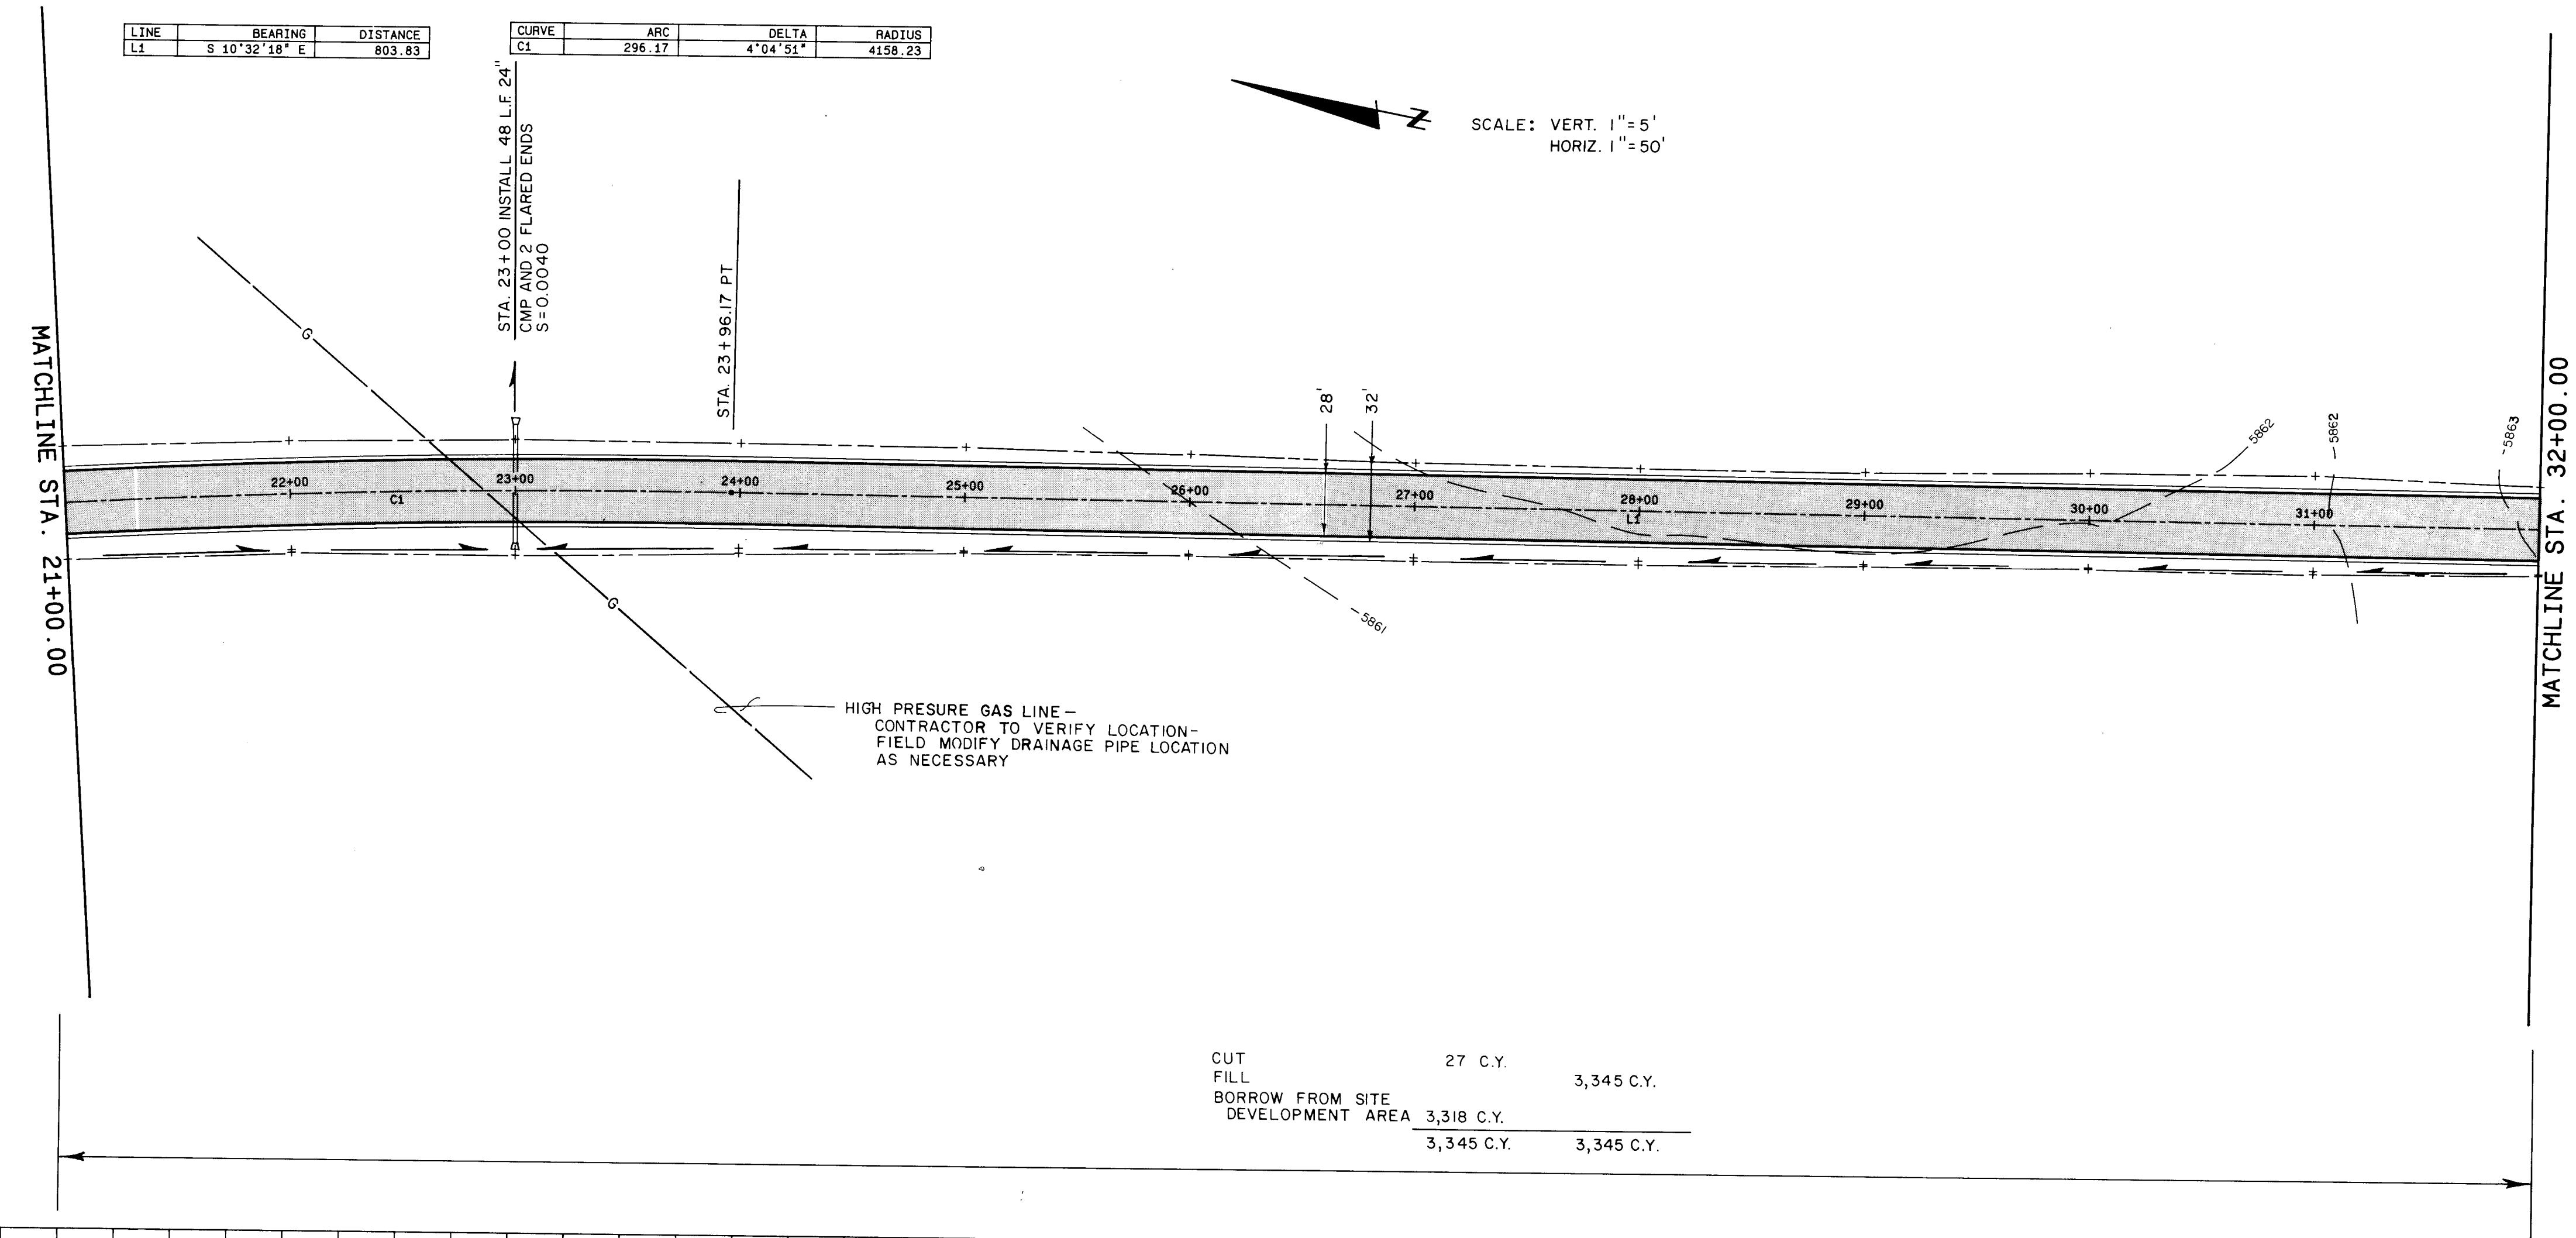

CUT 27 C.Y. 3,345 C.Y.
 FILL 3,345 C.Y.
 BORROW FROM SITE 3,318 C.Y.
 DEVELOPMENT AREA 3,345 C.Y.

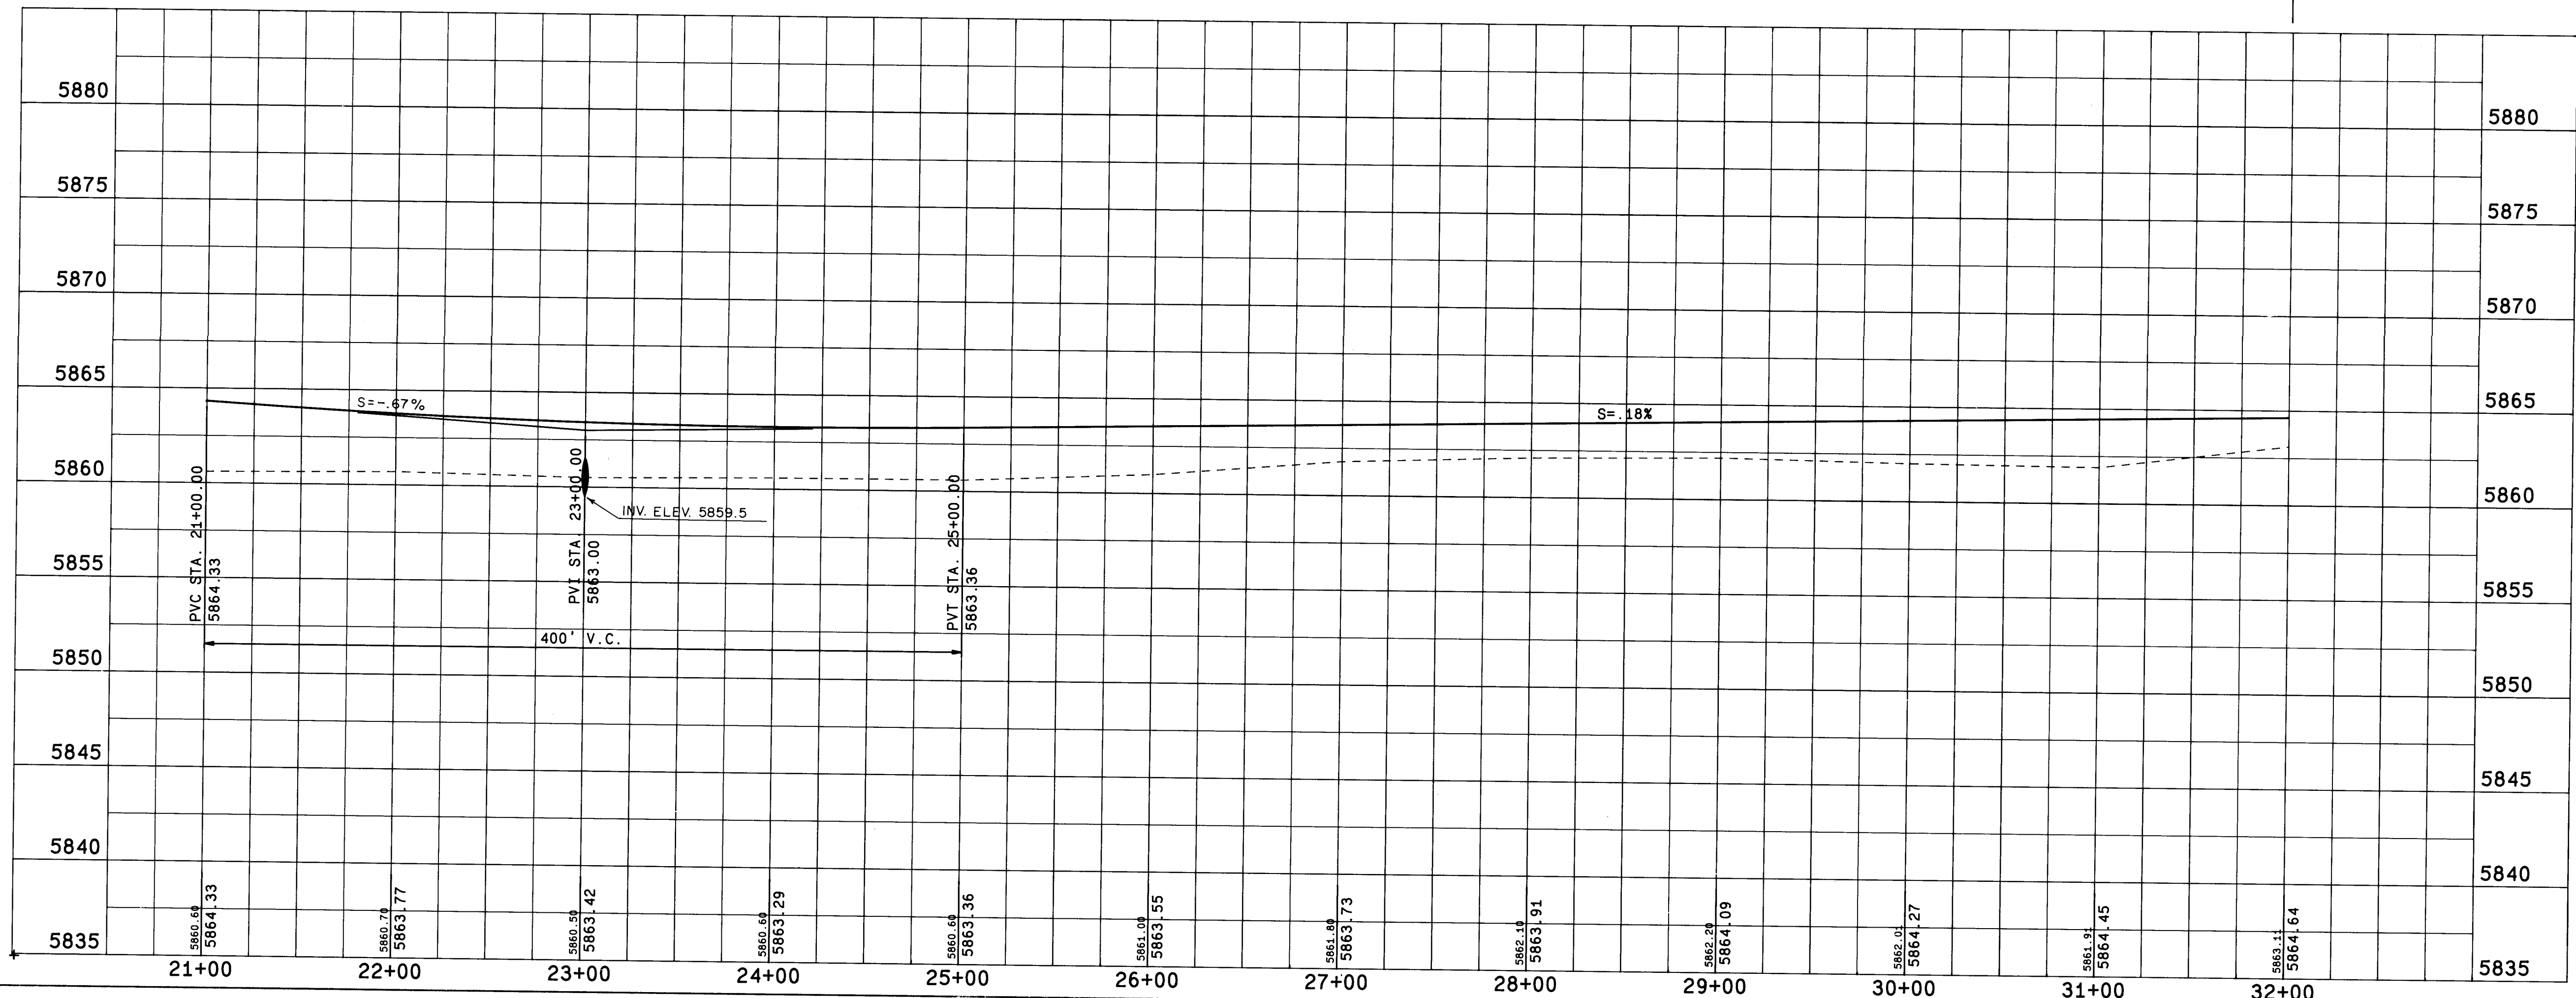

SEE SHEET 4 FOR LEGEND

AS BUILT INFORMATION		BENCH MARKS		SURVEY INFORMATION		FIELD NOTES		DATE	
CONTRACTOR	DATE	NO.	BY	NO.	BY	NO.	BY	NO.	BY
DATE	DATE	DATE	DATE	DATE	DATE	DATE	DATE	DATE	DATE
DATE	DATE	DATE	DATE	DATE	DATE	DATE	DATE	DATE	DATE
AS BUILT INFORMATION		BENCH MARKS		SURVEY INFORMATION		FIELD NOTES		DATE	
CONTRACTOR	DATE	NO.	BY	NO.	BY	NO.	BY	NO.	BY
DATE	DATE	DATE	DATE	DATE	DATE	DATE	DATE	DATE	DATE
DATE	DATE	DATE	DATE	DATE	DATE	DATE	DATE	DATE	DATE
ENGINEER'S SEAL		REVISIONS		DATE	
NO.	DATE	NO.	DATE	NO.	DATE
NO.	DATE	NO.	DATE	NO.	DATE
C of A PWD Maps & Records
 1 2 3 4 5 6 7 8 9 10 11 12
 2 2 3 4 5 6 7 8 9 10 11 12

RECORD DRAWING
 DATE: MARCH, 1992 DRAFTED BY: D. SALAZAR
 THESE RECORD DRAWINGS HAVE BEEN PREPARED, IN PART, ON THE BASIS OF INFORMATION COMPILED AND FURNISHED BY OTHERS. THE ENGINEER WILL NOT BE RESPONSIBLE FOR ANY ERRORS OR OMISSIONS WHICH HAVE BEEN INCORPORATED INTO THIS DOCUMENT AS A RESULT.



CITY OF ALBUQUERQUE, NEW MEXICO
SOLIDS HANDLING FACILITIES
 PHASE II B-3, CONTRACT 2



MOLZEN-CORBIN
STANLEY CONSULTANTS
 A JOINT VENTURE



CITY OF ALBUQUERQUE
 PUBLIC WORKS DEPARTMENT
 LIQUID WASTE DIVISION

TITLE: **PLAN AND PROFILE**
SAF ACCESS ROAD

APPROVALS	ENGINEER	DATE	APPROVALS	ENGINEER	DATE
City Engineer			Liquid Waste		
A.C.E.-Design			Traffic		
A.C.E.-Hydrology			Water		

DRAWING NO. **3406** MAP NO. SHEET 5 OF 27

LINE	BEARING	DISTANCE
L1	S 10°32'18" E	860.89
L2	S 10°32'18" E	239.11

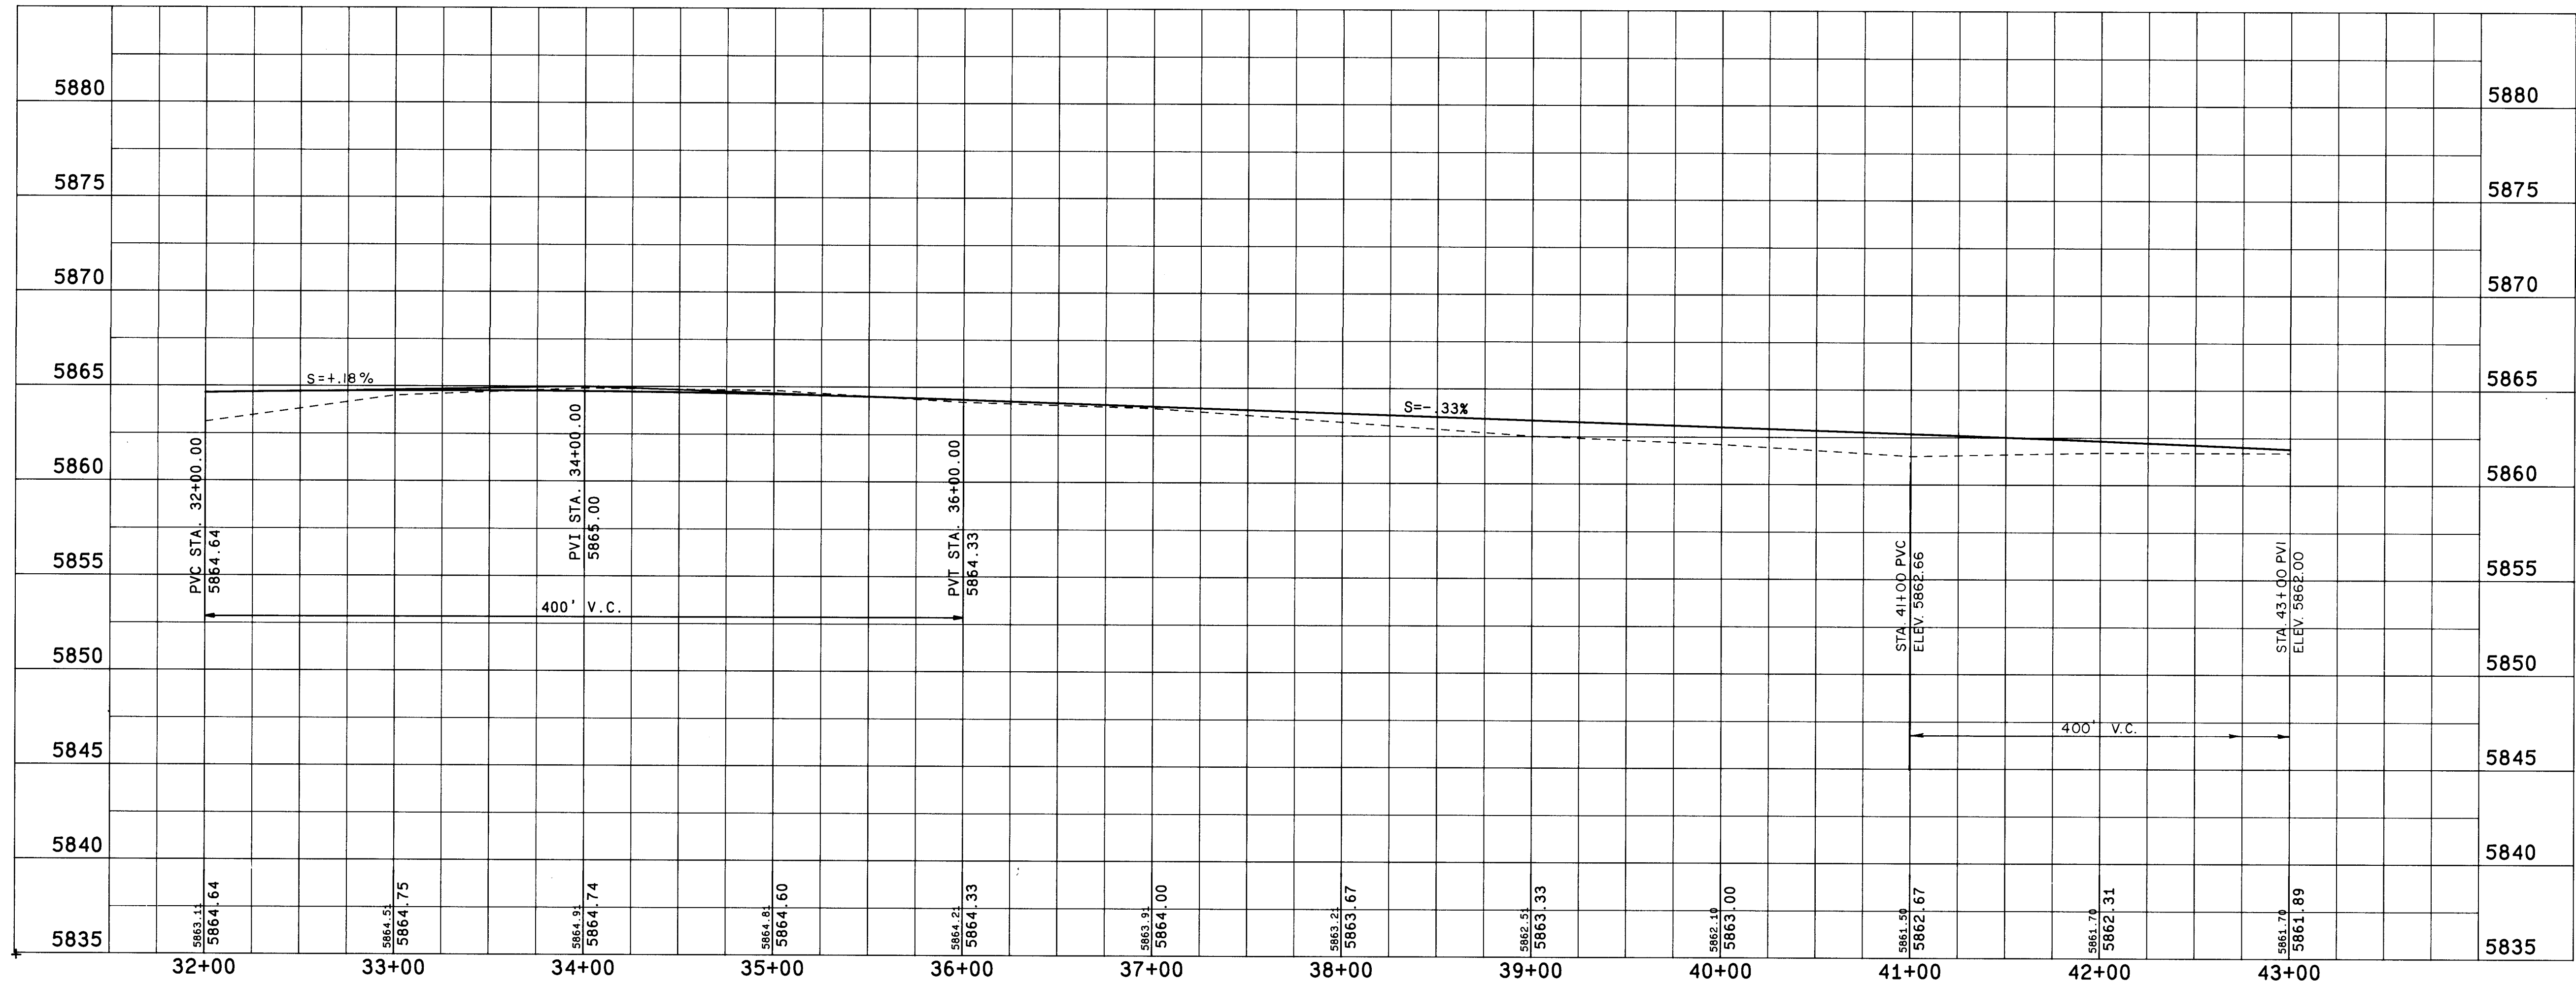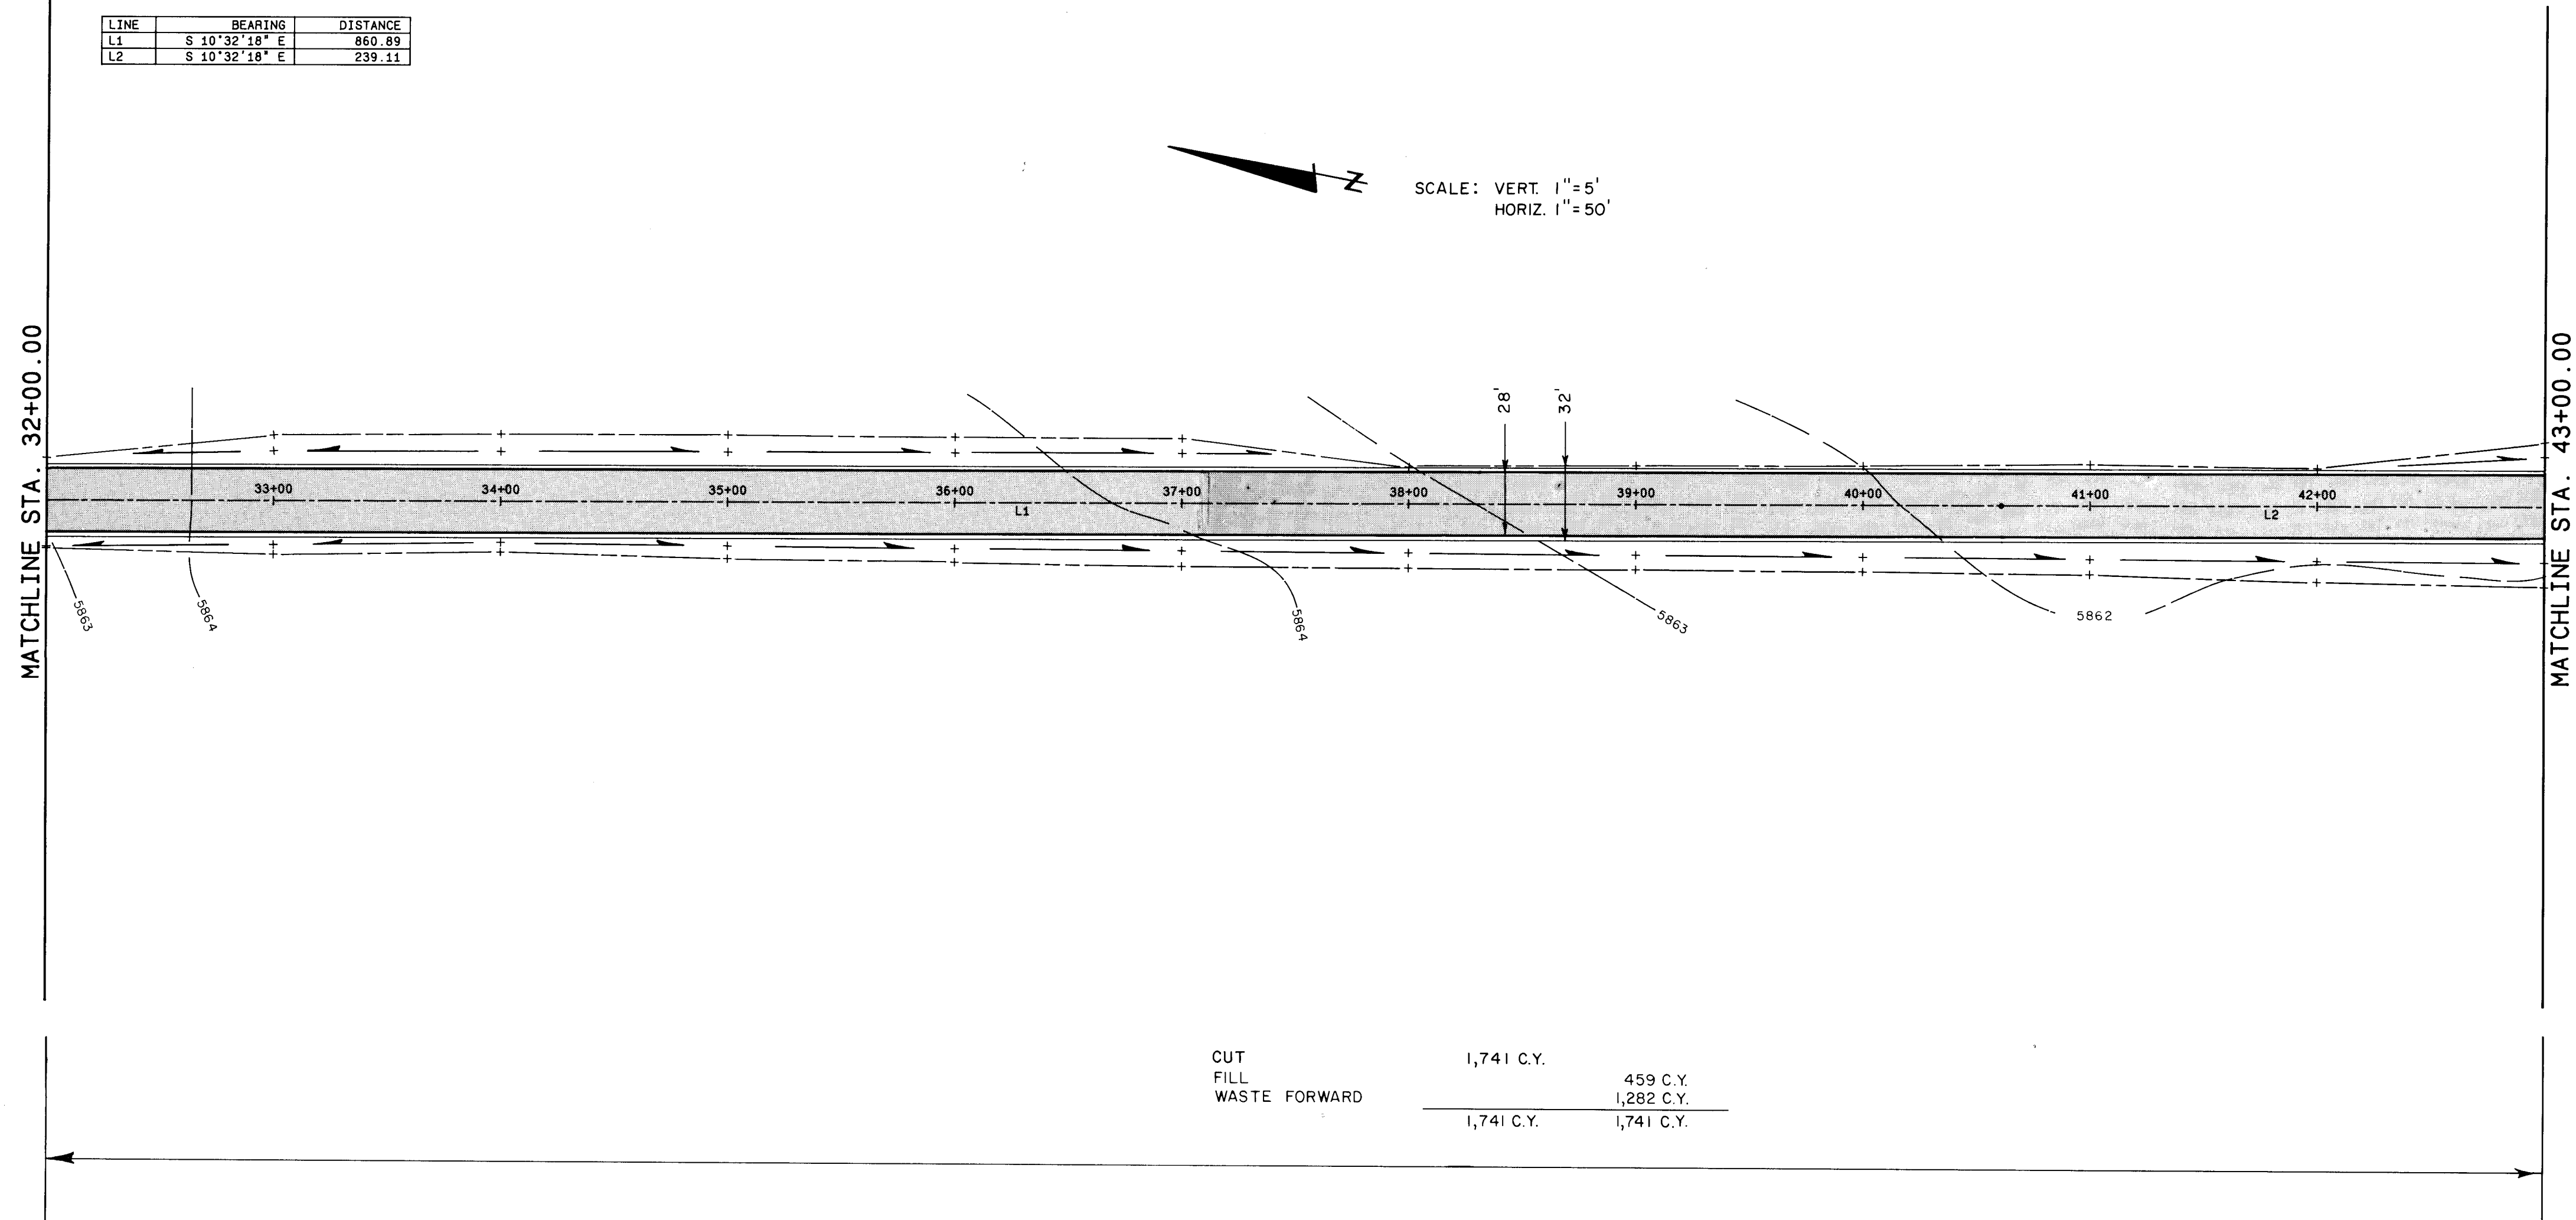

SEE SHEET 4 FOR LEGEND

ENGINEER'S SEAL		SURVEY INFORMATION		BENCH MARKS		AS BUILT INFORMATION	
		FIELD NOTES		SEE SHEET 4		CONTRACTOR	
		NO.	BY	DATE	NO.	BY	DATE
REVISIONS		NO.		NO.		NO.	
DESIGN		BY		BY		BY	
DATE		DATE		DATE		DATE	
DESIGNED BY K.W.C.		DATE 10/12/87		DATE		DATE	
DRAWN BY		DATE		DATE		DATE	
CHECKED BY		DATE		DATE		DATE	

C of A PWD Maps & Records
1 2 3 4 5 6 7 8 9 10 11 12
26 34 06 27 2

RECORD DRAWING
DATE: MARCH, 1992 DRAFTED BY: R. SALAZAR
THESE RECORD DRAWINGS HAVE BEEN PREPARED, IN PART, ON THE BASIS OF INFORMATION COMPILED AND FURNISHED BY OTHERS. THE ENGINEER WILL NOT BE RESPONSIBLE FOR ANY ERRORS OR OMISSIONS WHICH HAVE BEEN INCORPORATED INTO THIS DOCUMENT AS A RESULT.



CITY OF ALBUQUERQUE, NEW MEXICO
SOLIDS HANDLING FACILITIES
PHASE II B-3, CONTRACT 2



MOLZEN-CORBIN
STANLEY CONSULTANTS
A JOINT VENTURE

CITY OF ALBUQUERQUE
PUBLIC WORKS DEPARTMENT
LIQUID WASTE DIVISION


TITLE: **PLAN AND PROFILE
SAF ACCESS ROAD**

APPROVALS	ENGINEER	DATE	APPROVALS	ENGINEER	DATE
City Engineer			Liquid Waste		
A.C.E.—Design			Traffic		
A.C.E.—Hydrology			Water		


DRAWING NO. **3406** MAP NO. SHEET 6 OF 27

LINE	BEARING	DISTANCE
L1	S 10°32'18" E	398.45
L2	S 10°32'18" E	701.55


 SCALE: VERT. 1"=5'
 HORIZ. 1"=50'

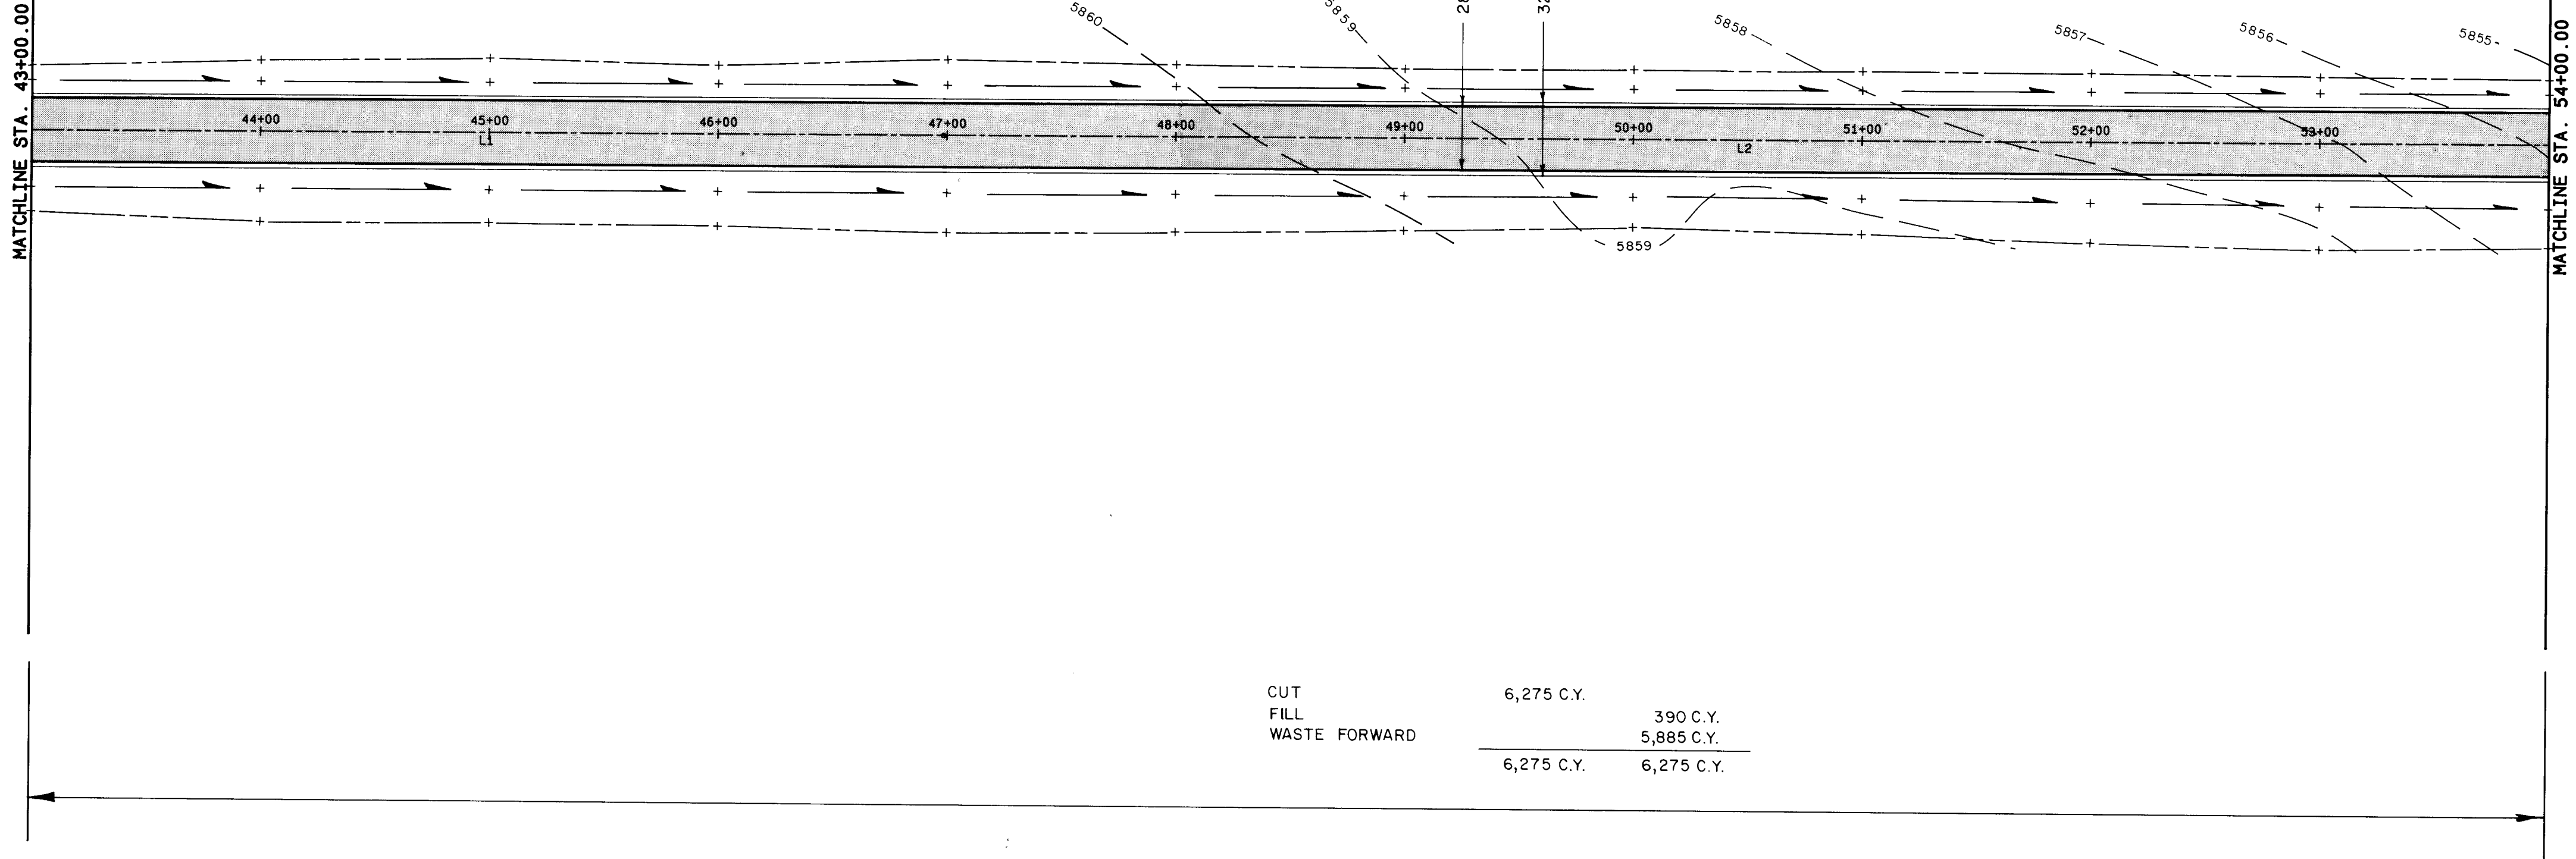

CUT	6,275 C.Y.
FILL	390 C.Y.
WASTE FORWARD	5,885 C.Y.
	6,275 C.Y.

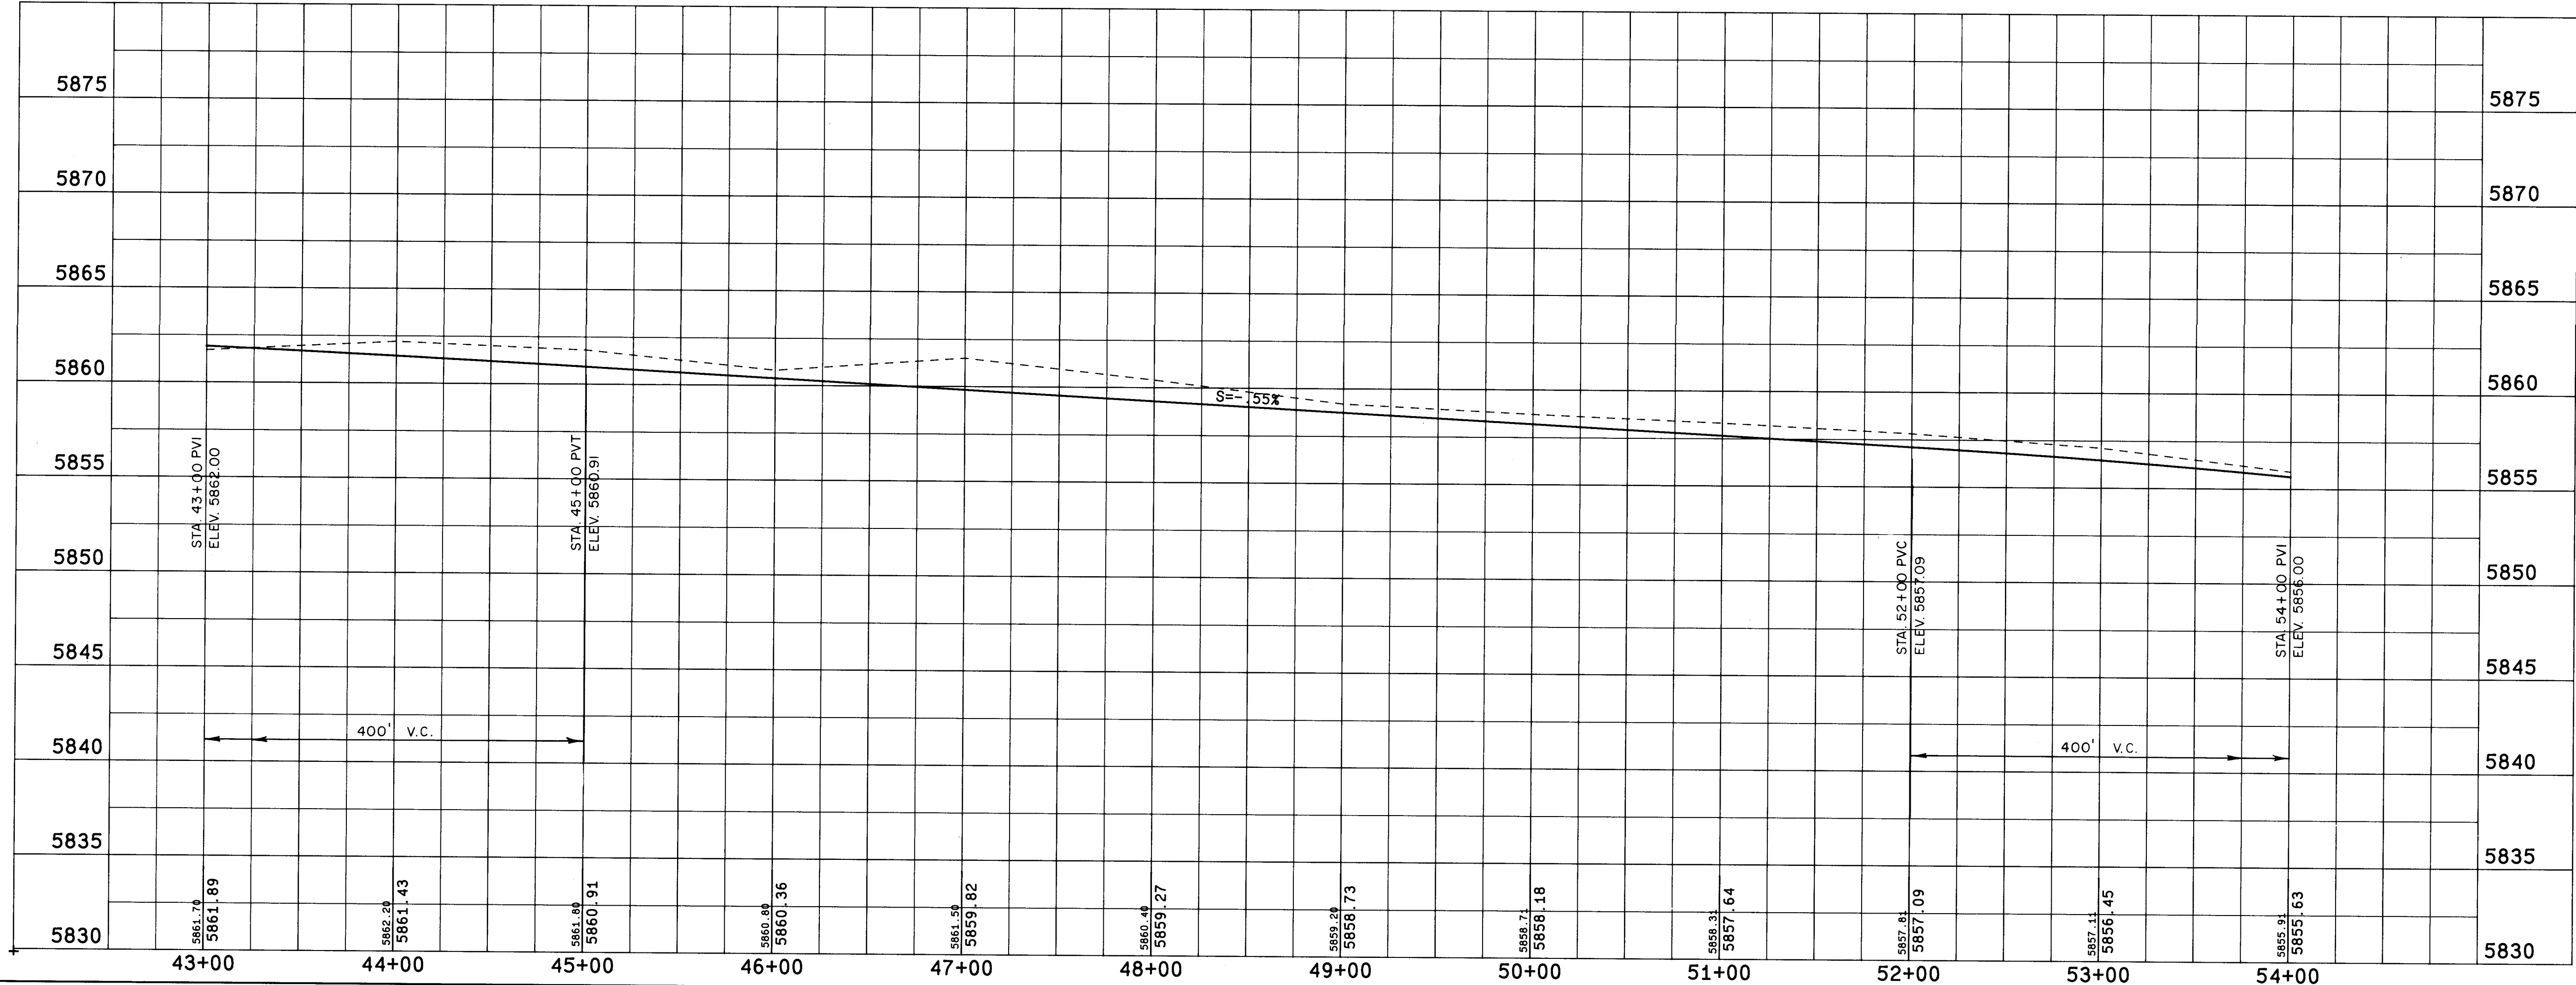


SEE SHEET 4 FOR LEGEND

AS BUILT INFORMATION	
CONTRACTOR	NO.
WORKED BY	DATE
INSPECTOR'S	DATE
ACCEPTANCE BY	DATE
VERIFICATION BY	DATE
DRAWINGS	DATE
REVISIONS	DATE
RECORDED BY	NO.

BENCH MARKS	
SEE SHEET 4	

SURVEY INFORMATION	
FIELD NOTES	DATE
BY	
NO.	

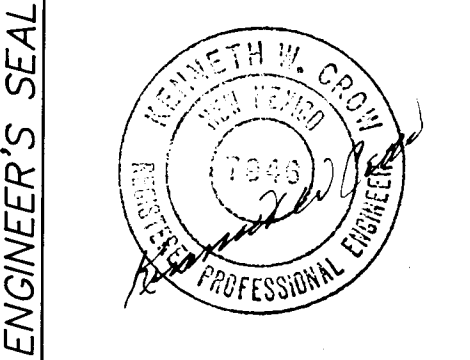

ENGINEER'S SEAL	
REVISIONS	BY
NO.	DATE
DESIGNED BY	DATE
DRAWN BY	DATE
CHECKED BY	DATE

C of A PWD Maps & Records											
1	2	3	4	5	6	7	8	9	10	11	12
2	6	3	9	0	6	0	7	9	2		

RECORD DRAWING

DATE: MARCH 1992
 DRAFTED BY: D. SALAZAR

THESE RECORD DRAWINGS HAVE BEEN PREPARED, IN PART, ON THE BASIS OF INFORMATION COMPILED AND FURNISHED BY OTHERS. THE ENGINEER WILL NOT BE RESPONSIBLE FOR ANY ERRORS OR OMISSIONS WHICH HAVE BEEN INCORPORATED INTO THIS DOCUMENT AS A RESULT.



CITY OF ALBUQUERQUE, NEW MEXICO
 SOLIDS HANDLING FACILITIES
 PHASE II B-3, CONTRACT 2



MOLZEN-CORBIN
 STANLEY CONSULTANTS
 A JOINT VENTURE

CITY OF ALBUQUERQUE
 PUBLIC WORKS DEPARTMENT
 LIQUID WASTE DIVISION

TITLE: PLAN AND PROFILE
 SAF ACCESS ROAD

APPROVALS	ENGINEER	DATE	APPROVALS	ENGINEER	DATE
City Engineer			Liquid Waste		
A.C.E.-Design			Traffic		
A.C.E.-Hydrology			Water		

DRAWING NO. 3406
 MAP NO.
 SHEET 7 OF 27

SEE SHEET 4 FOR LEGEND

C of A PWD Maps & Records
1 2 3 4 5 6 7 8 9 10 11 12
26 34 06 08 9 2

RECORD DRAWING
DATE: MARCH 1997 DRAFTED BY: P. SALAZAR
THESE RECORD DRAWINGS HAVE BEEN PREPARED, IN PART, ON THE BASIS OF INFORMATION COMPILED AND FURNISHED BY OTHERS. THE ENGINEER WILL NOT BE RESPONSIBLE FOR ANY ERRORS OR OMISSIONS WHICH HAVE BEEN INCORPORATED INTO THIS DOCUMENT AS A RESULT.

CITY OF ALBUQUERQUE, NEW MEXICO
SOLIDS HANDLING FACILITIES
PHASE II B-3, CONTRACT 2

MOLZEN-CORBIN
STANLEY CONSULTANTS
A JOINT VENTURE

CITY OF ALBUQUERQUE
PUBLIC WORKS DEPARTMENT
LIQUID WASTE DIVISION

TITLE: PLAN AND PROFILE
SAF ACCESS ROAD

APPROVALS	ENGINEER	DATE	APPROVALS	ENGINEER	DATE
City Engineer			Liquid Waste		
A.C.E.—Design			Traffic		
A.C.E.—Hydrology			Water		



DRAWING NO. 3406 MAP NO. SHEET 8 OF 27

AS BUILT INFORMATION	
CONTRACTOR	NO.
WORKED BY	DATE
INSPECTOR'S	DATE
ACCEPTANCE BY	DATE
VERIFICATION BY	DATE
DRAWN BY	DATE
RECORDED BY	DATE
MICRO-FILM INFORMATION	
NO.	DATE

SURVEY INFORMATION	
FIELD NOTES	DATE
BY	DATE
NO.	DATE

BENCH MARKS	
SEE SHEET 4	DATE
NO.	DATE


ENGINEER'S SEAL	
NO.	DATE
REMARKS	DATE
REVISIONS	DATE
DESIGN	DATE

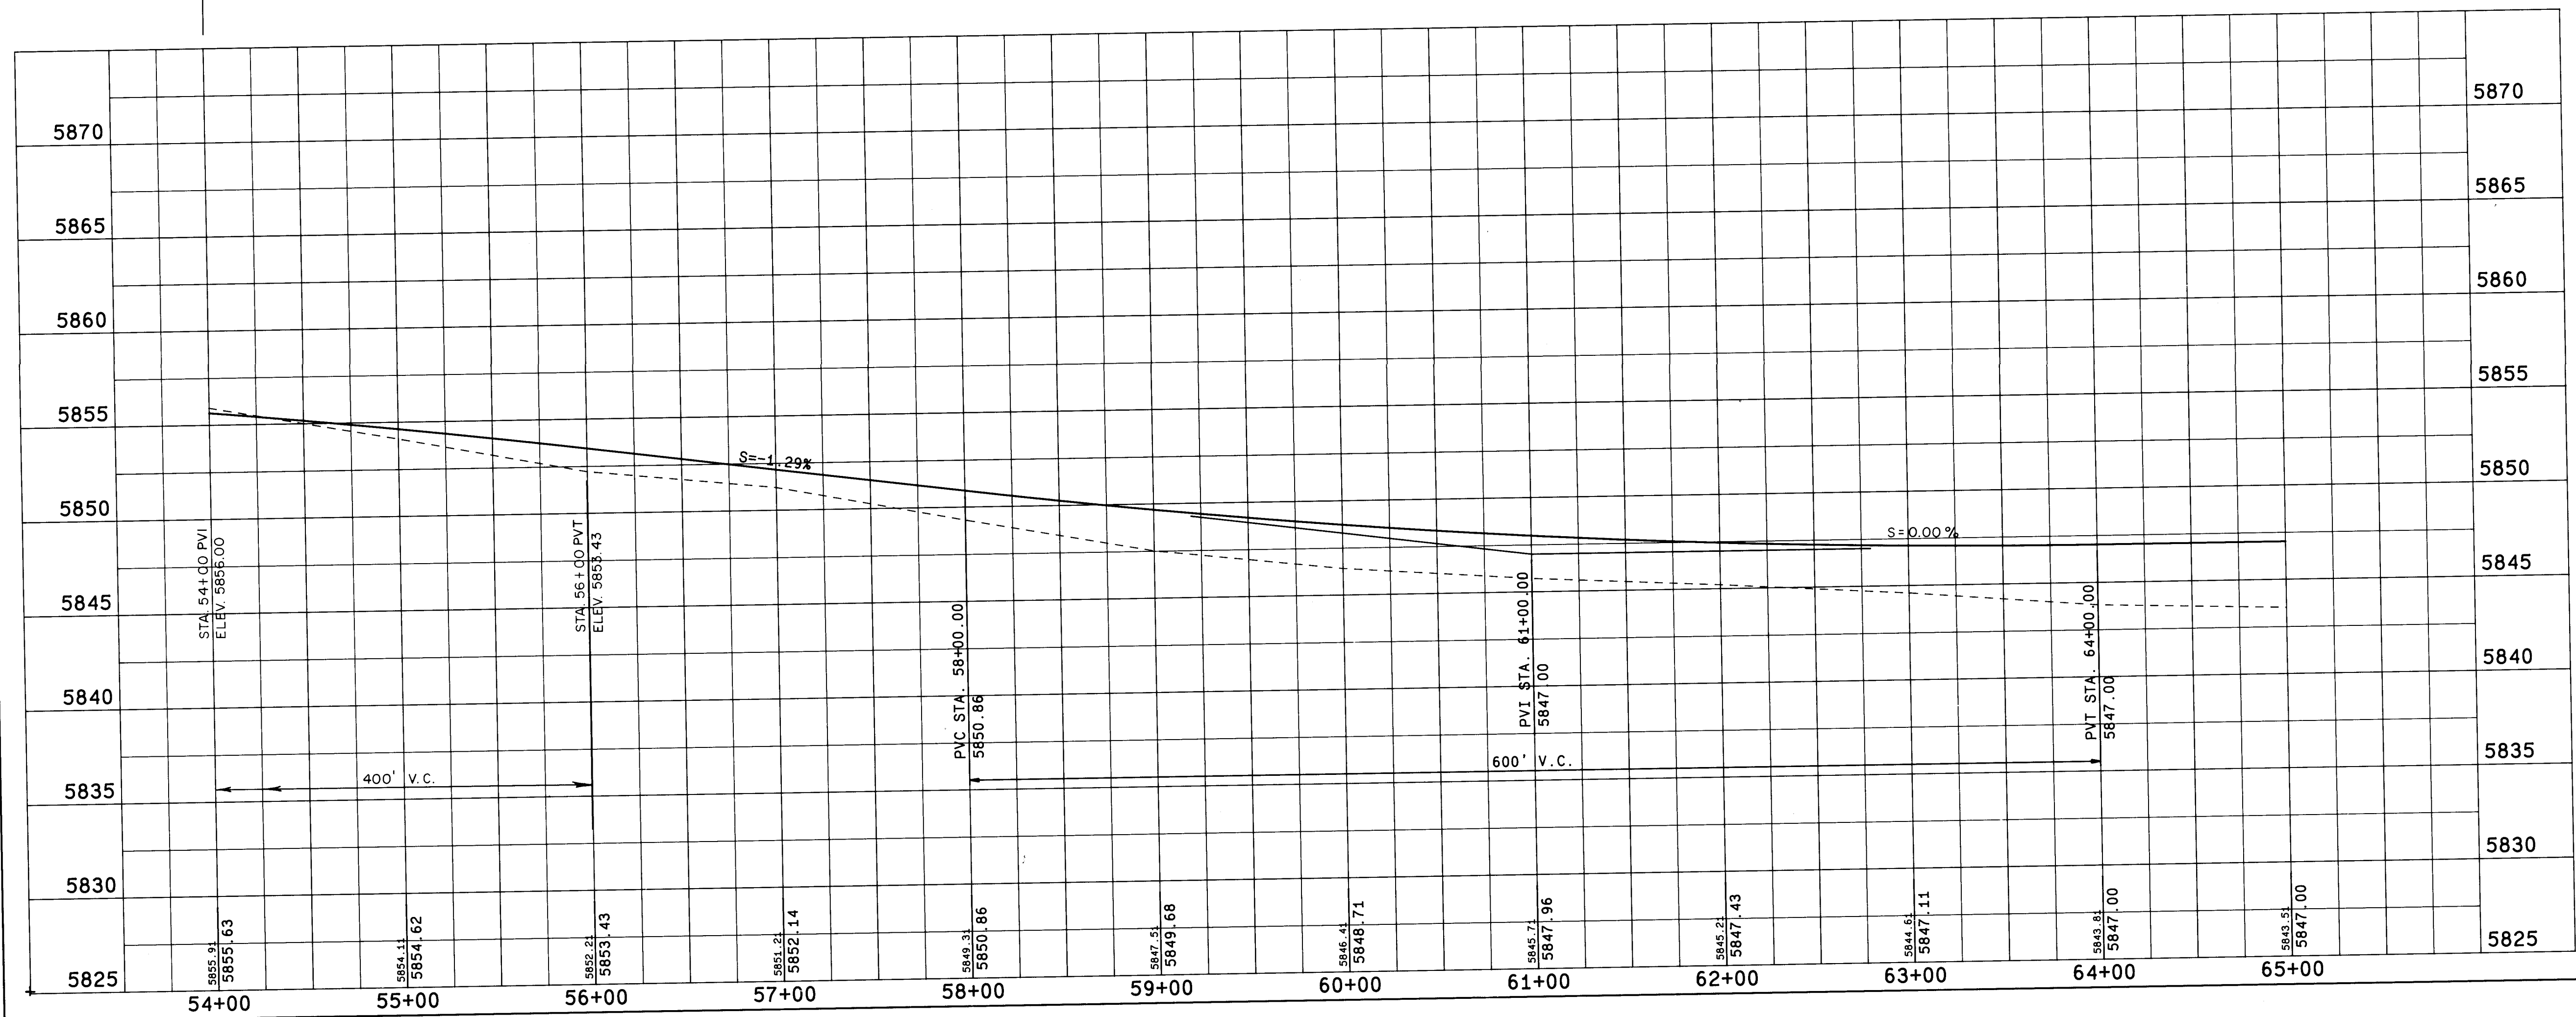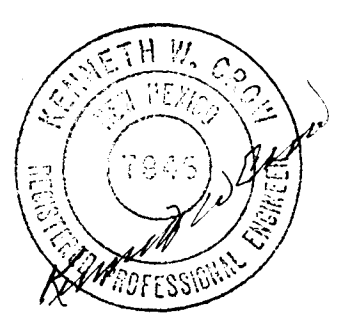

LINE	BEARING	DISTANCE
L1	S 10°32'18" E	1100.00

SCALE: VERT. 1"=5'
HORIZ. 1"=50'

CUT	1,235 C.Y.	2,319 C.Y.
FILL	1,084 C.Y.	2,319 C.Y.
BORROW BACK	2,319 C.Y.	2,319 C.Y.

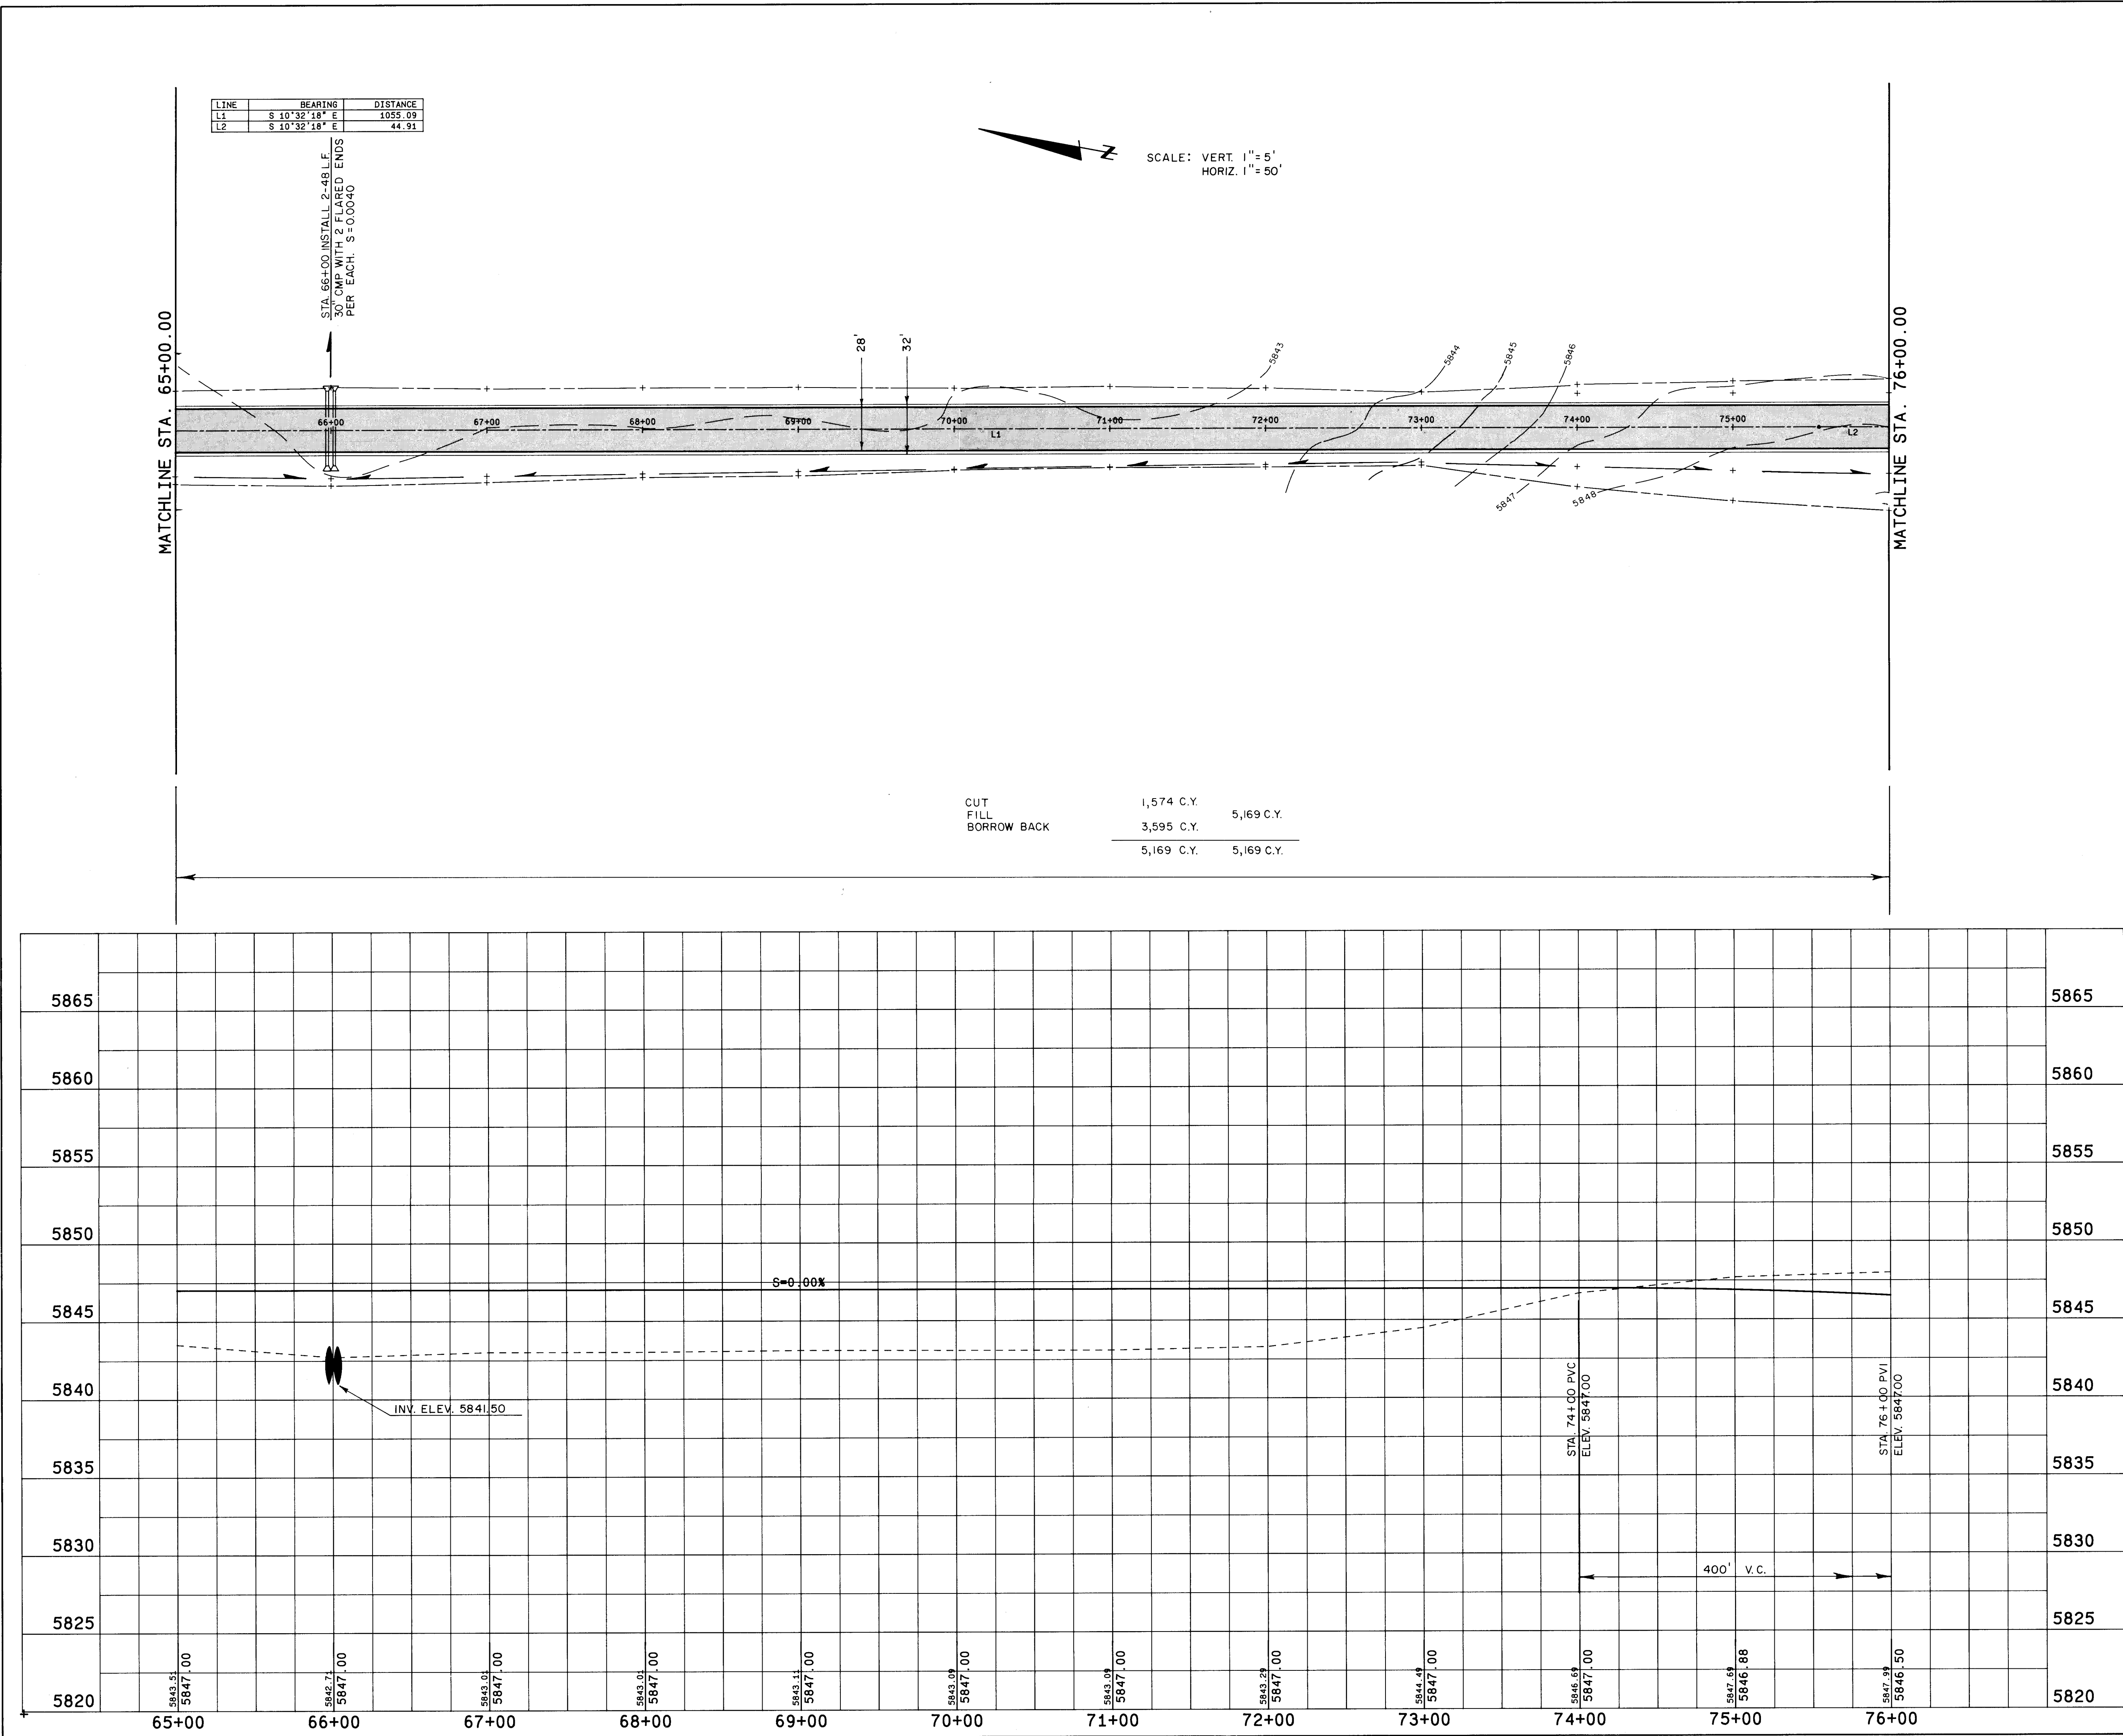

SEE SHEET 4 FOR LEGEND

C of A PWD Maps & Records
1 2 3 4 5 6 7 8 9 10 11 12
26 34 06 07 72

RECORD DRAWING

DATE: MARCH 1992 DRAFTED BY: D. SALAZAR

THESE RECORD DRAWINGS HAVE BEEN PREPARED, IN PART, ON THE BASIS OF INFORMATION COMPILED AND FURNISHED BY OTHERS. THE ENGINEER WILL NOT BE RESPONSIBLE FOR ANY ERRORS OR OMISSIONS WHICH HAVE BEEN INCORPORATED INTO THIS DOCUMENT AS A RESULT.



CITY OF ALBUQUERQUE, NEW MEXICO
SOLIDS HANDLING FACILITIES
PHASE II B-3, CONTRACT 2



MOLZEN-CORBIN
STANLEY CONSULTANTS
A JOINT VENTURE


CITY OF ALBUQUERQUE
PUBLIC WORKS DEPARTMENT
LIQUID WASTE DIVISION

TITLE: PLAN AND PROFILE
SAF ACCESS ROAD

APPROVALS	ENGINEER	DATE	APPROVALS	ENGINEER	DATE
City Engineer			Liquid Waste		
A.C.E.-Design			Traffic		
A.C.E.-Hydrology			Water		

DRAWING NO. 3406 MAP NO. SHEET 9 OF 27

FILE LOAD		DIVISION		DEPARTMENT		PROJECT		ENGINEER'S SEAL		SURVEY INFORMATION		BENCH MARKS		AS BUILT INFORMATION	
DATE		ENGINEER		VALS		DATE		NO.		BY		SEE SHEET 4		CONTRACTOR	
CHECKED BY		DATE		DRAWN BY		DATE		DESIGNED BY K.W.C.		REVISIONS				WORK	
DATE		DATE		DATE		DATE		DATE		DATE				RECORDED BY	
DATE		DATE		DATE		DATE		DATE		DATE				NO.	
DATE		DATE		DATE		DATE		DATE		DATE				DATE	
DATE		DATE		DATE		DATE		DATE		DATE				DATE	
DATE		DATE		DATE		DATE		DATE		DATE					

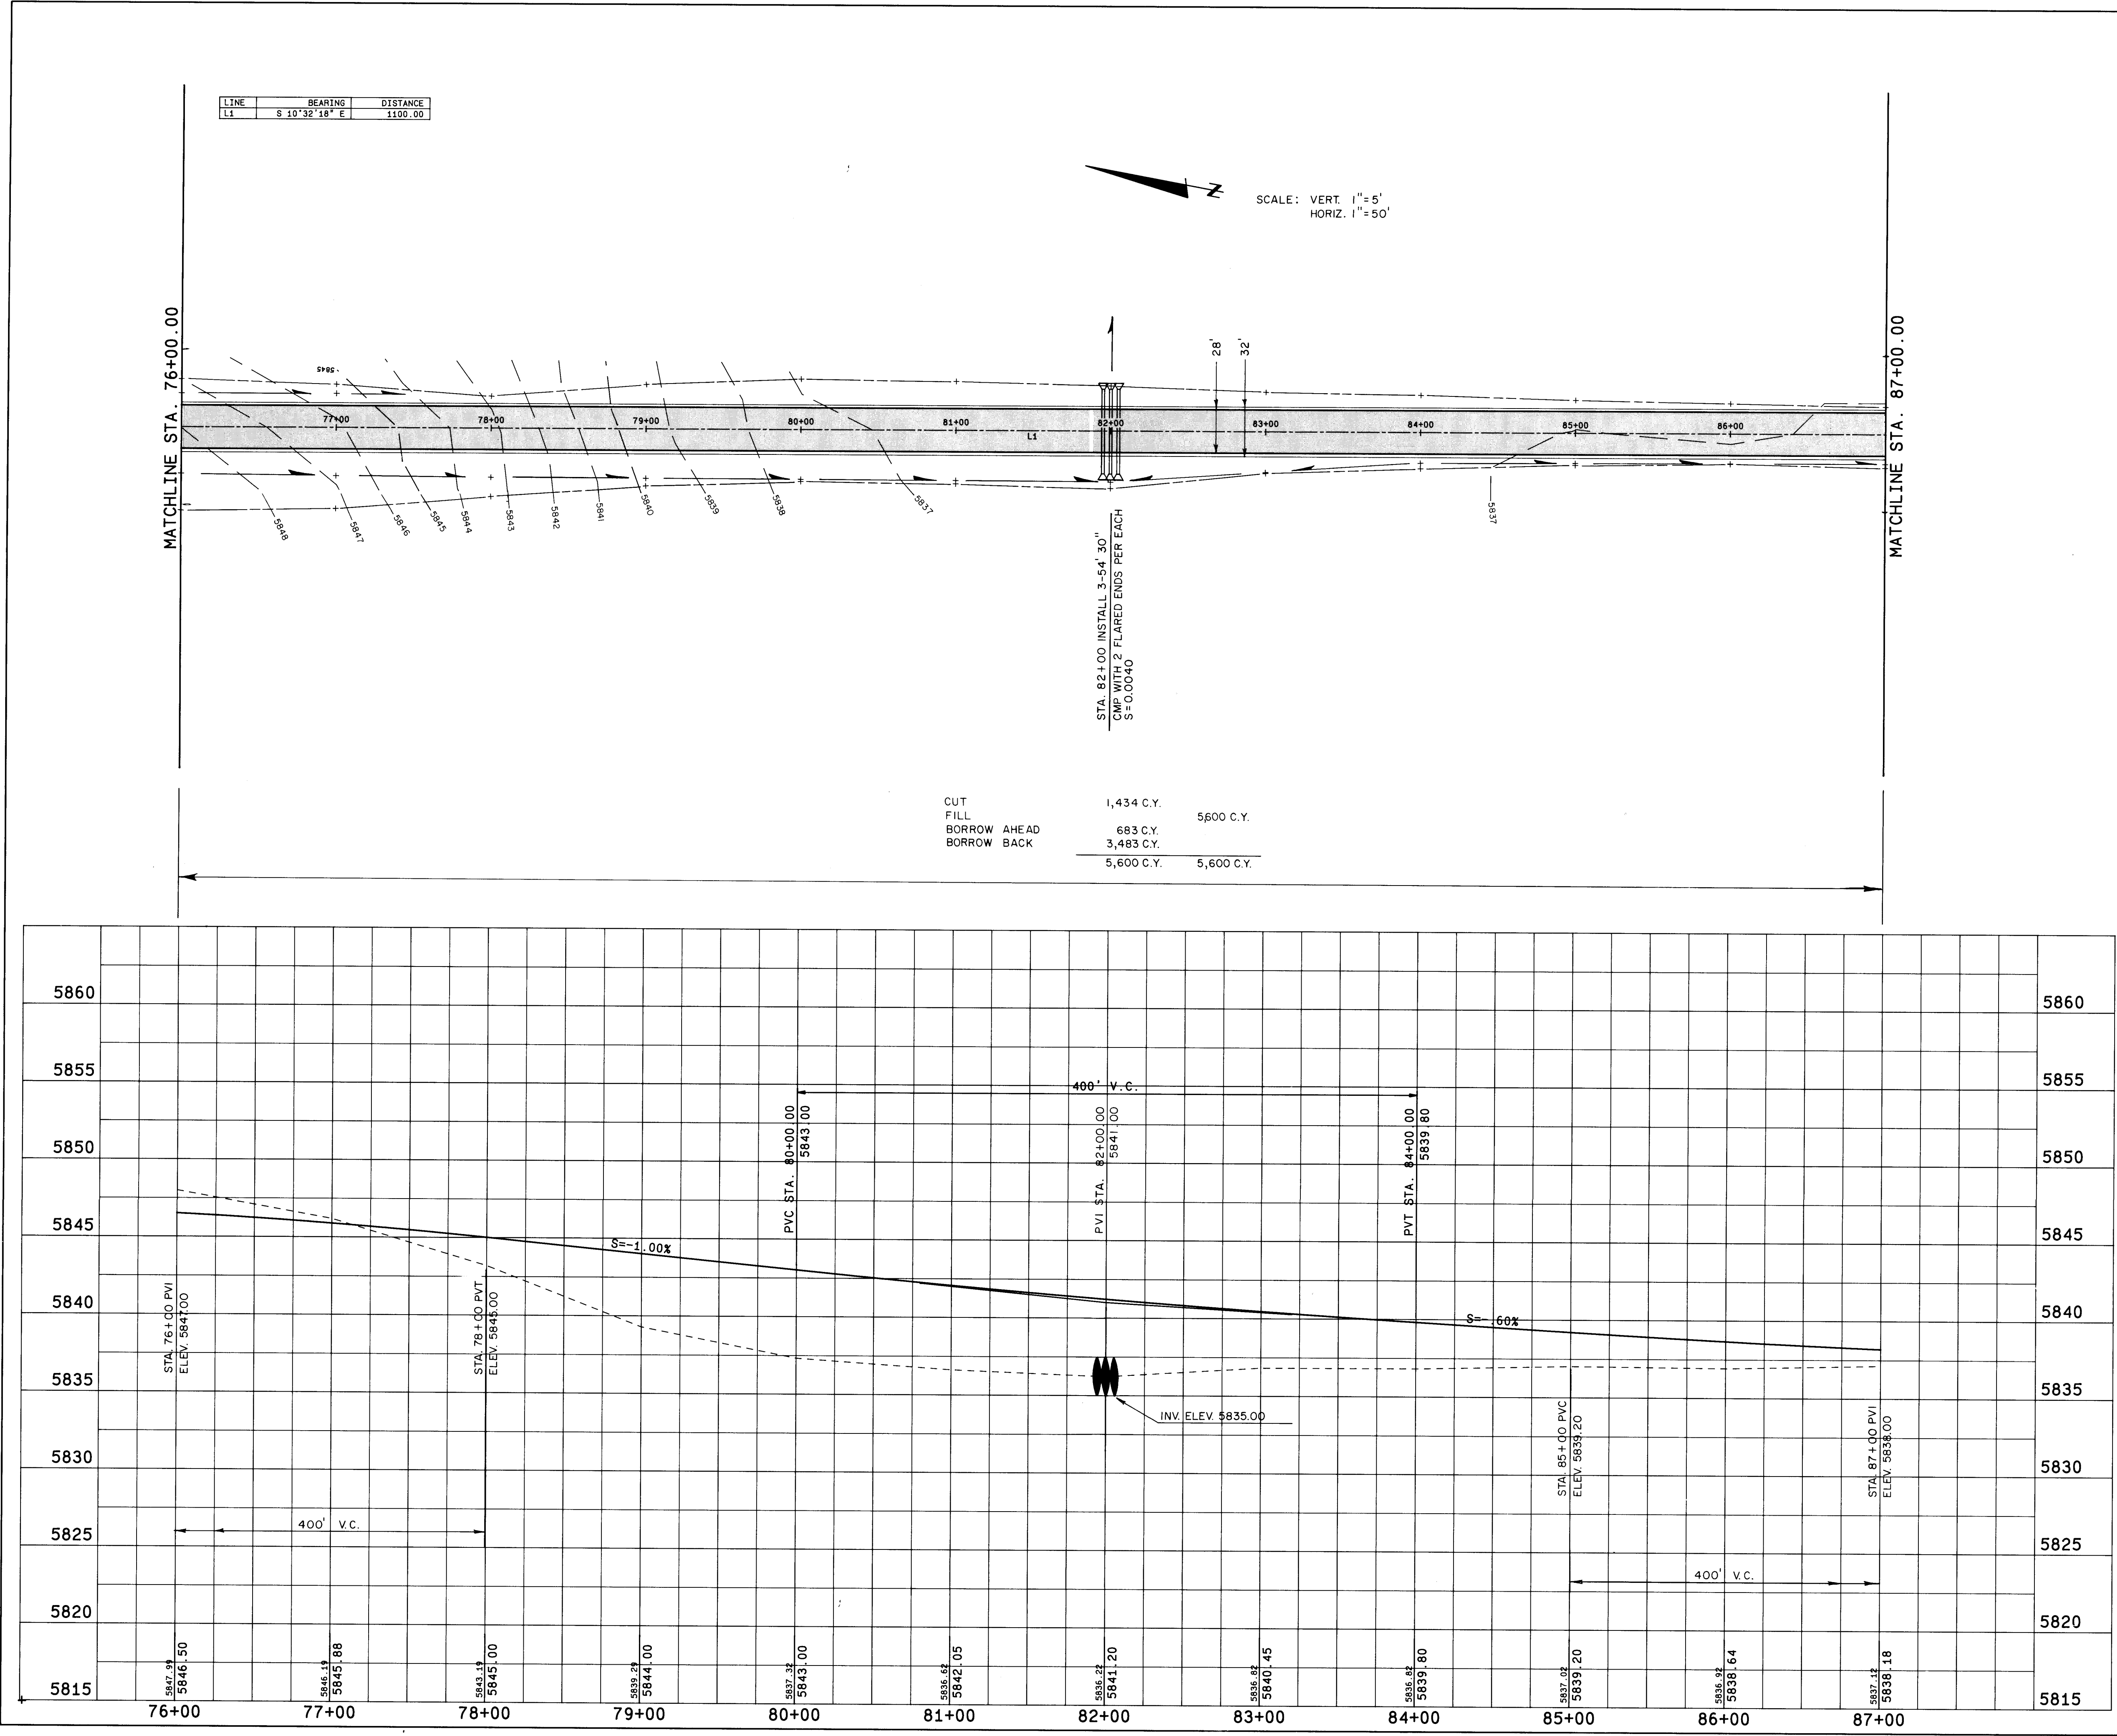

SEE SHEET 4 FOR LEGEND

AS BUILT INFORMATION

CONTRACTOR
WORKS BY
INSPECTOR'S
ACCEPTANCE BY
VERIFICATION BY
DRAWINGS
DATE
NO.

BENCH MARKS

SEE SHEET 4

SURVEY INFORMATION

FIELD NOTES
BY
DATE
NO.

ENGINEER'S SEAL

RECORD DRAWING

DATE: MARCH, 1992
DRAFTED BY: D. SALAZAR

THESE RECORD DRAWINGS HAVE BEEN PREPARED, IN PART, ON THE BASIS OF INFORMATION COMPILED AND FURNISHED BY OTHERS. THE ENGINEER WILL NOT BE RESPONSIBLE FOR ANY ERRORS OR OMISSIONS WHICH HAVE BEEN INCORPORATED INTO THIS DOCUMENT AS A RESULT.

CITY OF ALBUQUERQUE, NEW MEXICO
SOLIDS HANDLING FACILITIES
PHASE II B-3, CONTRACT 2

MOLZEN-CORBIN
STANLEY CONSULTANTS
A JOINT VENTURE

CITY OF ALBUQUERQUE
PUBLIC WORKS DEPARTMENT
LIQUID WASTE DIVISION

TITLE: PLAN AND PROFILE SAF ACCESS ROAD

APPROVALS

ENGINEER DATE APPROVALS ENGINEER DATE

City Engineer Liquid Waste

A.C.E.-Design Traffic

A.C.E.-Hydrology Water

DRAWING NO. 3406 MAP NO. SHEET 10 OF 27

DESIGNED BY K.W.C. DATE 10/12/87
DRAWN BY DATE
CHECKED BY DATE

REVISIONS

NO. DATE REMARKS BY

DESIGN

ENGINEER'S SEAL


HEMMETH W. CORBIN
1946
PROFESSIONAL ENGINEER

MICRO-FILM INFORMATION


DATE
NO.

LINE	BEARING	DISTANCE
L1	S 10° 32' 18" E	578.02
L2	S 10° 32' 18" E	521.98

MATCHLINE STA. 87+00.00

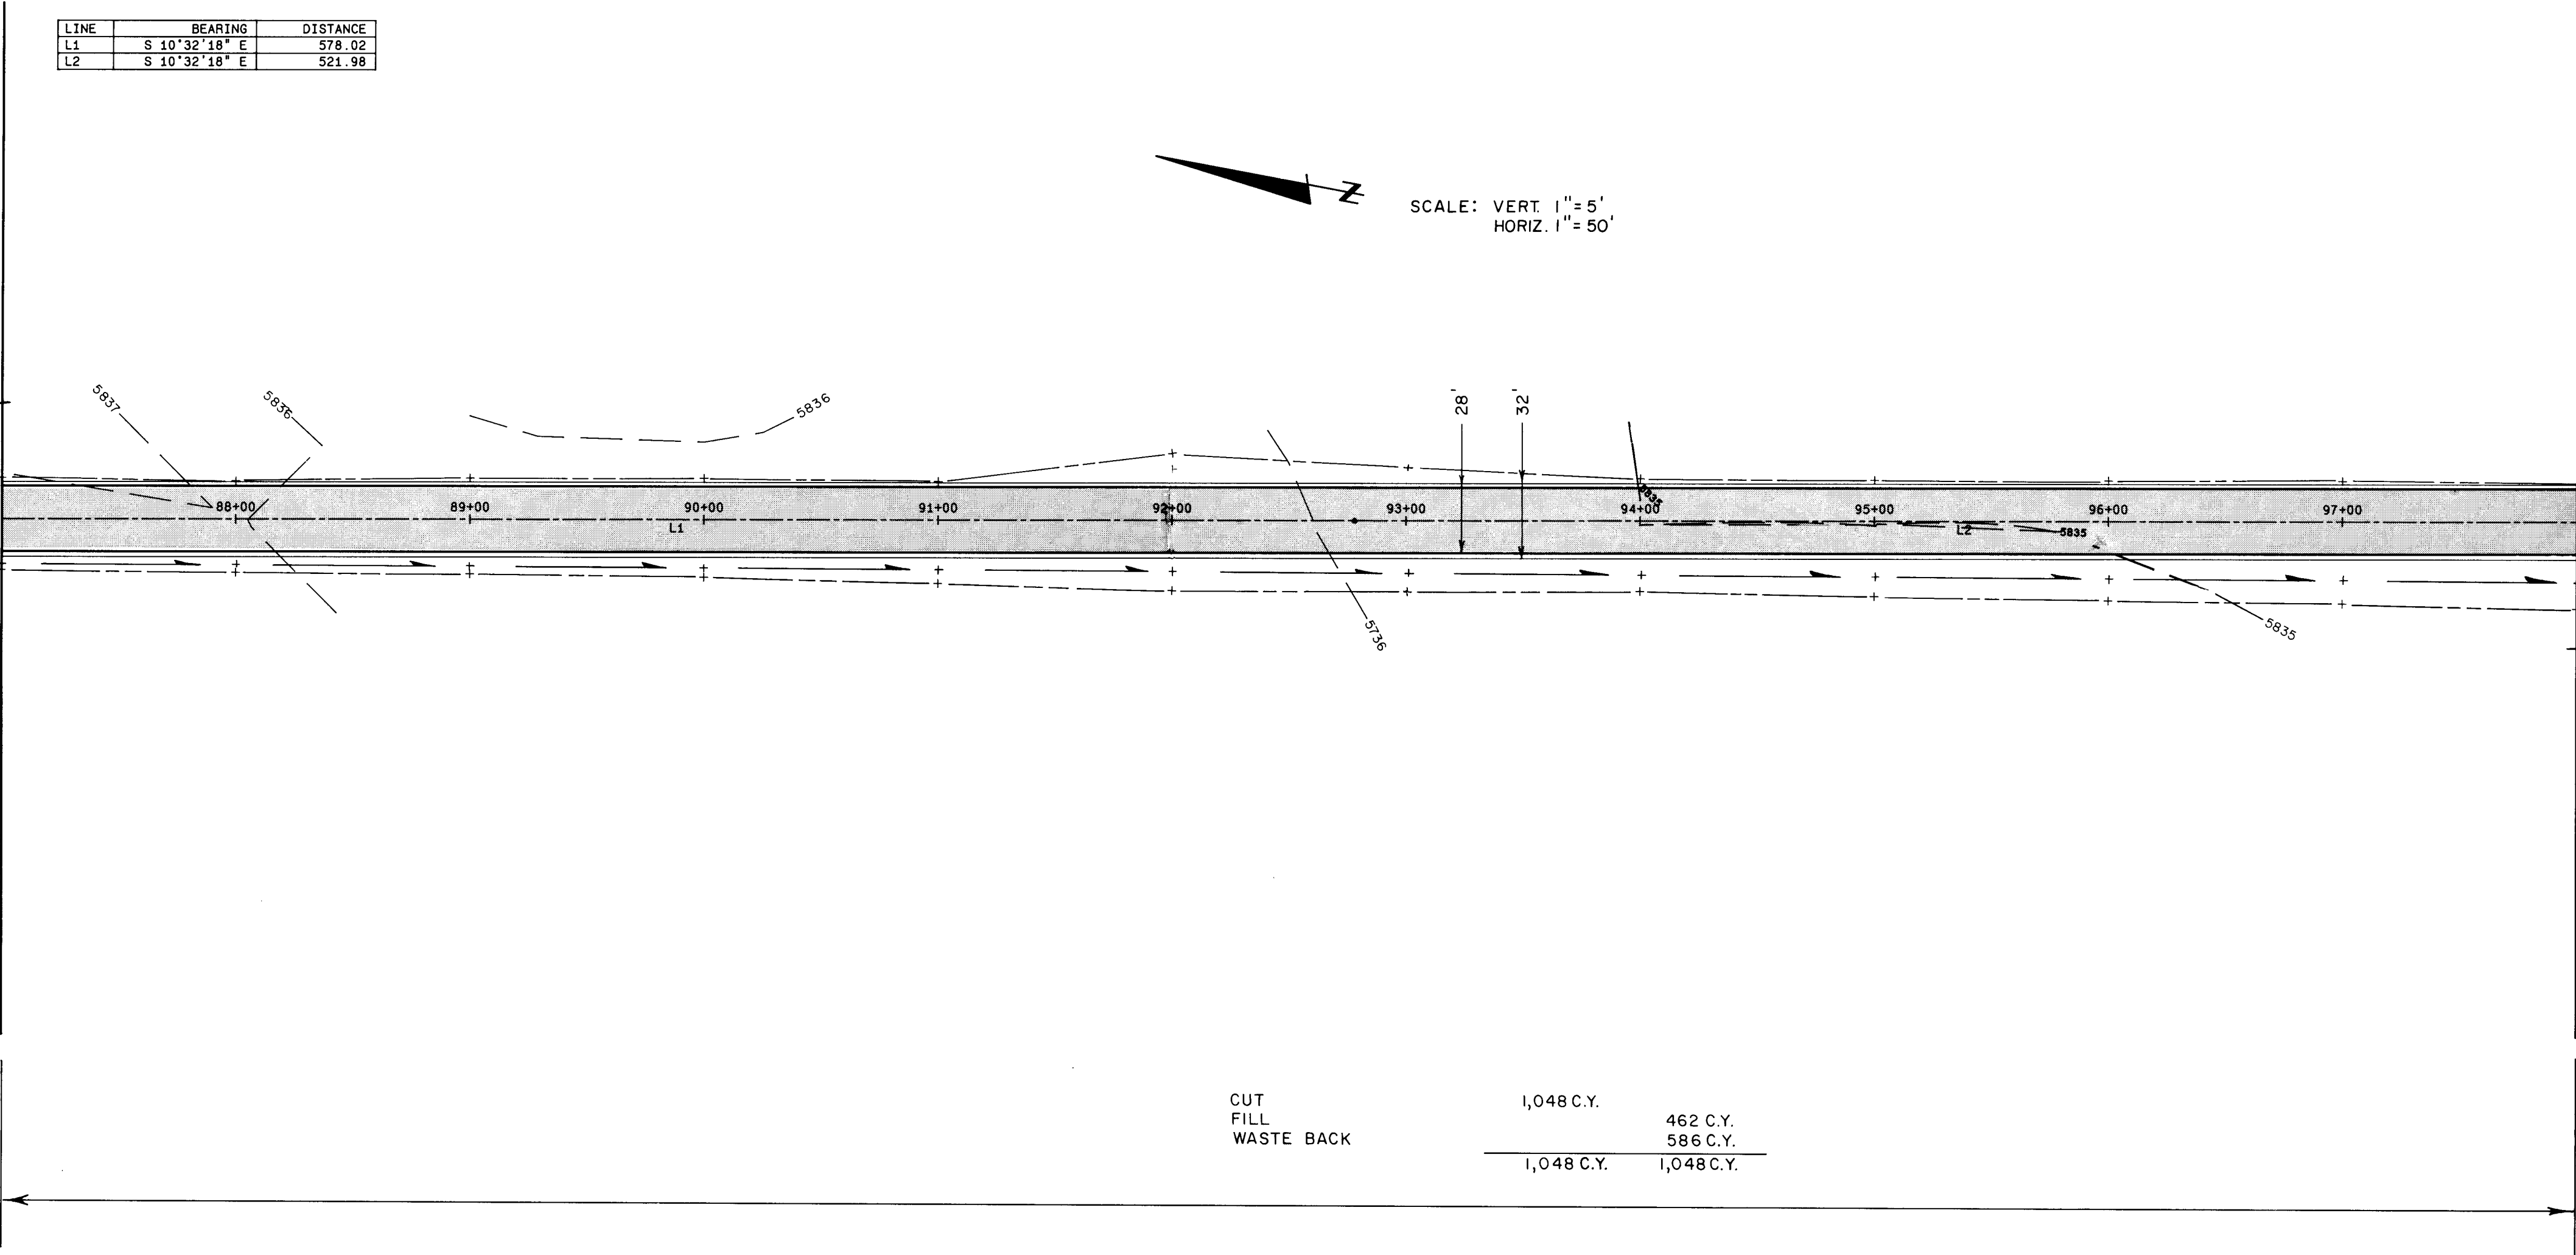

MATCHLINE STA. 98+00.00

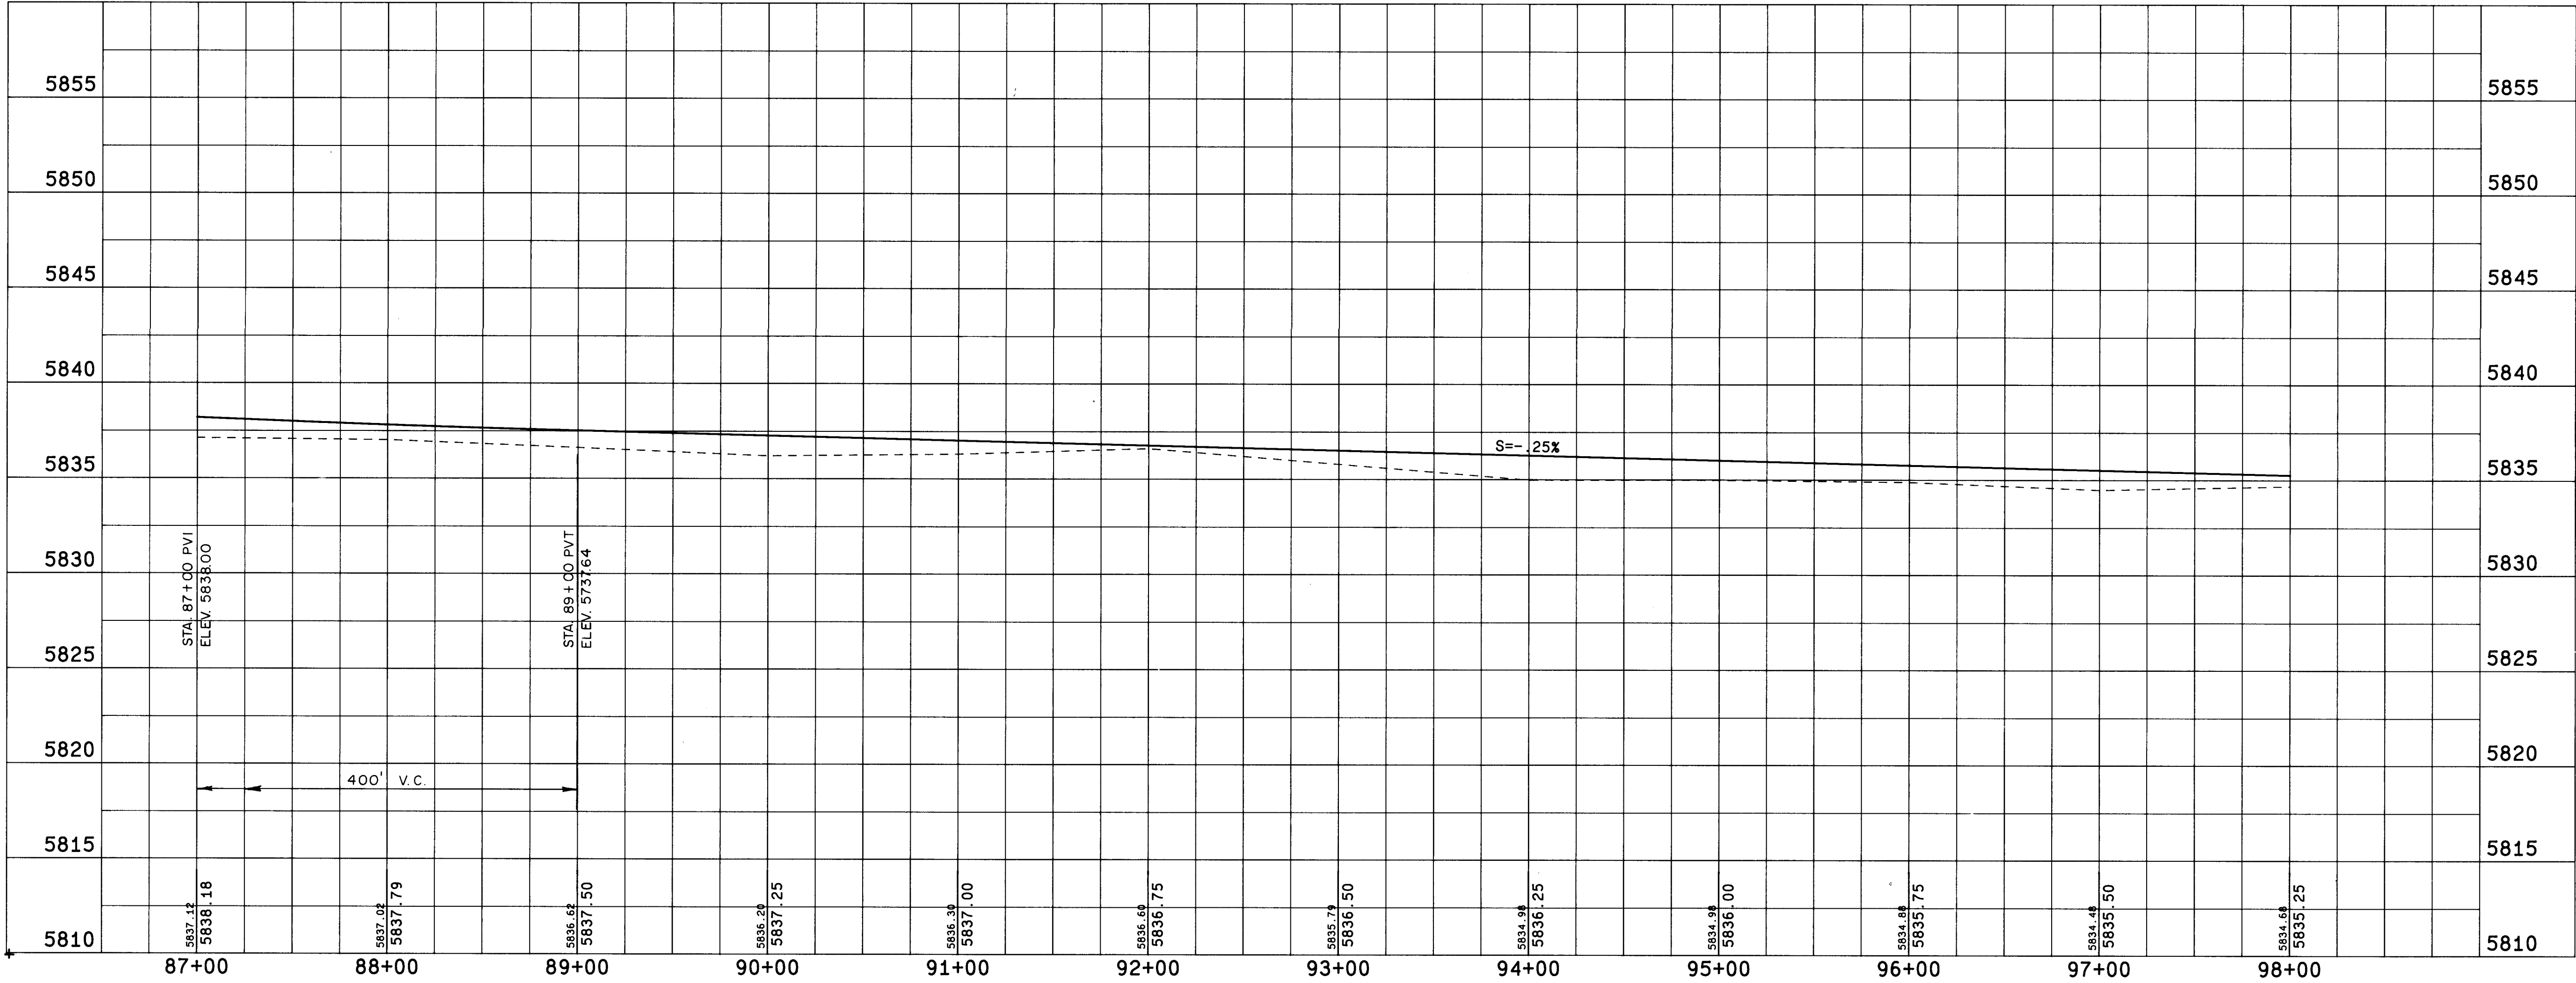


SEE SHEET 4 FOR LEGEND

AS BUILT INFORMATION			
CONTRACTOR	DATE	INSPECTOR'S	DATE
STAKED BY	DATE	FIELD	DATE
VERIFICATION BY	DATE	CORRECTION BY	DATE
MICRO-FILM INFORMATION			
RECORDED BY	DATE	NO.	

BENCH MARKS

NO.	BY	DATE

ENGINEER'S SEAL

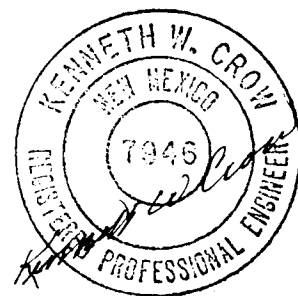

C of A PWD Maps & Records
1 2 3 4 5 6 7 8 9 10 11 12
26 34 06 11 92

RECORD DRAWING	
DATE: MARCH 1992	DRAFTED BY: D. SALAZAR
THESE RECORD DRAWINGS HAVE BEEN PREPARED, IN PART, ON THE BASIS OF INFORMATION COMPILED AND FURNISHED BY OTHERS. THE ENGINEER WILL NOT BE RESPONSIBLE FOR ANY ERRORS OR OMISSIONS WHICH HAVE BEEN INCORPORATED INTO THIS DOCUMENT AS A RESULT.	



CITY OF ALBUQUERQUE, NEW MEXICO
SOLIDS HANDLING FACILITIES
PHASE II B-3, CONTRACT 2



MOLZEN-CORBIN
STANLEY CONSULTANTS
A JOINT VENTURE

CITY OF ALBUQUERQUE
PUBLIC WORKS DEPARTMENT
LIQUID WASTE DIVISION

TITLE:
**PLAN AND PROFILE
SAF ACCESS ROAD**


APPROVALS	ENGINEER	DATE	APPROVALS	ENGINEER	DATE
City Engineer			Liquid Waste		
A.C.E.—Design			Traffic		
A.C.E.—Hydrology			Water		

DRAWING NO. **3406**

MAP NO.

SHEET 11 OF 27

LINE	BEARING	DISTANCE
L1	S 89° 47' 54" E	222.17
L2	S 89° 47' 54" E	77.83

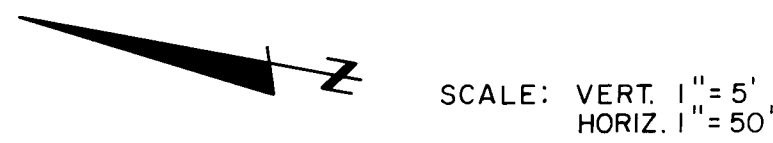

BEGIN STA. 95+00.00
 MATCHLINE STA. 98+00.00

STA. 95+00
 96+00
 97+00

50' R
 50' R

STA. 99+40.54 BK. =
 STA. 97+18.12 AHD.

STA. 95+00 ±, 90' RT. ±
 ACTUAL LOCATION OF FENCE
 CORNER TO BE DETERMINED
 IN THE FIELD. CORNER SHALL
 BE SET JUST INSIDE IRON PIN
 W/CAP STAMPED "LS NO. 1524"
 MARKING PROPERTY CORNER.

CUT 442 C.Y.
 FILL 297 C.Y.
 WASTE FORWARD 145 C.Y.

442 C.Y. 442 C.Y.

NOTE:
BORROW AN ADDITIONAL 2,463 C.Y.
FROM INTERSECTION AREA FOR
BALANCE FORWARD

C of A PWD Maps & Records

1	2	3	4	5	6	7	8	9	10	11	12
2	L		3	4	0	6	1	2	9	2	

RECORD DRAWING	
DATE: MARCH 1992	DRAFTED BY: D. SALAZAR
THESE RECORD DRAWINGS HAVE BEEN PREPARED, IN PART, ON THE BASIS OF INFORMATION COMPILED AND FURNISHED BY OTHERS. THE ENGINEER WILL NOT BE RESPONSIBLE FOR ANY ERRORS OR OMISSIONS WHICH HAVE BEEN INCORPORATED INTO THIS DOCUMENT AS A RESULT.	



CITY OF ALBUQUERQUE, NEW MEXICO
 DS HANDLING FACILITIES
 PHASE II B-3, CONTRACT 2



MOLZEN-CORBIN
STANLEY CONSULTANTS
A JOINT VENTURE


CITY OF ALBUQUERQUE
PUBLIC WORKS DEPARTMENT
LIQUID WASTE DIVISION

TITLE:	PLAN AND PROFILE SAF ACCESS ROAD
--------	-------------------------------------

APPROVALS	ENGINEER	DATE	APPROVALS	ENGINEER	DATE
City Engineer			Liquid Waste		
A.C.E.--Design			Traffic		
A.C.E.--Hydrology			Water		

DRAWING NO.	3406	MAP NO.	SHEET 12 OF 27
-------------	------	---------	----------------

ENGINEER'S SEAL	SURVEY INFORMATION		SEE SHEET 4	BENCH MARKS	AS BUILT INFORMATION
	NO.	FIELD NOTES BY DATE			
					CONTRACTOR
					WORKS BY
					INSPECTOR'S
					DATE
					ACCEPTANCE BY
					DATE
					VERIFICATION BY
					DATE
					DRAWINGS
					CORRECTED BY
				DATE	
				<i>MICRO-FILM INFORMATION</i>	
				RECORDED BY	DATE
				NO.	

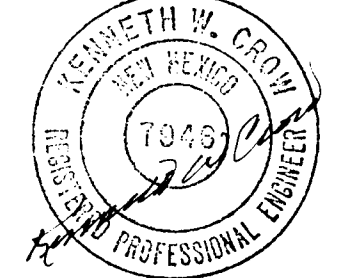[illegible]

LINE	BEARING	DISTANCE
L1	S 89° 47' 54" E	584.69
L2	S 89° 47' 54" E	515.31

CURVE DATA
CURVES NO. 1 & 2

Δ = 11° 28' 42"
R = 1500'
L = 300.50'
T = 150.76'

CUT	457 C.Y.	
FILL	229 C.Y.	686 C.Y.
BORROW AHEAD	686 C.Y.	686 C.Y.



SURVEY INFORMATION		BENCH MARKS		AS BUILT INFORMATION	
FIELD NOTES		SEE SHEET 4			
NO.	BY	DATE			
				CONTRACTOR	
				WORK ORDER BY	
				INSPECTOR'S	DATE
				ACCEPTANCE BY	DATE
				TEST	DATE
				VERIFICATION BY	DATE
				DRAWINGS	DATE
				CORRECTED BY	DATE
			<i>MICRO-FILM INFORMATION</i>		
				RECORDED BY	DATE
				NO.	

[illegible]

NO.	DATE	REMARKS	BY
DESIGN			
DESIGNED BY K.W.C.		DATE	10/12/87
DRAWN BY		DATE	
CHECKED BY		DATE	

C of A PWD Maps & Records											
1	2	3	4	5	6	7	8	9	10	11	12
2	6		3	4	0	6	1	3	9	2	

RECORD DRAWING	
DATE: MARCH, 1992	DRAFTED BY: D. SALAZAR
THESE RECORD DRAWINGS HAVE BEEN PREPARED, IN PART, ON THE BASIS OF INFORMATION COMPILED AND FURNISHED BY OTHERS. THE ENGINEER WILL NOT BE RESPONSIBLE FOR ANY ERRORS OR OMISSIONS WHICH HAVE BEEN INCORPORATED INTO THIS DOCUMENT AS A RESULT.	



CITY OF ALBUQUERQUE, NEW MEXICO

SOLIDS HANDLING FACILITIES

PHASE II B-3, CONTRACT 2




MOLZEN-CORBIN
STANLEY CONSULTANTS
A JOINT VENTURE

CITY OF ALBUQUERQUE
PUBLIC WORKS DEPARTMENT
LIQUID WASTE DIVISION

TITLE: PLAN AND PROFILE
SAF ACCESS ROAD

APPROVALS	ENGINEER	DATE	APPROVALS	ENGINEER	DATE
City Engineer			Liquid Waste		
A.C.E.—Design			Traffic		
A.C.E.—Hydrology			Water		

DRAWING NO.	3406	MAP NO.	SHEET 13 OF 27
-------------	------	---------	----------------

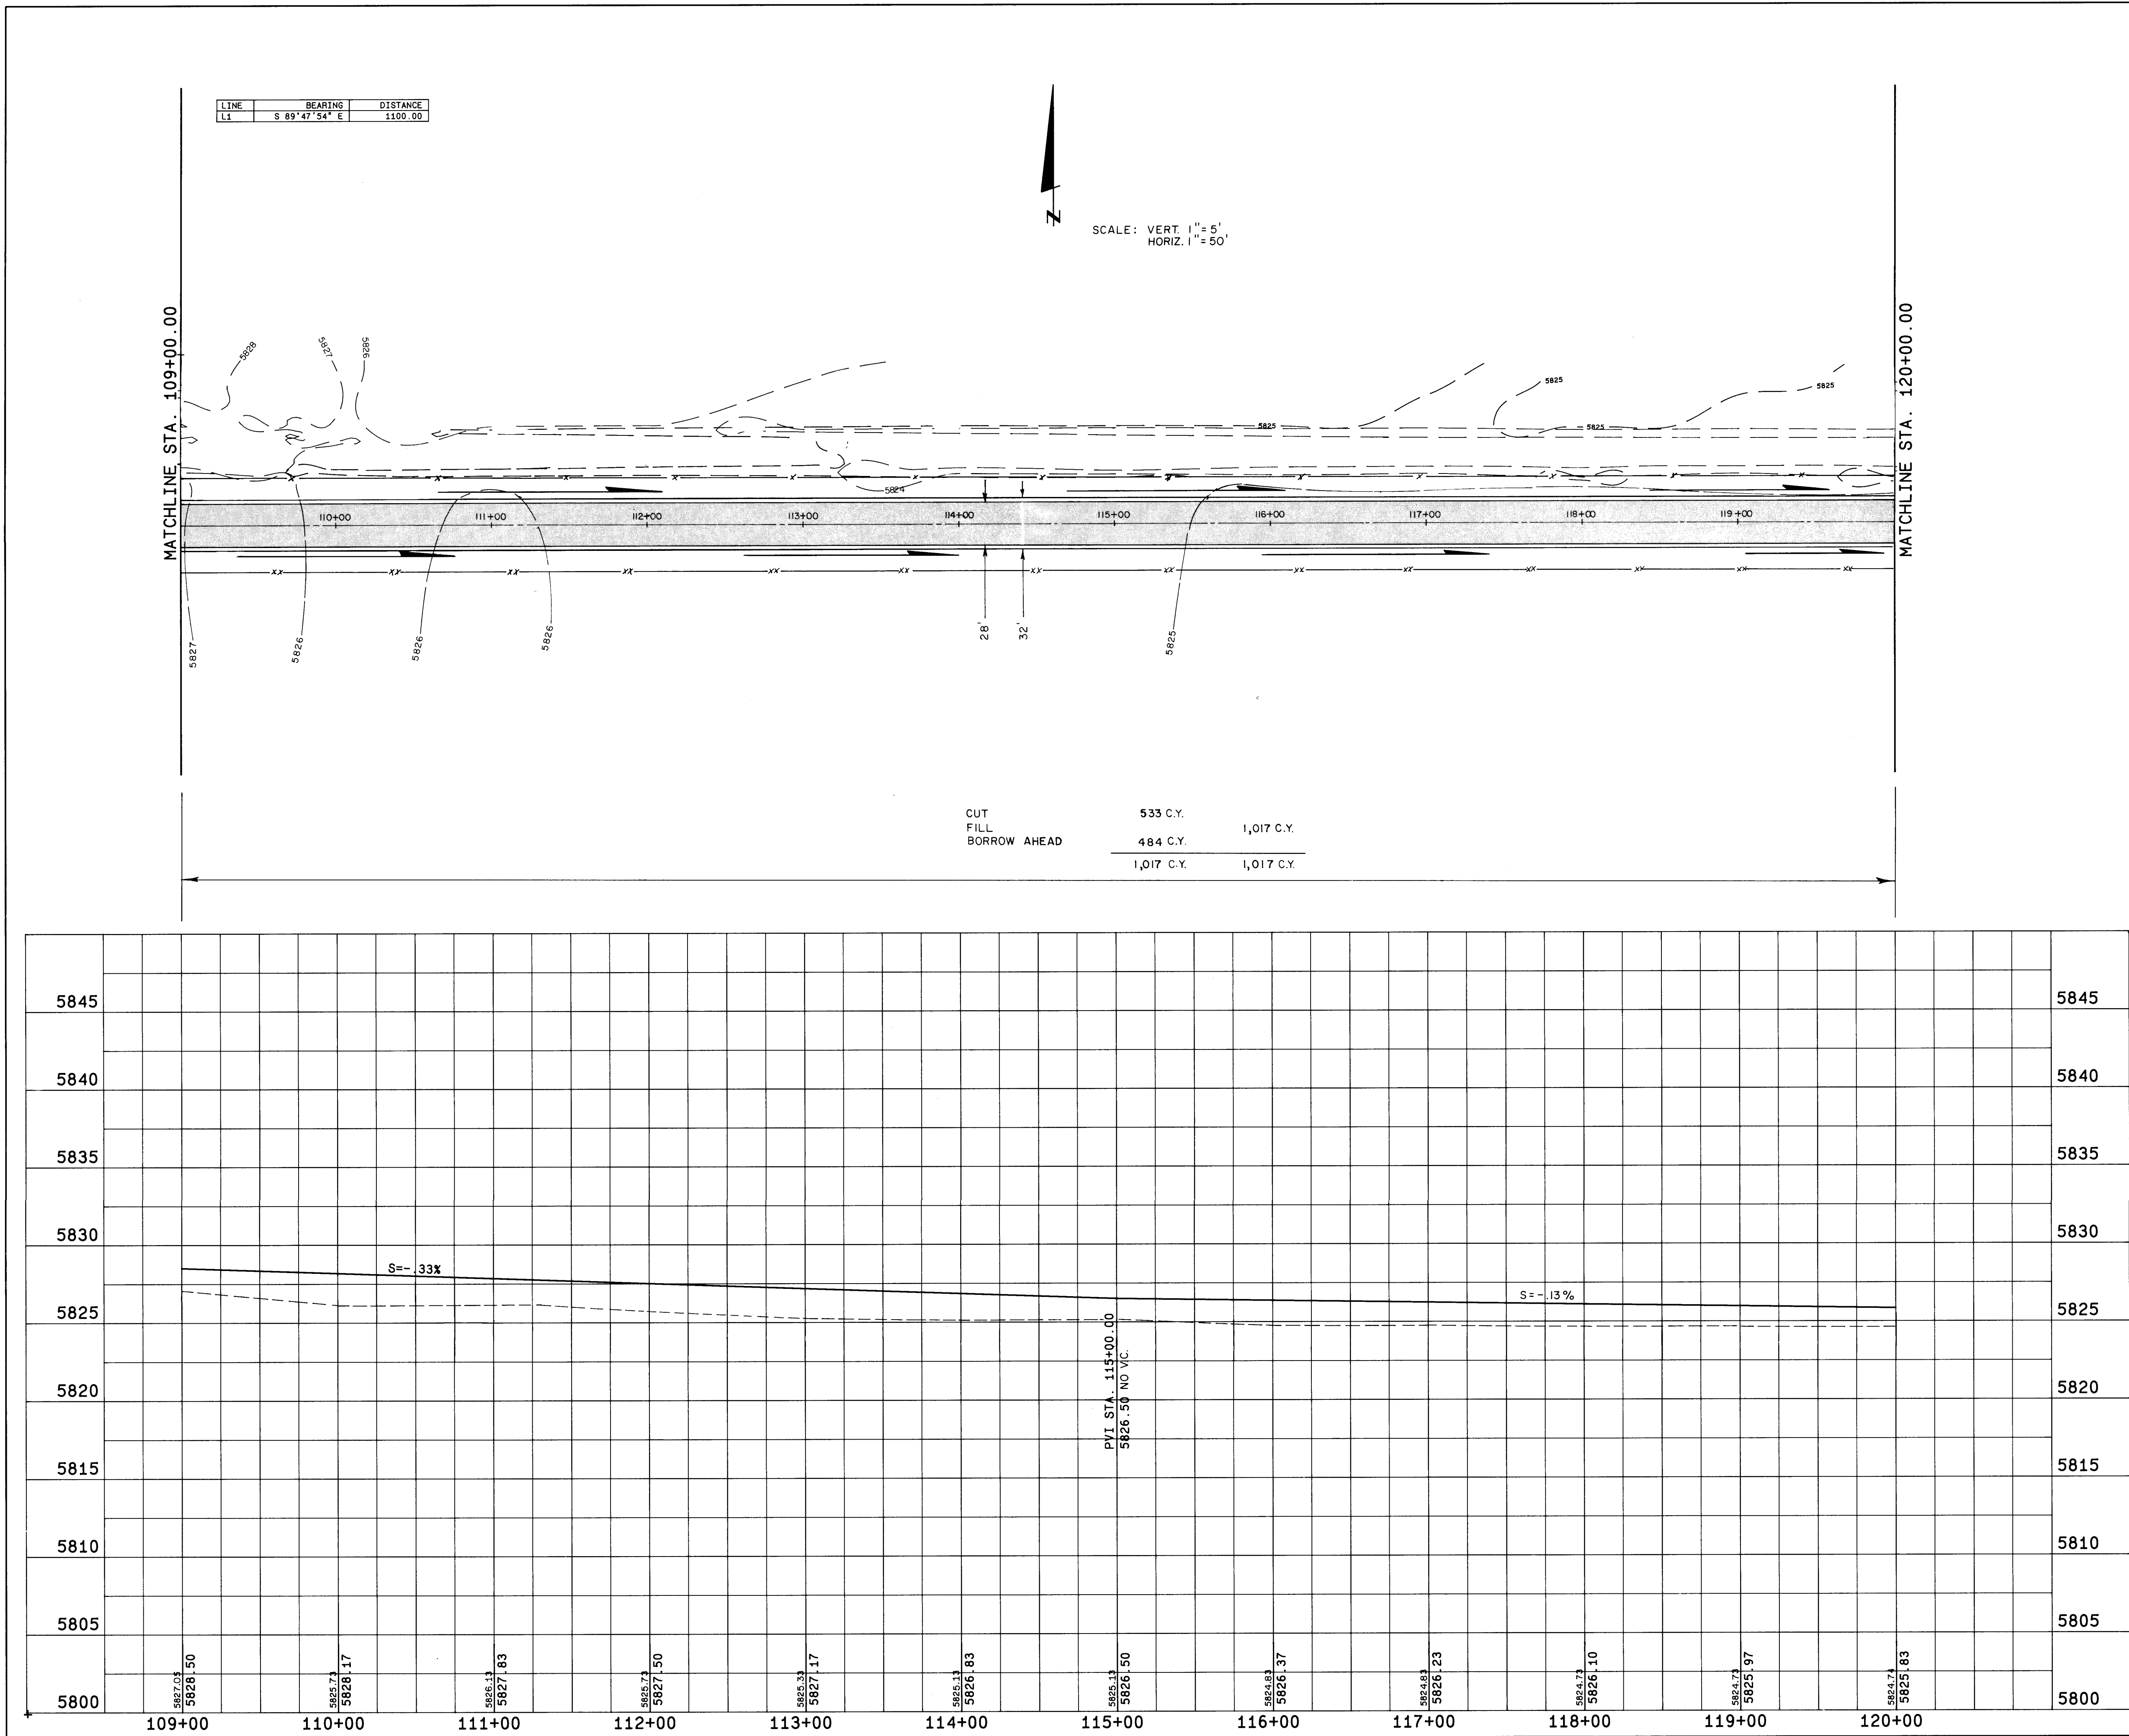

SEE SHEET 4 FOR LEGEND

AS BUILT INFORMATION

BENCH MARKS

SURVEY INFORMATION

FIELD NOTES

NO. BY DATE

ENGINEER'S SEAL

RECORD DRAWING

DATE: MARCH, 1972 DRAFTED BY: D. SALAZAR

THESE RECORD DRAWINGS HAVE BEEN PREPARED, IN PART, ON THE BASIS OF INFORMATION COMPILED AND FURNISHED BY OTHERS. THE ENGINEER WILL NOT BE RESPONSIBLE FOR ANY ERRORS OR OMISSIONS WHICH HAVE BEEN INCORPORATED INTO THIS DOCUMENT AS A RESULT.

CITY OF ALBUQUERQUE, NEW MEXICO

SOLIDS HANDLING FACILITIES

PHASE II B-3, CONTRACT 2

MOLZEN-CORBIN

STANLEY CONSULTANTS

A JOINT VENTURE

CITY OF ALBUQUERQUE

PUBLIC WORKS DEPARTMENT

LIQUID WASTE DIVISION

TITLE: PLAN AND PROFILE

SAF ACCESS ROAD

APPROVALS

ENGINEER

DATE

APPROVALS

ENGINEER

DATE

City Engineer

A.C.E.-Design

A.C.E.-Hydrology

Liquid Waste


Traffic

Water

DRAWING NO. 3406

MAP NO.

SHEET 14 OF 27

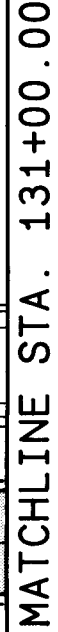

CUT	2,434 C.Y.	
FILL		23 C.Y.
WASTE		2,411 C.Y.
	<u>2,434 C.Y.</u>	<u>2,434 C.Y.</u>

DRAWING NO.	3406	MAP NO.	SHEET 15 OF 27
-------------	------	---------	----------------

LINE	BEARING	DISTANCE
L1	S 89°47'54" E	1100.00




SCALE: VERT. 1" = 5'
HORIZ. 1" = 50'

MATCHLINE STA. 131+00.00



MATCHLINE STA. 142+00.00

CUT 3,266 C.Y.
FILL 40 C.Y.
WASTE FORWARD 3,226 C.Y.
3,266 C.Y. 3,266 C.Y.

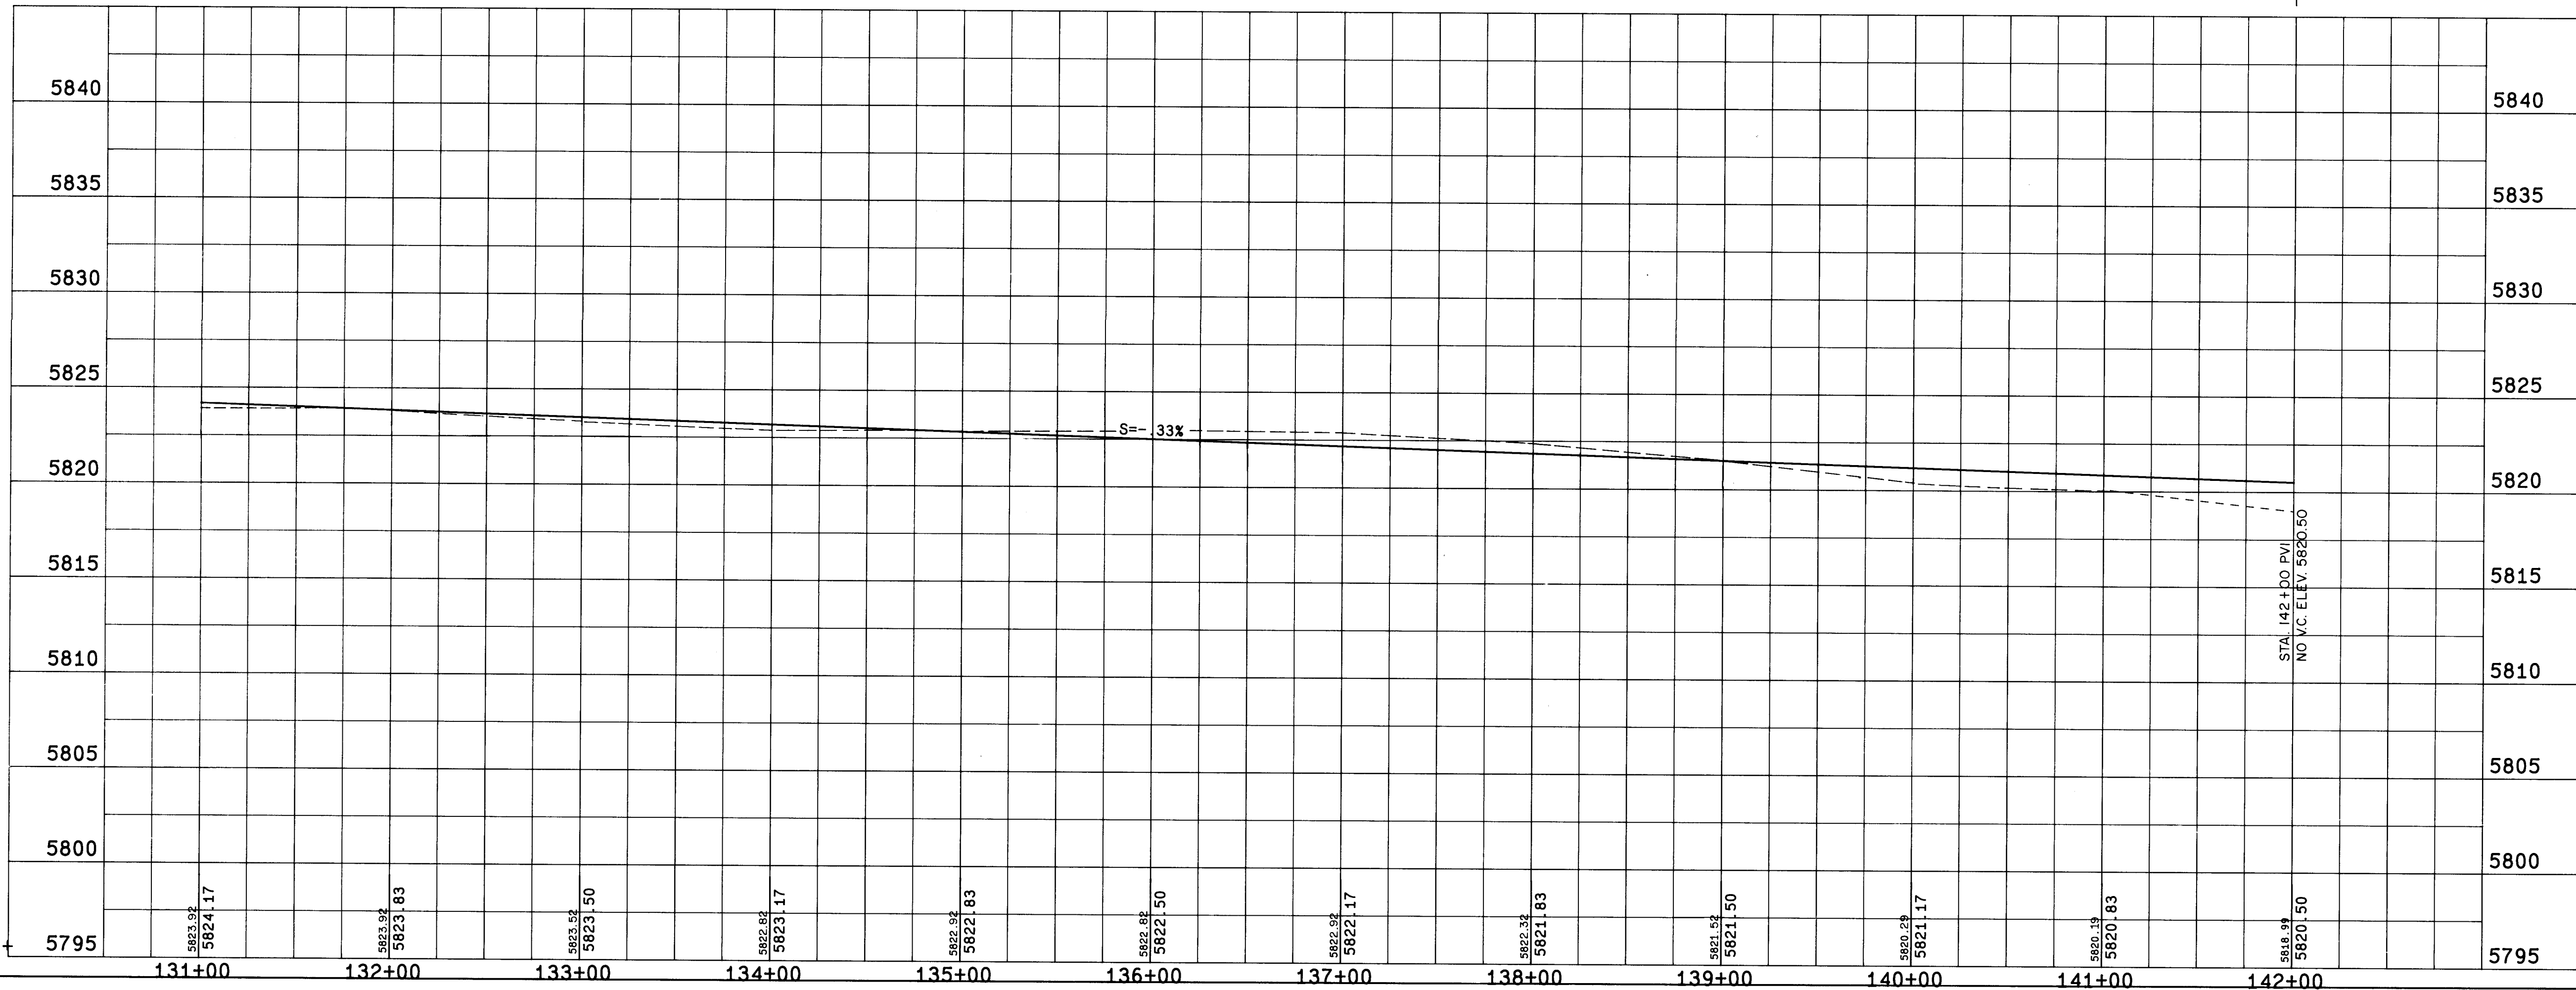

SEE SHEET 4 FOR LEGEND

ENGINEER'S SEAL			SURVEY INFORMATION			BENCH MARKS			AS BUILT INFORMATION																										
			FIELD NOTES			SEE SHEET 4			CONTRACTOR																										
			NO. BY DATE			NO. BY DATE			NO. BY DATE																										
REMARKS			NO. BY DATE			NO. BY DATE			NO. BY DATE																										
DESIGNED BY KWC			NO. BY DATE			NO. BY DATE			NO. BY DATE																										
DRAWN BY			NO. BY DATE			NO. BY DATE			NO. BY DATE																										
CHECKED BY			NO. BY DATE			NO. BY DATE			NO. BY DATE																										
CITY OF ALBUQUERQUE, NEW MEXICO SOLIDS HANDLING FACILITIES PHASE II B-3, CONTRACT 2 MOLZEN-CORBIN STANLEY CONSULTANTS A JOINT VENTURE CITY OF ALBUQUERQUE PUBLIC WORKS DEPARTMENT LIQUID WASTE DIVISION TITLE: PLAN AND PROFILE SAF ACCESS ROAD <table border="1"> <thead> <tr> <th>APPROVALS</th> <th>ENGINEER</th> <th>DATE</th> <th>APPROVALS</th> <th>ENGINEER</th> <th>DATE</th> </tr> </thead> <tbody> <tr> <td>City Engineer</td> <td></td> <td></td> <td>Liquid Waste</td> <td></td> <td></td> </tr> <tr> <td>A.C.E.—Design</td> <td></td> <td></td> <td>Traffic</td> <td></td> <td></td> </tr> <tr> <td>A.C.E.—Hydrology</td> <td></td> <td></td> <td>Water</td> <td></td> <td></td> </tr> </tbody> </table> DRAWING NO. 3406 MAP NO. SHEET 16 OF 27												APPROVALS	ENGINEER	DATE	APPROVALS	ENGINEER	DATE	City Engineer			Liquid Waste			A.C.E.—Design			Traffic			A.C.E.—Hydrology			Water		
APPROVALS	ENGINEER	DATE	APPROVALS	ENGINEER	DATE																														
City Engineer			Liquid Waste																																
A.C.E.—Design			Traffic																																
A.C.E.—Hydrology			Water																																

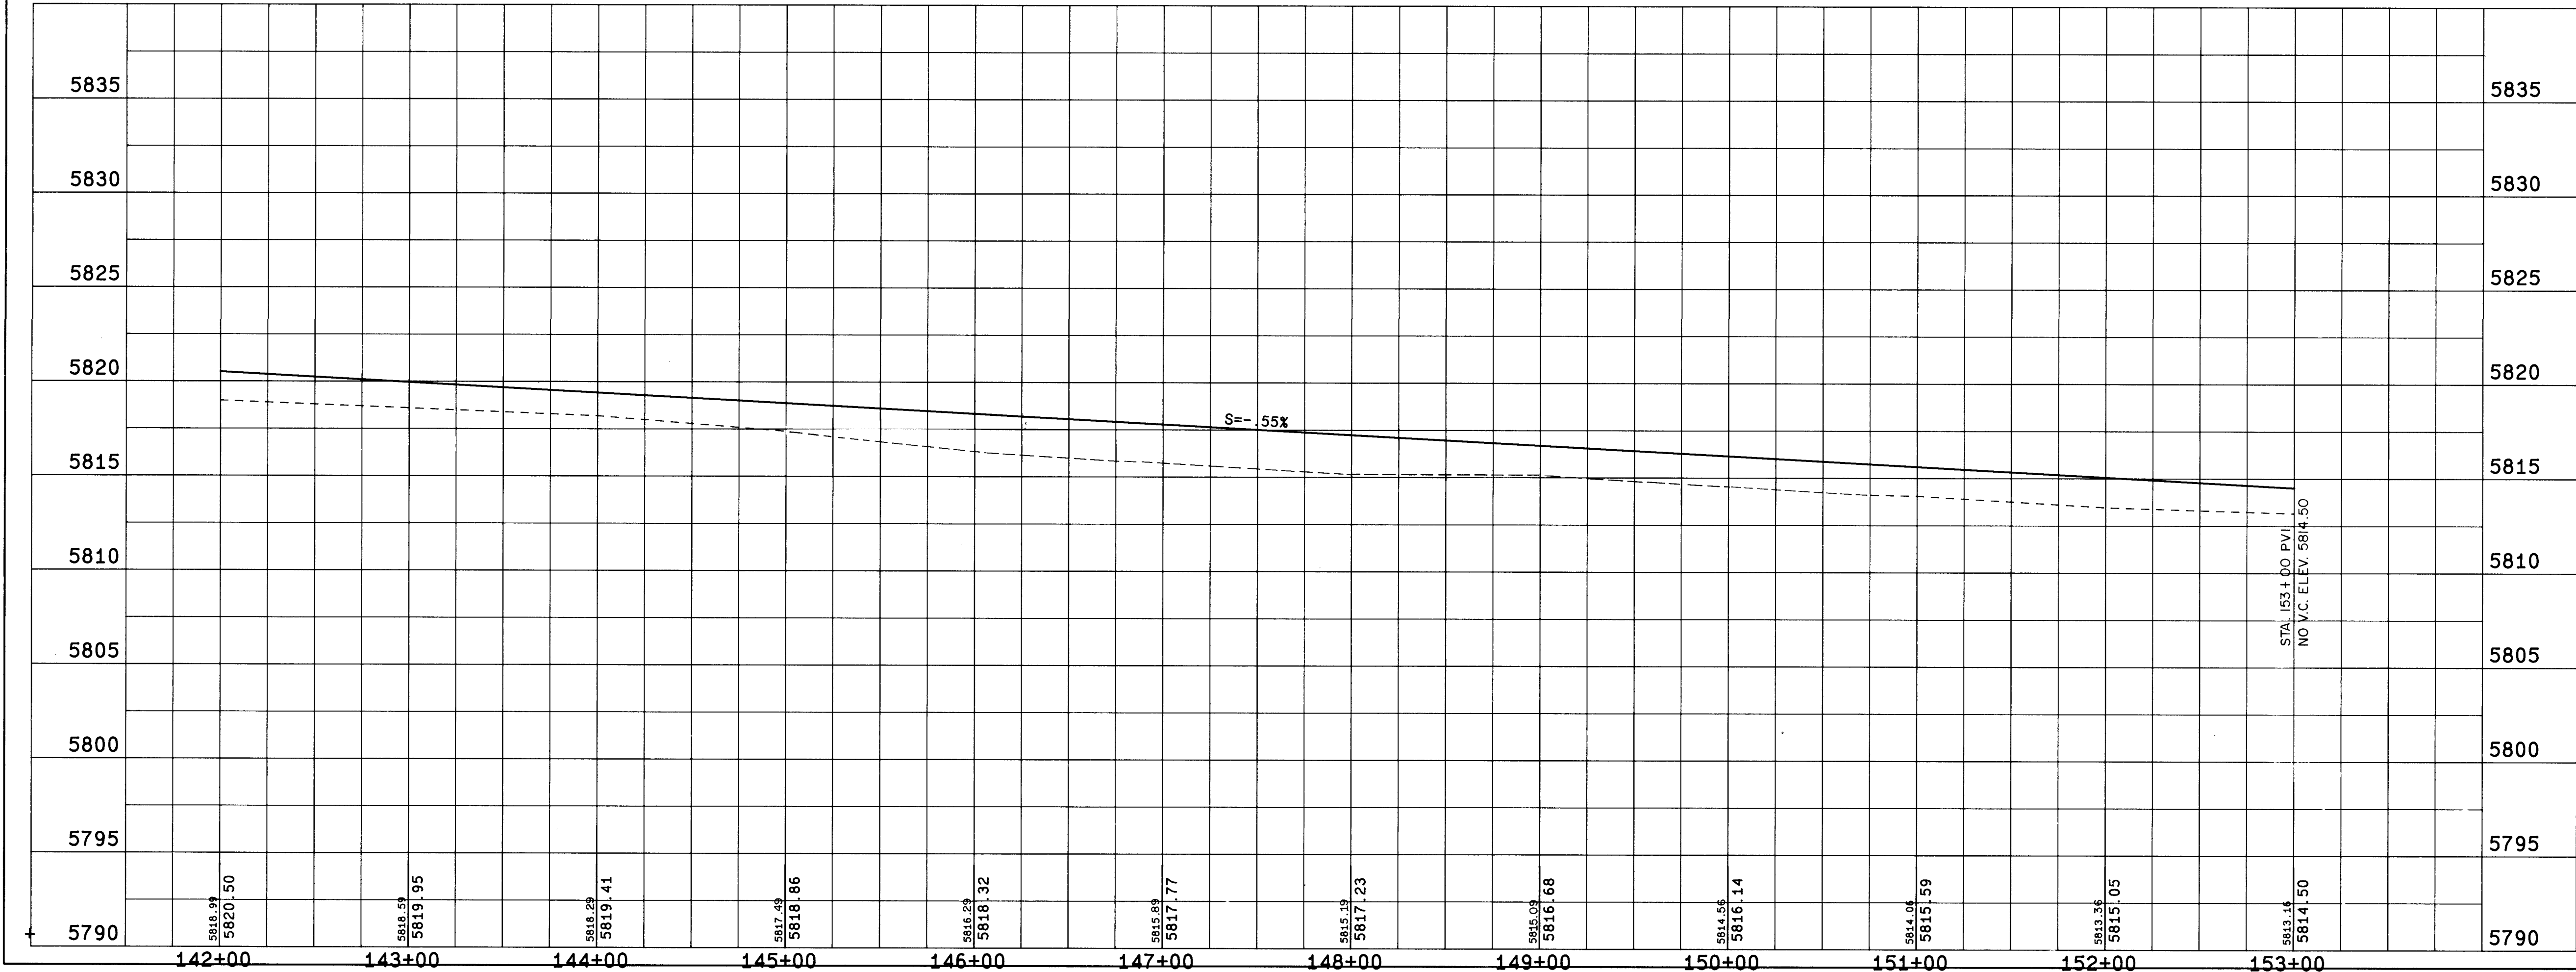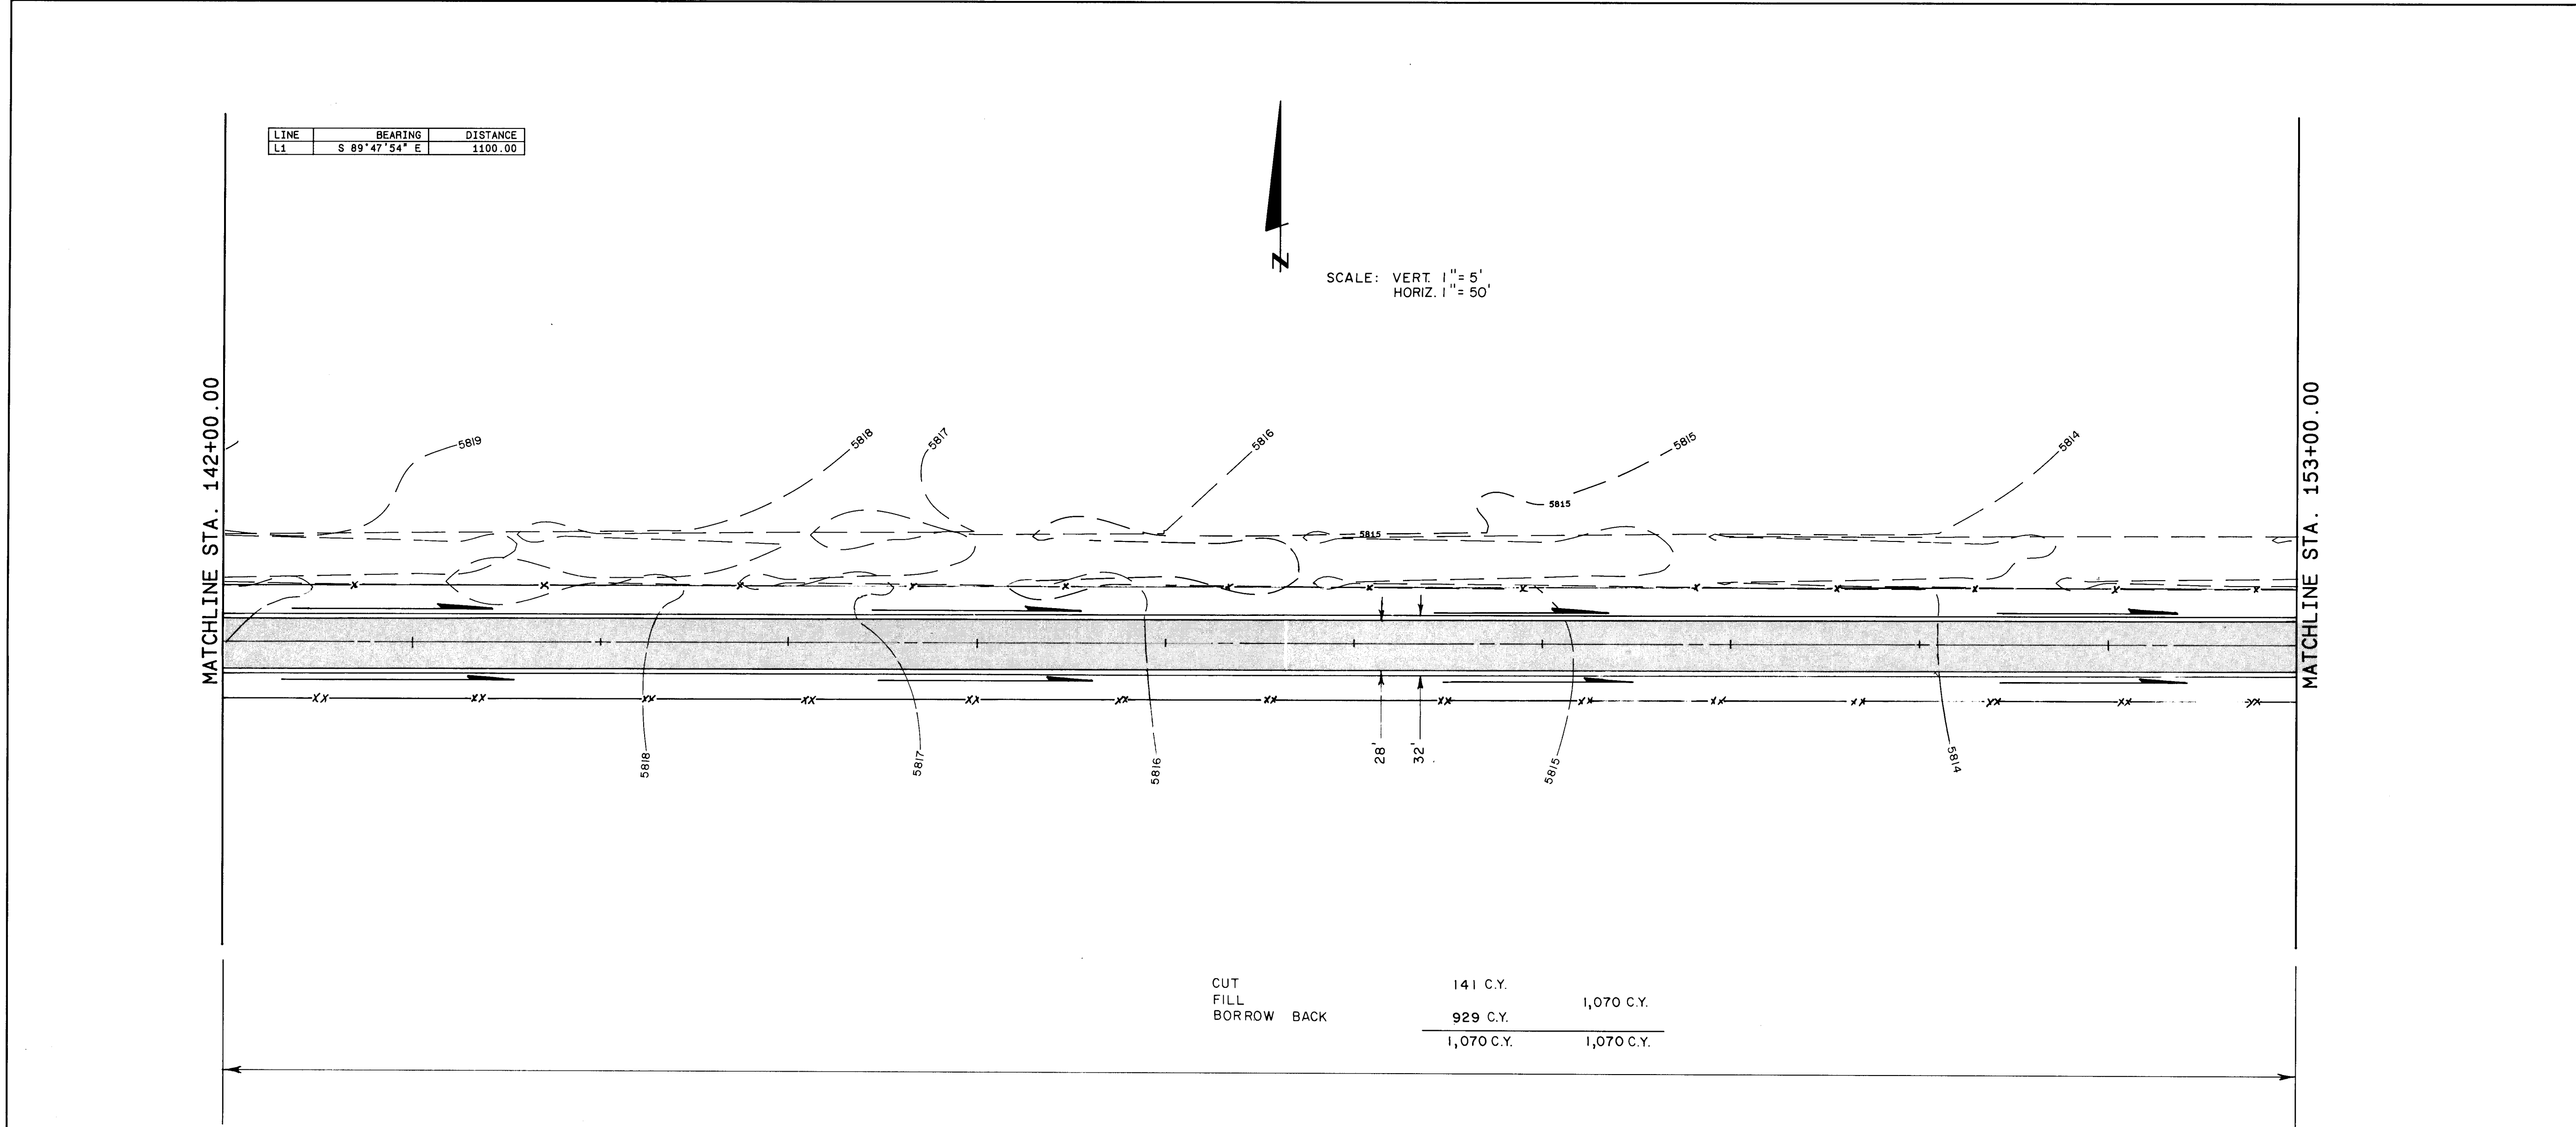

SEE SHEET 4 FOR LEGEND

AS BUILT INFORMATION		BENCH MARKS		SURVEY INFORMATION		ENGINEER'S SEAL	
CONTRACTOR	DATE	SEE SHEET 4	NO.	FIELD NOTES	BY	DATE	NO.
WORKED BY	DATE						
INSPECTOR'S	DATE						
DESIGNED BY	DATE						
VERIFICATION BY	DATE						
DRAWN BY	DATE						
CHECKED BY	DATE						
MICRO-FILM INFORMATION							
NO.	DATE						

C of A PWD Maps & Records
1 2 3 4 5 6 7 8 9 10 11 12
26 34 06 17 92

RECORD DRAWING
DATE: MARCH, 1992 DRAFTED BY: D. SALAZAR
THESE RECORD DRAWINGS HAVE BEEN PREPARED, IN PART, ON THE BASIS OF INFORMATION COMPILED AND FURNISHED BY OTHERS. THE ENGINEER WILL NOT BE RESPONSIBLE FOR ANY ERRORS OR OMISSIONS WHICH HAVE BEEN INCORPORATED INTO THIS DOCUMENT AS A RESULT.

CITY OF ALBUQUERQUE, NEW MEXICO
SOLIDS HANDLING FACILITIES
PHASE II B-3, CONTRACT 2


MOLZEN-CORBIN
STANLEY CONSULTANTS
A JOINT VENTURE

CITY OF ALBUQUERQUE
PUBLIC WORKS DEPARTMENT
LIQUID WASTE DIVISION

TITLE: PLAN AND PROFILE
SAF ACCESS ROAD

APPROVALS	ENGINEER	DATE	APPROVALS	ENGINEER	DATE
City Engineer			Liquid Waste		
A.C.E.-Design			Traffic		
A.C.E.-Hydrology			Water		

DRAWING NO. 3406 MAP NO. SHEET 17 OF 27

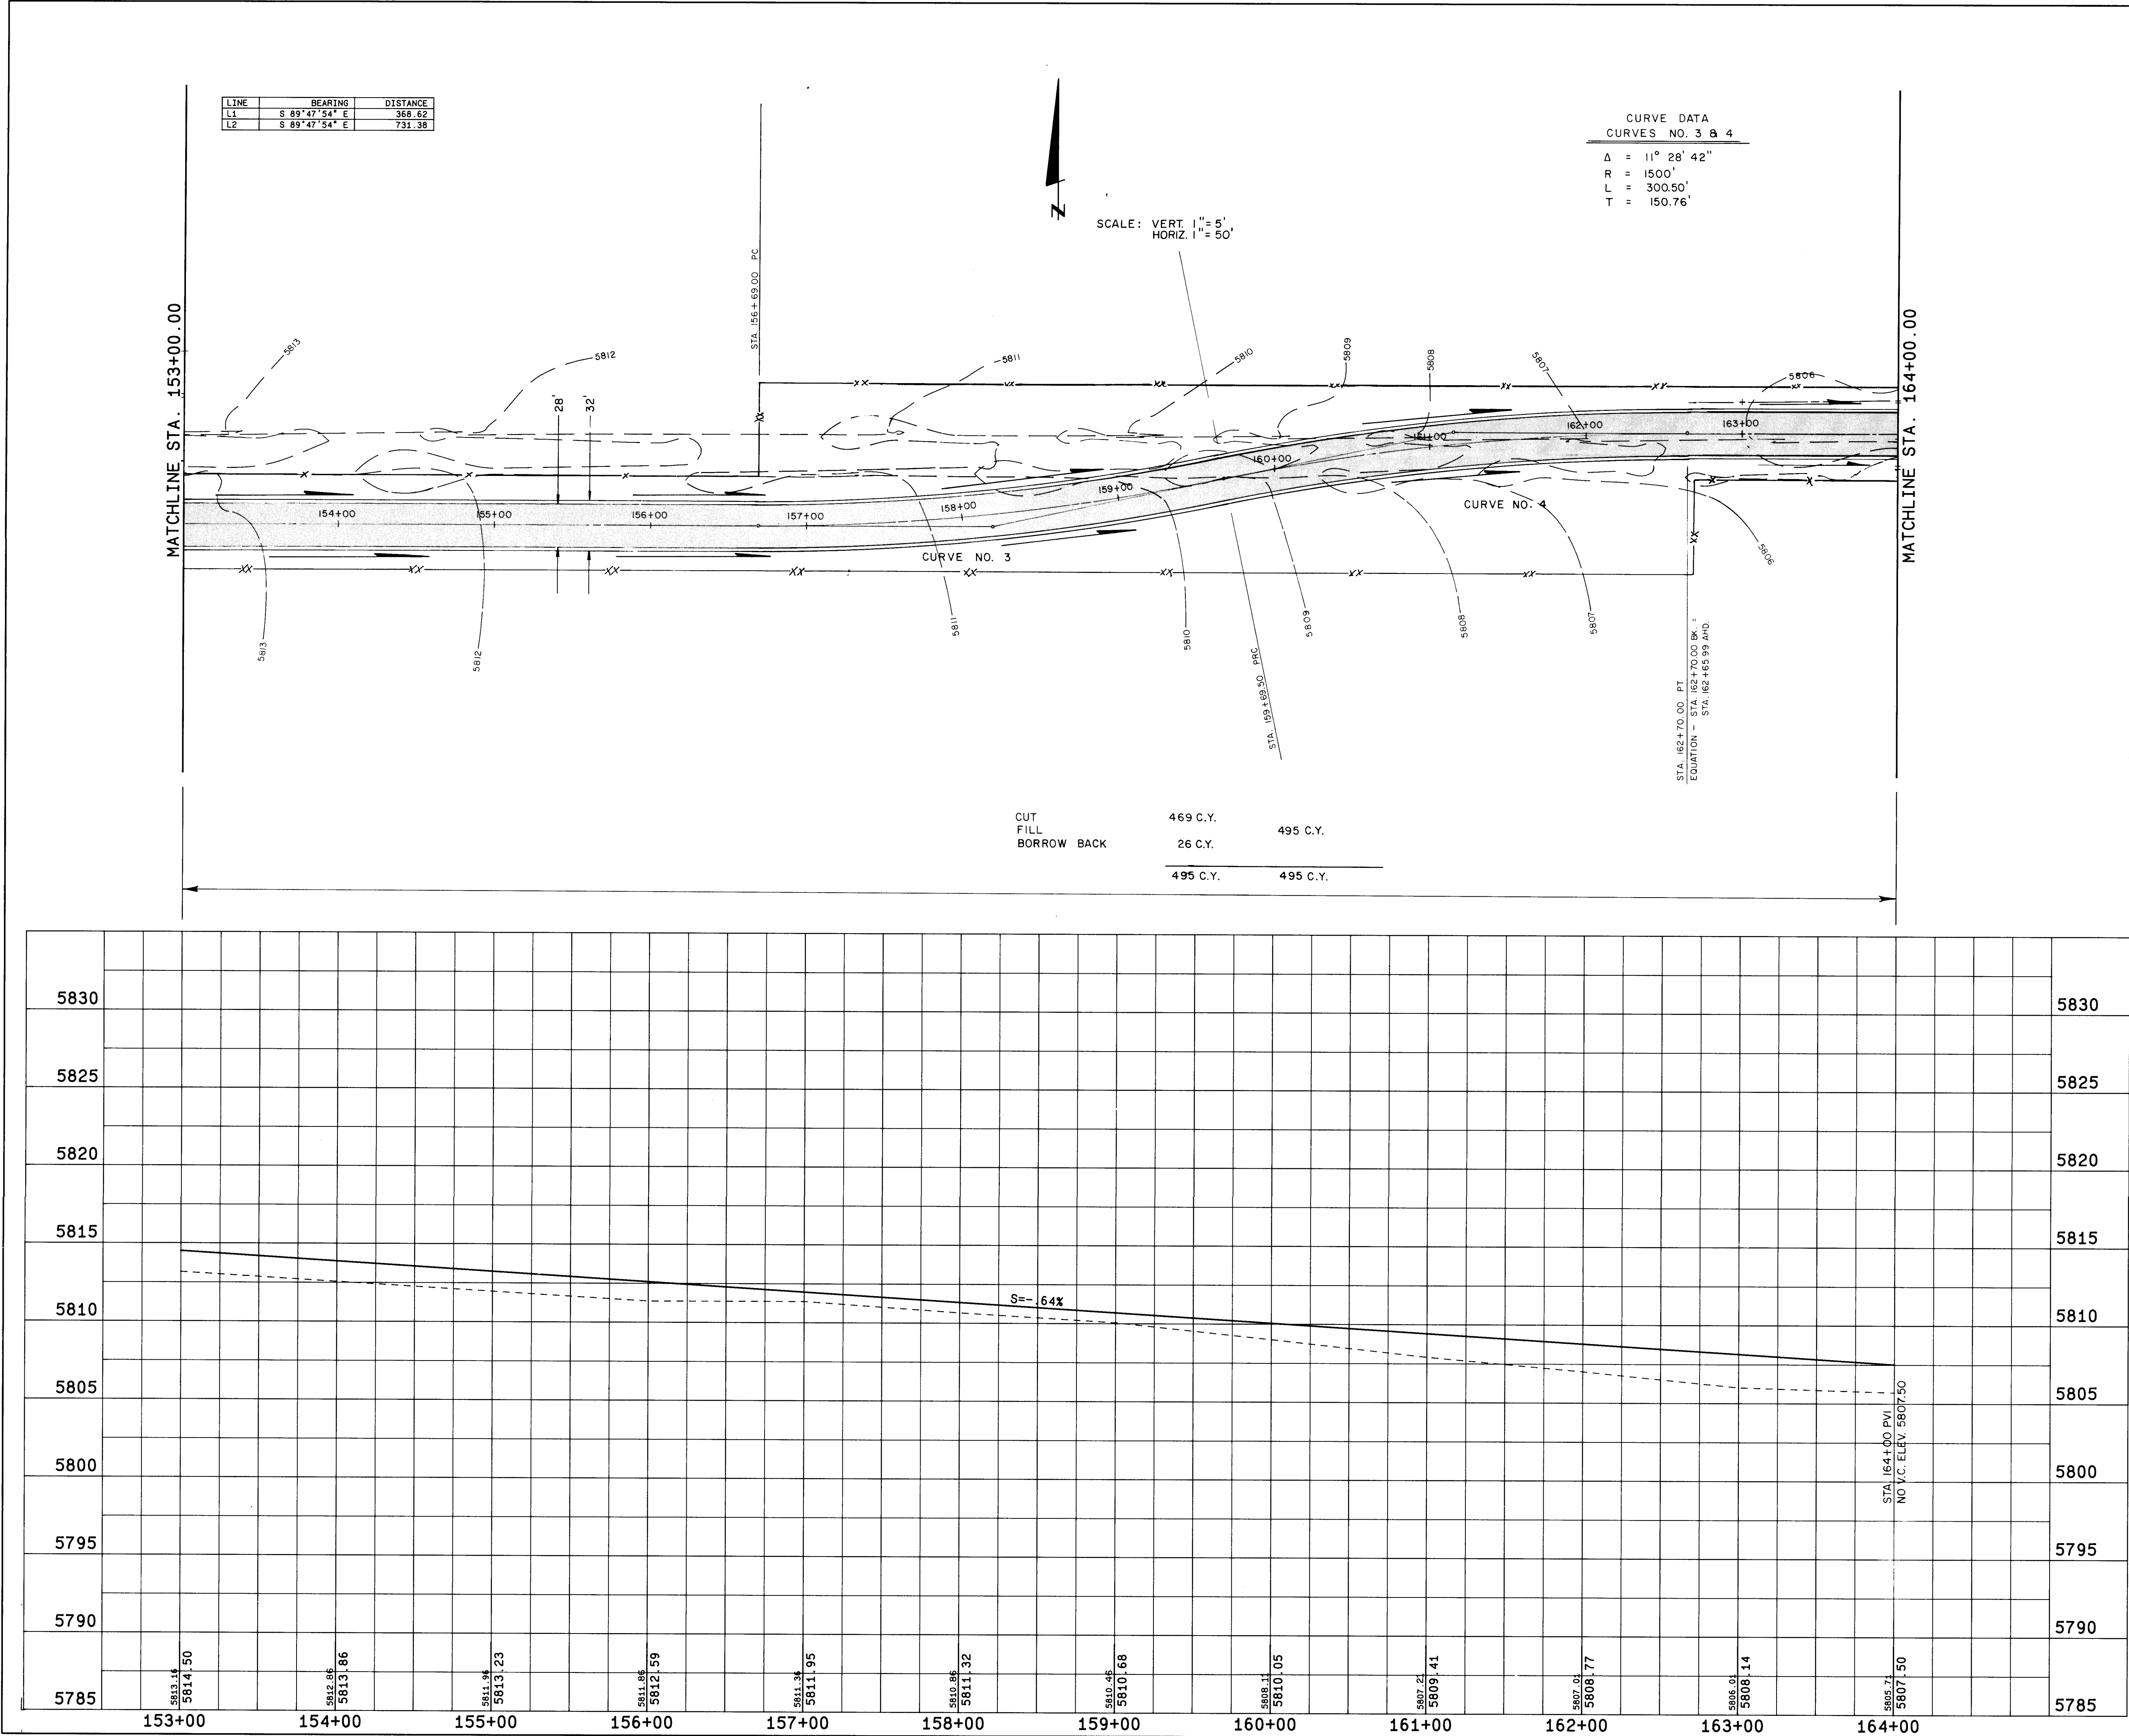

SEE SHEET 4 FOR LEGEND

AS BUILT INFORMATION

CONTRACTOR	DATE
INSPECTOR	DATE
FIELD	DATE
VERIFICATION BY	DATE
CORRECTED BY	DATE

MICRO-FILM INFORMATION

RECORDED BY	DATE
NO.	

BENCH MARKS

SEE SHEET 4

SURVEY INFORMATION

FIELD NOTES	BY	DATE
NO.		

ENGINEER'S SEAL

KENNETH W. CROW
REGISTERED PROFESSIONAL ENGINEER
7346

RECORD DRAWING

DATE: MARCH, 1992
DRAFTED BY: D. SALAZAR

THESE RECORD DRAWINGS HAVE BEEN PREPARED, IN PART, ON THE BASIS OF INFORMATION COMPILED AND FURNISHED BY OTHERS. THE ENGINEER WILL NOT BE RESPONSIBLE FOR ANY ERRORS OR OMISSIONS WHICH HAVE BEEN INCORPORATED INTO THIS DOCUMENT AS A RESULT.

CITY OF ALBUQUERQUE, NEW MEXICO

SOLIDS HANDLING FACILITIES
PHASE II B-3, CONTRACT 2

MOLZEN-CORBIN
STANLEY CONSULTANTS
A JOINT VENTURE

CITY OF ALBUQUERQUE
PUBLIC WORKS DEPARTMENT
LIQUID WASTE DIVISION

TITLE:
PLAN AND PROFILE
SAF ACCESS ROAD

APPROVALS	ENGINEER	DATE	APPROVALS	ENGINEER	DATE
City Engineer			Liquid Waste		
A.C.E.—Design			Traffic		
A.C.E.—Hydrology			Water		


DRAWING NO. 3406

MAP NO.


SHEET 18 OF 27

LINE	BEARING	DISTANCE
L1	S 89°47'54" E	1100.00

SCALE: VERT. 1" = 10'
HORIZ. 1" = 50'

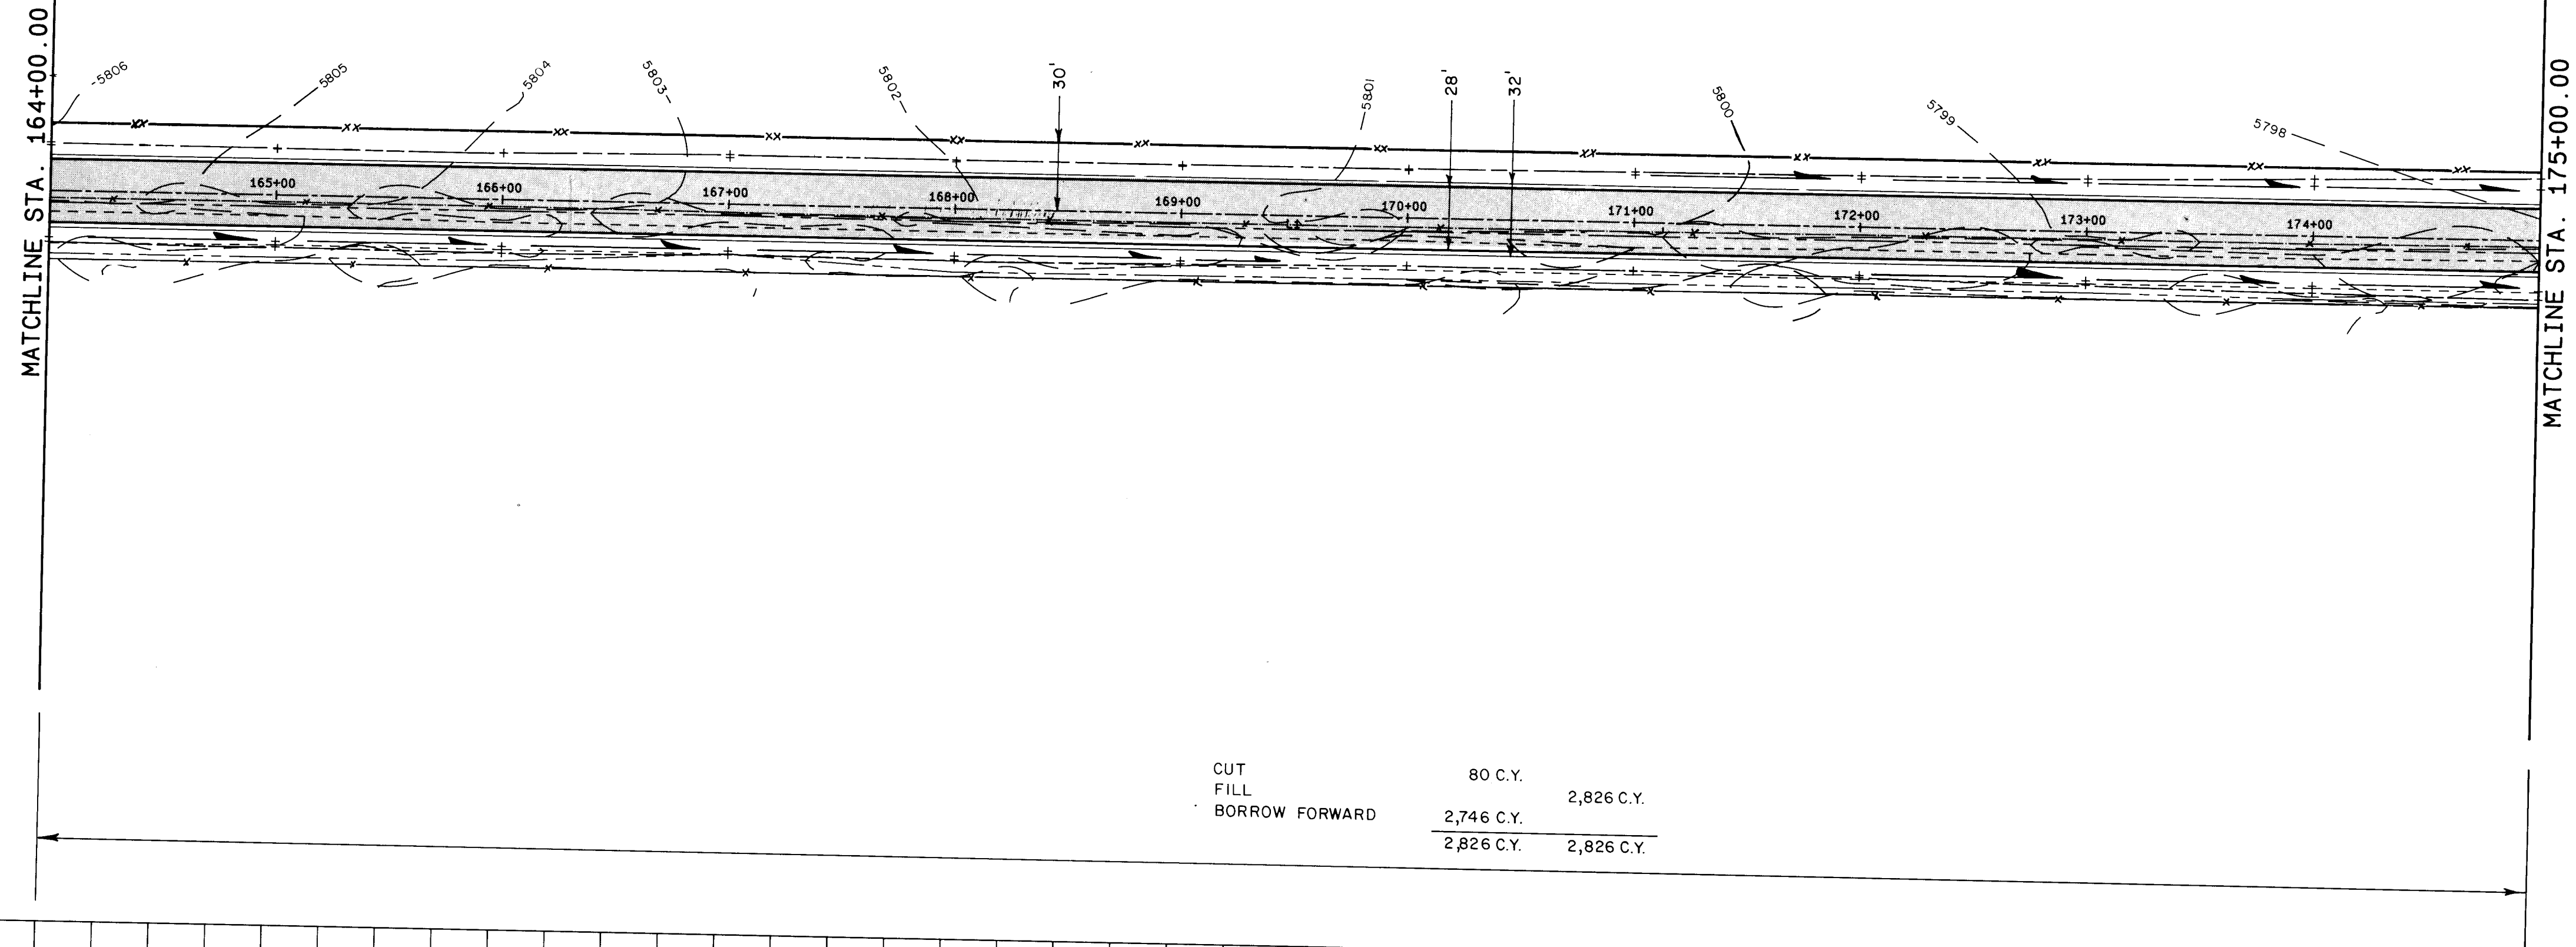


CUT	80 C.Y.
FILL	2,826 C.Y.
BORROW FORWARD	2,746 C.Y.
	2,826 C.Y.

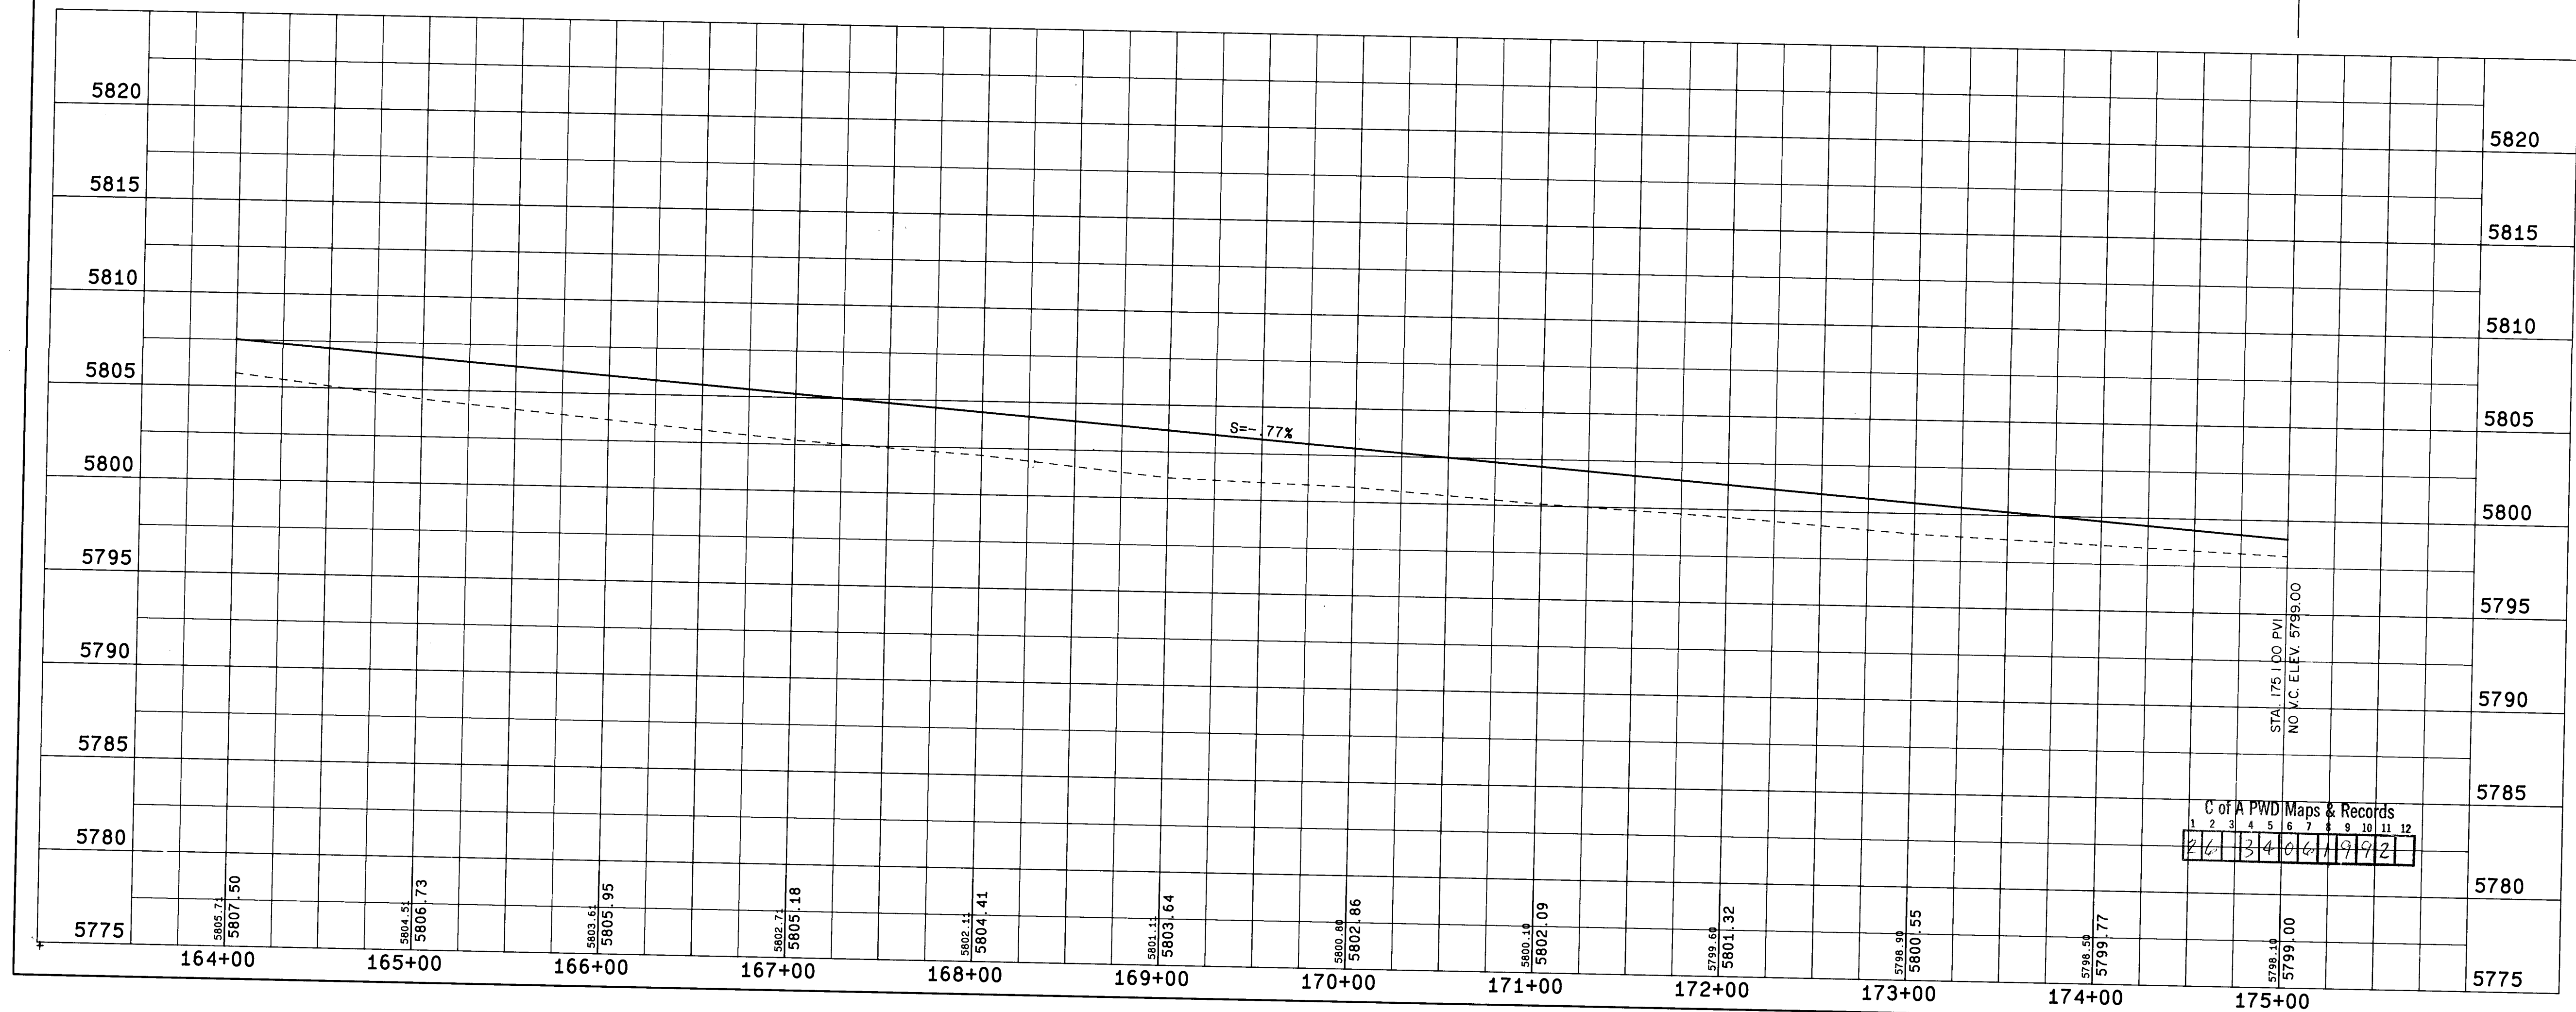

SEE SHEET 4 FOR LEGEND



SURVEY INFORMATION			BENCH MARKS			AS BUILT INFORMATION		
NO.	BY	DATE	NO.	BY	DATE	CONTRACTOR	DATE	NO.
						INSPECTOR'S	DATE	
						FIELD	DATE	
						VERIFICATION BY	DATE	
						CORRECTED BY	DATE	
						NO.		

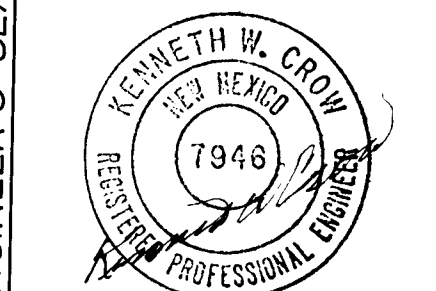

RECORD DRAWING
DATE: MARCH, 1992 DRAFTED BY: D. SALAZAR
THESE RECORD DRAWINGS HAVE BEEN PREPARED, IN PART, ON THE BASIS OF INFORMATION COMPILED AND FURNISHED BY OTHERS. THE ENGINEER WILL NOT BE RESPONSIBLE FOR ANY ERRORS OR OMISSIONS WHICH HAVE BEEN INCORPORATED INTO THIS DOCUMENT AS A RESULT.


CITY OF ALBUQUERQUE, NEW MEXICO
SOLIDS HANDLING FACILITIES
PHASE II B-3, CONTRACT 2
MOLZEN-CORBIN
STANLEY CONSULTANTS
A JOINT VENTURE

CITY OF ALBUQUERQUE PUBLIC WORKS DEPARTMENT LIQUID WASTE DIVISION					
TITLE: PLAN AND PROFILE SAF ACCESS ROAD					
APPROVALS	ENGINEER	DATE	APPROVALS	ENGINEER	DATE
City Engineer			Liquid Waste		
A.C.E.—Design			Traffic		
A.C.E.—Hydrology			Water		
DRAWING NO. 3406			MAP NO.		SHEET 19 OF 27

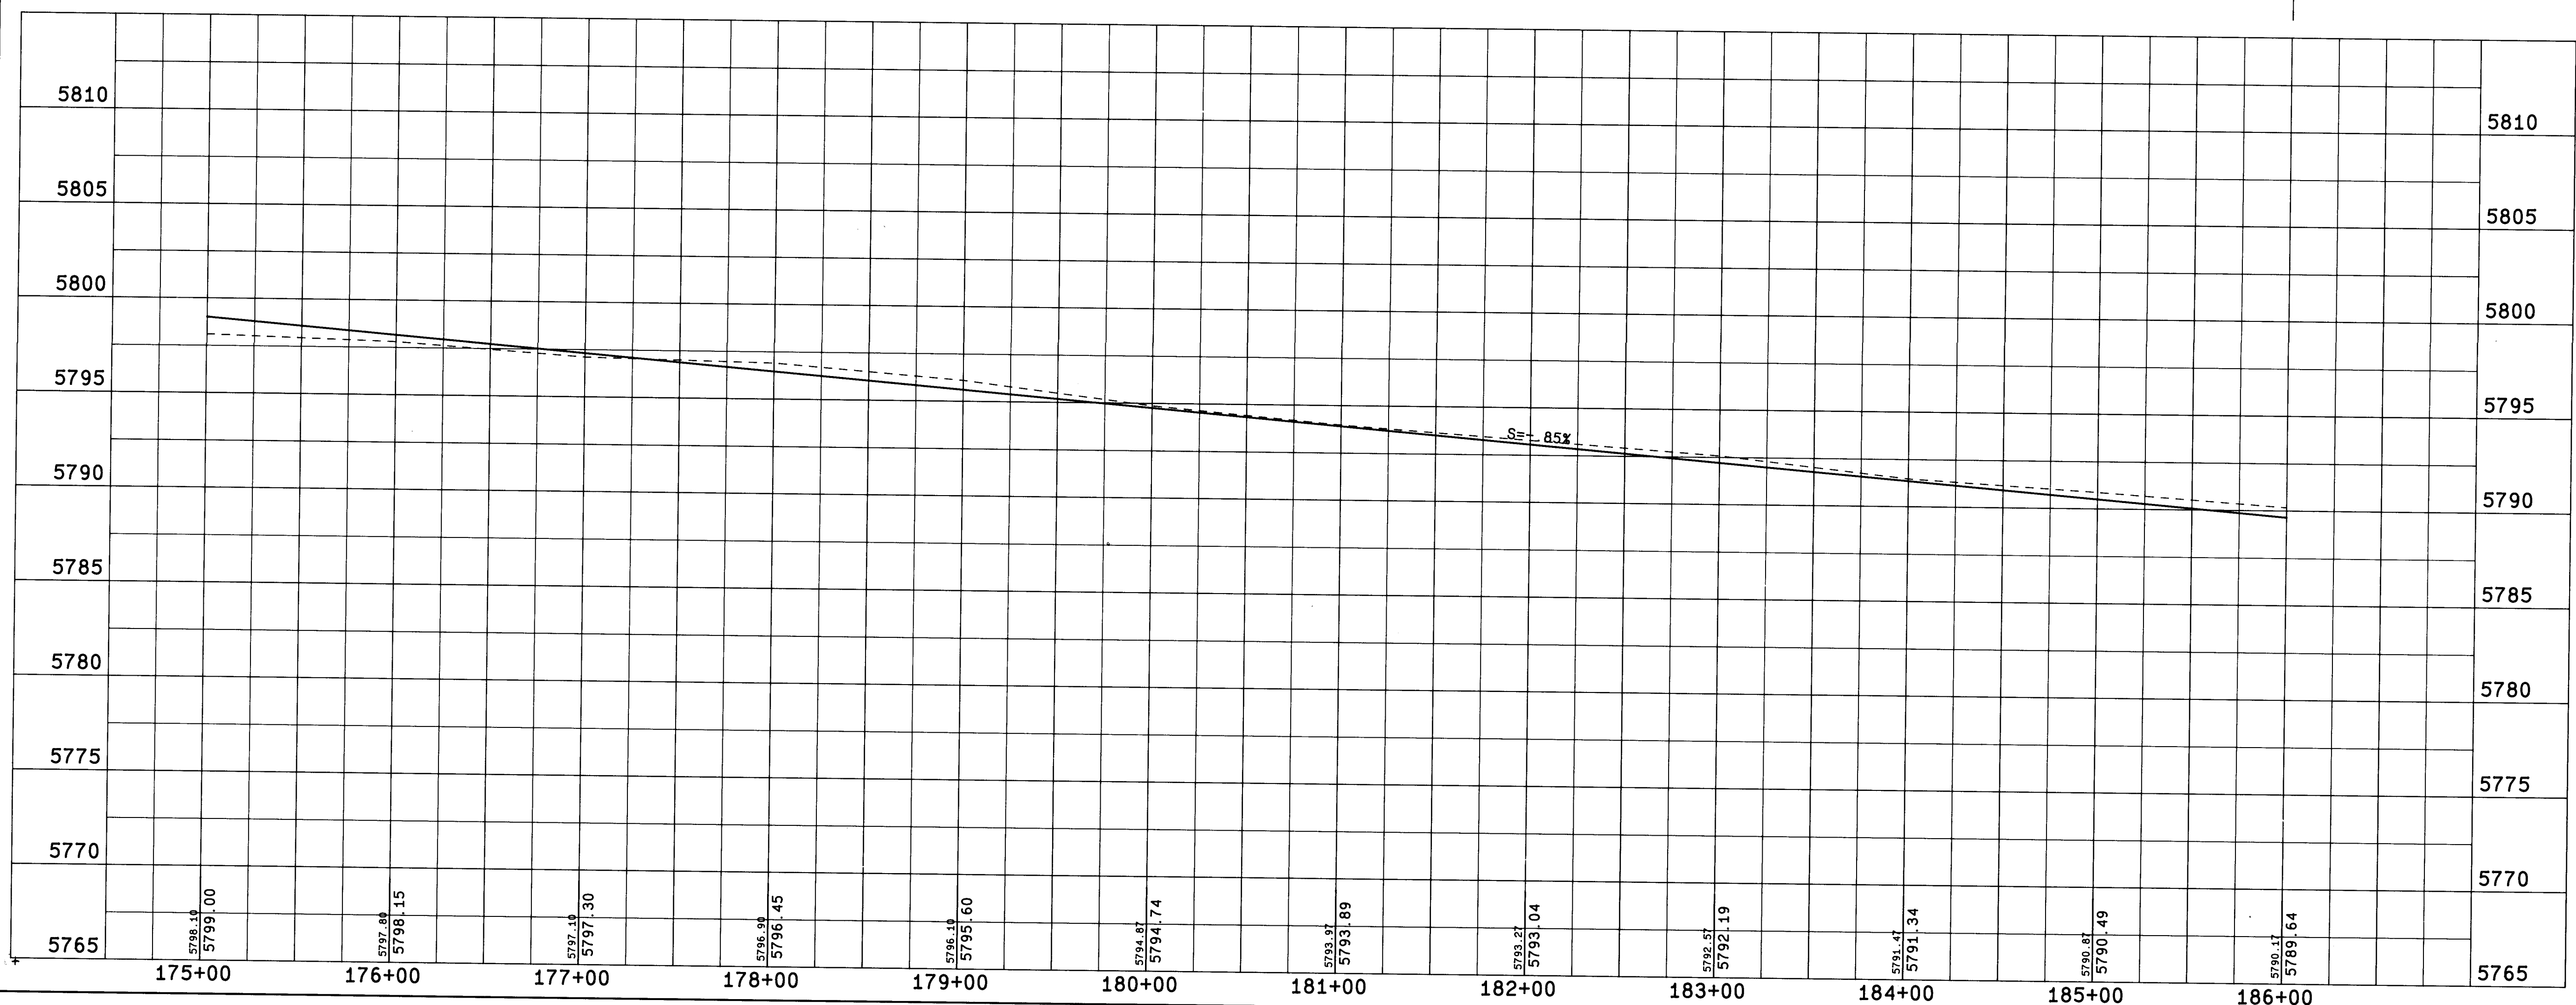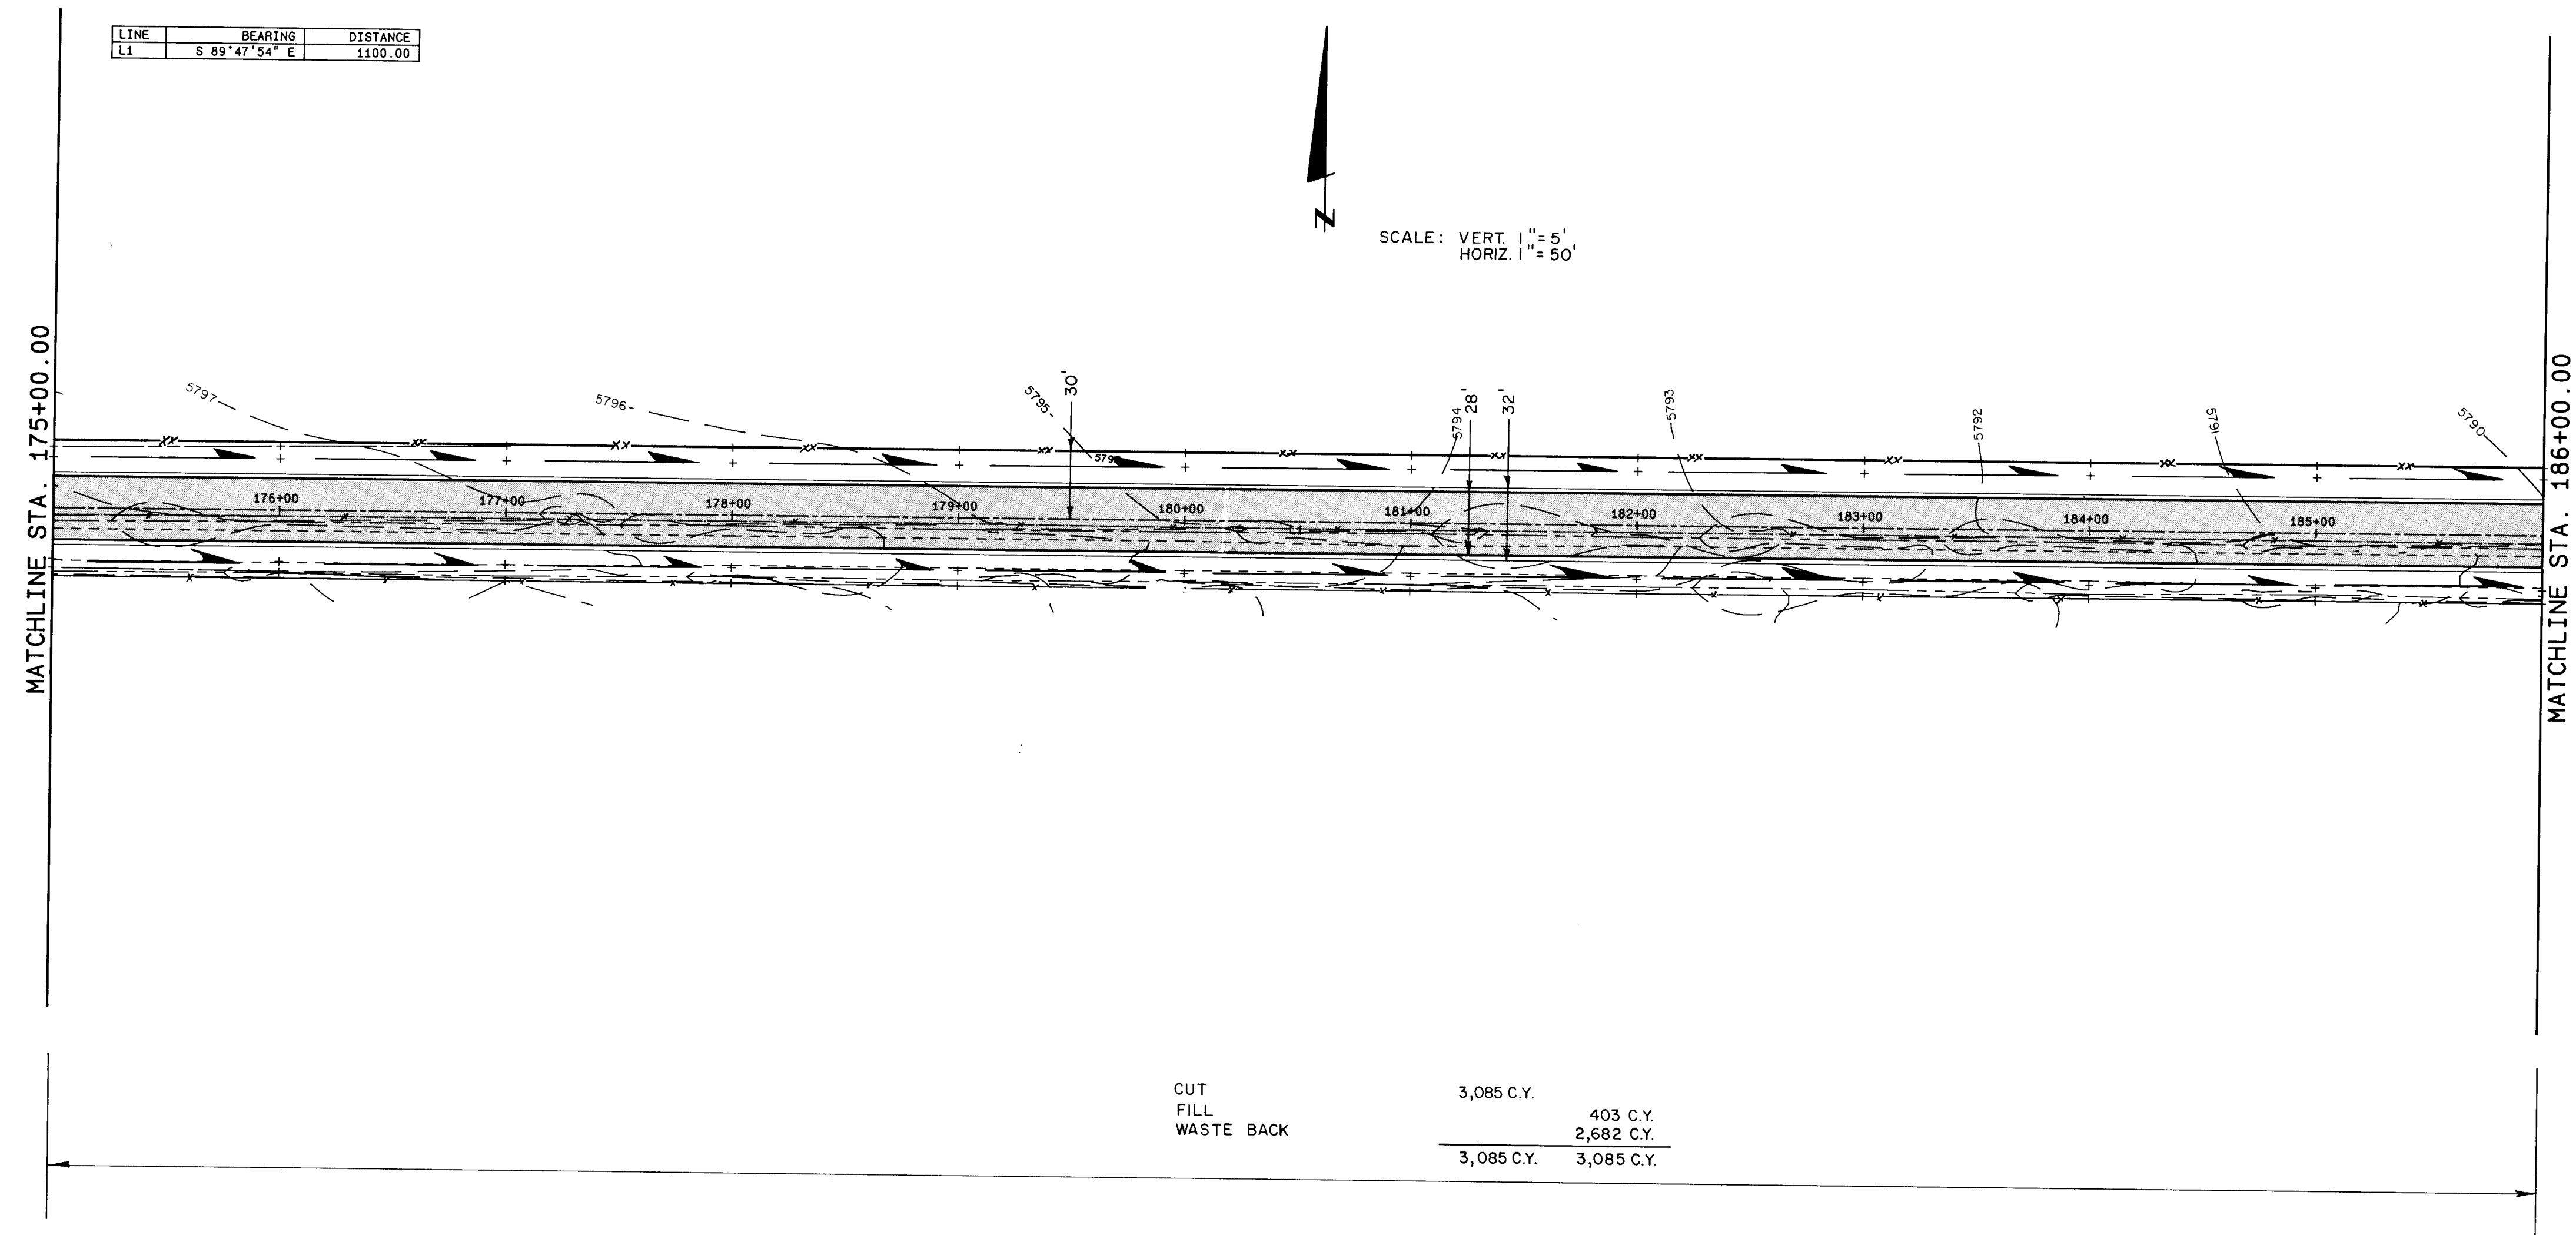

SEE SHEET 4 FOR LEGEND

[illegible]

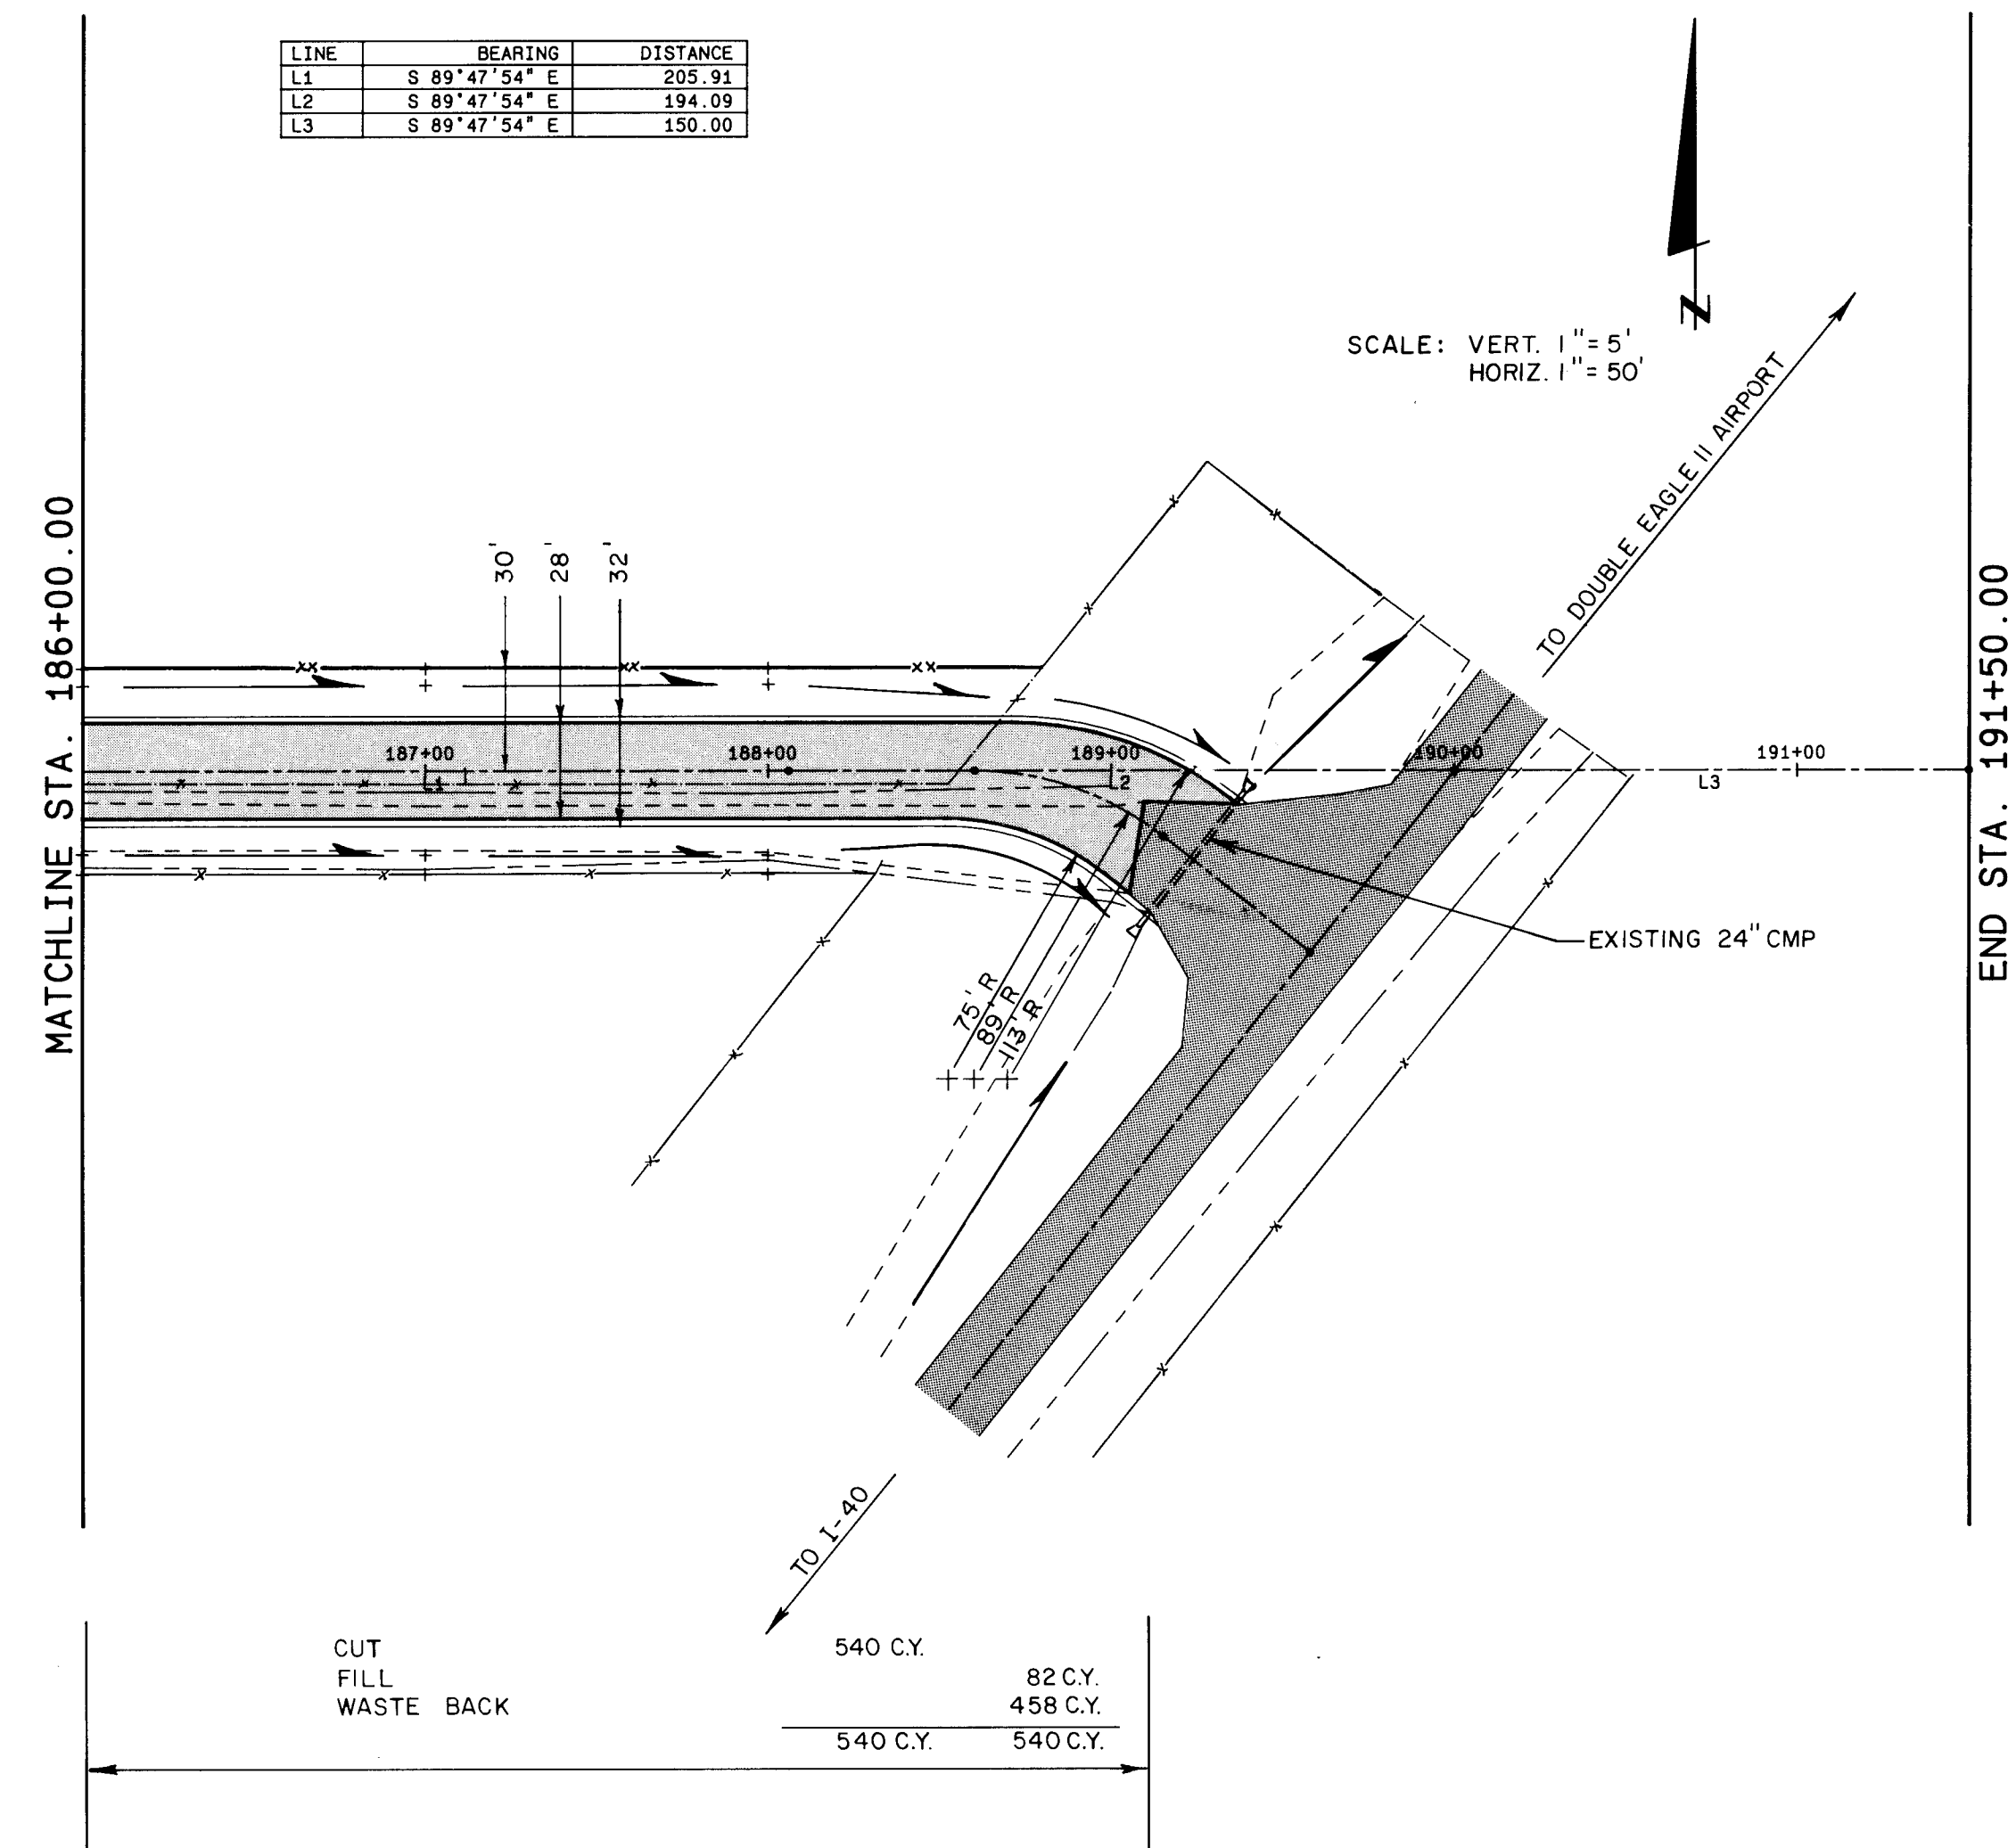

Profile view of a road segment. The vertical axis represents elevation in feet, ranging from 5760 to 5805. The horizontal axis represents stationing, ranging from 186+00 to 194+00. The profile shows a proposed grade (solid line) and an existing grade (dashed line). A vertical curve is indicated by the label $S = -.85\%$. Key points marked include PVI STA. 189+10.00, 5787.00, and 5784.95. The profile shows a slight dip in the existing grade around station 190+00.

SEE SHEET 4 FOR LEGEND

C of A PWD Maps & Records

1	2	3	4	5	6	7	8	9	10	11	12
2	6		3	4	0	6	2	1	9	2	

RECORD DRAWING

DATE: MARCH 1992	DRAFTED BY: D. SALAZAR
---------------------	---------------------------

THESE RECORD DRAWINGS HAVE BEEN PREPARED, IN PART, ON THE BASIS OF INFORMATION COMPILED AND FURNISHED BY OTHERS. THE ENGINEER WILL NOT BE RESPONSIBLE FOR ANY ERRORS OR OMISSIONS WHICH HAVE BEEN INCORPORATED INTO THIS DOCUMENT AS A RESULT.



SOLIDS HANDLING FACILITIES
PHASE II B-3, CONTRACT 2

STANLEY CONSULTANTS 

A JOINT VENTURE

CITY OF ALBUQUERQUE
PUBLIC WORKS DEPARTMENT
LIQUID WASTE DIVISION

TITLE: PLAN AND PROFILE
SAF ACCESS ROAD

APPROVALS	ENGINEER	DATE	APPROVALS	ENGINEER	DATE
City Engineer			Liquid Waste		
A.C.E.—Design			Traffic		
A.C.E.—Hydrology			Water		

DRAWING NO.	3406	MAP NO.	SHEET 21 OF 27
-------------	------	---------	----------------

AS BUILT INFORMATION	
INTRACTOR	
MAKED BY	DATE
INSPECTOR'S	
ACCEPTANCE BY	DATE
PREPARATION BY	DATE
DRAWINGS	
DIRECTED BY	DATE
MICRO-FILM INFORMATION	
RECORDED BY	DATE

BENCH MARKS


ADDITIONAL NOTES

NOTES

FIELD

[illegible]

ENGINEER'S SEAL

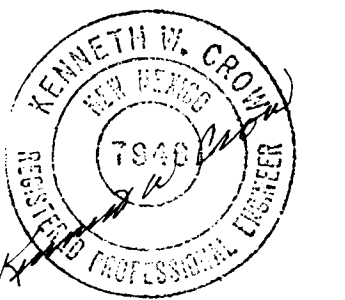


--	--

QUESTION

AD
LS

5

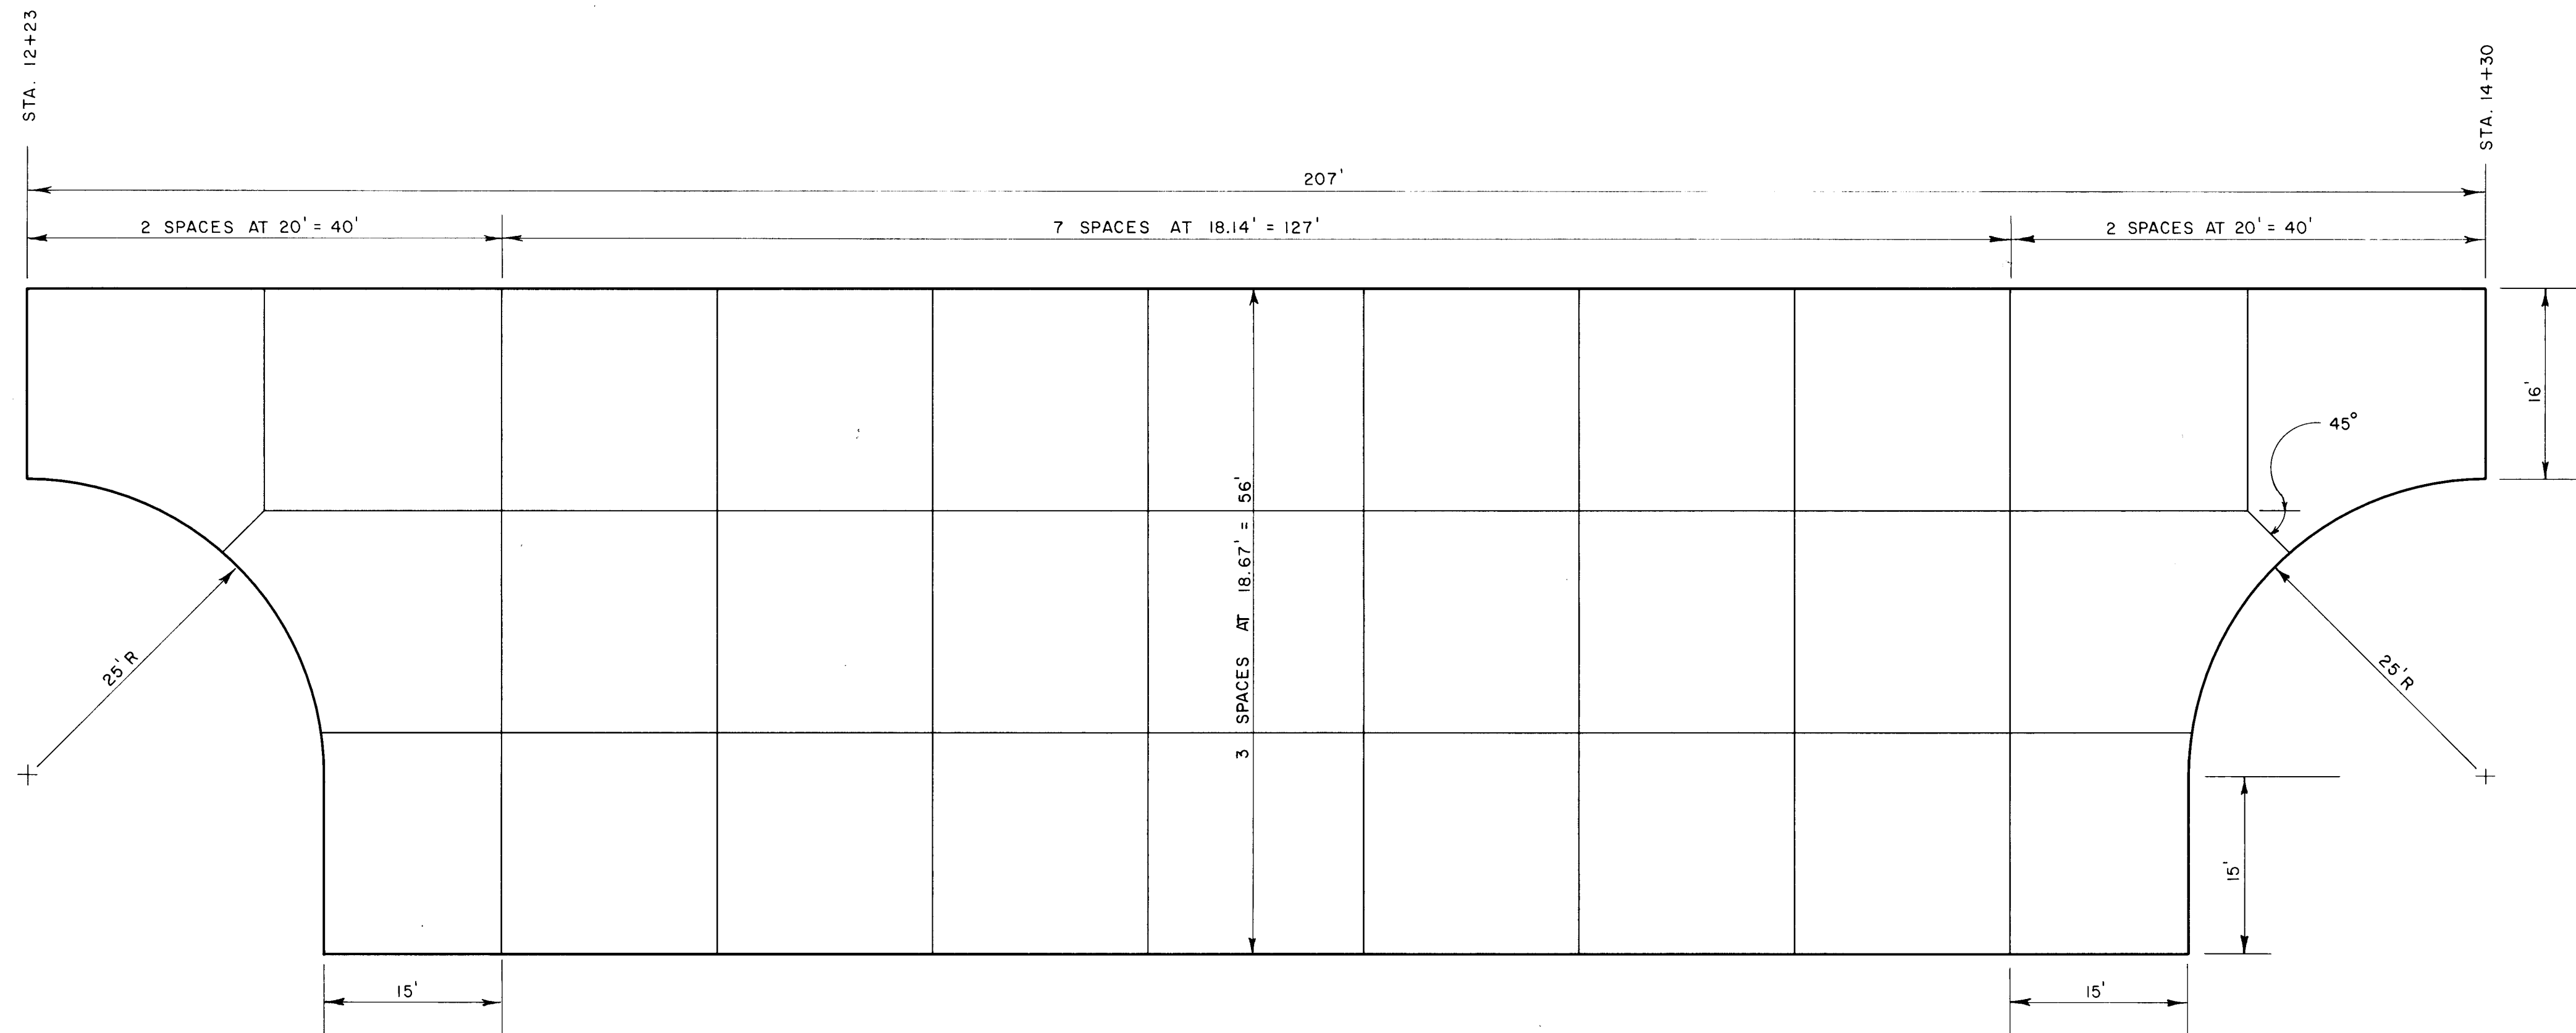

C of A PWD Maps & Records
1 2 3 4 5 6 7 8 9 10 11 12
2 4 3 4 0 2 2 9 2 1

RECORD DRAWING	
DATE: MARCH 1992	DRAFTED BY: D. SALAZAR
THESE RECORD DRAWINGS HAVE BEEN PREPARED, IN PART, ON THE BASIS OF INFORMATION COMPILED AND FURNISHED BY OTHERS. THE ENGINEER WILL NOT BE RESPONSIBLE FOR ANY ERRORS OR OMISSIONS WHICH HAVE BEEN INCORPORATED INTO THIS DOCUMENT AS A RESULT.	



CITY OF ALBUQUERQUE, NEW MEXICO
SOLIDS HANDLING FACILITIES
PHASE II B-3, CONTRACT 2




MOLZEN-CORBIN
STANLEY CONSULTANTS
A JOINT VENTURE

CITY OF ALBUQUERQUE
PUBLIC WORKS DEPARTMENT
LIQUID WASTE DIVISION

TITLE: CONCRETE PAVEMENT JOINT DETAILS

APPROVALS	ENGINEER	DATE	APPROVALS	ENGINEER	DATE
City Engineer			Liquid Waste		
A.C.E.—Design			Traffic		
A.C.E.—Hydrology			Water		


DRAWING NO. 3406	MAP NO.	SHEET 22 OF 27
------------------	---------	----------------

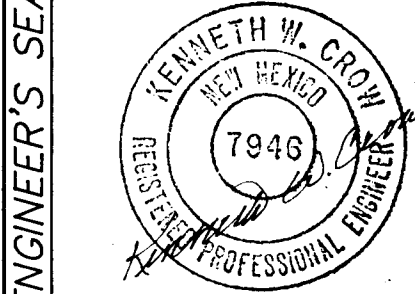

NO.	DATE	REMARKS	BY
		DESIGN	
		REVISIONS	
		DESIGN	
		DESIGNED BY	K.W.C.
		DRAWN BY	
		CHECKED BY	
		DATE	10/12/87
		DATE	
		DATE	

NO.	BY	DATE

AS BUILT INFORMATION		
CONTRACTOR		
STARTED BY		DATE
INSPECTOR'S		DATE
FIELD		DATE
VERIFICATION BY		DATE
CORRECTED BY		DATE
MICRO-FILM INFORMATION		
RECORDED BY		DATE
NO.		

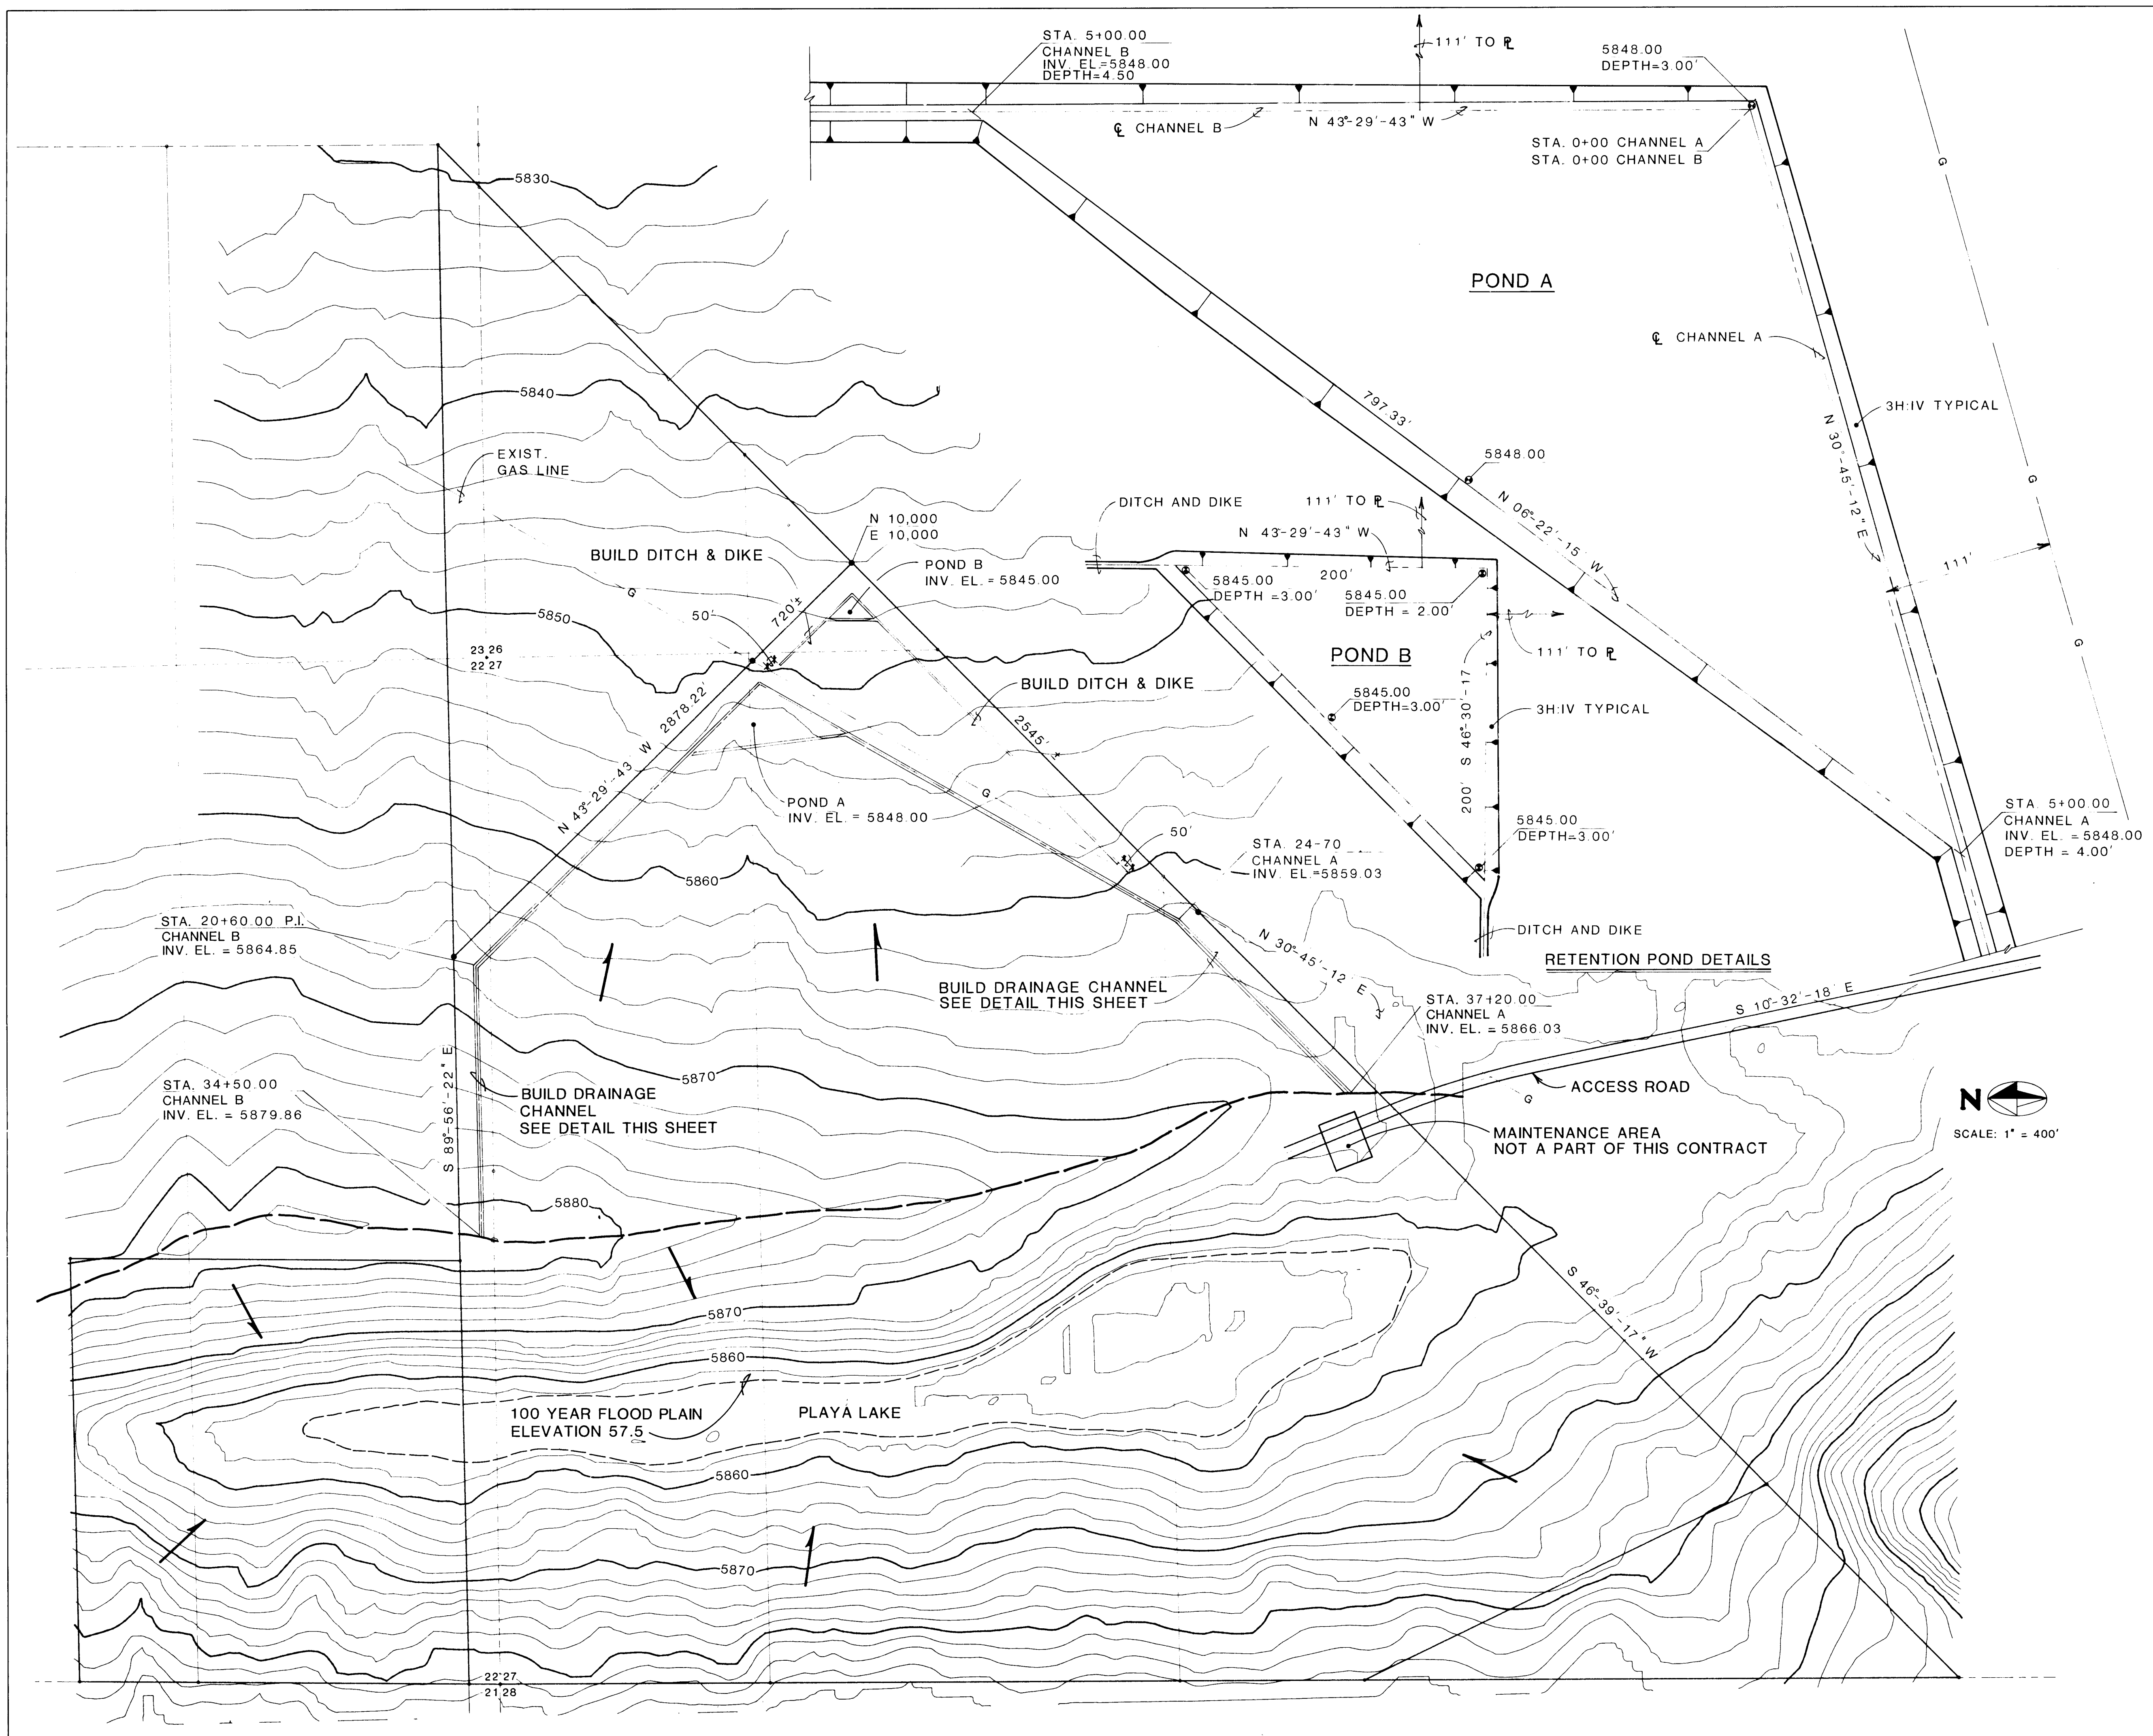

TYPICAL CHANNEL SECTION

NOTE :
CONTRACTOR SHALL NOT PLACE EXCESS MATERIAL FROM EXCAVATION IN THE DESIGNATED EMERGENCY SPILLWAY AREA. EMERGENCY SPILLWAY IS NOT TO BE CONSTRUCTED BUT SHALL BE LEFT AS UNDISTURBED NATURAL GROUND.

TYPICAL DITCH & DIKE SECTION

RECORD DRAWING

DATE: MARCH 1992 DRAFTED BY: D. SALAZAR

THESE RECORD DRAWINGS HAVE BEEN PREPARED, IN PART, ON THE BASIS OF INFORMATION COMPILED AND FURNISHED BY OTHERS. THE ENGINEER WILL NOT BE RESPONSIBLE FOR ANY ERRORS OR OMISSIONS WHICH HAVE BEEN INCORPORATED INTO THIS DOCUMENT AS A RESULT.

RETENTION POND INFORMATION:

POND A	POND B
A = 195 AC.	A = 21 AC.
Tc = 0.45 Hr.	Tc = 0.31 Hr.
P100 = 2.20 in.	P100 = 2.20 in.
CN = 75	CN = 75
Q100 = 94 cfs	Q100 = 13 cfs
V100 = 7.85 AcFt	V100 = 0.84 AcFt
Vact. = 9.20 AcFt	Vact. = 1.01 AcFt

1 of A PWD Maps & Records
26 3406 12392

ENGINEER'S SEAL

DATE: 10/87

DESIGNED BY: K.S.F.

DRAWN BY: CHAVEZ

CHECKED BY: K.S.F.

AS BUILT INFORMATION

BENCH MARKS

SURVEY INFORMATION

FIELD NOTES BY: NO. DATE

REVISIONS

NO. DATE

DESIGN

DATE: 10/87

DATE: 10/87

DATE: 10/87

CITY OF ALBUQUERQUE
PUBLIC WORKS DEPARTMENT
LIQUID WASTE DIVISION








TITLE: SOILS AMENDMENT FACILITY
SITE GRADING PLAN

APPROVALS	ENGINEER	DATE	APPROVALS	ENGINEER	DATE
City Engineer			Liquid Waste		
A.C.E. - Design			Traffic		
A.C.E. - Hydrology			Water		

DRAWING NO. 3406

MAP NO.

SHEET 23 OF 27

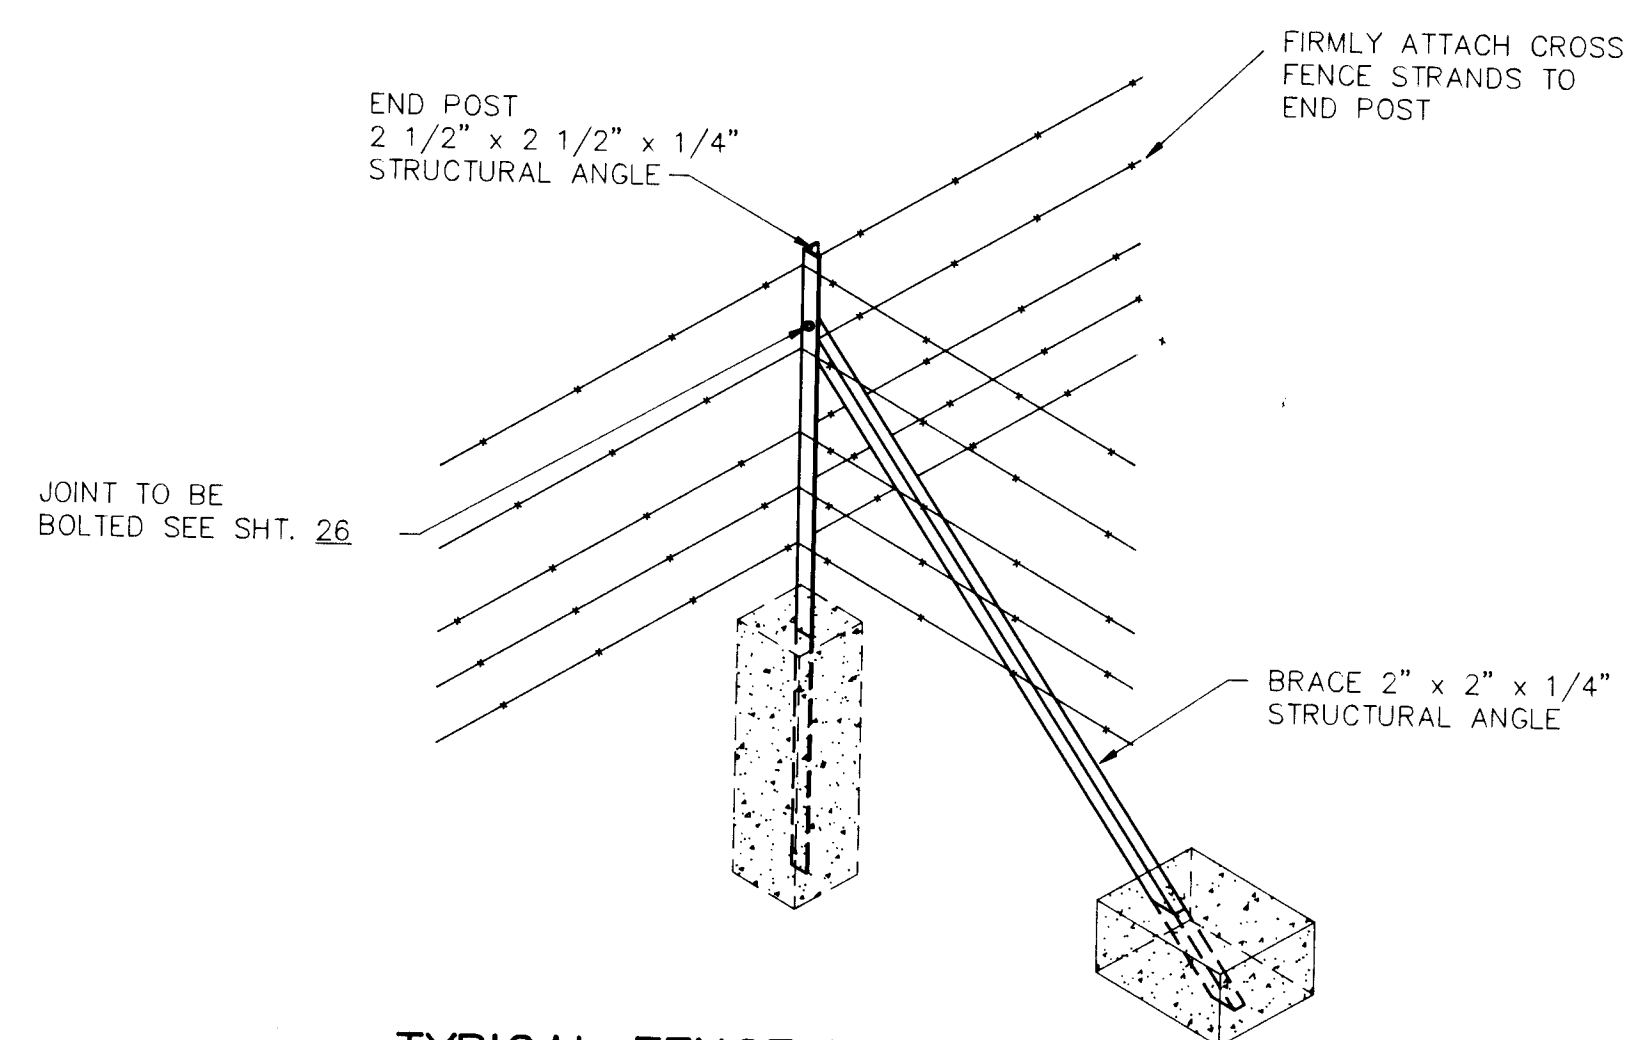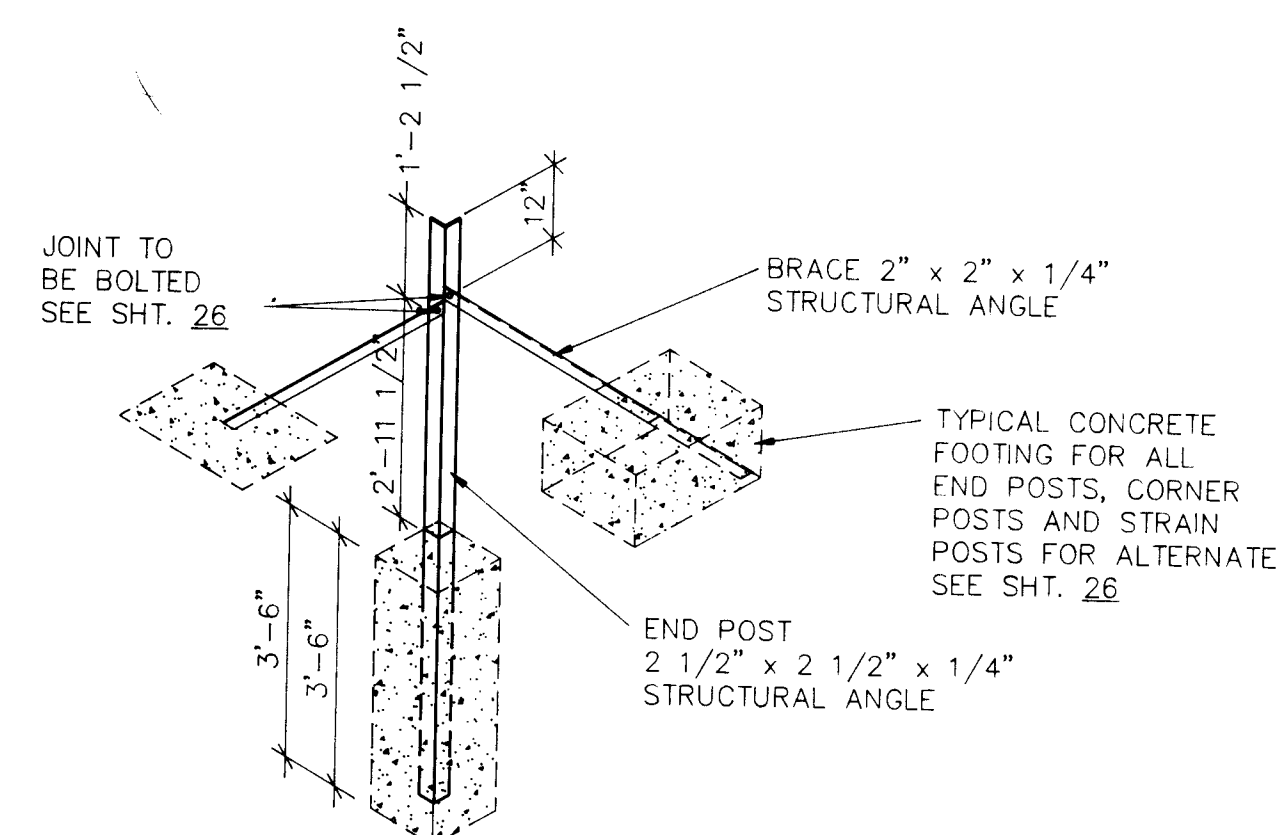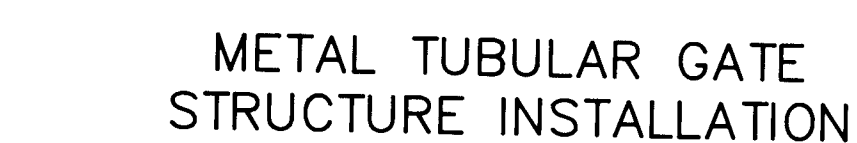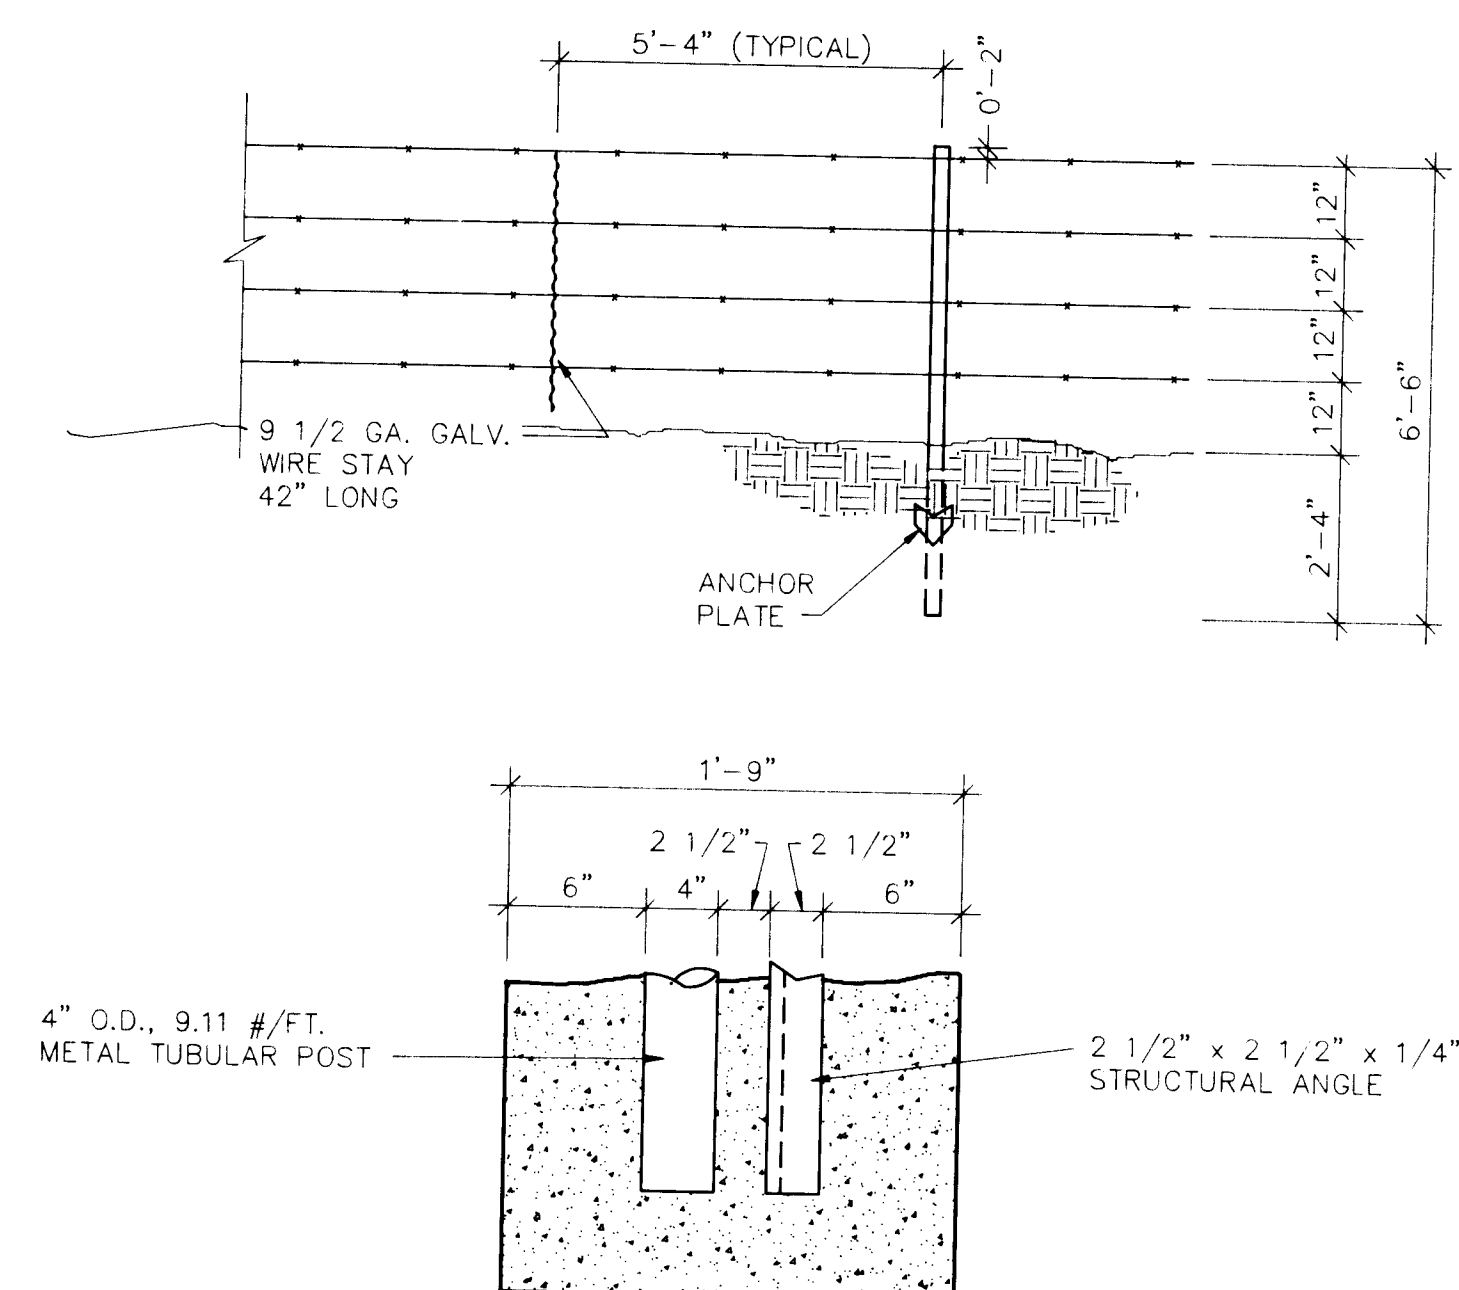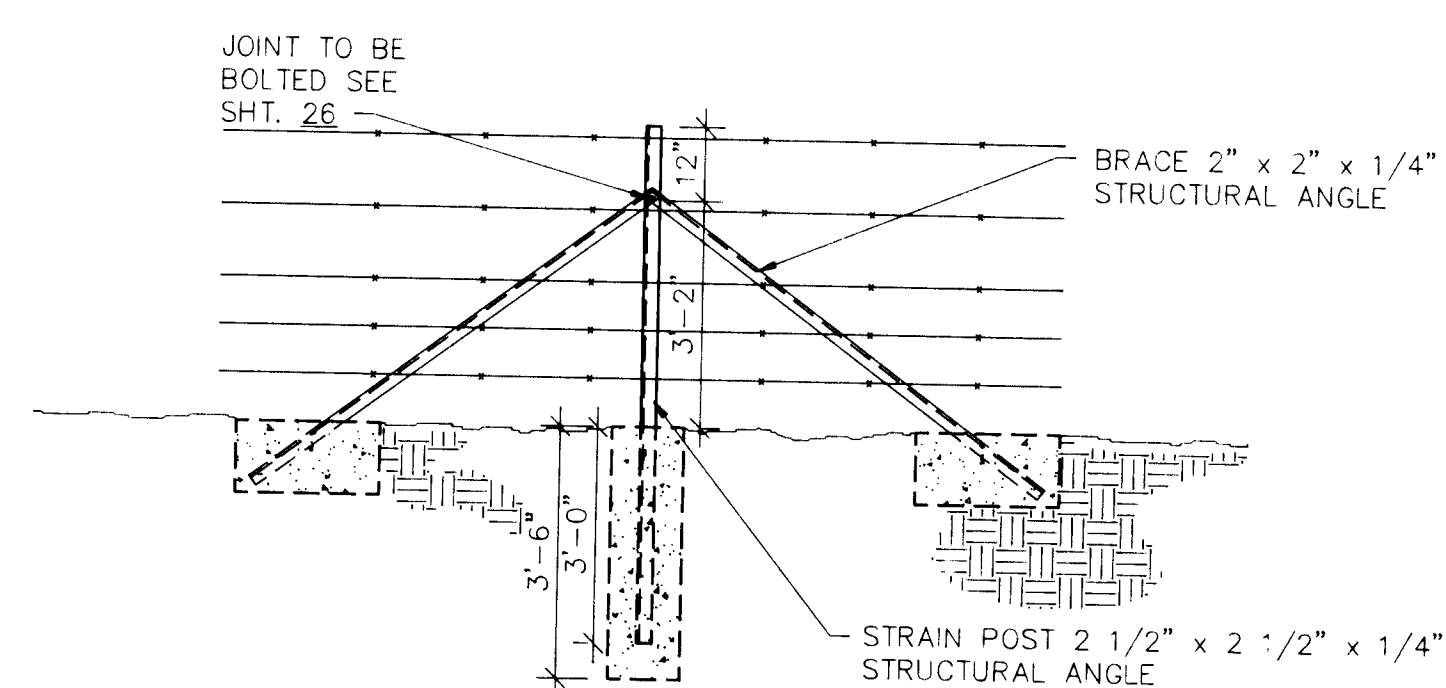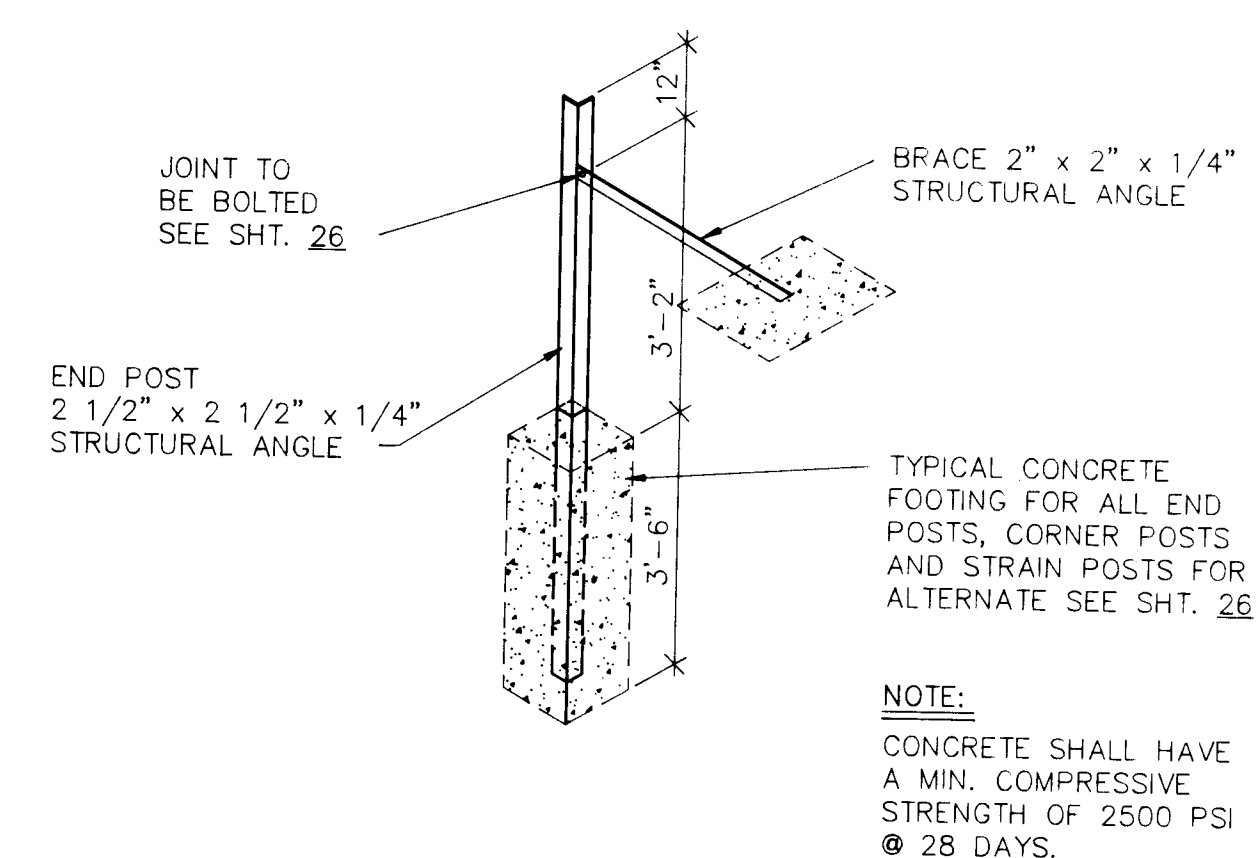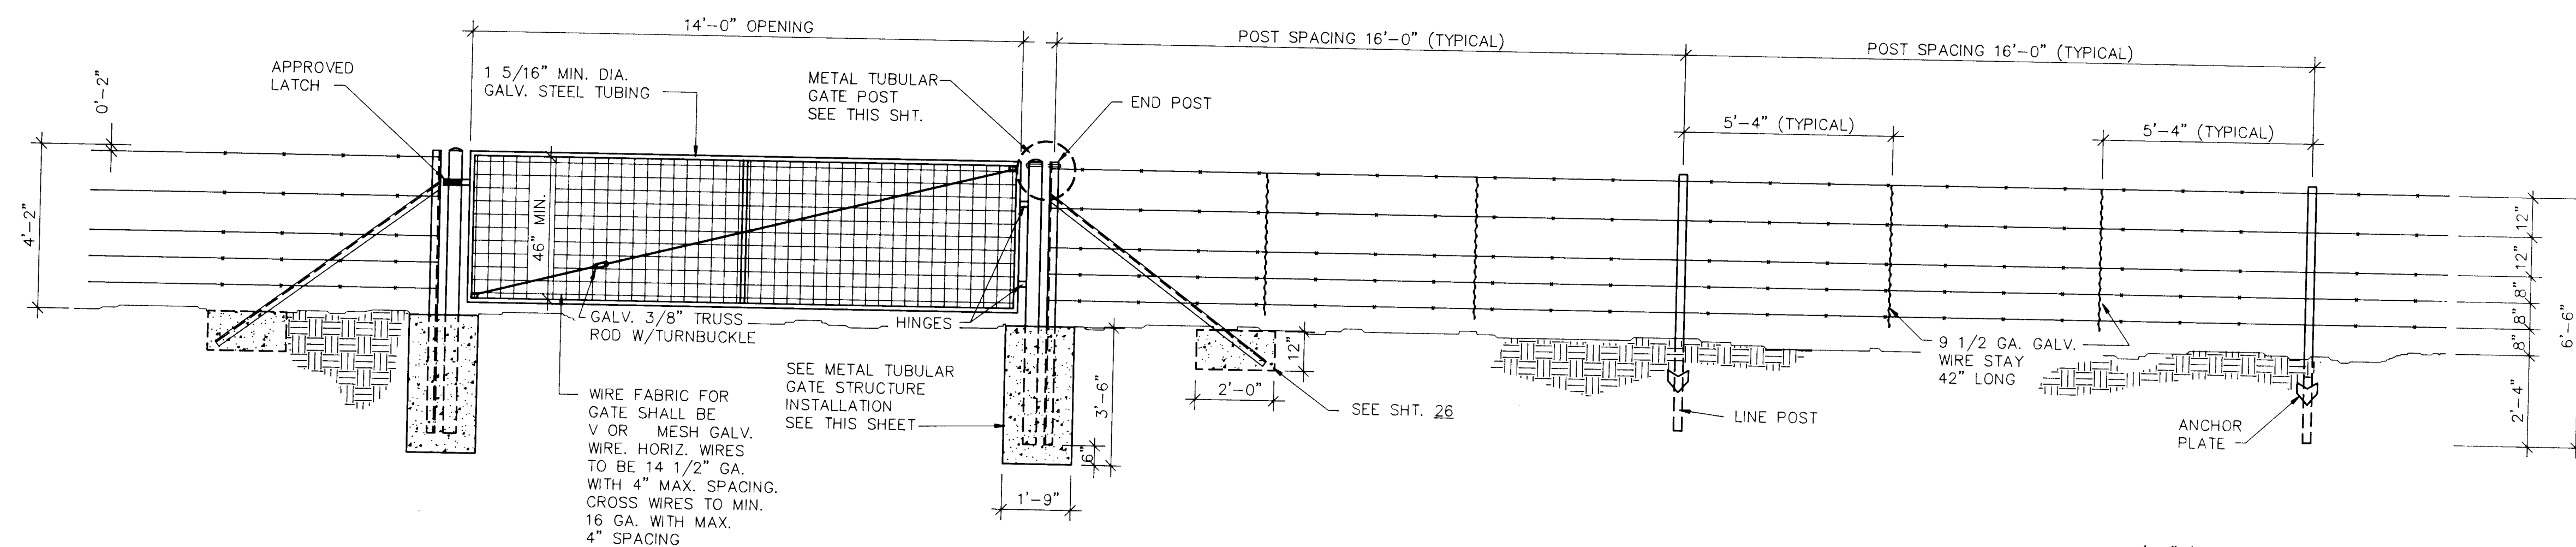

<i>AS-BUILT INFORMATION</i>	
CONTRACTOR	DATE
WORKED BY	DATE
INSPECTOR'S	DATE
ACCEPTANCE BY	DATE
FIELD	DATE
OPERATION BY	DATE
CORRECTED BY	DATE
<i>MICRO-FILM INFORMATION</i>	
RECORDED BY	DATE
NO.	

BENCH MARKS

[illegible]

NO.		DATE	REMARKS	BY
<i>REVISED</i>				
<i>DESIGN</i>				
DESIGNED BY			K.S.F.	DATE 10/87
DRAWN BY			M.B.	DATE 10/87
CHECKED BY			K.S.F.	DATE 10/87

RECORD DRAWING	
DATE: MARCH, 1992	DRAFTED BY: D. SALAZAR
THESE RECORD DRAWINGS HAVE BEEN PREPARED, IN PART, ON THE BASIS OF INFORMATION COMPILED AND FURNISHED BY OTHERS. THE ENGINEER WILL NOT BE RESPONSIBLE FOR ANY ERRORS OR OMISSIONS WHICH HAVE BEEN INCORPORATED INTO THIS DOCUMENT AS A RESULT.	

 CITY OF ALBUQUERQUE, NEW MEXICO

SOLIDS HANDLING FACILITIES


PHASE II B-3, CONTRACT 2

 **MOLZEN-CORBIN**

STANLEY CONSULTANTS 


A JOINT VENTURE

CITY OF ALBUQUERQUE PUBLIC WORKS DEPARTMENT ENGINEERING DIVISION					
TITLE:		SOILS AMENDMENT FACILITY			
FENCING DETAILS					
APPROVALS	ENGINEER	DATE	APPROVALS	ENGINEER	DATE
City Engineer			Liquid Waste		
A.C.E.--Design			Traffic		
A.C.E.--Hydrology			Water		
DRAWING NO. 3406		MAP NO.		SHEET 24 OF 27	

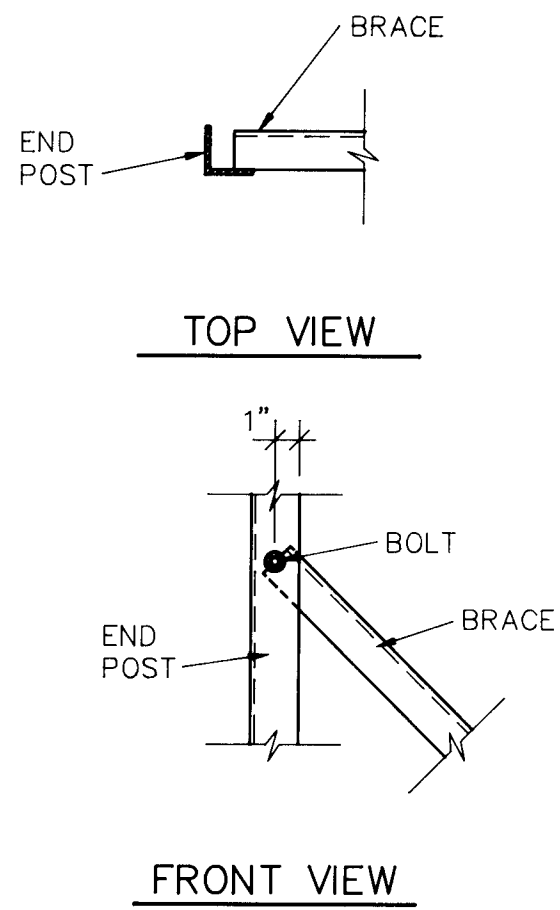


END POST BRACE ATTACHMENT DETAIL

N.T.S.

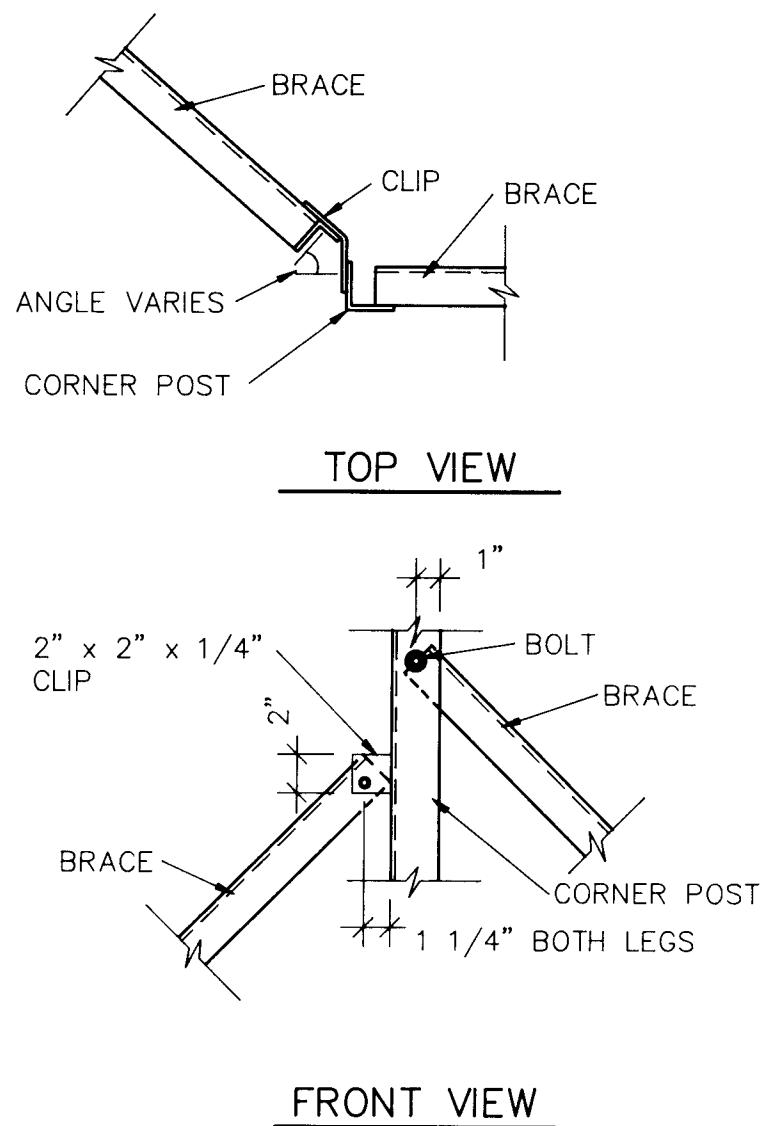


CORNER POST BRACE ATTACHMENT DETAIL

N.T.S.

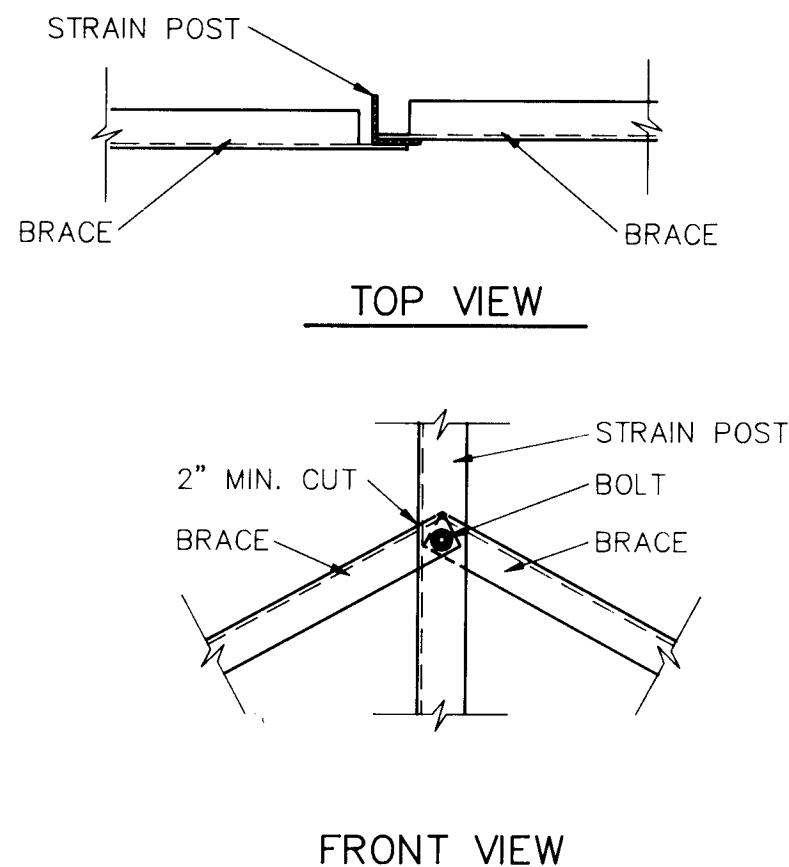


STRAIN POST BRACE ATTACHMENT DETAIL

N.T.S.

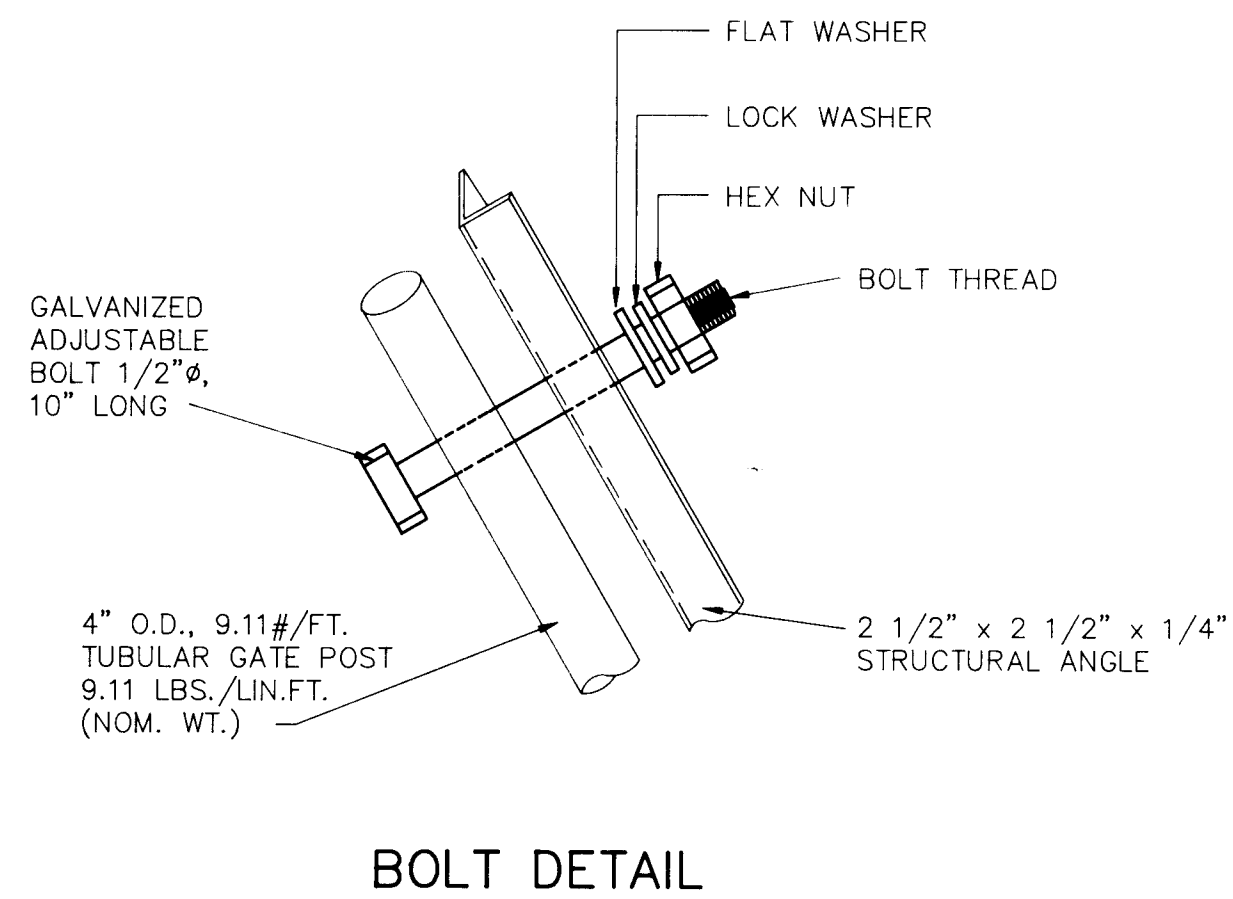


BOLT DETAIL

N.T.S.

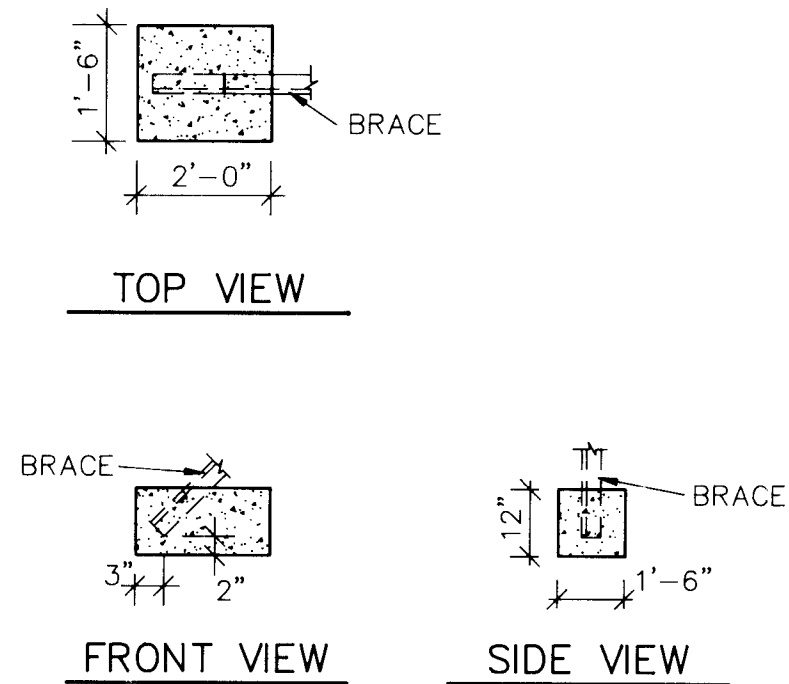

BRACE CONCRETE FOOTING DETAIL

N.T.S.

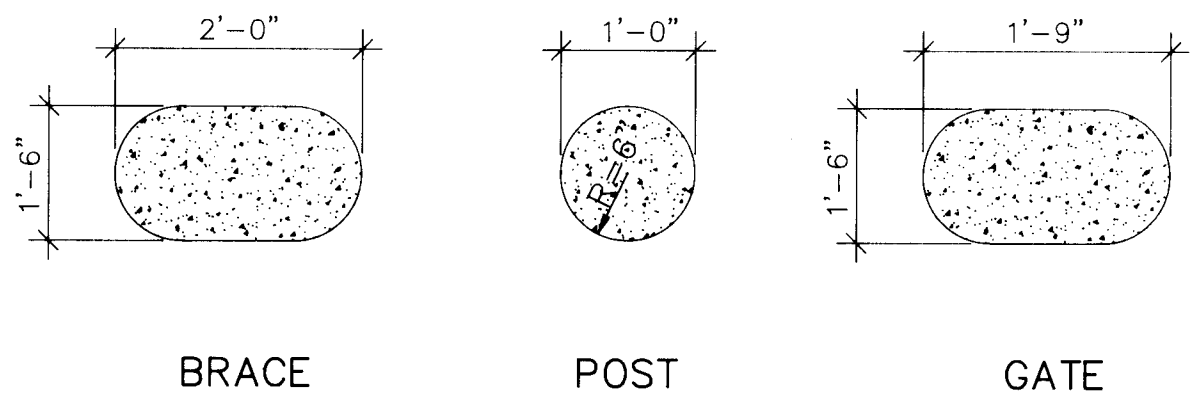

ALTERNATE FOOTING DETAILS

N.T.S.

C of A PWD Maps & Records
1 2 3 4 5 6 7 8 9 10 11 12
26 34 10 12 15 19 21

RECORD DRAWING	
DATE: MARCH 1992	DRAFTED BY: D. SALAZAR
THESE RECORD DRAWINGS HAVE BEEN PREPARED, IN PART, ON THE BASIS OF INFORMATION, COMPILED AND FURNISHED BY OTHERS. THE ENGINEER WILL NOT BE RESPONSIBLE FOR ANY ERRORS OR OMISSIONS WHICH HAVE BEEN INCORPORATED INTO THIS DOCUMENT AS A RESULT.	



CITY OF ALBUQUERQUE, NEW MEXICO

SOLIDS HANDLING FACILITIES

PHASE II B-3, CONTRACT 2




MOLZEN-CORBIN

STANLEY CONSULTANTS

A JOINT VENTURE

CITY OF ALBUQUERQUE PUBLIC WORKS DEPARTMENT ENGINEERING DIVISION SOILS AMENDMENT FACILITY					
TITLE: FENCING DETAILS					
APPROVALS	ENGINEER	DATE	APPROVALS	ENGINEER	DATE
City Engineer			Liquid Waste		
A.C.E.—Design			Traffic		
A.C.E.—Hydrology			Water		
DRAWING NO. 3406		MAP NO.		SHEET 25 OF 27	

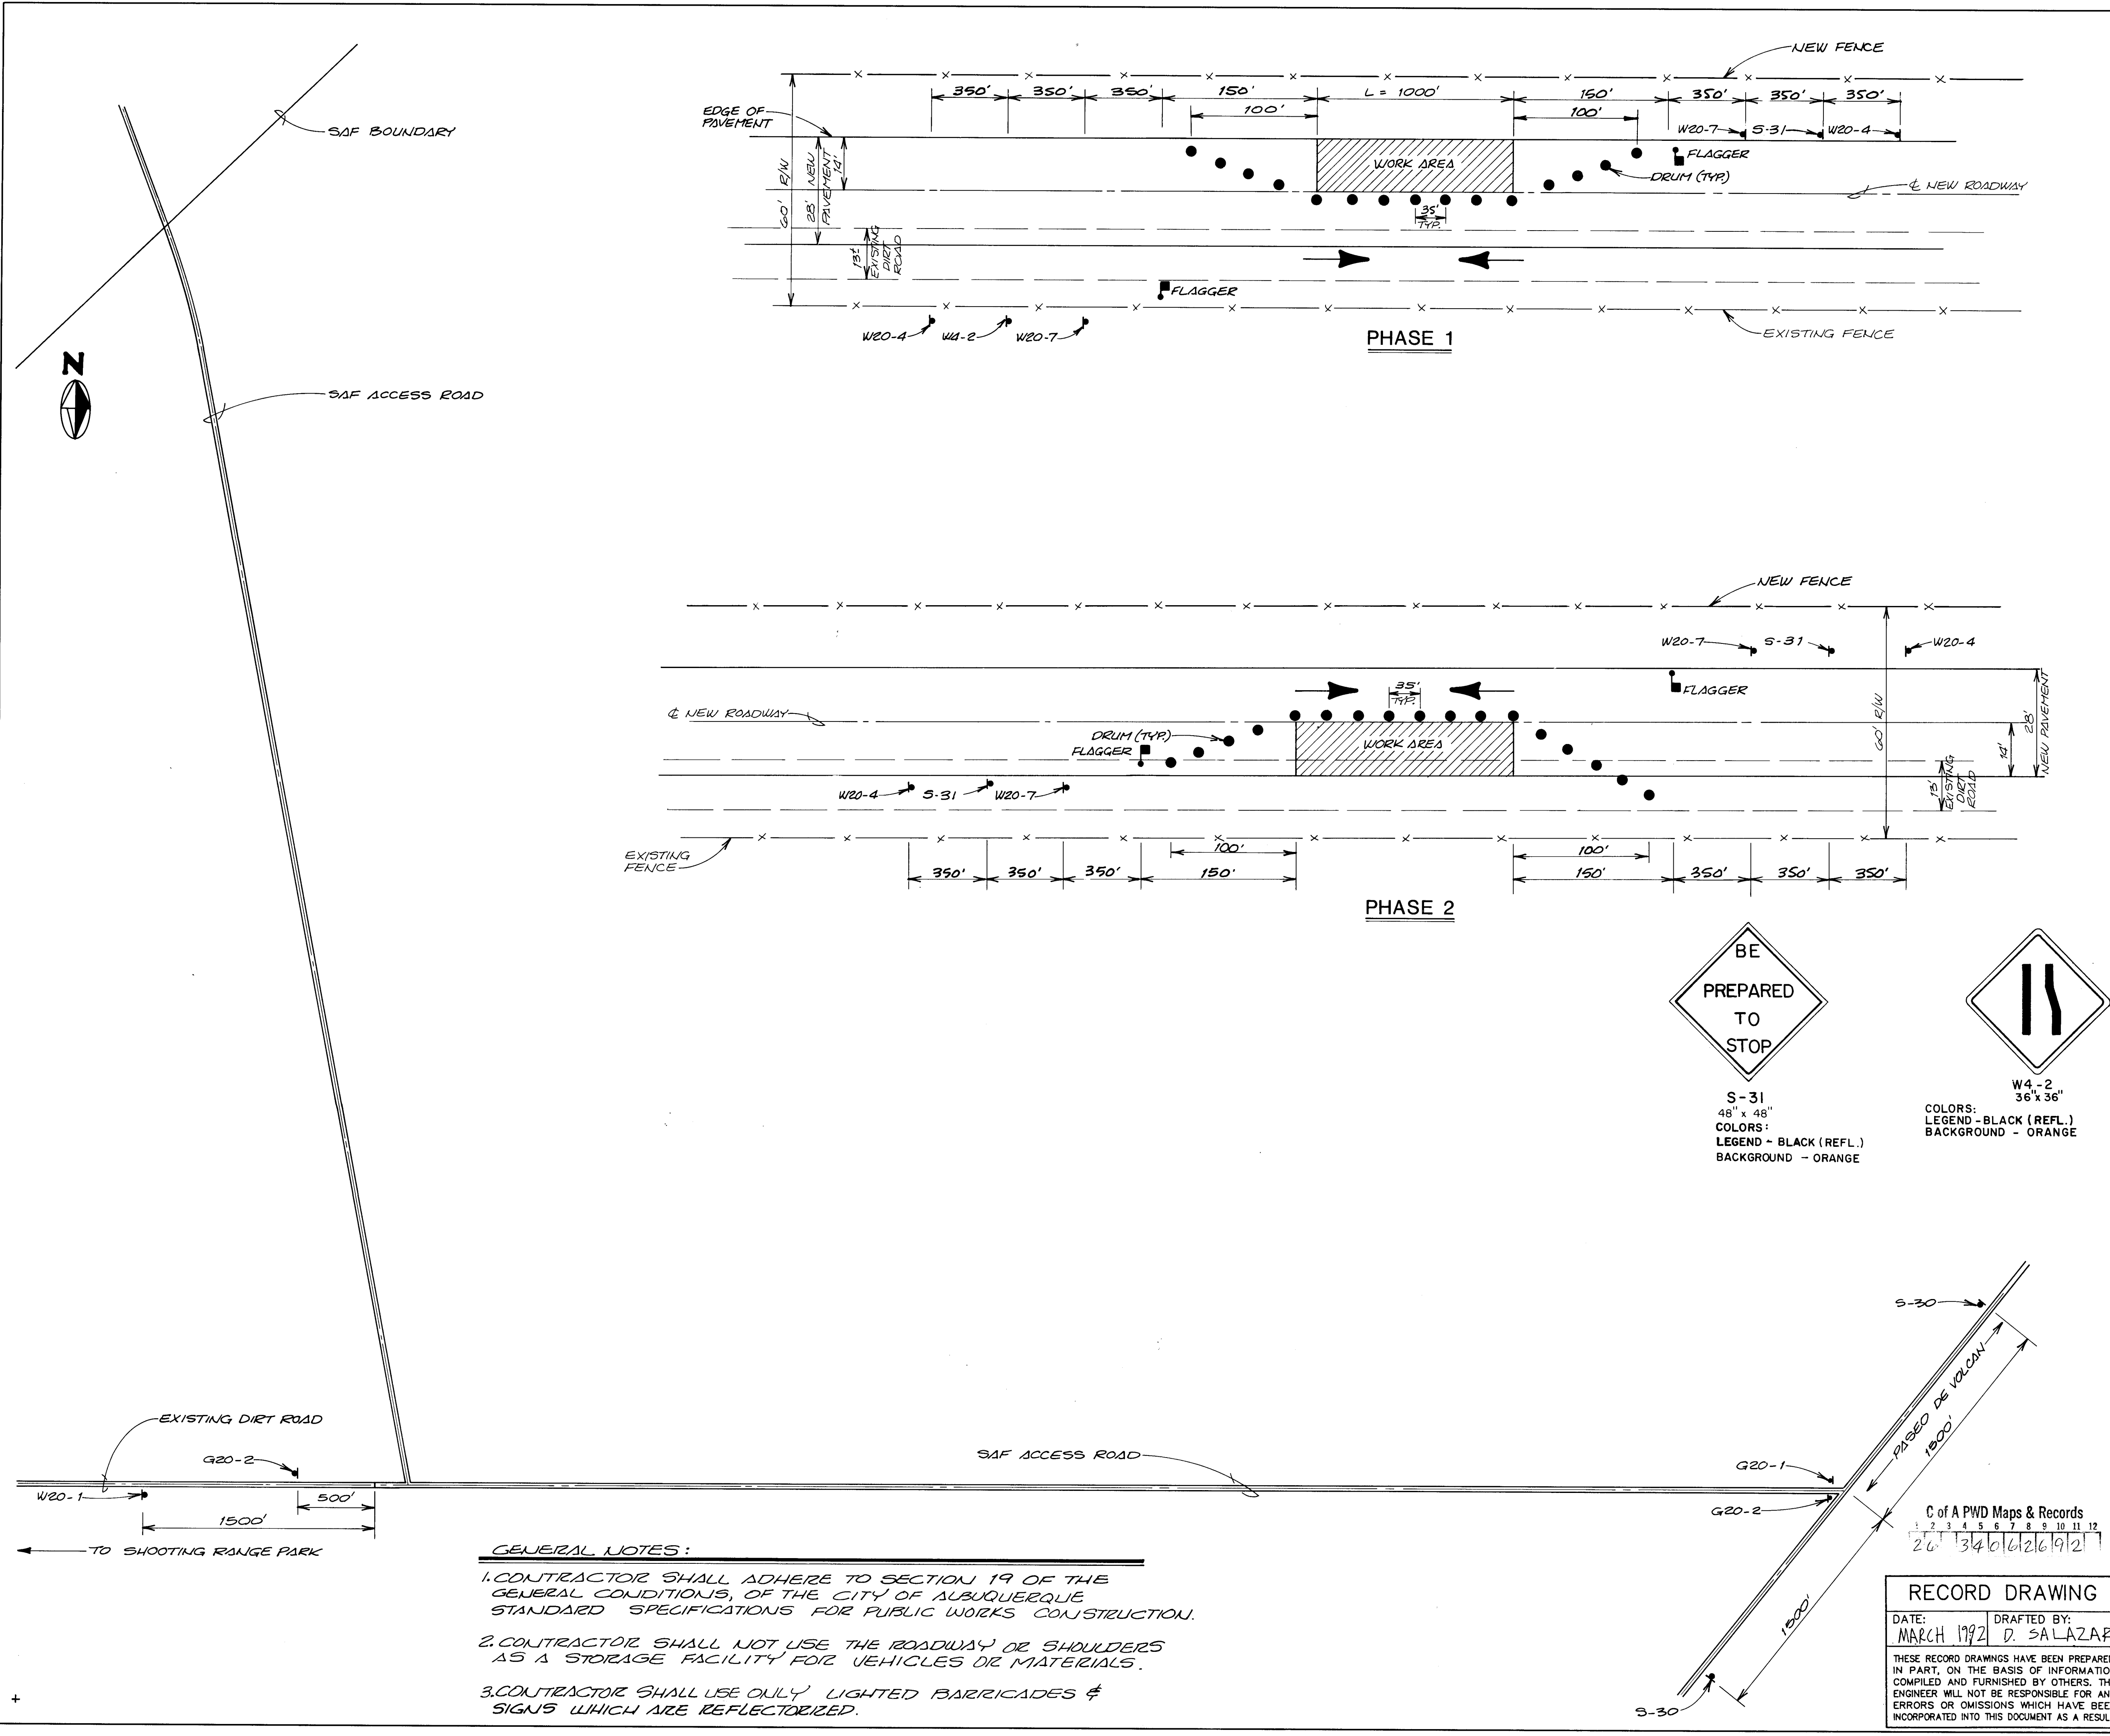

GENERAL NOTES:

1. CONTRACTOR SHALL ADHERE TO SECTION 19 OF THE GENERAL CONDITIONS, OF THE CITY OF ALBUQUERQUE STANDARD SPECIFICATIONS FOR PUBLIC WORKS CONSTRUCTION.
2. CONTRACTOR SHALL NOT USE THE ROADWAY OR SHOULDERS AS A STORAGE FACILITY FOR VEHICLES OR MATERIALS.
3. CONTRACTOR SHALL USE ONLY LIGHTED BARRICADES & SIGNS WHICH ARE REFLECTORIZED.

W20-1 48"x48"
COLORS:
LEGEND - BLACK (REFL.)
BACKGROUND - ORANGE

G20-1 60"x36"
COLORS:
LEGEND - BLACK (REFL.)
BACKGROUND - ORANGE

G20-2
60" x 24"
COLORS:
LEGEND - BLACK (REFL.)
BACKGROUND - ORANGE

S-30 36"x72"
COLORS:
LEGEND - BLACK (REFL.)
BACKGROUND - ORANGE

W20-4
48" x 48"

W20-7
36"x36"

DRUM
18" MIN.
WARNING LIGHT
3' APPROXIMATELY

S-31
48" x 48"
COLORS:
LEGEND - BLACK (REFL.)
BACKGROUND - ORANGE

W4-2
36"x36"
COLORS:
LEGEND - BLACK (REFL.)
BACKGROUND - ORANGE

ENGINEER'S SEAL
KYLE S. FEUER
REGISTERED PROFESSIONAL ENGINEER
NO. 8122
EXPIRATION DATE 12/31/2024

CITY OF ALBUQUERQUE, NEW MEXICO
SOLIDS HANDLING FACILITIES
PHASE II B- , CONTRACT

MOLZEN-CORBIN
STANLEY CONSULTANTS
A JOINT VENTURE

CITY OF ALBUQUERQUE
PUBLIC WORKS DEPARTMENT
LIQUID WASTE DIVISION

TITLE: SOILS AMENDMENT FACILITY
TRAFFIC CONTROL PLAN

APPROVALS	ENGINEER	DATE	APPROVALS	ENGINEER	DATE
City Engineer			Liquid Waste		
A.C.E.-Design			Traffic		
A.C.E.-Hydrology			Water		

DESIGNED BY KSF
DRAWN BY
CHECKED BY

REVISIONS
NO. DATE BY

REMARKS

RECORD DRAWING

DATE: MARCH 1992
DRAFTED BY: D. SALAZAR

THESE RECORD DRAWINGS HAVE BEEN PREPARED, IN PART, ON THE BASIS OF INFORMATION COMPILED AND FURNISHED BY OTHERS. THE ENGINEER WILL NOT BE RESPONSIBLE FOR ANY ERRORS OR OMISSIONS WHICH HAVE BEEN INCORPORATED INTO THIS DOCUMENT AS A RESULT.

DRAWING NO. 3406

MAP NO.

SHEET 26 OF 27

