

LENGTH OF PROJECT 1.008 MILES
LENGTH OF R.O.W. 1.008 MILES

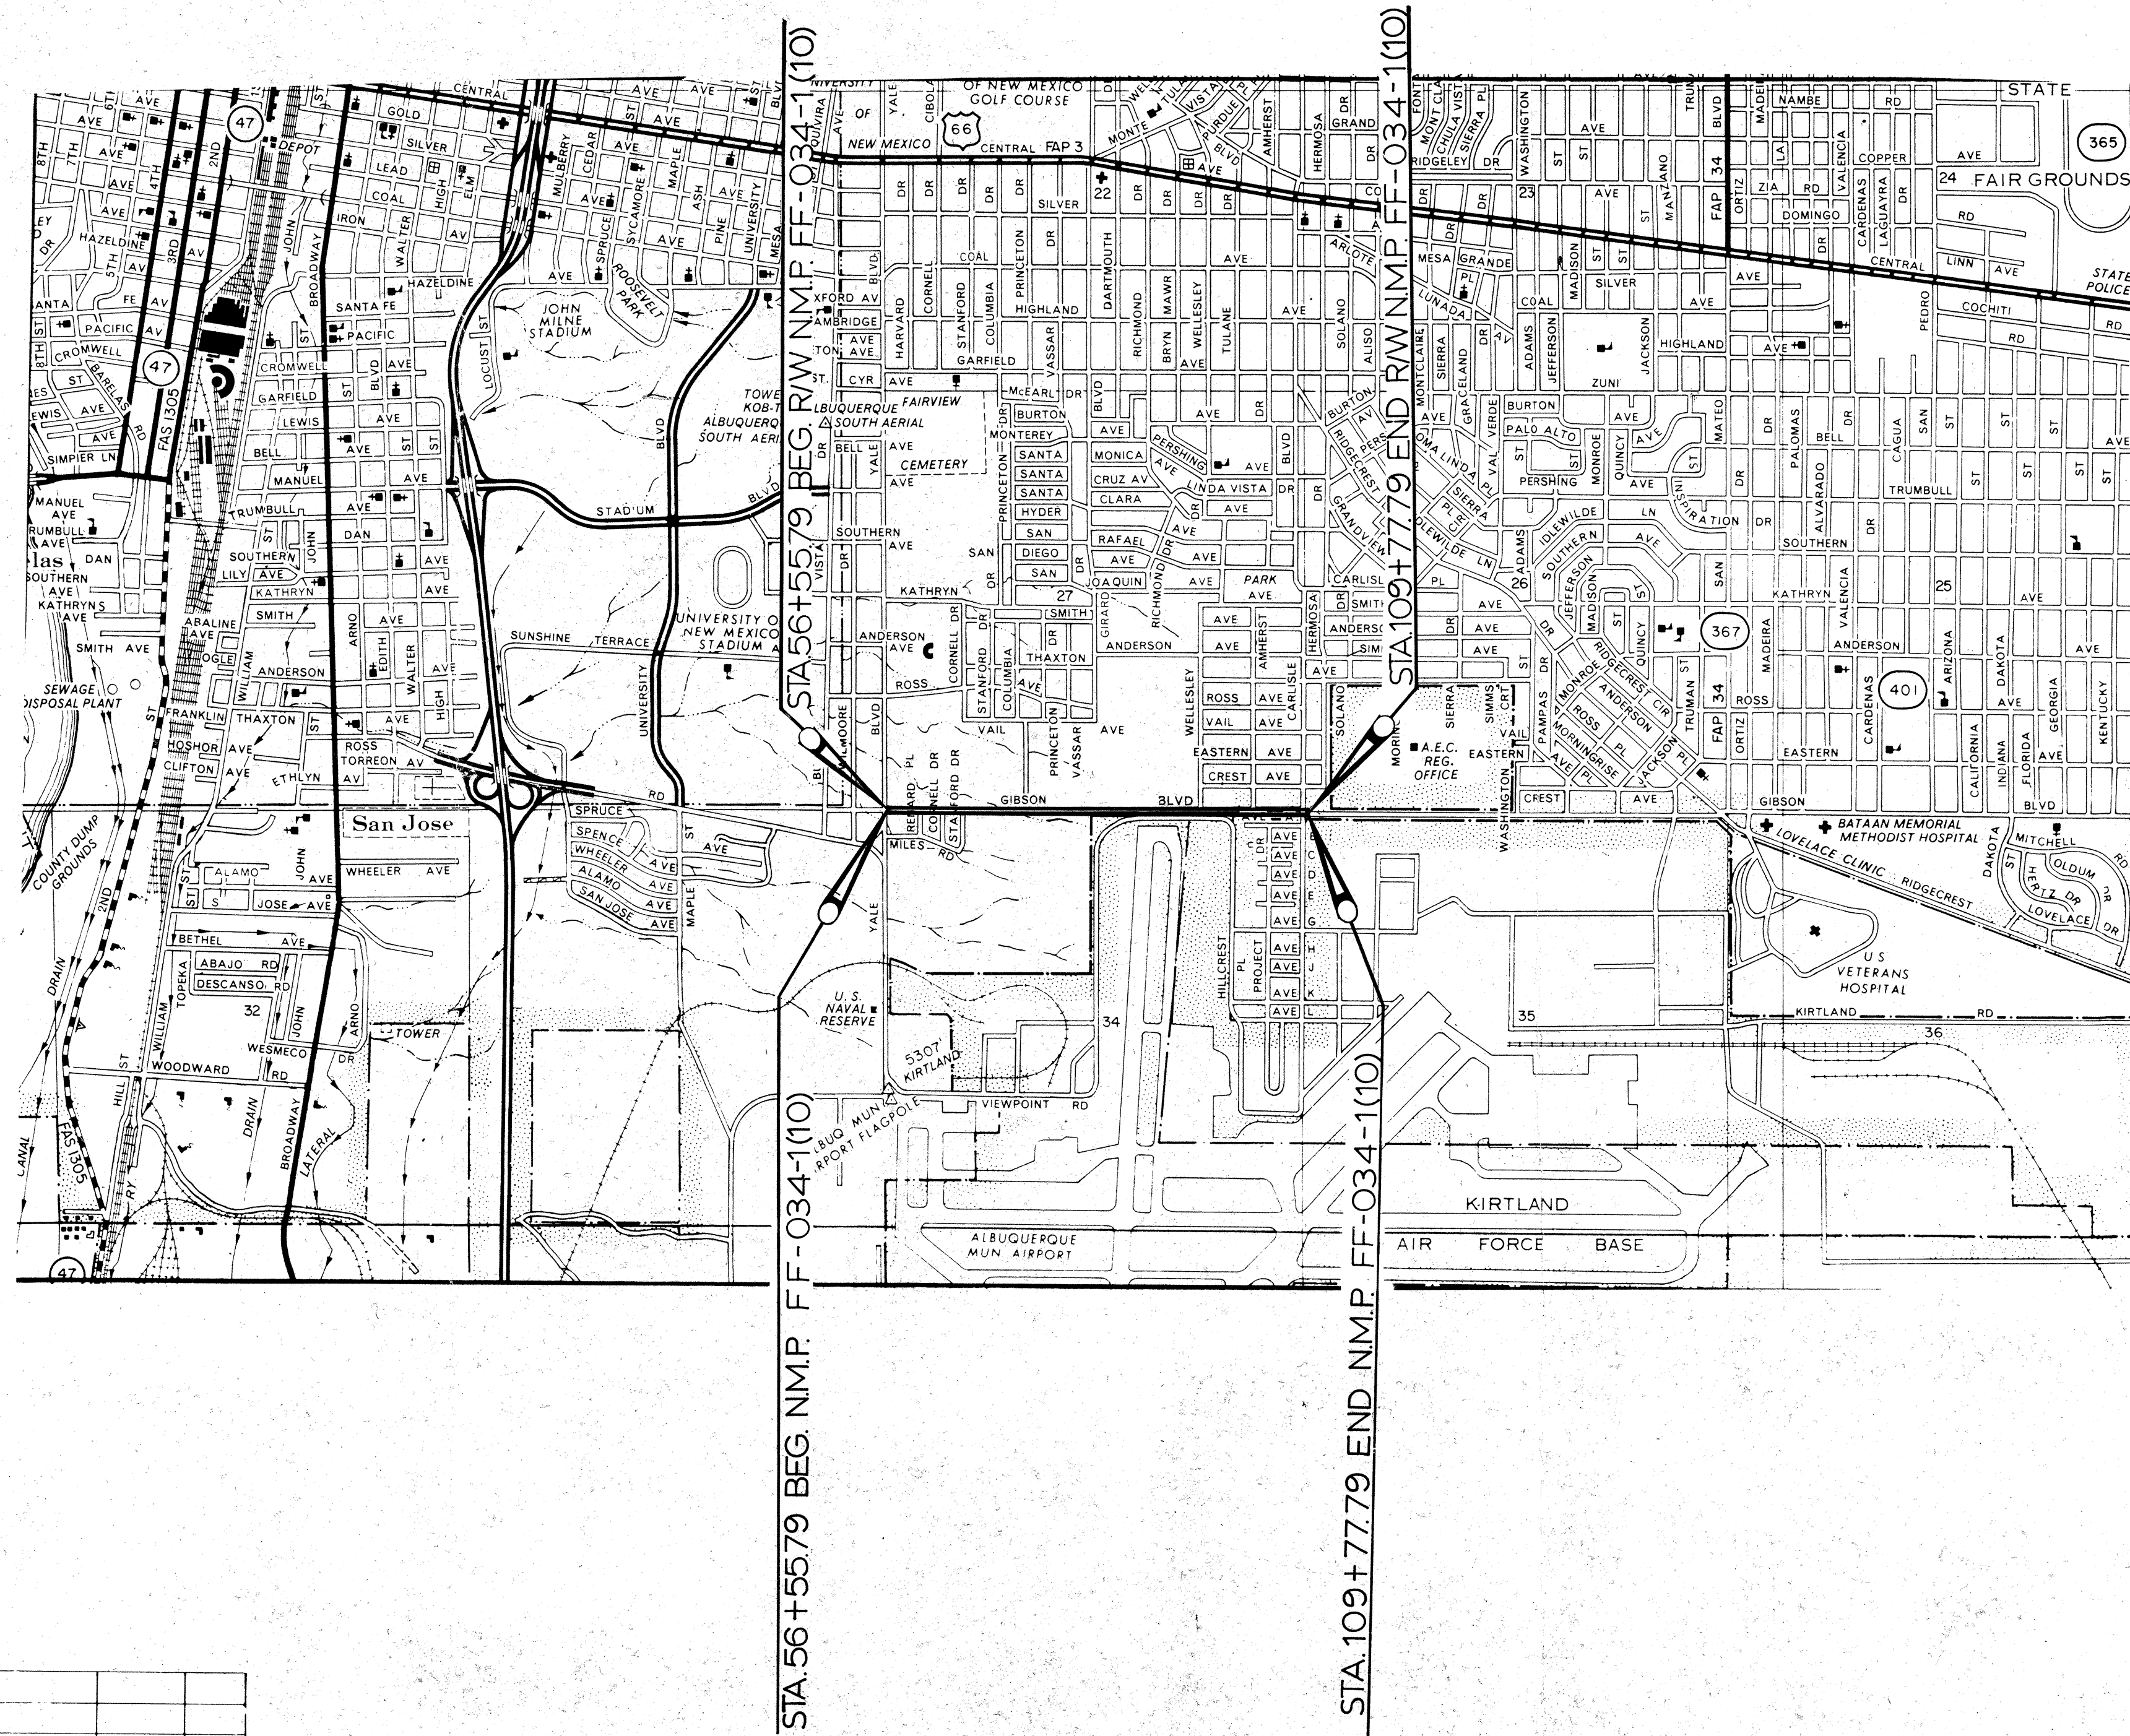
[illegible]

EXHIBIT "A"

APPROVED _____ AUG. _____ 1975
DATE

STATE HIGHWAY ENGINEER
BY *Carl E. Serna*
DEPUTY DESIGN ENGINEER

DEPARTMENT OF TRANSPORTATION
FEDERAL HIGHWAY ADMINISTRATION

APPROVED _____
DIVISION ENGINEER _____ DATE _____
DATE _____ JUN 17 1976

P.E. F-034-1(11)

NEW MEXICO STATE HIGHWAY COMMISSION

RIGHT OF WAY MAP

NEW MEXICO PROJECT NO.

R/W & CONST. FF-034-1(10)

BERNALILLO COUNTY

SCALE 1" = 1' SHEET 1 OF 5

6			
5			
4			
3			
2			
1			
NO	DESCRIPTION	DATE	BY
REVISIONS (OR CHANGE NOTICES)			

PARCEL BLOCKS

[illegible][illegible]

FINAL MAP

DATE AUG. 13, 1975

P.E. F-034-1(11)
NEW MEXICO STATE HIGHWAY COMMISSION

RIGHT OF WAY MAP

NEW MEXICO PROJECT NO.


R/W &
CONST.

FF-034-1(10)

BERNALILLO COUNTY

SCALE 1" = 1' SHEET 1A OF 5


6			
5			
4			
3	REVISED AREA TAKEN PARCELS 3-1 & 3-1-A	6-9-76	M.A.T.
2	REVISED PARCEL 3-1 & ADDED PARCEL 3-1-A	4-5-76	M.A.T.
1	REVISED LARGER PARCEL AREA REM. 3-4 & 3-4-A	2-20-76	J.R.R.
NO.	DESCRIPTION	DATE	BY

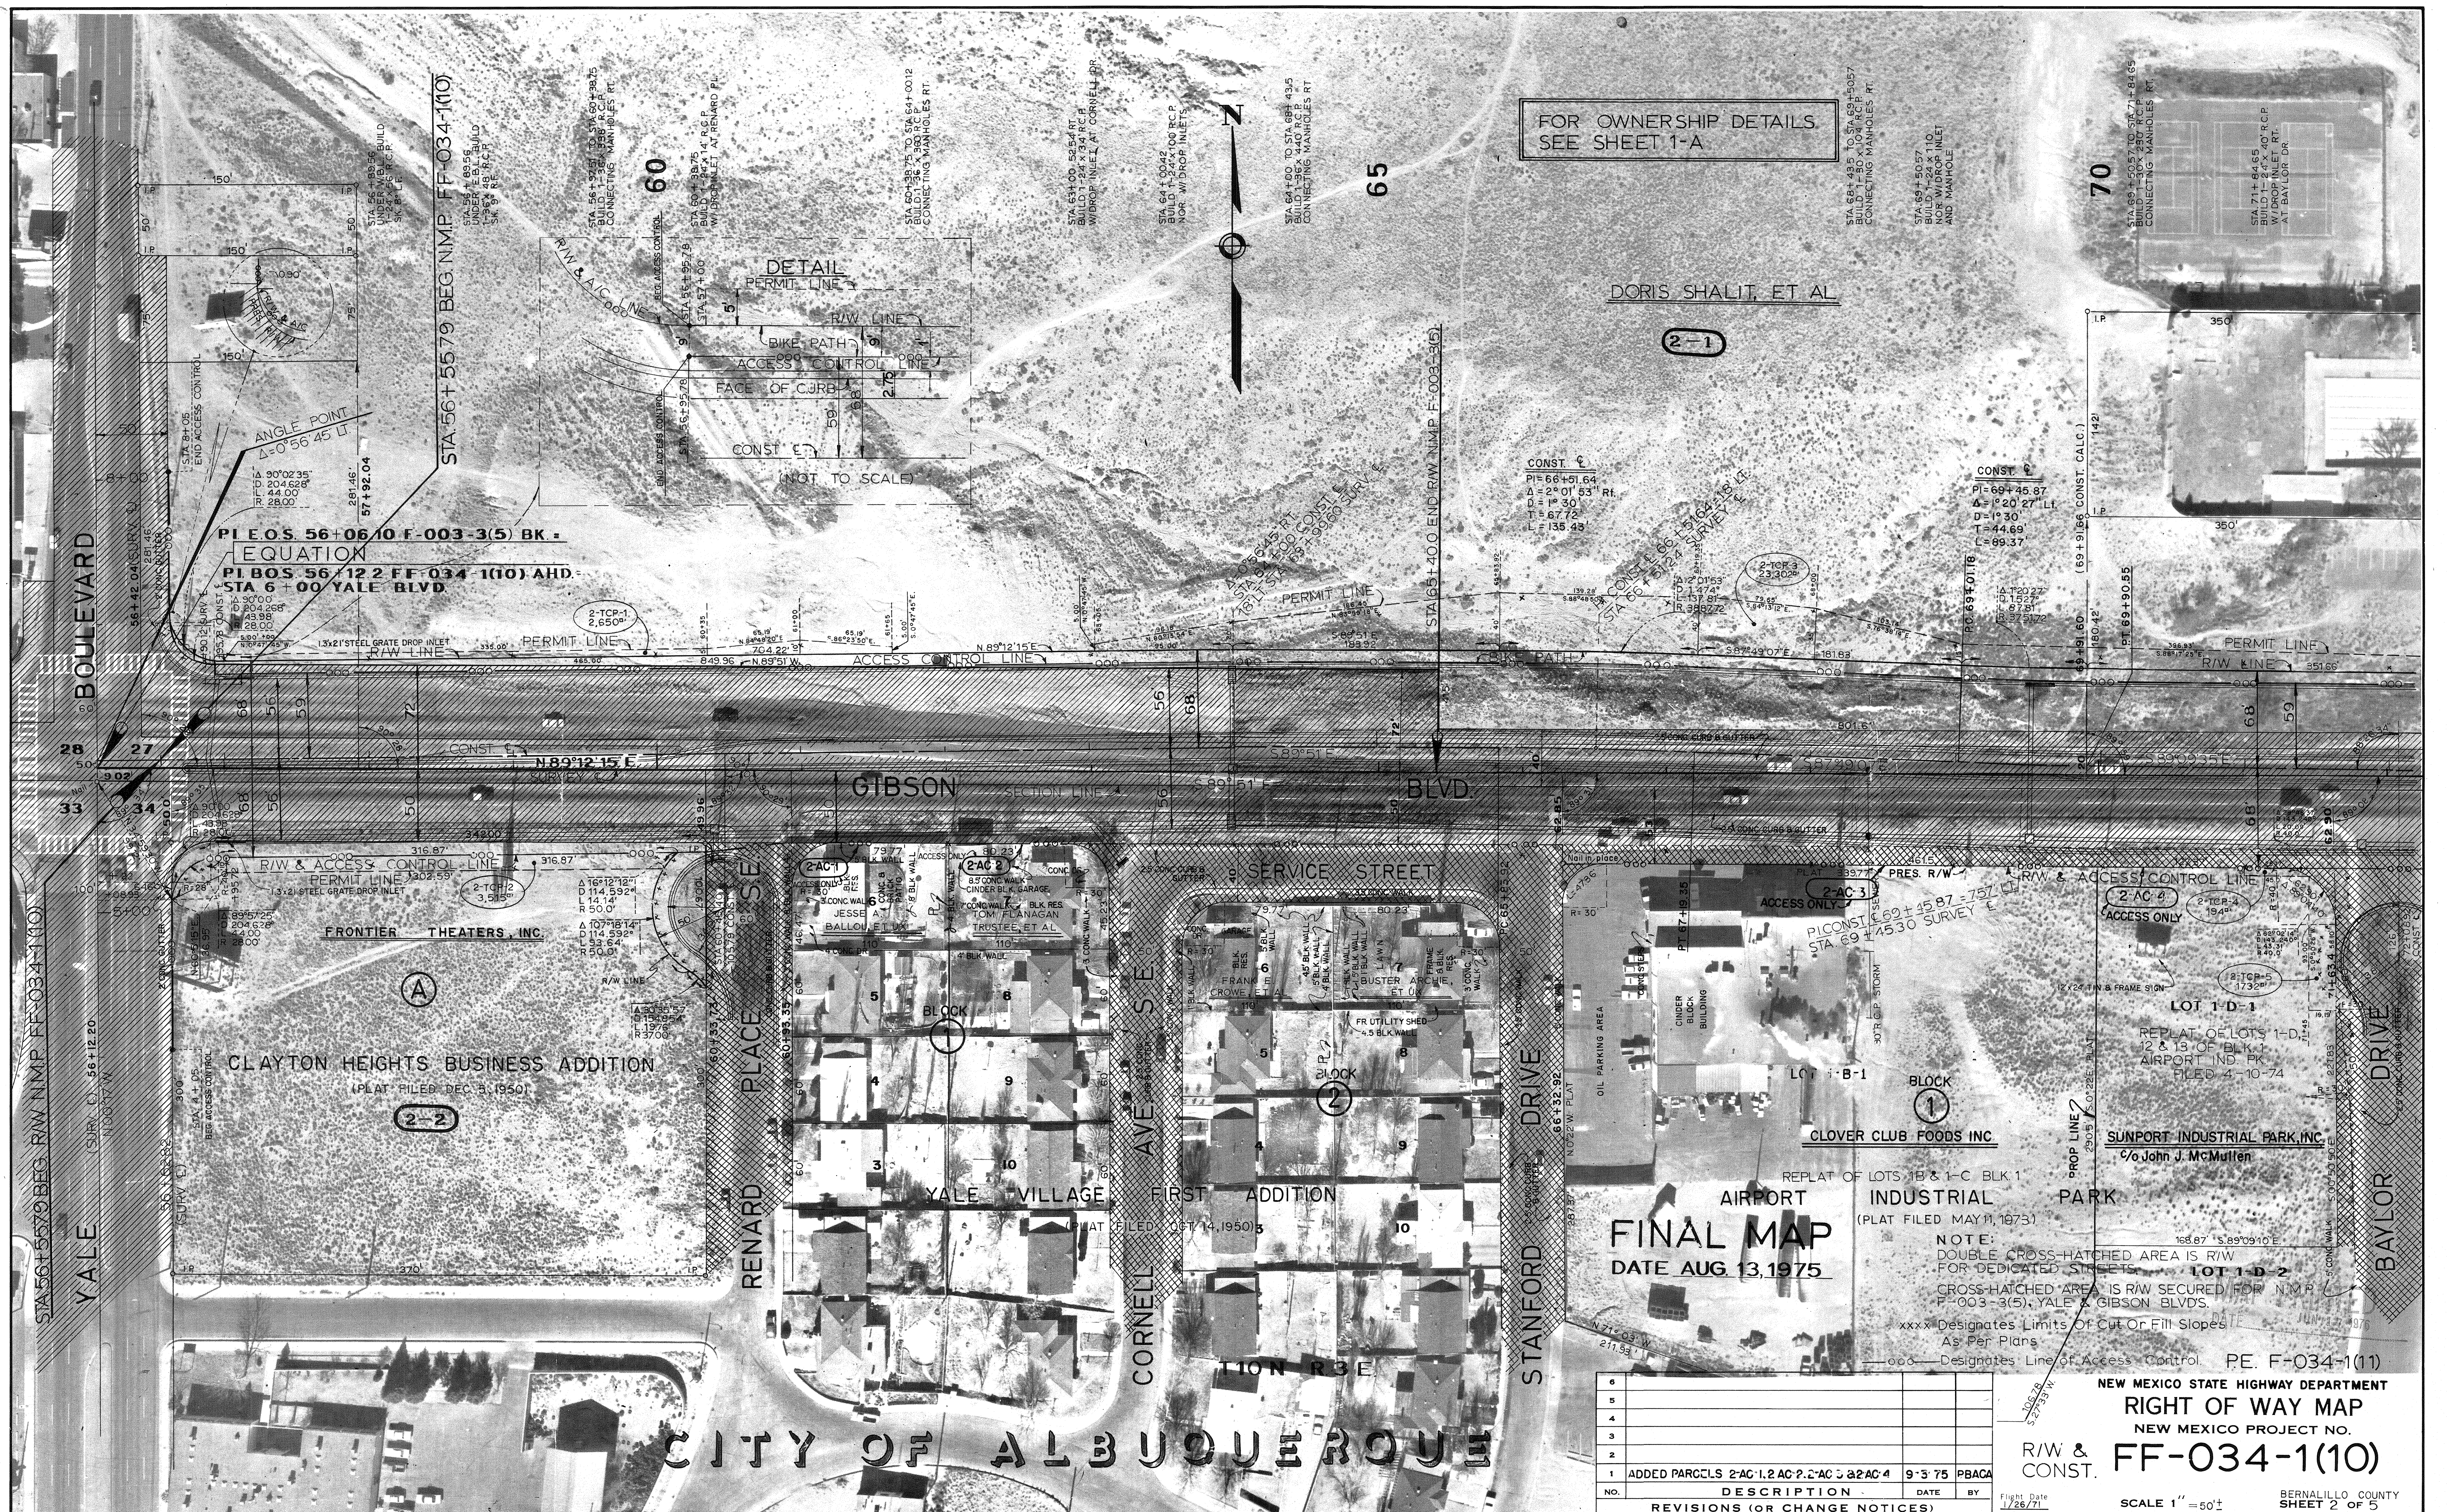

BASE MAP PREPARED BY PHOTOGRAMMETRY SECTION

6			
5			
4			
3			
2			
1	ADDED PARCELS 2-AC-1.2-AC-2.2-AC-3-2-AC-4	9-3-75	PBAC
NO.	DESCRIPTION	DATE	BY
REVISIONS (OR CHANGE NOTICES)			

10075
 922533 W
 NEW MEXICO STATE HIGHWAY DEPARTMENT
 RIGHT OF WAY MAP
 NEW MEXICO PROJECT NO.
 R/W &
 CONST.
 FF-034-1(10)
 SCALE 1" = 50'
 BERNALILLO COUNTY
 SHEET 2 OF 5
 Light Date
 7/26/71

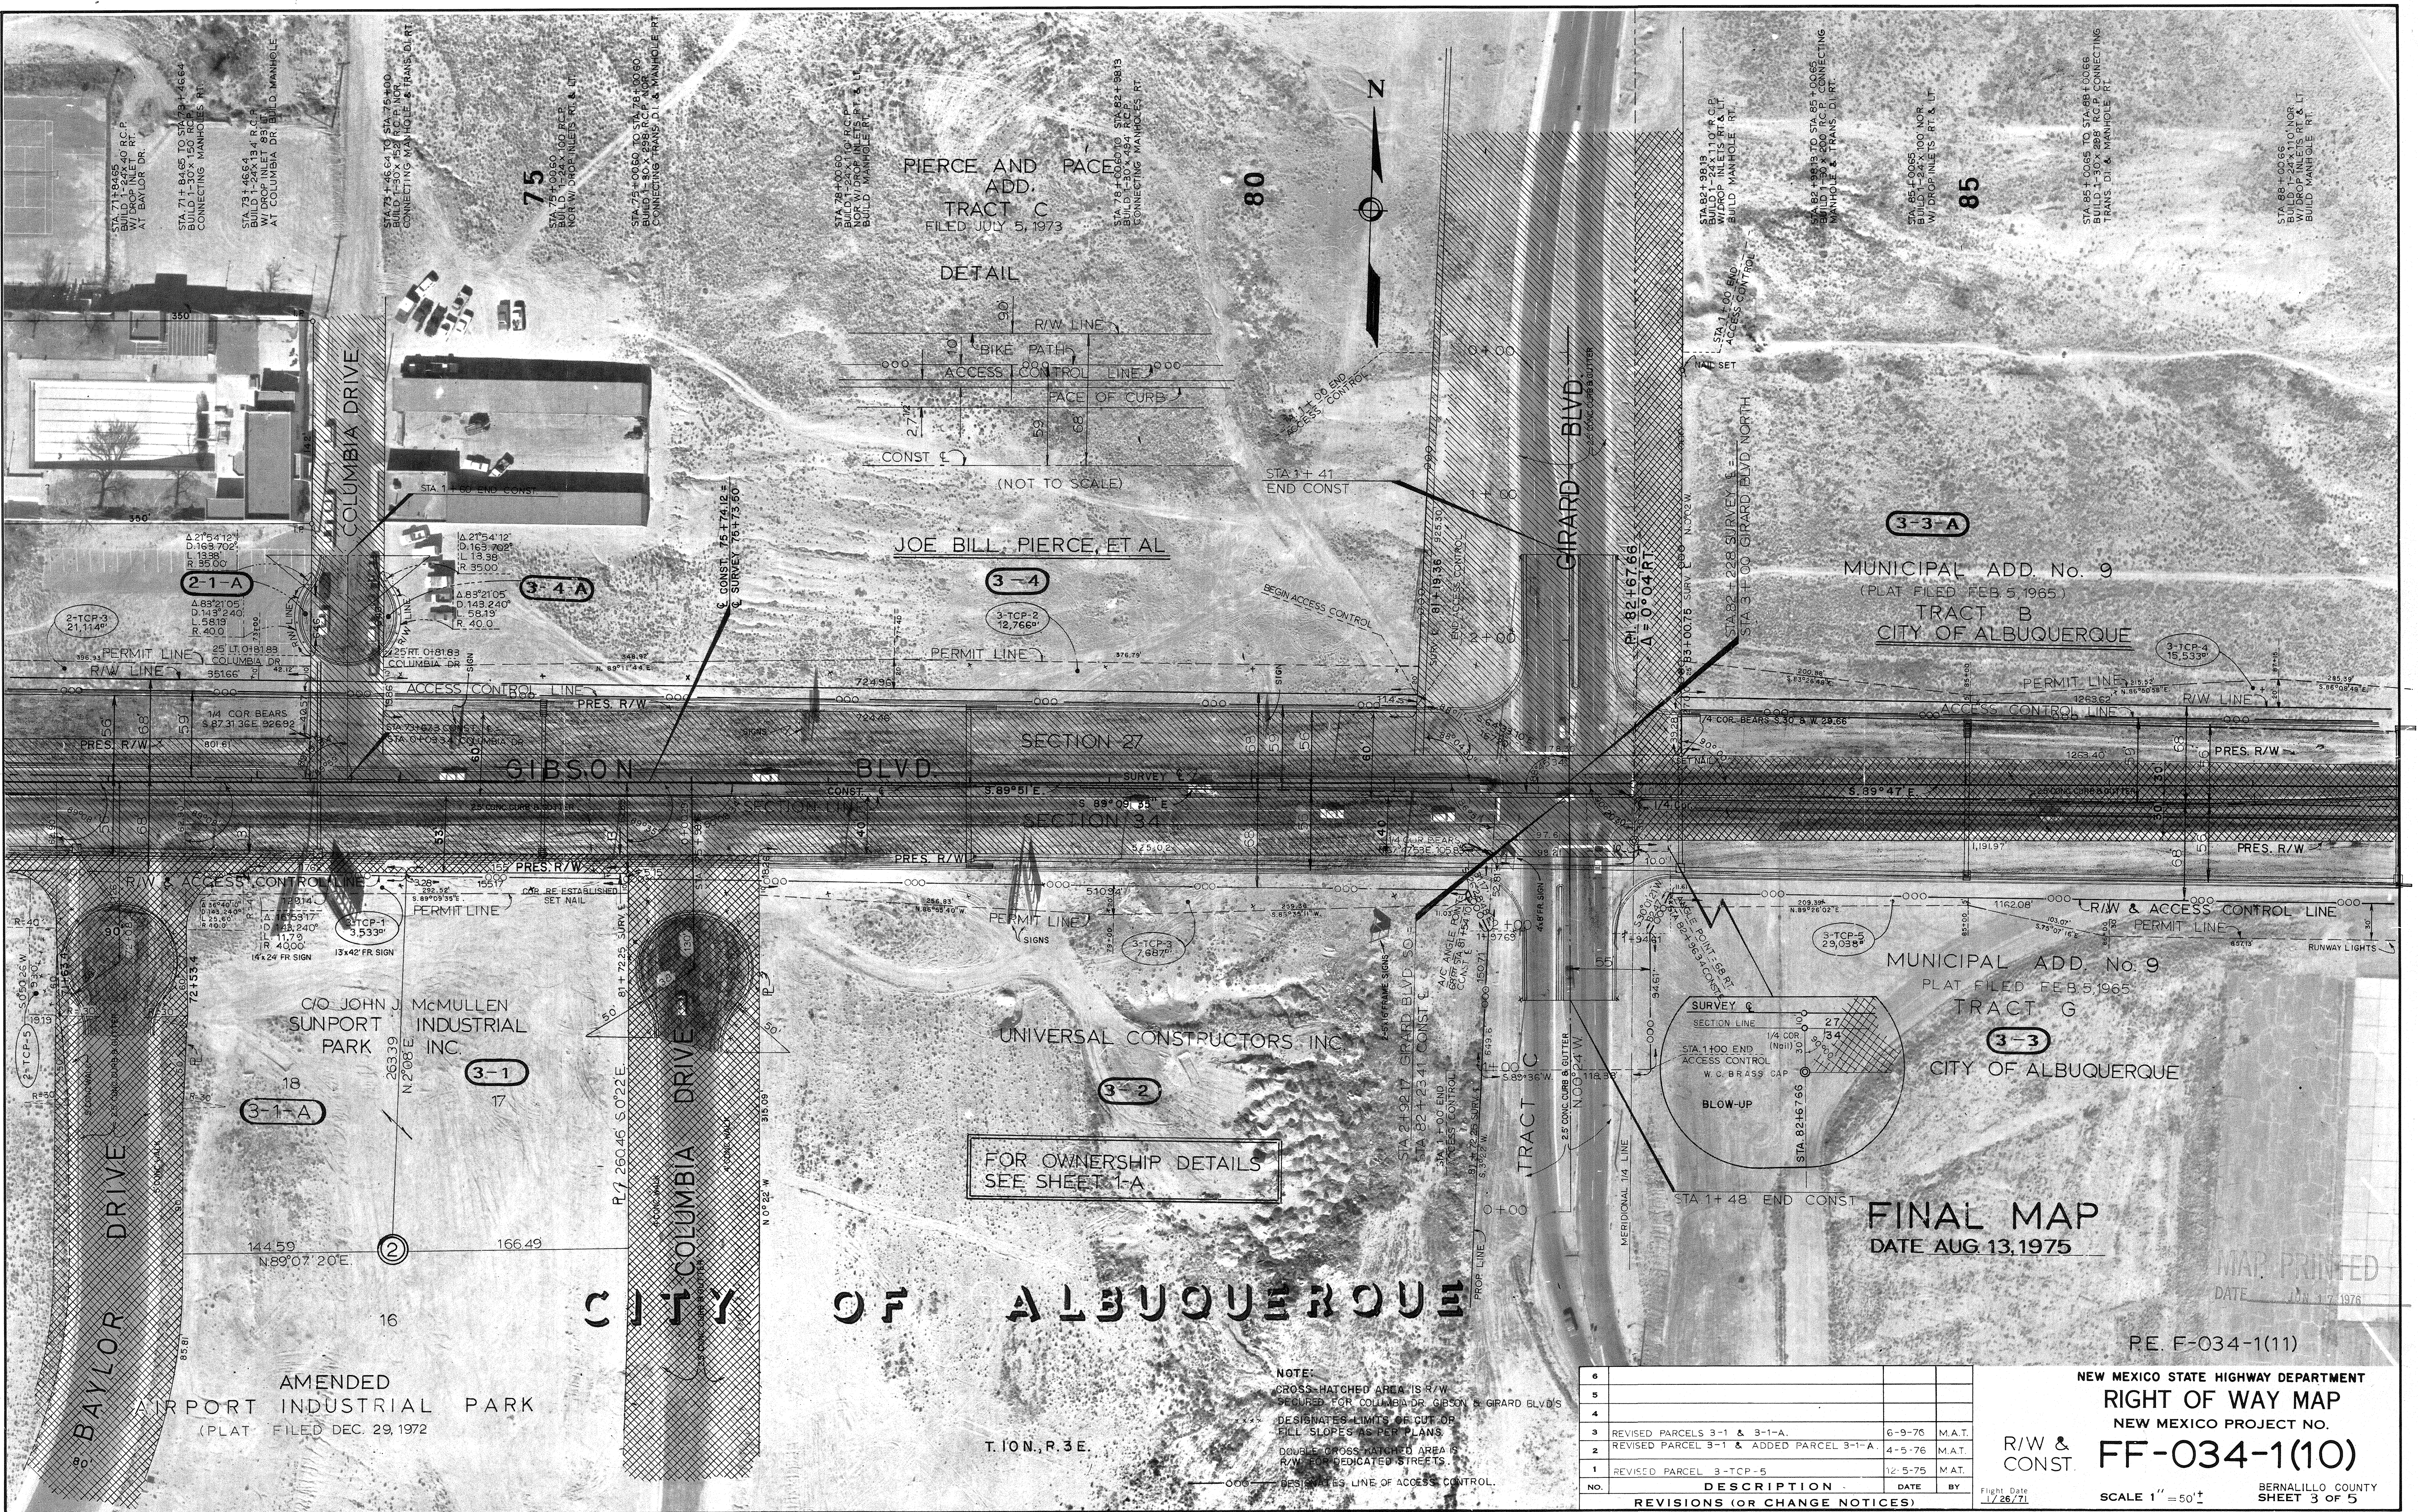

PIERCE AND PACIFIC
ADD.
TRACT C
FILED JULY 5, 1973

JOE BILL PIERCE, ET AL

MUNICIPAL ADD. No. 9
(PLAT FILED FEB 5, 1965)
TRACT B
CITY OF ALBUQUERQUE

MUNICIPAL ADD. No. 9
PLAT FILED FEB 5, 1965
TRACT G
CITY OF ALBUQUERQUE

FINAL MAP
DATE AUG 13, 1975

FOR OWNERSHIP DETAILS
SEE SHEET 1-A

NOTE:
CROSS-HATCHED AREA IS R/W
SECURED FOR COLUMBIA DR, GIBSON & GIRARD BLVD'S
DESIGNATES LIMITS OF CUT OR
FILL SLOPES AS PER PLANS
DOUBLE CROSS-HATCHED AREA IS
R/W FOR DEDICATED STREETS
--- DESIGNATES LINE OF ACCESS CONTROL.

NO.	DESCRIPTION	DATE	BY
6			
5			
4			
3	REVISED PARCELS 3-1 & 3-1-A.	6-9-76	M.A.T.
2	REVISED PARCEL 3-1 & ADDED PARCEL 3-1-A.	4-5-76	M.A.T.
1	REVISED PARCEL 3-TCP-5	12-5-75	M.A.T.
NO.	DESCRIPTION	DATE	BY
REVISIONS (OR CHANGE NOTICES)			

R/W &
CONST

NEW MEXICO STATE HIGHWAY DEPARTMENT
RIGHT OF WAY MAP
NEW MEXICO PROJECT NO.
FF-034-1(10)
SCALE 1" = 50'
BERNALILLO COUNTY
SHEET 3 OF 5

BASE MAP PREPARED BY PHOTOGRAMMETRY SECTION