



CERTIFICATE OF SURVEY
FOR
BLUE CROSS BLUE SHIELD
ALBUQUERQUE, NEW MEXICO
NOVEMBER, 1987

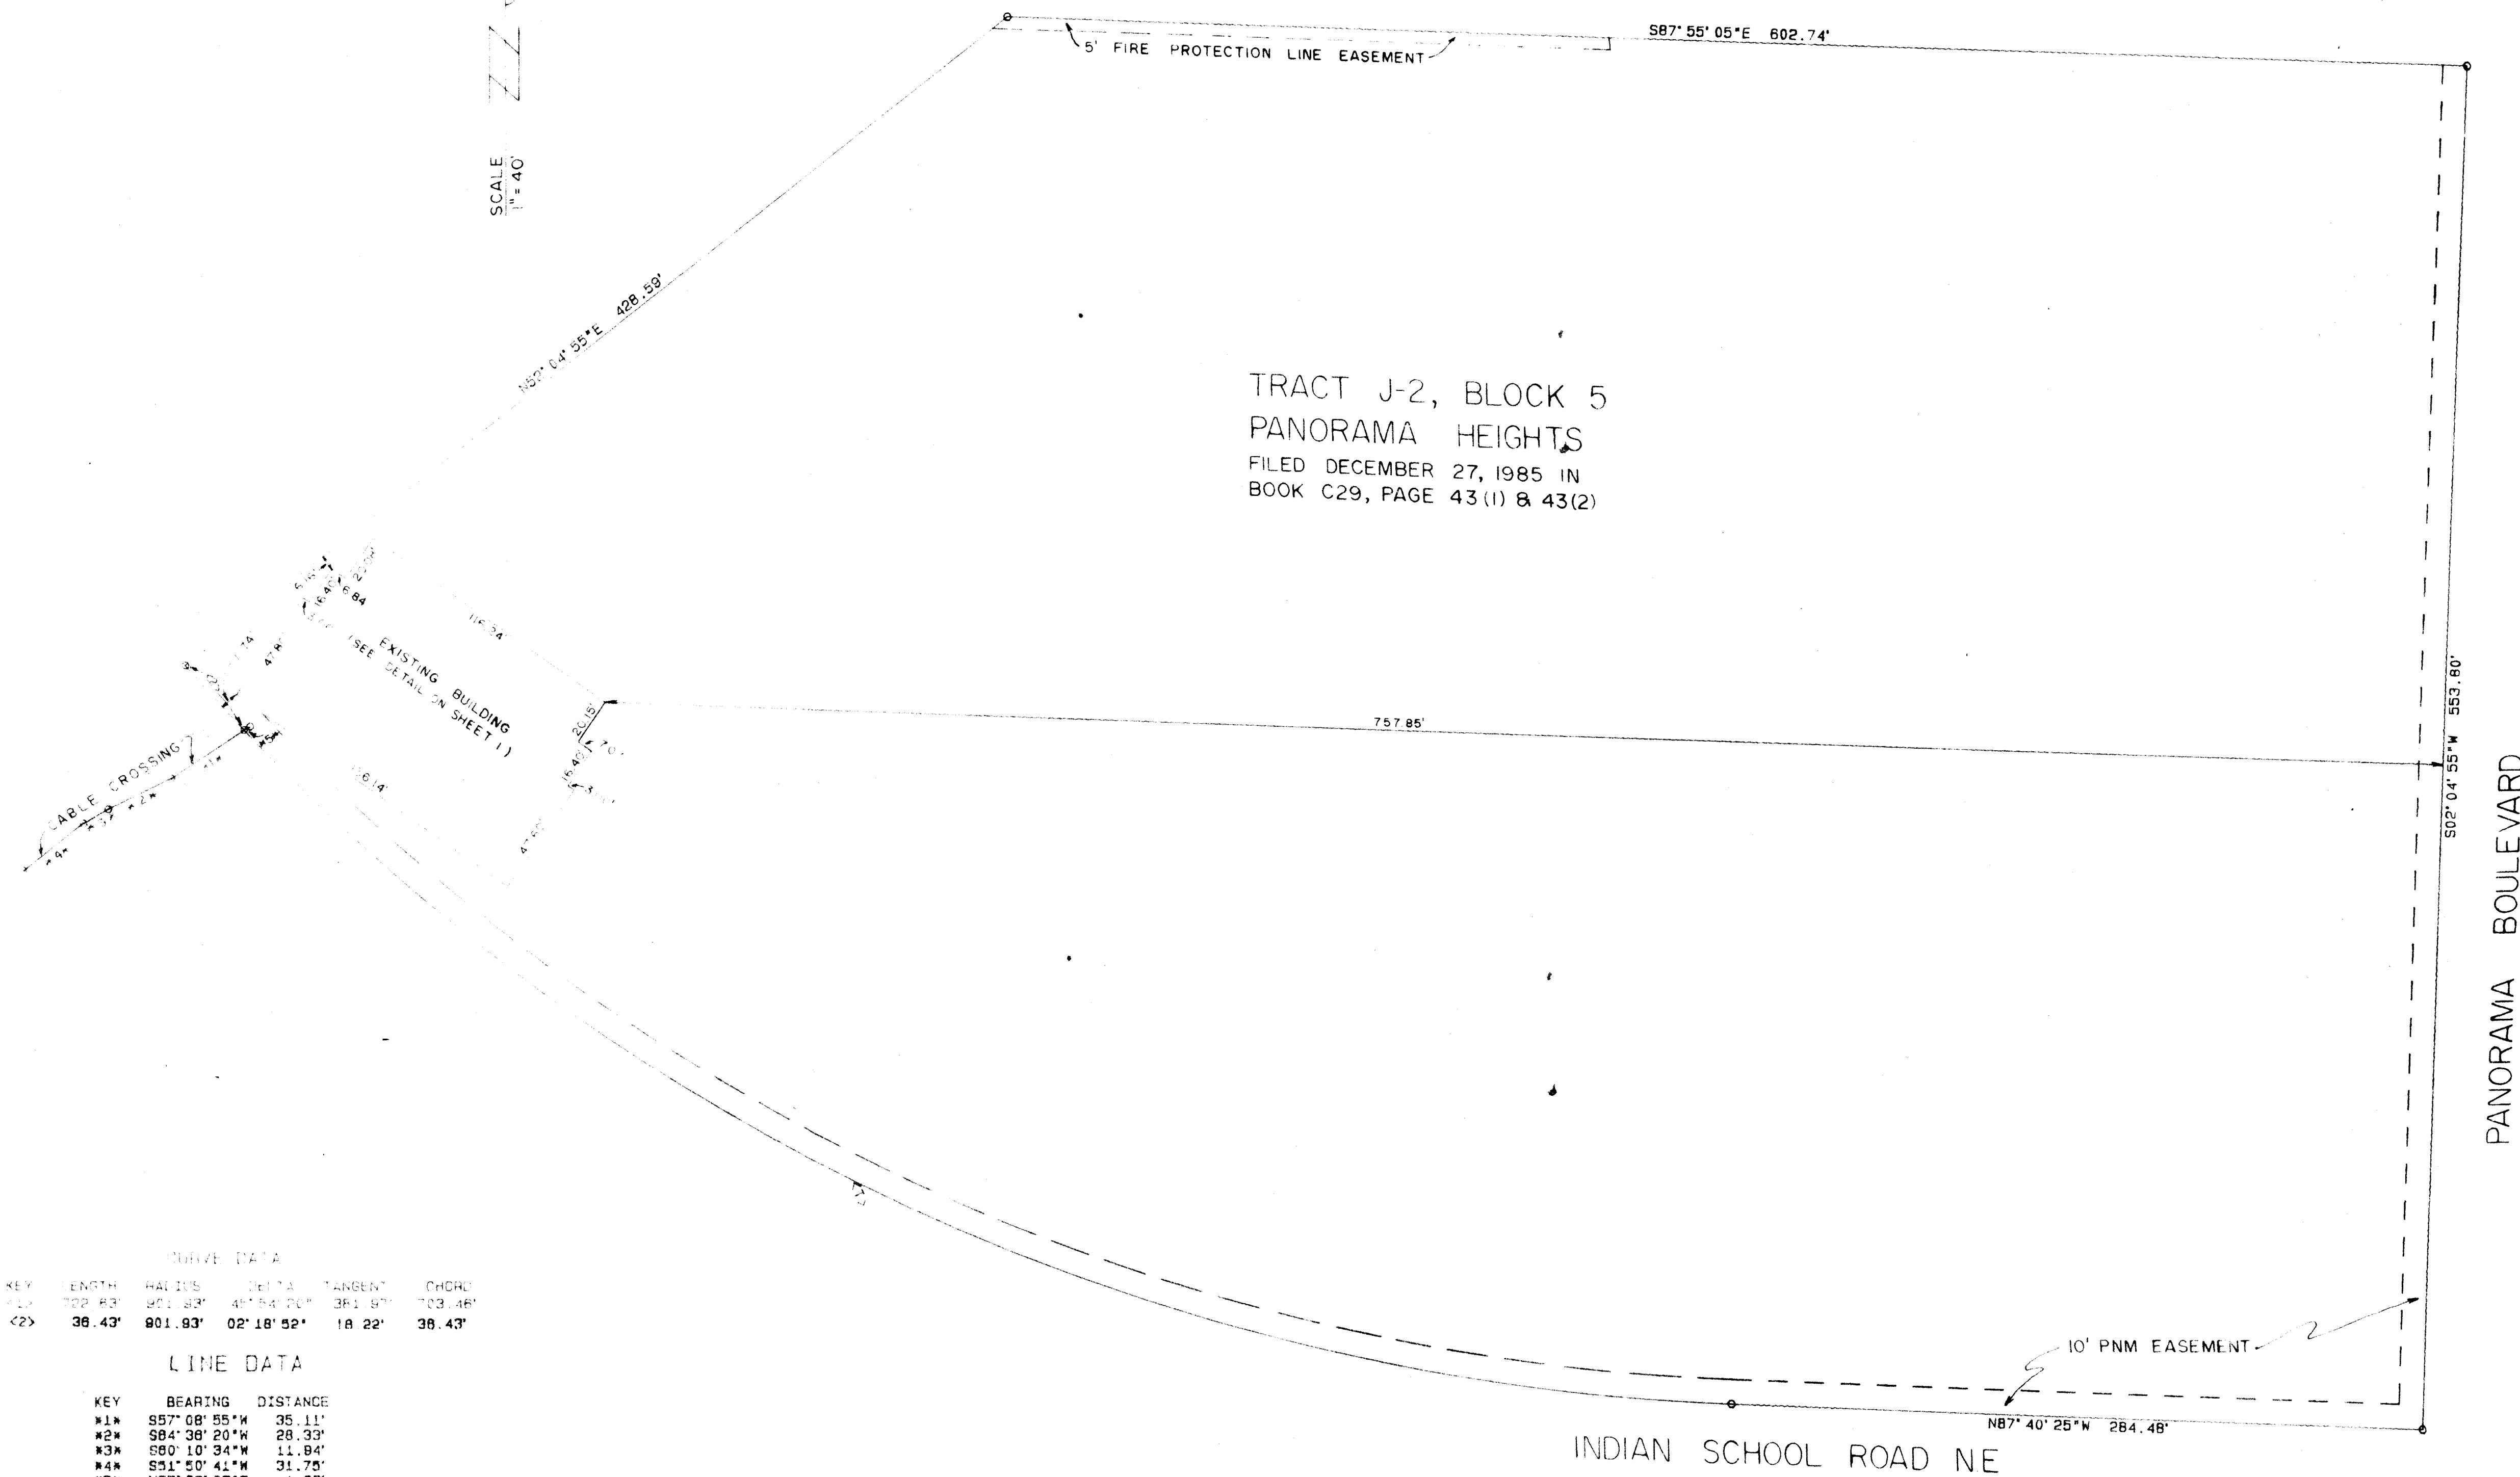

LEGAL DESCRIPTION

A certain tract of land situate within Section 15, Township 10 North, Range 4 East, New Mexico Principal Meridian, City of Albuquerque, Bernalillo County, New Mexico, said tract of land being Tract "A-2", Panorama Heights, as the same is shown and designated on the plat of record filed in the Office of the County Clerk of Bernalillo County, New Mexico on December 27, 1985, in Book C29, Page 43 (1) & 43 (2).

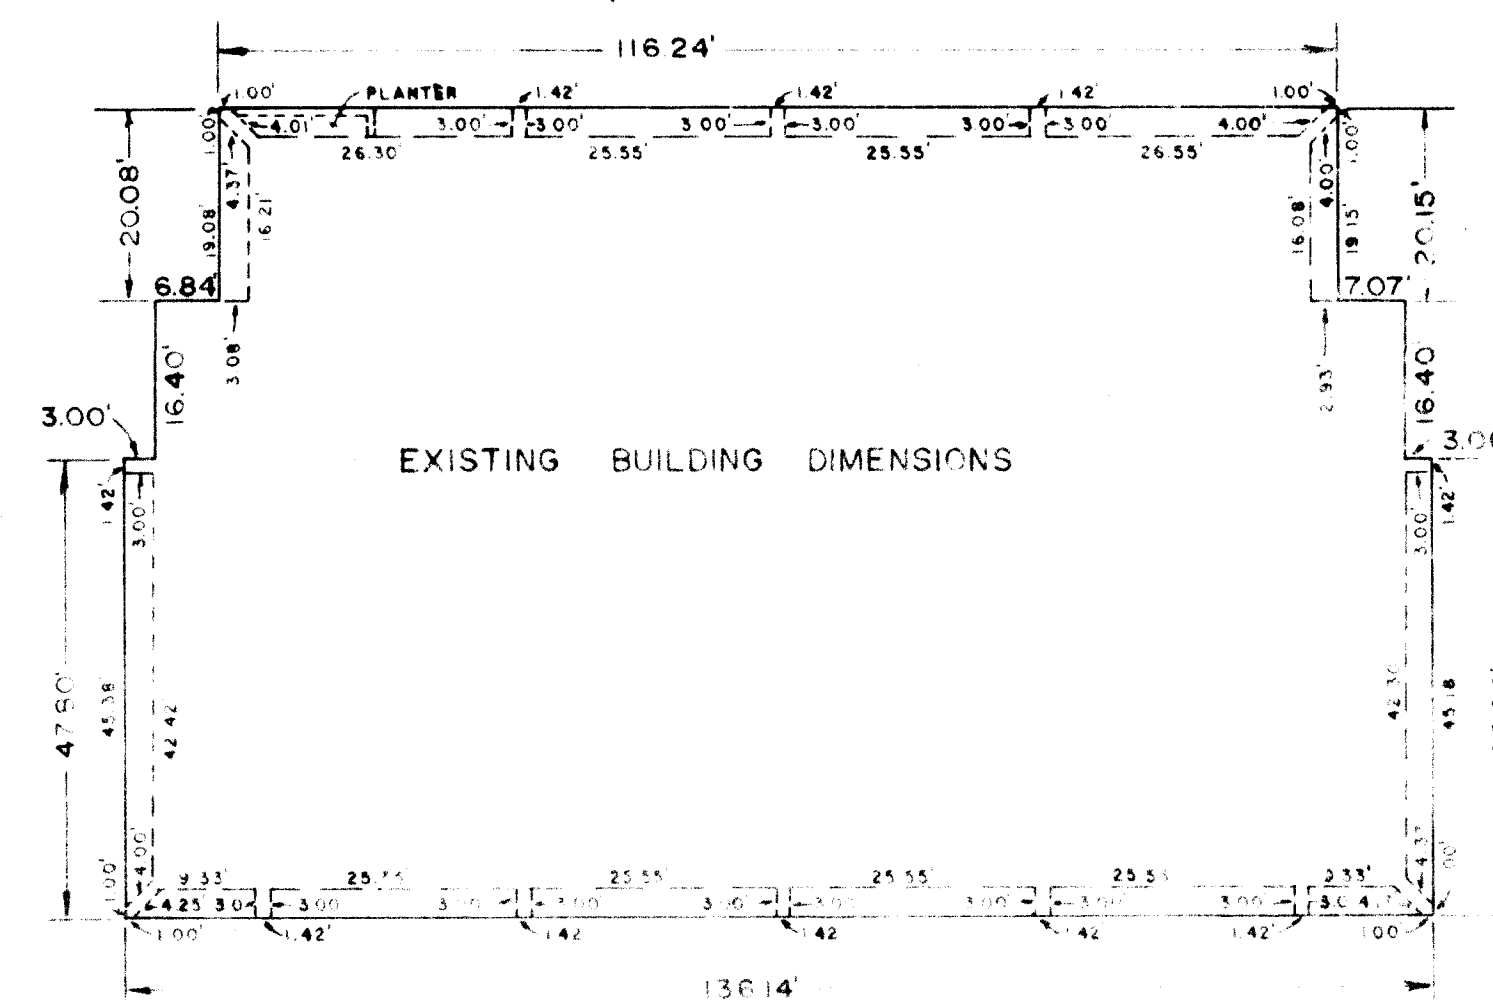

3440

SHEET 1 OF 2

1	2	3	4	5	6	7	8	9	10	11
2	6		3	4	4	0	0	1	8	7




1330 SAN PEDRO N.E.—SUITE 208
ALBUQUE RQUE NEW MEXICO 87110

CERTIFICATE OF SURVEY
FOR
BLUE CROSS BLUE SHIELD
ALBUQUERQUE, NEW MEXICO
NOVEMBER, 1987

Scale
1" = 20'

LEGEND	
○	MAN HOLE
○ WM	WATER METER
□ WM	WATER METER BOX
○ LP	LI
○ FH	FIRE HYDRANT
○	TRANSFORMER PAD
---	PROPERTY LINE
---	ALLEY

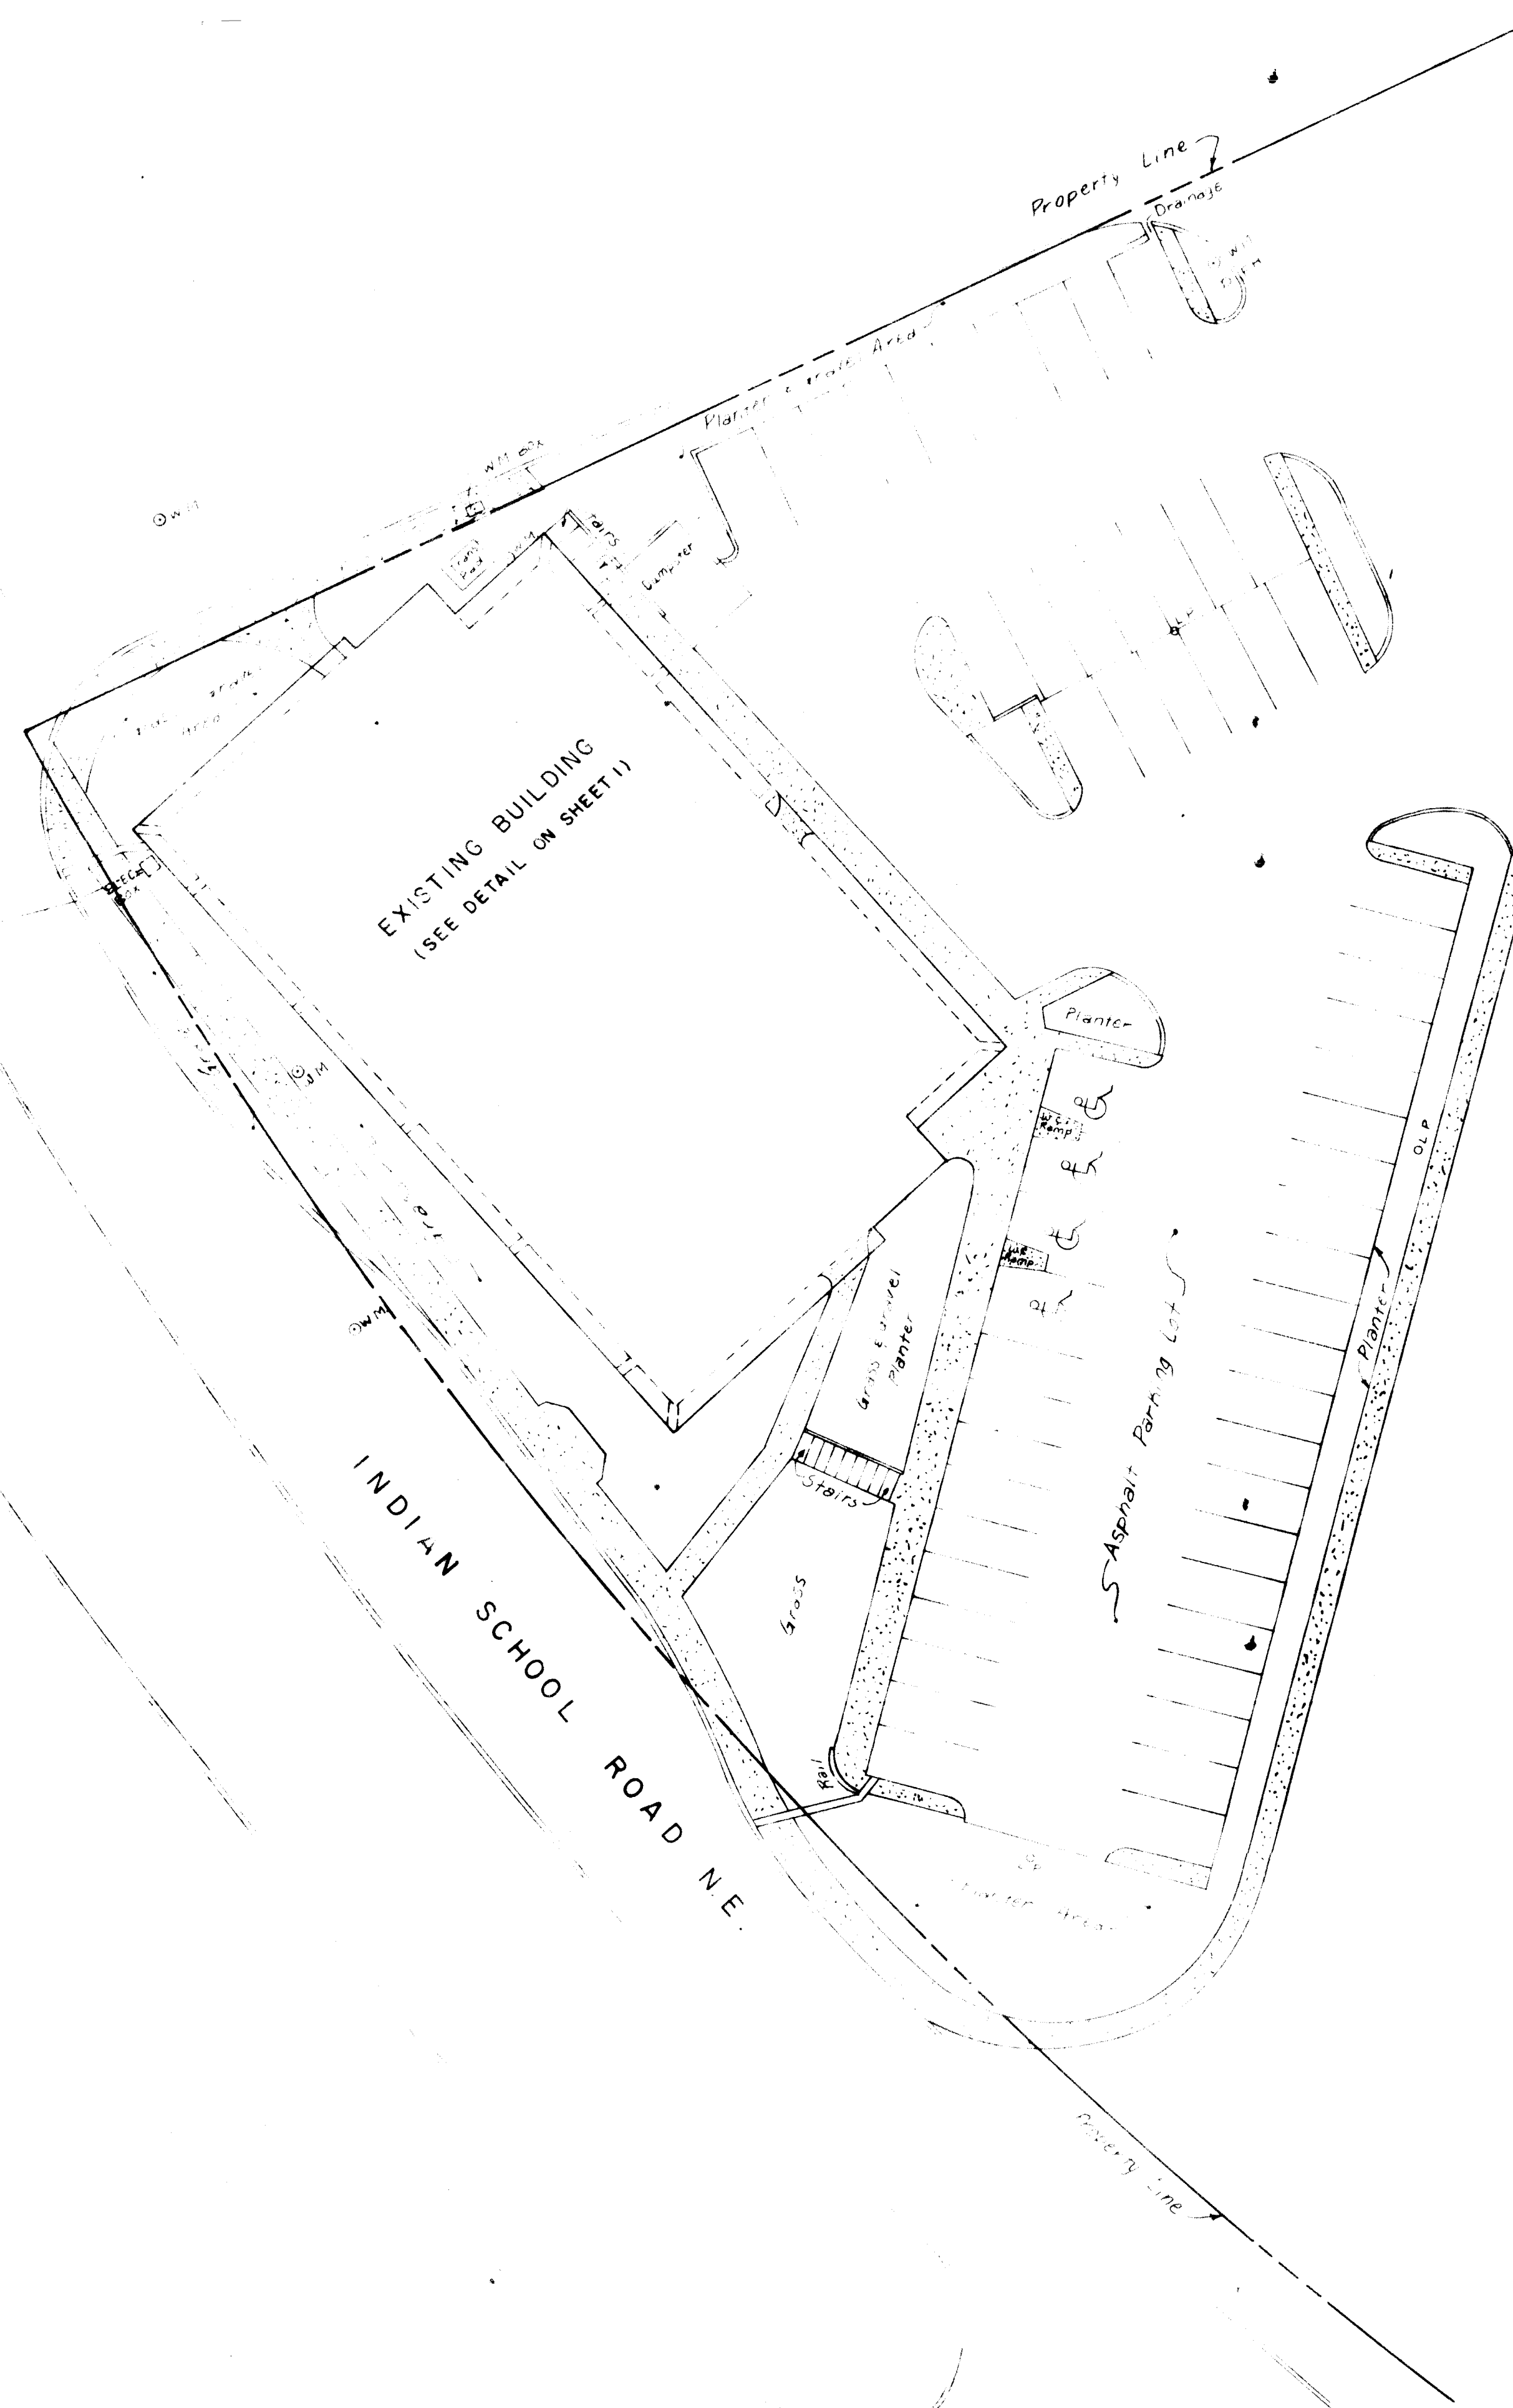

"As-Built"

Date: NOVEMBER 5, 1987

I, John F. Esquibel, New Mexico Registered Land Surveyor No. 5949 do hereby certify that to the best of my knowledge and belief, the dimensions shown hereon of the building with relation to lot lines are correct and that an encroachment exists on said property.

Prepared by:
A & E ENGINEERING INC.
1330 San Pedro, Suite 208
Albuquerque, New Mexico 87110

John F. Esquibel, N.M.R.L.S.
No. 5949

1 2 3 4 5 6 7 8 9 10 11 12
26 34400287

SHEET 2 OF 2

A & E ENGINEERING INC.
1330 SAN PEDRO, SUITE 208
ALBUQUERQUE, NEW MEXICO 87110