


RIDGEFIELD SUBDIVISION

IMPROVEMENTS FOR GRADING, PAVING AND UTILITIES

ALBUQUERQUE, NEW MEXICO

INDEX TO SHEETS


SHEET NO.	DESCRIPTION
1	TITLE SHEET & INDEX TO DRAWINGS
2	PLAT OF GEOMETRY
3	GRADING PLAN
4	EROSION CONTROL PLAN
5	PAVING COMPOSITE PLAN
	PAVING PLAN & PROFILES
6	RIDGEFIELD AVENUE, N.E. [△]
7	RIDGEFIELD COURT, N.E. AND RIDGEFIELD PLACE, N.E.
8	VENTURA STREET, N.E.
9	UTILITY COMPOSITE PLAN
	UTILITY PLAN & PROFILE
10	RIDGEFIELD AVENUE, N.E. [△]
11	RIDGEFIELD COURT, N.E. AND RIDGEFIELD PLACE, N.E.
12	PALOMAS AVENUE, N.E.

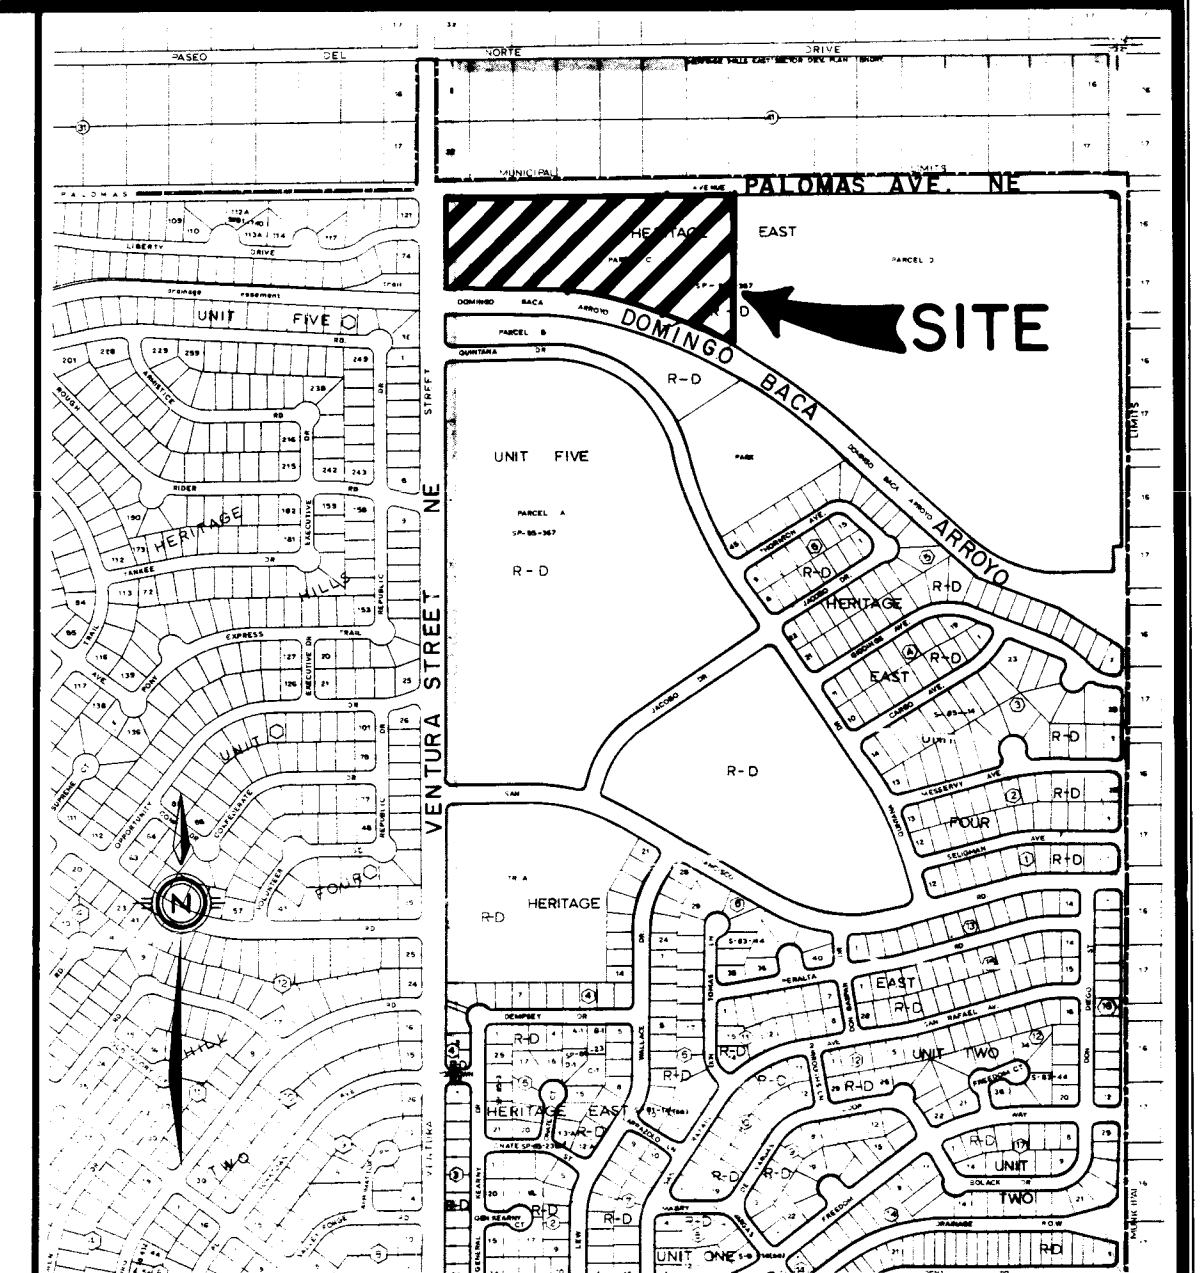

VICINITY MAP

GENERAL NOTES:

1. ALL WORK DETAILED ON THESE PLANS TO BE PERFORMED UNDER CONTRACT SHALL, EXCEPT AS OTHERWISE STATED OR PROVIDED FROM HEREON, BE CONSTRUCTED IN ACCORDANCE WITH THE CITY OF ALBUQUERQUE STANDARD SPECIFICATIONS FOR PUBLIC WORKS CONSTRUCTION, 1986.
2. TWO (2) WORKING DAYS PRIOR TO ANY EXCAVATION, CONTRACTOR MUST CONTACT LINE LOCATING SERVICE, 260-1990, FOR LOCATION OF EXISTING UTILITIES.
3. PRIOR TO CONSTRUCTION, THE CONTRACTOR SHALL EXCAVATE AND VERIFY THE HORIZONTAL AND VERTICAL LOCATIONS OF ALL OBSTRUCTIONS AND EXISTING PAVEMENT. SHOULD A CONFLICT EXIST, THE CONTRACTOR SHALL NOTIFY THE ENGINEER OR SURVEYOR SO THAT THE CONFLICT CAN BE RESOLVED WITH MINIMUM AMOUNT OF DELAY.
4. THE CONTRACTOR SHALL FURNISH ENDS ON ALL WATER AND SEWER SERVICE STUBS, CAPS AND PLUGS.
5. CONTRACTOR SHALL NOTIFY THE ENGINEER NOT LESS THAN SEVEN (7) DAYS PRIOR TO STARTING WORK IN ORDER THAT THE ENGINEER MAY TAKE NECESSARY MEASURES TO INSURE THE PRESERVATION OF SURVEY MONUMENTS. CONTRACTOR SHALL NOT DISTURB PERMANENT SURVEY MONUMENTS WITHOUT THE CONSENT OF THE ENGINEER AND SHALL NOTIFY THE ENGINEER AND BEAR THE EXPENSE OF REPLACING ANY THAT MAY BE DISTURBED WITHOUT PERMISSION. REPLACEMENT SHALL BE DONE ONLY BY THE ENGINEER. WHEN A CHANGE IS MADE IN ANY ROADWAY IN WHICH A PERMANENT SURVEY MONUMENT IS LOCATED, CONTRACTOR SHALL, AT HIS OWN EXPENSE, ADJUST THE MONUMENT COVER TO THE NEW GRADE UNLESS OTHERWISE SPECIFIED.
6. REFER TO SECTION 4.4 OF GENERAL CONDITIONS OF THE CITY OF ALBUQUERQUE STANDARD SPECIFICATIONS FOR PUBLIC WORKS CONSTRUCTION.

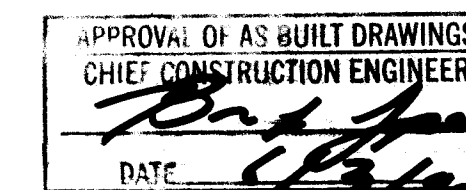


AS BUILT

1 2 3 4 5 6 7 8 9 10 11 12 13 14 15
26 34 47 70 101 142

△ UPDATE , OCTOBER 1991 M.J.Y.

REV.	SHEETS	CITY ENGINEER	DATE	USER DEPARTMENT	DATE	USER DEPARTMENT	DATE
APPROVAL OF REVISIONS							

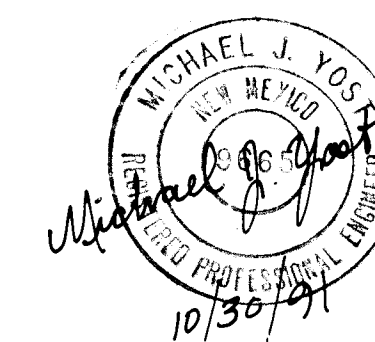


ENGINEER'S SEAL	DATE OCT., 1991	community sciences corporation	APPROVED FOR CONSTRUCTION CITY ENGINEER 11/15/91 DATE
	SCALE: N/A		
DRAWN: C.S.C.	DESIGNED: P.L.		
JOB NO: 252-02-PRE	PROJECT NO: 3464.90		
			SHEET 1 OF 12

9106330

 REPLAT
OF
PARCEL "C" HERITAGE EAST UNIT 5
TO

RIDGE FIELD SUBDIVISION

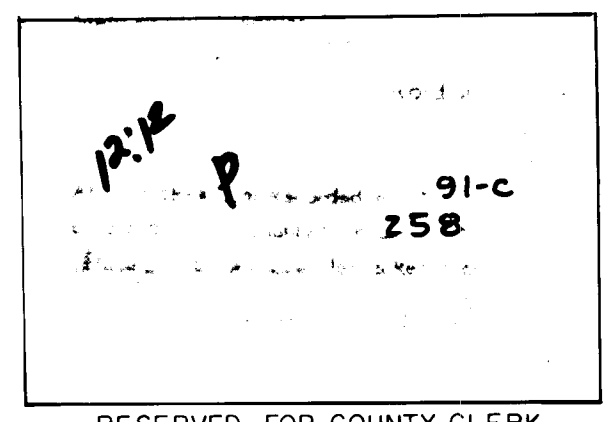 SITUATE WITHIN THE ELENA GALLEGOS GRANT
("PROJECTED" SECTION 20, T11N, R4E, N.M.P.M.)
CITY OF ALBUQUERQUE
BERNALILLO COUNTY, NEW MEXICO


SUBDIVISION DATA

 SUBDIVISION CASE NO. DRB-87-363, SV-87-34
GROSS SUBDIVISION ACRES 10.0002 AC
ZONE ATLAS INDEX NO. D-20
NO. OF EXISTING TRACTS/LOTS 1
NO. OF TRACTS/LOTS CREATED 40
MILES OF FULL-WIDTH STREETS CREATED 0.26
MILES OF HALF-WIDTH STREETS CREATED 0
DATE OF SURVEY APRIL, '87

APPROVALS:

 SUBDIVISION CASE NUMBER 5-87-37
 L.A. Carleton, Jr. 11-20-91
 Planner/Albuquerque, Bernalillo Co. Planning Division 10-6-87
 Parks and Recreation Department 10-6-87
 Traffic Engineering, Transportation Department 10-6-87
 City Engineer, Engineering Division 11-18-91
 Albuquerque Metropolitan Flood Control Authority 11-18-91
 City of Albuquerque 10-6-87
 Chief City Surveyor, Engineering Division 10-29-91
 Property Management 9-29-87
 City of Albuquerque 8-25-87
 City of Albuquerque 8-19-87
 Public Service Company of New Mexico 8-9-87

SURVEYOR'S CERTIFICATION:


I, L.A. CARLETON, JR., HEREBY AFFIRM THAT I AM A DULY QUALIFIED REGISTERED PROFESSIONAL LAND SURVEYOR UNDER THE LAWS OF THE STATE OF NEW MEXICO AND DO CERTIFY THAT THIS PLAT WAS PREPARED BY ME OR UNDER MY DIRECT SUPERVISION; SHOWS ACCURATE DIMENSIONS, AND LAND AREAS; SHOWS ALL EASEMENTS AND RESTRICTIONS AS SHOWN ON THE PLAT OF RECORD OR MADE KNOWN TO ME BY THE OWNERS AND/OR PROPRIETORS OF THE SUBDIVISION SHOWN HEREON, TITLE COMPANIES, UTILITY COMPANIES OR OTHER PARTIES EXPRESSING AN INTEREST. I FURTHER CERTIFY THAT THIS PLAT MEETS THE MINIMUM REQUIREMENTS FOR MONUMENTATION AND SURVEYS OF THE ALBUQUERQUE SUBDIVISION ORDINANCE, MEETS THE REQUIREMENTS SET FORTH BY THE STATE OF NEW MEXICO AND IS TRUE AND CORRECT TO THE BEST OF MY KNOWLEDGE AND BELIEF.

L.A. CARLETON, JR., N.M. State Plane Coordinates, Central Zone, X=415,503.35, Y=1,516,380.98, ELEV. = 5634.65, Ground to Grid Factor = 0.99963867.

THE FOREGOING SURVEYOR'S CERTIFICATE WAS ACKNOWLEDGED BEFORE ME THIS 28 DAY OF August, 1987 BY L.A. CARLETON, JR.

 MY COMMISSION EXPIRES: 3-25-89
3-25-93

SHEET 1 OF 2

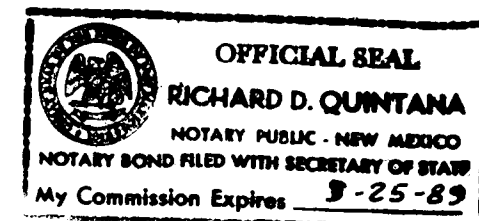
 JUNE, 1987
SCALE: 1"=100'
C.S.C.
M.C.G.
252-02-PRE

PROJECT LOCATION

VICINITY MAP

NOTES:

- HEARING BASE FOR THIS PLAT IS THE RESULT OF SURVEY FOR HERITAGE HILLS EAST FILED FOR RECORD ON FEBRUARY 4, 1981 IN VOLUME C17, FOLIO 200. BEARINGS ARE REFERENCED TO GRID NORTH NEW MEXICO STATE PLANE COORDINATE SYSTEM, CENTRAL ZONE. ALL DISTANCES ARE GROUND.
- ALL DIMENSIONS PUBLISHED ALONG CURVED LINES ARE ARC DISTANCES. LOT LINES MARKED N/R ARE NON-RADIAL.
- BENCHMARK FOR THIS PLAT IS THE A.C.S. BRASS TABLE "I-C21A" SET IN TOP OF CONCRETE POST FLUSH WITH GROUND AND LOCATED AT THE NORTHEAST CORNER OF THE INTERSECTION OF PASEO DEL NORTE, N.E. AND HOLBROOK STREET, N.E. ELEV. = 5634.65.
- CENTERLINE (IN LIEU OF R/W) MONUMENTATION TO BE INSTALLED AT ALL CENTERLINE P.C.'S, P.T.'S, ANGLE POINTS AND STREET INTERSECTIONS PRIOR TO ACCEPTANCE OF SUBDIVISION STREET IMPROVEMENTS AND WILL CONSIST OF A FOUR INCH (4") ALUMINUM ALLOY CAP STAMPED "CITY OF ALBUQUERQUE CENTERLINE MONUMENTATION SURVEY MARKER DO NOT DISTURB L.S. 4972".
- UNLESS OTHERWISE NOTED ALL BOUNDARY CORNERS ARE MARKED WITH A #5 REBAR W/ CAP STAMPED "L.S. NO. 4972".
- PUBLIC UTILITY EASEMENTS SHOWN ON THIS PLAT ARE TEN (10) FEET WIDE AND ARE GRANTED FOR THE COMMON AND JOINT USE OF:
 - THE PUBLIC SERVICE COMPANY OF NEW MEXICO FOR THE INSTALLATION, MAINTENANCE, AND SERVICE OF OVERHEAD AND UNDERGROUND ELECTRICAL LINES, TRANSFORMERS, AND OTHER EQUIPMENT AND RELATED FACILITIES REASONABLY NECESSARY TO PROVIDE ELECTRICAL SERVICE.
 - THE GAS COMPANY OF NEW MEXICO FOR INSTALLATION, MAINTENANCE, AND SERVICE OF NATURAL GAS LINES, VALVES AND OTHER EQUIPMENT AND FACILITIES REASONABLY NECESSARY TO PROVIDE NATURAL GAS.
 - MOUNTAIN BELL FOR THE INSTALLATION, MAINTENANCE AND SERVICE OF ALL BURIED AND AERIAL COMMUNICATION LINES AND OTHER RELATED EQUIPMENT AND FACILITIES REASONABLY NECESSARY TO PROVIDE COMMUNICATION SERVICES, INCLUDING BUT NOT LIMITED TO ABOVE GROUND PEDESTALS AND CLOSURES.
 - JONES INTERCABLE FOR THE INSTALLATION, MAINTENANCE, AND SERVICE OF SUCH LINES, CABLE, AND OTHER RELATED EQUIPMENT AND FACILITIES REASONABLY NECESSARY TO PROVIDE CABLE TV SERVICE.
 INCLUDED IS THE RIGHT OF INGRESS AND EGRESS FOR THE CONSTRUCTION AND MAINTENANCE AND THE RIGHT TO TRIM INTERFERING TREES AND SHRUBS. ALSO INCLUDED IS THE RIGHT TO INSTALL AND MAINTAIN SERVICE LINES.
- MINIMUM TEN FEET (10') SOUTH SIDEYARD SETBACKS AND MINIMUM FIVE FEET (5') NORTH SIDEYARD SETBACKS SHALL APPLY TO THE DEVELOPMENT OF THE FOLLOWING LOTS: 1, 2, 3, 5.
- ALL OTHER LOTS SHALL HAVE MINIMUM SIDEYARD SETBACKS AS REQUIRED BY SECTION 10.6.3 OF THE CITY ZONING CODE. ALL STRUCTURES SHALL BE SUBJECT TO THE BUILDING HEIGHT LIMITATIONS OF SECTION 40.0.1.9 OF THE CITY ZONING CODE UNLESS ENERGY EFFICIENT CONSTRUCTION STANDARDS SPECIFIED IN SECTION 40.0.1.9(4) ARE USED AND A HEIGHT LIMIT WAIVER IS OBTAINED FROM THE ZONING ENFORCEMENT OFFICER.
- THERE SHALL BE NO DRIVEWAY ACCESS FROM VENTURA STREET TO LOTS 20, 21, AND 22 OR FROM PALOMAS TO LOTS 1, 22, 23, 24, 25, AND 28.
- SPECIAL FRONT YARD SETBACKS: LOTS 6, 7 AND 8 SHALL HAVE A MINIMUM FRONT YARD SETBACK OF 25 FEET; LOTS 20 AND 22 SHALL HAVE A MINIMUM FRONT YARD SETBACK OF 30 FEET.
- LOTS 9 AND 27 SHALL HAVE A MINIMUM SIDEYARD OF 20 FEET ON THE STREET SIDE.

LEGAL DESCRIPTION:

THAT CERTAIN PARCEL OF LAND SITUATE WITHIN THE ELENA GALLEGOS GRANT ("PROJECTED" SECTION 20, TOWNSHIP 11 NORTH, RANGE 4 EAST, NEW MEXICO PRINCIPAL MERIDIAN, CITY OF ALBUQUERQUE, BERNALILLO COUNTY, NEW MEXICO AND BEING COMPRISED OF ALL OF PARCEL "C", HERITAGE EAST UNIT FIVE AS THE SAME IS SHOWN AND DESIGNATED ON THE PLAT ENTITLED "REDIVISION OF PORTIONS OF BLOCKS 42, 43, 44, 45, NORTH ALBUQUERQUE ACRES (NOW COMPOSING PARCELS A, B, C, & D) HERITAGE EAST UNIT 5" FILED FOR RECORD IN THE OFFICE OF THE COUNTY CLERK OF BERNALILLO COUNTY, NEW MEXICO ON AUGUST 30, 1985 IN VOLUME C28, FOLIO 43 AS DOCUMENT NO. 85 72737, AND BEING MORE PARTICULARLY DESCRIBED AS FOLLOWS:

BEGINNING AT A.C.S. "I-C21A" (BRASSCAP IN PLACE AND HAVING NEW MEXICO STATE PLANE COORDINATES, CENTRAL ZONE OF X=415,503.35 AND Y=1,516,380.98); THENCE, S89°09'41"W, 1638.67 FEET TO A POINT ON THE SOUTHERLY RIGHT-OF-WAY LINE OF PALOMAS AVENUE N.E. (60' R/W) SAID POINT BEING THE NORTHEAST CORNER OF PARCEL "C" OF THE AFFOREMENTIONED HERITAGE EAST UNIT 5 AND THE NORTHEAST CORNER AND TRUE PLACE OF BEGINNING, OF THE PARCEL HEREIN DESCRIBED; THENCE LEAVING SAID RIGHT-OF-WAY LINE, S00°20'39"W, 565.83 FEET TO THE SOUTHEAST CORNER AND POINT-ON-CURVE (P.O.C.) ON THE NORTHERLY BOUNDARY LINE OF THE DOMINGO BACA ARROYO (100' R/W); THENCE ALONG SAID NORTHERLY RIGHT-OF-WAY LINE, NORTHWESTERLY 914.51 FEET ALONG THE ARC OF A CURVE (SAID ARC HAVING A RADIUS OF 1778.43 FEET, A CENTRAL ANGLE OF 29°27'46" AND A CHORD THAT BEARS N75°08'03"W, 904.47' TO A POINT-OF-TANGENCY (P.T.); THENCE, N00°01'56"W, 220.43 FEET TO THE SOUTHWEST CORNER AND POINT ON THE EASTERLY RIGHT-OF-WAY LINE OF VENTURA STREET, N.E. (87' R/W); THENCE ALONG SAID RIGHT-OF-WAY LINE, N00°08'04"E 309.73 FEET TO A POINT-OF-TANGENCY (P.T.); THENCE NORTHWESTERLY, 47.23 FEET ALONG THE ARC OF A CURVE (SAID ARC HAVING A RADIUS OF 30.00 FEET, A CENTRAL ANGLE OF 90°12'35" AND A CHORD THAT BEARS N45°14'22", 42.30 FEET) TO A POINT-OF-TANGENCY (P.T.) ON THE SOUTHERLY RIGHT-OF-WAY LINE OF PALOMAS BOULEVARD N.E.; THENCE ALONG SAID RIGHT-OF-WAY LINE, S89°39'21"E 1067.13 FEET TO THE NORTHEAST CORNER AND TRUE PLACE OF BEGINNING OF THE PARCEL HEREIN DESCRIBED. THE ABOVE DESCRIBED ENCLOSURE CONTAINS 10.0002 ACRES MORE OR LESS.

FREE CONSENT AND DEDICATION:

THE SUBDIVISION SHOWN HEREON IS WITH THE FREE CONSENT AND IN ACCORDANCE WITH THE DESIRES OF THE UNDERSIGNED OWNERS(S) AND/OR PROPRIETOR(S) THEREOF AND SAID OWNERS(S) AND/OR PROPRIETOR(S) DO HEREBY DEDICATE ALL STREETS AND PUBLIC RIGHT-OF-WAYS SHOWN HEREON TO THE CITY OF ALBUQUERQUE IN FEE SIMPLE AND DO HEREBY GRANT: ALL ACCESS, UTILITY AND DRAINAGE EASEMENTS SHOWN HEREON, INCLUDING THE RIGHT TO CONSTRUCT, OPERATE, INSPECT, AND MAINTAIN FACILITIES THEREIN; AND ALL PUBLIC UTILITY EASEMENTS SHOWN HEREON FOR THE COMMON AND JOINT USE OF GAS, ELECTRICAL POWER AND COMMUNICATION SERVICES FOR BURIED DISTRIBUTION LINES, CONDUITS, AND PIPES FOR UNDERGROUND UTILITIES WHERE SHOWN OR INDICATED, AND INCLUDING THE RIGHT OF INGRESS AND EGRESS FOR CONSTRUCTION AND MAINTENANCE, AND THE RIGHT TO TRIM INTERFERING TREES AND SHRUBS (SEE NOTE 6). SAID OWNERS(S) AND/OR PROPRIETOR(S) DO HEREBY CONSENT TO THE CITY OF ALBUQUERQUE DOING AS IT DEEMES PROPER AND DO HEREBY CERTIFY THAT THIS SUBDIVISION IS THEIR FREE ACT AND DEED.

 ARGUS DEVELOPMENT COMPANY, INC.
A NEW MEXICO CORPORATION
Ben F. Spencer
BEN F. SPENCER, PRESIDENT

 STATE OF NEW MEXICO) SS
COUNTY OF BERNALILLO)

THE FOREGOING INSTRUMENT WAS ACKNOWLEDGED BEFORE ME THIS 21ST DAY OF OCTOBER, 1991 BY BEN F. SPENCER, PRESIDENT OF ARGUS DEVELOPMENT COMPANY, INC., A NEW MEXICO CORPORATION ON BEHALF OF SAID CORPORATION.

 BY: [Signature]
NOTARY PUBLIC
MY COMMISSION EXPIRES: 3-25-93


REVIEWED AND UPDATED

L.A. CARLETON, JR. N.M.P.S. NO. 4972 DATE 10/3/91


1-020-063-318453-10403

 Heritage East
Allen Kammuff 11-19-91

9106330

 REPLAT
OF
PARCEL "C" HERITAGE EAST UNIT 5
TO

RIDGEFIELD SUBDIVISION

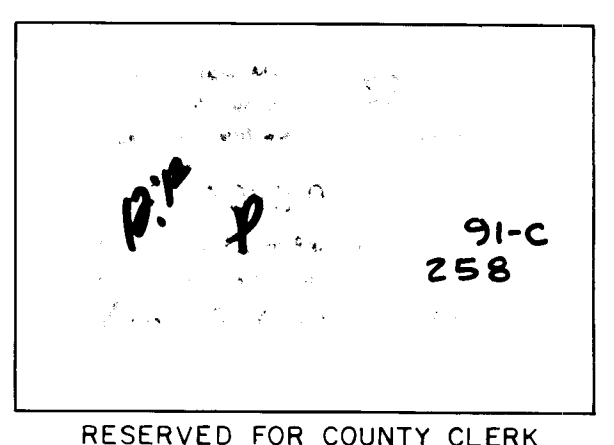 SITUATE WITHIN THE ELENA GALLEGOS GRANT
("PROJECTED" SECTION 20, T11N, R4E, N.M.P.M.)
CITY OF ALBUQUERQUE
BERNALILLO COUNTY, NEW MEXICO


RESERVED FOR COUNTY CLERK

RESERVED FOR COUNTY CLERK


RESERVED FOR COUNTY CLERK

RESERVED FOR COUNTY CLERK

RESERVED FOR COUNTY CLERK

RESERVED FOR COUNTY CLERK

RESERVED

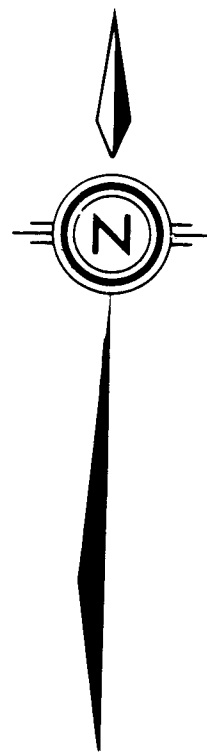

PERMANENT COMMUNITY SIGN PER SIVAGE THOMAS DESIGN

5' HIGH DECORATIVE PERIMETER WALL PER SIVAGE THOMAS DESIGN

RETAINING WALL (5 COURSES)
RETAINING WALL (4 COURSES)
RETAINING WALL (4 COURSES)

RETAINING WALL (5 COURSES)
RETAINING WALL (4 COURSES)

RETAINING WALL, 3'-5' (AVG. 4' HIGH)

5' HIGH DECORATIVE PERIMETER WALL PER SIVAGE THOMAS DESIGN


THIS PORTION TO BE STRUCTURAL FOR RETAINING (4 COURSES)

DOMINGO EXISTING
THIS PORTION TO BE STRUCTURAL FOR RETAINING (4 COURSES)

NOTE: 1) RETAINING WALL NOT BEING FOR LOT 14 & 15 TO SURF NOT EXCEEDING 3:1

BACA CONCRETE
5' HIGH, 6" BLOCK PERIMETER WALL (UNFINISHED)

THIS SECTION TO BE STRUCTURAL FOR RETAINING (4 COURSES)
SEE NOTE 1

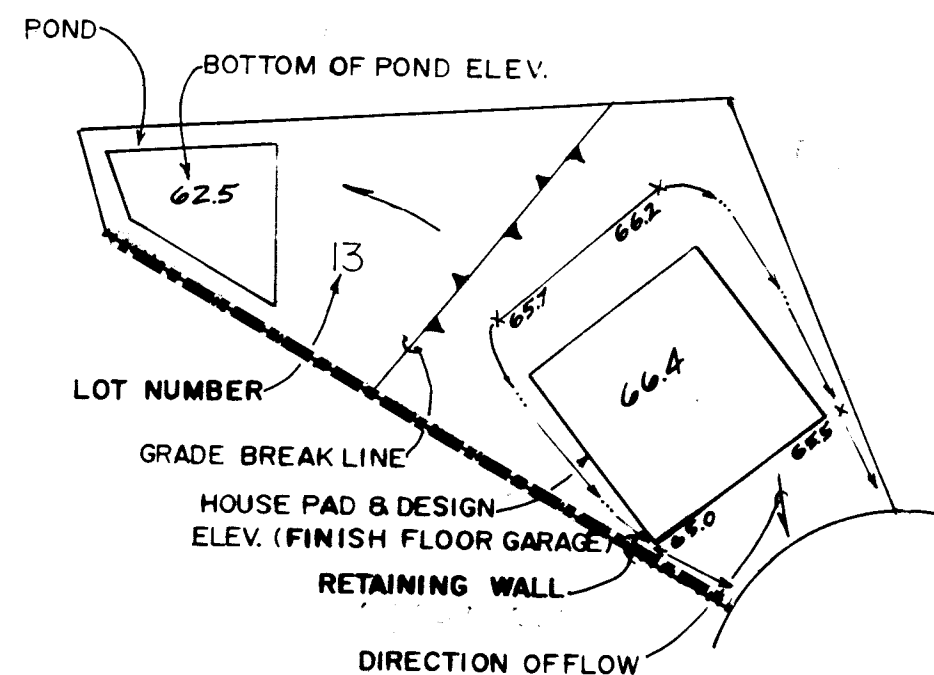

LOT LEGEND (TYPICAL)

N.T.S.
NOTE: PADS ARE TO BE 55'x63' UNLESS OTHERWISE NOTED

GENERAL NOTES FOR GRADING

- 1) CONTRACTOR MUST OBTAIN TOP SOIL DISTURBANCE PERMIT PRIOR TO MASS GRADING OPERATION.
- 2) CONTRACTOR MUST OBTAIN RETAINING WALL PERMIT PRIOR TO RETAINING WALL CONSTRUCTION.
- 3) MASS GRADING SHALL BE IN ACCORDANCE WITH "CITY OF ALBUQUERQUE INTERIM STANDARD SPECIFICATIONS, PUBLIC WORKS CONSTRUCTION, 1985."

EARTHWORK QUANTITIES

CUT 10461 C.Y.
COMPACTED FILL 13820 C.Y.
(based on 1.3 C/F ratio)

IMPORT 7505 C.Y.


* DOES NOT MEET ZONING SETBACK CRITERIA WITH 50' PAD (15'-20'-10' = 45'). WILL SEEK VARIANCE.

** MUST INCORPORATE R/W AS PART OF SOLAR SETBACK.

NOTE: ADDITIONAL PAD WIDTH IN NO WAY AFFECTS THE STANDARD CITY OF ALBUQUERQUE SETBACK REQUIREMENTS.

AS BUILT INFORMATION	
CONTRACTOR	CHH, INC.
DATE	11/12/91
INSPECTOR	ALBUQUERQUE
DATE	11/12/91
VERIFICATION BY	DATE 11/12/91
DATE	11/12/91
RECORDED BY	DATE
NO	DATE

BENCH MARKS	
A.C.S. BRASS TABLET "1-C21" SET IN THE TOP OF CONCRETE POST FLUSH WITH GROUND AND LOCATED AT THE NORTHEAST CORNER OF THE INTERSECTION OF PASO DEL NORTE (LOS ANGELES DRIVE, N.E.) AND HOLBROOK STREET, N.E. ELEVATION = 5634.65'	
SURVEY INFORMATION	
FIELD NOTES	DATE
NO.	BY

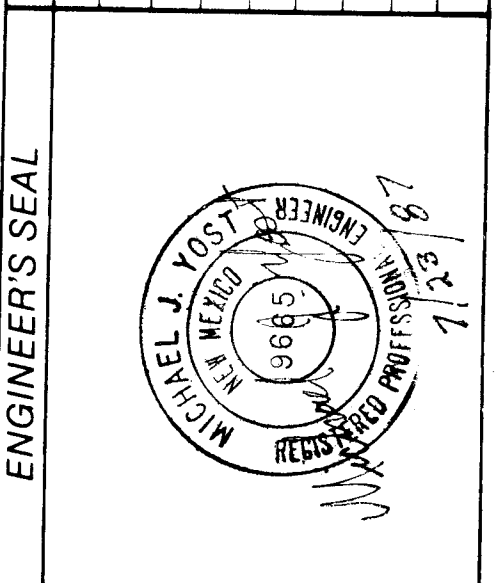

ENGINEER'S SEAL	
DATE	DATE
NO.	BY
REVISIONS	DESIGN
DESIGNED BY	DATE 11/12/91
DRAWN BY	DATE 11/12/91
CHECKED BY	DATE 11/12/91

SCALE
1" = 50'

community sciences corporation

CITY OF ALBUQUERQUE
PUBLIC WORKS DEPARTMENT
ENGINEERING GROUP

TITLE: RIDGEFIELD SUBDIVISION
GRADING PLAN


APPROVALS	ENGINEER	DATE	APPROVALS	ENGINEER	DATE
D.R.C. Chair	11-12-91	11-12-91	11-12-91	11-12-91	11-12-91
Trans. Dev.	11-12-91	11-12-91	11-12-91	11-12-91	11-12-91
HYDROLOGY	11-12-91	11-12-91	11-12-91	11-12-91	11-12-91
DRAWING NO.	3464.90	MAP NO.	D-20	SHEET	3 OF 12

2 3 4 5 6 7 8 9 10 11 12 13 14 15
216 3464 9003 92

SHEET 3 OF 12 ONLY


APPROVED FOR ROUGH GRADING
(± 1 FT.)

DATE 10/30/91


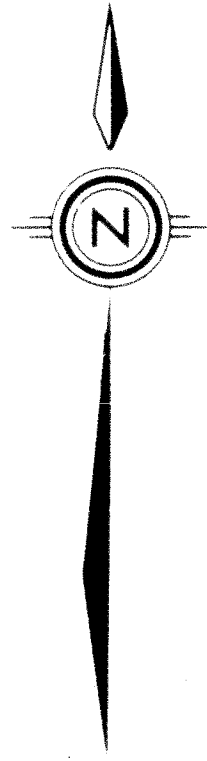


VENTURA STREET N.E.

PALOMAS AVENUE N.E.

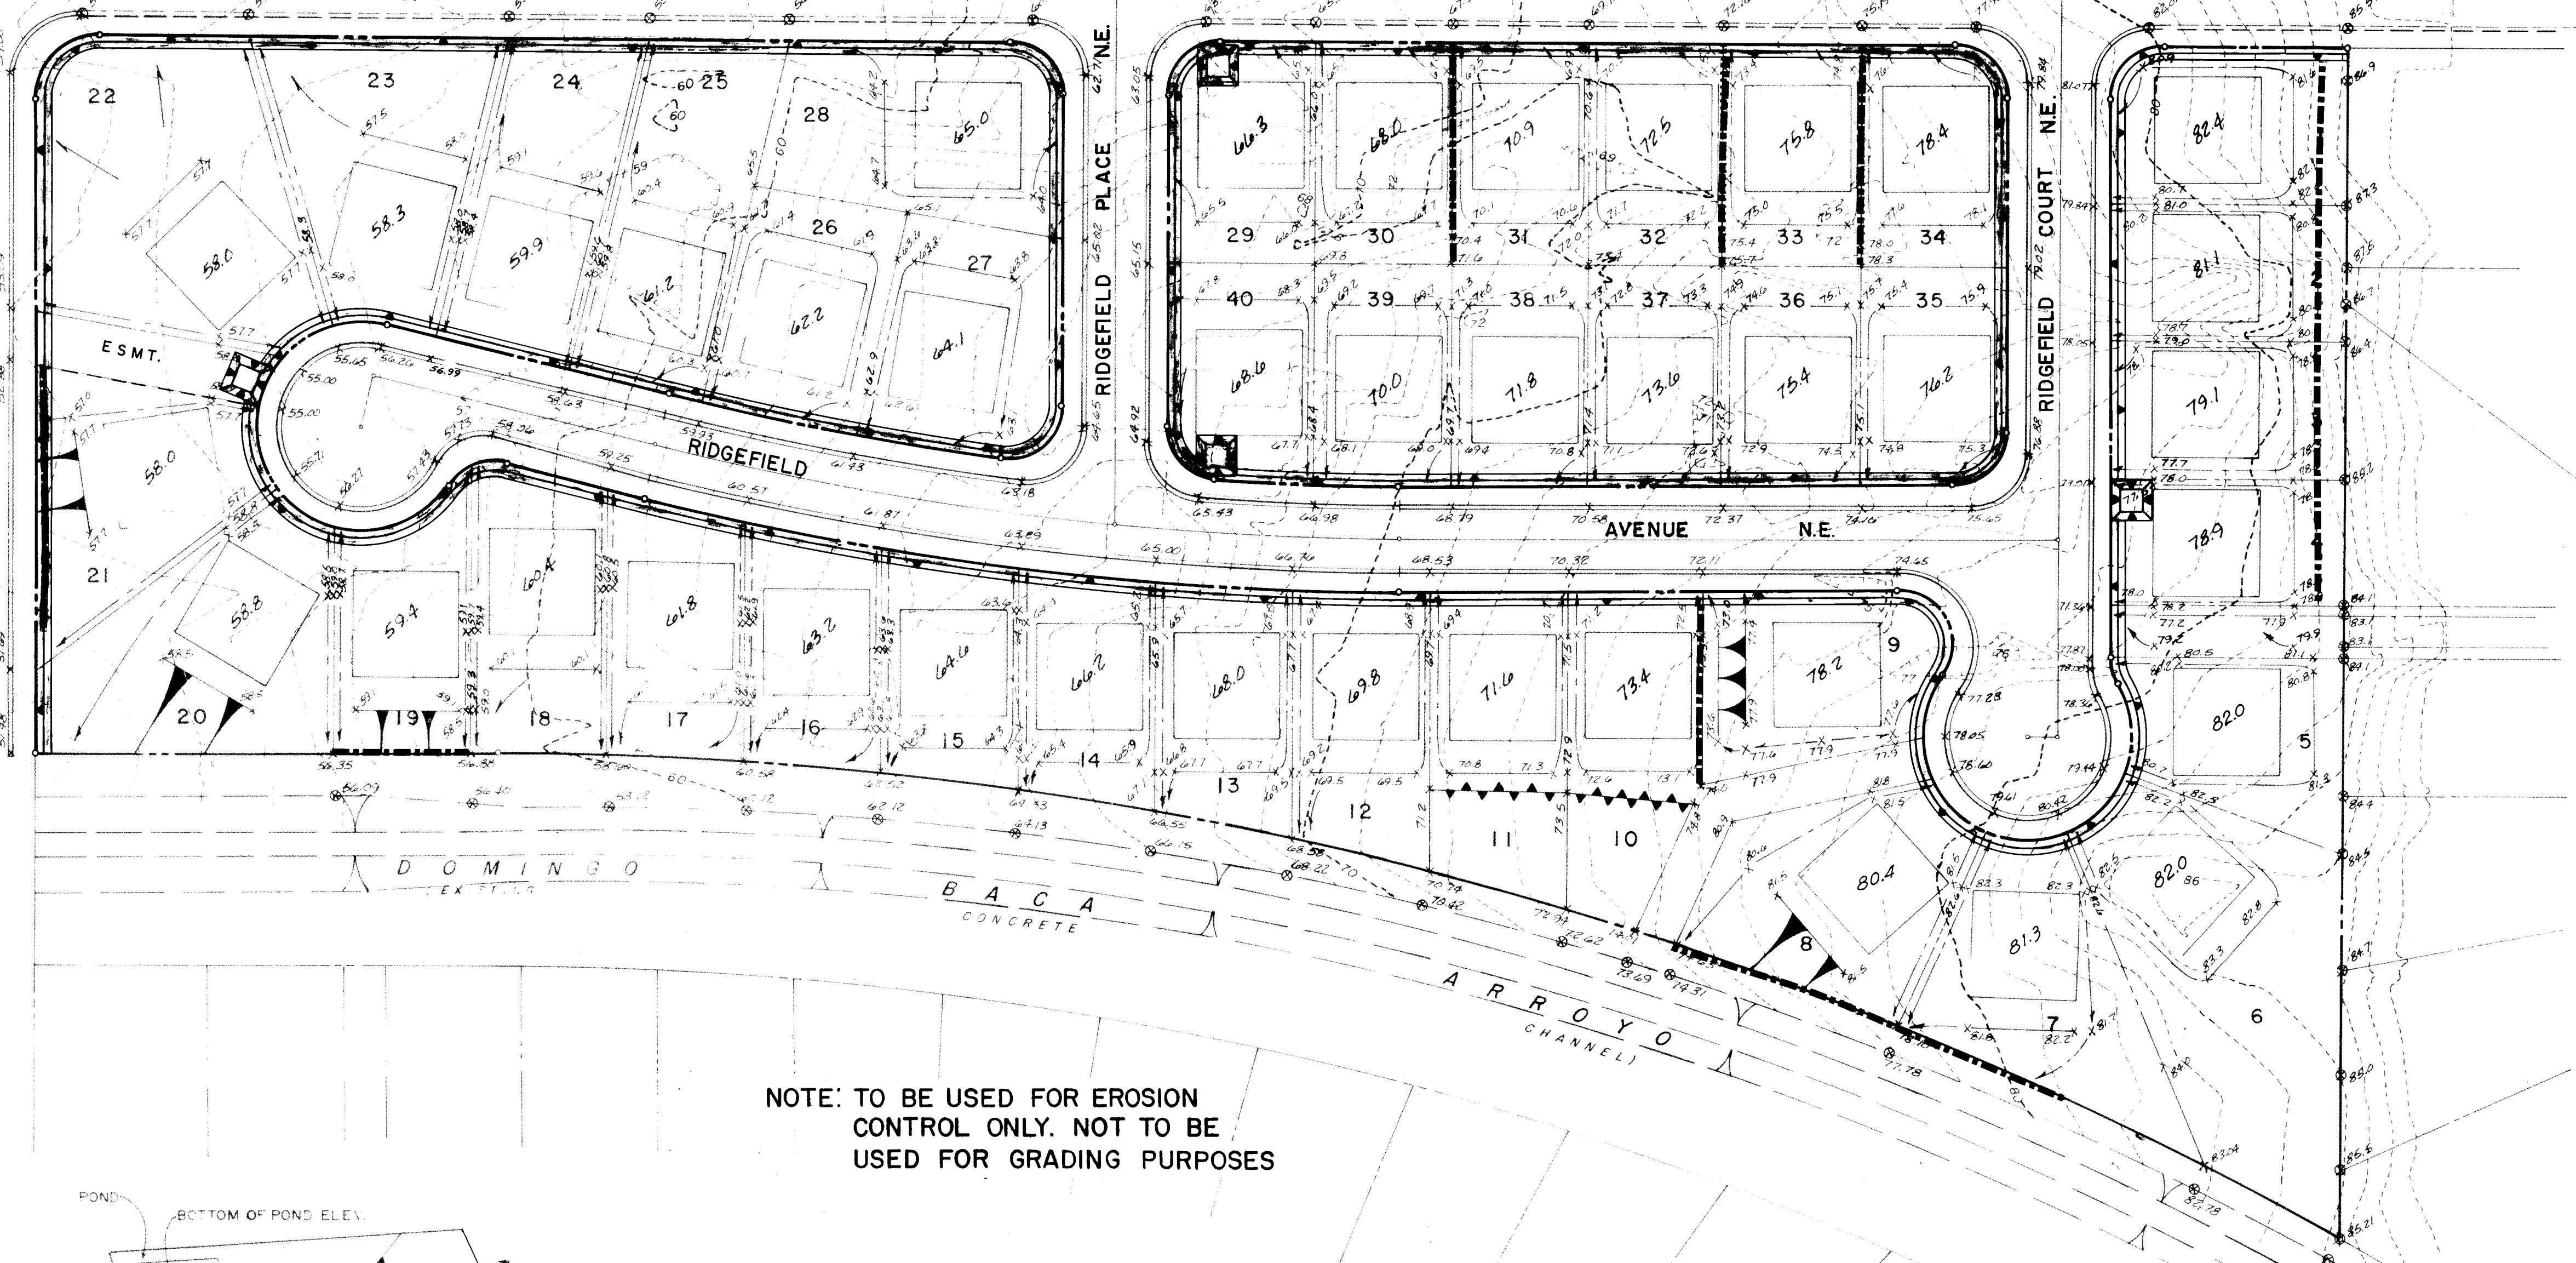

NOTE: TO BE USED FOR EROSION CONTROL ONLY. NOT TO BE USED FOR GRADING PURPOSES

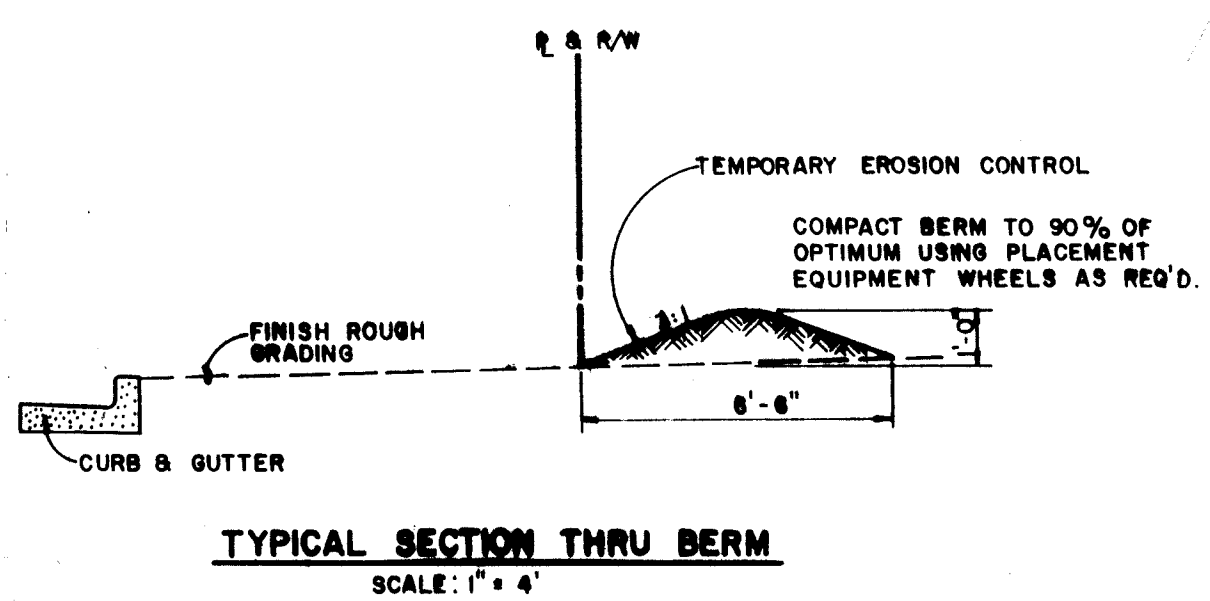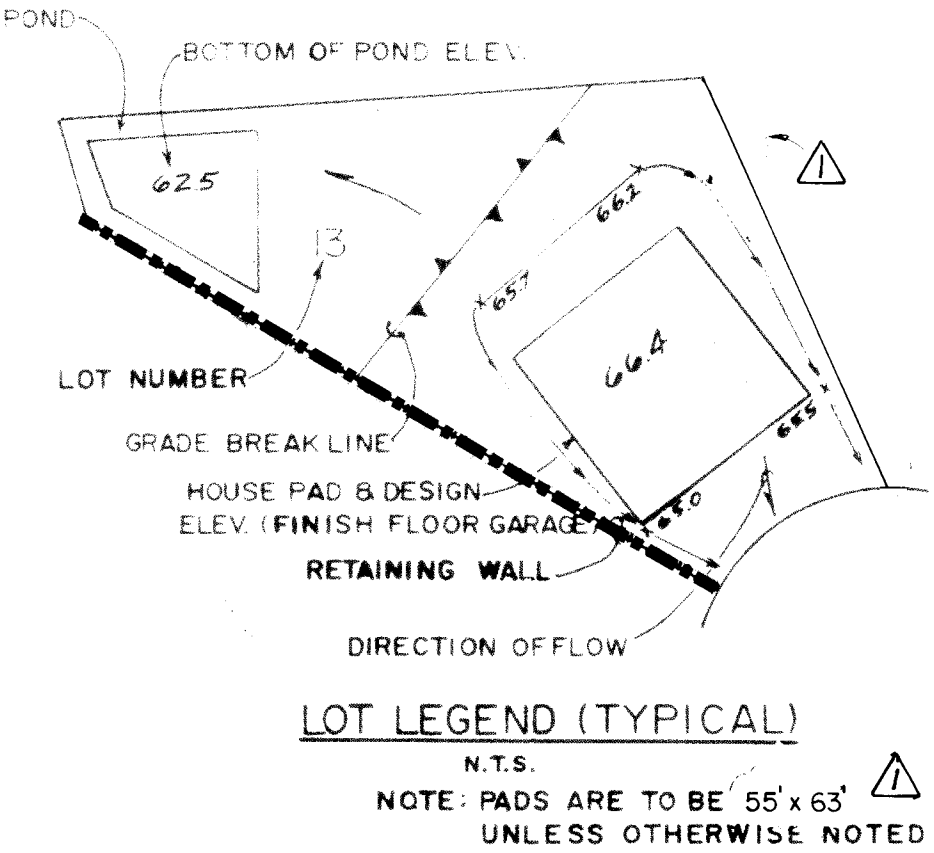

LEGEND
10' x 10' INSIDE BOTTOM, 2' DEPTH
EROSION CONTROL BERM SEE TYPICAL SECTION THIS SHEET


1 2 3 4 5 6 7 8 9 10 11 12 13 14 15
26 34 64 9 0 0 4 9 2

SHEET 4 OF 12
APPROVED FOR ROUGH GRADING
(± 1 FT.)
[Signature]
CITY HYDROLOGIST
DATE 10/20/91



SCALE: 1" = 50'

CITY OF ALBUQUERQUE PUBLIC WORKS DEPARTMENT ENGINEERING GROUP					
TITLE: RIDGEFIELD SUBDIVISION EROSION CONTROL PLAN					
APPROVALS	ENGINEER	DATE	APPROVALS	ENGINEER	DATE
D.R.C. Chair	[Signature]	11-18-91	WATER	[Signature]	11-18-91
Trans. Dev	[Signature]	11-12-91	WASTE WATER	[Signature]	11-12-91
HYDROLOGY			DATE 11-28-91		
DRAWING NO. 3464.90			MAP NO. D-20		
SHEET 4			OF 12		

ENGINEER'S SEAL		SURVEY INFORMATION		BENCH MARKS		AS BUILT INFORMATION	
		FIELD NOTES		DATE		CONTRACTOR CCM, INC.	
		NO.	BY	DATE	WORKED BY ALDRICH L.S.		
		REVISIONS		INSPECTORS		DATE 11/91	
		DESIGN		ACCEPTANCE BY [Signature]		DATE 5/92	
DESIGNED BY PL.		NO.		DATE		VERIFICATION BY [Signature]	
DRAWN BY M.C.G.		NO.		DATE		DATE 5/22/92	
CHECKED BY C.M.W.		NO.		DATE		MICRO-FILM INFORMATION	
		NO.		DATE		RECORDED BY	
		NO.		DATE		NO.	

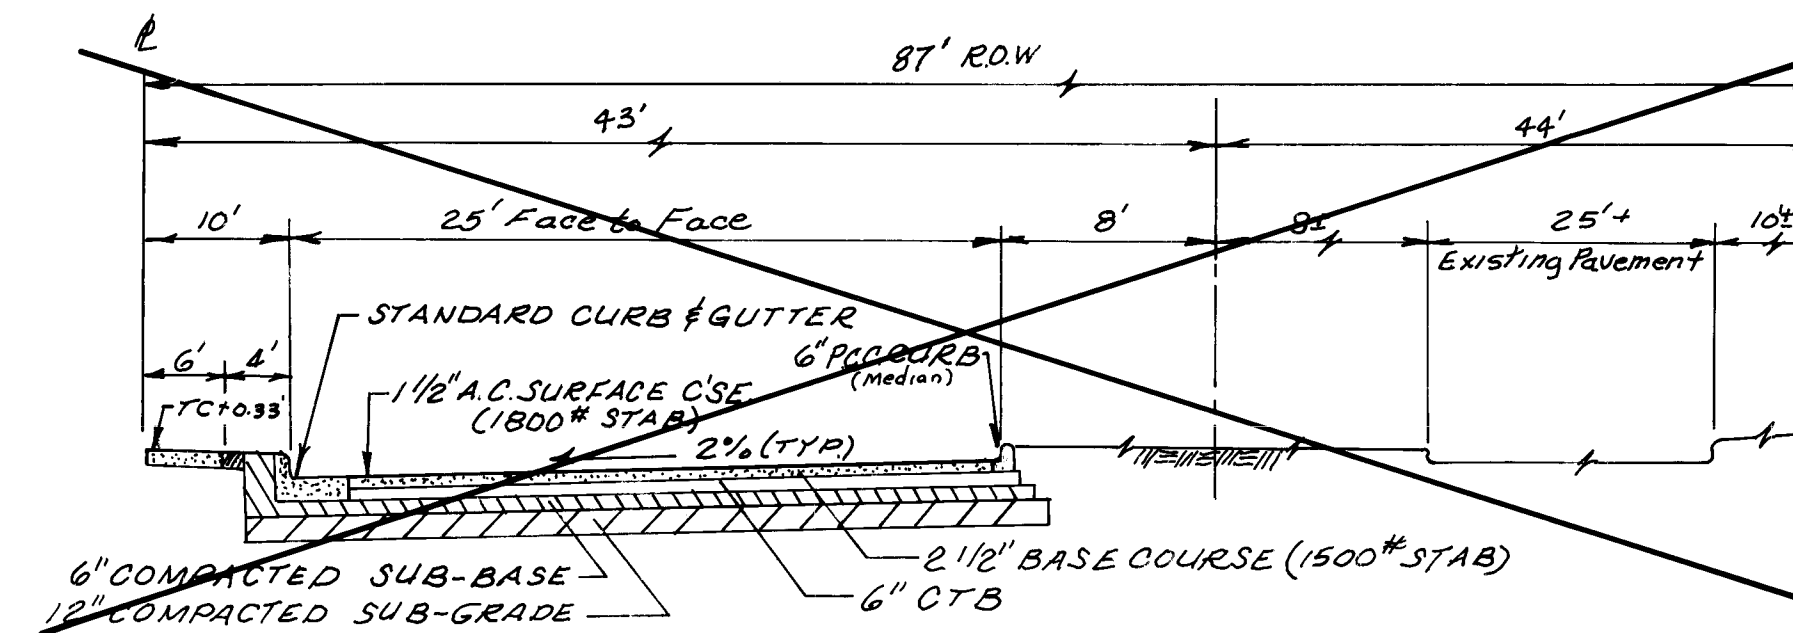

TYPICAL STREET SECTION FOR
VENTURA BLVD.
N. T. S.

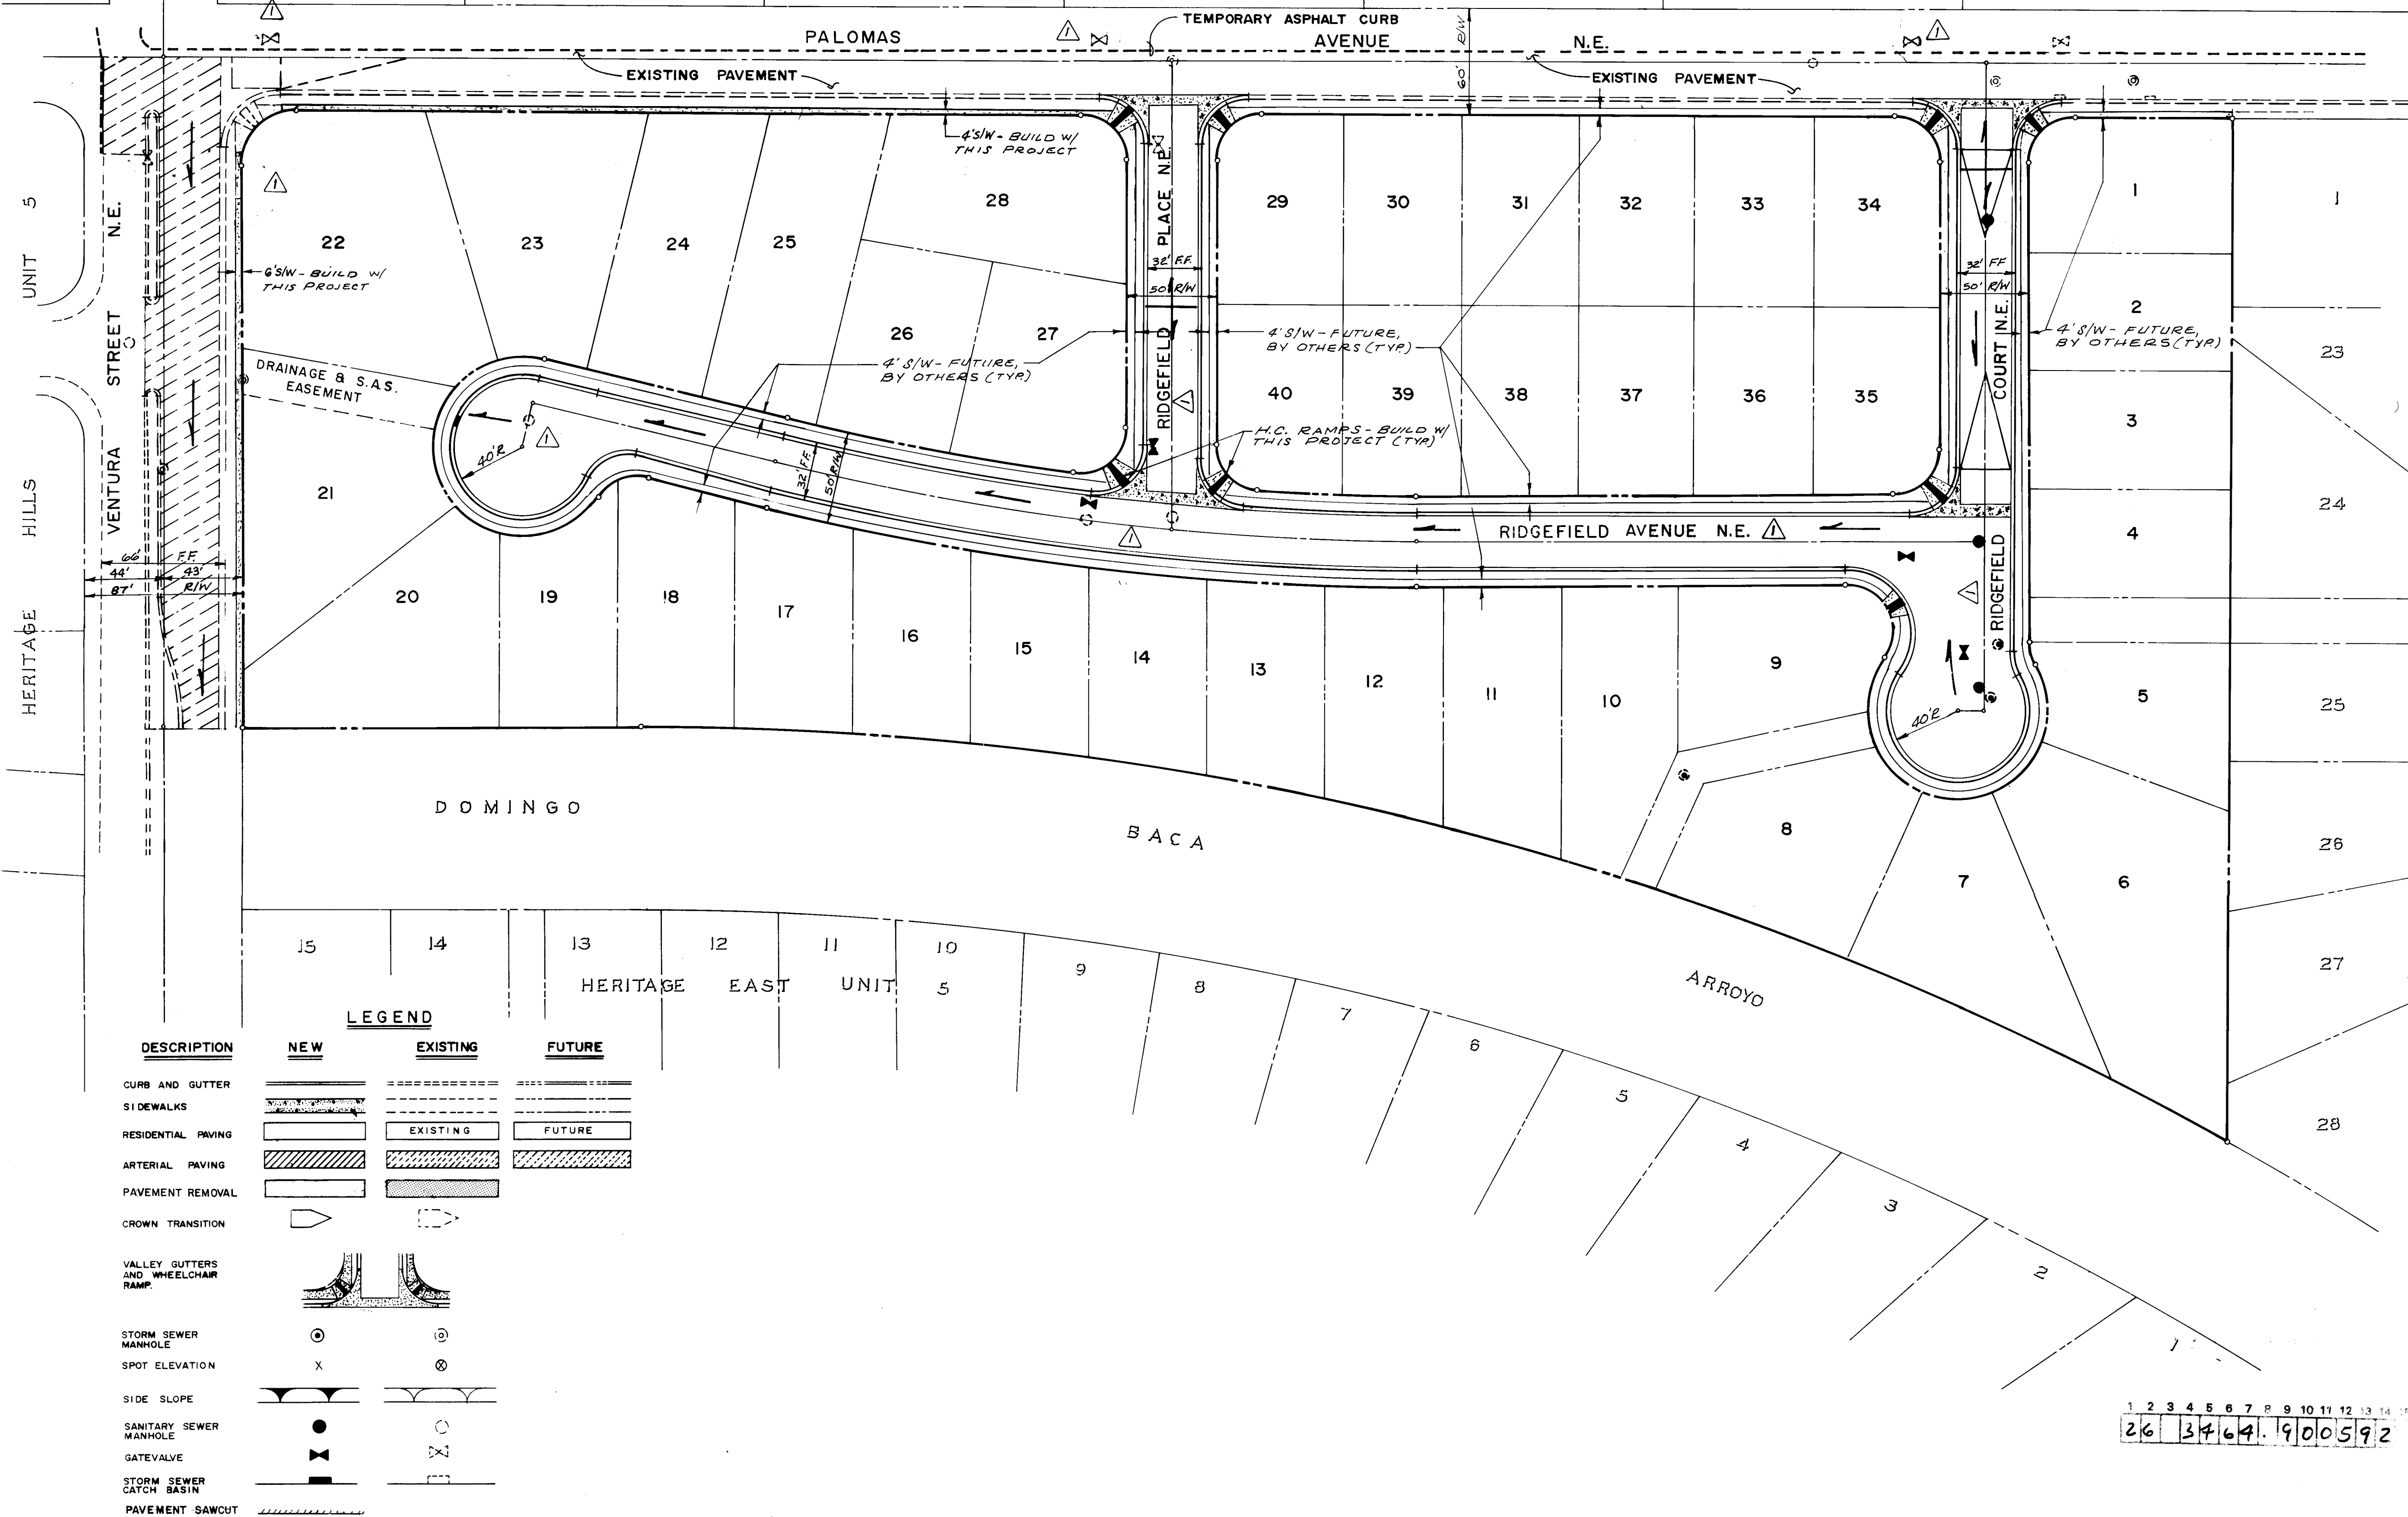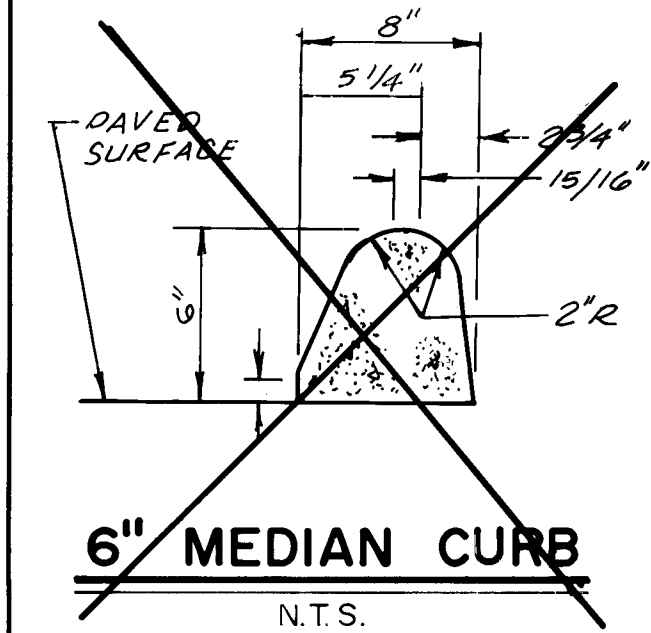

ENGINEER'S SEAL				SURVEY INFORMATION		BENCH MARKS		AS BUILT INFORMATION	
 8/27/87				FIELD NOTES		A.C.S. BRASS TABLET "11-C21A" SET IN THE TOP OF CONCRETE POST FLUSH WITH GROUND AND LOCATED AT THE NORTHEAST CORNER OF THE INTERSECTION OF PASEO DEL NORTE (LOS ANGELES DRIVE, N.E.) AND HOLBROOK STREET, N.E. ELEVATION = 5634.65'			
				NO. BY DATE				CONTRACTOR	
				REMARKS				WORKED BY	
				REVISONS				INSPECTED BY	
				DESIGN				ACCEPTANCE BY	
DESIGNED BY <i>PL.</i>		DATE <i>7-25-87</i>		FIELD VERIFICATION BY <i>PL.</i>		DATE <i>7/27/87</i>			
DRAWN BY <i>T.G.O.</i>		DATE <i>7-25-87</i>		DRAWINGS CORRECTED BY <i>PL.</i>		DATE <i>7/27/87</i>			
CHECKED BY <i>K.M.W.</i>		DATE <i>8/1/87</i>		RECORDED BY		DATE			
				NO					

SCALE :
1" = 50'


community
sciences
corporation

CITY OF ALBUQUERQUE
PUBLIC WORKS DEPARTMENT
ENGINEERING GROUP

TITLE: RIDGEFIELD SUBDIVISION 
PAVING COMPOSITE PLAN

APPROVALS	ENGINEER	DATE	APPROVALS	ENGINEER	DATE
D.R.C. Chair	<i>Roger A. Brown</i>	11-18-91	WATER	<i>Bill Brown</i>	11-14-91
Trans. Dev.	<i>R. D. Danks</i>	11-12-91	WASTE WATER	<i>Bill Brown</i>	-
HYDROLOGY	<i>Bill Brown</i>	11-12-91			

DRAWING NO.	3464.90	MAP NO.	D-20	SHEET	5	OF	12
-------------	---------	---------	------	-------	---	----	----

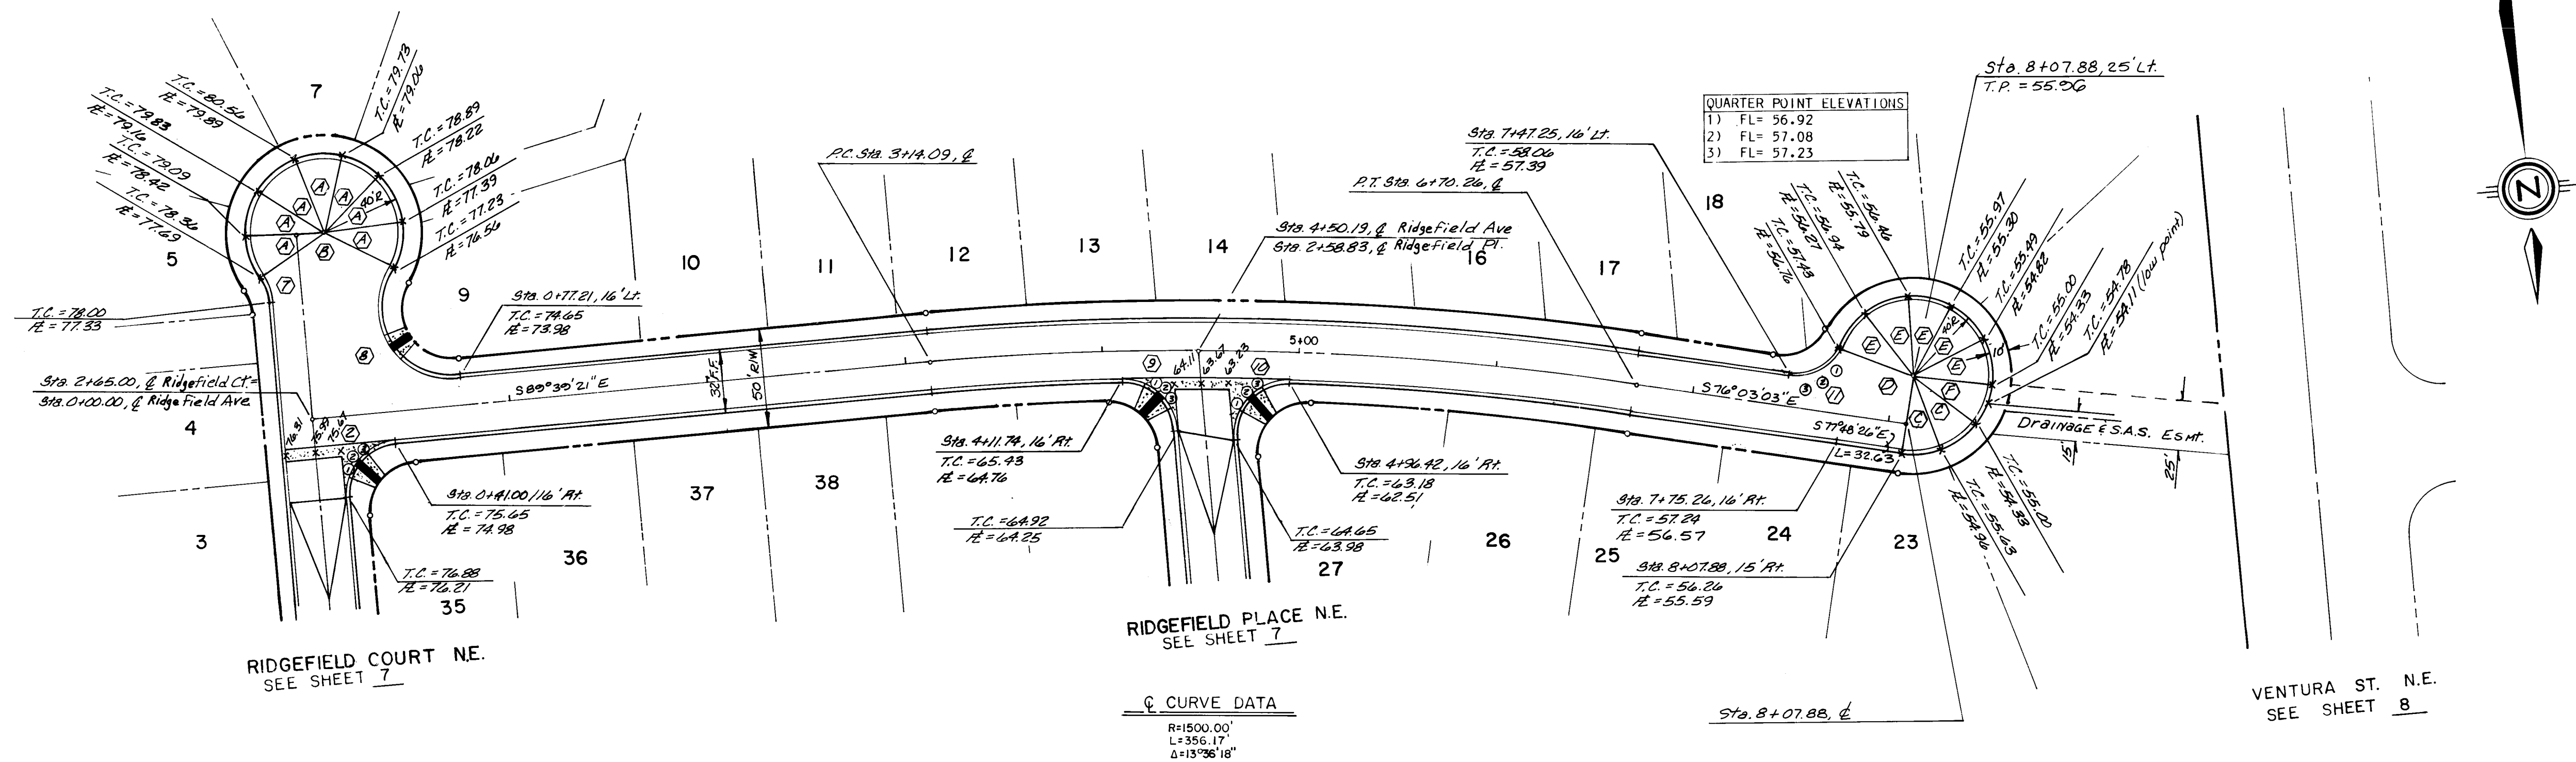


CURVE	RADIUS	ARC	DELTA
A	40.00'	24.46'	35°01'49"
B	40.00'	-	114°47'31"
C	40.00'	21.66'	31°01'33"
D	40.00'	-	102°06'12"
E	40.00'	23.12'	33°01'12"
F	40.00'	21.10'	30°13'30"
1	30.00'	47.23'	90°12'35"
2	25.00'	39.27'	90°00'00"
3	150.00'	42.57'	16°15'37"
4	2.39'	7.51'	180°00'00"
5	2.36'	7.41'	180°00'00"
6	2.30'	7.22'	180°00'00"
7	22.00'	12.00'	31°15'29"
8	35.00'	75.72'	123°57'10"
9	25.00'	37.64'	86°16'13"
10	25.00'	42.31'	96°57'52"
11	22.00'	29.91'	77°53'48"

A.C.S. BRASS TABLET "1-C21A" SET IN THE TOP OF CONCRETE POST FLUSH WITH GROUND AND LOCATED AT THE NORTHEAST CORNER OF THE INTERSECTION OF PASEO DEL NORTE (LOS ANGELES DRIVE, N.E.) AND HOLBROOK STREET, N.E. ELEVATION = 5634.65'

RIDGEFIELD AVENUE, N.E. △ (RESIDENTIAL PAVEMENT)

NOTE: THIS SHEET IS ORIENTED SUCH THAT NORTH ARROW POINTS DOWN.

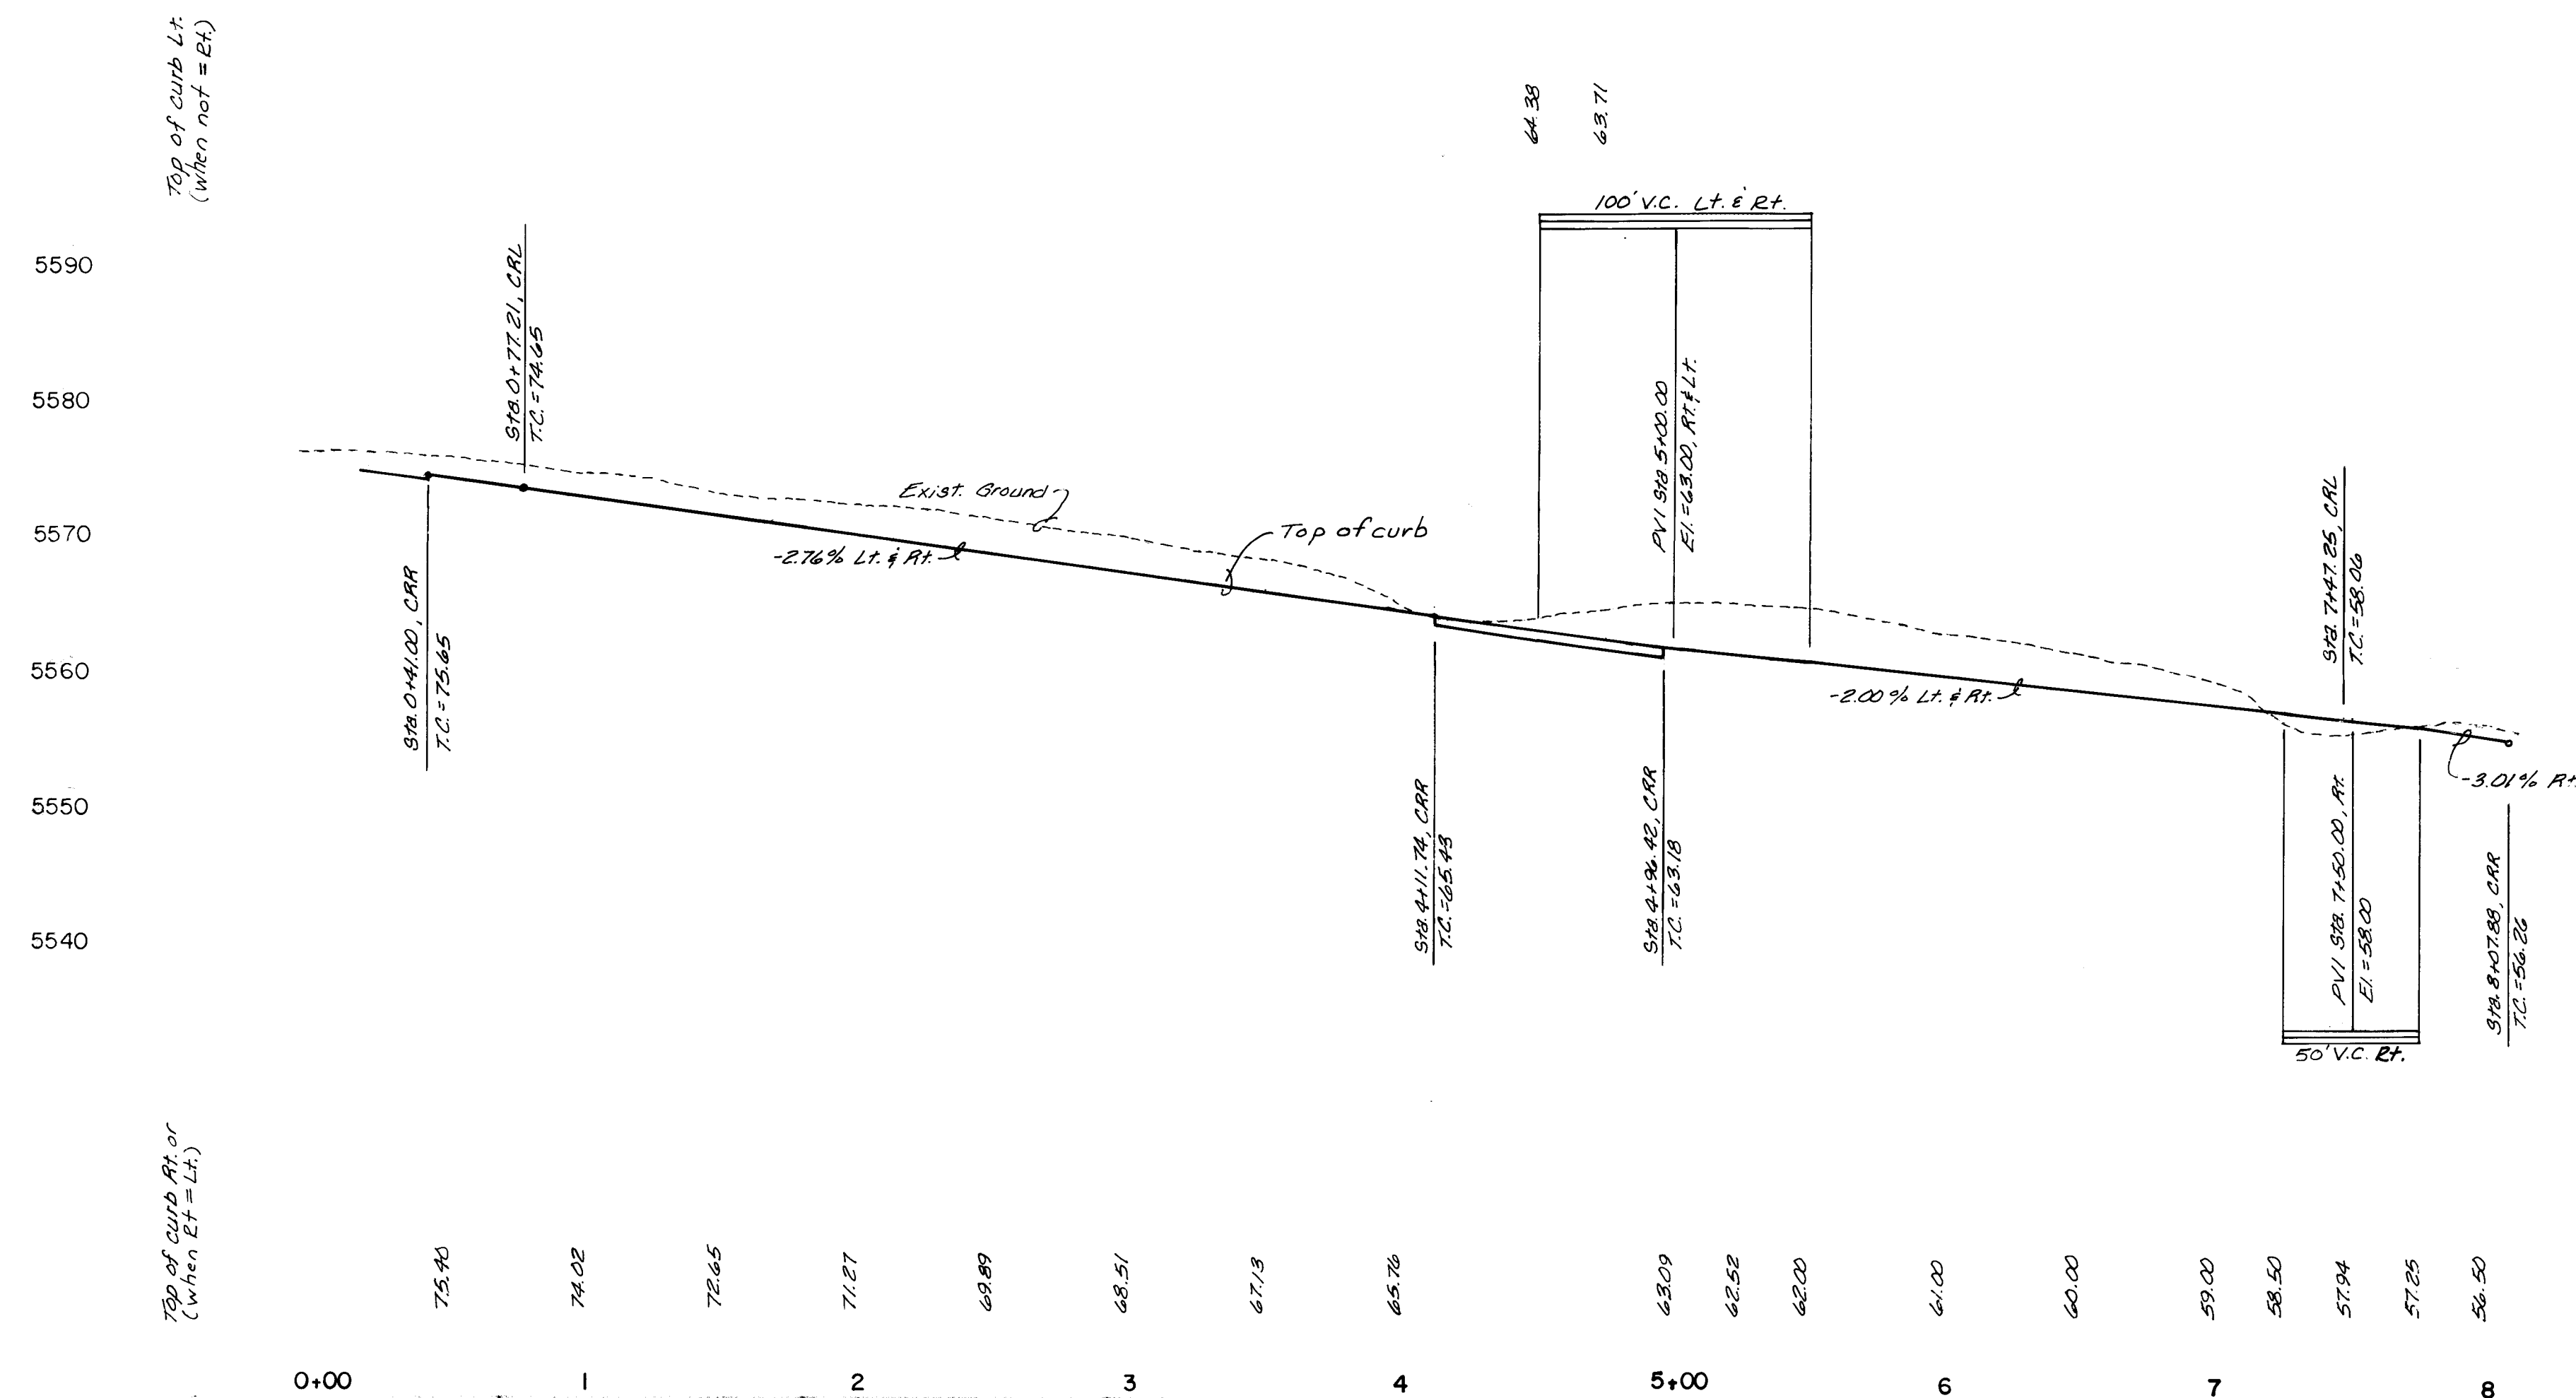


5590
5580
5570
5560
5550
5540

SCALE:
1"=50' HORIZ.
1"=10' VERT.




RIDGEFIELD SUBDIVISION
PAVING PLAN AND PROFILE
RIDGEFIELD AVENUE, N.E.

HYDROLOGY
WATER
WASTE WATER
11-18-91
11-12-91
11-18-91

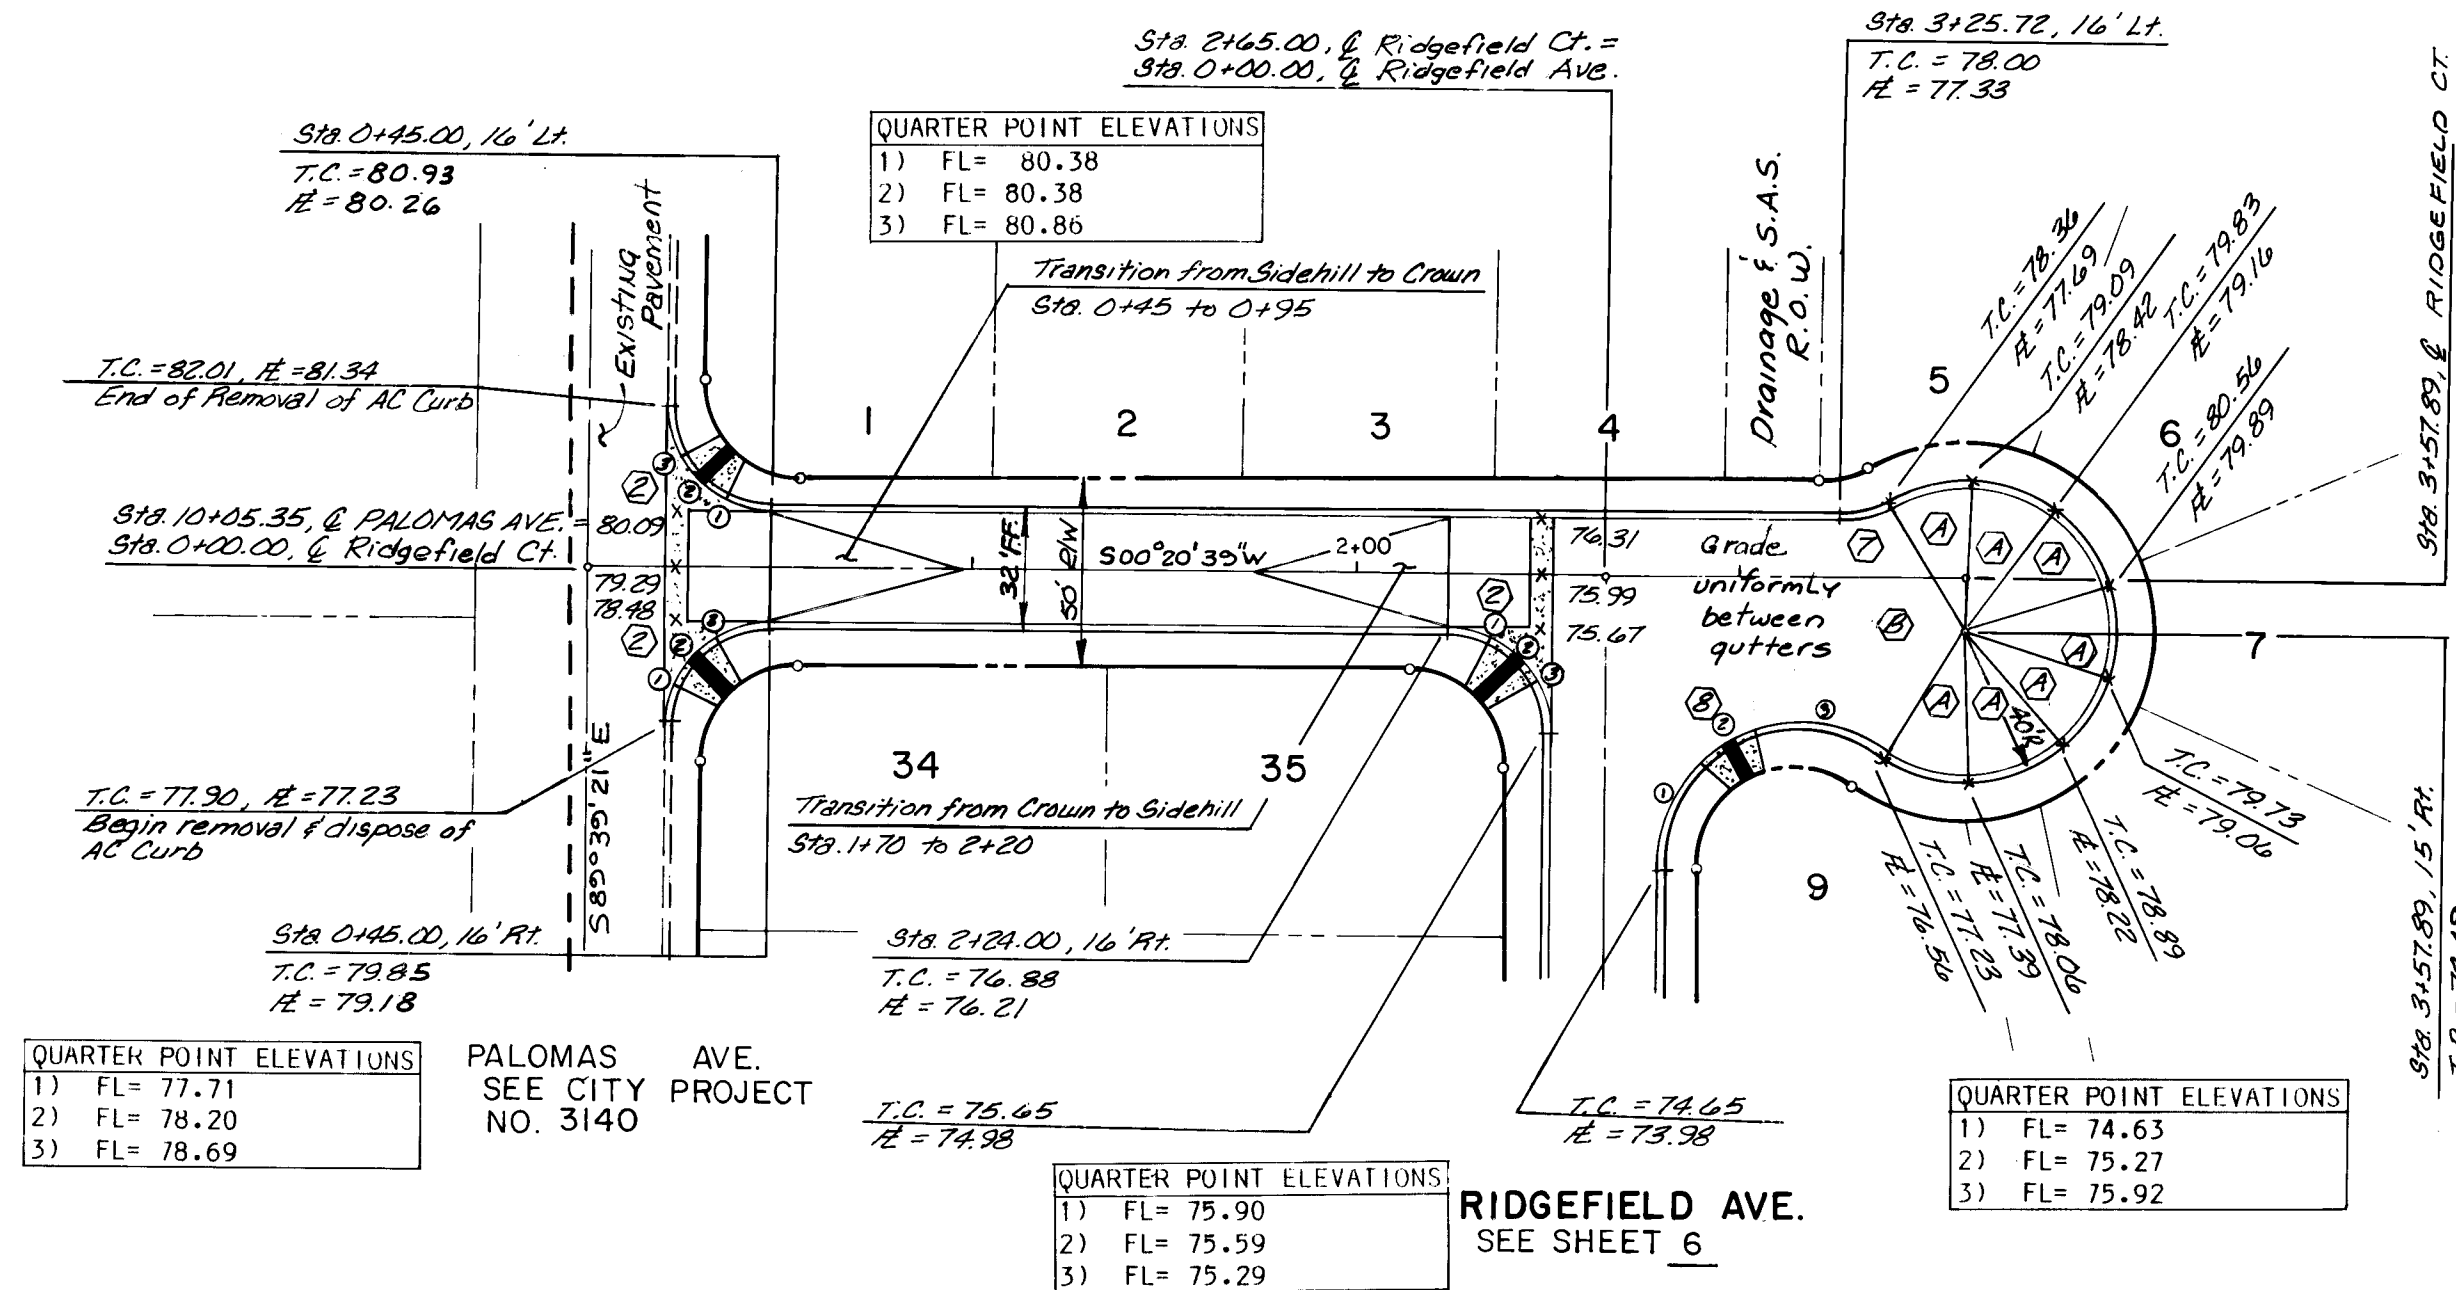


RIDGEFIELD COURT, N E
(RESIDENTIAL PAVEMENT)


Top of curb Lt. (When not = to Rt.)	80.91	80.62	79.99	77.93	77.39	77.08	76.98	77.10	77.43
---	-------	-------	-------	-------	-------	-------	-------	-------	-------

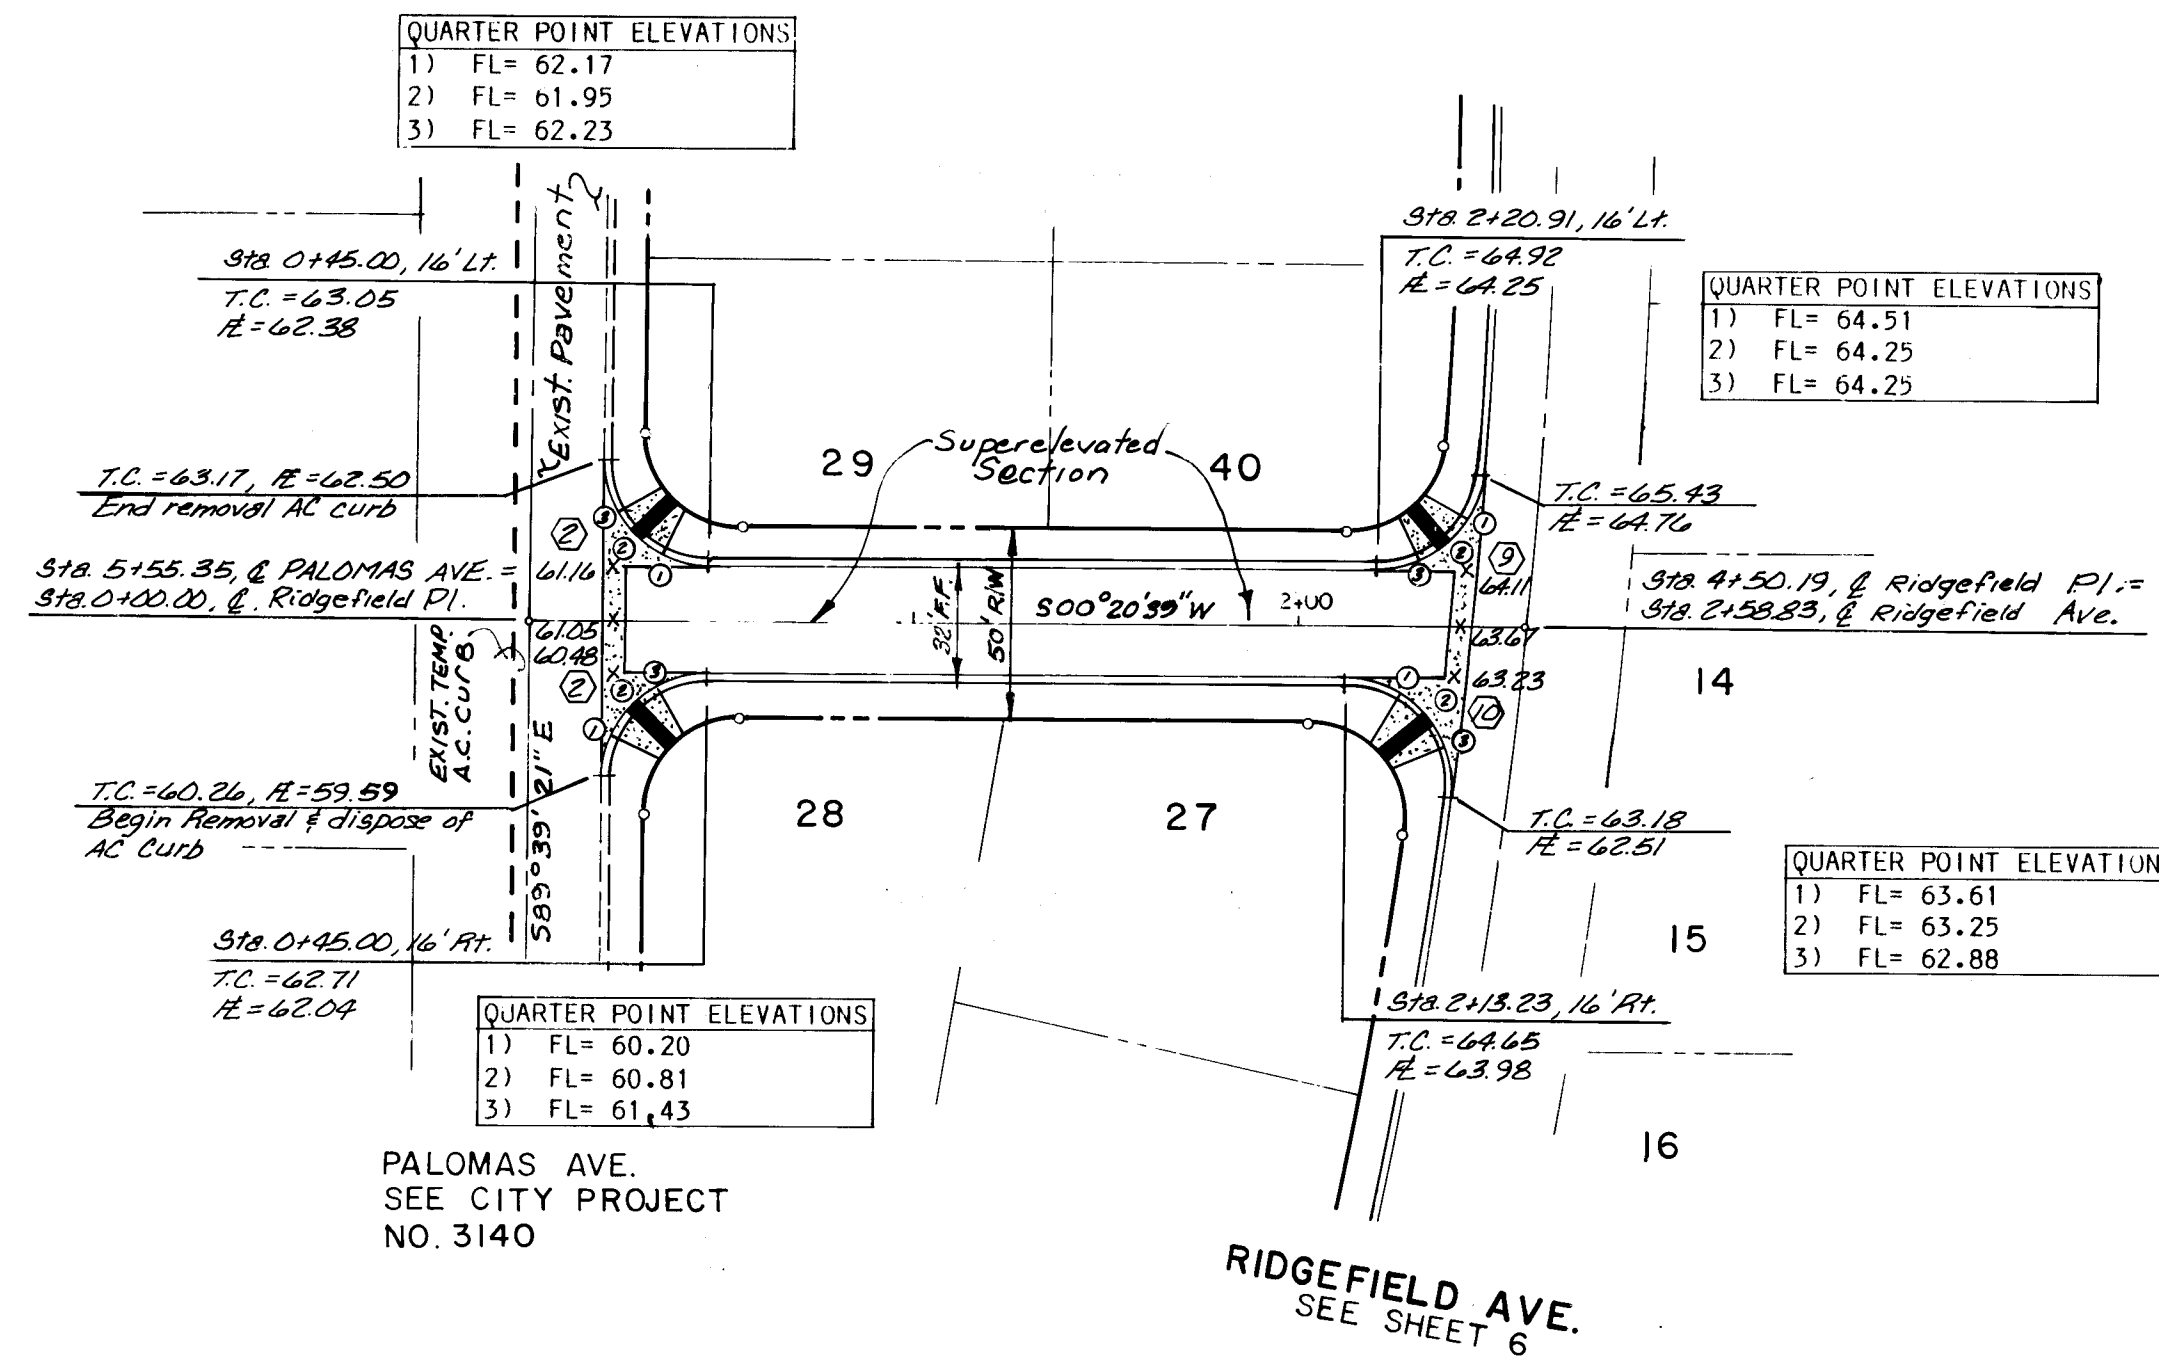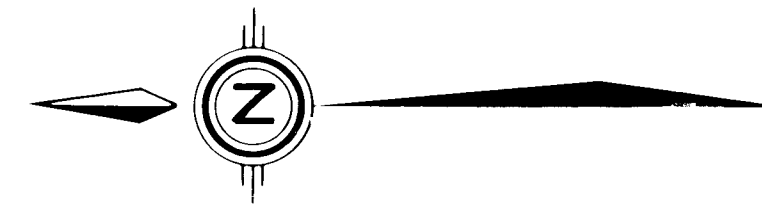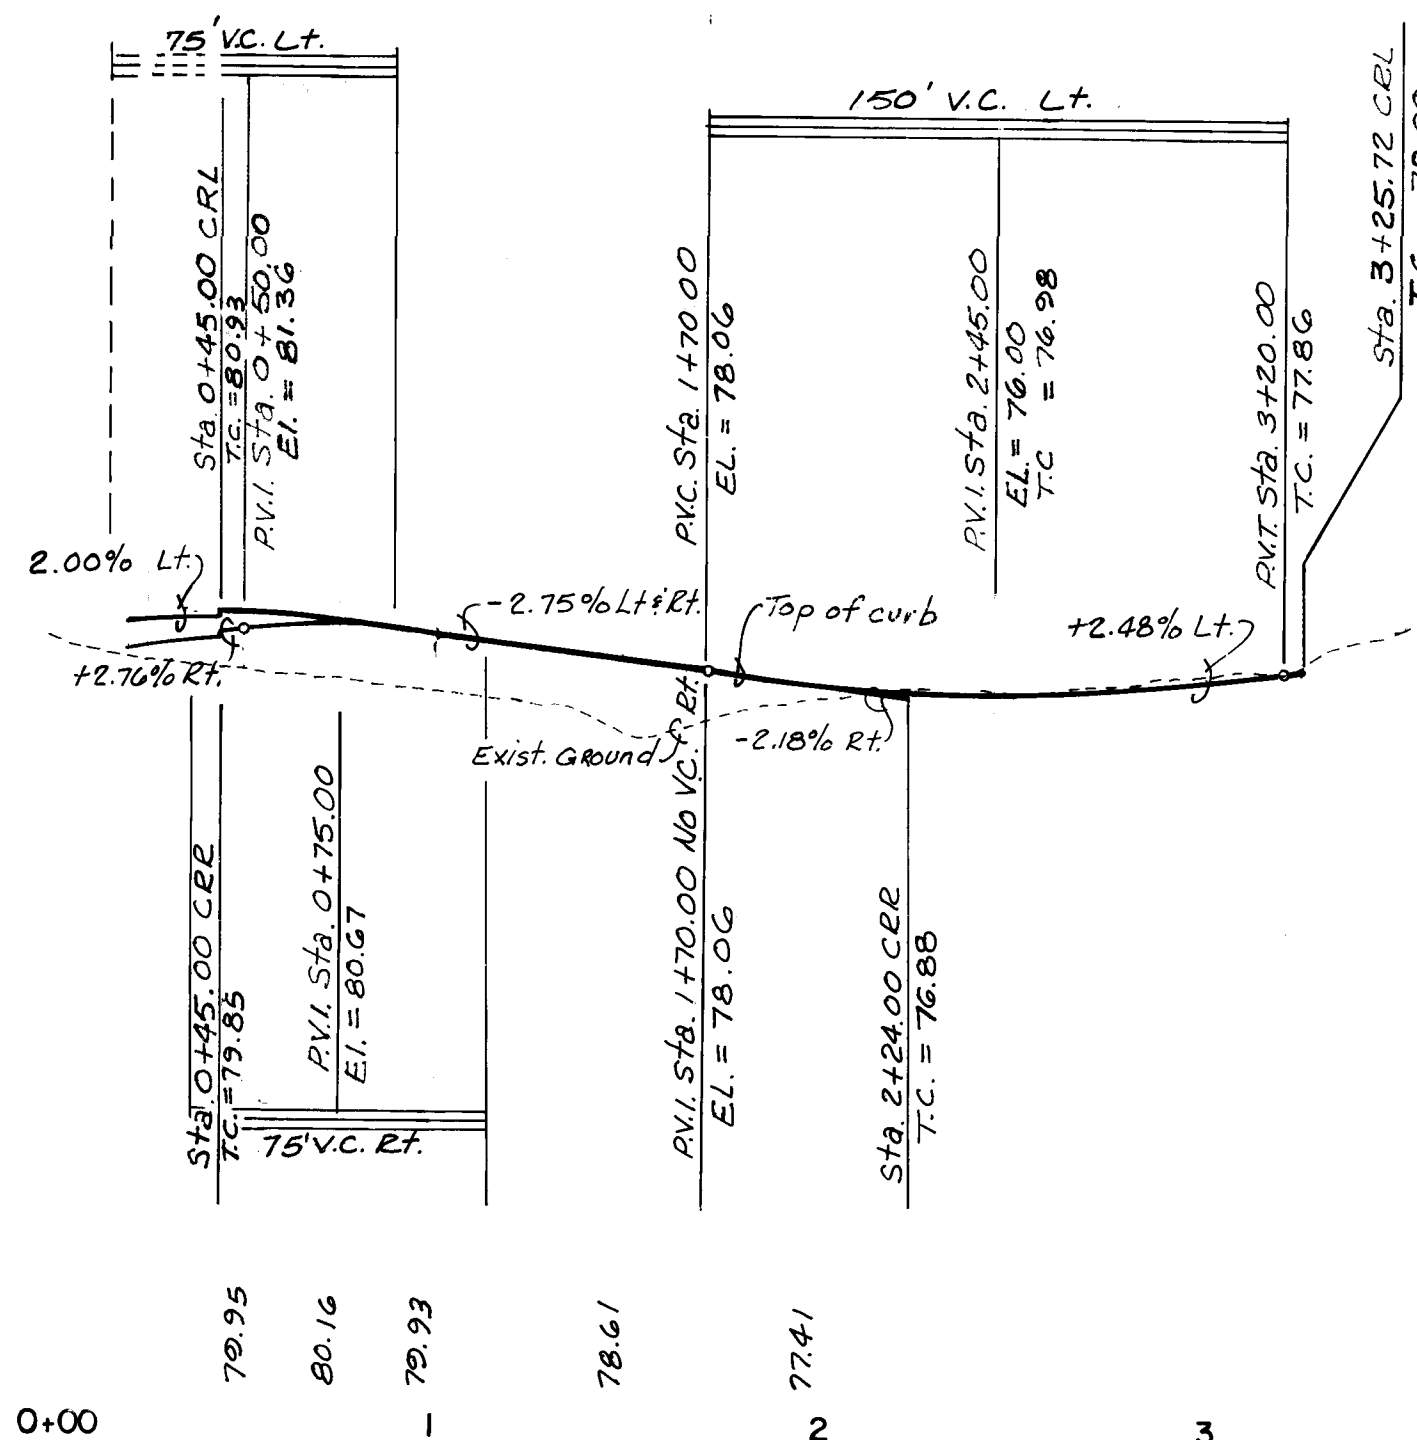

RIDGEFIELD PLACE, N.E.
(RESIDENTIAL PAVEMENT)

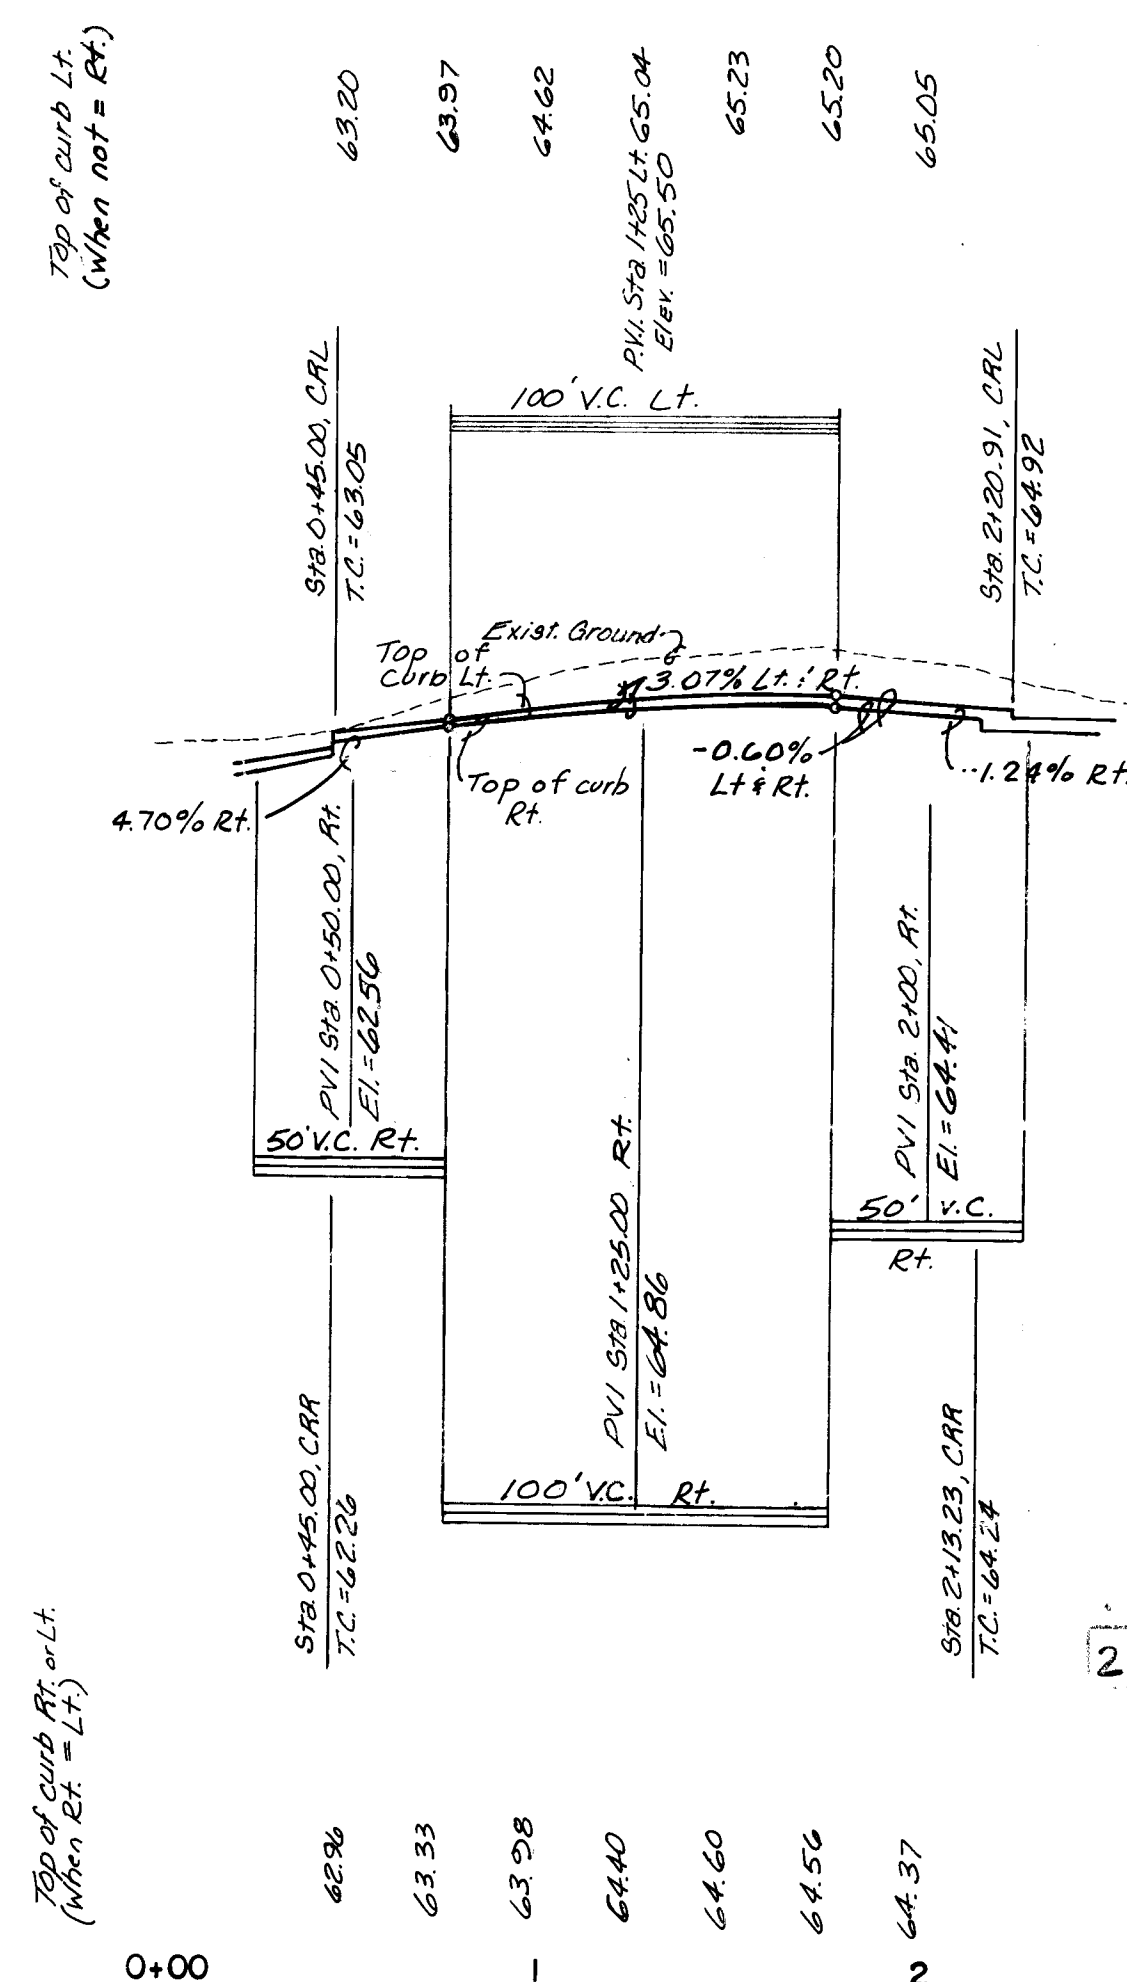

CURVE	RADIUS	ARC	DELTA
A	40.00'	24.46'	35°01'49"
B	40.00'	114°47'31"	114°47'31"
C	40.00'	21.66'	31°01'33"
D	40.00'	102°06'12"	102°06'12"
E	40.00'	23.12'	33°01'27"
F	40.00'	21.10'	30°13'30"
1	30.00'	47.23'	90°12'35"
2	25.00'	39.27'	90°00'00"
3	150.00'	42.57'	16°15'37"
4	2.39'	7.51'	180°00'00"
5	2.36'	7.41'	180°00'00"
6	2.30'	7.22'	180°00'00"
7	22.00'	12.00'	31°15'29"
8	35.00'	75.72'	123°57'10"
9	25.00'	37.64'	86°16'13"
10	25.00'	42.31'	96°57'52"
11	22.00'	29.91'	77°53'48"

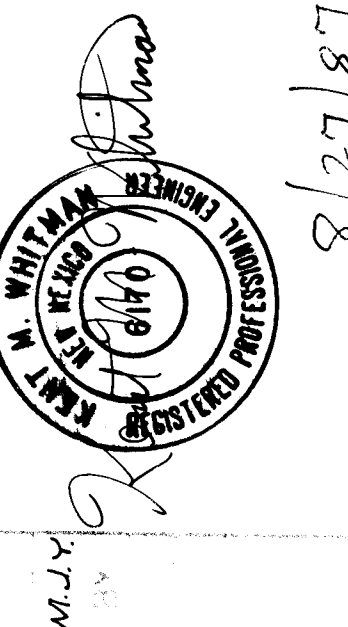


SCALE:
1"=50' HORIZ.
1"=10' VERT.

community
sciences
corporation

RIDGEFIELD SUBDIVISION
PAVING PLAN AND PROFILE
RIDGEFIELD COURT, NE - RIDGEFIELD PLACE, NE

Hydrology: *Hydrology* 11-18-91
WATER
WASTE WATER
11-18-91
11-18-91

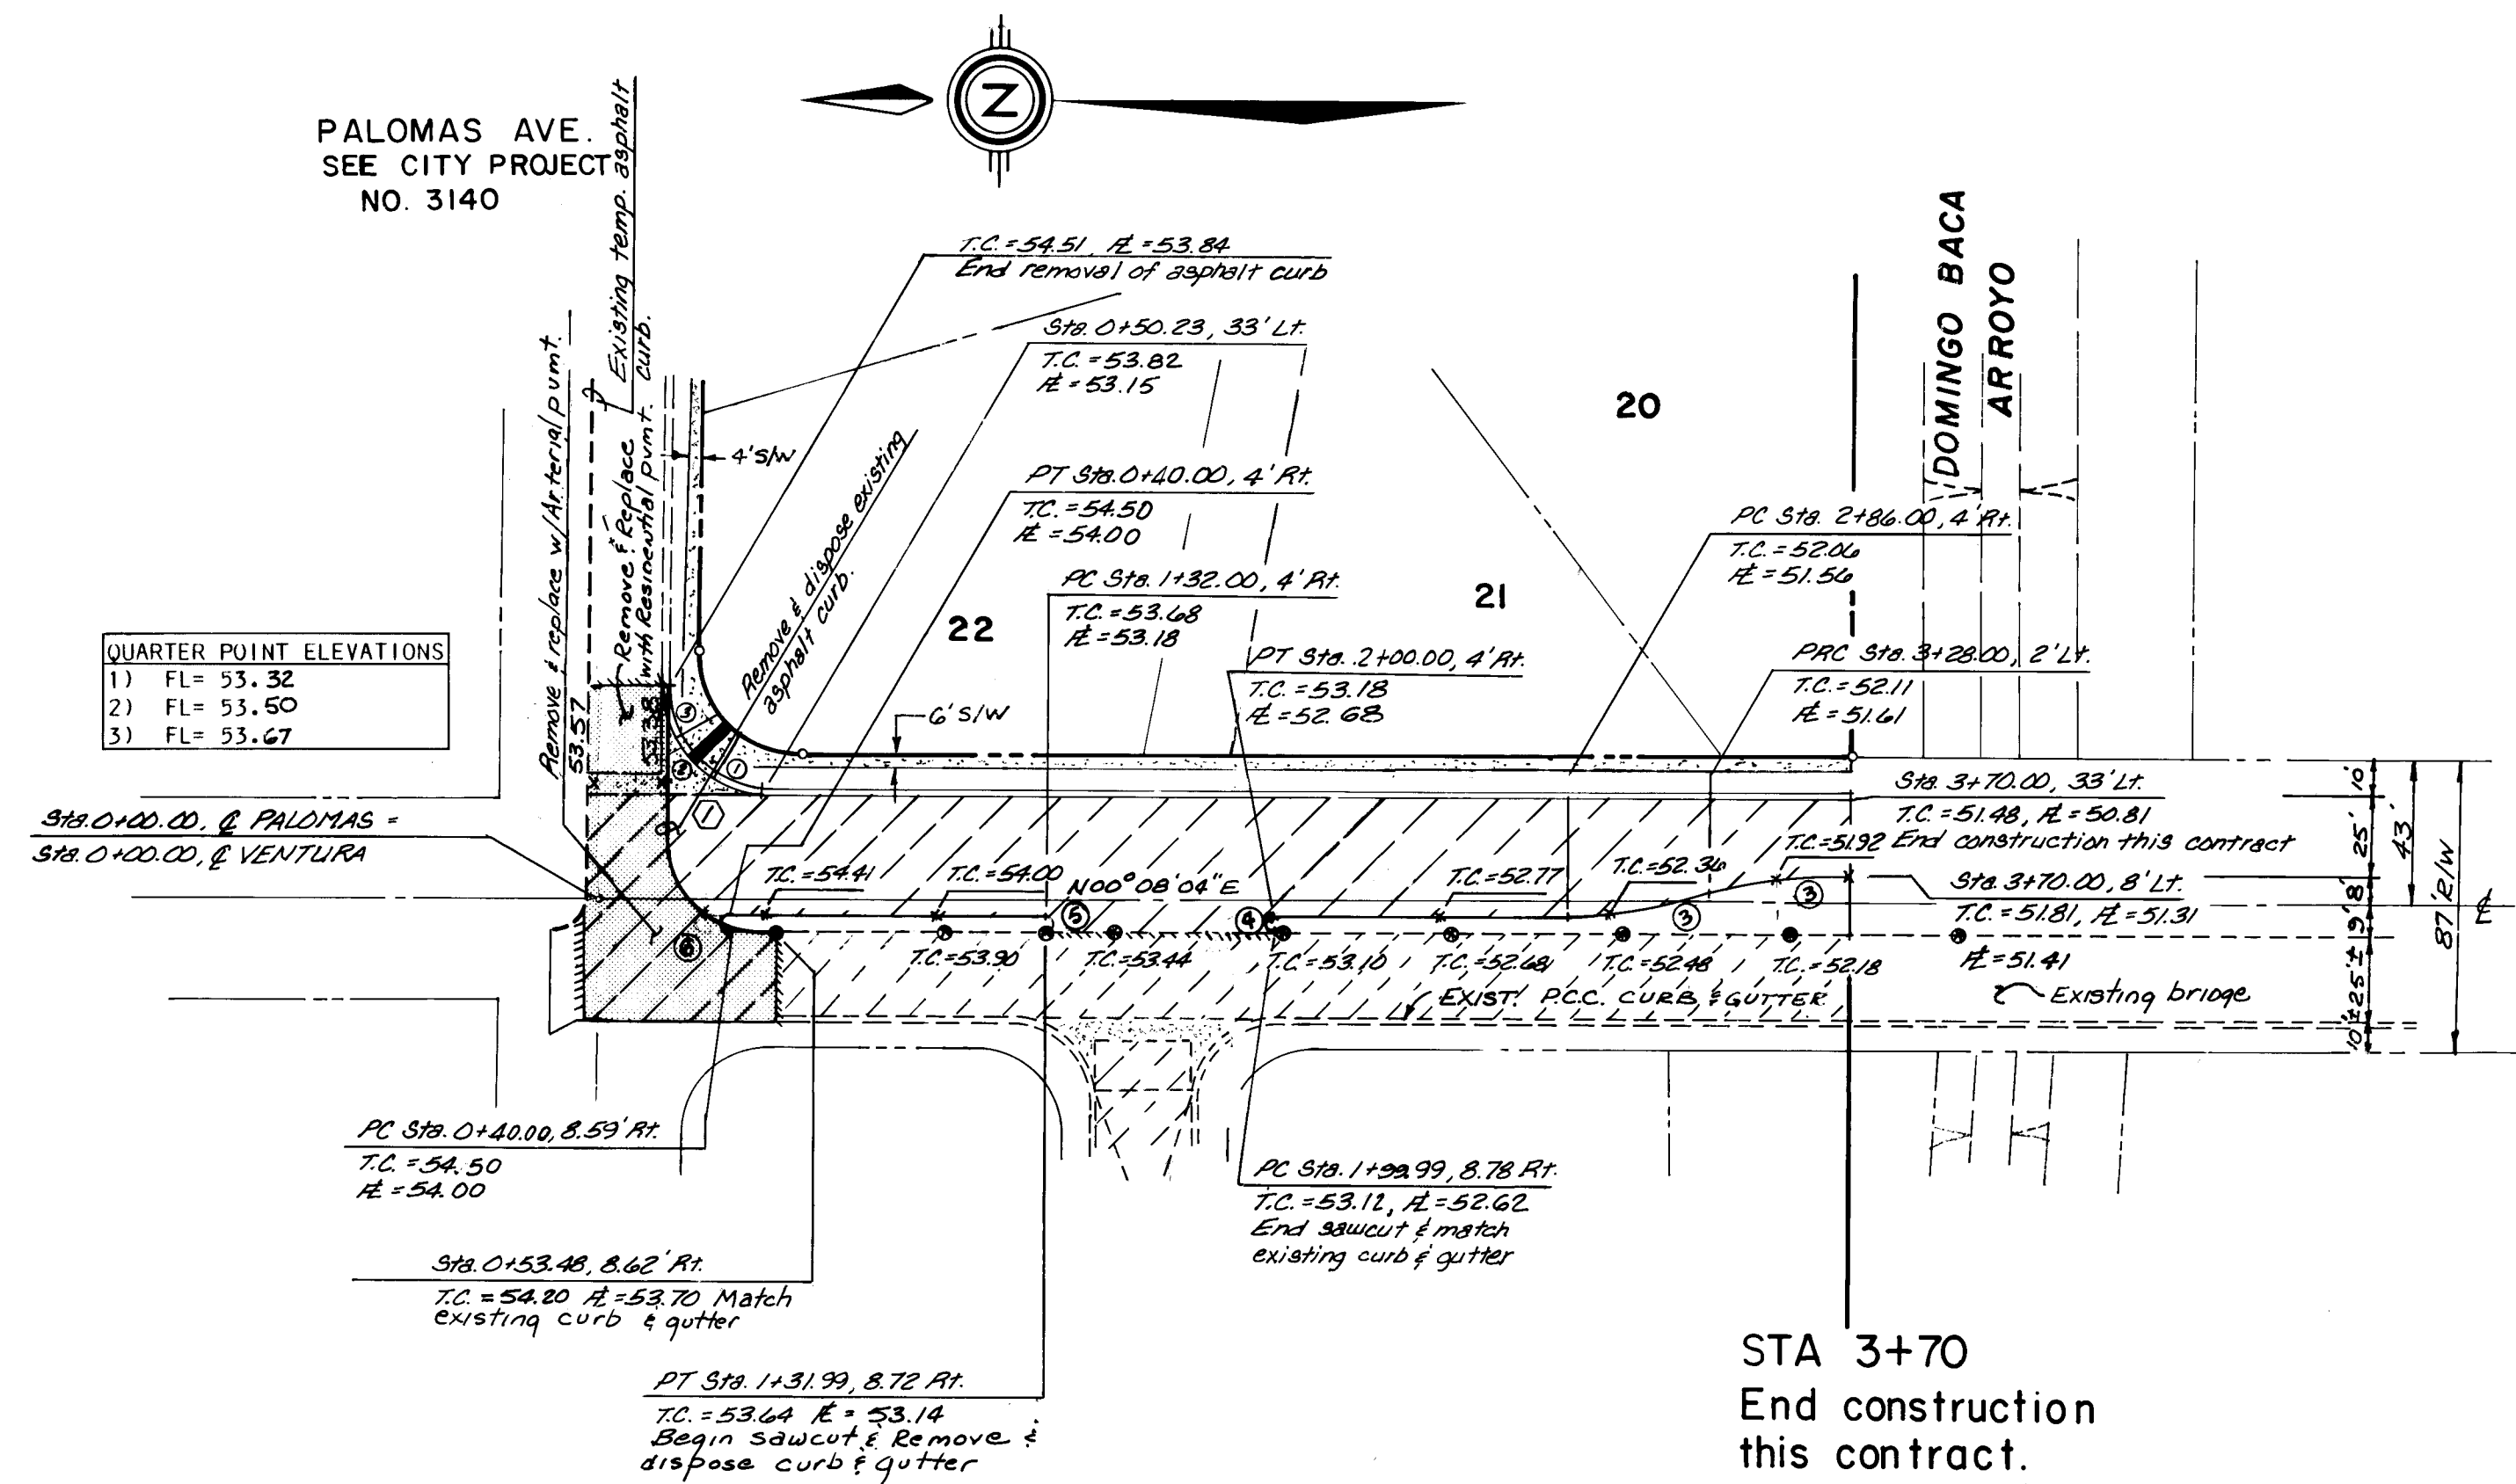


QUARTER POINT ELEVATIONS

1)	FL= 53.32
2)	FL= 53.50
3)	FL= 53.67

NOT A PART
PER C.O.A. PROJECT NO. 3334
(VENTURA ST. NORTH OF DOMINGO
BACA ARROYO)


VENTURA ST. N.E.
(ARTERIAL PAVEMENT)

FOR INFORMATION ONLY

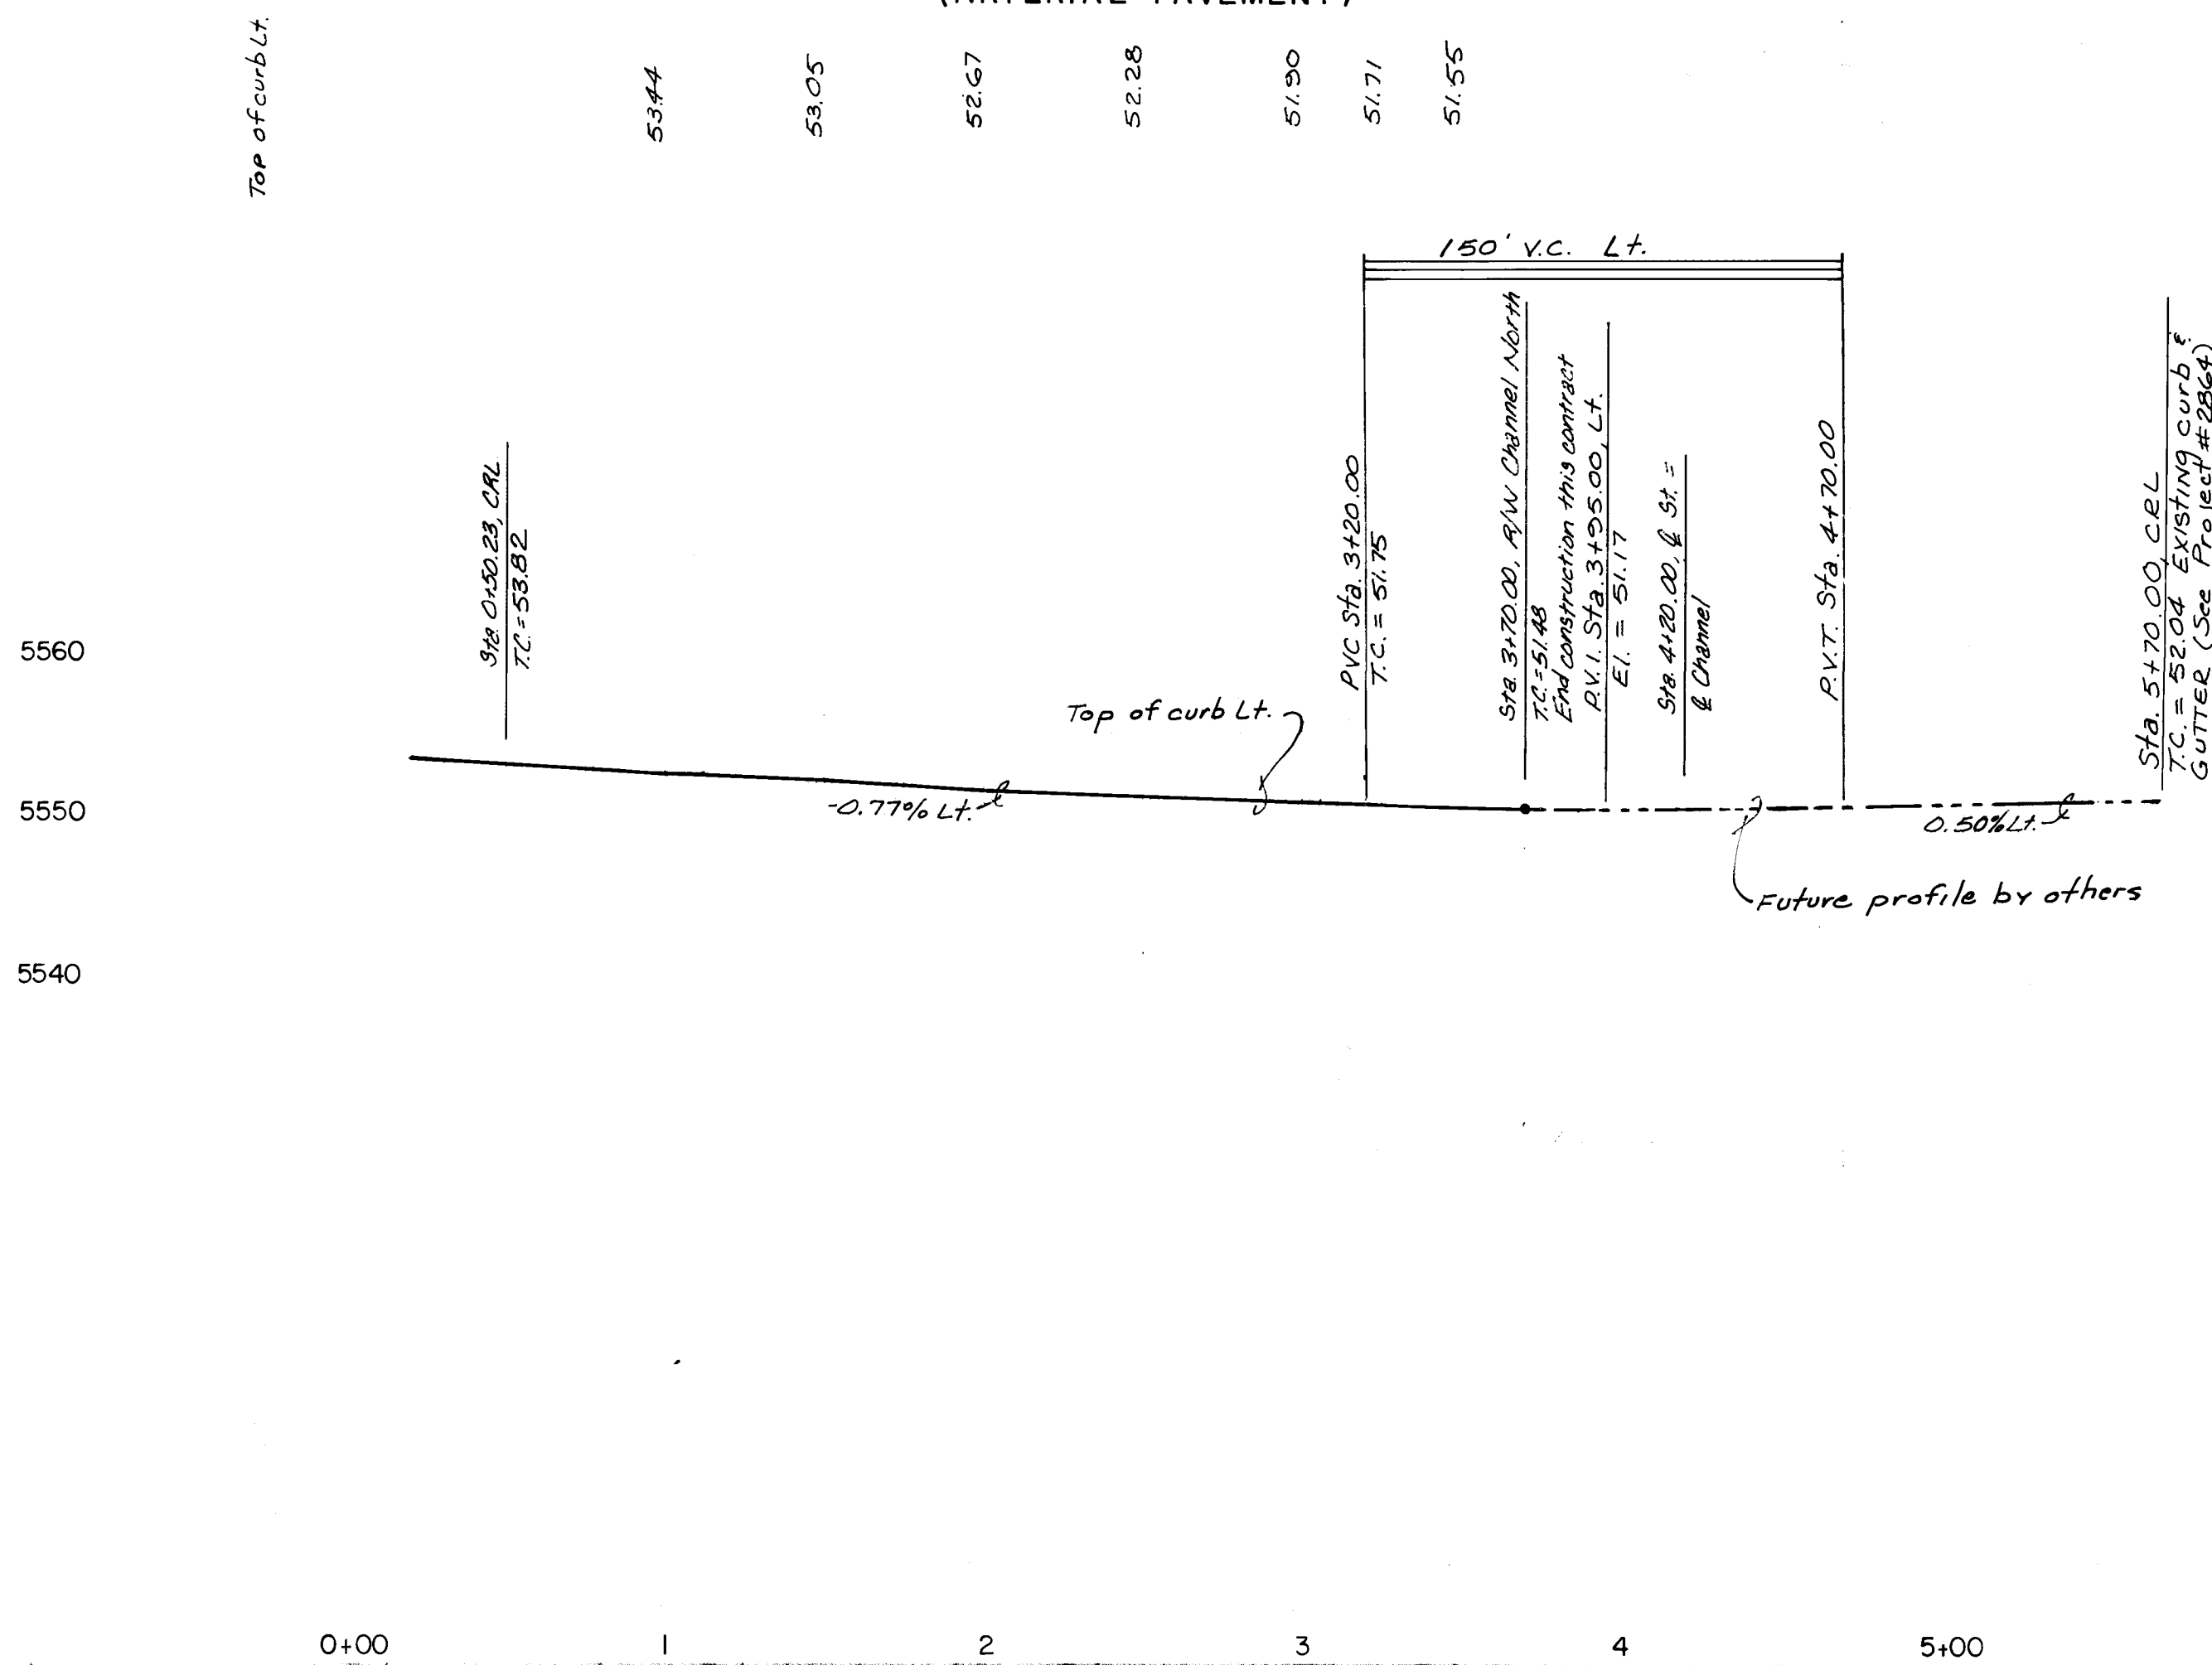

CURVE	RADIUS	ARC	DELTA
A	40.00'	24.46'	35°01'149"
B	40.00'	24.46'	114°47'31"
C	40.00'	21.66'	31°01'33"
D	40.00'	21.66'	102°06'12"
E	40.00'	23.12'	33°07'27"
F	40.00'	21.10'	30°13'30"
1	30.00'	47.23'	90°12'35"
2	25.00'	39.27'	90°00'00"
3	150.00'	42.57'	16°15'37"
4	2.39'	7.51'	180°00'00"
5	2.36'	7.41'	180°00'00"
6	2.30'	7.22'	180°00'00"
7	22.00'	12.00'	31°15'29"
8	35.00'	75.72'	123°57'10"
9	25.00'	37.64'	86°16'13"
10	25.00'	42.31'	96°57'52"
11	22.00'	29.91'	77°53'148"

A.C.S. BMASS TABLE #1-C21A" SET IN THE
TOP OF CONCRETE POST FLUSH WITH GROUND AND
LOCATED AT THE NORTHEAST CORNER OF THE
INTERSECTION OF PASO DEL NORTE (LOS
ANGELES DRIVE, N.E.) AND HOLBROOK STREET,
N.E. ELEVATION = 5634.65'

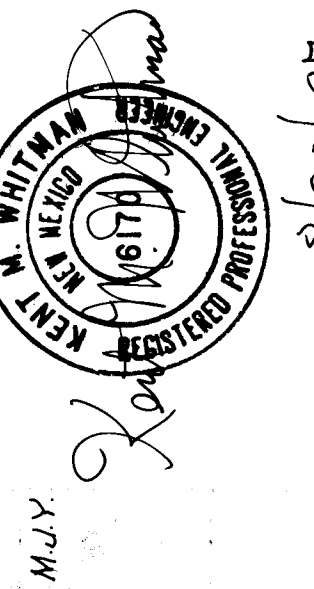


SCALE:
1" = 50' HOR.
1" = 10' VERT.



COMMUNITY
SCENARIOS
CORPORATION

RIDGEFIELD SUBDIVISION
PAVING PLAN AND PROFILE
VENTURA STREET, N.E.


HYDROLOGY	11-18-91	WATER	11-18-91
	11-12-91	WASTE WATER	11-12-91
DRAWING NO.	3464.90	MAP NO.	D-20
SHEET	8	OF	12

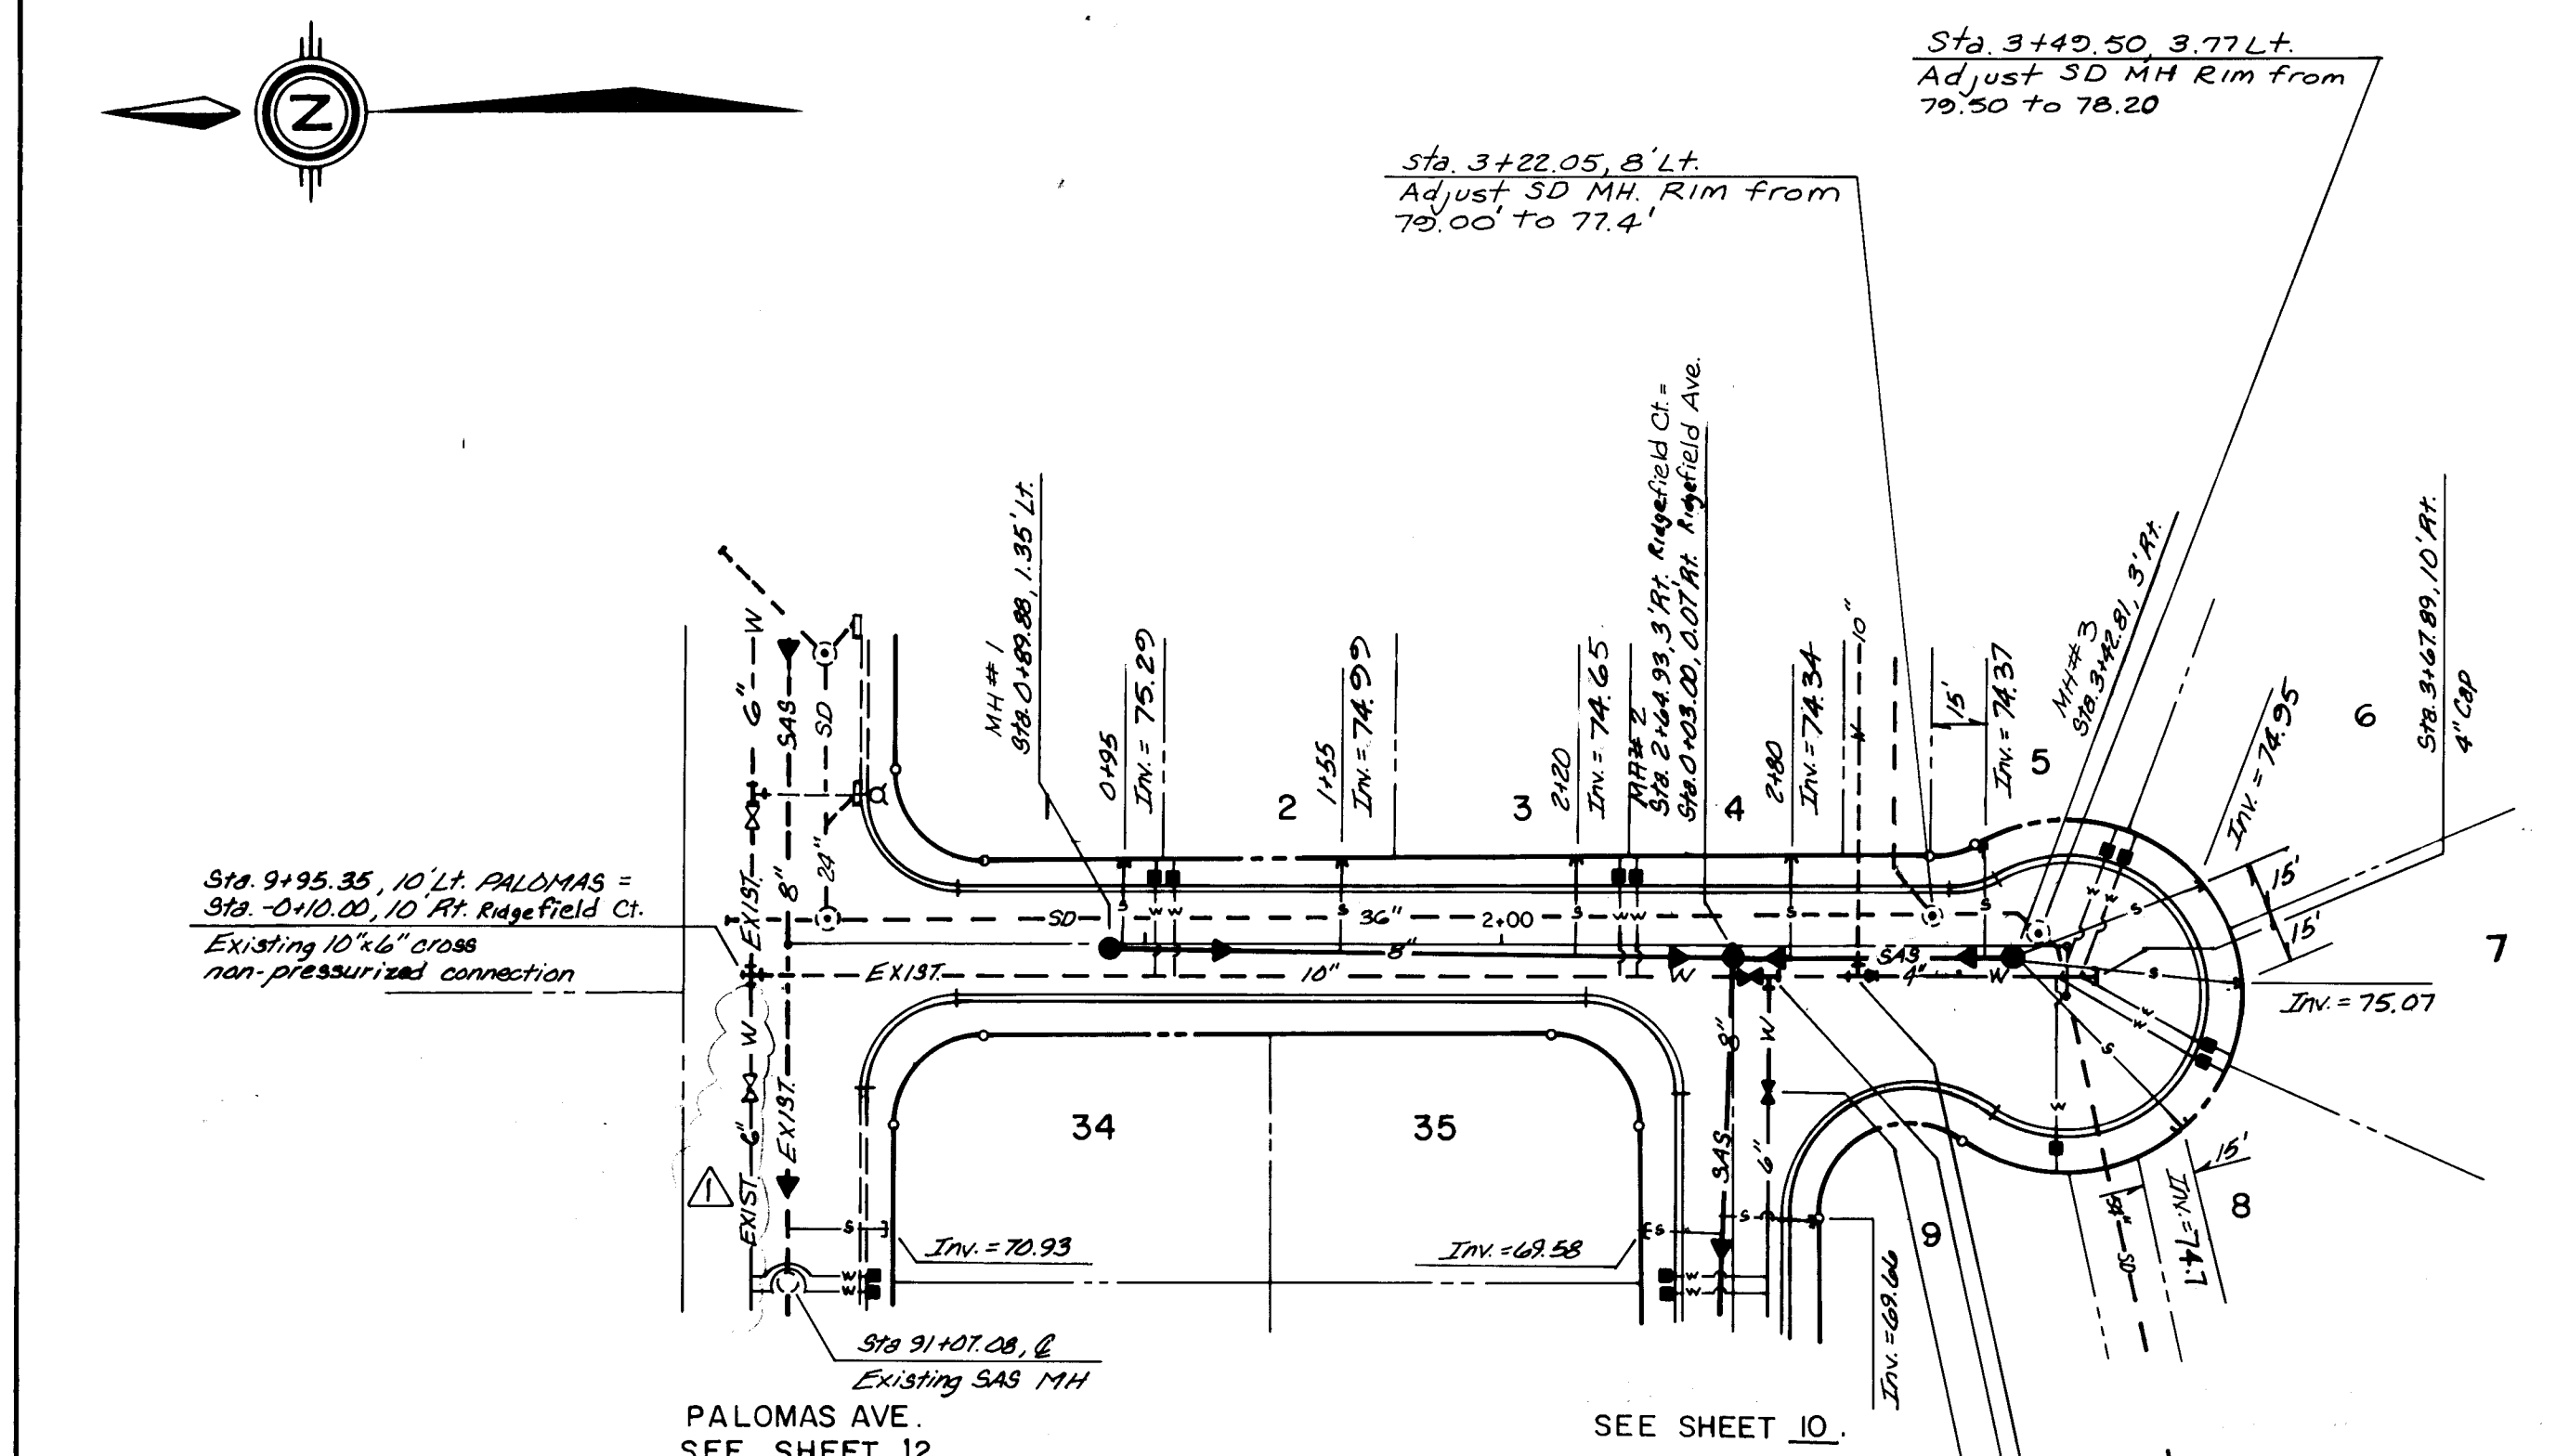

RISER DATA		
STATION	(FT.) DISTANCE A	(FT.) RISER ELEVATION
0 + 95	23	74.83
1 + 55	23	74.53
2 + 20	24	74.17
2 + 80	25	73.84
CUL-DE-SAC (LOT#5)	32	73.73
CUL-DE-SAC (LOT#6)	53	73.89
CUL-DE-SAC (LOT#7)	61	73.89
CUL-DE-SAC (LOT#8)	63	73.44

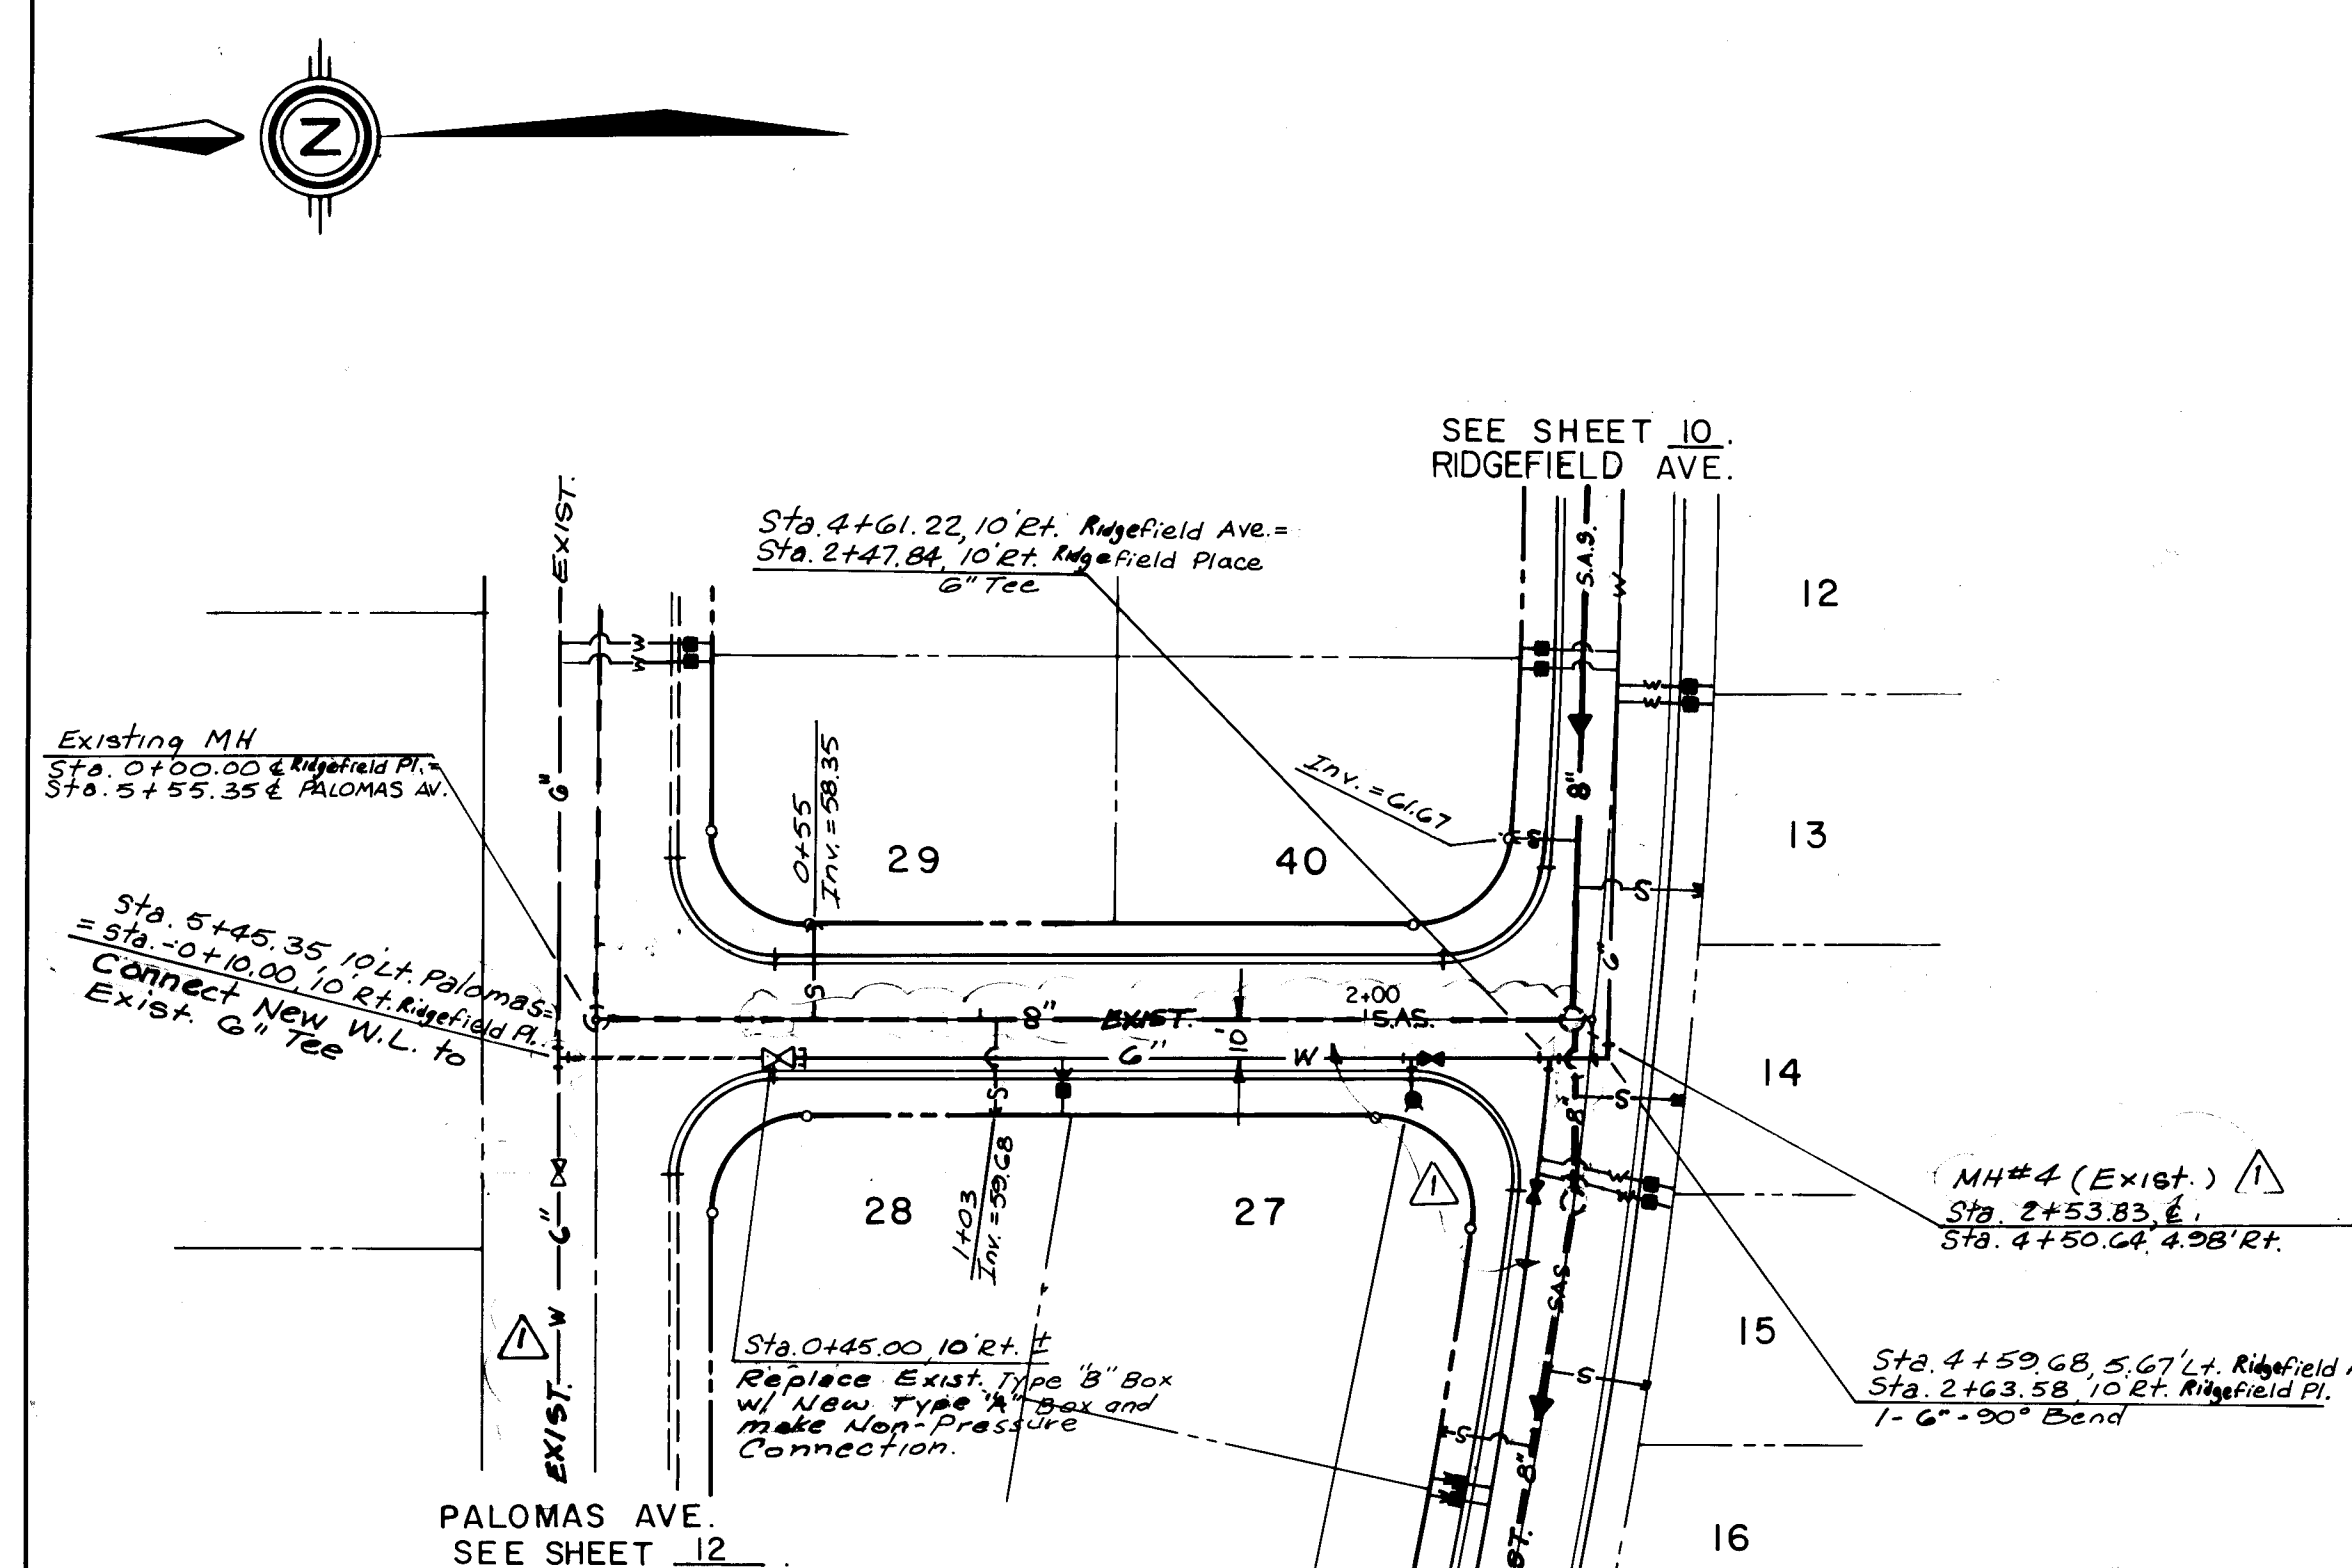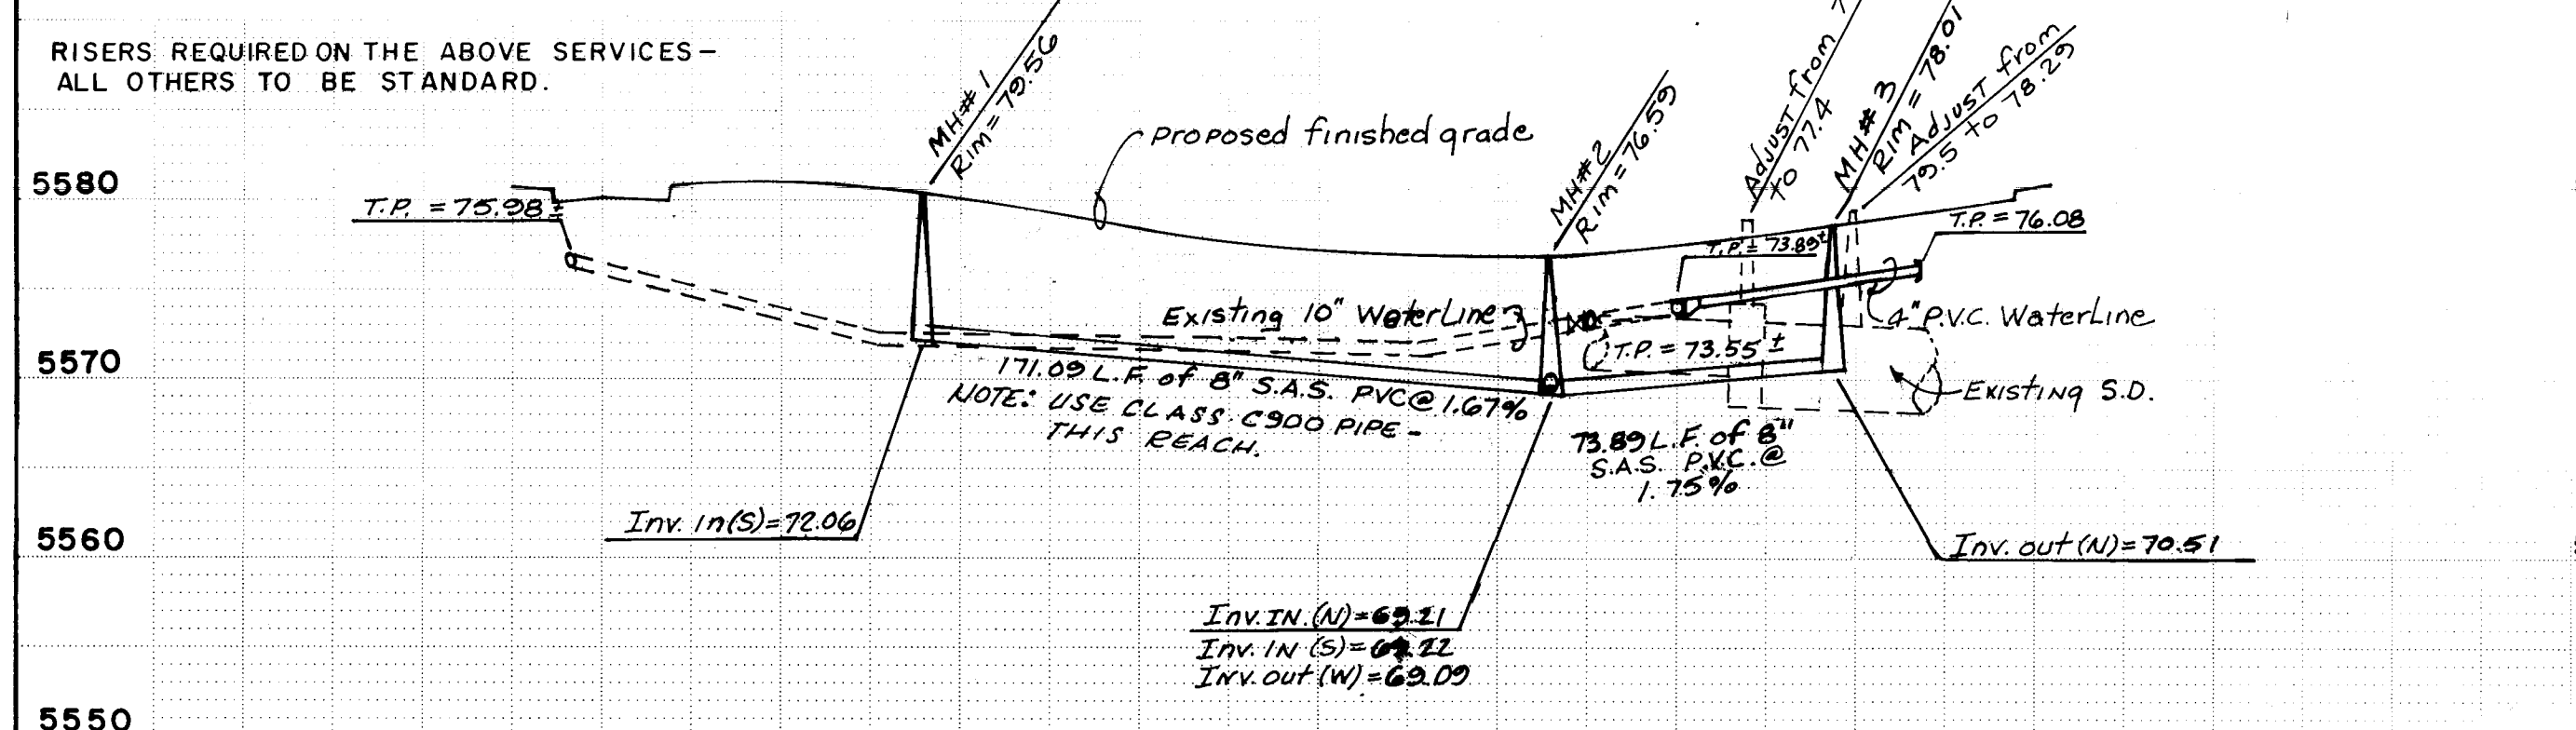

RISER DATA		
STATION	(FT.) DISTANCE A	(FT.) RISER ELEVATION
1 + 03	22	59.24

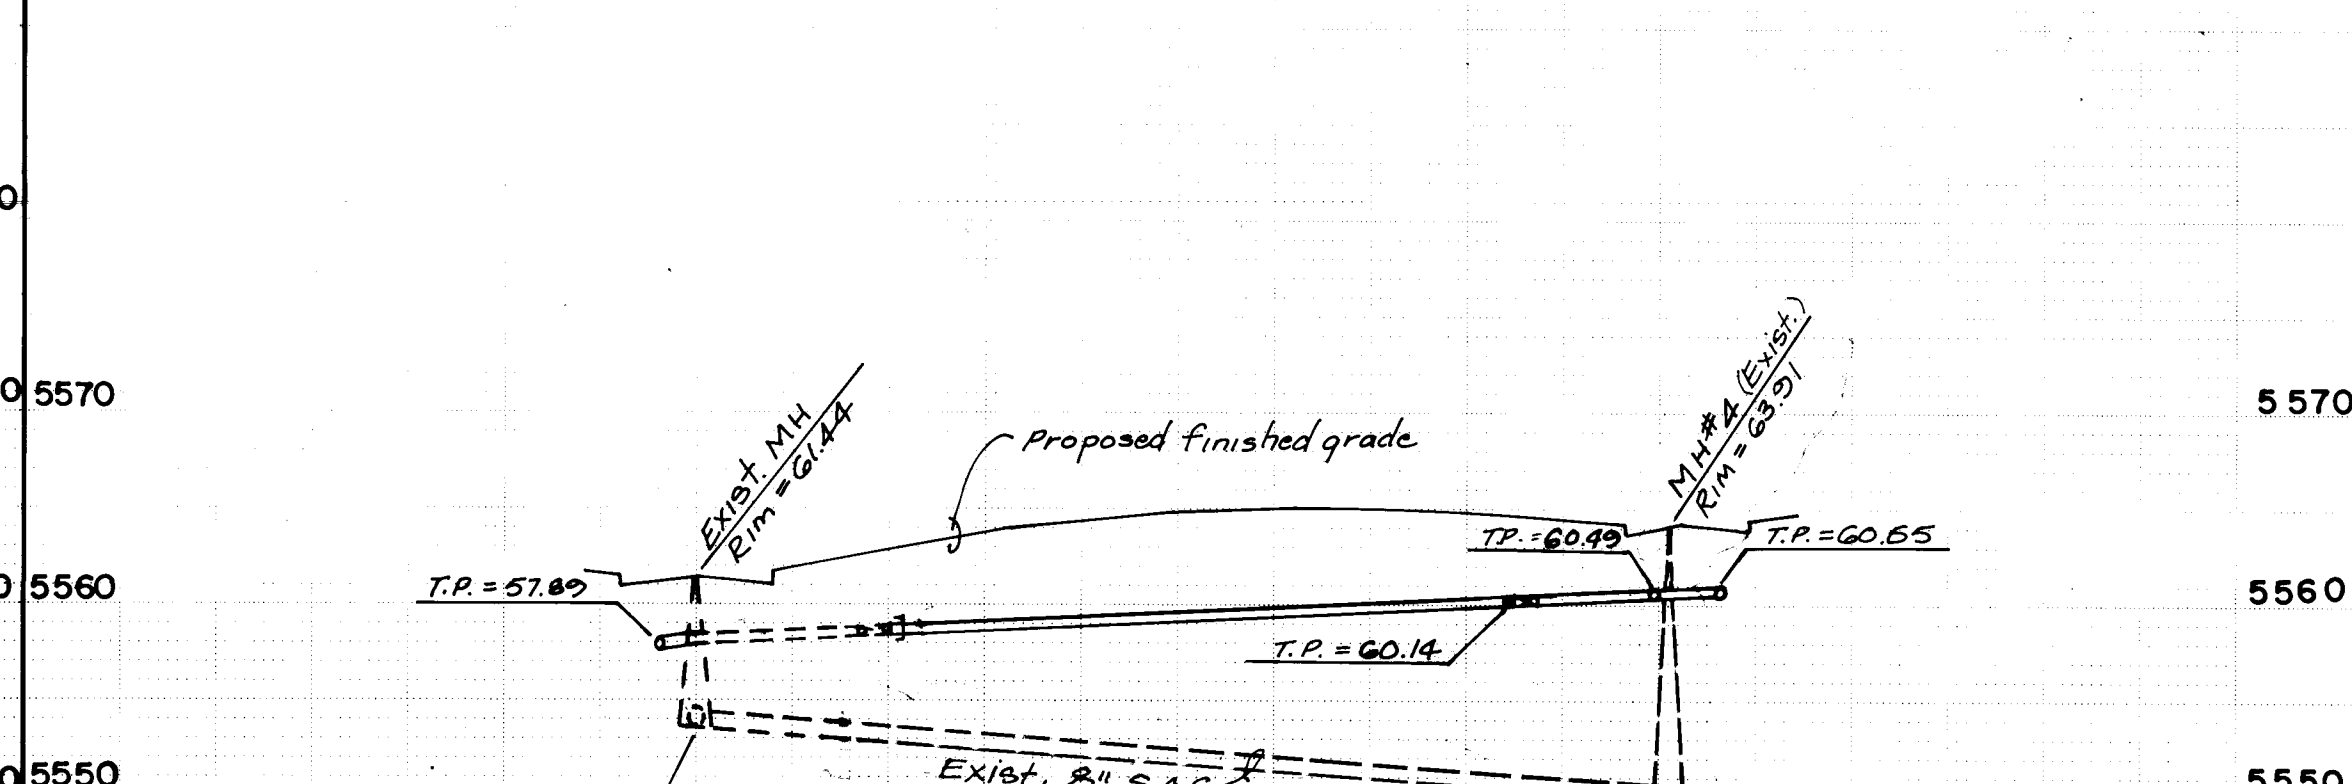

SCALE: 1"=50' HORIZ. 1"=10' VERT.

CITY OF ALBUQUERQUE
PUBLIC WORKS DEPARTMENT
ENGINEERING GROUP

TITLE: RIDGEFIELD SUBDIVISION
UTILITY PLAN & PROFILE
RIDGEFIELD COURT, N.E., RIDGEFIELD PLACE, N.E.

APPROVALS	ENGINEER	DATE	APPROVALS	ENGINEER	DATE
D.R.C. Chair	<i>[Signature]</i>	11-18-91	WATER	<i>[Signature]</i>	11-18-91
Trans. Dev.	<i>[Signature]</i>	11-18-91	WASTE WATER	<i>[Signature]</i>	"
HYDROLOGY	<i>[Signature]</i>	11-18-91			

DRAWING NO. 3464.90 MAP NO. D-20 SHEET 11 OF 12

SURVEY INFORMATION		BENCH MARKS		AS BUILT INFORMATION	
NO.	DATE	BY	FIELD NOTES	CONTRACTOR	DATE
				CONTRACTOR	DATE
				INSPECTORS	DATE
				ACCEPTANCE BY	DATE
				VERIFICATION BY	DATE
				CORRECTED BY	DATE
				MICRO-FILM INFORMATION	DATE
				RECORDED BY	NO.

ENGINEER'S SEAL

8/27/87

DESIGNED BY R.L.
DRAWN BY W.J.W.
CHECKED BY K.A.W.

REVISIONS

NO.	DATE	REMARKS
1	10-91	Update

