

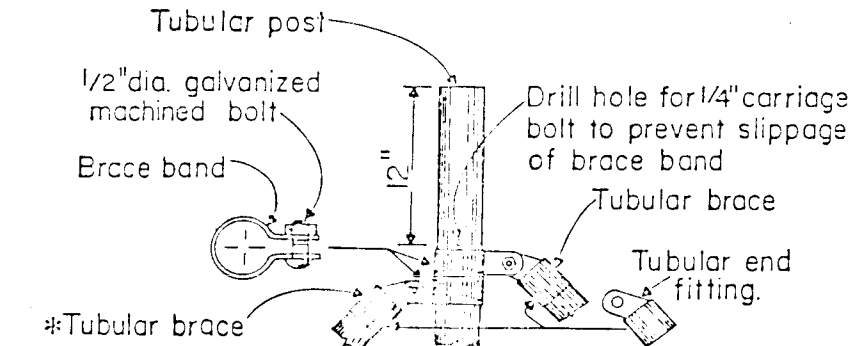
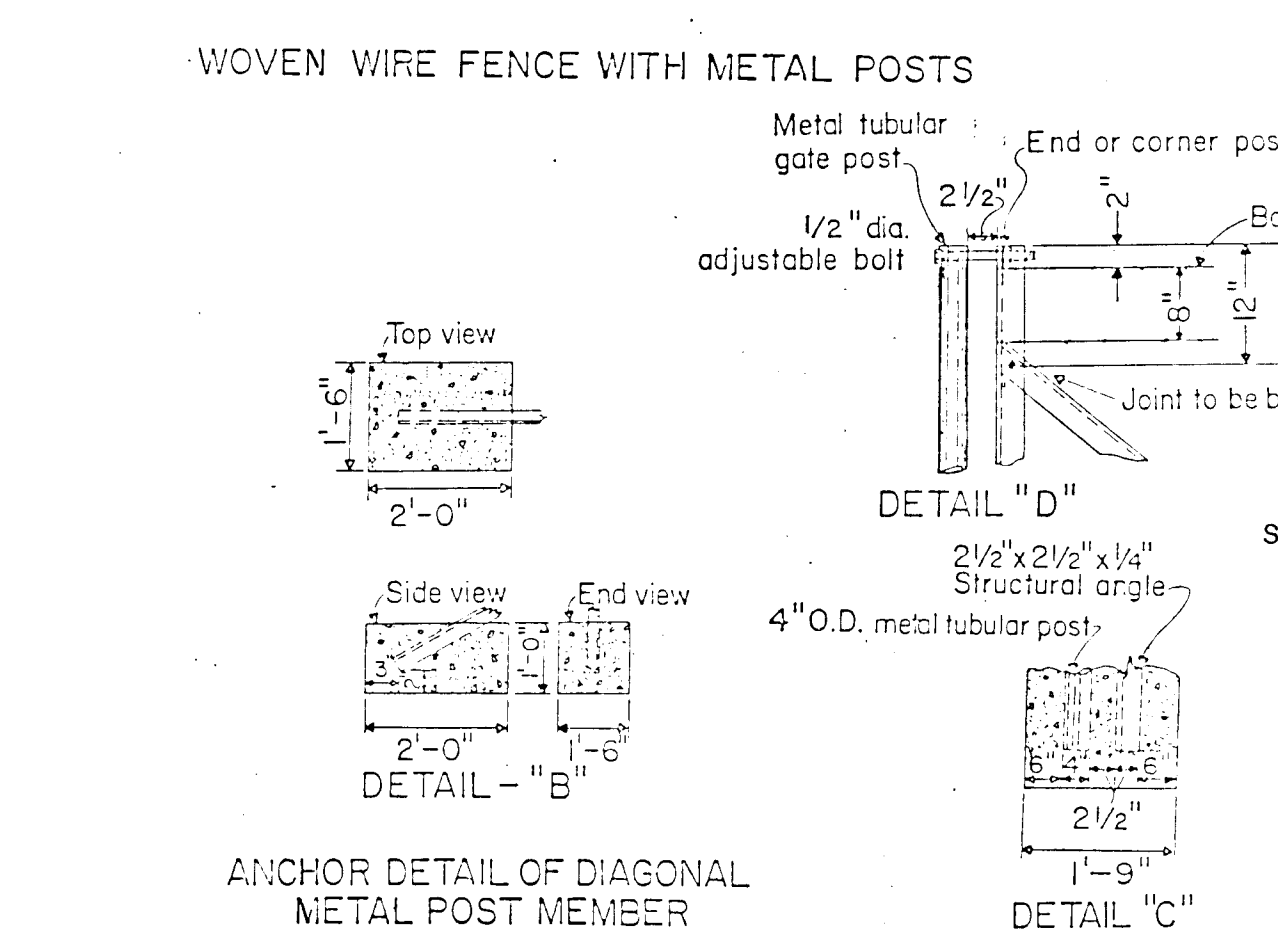
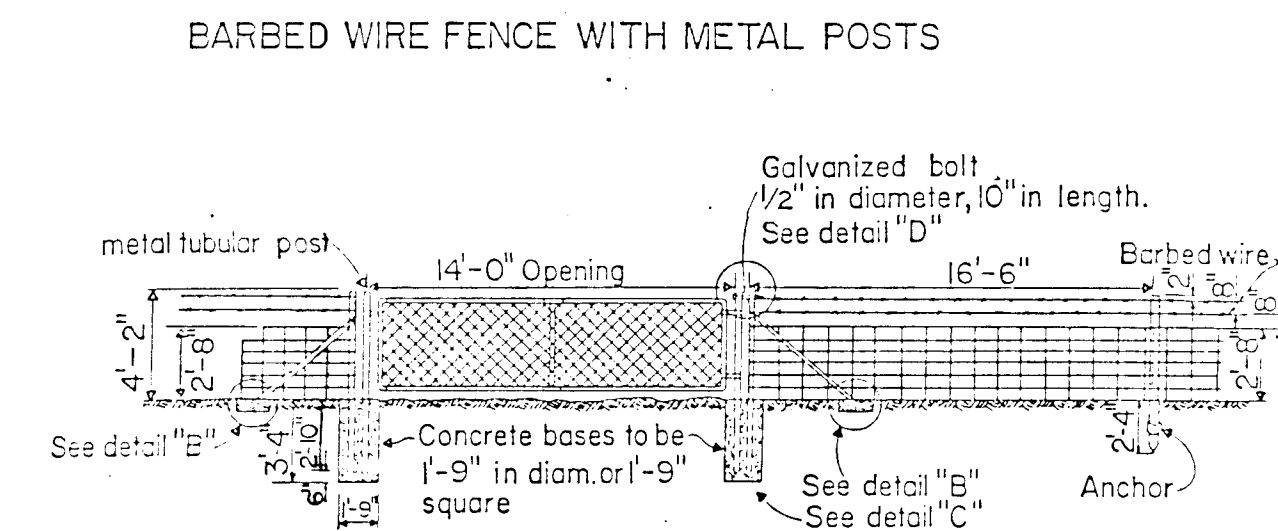
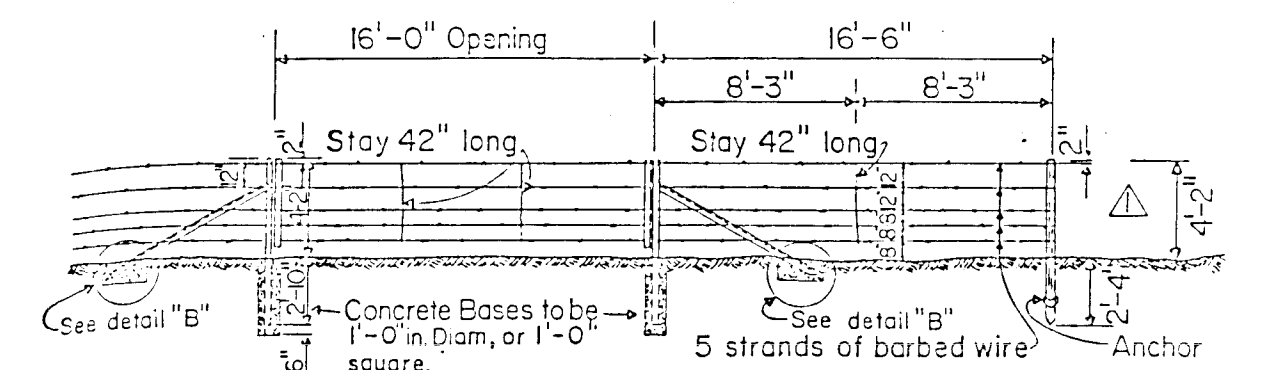
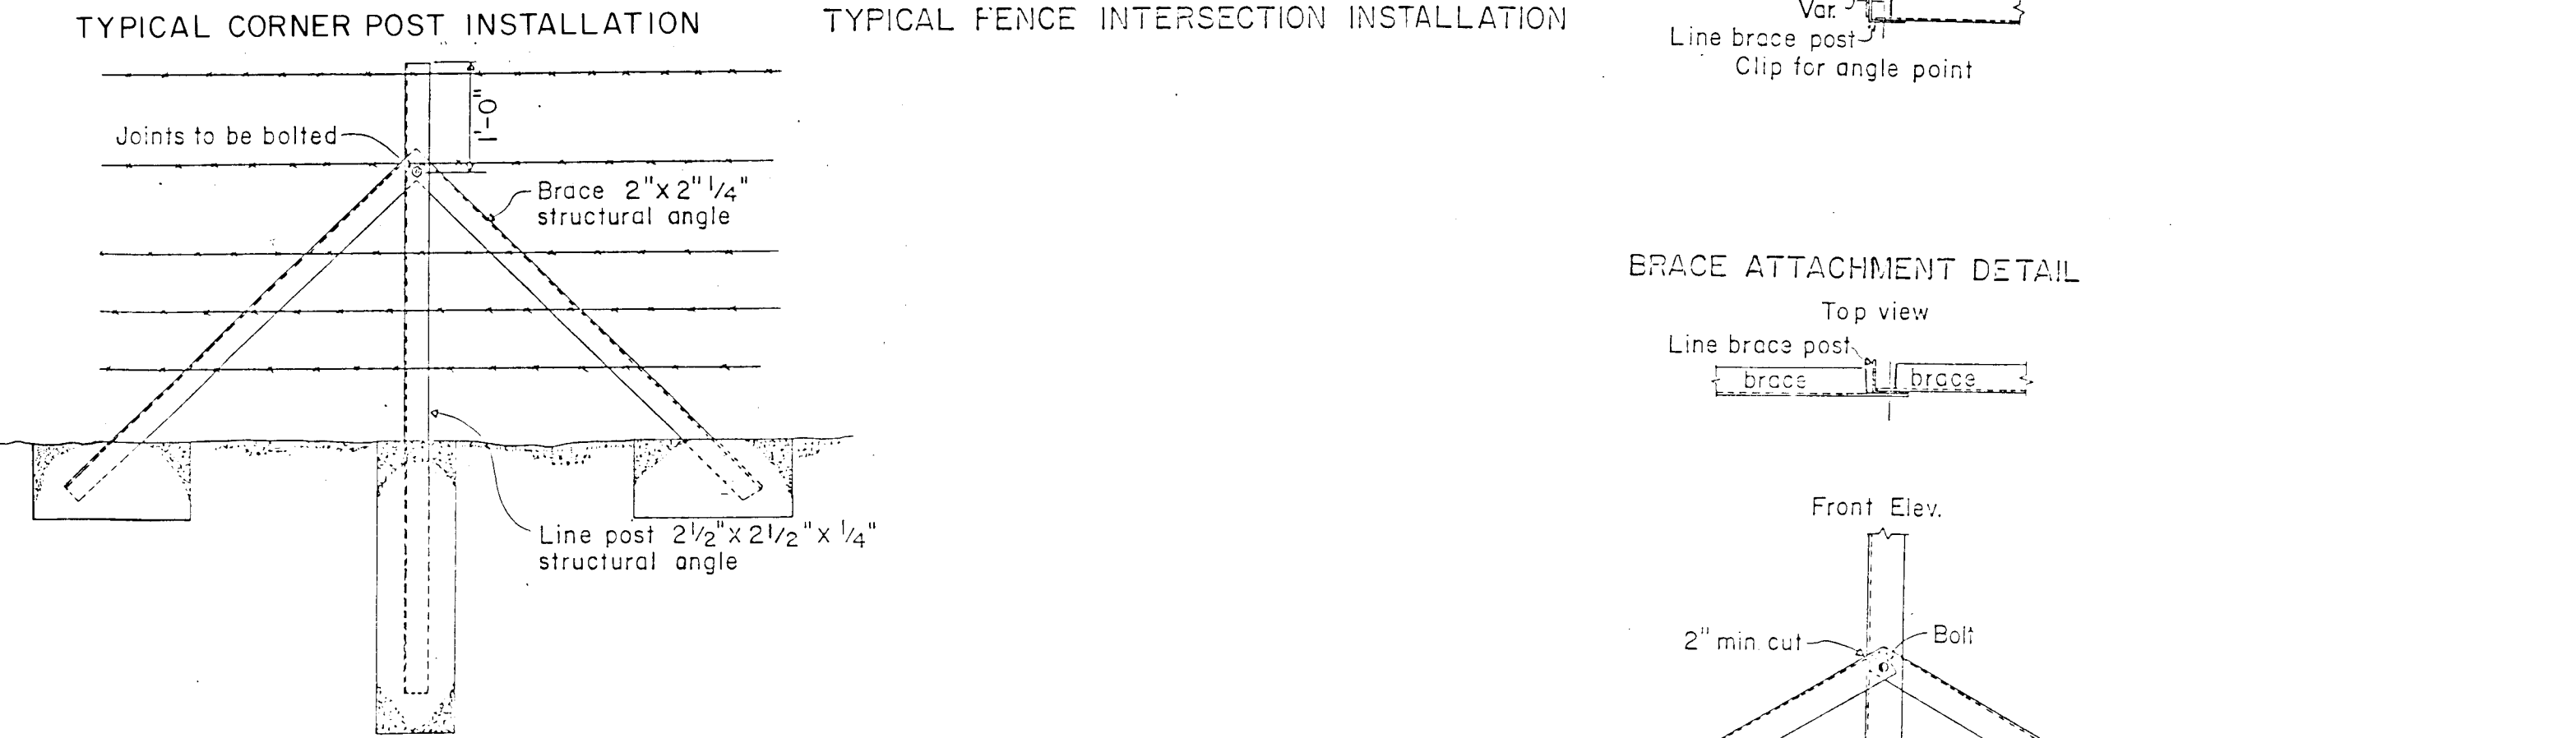
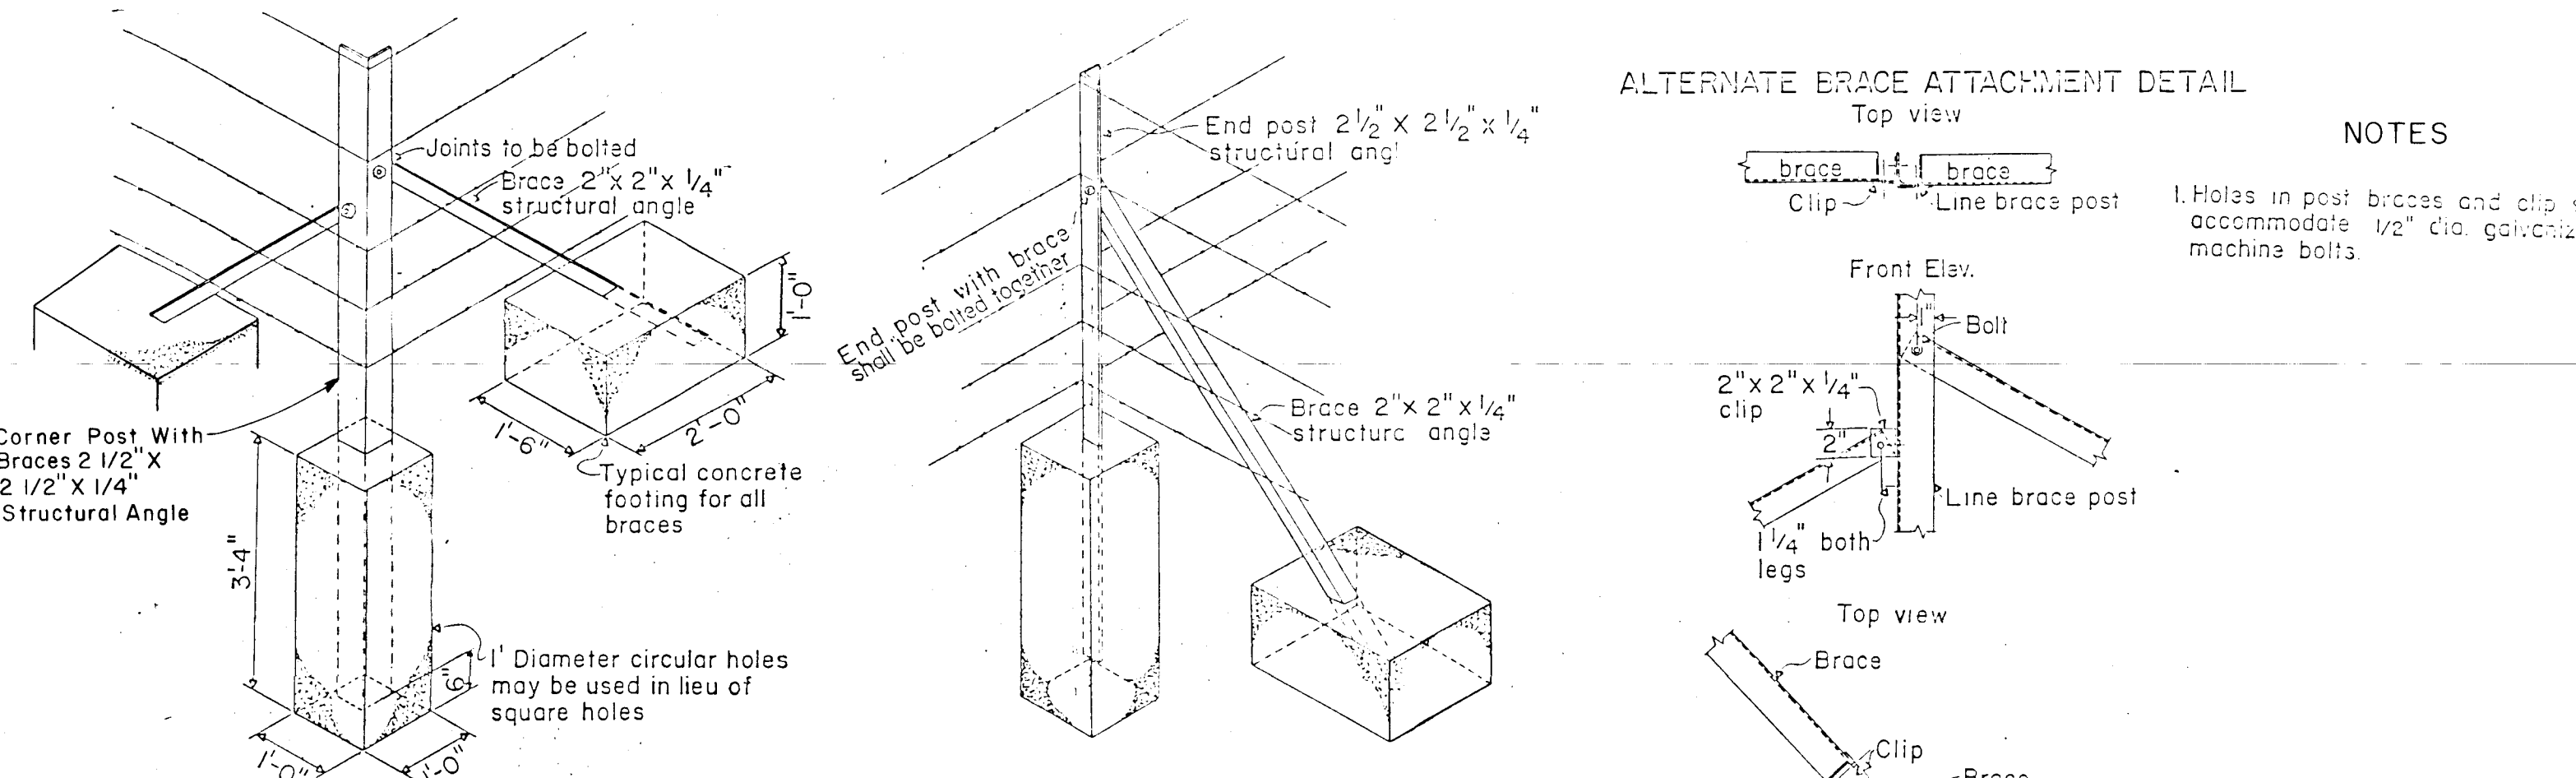
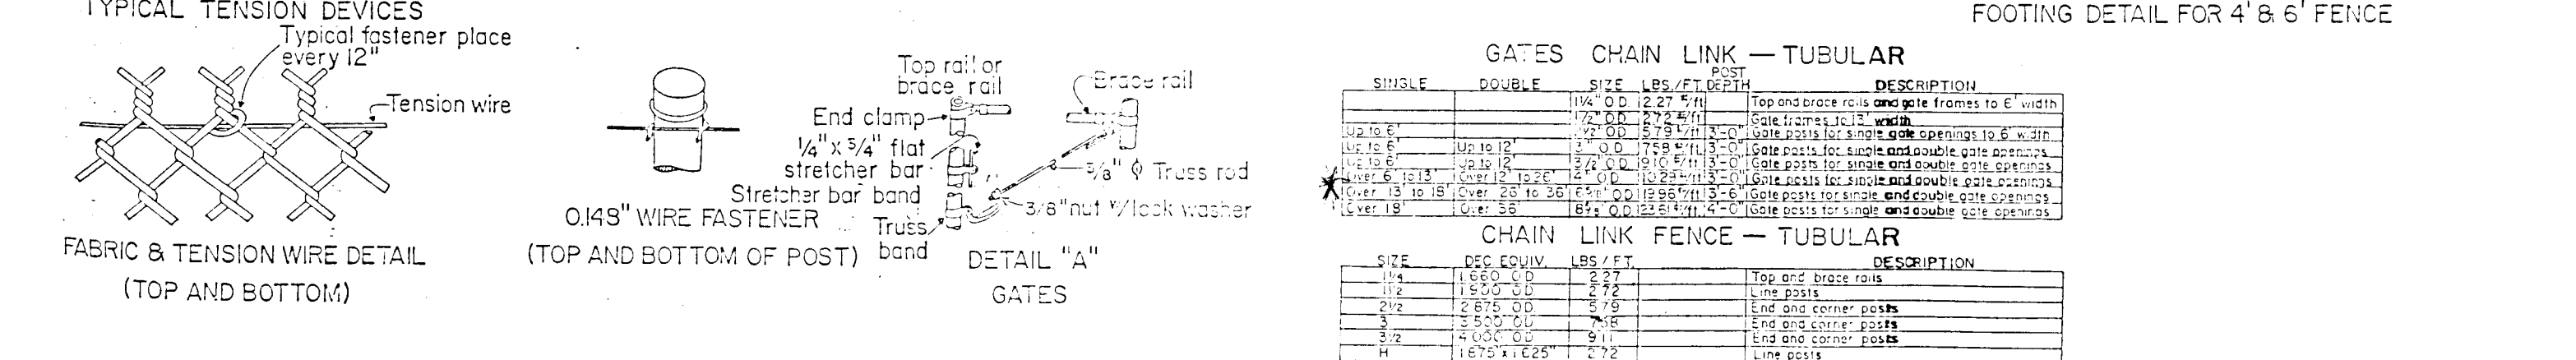
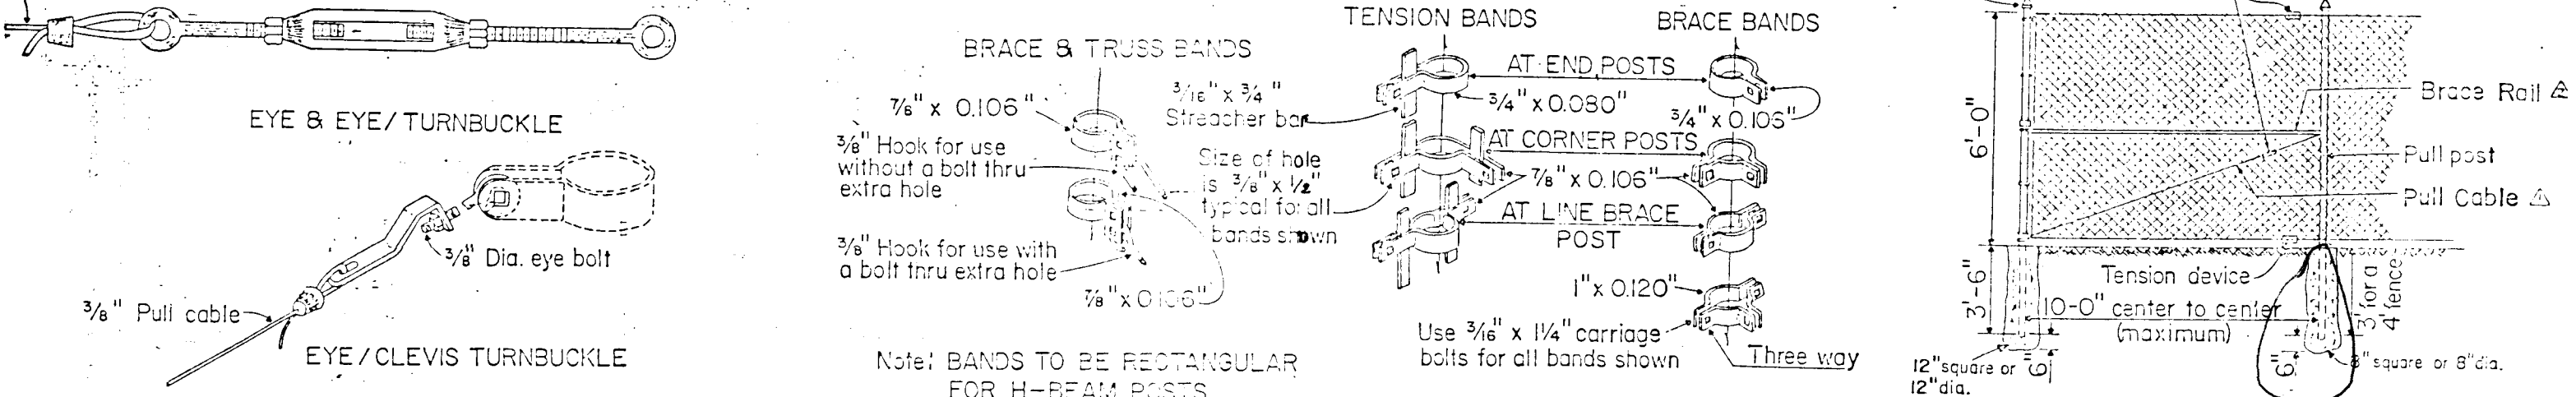
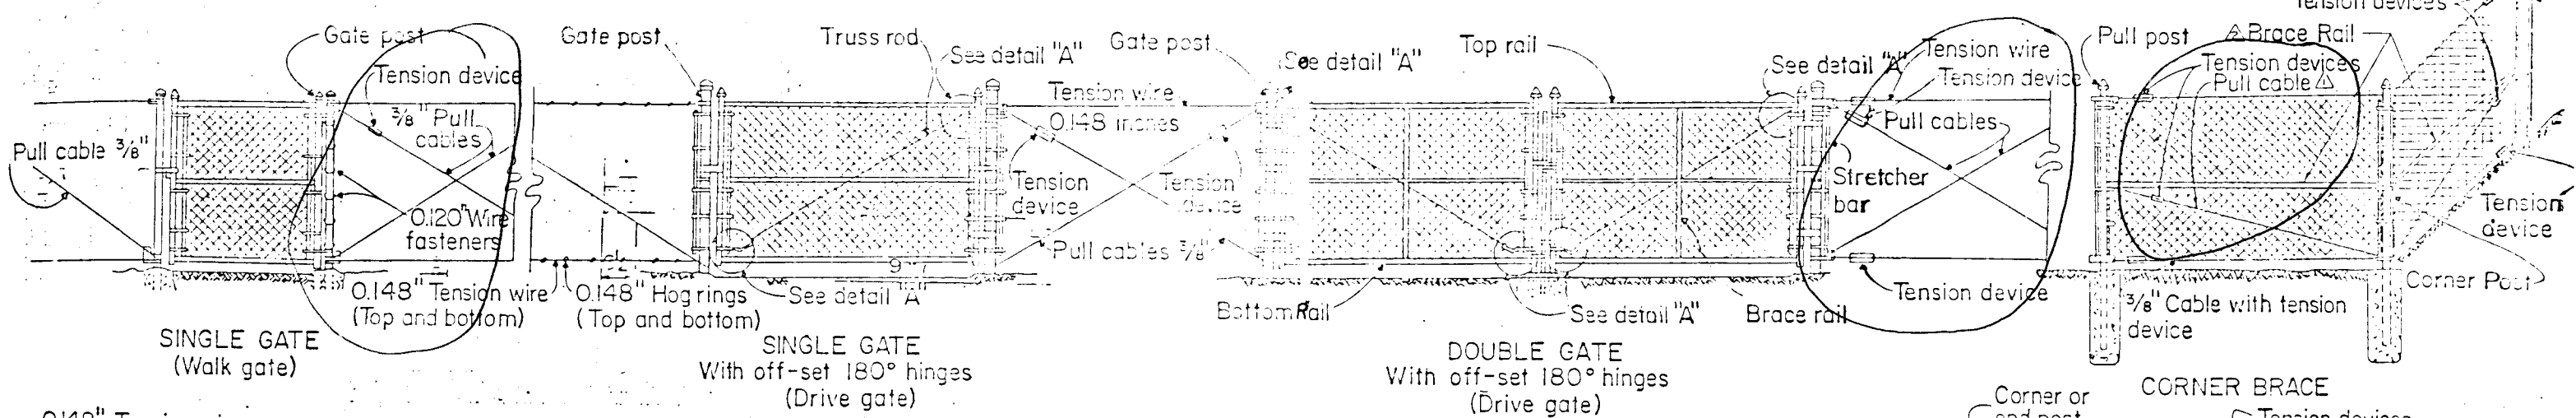
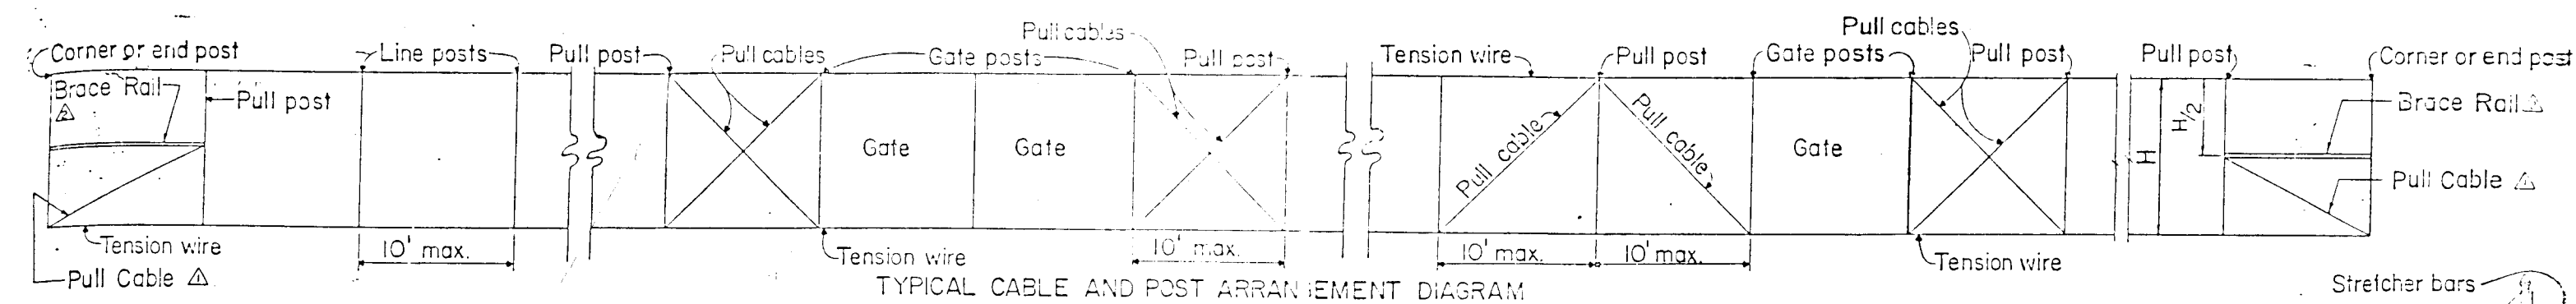


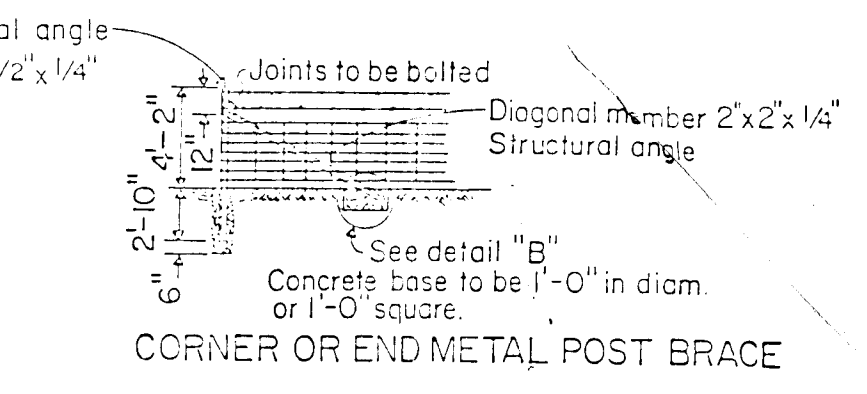

NOTES
1. Drawings apply to structural angles or tubular posts.
2. For tubular post dimensions see table for metal tubular posts.

TABLE FOR METAL TUBULAR POSTS

TYPE	OD. inches	Wt. lbs./lin. ft.
Brace Posts	1.66"	2.27
Intermediate Posts	2.875"	5.79
Corner Posts	4.00"	9.11
Gate Posts, up to 18 feet	4.00"	9.11

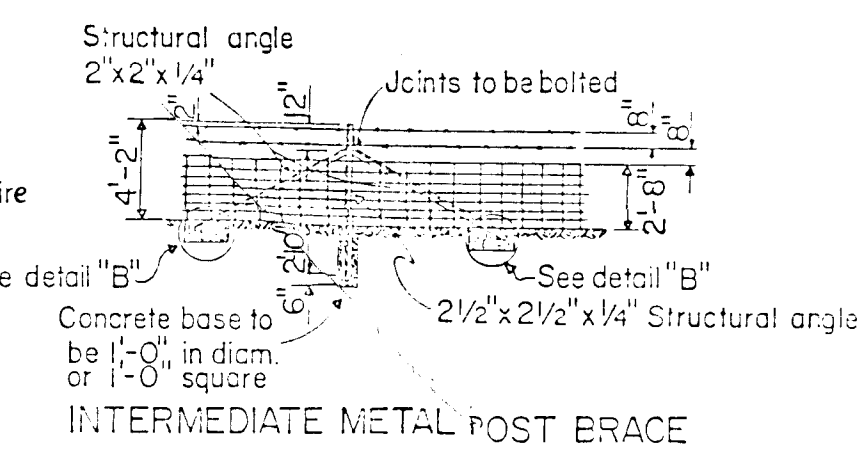

NOTES
1. Holes in post braces and clip shall accommodate 1/2" dia. galvanized machine bolts.

5. Details adapted from the New Mexico State Highway Dept.

* 2-16' CHAIN LINK GATES INSTALLED (STANDARD)
** 1-16' CHAIN LINK GATE INSTALLED (NEW)

WATER DRAINAGE

26 34846391

CITY OF ALBUQUERQUE

ACCESS ROAD
DURANES WELL NO. 7

ENGINEER DATE APPROVALS ENGINEER DATE

Liquid Waste
Traffic
Water

DESIGNED BY
DRAWN BY
CHECKED BY

NO. DATE

REVISIONS

BY

DATE

DATE

DATE

3484

SHEET 3 OF