



SAS SERVICES SCHEDULE				
BLK.	LOT	ST. STA.	LEN. REQ'D.	INV. @ E
5	37-A	7 + 19.00	25.00'	5899.68 .74
5	38-A	7 + 87.00	25.00'	5903.08
5	39-A	8 + 55.00	25.00'	5906.48 .51
5	40-A	9 + 22.00	25.00'	5909.87 .75
5	41-A	9 + 83.00	25.00'	5912.04 .18
5	42-A	10 + 22.00	25.00'	5913.23 .20
5	43-A	10 + 85.00	25.00'	5915.32 .42
5	44-A	11 + 50.00	25.00'	5917.42 .52
13	31	9 + 97.00	25.00'	5912.49 .55
13	32	10 + 50.00	25.00'	5914.20 .21
13	33	11 + 18.00	25.00'	5916.34 .50
13	34	11 + 86.00	25.00'	5918.58 .69
13	35	12 + 54.00	25.00'	5920.90
14	23-A	12 + 82.00	25.00'	5921.80

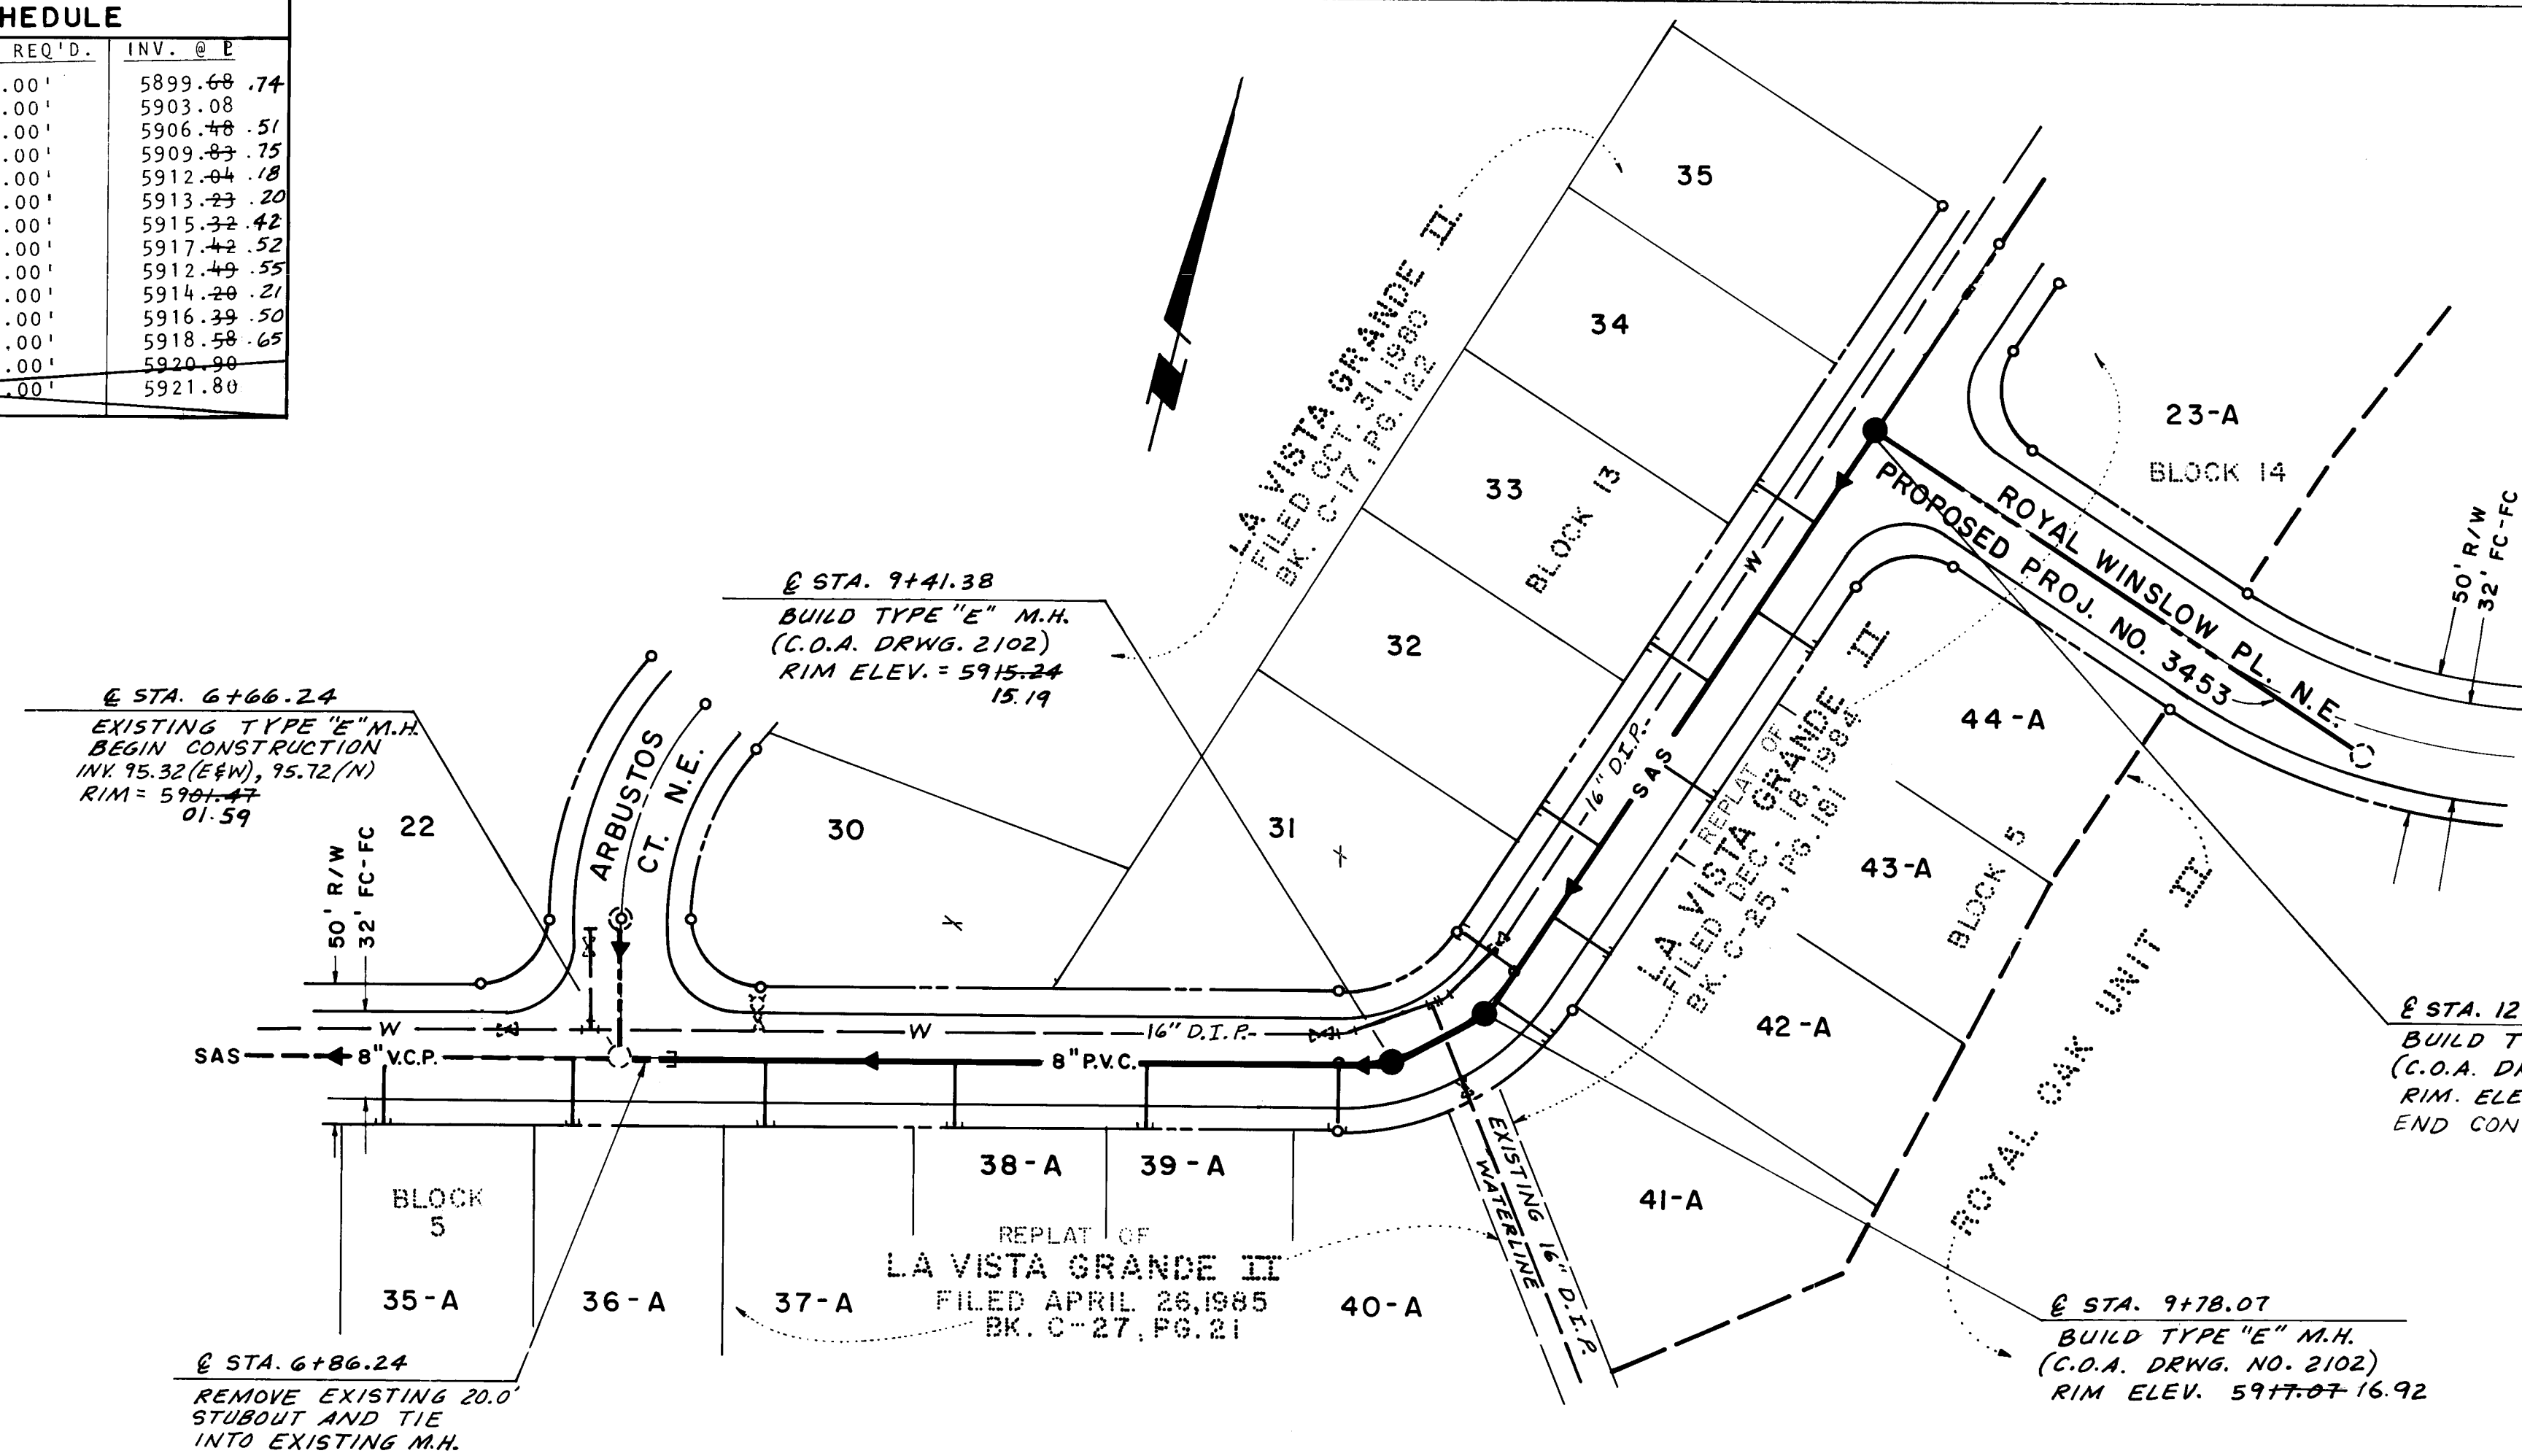

CAMINO ARBUSTOS N.E.

HORIZONTAL SCALE: 1" = 50'
VERTICAL SCALE: 1" = 05'

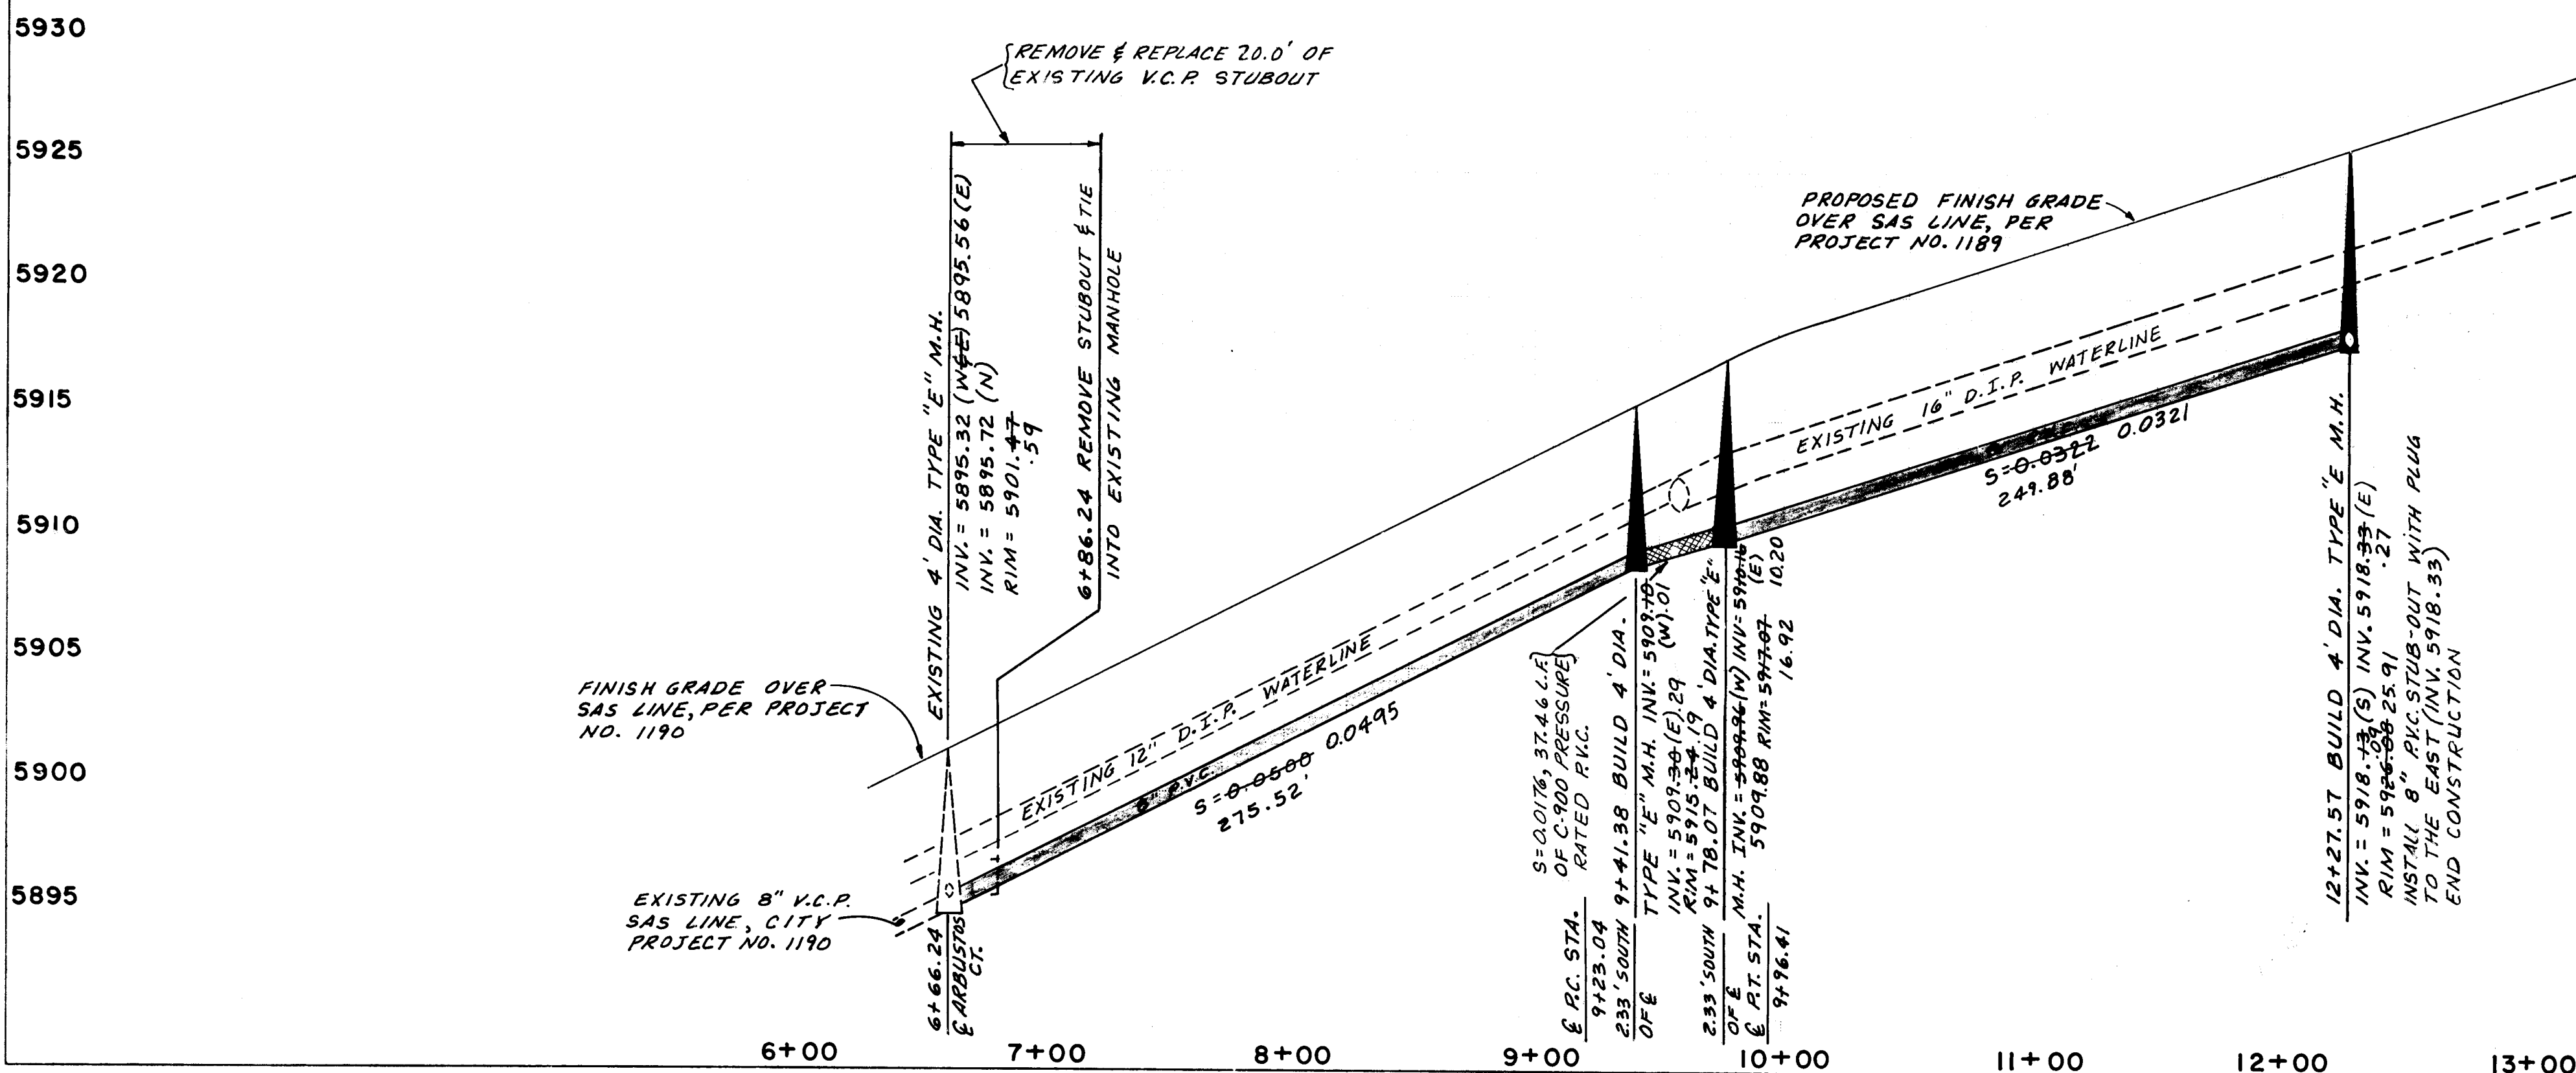

RECORD DRAWING

This drawing as modified shows public improvements as constructed. These modifications have been made using information and measurements obtained by field survey crews, the contractor, inspection, and inspection reports performed by A & E Engineering Inc. The modifications conform to the minimum requirements of Albuquerque per Development Process Manual Section 27.4 to the best of my knowledge and belief.


Carlos F. Salazar, III P.E. 6553 9/9/88 Date



APPROVAL OF AS BUILT DRAWINGS
CHIEF CONSTRUCTION ENGINEER
DATE 10-4-88

APPROVED FOR
CONSTRUCTION
DATE 10-4-88

BASE LINE DATA
BASE LINE IS BASED ON THE CENTER LINE OF CAMINO ARBUSTOS N.E.
BEGINNING OF PROFILE STATION 6+66.24 TIE TO A.C.S. MONUMENT "HARRY", (S 47°33'58" W, 1,353.59').
E STA. 6+66.24-- E STA. 9+41.83 = (N 75°59'53" E, 275.52')
E STA. 9+41.83-- E STA. 9+78.07 = (N 47°40'15" E, 37.46')
E STA. 9+78.07-- E STA. 12+27.57 = (N 19°20'36" E, 249.88')
E STA. 12+27.57-- E STA. 12+87.00 = (N 19°20'36" E, 59.43')
-END STATIONING-

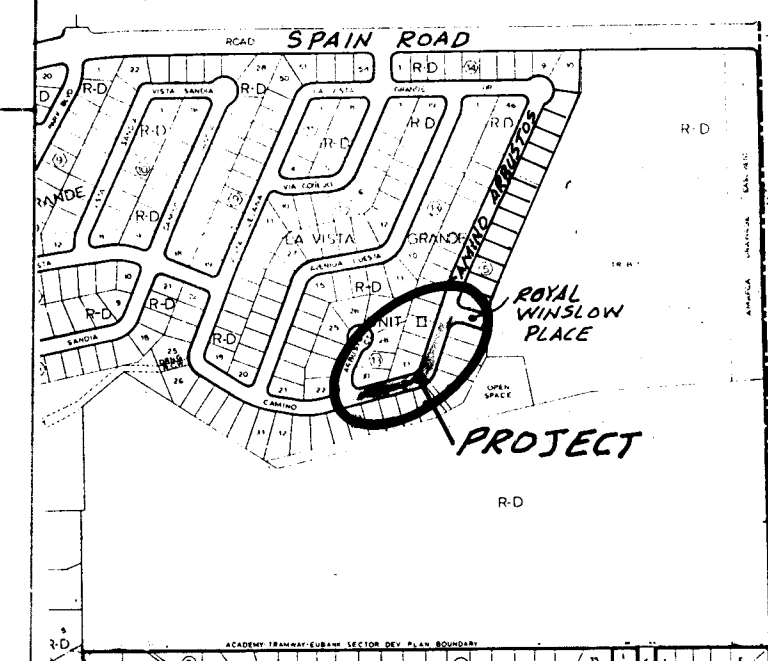

VICINITY MAP F-22 SCALE: 1" = 800'

NOTICE TO CONTRACTORS:


- CITY OF ALBUQUERQUE STANDARD SPECIFICATIONS FOR PUBLIC WORKS CONSTRUCTION 1986 EDITION WILL BE REFERRED TO HEREIN AS THE STANDARD SPECIFICATIONS.
- ALL WORK DETAILED ON THESE PLANS TO BE PERFORMED UNDER CONTRACT SHALL, EXCEPT AS OTHERWISE STATED OR PROVIDED FOR HEREON, BE CONSTRUCTED IN ACCORDANCE WITH PUBLIC WORKS CONTRACT NO. 1985
- TWO WORKING DAYS PRIOR TO ANY EXCAVATION CONTRACTOR MUST CONTACT LINE LOCATION SERVICE, 765-1234, FOR LOCATION OF EXISTING UTILITIES.
- PRIOR TO CONSTRUCTION, THE CONTRACTOR SHALL EXCAVATE AND VERIFY THE HORIZONTAL AND VERTICAL LOCATION OF ALL OBSTRUCTIONS SHOULD A CONFLICT EXIST, THE CONTRACTOR SHALL NOTIFY THE ENGINEER OR SURVEYOR SO THAT THE CONFLICT CAN BE RESOLVED WITH MINIMUM DELAY.

GENERAL NOTES:

- SANITARY SEWER LINE TO BE 8" P.V.C., AND MEET THE REQUIREMENTS OF ASTM D 3034. MINIMUM WALL CLASSIFICATIONS SHALL BE SDR 26, AS REQUIRED. ONLY SOLID WALL PIPE WILL BE ACCEPTABLE.
- SANITARY SEWER LINE LATERALS SHALL BE DUCTILE IRON PIPE (SERVICE WEIGHT).
- MANHOLES TO BE TYPE "E", UNLESS OTHERWISE INDICATED.
- INFORMATION ON EXISTING LINES, WATER AND SAS, WERE TAKEN FROM CITY DRAWINGS NO. 1189 AND 1190.
- SANITARY SEWER LINES AND SAS LATERALS ARE THE ONLY IMPROVEMENTS TO BE CONSTRUCTED PER THESE DRAWINGS. STREET, CURB & GUTTER, SIDEWALK, HANDI-CAP RAMPS AND WATER SERVICES ARE NOT A PART OF THIS CONTRACT.
- HANDI-CAP RAMPS AT THE INTERSECTION OF CAMINO ARBUSTOS AND ROYAL WINSLOW PLACE TO BE BUILT PER CITY DRAWINGS NO. 3453.
- BACKFILL COMPACTION SHALL BE ACCORDING TO RESIDENTIAL STREET USE.

LEGEND

- W - EXISTING WATERLINE
- F - EXISTING FIRE HYDRANT
- V - EXISTING VALVE
- M - EXISTING MANHOLE
- SAS - BUILD MANHOLE
- SAS - BUILD SAS LINE
- NEW SAS SERVICES

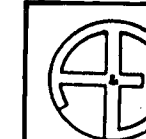

A & E ENGINEERING INC.
CIVIL ENGINEERING, PLANNING AND SURVEYING
ALBUQUERQUE - NEW MEXICO
1330 SAN PEDRO N.E. - SUITE 208
ALBUQUERQUE, NEW MEXICO 87110 (505) 266-8791

CITY OF ALBUQUERQUE
PUBLIC WORKS DEPARTMENT
ENGINEERING GROUP

TITLE LA VISTA GRANDE UNIT II
SANITARY SEWER LINE EXTENSION
CAMINO ARBUSTOS N.E.

APPROVAL	ENGINEER	DATE	APPROVAL	ENGINEER	DATE
APPROVED FOR CONSTRUCTION	DATE 03/10/88		APPROVED FOR CONSTRUCTION	DATE 03/10/88	
TRANS. DIV.	DATE 03/10/88		TRANS. DIV.	DATE 03/10/88	
UTILITY DIV.	DATE 03/10/88		UTILITY DIV.	DATE 03/10/88	

DRAWING NO. 3487 MAP NO. F-22 SHEET 1 OF 1