
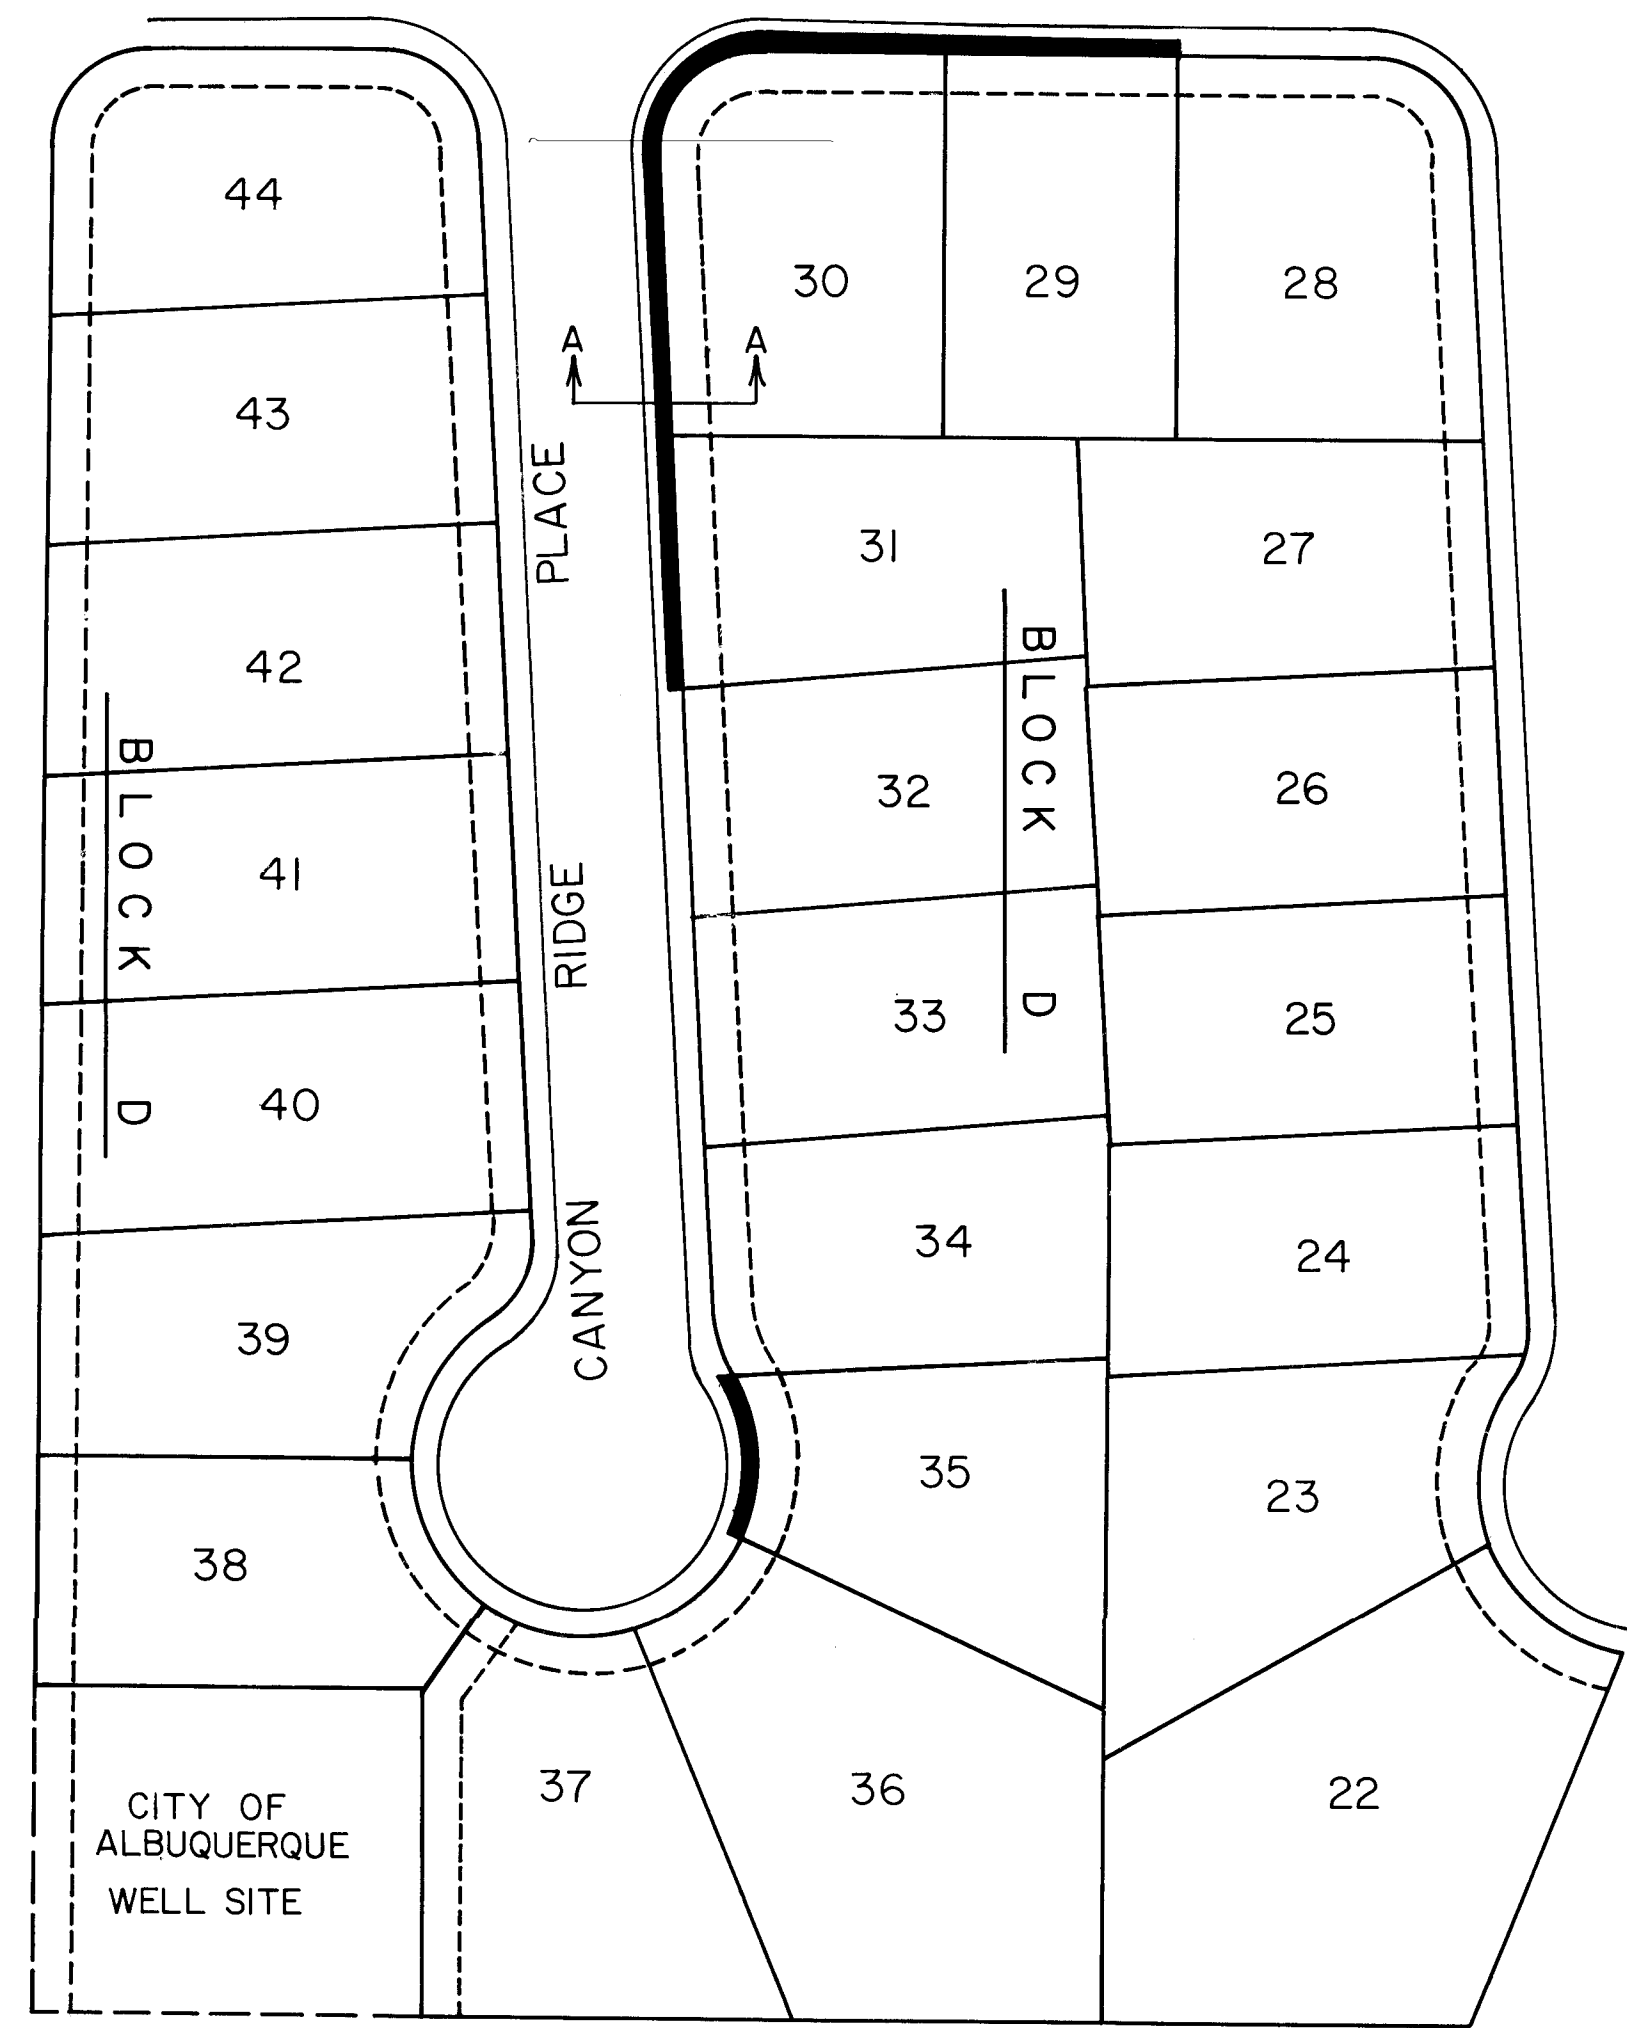


TO ACADEMY BLVD. —



N. E.

STREET

MOON

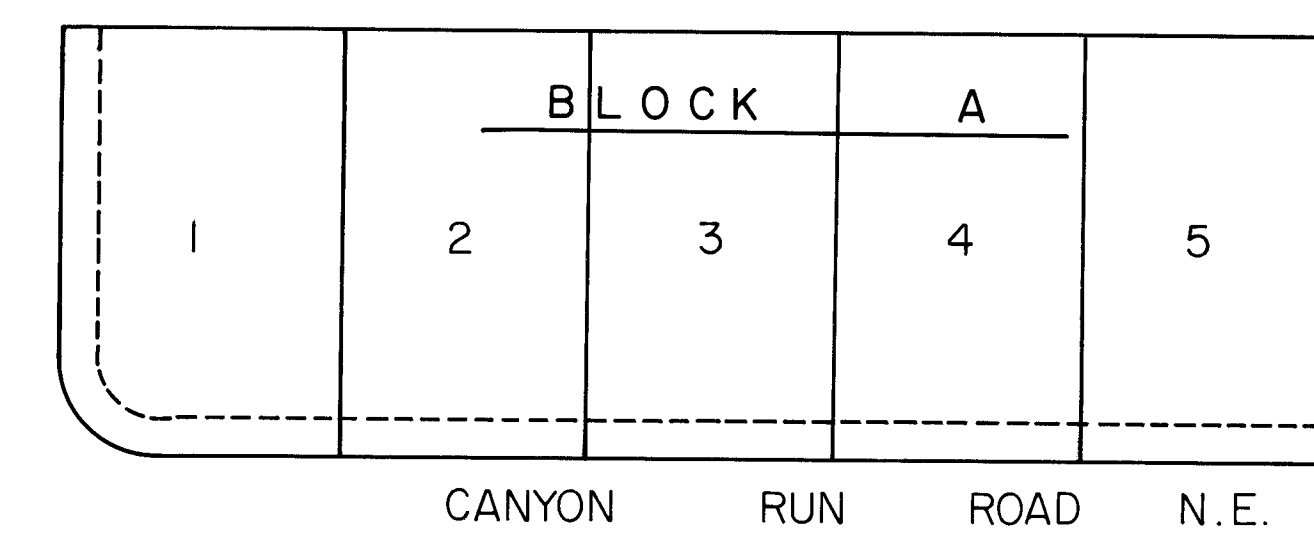

CANYON RUN SUBDIVISION

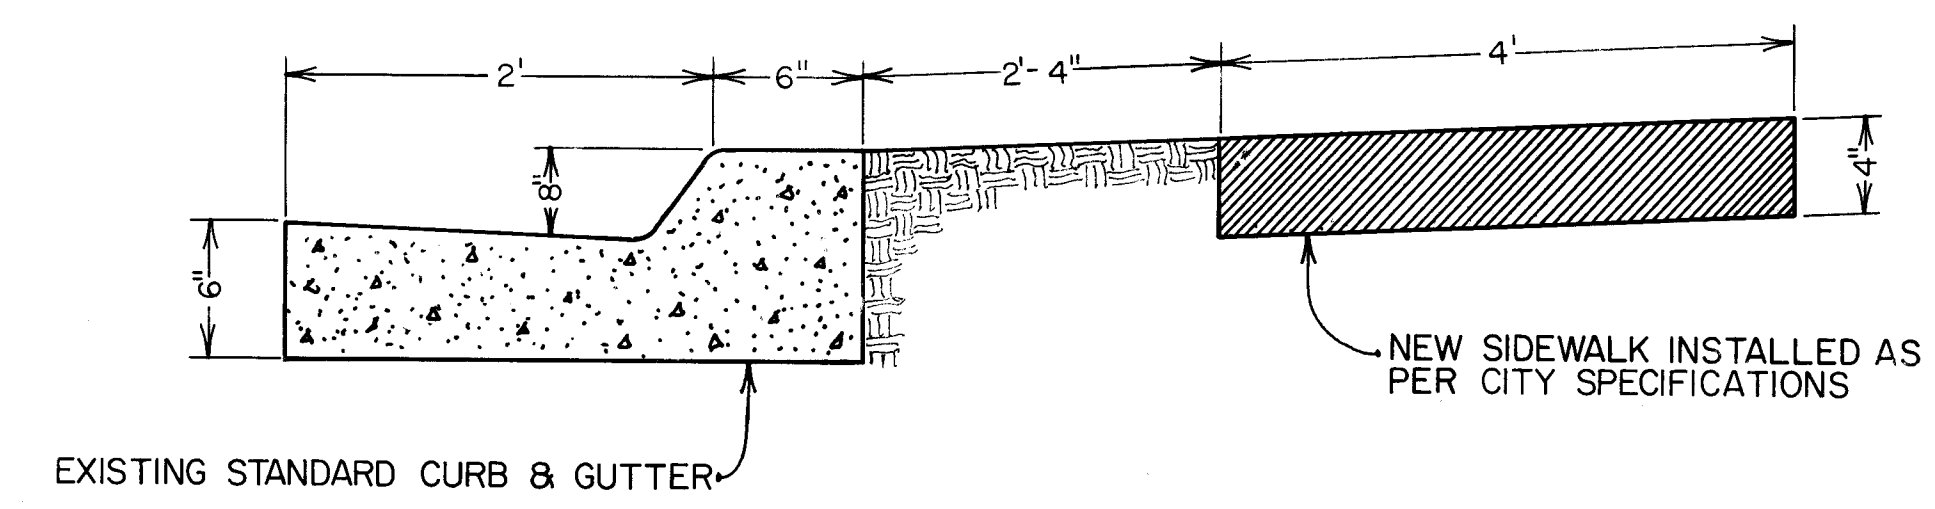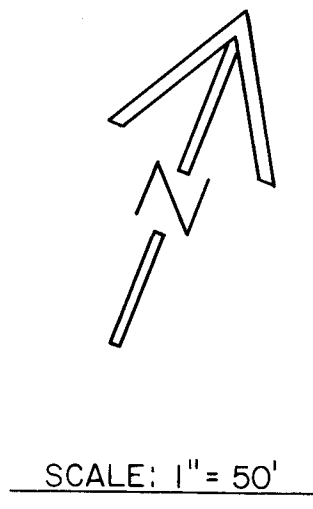

NOTE: A TOTAL OF 1593 SQ. FT. OF SIDEWALK WAS INSTALLED UNDER P.W. CONTRACT 87-2

APPROVAL OF AS BUILT DRAWINGS
CHIEF CONSTRUCTION ENGINEER
[Signature]
DATE 3-9-89

26 34880189

APPROVED FOR
CONSTRUCTION
DATE 3-9-89

CITY OF ALBUQUERQUE
PUBLIC WORKS DEPARTMENT

CANYON RUN SUBDIVISION SIDEWALK FOR LOTS 29, 30, 31, & 35 BLOCK D ON CANYON RIDGE PL. AND CANYON RUN RD.

DATE	BY	REMARKS
3/8/89	PAUL A. YANNONI	PAUL A. YANNONI
3/8/89	FRED GOMEZ	FRED GOMEZ

DRAWING NO. 3488

E-20-Z 87-2

MCC

LENNY ROMERO 3/8/89

PAUL A. YANNONI
FRED GOMEZ
3/8/89
3/8/89