

CONSTRUCTION PLANS
FOR
PROJECT NO. 3494.91
**ADOBE ACRES / LAKEVIEW
WATERLINES
EL CHARRO-CLEAR ADDITION**

PUBLIC WORKS DEPARTMENT
CITY OF ALBUQUERQUE



RECORD DRAWING

WARNING
This is part of a record document. Record documents are based on reports submitted by others. Engineers do not assume any liability for any responsibility, or liability for the accuracy or reliability of the Users of record documents are cautioned and advised to obtain independent verification of actual conditions.

Russell B. Lujan
3-30-93

INDEX TO DRAWINGS

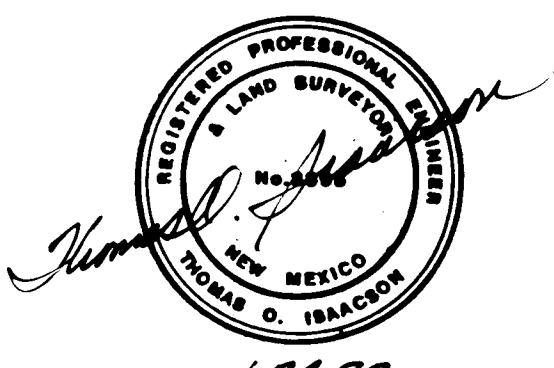
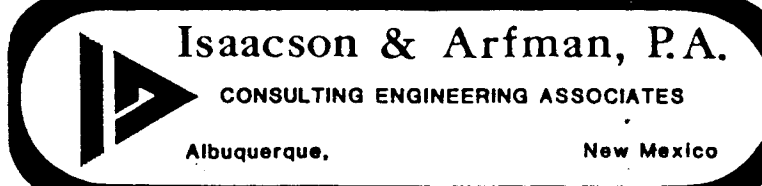
| SHEET NO. | TITLE |
|-----------|---|
| 1 | COVER SHEET |
| 2 | GENERAL NOTES, LOCATION MAP |
| 3 | CLEAR STREET |
| 4 | LISA ROAD |
| 4A | LISA ROAD, DON PEDRO FACILTA ROAD |
| 5 | EL CHARRO PLACE, 0+00 TO 9+00 |
| 6 | EL CHARRO PLACE, 9+00 TO END AND CUL-DE-SAC |
| 7 | DETAILS |
| 8 | TRAFFIC CONTROL PLAN |

APPROVED

Boles A. Romero 1/23/92
BERNALILLO COUNTY PUBLIC WORKS DEPARTMENT DATE

26 3494.910193

| REV. | SHEETS | CITY ENGR. | DATE | USER DEPT. | DATE | USER DEPT. | DATE |
|-----------------------|--------|------------|------|------------|------|------------|------|
| APPROVAL OF REVISIONS | | | | | | | |

| | | |
|---|---|--|
|  |  <i>Isaacson & Arfman, P.A.</i> 2-4-92 | APPROVED FOR CONSTRUCTION <i>Isaacson & Arfman, P.A.</i> 2-4-92 |
| PROJECT NO. 3494.91 | | SHEET 1 OF 8 |

CON-91-9

GENERAL NOTES

- ALL WORK DETAILED ON THESE PLANS TO BE PERFORMED UNDER CONTRACT SHALL, EXCEPT AS OTHERWISE STATED OR PROVIDED FOR HEREON, BE CONSTRUCTED IN ACCORDANCE WITH THE CITY OF ALBUQUERQUE STANDARD SPECIFICATIONS FOR PUBLIC WORKS CONSTRUCTION.
- PRIOR TO CONSTRUCTION, THE CONTRACTOR SHALL EXCAVATE & VERIFY THE HORIZONTAL AND VERTICAL LOCATIONS OF ALL OBSTRUCTIONS. SHOULD A CONFLICT EXIST, THE CONTRACTOR SHALL NOTIFY THE ENGINEER SO THAT THE CONFLICT CAN BE RESOLVED WITH MINIMUM DELAY.
- TWO (2) WORKING DAYS PRIOR TO ANY EXCAVATION, CONTRACTOR MUST CONTACT LINE LOCATING SERVICE @ 260-1990 FOR LOCATION OF EXISTING UTILITIES.
- THE REMOVAL & REPLACEMENT OF ALL SIGNS, POSTS, FENCES, MAIL-BOXES AND ROAD MARKINGS SHALL BE CONSIDERED INCIDENTAL TO THE WATERLINE CONSTRUCTION. NO SEPARATE PAYMENT WILL BE MADE THEREFOR UNLESS NOTED OTHERWISE ON THE PLANS.
- NO WATER VALVE SHUTOFFS ARE REQUIRED ON THIS PROJECT (EXISTING LINES BEING EXTENDED ARE NOT PRESSURIZED).
- ALL UTILITIES AND UTILITY SERVICE LINES SHALL BE INSTALLED PRIOR TO PAVING. THE SURFACE COURSE SHALL BE INSTALLED AFTER FULL APPROVAL AND ACCEPTANCE OF THE UTILITY LINES.
- PAVEMENT REPLACEMENT AND BACKFILL SHALL BE PER COUNTY OF BERNALILLO STANDARD DRAWING 2465.
- TACK COAT REQUIREMENTS SHALL BE DETERMINED BY THE CITY ENGINEER.
- THE CONTRACTOR IS SOLELY RESPONSIBLE FOR THE PROTECTION AND SUPPORT OF POWER POLES AND GUY LINES DURING CONSTRUCTION. HE SHALL ARRANGE FOR SUPPORT, BY THE PUBLIC SERVICE CO. OF NEW MEXICO (PNM), FOR ANY POLES WHICH MIGHT BECOME ENDANGERED BY CONSTRUCTION ACTIVITIES.

PAYMENT FOR POLE SUPPORTING AND GUY WIRE RELOCATIONS SHALL BE A DIRECT REIMBURSEMENT TO THE CONTRACTOR OF PNM CHARGES. NO MARK-UP OF PNM CHARGES WILL BE ALLOWED.
- ALL BUILD NOTES ARE REFERENCED TO THE SURVEY CENTERLINE UNLESS OTHERWISE NOTED.
- RESTRAINED JOINT FITTINGS SHALL BE PROVIDED AT ALL TEES, CROSSES, REDUCERS, BENDS, HYDRANTS, AND VALVES. CONCRETE BLOCKING SHALL BE PROVIDED FOR ALL CAPS & PLUGS.
- ELEVATIONS SHOWN FOR FITTINGS ON PROFILE (SHEETS 4-6) ARE PIPE INVERT ELEVATIONS.
- ALL WATERLINES SHALL HAVE A MINIMUM COVER OF 5'.
- THIS PROJECT IS SUBJECT TO THE TERMS AND CONDITIONS OF THE MASTER UTILITY EASEMENT AND RIGHT-OF-WAY AGREEMENT ENTERED INTO BETWEEN THE COUNTY OF BERNALILLO AND THE CITY OF ALBUQUERQUE, EFFECTIVE DATE 8/20/90, THE "GRADE LINE"; AS DEFINED IN ITEM NO. 4, SECTION 1 OF THAT AGREEMENT; IS THE EXISTING GROUND LINE AS SHOWN AND NOTED ON SHEETS 3-7 OF THESE PLANS.

SPECIAL NOTES

- ADDITIONAL WORK NOT SHOWN ON PLANS:

AT NORTHWEST CORNER OF GUN CLUB ROAD AND PADILLA ROAD- REMOVE EXISTING BLIND FLANGE AND FURNISH AND INSTALL THE FOLLOWING MISSING SECTIONS TO AN EXISTING MUELLER FIRE HYDRANT (HYDRANT #40 ON SHEET 7, LAYOUT & WATER SHUTOFF PLAN).
1-UPPER BARREL
1-BONNET
1-VALVE ROD W/ ROD COUPLINGS
AS REQUIRED

CONTRACTOR SHALL UNCOVER EXISTING HYDRANT AND VERIFY BRAND AND MODEL OF HYDRANT PRIOR TO ORDERING REPLACEMENT PARTS. REMAINING FIRE HYDRANT PARTS SHALL BE DELIVERED TO CITY WATER UTILITIES.

- FURTHER ADDITIONAL WORK NOT SHOWN ON PLANS:

AT THE NORTHWEST CORNER OF GUN CLUB ROAD AND KIRK LANE DUPLICATE WORK DESCRIBED UNDER SPECIAL NOTE NO. 1 ABOVE FOR EXISTING HYDRANT (HYDRANT #36 ON SHEET 7, LAYOUT & WATER SHUTOFF PLAN).

BERNALILLO COUNTY CONSTRUCTION NOTES

- CONTRACTOR SHALL NOTIFY THE BERNALILLO COUNTY PUBLIC WORKS DEPARTMENT IN WRITING A MINIMUM OF 10 DAYS PRIOR TO BEGINNING ANY WORK.
- CONTRACTOR SHALL NOTIFY THE BERNALILLO COUNTY SHERIFF'S DEPARTMENT AND FIRE DEPARTMENT PRIOR TO ANY ROAD CLOSURES.
- CONTRACTOR SHALL OBTAIN AN EXCAVATION PERMIT FROM BERNALILLO COUNTY PRIOR TO BEGINNING WORK.
- COUNTY INSPECTION OF WORK IS REQUIRED.
- OBTAIN PERMITS FROM G.J. FOSTER, BERNALILLO COUNTY PUBLIC WORKS DEPARTMENT (843-6120).
- REPAIRED GRAVEL ROADS IN COUNTY R/W SHALL MEET FOLLOWING COUNTY STANDARDS:
A. GRAVEL SURFACING SHALL MEET REQUIREMENTS FOR CRUSHED AGGREGATE BASE COURSE (CITY SPEC. SECTION 302)
B. GRAVEL THICKNESS SHALL BE 6" MIN.
- ALL BACKFILL SHALL BE COMPACTED TO COUNTY STANDARDS OF 95% MODIFIED PROCTOR DENSITY.

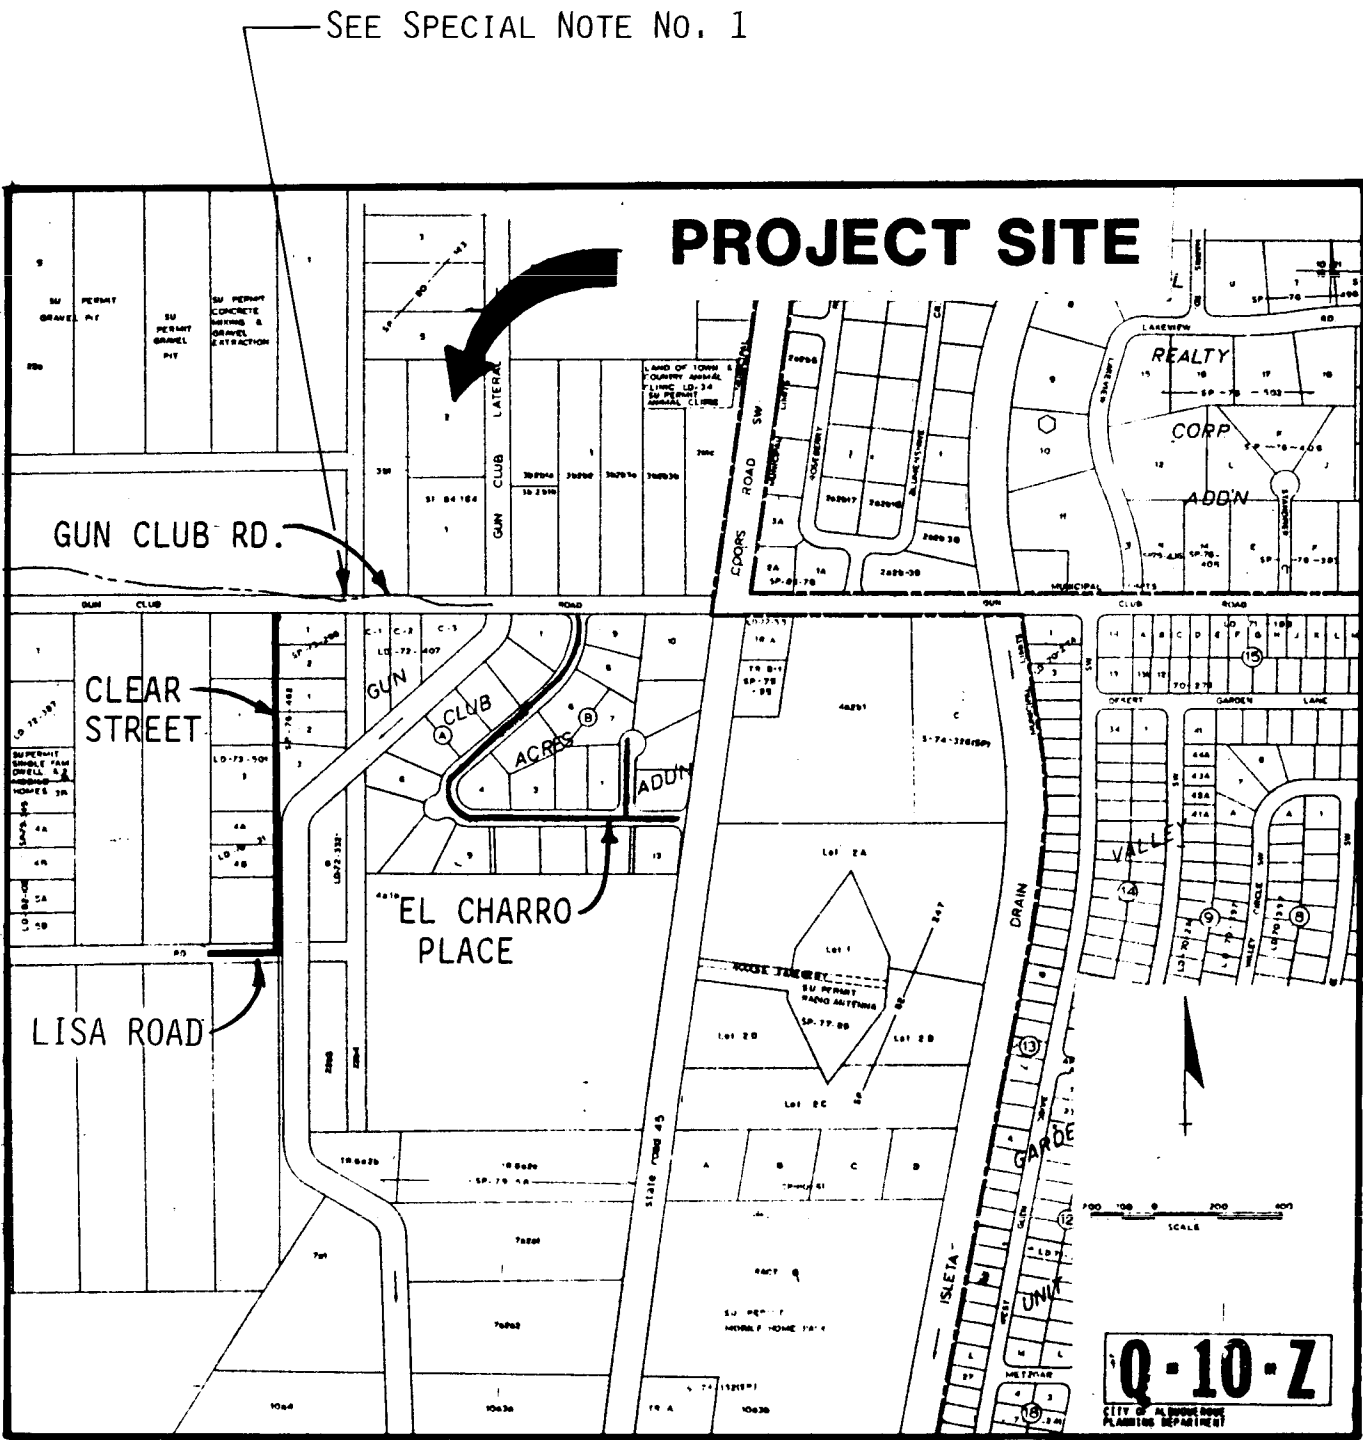
WATER SERVICES NOTES

- ALL TRACTS AND LOTS SHALL HAVE SERVICE LINES AND METER BOXES INSTALLED. THE CITY SHALL BE RESPONSIBLE FOR CONTACTING THE HOMEOWNER TO DETERMINE THE SERVICE LINE SIZE AND TO COORDINATE THE LOCATION OF THE METER BOX WITHIN PUBLIC RIGHT-OF-WAY. FOR VACANT TRACTS, THE METER BOX SHALL BE LOCATED AT THE MIDPOINT OF THE LOT'S FRONTAGE FOR SINGLE LOTS AND AT THE COMMON SIDE LOT LINE FOR VACANT DOUBLE LOTS.
- AS PER SECTION 802.3.6.2 OF THE STANDARD SPECIFICATIONS, HEAVYWEIGHT METER BOX COVERS & LIDS (STD. DWG. NO. 2369) SHALL BE INSTALLED AT ALL LOTS.
- AS PER SECTION 802.3.13 OF THE STANDARD SPECIFICATIONS, ALL COPPERSETTERS SHALL INCLUDE A CHECK VALVE AS ALL SERVICES INSTALLED UNDER THIS CONTRACT WILL BE WITHIN ZONE 0-W OF THE WATER DISTRIBUTION SYSTEM. (SEE METERED SERVICE LINE INSTALLATION DETAIL.)
- WHERE WATER SERVICE IS REQUIRED TO BE EXTENDED ACROSS EXISTING PAVED ROADS, THE CONTRACTOR SHALL BORE THESE SERVICE LINES. BORING FOR SERVICES LINES SHALL BE CONSIDERED INCIDENTAL TO WATER SERVICE LINE CONSTRUCTION AND NO SEPARATE PAYMENT WILL BE MADE THEREFOR.

UTILITY LINES NOTES

WARNING - EXISTING UTILITY LINE LOCATIONS ARE SHOWN IN AN APPROXIMATE MANNER ONLY, AND SUCH LINES MAY EXIST WHERE NONE ARE SHOWN. THE LOCATION OF ANY SUCH EXISTING LINES IS BASED UPON INFORMATION PROVIDED BY THE UTILITY COMPANY, THE OWNER, OR BY OTHERS, AND THE INFORMATION MAY BE INCOMPLETE OR MAY BE OBSOLETE BY THE TIME CONSTRUCTION COMMENCES.

THE ENGINEER HAS UNDERTAKEN NO FIELD VERIFICATION OF THE LOCATION, DEPTH, SIZE, OR TYPE OF EXISTING UNDERGROUND UTILITY LINES, MAKES NO REPRESENTATION PERTAINING THERETO, AND ASSUMES NO RESPONSIBILITY OR LIABILITY THEREFOR. THE CONTRACTOR SHALL INFORM ITSELF OF THE LOCATION OF ANY UTILITY LINE IN OR NEAR THE AREA OF THE WORK IN ADVANCE OF AND DURING EXCAVATION WORK. THE CONTRACTOR IS FULLY RESPONSIBLE FOR ANY AND ALL DAMAGE CAUSED BY ITS FAILURE TO LOCATE, IDENTIFY, AND PRESERVE ANY AND ALL EXISTING UTILITIES. THE CONTRACTOR SHALL COMPLY WITH STATE STATUTES, MUNICIPAL AND LOCAL ORDINANCES, RULES AND REGULATIONS PERTAINING TO THE LOCATION OF THESE LINES AND FACILITIES, IN PLANNING AND CONDUCTING EXCAVATION, WHETHER BY CALLING OR NOTIFYING THE UTILITIES, COMPLYING WITH "BLUE STAKES" PROCEDURES, OR OTHERWISE.



LOCATION MAP

1"=600'±

PLAN & PROFILE SHEETS LEGEND

- R/W OR PROPERTY LINE
- WOVEN WIRE FENCE
- CHAIN LINK FENCE
- WOOD FENCE
- BARBED WIRE FENCE
- MASONRY WALL
- GATE
- MAIL BOX
- SIGN
- POWER POLE W/ ANCHOR
- UGT UNDERGROUND TELEPHONE W/ JUNCTION BOX
- CATV UNDERGROUND TV W/ RISER
- G UNDERGROUND GAS
- GS GAS SERVICE LINE
- 6"W NEW WATERLINE W/ SIZE
- NEW GATE VALVE / FIRE HYDRANT
- EXISTING WATER METER
- NEW WATER SERVICE LINE & METER

26 3494.910293


RECORD DRAWING

WARNING


This is not a record document. Record documents are based on report. This is not a record document. Record documents are based on report. This is not a record document. Record documents are based on report.

1 2 3 100

| | | | | | |
|---|--------------------|--------------|-------------|--------------------|---------|
| CITY OF ALBUQUERQUE PUBLIC WORKS DEPARTMENT ENGINEERING GROUP | | | | | |
| TITLE: Adobe Acres / Lakeview Waterlines GENERAL NOTES, LEGEND, LOCATION MAP | | | | | |
| APPROVALS | ENGINEER | DATE | APPROVALS | ENGINEER | DATE |
| D.R.C. Chair | <i>[Signature]</i> | 2-4-92 | Water | <i>[Signature]</i> | 1-27-92 |
| Trans. Dev. | <i>[Signature]</i> | | Waste Water | <i>[Signature]</i> | |
| Hydrology | <i>[Signature]</i> | | | | |
| PROJECT NO. 3494.91 | | MAP NO. Q-10 | | SHEET 2 OF 8 | |

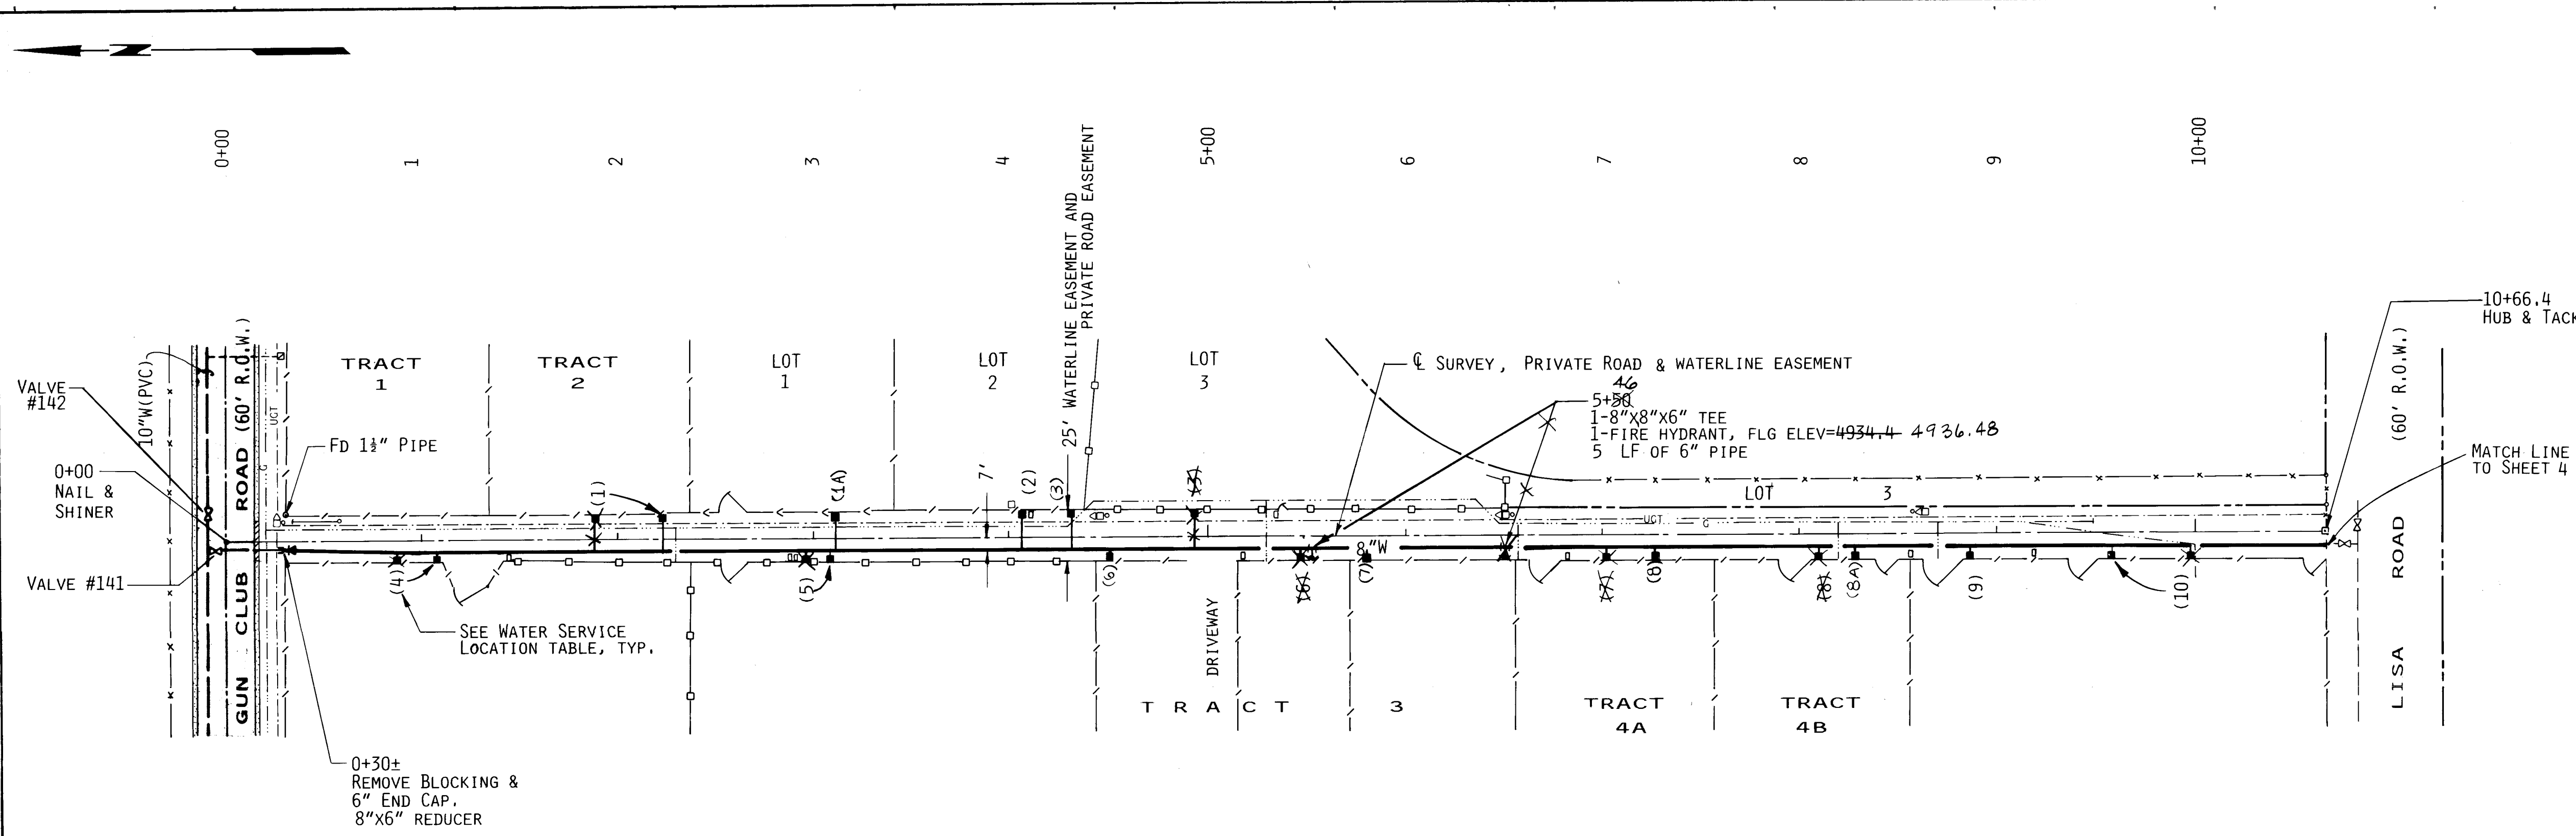

CLEAR STREET (25' PRIVATE ROAD)

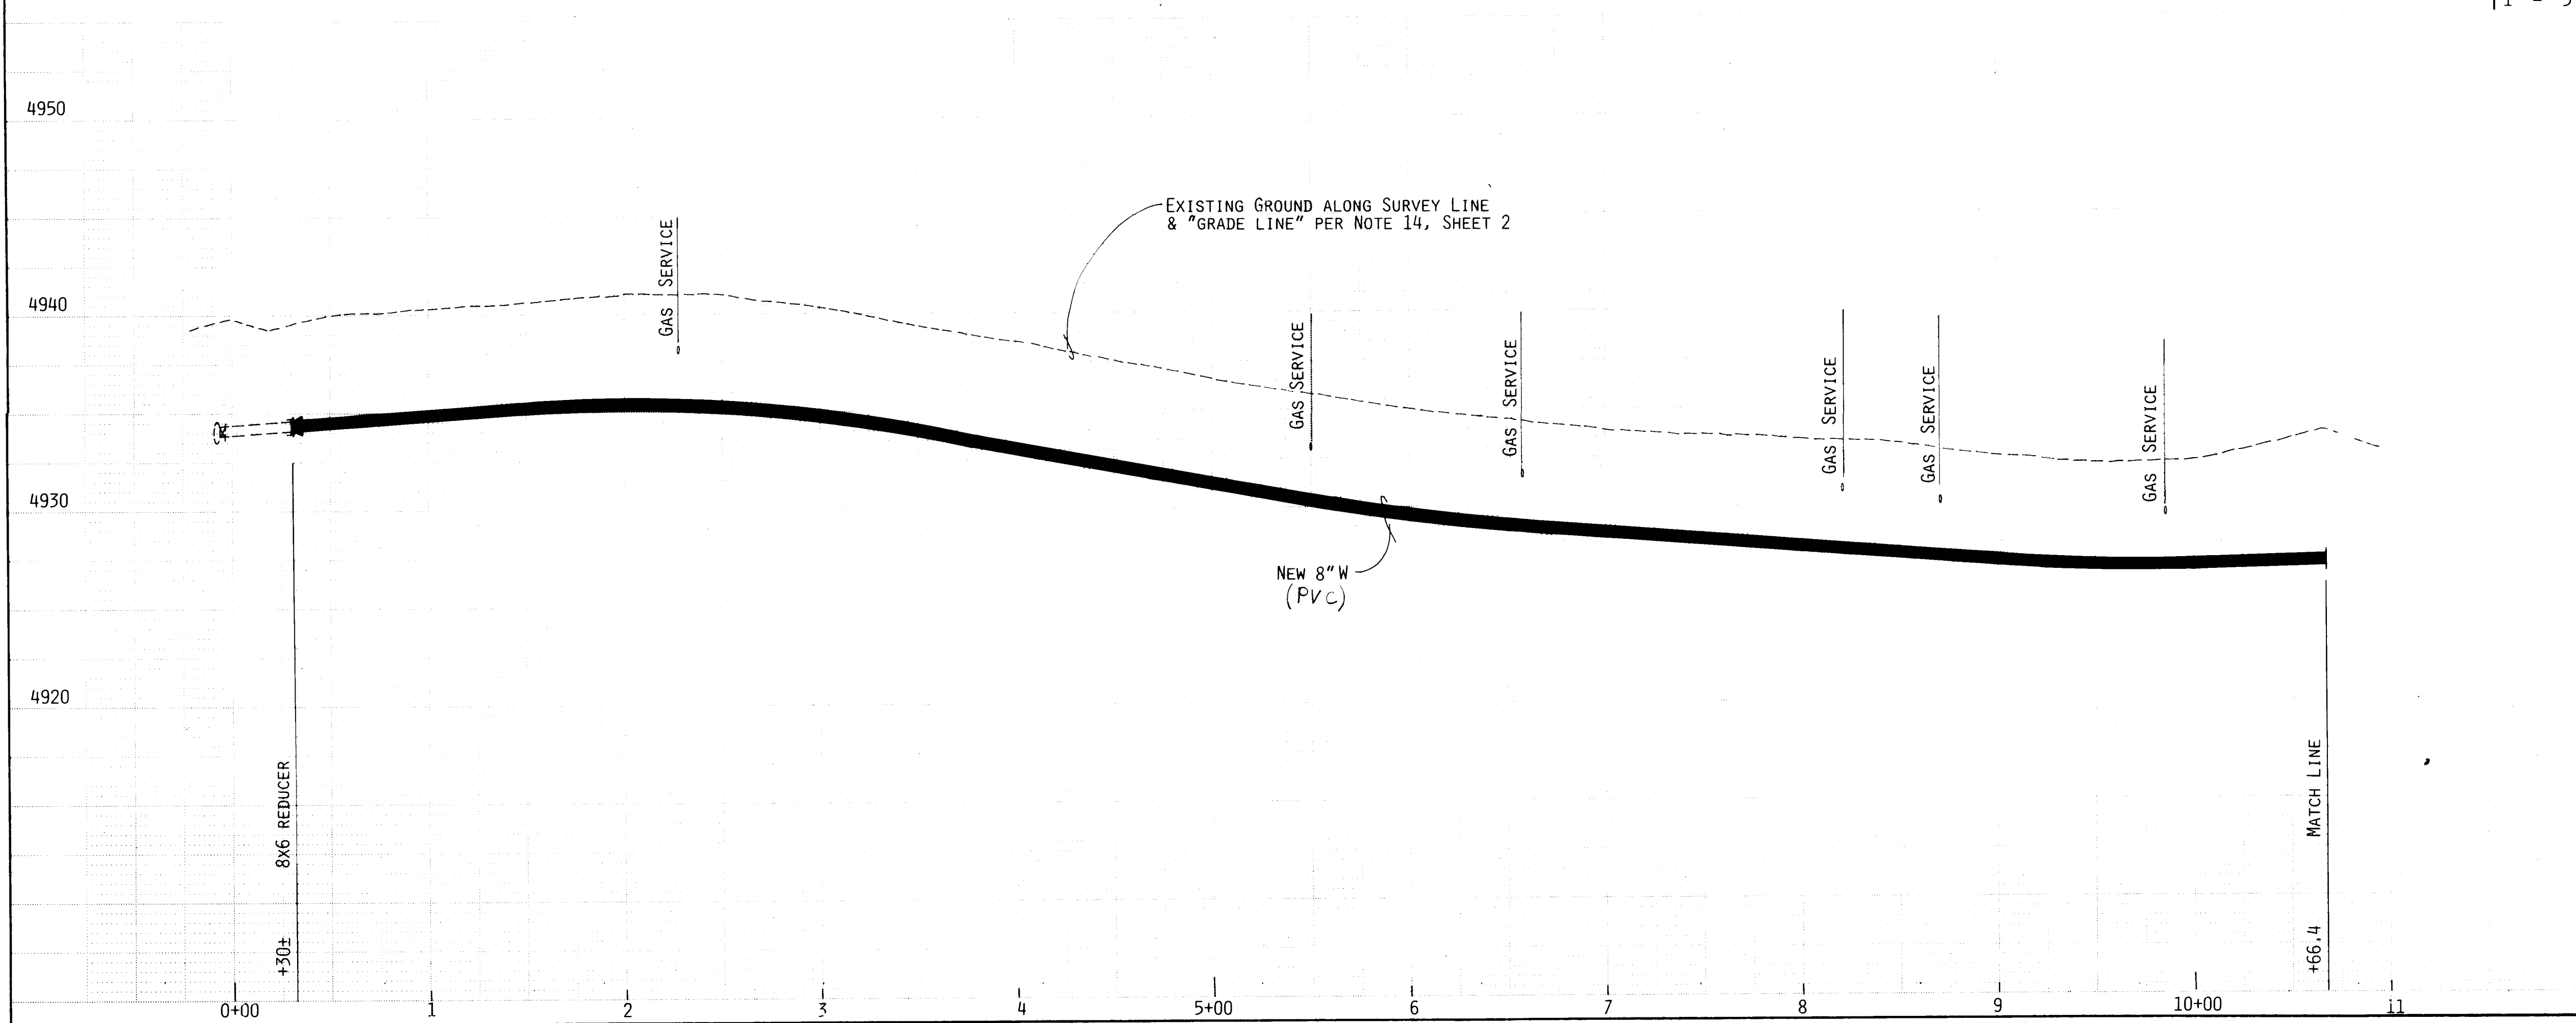

SCALE:
1" = 50' HOR.
1" = 5' VERT.

| WATER SERVICE LOCATION | | |
|------------------------|----------|-------------------|
| MARK | STATION* | LINE LENGTH* (LF) |
| (1) | 2+22 | - |
| (2) | 4+10 | - |
| (3) | 4+30 | - |
| (4) | 1+07 | - |
| (5) | 3+08 | - |
| (6) | 4+50 | - |
| (7) | 5+77 | - |
| (8) | 7+27 | - |
| (9) | 8+86 | - |
| (10) | 9+58 | - |
| (1A) | 3+10 | - |
| (8A) | 8+28 | - |

*STATION & LENGTH VALUES TO BE DETERMINED FROM FIELD MEASUREMENTS AND PLACED ON RECORD DRAWINGS.

All Service Lines are 6"4"

RECORD DRAWING


WARNING
This is part of a record document. Record documents are based on reports submitted by others. Engineers cannot assure nor assume any responsibility or liability for the accuracy of record documents. Users of record documents are cautioned and advised to obtain independent verification of actual conditions.

26 3494.91 0893

| | | | | | |
|---|---------------|--------------|------------|----------------|---------|
| CITY OF ALBUQUERQUE PUBLIC WORKS DEPARTMENT ENGINEERING GROUP | | | | | |
| TITLE: Adobe Acres/Lakeview Waterlines CLEAR STREET (25' PRIVATE ROAD) | | | | | |
| APPROVALS | ENGINEER | DATE | APPROVALS | ENGINEER | DATE |
| D.R.C. Chair | <i>Regina</i> | 2-4-92 | Water | <i>W. Plan</i> | 1-24-92 |
| Trans. Dev | <i>N/A</i> | | Wastewater | <i>NO</i> | |
| Hydrology | <i>N/A</i> | | | | |
| PROJECT NO. 3494.91 | | MAP NO. Q-10 | | SHEET 3 OF 8 | |

| SURVEY INFORMATION | | BENCH MARKS | | AS BUILT INFORMATION | |
|--------------------|------|-------------|-------------|--|-------------|
| FIELD NOTES | DATE | NO. | BY | CONTRACTOR | M.C.C. INC. |
| 1 | 8-91 | | B. PETTIT | ACS BM "6-Q10," A 31" ALUMINUM CAP SET IN NW CORNER TRAFFIC LIGHT CONCRETE BASE IN THE SE QUADRANT OF GUN CLUB ROAD & COORS ROAD SW ELEV. = 4928.456 | |
| NO. | DATE | REMARKS | DESIGNED BY | DATE | NO. |
| | | | TOI | 8/91 | |
| | | | BY | DATE | |
| | | | NOV | 8/91 | |
| | | | TOI | 8/91 | |
| | | | DESIGNED BY | DATE | |
| | | | NOV | 8/91 | |
| | | | CHECKED BY | DATE | |
| | | | TOI | 8/91 | |
| | | | DESIGNED BY | DATE | |
| | | | NOV | 8/91 | |
| | | | CHECKED BY | DATE | |
| | | | TOI | 8/91 | |



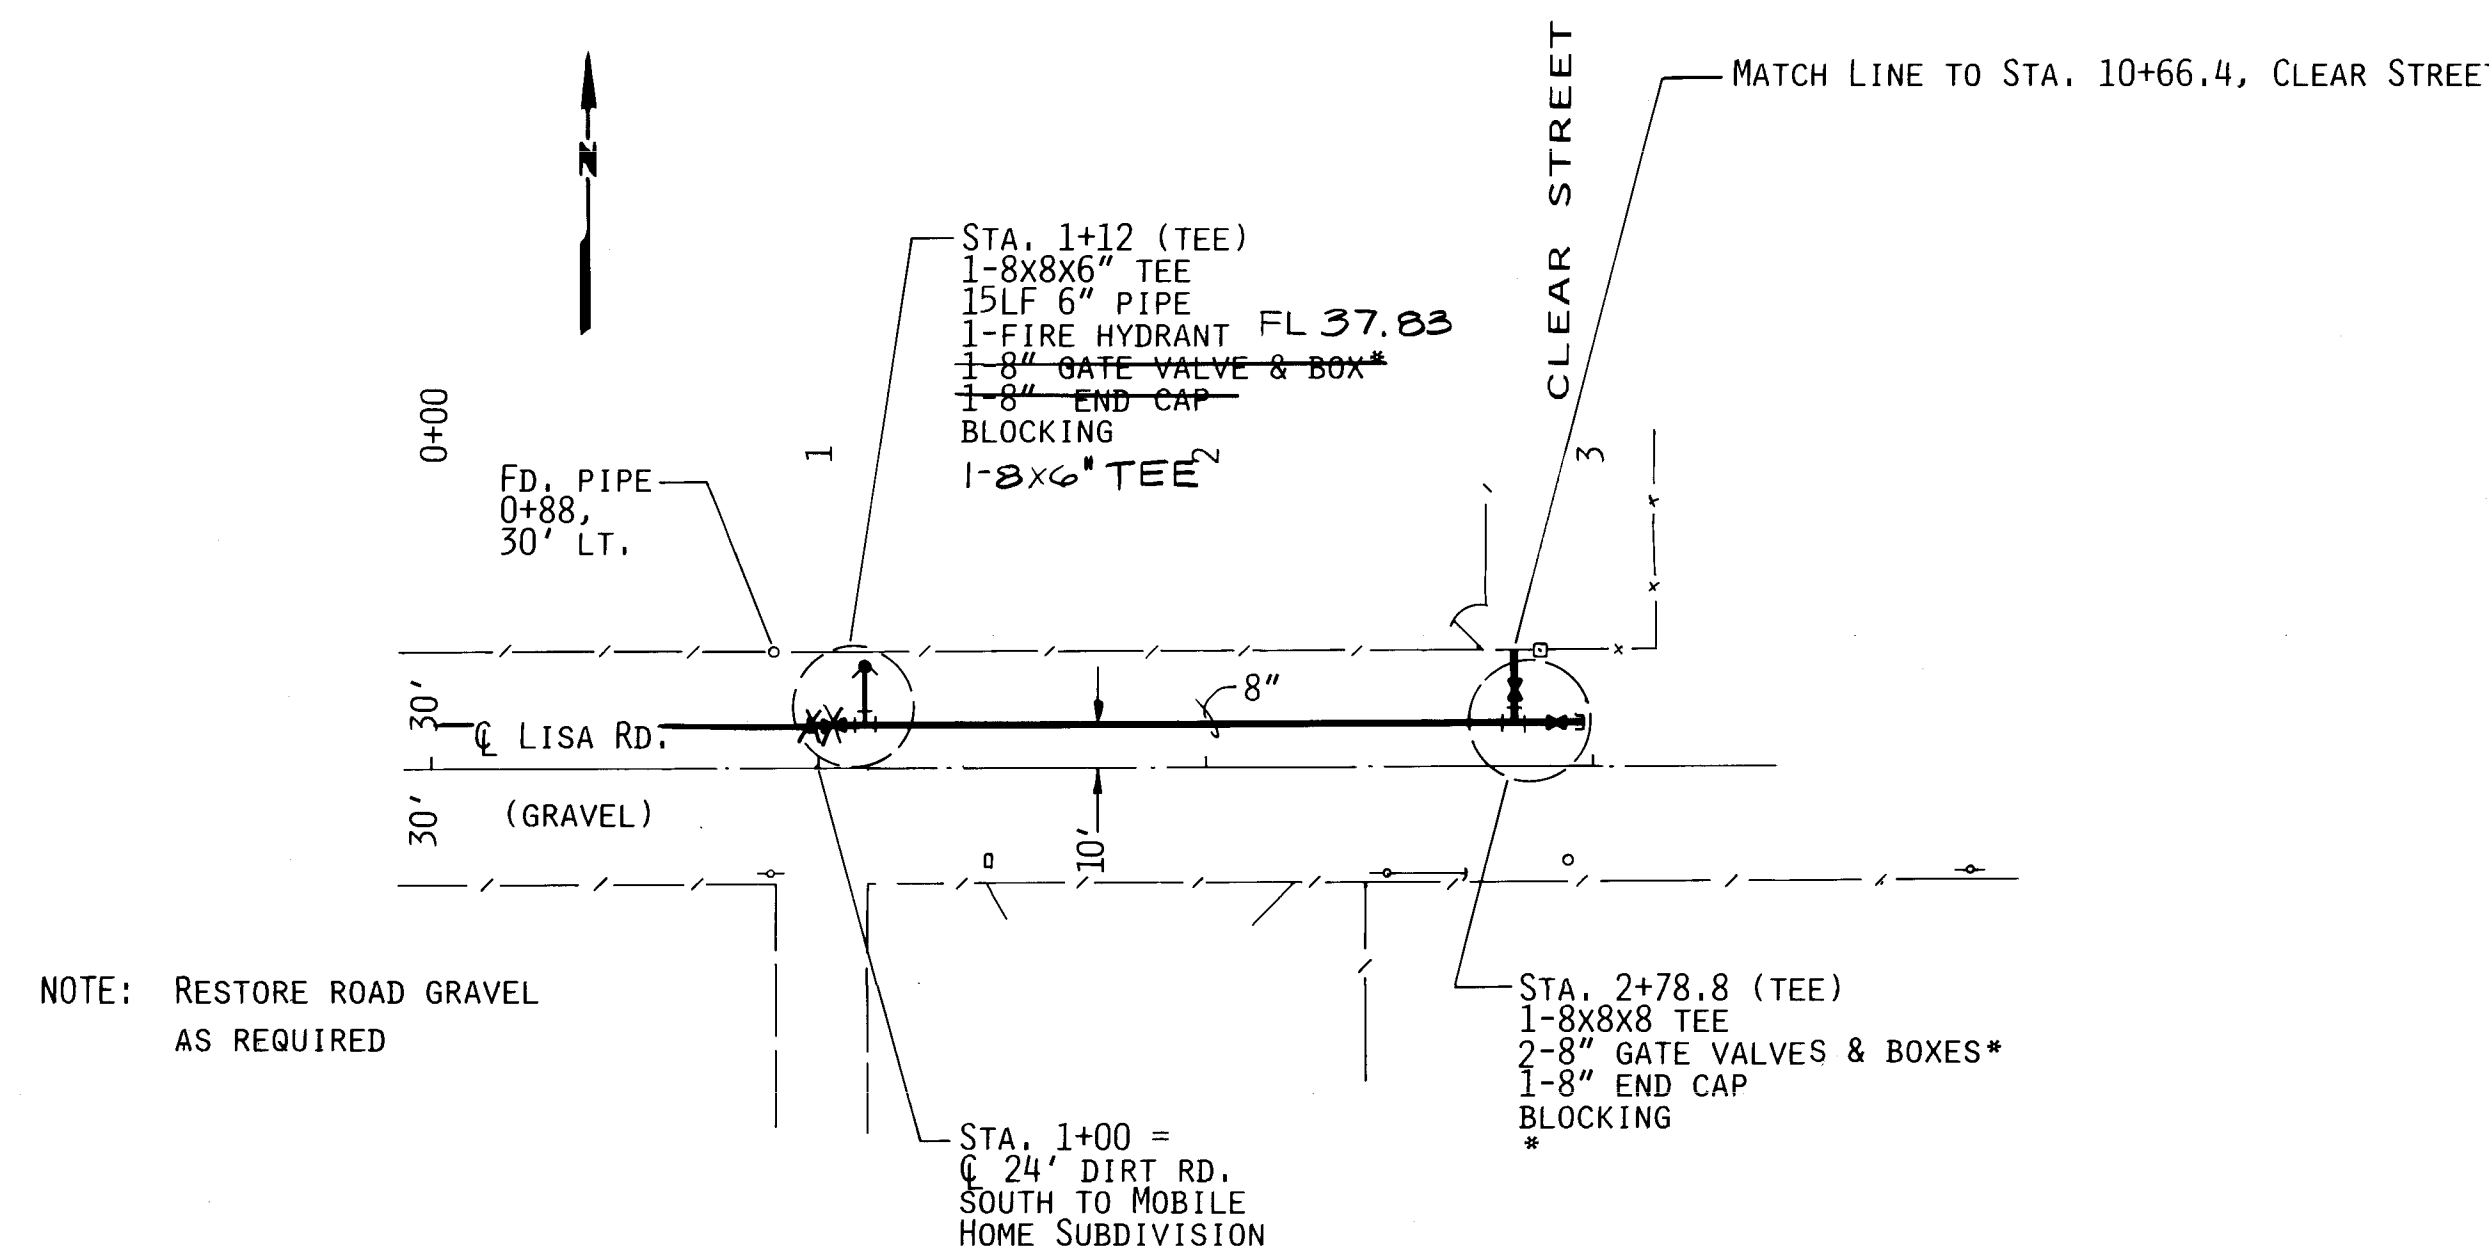


NOTE: RESTORE ROAD GRAVEL AS REQUIRED

*PROVIDE MIN. 35 LF OF RESTRAINED JOINT PIPELINE ON "UPSTREAM" SIDE OF GATE VALVES.


LISA ROAD

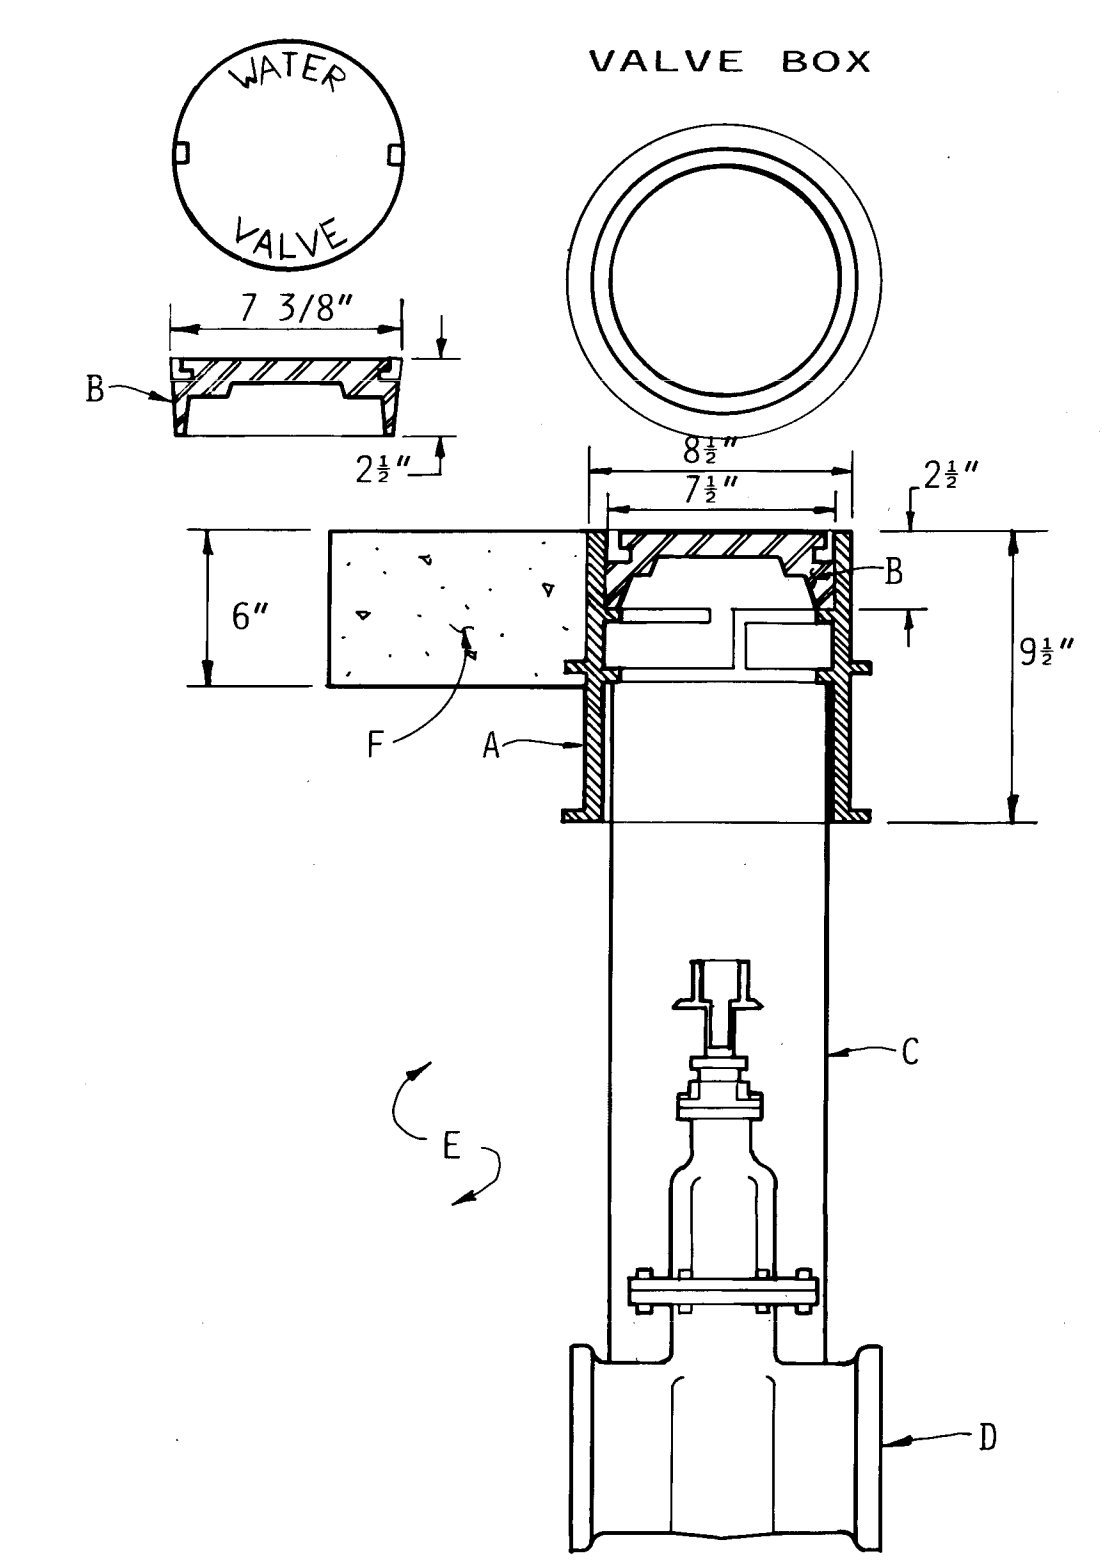1"=50' HOR.
1"= 5' VER.



- A--CAST VALVE BOX
- B--VALVE BOX LID (LOCKING LID OPTIONAL)
- C--6" Φ PVC C-900 PIPE (LENGTH VARIES)
- D--NEW OR EXISTING VALVE
- E--COMPACTED BACKFILL
- F--CONCRETE COLLAR (2'x2'x6") TO BE TAPEDED IN UNPAVED ROADWAYS

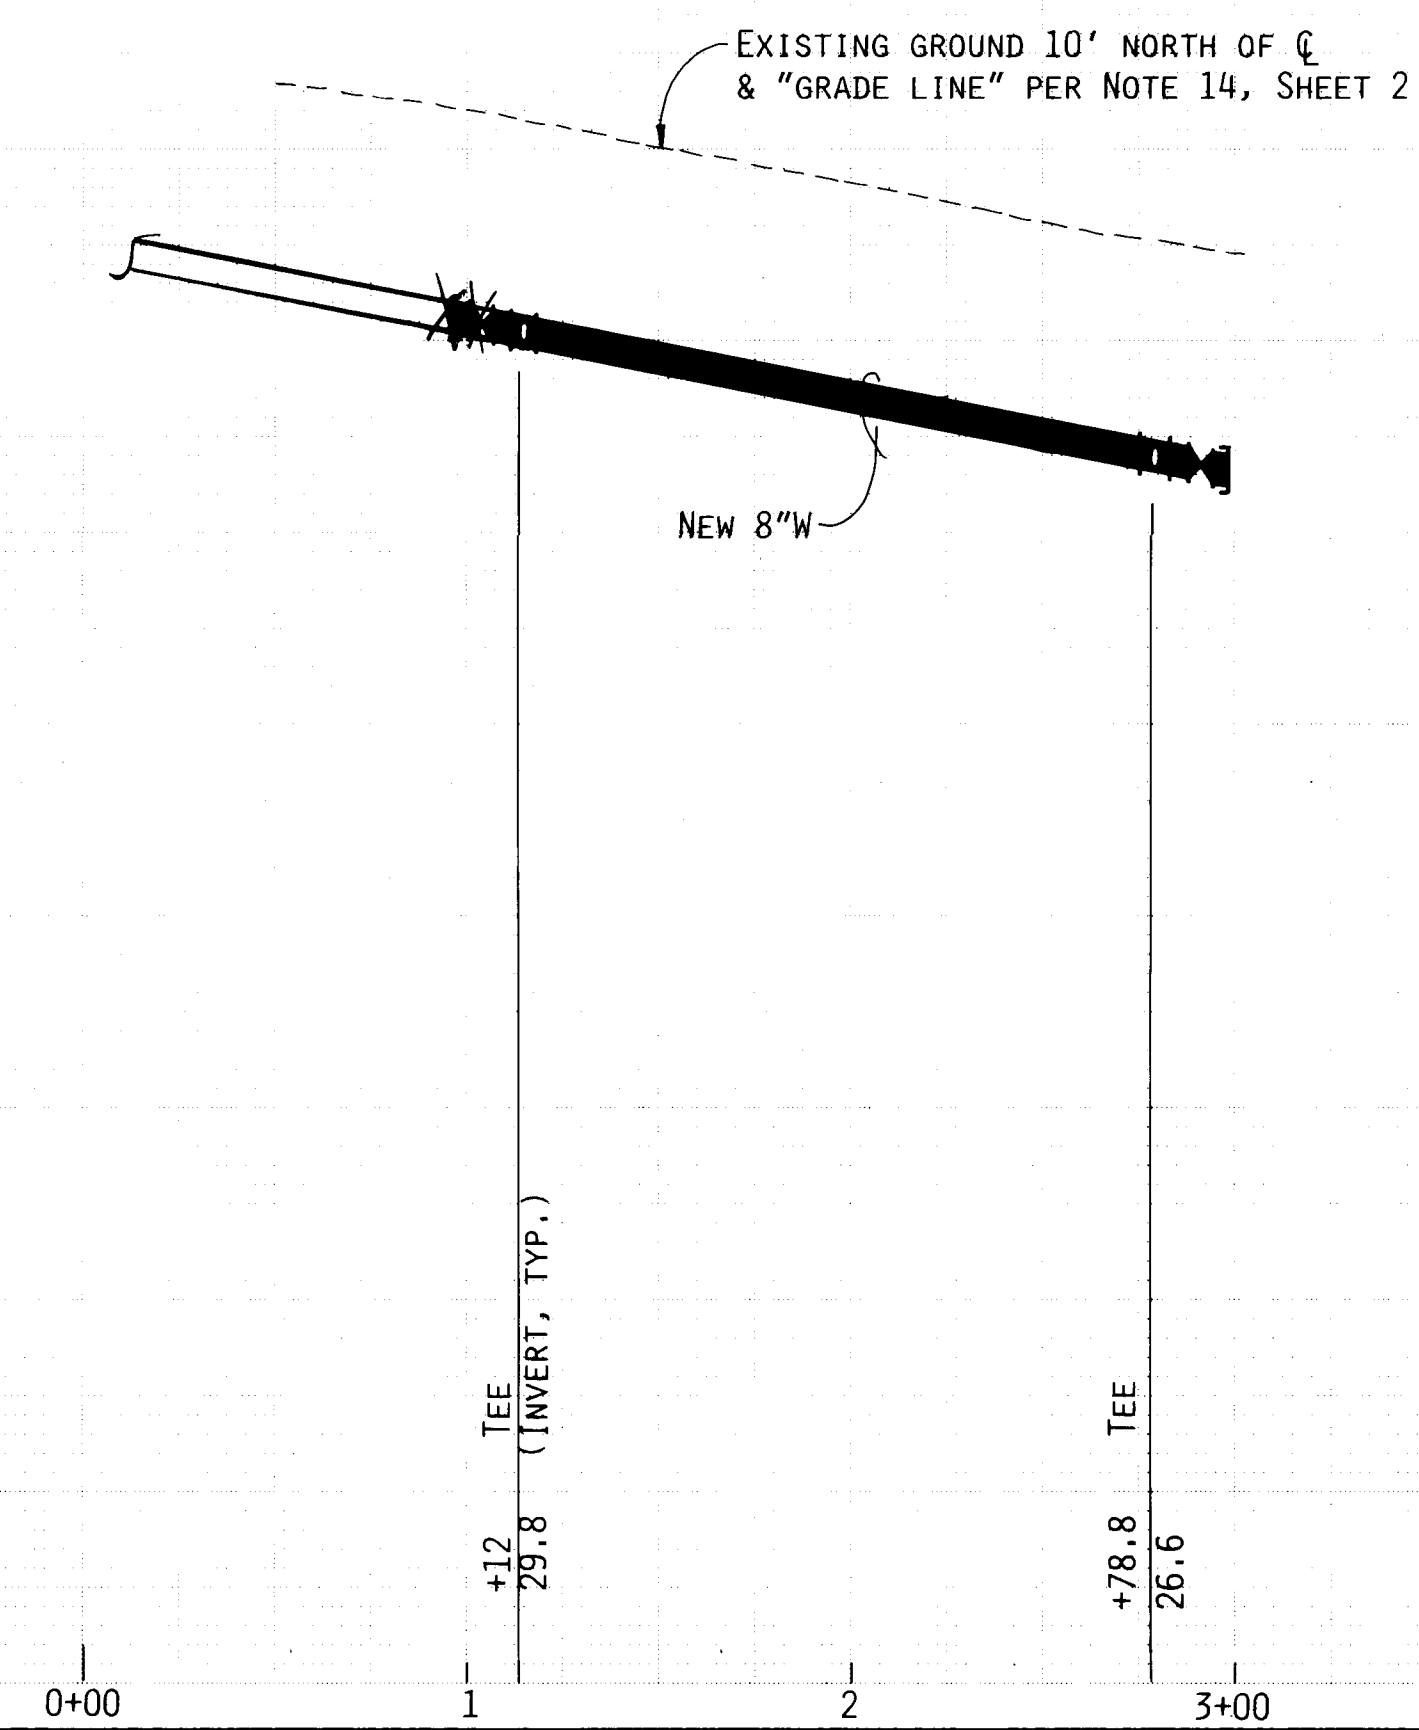TYPE 'B' VALVE BOX
NO SCALE




RECORD DRAWING

WARNING
This is part of a record document. Record documents are based on reports submitted by others. Engineers cannot assure nor assume any responsibility or liability for the accuracy of record documents. Users of record documents are cautioned and advised to obtain independent verification of actual conditions.

| |
|---|
| |
|---|

26 3494.91 0493


| | | | | | |
|---|--------------------|---------|------------|--------------------|---------|
| CITY OF ALBUQUERQUE PUBLIC WORKS DEPARTMENT ENGINEERING GROUP | | | | | |
| TITLE: Adebe Acres/Lakeview Waterlines LISA ROAD | | | | | |
| APPROVALS | ENGINEER | DATE | APPROVALS | ENGINEER | DATE |
| D.R.C. Chair | <i>[Signature]</i> | 2-4-92 | Water | <i>[Signature]</i> | 1-24-92 |
| Trans. Dev | <i>[Signature]</i> | | Wastewater | <i>[Signature]</i> | |
| NO. | | 3494.91 | MAP NO. | | Q-10 |
| SHEET | | 4 | OF | | 8 |

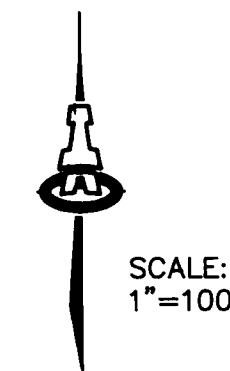



26 3494.910493A

WARNING
This is part of a record document. Record documents are based on reports submitted by others. Engineers cannot assure nor assume any responsibility or liability for the accuracy of record documents. Users of record documents are cautioned and advised to obtain independent verification of actual conditions.



| APPROVALS | ENGINEER | DATE | APPROVALS | ENGINEER | DATE |
|----------------|----------|------|-------------|----------|------|
| DRC CHAIRMAN | | | WATER | | |
| TRANSPORTATION | | | WASTE WATER | | |
| HYDROLOGY | | | | | |
| | | | | | |

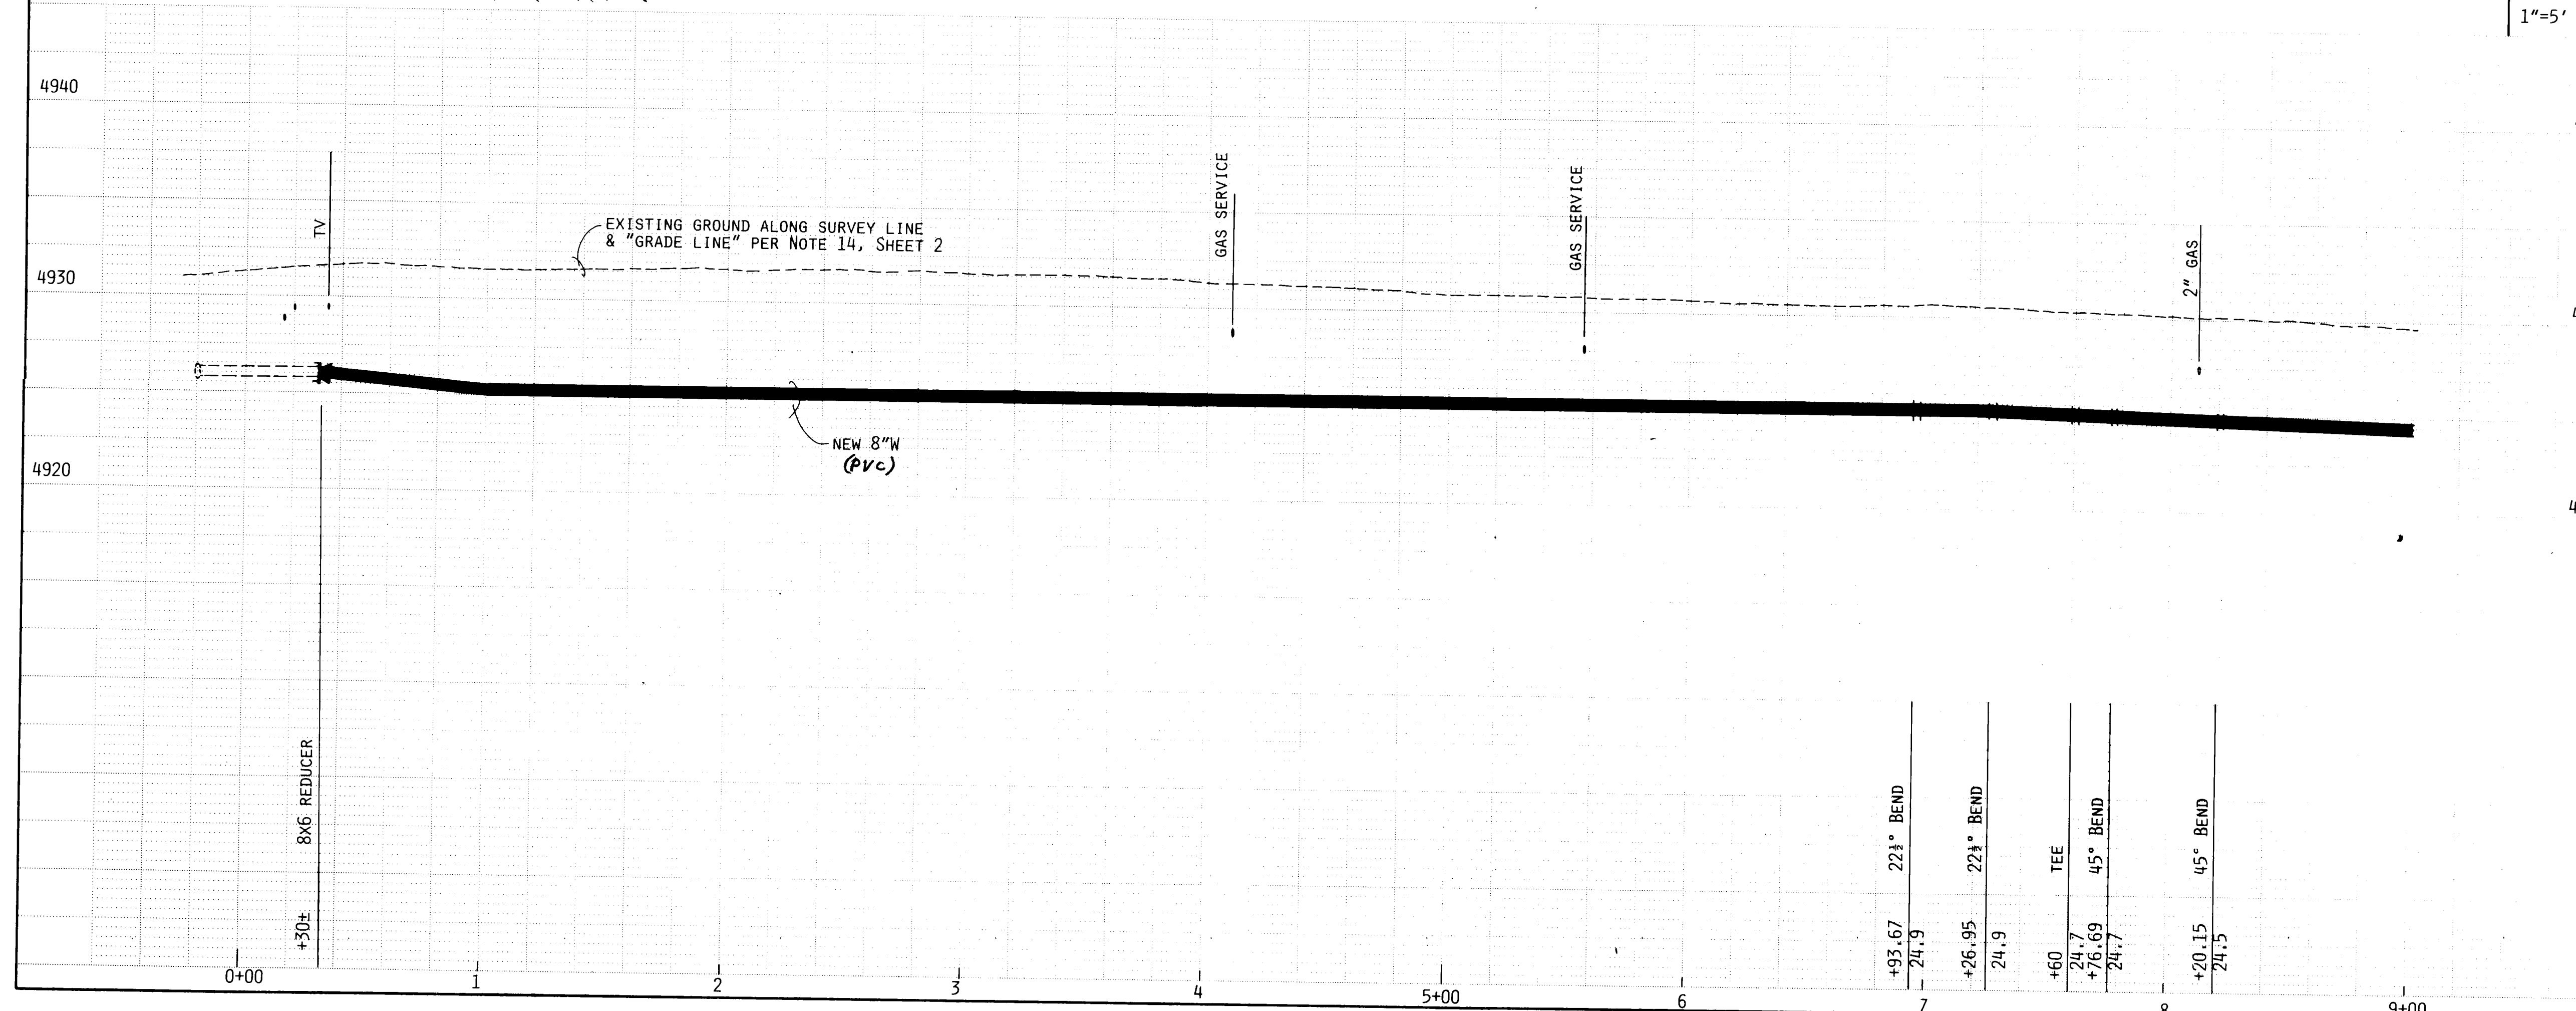

| | | | | | | | |
|-------------|---------|---------|------|-------|---|----|---|
| PROJECT NO. | 3494.91 | MAP NO. | Q-10 | SHEET | 5 | OF | 8 |
|-------------|---------|---------|------|-------|---|----|---|

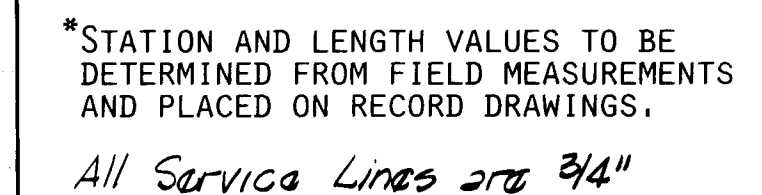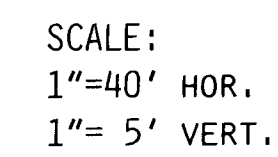

| | | | | | |
|--|------------------------|---------------------|----------------------------|------------|---------|
| CITY OF ALBUQUERQUE PUBLIC WORKS DEPARTMENT ENGINEERING GROUP | | | | | |
| TITLE: Adobe Acres/Lakeview Waterlines EL CHARRO PLACE-STA. 9+00 to END CUL-DE-SAC - STA. 0+00 to END | | | | | |
| APPROVALS | ENGINEER | DATE | APPROVALS | ENGINEER | DATE |
| D.R.C. Chair | <i>Rogelio Nolasco</i> | 2-4-72 | Water | <i>MCD</i> | 2-22-72 |
| Trans. Dev. | <i>N/A</i> | | Wastewater | <i>N/A</i> | |
| Hydrology | <i>N/A</i> | | | | |
| | | | | | |
| PROJECT NO. 3494.91 | | MAP NO. Q-10 | SHEET 6 OF 8 | | |



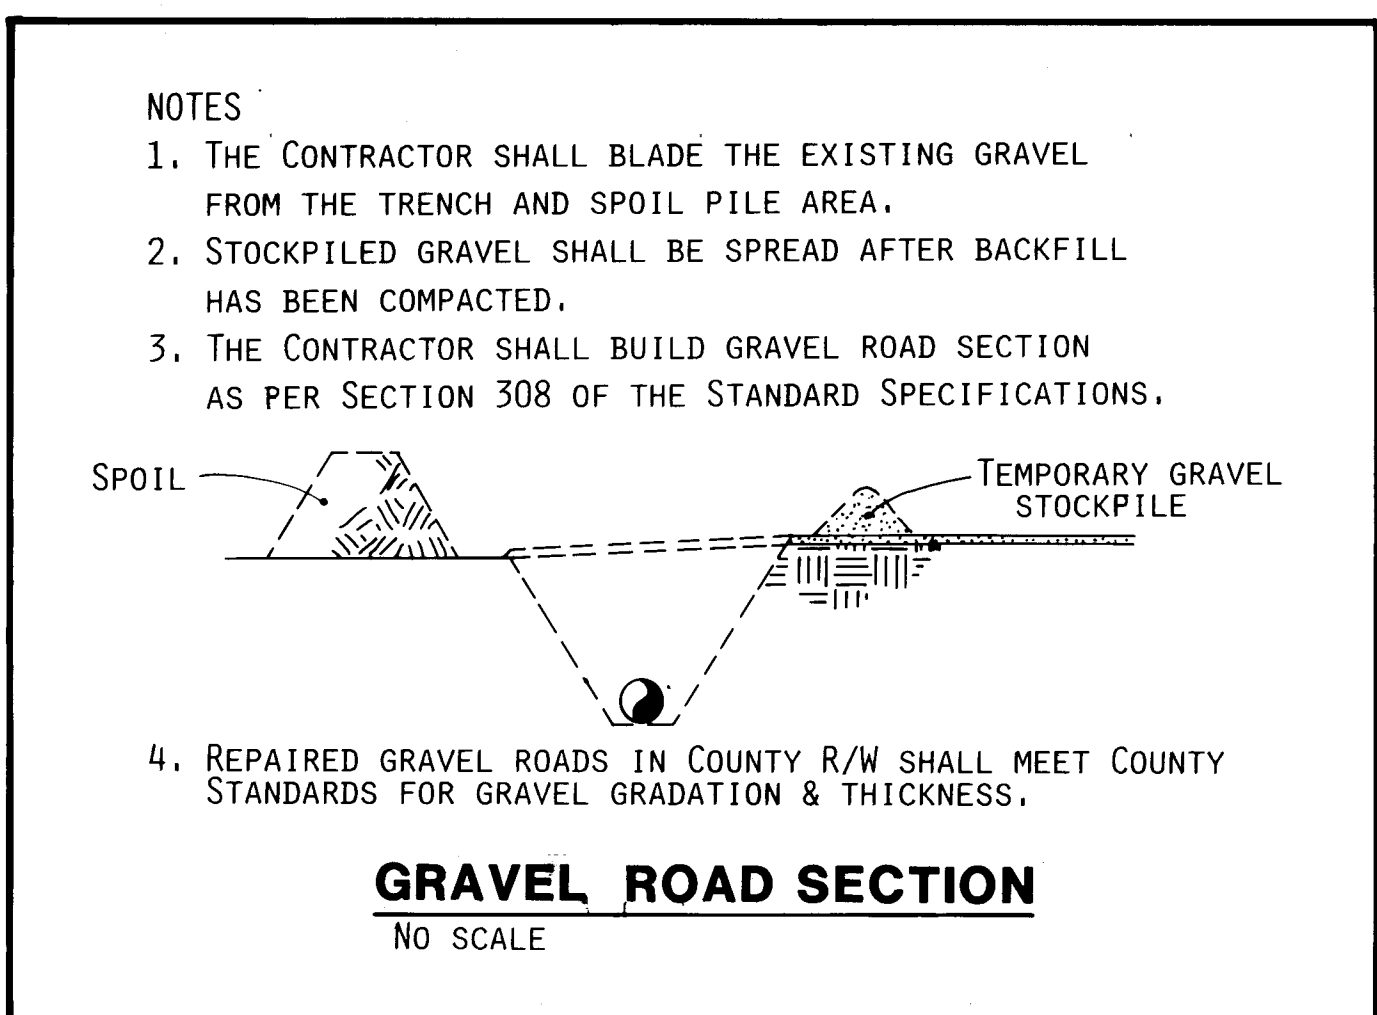
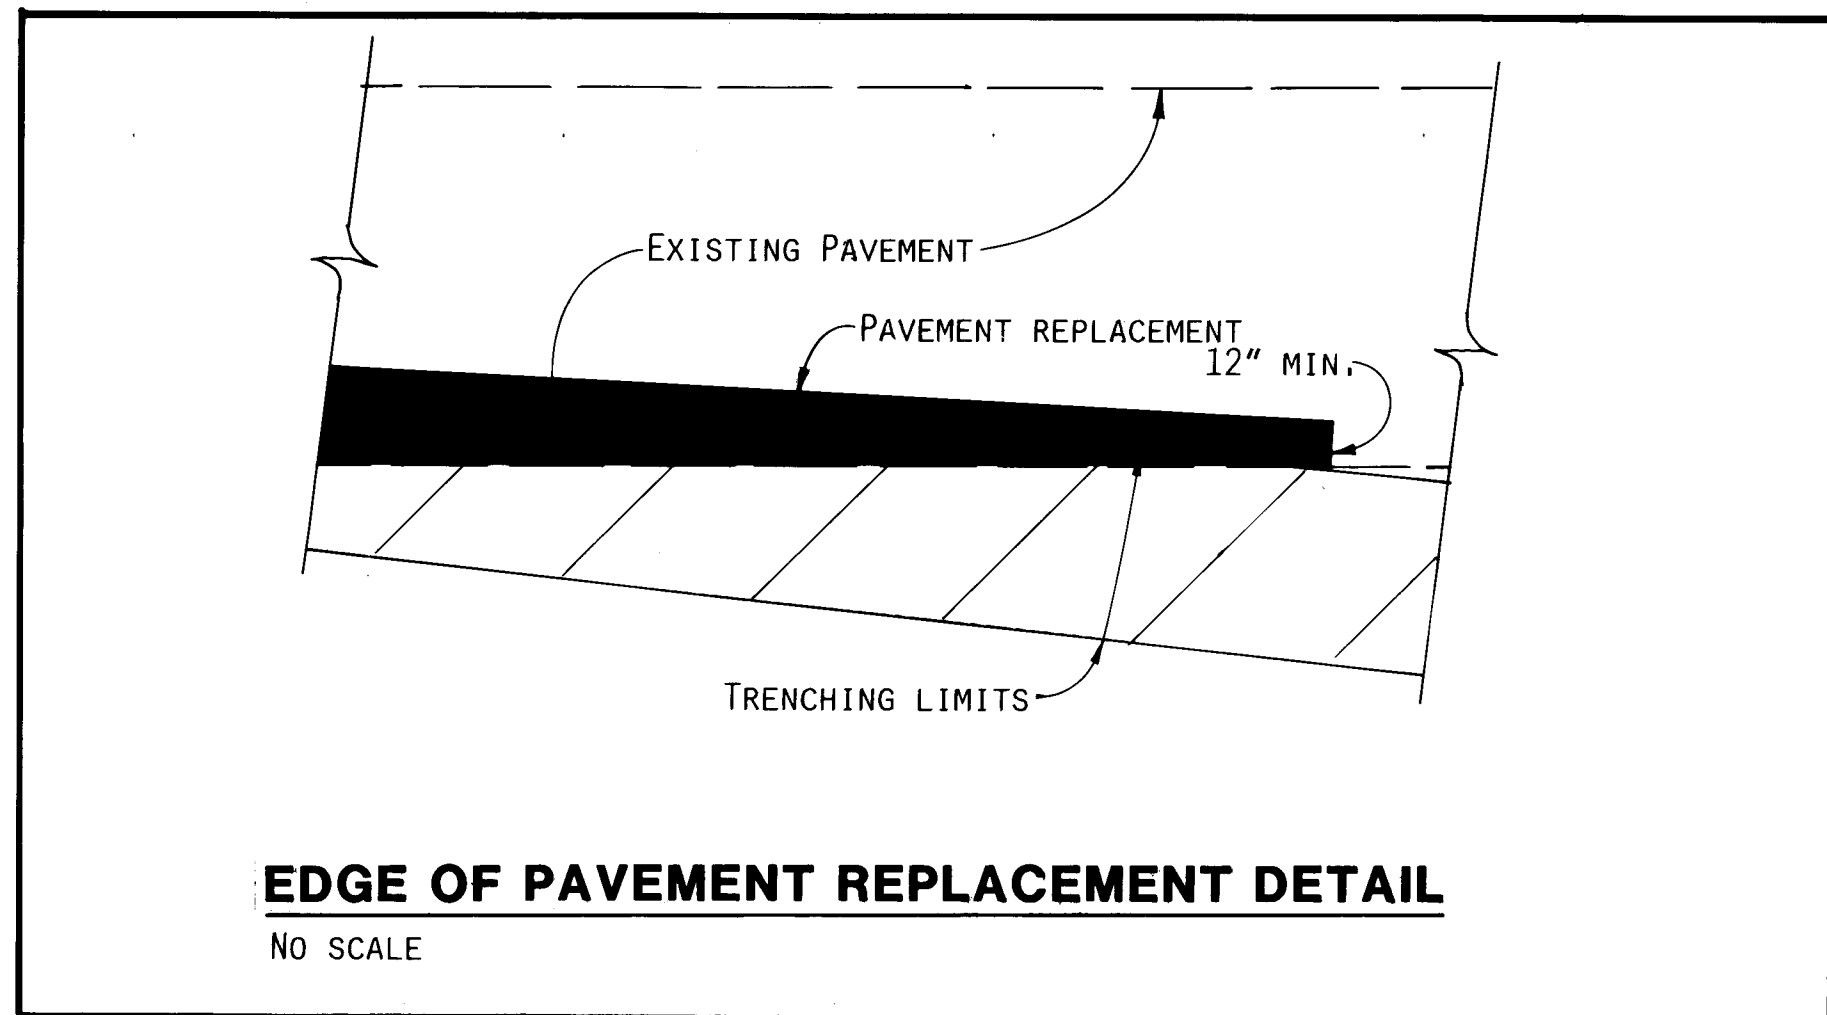


NOTES

- WHERE PVC PIPE IS INSTALLED ALONG A CURVILINEAR ALIGNMENT, THE DEFLECTION SHALL OCCUR ALONG THE BARREL LENGTH OF THE PIPE, NOT AT THE JOINT.
- THE FOLLOWING OFFSETS SHALL NOT BE EXCEEDED.
- MECHANICAL MEANS SHALL NOT BE USED TO BEND PVC PIPE.

| PIPE DIA. (INCHES) | MIN. ALLOWABLE RADIUS (FEET) | MAX. OFFSET PER 20' PIPE LENGTH (INCHES) |
|--------------------|------------------------------|--|
| 4 | 135 | 18 |
| 6 | 240 | 10 |
| 8 | 270 | 9 |

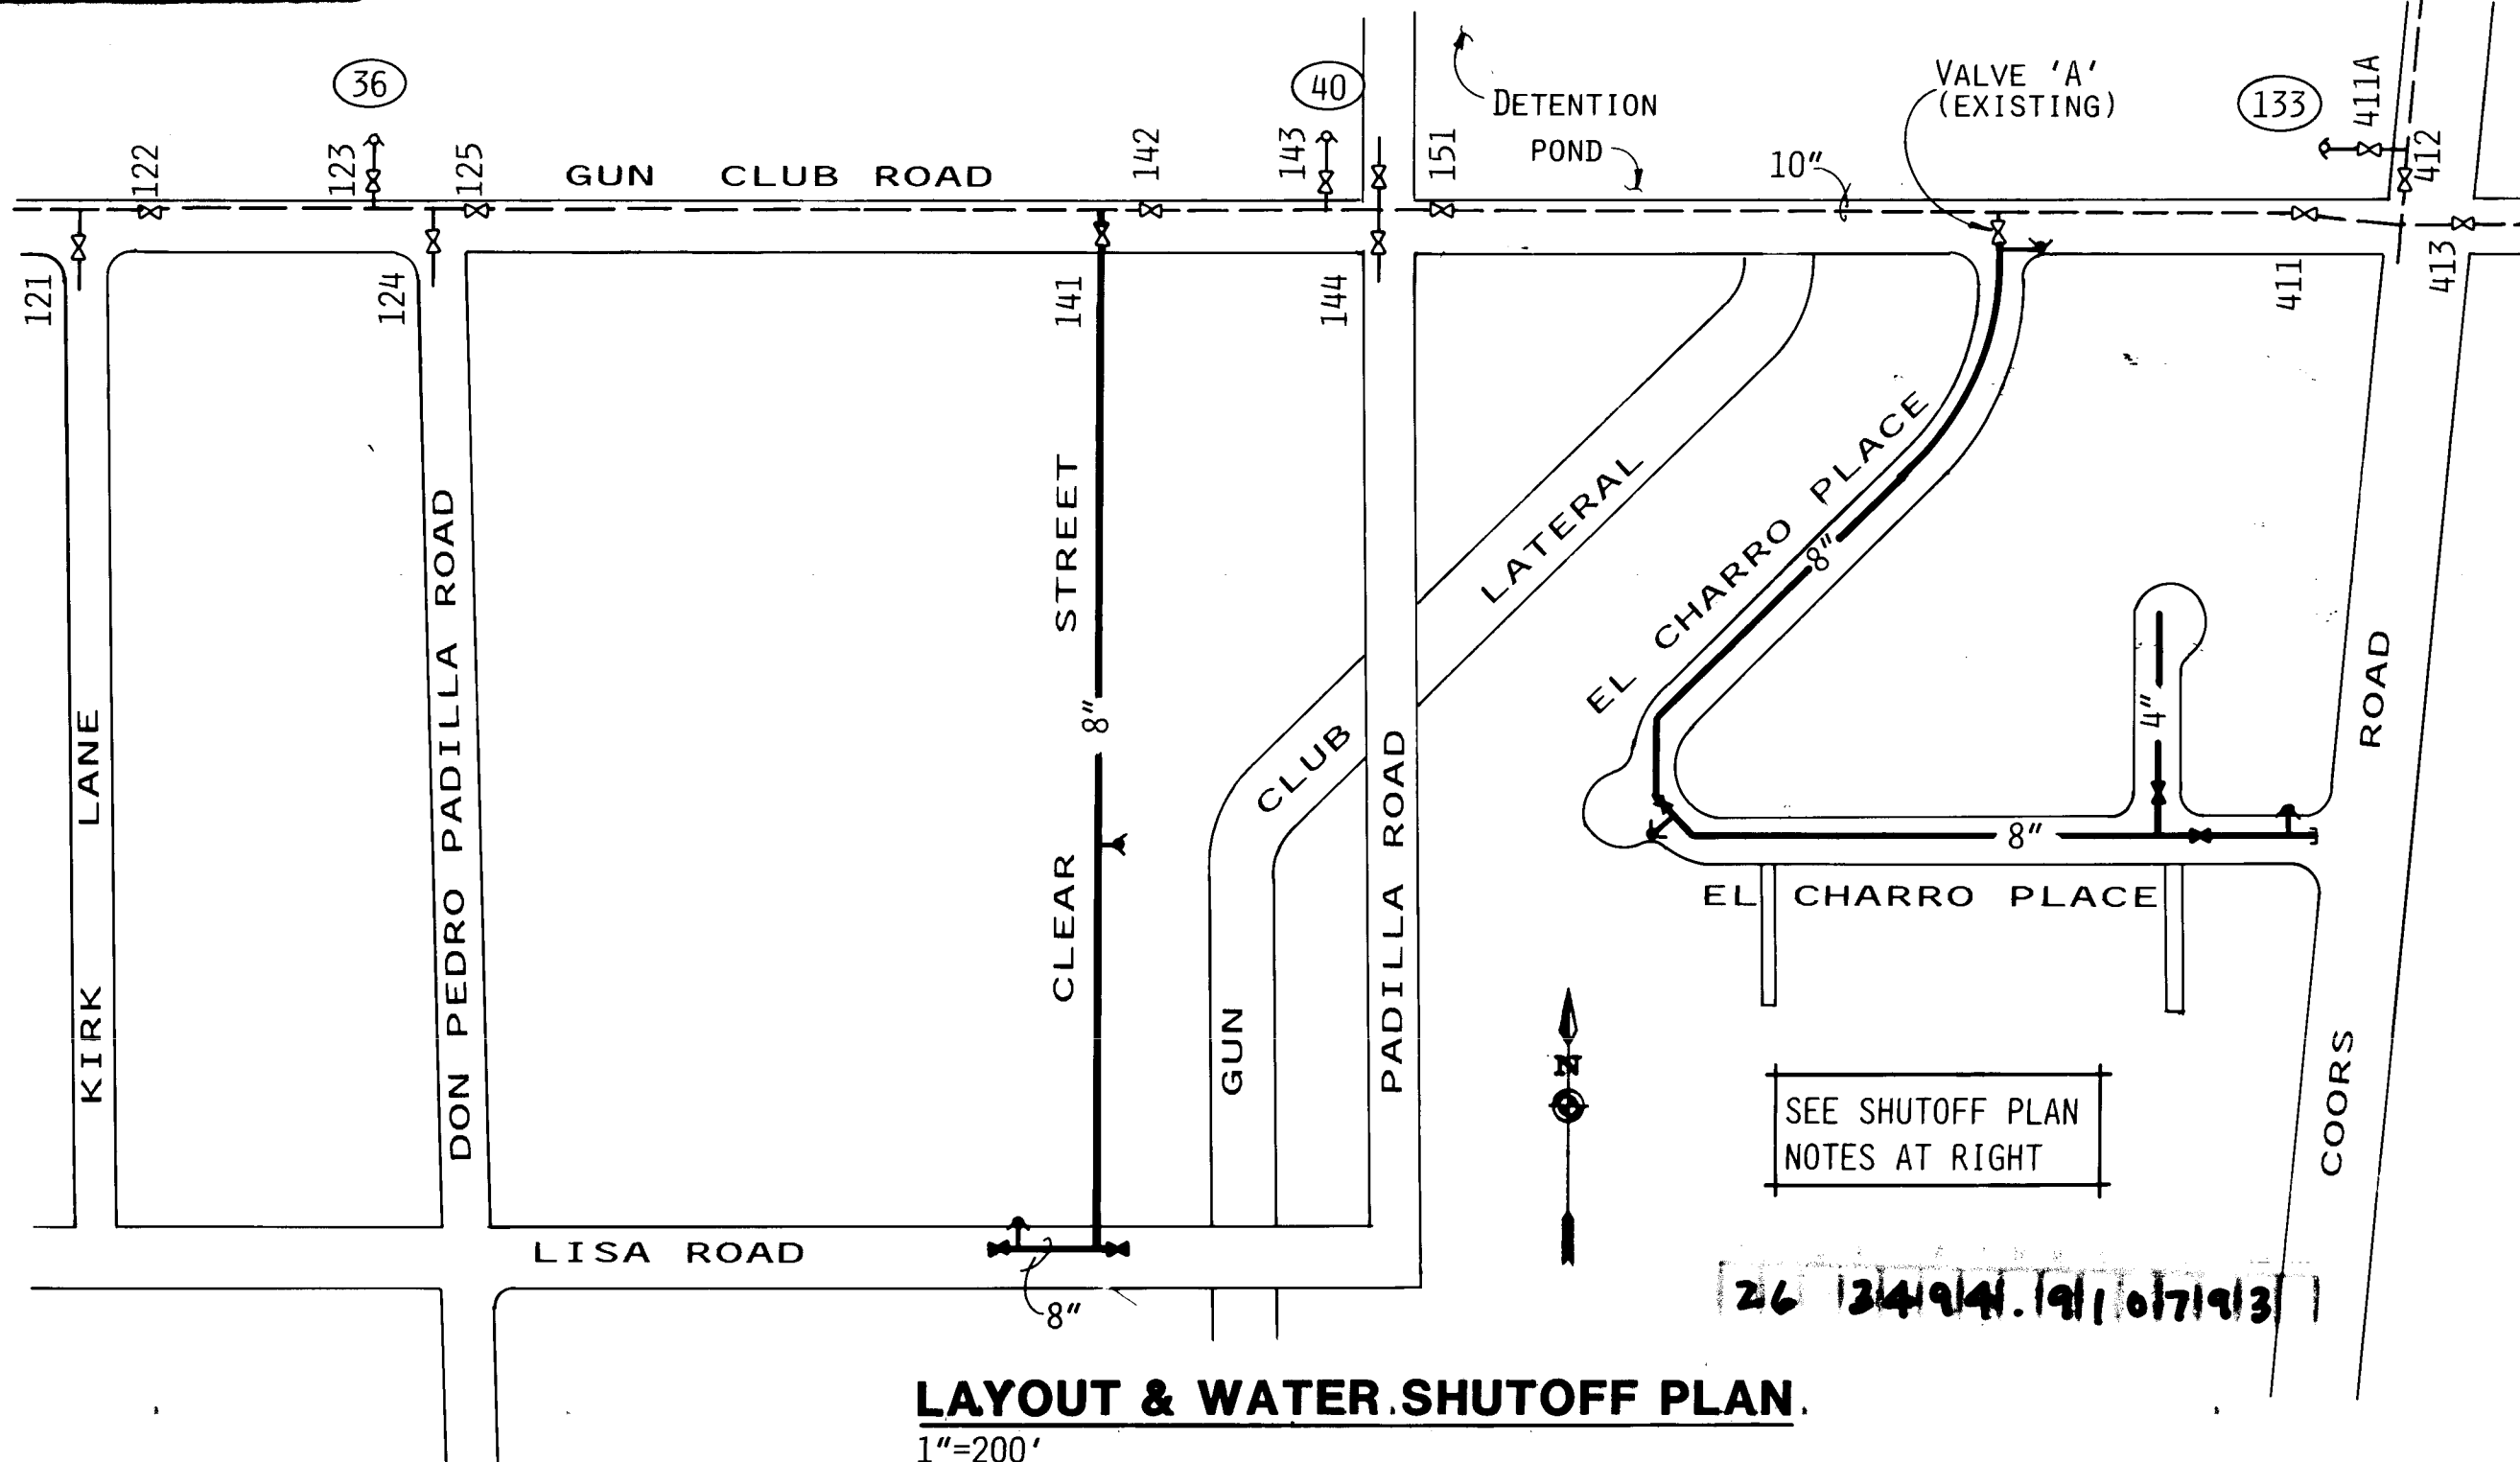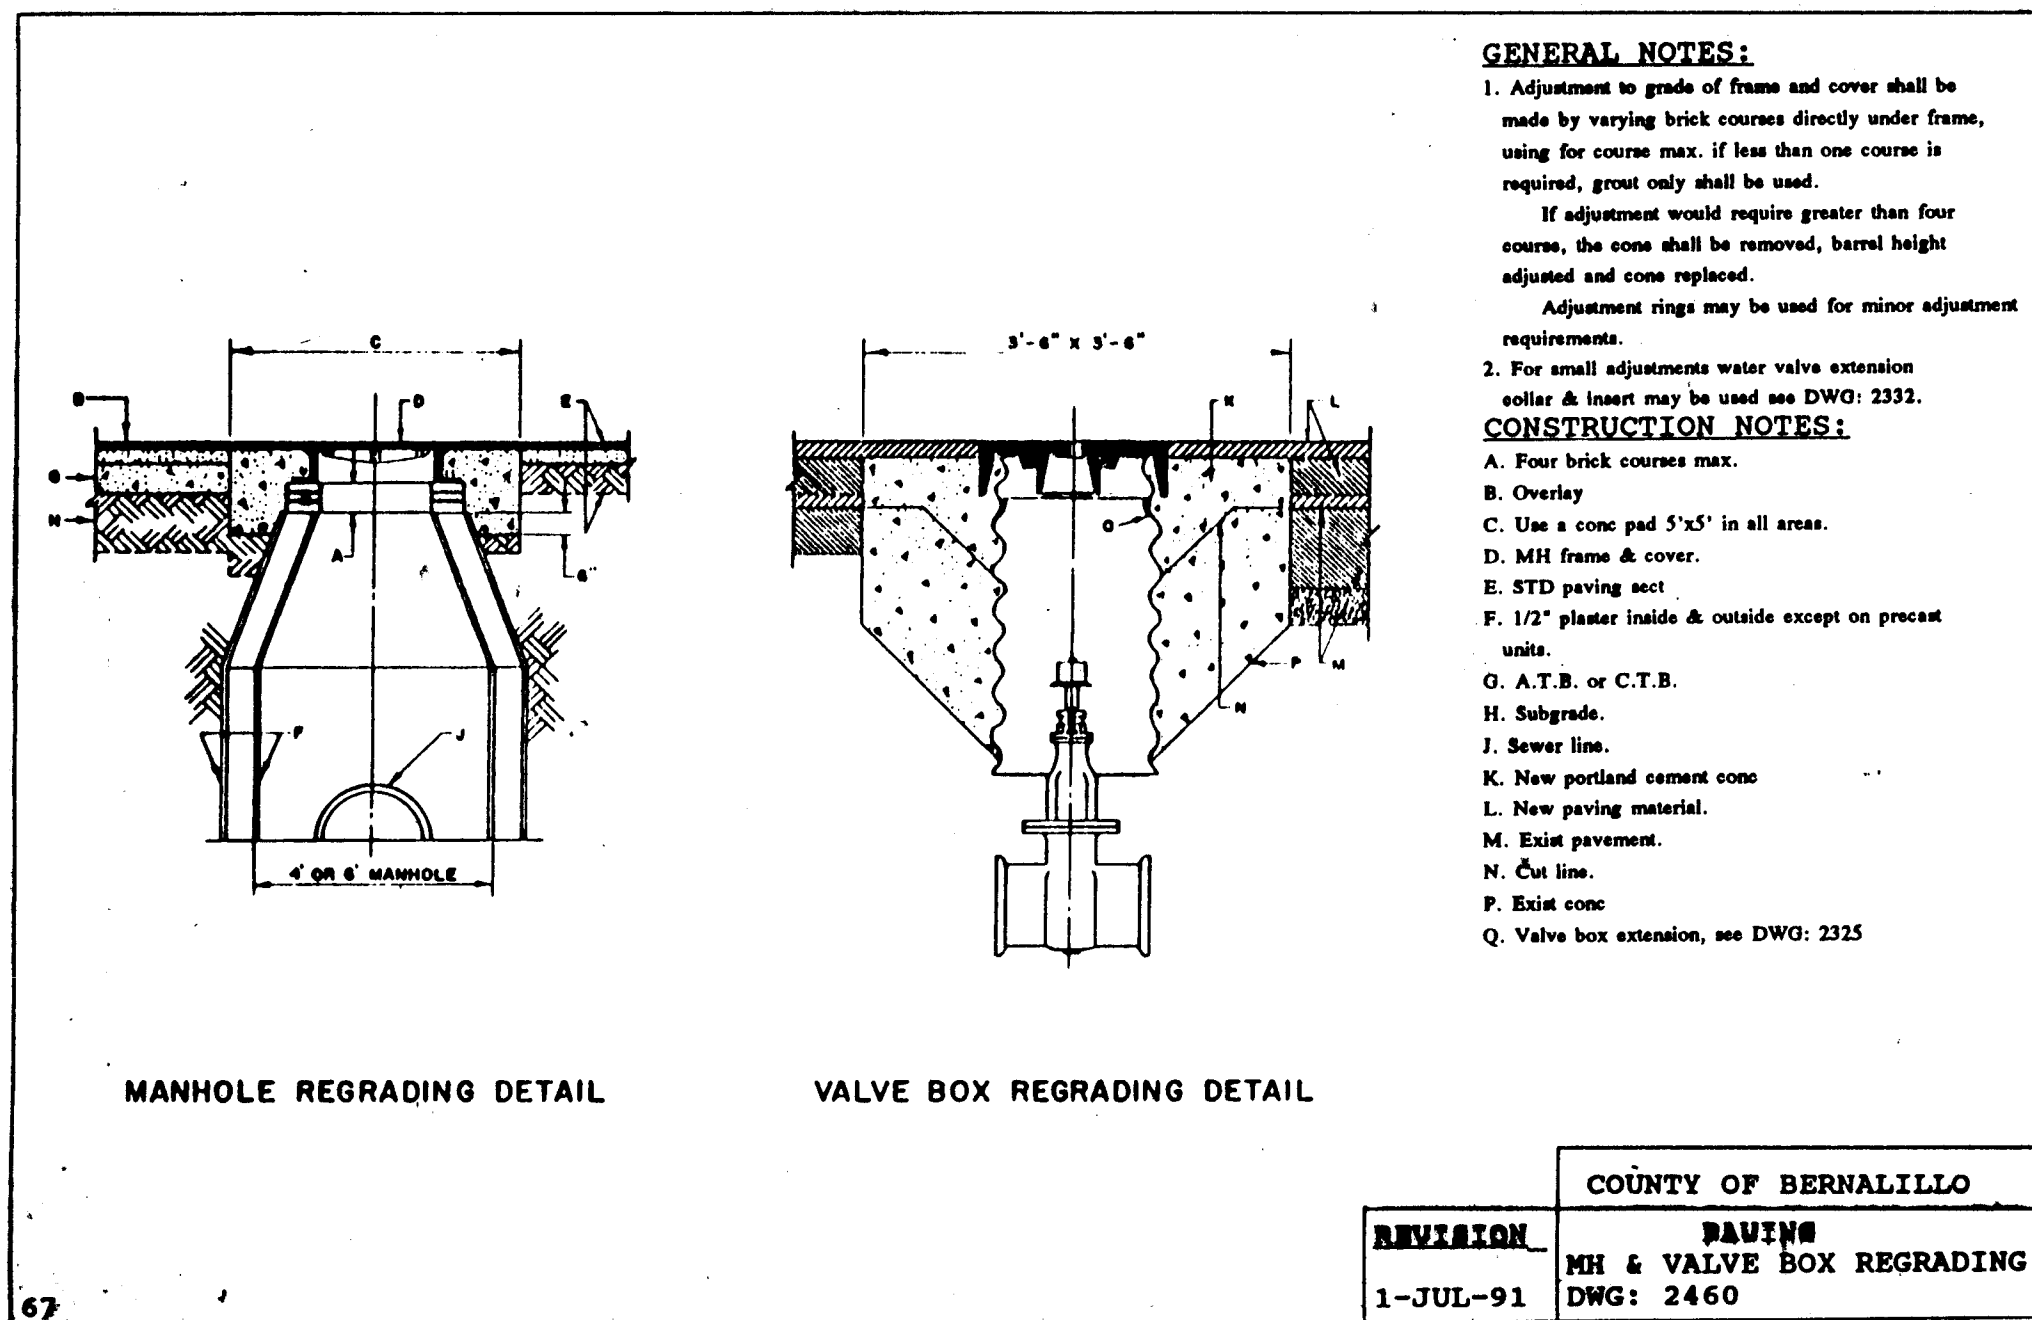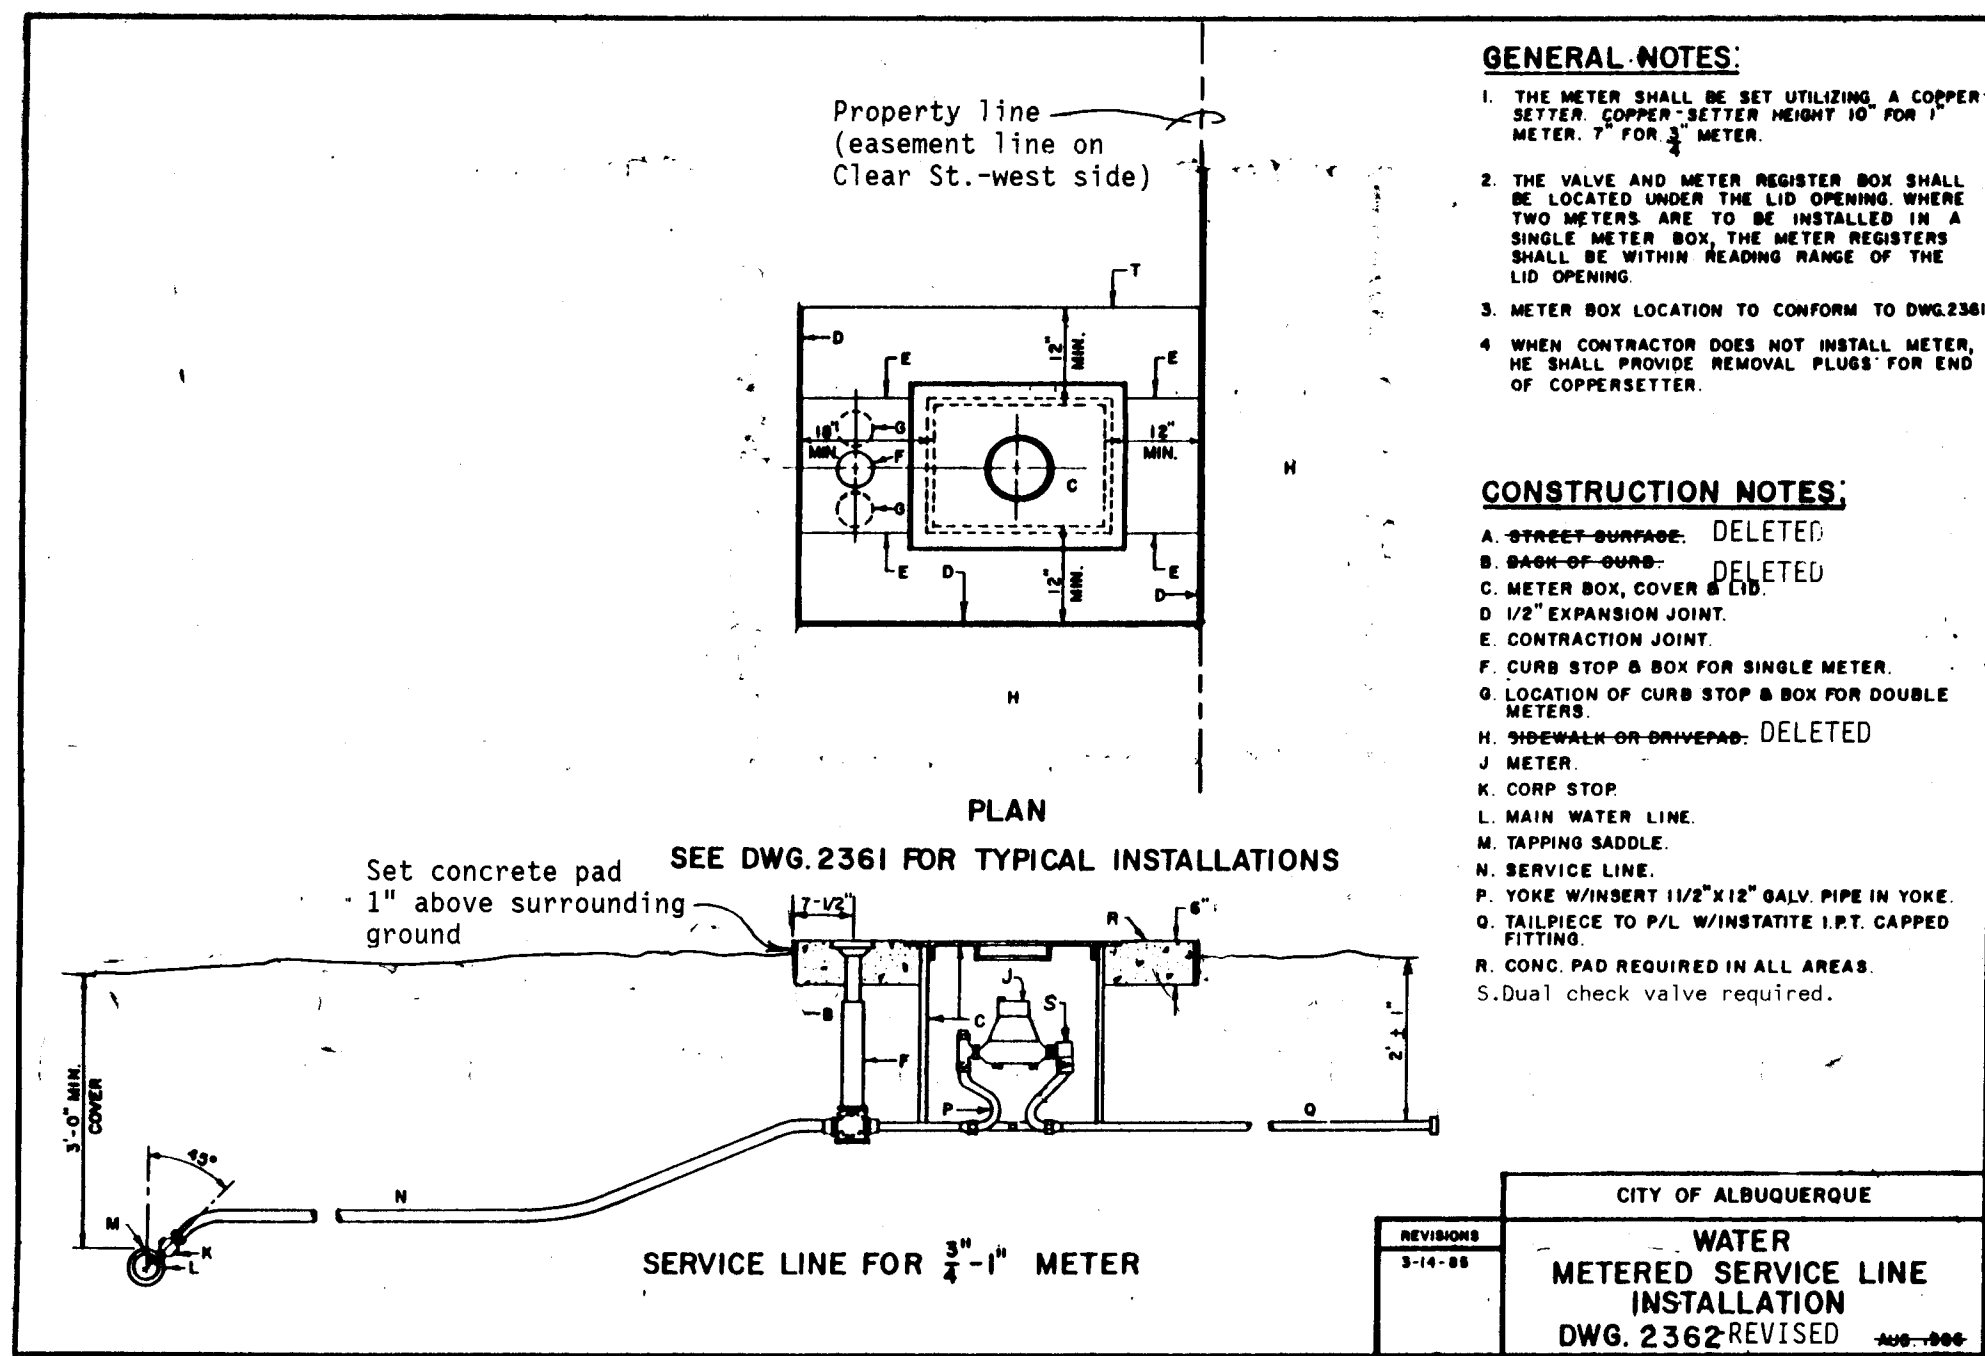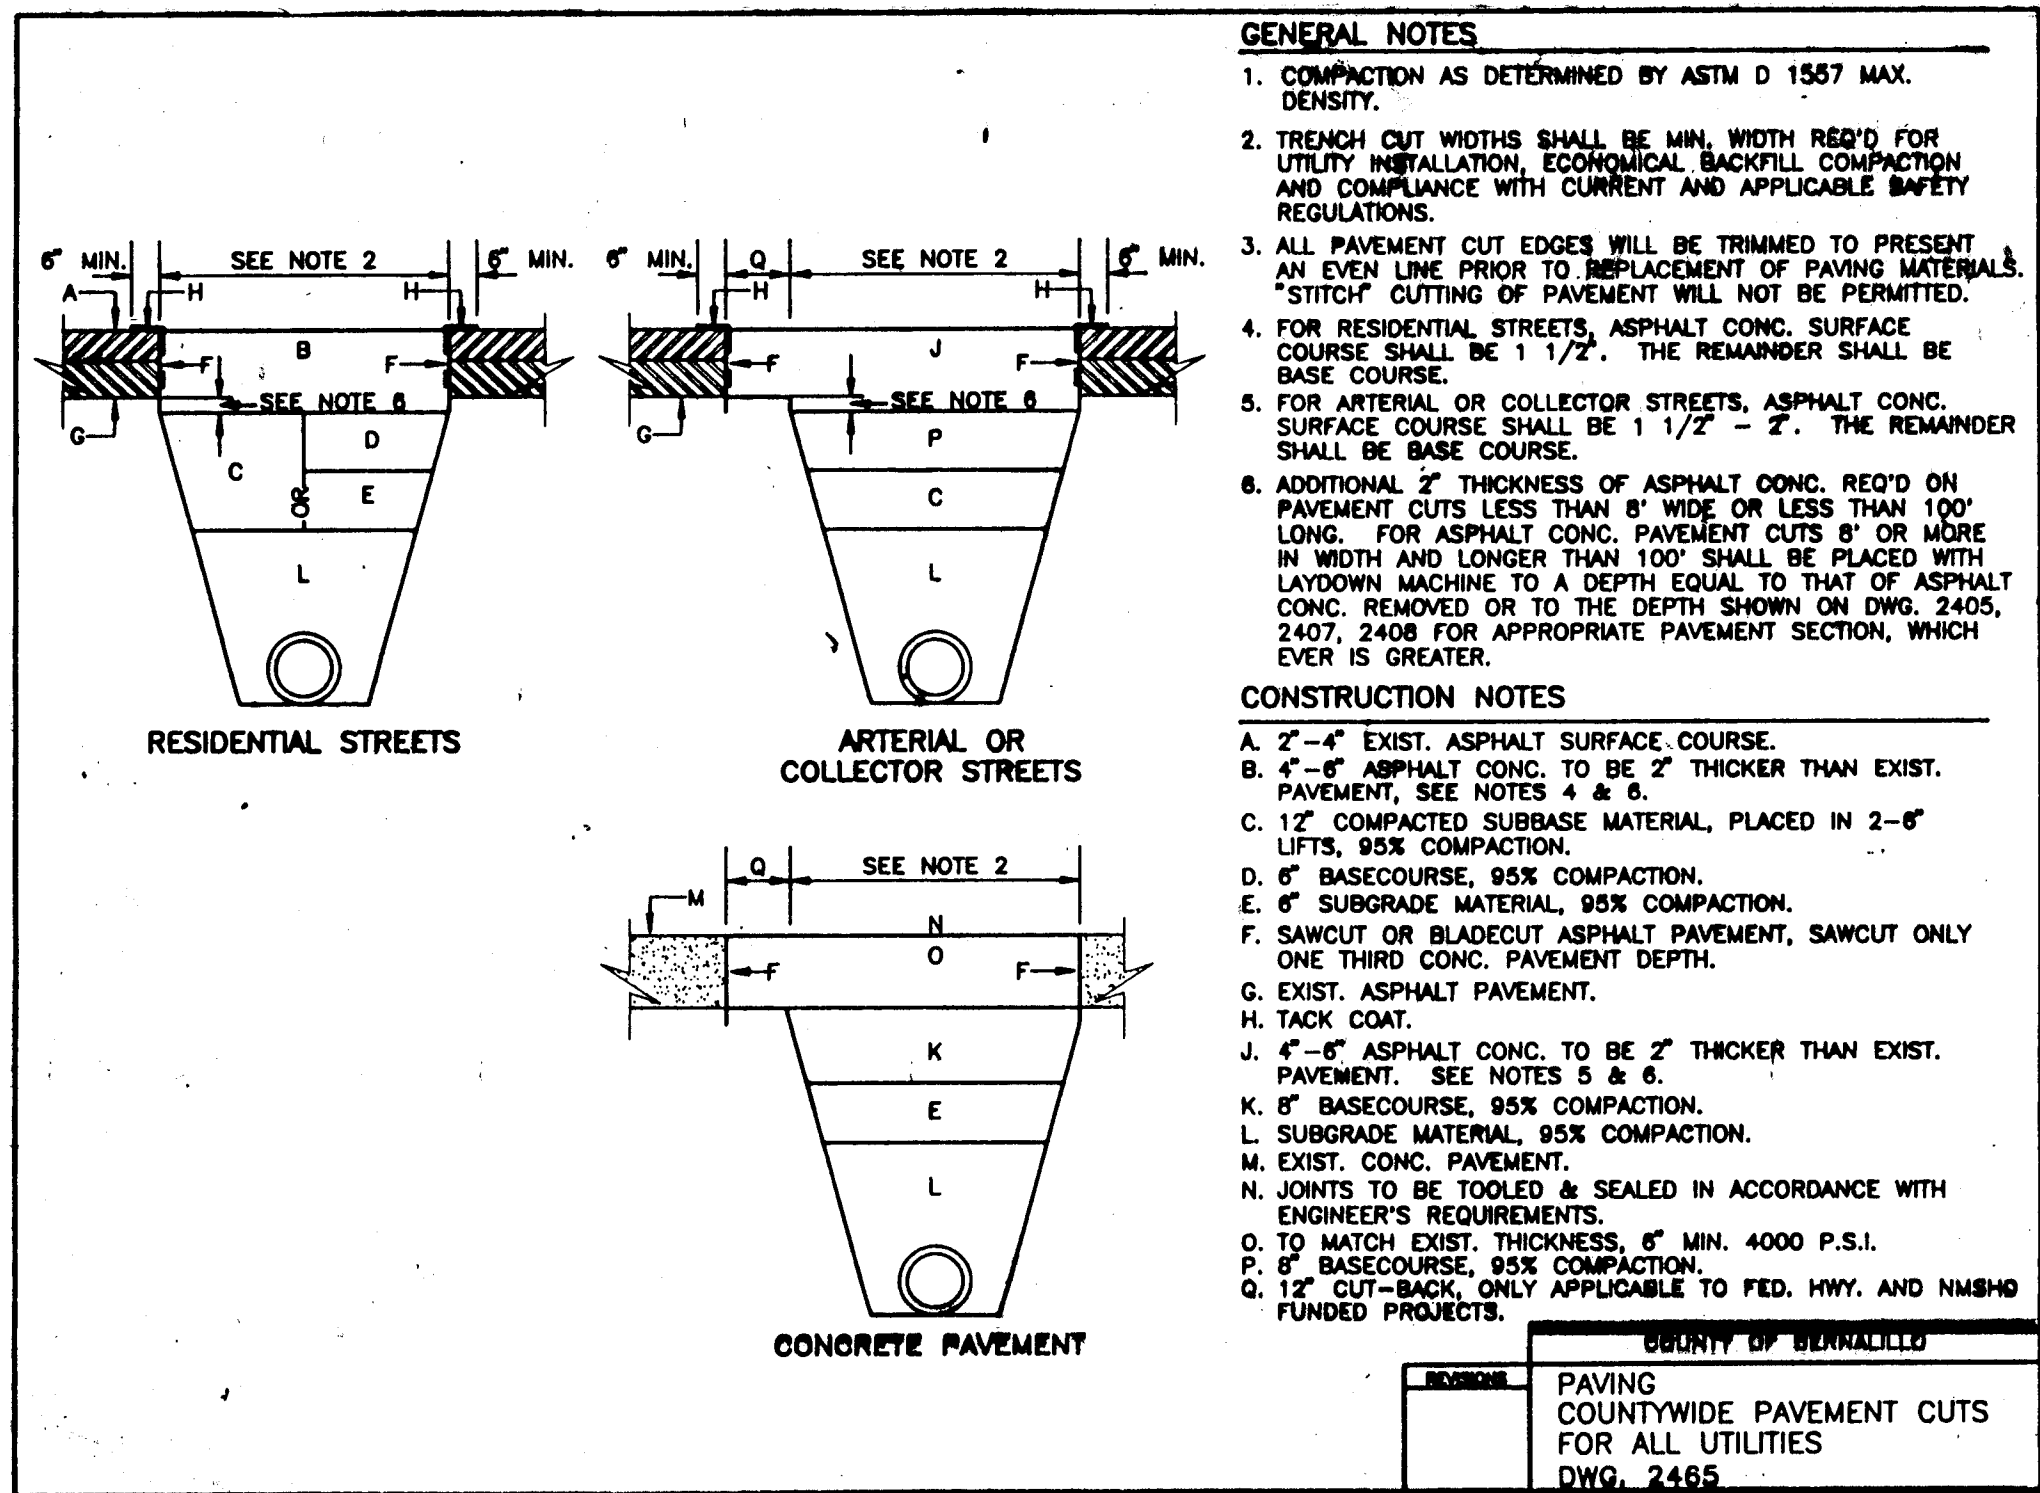CURVATURE DATA FOR PVC PIPE



RECORD DRAWING


WARNING

This is part of a record document. Record documents are based on reports submitted by others. Engineers cannot assure nor assume any responsibility or liability for the accuracy of record documents. Users of record documents are cautioned and advised to obtain independent verification of actual conditions.


WATER SHUTOFF PLAN & RELATED WORK

- EXISTING 10" LINE IN GUN CLUB ROAD IS "DRY" FROM VALVE #411 (NEAR COORS) TO THE WEST. THIS SYSTEM HAS BEEN CHLORINATED, PRESSURE TESTED, FLUSHED AND DRAINED IN 1990.
- PRIOR TO PRESSURIZING THE NEW LINES CONSTRUCTED UNDER THIS CONTRACT, THE CONTRACTOR SHALL THOROUGHLY FLUSH THE EXISTING 10" LINE BETWEEN VALVES #411 & #122. (KIRK LANE) WATER MAY BE DISPOSED IN DETENTION POND LOCATED AT THE NORTHEAST CORNER OF GUN CLUB & PADILLA.
- VALVE BOX COVER FOR VALVE #411 HAS BEEN TACK-WELDED CLOSED. CONTRACTOR TO REMOVE WELDS FOR ACCESS TO VALVE.
- VALVES #122 & #124 TO BE CLOSED. CONTRACTOR SHALL TACK WELD VALVE BOX COVERS TO PREVENT UNAUTHORIZED ENTRY AFTER VALVE IS CLOSED.
- CONTRACTOR SHALL NOTIFY WATER SYSTEMS DIVISION (857-8200) 3 WORKING DAYS PRIOR TO PRESSURIZING GUN CLUB ROAD LINE (BETWEEN VALVES #411 & #122).
- VALVES MAY ONLY BE OPERATED BY CITY WATER SYSTEM CREWS.
- CLOSE VALVES 'A' & #141 TO PRESSURE TEST NEW LINES.
- ALL WORK DESCRIBED IN THESE NOTES IS INCIDENTAL TO NEW WATER LINE WORK COSTS & NO EXTRA PAYMENT SHALL BE MADE.


| | | | | | |
|---|----------|-------------|-----------|----------|------|
| CITY OF ALBUQUERQUE PUBLIC WORKS DEPARTMENT ENGINEERING GROUP | | | | | |
| TITLE: Adobe Acres/Lakeview Waterlines | | | | | |
| DETAILS | | | | | |
| APPROVALS | ENGINEER | DATE | APPROVALS | ENGINEER | DATE |
| D.R.C. Chair | 2-4-92 | Water | ADG | 1-24-92 | |
| Trans. Dev. | N/A | Waste Water | ADG | | |
| Hydrology | N/A | | | | |
| PROJECT NO. 3494.96 MAP NO. SHEET 7 OF 8 | | | | | |

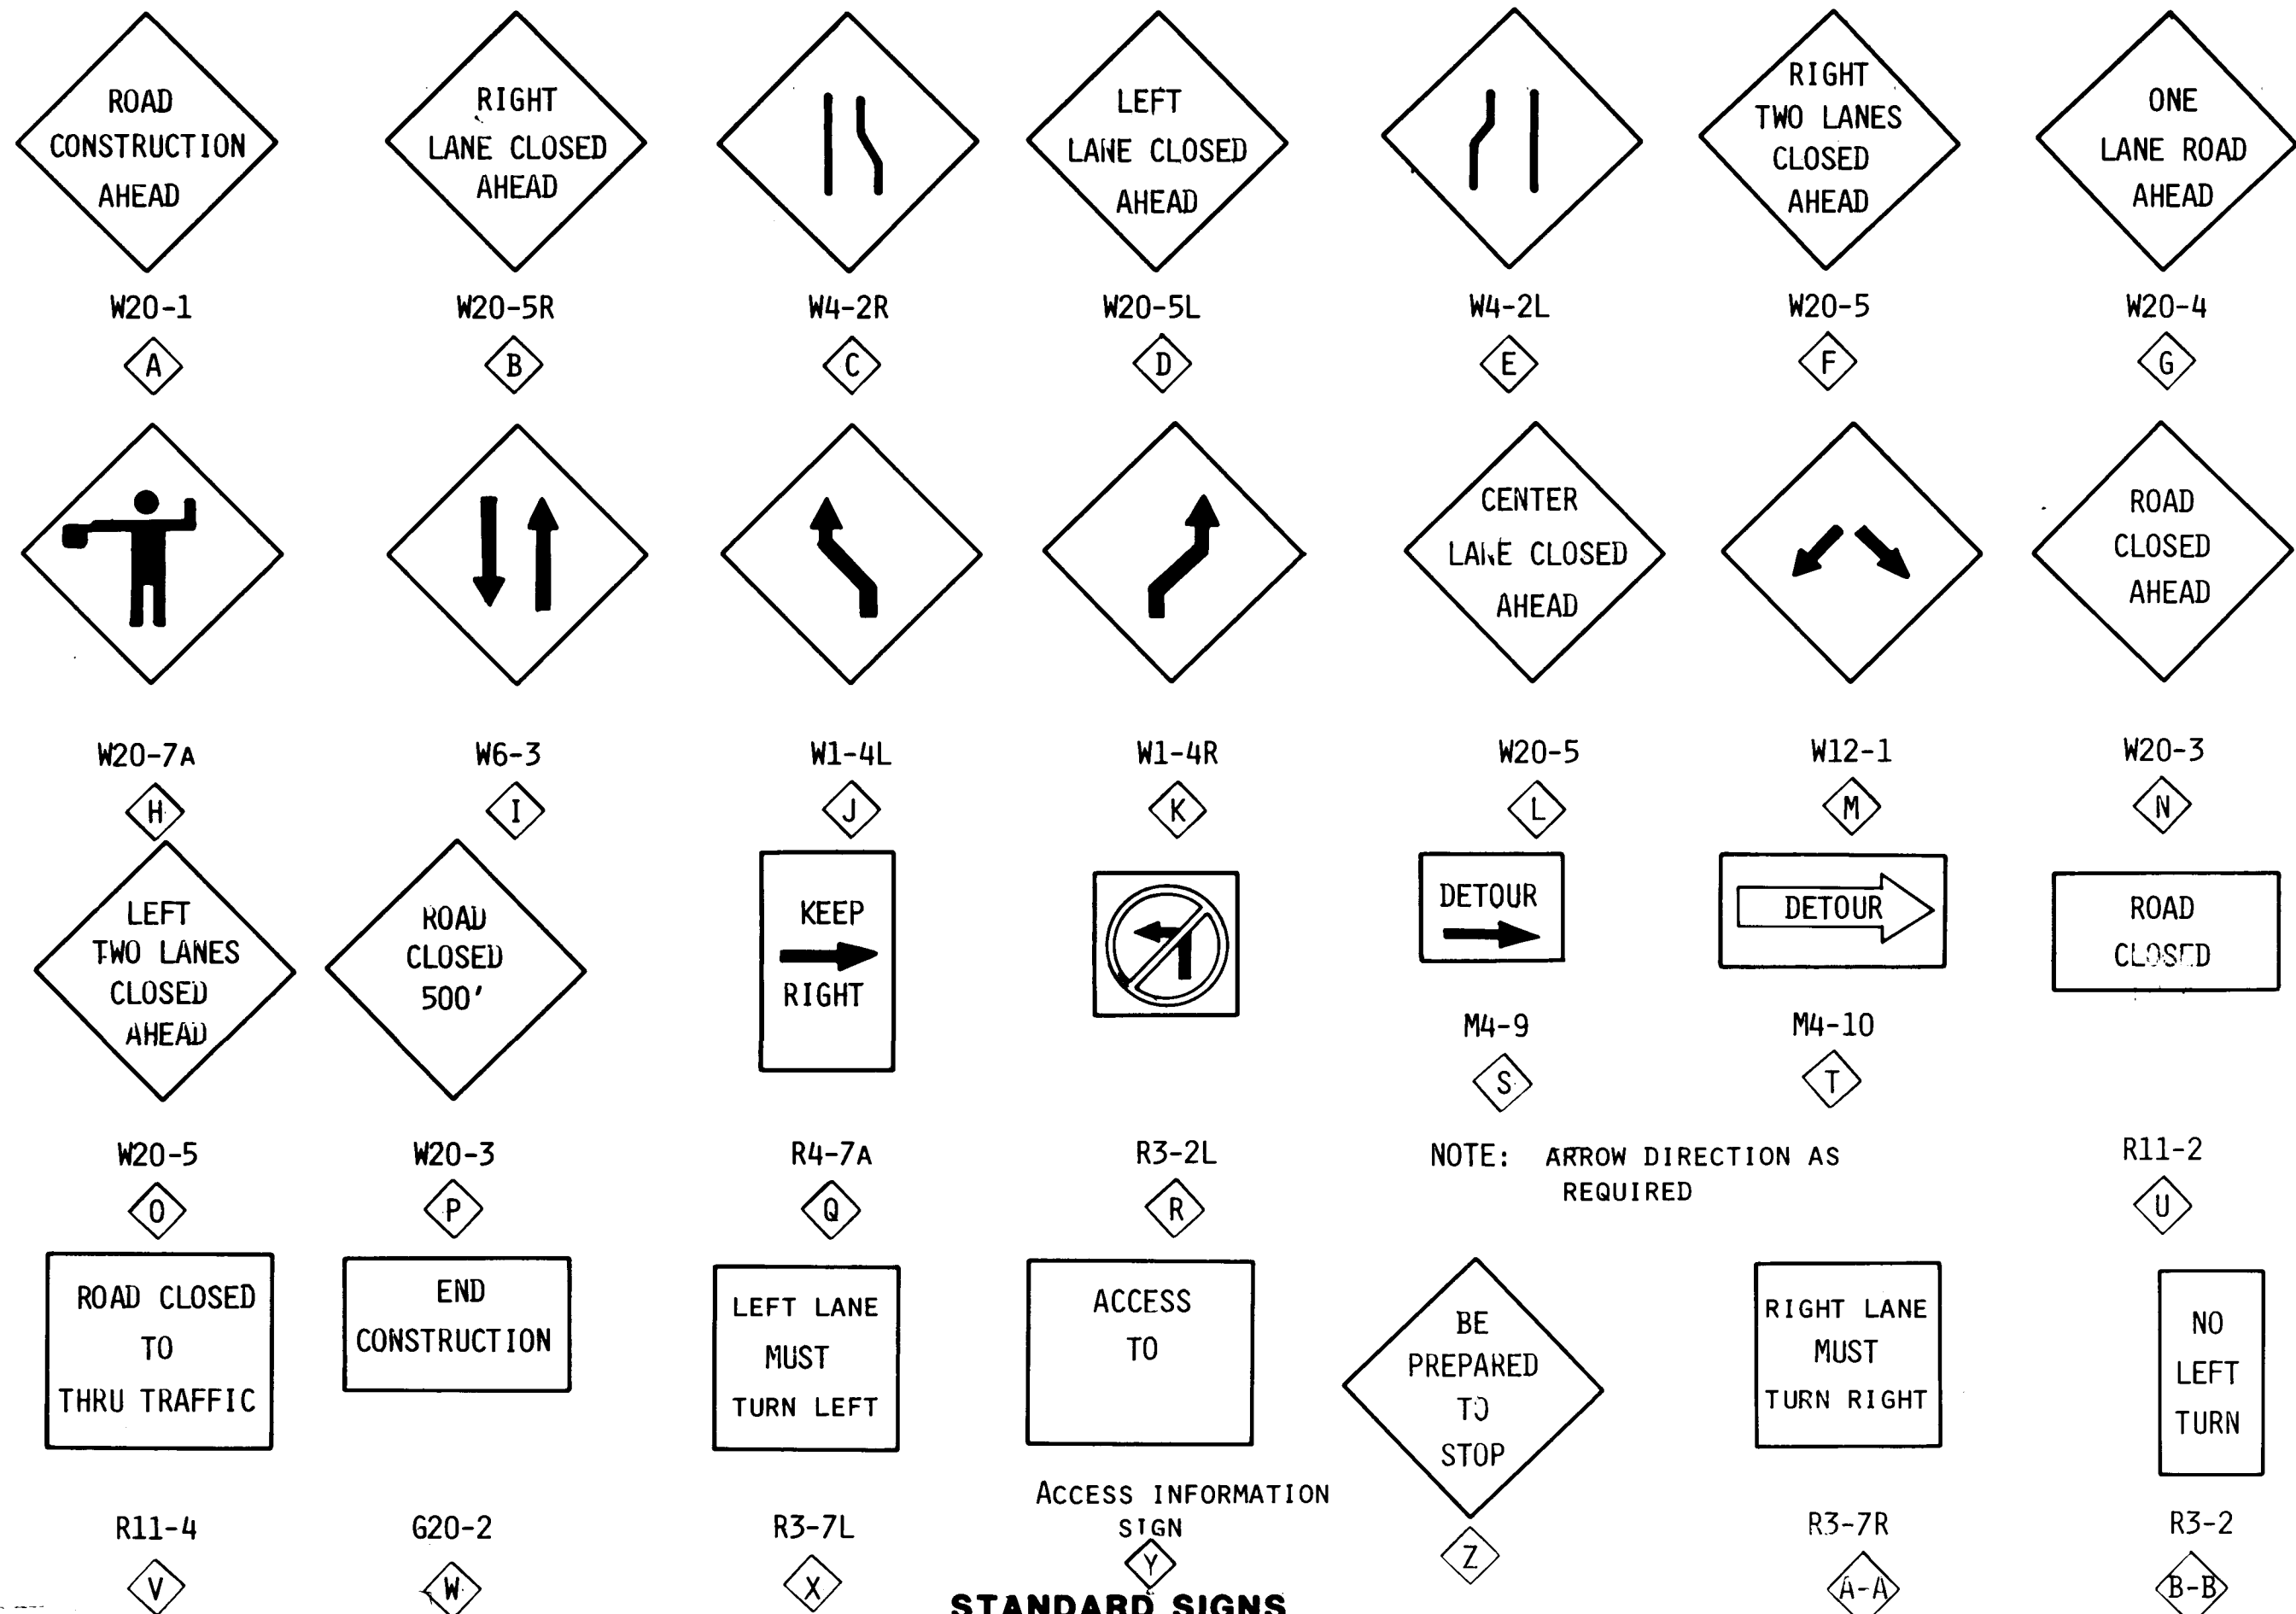

STANDARD SIGNS
NO SCALE

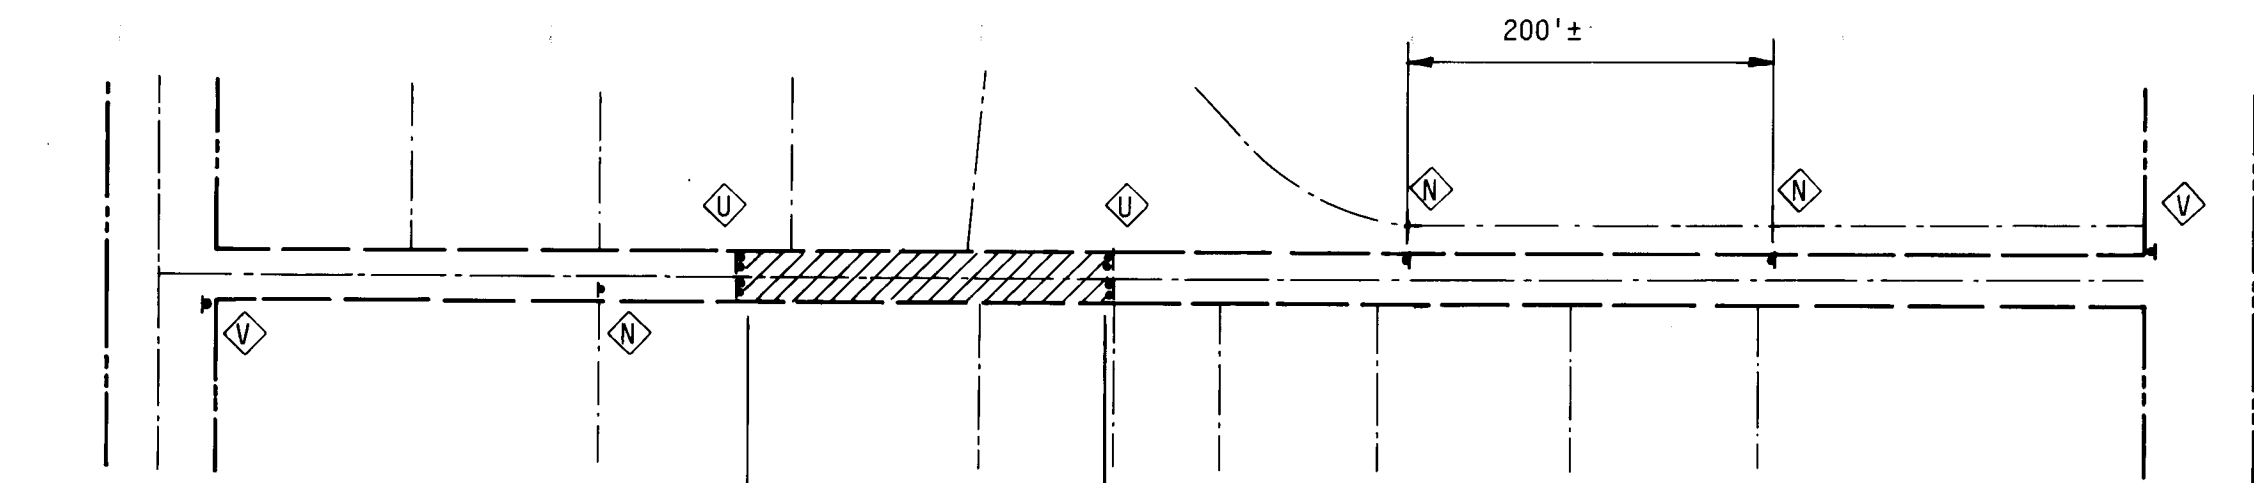

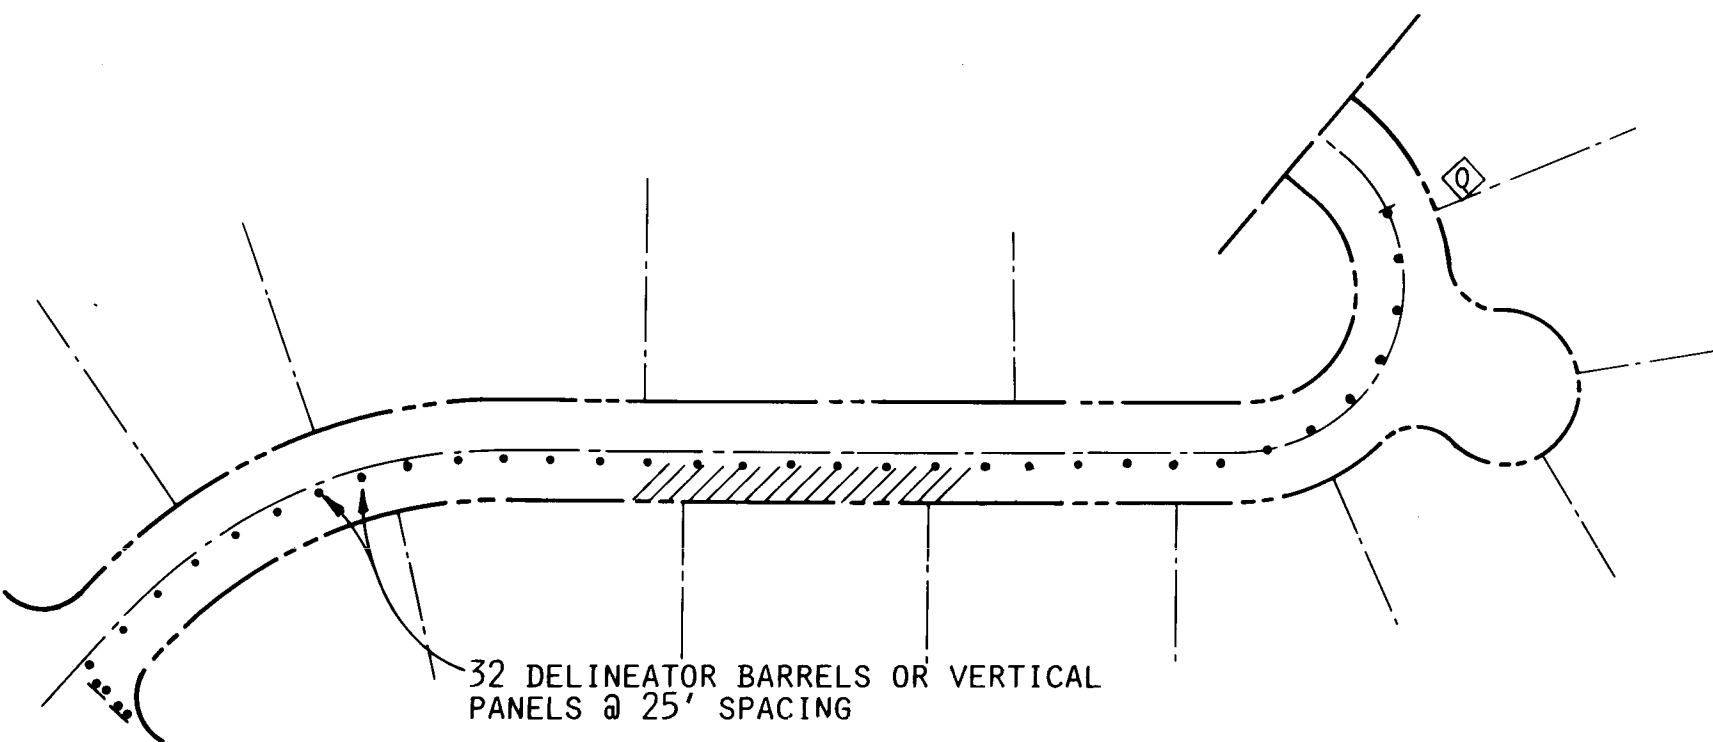CLEAR STREET (25' PRIVATE ROAD)
NO SCALE




EL CHARRO PLACE - NORTH PORTION
NO SCALE

| TAPER REQUIREMENTS | | | | | |
|--------------------|---------------------|----------|----------|---|------------------------------------|
| SPEED LIMIT (MPH) | TAPER LENGTH (FEET) | | | MAXIMUM DISTANCE BETWEEN DEVICES (FEET) | MINIMUM NUMBER OF DEVICES REQUIRED |
| | 10' LANE | 11' LANE | 12' LANE | | |
| 25 | 104 | 115 | 125 | 25 | 6 |
| 30 | 150 | 165 | 185 | 30 | 7 |
| 35 | 204 | 225 | 245 | 35 | 8 |
| 40 | 267 | 293 | 320 | 40 | 9 |
| 45 | 450 | 495 | 540 | 45 | 13 |
| 50 | 500 | 550 | 600 | 50 | 13 |
| 55 | 550 | 605 | 660 | 55 | 13 |

- LEGEND
- WORK AREA
 - TRAFFIC SIGN & QUANTITY (SEE THIS SHEET FOR DESIGNATION)
 - BARRICADE-TYPE I, TYPE II, OR BARREL
 - BARRICADE-TYPE III
 - VERTICAL PANEL
 - WARNING SIGN
 - DISTANCE BETWEEN SIGNS-A DISTANCE MEASURED IN FEET EQUAL TO A VALUE OF TEN TIMES THE SPEED LIMIT OF THE STREET
 - SPACING BETWEEN BARRICADES-A DISTANCE MEASURED IN FEET EQUAL TO THE SPEED LIMIT OF THE STREET

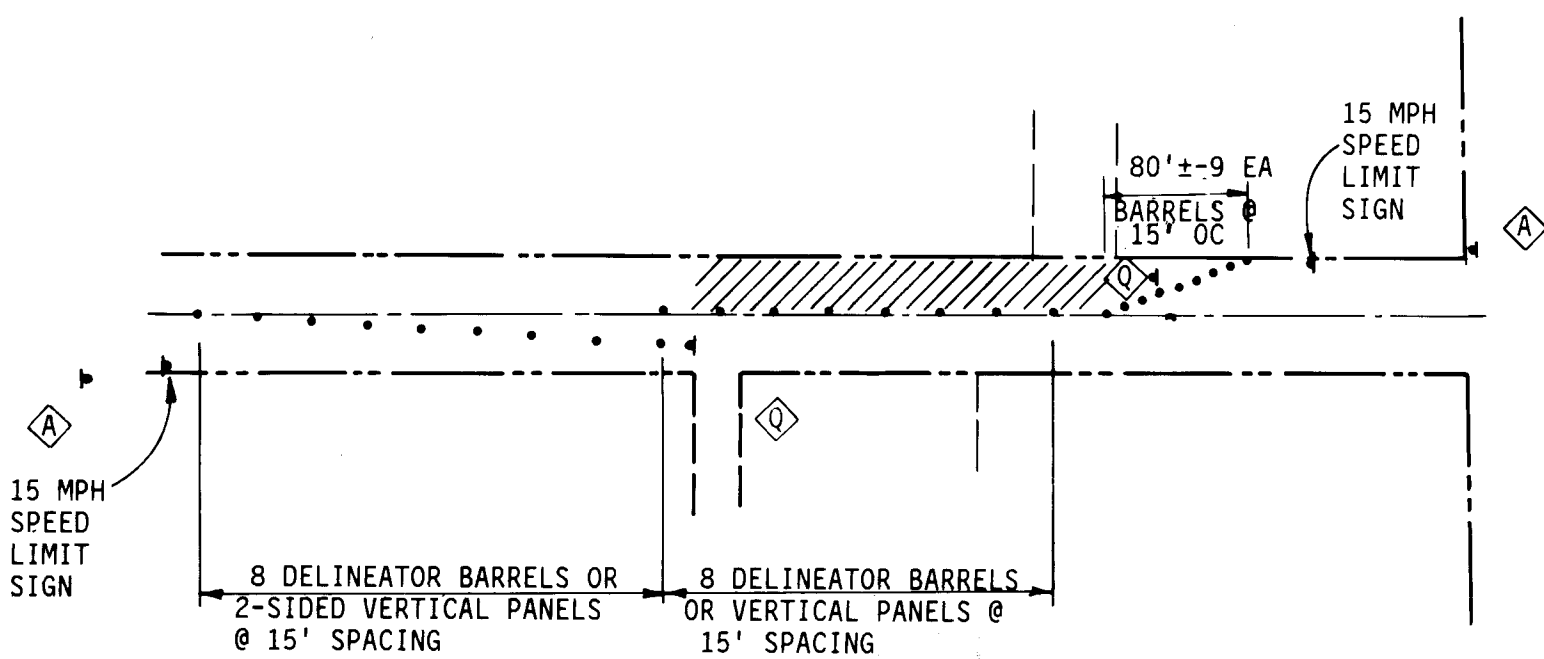
TAPER LENGTH-SEE CHART ABOVE
TANGENT LENGTH-IS EQUAL TO THE TAPER LENGTH FOR A GIVEN STREET



LISA ROAD
NO SCALE

RECORD DRAWING

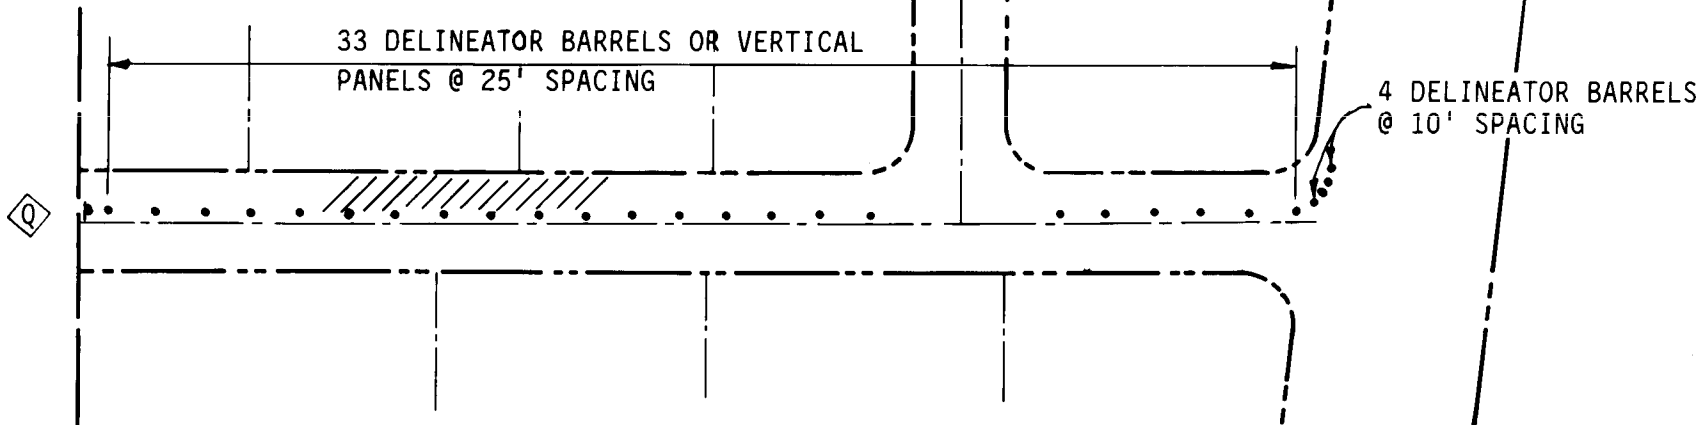WARNING
This is part of a record document. Record documents are based on reports submitted by others. Engineers cannot assure nor assume any responsibility or liability for the accuracy of record documents. Users of record documents are cautioned and advised to obtain independent verification of actual conditions.



EL CHARRO PLACE - EAST PORTION
NO SCALE

- NMSH & TD NOTES
- TRAFFIC CONTROL SHALL BE IN ACCORDANCE WITH THE MANUAL ON UNIFORM TRAFFIC CONTROL DEVICES FOR STREETS AND HIGHWAYS.

- GENERAL NOTES
- CONTRACTOR SHALL ADHERE TO SECTION 19 OF THE GENERAL CONDITIONS OF THE CITY OF ALBUQUERQUE STANDARD SPECIFICATIONS FOR PUBLIC WORKS CONSTRUCTION.
 - ACCESS TO EACH PRIVATE RESIDENCE OR BUSINESS AFFECTED BY THE CONSTRUCTION OF THIS PROJECT SHALL BE MAINTAINED AT ALL TIMES.
 - CONTRACTOR'S HOURS OF OPERATION SHALL BE BETWEEN THE HOURS OF 8:30 AM AND 4:00 PM, SEVEN (7) DAYS A WEEK ON ALL COLLECTOR AND ARTERIAL ROADS.
 - CONTRACTOR MUST MAINTAIN TWO WAY TRAFFIC ON COLLECTOR AND ARTERIAL ROADS.
 - DELETED.
 - DELETED.
 - WHEN CROSSING A PAVED STREET, CONTRACTOR MUST PROVIDE A TEMPORARY DETOUR WHILE ONLY TRAVERSING ONE LANE AT A TIME.
 - IF CONTRACTOR PLACES VEHICLE IN ROADWAY, VEHICLE WILL ONLY OCCUPY ONE LANE, BETWEEN THE HOURS OF 8:30 AM AND 4:00 PM FOR A MAXIMUM OF TWO (2) DAYS.
 - CONTRACTOR SHALL NOT OCCUPY ANY NON-SIGNALIZED INTERSECTION FOR MORE THAN THREE (3) DAYS.
 - DELETED.
 - ON ALL RESIDENTIAL STREETS, ONE LANE OF TRAFFIC MUST BE MAINTAINED AT ALL TIMES.
 - TYPICAL TRAFFIC CONTROL PLANS SHOWN ON THIS SHEET ARE SCHEMATIC. ACTUAL PLANS SHALL BE PREPARED TO SATISFY SECTION 19 OF THE CITY OF ALBUQUERQUE STANDARD SPECIFICATIONS FOR PUBLIC WORKS CONSTRUCTION, AND THE FIELD CONDITION PRESENT AT THE PROJECT SITES, AND SHALL BE SUBMITTED TO BERNALILLO COUNTY PUBLIC WORKS FOR APPROVAL PRIOR TO CONSTRUCTION.
 - CONTRACTOR SHALL OBTAIN NECESSARY BARRICADE PERMIT FROM BERNALILLO COUNTY PUBLIC WORKS DEPARTMENT.

| AS BUILT INFORMATION | | | BENCH MARKS | | | SURVEY INFORMATION | | | ENGINEER'S SEAL | | |
|----------------------|----------|------|-----------------|----------|------|--------------------|----|------|-----------------|----|------|
| CONTRACTOR | DATE | NO. | CONTRACTOR | DATE | NO. | NO. | BY | DATE | NO. | BY | DATE |
| WORKED BY | C. OF A. | DATE | INSPECTED BY | C. OF A. | DATE | NO. | BY | DATE | NO. | BY | DATE |
| ACCEPTANCE BY | DATE | NO. | ACCEPTANCE BY | DATE | NO. | NO. | BY | DATE | NO. | BY | DATE |
| VERIFICATION BY | DATE | NO. | VERIFICATION BY | DATE | NO. | NO. | BY | DATE | NO. | BY | DATE |
| CONTRACTOR | DATE | NO. | CONTRACTOR | DATE | NO. | NO. | BY | DATE | NO. | BY | DATE |
| RECORDED BY | DATE | NO. | RECORDED BY | DATE | NO. | NO. | BY | DATE | NO. | BY | DATE |

26 3494.910893

CITY OF ALBUQUERQUE
PUBLIC WORKS DEPARTMENT
ENGINEERING GROUP

TITLE: Adobe Acres / Lakeview Waterlines
TRAFFIC CONTROL PLAN

| APPROVALS | ENGINEER | DATE | APPROVALS | ENGINEER | DATE |
|--------------|----------|---------|-----------|----------|------|
| D.R.C. Chair | Rogelio | 2-4-92 | | | |
| Trans Dev | NA | | | | |
| Utility Dev | NA | 1-24-92 | | | |

DRAWING NO. 3494.91 MAP NO. SHEET 8 OF 8