

GENERAL NOTES

1. ALL WORK DETAILED ON THESE PLANS TO BE PERFORMED UNDER CONTRACT SHALL, EXCEPT AS OTHERWISE STATED OR PROVIDED FOR HEREON, BE CONSTRUCTED IN ACCORDANCE WITH THE CITY OF ALBUQUERQUE STANDARD SPECIFICATIONS FOR PUBLIC WORKS CONSTRUCTION 1986.
2. PRIOR TO CONSTRUCTION, THE CONTRACTOR SHALL EXCAVATE & VERIFY THE HORIZONTAL AND VERTICAL LOCATIONS OF ALL OBSTRUCTIONS. SHOULD A CONFLICT EXIST, THE CONTRACTOR SHALL NOTIFY THE ENGINEER SO THAT THE CONFLICT CAN BE RESOLVED WITH MINIMUM DELAY.
3. TWO (2) WORKING DAYS PRIOR TO ANY EXCAVATION, CONTRACTOR MUST CONTACT LINE LOCATING SERVICE @ 765-1234 FOR LOCATION OF EXISTING UTILITIES.
4. CONTRACTOR SHALL PROVIDE CONTINUOUS WATER SERVICE TO AFFECTED RESIDENCES & BUSINESSES DURING CONSTRUCTION PERIOD BY INSTALLING A SURFACE "SHOE-FLY" LINE OR SOME OTHER APPROPRIATE MEANS TO MINIMIZE SERVICE DISRUPTION.
5. WATER SYSTEMS SHALL BE CONTACTED @ 823-4200, 3 WORKING DAYS PRIOR TO ANY SHUT-OFFS. ALL SYSTEM SHUT-OFFS SHALL BE AS PER SECTION 18.3 OF THE GENERAL CONDITIONS.
6. ALL UTILITIES AND UTILITY SERVICE LINES SHALL BE INSTALLED PRIOR TO PAVING. THE SURFACE COURSE SHALL BE INSTALLED AFTER FULL APPROVAL AND ACCEPTANCE OF THE UTILITY LINES.
7. PAVEMENT REPLACEMENT AND BACKFILL SHALL BE PER CITY OF ALBUQUERQUE STANDARD DRAWING 2465. CURB AND GUTTER, SIDEWALKS, DRIVEPADS AND CURB RETURNS DAMAGED BY THE CONTRACTOR SHALL BE REPLACED PER CITY STANDARD DRAWINGS 2415, 2430, 2425 AND 2440.
8. THE CONTRACTOR SHALL PROVIDE FOUR PROJECT CONSTRUCTION SIGNS WHICH ARE TO BE MOVED DURING THE PROJECT AT THE DIRECTION OF THE ENGINEER.
9. EXISTING WATER LINES TO BE REPLACED SHALL BE REMOVED & DISPOSED OF EXCEPT WHERE OTHERWISE NOTED ON THE PLANS. THE ENDS OF ABANDONED LINES SHALL BE PLUGGED, VALVES SHALL HAVE THE OPERATING NUT & VALVE CAN REMOVED.
10. ALL WATER LINE REPLACEMENT CONNECTIONS SHALL BE PER CITY OF ALBUQUERQUE STANDARD DRAWING No. 2301.
11. WATER SERVICE LINES, METERS, & BOXES SHALL BE REPLACED, TRANSFERRED, RELOCATED & REHABILITATED AS PER SECTION 802 OF THE TECHNICAL SPECIFICATIONS AND THE PLANS. METER BOX RELOCATIONS SHALL BE AS NOTED ON THE PLANS AS PER STANDARD DRAWINGS 2360 AND 2363.
12. WATER SERVICE LINES SHALL BE REPLACED WHEN THE EXISTING SERVICE LINE IS EITHER GALVANIZED OR LEAD, OR WHEN THE SERVICE LINE MUST BE LENGTHENED TO CONNECT TO THE NEW WATER MAIN PER SECTION 802.4.2 OF THE SPECIFICATIONS.
13. TACK COAT REQUIREMENTS SHALL BE DETERMINED BY THE CITY ENGINEER.
14. IT IS THE CONTRACTOR'S RESPONSIBILITY TO LOCATE AND RECONNECT ALL EXISTING SEWER SERVICE CONNECTIONS PER SECTION 905.6. RECONNECTIONS AND TRANSFERS SHALL BE PAID FOR IN ACCORDANCE WITH THE UNIT PRICE LISTED ON THE BID PROPOSAL. HOWEVER, THOSE CONNECTIONS DAMAGED WHILE PERFORMING THE WORK UNDER THIS PROJECT SHALL BE REPLACED AT NO ADDITIONAL COST TO THE CITY.
15. ALL SANITARY SEWER MANHOLES SHALL BE BUILT IN ACCORDANCE WITH THE CITY OF ALBUQUERQUE STANDARD DRAWING 2102. ALL SANITARY SEWER MANHOLES SHALL BE 4 FEET IN DIAMETER UNLESS OTHERWISE NOTED.
16. ON EXISTING SEWER MANHOLES THAT ARE TO BE ABANDONED IN PLACE, REMOVE AND RETURN THE EXISTING RING AND COVER AND ABANDON THE MANHOLE AS PER SECTION 920.6.
17. CONTRACTOR SHALL SUPPORT ALL EXISTING, UNDERGROUND UTILITY LINES WHICH BECOME EXPOSED DURING CONSTRUCTION. PAYMENT FOR SUPPORTING WORK SHALL BE INCIDENTAL TO WATERLINE AND/OR SEWERLINE COSTS.
18. ALL EXISTING SANITARY SEWER LINES ARE CONCRETE PIPE EXCEPT WHERE NOTED OTHERWISE ON THE PLANS.
19. THE CONTRACTOR IS HEREBY NOTIFIED OF THE POSSIBILITY OF ELECTRICAL SHOCK WHEN WORKING NEAR EXISTING STEEL LINES. PRECAUTIONS SHALL BE TAKEN TO GROUND ANY STRAY CURRENTS BEFORE SEPARATING STEEL PIPES.
20. NO SEPARATE PAYMENT WILL BE MADE FOR EXPANSION JOINT MATERIAL NOTED ON THE PLANS. THIS WILL BE CONSIDERED INCIDENTAL TO WATERLINE CONSTRUCTION.

WARNING - EXISTING UTILITY LINE LOCATIONS ARE SHOWN IN AN APPROXIMATE MANNER ONLY, AND SUCH LINES MAY EXIST WHERE NONE ARE SHOWN. THE LOCATION OF ANY SUCH EXISTING LINES IS BASED UPON INFORMATION PROVIDED BY THE UTILITY COMPANY, THE OWNER, OR BY OTHERS, AND THE INFORMATION MAY BE INCOMPLETE OR MAY BE OBSOLETE BY THE TIME CONSTRUCTION COMMENCES.

THE ENGINEER HAS UNDERTAKEN NO FIELD VERIFICATION OF THE LOCATION, DEPTH, SIZE, OR TYPE OF EXISTING UNDERGROUND UTILITY LINES, MAKES NO REPRESENTATION PERTAINING THERETO, AND ASSUMES NO RESPONSIBILITY OR LIABILITY THEREFOR. THE CONTRACTOR SHALL INFORM ITSELF OF THE LOCATION OF ANY UTILITY LINE IN OR NEAR THE AREA OF THE WORK IN ADVANCE OF AND DURING EXCAVATION WORK. THE CONTRACTOR IS FULLY RESPONSIBLE FOR ANY AND ALL DAMAGE CAUSED BY ITS FAILURE TO LOCATE, IDENTIFY, AND PRESERVE ANY AND ALL EXISTING UTILITIES. THE CONTRACTOR SHALL COMPLY WITH STATE STATUTES, MUNICIPAL AND LOCAL ORDINANCES, RULES AND REGULATIONS PERTAINING TO THE LOCATION OF THESE LINES AND FACILITIES, IN PLANNING AND CONDUCTING EXCAVATION, WHETHER BY CALLING OR NOTIFYING THE UTILITIES, COMPLYING WITH "BLUE STAKES" PROCEDURES, OR OTHERWISE.

FY 1988-1989

WATER & SEWER LINE

RENEWAL PROGRAM

AREA II

CONSTRUCTION PLANS
FOR
PUBLIC WORKS DEPARTMENT
CITY OF ALBUQUERQUE



TABLE OF CONTENTS

DESCRIPTION	SHEET NO.
TITLE SHEET & VICINITY MAP	1
LOCATION MAP	2
WATER & SEWER PLAN AND PROFILE SHEETS	3 - 21
WATER VALVE SHUT-OFF PLANS	22
DETAIL SHEET	23
TRAFFIC CONTROL	24

LEGEND

CI	CAST IRON
S,ST	STEEL
PVC	POLYVINYL CHLORIDE
SAS	SANITARY SEWER
SD	STORM DRAIN
o PP	POWER POLE
OHE	OVERHEAD ELECTRIC
HPG	HIGH PRESSURE GAS
EXT	EXISTING
2513	STREET ADDRESS
R&D	REMOVE & DISPOSE
R&R	REMOVE & REPLACE
FL EL	FLANGE ELEVATION
□	WATER METER BOX
→	INDICATES VALVE TO BE CLOSED


C of A PWD Plans & Records
26 35 030 193

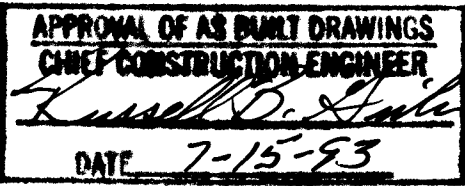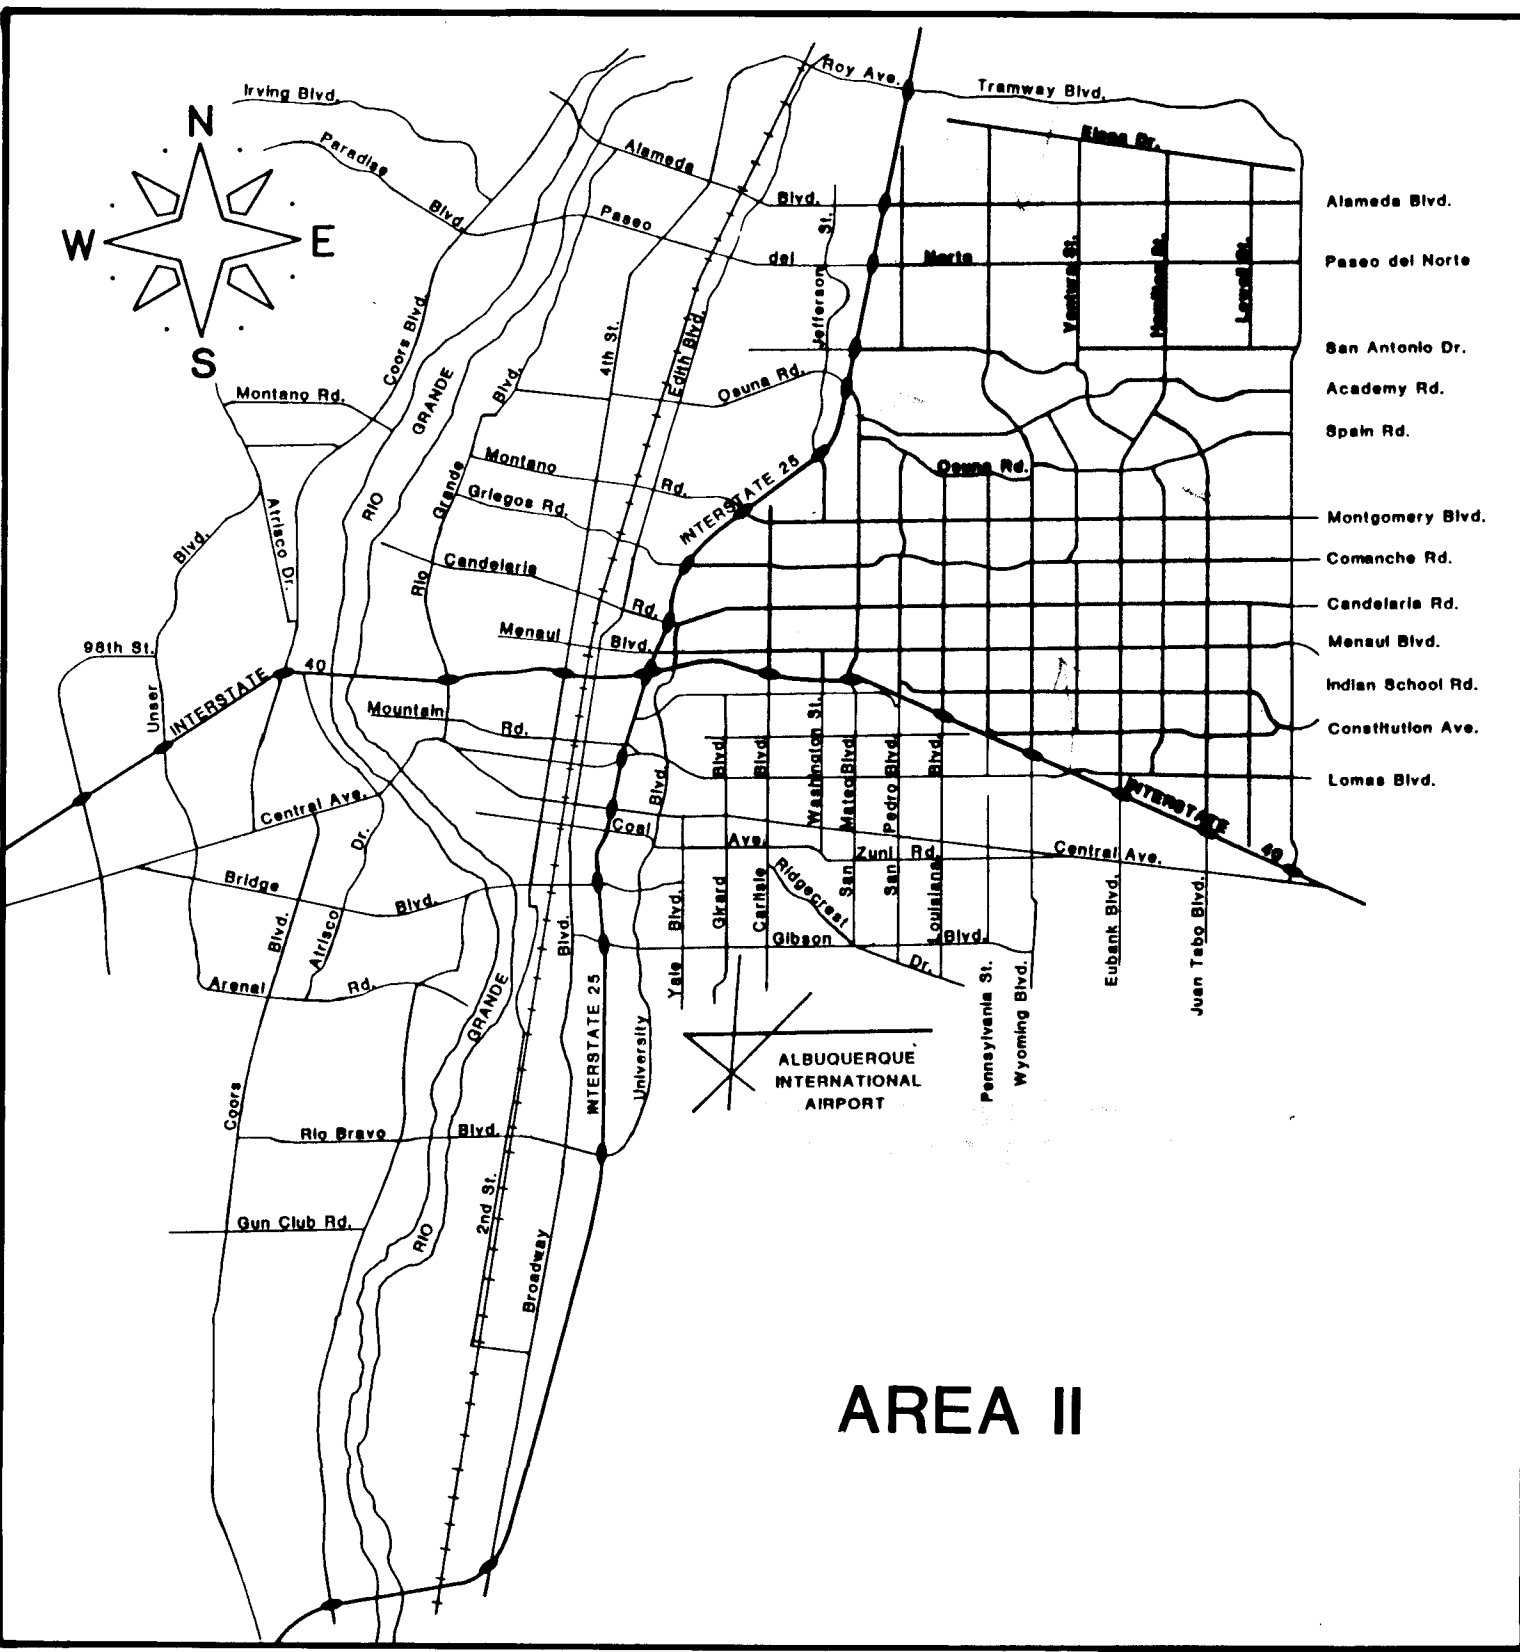

RECORD DRAWING

WARNING
This is part of a record document. Record documents are based on information provided by others. Users of this information are advised to obtain independent verification of actual conditions.

REV	SHEETS	CITY ENGR	DATE	USER DEPT	DATE	USER DEPT	DATE
APPROVAL OF REVISIONS							
APPROVED FOR CONSTRUCTION				DATE: 12/12/89			
DRAWING NO. 3503				SHEET 1 OF 24			

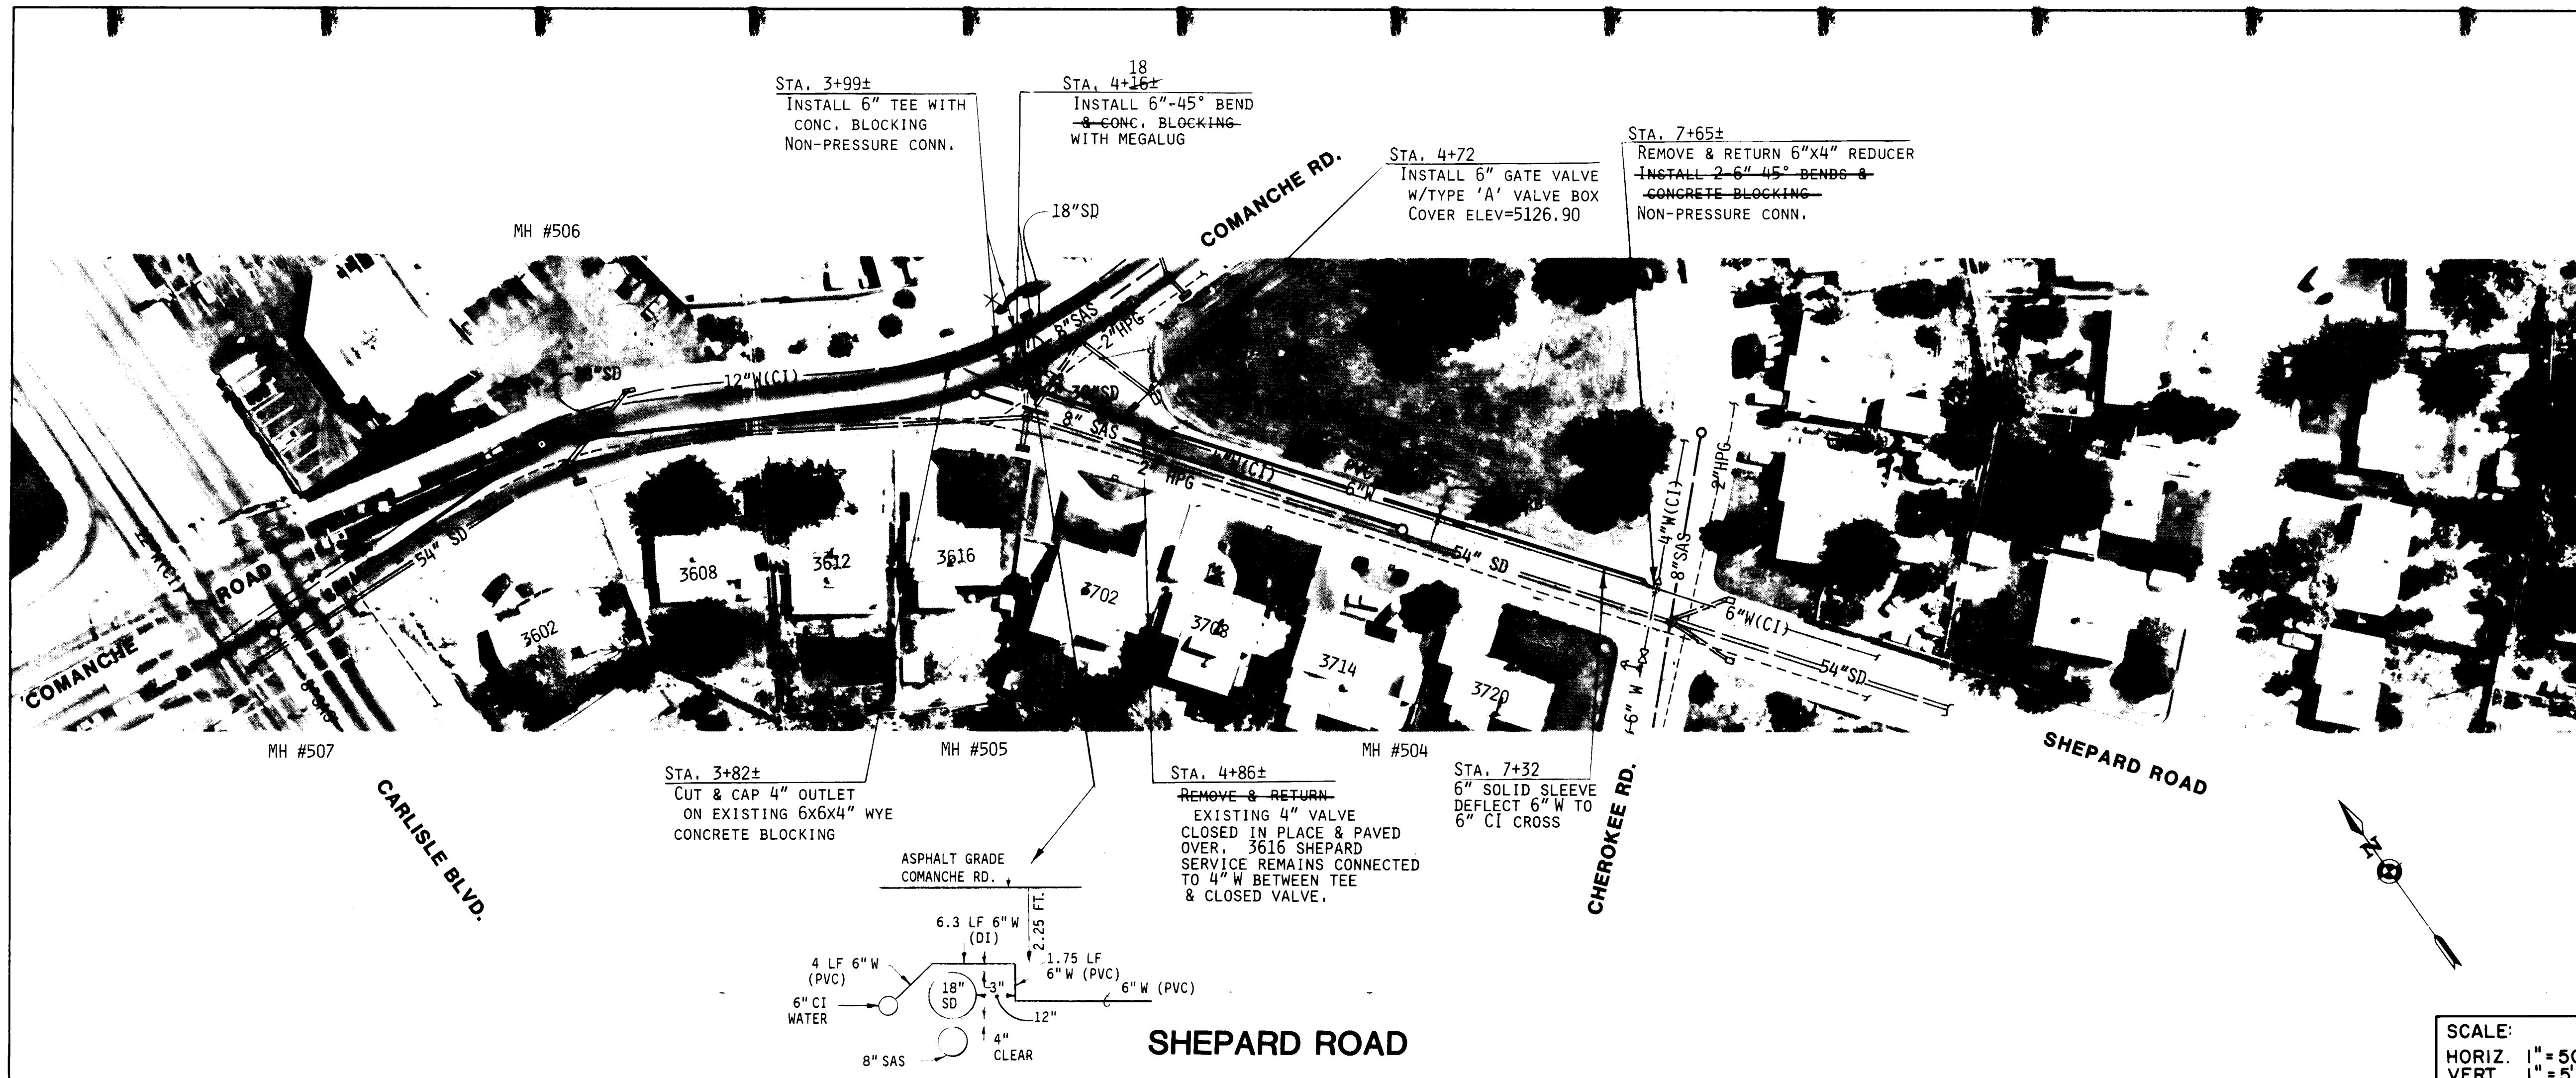


NOTES

- SEE SHEET 4 FOR CONTINUATION OF REHABILITATION WORK ON CHEROKEE RD.
- SUPPORT EXISTING GAS LINES IN THE VICINITY OF STATION 0+50 AND 2+75 AS REQUIRED FOR CONSTRUCTION.
- THE EXISTING 4" WATERLINE SHALL BE REMOVED AND DISPOSED OF FROM APPROXIMATELY STA. 4+15 TO STA. 7+65.
- ANY PARK FACILITIES DAMAGED BY THE CONTRACTOR SHALL BE RESTORED AT NO EXPENSE TO THE CITY.


RECORD DRAWING

WARNING

This is part of a record document. Record documents are based on reports submitted by others. Engineers cannot assure nor assume any responsibility or liability for the accuracy of record documents. Users of record documents are cautioned and advised to obtain independent verification of actual conditions.

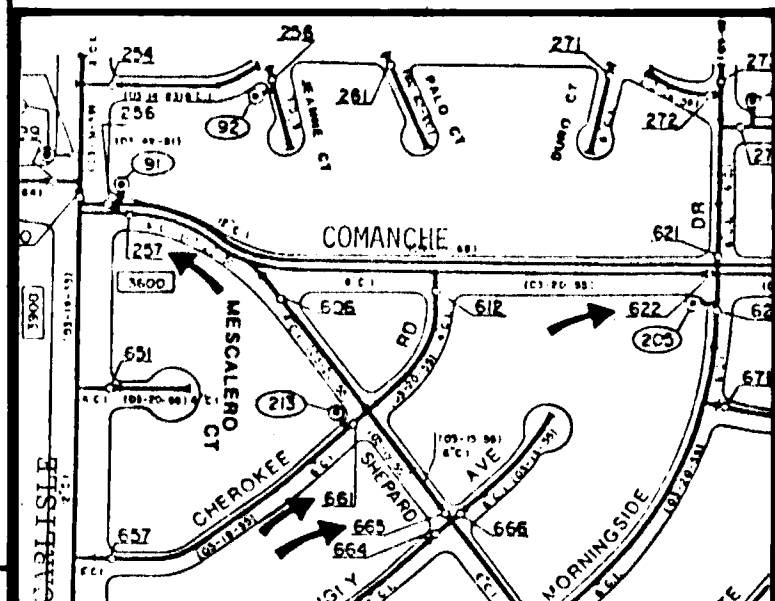

SCALE:
HORIZ. 1" = 50'
VERT. 1" = 5'

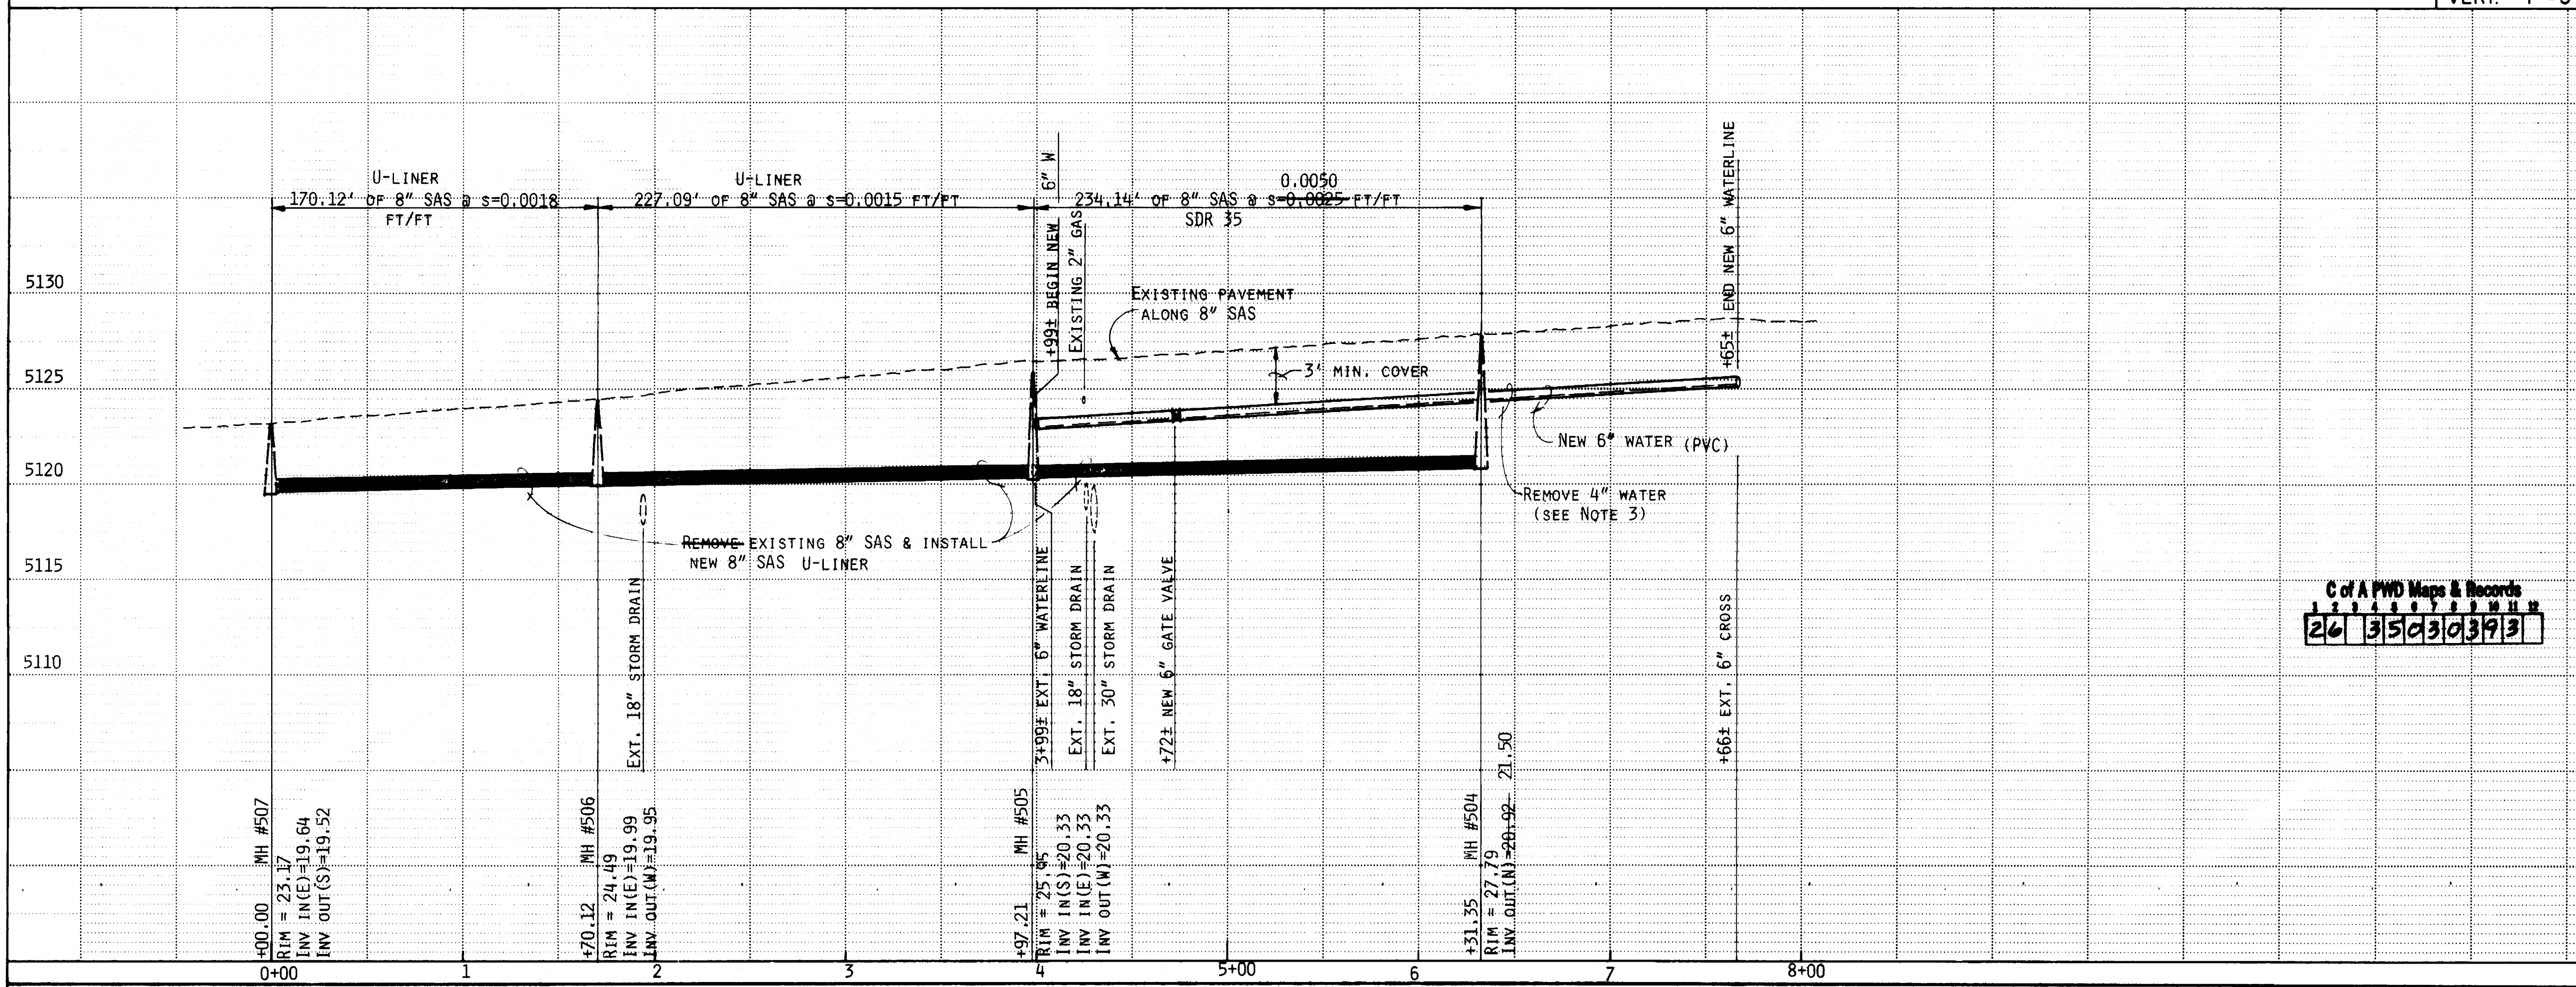

WATER VALVE SHUT-OFF PLAN

WATER SERVICE REHABILITATION

SHEPARD ADDRESS	METER SIZE	①	②	③
3616	3/4"			X
3702	"			X
3708	"			X
3714	"			X
3720	"			X

- KEY:
- ① SERVICE LINE TRANSFER
 - ② METER BOX RELOCATION & REPLACEMENT
 - ③ SERVICE LINE REPLACEMENT



Isaacson & Arfman, P.A.
CONSULTING ENGINEERING ASSOCIATES
Albuquerque, New Mexico

CITY OF ALBUQUERQUE
PUBLIC WORKS DEPARTMENT
ENGINEERING GROUP

TITLE: FY88-89 WATERLINE & SEWERLINE RENEWAL PROGRAM, AREA II
SHEPARD ROAD

APPROVALS	ENGINEER	DATE	APPROVALS	ENGINEER	DATE
D.R. Chair			Liquid Waste		
Trans. Dev.			Traffic		
Utility Dev.			Water		

DRAWING NO. 3503 MAP NO. G-17 SHEET 3 OF 24

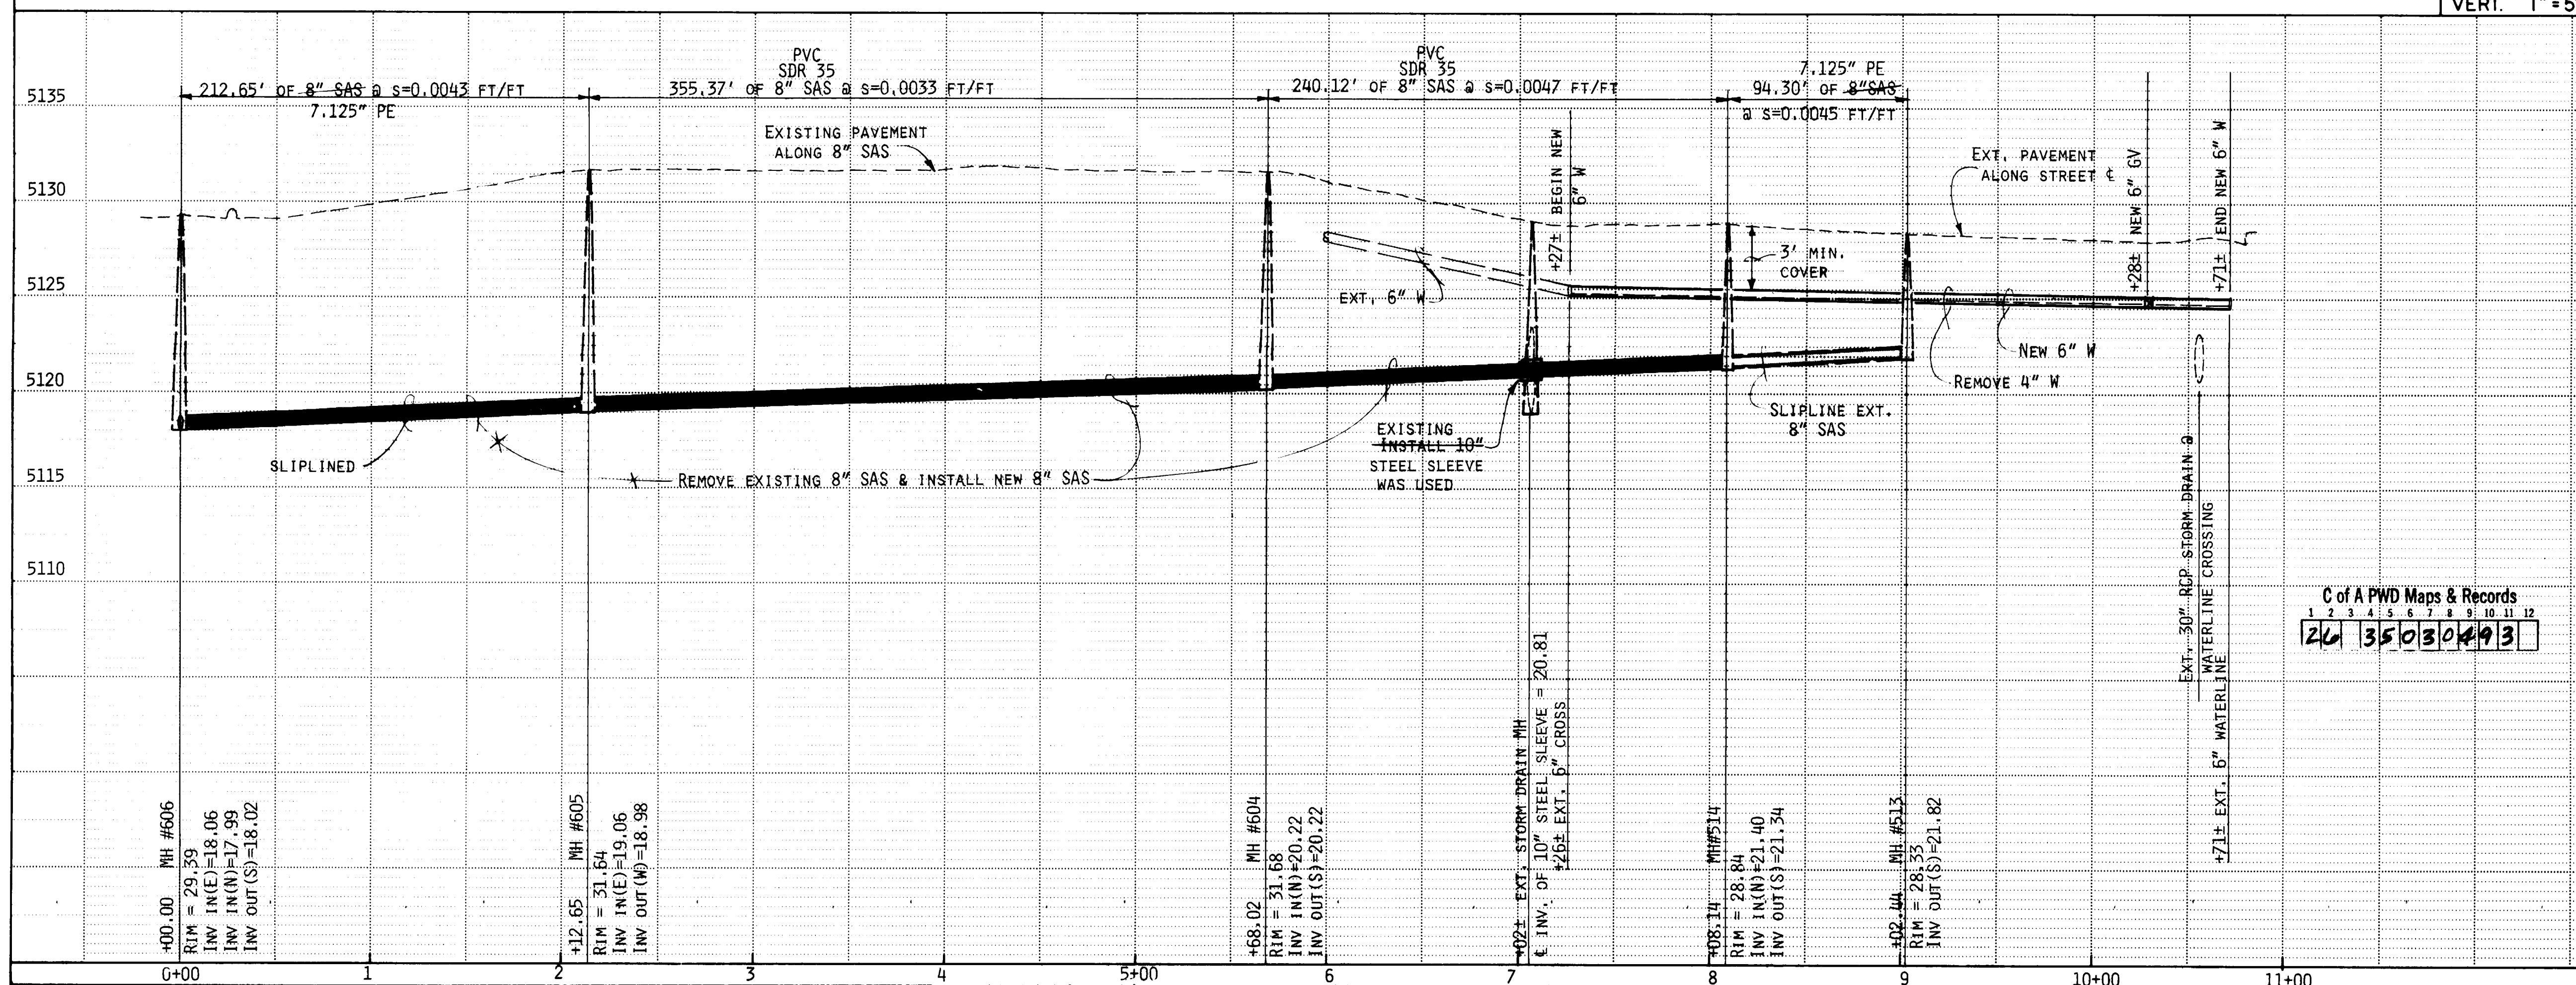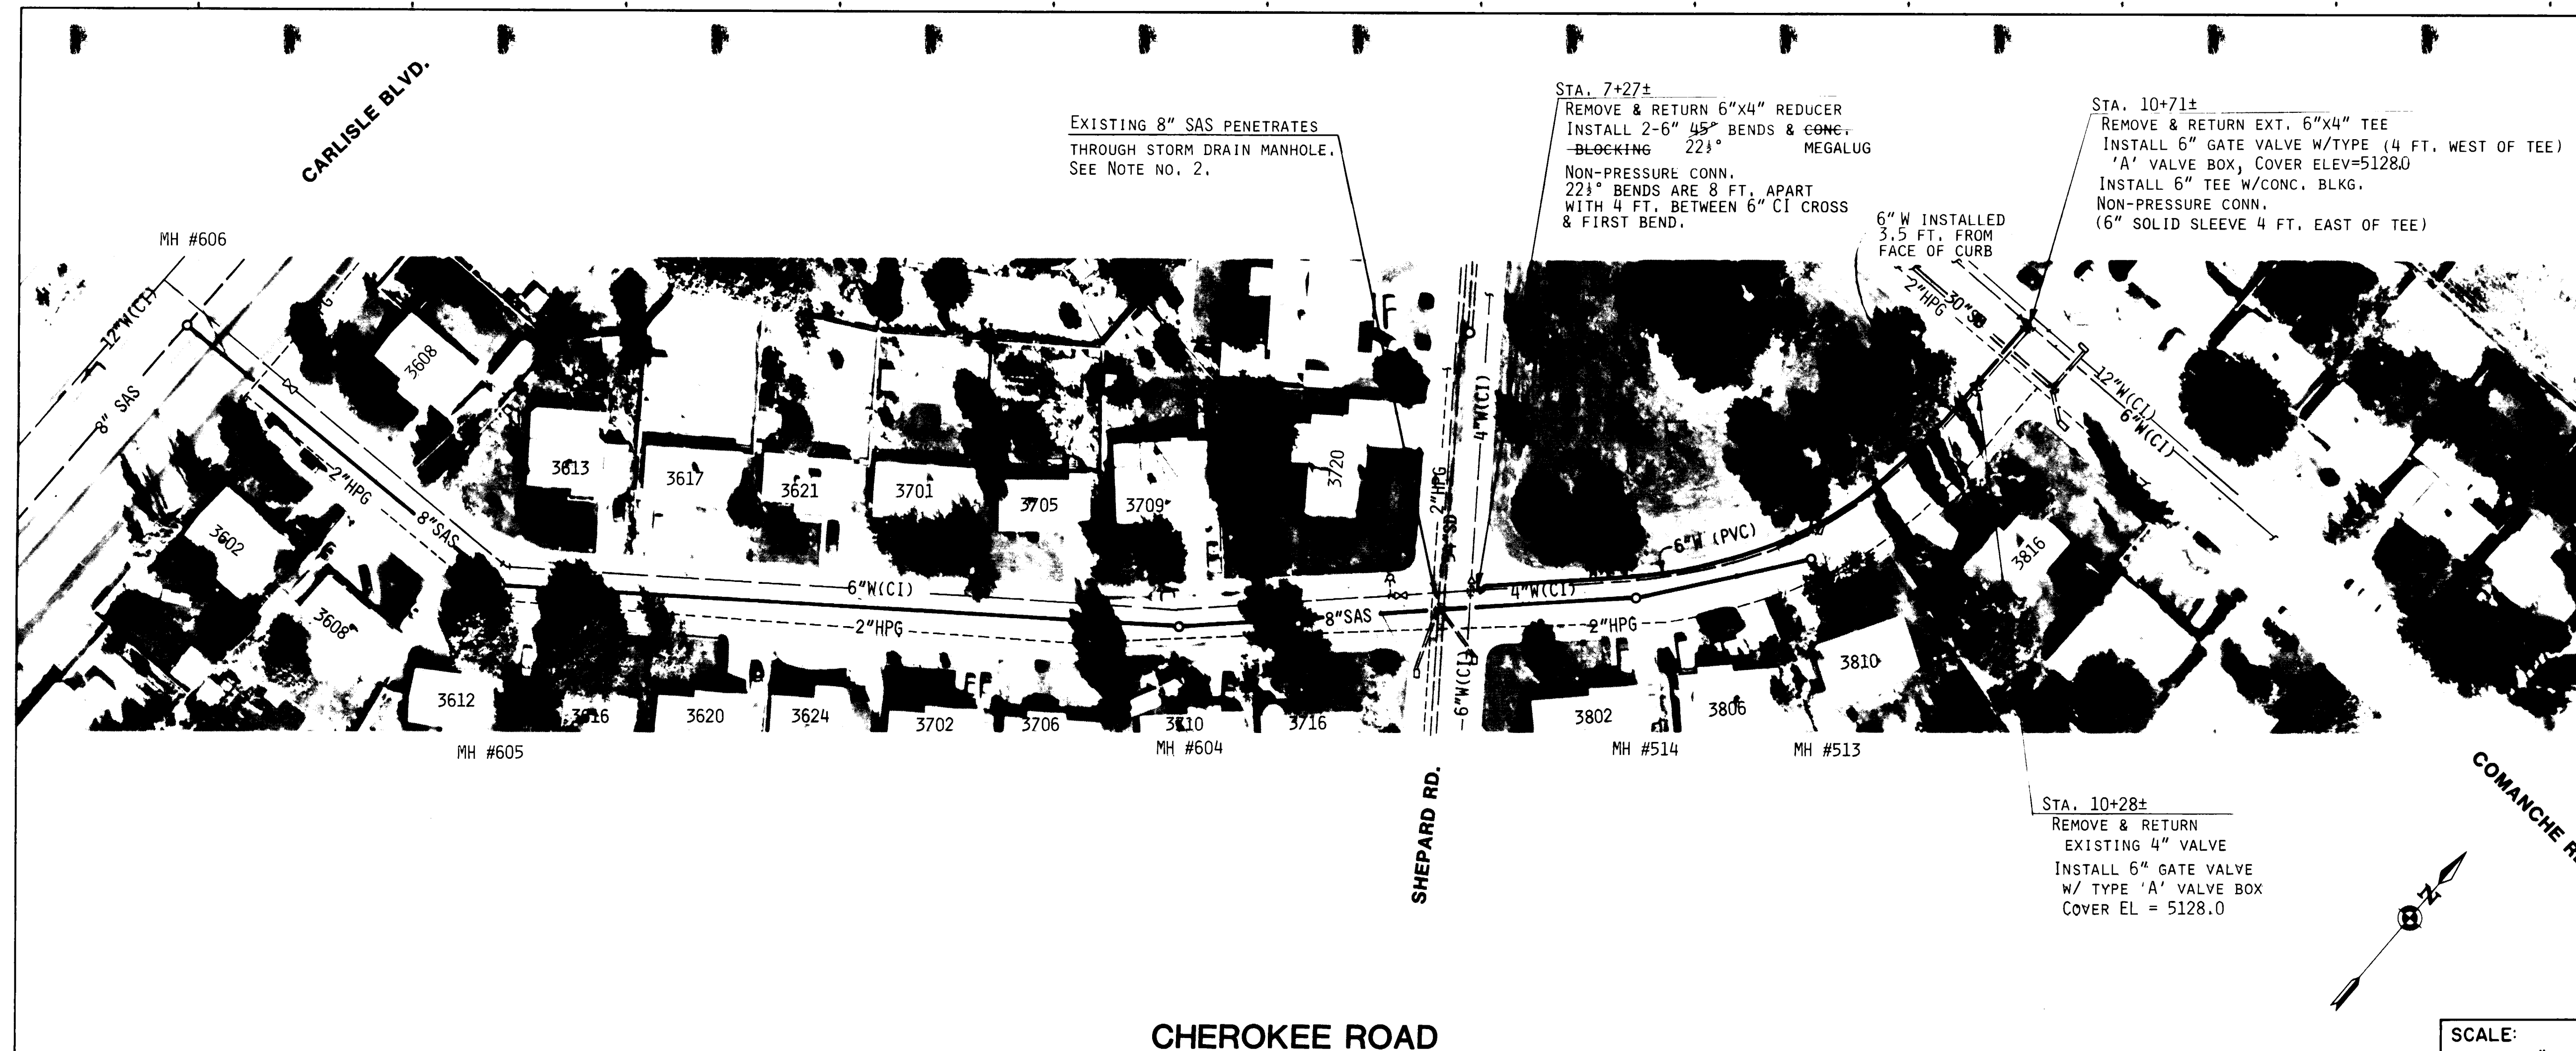

NOTES

- SEE SHEET 3 FOR CONTINUATION OF REHABILITATION WORK ON SHEPARD RD. & WATER VALVE SHUT-OFF PLAN FOR THIS WORK.
- EXISTING SLEEVE USED
THE CONTRACTOR SHALL REMOVE & DISPOSE OF THE DI SANITARY SEWER LINE RUNNING THROUGH THE MANHOLE & REPLACE IT WITH A 10 INCH DIAMETER STEEL CASING. MANHOLE WALLS SHALL BE REPAIRED WITH GROUT. THE BELL END OF THE ADJACENT DOWNGRADE SECTION OF NEW 8" SAS SHALL BE LOCATED WITHIN 5' OF THE STEEL CASING. THE NEXT LENGTH OF 8" SAS SHALL BE INSERTED THROUGH THE CASING, WITH INSTALLATION THEN PROCEEDING NORMALLY UPGRADE.
- THE EXISTING 4" WATER SHALL BE REMOVED & DISPOSED OF FROM STA. 7+27± TO STA. 10+71±.

WATER SERVICE REHABILITATION				
CHEROKEE ADDRESS	METER SIZE	1	2	3
3802	3/4"			X
3806	"			X
3810	"			X

KEY: ① SERVICE LINE TRANSFER
② METER BOX RELOCATION & REPLACEMENT
③ SERVICE LINE REPLACEMENT

ENGINEER'S SEAL
Isaacson & Artman
CONSULTING ENGINEERING ASSOCIATES
ALBUQUERQUE, NEW MEXICO

RECORD DRAWING

WARNING
This is part of a record document. Record documents are based on reports submitted by others. Engineers cannot assume responsibility for the accuracy of record documents. Users of record documents are cautioned and advised to obtain independent verification of actual conditions.



Isaacson & Artman, P.A.
CONSULTING ENGINEERING ASSOCIATES
Albuquerque, New Mexico

CITY OF ALBUQUERQUE
PUBLIC WORKS DEPARTMENT
ENGINEERING GROUP

TITLE: FY88-89 WATERLINE & SEWERLINE RENEWAL PROGRAM, AREA II
CHEROKEE ROAD

APPROVALS	ENGINEER	DATE	APPROVALS	ENGINEER	DATE
O'R Chair			Liquid Waste		
Trans. Dev.			Traffic		
Utility Dev.			Water		

DRAWING NO. 3503 **MAP NO.** G-17 **SHEET** 4 **OF** 24

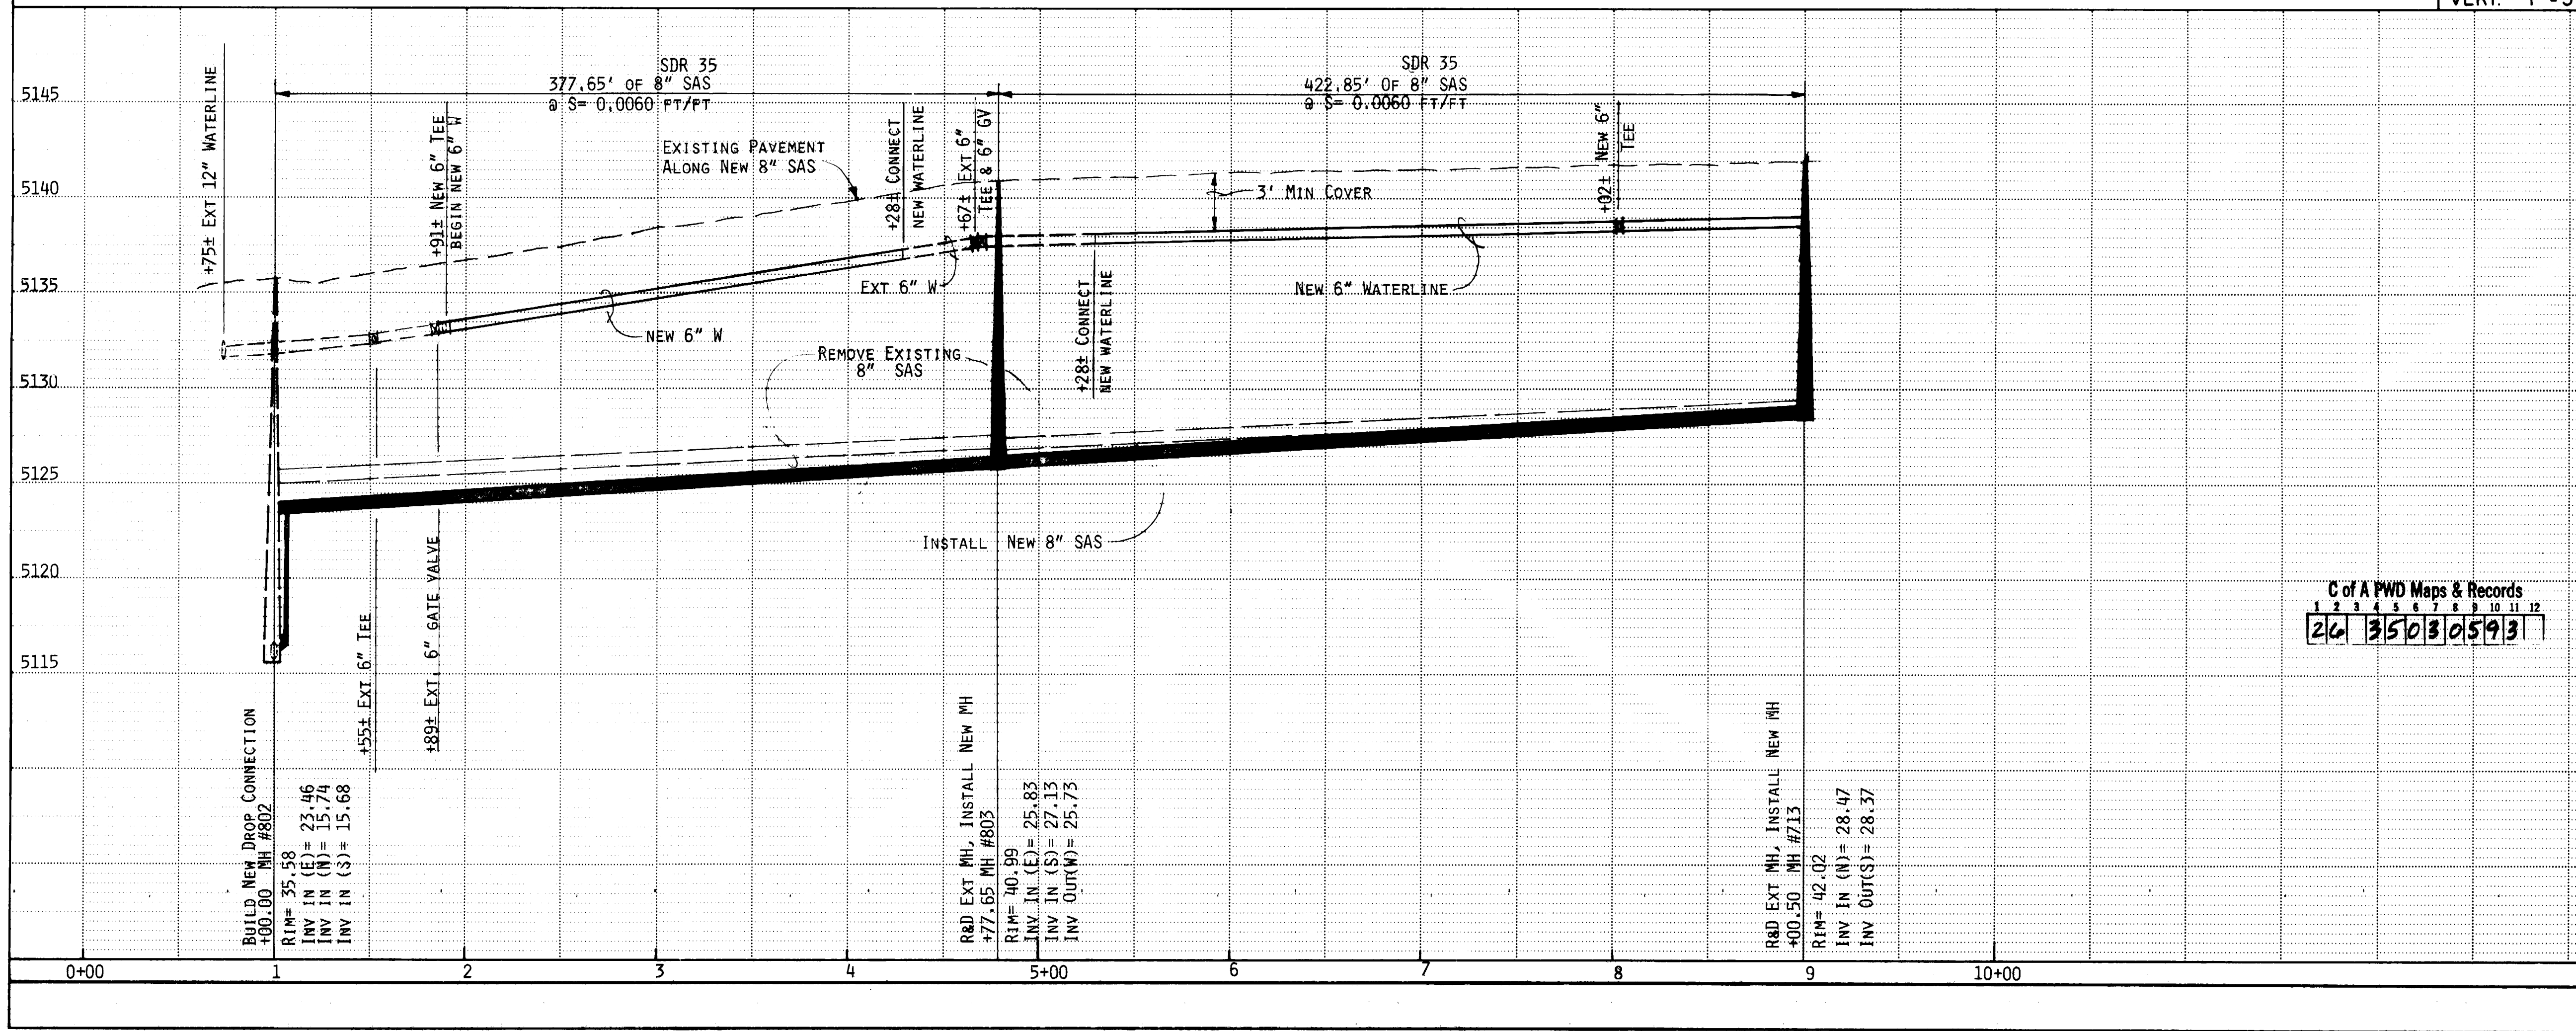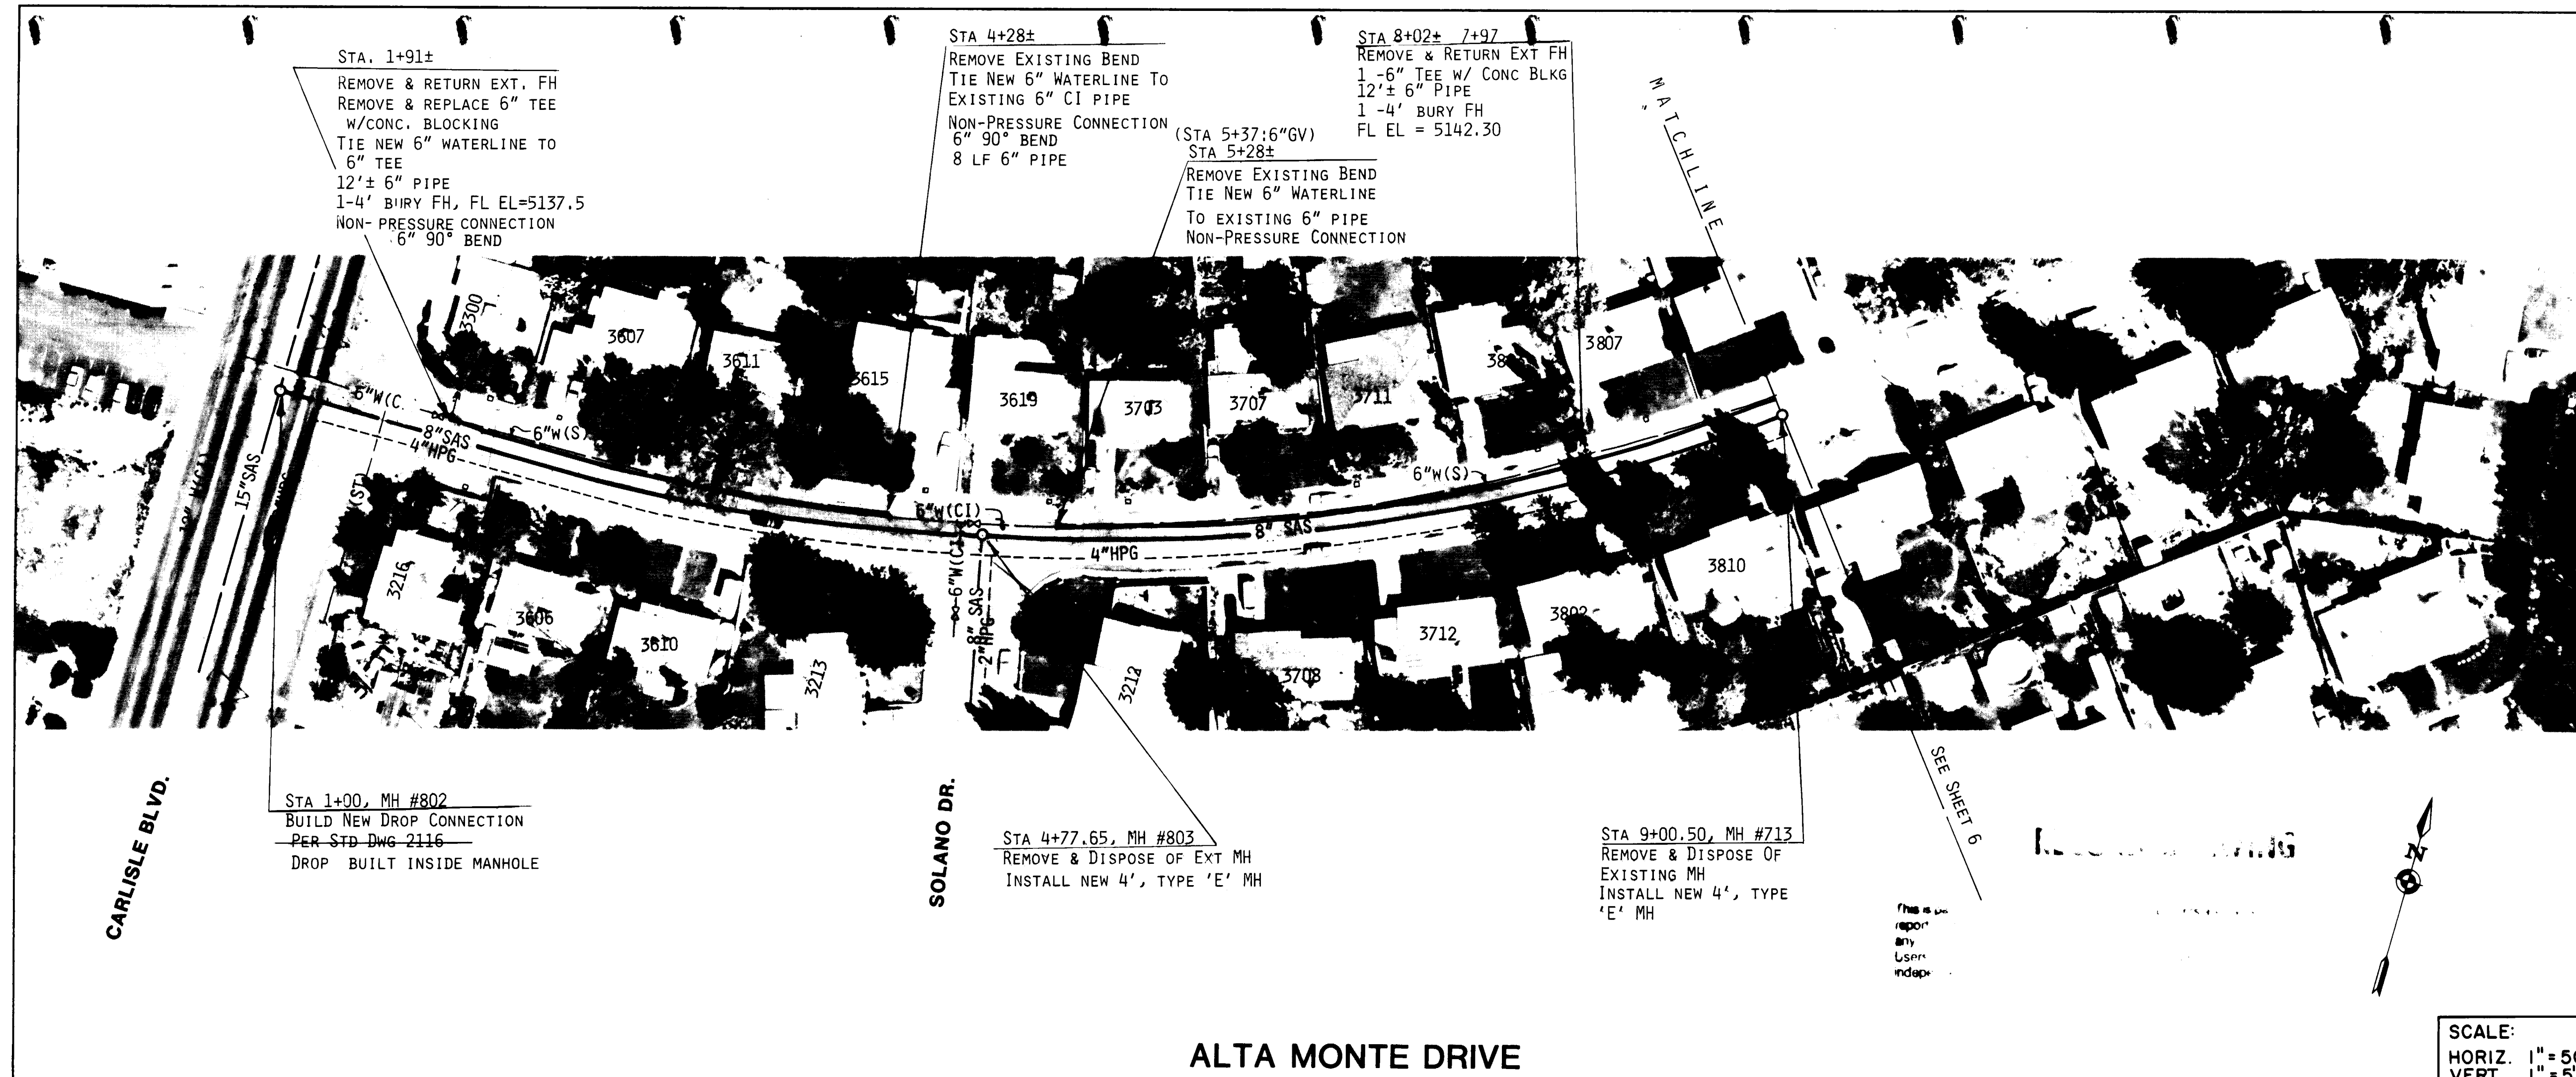

NOTES

1. SEE SHEET 22 FOR WATER VALVE SHUT-OFF PLAN FOR THIS WORK.

2. THE EXISTING 6 INCH STEEL WATERLINE SHALL BE REMOVED & DISPOSED OF FROM STA. 1+91± TO STA. 4+28± AND FROM STA. 5+28± TO APPROXIMATELY STA. 10+00.

WATER SERVICE REHABILITATION				
STREET ADDRESS	METER SIZE	①	②	③
3216 CARLISLE	3/4"	X		
3300 "	"			X
3606 ALTA MONTE	"	X	X	
3607 "	"			X
3610 "	"	X	X	
3611 "	"			X
3615 "	"			
3619 "	"			
3703 "	"			X
3707 "	"			X
3708 "	"	X	X	
3711 "	"			X
3712 "	"	X	X	
3802 "	"	X	X	
3803 "	"			X
3807 "	"			X
3810 "	"	X		

KEY:

- ① SERVICE LINE TRANSFER
- ② METER BOX RELOCATION & REPLACEMENT
- ③ SERVICE LINE REPLACEMENT

Isaacson & Arfman, P.A.

CONSULTING ENGINEERING ASSOCIATES

Albuquerque, New Mexico

CITY OF ALBUQUERQUE
PUBLIC WORKS DEPARTMENT
ENGINEERING GROUP


TITLE: FY88-89 WATERLINE & SEWERLINE RENEWAL PROGRAM, AREA II
ALTA MONTE DRIVE

APPROVALS	ENGINEER	DATE	APPROVALS	ENGINEER	DATE
D.R.C. Chair	Isaacson & Arfman	10/88	Liquid Waste		
Trans. Dev.			Traffic		
Utility Dev.			Water		

DRAWING NO. 3503

MAP NO. G-17


SHEET 5 **OF** 24

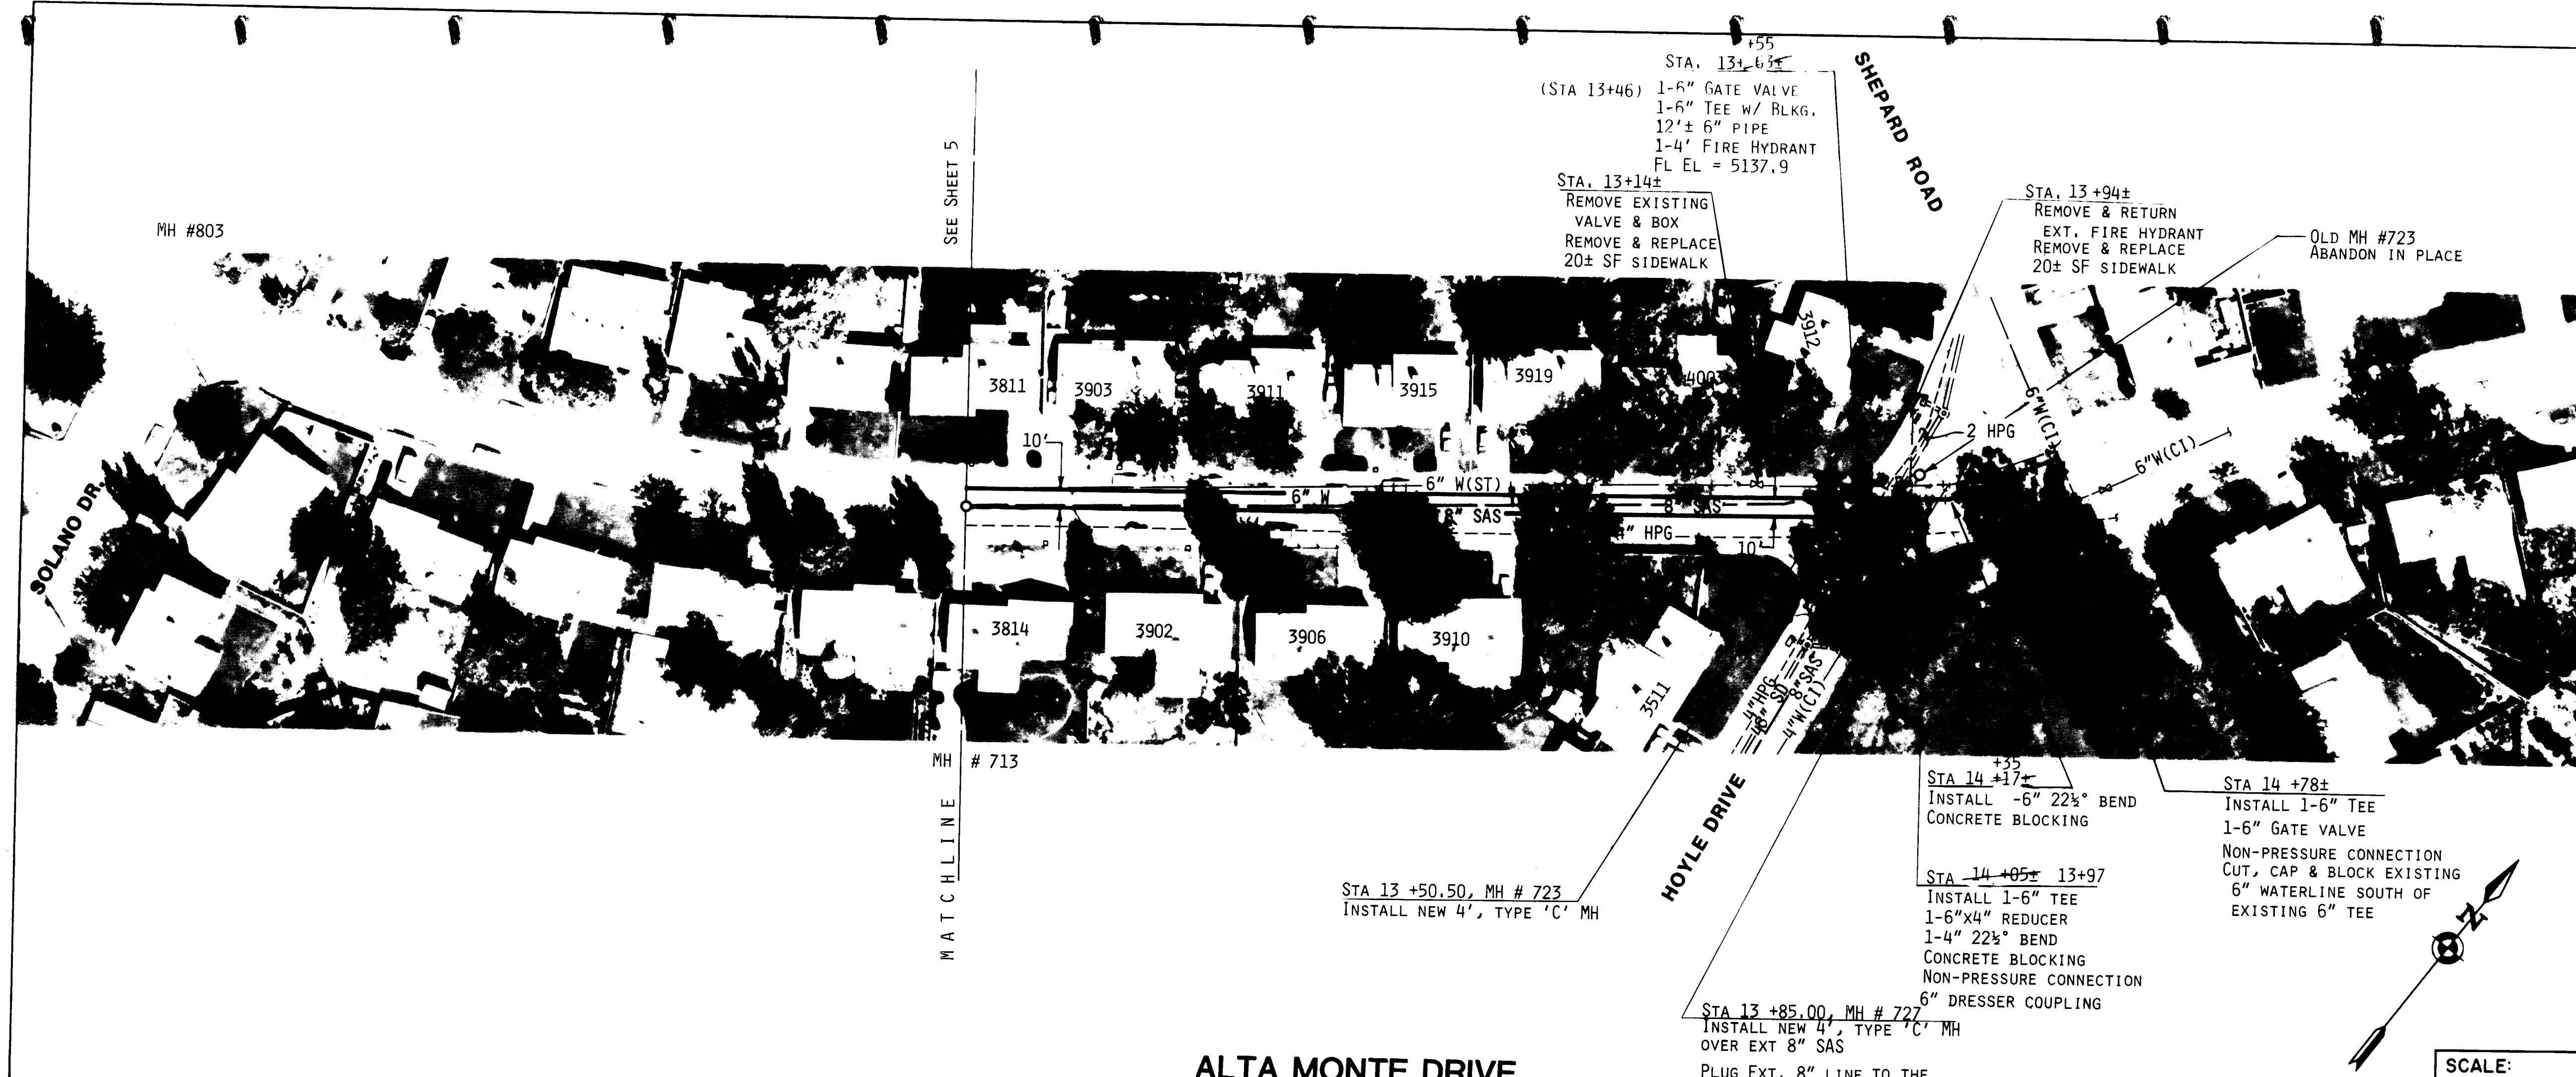


- NOTES**
- SEE SHEET 22 FOR WATER VALVE SHUT-OFF PLAN FOR THIS WORK.
 - THE EXISTING 8" SANITARY SEWER LINE AND 6" STEEL WATERLINE SHALL BE REMOVED & DISPOSED OF WHERE THE NEW PIPE AND THE OLD PIPE ARE SEPARATED BY LESS THAN 12 INCHES, MEASURED O.D. TO O.D.
 - THE CONTRACTOR SHALL LOCATE ONE OF THE NEW WATER SERVICES WITHIN 3 FEET OF THE HIGHPOINT ON THE NEW 6" WATERLINE (APPROX. STA. 9+00).

WATER SERVICE REHABILITATION				
ALTA MONTE ADDRESS	METER SIZE	①	②	③
3811	3/4"			X
3814	"	X	X	
3902	"	X	X	
3903	"			X
3906	"	X		
3910	"	X	X	
3911	"			X
3915	"			X
3919	"			X
4003	"			X

- KEY:
- ① SERVICE LINE TRANSFER
 - ② METER BOX RELOCATION & REPLACEMENT
 - ③ SERVICE LINE REPLACEMENT

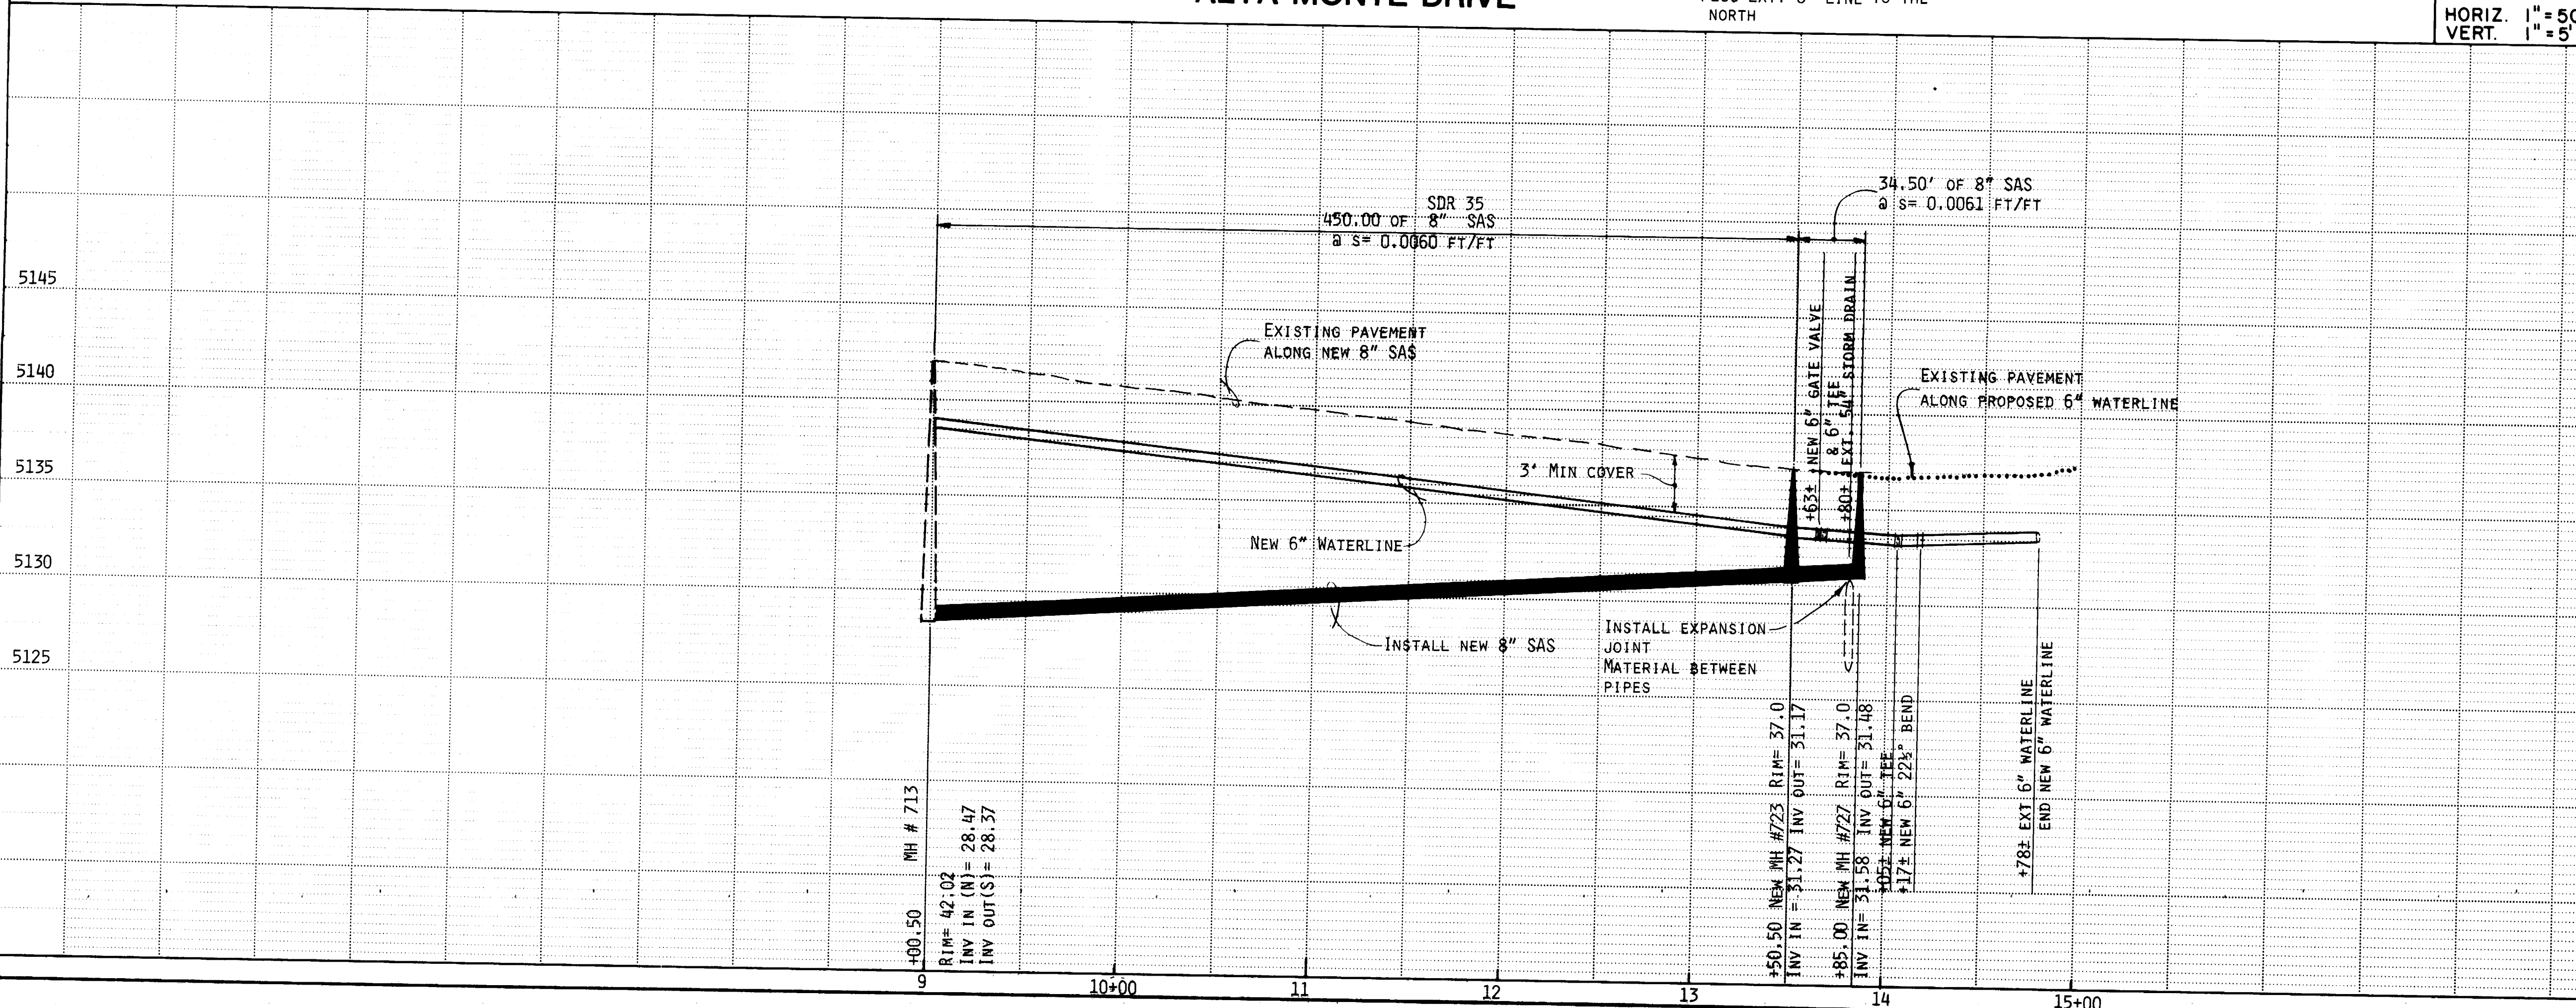


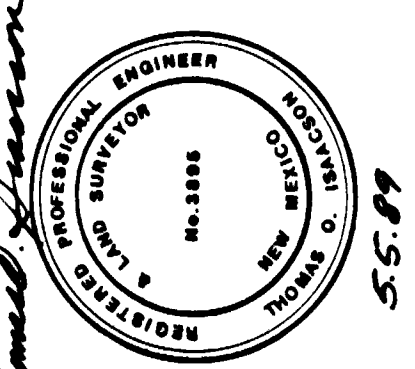
AS BUILT INFORMATION		BENCH MARKS		SURVEY INFORMATION		ENGINEER'S SEAL	
CONTRACTOR	SUNDANCE MECHANICAL	NO.		NO.			
INSPECTOR	G. MARQUEZ	DATE	7/88	DATE	7/88		
FIELD ENGINEER	T. ARCHULETA	DATE	7/88	DATE	7/88	REVISIONS	
FIELD ENGINEER	T. ARCHULETA	DATE	7/88	DATE	7/88		
FIELD ENGINEER	T. ARCHULETA	DATE	7/88	DATE	7/88	DESIGN	
FIELD ENGINEER	T. ARCHULETA	DATE	7/88	DATE	7/88		
FIELD ENGINEER	T. ARCHULETA	DATE	7/88	DATE	7/88	CHECKED BY	
FIELD ENGINEER	T. ARCHULETA	DATE	7/88	DATE	7/88		



C of A PWD Maps & Records
26 35030693

RECORD DRAWING

Isaacson & Arfman, P.A.
CONSULTING ENGINEERING ASSOCIATES
Albuquerque, New Mexico

CITY OF ALBUQUERQUE PUBLIC WORKS DEPARTMENT ENGINEERING GROUP					
TITLE: FY88-89 WATERLINE & SEWERLINE RENEWAL PROGRAM, AREA II					
ALTA MONTE DRIVE					
APPROVALS	ENGINEER	DATE	APPROVALS	ENGINEER	DATE
DR. Chair	Isaacson	7/88	Liquid Waste		
Trans. Dev.			Sanitary		
Utility Dev.			Water		

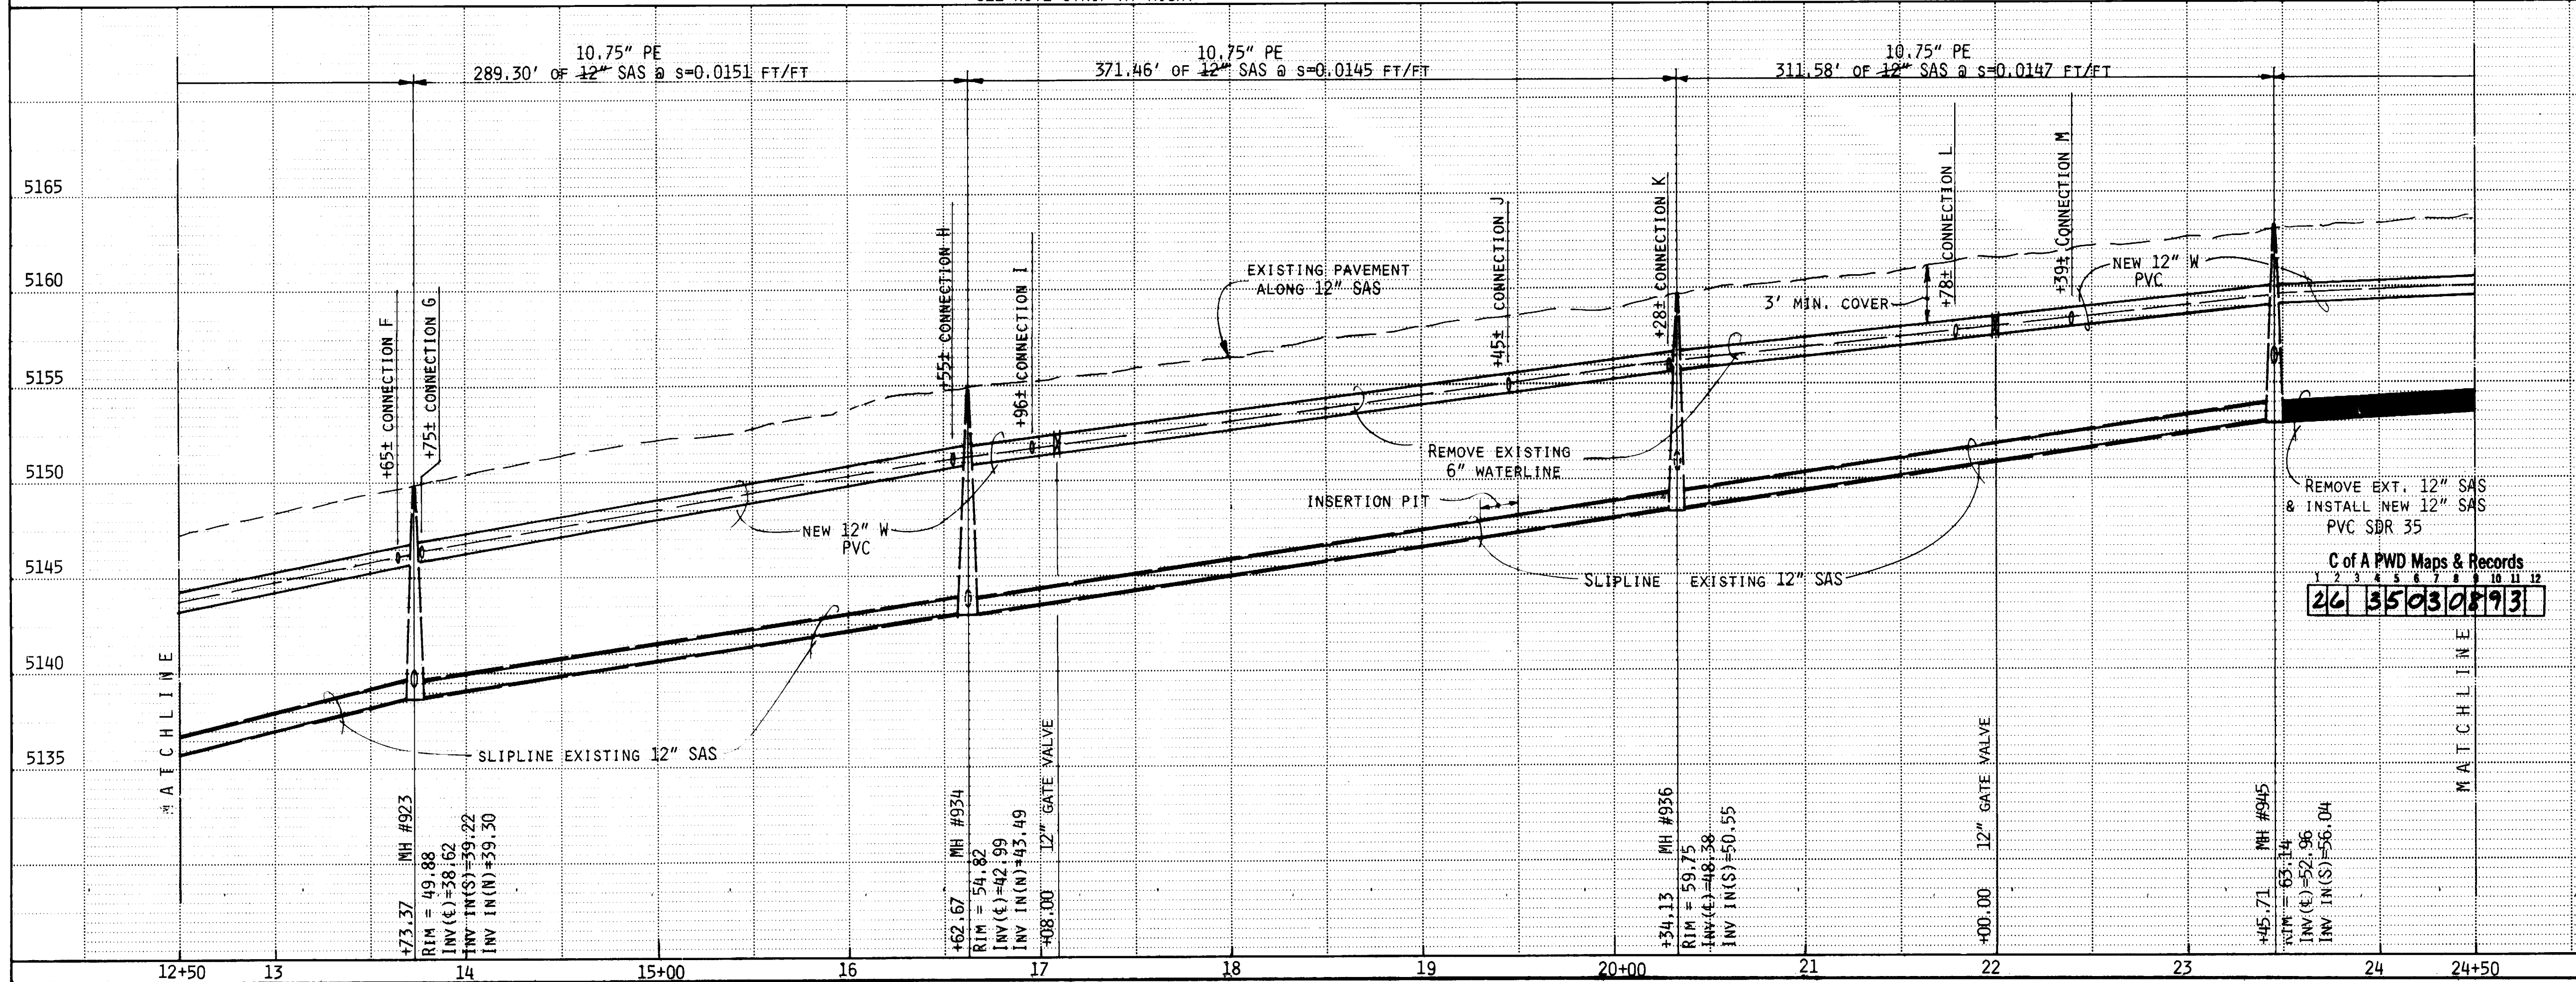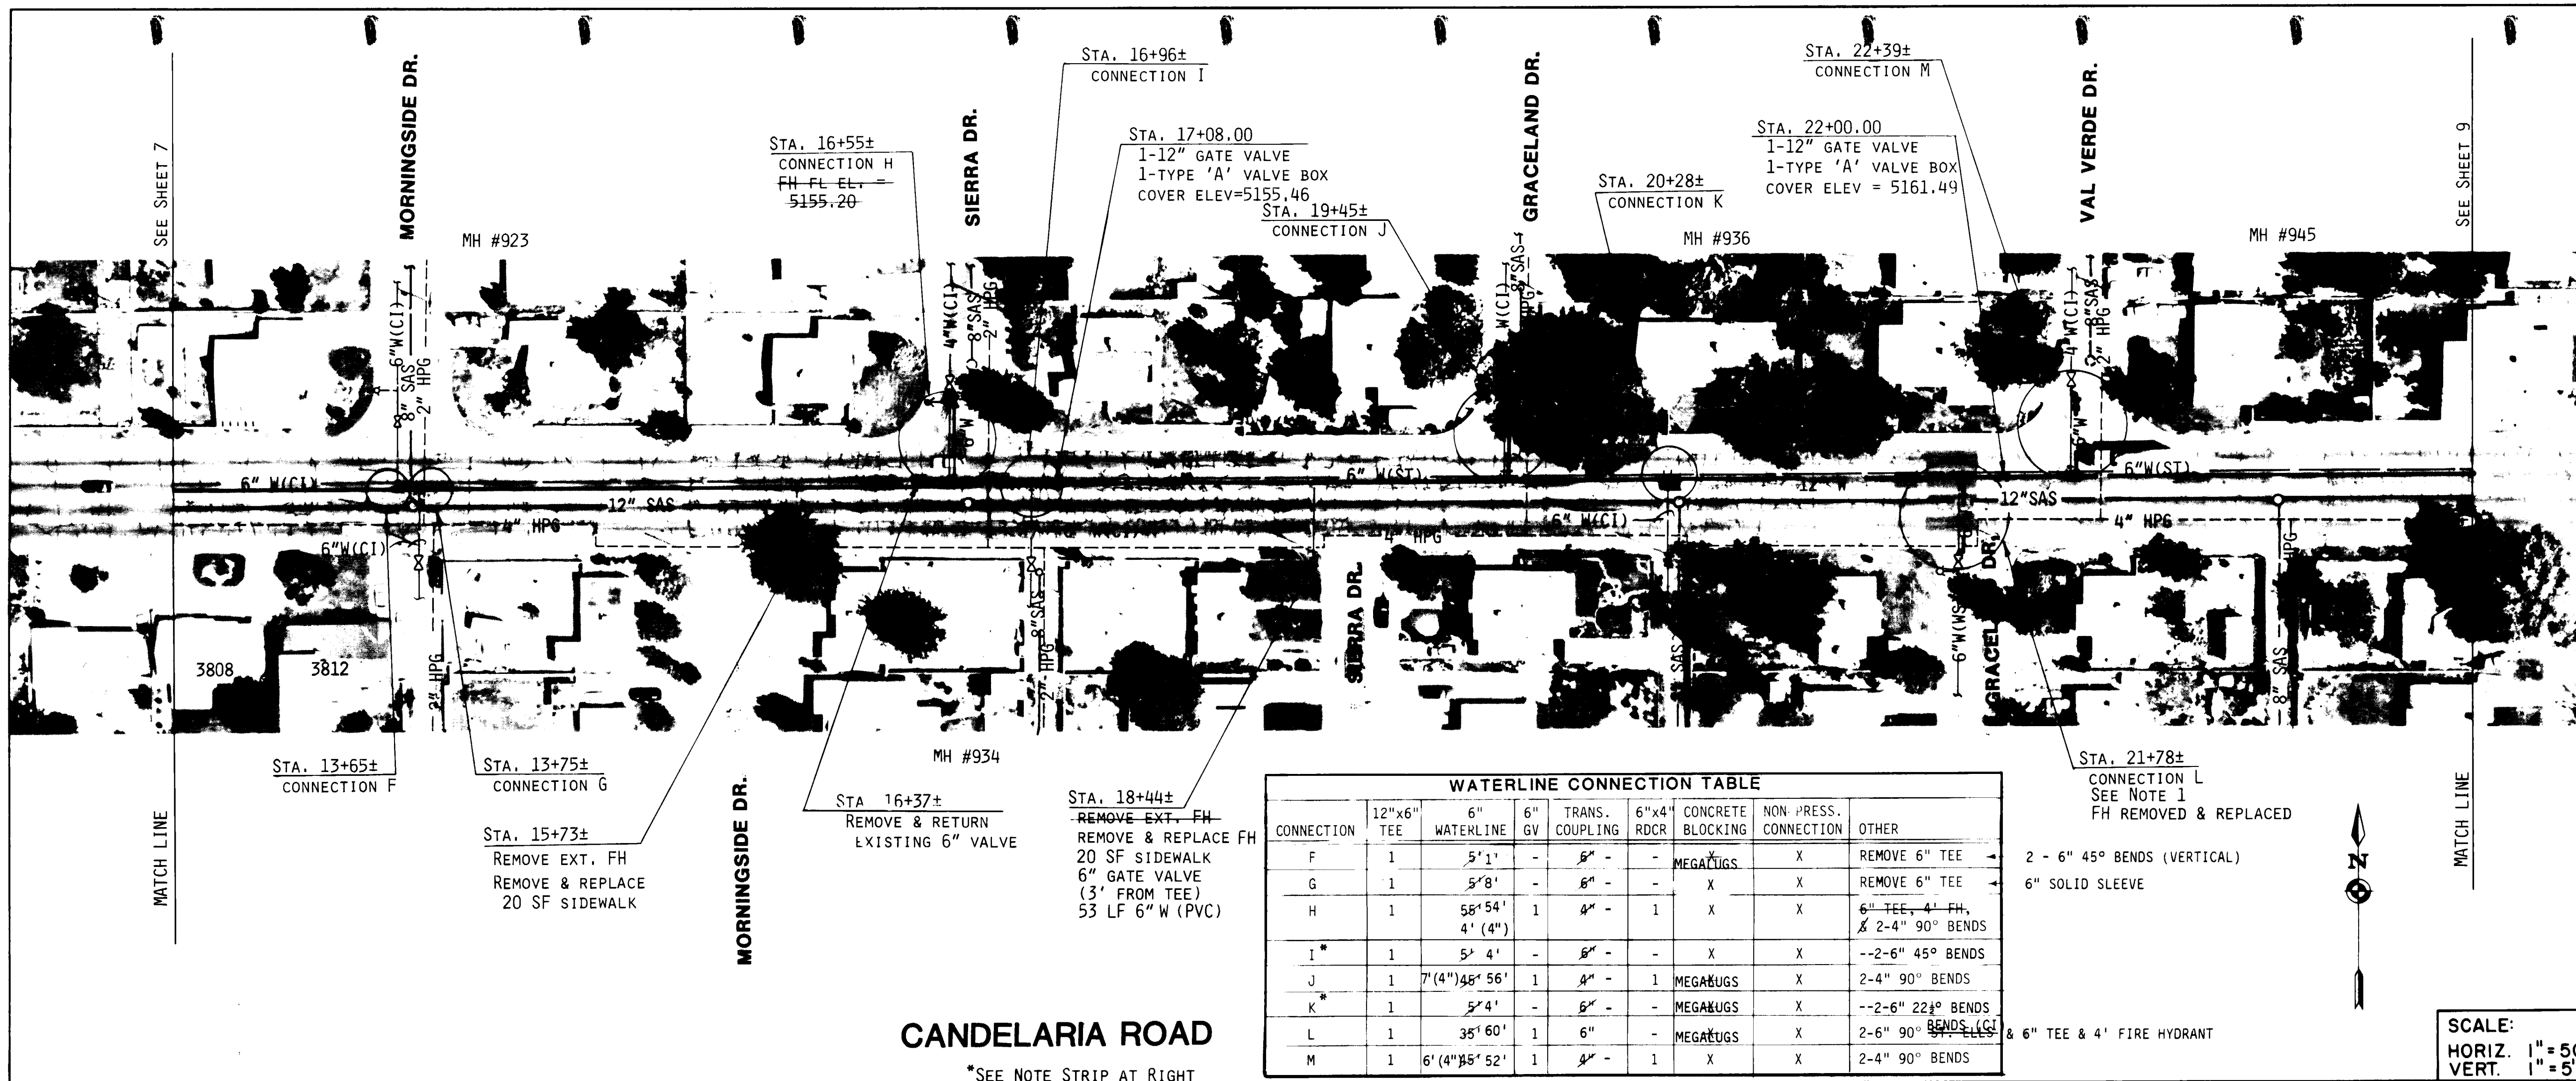

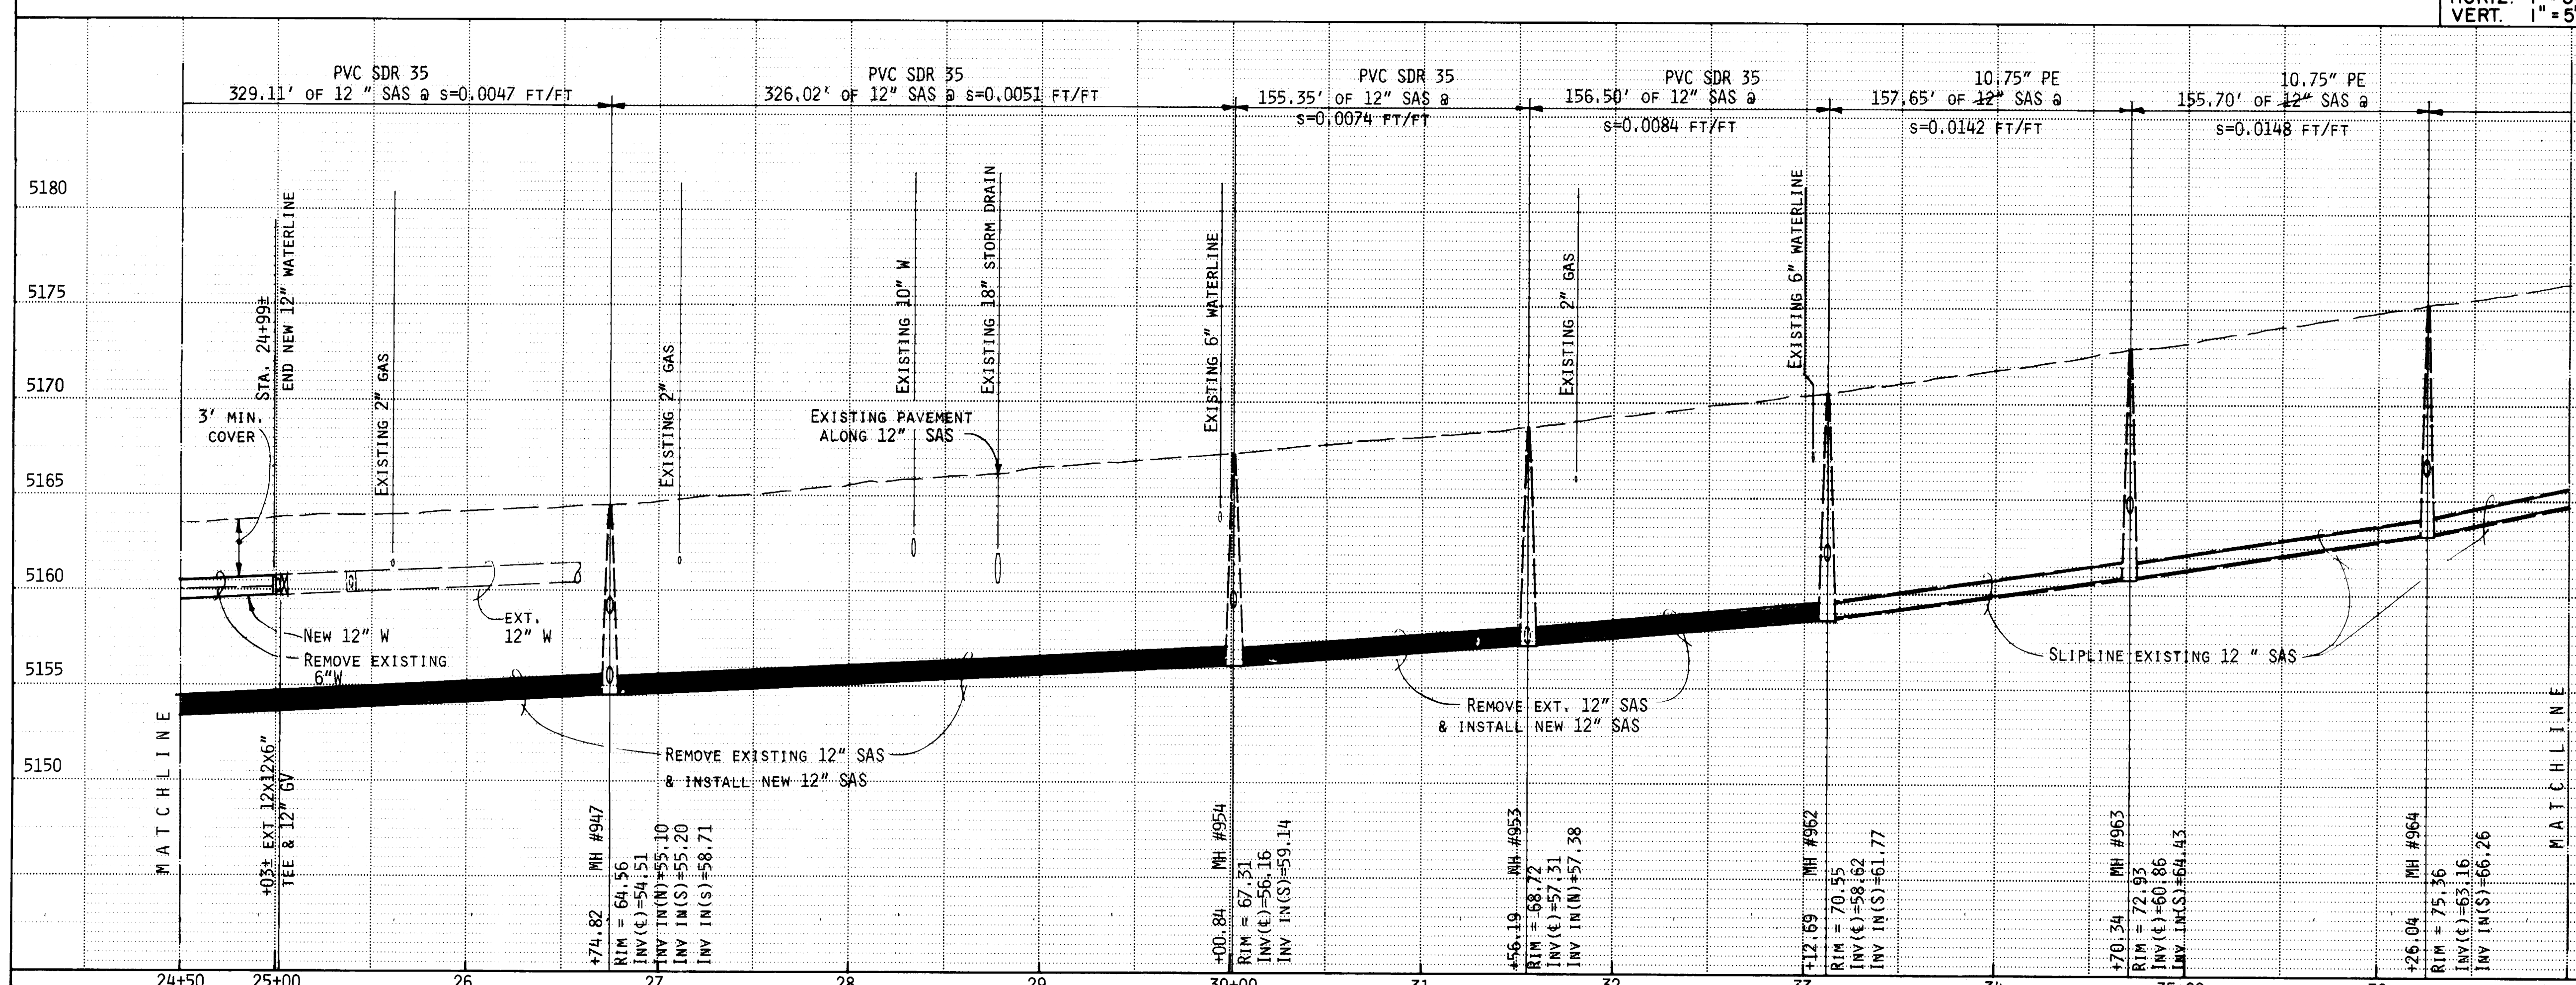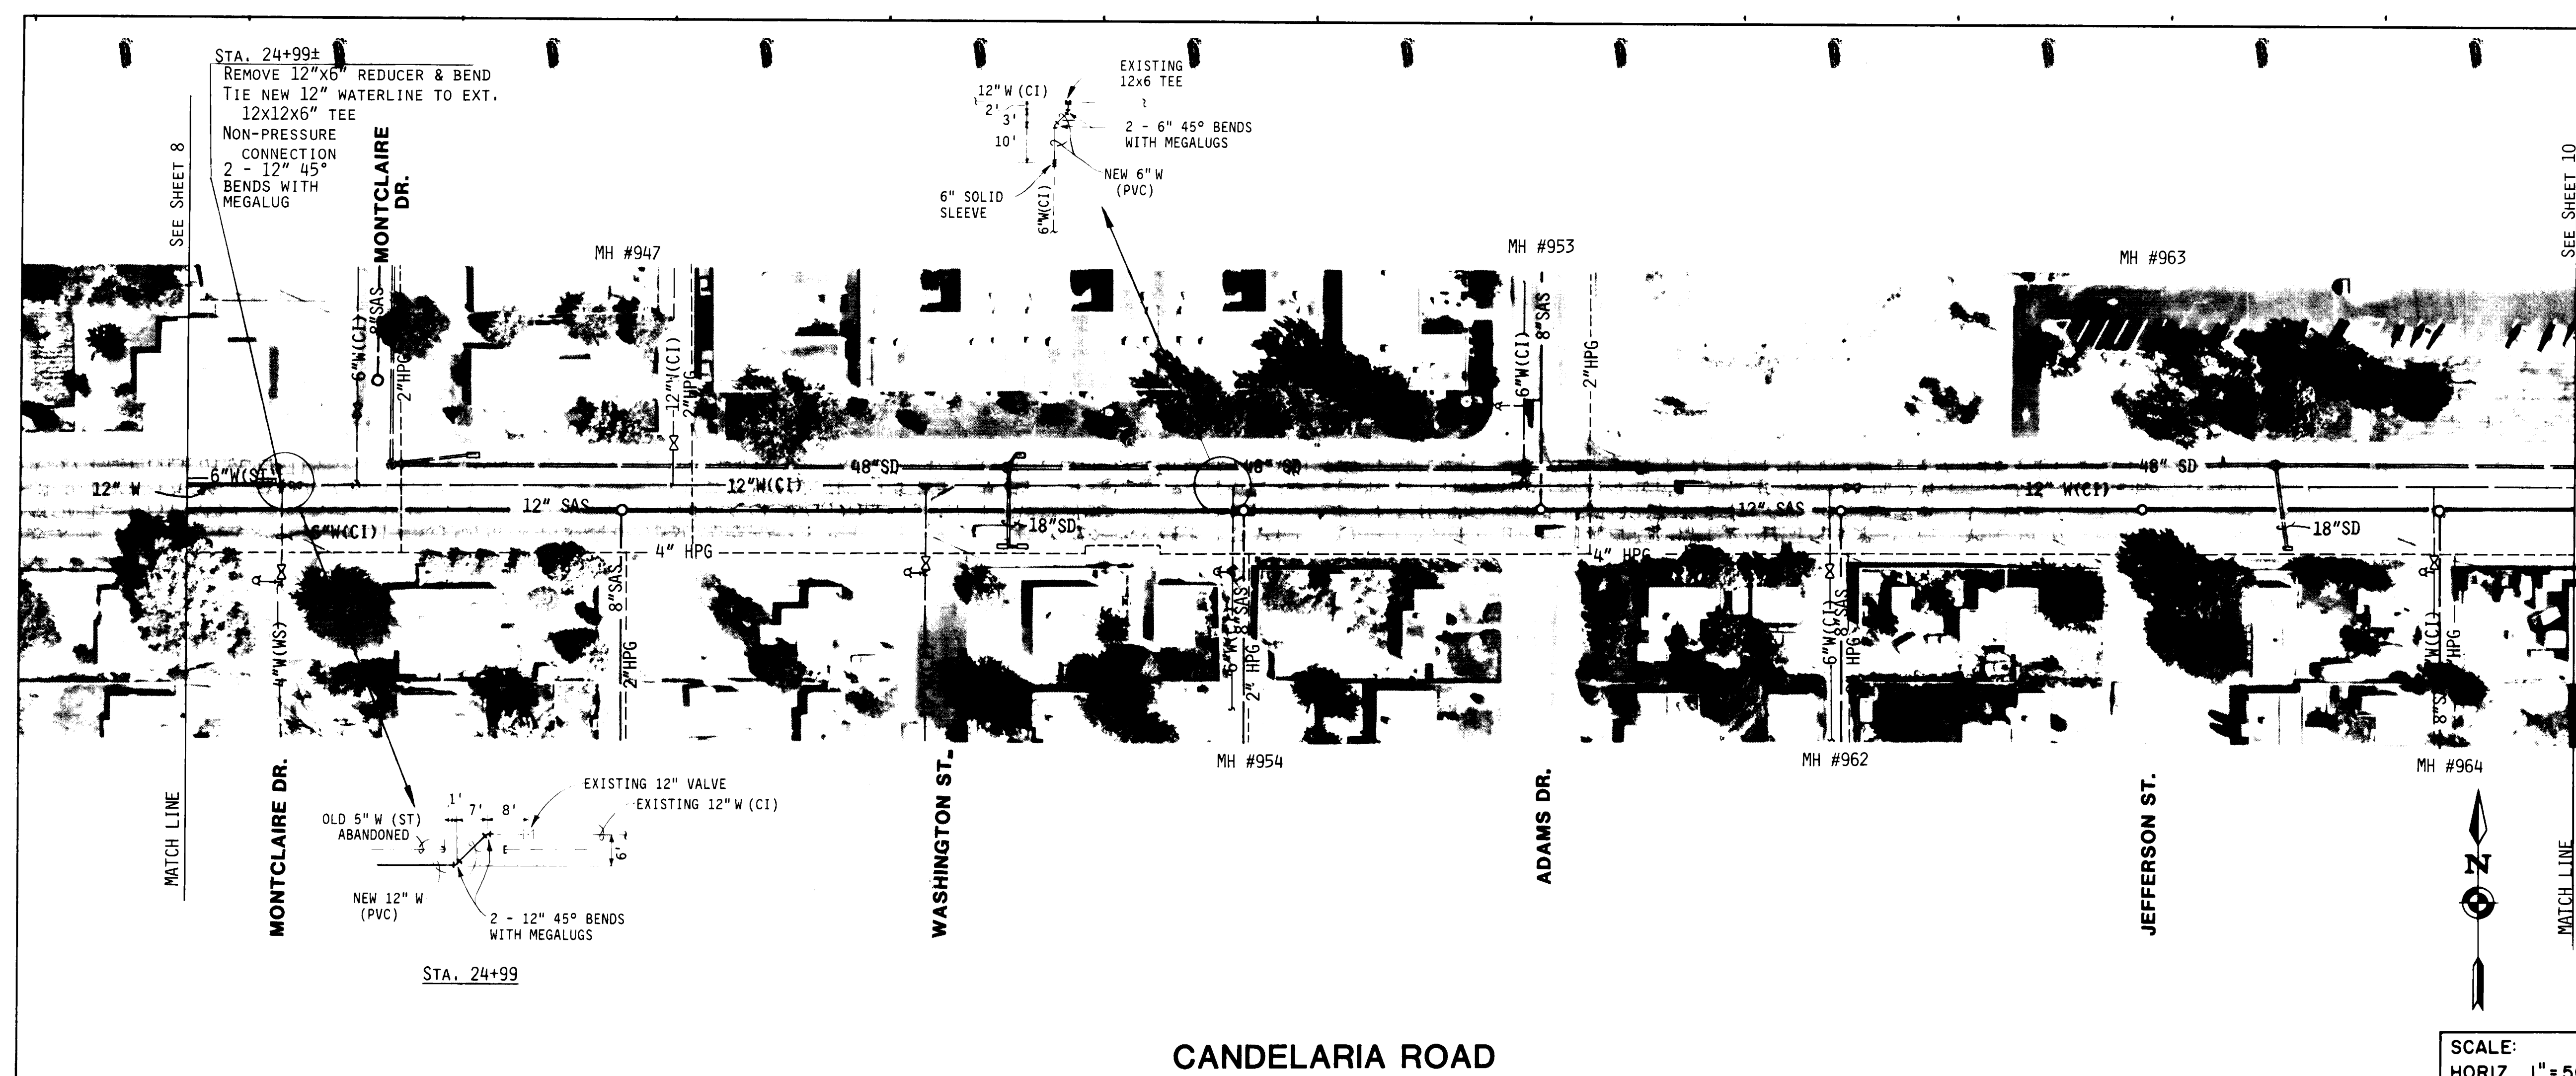

NOTES
1. SEE WATER VALVE SHUT-OFF PLAN ON SHEET 22.

SURVEY INFORMATION		BENCH MARKS		AS BUILT INFORMATION	
NO.	BY	DATE	FIELD NOTES	CONTRACTOR	SUNDANCE MECHANICAL
1	S.D.G.	7/88	ACB BRASS CAP "6-H17" SET FLUSH WITH THE CURB IN THE SW QUADRANT OF THE INTERSECTION OF GRACELAND DR. AND CANDELARIA RD. NE ELEVATION: 5161.13	STAKED BY	G. MARQUEZ
2				DATE	1990
3				FIELD	DATE 6/90
4				VERIFICATION	DATE 8/90
5				CORRECTED BY	DATE 8/90
6				RECORDED BY	DATE
7				NO	

ENGINEER'S SEAL

5.5.89

REVIEW DRAWING
C of A PWD Maps & Records
26 3503 10793
WARNING
This is part of a record document. Record documents are based on reports submitted by others. Engineers cannot assure nor assume any responsibility, or liability, for the accuracy or completeness of record documents. Users of record documents are advised to obtain independent verification of actual conditions.

Isaacson & Arfman, P.A.
CONSULTING ENGINEERING ASSOCIATES
Albuquerque, New Mexico

CITY OF ALBUQUERQUE
PUBLIC WORKS DEPARTMENT
ENGINEERING GROUP

TITLE:
FY88-89 WATERLINE & SEWERLINE RENEWAL PROGRAM, AREA II
CANDELARIA ROAD STA. 24+50 TO STA. 37+00

APPROVALS	ENGINEER	DATE	APPROVALS	ENGINEER	DATE
D.R.C. Chair		5.11.89	Liquid Waste		
Trans. Dev.			Freight		
Utility Dev.			Water		

DRAWING NO.	3503	MAP NO.	G-17	SHEET	9	OF	24
-------------	------	---------	------	-------	---	----	----



MH #611

MH #711

MH #631


MH #731

NOT PART OF THIS CONTRACT

LA VETA DRIVE

VALENCIA DRIVE

SCALE:
HORIZ. 1" = 50'
VERT. 1" = 5'

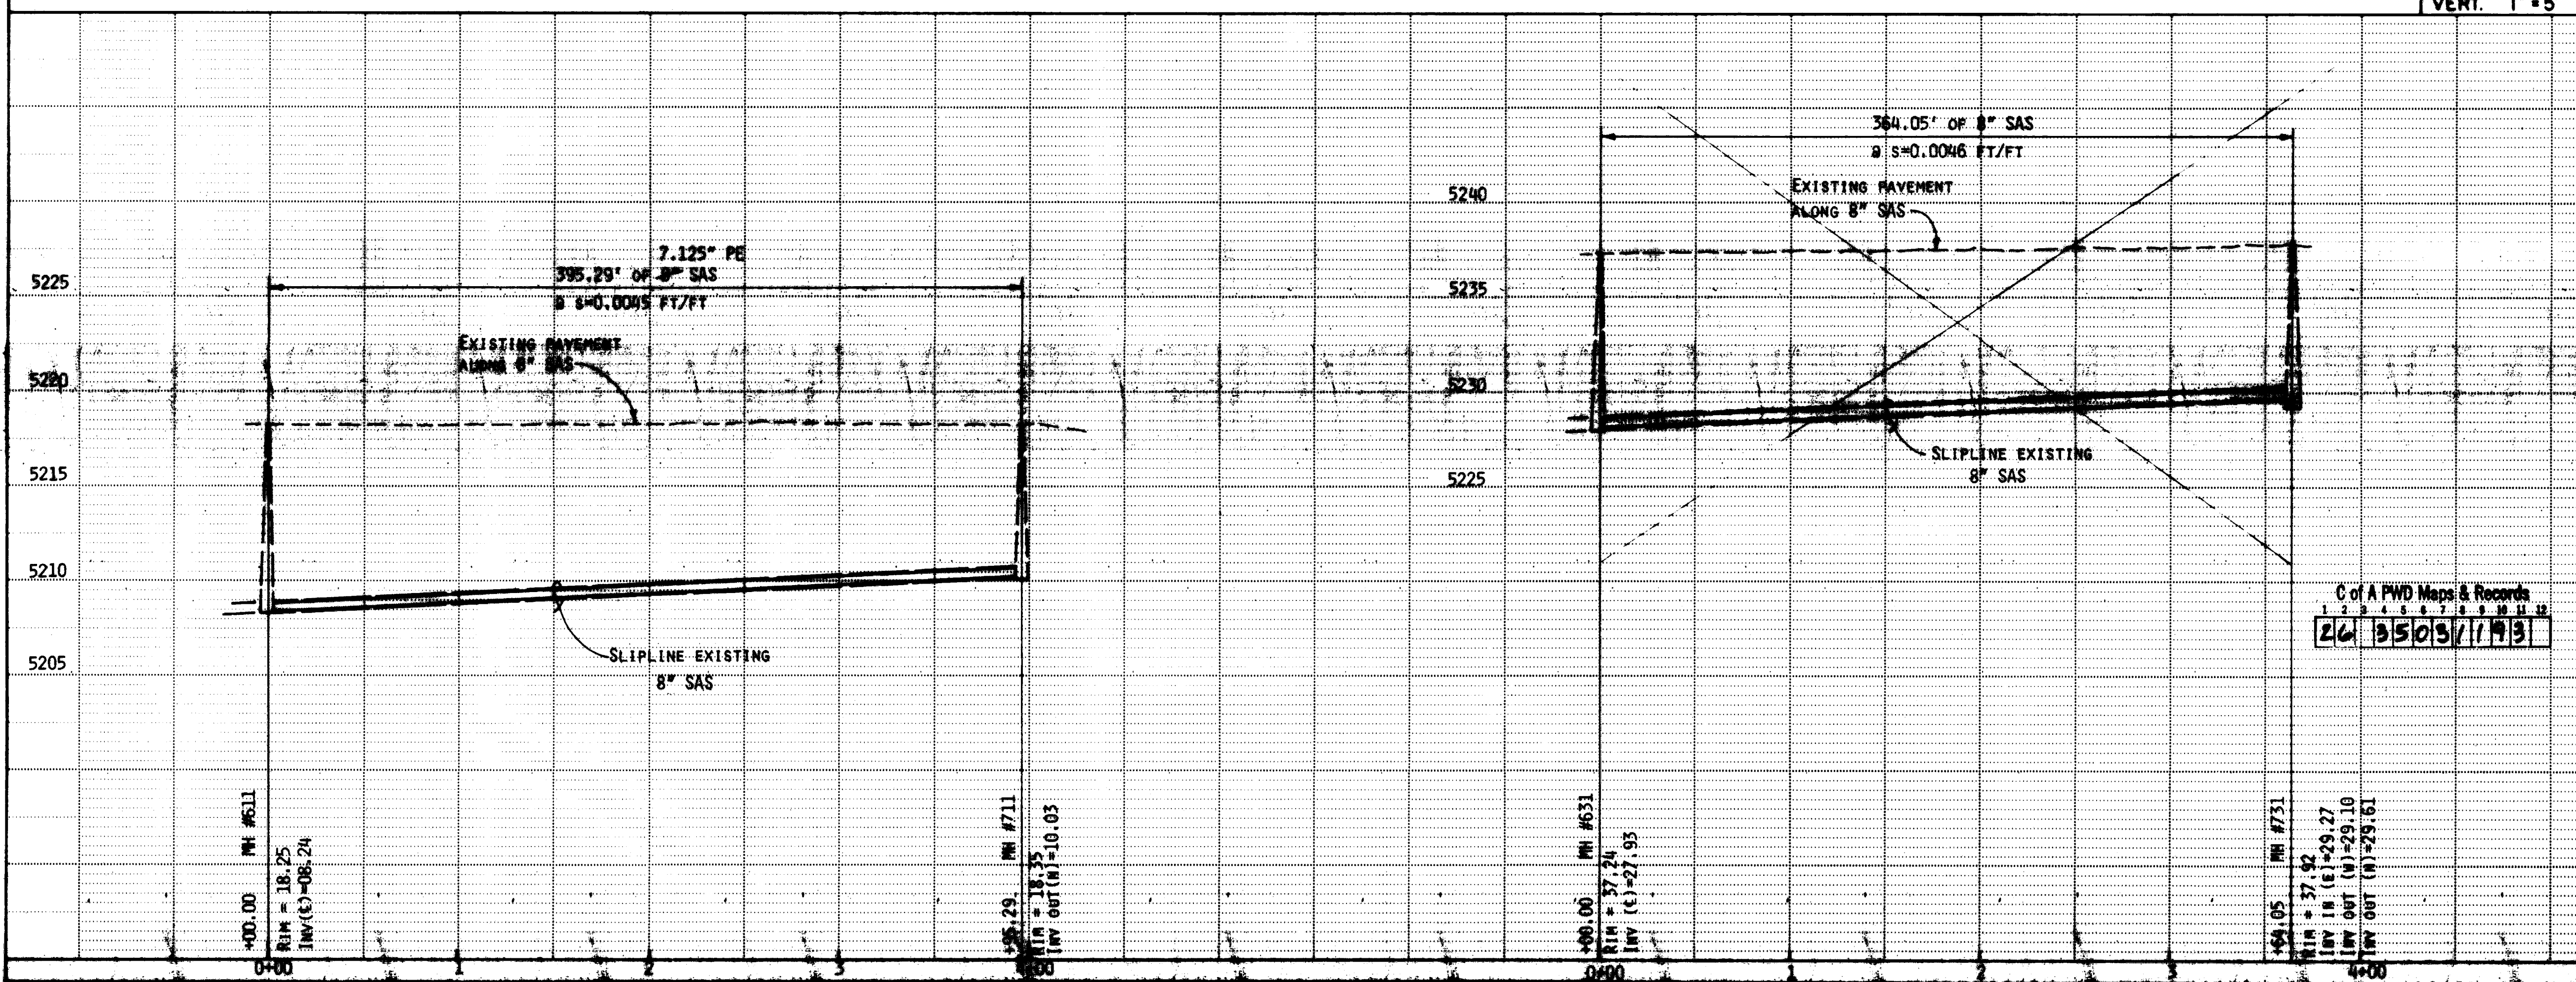

NOTES

1. NO WATERLINE REPLACEMENT WORK IS SCHEDULED FOR EITHER OF THE TWO AREAS SHOWN ON THIS SHEET.

SURVEY INFORMATION			BENCH MARKS			AS BUILT INFORMATION		
NO.	BY	DATE	NO.	BY	DATE	NO.	BY	DATE
	S. D. G.	7/88						
FIELD NOTES			MUSIC JESS CAP "MH 367-6" LOCATED 10 FEET NORTH OF THE NOSE OF THE MEDIAN IN SAN MATEO BLVD NE NORTH OF ITS INTERSECTION WITH ARVILLA AVENUE NE			CONTRACTOR: SUNDANCE MECHANICAL		
						STATED BY: G. MARQUEZ DATE: 1/90		
						ACCEPTANCE BY: A. OSTAPACK DATE: 4/90		
						FIELD NOTES BY: ALAN O. DATE: 4/90		
						CORRECTED BY: J. & A. DATE: 8/91		
						MICRO-FILM INFORMATION		
						RECORDED BY: DATE:		
						NO.		

ENGINEER'S SEAL

Isaacson & Arfman

24 3503/1/93

NO.	DATE	REVISIONS	BY
		DESIGN	

DESIGNED BY	DATE
SM	11/88

DRAWN BY	DATE
NA	1/89

CHECKED BY	DATE

Isaacson & Arfman, P.A.
CONSULTING ENGINEERING ASSOCIATES
Albuquerque, New Mexico

RECORD DRAWING

WARNING
This is a record drawing. It is not to be used for construction. It is for informational purposes only. The accuracy of the information is not guaranteed. The user assumes all responsibility for the use of this information.



Isaacson & Arfman, P.A.
CONSULTING ENGINEERING ASSOCIATES
Albuquerque, New Mexico

CITY OF ALBUQUERQUE
PUBLIC WORKS DEPARTMENT
ENGINEERING GROUP

TITLE: FY88-89 WATERLINE & SEWERLINE RENEWAL PROGRAM, AREA II
LA VETA DRIVE & VALENCIA DRIVE

APPROVALS	ENGINEER	DATE	APPROVALS	ENGINEER	DATE
D.R.C. Chair	<i>[Signature]</i>	<i>[Date]</i>	D.R.C. Chair	<i>[Signature]</i>	<i>[Date]</i>
Trans. Dev.	<i>[Signature]</i>	<i>[Date]</i>	Trans. Dev.	<i>[Signature]</i>	<i>[Date]</i>
Utility Dev.	<i>[Signature]</i>	<i>[Date]</i>	Utility Dev.	<i>[Signature]</i>	<i>[Date]</i>

NO. 24 3503/1/93

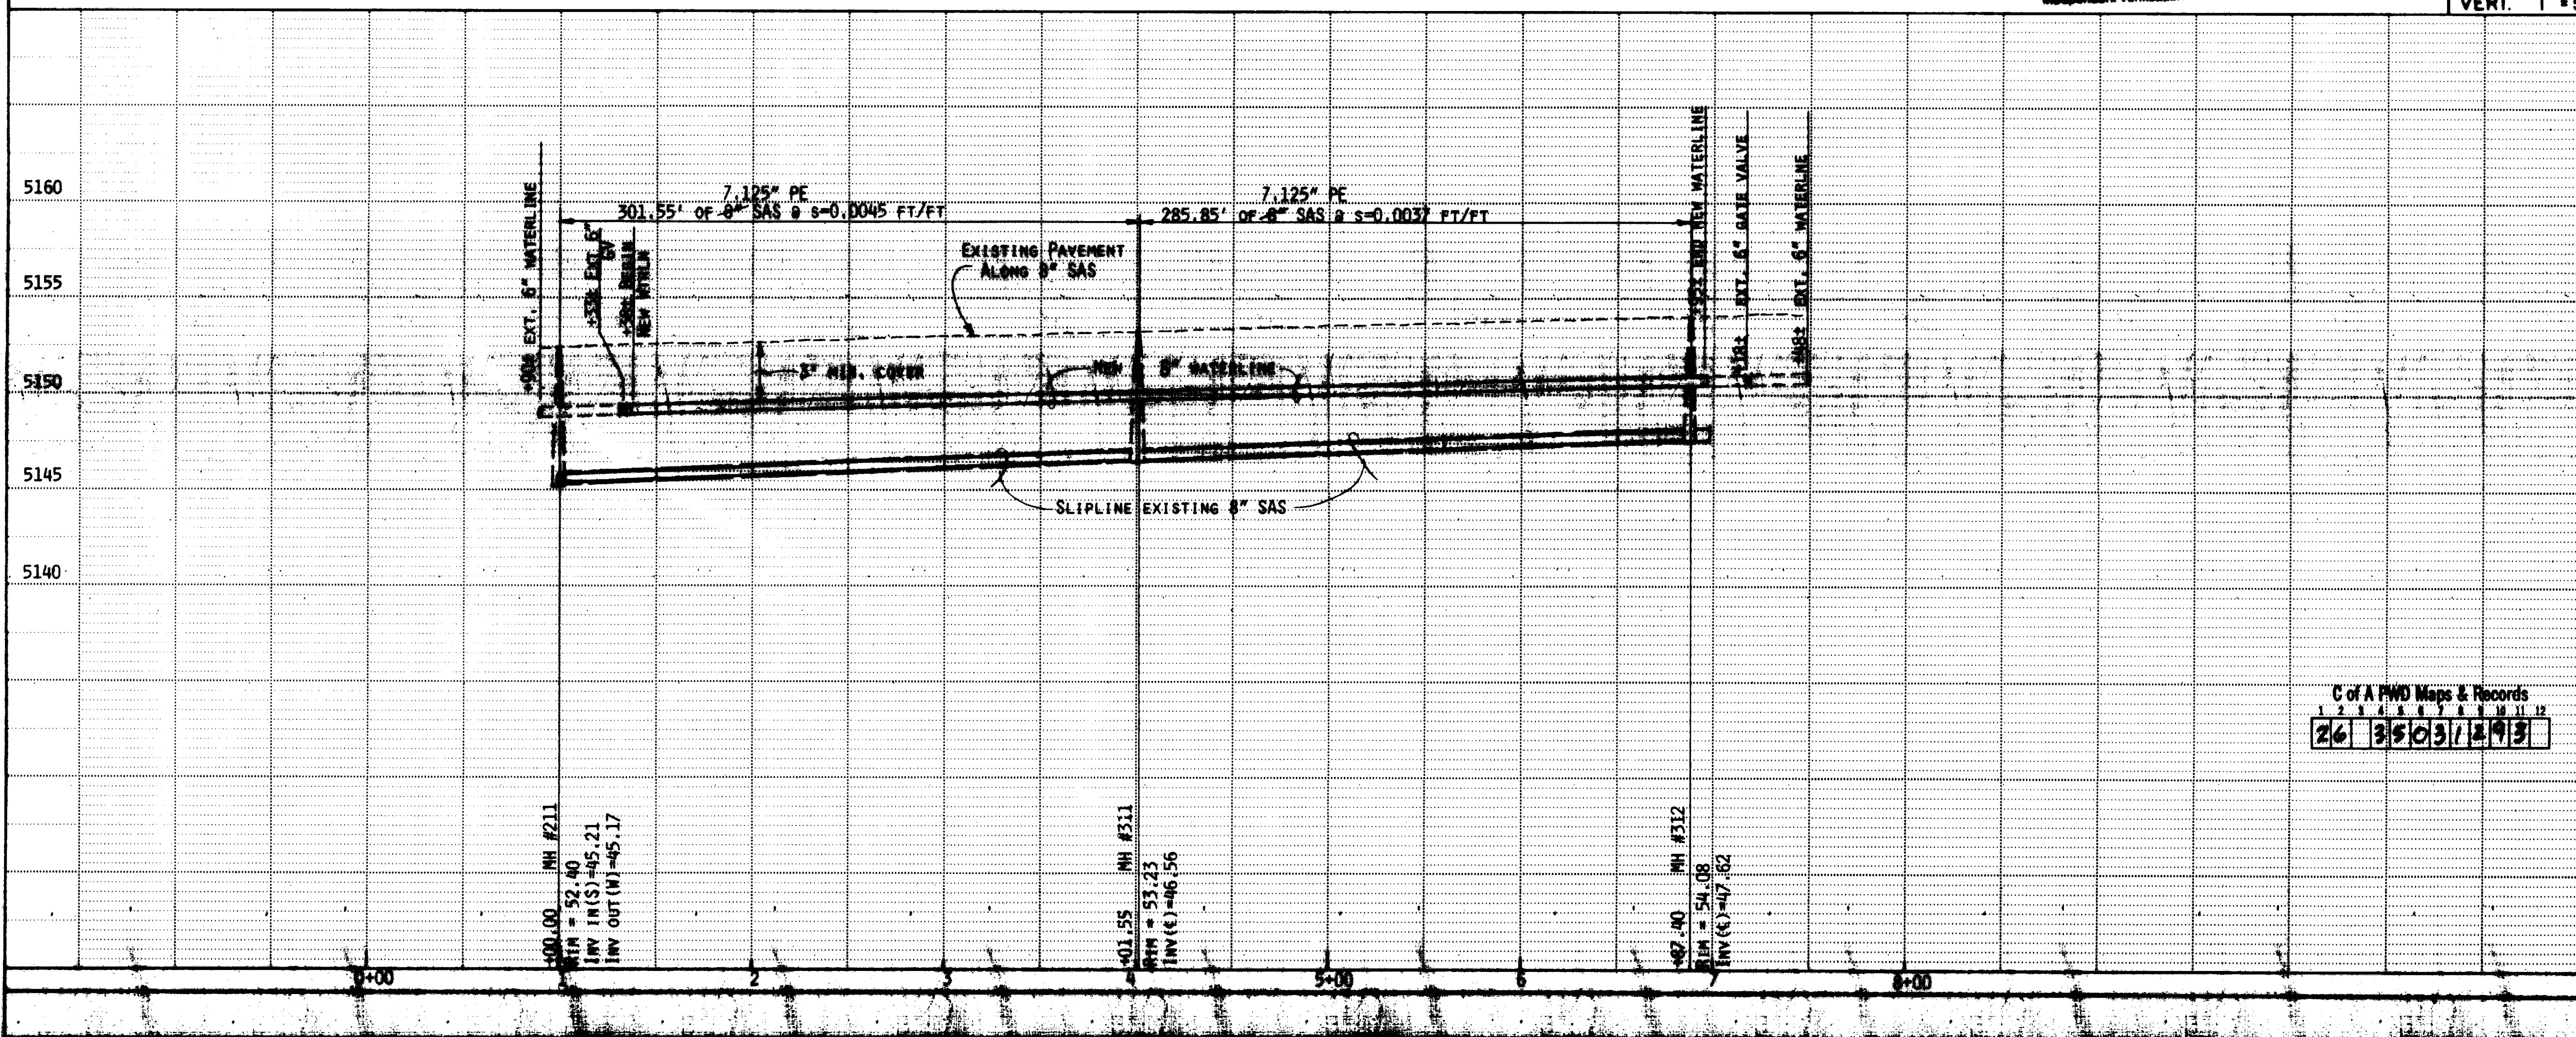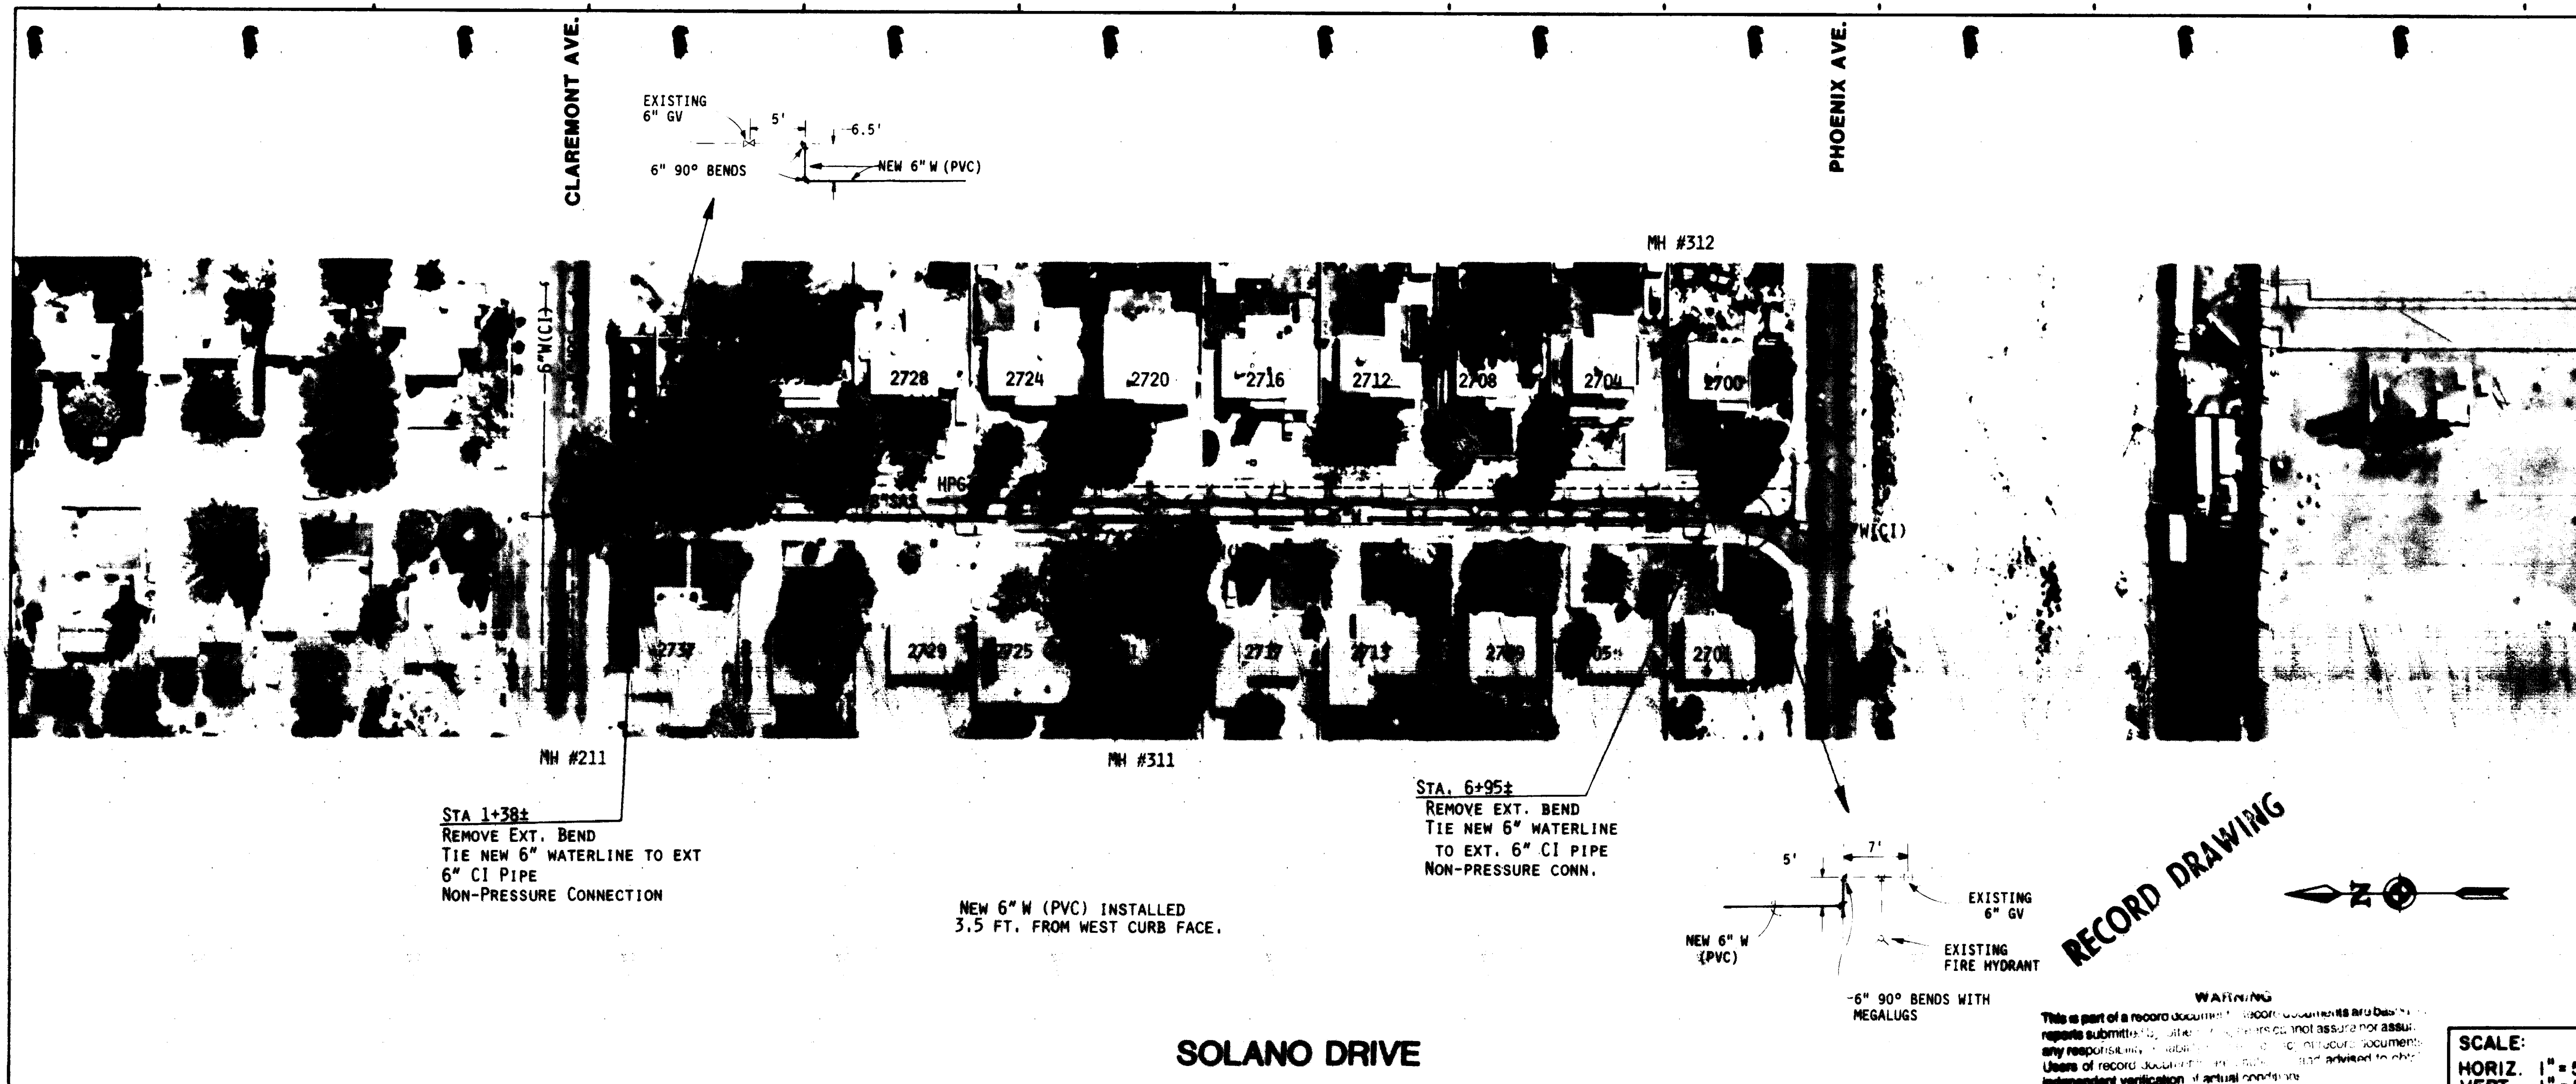

NOTES

1. THE EXISTING 6" STEEL WATERLINE SHALL BE REMOVED AND DISPOSED OF FROM STA. 1+38± TO STA. 6+95±. OLD WATERLINES WERE ABANDONED IN PLACE.

AS BUILT INFORMATION

CONTRACTOR: SUNDANCE MECHANICAL

WORK: WATER SERVICE REHABILITATION

INSPECTED BY: G. MARQUEZ

DATE: 1/90

ACCEPTANCE BY: A. OSTAPACK

DATE: 4/90

REVISIONS BY: J. & A. MARQUEZ

DATE: 8/91

REVISIONS BY: J. & A. MARQUEZ

DATE: 8/91

REVISIONS BY: J. & A. MARQUEZ

DATE: 8/91

WATER VALVE SHUT-OFF PLAN

KEY TO WATER SERVICE REHAB. TABLE

- 1 SERVICE LINE TRANSFER
- 2 METER BOX RELOCATION & REPLACEMENT
- 3 SERVICE LINE REPLACEMENT

WATER SERVICE REHABILITATION

SOLANO ADDRESS	METER SIZE	1	2	3
2700	3/4"			
2701	"			
2704	"	X	X	
2705	"			X
2708	"	X	X	
2709	"			X
2712	"	X	X	
2713	"			X
2716	"	X	X	
2717	"			X
2720	"	X	X	
2721	"			X
2724	"	X	X	
2725	1-1/4"			X
2728	3/4"	X	X	
2729	"			X
2732	"	X	X	
2733	"			X
2736	"	X	X	
2737	"			X

Isaacson & Arfman, P.A.

CONSULTING ENGINEERING ASSOCIATES

Albuquerque, New Mexico

CITY OF ALBUQUERQUE



PUBLIC WORKS DEPARTMENT

ENGINEERING GROUP

TITLE: FY88-89 WATERLINE & SEWERLINE RENEWAL PROGRAM, AREA II

SOLANO DRIVE

APPROVALS	ENGINEER	DATE	APPROVALS	ENGINEER	DATE
Dr. C. Chair	Isaacson	12/88	Isaacson		
Trans. Dev.					
Utility Dev.					

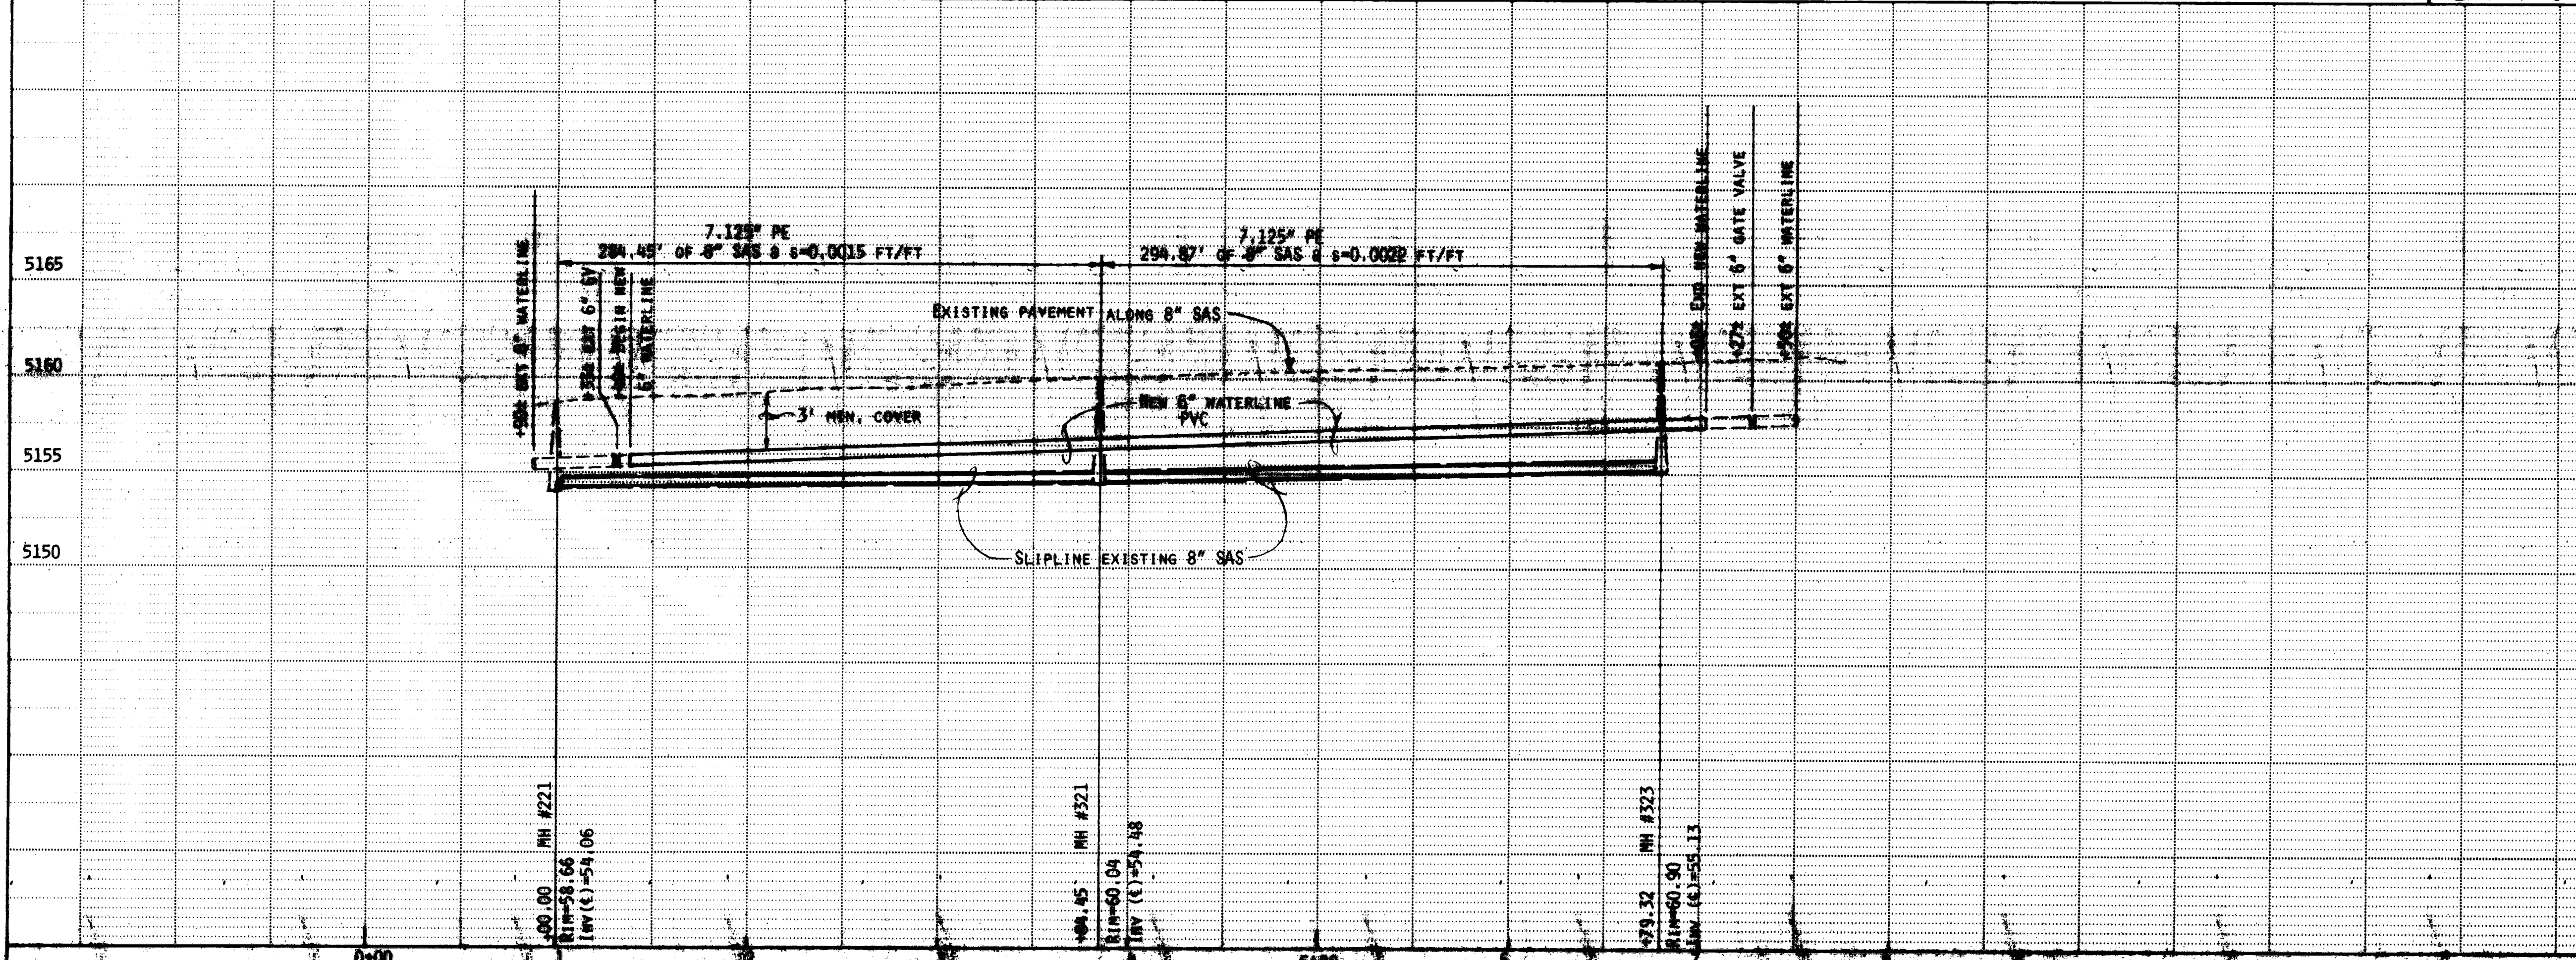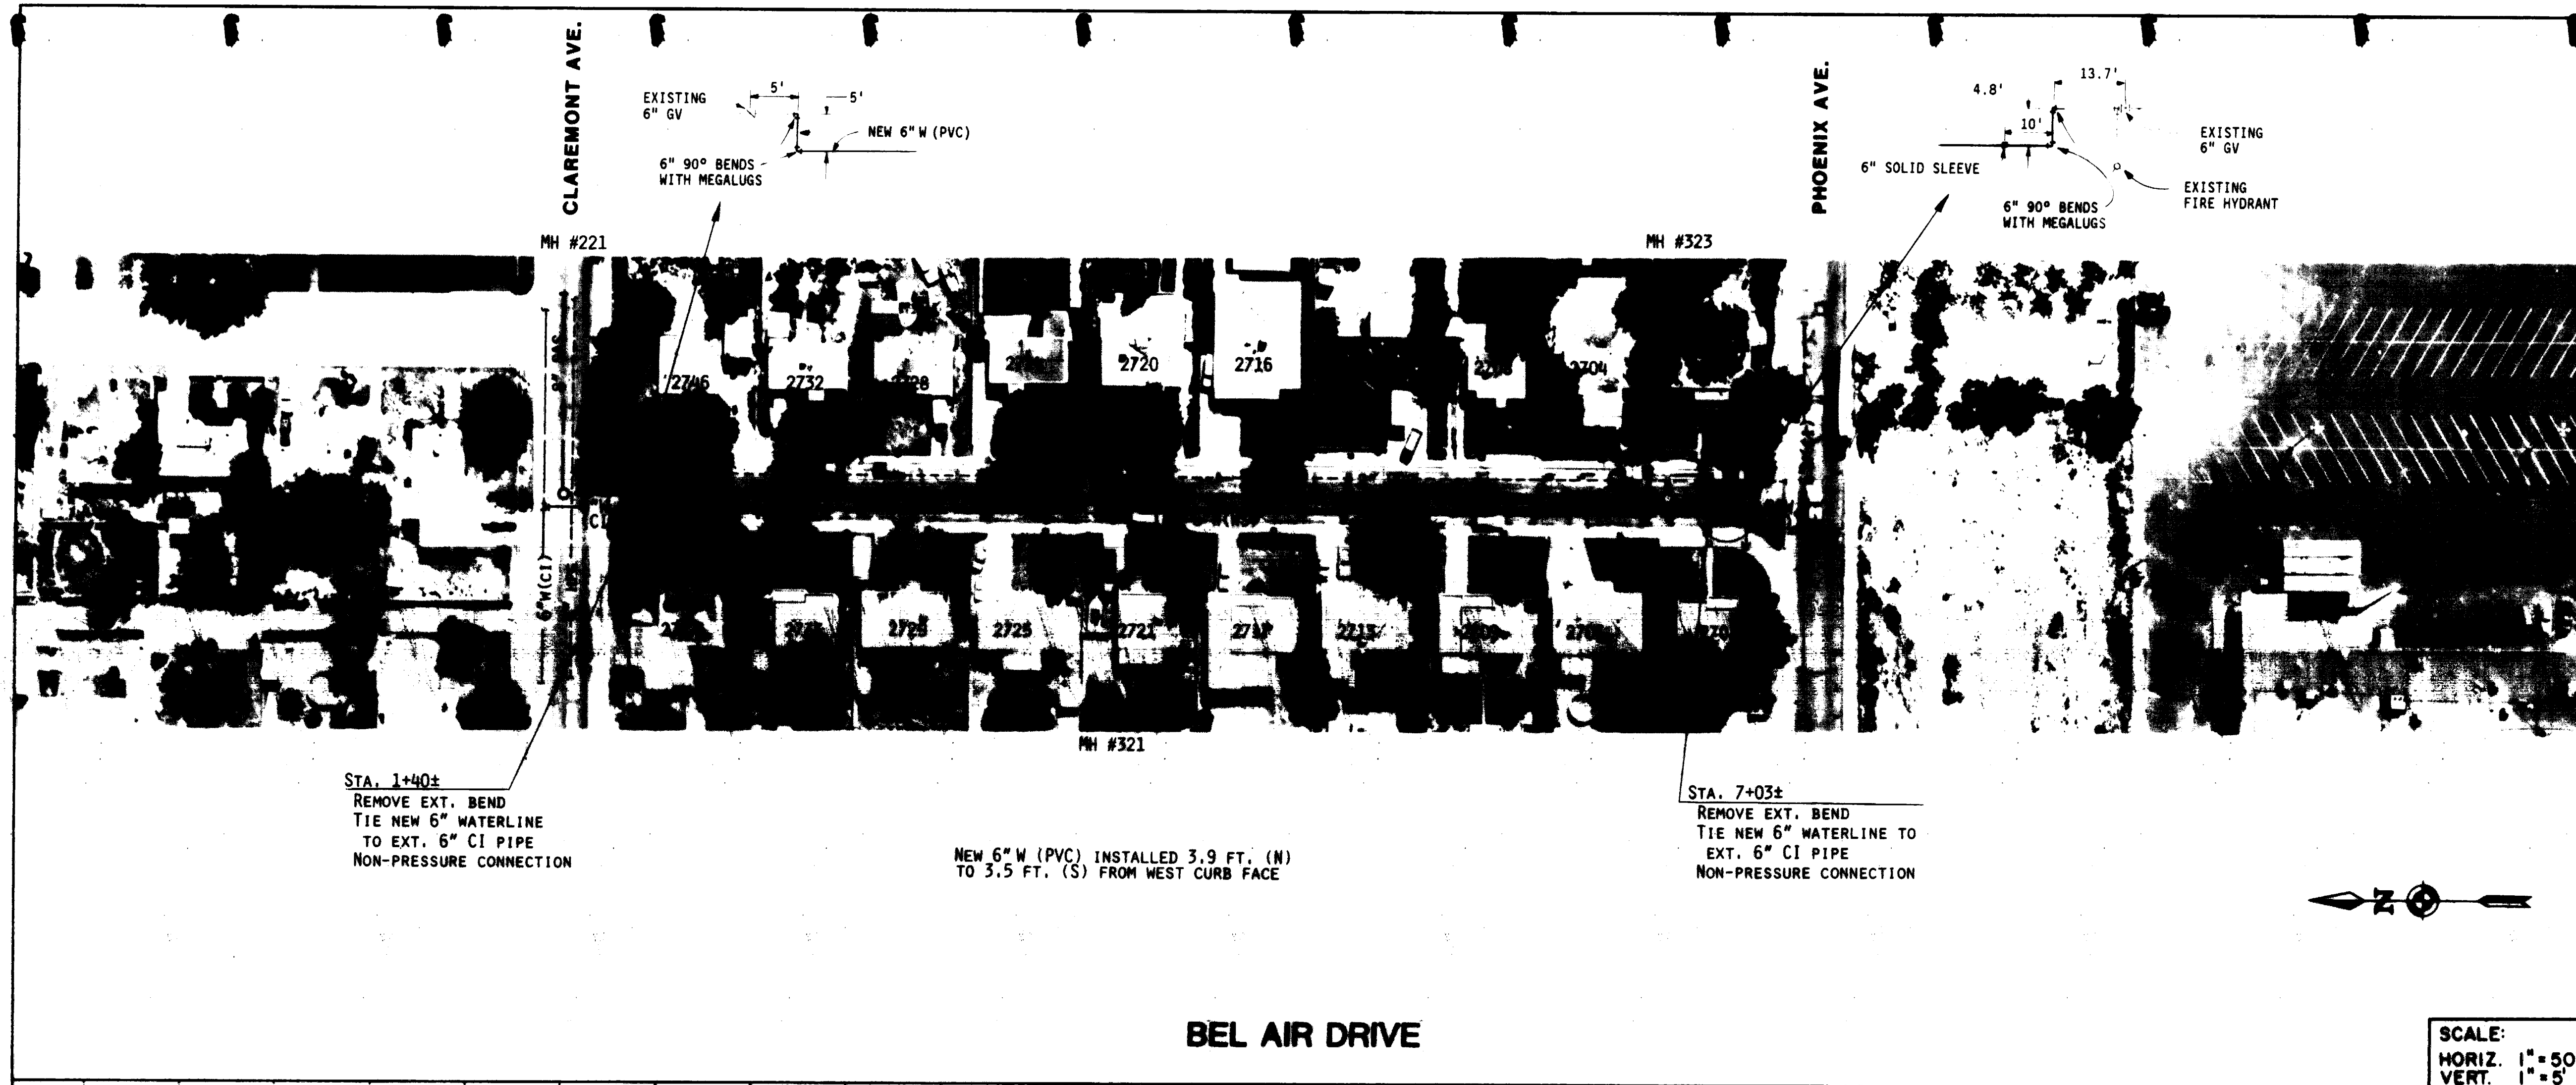

NOTES

- SEE SHEET 12 FOR WATER VALVE SHUT-OFF PLAN.
- THE EXISTING 6" STEEL WATERLINE SHALL BE REMOVED AND DISPOSED OF FROM STA. 1+40± TO STA. 7+03±. OLD WATERLINES WERE ABANDONED IN PLACE.

RECORD DRAWING

WARNING: This is part of a record document. Record documents are based on reports submitted by others. Engineers cannot assure nor assume any responsibility for the accuracy of record documents. Users of record documents are cautioned and advised to obtain independent verification of actual conditions.

WATER SERVICE RENOVATION

BEL. ADDR.	METER SIZE	①	②	③
2700	3/4"	X	X	
2701	"			X
2704	"	X		
2705	"			X
2708	"	X	X	
2709	"			X
2712	"	X	X	
2713	"			X
2716	"	X	X	
2717	"			X
2720	"	X	X	
2721	"			X
2724	"	X	X	
2725	"			X
2728	"	X	X	
2729	"			X
2732	"	X	X	
2733	"			X
2737	"			X
2746	"	X	X	

KEY:

- ① SERVICE LINE TRANSFER
- ② METER BOX RELOCATION & REPLACEMENT
- ③ SERVICE LINE REPLACEMENT

C of A PWD Maps & Records


24 35 03 13 93

Isaacson & Arfman, P.A.
CONSULTING ENGINEERING ASSOCIATES
Albuquerque, New Mexico

CITY OF ALBUQUERQUE
PUBLIC WORKS DEPARTMENT
ENGINEERING GROUP

TITLE: FY88-89 WATERLINE & SEWERLINE RENEWAL PROGRAM, AREA I
BEL AIR DRIVE

APPROVALS	ENGINEER	DATE	APPROVALS	ENGINEER	DATE
D.R.C. Chair	Isaacson	12/28	Isaacson		
Trans. Div.			Isaacson		
Utility Div.			Isaacson		

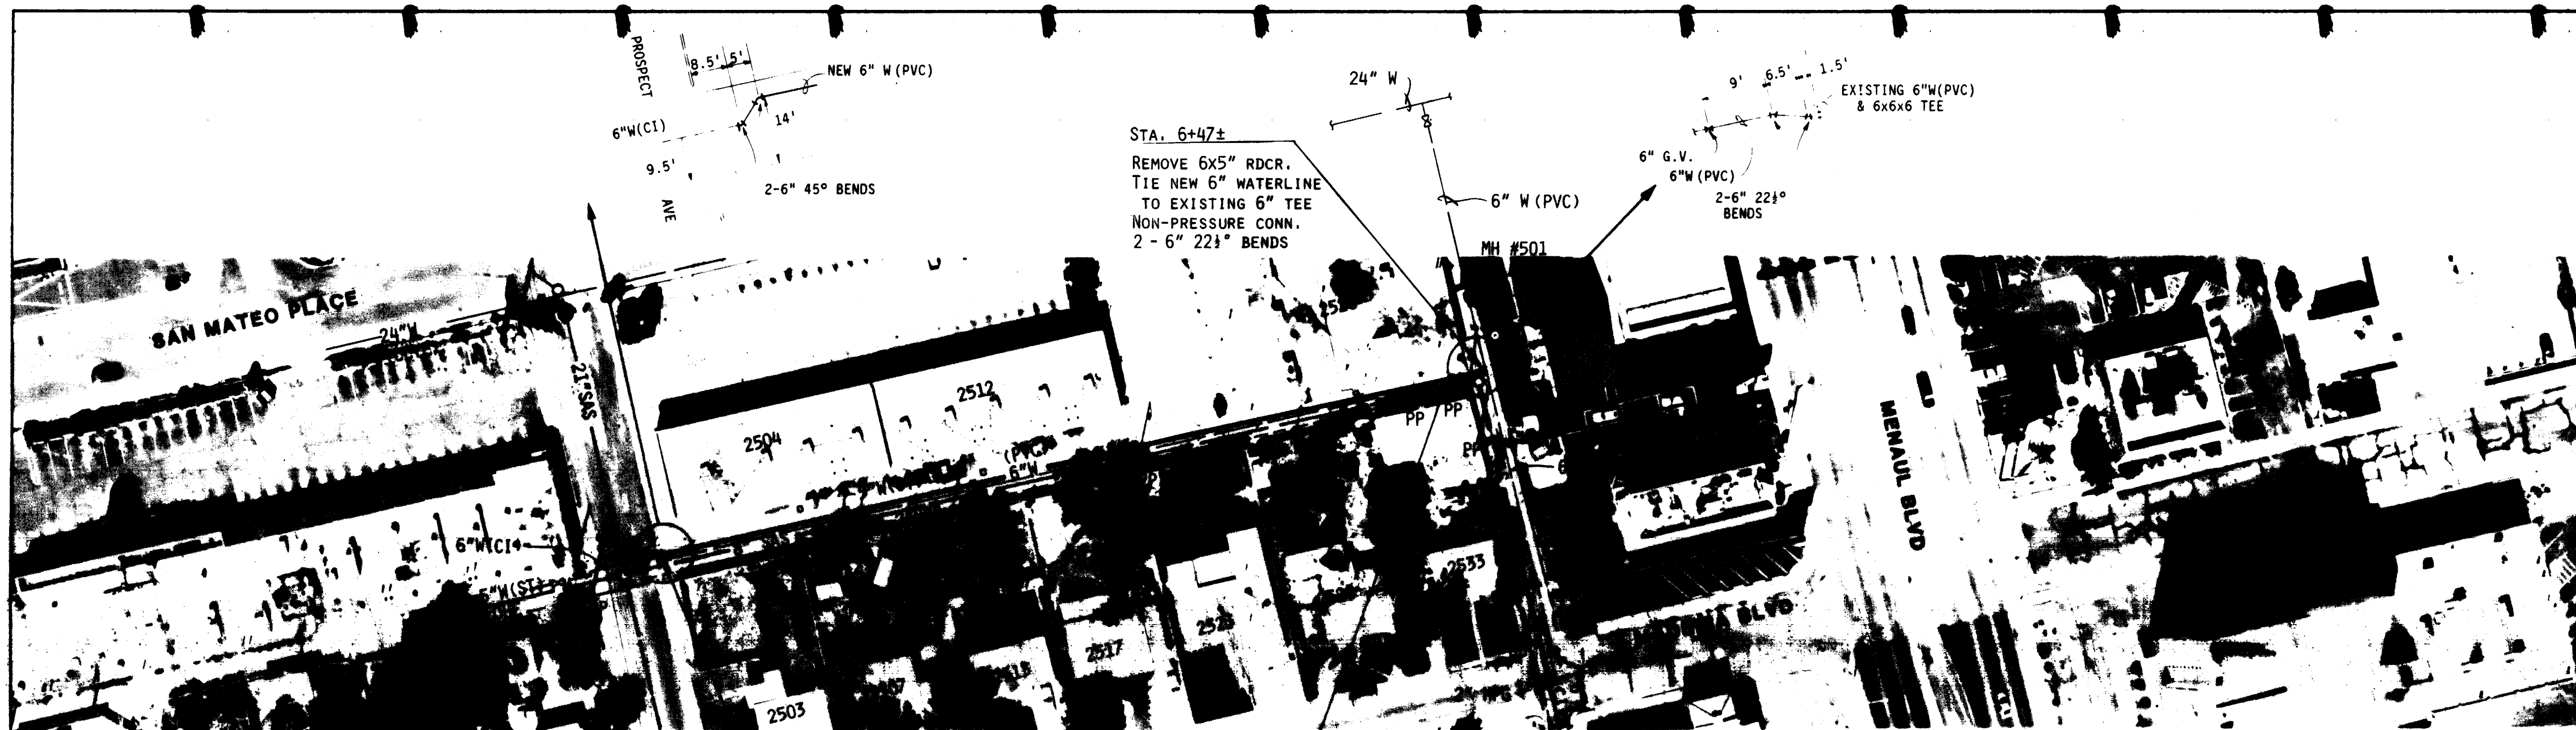


RECORD DRAWING

SAN MATEO EAST ALLEY

WARNING
This is part of a record document. Record documents are based on reports submitted by the contractor. The engineer does not assume any responsibility for the accuracy of the information provided. Users of record documents are advised to obtain independent verification of actual conditions.

SCALE:
HORIZ. 1" = 50'
VERT. 1" = 5'

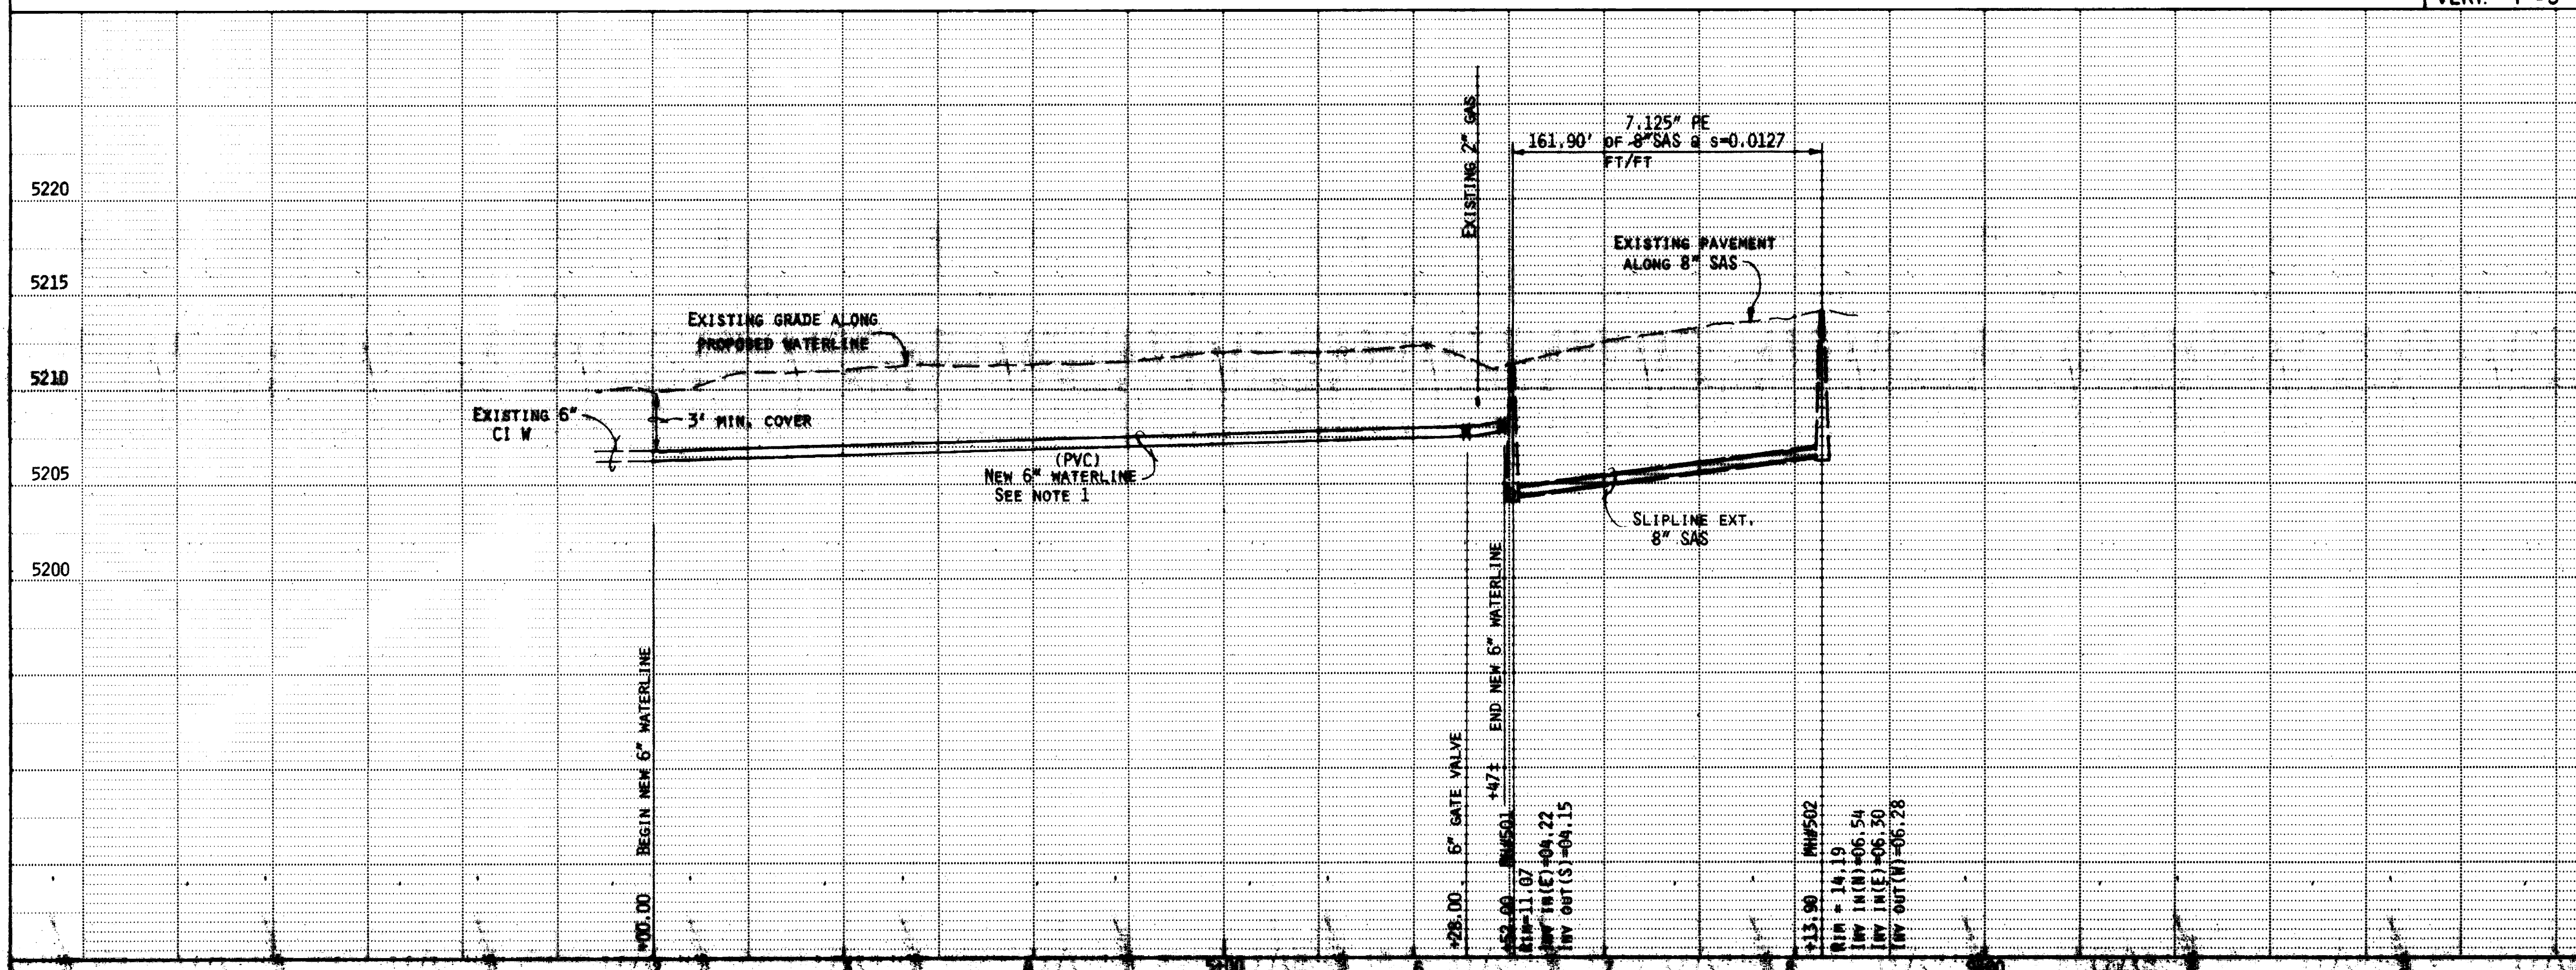

NOTES

- CONTRACTOR SHALL PROVIDE A CONTINUOUS POSITIVE GRADE FOR THE WATERLINE INSTALLATION SHOWN.
- THE WATER VALVE SHUT-OFF PLAN FOR THIS WORK IS SHOWN ON SHEET 22.
- CONTRACTOR SHALL REPLACE APPROX. 150 FEET OF PAVING AT THE SOUTH END OF ALLEY EAST OF SAN MATEO PLACE AS PER DRAWING NO. 2415 FOR TEMPORARY PAVEMENT.
- CONTRACTOR SHALL NOTIFY PUBLIC SERVICE CO. OF NM WHEN LIP OF TRENCH IS LESS THAN 5' FROM POWER POLE. COSTS ASSOCIATED WITH SUPPORTING EXISTING POLES SHALL BE INCIDENTAL TO THE PROJECT.
- THE EXISTING 5" STEEL WATERLINE SHALL BE REMOVED & DISPOSED OF FROM STA. 2+00± TO STA. 6+47±.
- CONTRACTOR SHALL VERIFY WATER LINE PIPE MATERIAL, IN EAST-WEST ALLEY SOUTH OF MANUAL BLVD. WHEN MAKING THE CONNECTION AT STA. 6+47±.

WATER SERVICE REHABILITATION

STREET ADDRESS	METER SIZE	①	②	③
2504 SAN MATEO PL	3/4"	X	X	
2512 " " "	"	X	X	
2520 " " "	"	X		
2503 MADEIRA	"			X
2507 " " "	"			X
2513 " " "	"			X
2517 " " "	"			X
2523 " " "	"			X
2529 " " "	"			X
2533 " " "	"			X

C of A PWD Maps & Records

26 350317493

- KEY:**
- ① SERVICE LINE TRANSFER
 - ② METER BOX RELOCATION & REPLACEMENT
 - ③ SERVICE LINE REPLACEMENT

Isaacson & Arfman, P.A.
CONSULTING ENGINEERING ASSOCIATES
Albuquerque, New Mexico

CITY OF ALBUQUERQUE
PUBLIC WORKS DEPARTMENT
ENGINEERING GROUP

TITLE: FY88-89 WATERLINE & SEWERLINE RENEWAL PROGRAM, AREA I
SAN MATEO EAST ALLEY

APPROVALS	ENGINEER	DATE	APPROVALS	ENGINEER	DATE
D.R.C. Chair	Isaacson	5/2/89			
Specs. Dev.					
City Eng.					

AS BUILT INFORMATION

CONTRACTOR: SUNDANCE MECHANICAL
WORK: 6" MARQUEZ
DATE: 1990
FIELD ACCEPTANCE: A. OSTAPACK
DATE: 4/90
DATE: 10/90
DATE: 8/91
RECORDED BY: I & A
DATE: 8/91

RECORD INFORMATION



DATE: 7/88
BY: S.D.G.
NO. 1

ENGINEER'S SEAL

Isaacson & Arfman, P.A.

REMARKS

DESIGNED BY: SWM
DRAWN BY: MA
CHECKED BY: [Signature]

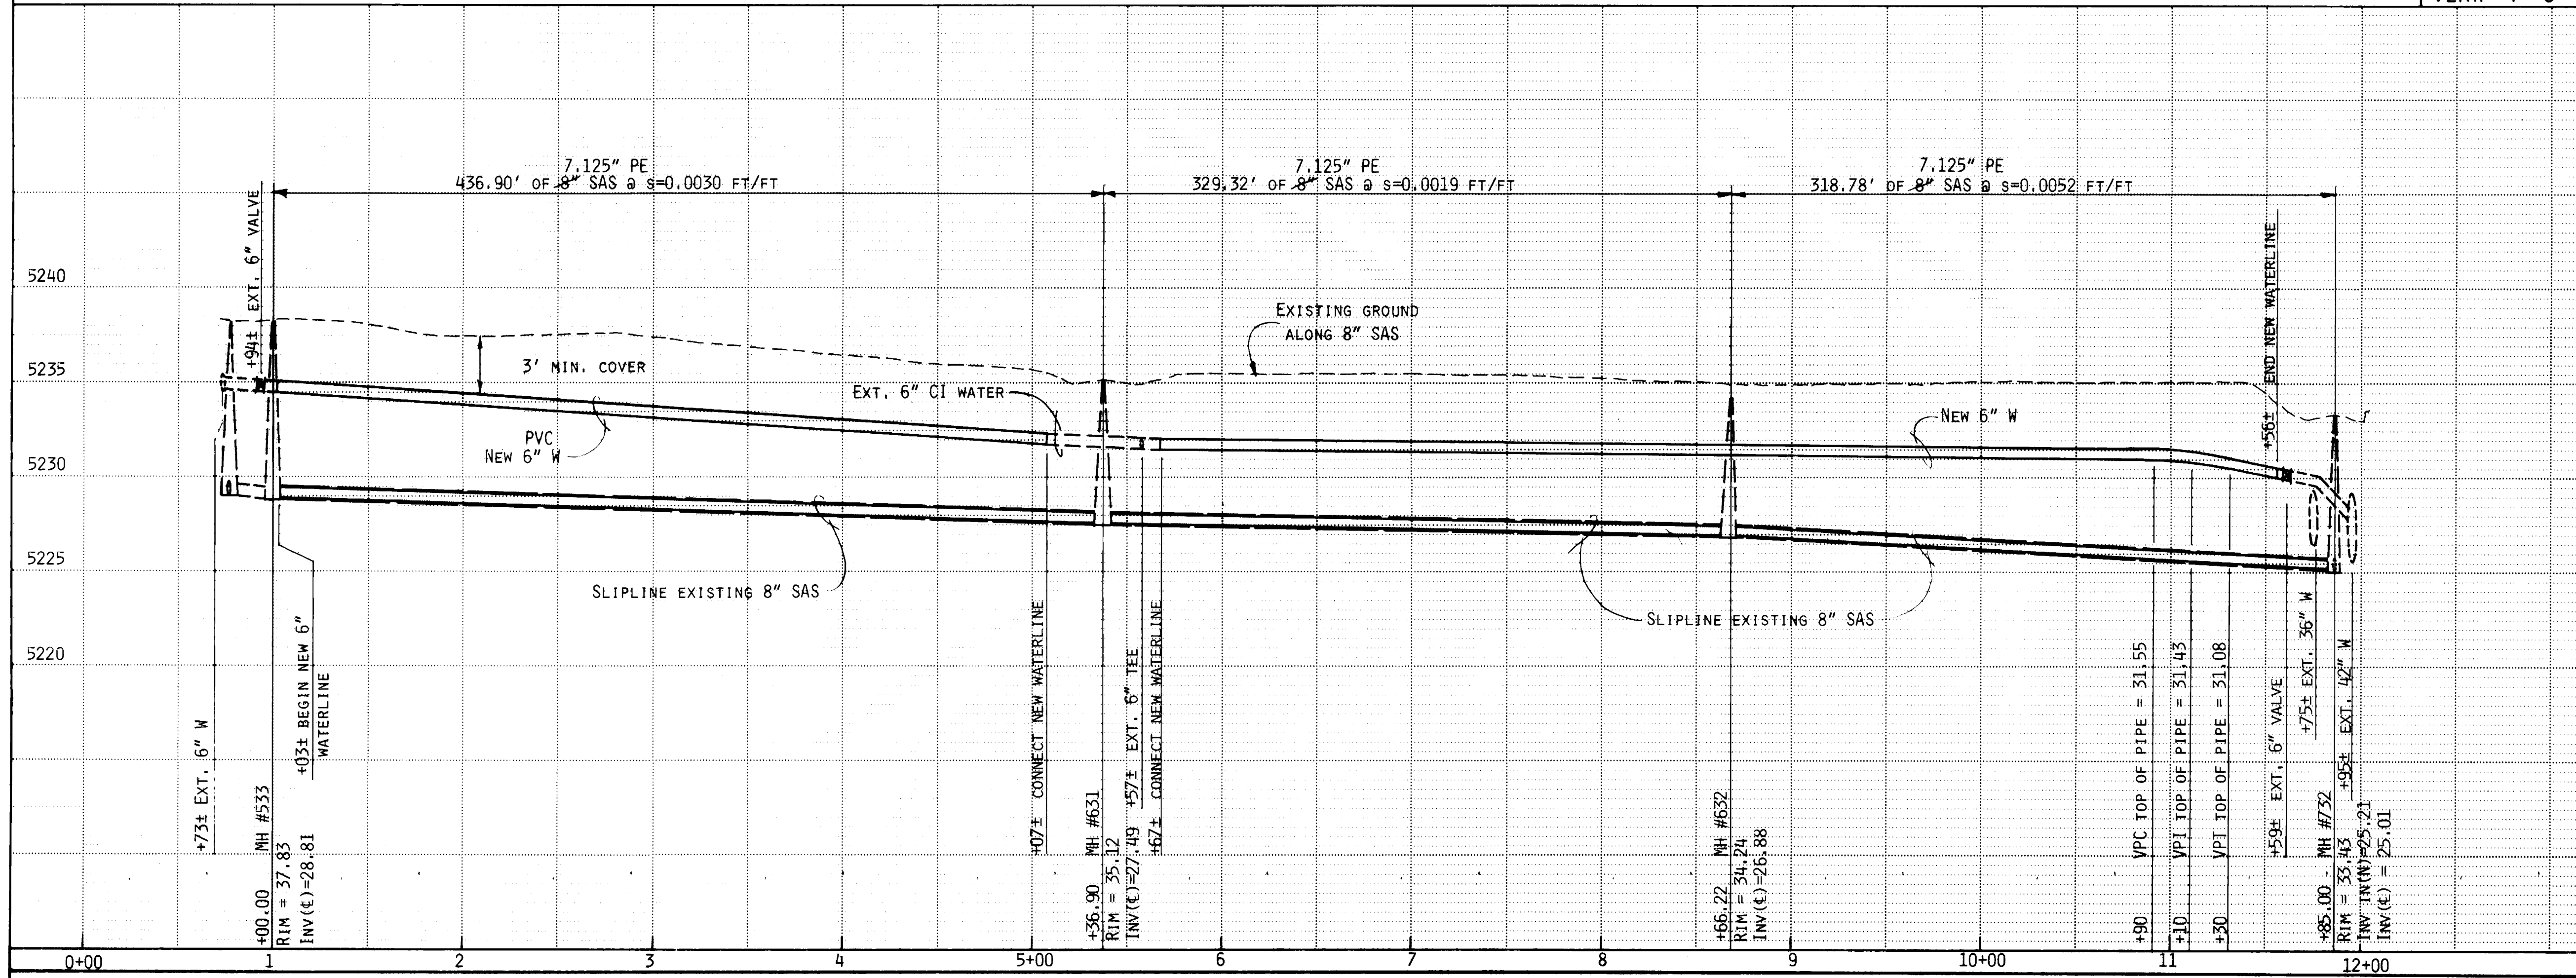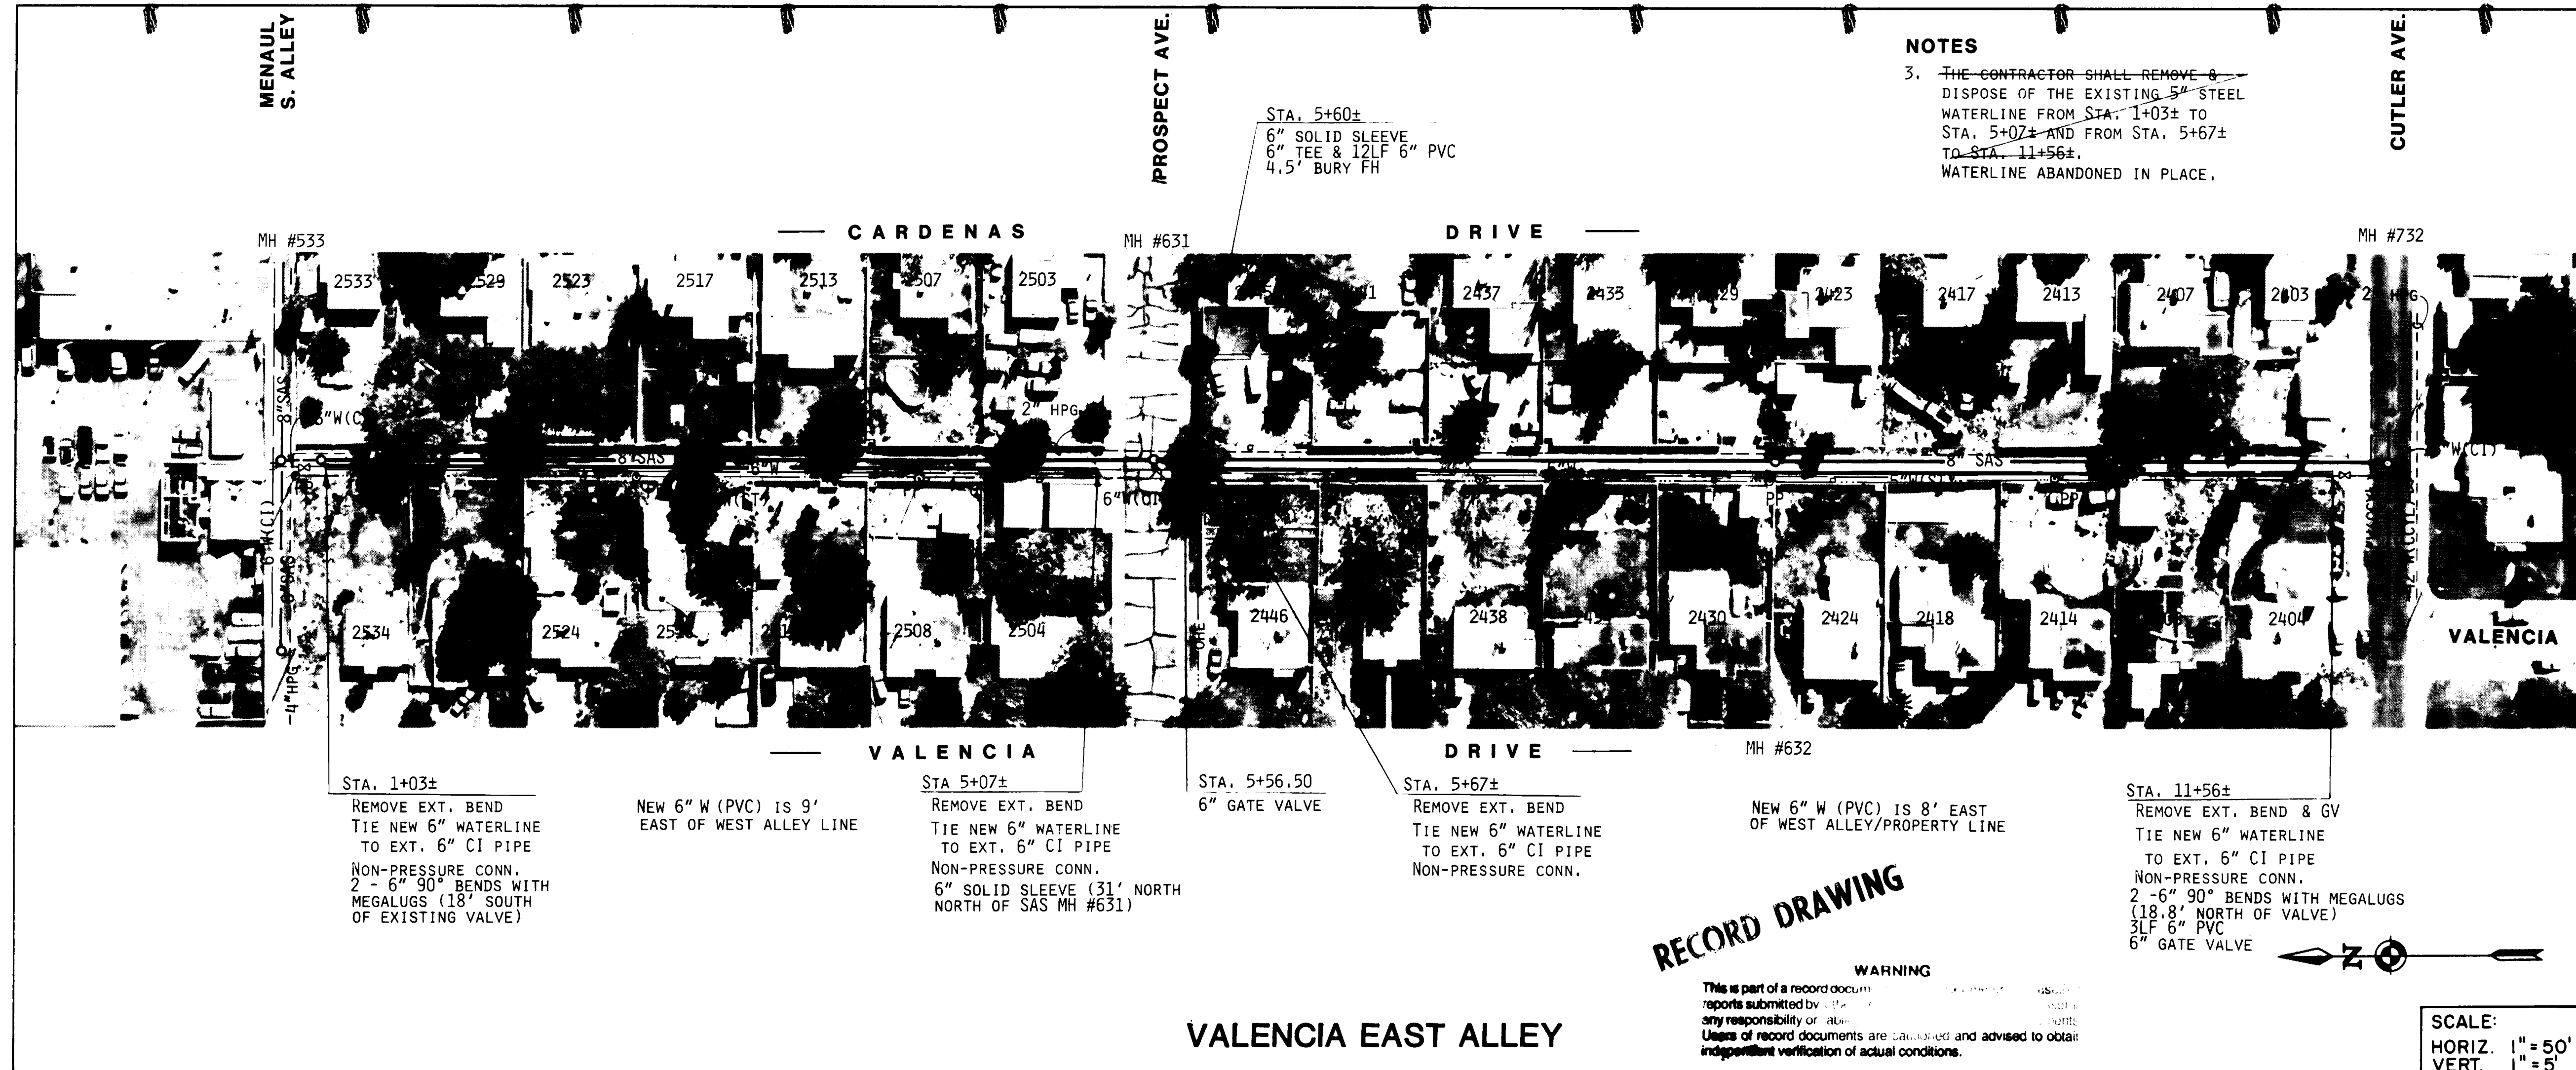


NOTES

3. THE CONTRACTOR SHALL REMOVE & DISPOSE OF THE EXISTING 5" STEEL WATERLINE FROM STA. 1+03± TO STA. 5+07± AND FROM STA. 5+67± TO STA. 11+56±. WATERLINE ABANDONED IN PLACE.

NOTES (CONT. AT LEFT)

1. SEE SHEET NO. 17 FOR REHABILITATION WORK ON VALENCIA DRIVE TO THE SOUTH.

2. CONTRACTOR SHALL NOTIFY PUBLIC SERVICE CO. OF NM WHEN LIP OF TRENCH IS LESS THAN 5' FROM POWER POLE. COSTS ASSOCIATED WITH SUPPORTING EXISTING POLES SHALL BE INCIDENTAL TO THE PROJECT.

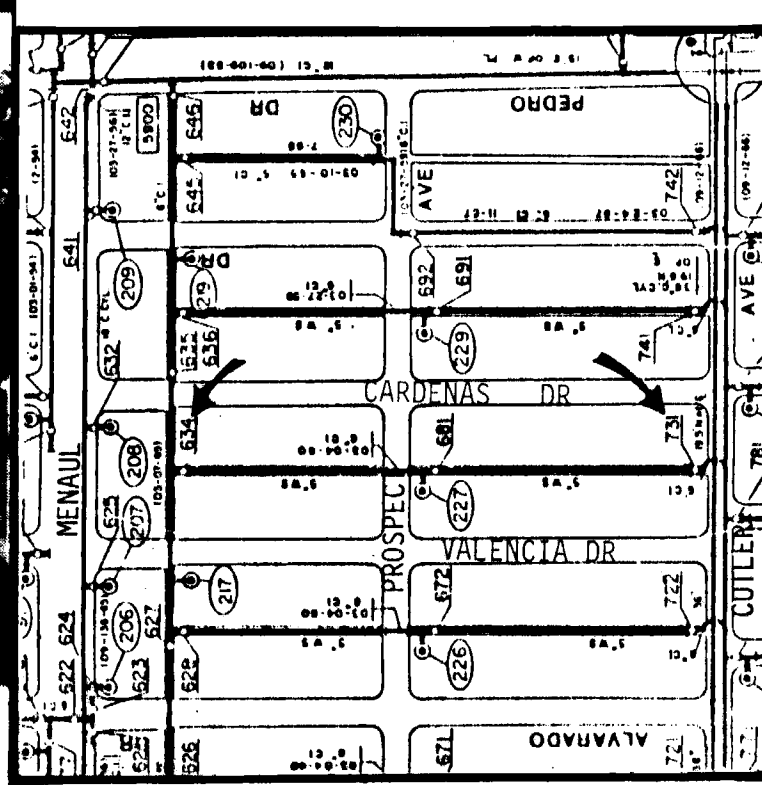

WATER VALVE SHUT-OFF PLAN

WATER SERVICE REHABILITATION				
STREET ADDRESS	METER SIZE	①	②	③
2404 VALENCIA	3/4"	X	X	
2408 " "	" "	X		
2414 " "	" "	X	X	
2418 " "	" "			X
2424 " "	" "			X
2430 " "	" "			X
2434 " "	" "			X
2438 " "	" "			X
2442 " "	" "			X
2446 " "	" "			X
2504 " "	" "			X
2508 " "	" "			X
2514 " "	" "			X
2518 " "	" "			X
2524 " "	" "			X
2534 " "	" "			X
2403 CARDENAS	" "			X
2407 " "	" "			X
2413 " "	" "			X
2417 " "	" "	X	X	
2423 " "	" "	X	X	
2429 " "	" "	X		
2433 " "	" "	X		
2437 " "	" "	X	X	
2441 " "	" "	X	X	
2445 " "	" "	X		
2503 " "	" "	X		
2507 " "	" "	X	X	
2513 " "	" "	X	X	
2517 " "	" "	X	X	
2523 " "	" "	X	X	
2529 " "	" "	X	X	
2533 " "	" "	X		
2530 VALENCIA	" "	X	X	X

KEY:

- ① SERVICE LINE TRANSFER
- ② METER BOX RELOCATION & REPLACEMENT
- ③ SERVICE LINE REPLACEMENT


C of A PWD Maps & Records
26 3603/593
Sullivan & Artman, P.A.
CONSULTING ENGINEERING ASSOCIATES
Albuquerque, New Mexico

**CITY OF ALBUQUERQUE
PUBLIC WORKS DEPARTMENT
ENGINEERING GROUP**


TITLE: FY88-89 WATERLINE & SEWERLINE RENEWAL PROGRAM, AREA I
VALENCIA EAST ALLEY

APPROVALS	ENGINEER	DATE	APPROVALS	ENGINEER	DATE
D.R. Chair	James S. ...	1/89	Trans. Dev	...	...
Utility Dev	...	...	...	...	...

DRAWING NO. 3503 **MAP NO. H-18** **SHEET 15 OF 24**

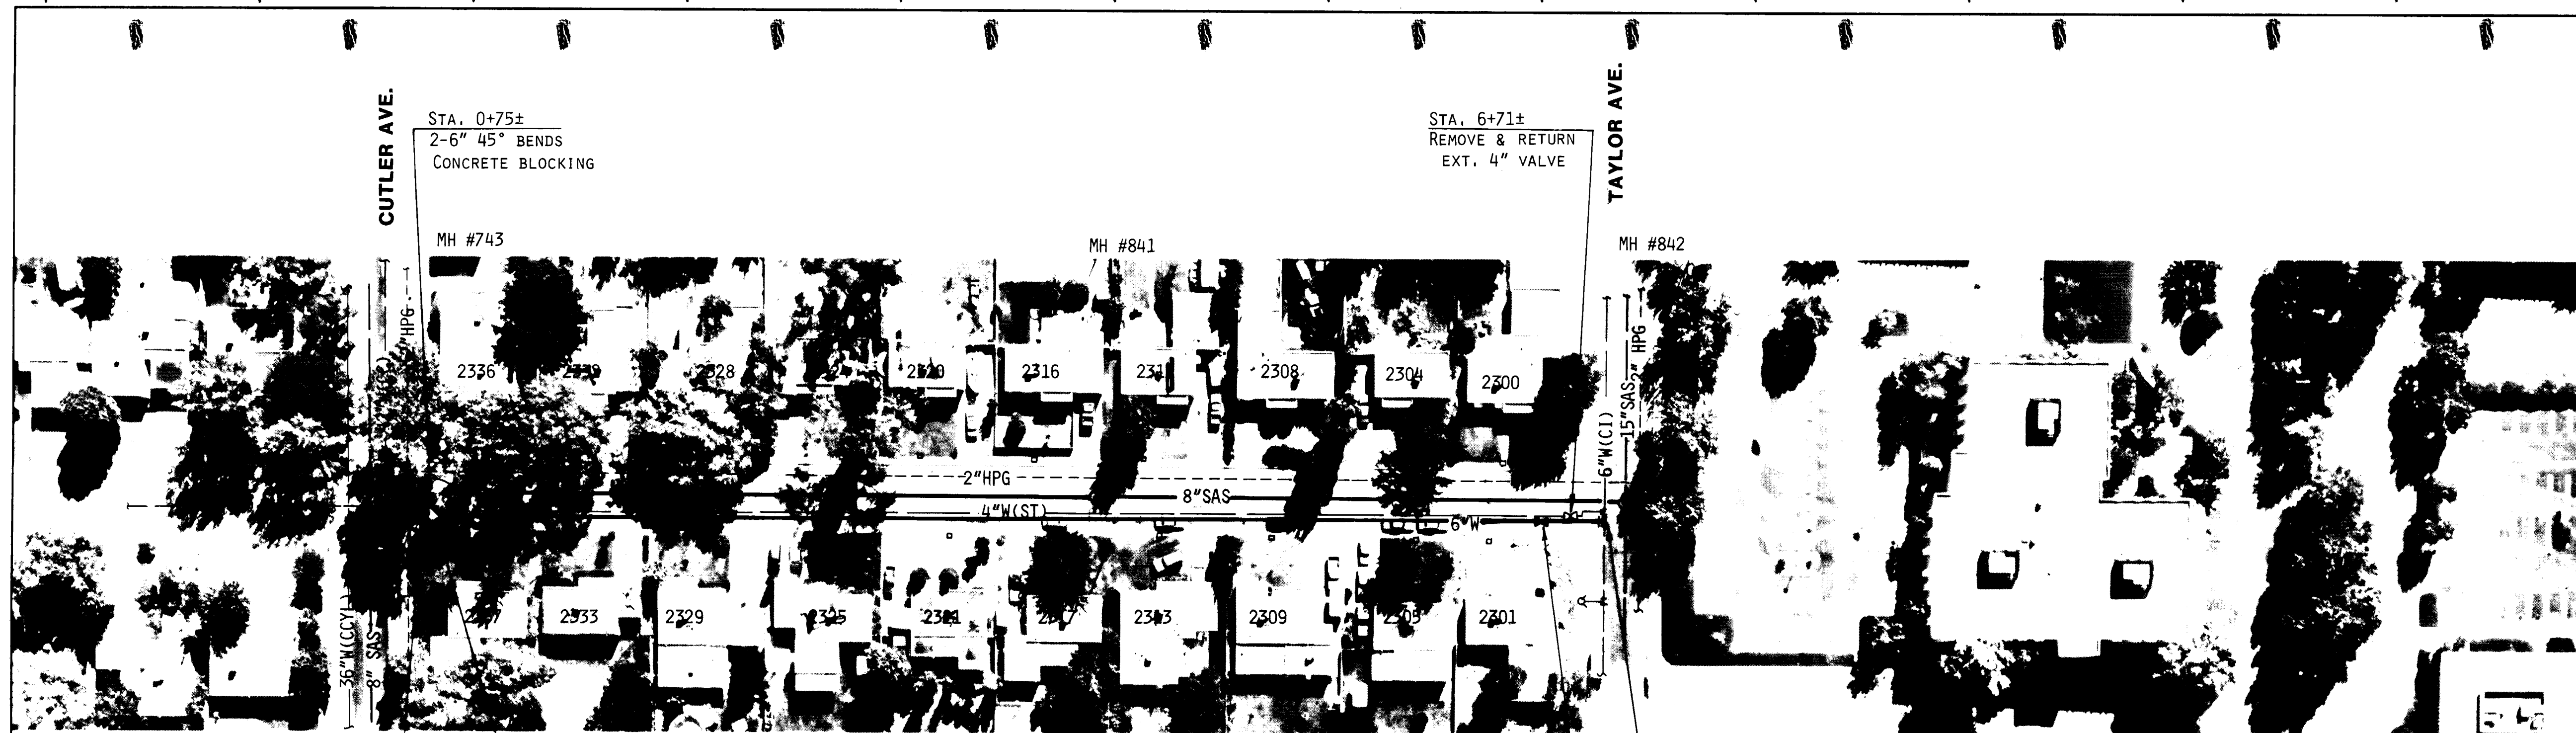

STA. 0+73±
REMOVE & RETURN 6"x6"x4" TEE
REMOVE & RETURN FIRE HYDRANT
INSTALL 6" TEE W/BLKG.
10'± OF 6" WATERLINE
INSTALL FIRE HYDRANT, 4' BURY
FLANGE ELEV = 5243.0
TIE NEW 6" WATERLINE TO NEW
6" TEE
NON-PRESSURE CONNECTION

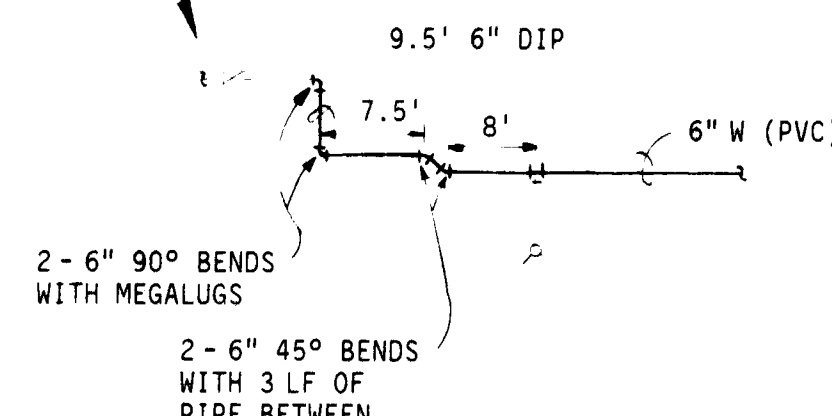


NEW 6" W (PVC) IS 3.5' EAST
OF WEST CURB FACE

STA. 6+54
INSTALL 6" GATE VALVE
W/TYPE 'A' VALVE BOX
COVER ELEV = 5235.40

STA. 6+87±
REMOVE 6"x6"x4" TEE
INSTALL 6"x6"x6" TEE
NON-PRESSURE CONNECTION

CAGUA DRIVE

SCALE:
HORIZ. 1" = 50'
VERT. 1" = 5'

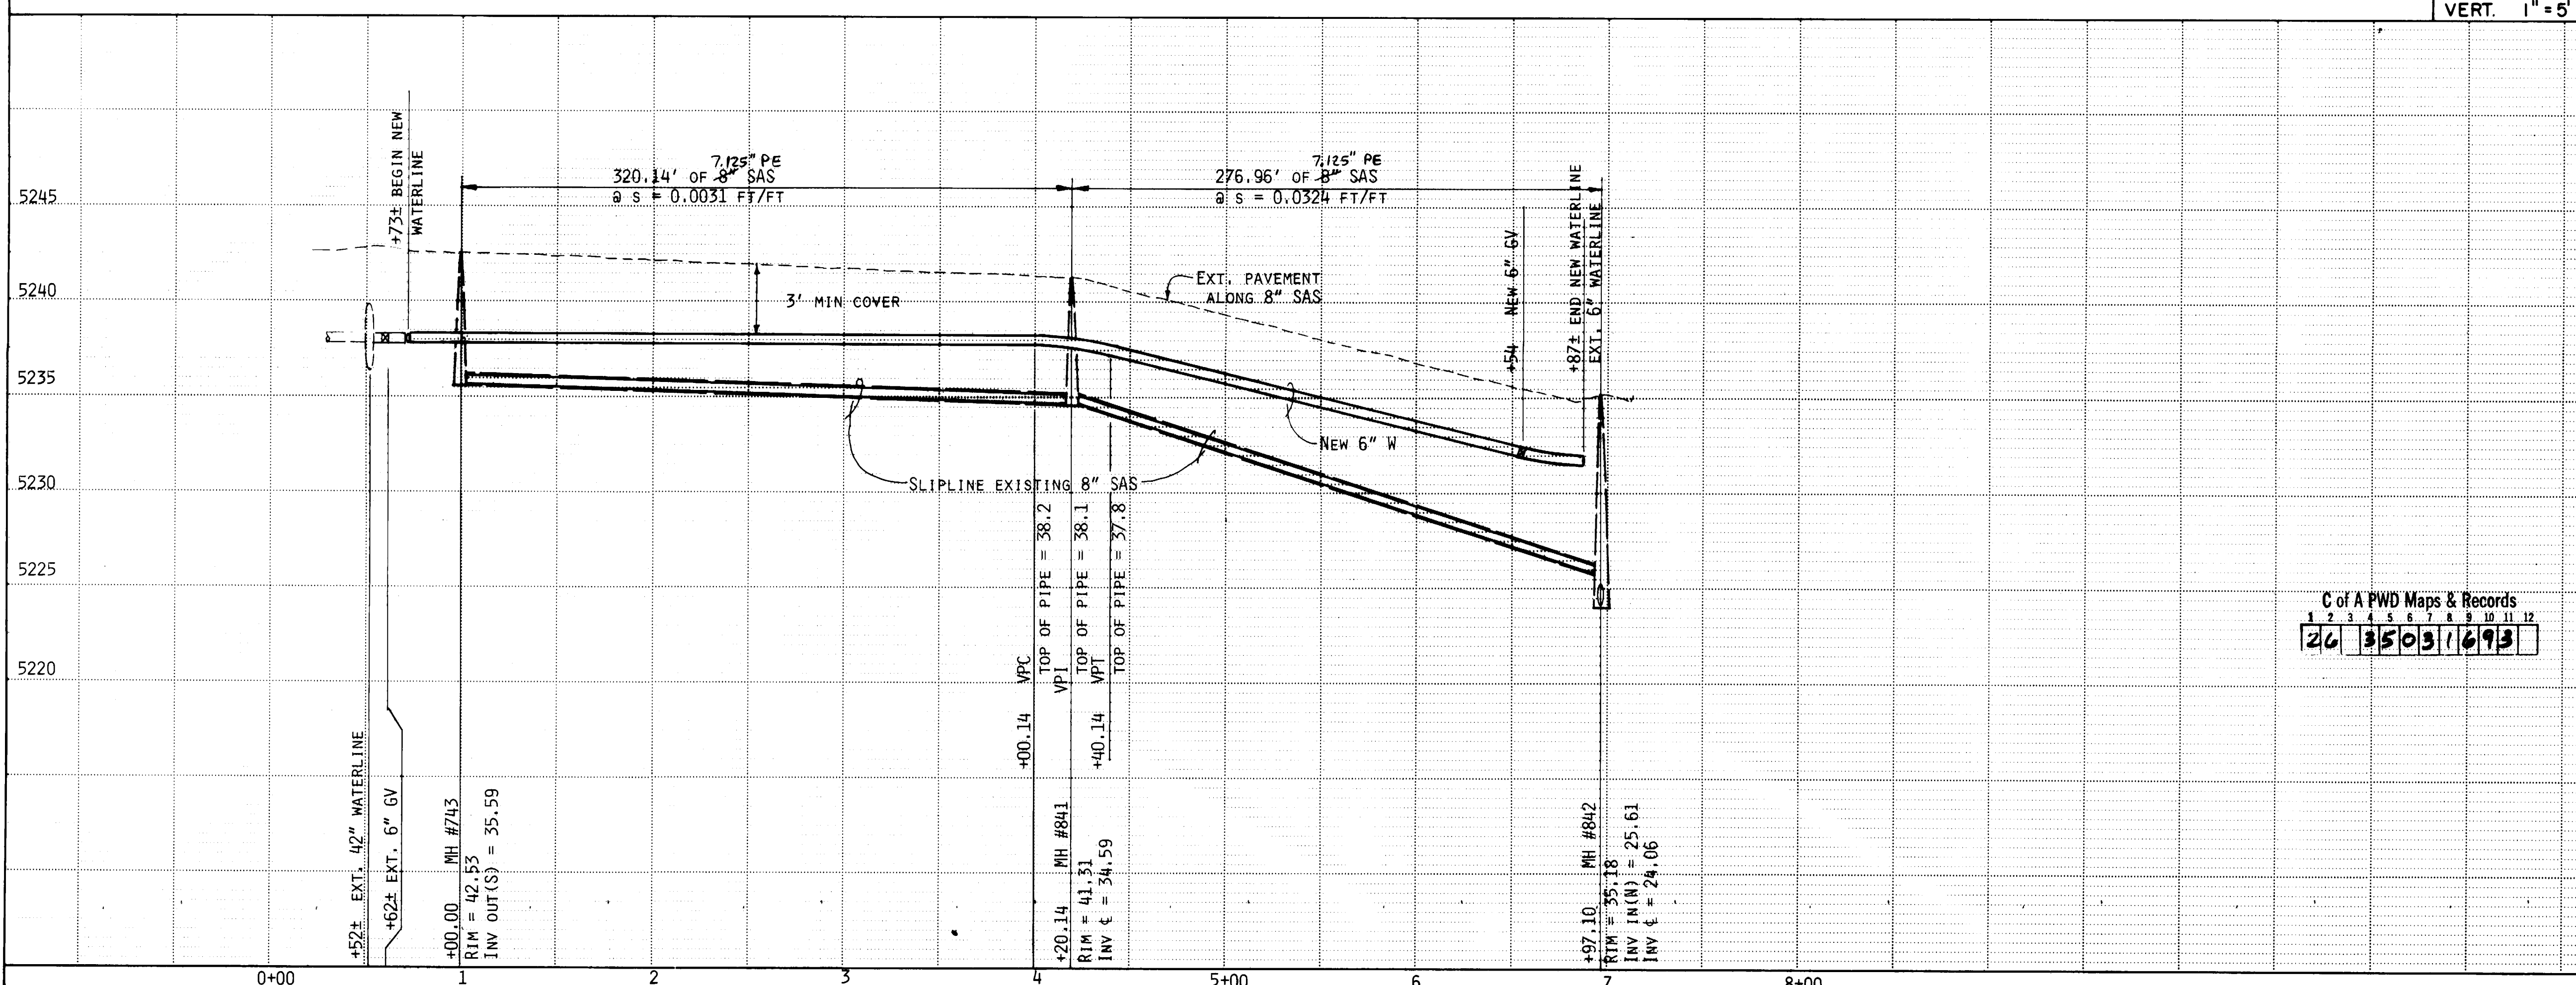

C of A PWD Maps & Records
26 3503 1693

NOTES

1. IF EXISTING FIRE HYDRANT AT STA. 0+73 IS CONNECTED TO THE MAIN WITH A 6" TEE AND 6" PIPE, THEN REMOVAL & REPLACEMENT NOTED FOR FIRE HYDRANT SHALL NOT BE REQUIRED.

2. THE CONTRACTOR SHALL REMOVE & DISPOSE OF THE EXISTING 4 INCH STEEL WATERLINE FROM STA. 0+73± TO STA. 6+87±.

WATER VALVE SHUT-OFF PLAN

WATER SERVICE REHABILITATION

CAGUA ADDRESS	METER SIZE	①	②	③
2300	3/4"			X
2301	"	X	X	
2304	"			X
2305	"	X	X	
2308	"			X
2309	"	X	X	
2312	"			X
2313	"	X	X	
2316	"			X
2317	"	X	X	
2320	"			X
2321	"	X	X	
2324	"			X
2325	"	X	X	
2328	"			X
2329	"	X	X	
2332	"			X
2333	"	X		
2336	1"			X
2337	3/4"	X	X	

KEY:

① SERVICE LINE TRANSFER

② METER BOX RELOCATION & REPLACEMENT

③ SERVICE LINE REPLACEMENT

RECORD DRAWING

WARNING

This is part of a record document. Record documents are based on reports submitted by others. Engineers cannot assume nor assume any responsibility or liability for the accuracy of record documents. Users of record documents are cautioned and advised to obtain independent verification of actual conditions.

Isaacson & Arfman, P.A.

CONSULTING ENGINEERING ASSOCIATES

Albuquerque, New Mexico

CITY OF ALBUQUERQUE

PUBLIC WORKS DEPARTMENT

ENGINEERING GROUP

TITLE: FY88-89 WATERLINE & SEWERLINE RENEWAL PROGRAM, AREA II





CAGUA DRIVE

APPROVALS	ENGINEER	DATE	APPROVALS	ENGINEER	DATE
D.R. Chair	Isaacson	5/2/89	Liquid Waste		
Trans. Dev			Wastewater		
Utility Dev	Isaacson	5/2/89	Water		

DRAWING NO. 3503

MAP NO. H-18

SHEET 16 **OF** 24

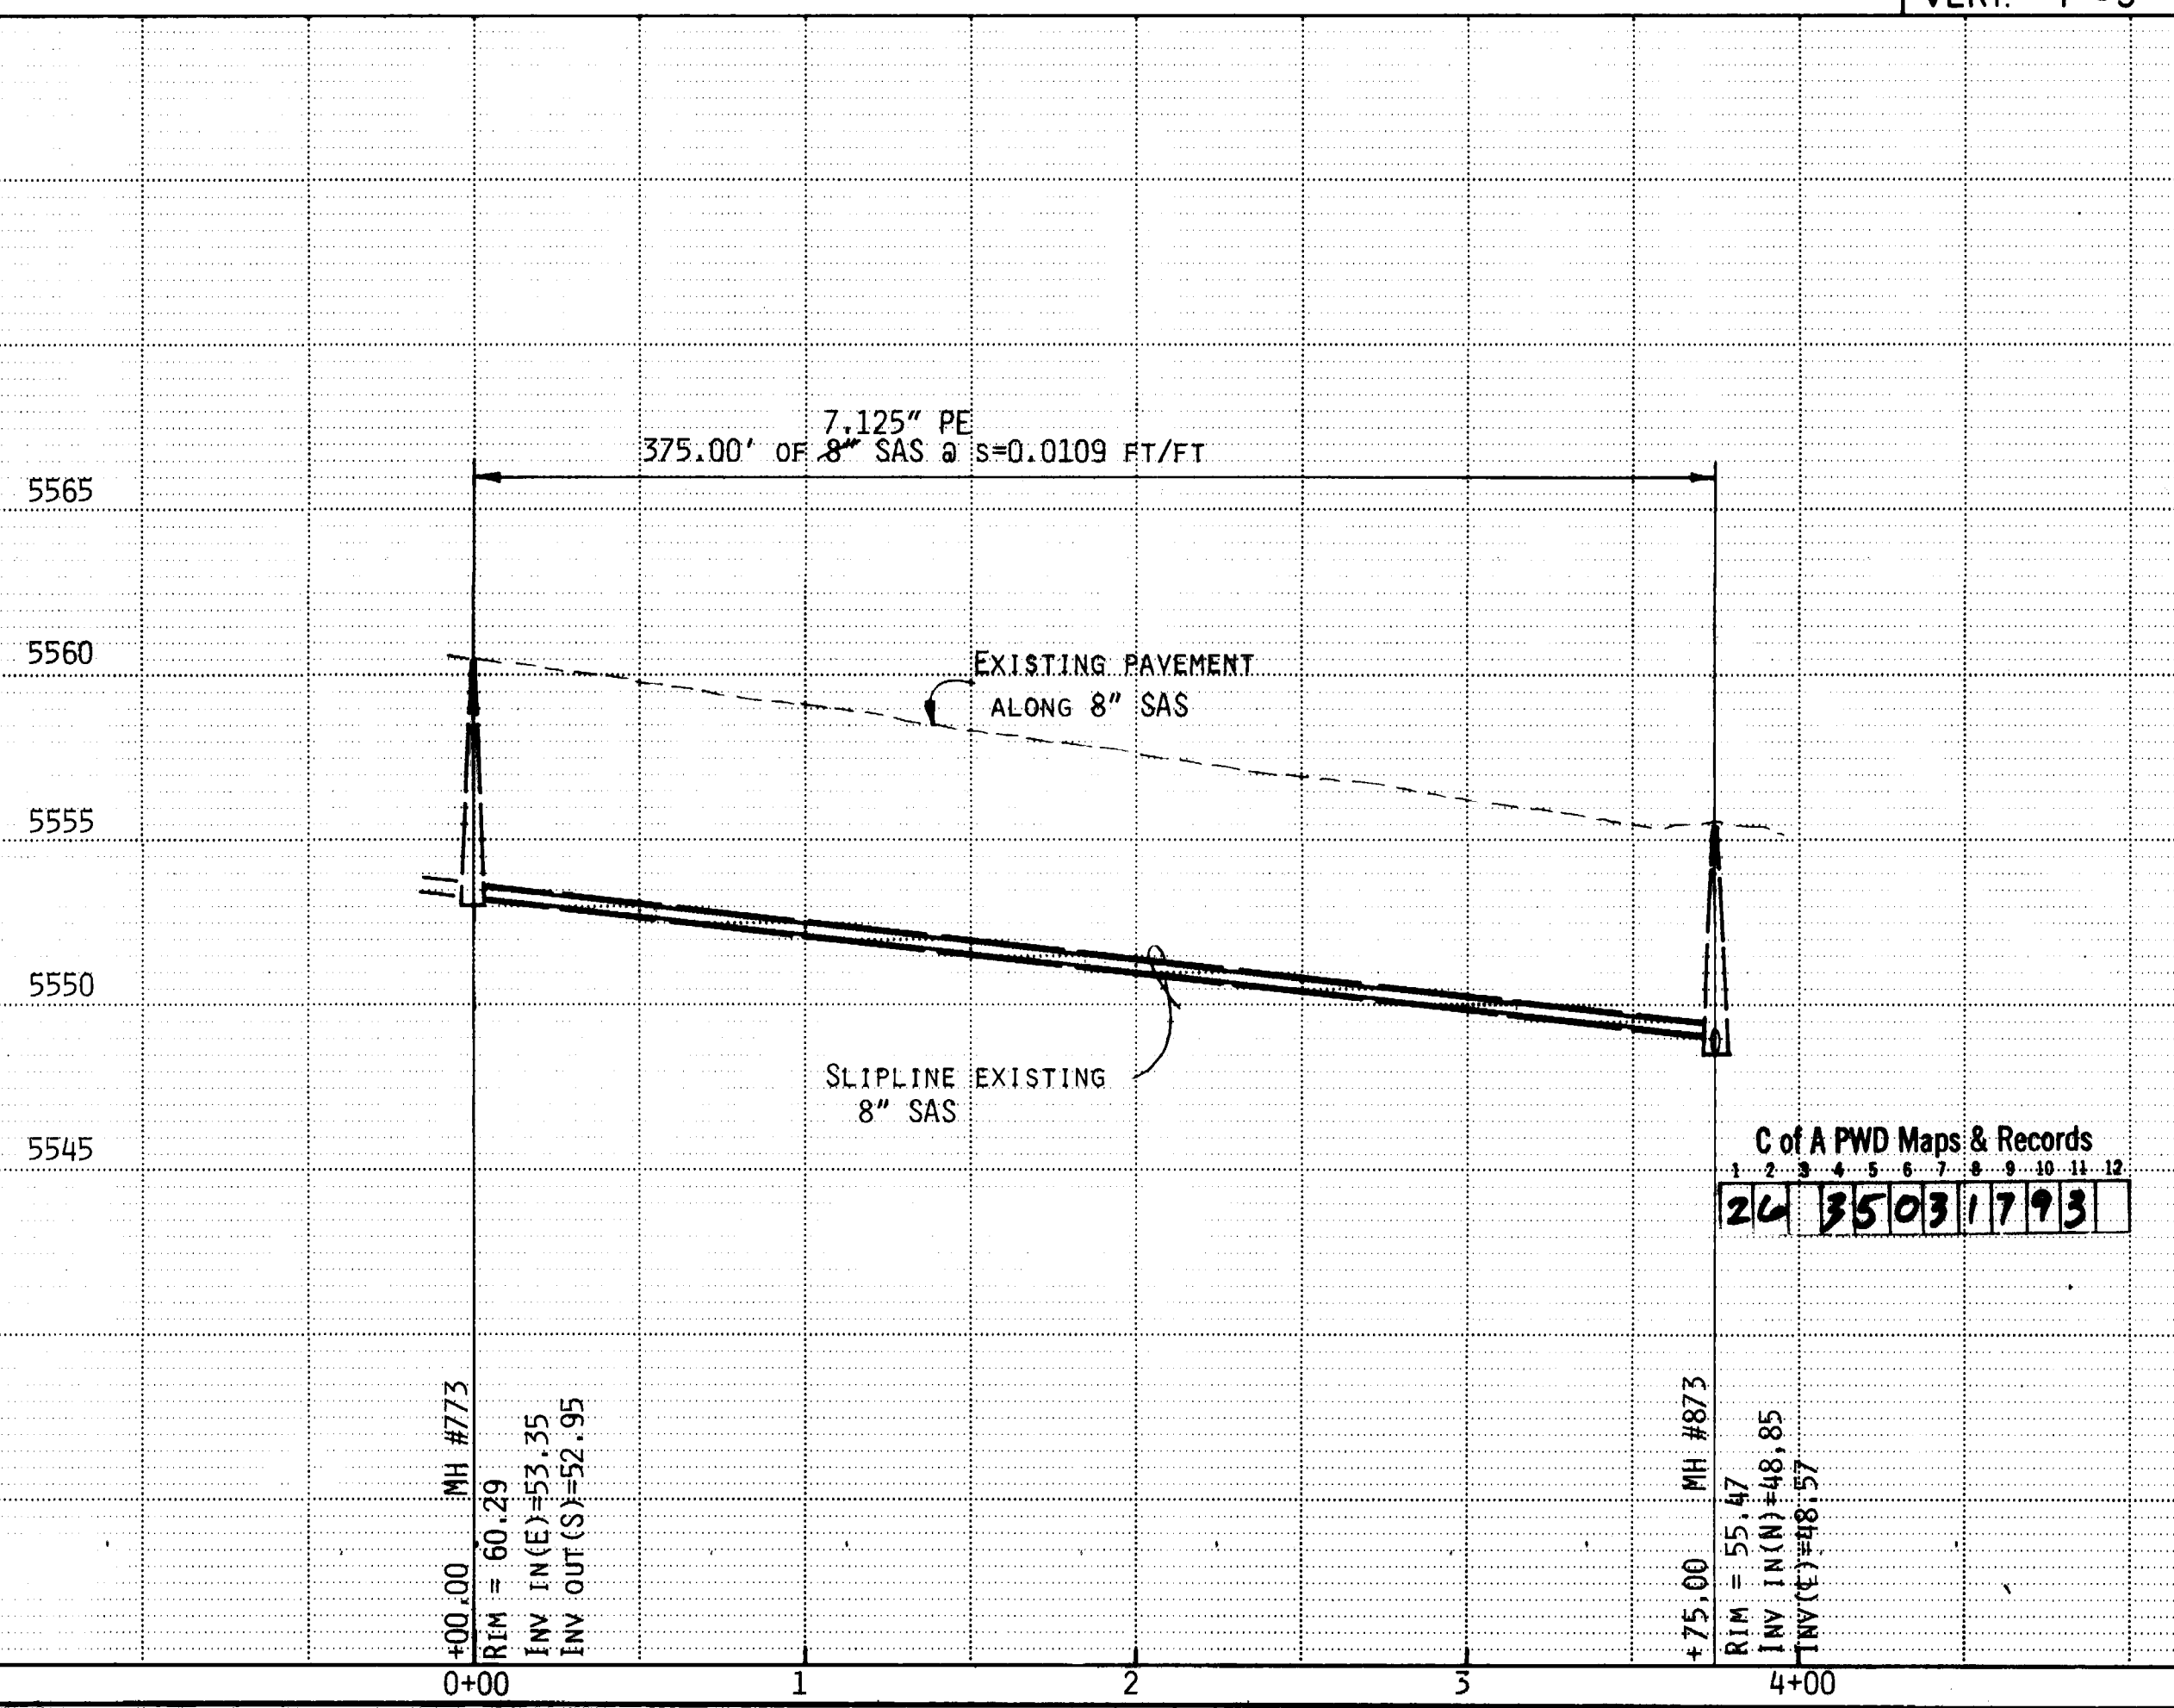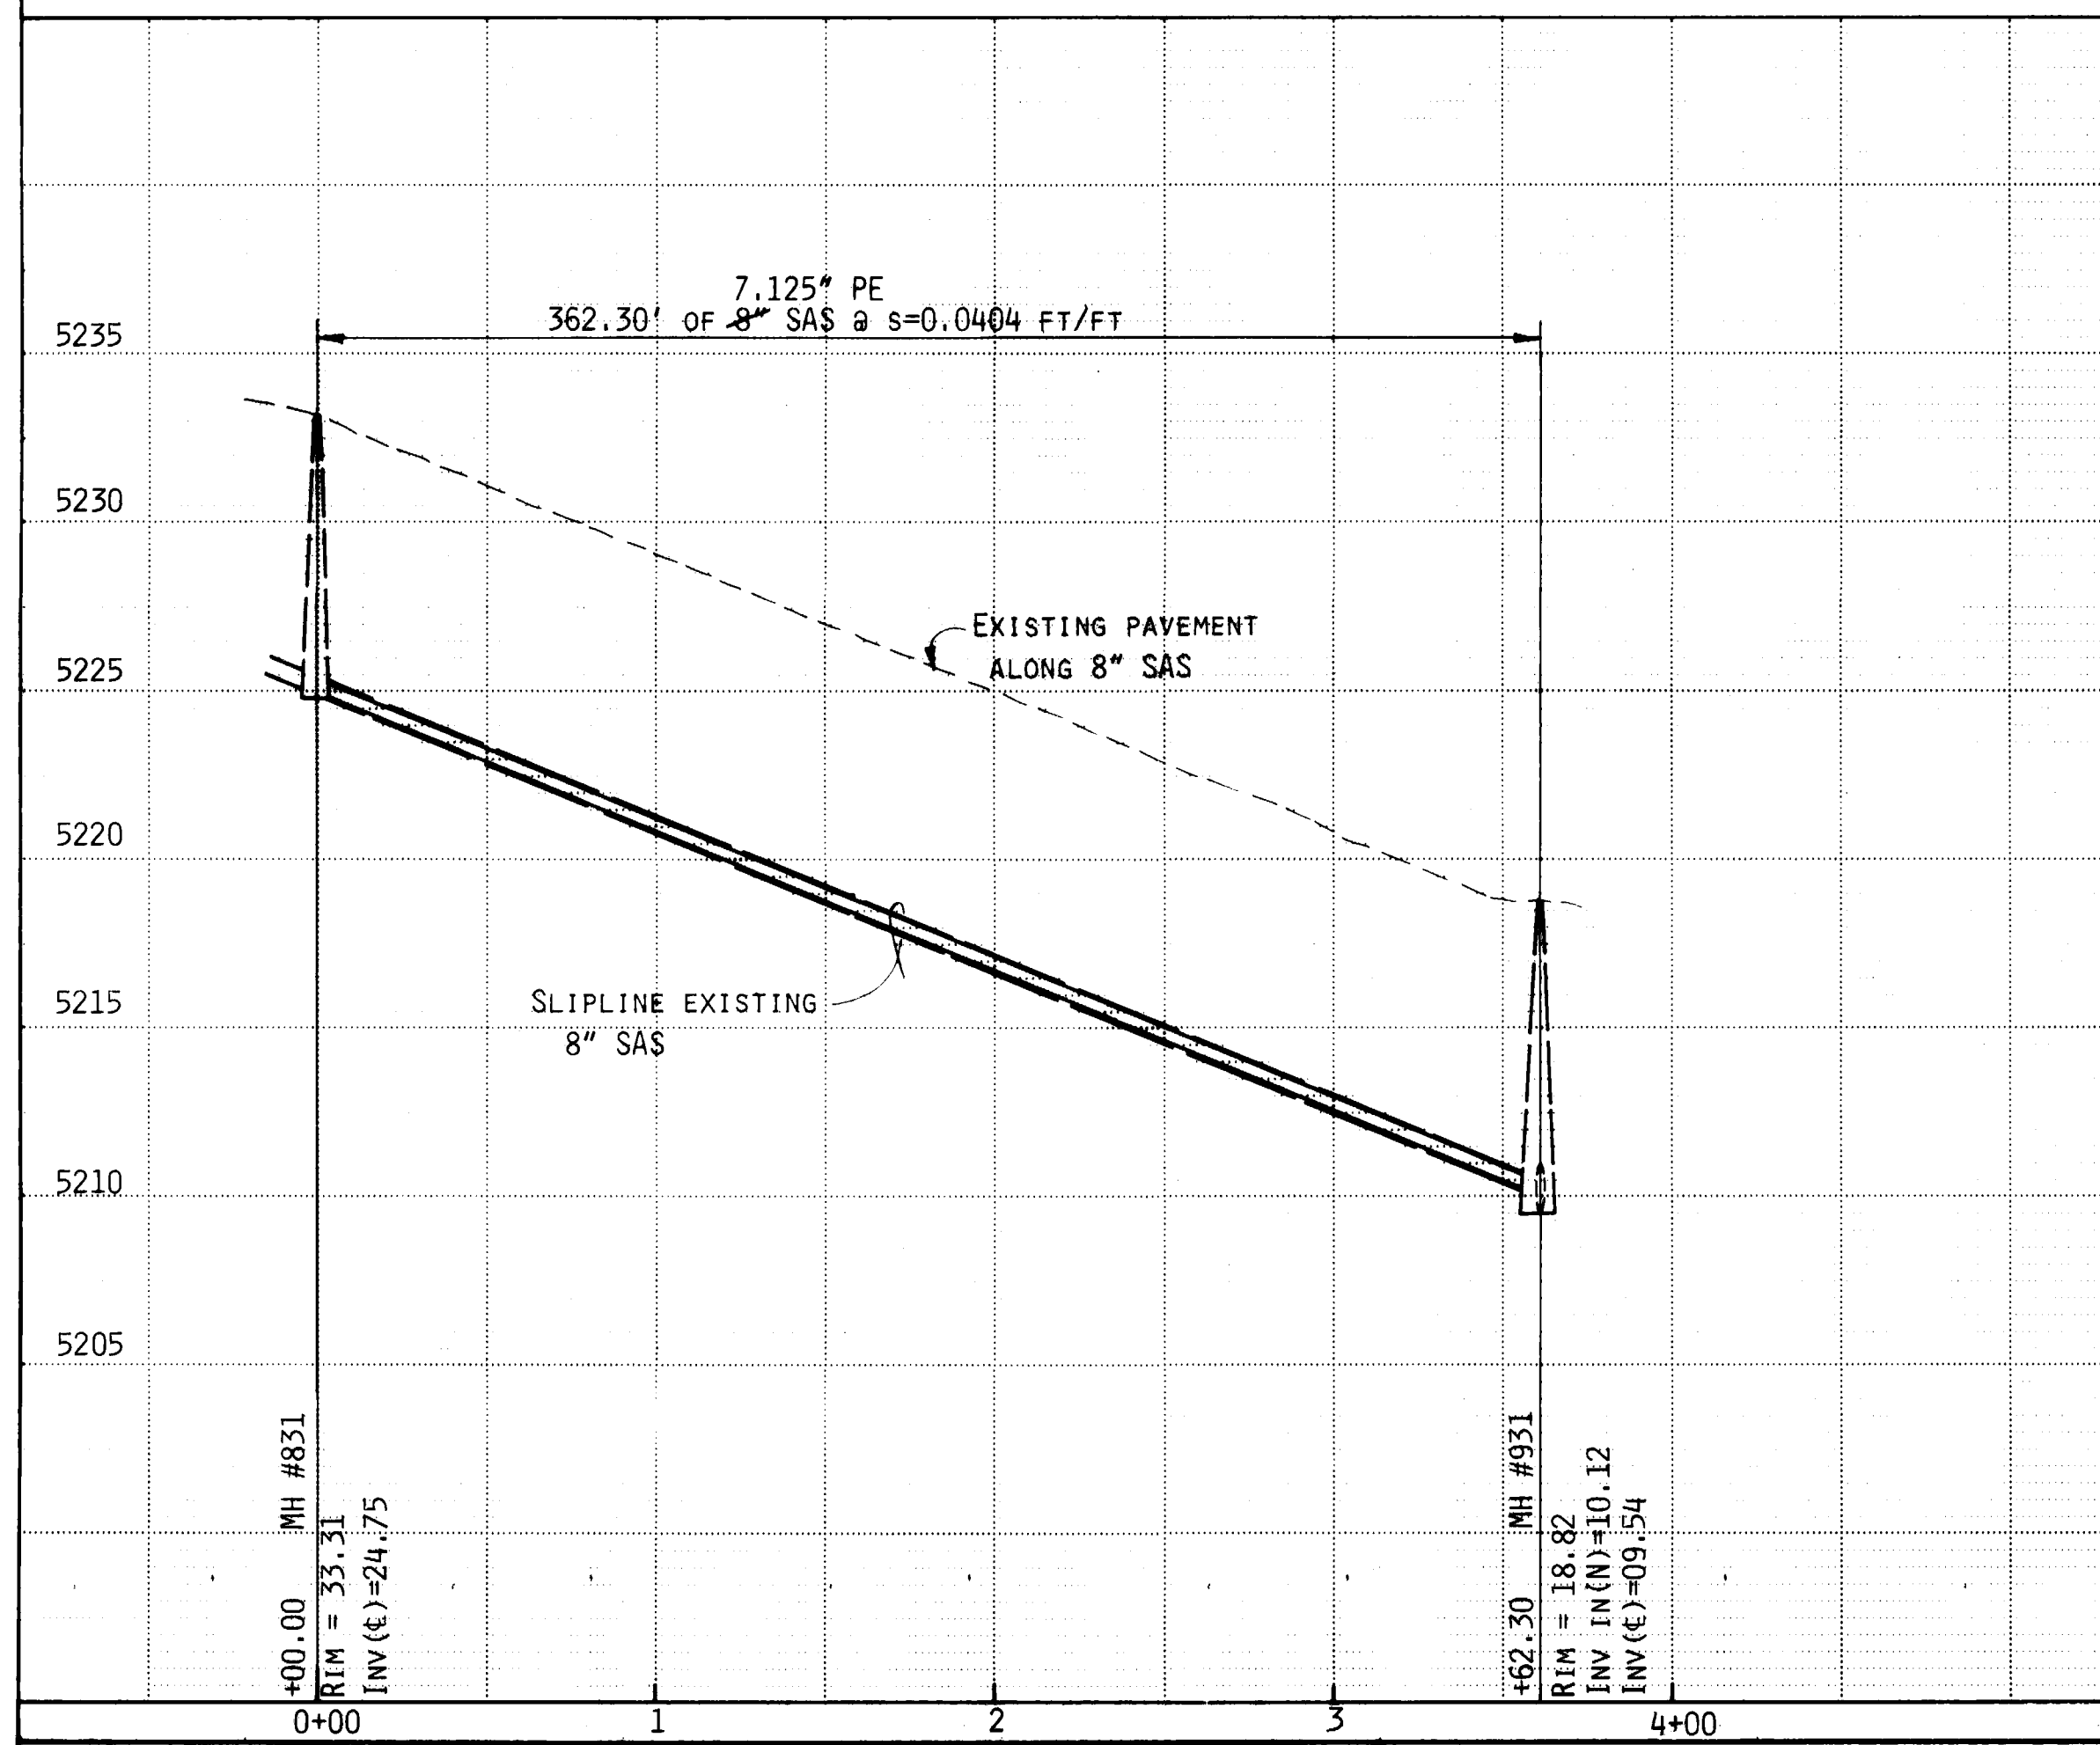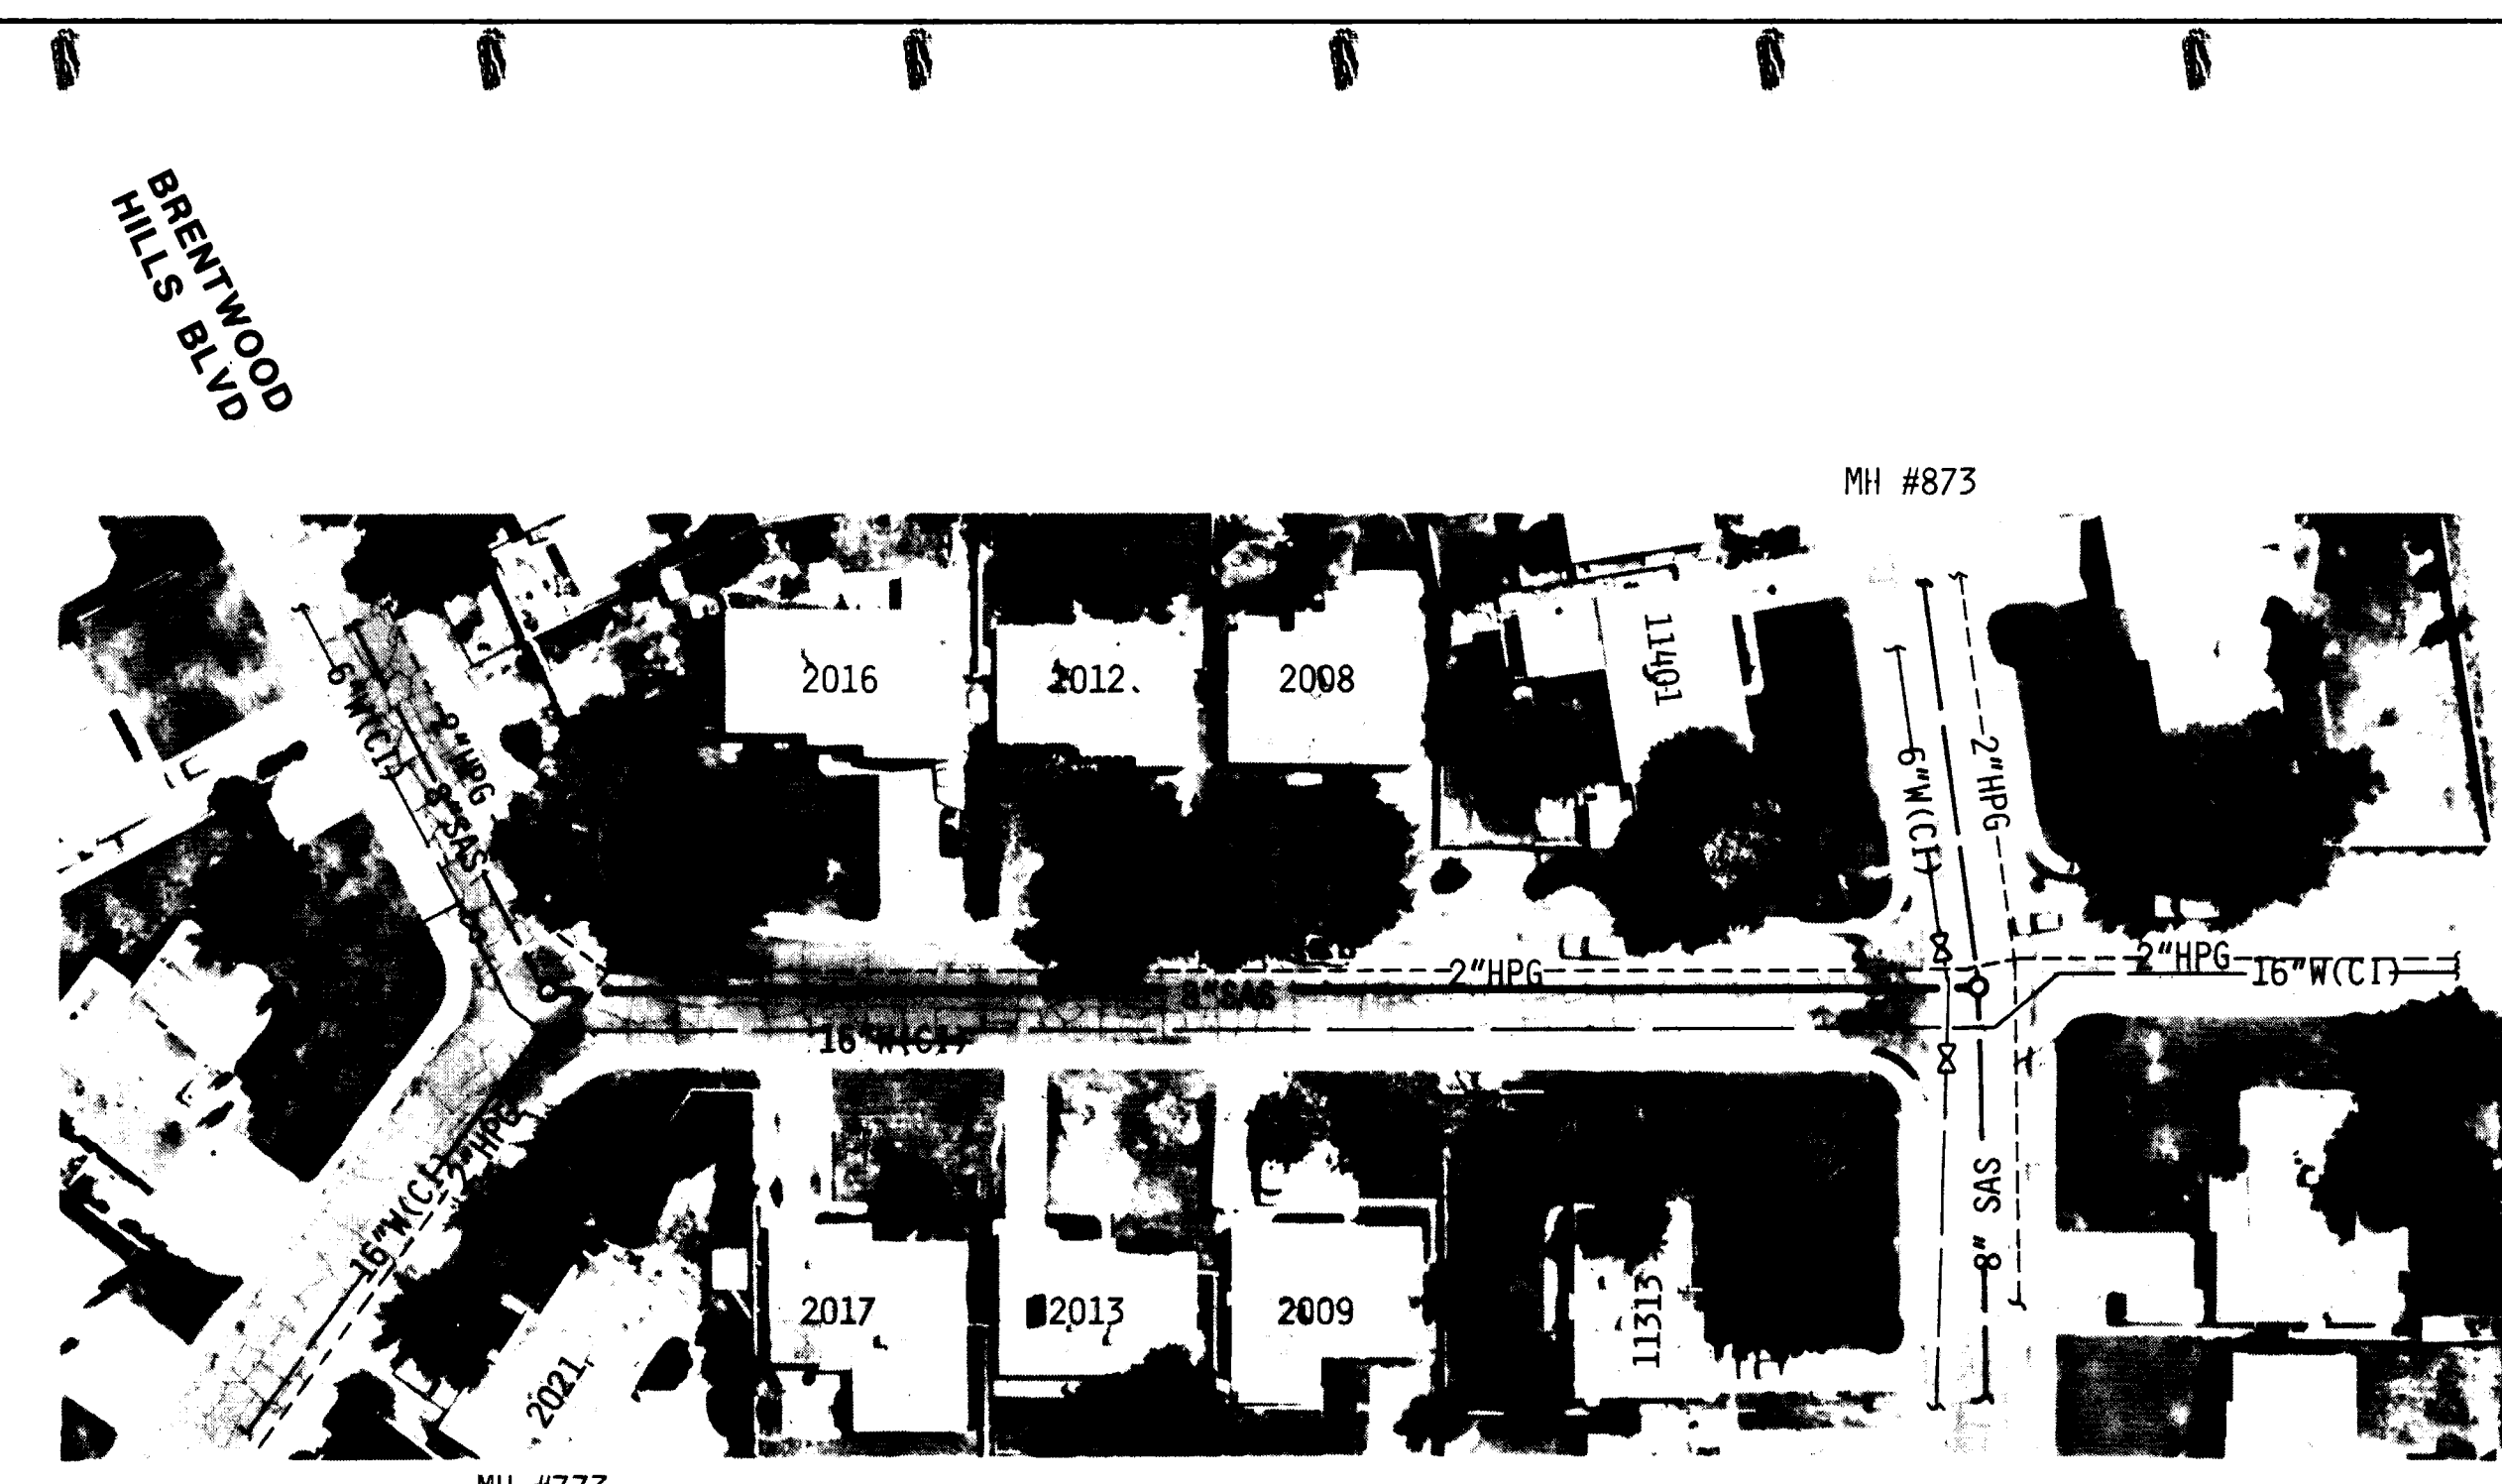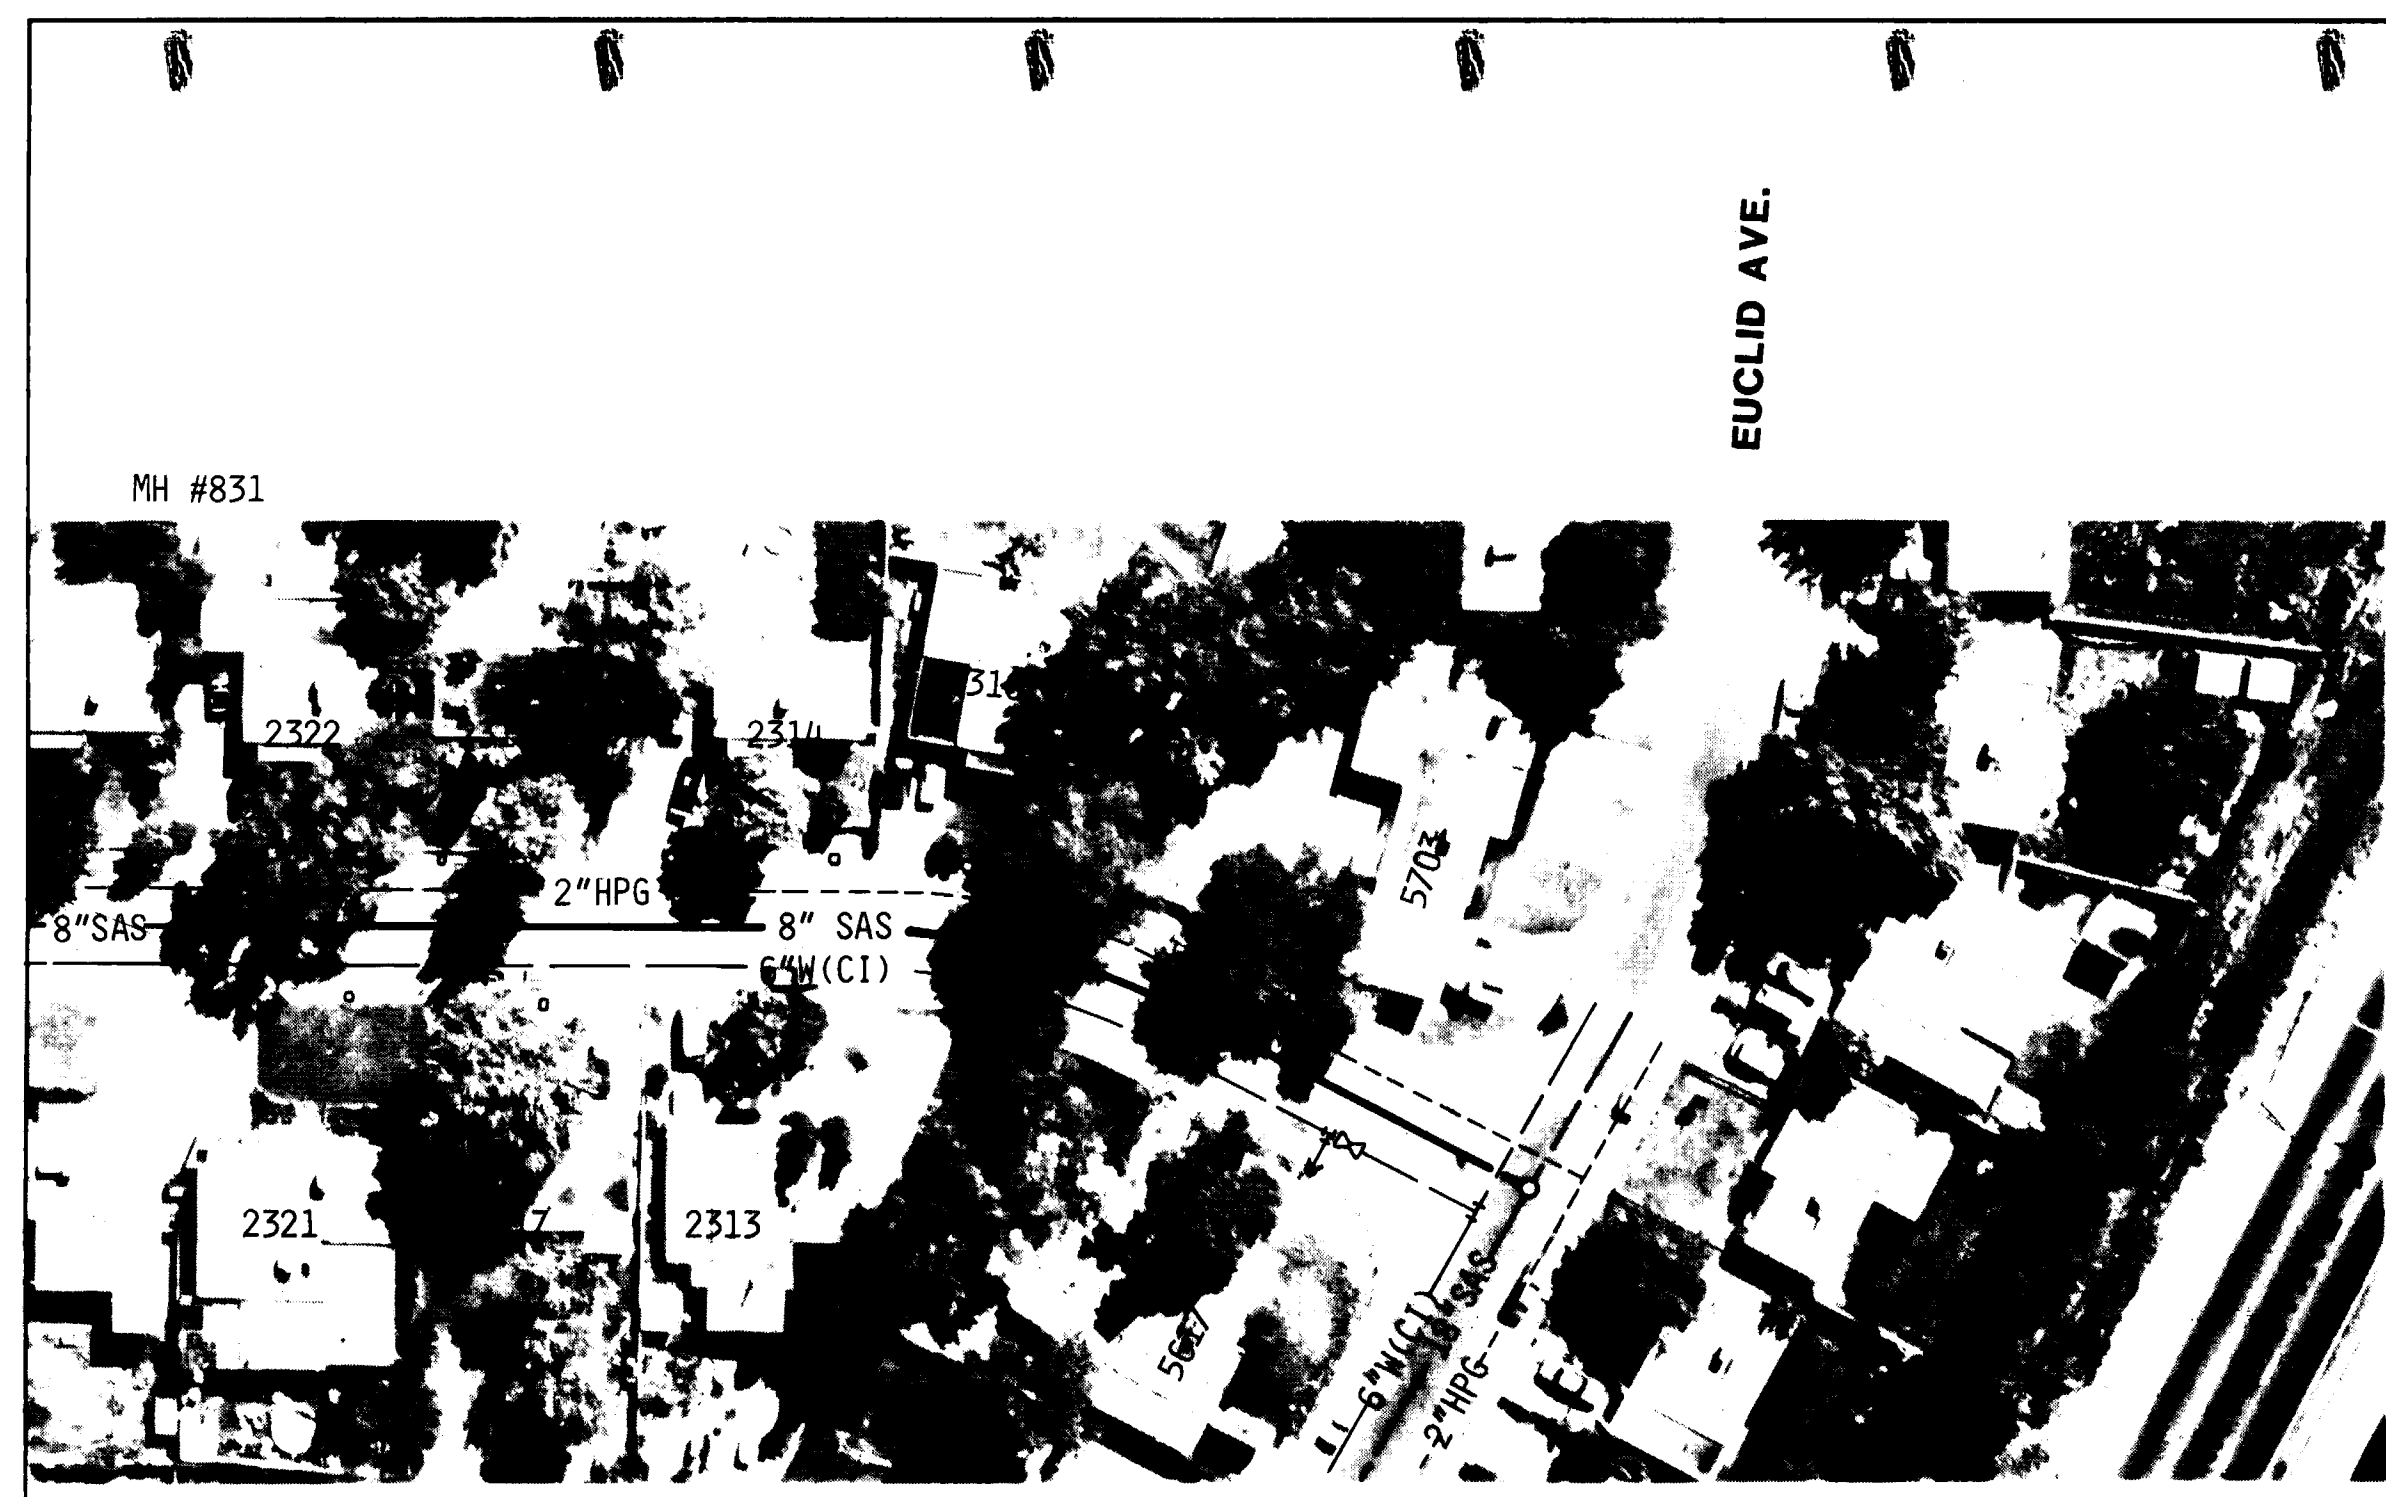

NOTES

1. NO WATERLINE REPLACEMENT WORK IS SCHEDULED FOR EITHER OF THE TWO AREAS SHOWN ON THIS SHEET.
2. THE MANHOLE LOCATED AT EUCLID AVE. AND VALENCIA DRIVE (MH #931) SHALL BE PLASTERED AT THE DIRECTION OF THE CITY INSPECTOR - 100± SF.

AS BUILT INFORMATION		BENCH MARKS		SURVEY INFORMATION		ENGINEER'S SEAL	
CONTRACTOR	SUNDANCE MECHANICAL	ACS BRASS CAP "13-H18" LOCATED AT THE SW QUADRANT OF THE INTERSECTION OF CUTLER AVE.	DATE	7/88	BY	S.D.G.	NO.
WORK	BY G. MARQUEZ	WITH SAN PEDRO BLVD. NE	DATE	1/90	BY	S.D.G.	NO.
INSPECTION	DATE 1/90	ELEVATION: 5248.55	DATE	1/90	BY	S.D.G.	NO.
ACCEPTANCE	DATE 1/90	ACS BM "3-H21", A SQUARE CHISELED IN THE NW CURB RETURN AT THE INTERSECTION OF INDIAN SCHOOL ROAD WITH SHIRLEY ST. NE	DATE	1/90	BY	S.D.G.	NO.
VERIFICATION	DATE 1/90	ELEVATION: 5574.92	DATE	1/90	BY	S.D.G.	NO.
REVISIONS	DATE 1/90		DATE	1/90	BY	S.D.G.	NO.
MICRO-FILM INFORMATION		RECORDED BY		DATE		NO.	

WARNING

This is part of a record document. Record documents are based on reports submitted by others. Engineers cannot assume nor assume any responsibility or liability for the accuracy of record documents. Users of record documents are cautioned and advised to obtain independent verification of actual conditions.

Isaacson & Arfman, P.A.

CONSULTING ENGINEERING ASSOCIATES

Albuquerque, New Mexico

RECORD DRAWING

CITY OF ALBUQUERQUE

PUBLIC WORKS DEPARTMENT

ENGINEERING GROUP

TITLE: FY88-89 WATERLINE & SEWERLINE RENEWAL PROGRAM, AREA I



VALENCIA DRIVE & MARTHA STREET

APPROVALS	ENGINEER	DATE	APPROVALS	ENGINEER	DATE
D.R.C. Chair			Trans. Dev.		
Utility Dev.					

DRAWING NO. 3503

MAP NO. H-18&21

SHEET 17 OF 24

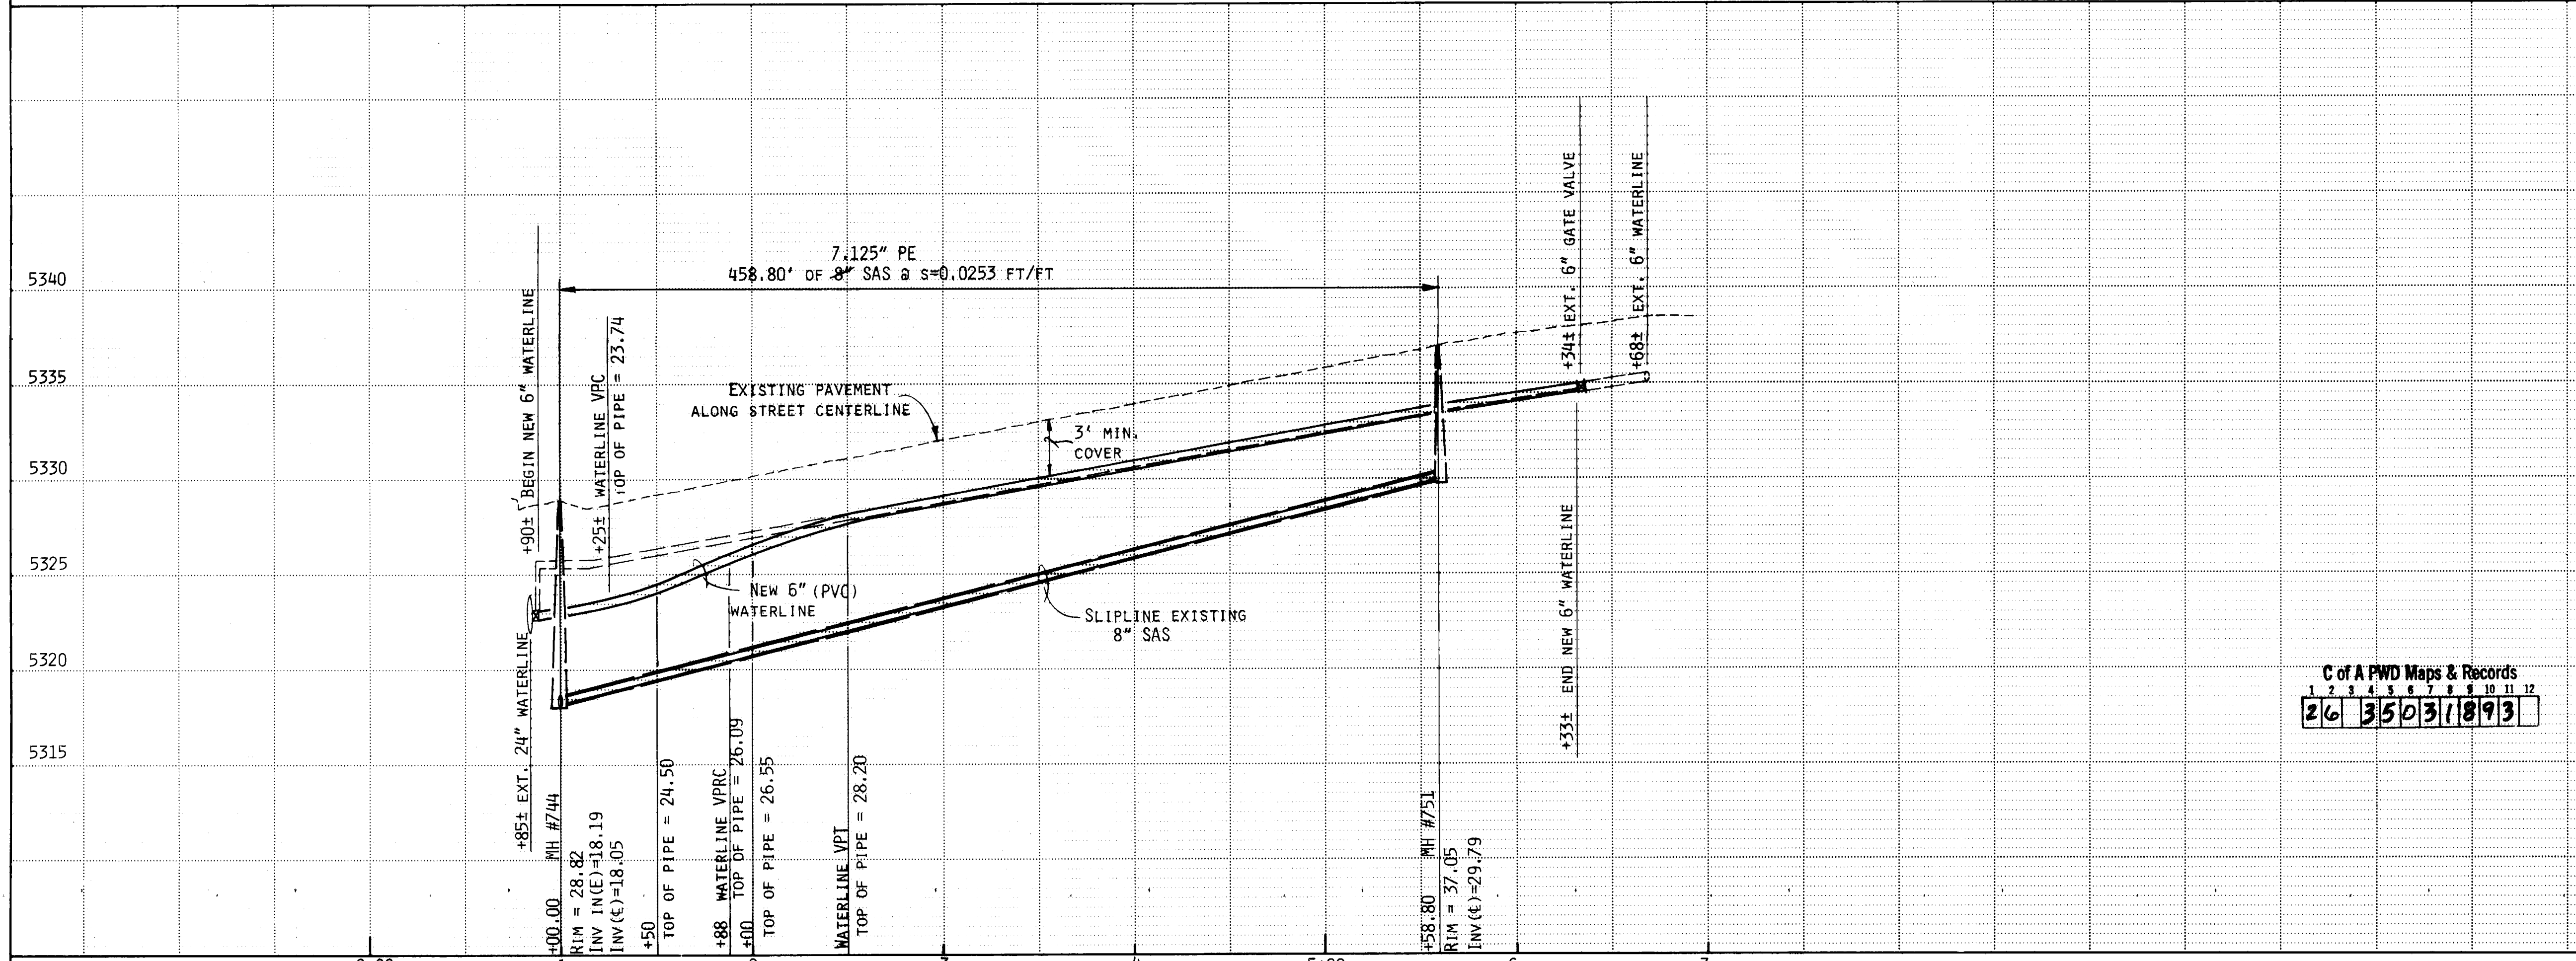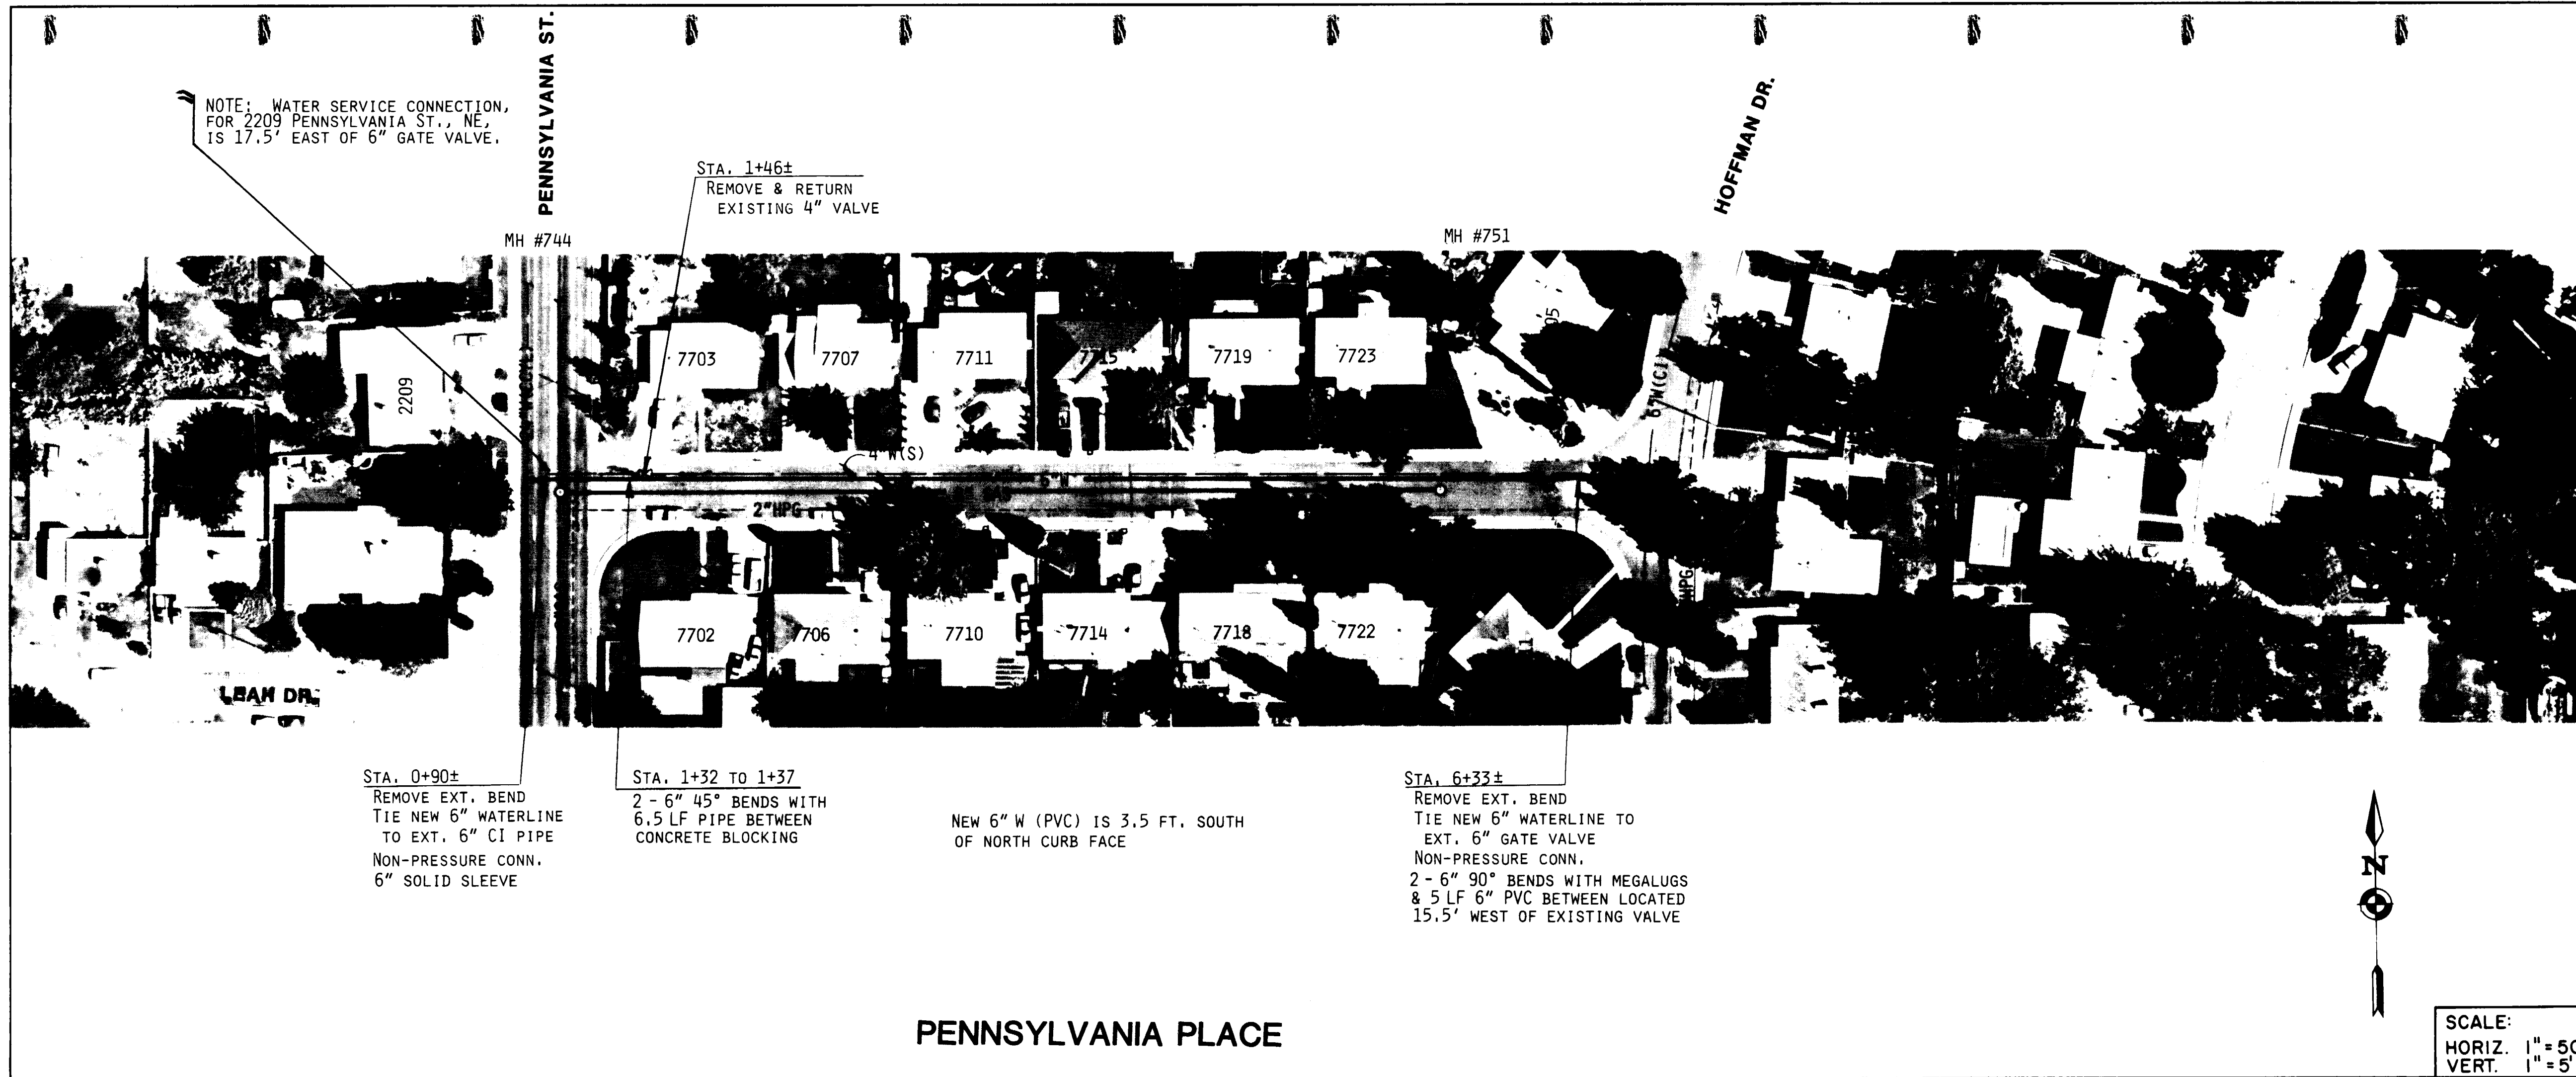

NOTES
1. THERE ARE TWO ACTIVE WATER SERVICES AT 7702 PENNSYLVANIA PLACE AS SHOWN
2. THE CONTRACTOR SHALL REMOVE & DISPOSE OF THE 4" STEEL WATERLINE FROM STA. 0+90± TO STA. 6+33±.

WATER SERVICE REHABILITATION

PENN. PL. ADDRESS	METER SIZE	①	②	③
7702	1-1/4"	X	X	
7703	3/4"			X
7706	"	X	X	
7707	"			X
7710	"	X	X	
7711	"			X
7714	"	X	X	
7715	"			X
7718	1-1/4"	X	X	
7719	3/4"			X
7722	1-1/4"	X	X	
7723	3/4"			X

KEY:
① SERVICE LINE TRANSFER
② METER BOX RELOCATION & REPLACEMENT
③ SERVICE LINE REPLACEMENT

SCALE:
HORIZ. 1" = 50'
VERT. 1" = 5'

WATER VALVE SHUT-OFF PLAN

RECORD DRAWING
This is part of a record drawing. It is not to be used for construction. It is for informational purposes only. It is not to be used for any other purpose.
Isaacson & Artman, P.A.
CONSULTING ENGINEERING ASSOCIATES
Albuquerque, New Mexico

ENGINEER'S SEAL


REVISIONS

NO.	DATE	REMARKS	BY
1	10/88	DESIGN	SMH
2	1/89	DATE	NA

TITLE: FY88-89 WATERLINE & SEWERLINE RENEWAL PROGRAM, AREA II
PENNSYLVANIA PLACE

APPROVALS	ENGINEER	DATE	APPROVALS	ENGINEER	DATE
D.R.C. Chair			Liquid Waste		
Trans. Dev			Traffic		
Utility Dev			Water		

DRAWING NO. 3503
MAP NO. H-19
SHEET 18 **OF** 24

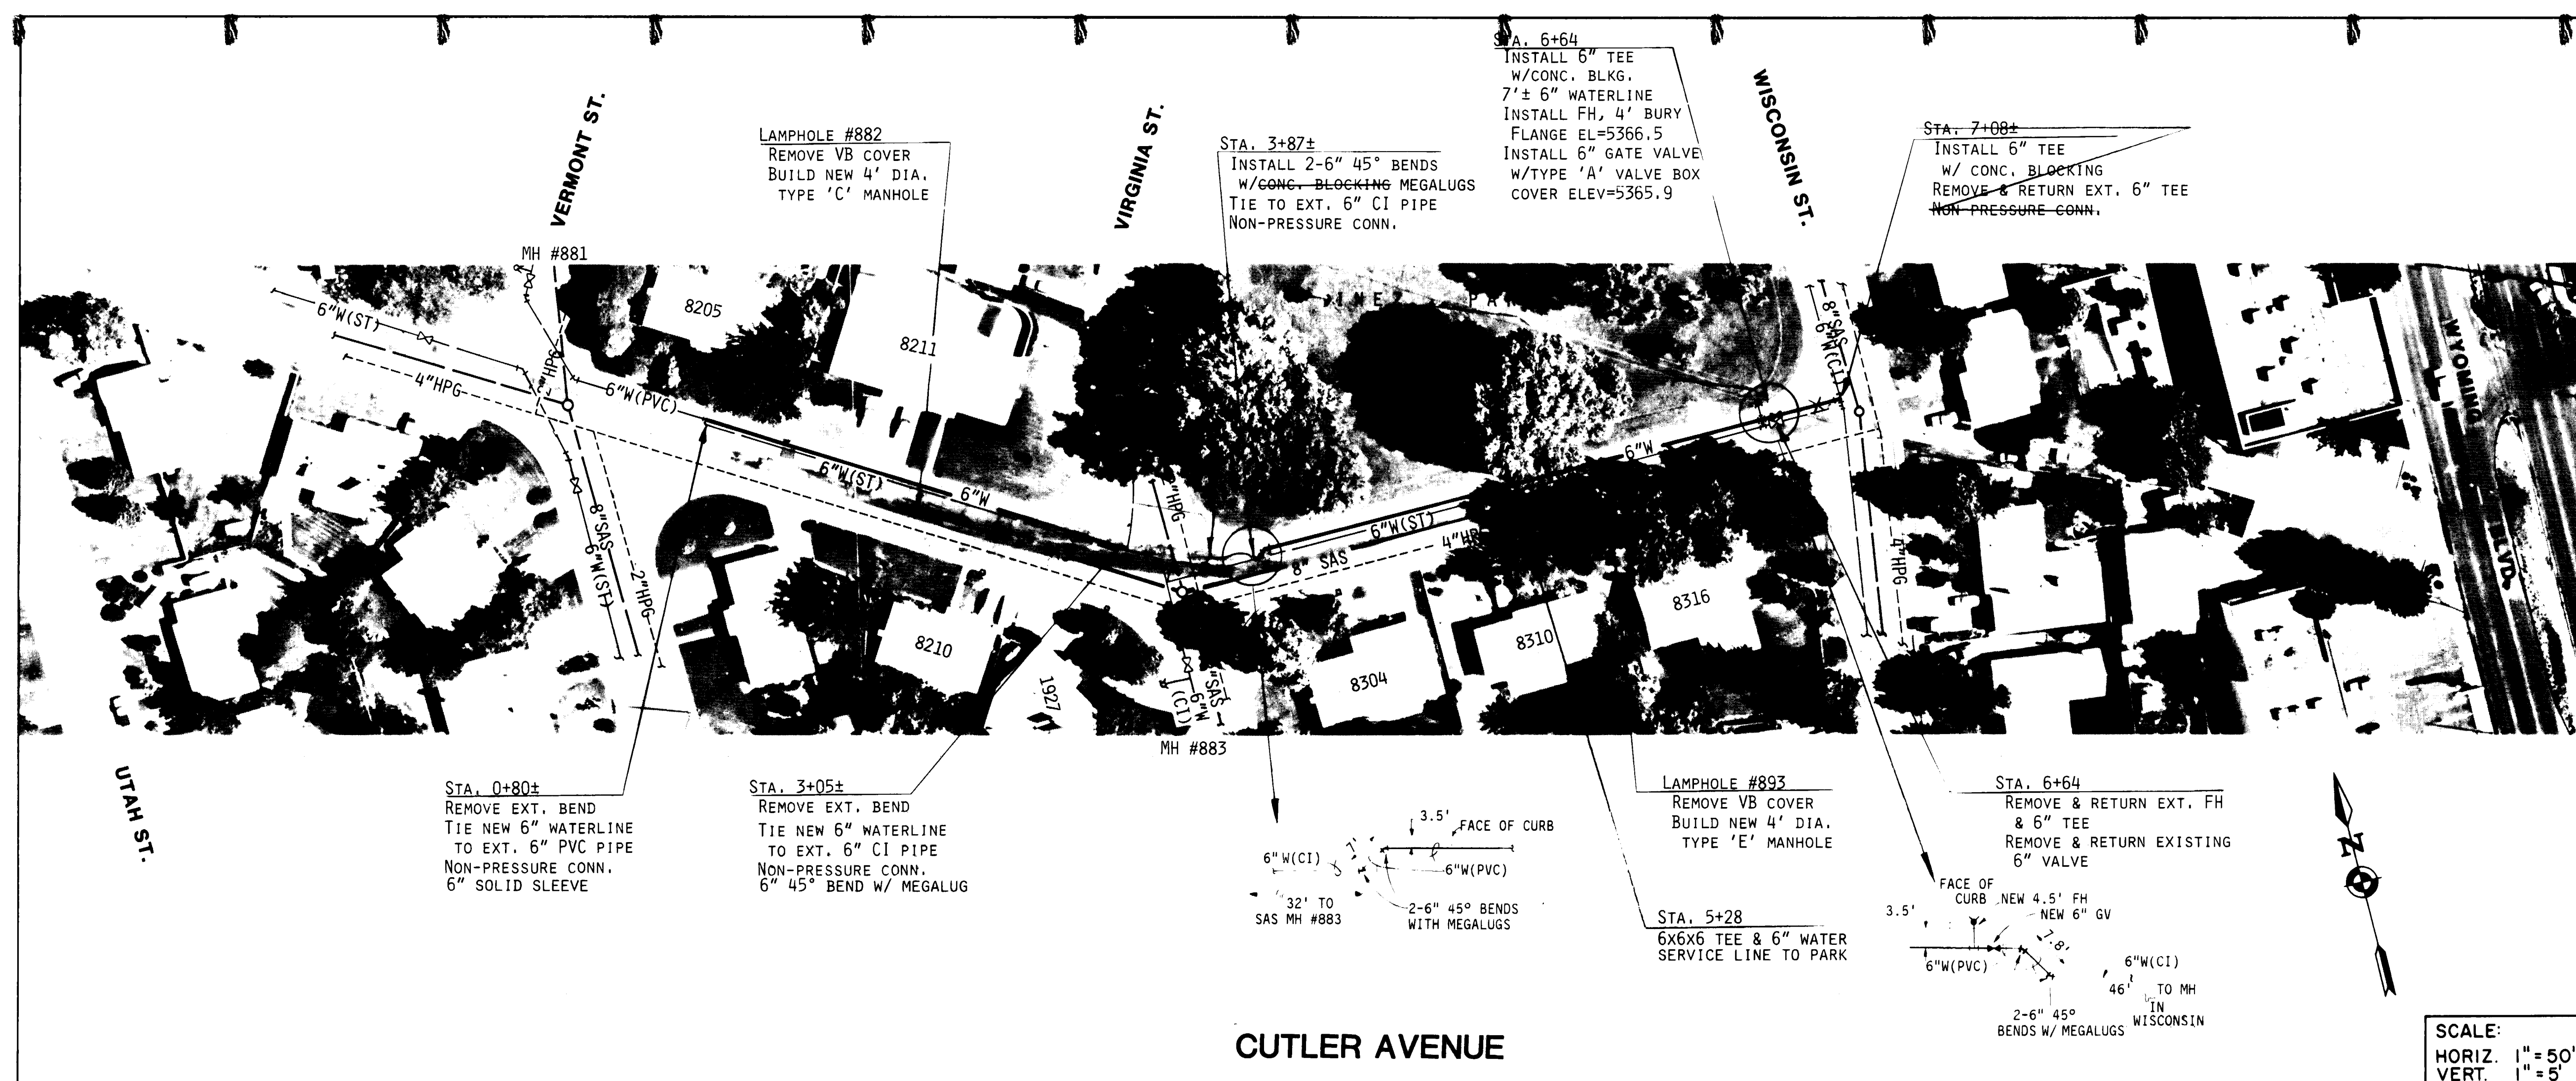

NOTES

1. THE REMOVAL OF THE VB COVERS AT THE LAMPHOLE ACCESS POINTS IS INCIDENTAL TO THE REMOVAL OF THE EXT. 8" SEWER AND NO SEPARATE PAYMENT WILL BE MADE THEREFOR.
2. THE CONTRACTOR SHALL REMOVE THE EXISTING 6" STEEL WATERLINE FROM STA. 0+80± TO STA. 3+05± AND FROM STA. 3+87± TO STA. 7+08±.
3. ANY PARK FACILITIES DAMAGED BY THE CONTRACTOR SHALL BE RESTORED AT NO EXPENSE TO THE CITY.

WARNING
This is part of a record document. All documents are based on reports submitted by the contractor. The City of Albuquerque does not warrant the accuracy of the information provided herein.

SCALE:
HORIZ. 1" = 50'
VERT. 1" = 5'

ENGINEER'S SEAL
Isaacson & Arfman, P.A.
REGISTERED PROFESSIONAL ENGINEER
No. 2088
NEW MEXICO
5-5-89

WATER VALVE SHUT-OFF PLAN

WATER SERVICE REHABILITATION				
CUTLER ADDRESS	METER SIZE	①	②	③
8210	3/4"			X
8211	"	X	X	
8304	1-1/4"			X
8310	3/4"			X
8316	"			X

KEY: ① SERVICE LINE REPLACEMENT
② METER BOX RELOCATION & REPLACEMENT
③ SERVICE LINE REPLACEMENT


Isaacson & Arfman, P.A.
CONSULTING ENGINEERING ASSOCIATES
Albuquerque, New Mexico

**CITY OF ALBUQUERQUE
PUBLIC WORKS DEPARTMENT
ENGINEERING GROUP**

TITLE: FY88-89 WATERLINE & SEWERLINE RENEWAL PROGRAM, AREA II
CUTLER AVENUE

APPROVALS	ENGINEER	DATE	APPROVALS	ENGINEER	DATE
D.R.C. Chair			Liquid Waste		
Trans. Dev.			Traffic		
Utility Dev.			Water		

DRAWING NO. 3503 **MAP NO. H-19** **SHEET 19 OF 24**

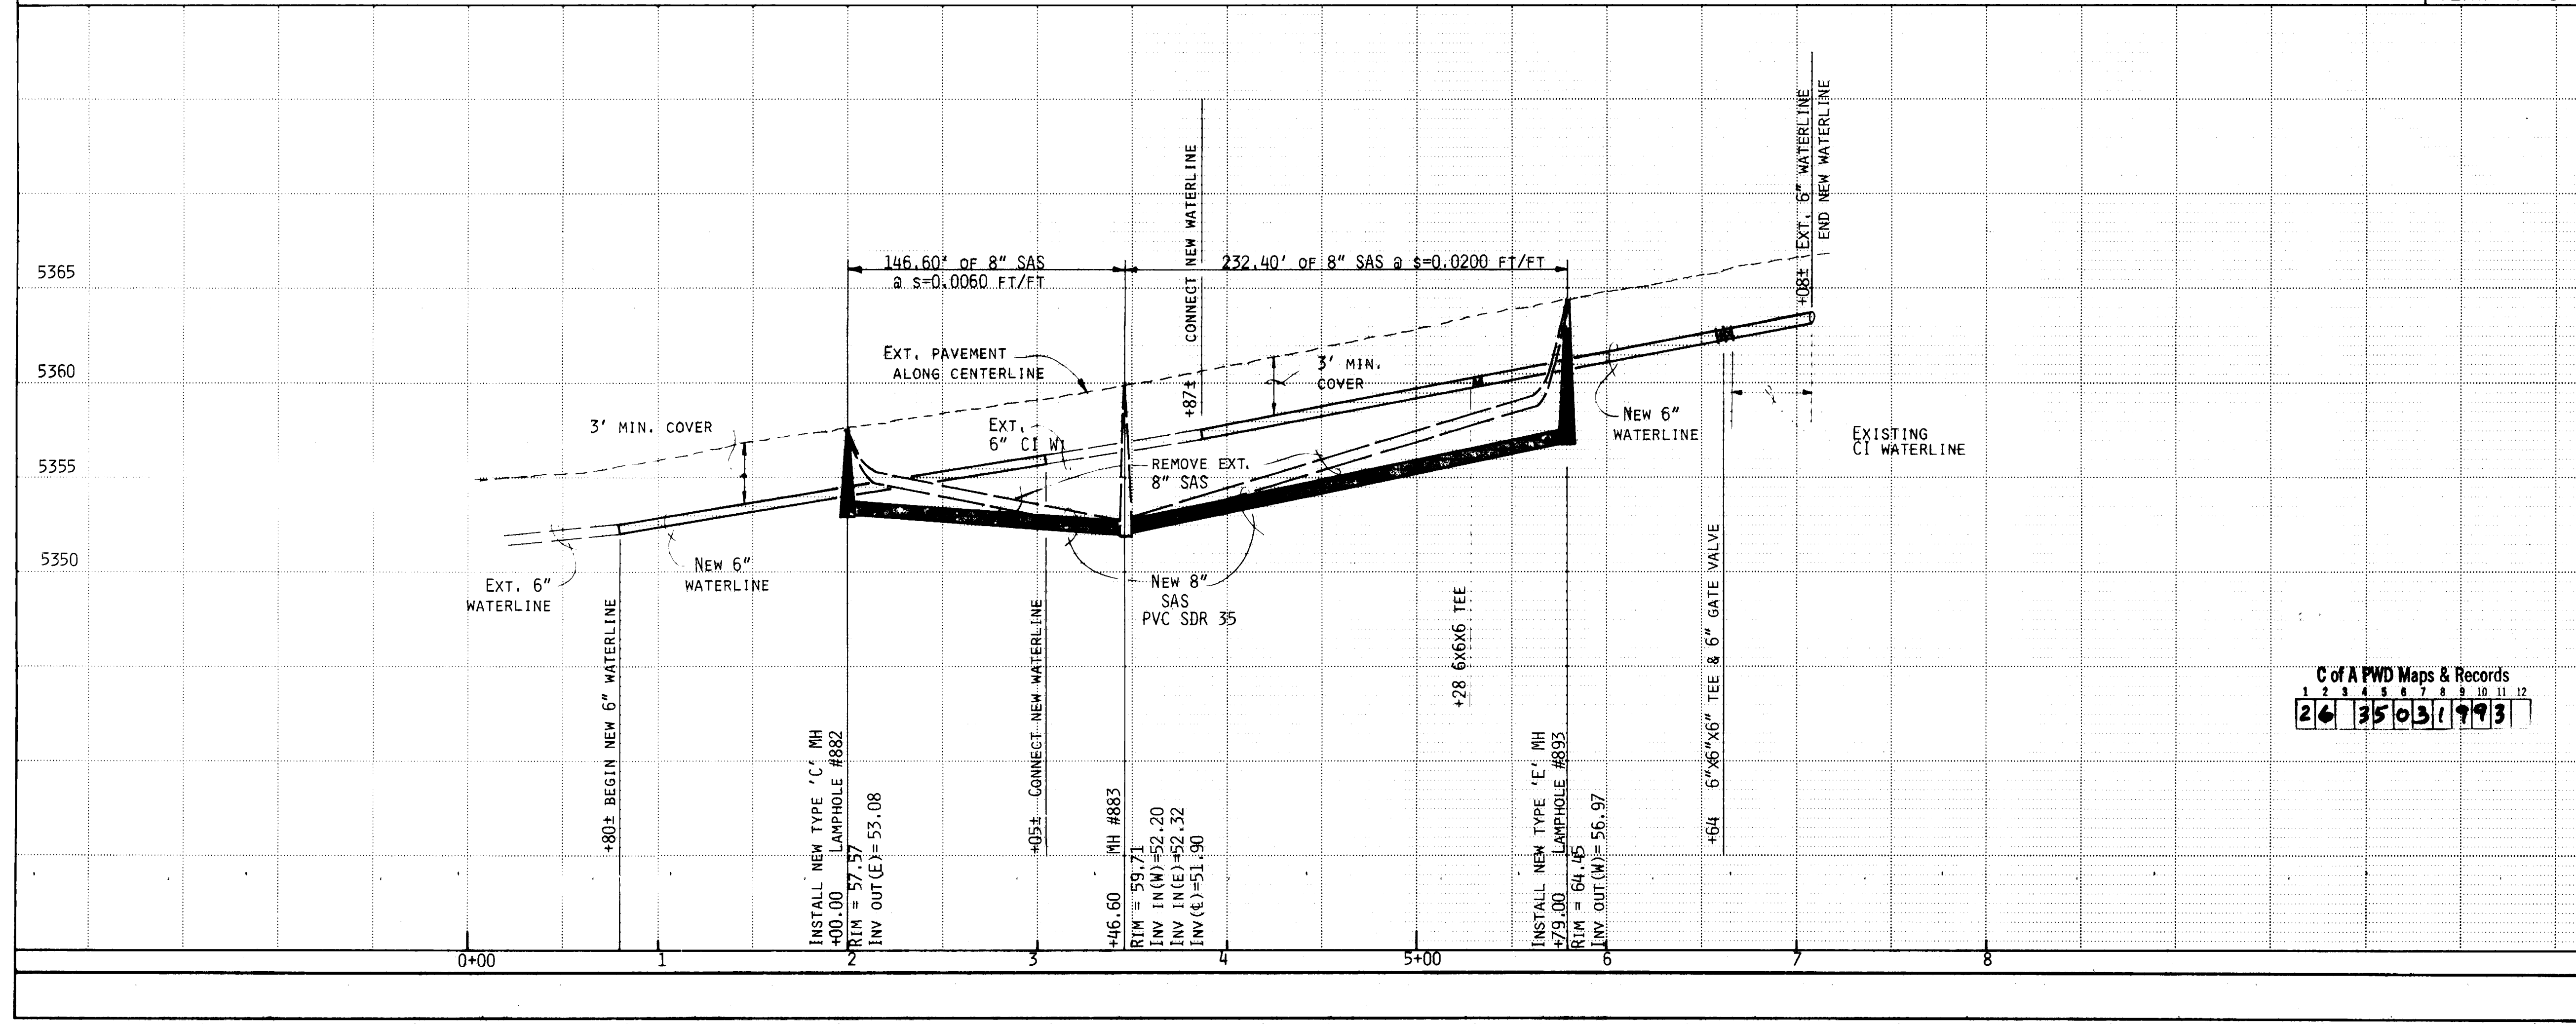

ENGINEER'S SEAL
Isaacson & Arfman, P.A.
REGISTERED PROFESSIONAL ENGINEER
No. 2088
NEW MEXICO
5-5-89

WATER VALVE SHUT-OFF PLAN

WATER SERVICE REHABILITATION				
CUTLER ADDRESS	METER SIZE	①	②	③
8210	3/4"			X
8211	"	X	X	
8304	1-1/4"			X
8310	3/4"			X
8316	"			X

KEY: ① SERVICE LINE REPLACEMENT
② METER BOX RELOCATION & REPLACEMENT
③ SERVICE LINE REPLACEMENT



Isaacson & Arfman, P.A.
CONSULTING ENGINEERING ASSOCIATES
Albuquerque, New Mexico

**CITY OF ALBUQUERQUE
PUBLIC WORKS DEPARTMENT
ENGINEERING GROUP**

TITLE: FY88-89 WATERLINE & SEWERLINE RENEWAL PROGRAM, AREA II
CUTLER AVENUE

APPROVALS	ENGINEER	DATE	APPROVALS	ENGINEER	DATE
D.R.C. Chair			Liquid Waste		
Trans. Dev.			Traffic		
Utility Dev.			Water		

DRAWING NO. 3503 **MAP NO. H-19** **SHEET 19 OF 24**

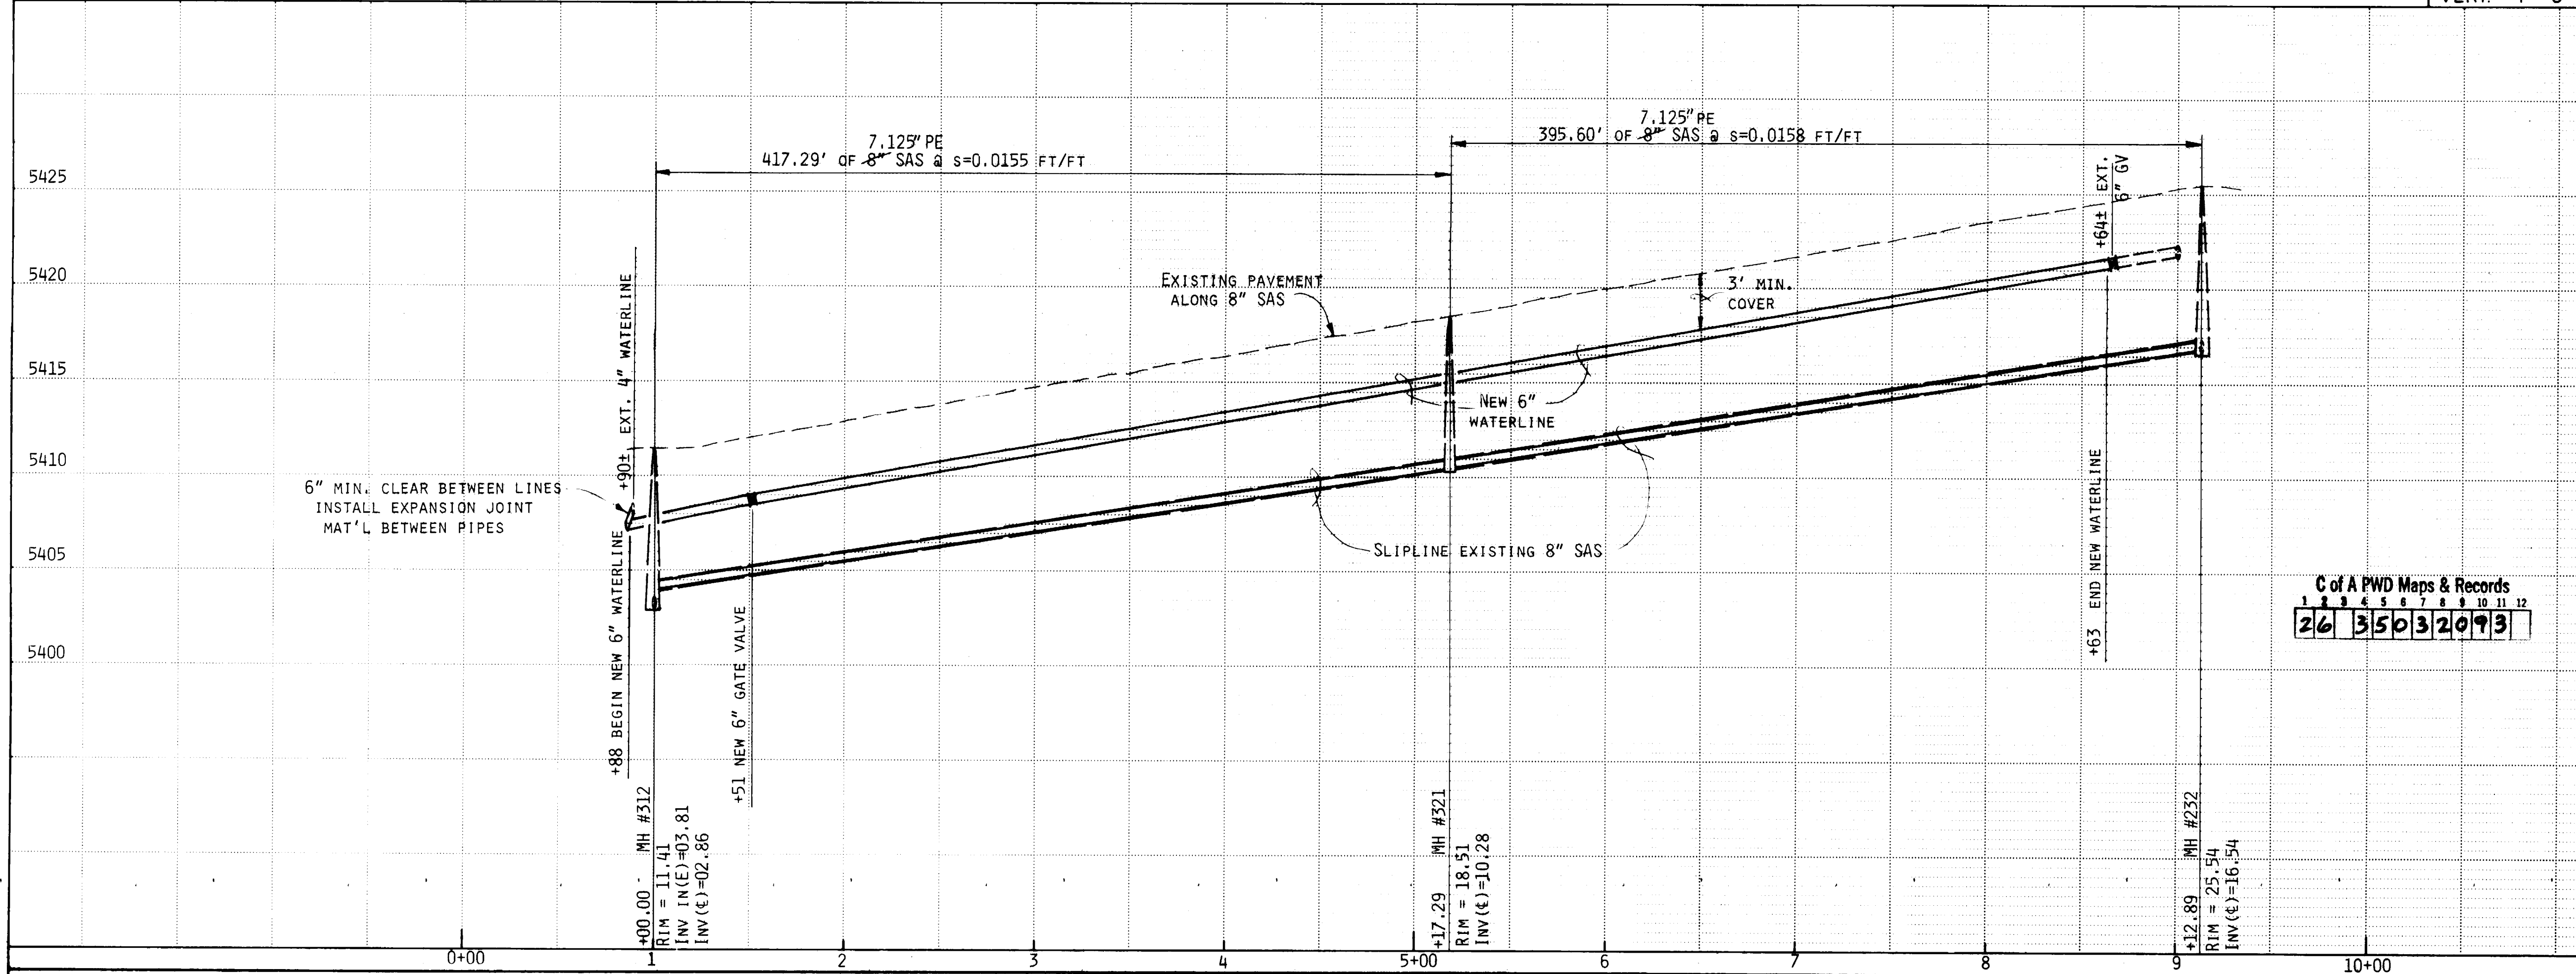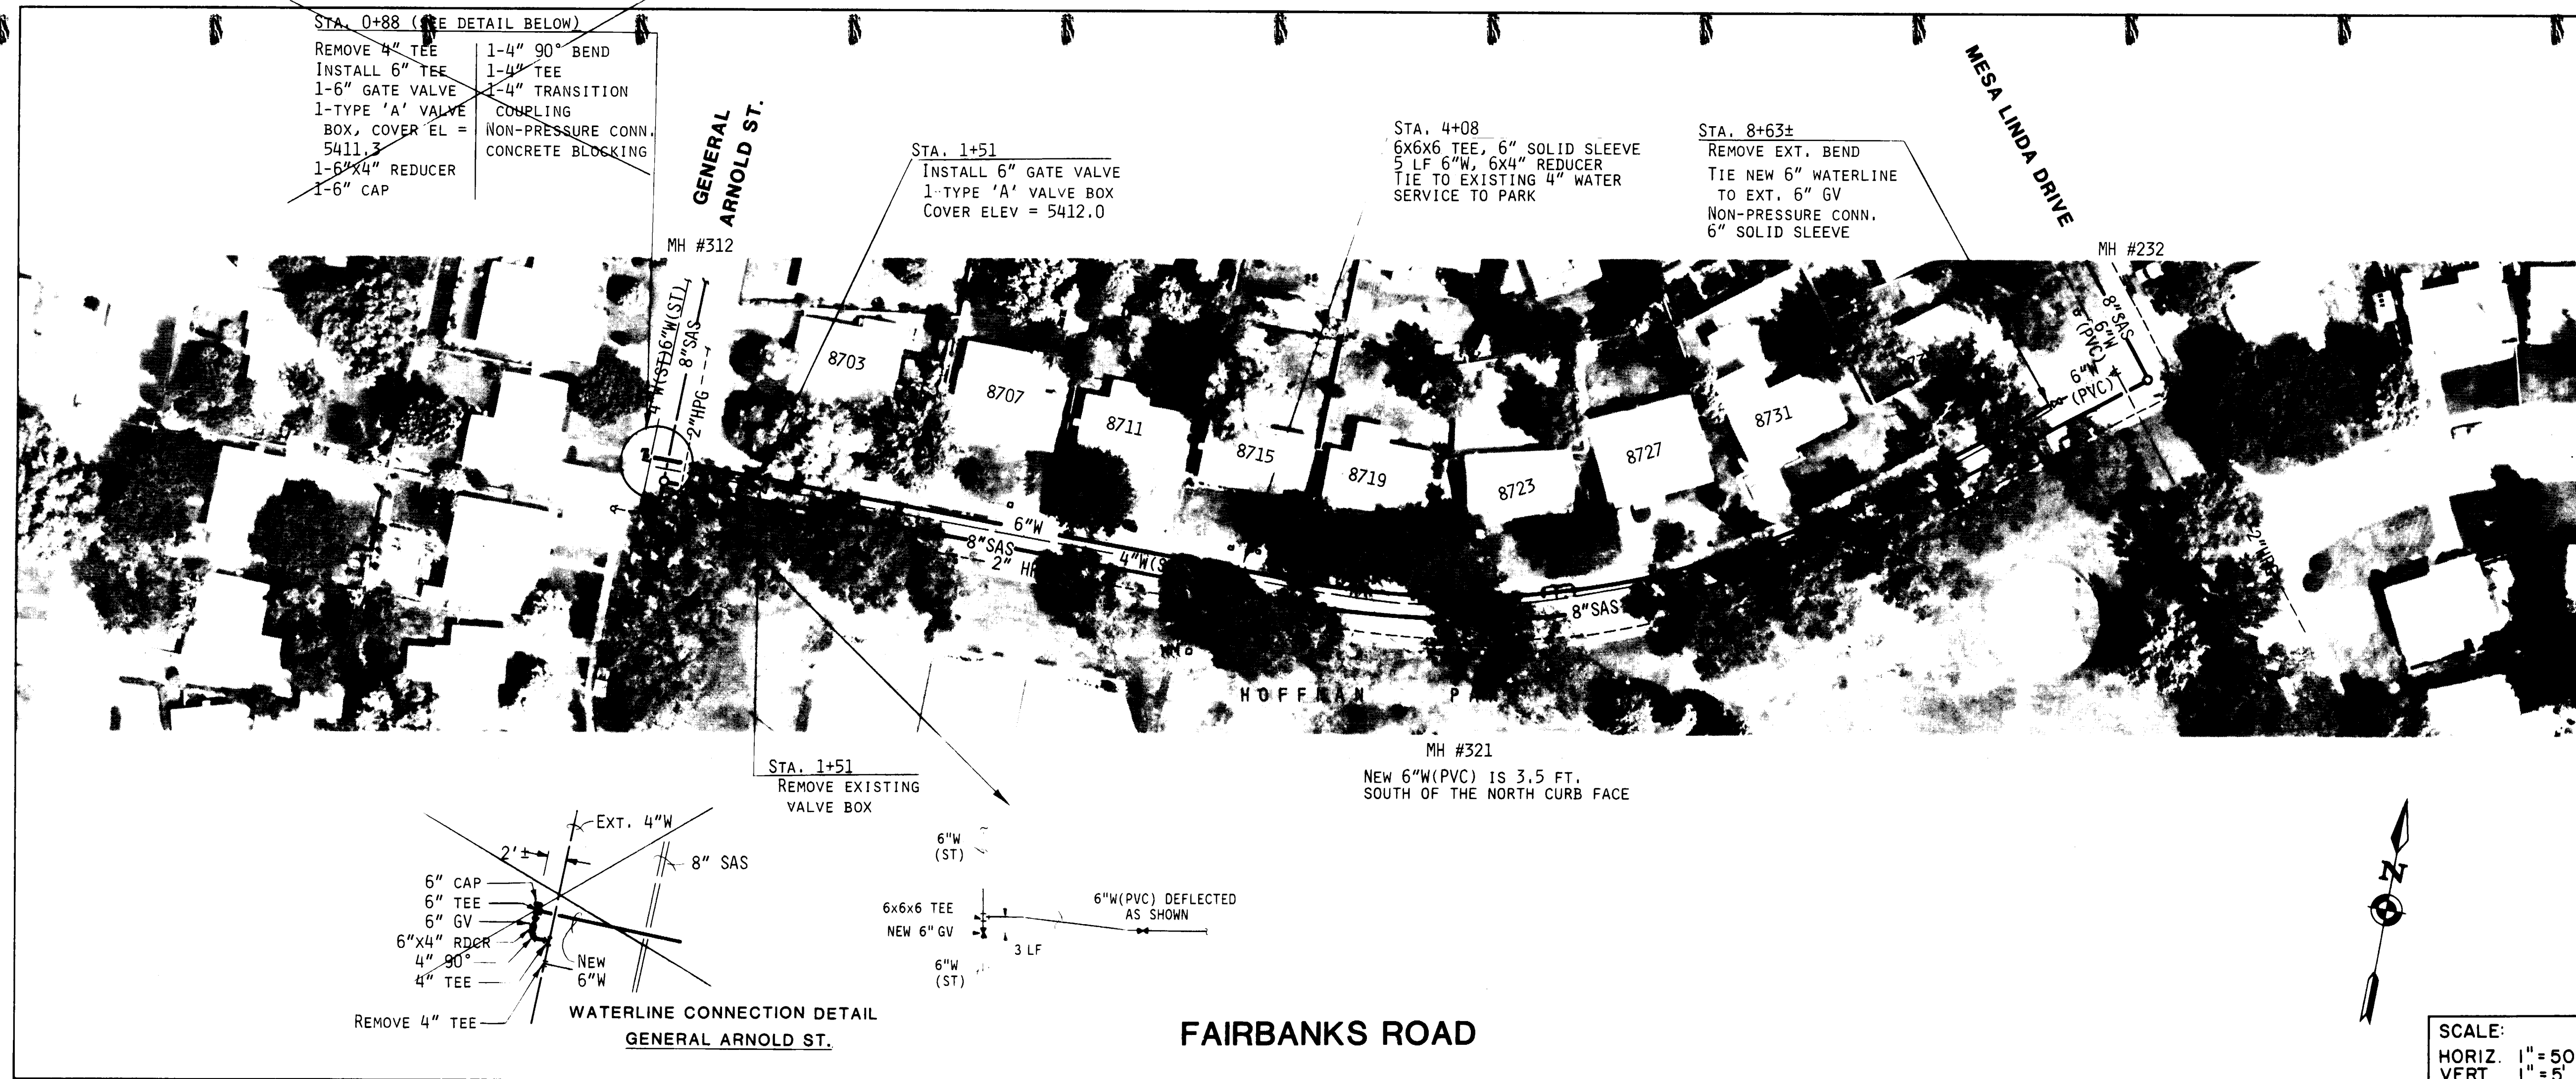

NOTES

1. THE CONTRACTOR SHALL REMOVE & DISPOSE OF THE EXISTING 4" STEEL WATERLINE FROM STA. 0+90± TO STA. 8+63±.

RECORD DRAWING

WARNING

This is a part of a record document. Record documents are the basis for reports submitted by the contractor. The contractor is responsible for any errors or omissions in the record drawing. Users of record drawings are advised to verify the information shown on the drawing with the actual conditions on the ground.

AS BUILT INFORMATION

CONTRACTOR: SUNDANCE MECHANICAL
WORK: WATERLINE RENEWAL
STARTED BY: G. MARQUEZ
DATE: 1990
FIELD: 1990
CHECKED BY: A. OSTAPACK
DATE: 90-91
REVISION: 1
DATE: 90-91
CORRECTED BY: 1 & A
DATE: 8/91
MICRO-FILM INFORMATION
RECORDED BY: NO
DATE: NO

BENCH MARKS

ACS BM "6-620", A SQUARE CHISEL IN THE CURB RETURN AT THE INTERSECTION OF CANDELARIA RD. WITH GENERAL STILLWELL ST. NE
ELEVATION: 5430.01

SURVEY INFORMATION

FIELD NOTES
NO. 1
BY S.D.G.
DATE 7/88

ENGINEER'S SEAL

Professional Engineer
No. 3888
New Mexico
5-5-89

WATER VALVE SHUT-OFF PLAN

FAIRBANKS ADDRESS	METER SIZE	①	②	③
8703	1-1/2"	X	X	X
8707	"	X	X	
8711	3/4"	X	X	
8715	"			X
8719	"	X	X	
8723	1-1/2"	X	X	
8727	3/4"	X		
8731	"			X
8735	"	X	X	

KEY: ① SERVICE LINE TRANSFER
② METER BOX RELOCATION & REPLACEMENT
③ SERVICE LINE REPLACEMENT

Isaacson & Artman, P.A.
CONSULTING ENGINEERING ASSOCIATES
Albuquerque, New Mexico



**CITY OF ALBUQUERQUE
PUBLIC WORKS DEPARTMENT
ENGINEERING GROUP**

TITLE:
FY88-89 WATERLINE & SEWERLINE RENEWAL PROGRAM, AREA I

FAIRBANKS ROAD

APPROVALS	ENGINEER	DATE	APPROVALS	ENGINEER	DATE
D.R. Chair			Liquid Waste		
Trans. Dev.			Traffic		
Utility Dev.			Water		

DRAWING NO. 3503 **MAP NO.** H-20 **SHEET** 20 **OF** 24

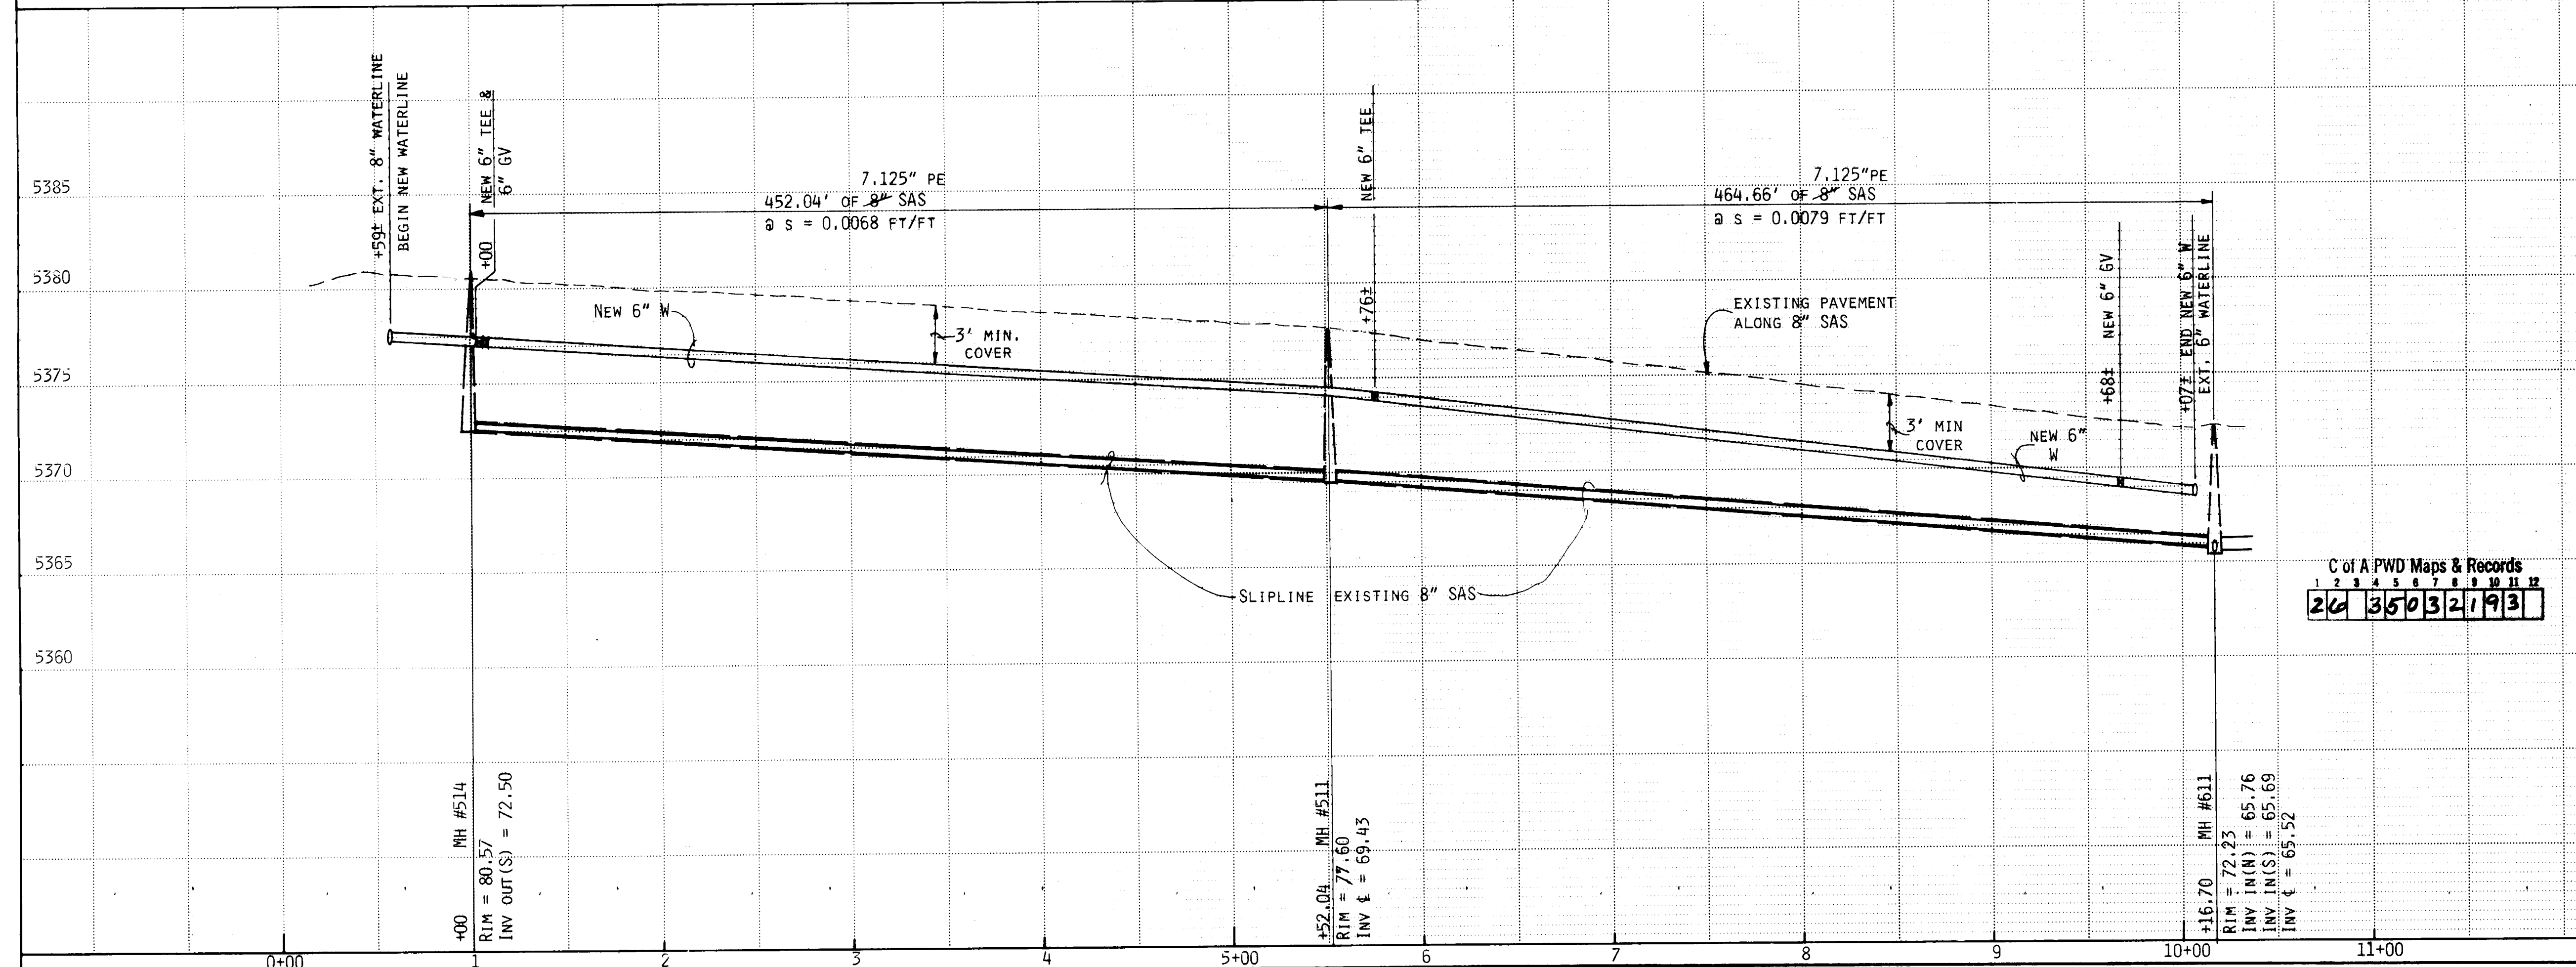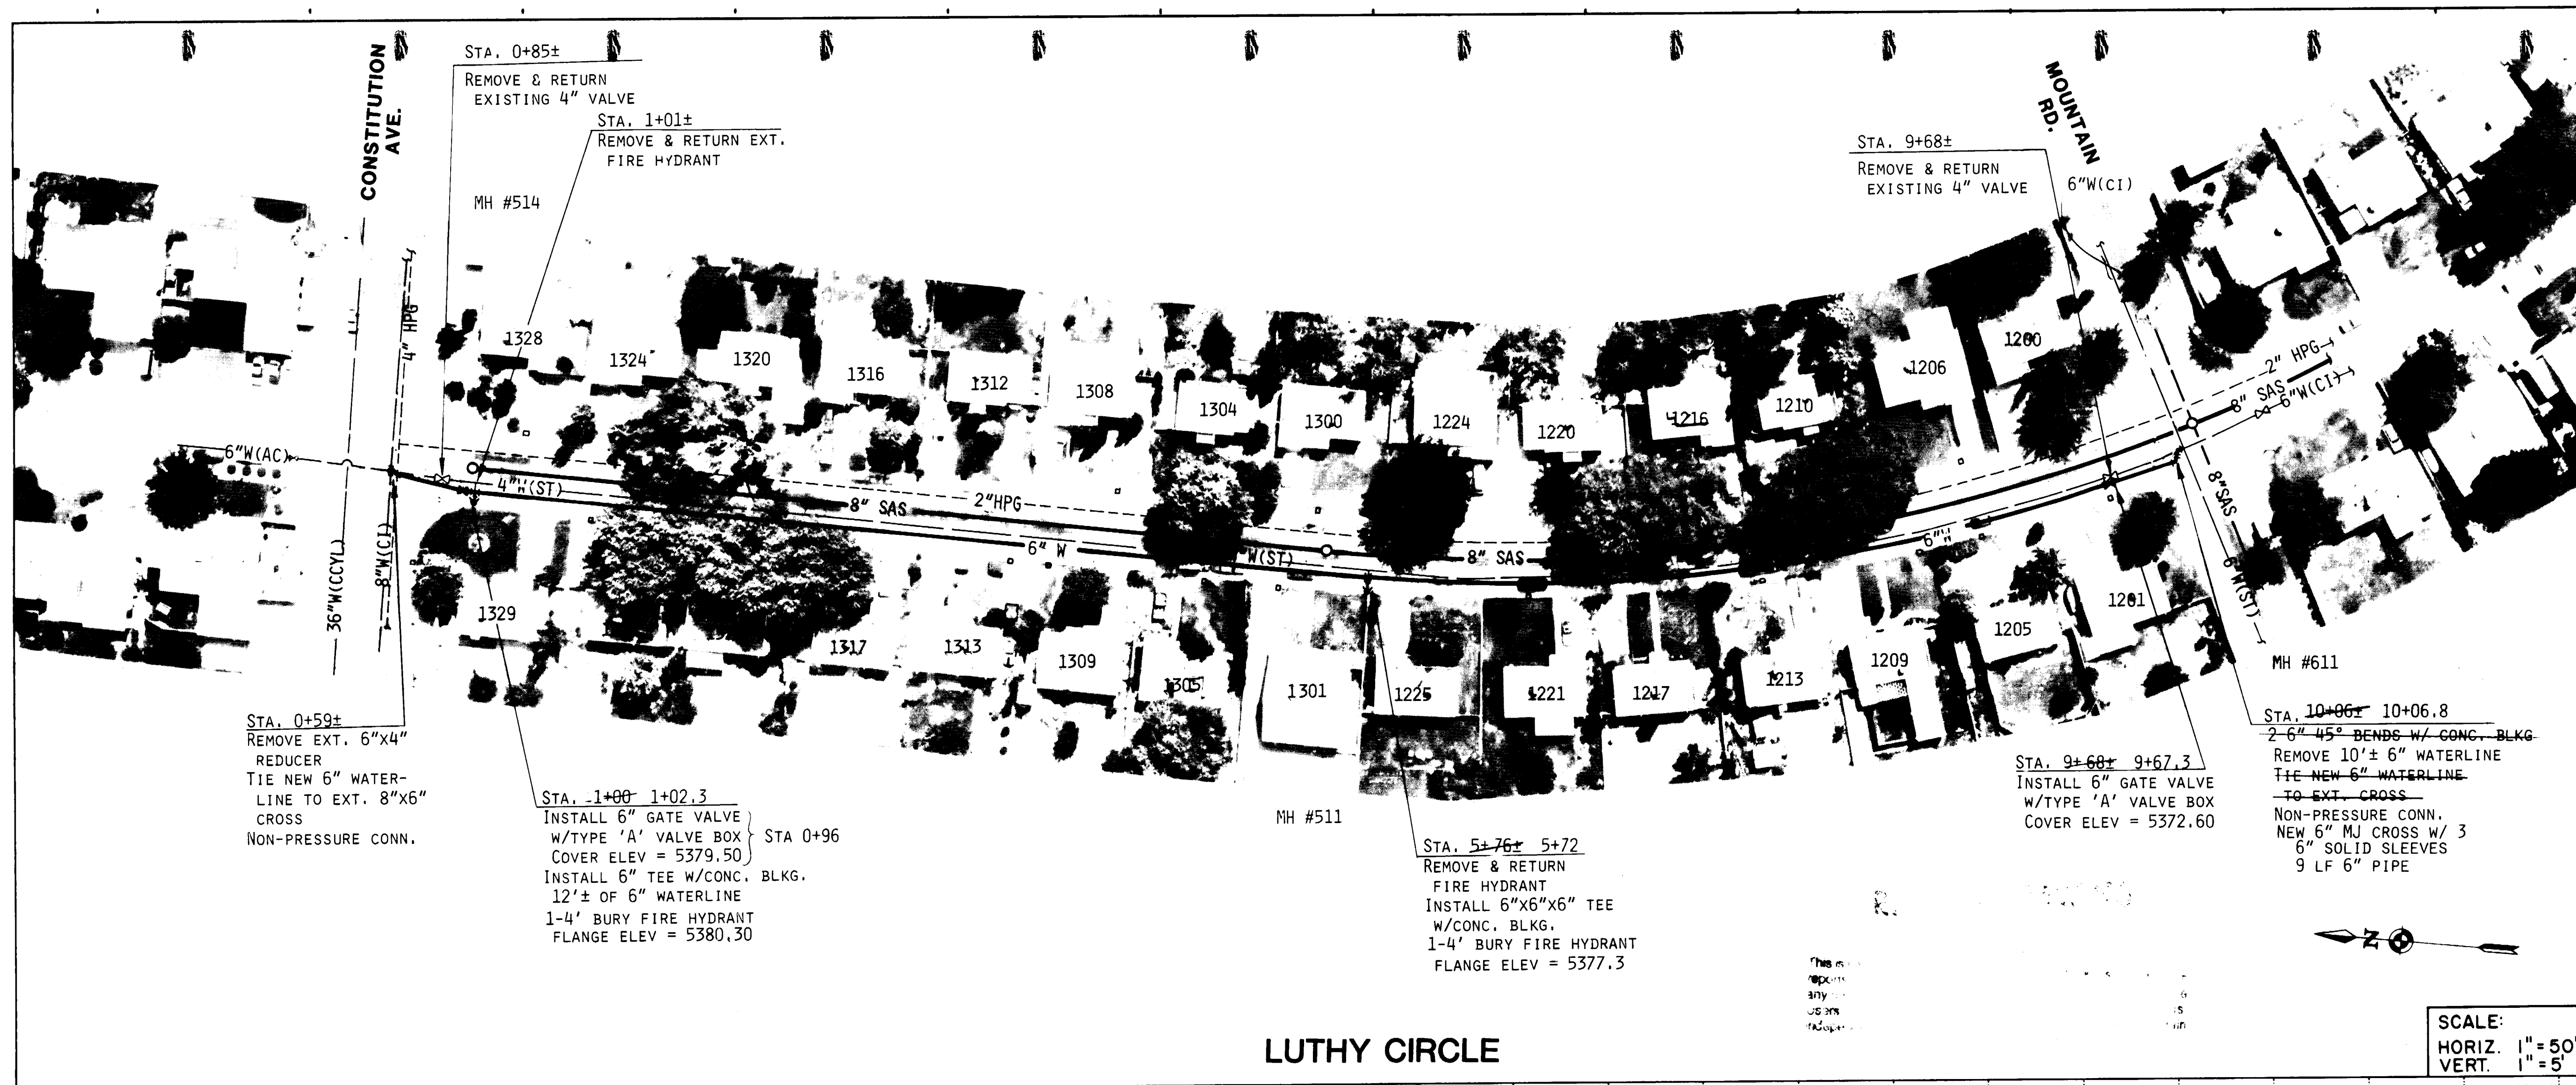

NOTES
1. THE CONTRACTOR SHALL REMOVE AND DISPOSE OF THE EXISTING 4-INCH STEEL WATERLINE FROM STA. 0+59± TO STA. 10+06±.

AS BUILT INFORMATION
CONTRACTOR: SUNDANCE MECHANICAL
STAKED BY: G. MARQUEZ
DATE: 1990
FIELD ACCEPTANCE BY: TONY A. DATE: 9/90
CORRECTED BY: TONY A. DATE: 9/91
RECORDED BY: TONY A. DATE: 9/91

BENCH MARKS
ACS BRASS CAP "3-120" SET BEHIND THE SIDEWALKS AT THE NW QUADRANT OF THE INTERSECTION OF CONSTITUTION AVE. AND MOON ST. NE
ELEVATION: 5410.93

WATER VALVE SHUT-OFF PLAN
N

WATER SERVICE REHABILITATION

LUTHY ADDRESS	METER SIZE	①	②	③
1200	3/4"			X
1201	"	X	X	
1205	"	X	X	
1206	"			X
1209	"	X	X	
1210	"			X
1213	"	X	X	
1216	"			X
1217	"	X	X	
1220	"			X
1221	"	X		
1224	"			X
1225	"	X	X	
1300	"			X
1301	"	X	X	
1304	"			X
1305	"	X	X	
1308	"			X
1309	"	X	X	
1312	"			X
1313	"	X	X	
1316	"			X
1317	"	X	X	
1320	"			X
1321	"	X	X	
1324	"			X
1325	"	X		
1328	"			X
1329	1-1/2"			

KEY:
① SERVICE LINE TRANSFER
② METER BOX RELOCATION & REPLACEMENT
③ SERVICE LINE REPLACEMENT

Isaacson & Arfman, P.A.
CONSULTING ENGINEERING ASSOCIATES
Albuquerque, New Mexico

**CITY OF ALBUQUERQUE
PUBLIC WORKS DEPARTMENT
ENGINEERING GROUP**

TITLE:
FY88-89 WATERLINE & SEWERLINE RENEWAL PROGRAM, AREA II
LUTHY CIRCLE

APPROVALS	ENGINEER	DATE	APPROVALS	ENGINEER	DATE
D.R.C. Chair			W. J. M. Chair		
Trans. Dev.			W. J. M. Chair		
Utility Dev.			W. J. M. Chair		

DRAWING NO. 3503
MAP NO. J-20
SHEET 21 OF 24



NOTE: 6" PRESSURE CONNECTION REQUIRED TO
12 CI PIPE IN CARLISLE.


[illegible]

NOTE: 12" PRESSURE CONNECTION REQUIRED TO
12" CI PIPE IN CARLISLE

RECORD DRAWING

WARNING
This is part of a record document. Record documents are used to report, submit, or otherwise provide information to assure or assume any responsibility for the accuracy or veracity of record documents. Users of record documents are cautioned and advised to obtain independent verification of actual conditions.

CITY OF ALBUQUERQUE PUBLIC WORKS DEPARTMENT ENGINEERING GROUP					
TITLE: FY 88-89 WATERLINE & SEWERLINE RENEWAL PROGRAM, AREA II WATER VALVE SHUT-OFF PLANS FOR SP-2,3, & 7					
APPROVALS	ENGINEER	DATE	APPROVALS	ENGINEER	DATE
D.R.C. Chair	<i>[Signature]</i>	<i>5/2/89</i>			
Trans. Dev	"				
Utility Dev	<i>[Signature]</i>	<i>5/2/89</i>			
		<i>4/21/89</i>			
DRAWING NO.	3503		MAP NO.	SHEET 22 OF 24	

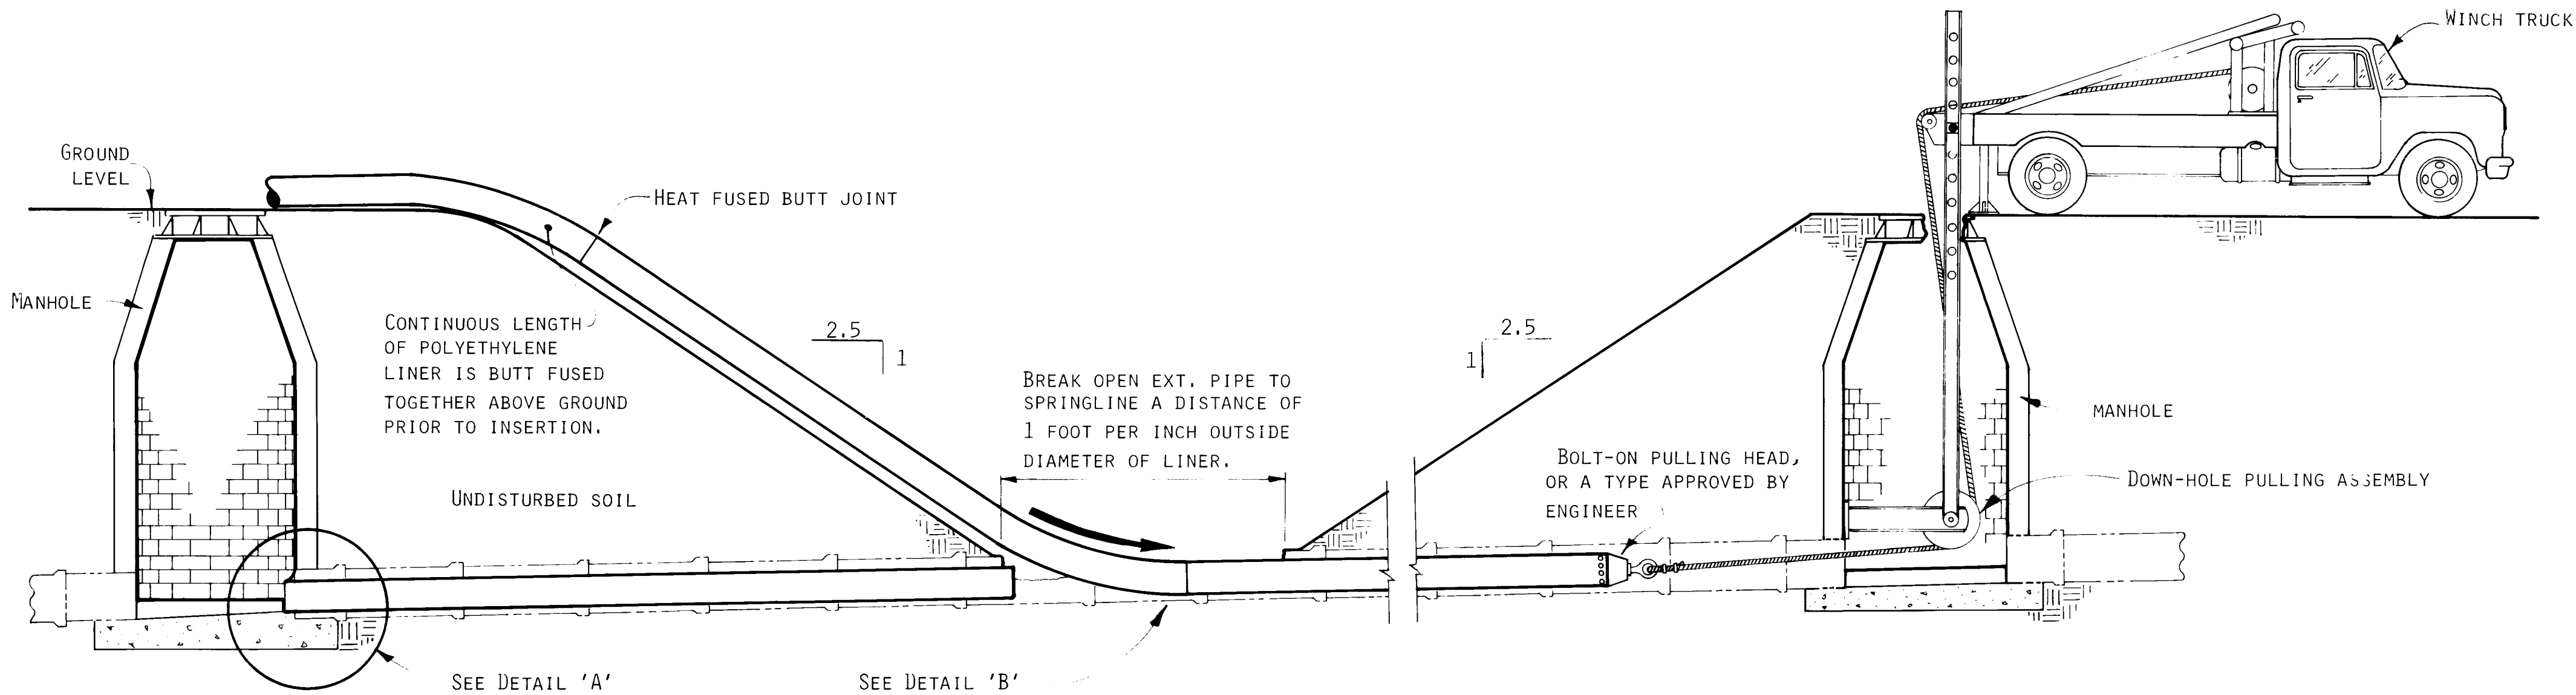


GENERAL NOTES

1. INSERTION HOLES AT MANHOLES MUST BE CORE DRILLED.
2. JOINTS AT MID-LINE INSERTION PITS SHALL BE MADE USING WRAP AROUND CLAMP COUPLINGS (SUPERIOR STYLE 121 OR CITY APPROVE EQUAL). ALL OTHER JOINTS SHALL BE MADE BY BUTT FUSION.
3. AFTER PULLING THE LINER PIPE INTO PLACE, THE CONTRACTOR SHALL ALLOW AT LEAST 12 HOURS FOR PIPE CONTRACTION BEFORE TRIMMING PIPE ENDS AND SEALING ANNULAR SPACE AT MANHOLES.
4. CITY APPROVED TAPPING SADDLES SUITABLE FOR USE ON POLYETHYLENE LINER PIPE, WITH STAINLESS STEEL STRAPS, SHALL BE USED TO RECONNECT SERVICE LINES TO STREET MAINS. SERVICE LINES SHALL BE REINSTALLED AS REQUIRED TO COMPLETE THE CONNECTION OF SERVICE LINES TO MAINS.
5. SERVICE LINE ELBOW DEFLECTIONS SHALL BE A MAXIMUM OF 45° AS PER CITY OF ALBUQUERQUE STANDARD DRAWING 2134.

TYPICAL MID-LINE INSERTION SECTION

NO SCALE

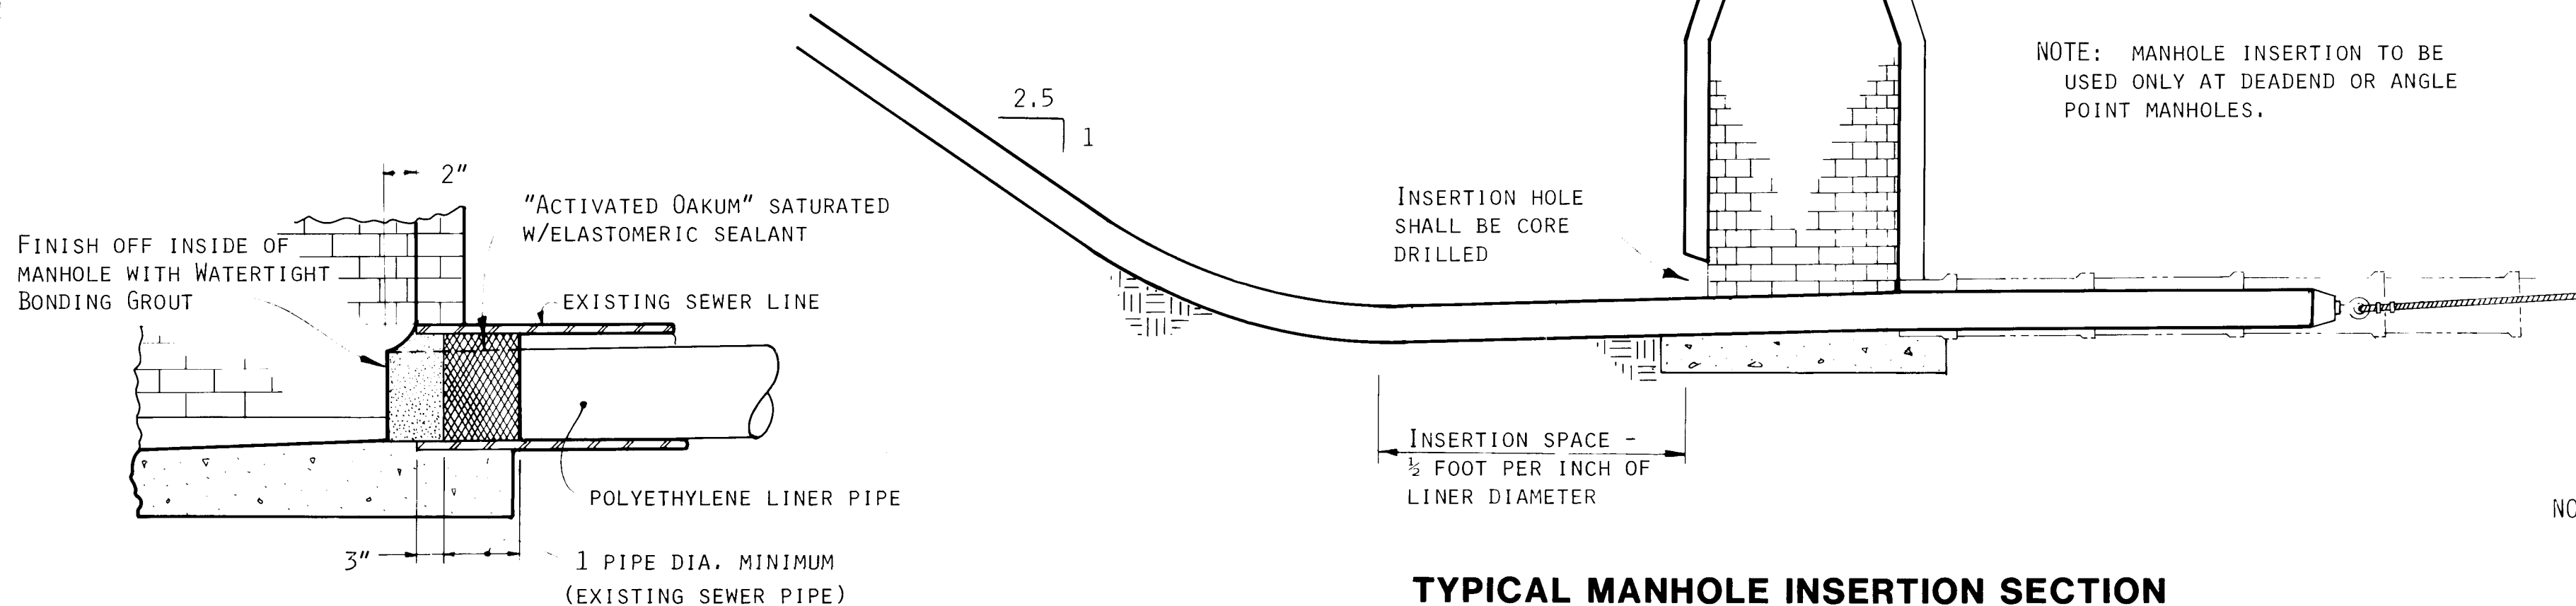


TYPICAL MANHOLE INSERTION SECTION

NO SCALE


DETAIL 'A'-MANHOLE WALL CONNECTION

NO SCALE

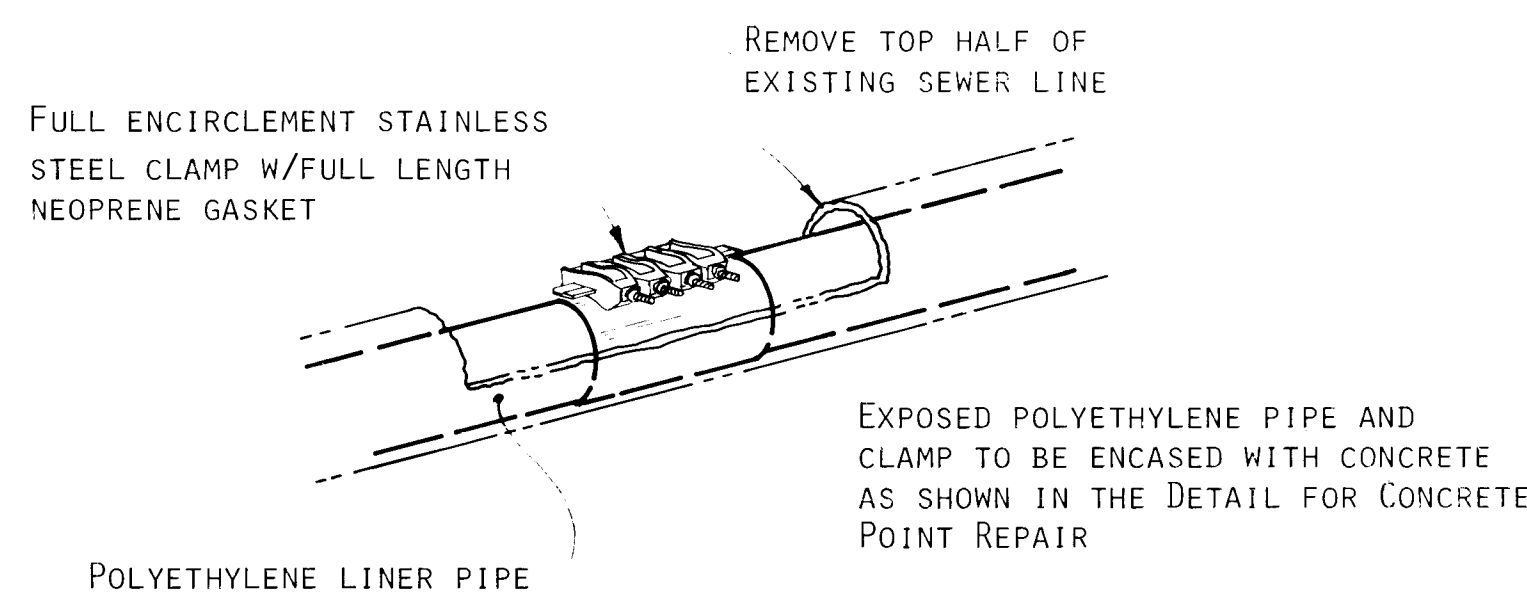


DETAIL 'B'-INSERTION PIT CONNECTION

NO SCALE

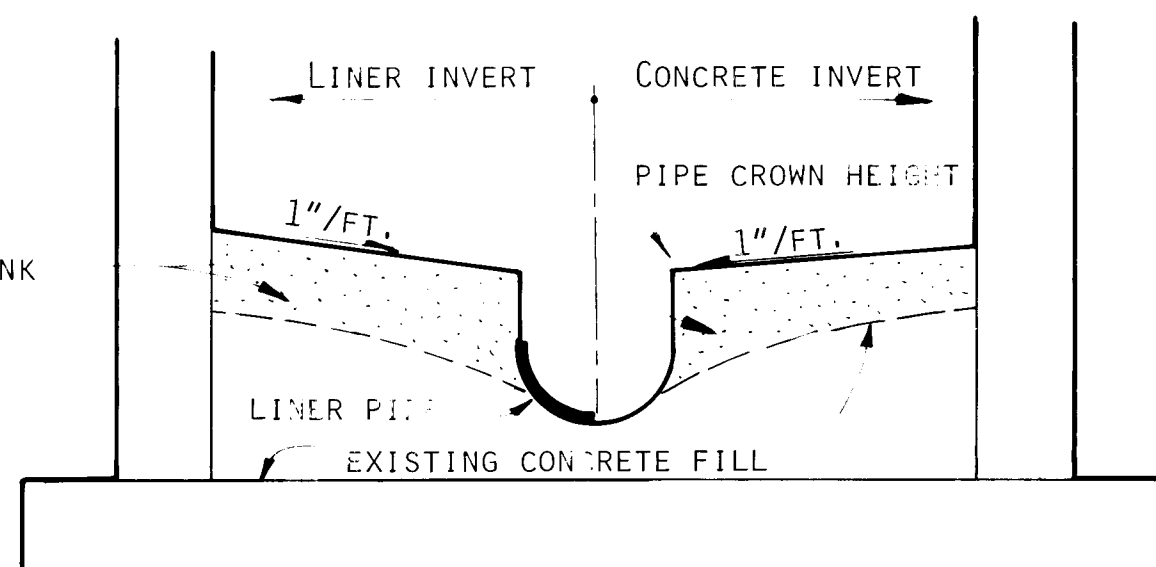


MANHOLE INVERT REHABILITATION

NO SCALE

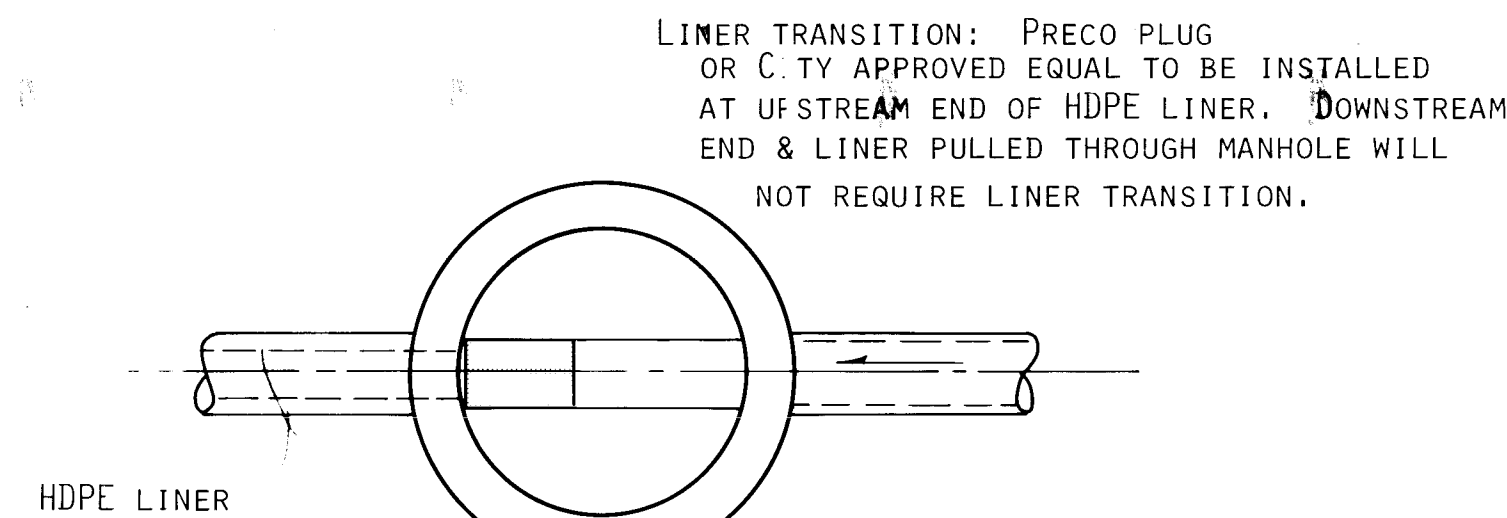


PLAN

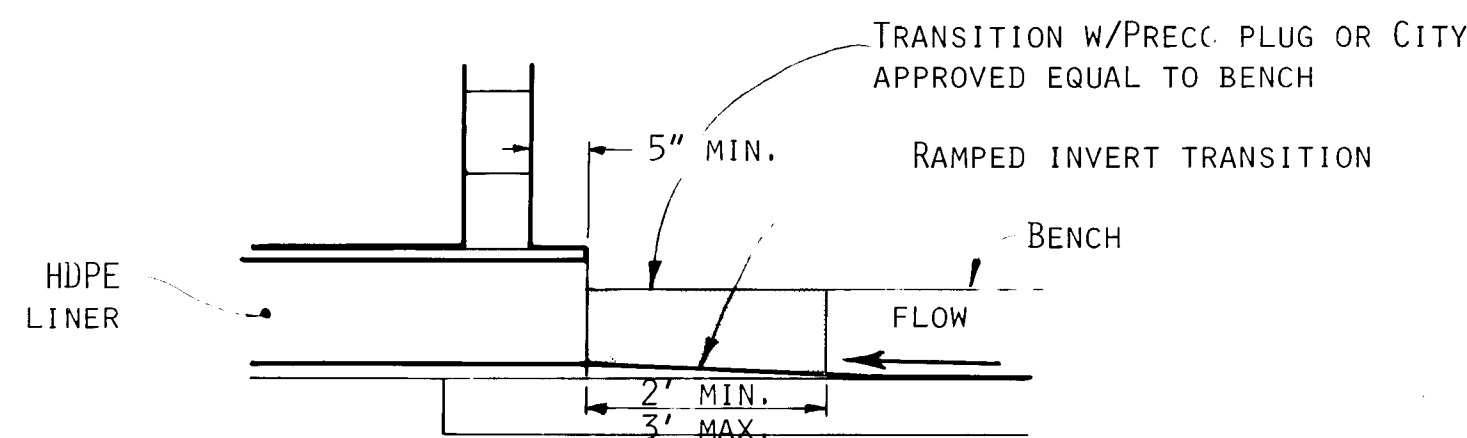

SECTION

LINER TRANSITION AT UPSTREAM MANHOLE


NO SCALE

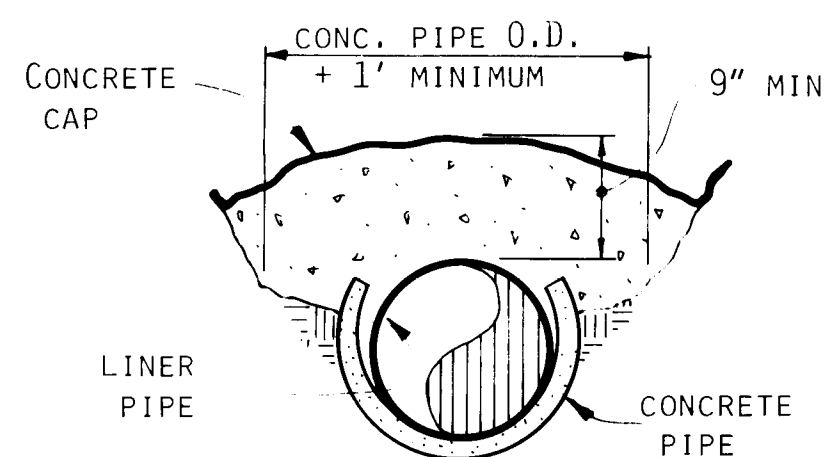

TRANSVERSE SECTION

CONCRETE POINT REPAIR

NO SCALE

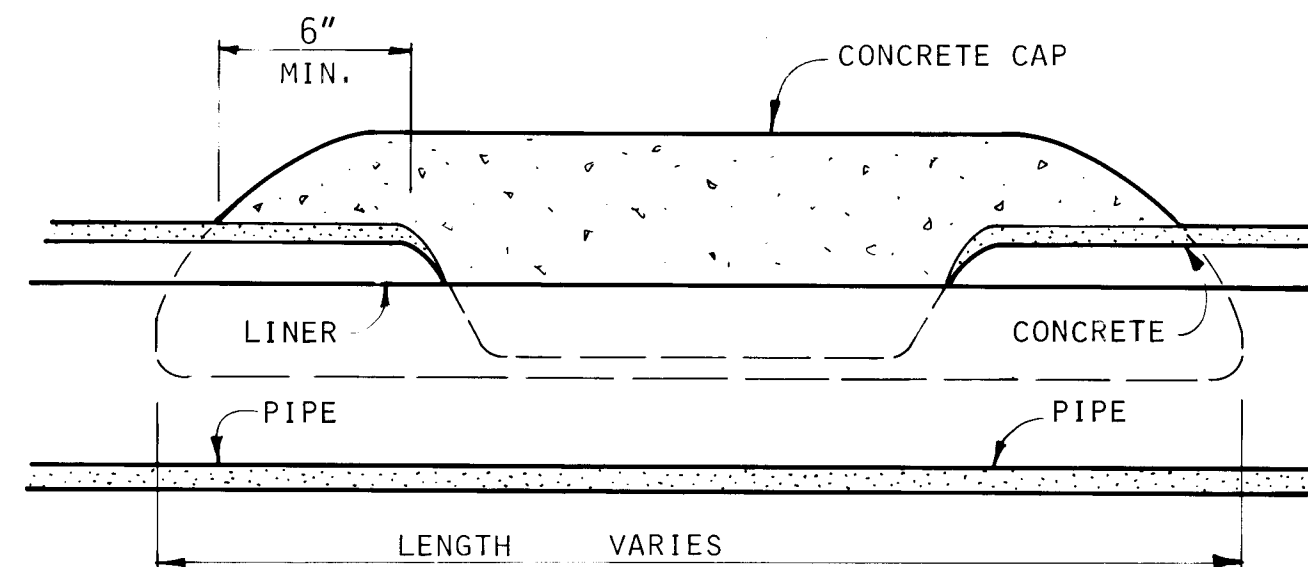


LONGITUDINAL SECTION

RECORD DRAWING

WARNING


This is part of a record drawing. It is not to be used for construction purposes. It is for informational purposes only. Users of record drawings are cautioned and advised to obtain independent verification of actual conditions.

NOTE: PULL LINER PIPE TO CENTER OF MANHOLE AND ALLOW 12 HOURS FOR CONTRACTION PRIOR TO TRIMMING.

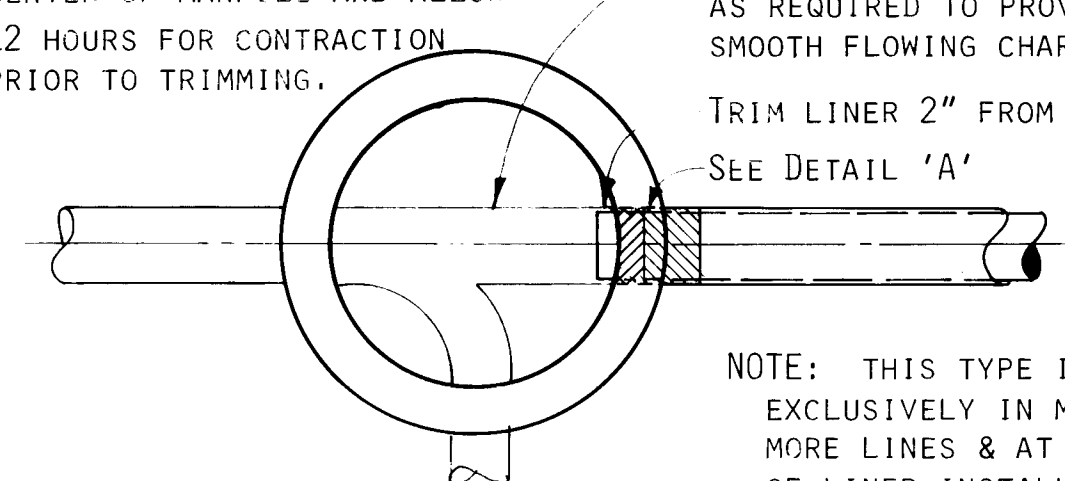

PLAN VIEW OF MANHOLE W/CONCRETE INVERT


NO SCALE

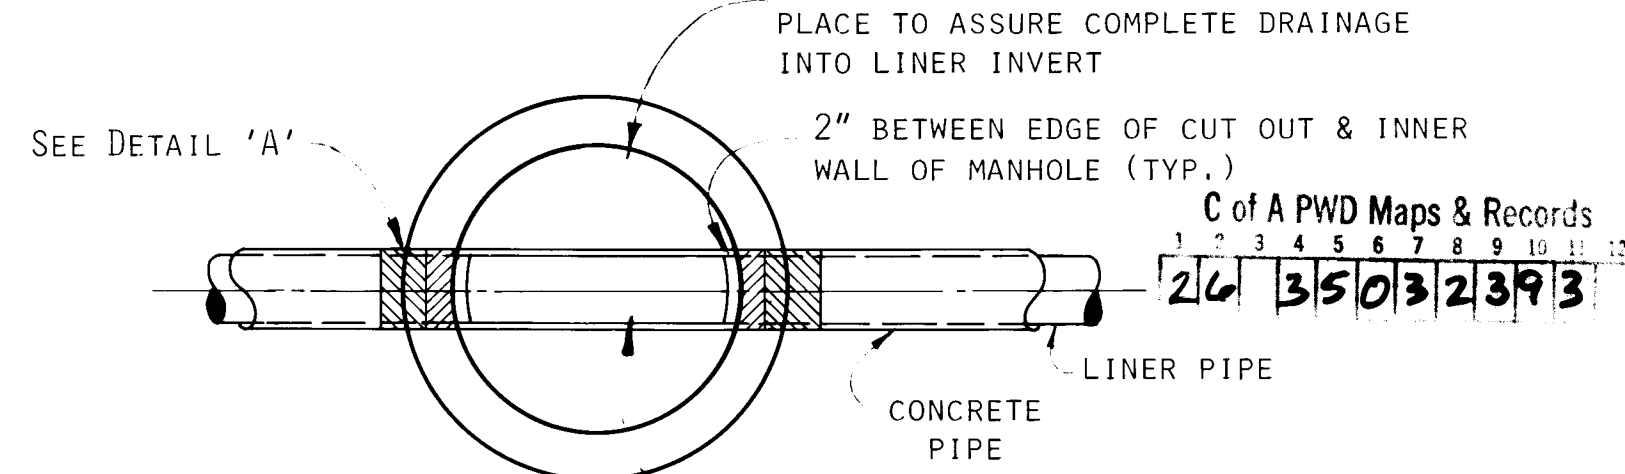


NOTE: THIS TYPE OF INVERT FOR PULL-THROUGH MANHOLES OR MANHOLES WITH ONLY TWO LINES.

PLAN VIEW OF MANHOLE W/LINER INVERT

NO SCALE

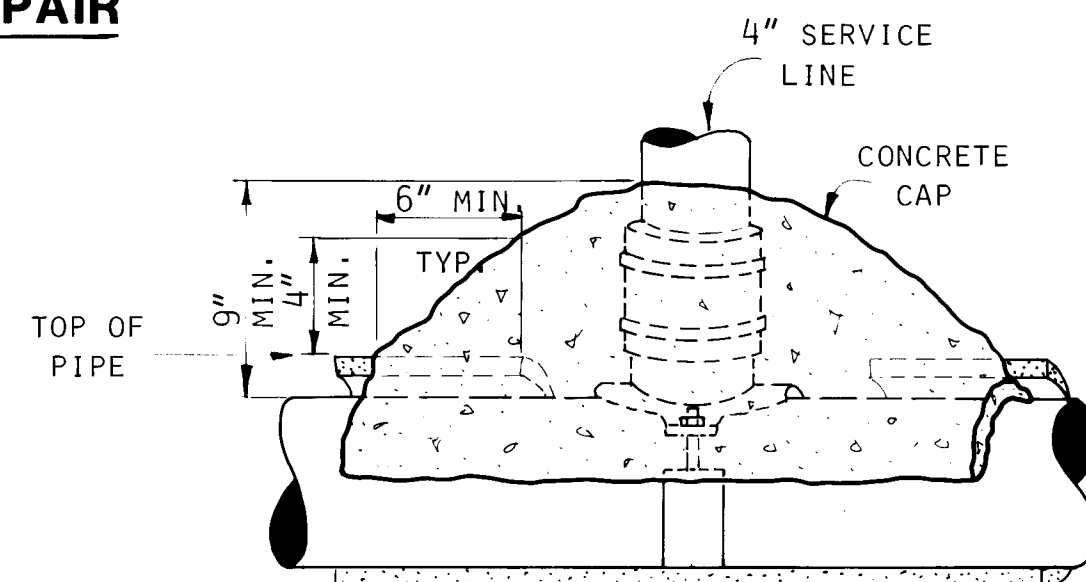

LONGITUDINAL SECTION

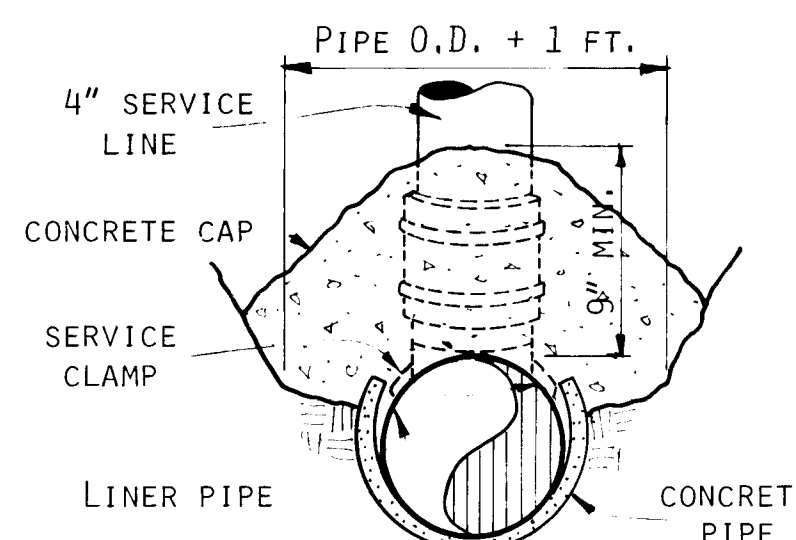

TRANSVERSE SECTION

SERVICE CONNECTION

NO SCALE

AS BUILT INFORMATION	
CONTRACTOR	SUNDANCE MECHANICAL
WORK NO.	1990
INSPECTOR	ALAN O. MARQUEZ
DATE	04/19/91
FIELD ACCEPTANCE BY	ALAN O. MARQUEZ
DATE	04/19/91
DRAWINGS	DESIGNED BY ALAN O. MARQUEZ
CHECKED BY	ALAN O. MARQUEZ
DATE	04/19/91
RECORDED BY	ALAN O. MARQUEZ
DATE	04/19/91


BENCH MARKS	
NO.	DATE

SURVEY INFORMATION	
NO.	DATE

ENGINEER'S SEAL	
PROFESSIONAL ENGINEER	ALAN O. MARQUEZ
NO. 1990	04/19/91
STATE OF NEW MEXICO	5-5-89

REVISIONS	
NO.	DATE

CITY OF ALBUQUERQUE PUBLIC WORKS DEPARTMENT ENGINEERING GROUP	
TITLE	FY88-89 WATERLINE & SEWERLINE RENEWAL PROGRAM, AREA II
DETAIL SHEET	
APPROVALS	ENGINEER
DATE	DATE
City Engr.	Alfonso J. Garcia
ACE Design	ACE Design
ACE Hydrology	ACE Hydrology
DRAWING NO.	3503
MAP NO.	
SHEET	23 OF 24

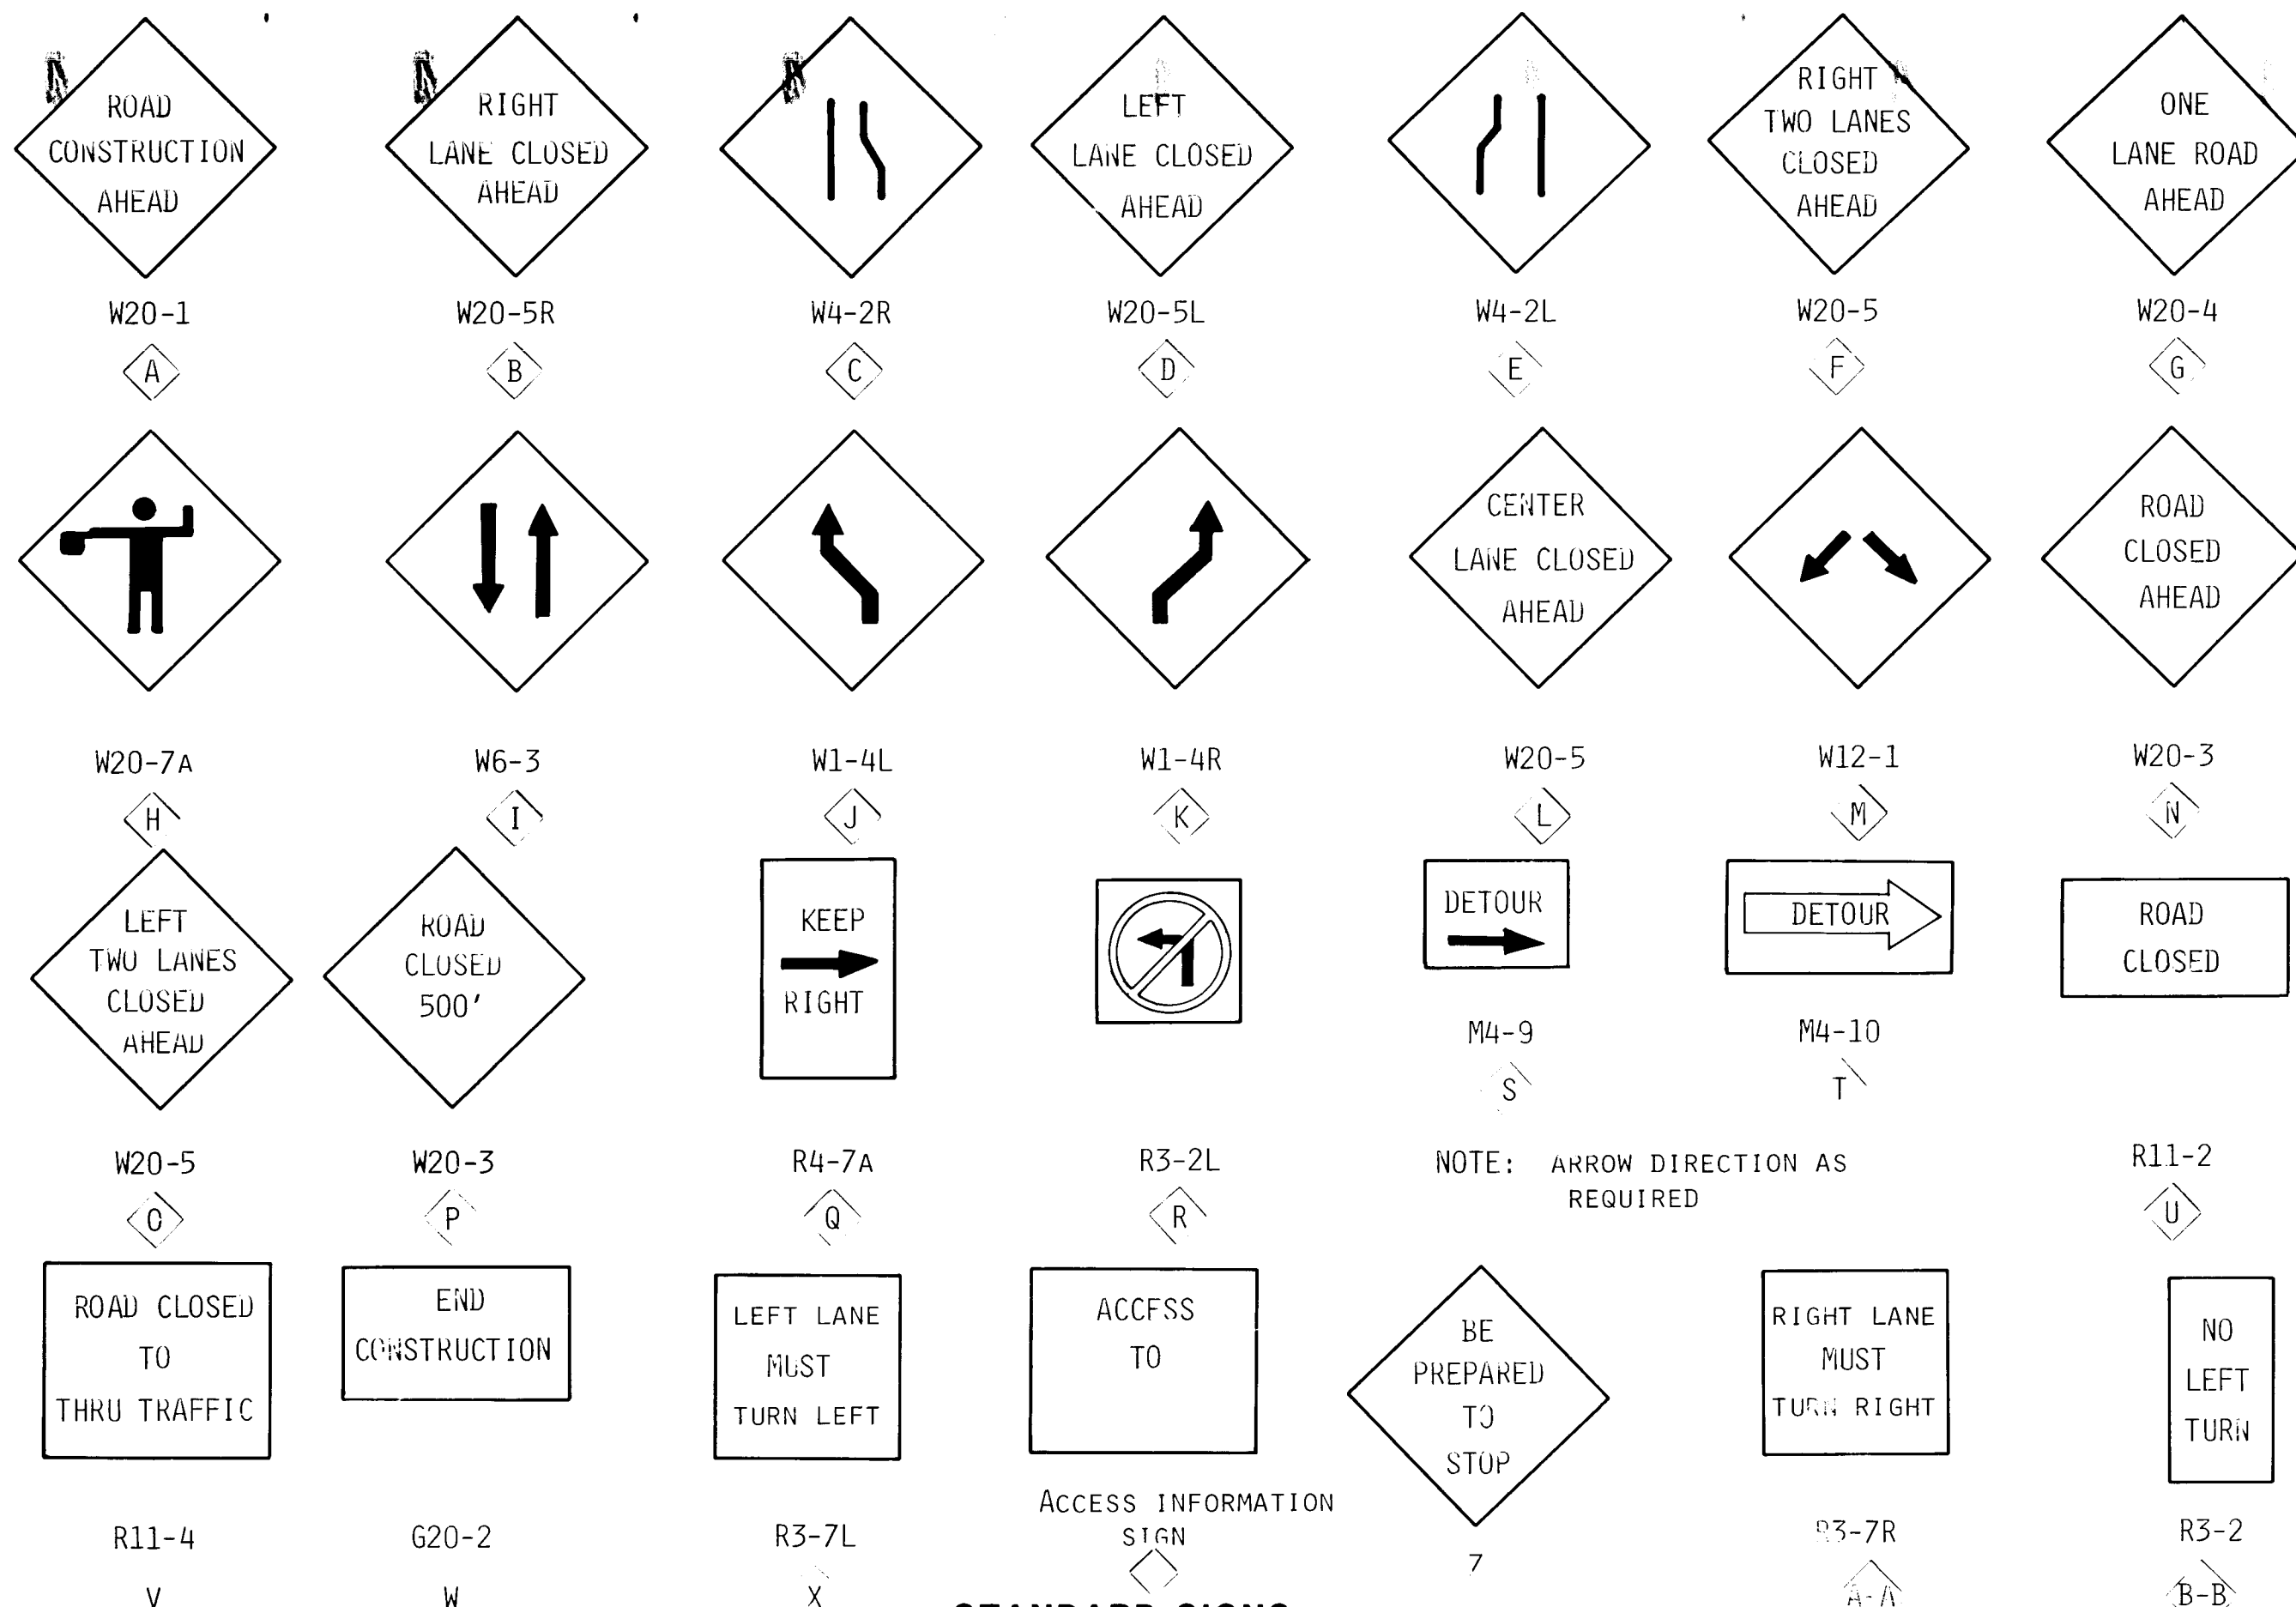

STANDARD SIGNS
NO SCALE


TAPER REQUIREMENTS					
SPEED LIMIT (MPH)	TAPER LENGTH (FEET)			MAXIMUM DISTANCE BETWEEN DEVICES (FEET)	MINIMUM NUMBER OF DEVICES REQUIRED
	10' LANE	11' LANE	12' LANE		
25	104	115	125	25	6
30	150	165	185	30	7
35	204	225	245	35	8
40	267	293	320	40	9
45	450	495	540	45	13
50	500	550	600	50	13
55	550	605	660	55	13

LEGEND

- WORK AREA
- TRAFFIC SIGN & QUANTITY (SEE THIS SHEET FOR DESIGNATION)
- BARRICADE-TYPE I, TYPE II, OR BARREL
- BARRICADE-TYPE III
- VERTICAL PANEL
- WARNING SIGN
- DISTANCE BETWEEN SIGNS-A DISTANCE MEASURED IN FEET EQUAL TO A VALUE OF TEN TIMES THE SPEED LIMIT OF THE STREET
- SPACING BETWEEN BARRICADES-A DISTANCE MEASURED IN FEET EQUAL TO THE SPEED LIMIT OF THE STREET

TAPER LENGTH-SEE CHART ABOVE

TANGENT LENGTH-IS EQUAL TO 1/2 TAPER LENGTH FOR GIVEN STREET

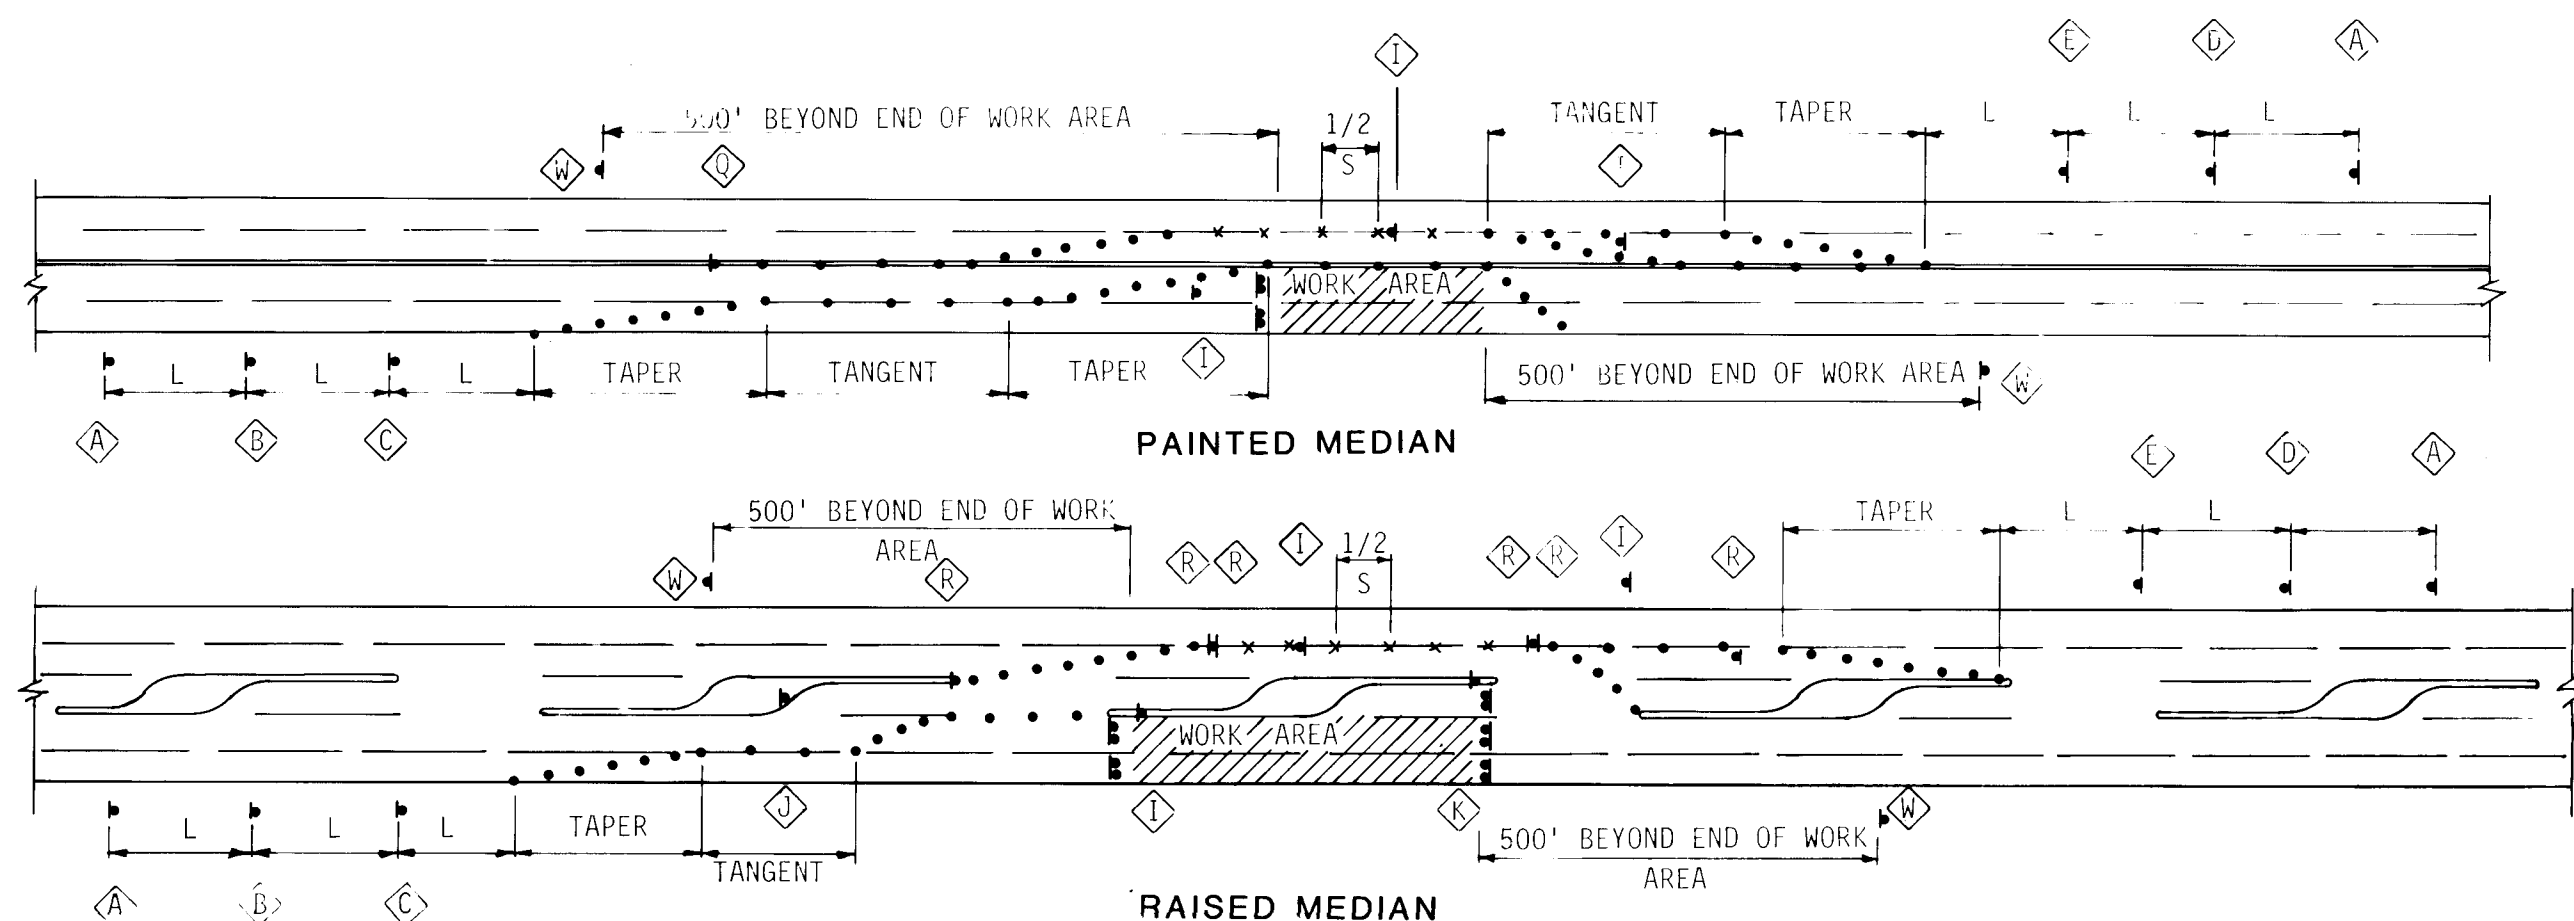

TYPICAL TRAFFIC SPLIT

NO SCALE

TYPICAL LANE CLOSURE

NO SCALE

TYPICAL QUADRANT INTERSECTION PLAN

NO SCALE

GENERAL NOTES

- CONTRACTOR SHALL ADHERE TO SECTION 19 OF THE GENERAL CONDITIONS OF THE CITY OF ALBUQUERQUE STANDARD SPECIFICATIONS FOR PUBLIC WORKS CONSTRUCTION, 1986.
- ACCESS TO EACH PRIVATE RESIDENCE OR BUSINESS AFFECTED BY THE CONSTRUCTION OF THIS PROJECT SHALL BE MAINTAINED AT ALL TIMES.
- CONTRACTOR'S HOURS OF OPERATION SHALL BE BETWEEN THE HOURS OF 8:30 AM AND 4:00 PM, SEVEN (7) DAYS A WEEK ON ALL COLLECTOR AND ARTERIAL STREETS.
- CONTRACTOR MUST MAINTAIN TWO WAY TRAFFIC ON COLLECTOR AND ARTERIAL STREETS.
- LANE CHANGES SHALL NOT BE MADE WHILE PASSING THROUGH AN INTERSECTION.
- IF A TRAFFIC SPLIT IS REQUIRED, CONTRACTOR SHALL NOTIFY A TRAFFIC ENGINEER.
- AT A SIGNALIZED INTERSECTION, ALL LEFT TURNS SHALL BE PROHIBITED. CONTRACTOR SHALL BE LIMITED TO TWO (2) WORKING DAYS IN A SIGNALIZED INTERSECTION.
- IF CONTRACTOR PLACES VEHICLE IN ROADWAY, VEHICLE WILL ONLY OCCUPY ONE LANE, BETWEEN THE HOURS OF 8:30 AM AND 4:00 PM FOR A MAXIMUM OF TWO (2) DAYS.
- CONTRACTOR SHALL NOT OCCUPY ANY NON-SIGNALIZED INTERSECTION FOR MORE THAN THREE (3) DAYS.
- AT NO TIME SHALL ANY RESIDENTIAL STREET OR COLLECTOR STREET BE CLOSED.
- ON ALL RESIDENTIAL STREETS, ONE LANE OF TRAFFIC MUST BE MAINTAINED AT ALL TIMES.

- TYPICAL TRAFFIC CONTROL PLANS SHOWN ON THIS SHEET ARE SCHEMATIC. IT IS THE CONTRACTOR'S RESPONSIBILITY TO HAVE DETAILED PLANS PREPARED FOR EACH SITE IN ACCORDANCE WITH THE FIELD CONDITIONS PRESENT AT THE PROJECT SITES & SECTION 19 OF THE SPECIFICATIONS REFERENCED ABOVE.
- ALL WORK ON CARLISLE AND PENNSYLVANIA SHALL BE ACCOMPLISHED DURING SATURDAYS AND SUNDAYS.
- CONTRACTOR SHALL COMPLY WITH SECTION SP-3 OF THE SPECIFICATIONS REGARDING CONSTRUCTION WORK AFFECTING CANDELARIA, CARLISLE, PENNSYLVANIA, CONSTITUTION, AND COMANCHE STREETS.
- CONTRACTOR SHALL CONTACT CITY BARRICADE ENGINEER @ 768-2551 TO OBTAIN A BARRICADE PERMIT PRIOR TO OCCUPYING AN INTERSECTION OR STARTING CONSTRUCTION AT A NEW SITE.

RECORD DRAWING

WARNING
This is not a record document. Record documents are based on the information provided by the user. The user cannot assume that the information provided is accurate. Users of record documents are cautioned and advised to obtain independent verification of actual conditions.

CITY OF ALBUQUERQUE PUBLIC WORKS DEPARTMENT ENGINEERING GROUP					
TITLE: FY 88-89 WATERLINE & SEWERLINE RENEWAL PROGRAM, AREA II					
TRAFFIC CONTROL PLAN					
APPROVALS	ENGINEER	DATE	APPROVALS	ENGINEER	DATE
D.R.C. Chair	Reginald	5/24/89			
Trans. Dev					
Utility Dev	REGO	5/24/89			
DRAWING NO.	3503	MAP NO.	SHEET	24	OF 24