


RIVERVIEW SANITARY SEWER OUTFALL

ALBUQUERQUE, NEW MEXICO

INDEX TO SHEETS

SHEET NO.	DESCRIPTION
-----------	-------------

1	TITLE, VICINITY MAP AND INDEX TO SHEETS
2	SURVEY CONTROL MAP
<u>SANITARY SEWER - PLAN AND PROFILE</u>	
3	STA. 22+60.80 TO STA. 34+50.00 (NIC)
4	STA. 34+50.00 TO STA. 46+00.00 (NIC)
5	STA. 46+00.00 TO STA. 57+00.00 (NIC)
6	STA. 57+00.00 TO STA. 68+00.00 (NIC STA. 57+00 TO STA. 63+17.25) (THIS CONTRACT STA. 63+17.25 TO STA. 68+00.)
7	STA. 68+00.00 TO STA. 79+00.00 (THIS CONTRACT)
8	STA. 79+00.00 TO STA. 94+00.00 (THIS CONTRACT) 81+81 END OF PROJECT

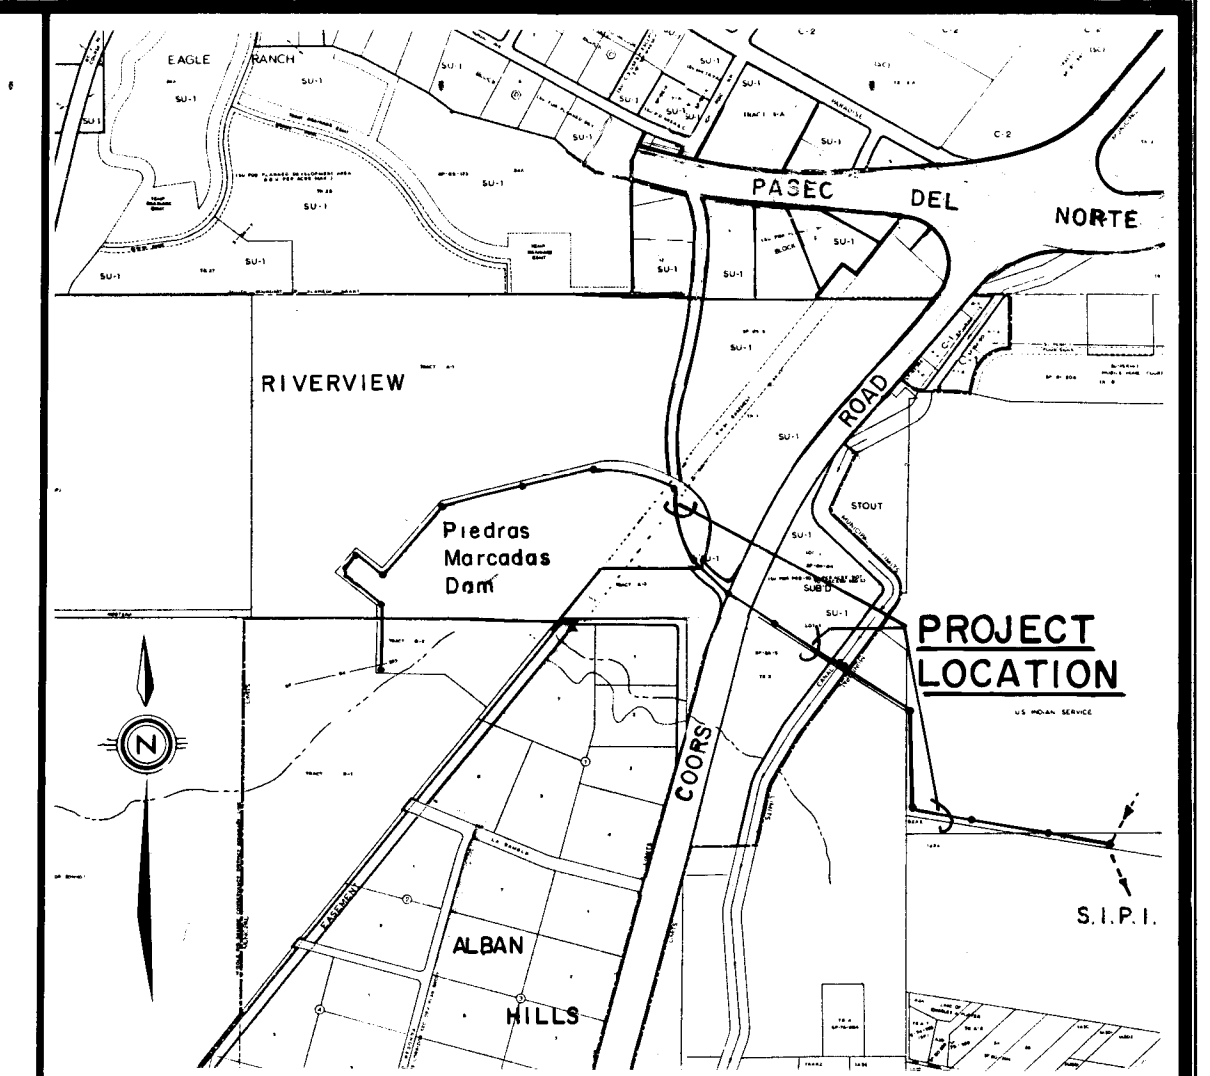

VICINITY MAP

GENERAL NOTES:


- ALL WORK DETAILED ON THESE PLANS TO BE PERFORMED UNDER CONTRACT SHALL, EXCEPT AS OTHERWISE STATED OR PROVIDED FROM HEREON, BE CONSTRUCTED IN ACCORDANCE WITH THE CITY OF ALBUQUERQUE STANDARD SPECIFICATIONS PUBLIC WORKS CONSTRUCTION, 1986.
- TWO (2) WORKING DAYS PRIOR TO ANY EXCAVATION, CONTRACTOR MUST CONTACT LINE LOCATING SERVICE, 765-1234, FOR LOCATION OF EXISTING UTILITIES.
- PRIOR TO CONSTRUCTION, THE CONTRACTOR SHALL EXCAVATE AND VERIFY THE HORIZONTAL AND VERTICAL LOCATIONS OF ALL OBSTRUCTIONS AND EXISTING PAVEMENT. SHOULD A CONFLICT EXIST, THE CONTRACTOR SHALL NOTIFY THE ENGINEER OR SURVEYOR SO THAT THE CONFLICT CAN BE RESOLVED WITH MINIMUM AMOUNT OF DELAY.
- THE CONTRACTOR SHALL FURNISH ENDS ON ALL WATER AND SEWER SERVICE STUBS, CAPS AND PLUGS.
- ALL PIPE SHALL BE FURNISHED WITH CLASS III BEDDING UNLESS OTHERWISE NOTED.
- ALL TRENCH BACKFILL SHALL BE COMPACTED TO A MINIMUM OF 95% OF OPTIMUM (MODIFIED).
- SEWER PIPE SHALL BE P.V.C. CLASS SDR35, EXCEPT AS OTHERWISE NOTED.
- ALL MANHOLES SHALL BE 4 FOOT DIA. TYPE "E" PER STD. DWGS. 2102 AND 2118 UNLESS OTHERWISE NOTED.

APPROVAL OF AS BUILT DRAWINGS CHIEF CONSTRUCTION ENGINEER <i>Michael J. Yost</i> DATE <u>9-13-89</u>

1	2	3	4	5	6	7	8	9	10	11	12
2	6	3	5	4	4	0	1	8	9		


REV.	SHEETS	CITY ENGINEER	DATE	USER	DEPARTMENT	DATE	USER	DEPARTMENT	DATE
APPROVAL OF REVISIONS									

ENGINEER'S SEAL MICHAEL J. YOST NEW MEXICO 9665 7/5/88	DATE: MAR., 1988 SCALE: N. A. DESIGNED: R. H. D. DRAWN: W. J. W. JOB NO: 73-38-056 PROJECT NO. 3544	APPROVED FOR CONSTRUCTION <i>Michael J. Yost</i> CITY ENGINEER 1-24-89 DATE SHEET 1 OF 8
--	--	---

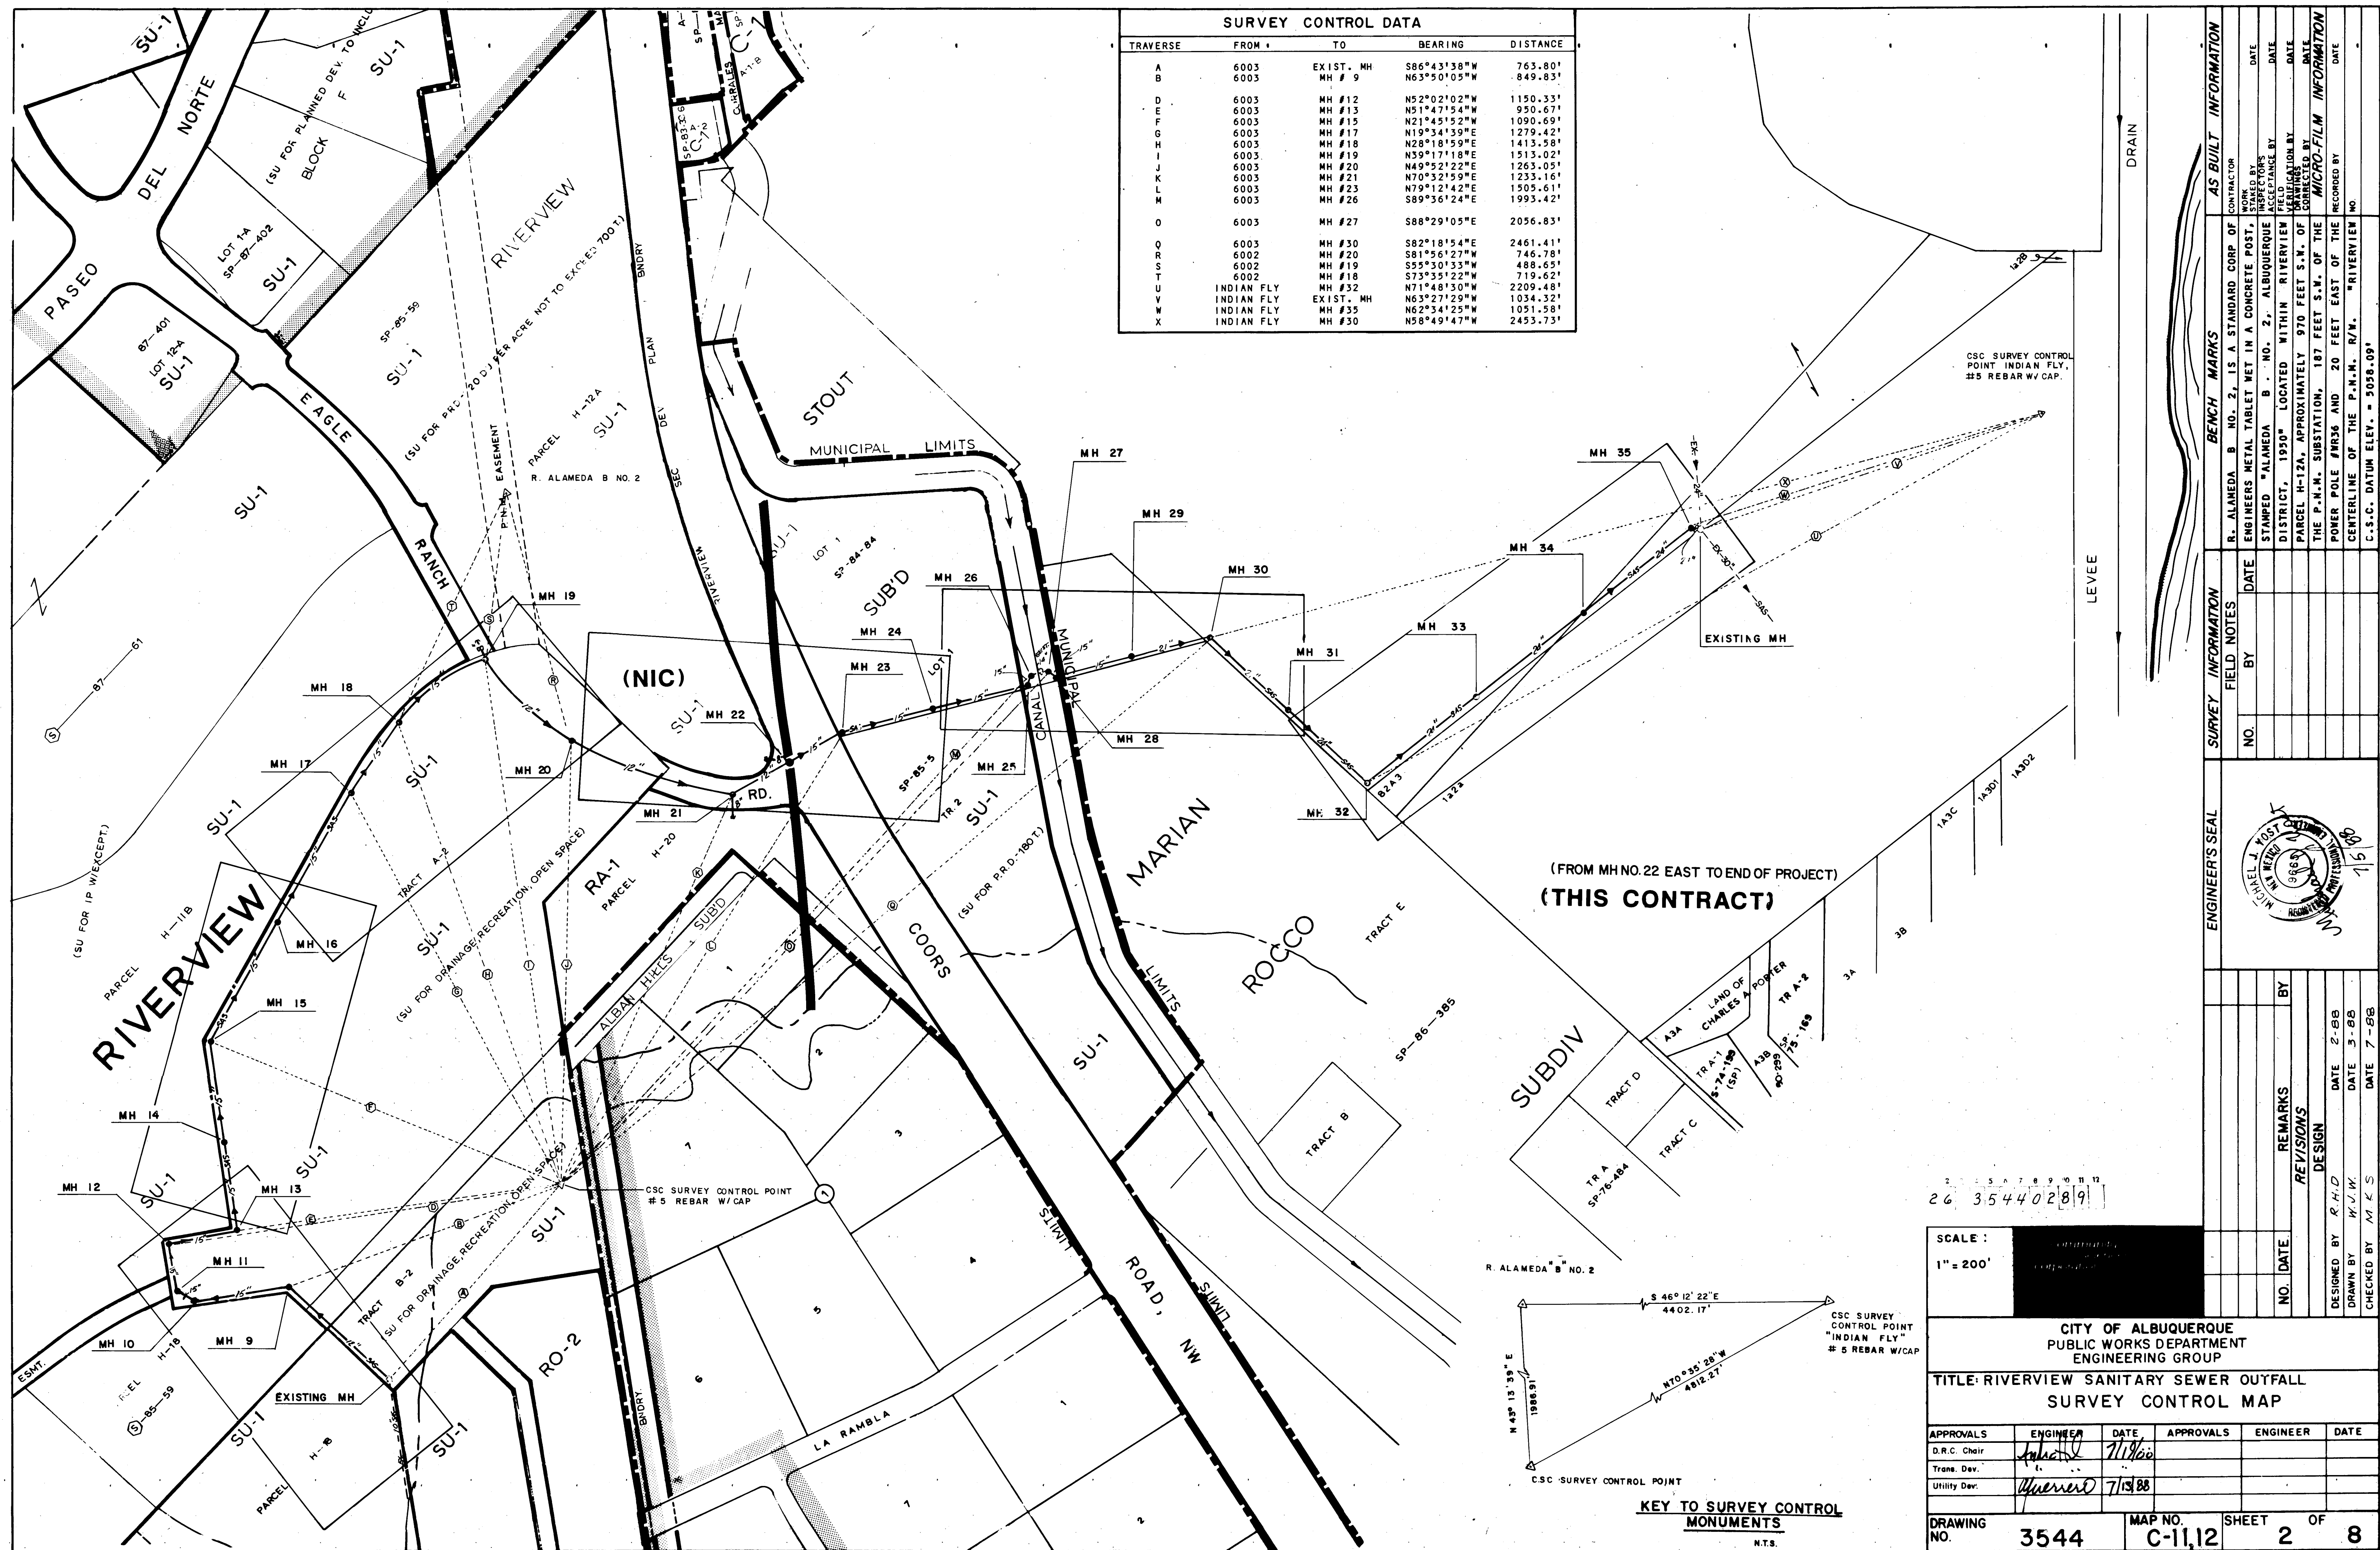




89-1

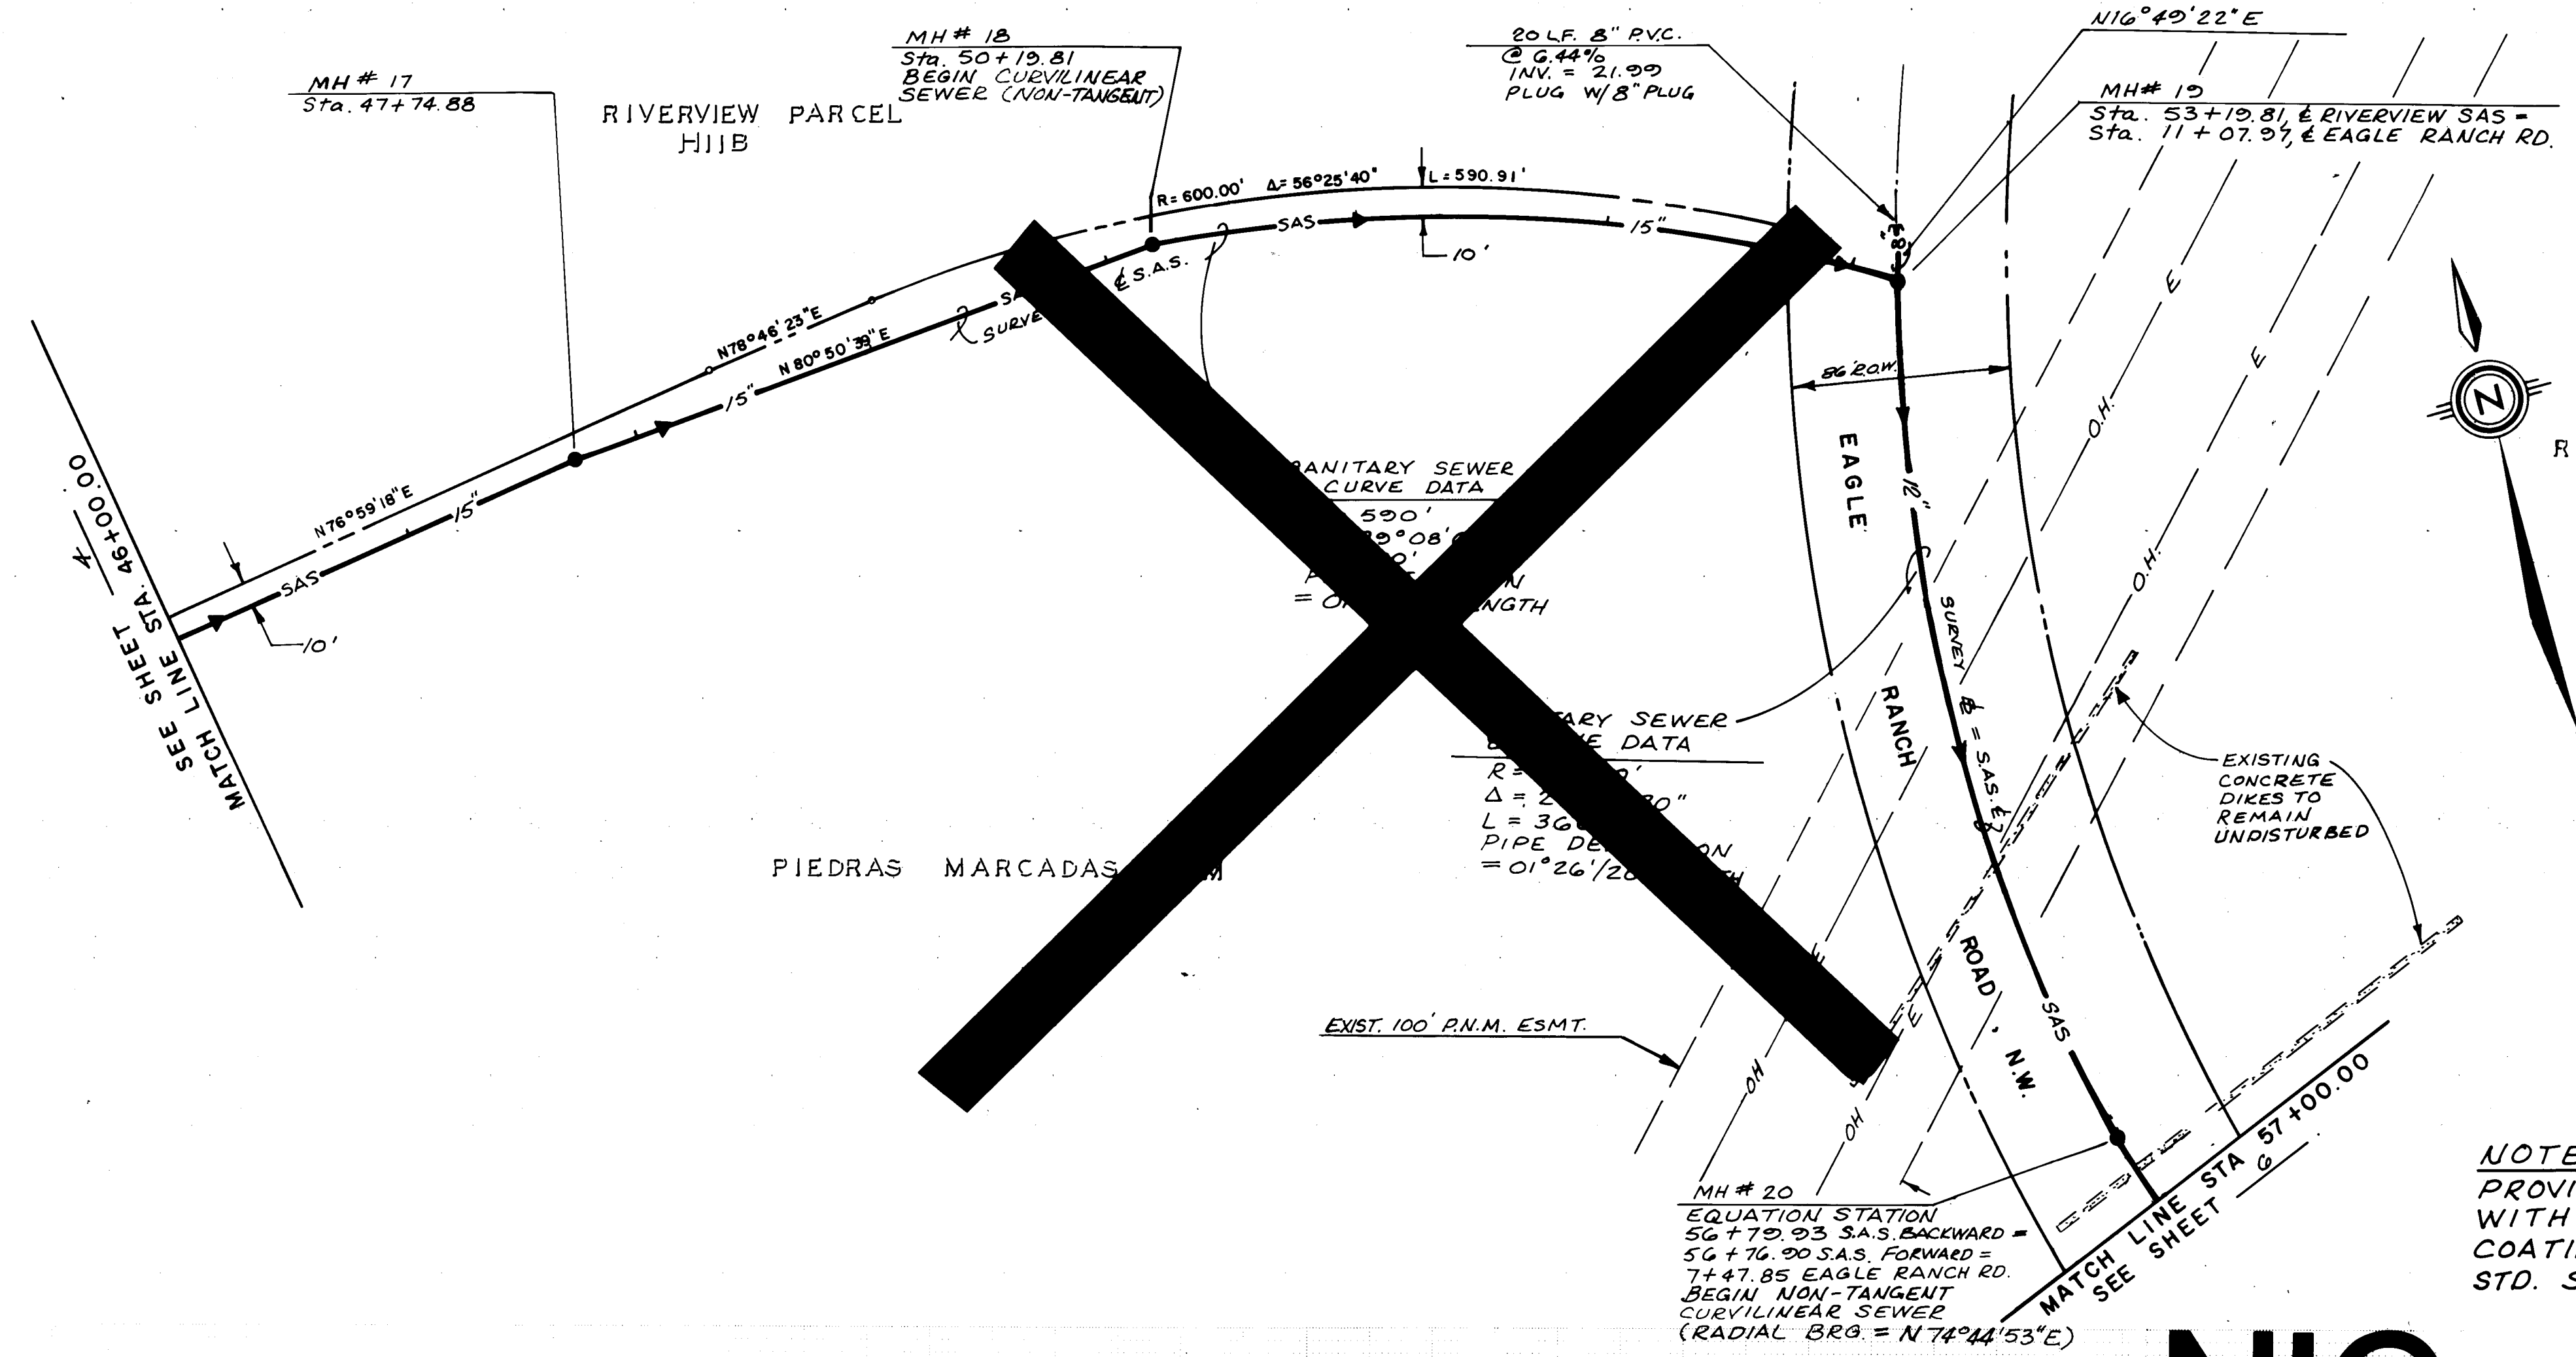

NOTE:
PROVIDE MH 19
WITH EPOXY-RESIN INTERIOR
COATING PER CITY OF ALBUQUERQUE
STD. SPEC. 920.4.6.2

NIC

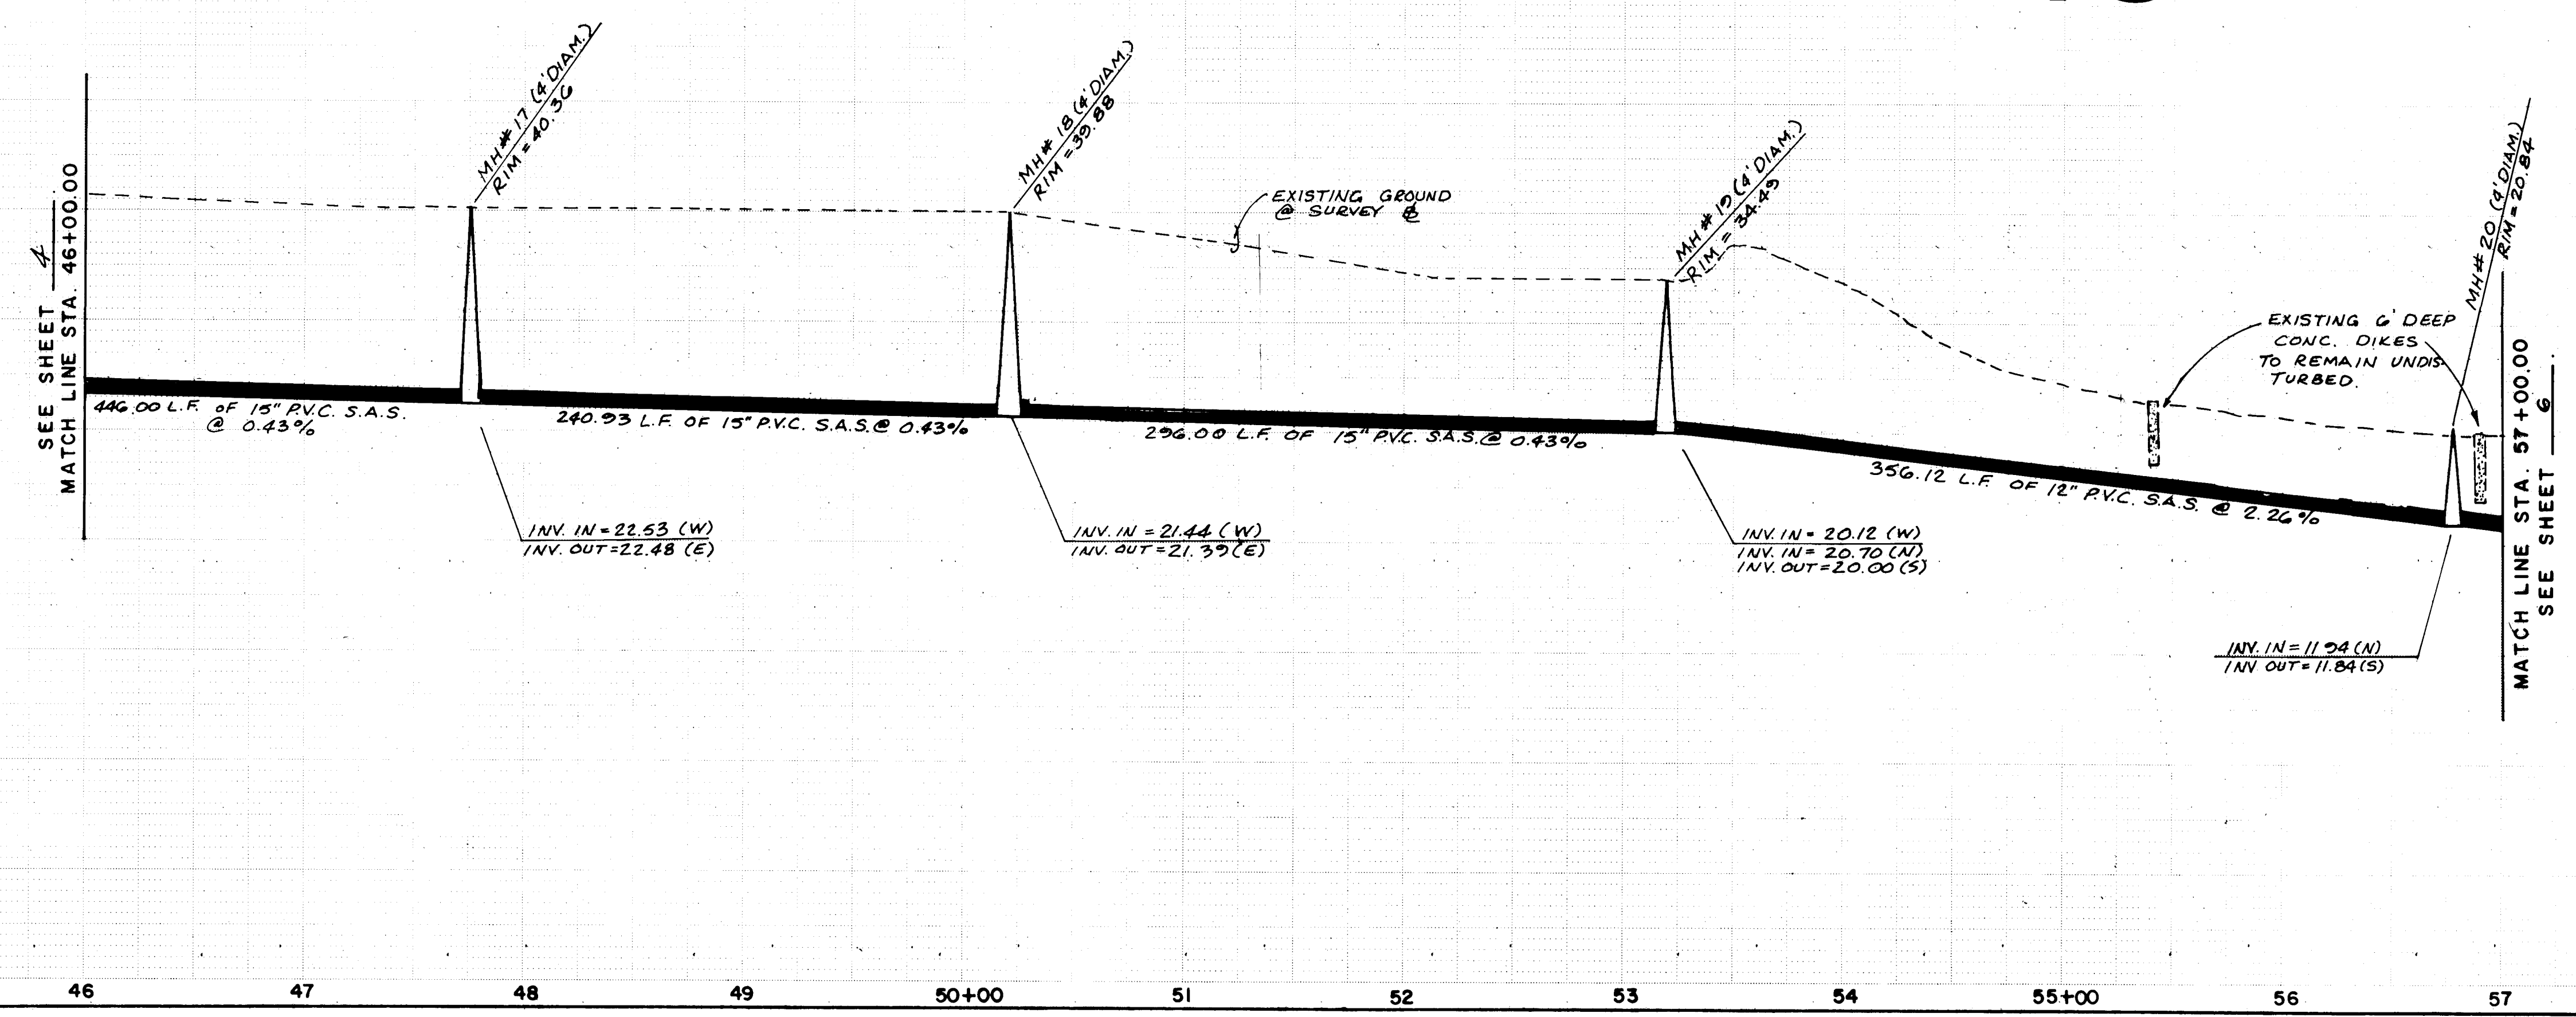

--	--	

SCALE:
1" = 50' HOR.
1" = 10' VER.

CITY OF ALBUQUERQUE
PUBLIC WORKS DEPARTMENT
ENGINEERING GROUP

TITLE: RIVERVIEW SANITARY SEWER OUTFALL
STA. 46+00.00 TO STA. 57+00.00

APPROVALS	ENGINEER	DATE	APPROVALS	ENGINEER	DATE
D.R.C. Chair		7/13/88			
Trans. Dev					
Utility Dev		7/13/88			


DRAWING NO. 3544 MAP NO. C-12.13 SHEET 5 OF 8

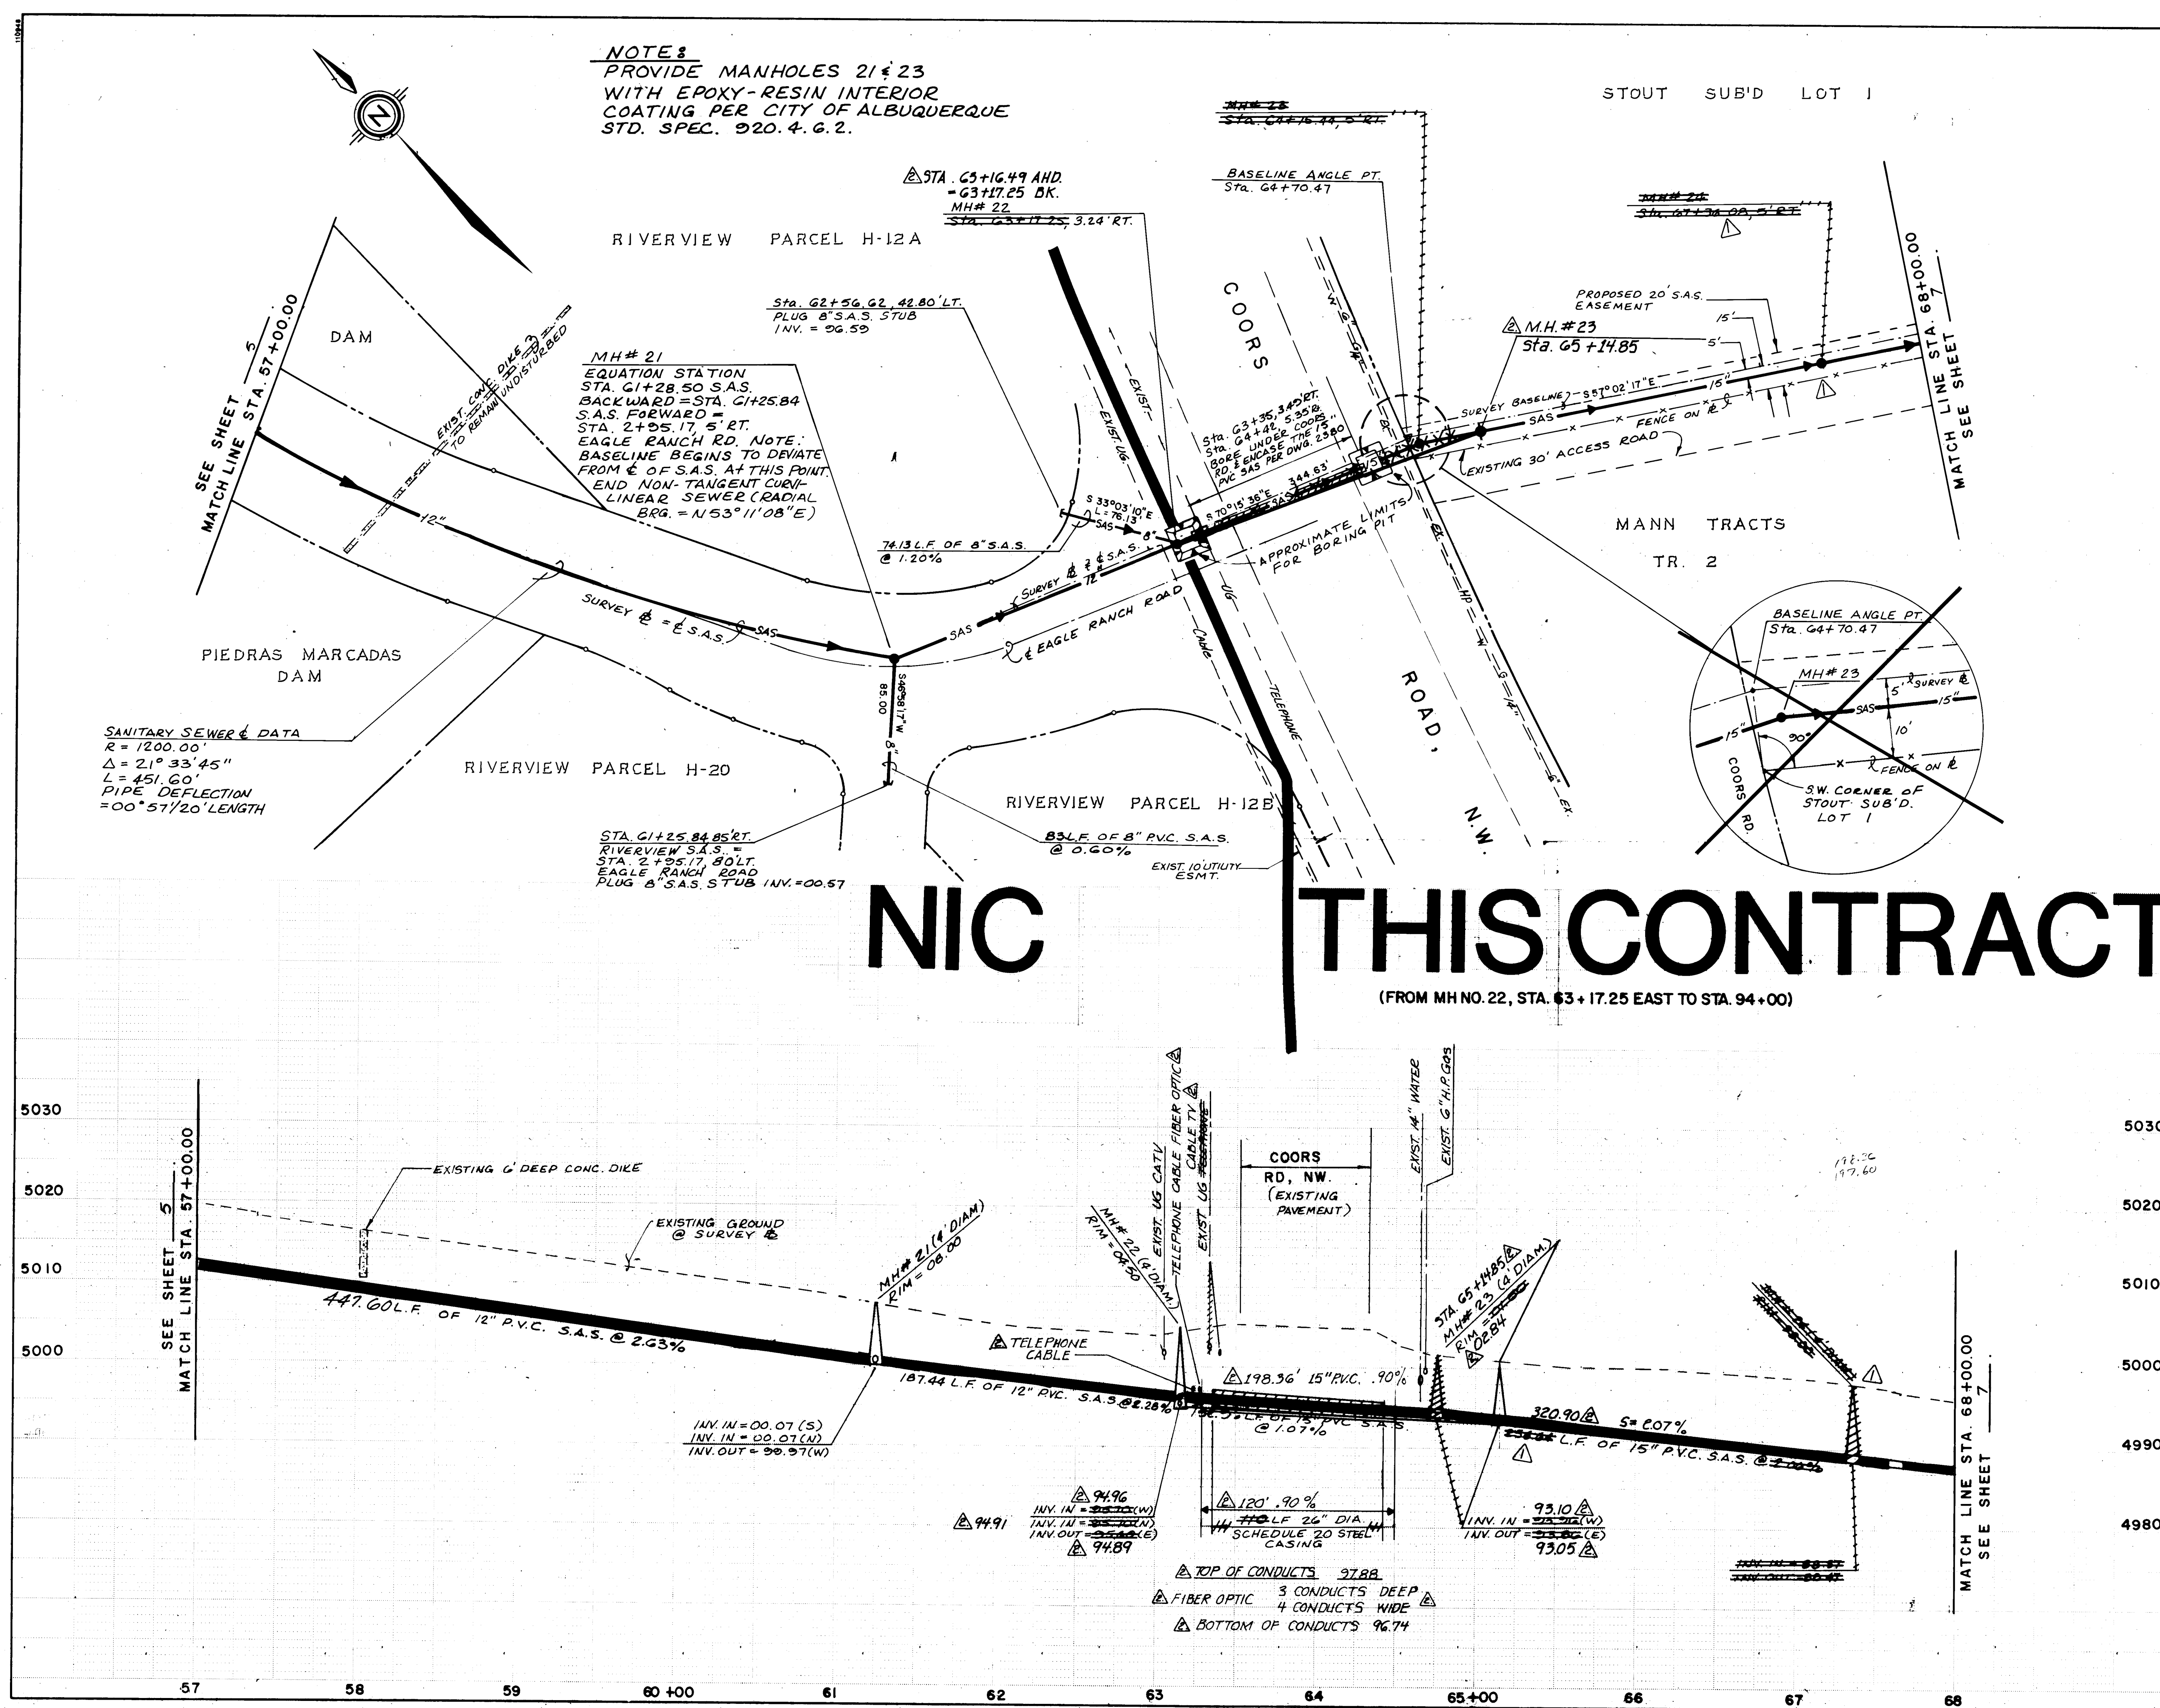

NIC THIS CONTRACT


(FROM MH NO. 22, STA. 63+17.25 EAST TO STA. 94+00)

ENGINEER'S SEAL			SURVEY INFORMATION			BENCH MARKS			AS BUILT INFORMATION		
MICHAEL J. TOBY REGISTERED PROFESSIONAL ENGINEER No. 117189 7/15/88			FIELD NOTES			R. ALAMEDA B. NO. 2, IS A STANDARD CORP. OF ENGINEERS METAL TABLE NET IN A CONCRETE POST, STAMPED "ALAMEDA B. NO. 2, ALBUQUERQUE DISTRICT, 1950" LOCATED WITHIN RIVERVIEW PARCEL H-12A, APPROXIMATELY 970 FEET S.W. OF THE P.N.H. SUBSTATION, 187 FEET EAST OF THE POWER POLE #NR36 AND 20 FEET EAST OF THE CENTERLINE OF THE P.N.H. R/W. "RIVERVIEW" - S.S.C. DATUM ELEV. = 5058.00'			CONTRACTOR SURNAME MECH. DATE		
REVISIONS			NO. DATE			DATE			DATE		
1. CHANGED LOCATION OF MH #24 (24\"/>			1. 7/15/88			7/15/88			7/15/88		
DESIGN			BY			DATE			DATE		
DESIGNED BY R.H.D.			DATE 2-88			DATE 2-88			DATE 2-88		
DRAWN BY W.J.W.			DATE 3-88			DATE 3-88			DATE 3-88		
CHECKED BY M.K.S.			DATE 7-88			DATE 7-88			DATE 7-88		
CITY OF ALBUQUERQUE PUBLIC WORKS DEPARTMENT ENGINEERING GROUP											
TITLE: RIVERVIEW SANITARY SEWER OUTFALL STA. 57+00.00 TO STA. 68+00.00											
APPROVALS			ENGINEER			DATE			APPROVALS		
D.R.C. Chair			7/13/88			7/13/88			7/13/88		
Trans. Dev			7/13/88			7/13/88			7/13/88		
Utility Dev			7/13/88			7/13/88			7/13/88		
DRAWING NO. 3544			MAP NO. C-13			SHEET 6			OF 8		

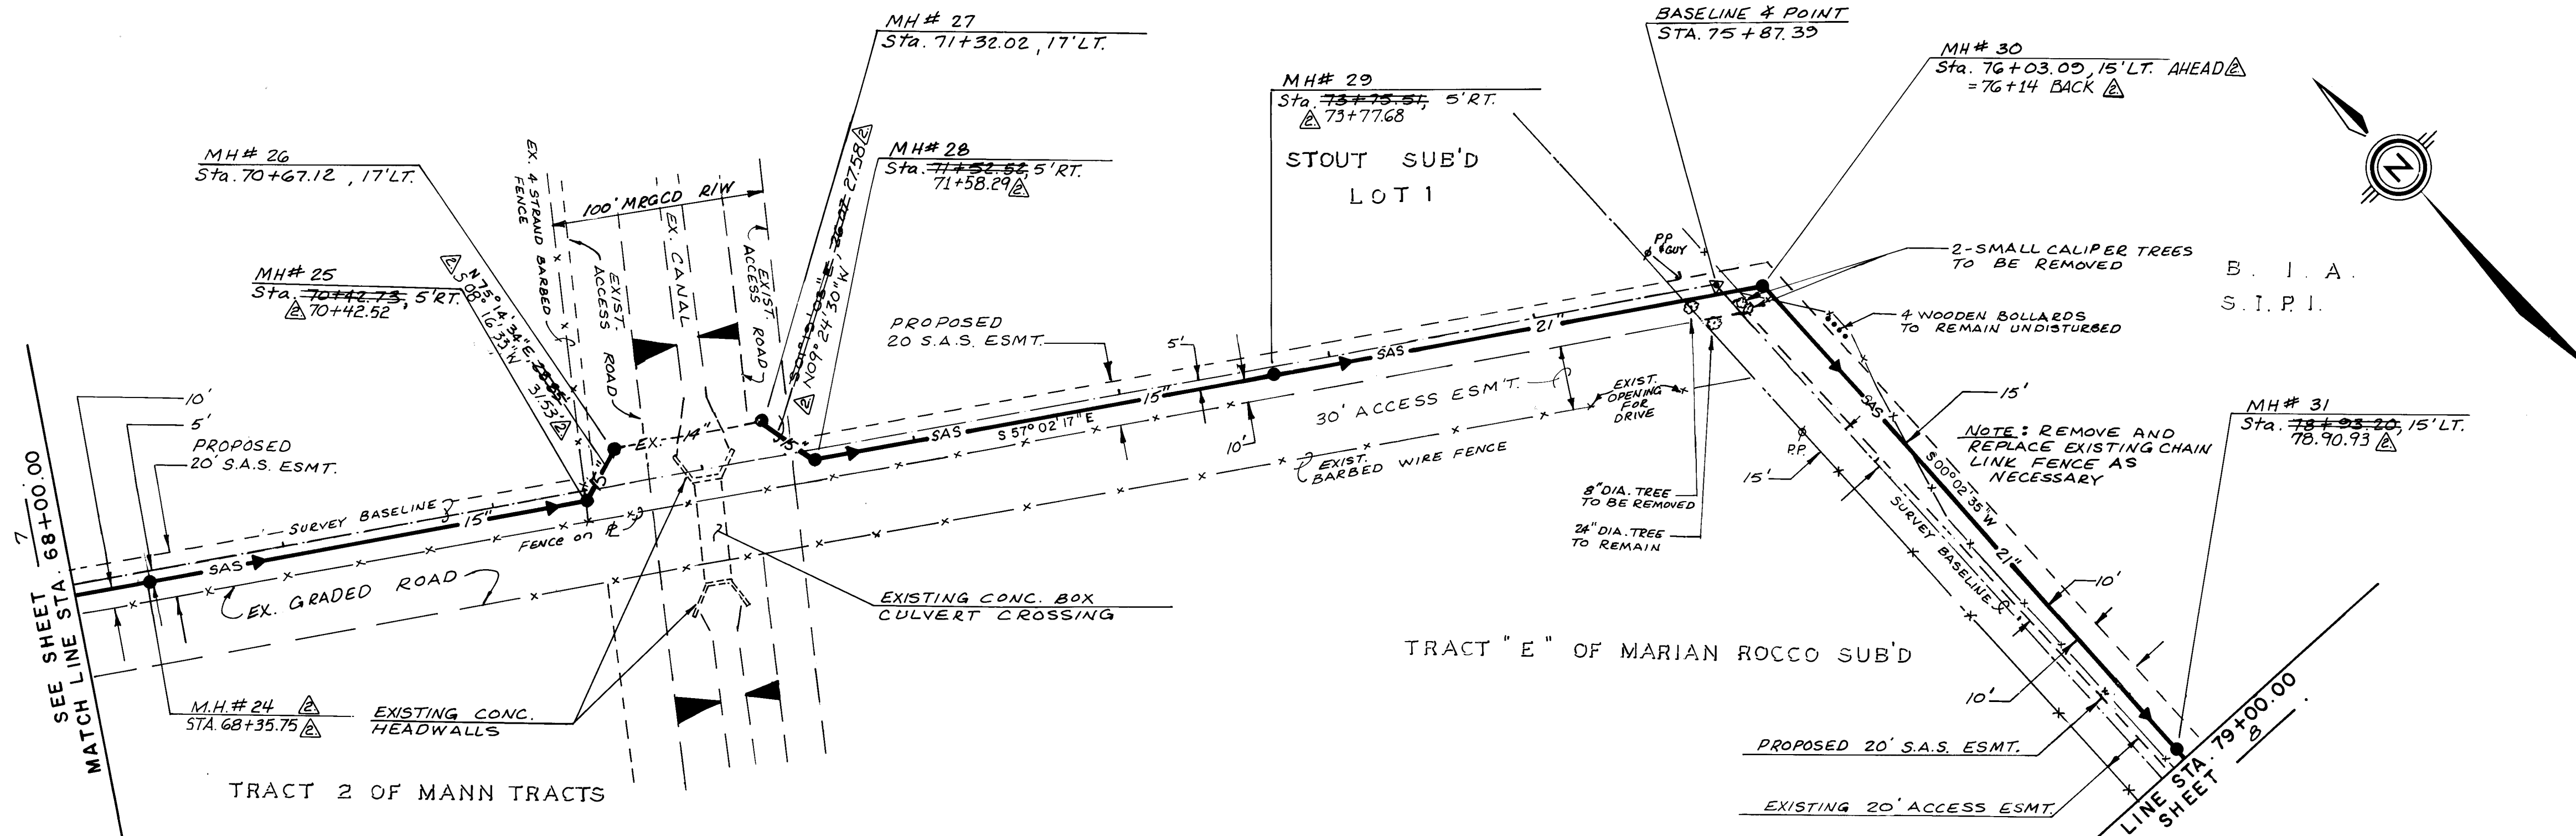

NOTE:
PROVIDE MANHOLES 25, 26, 27, 28 & 30
WITH EPOXY-RESIN INTERIOR
COATING PER CITY OF ALBUQUERQUE
STD. SPEC. 920.4.G.2.

THIS CONTRACT

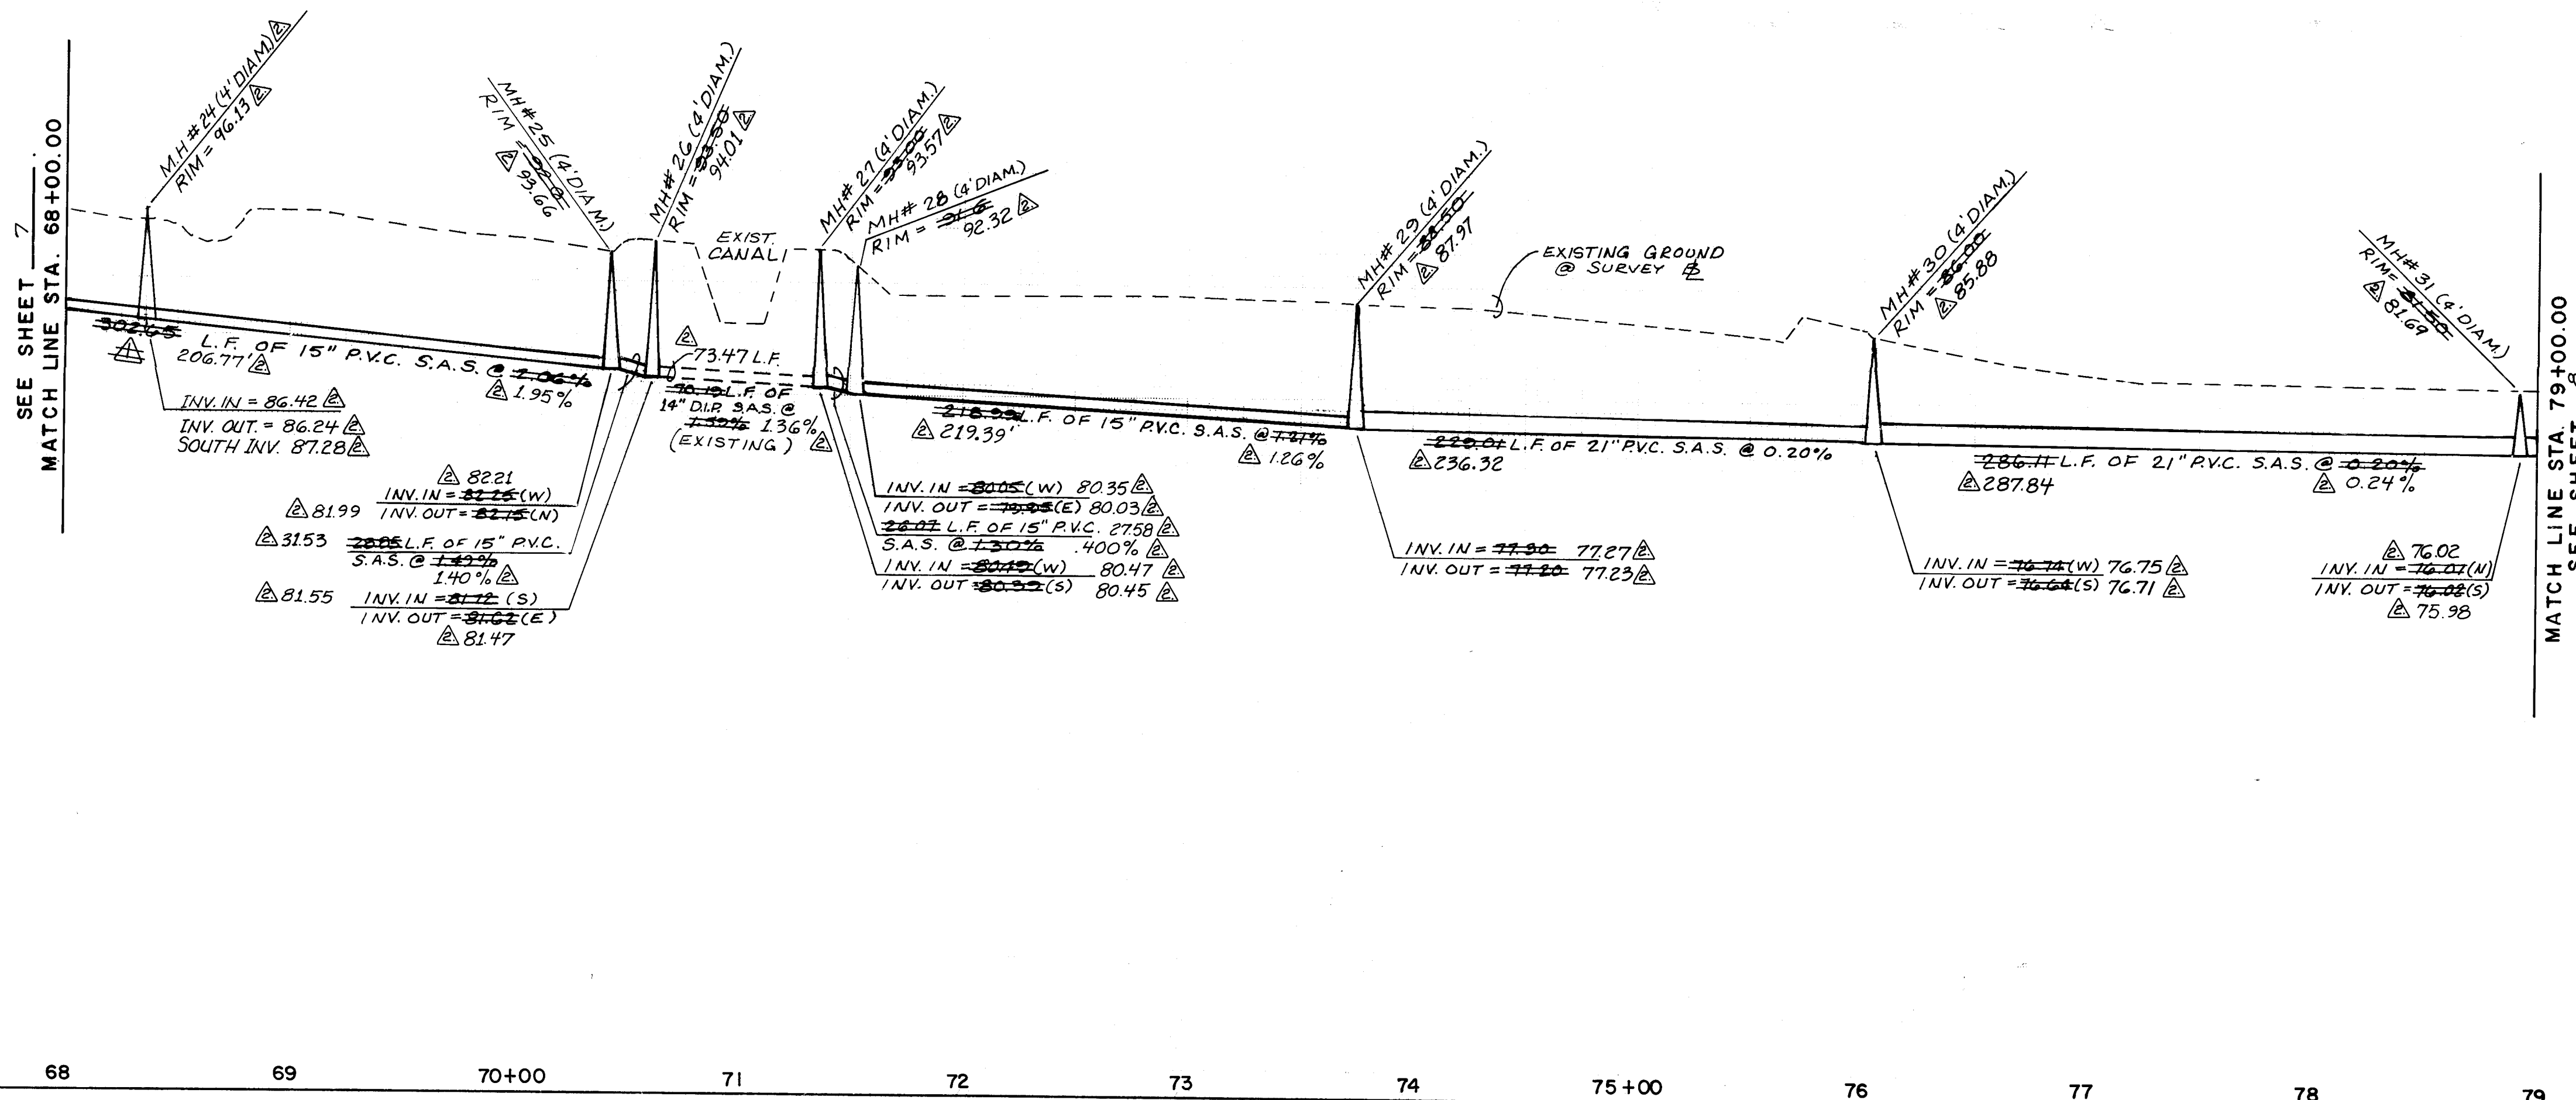


SCALE:
1" = 50' HOR.
1" = 10' VER.

CITY OF ALBUQUERQUE
PUBLIC WORKS DEPARTMENT
ENGINEERING GROUP
TITLE RIVERVIEW SANITARY SEWER OUTFALL
STA. 68+00.00 TO STA. 79+00.00

APPROVALS	ENGINEER	DATE	APPROVALS	ENGINEER	DATE
D.R.C. Chair		7/13/88			
Trans. Dev.					
Utility Dev.		7/13/88			

DRAWING NO. 3544 MAP NO. D-13 SHEET 7 OF 8

AS BUILT INFORMATION		BENCH MARKS		SURVEY INFORMATION		ENGINEER'S SEAL	
R. ALAMEDA B. NO. 2, IS A STANDARD CORP. OF ENGINEERS METAL TABLE SET IN A CONCRETE POST, STAMPED "ALAMEDA B. NO. 2, ALBUQUERQUE DISTRICT, 1950" LOCATED WITHIN RIVERVIEW PARCEL H-12A, APPROXIMATELY 970 FEET S.W. OF THE P.N.M. SUBSTATION, 187 FEET S.W. OF THE POWER POLE #MR36 AND 20 FEET EAST OF THE CENTERLINE OF THE P.N.M. R/W. "RIVERVIEW C.S.C. DATUM ELEV. = 5038.09"	DATE	DATE	DATE	DATE	DATE	DATE	DATE
DATE 7/17/88	DATE 7/17/88	DATE 7/17/88	DATE 7/17/88	DATE 7/17/88	DATE 7/17/88	DATE 7/17/88	DATE 7/17/88

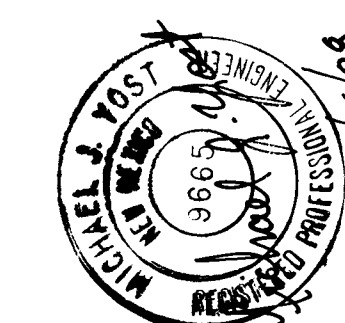

REVISIONS	DESIGN	DATE	DATE	DATE
1	DESIGNED BY R.H.D.	2-88		
2	DRAWN BY W.J.W.	3-88		
3	CHECKED BY M.K.S.	7-88		

