


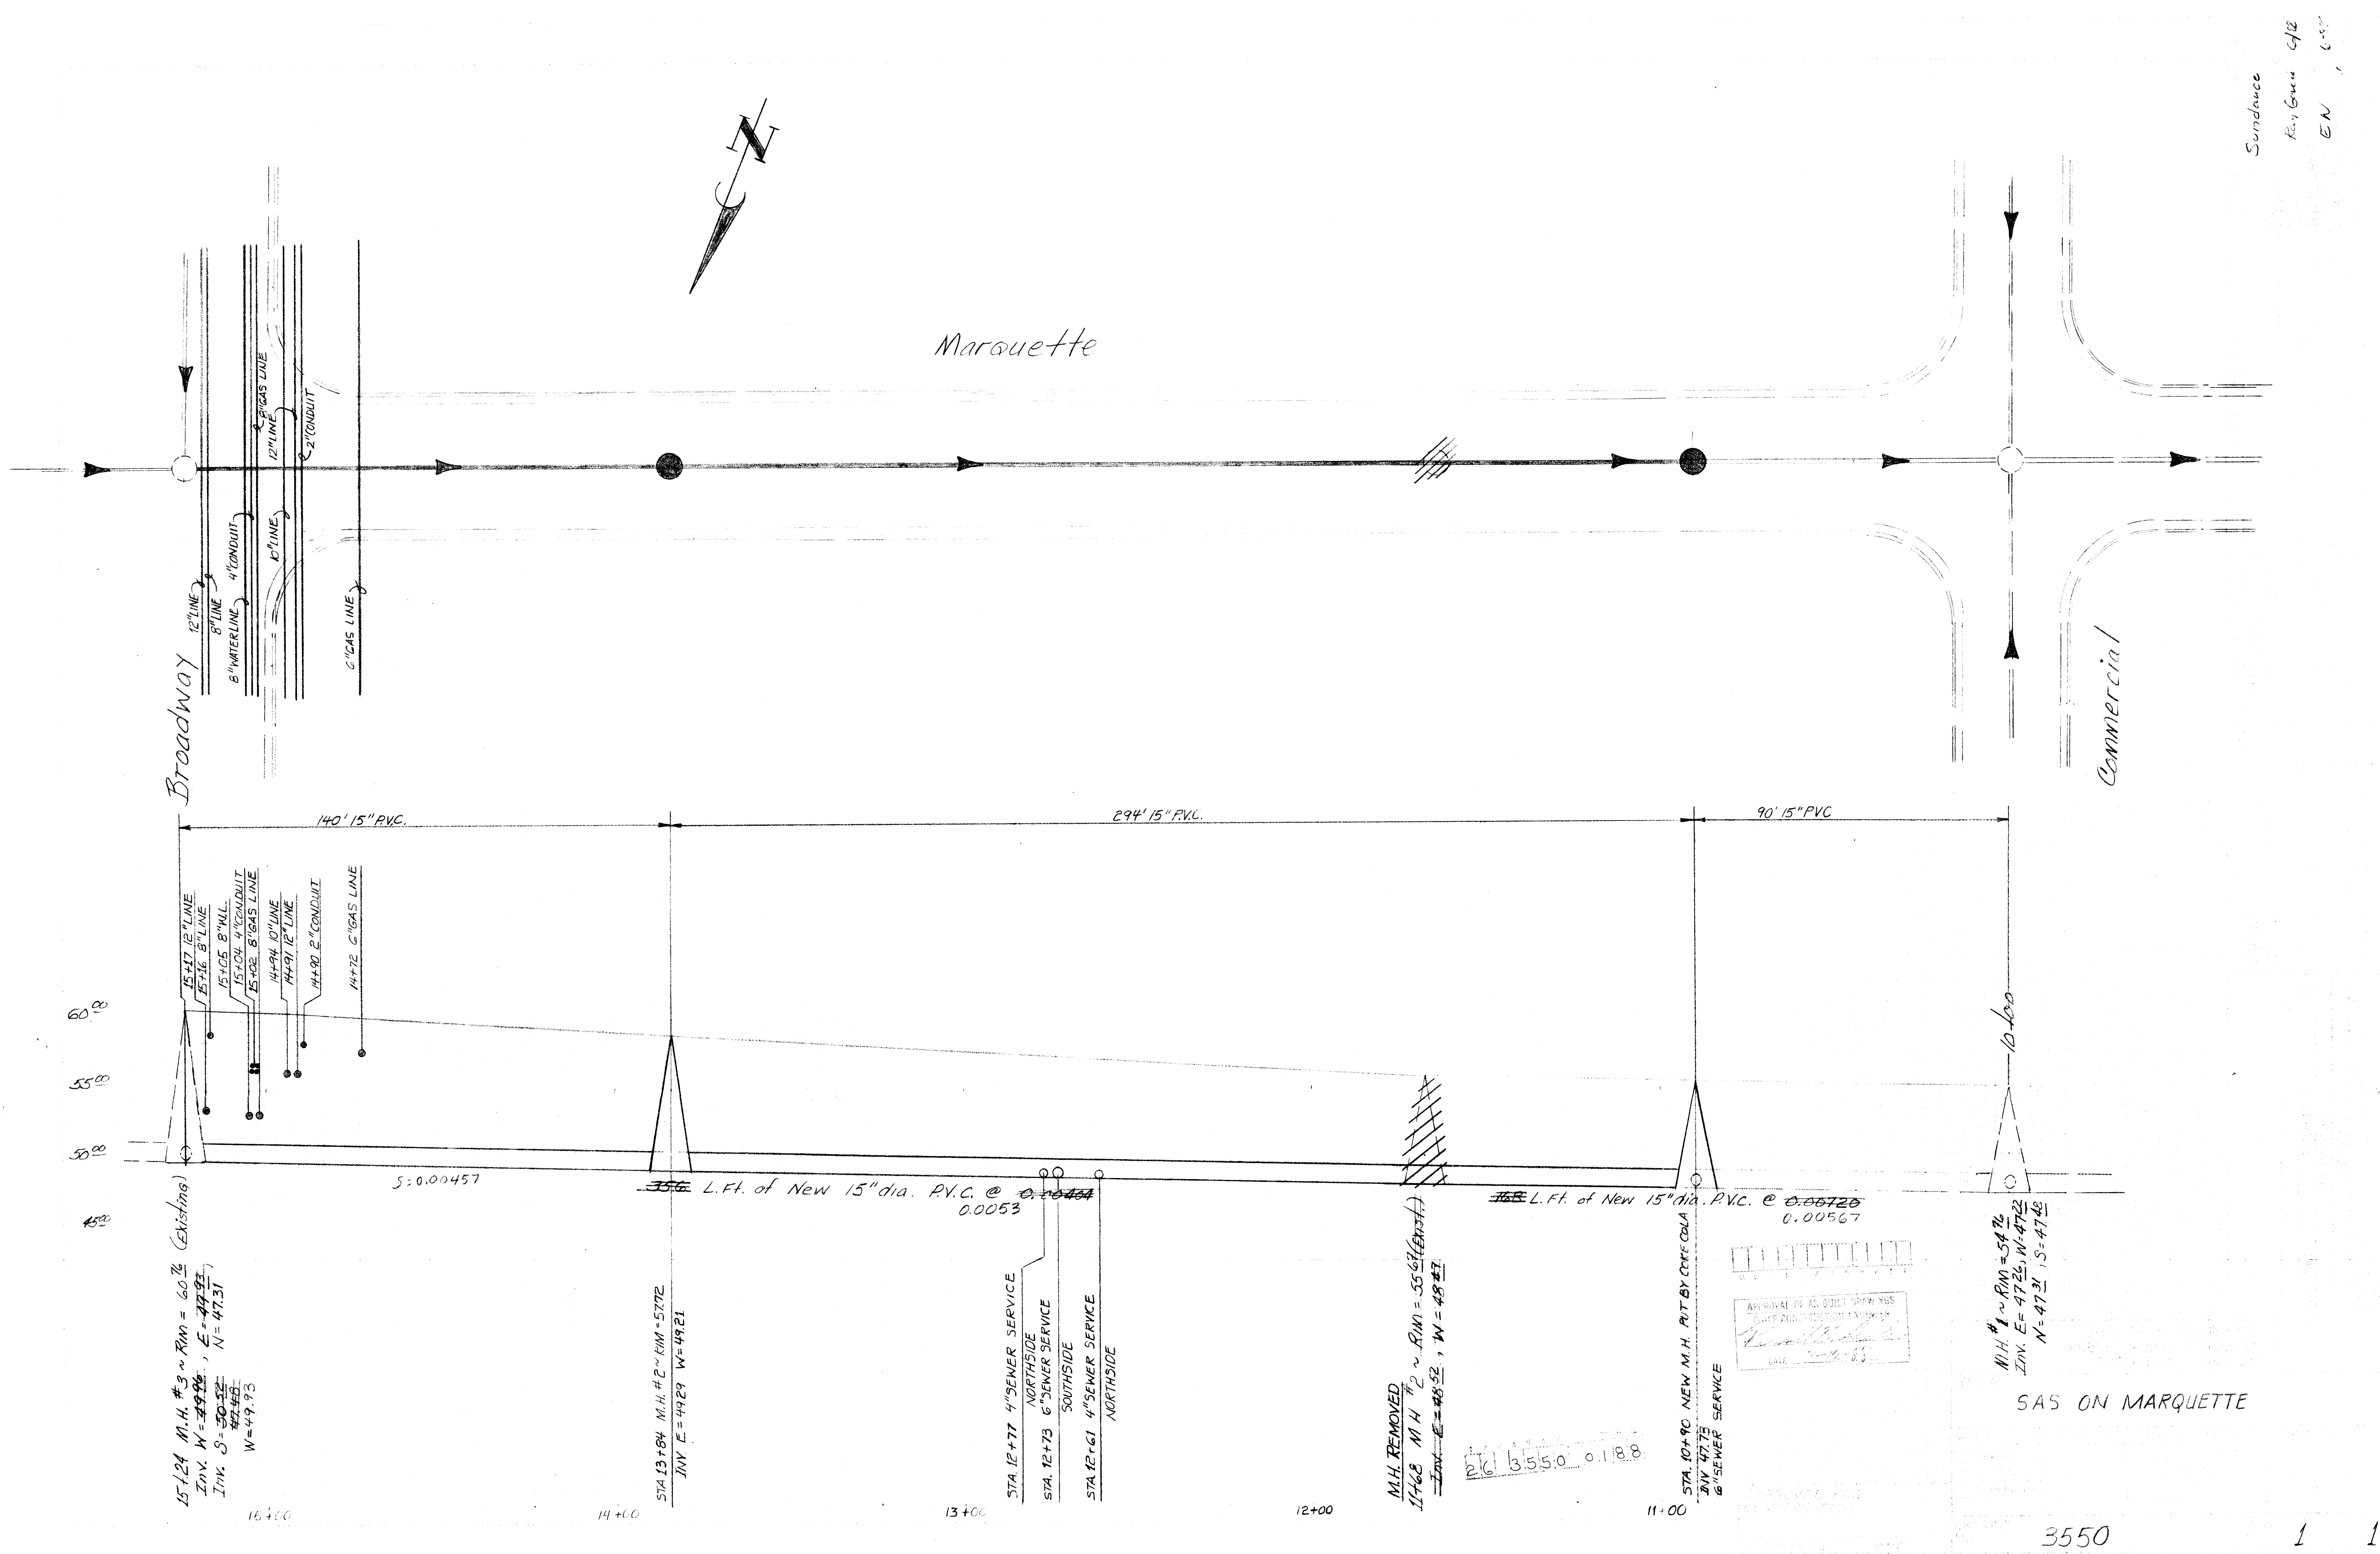

Sundance
Riv. Gr. 4/12
EN 6-50

SAS ON MARQUETTE

3550

1 1