


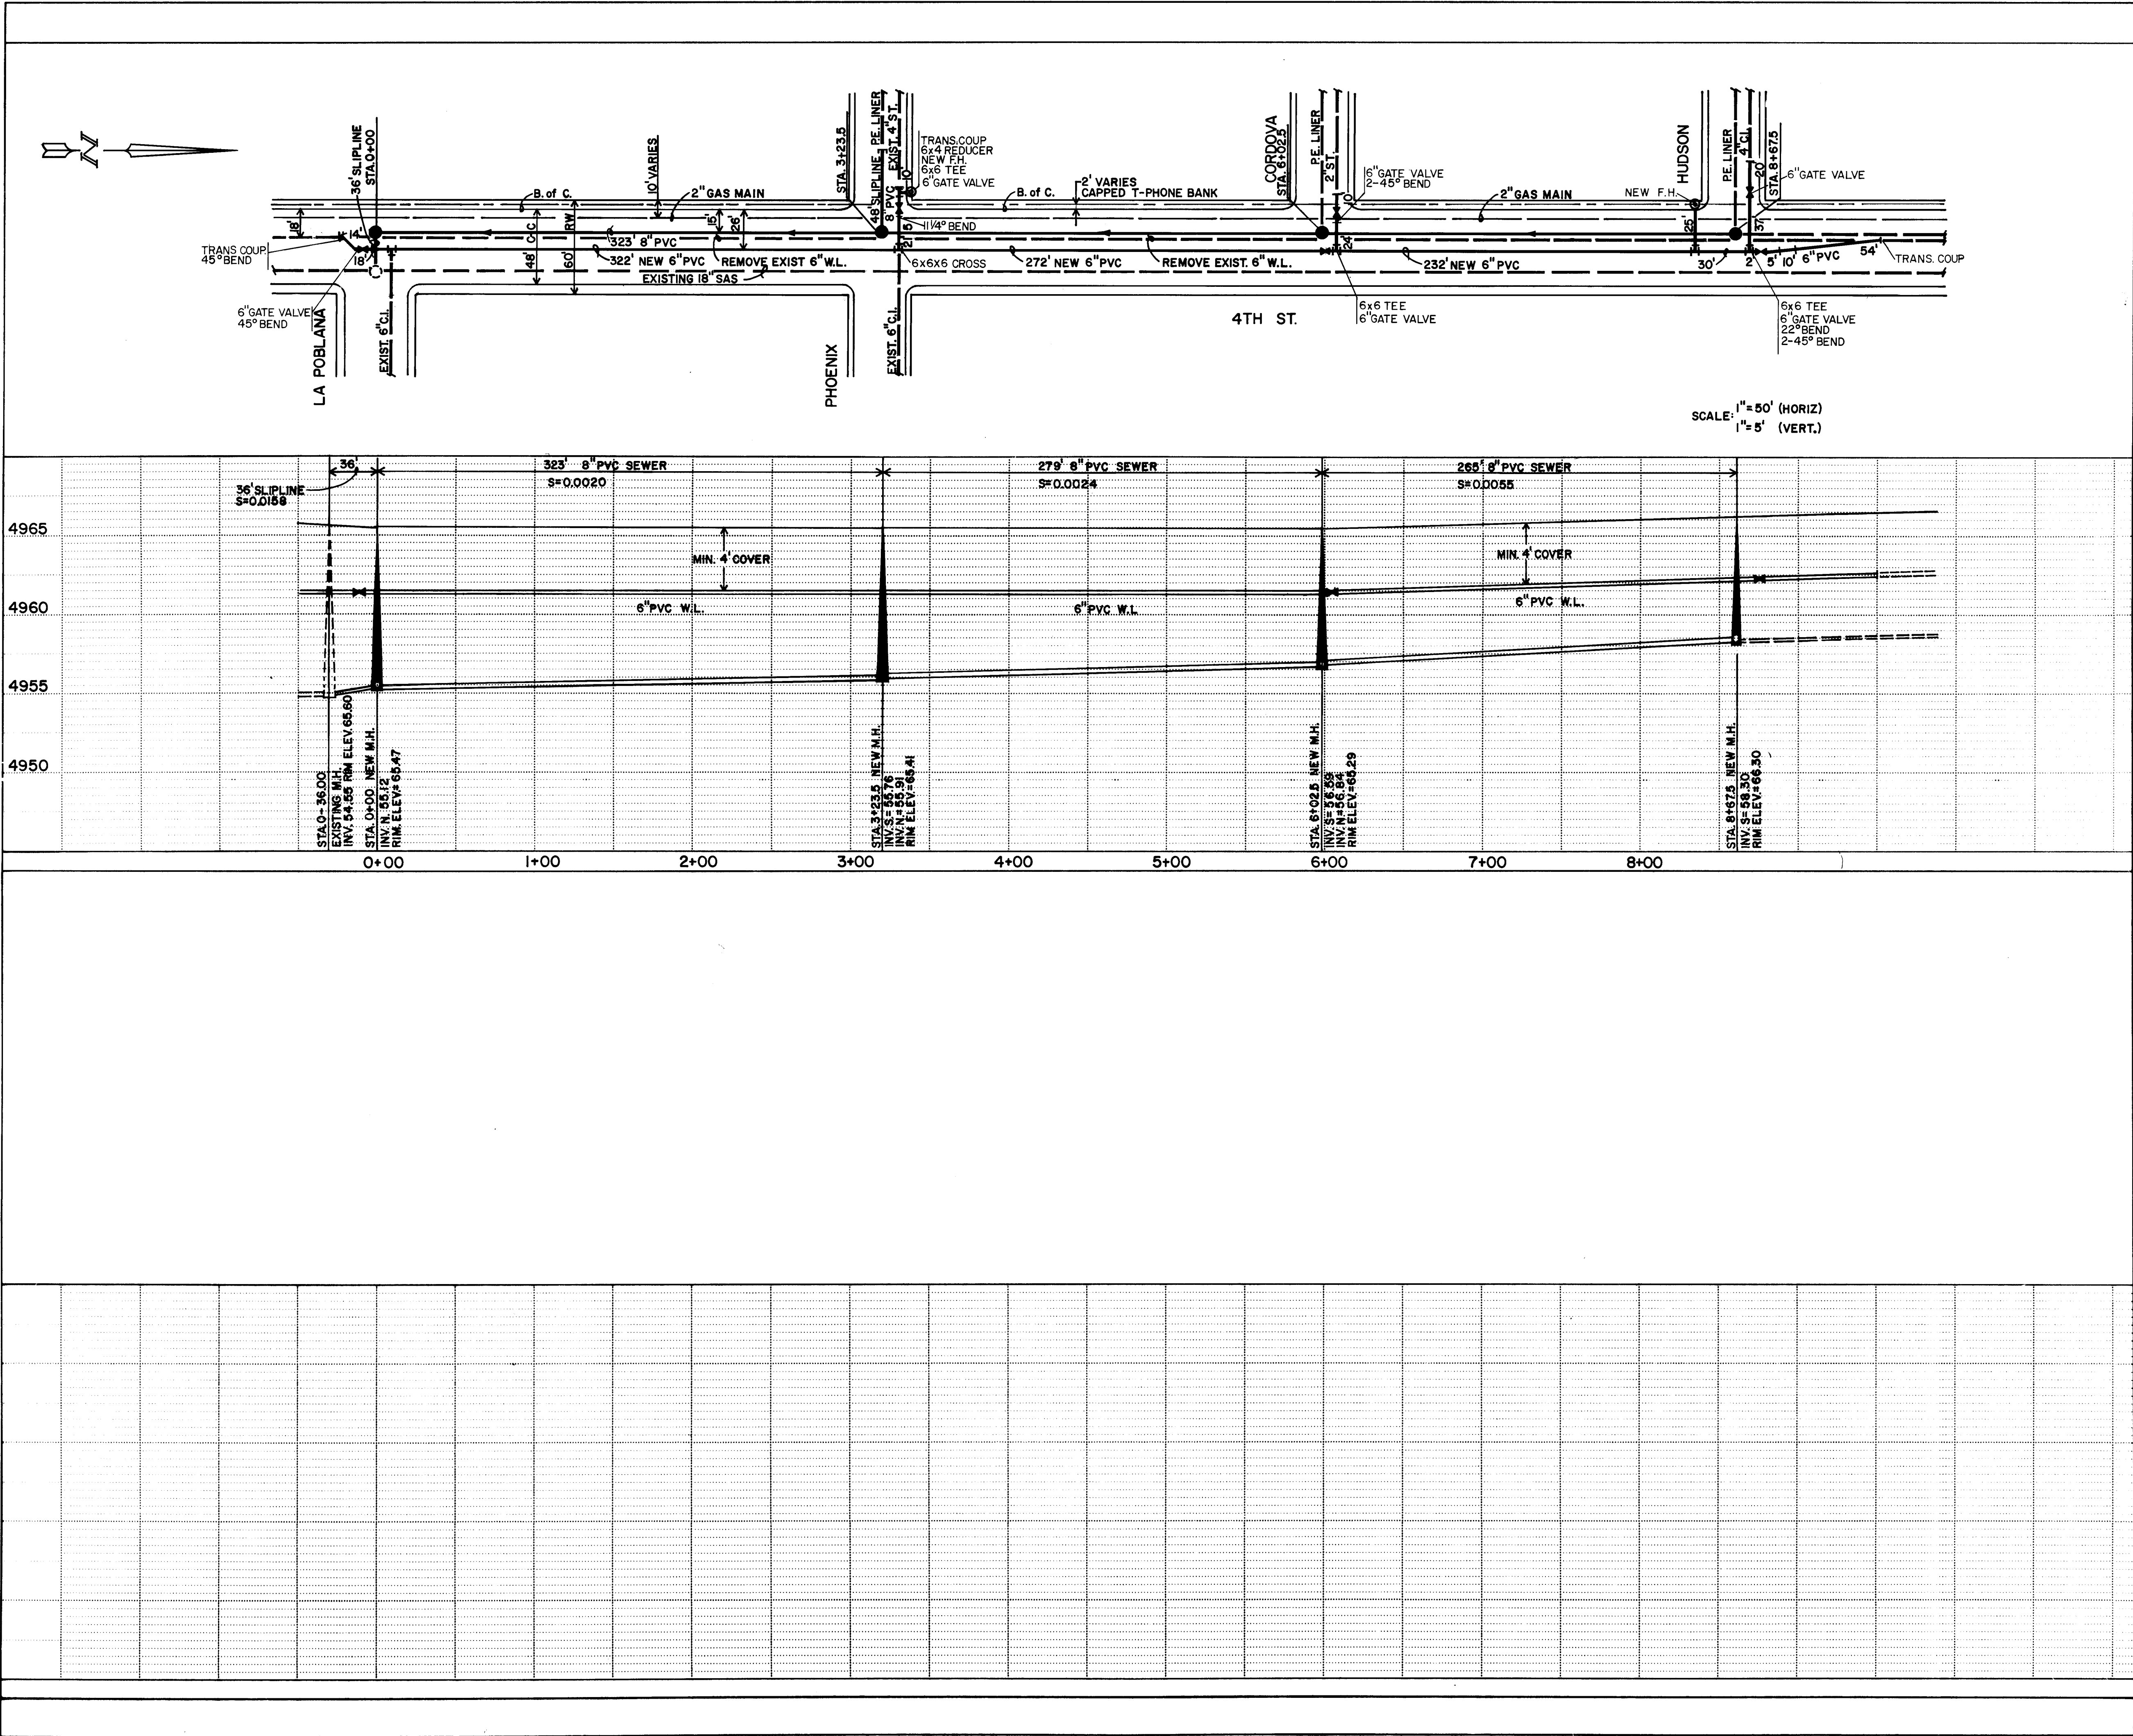

26 35510188

APPROVAL OF AS BUILT DRAWINGS
DATE 8-18-88

CITY OF ALBUQUERQUE PUBLIC WORKS ENGINEERING DIVISION					
TITLE: WATER & SEWER LINE ON 4TH ST. BETWEEN HUDSON AND LA POBLANA N.W.					
APPROVALS	ENGINEER	DATE	APPROVALS	ENGINEER	DATE
City Engineer			Liquid Waste		
A C E - Design			Traffic		
A C E - Hydrology			Water		
DRAWING NO. 3551			MAP NO. H-14N		
SHEET 1 OF 1			SHEET 1 OF 1		

SURVEY INFORMATION		BENCH MARKS		AS BUILT INFORMATION	
NO.	BY	DATE	LOCATED AT THE INTERSECTION OF 4TH AND CLAREMONT NW IN THE SOUTHEAST QUAD - RANT OF THE INTERSECTION.	CONTRACTOR	NEW CONCEIPTS
6. ARCHUNDE		7-1-88	A SQUARE, 12" CHISELED ON TOP OF CONCRETE CURB AT THE SSE CURB RETURN.	INSPECTOR	DATE
				APPROVED BY	DATE
				DESIGNED BY	DATE
				RECORDED BY	DATE
				NO.	NO.