


Vehicle Storage Building

PROJECT NO. 8525-23.01

City Project no. 3562

A.I.P. Project No. 3-35-0003-08-88

Master Plan Improvement Program Albuquerque International Airport

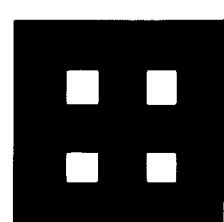


CONTACT: Jonathan C. Sanchez 505/881-BPLW

Project Manager: Charlie M. Otero, AIA


Philip W. Clark, PE
Vincent A. Meyer, PE
Richard G. Brown, PE
David A. Penasa, PE

Civil
Structural
Mechanical
Electrical

Albuquerque International Airport

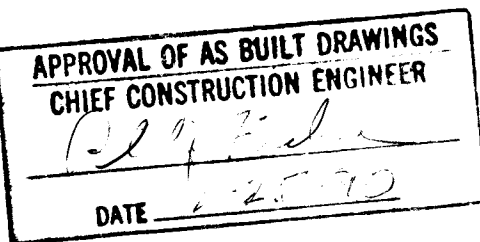


26 3562 09 01

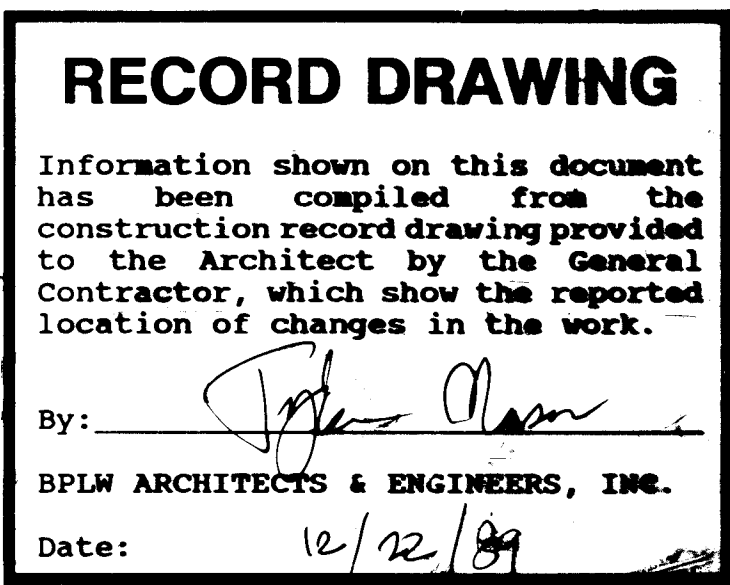

REV	SHEETS	CITY ENGR	DATE	USER DEPT	DATE	USER DEPT	DATE
APPROVAL OF REVISIONS							

DRAWING NO. 3562

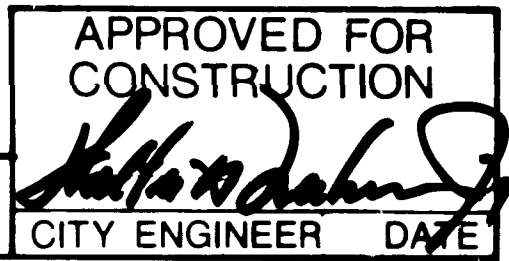

	EARTH
	CONCRETE
	BRICK
	CONCRETE BLOCK
	STEEL
	BATT INSULATION
	RIGID INSULATION
	GRAVEL
	SAND
	WOOD (FINISH)
	WOOD (THROUGH MEMBER)
	WOOD (INTERRUPTED MEMBER)
	GYPSUM BOARD
	PLYWOOD
	CEILING TILE
	PARTICLE BOARD

SECTION OR DETAIL

SUB-TITLE LOCATION

SCALE:

SHEET WHERE CUT

SECTION LETTER

SHEET WHERE DRAWN

DETAIL NUMBER

SHEET WHERE DRAWN

ELEVATION LETTER

SHEET WHERE DRAWN

ROOM NUMBER

ROOM NAME

CEILING FINISH GROUP

INTERIOR ELEVATION

SHEET WHERE DRAWN

DOOR NUMBER

FRAME OR WINDOW TYPE

EQUIPMENT OR FIXTURE NUMBER



K PREFIX DESIGNATES KITCHEN EQUIPMENT

KEYED NOTE

SPOT ELEVATION

CONTROL OR DATUM POINT

PROPERTY LINE

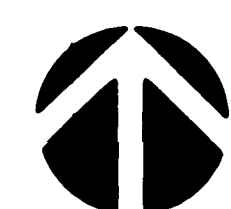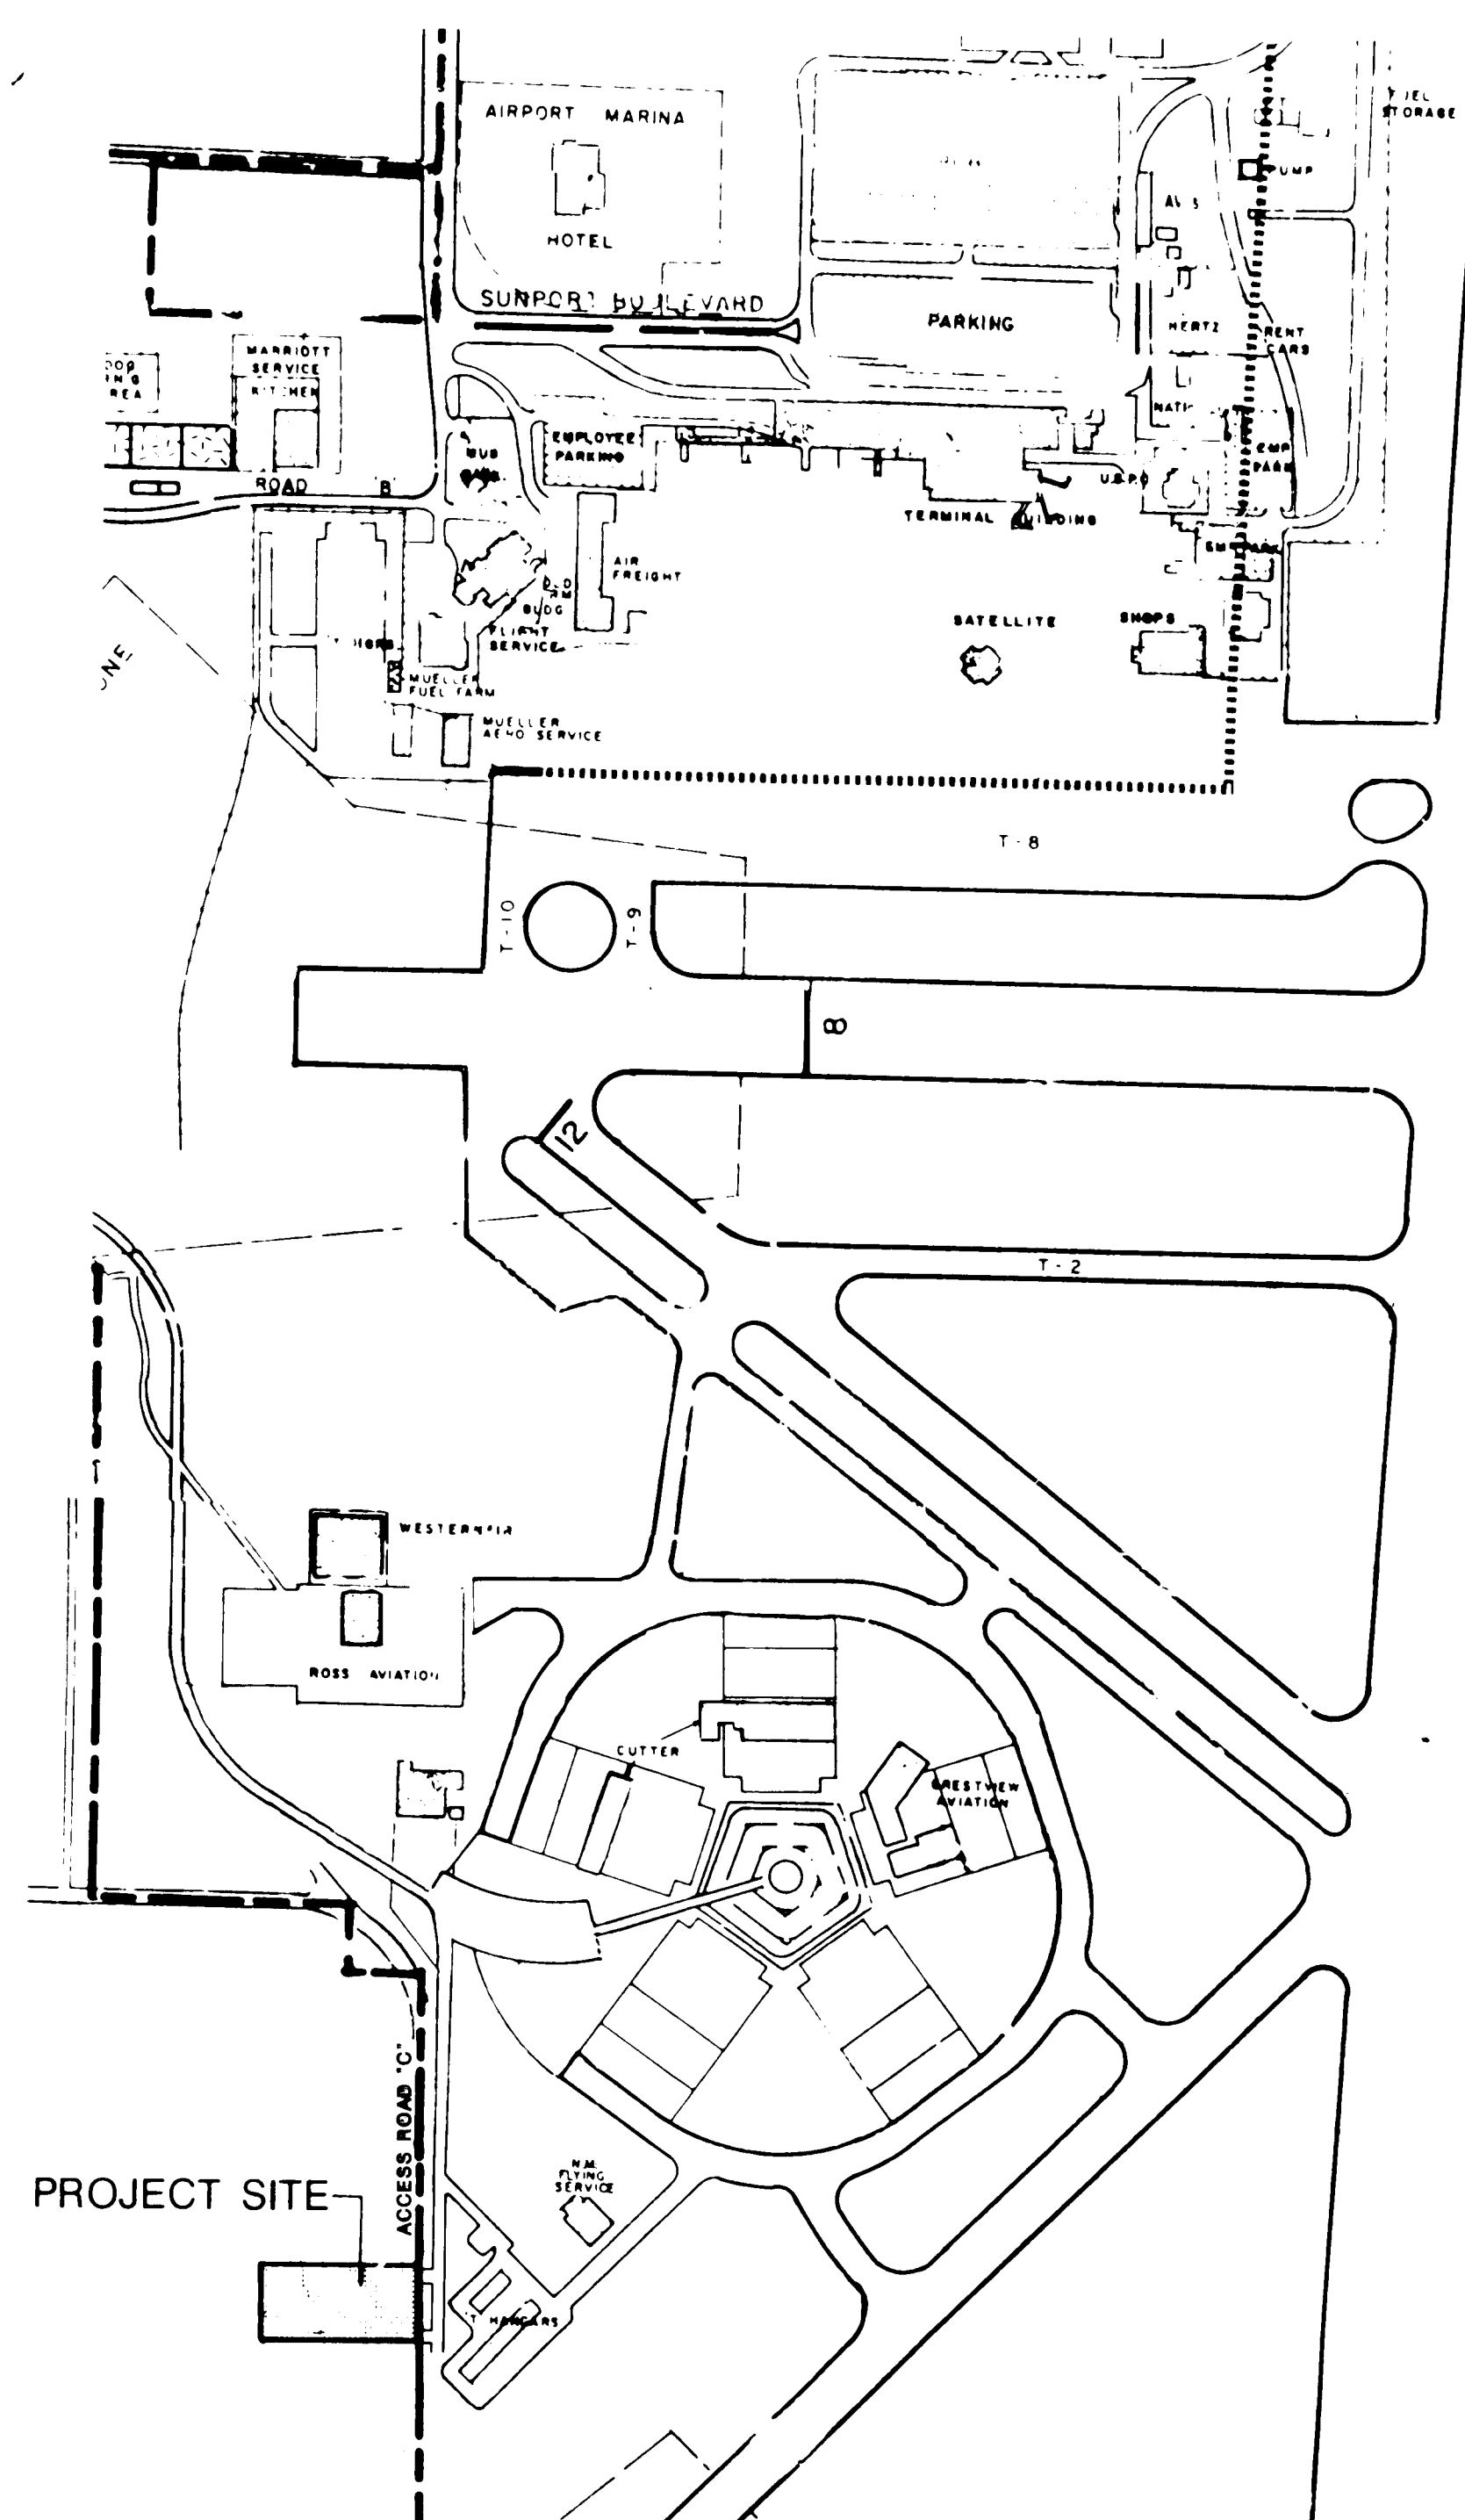[illegible]

LOCATION MAP

EPC CASE NO.: Z-1449-1

ZONING: M-2

DECIBEL LEVEL: Ldn-70

ADDRESS
3601 Access Road "C", Albuquerque, NM 87106

REFERENCES

City of Albuquerque Comprehensive Zoning Code
Uniform Building Code, 1985 Edition

OCCUPANCY GROUP B1

Gasoline service stations, garages where no repair work is done except exchange of parts and maintenance requiring no open flame, welding, or use of Class I, II or III-A liquids.

CONSTRUCTION TYPE II N

FLOOR AREA (Allowable)

Base Garage, Parking	12,000 sq. ft.
Area Increases (Separation 3 Sides) 648	19,680 sq. ft.

FLOOR AREA (Actual)

	2,370 sq. ft.
Garage, Parking	<u>10,426 sq. ft.</u>
TOTAL	12,796 sq. ft.

BUILDING HEIGHT

Allowable	2 Stories/55 ft. (B-1/II N)
Actual	1 Story/22'-8" (B-1/II N)

OCCUPANT LOAD

	<u>Area (Sq. Ft.)</u>	<u>Sq. Ft./Person</u>		
Storage	2,370	200	=	8
Garage, Parking	10,426	200	=	53
		TOTAL	=	61

EXITS

Required	2
Provided	9

EXIT WIDTH

Required	4 ft.
Provided	27 ft.

PARKING

Required	35 spaces
Provided	35 spaces

LANDSCAPING

Required	9 % X Paved Offstreet Parking (2,650 sq. ft.) - 14.74 sq. ft.
Provided	Planted 930 sq. ft.

G1	GENERAL INFORMATION
C1	SITE PLAN-LOCATION
C2	GRADING AND DRAINAGE PLAN
C3	SEWER LINE EXTENSION
S1	FOUNDATION PLAN
S2	FRAMING PLANS
S3	STRUCTURAL DETAILS
A1.1	FLOOR PLAN AND SCHEDULES
A5.1	ELEVATIONS
A5.2	SECTIONS
A7.1	INTERIOR ELEVATIONS
	ENLARGED STAIR PLAN & SECTIONS
A9.1	DETAILS
M1	MECHANICAL FLOOR PLAN
E0.1	SITE PLAN-ELECTRICAL AND RISER DIAGRAM
E1.0	LIGHTING PLAN
E2.0	POWER PLAN
EPC-1	1 OF 3
EPC-1	2 OF 3
EPC-1	3 OF 3
BT-1	BEACON TOWER

Information shown on this document has been compiled from the construction record drawing provided to the Architect by the General Contractor, which show the reported location of changes in the work.

By: *[Signature]*
BPLW ARCHITECTS & ENGINEERS, INC.

Date: 12/22/89

1	2	3	4	5	6	7	8	9	10	11	12
2	6		3	5	6	2	0	1	9	0	

Designing to Shape the future



VEHICLE STORAGE BUILDING

ALBUQUERQUE INTERNATIONAL AIRPORT
ALBUQUERQUE, NEW MEXICO

CITY PROJ. NO. 3582

PROJECT NO.

(MT)

GENERAL INFORMATION

11-26-74, No.

5. $\text{Al} + \text{H}_2\text{SO}_4 \rightarrow \text{Al}_2(\text{SO}_4)_3 + \text{H}_2$

SHEET OF

BPLW



KEYED NOTES: ○

1. ASPHALT PAVING AS SPECIFIED - SEE DETAIL 2/C1.
2. CONCRETE APRON - SEE DETAIL 1/C1.
3. SHADED AREA EAST OF THE EXISTING MAINTENANCE BUILDING: SEE SITE UTILITY PLAN, SHEET M1 AND SITE PLAN - ELECTRICAL, SHEET E0.1 FOR EXTENT OF WORK IN THIS AREA. ALL WORK PERFORMED IN THIS AREA SHALL BE IN CONFORMANCE WITH SECTION 01045 "CUTTING AND PATCHING" OF THE SPECIFICATIONS.
4. SPLASH BLOCK - SEE DETAIL 5/C1.
5. AIRWASHER - SEE MECHANICAL SHEET M1.

GENERAL NOTES

1. BUILDING IS LOCATED ACCORDING TO WORKING POINT AT NORTHWEST BUILDING CORNER.
2. BUILDING IS PARALLEL TO EAST AND WEST PROPERTY LINES.
3. CONTRACTOR TO ACCESS AND UTILIZE SITE IN A MANNER THAT IS COOPERATIVE AND LEAST DISRUPTIVE TO THE COURSE OF DAILY WORK AT THE EXISTING MAINTENANCE BUILDING.
4. ALL CHAINLINK FENCE IS EXISTING (N.I.C.) UNLESS OTHERWISE NOTED.


LEGEND

DEMARCATION OF ASPHALT PAVING. SEE DETAIL 1/C1 FOR CONDITION AT APRON EDGE AND 1/C2 FOR CONDITION AT CHAINLINK FENCE.

RECORD DRAWING

Information shown on this document has been compiled from the construction record drawing provided to the Architect by the General Contractor, which show the reported location of changes in the work.

By: *John Nelson*
BPLW ARCHITECTS & ENGINEERS, INC.
Date: 12/22/89

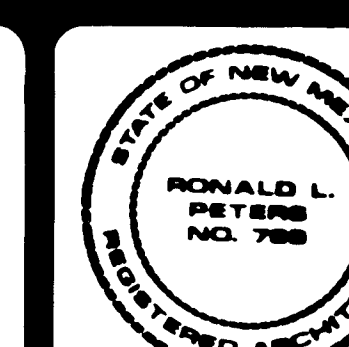

ENGINEER

ARCHITECT

VEHICLE STORAGE BUILDING
ALBUQUERQUE INTERNATIONAL AIRPORT
ALBUQUERQUE, NEW MEXICO

CITY PROJ. NO. 3582

PROJECT NO.

8525-23.01



DATE

SEPT. 1988


SITE PLAN

(DRAWING NO.)


C1
SHEET OF

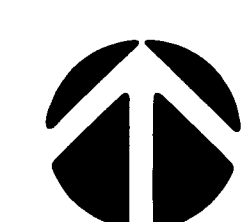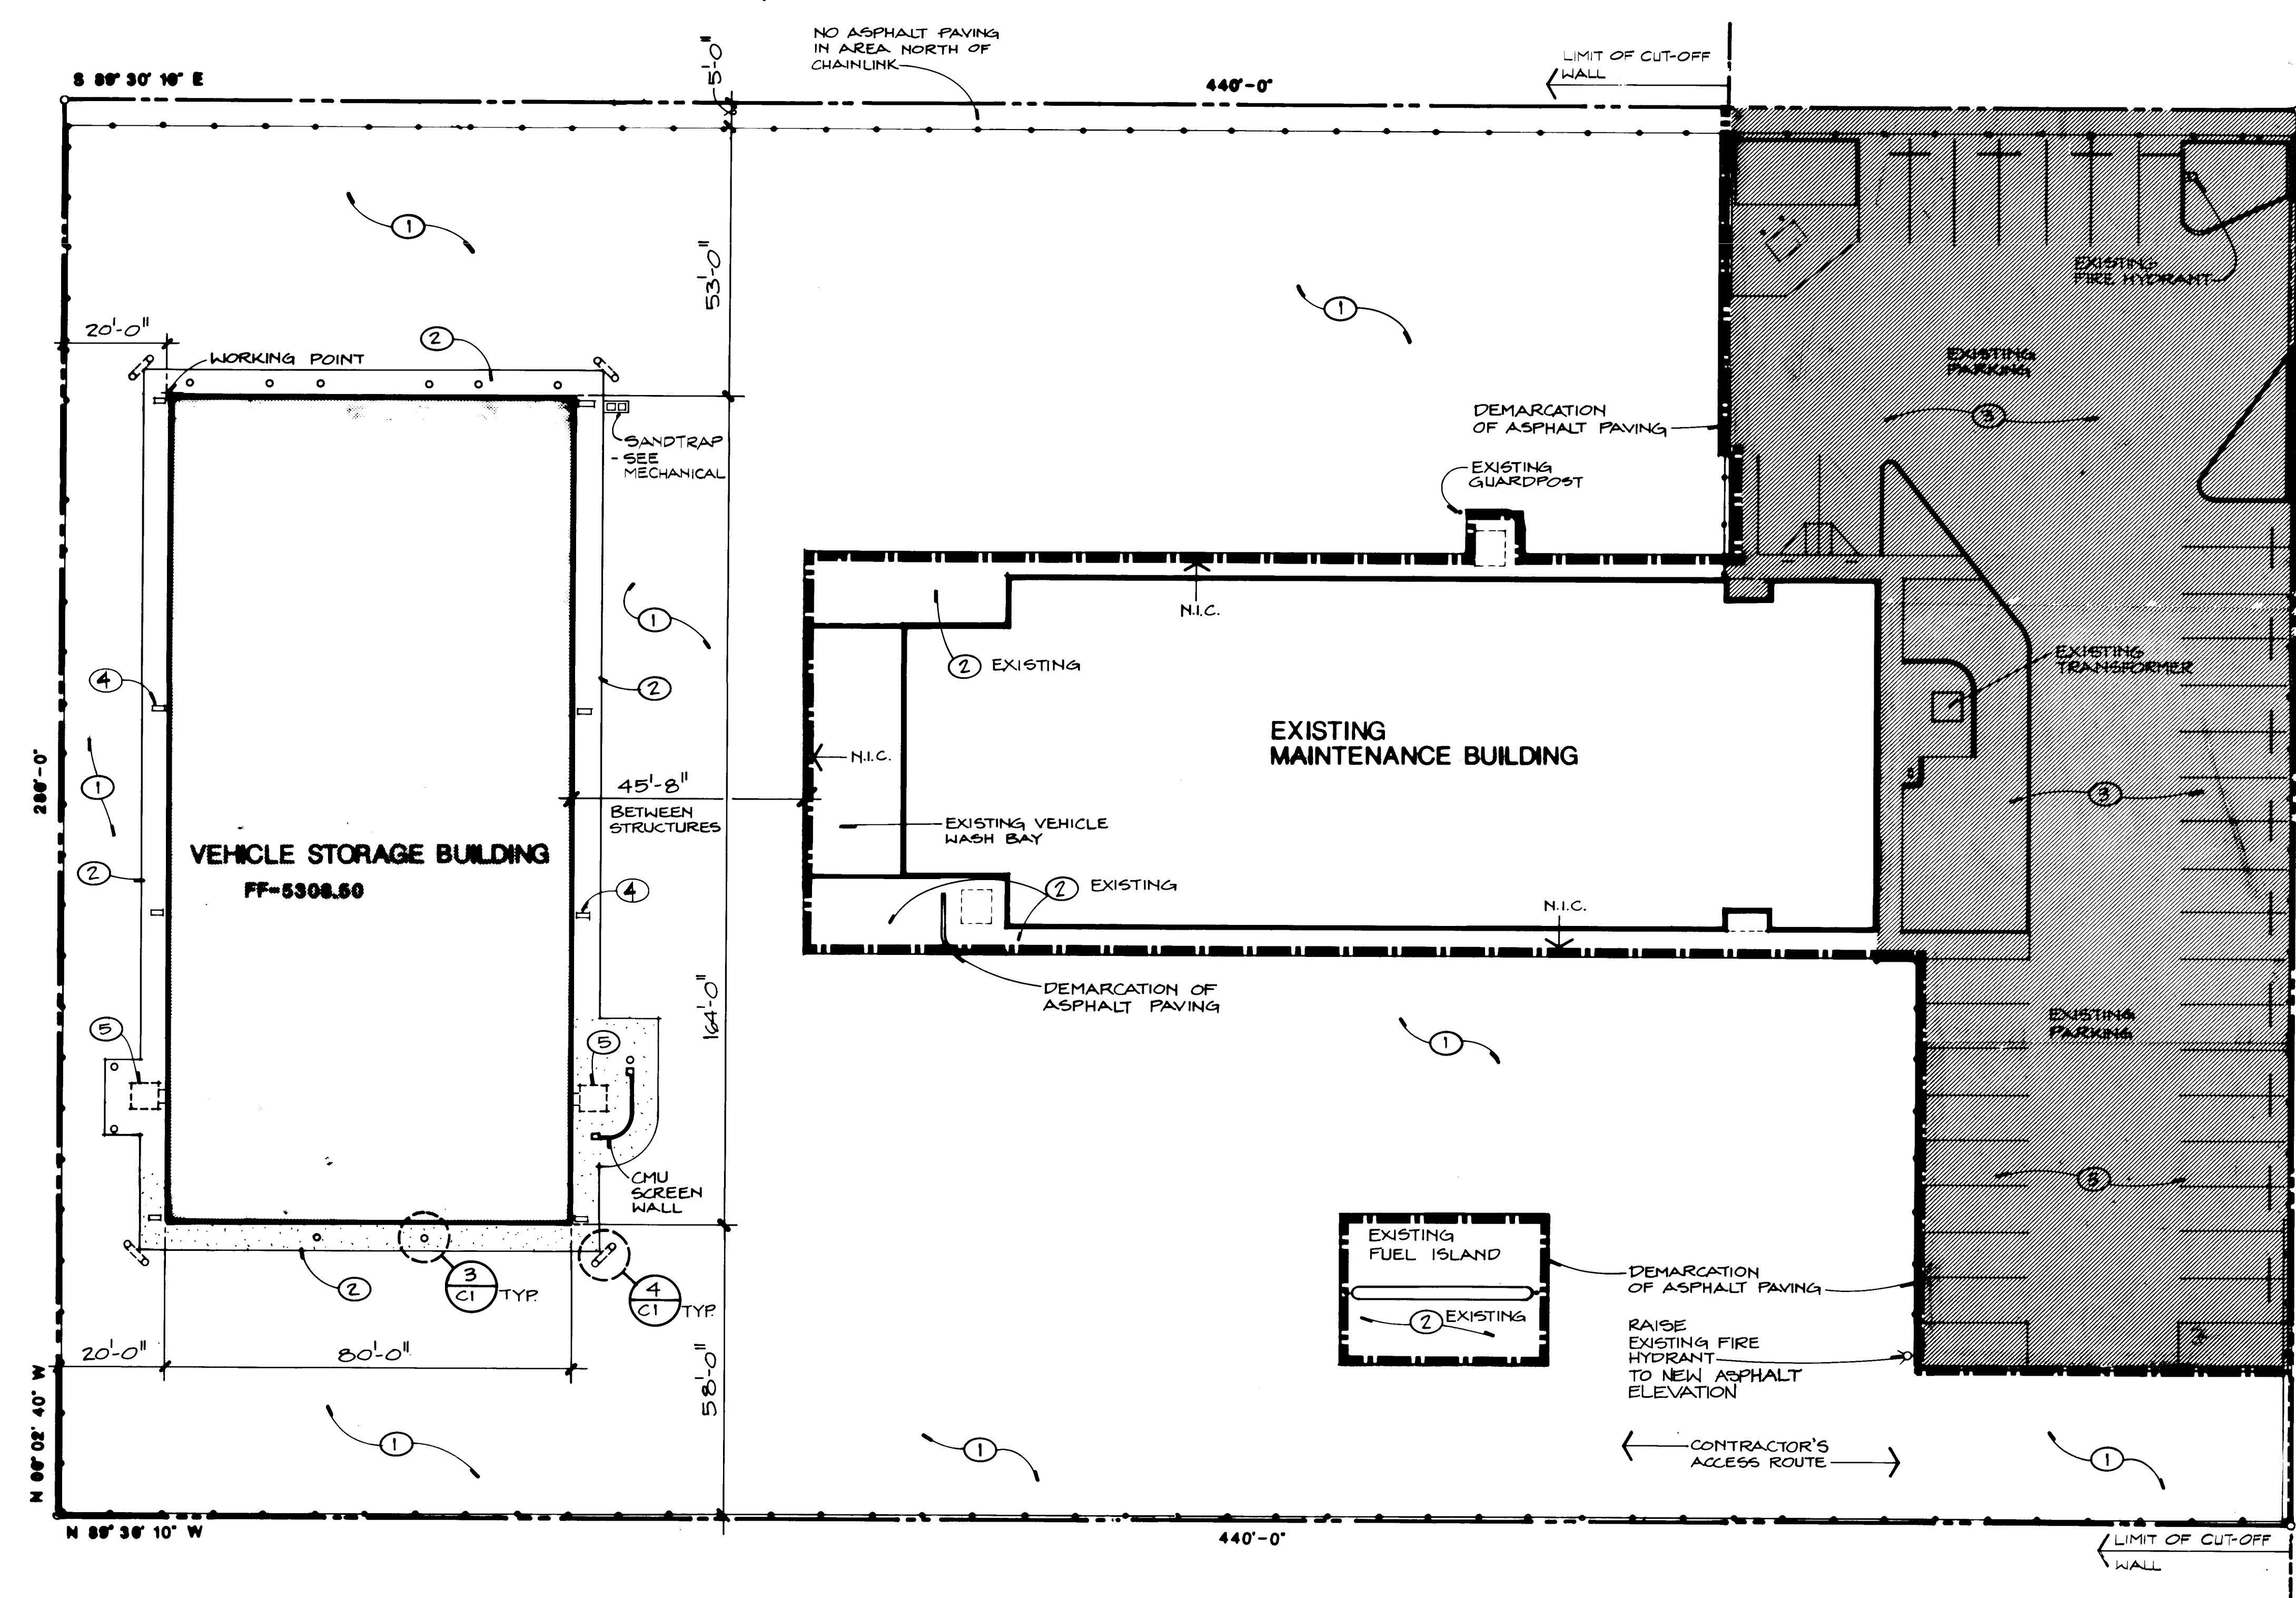


SITE PLAN
SCALE: 1"=20'-0"

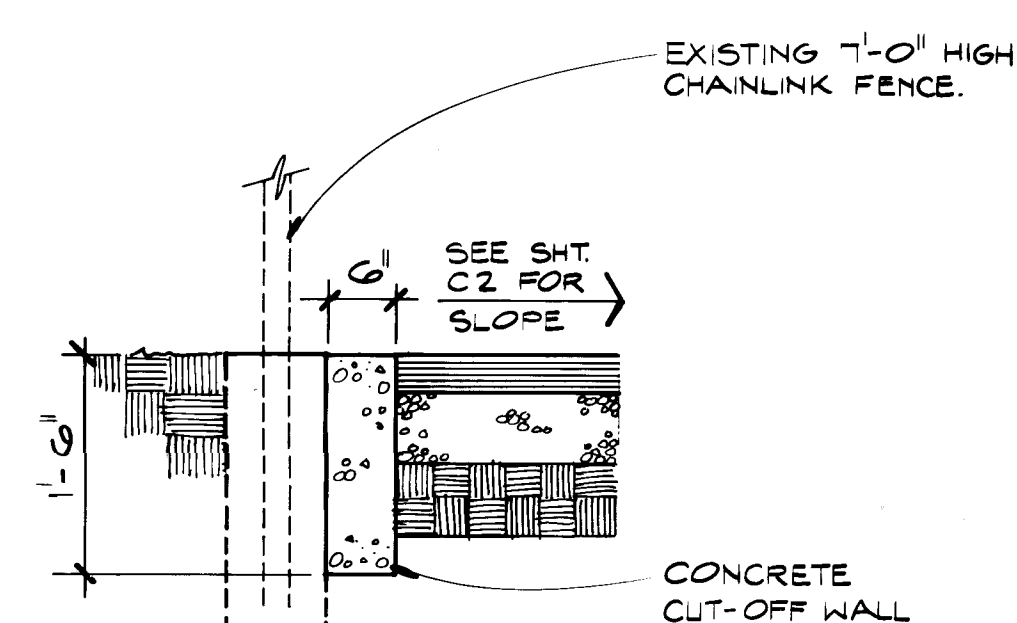


6
C2 CUT-OFF WALL
SCALE: 3/4"=1'-0"

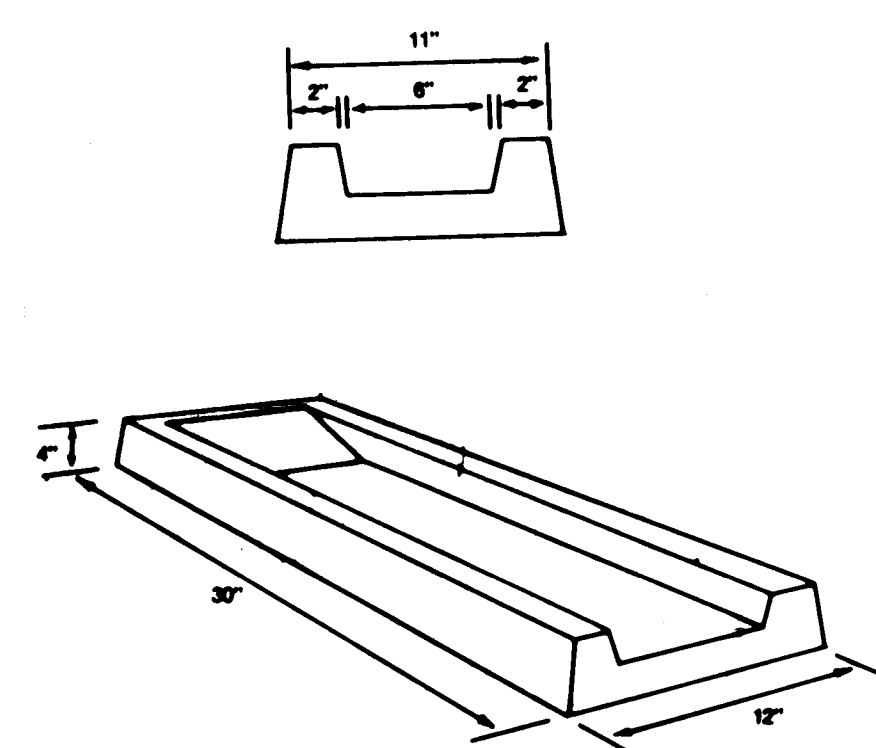


5
C1 SPLASHBLOCK
N.T.S.

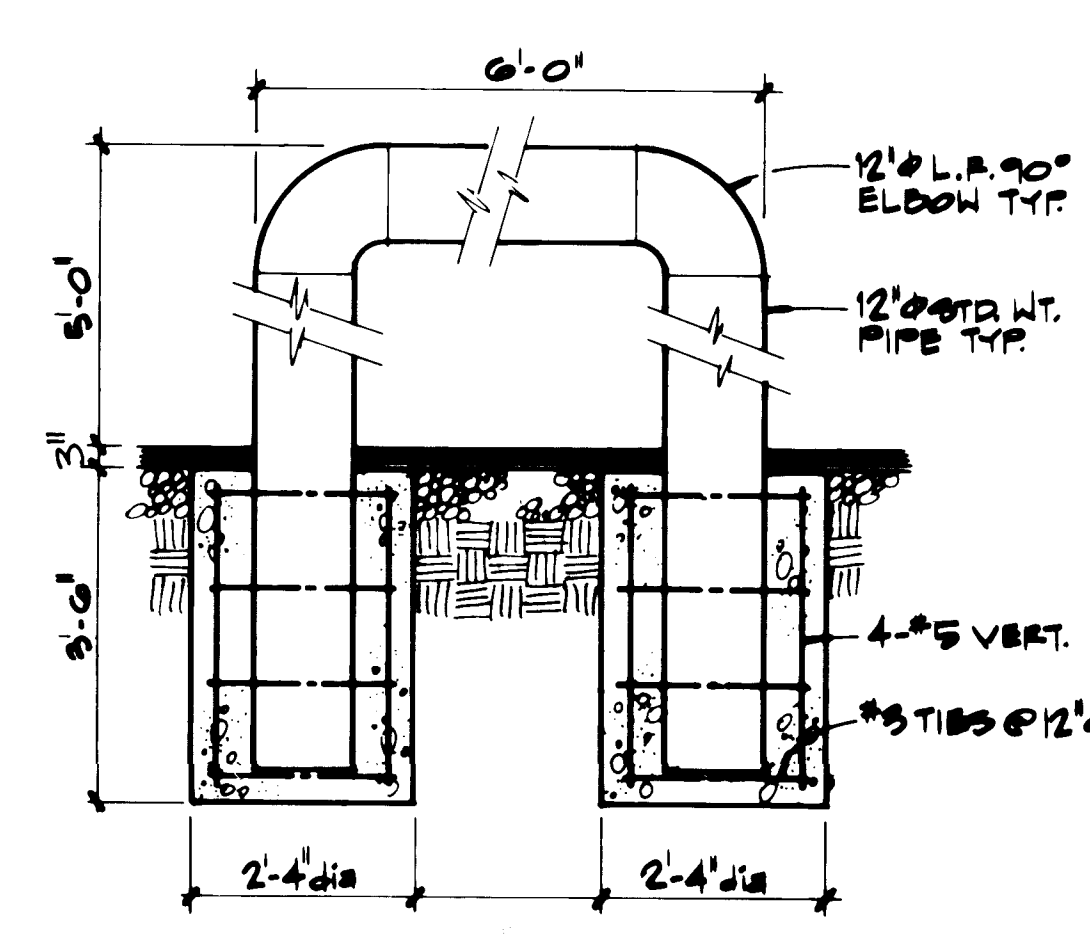


4
C1 GUARD POST
SCALE: 1/2"=1'-0"

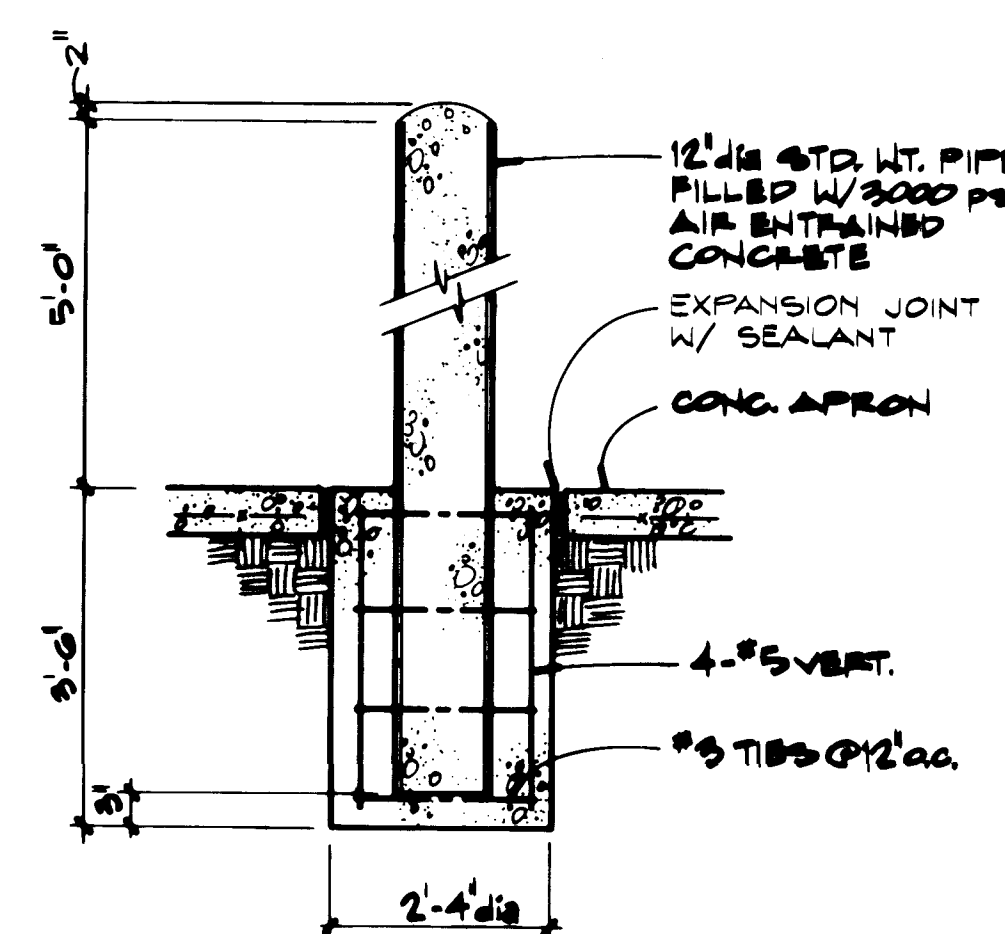

3
C1 GUARD POST
SCALE: 1/2"=1'-0"

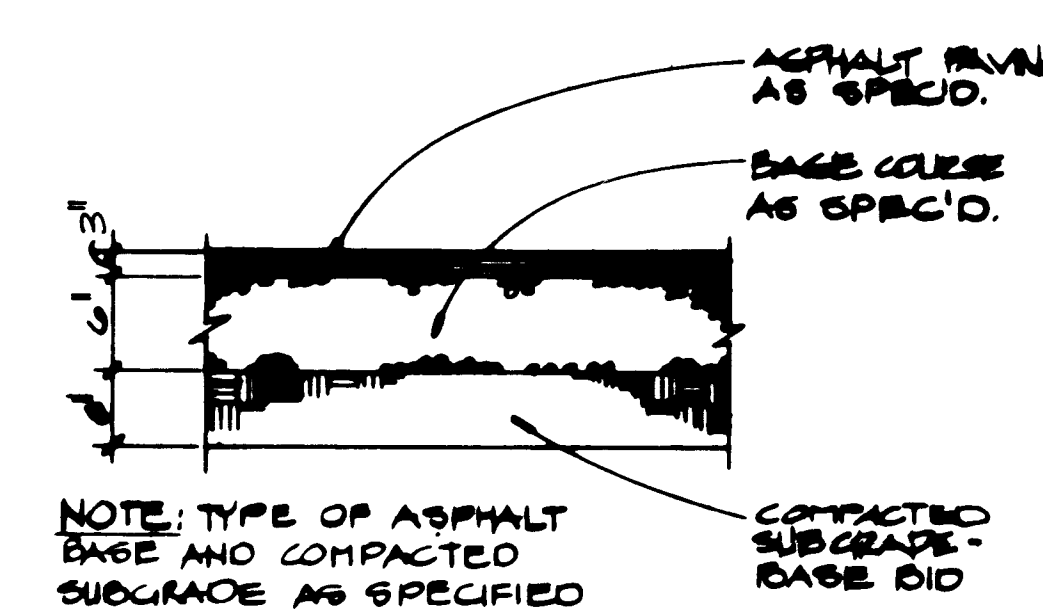

2
C1 PAVING SECTION
SCALE: 3/4"=1'-0"

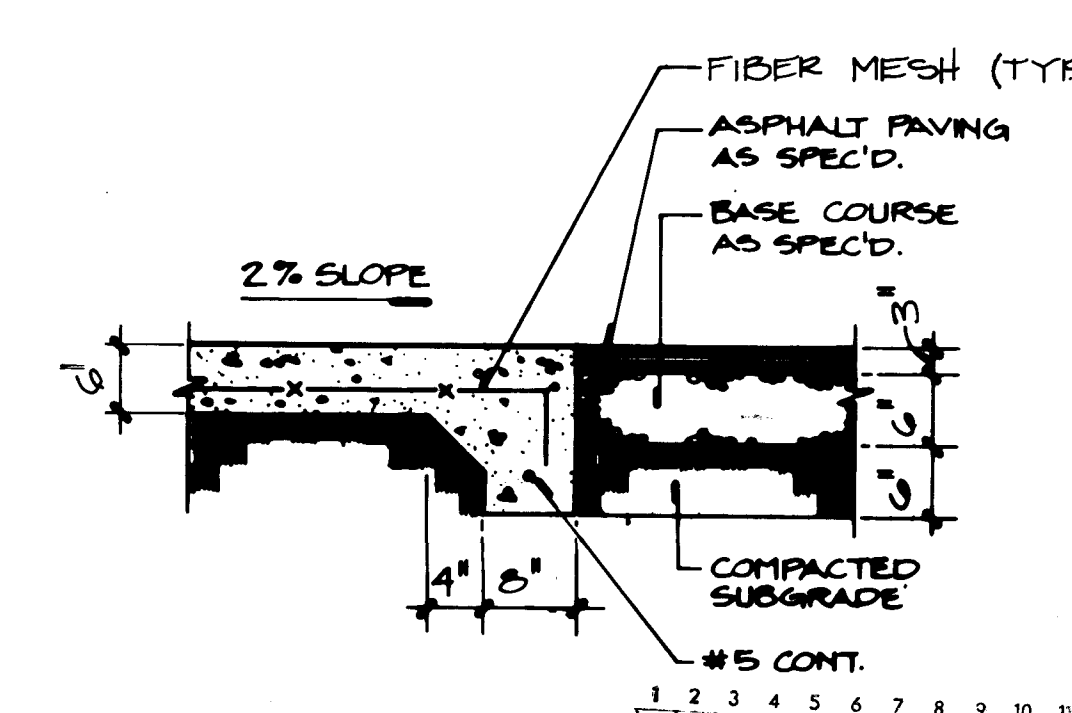



1
C1 APRON EDGE
SCALE: 3/4"=1'-0"

TS
CB
C2
C2

NOTE:
DRAINAGE POND DELETED AND STORM SEWER
ADDED UNDER SEPARATE CONTRACT. FOR AS-
BUILT CONDITIONS REFER TO CITY OF
ALBUQUERQUE PROJECT 8172 - HIGHWAY, 3-21
IMPROVEMENTS, CONSULTANT: MOLEMAN-CORBIN
ASSOCIATES

PROPERTY LEASED TO MARTIN ECKERT

BEAUMAR STA.
1-NIGR.

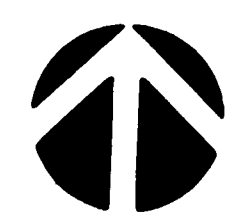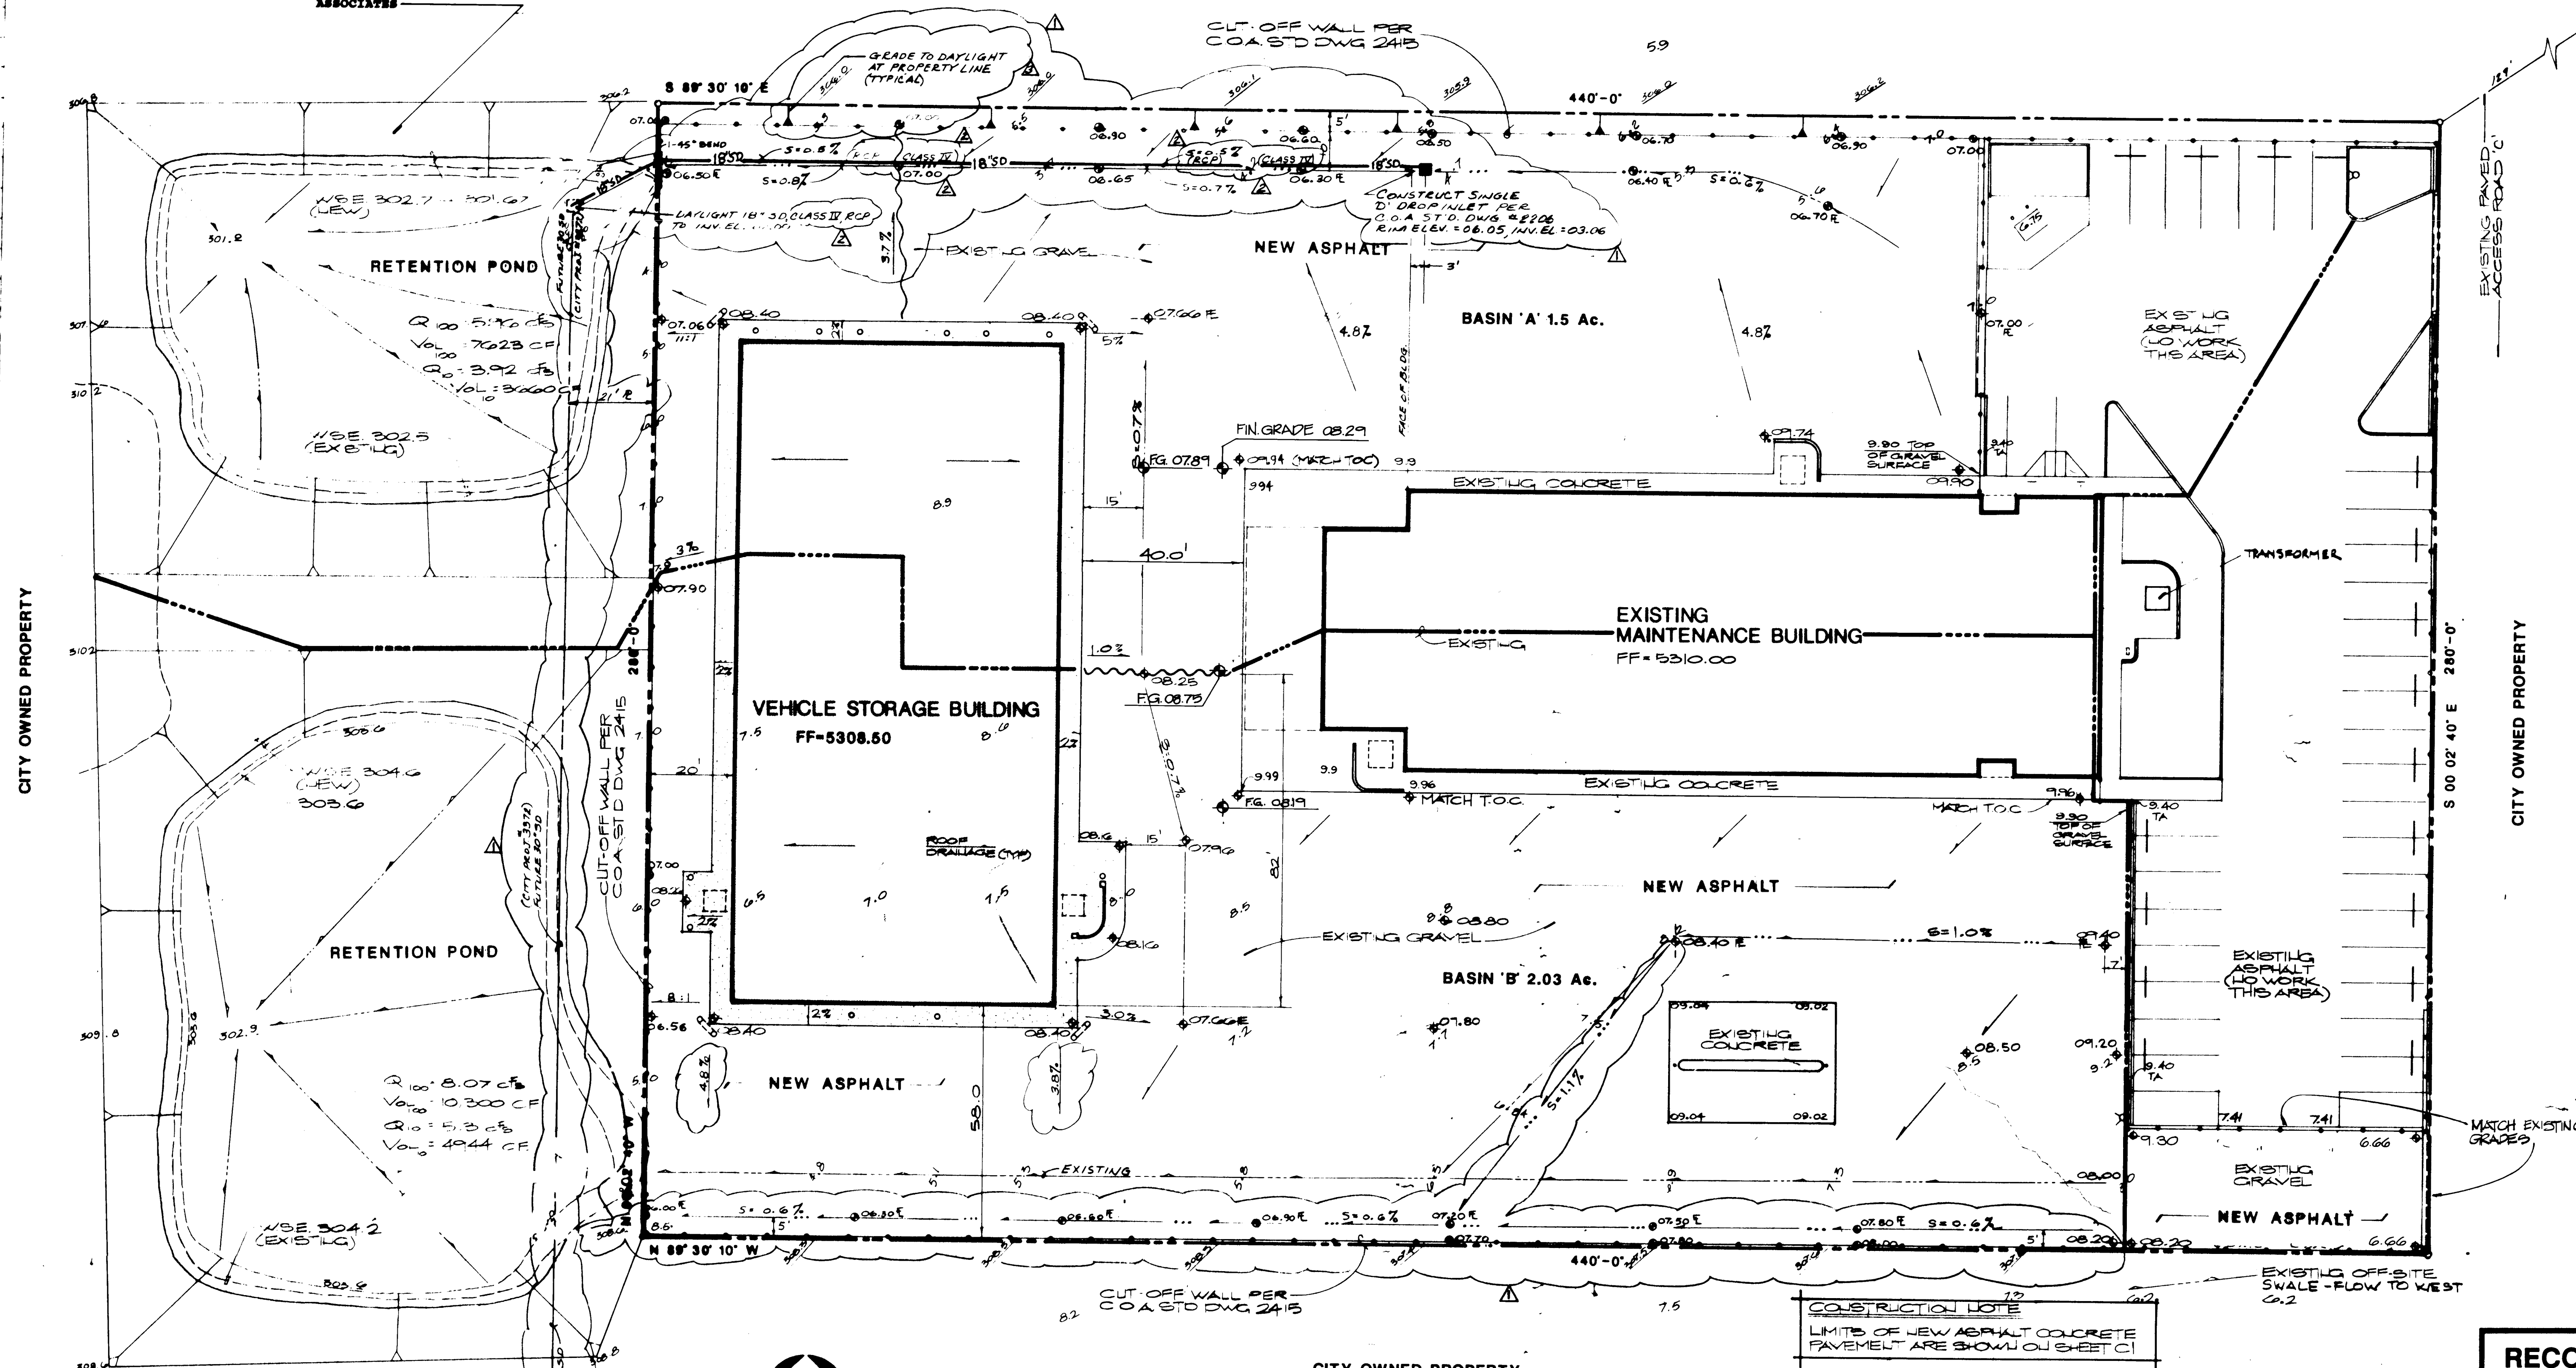

GRADING & DRAINAGE PLAN
SCALE: 1" = 20'-0"

CITY OWNED PROPERTY

RECORD DRAWING

Information shown on this document
has been compiled from the
construction record drawing provided
to the Architect by the General
Contractor, which show the reported
location of changes in the work.

By: *[Signature]*
BPLW ARCHITECTS & ENGINEERS, INC.
Date: 12-22-89

I. DESIGN CRITERIA

Methodology - Rational Formula (discharge rate) and SCS (volume
discharge) Development Process Manual: Ch. 22, Vol. II.
Soil Type - "B" - Wink - MAB (per Bernalillo County, SCS Soil
Survey, Panel 41).

Q = CIA
VOL. = R X A
11(100) = 0.644C - 0.51
TC = 0.00786C - 0.775 + 0.385
P(100) = 2.35 IN., P(10) = 1.34 IN.

C(L.S.) = 0.25
C(PAV.) = 0.95
C(ROOF) = 0.90
C(UNDEV.) = 0.40
C(GRAVEL) = 0.705

II. EXISTING CONDITIONS

TC = 10 min., R = 1.05 in., I = 4.97 in./hr.

PAV.	UNDEV.	GRAVEL	ROOF
14	39	80	127
1.5 AC	0.69	5.14 CFS	5717 C.F.

BASIN 'B'

PAV.	UNDEV.	GRAVEL	ROOF
05	54	127	127
1.5 AC	0.67	6.76 CFS	7737 C.F.


III. DEVELOPED CONDITIONS

TC = 10 min., R = 1.4 in., I = 4.97 in./hr.

AREA	'CC'	Q100	VOL 100
1.5 AC	0.80	5.96 CFS	7623 C.F.

BASIN 'B'

AREA	'CC'	Q100	VOL 100
1.15	0.80	8.07 CFS	10,300 C.F.

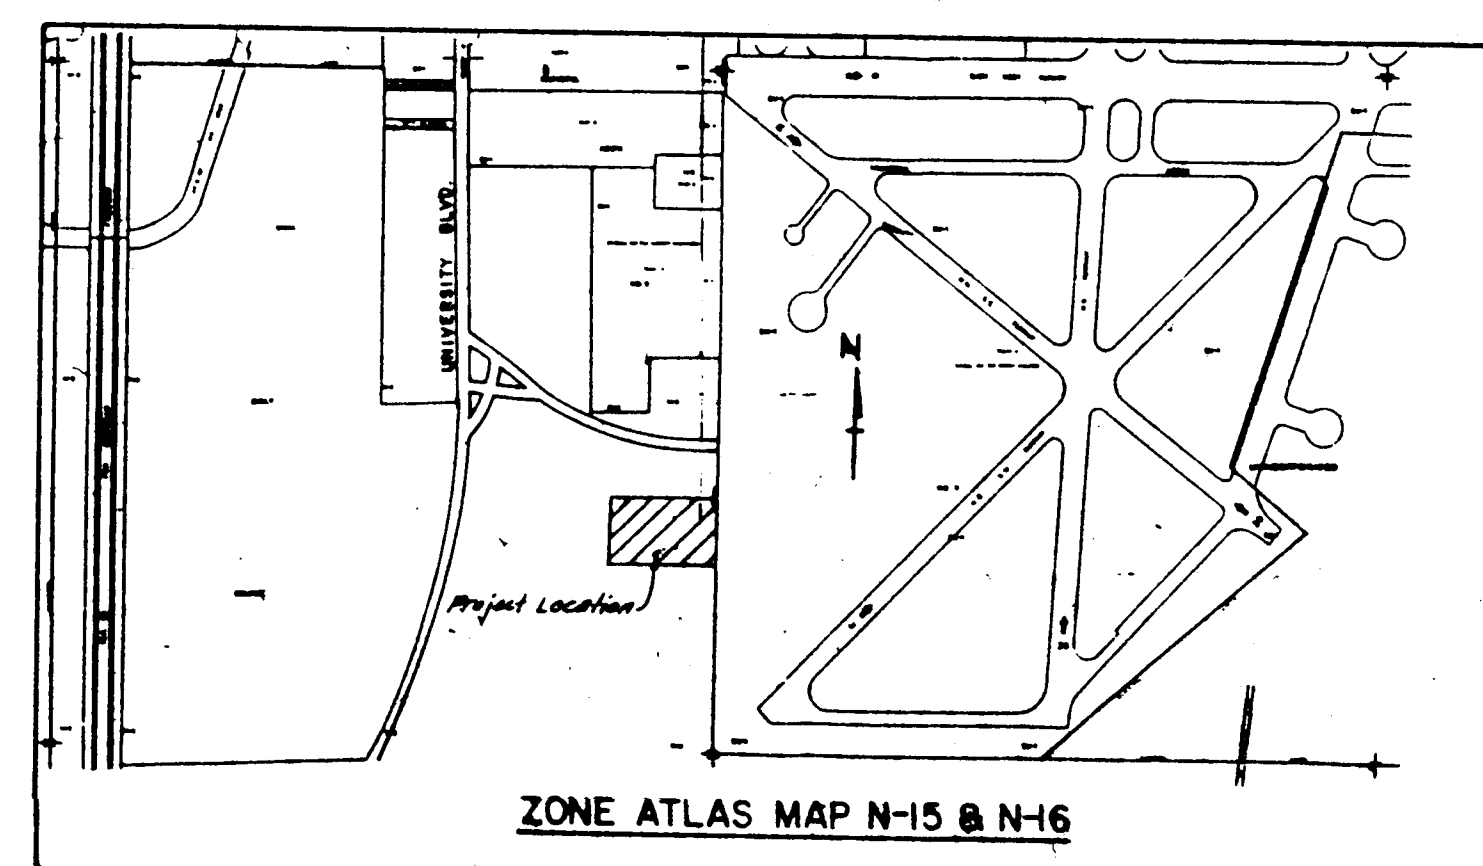

1 2 3 4 5 6 7 8 9 10 11
26 35 62 20 39 10

REVISION #3, 2-27-89, RUC
REVISION #2, 2-15-89, RUC
REVISION #1, 1-31-89, RUC

BPLW


GENERAL NOTES

- LEGAL - SEE ARCHITECTURAL SURVEY FOR AIRPORT MAINTENANCE FACILITY, DATED: MARCH, 1986.
 - BENCH MARK - STA. 1-NIGR. ESTABLISHED BY ACS. STATION IS A STANDARD C.O.A. BRASS CAP SET IN CONCRETE MONUMENT STAMPED "1-NIGR" AND PROJECTING 0.1 FT. ABOVE GROUND. EL=5308.75.
 - THE MAINTENANCE FACILITY IS NOT LOCATED WITHIN A FLOOD HAZARD AREA. SEE FIRM PANEL NUMBER 350002-0041-C, SHEET 41 OF 50.
 - THE DRAINAGE CONTROL MANAGEMENT FOR THE MAINTENANCE FACILITY IS TOTAL RETENTION OF ANTICIPATED DEVELOPMENT DRAINAGE RUNOFF. THE PROPOSED PONDING AREAS AND BEAMS SHALL BE CARED FOR AND MAINTAINED BY THE CITY'S AVIATION DEPARTMENT. THE PONDING AREAS SHOWN ON THE PLAN ARE LOCATED IN CITY OWNED PROPERTY.
- BOB GILL FROM THE CITY AVIATION DEPARTMENT HAS ASSURED PERD ACQUIRE THAT THE AVIATION DEPARTMENT WILL BE EXPANDING IN THE FUTURE WITH ADDITIONAL DEVELOPMENT IN THE AREA. WHEN THIS OCCURS A STORM DRAINAGE SYSTEM WILL BE ENGINEERED AND DEVELOPED. THE DEVELOPMENT OF THIS SYSTEM WILL ALSO INCLUDE FINANCIAL PARTICIPATION BY THE CITY AVIATION DEPARTMENT FOR A PORTION OF THE DOWNSTREAM INFRASTRUCTURE COSTS.
- WHEN THE DEVELOPMENT OF THE STORM SEWER SYSTEM OCCURS, THE EXISTING RETENTION PONDING AREAS WILL BE REMOVED IF FUTURE OUTFALL SYSTEM ALLOWS FREE DISCHARGE, OTHERWISE DETENTION PONDS WILL BE REQUIRED.
- THE MAINTENANCE FACILITY'S DEVELOPED DRAINAGE RUNOFF WILL NOT FLOOD OR DAMAGE ANY EXISTING PROPERTY OWNERS IF THE GRADING PARAMETERS ARE MET. ALSO NO UPLAND DRAINAGE FLOWS WILL CROSS OUR PROPOSED SITE, THEREFORE NOT TAKING THE PONDING AREAS.

- REMOVE AND REPLACE EXISTING FENCE AS NECESSARY ALONG WEST AND NORTH PROPERTY LINES.

LEGEND

- EXIST SPOT ELEVATION
- NEW SPOT ELEVATION
- EXISTING BACK SLOPE
- EXISTING SWALE
- NEW SWALE
- DRAINAGE DIRECTION
- DRAINAGE BASIN
- PROPERTY LINE
- CHAIN LINK FENCE (EXISTING)
- WATER BLOCK
- W.S.E. WATER SURFACE ELEVATION
- GRADE BREAK
- TOC TOP OF CONCRETE
- E FLOWLINE
- TA TOP OF ASPHALT

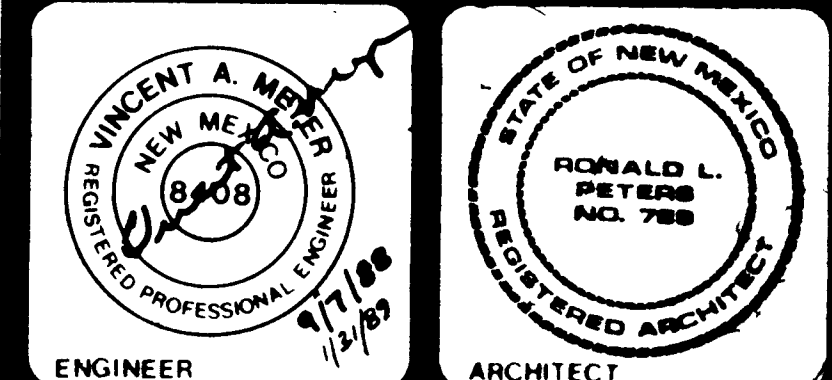


VEHICLE STORAGE BUILDING
ALBUQUERQUE INTERNATIONAL AIRPORT
ALBUQUERQUE, NEW MEXICO

PROJECT NO. 8525-23.01 DATE SEPT. 1988

GRADING & DRAINAGE

DRAWING NO.

C2
SHEET OF

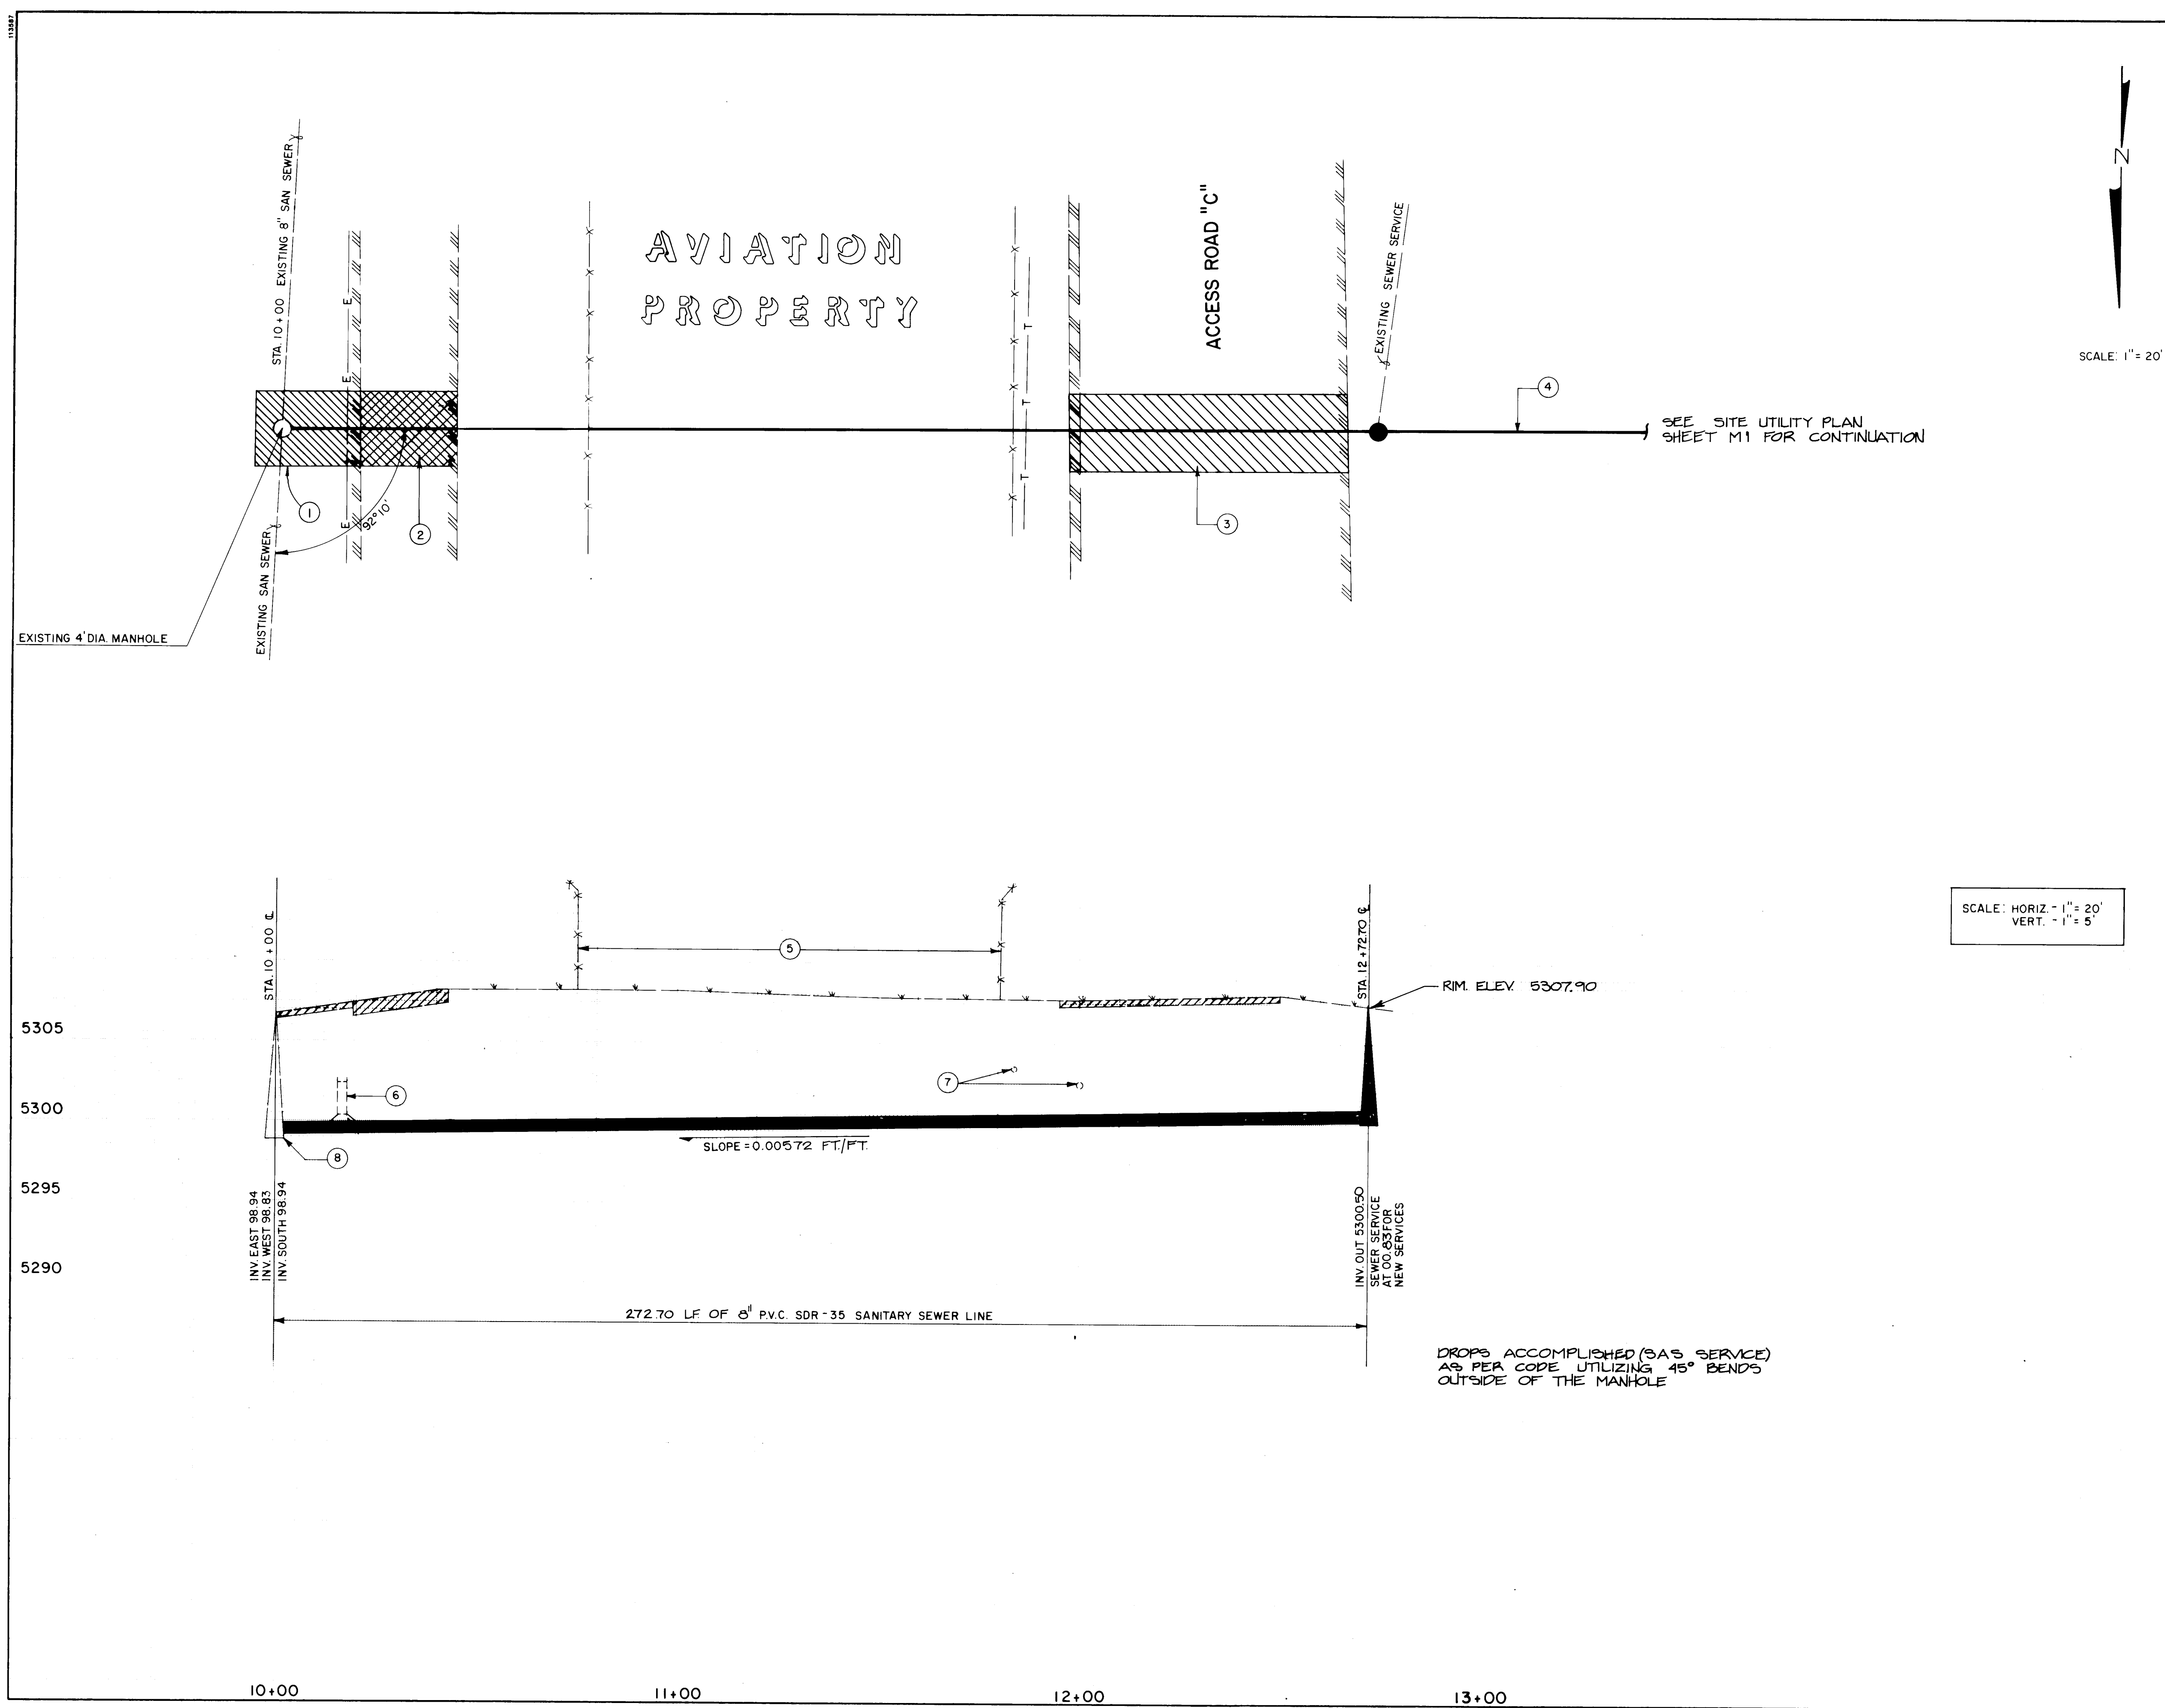

CONSTRUCTION NOTES

- REMOVE AND REPLACE WITH 3" ASPHALT SURFACE AND 12" SUBGRADE.
- REMOVE AND REPLACE WITH 8" ASPHALT SURFACE COURSE AND 12" SUBGRADE.
- REMOVE AND REPLACE WITH 6" AGGREGATE BASE COURSE AND 3" ASPHALT SURFACE COURSE.
- INTERCEPT EXISTING SEWER SERVICE AND SET DROP SERVICE IN MANHOLE
- SECURITY FENCES TO BE MAINTAINED DURING CONSTRUCTION AT ALL TIMES.
- UNDERGROUND ELECTRICAL DUCT - PROTECT AND SUPPORT AS REQUIRED TO SET 8" SANITARY SEWER. VERIFY LOCATION.
- PROTECT & SUPPORT TELEPHONE AND POWER LINES AS REQUIRED TO SET 8" SANITARY SEWER MAIN. VERIFY LOCATION.
- CONTRACTOR TO RECONSTRUCT MANHOLE INVERT AT STA. 10+00 FOR NEW LATERAL SOUTH. SEE CITY STD DWG 2102 SECTION C-C

ENGINEER'S SEAL		SURVEY INFORMATION		BENCH MARKS		AS BUILT INFORMATION	
NO.	BY	NO.	DATE	INSTR.	DATE	NO.	DATE
				INSTR.	DATE		DATE

REVISIONS		MICRO-FILM INFORMATION	
NO.	DATE	NO.	DATE

CITY OF ALBUQUERQUE
PUBLIC WORKS DEPARTMENT
ENGINEERING GROUP

TITLE
SANITARY SEWER EXTENSION FOR
VEHICLE STORAGE BUILDING

APPROVALS	ENGINEER	DATE	APPROVALS	ENGINEER	DATE
D.R.C. Chair					
Trans. Dev.					
Utility Dev.					

DRAWING NO. 3562 MAP NO. N-16 SHEET 1 OF 1

1 2 3 4 5 6 7 8 9 10 11 12
26 35 62 04 90

RECORD DRAWING

Information shown on this document has been compiled from the construction record drawing provided to the Architect by the General Contractor, which show the reported location of changes in the work.

By: *[Signature]*
BPLW ARCHITECTS & ENGINEERS, INC.
Date: 12/22/89

BPLW
Architects & Engineers, Inc.
American Financial Center #5
Suite 400
2400 Louisiana Blvd. NE
Albuquerque, New Mexico 87110
505/881-BPLW

Designing to Shape the Future

ENGINEER

ARCHITECT


VEHICLE STORAGE BUILDING
ALBUQUERQUE INTERNATIONAL AIRPORT
ALBUQUERQUE, NEW MEXICO

CITY PROJECT NO. 3562


PROJECT NO. 8525-23.01 DATE SEPT. 1988

SEWER LINE EXTENSION


DRAWING NO. **C3**
SHEET OF

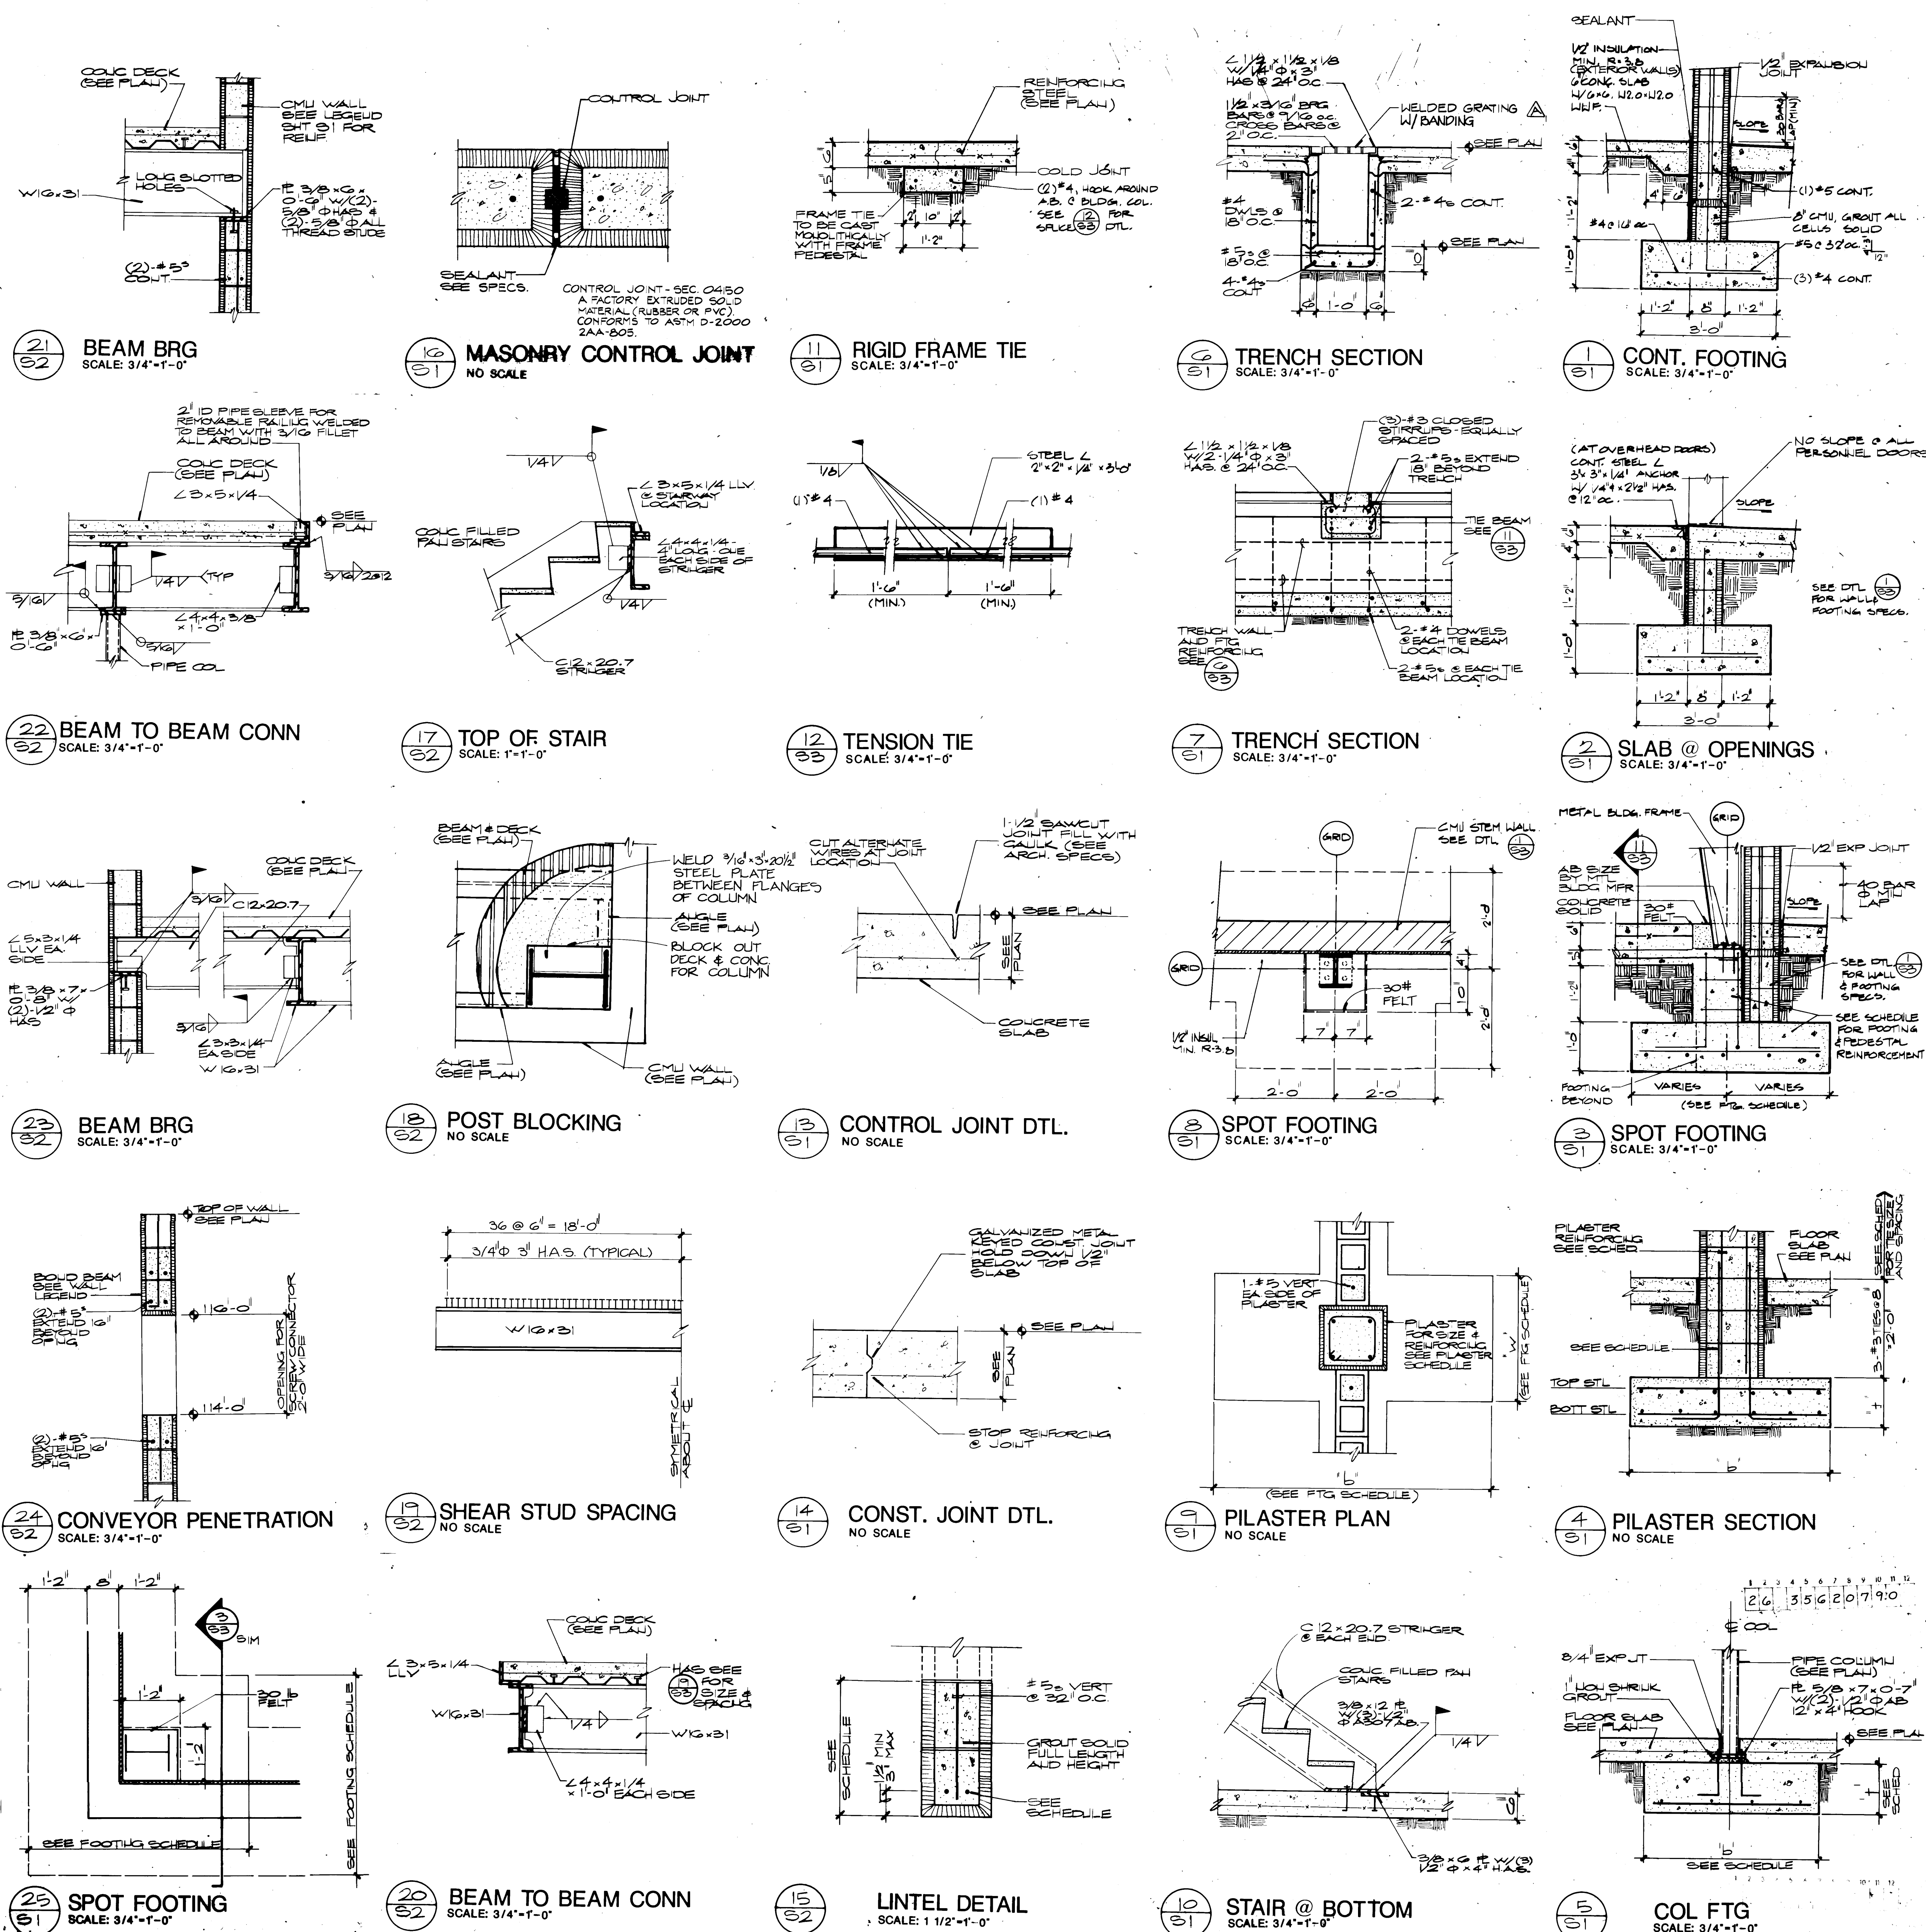


BPLW	B
Architects & Engineers, Inc.	
Americon Financial Center #5 Suite 400 2400 Louisiana Blvd NE Albuquerque New Mexico 87110 505/881-BPLW	
Designing to Shape the Future	
RECORD DRAWING	
Information shown on this document has been compiled from the construction record drawing provided to the Architect by the General Contractor, which show the reported location of changes in the work.	
By:	
BPLIN ARCHITECTS & ENGINEERS, INC.	
Date:	12/22/89
REVISION A NOVEMBER 4, 1988	
 ENGINEER	 ARCHITECT
VEHICLE STORAGE BUILDING ALBUQUERQUE INTERNATIONAL AIRPORT ALBUQUERQUE, NEW MEXICO	
CITY PROJ. NO. 3582	
PROJECT NO. 8525-23.01	DATE SEPT. 1988
STRUCTURAL DETAILS	
DRAWING NO.	SHEET OF
S3	

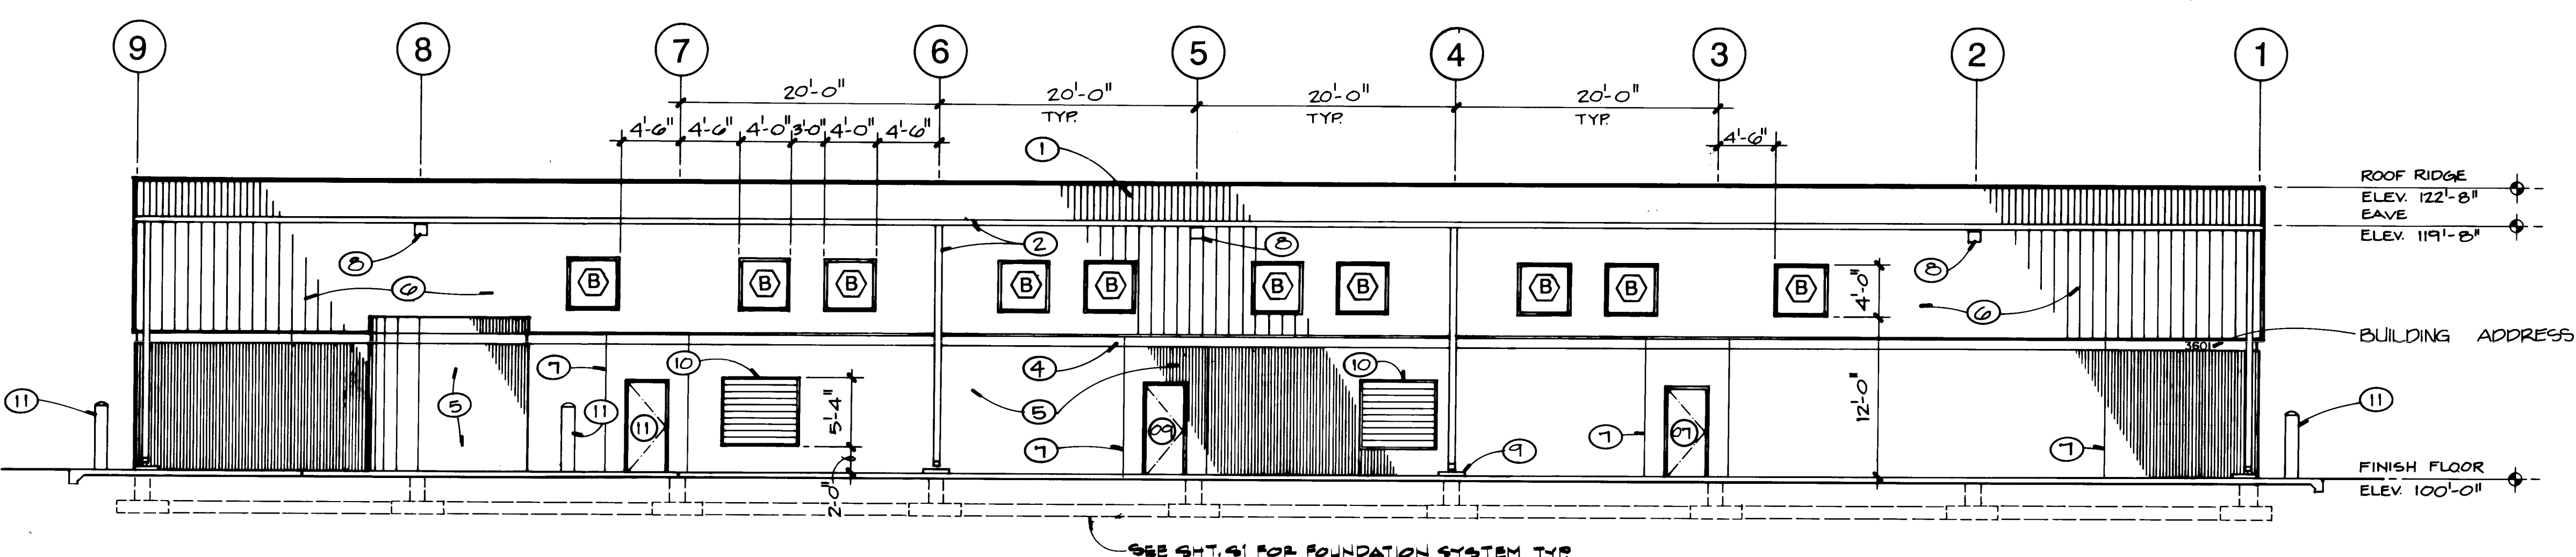


1 EAST ELEVATION
SCALE: 1/8"=1'-0"

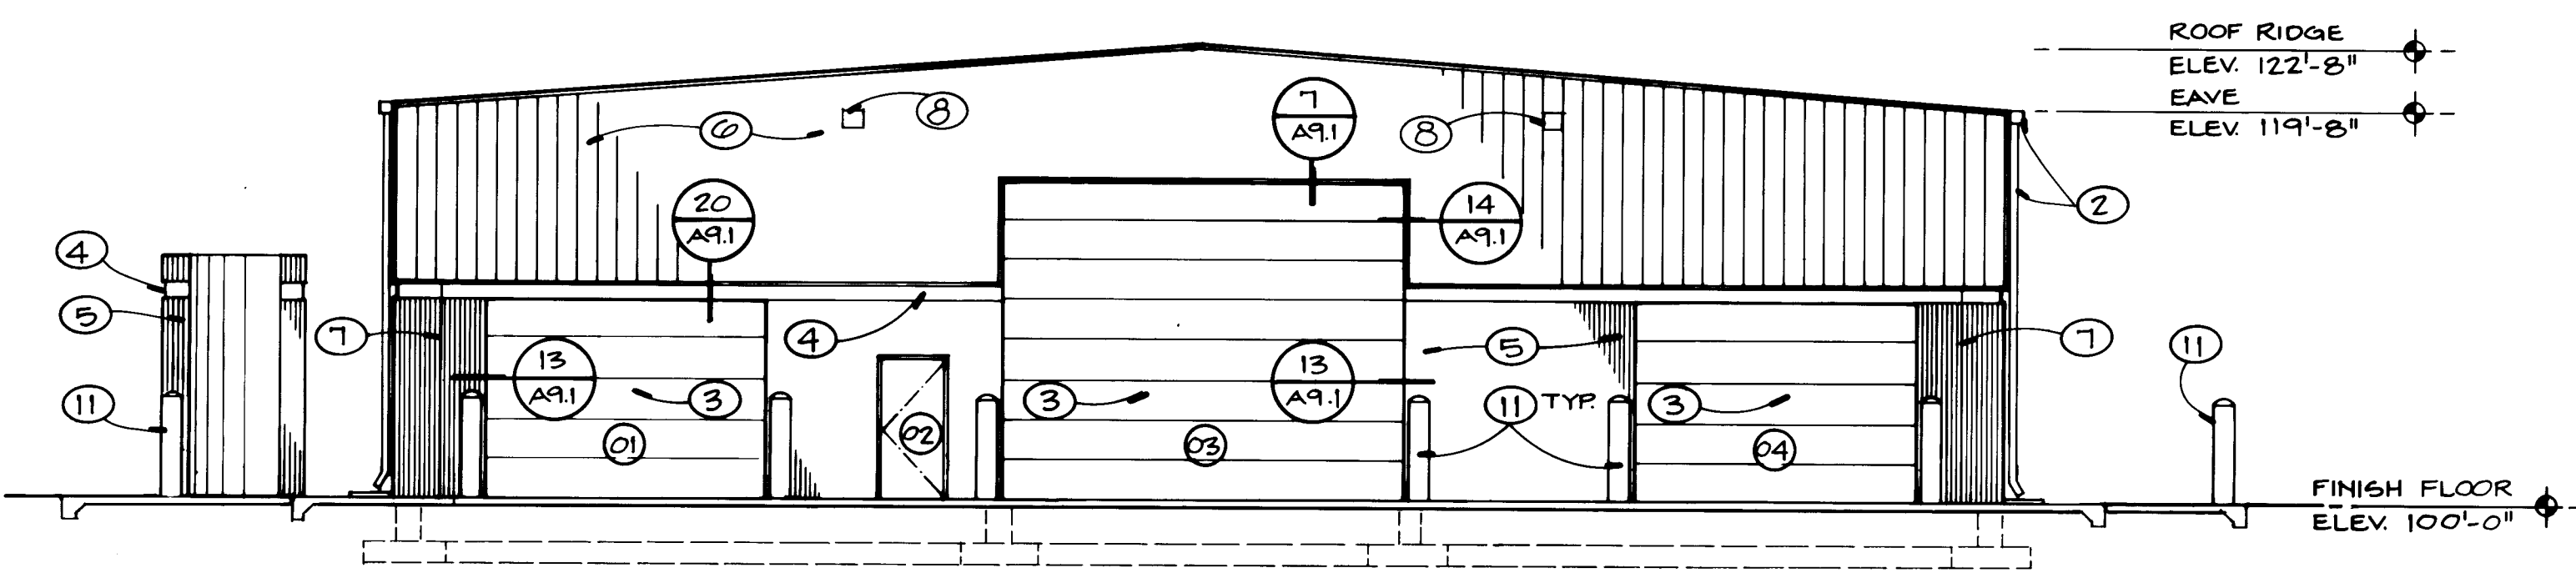

3 NORTH ELEVATION
SCALE: 1/8"=1'-0"

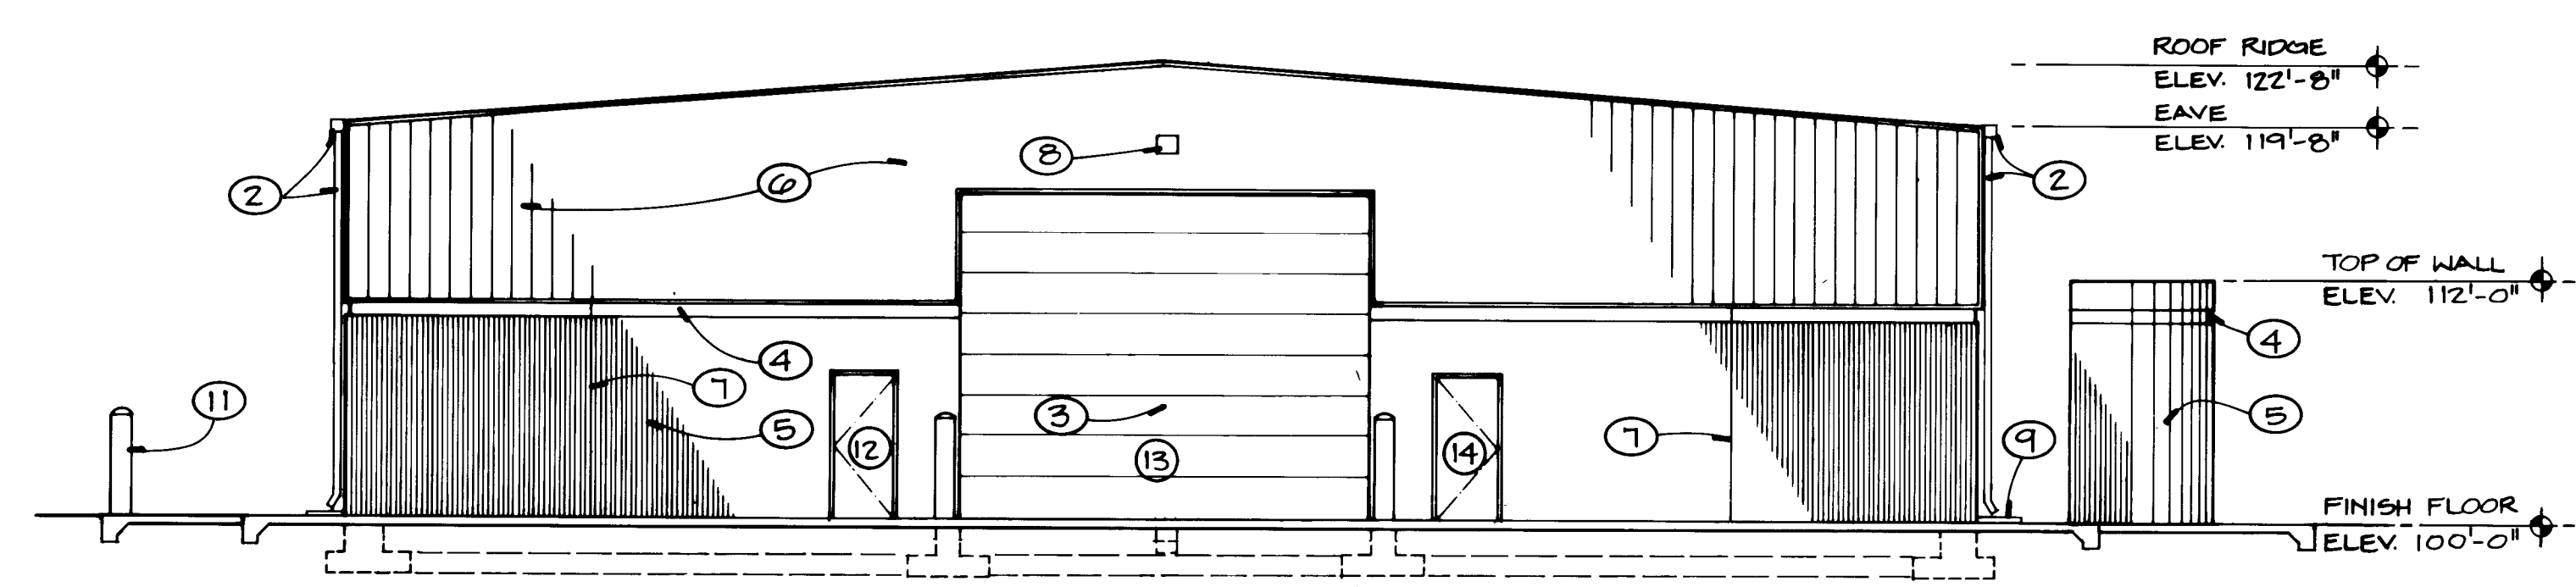


2 SOUTH ELEVATION
SCALE: 1/8"=1'-0"

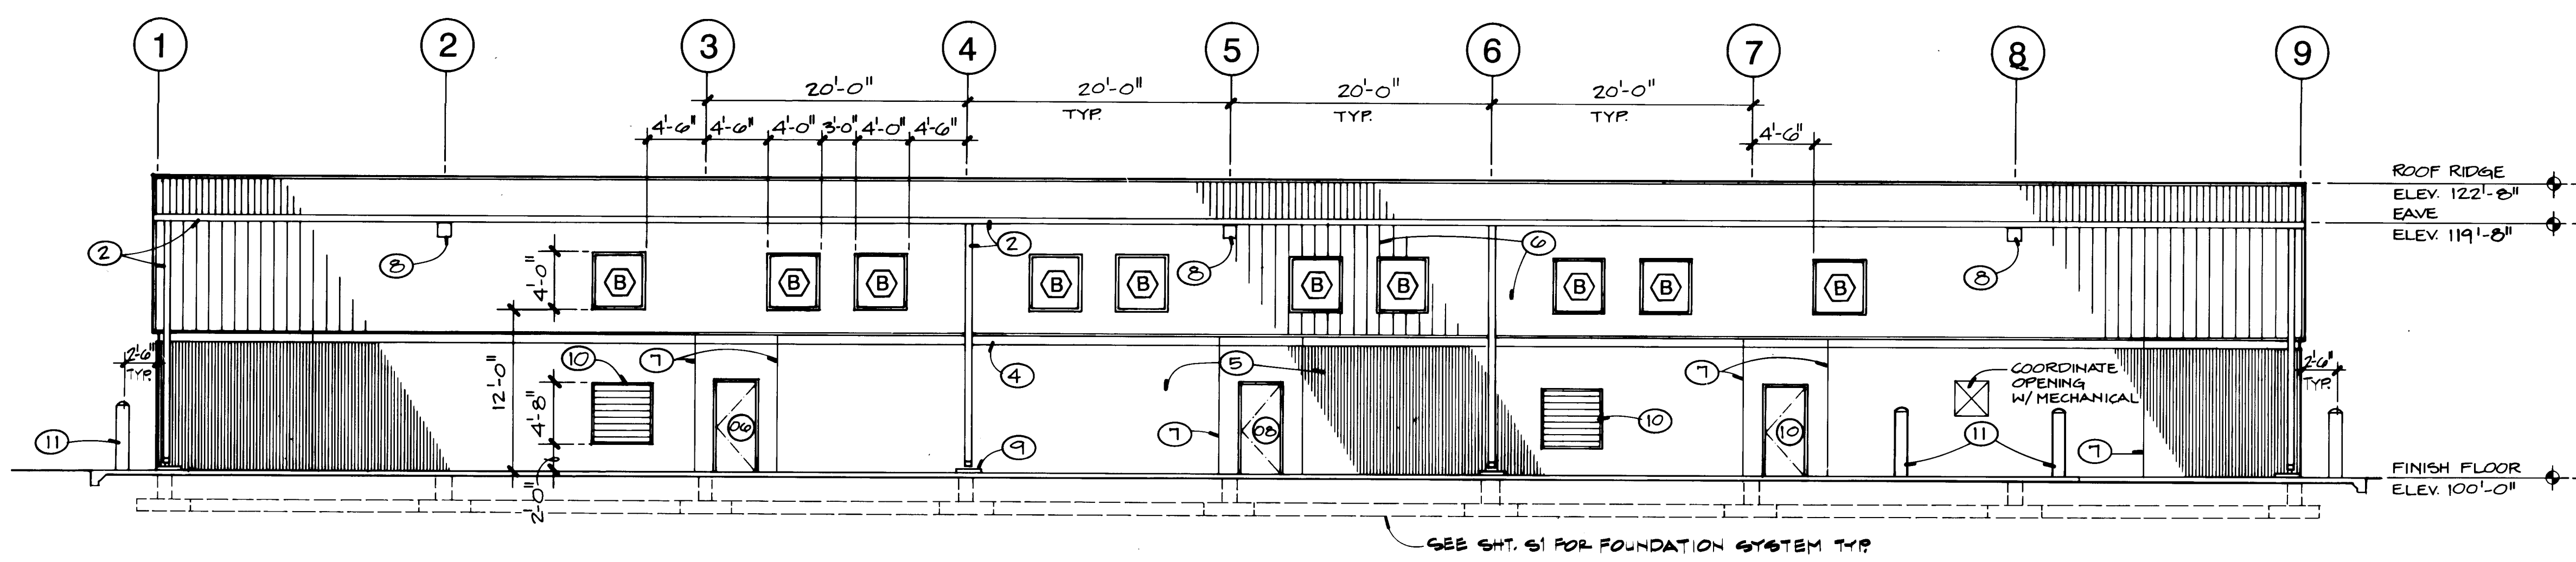

4 WEST ELEVATION
SCALE: 1/8"=1'-0"

BPLW

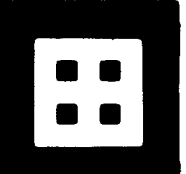

Architects & Engineers
Suite 100
2400 Central Expressway, N.E.
Albuquerque, New Mexico 87110
505.881.1111

Designing to keep the future

KEYED NOTES:

1. METAL ROOF
2. METAL GUTTER AND DOWNSPOUT
3. OVERHEAD SECTIONAL DOOR
4. CMU ACCENT STRIPE (STD. CMU)
5. RIBBED CMU
6. EXTERIOR METAL WALL PANEL
7. EXPANSION JOINT
8. LIGHT FIXTURE - SEE ELECTRICAL
9. SPLASH BLOCK - TYP. OF EIGHT
10. LOUVER - SEE MECHANICAL
11. GUARD POST - SEE CIVIL SHEET C1

RECORD DRAWING

Information shown on this document has been compiled from the construction record drawing provided to the Architect by the General Contractor, which show the reported location of changes in the work.

By: *[Signature]*
BPLW ARCHITECTS & ENGINEERS, INC.
Date: 12/22/89

1 2 3 4 5 6 7 8 9 10 11 12
26 35 62 09 90

ENGINEER


STATE OF NEW MEXICO
RONALD L. PETERSON
NO. 788
REGISTERED ARCHITECT
ARCHITECT

VEHICLE STORAGE BUILDING
ALBUQUERQUE INTERNATIONAL AIRPORT
ALBUQUERQUE, NEW MEXICO


CITY PROJ. NO. 3582
PROJECT NO. 8525-23.01
DATE SEPT. 1988

ELEVATIONS


(DRAWING NO.)
A5.1
SHEET OF

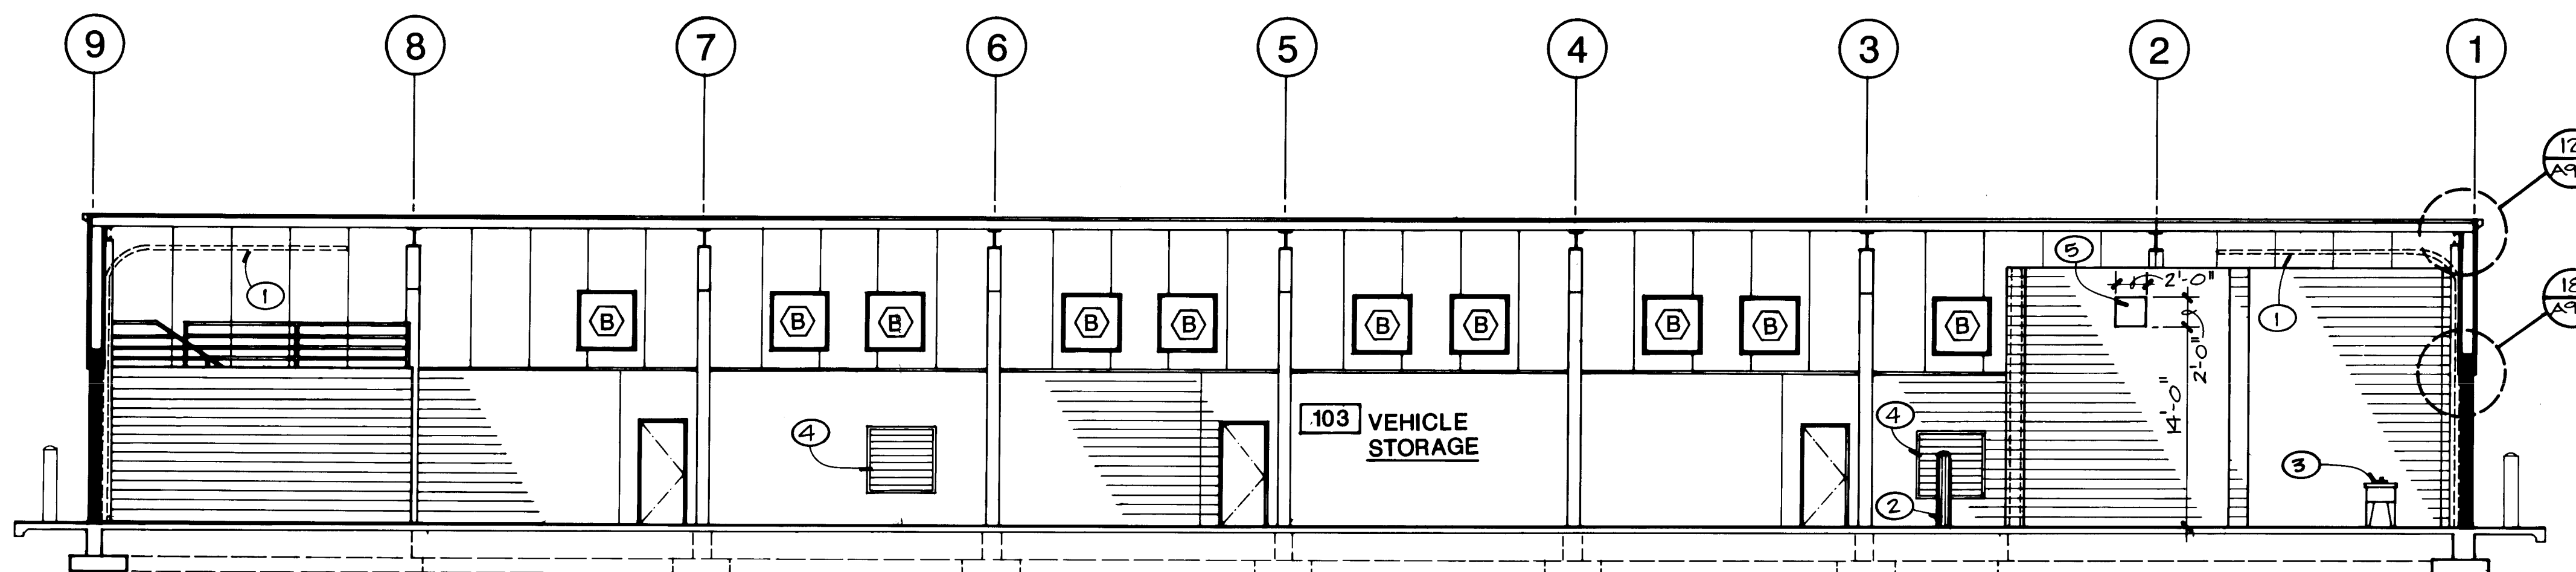


A
SECTION
SCALE: 1/8"=1'-0"

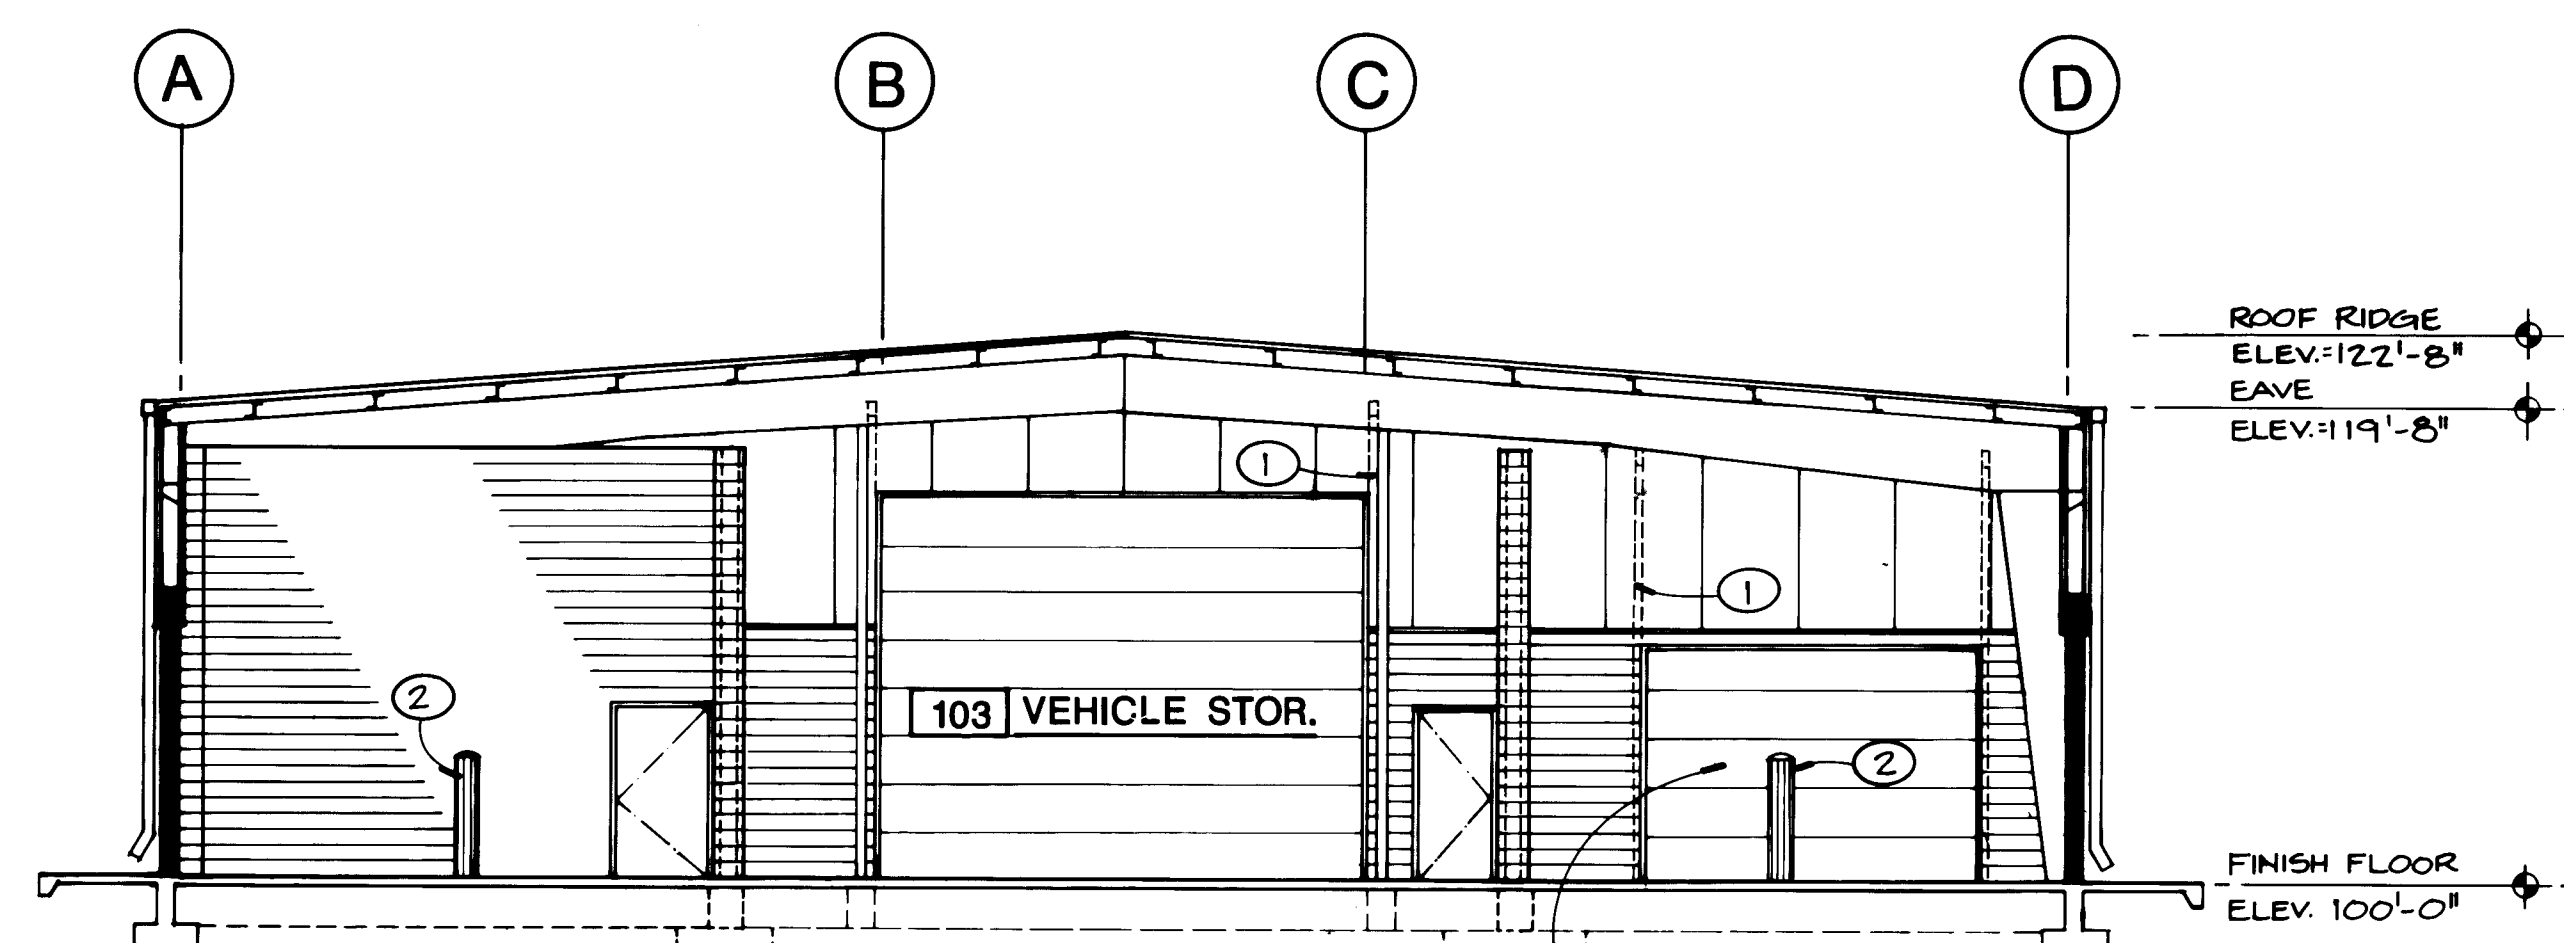

C
SECTION
SCALE: 1/8"=1'-0"

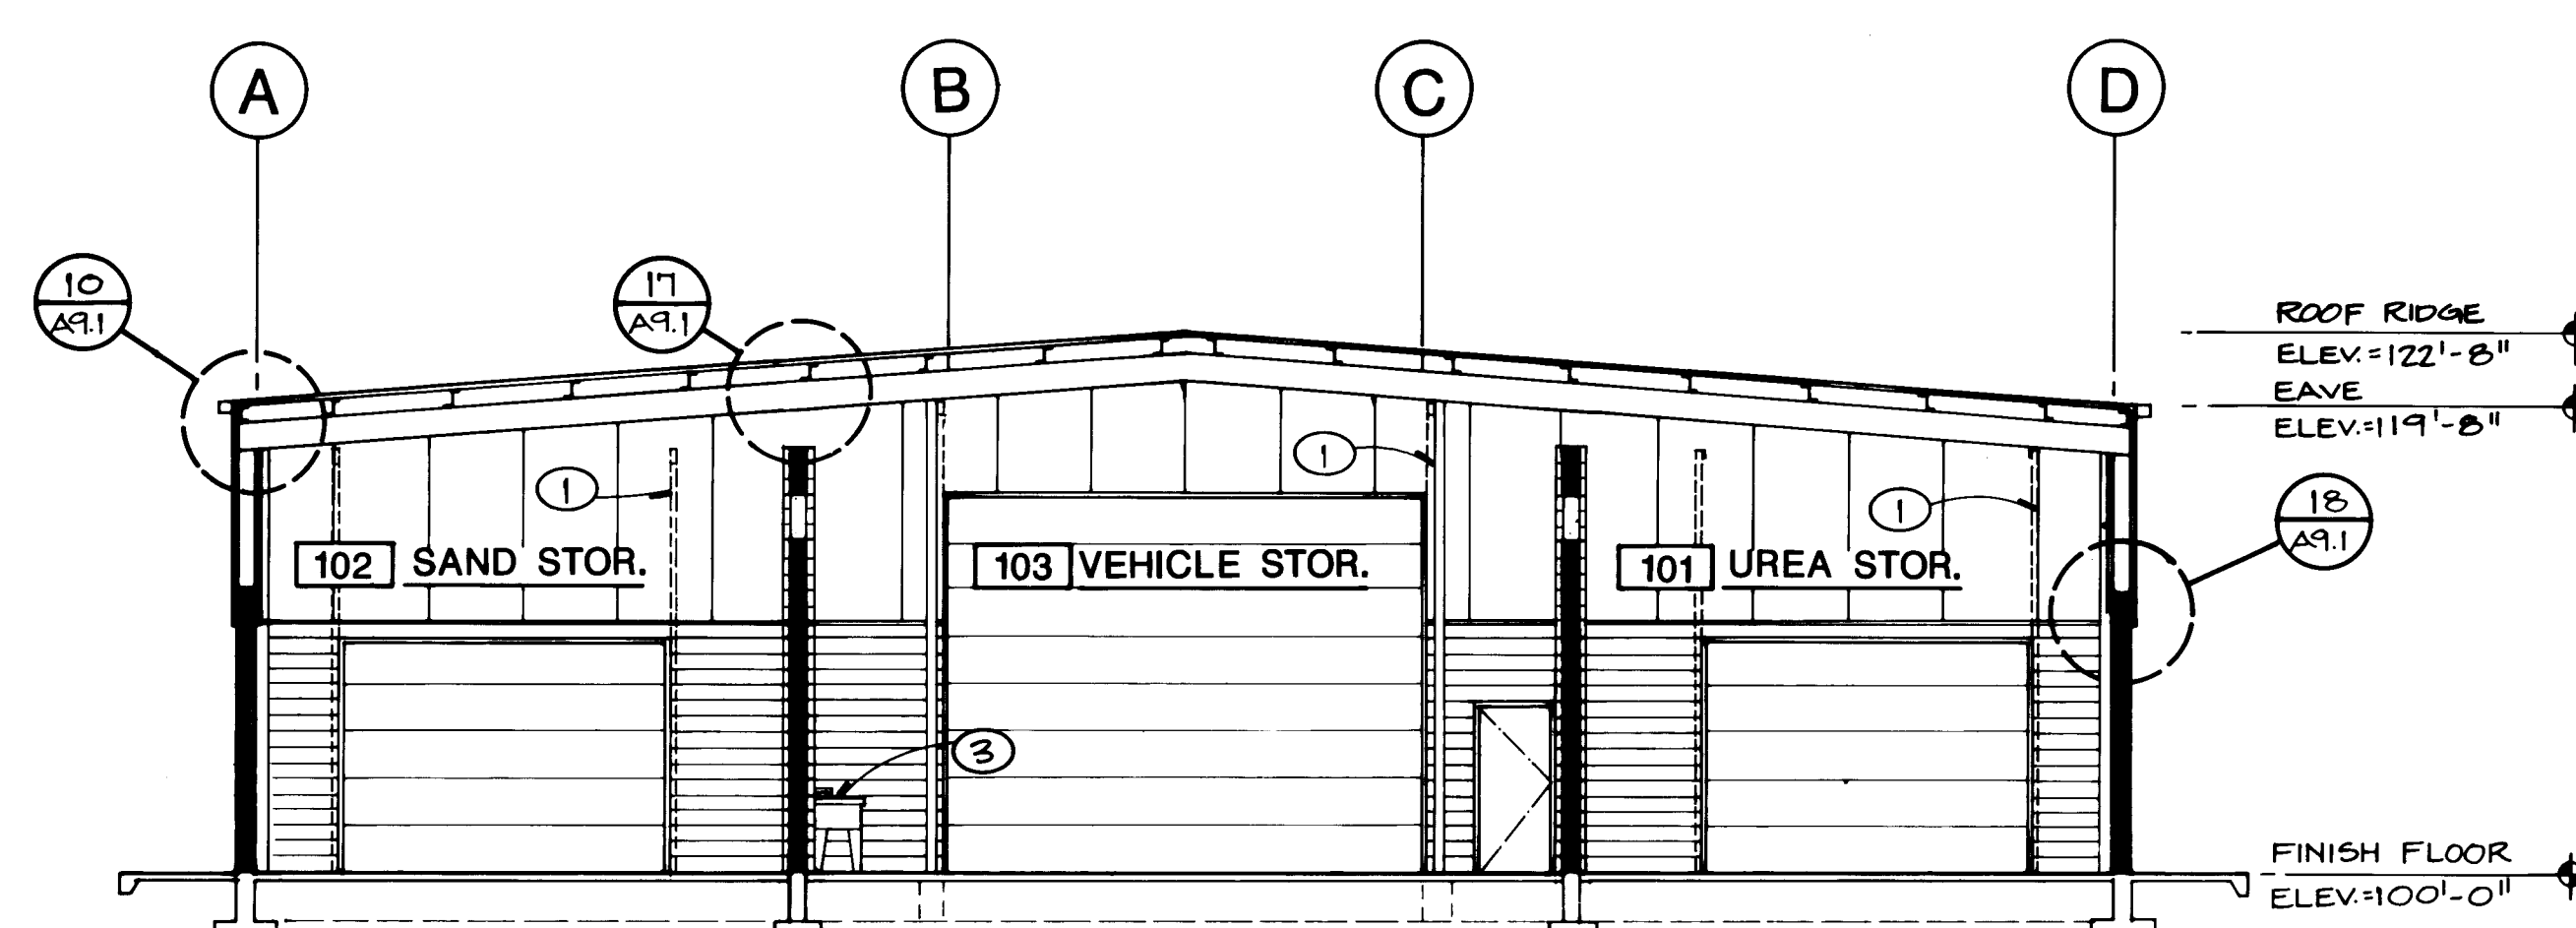

B
SECTION
SCALE: 1/8"=1'-0"

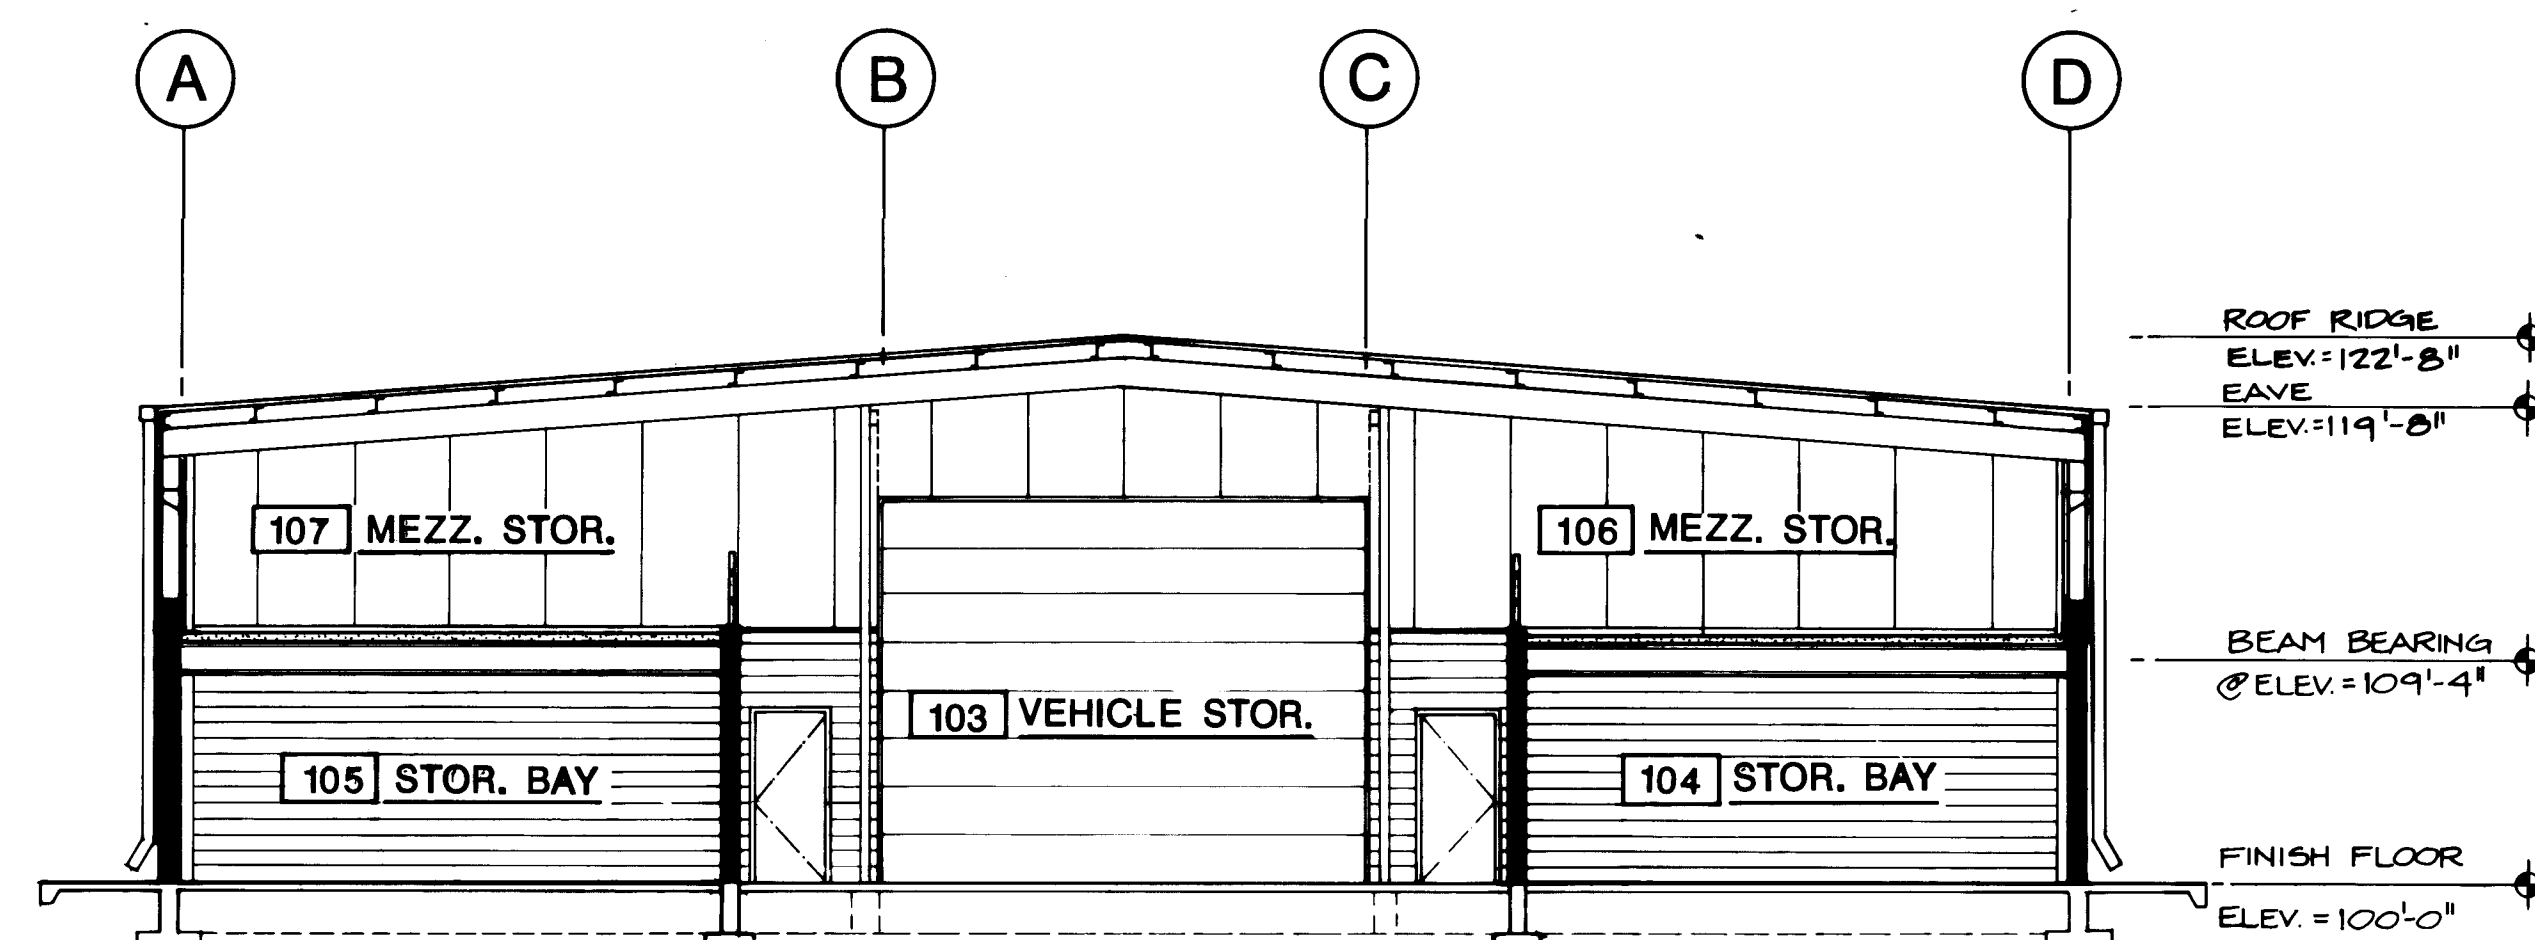

D
SECTION
SCALE: 1/8"=1'-0"

BPLW

ARCHITECTS & ENGINEERS, INC.
10000 10TH AVENUE, N.E.
ALBUQUERQUE, NEW MEXICO 87111
TEL: 845-2301 FAX: 845-2302

Designing to help the future

KEYED NOTES: ○

1. TRACK FOR OVERHEAD DOOR.
2. GUARD POST - SEE PLAN FOR EXACT LOCATION.
3. SERVICE SINK - SEE MECHANICAL.
4. LOUVERS - SEE MECHANICAL.
5. OPENING IN CMU WALL FOR SCREW CONVEYOR.


RECORD DRAWING

Information shown on this document has been compiled from the construction record drawing provided to the Architect by the General Contractor, which show the reported location of changes in the work.

By: *[Signature]*
BPLW ARCHITECTS & ENGINEERS, INC.
Date: 12/22/89

26 35621090

ENGINEER

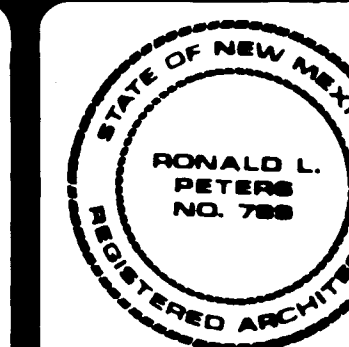

ARCHITECT

VEHICLE STORAGE BUILDING
ALBUQUERQUE INTERNATIONAL AIRPORT
ALBUQUERQUE, NEW MEXICO








CITY PROJ. NO. 3582

PROJECT NO. 8525-23.01 DATE SEPT. 1988

BUILDING SECTIONS

DRAWING NO.


A5.2
SHEET OF

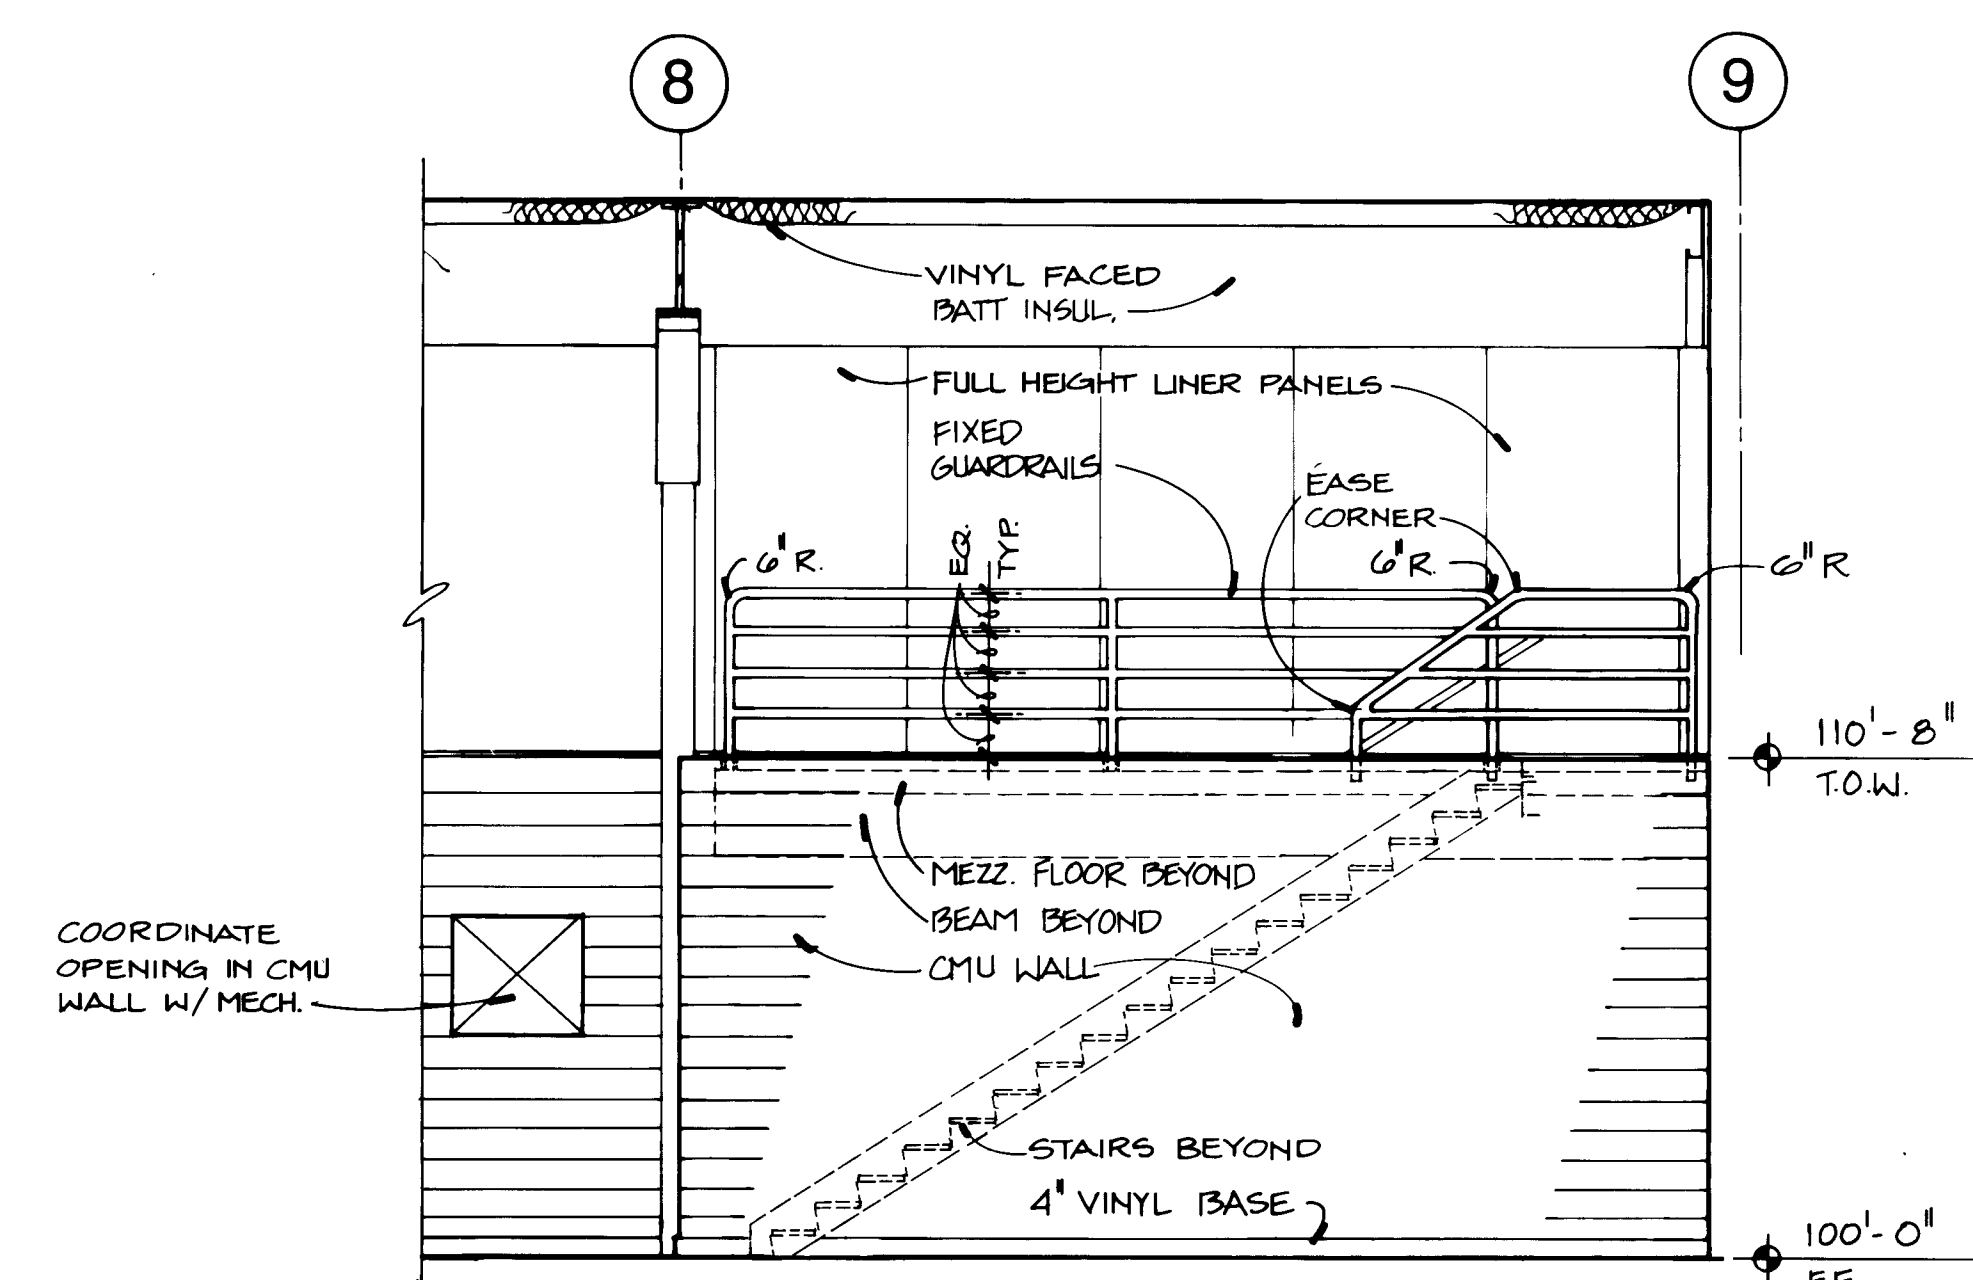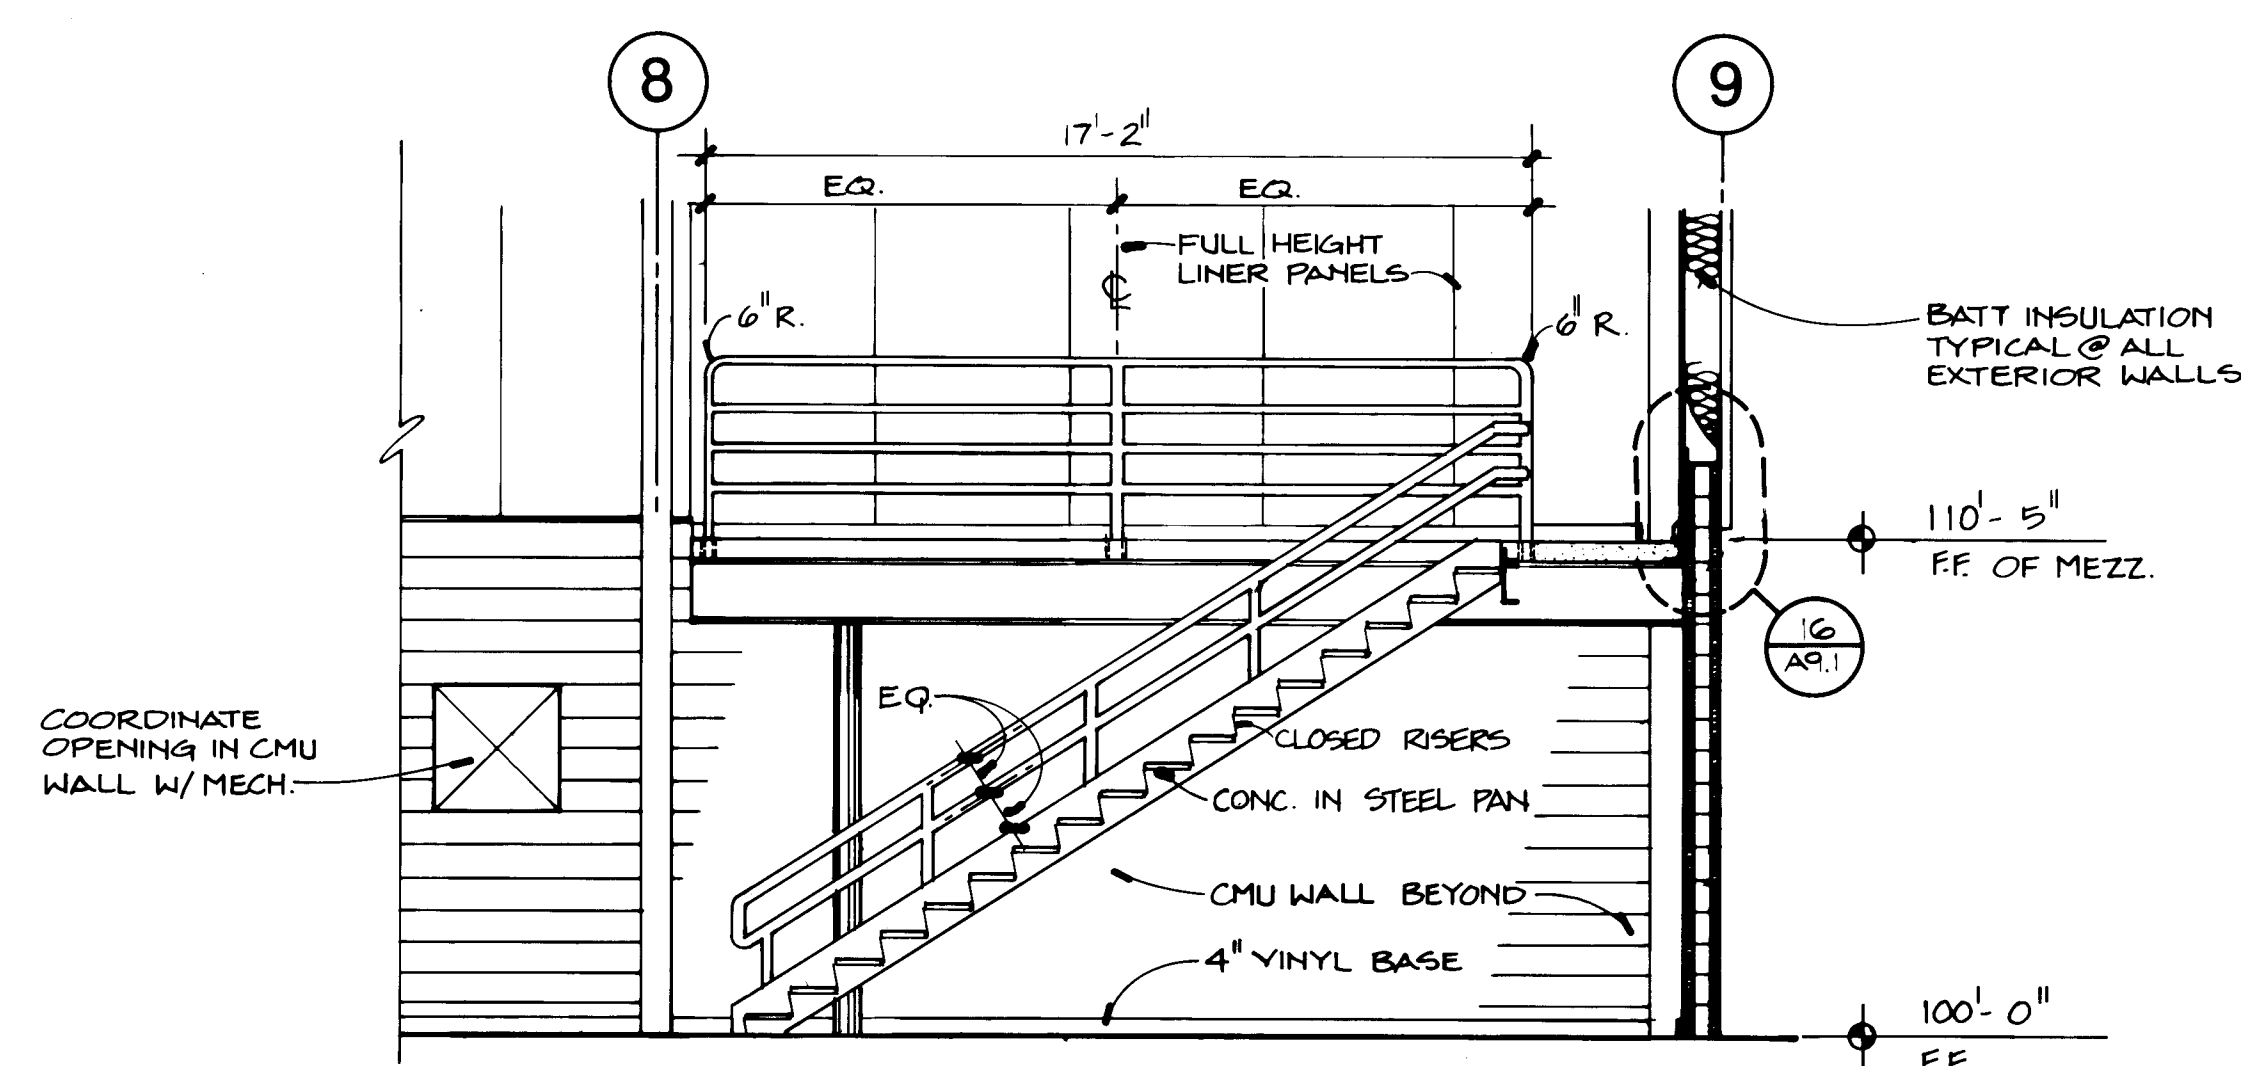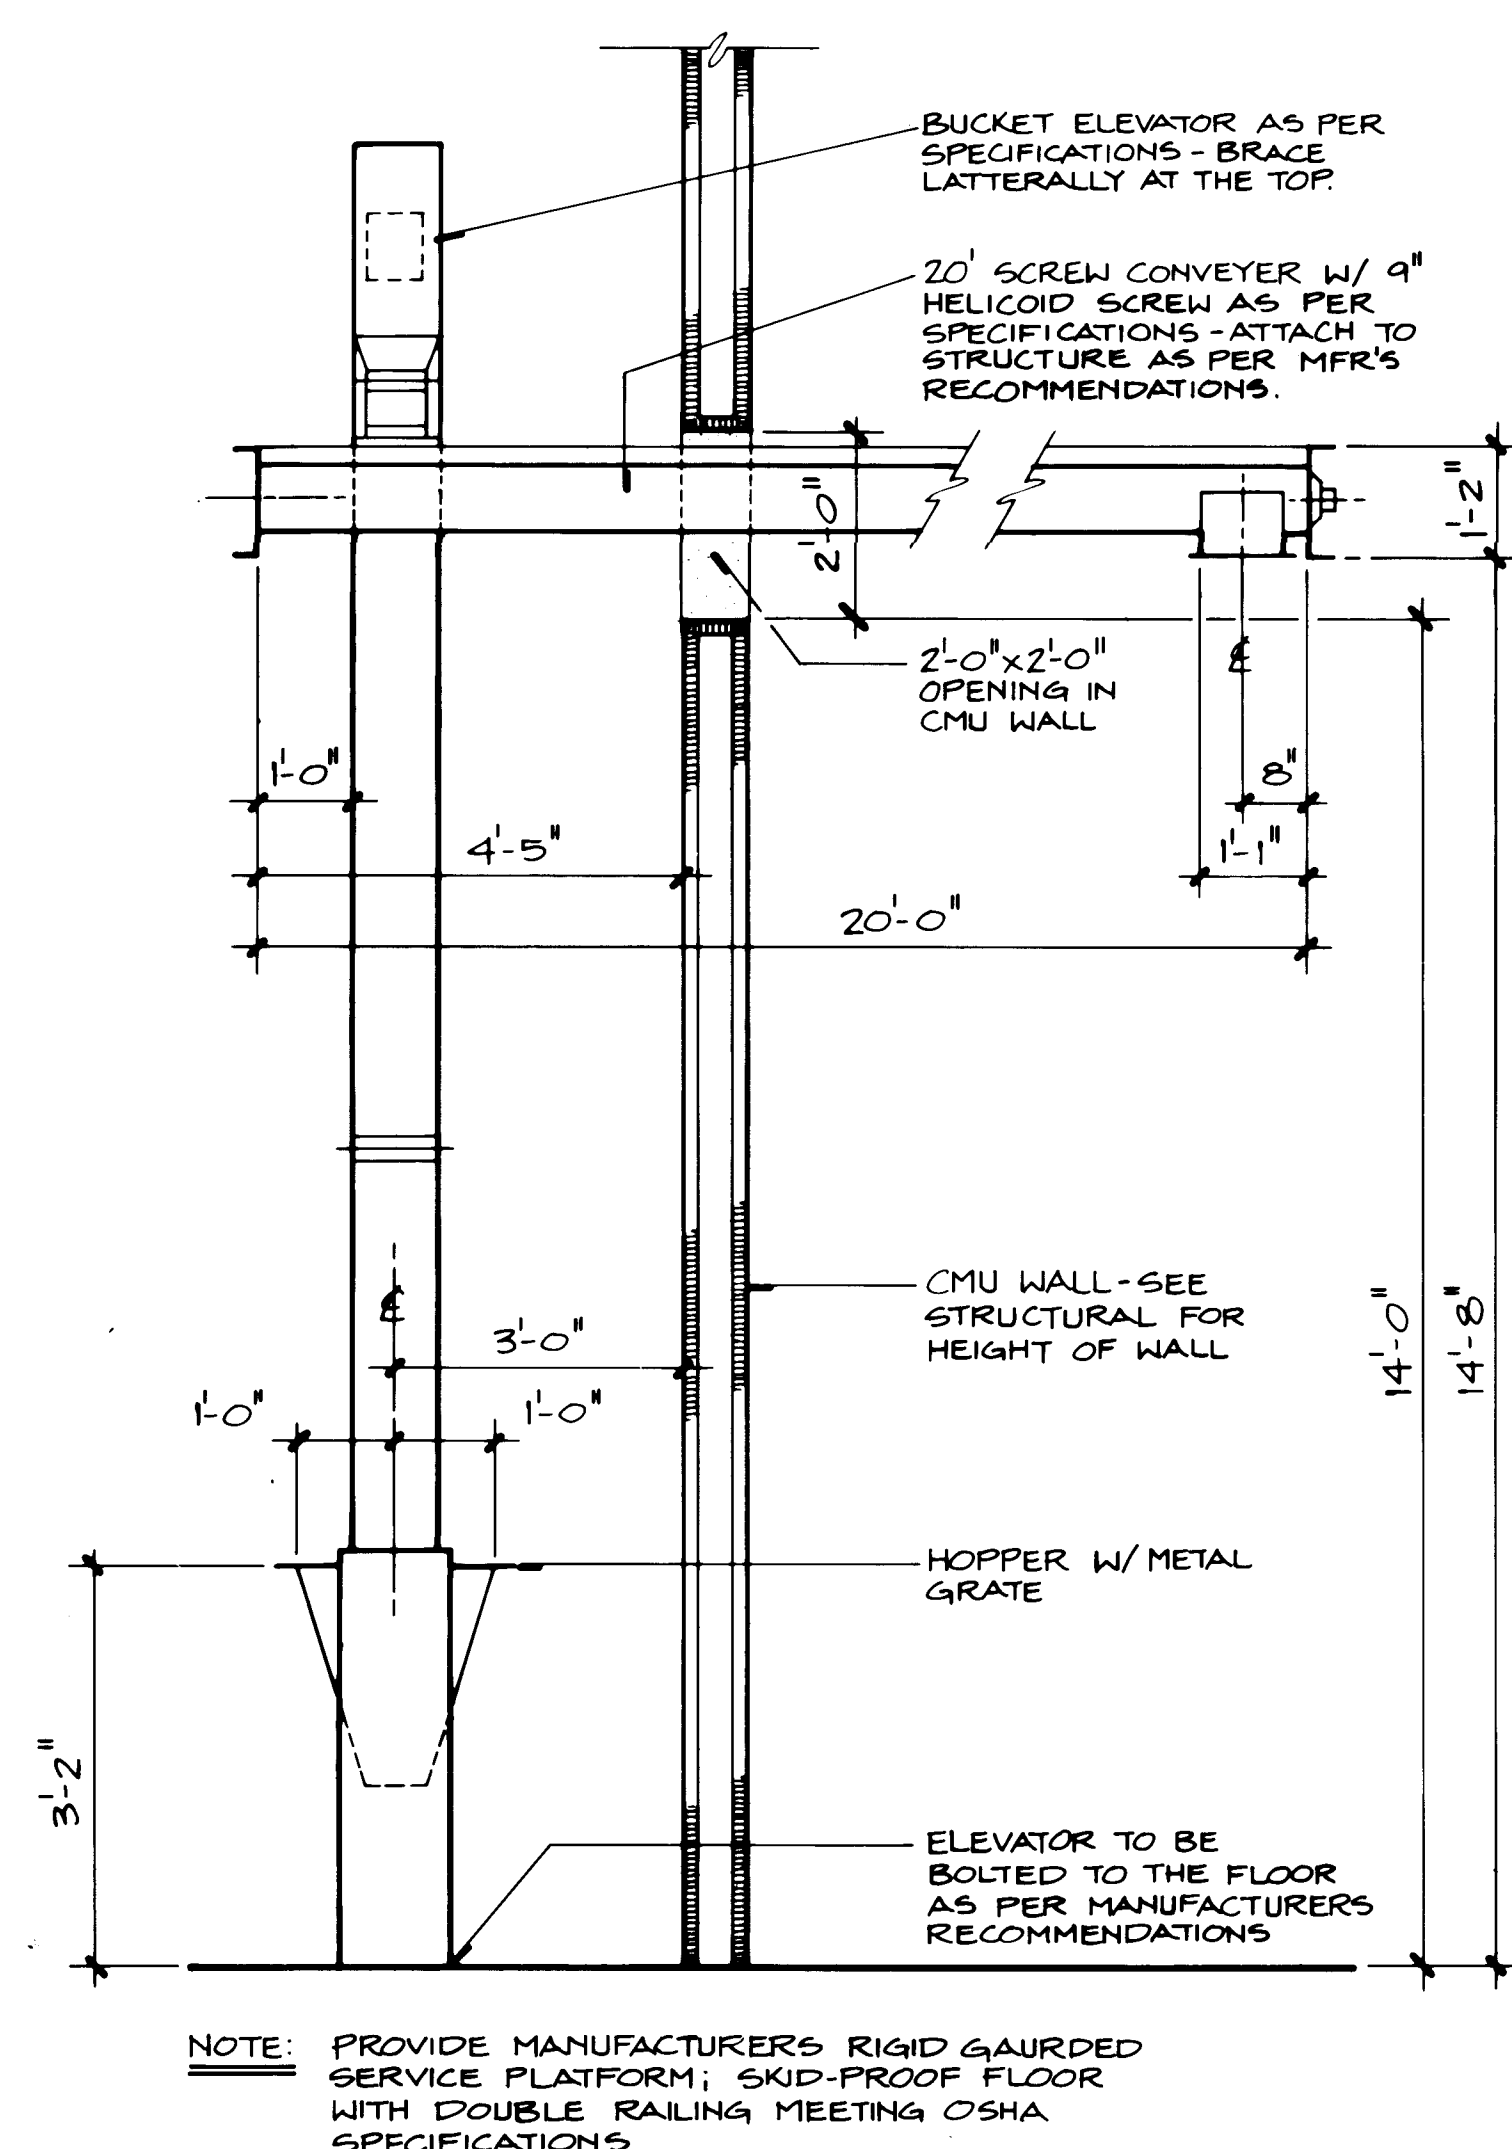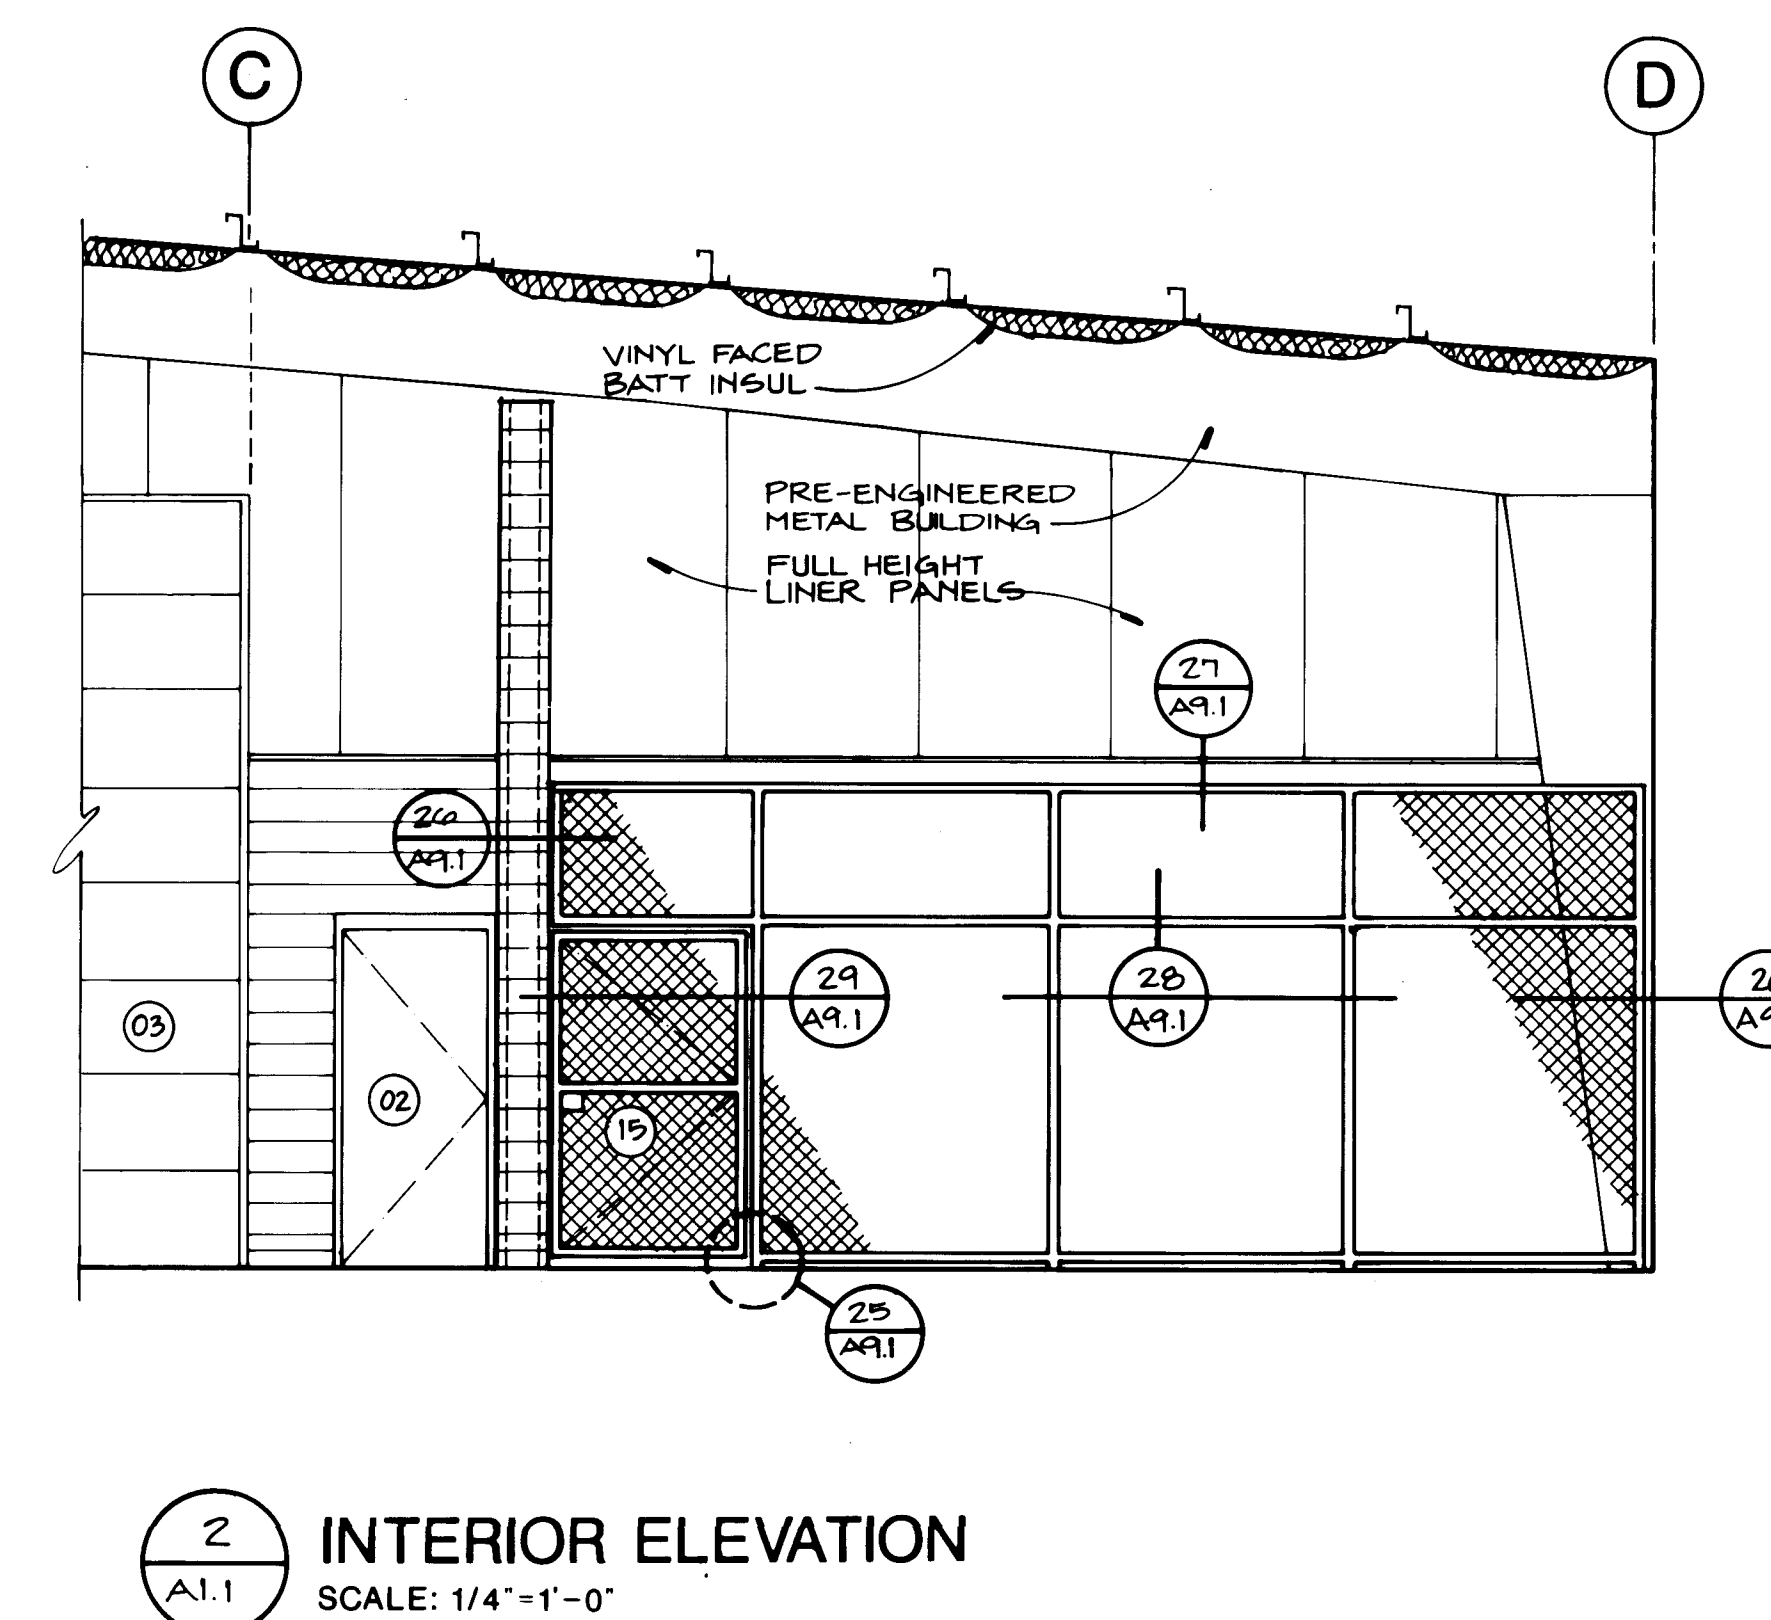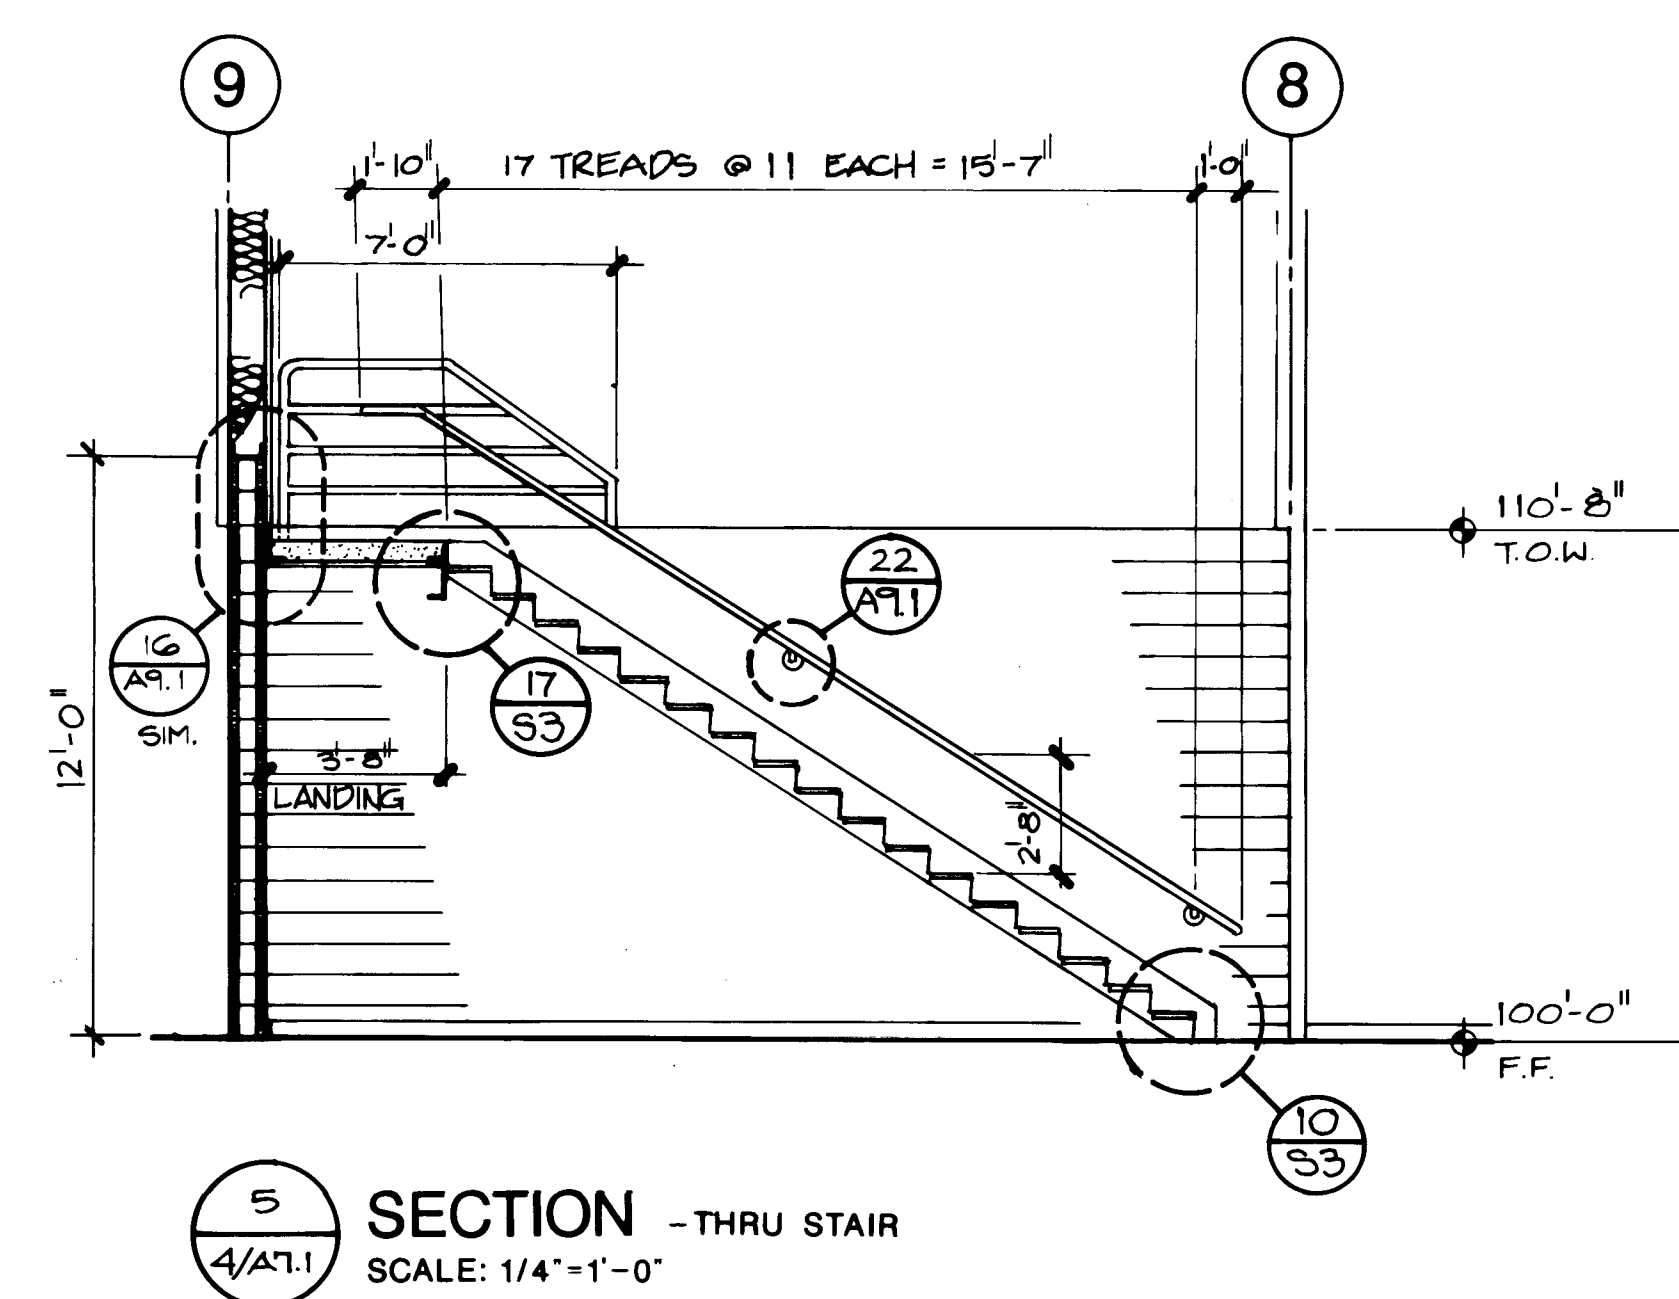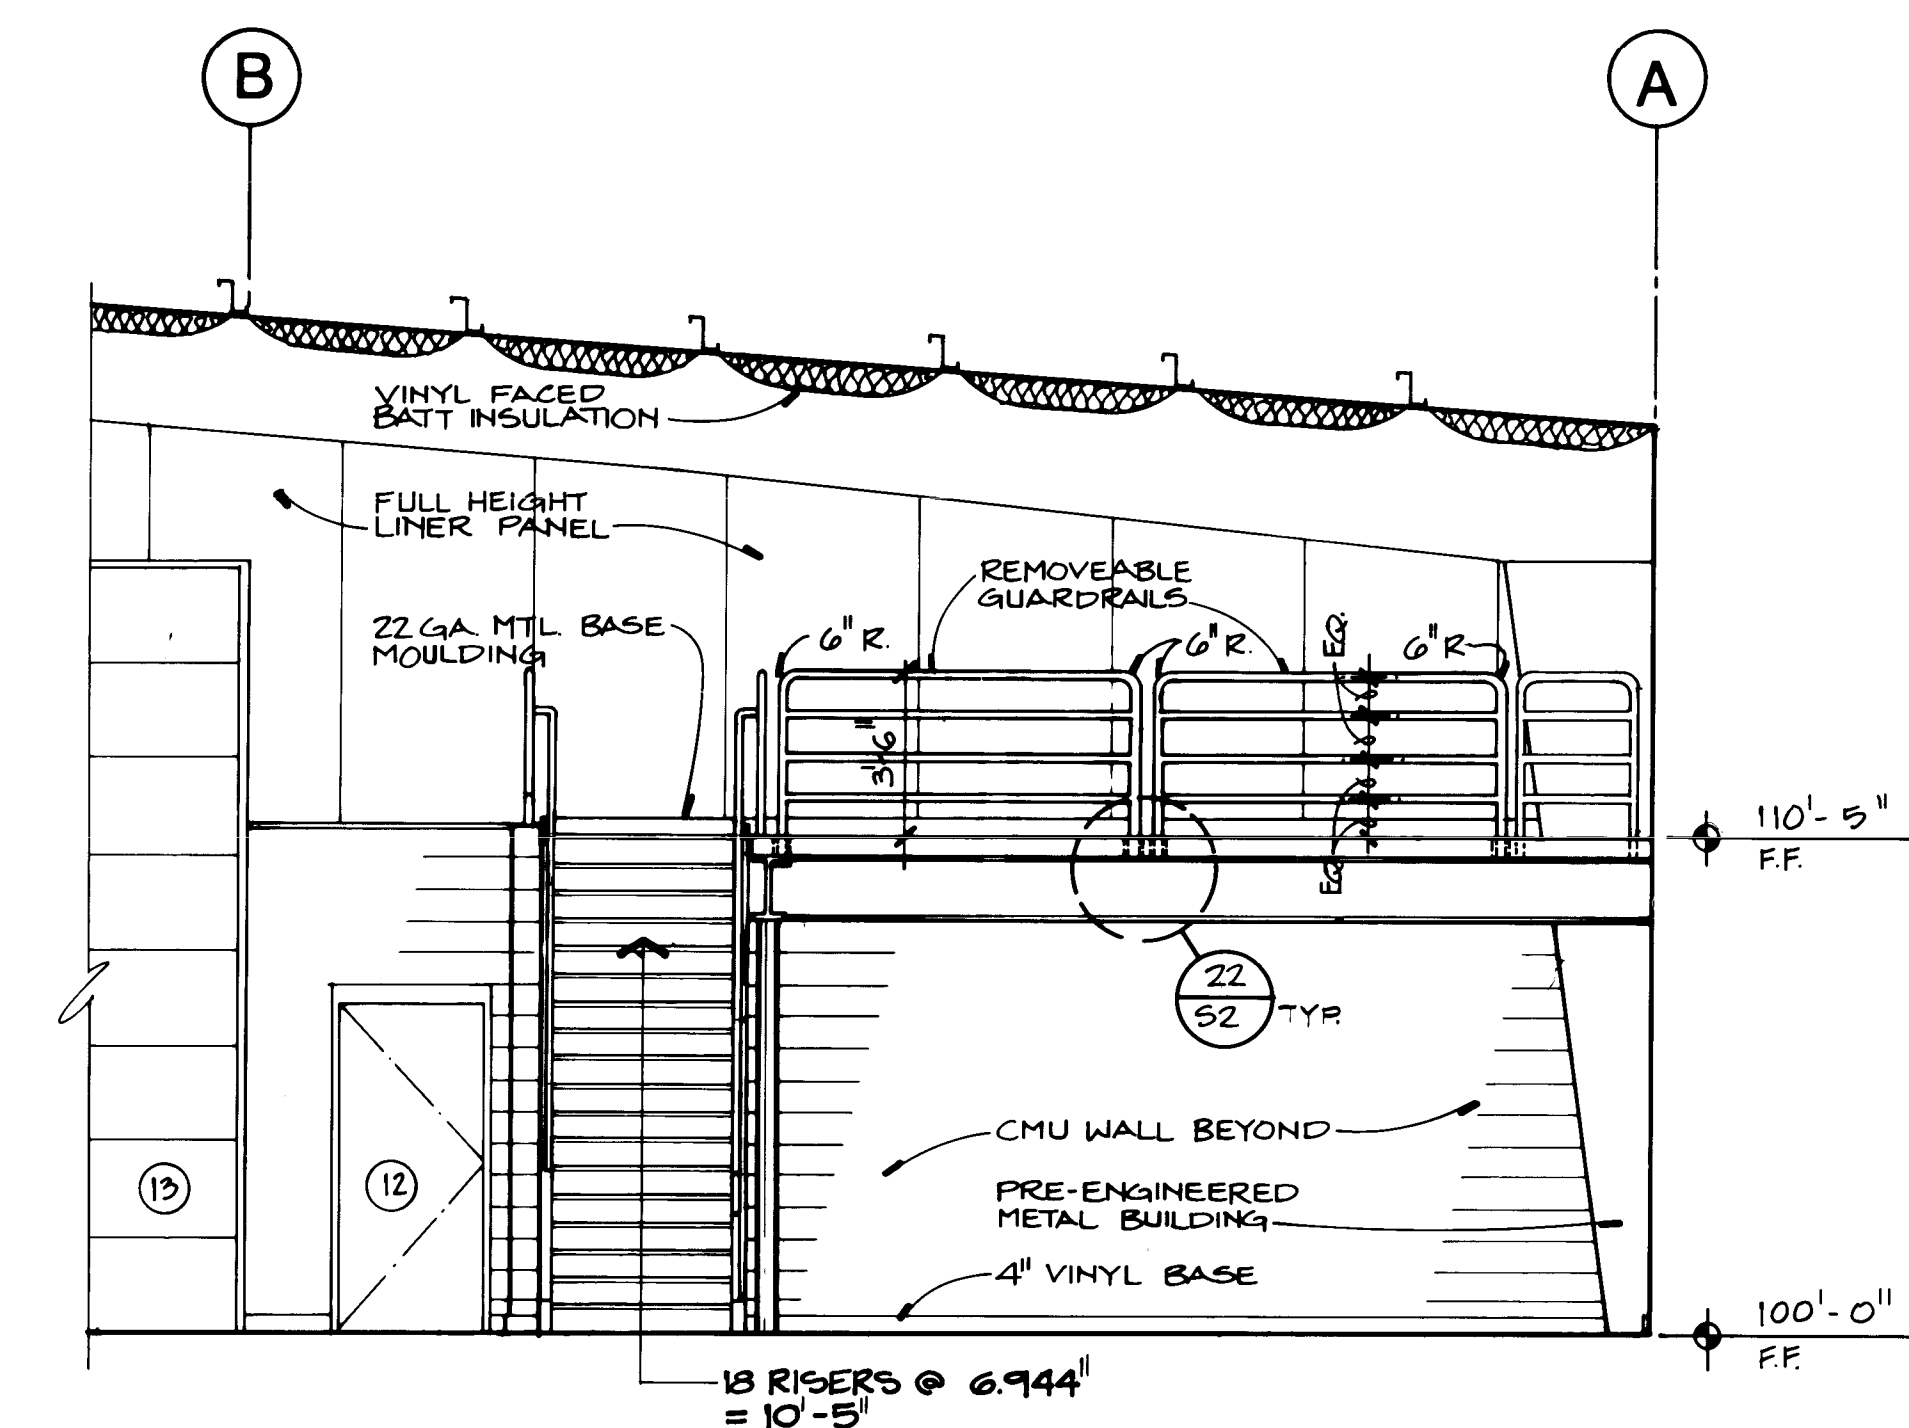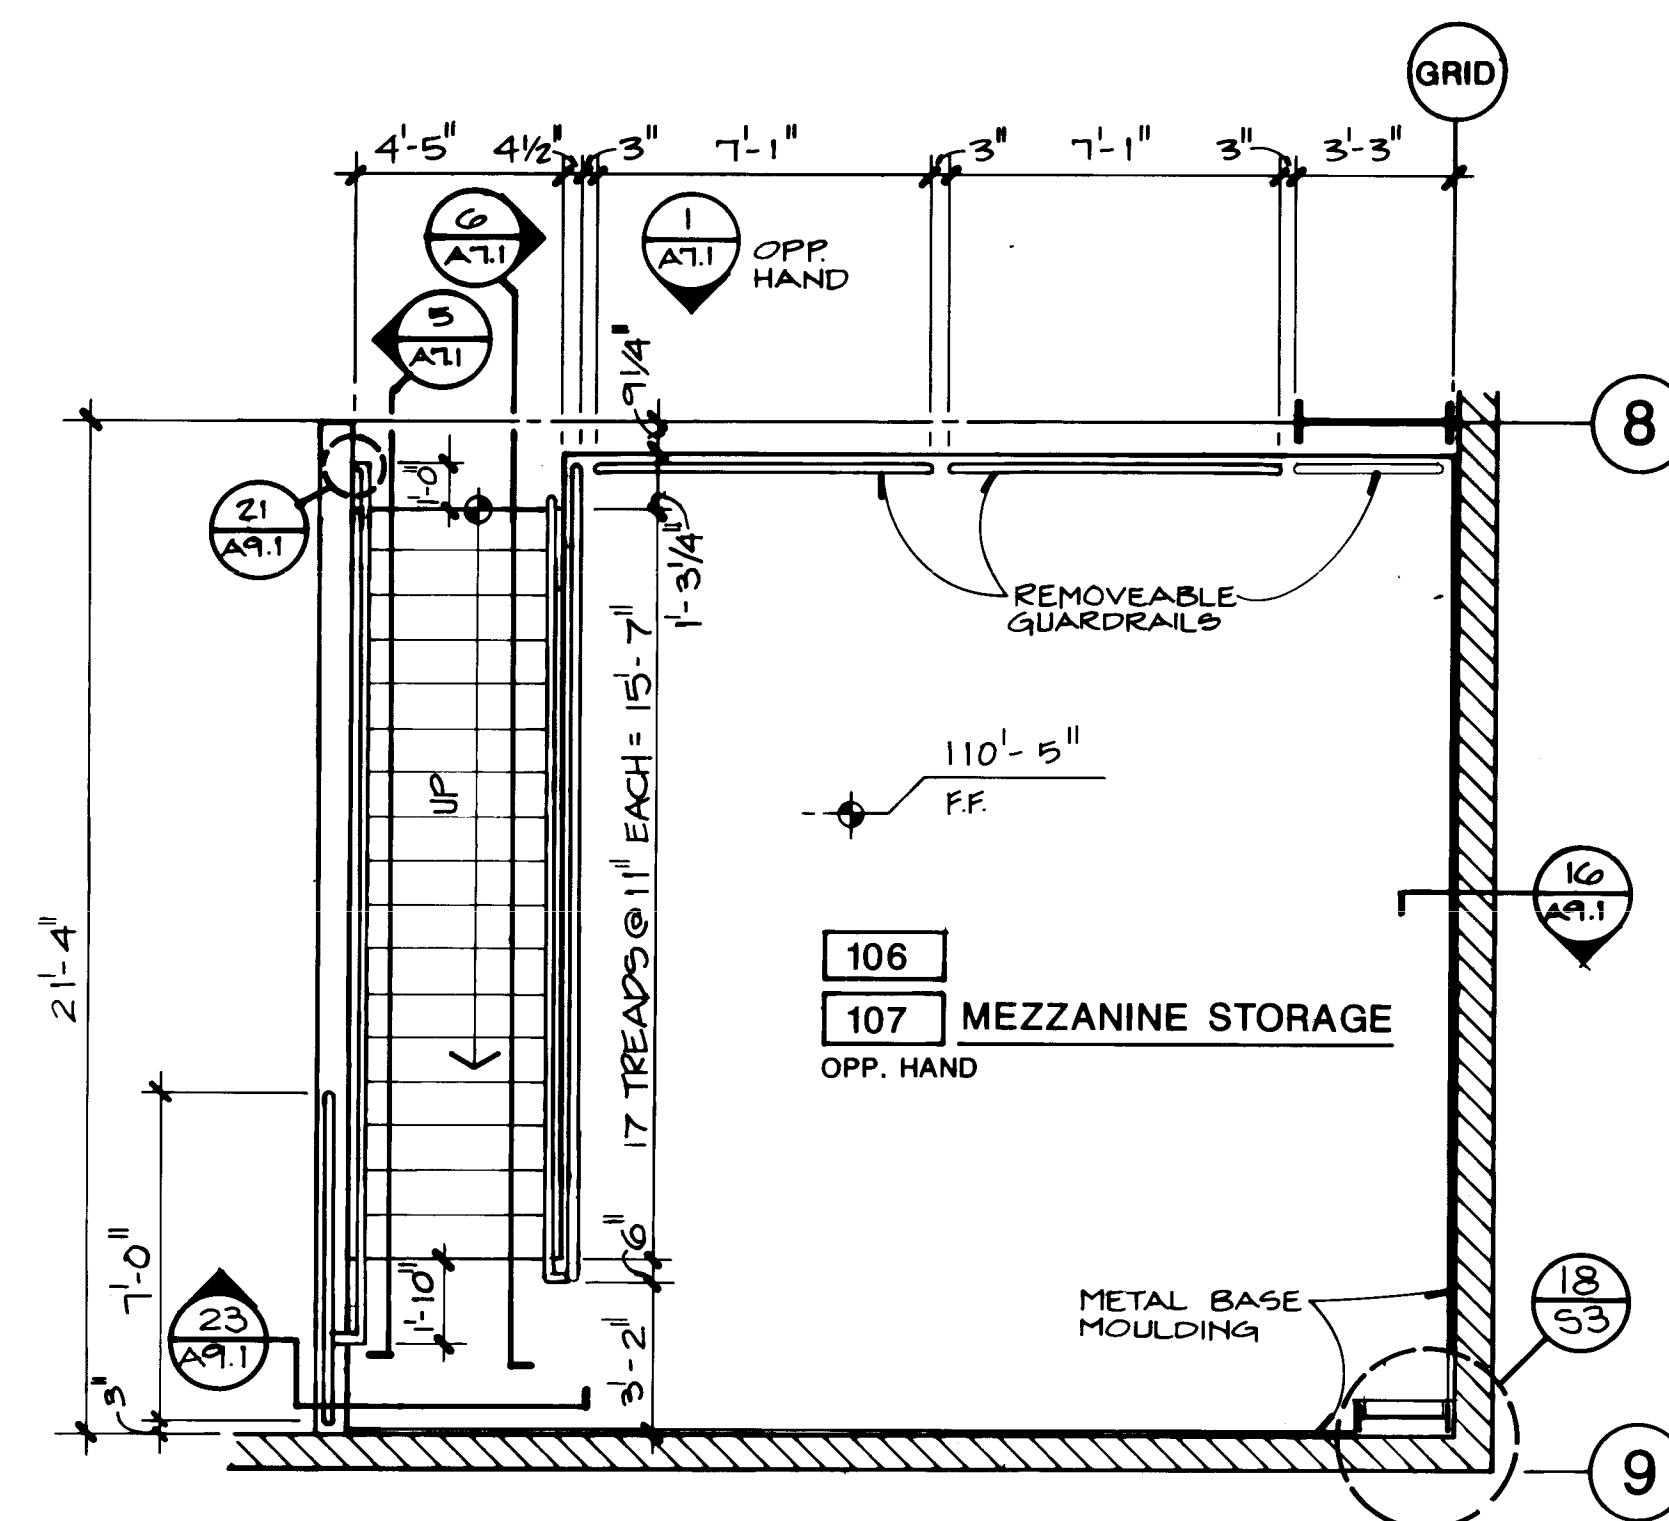


RECORD DRAWING

Information shown on this document has been compiled from the construction record drawing provided to the Architect by the General Contractor, which show the reported location of changes in the work.


By: T. J. Mc
BPLW ARCHITECTS & ENGINEERS, INC.
Date: 12/22/89

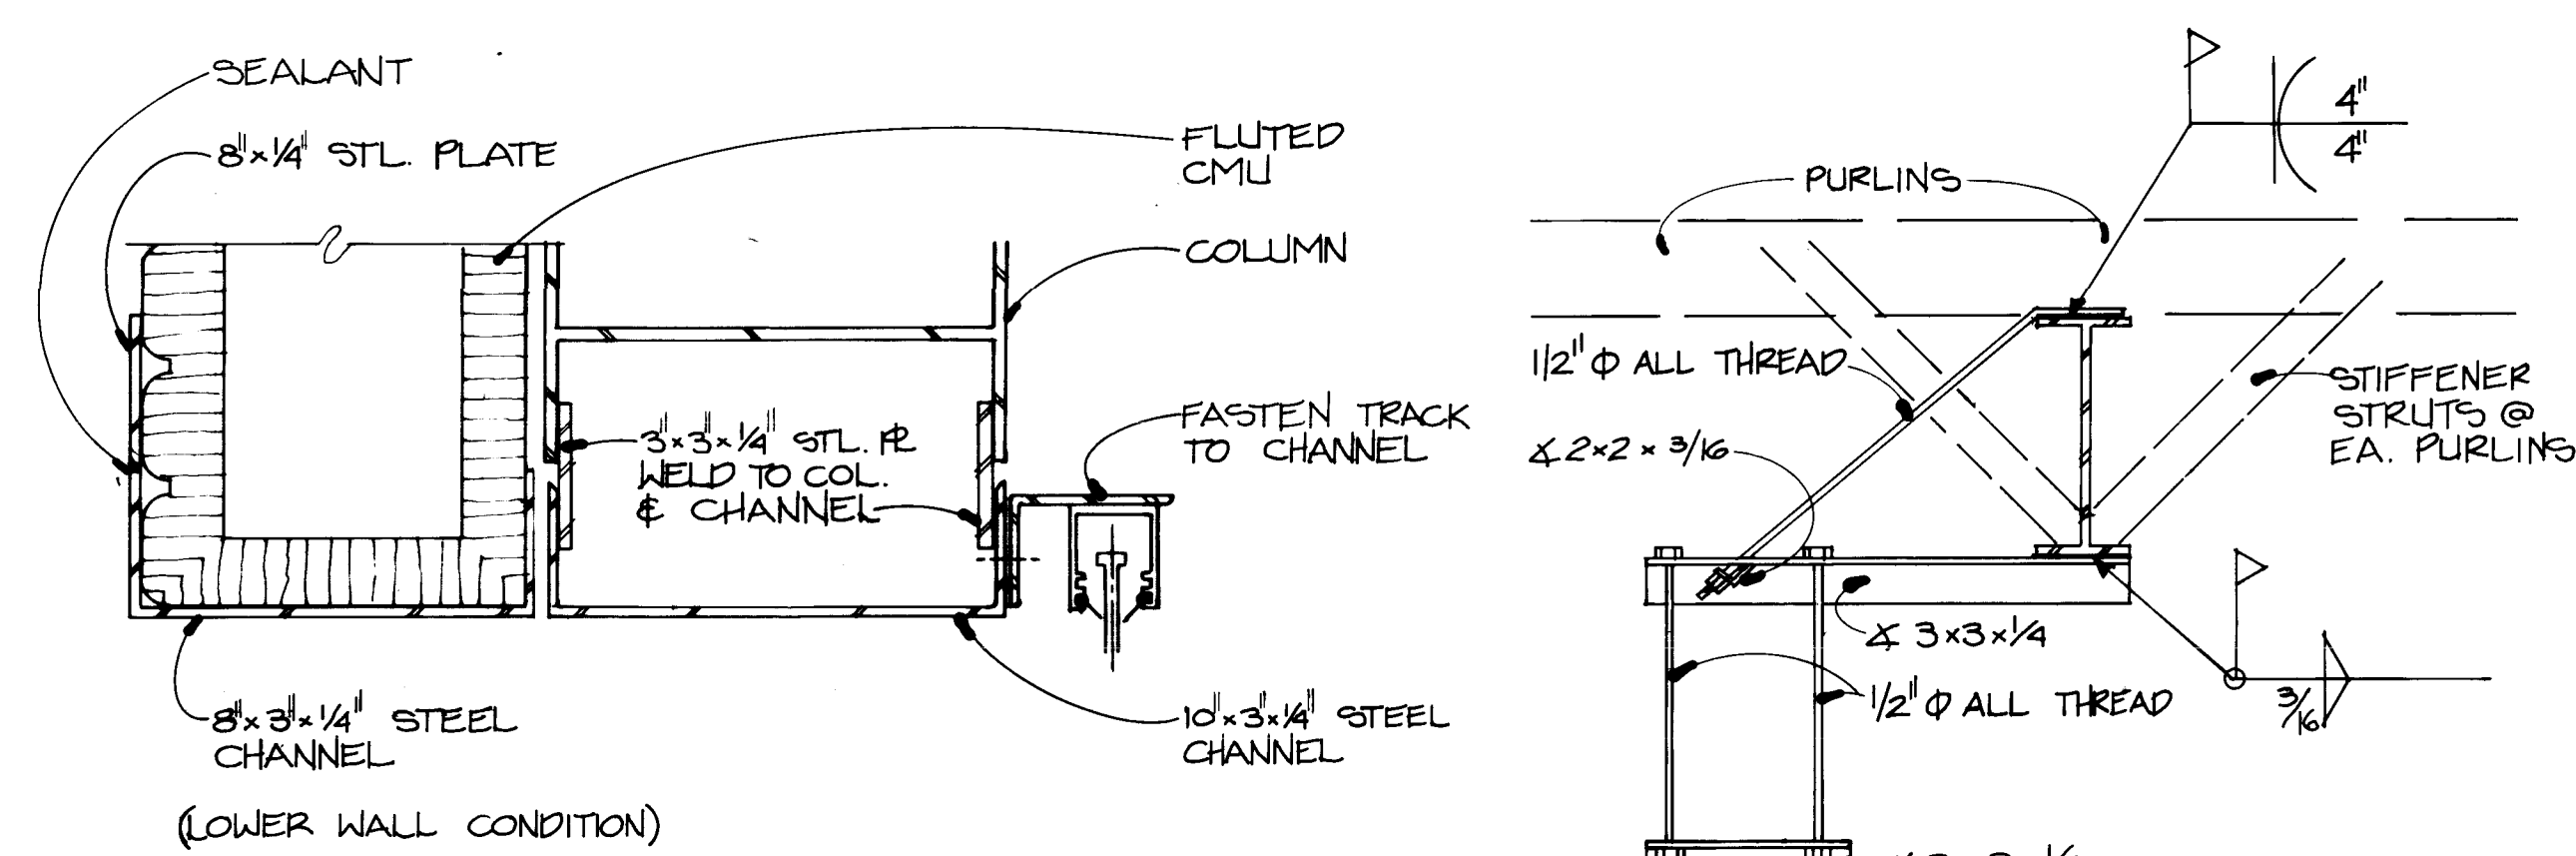


5 JAMB-OVERHEAD DOOR
SCALE: 3'-1'-0"

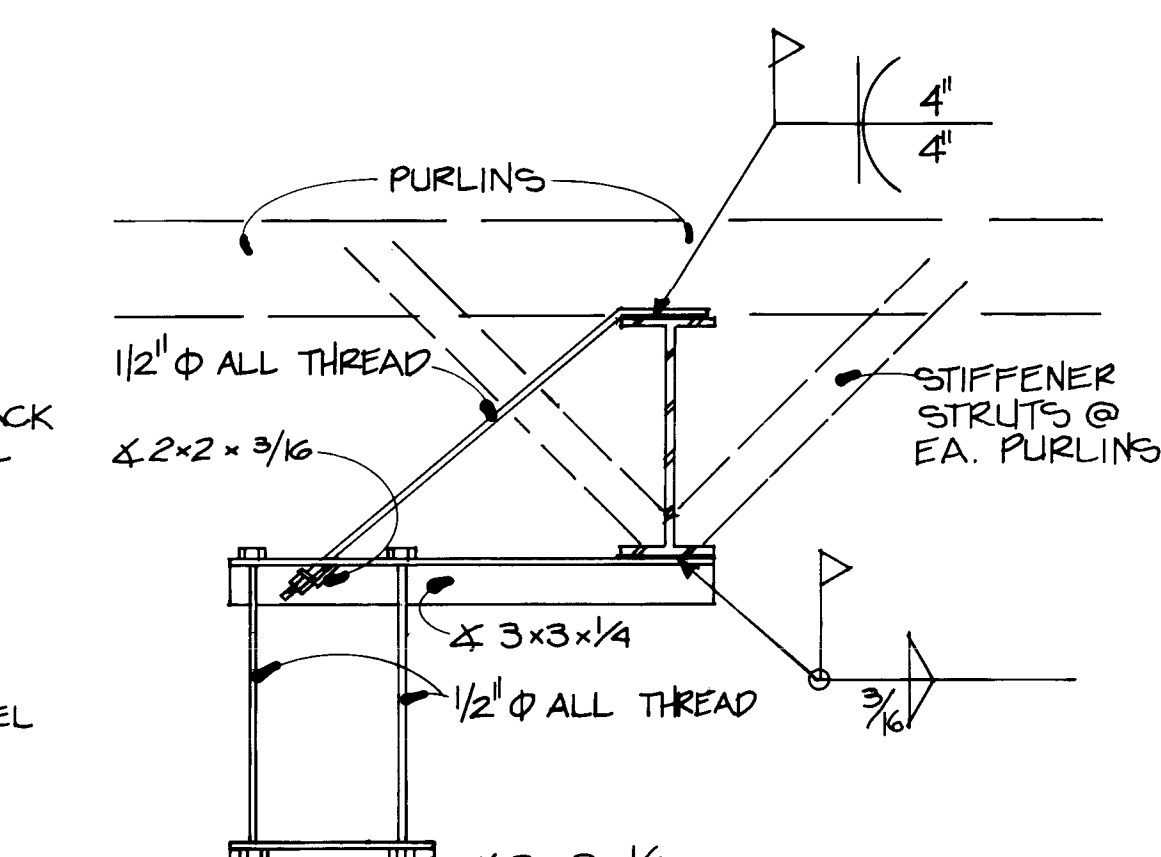


4 CONVEYOR HANGER
NO SCALE

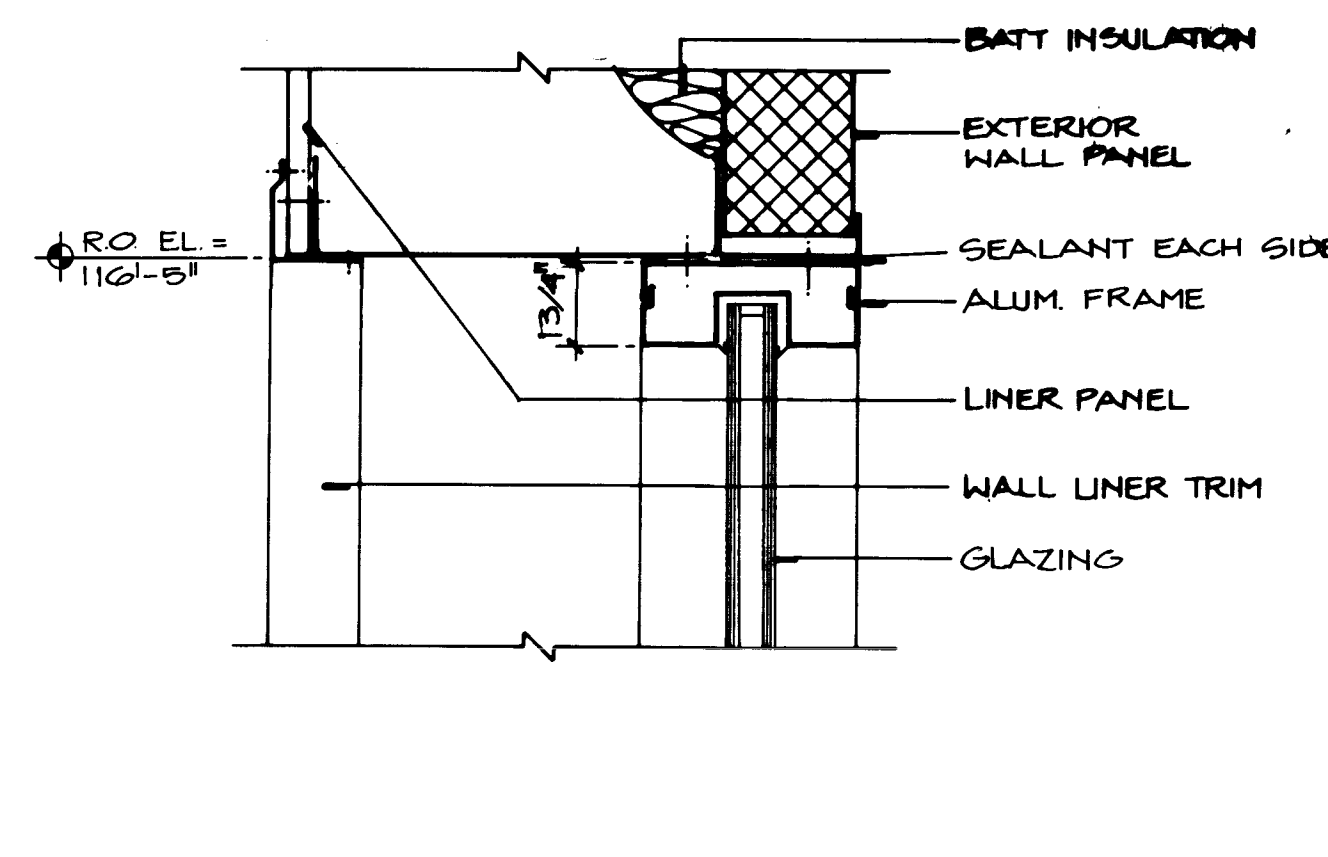


3 JAMB DETAIL SIMILAR
HEAD DETAIL
SCALE: 3'-1'-0"

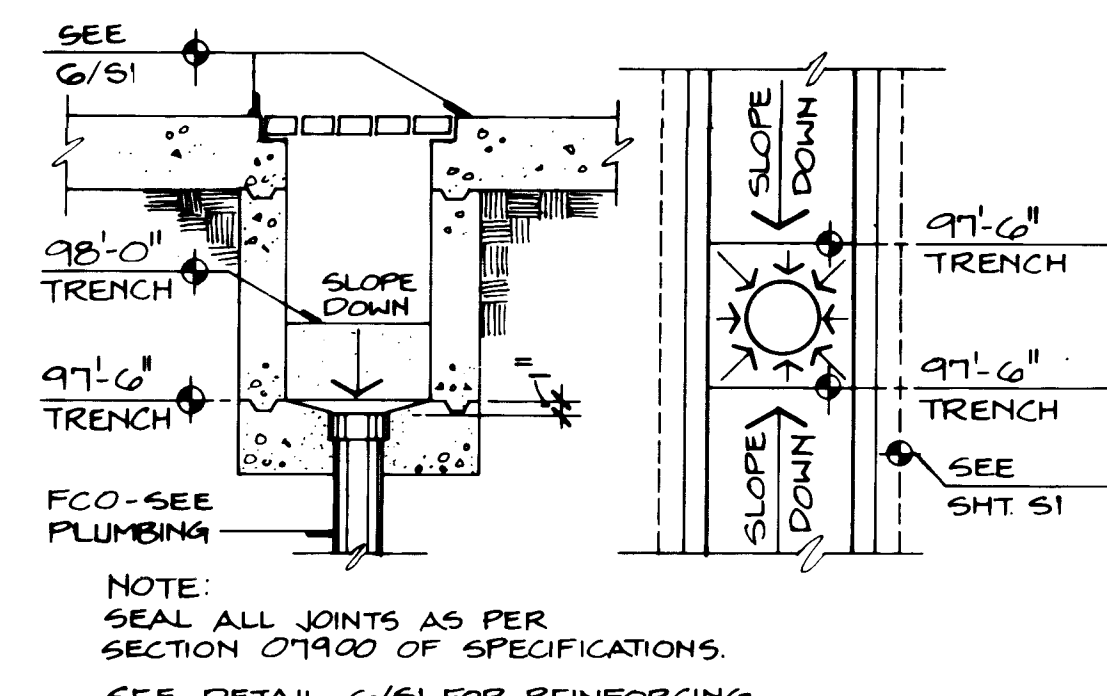


1 TRENCH SECTION/PLAN
SCALE: 3'-1'-0"

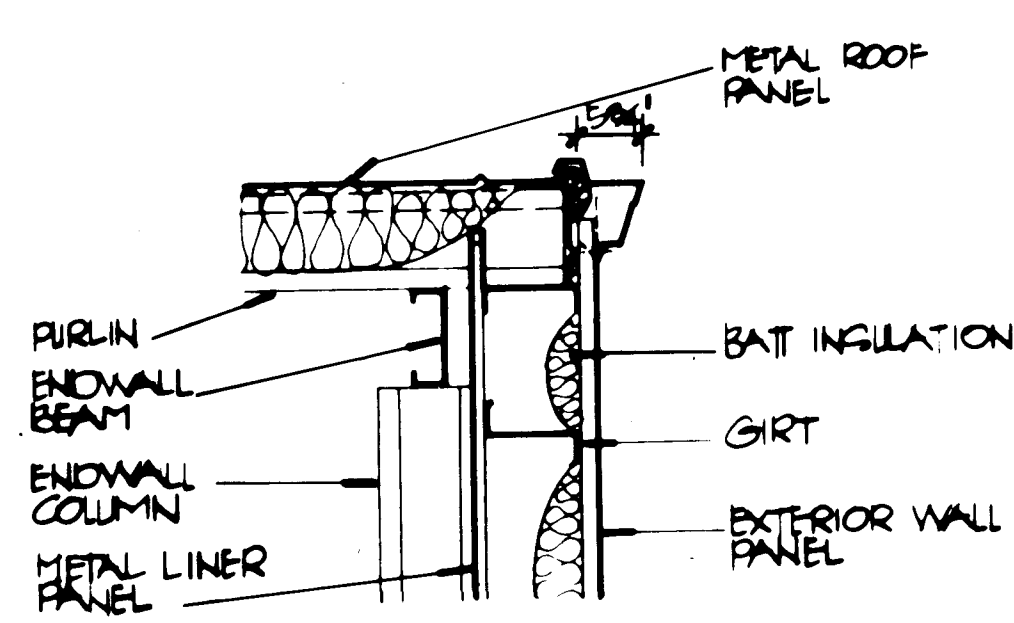


12 RAKE
SCALE: 3'-1'-0"

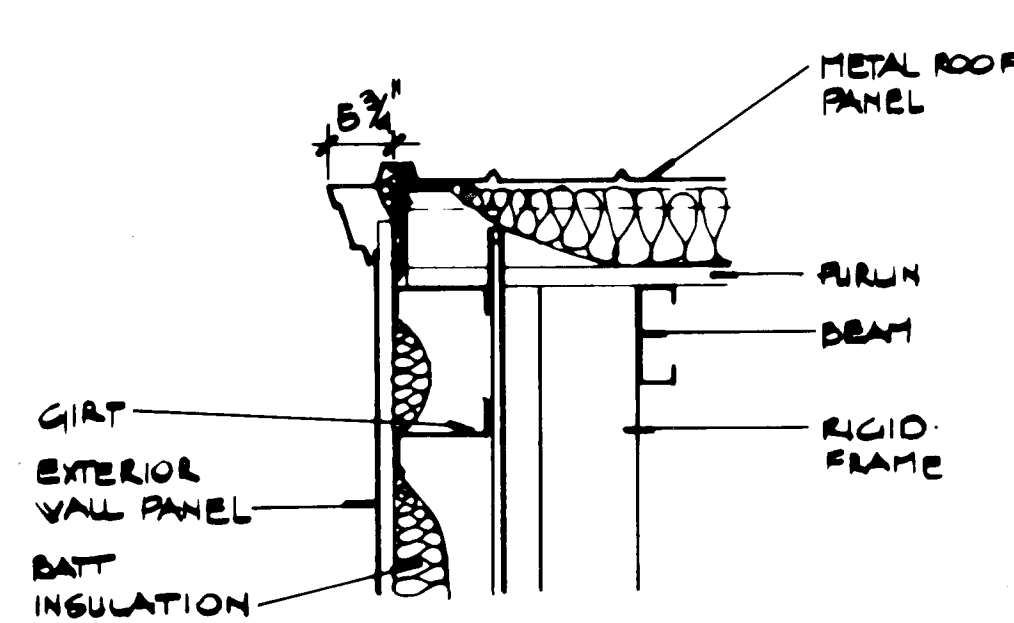


11 RAKE
SCALE: 3'-1'-0"

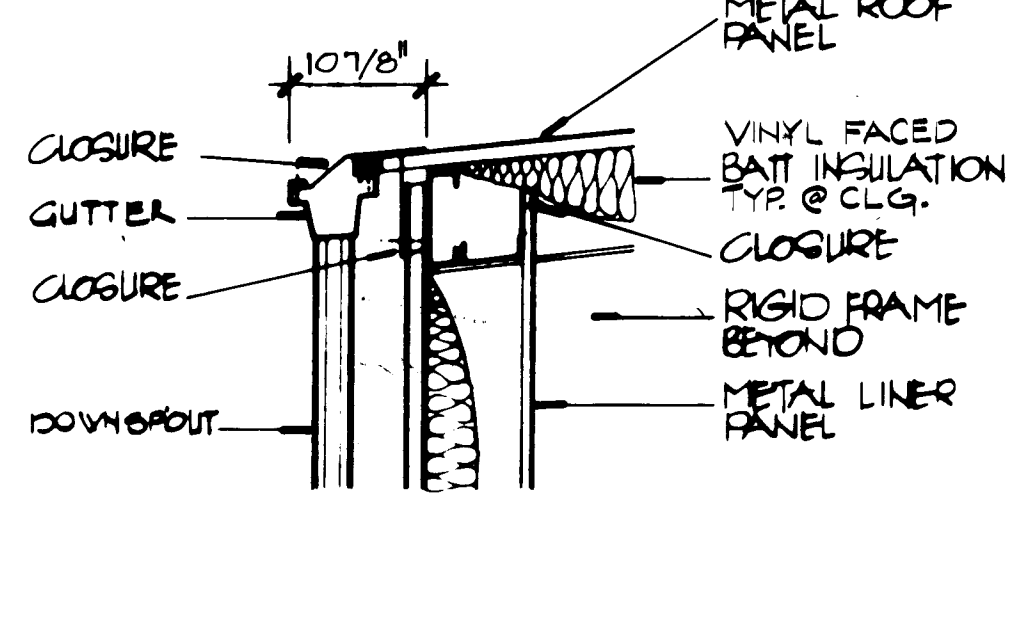


10 EAVE
SCALE: 3'-1'-0"

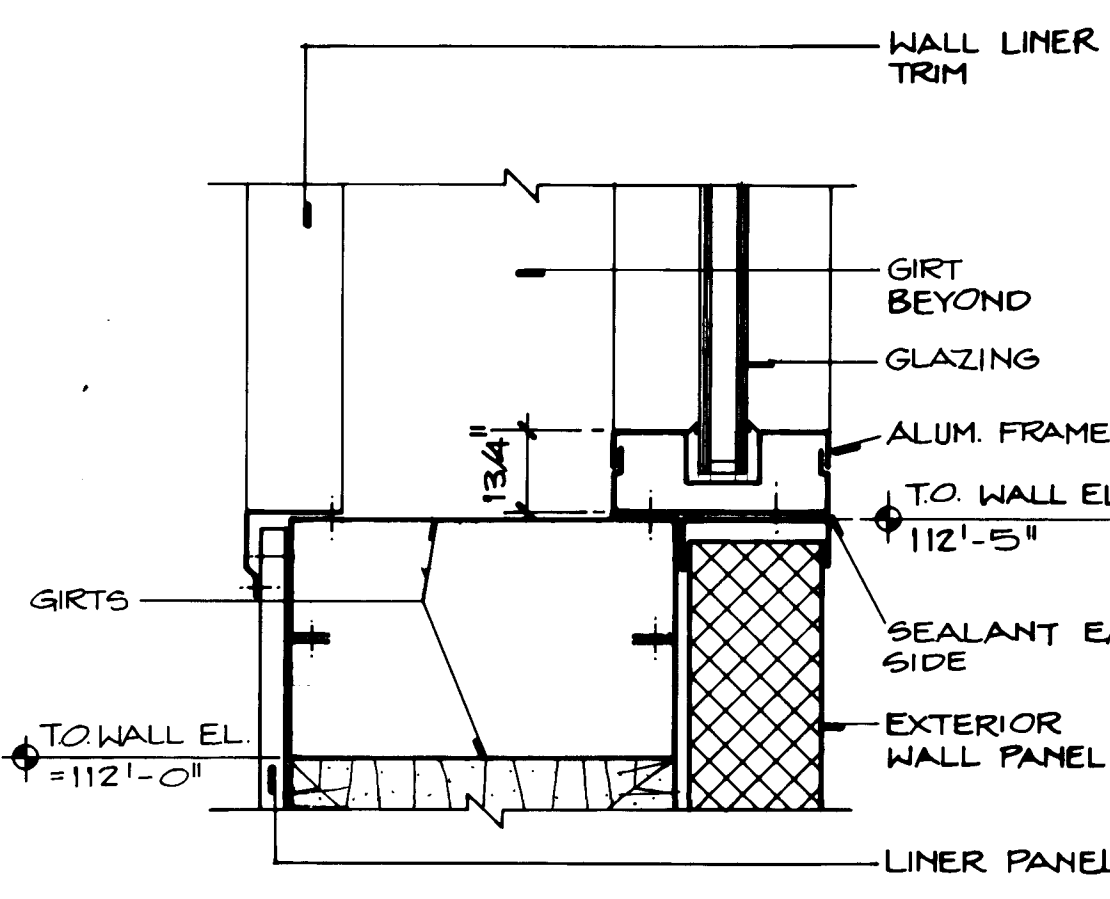


9 SILL DETAIL
SCALE: 3'-1'-0"

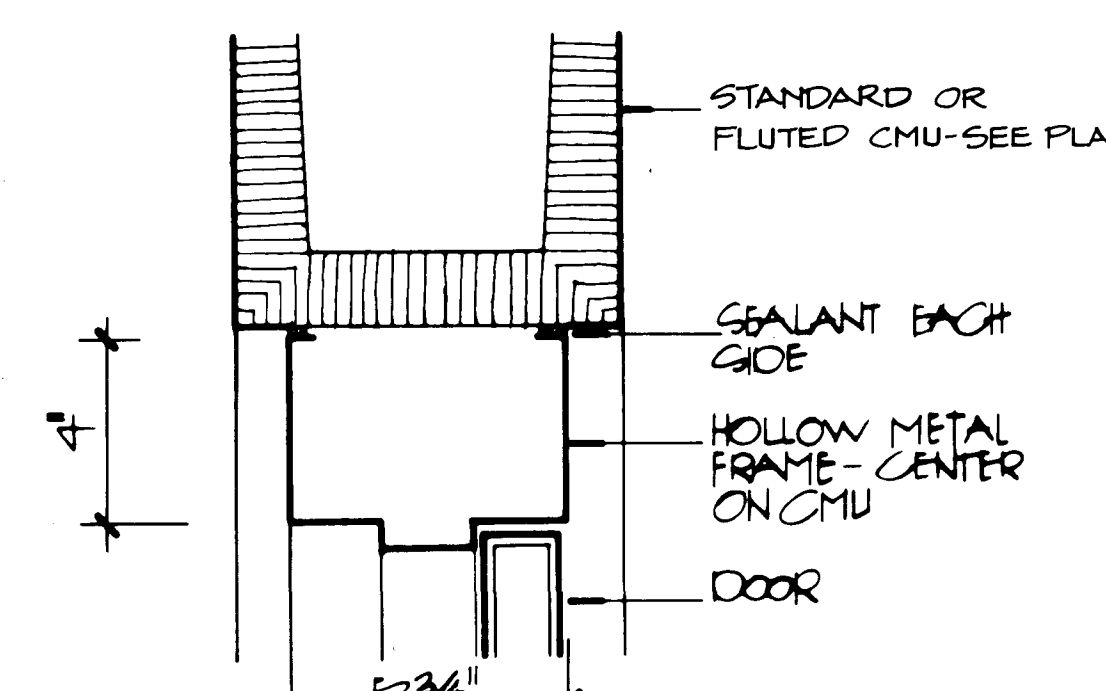


8 HEAD
SCALE: 3'-1'-0"

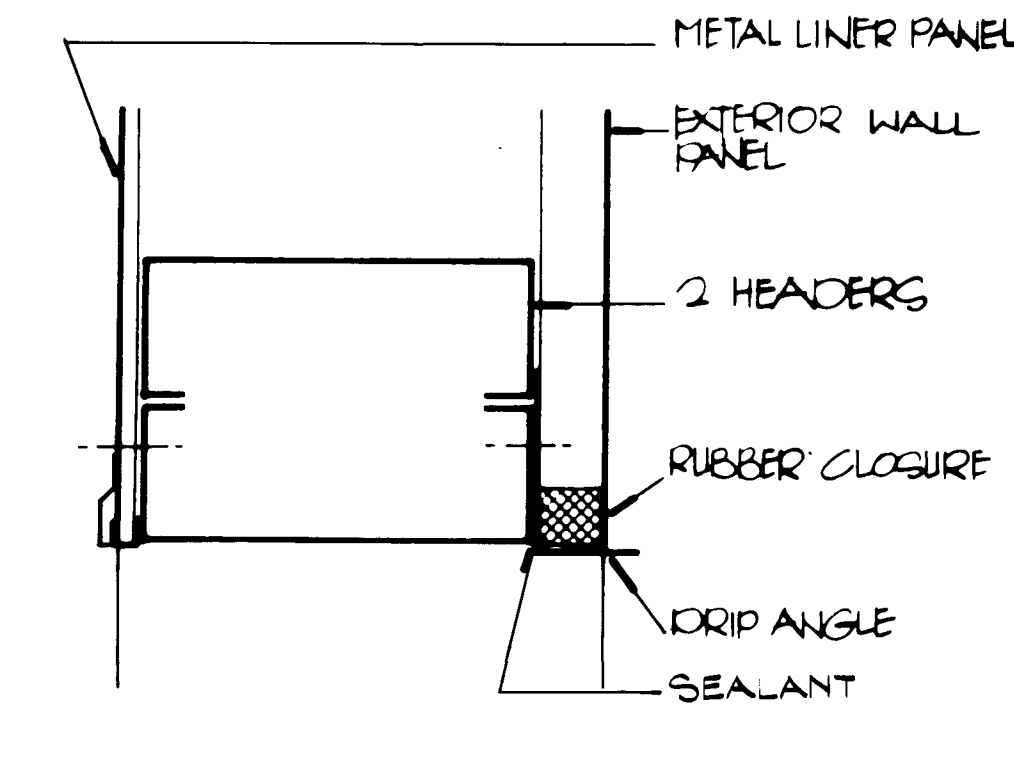


7 HEAD - OVERHEAD DOOR
SCALE: 3'-1'-0"

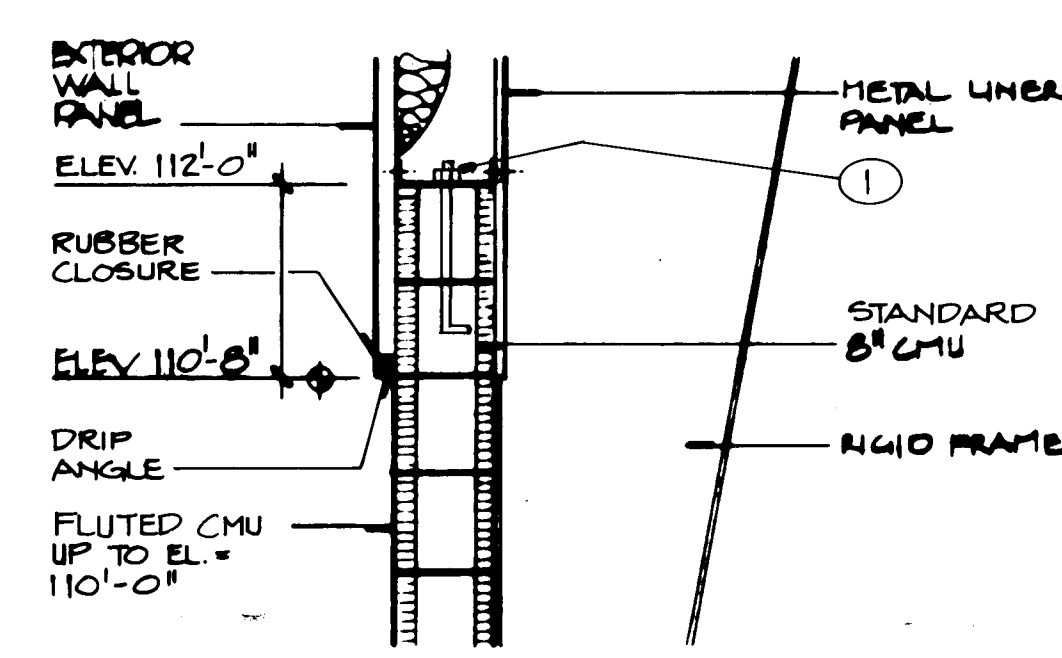


18 WALL SECTION
SCALE: 3'-1'-0"

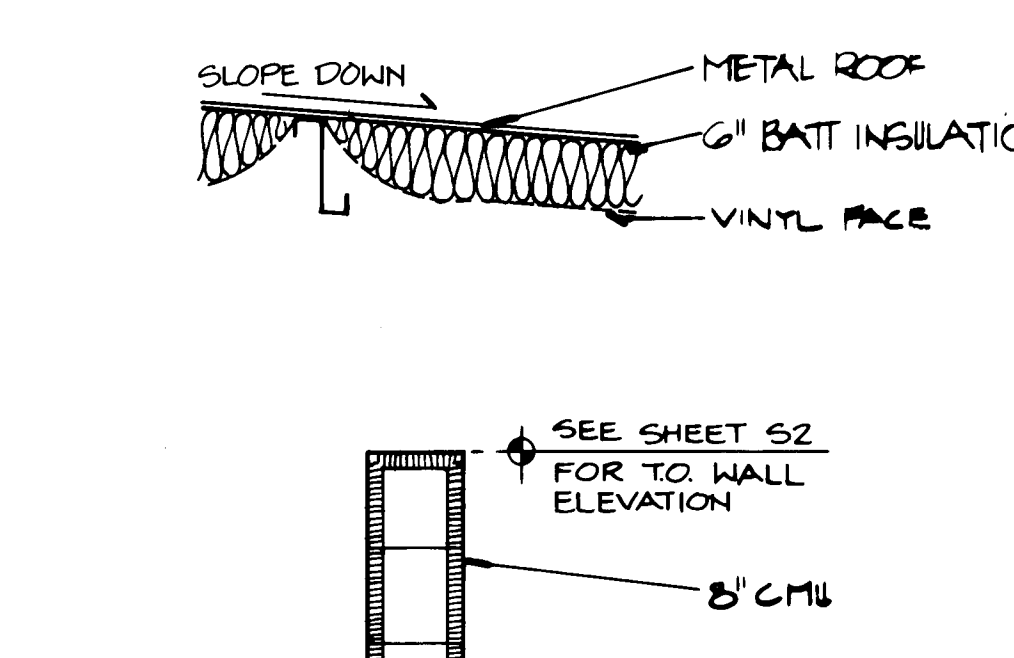


17 WALL SECTION
SCALE: 3'-1'-0"

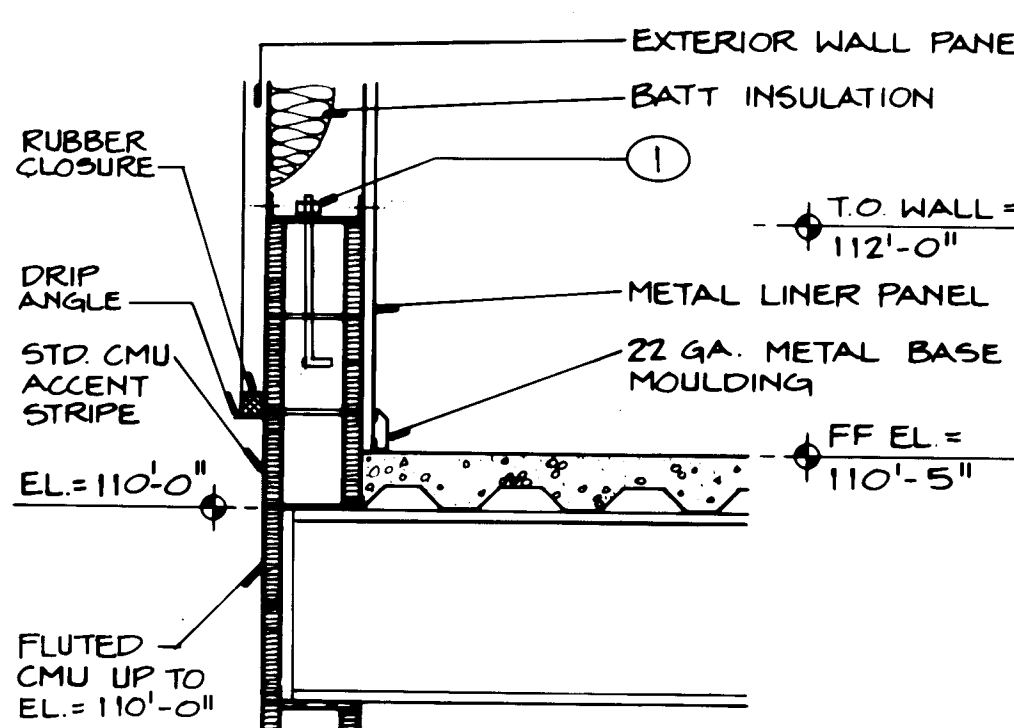


16 WALL SECTION @ MEZZANINE
SCALE: 3'-1'-0"

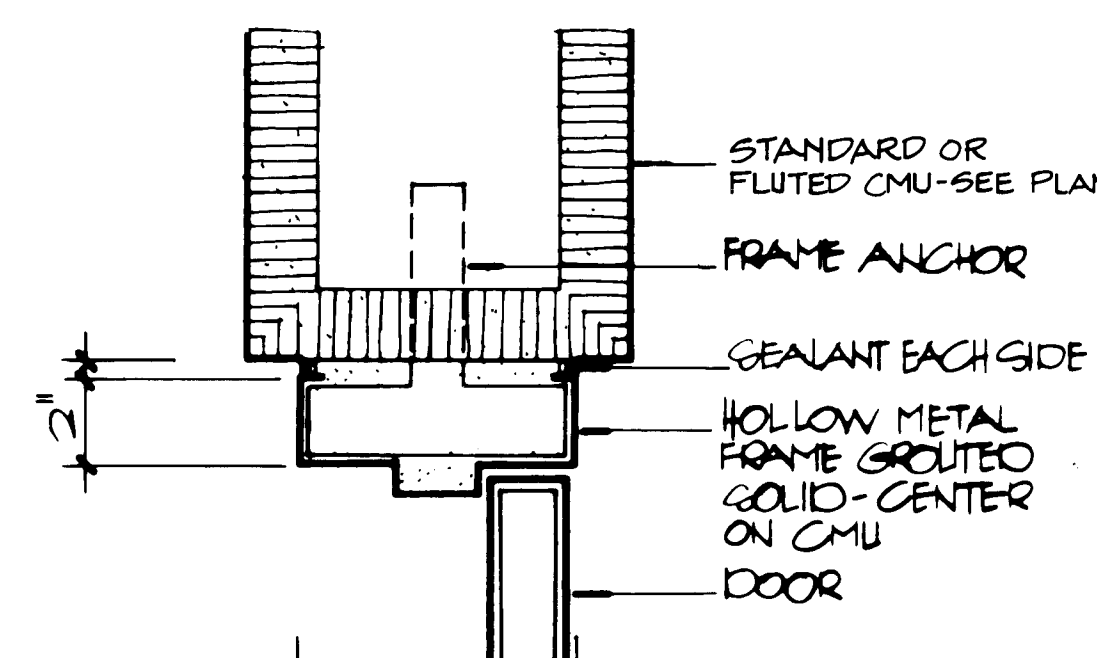


15 JAMB
SCALE: 3'-1'-0"

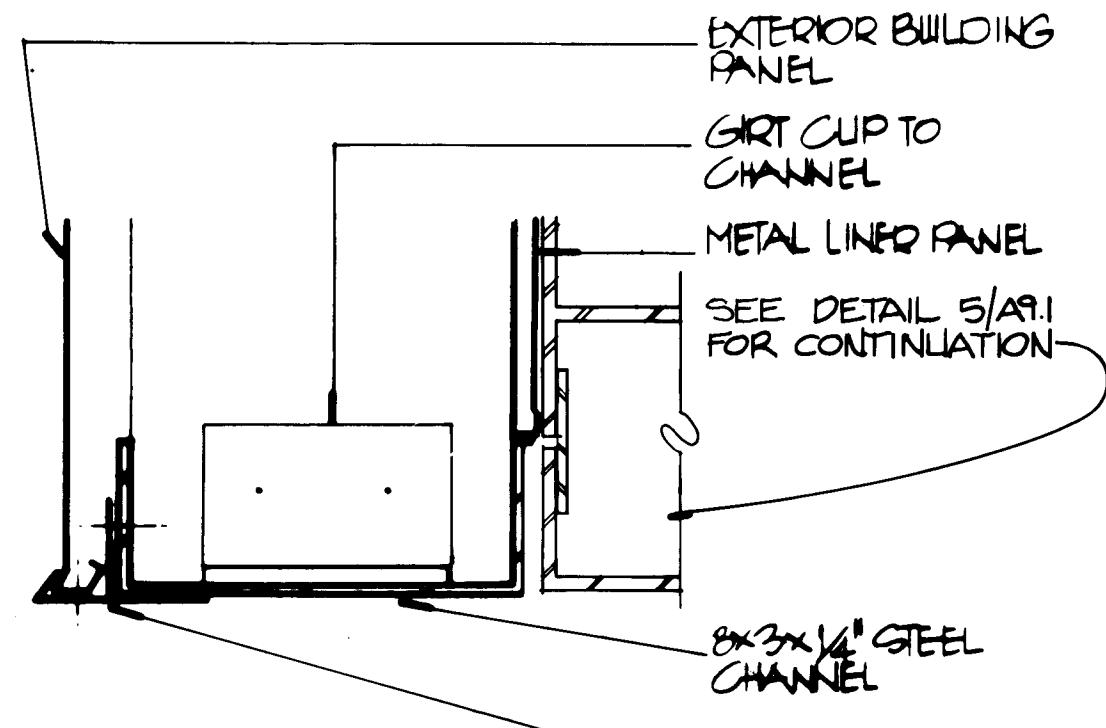


14 JAMB - OVERHEAD DOOR
SCALE: 3'-1'-0"

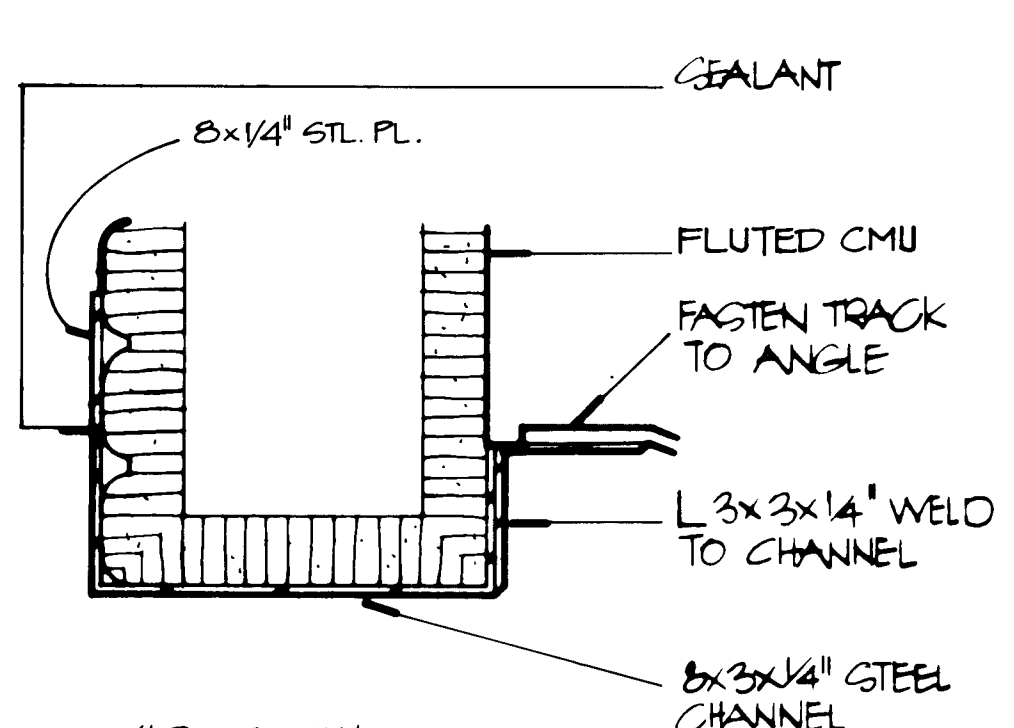


13 JAMB - OVERHEAD DOOR
SCALE: 3'-1'-0"

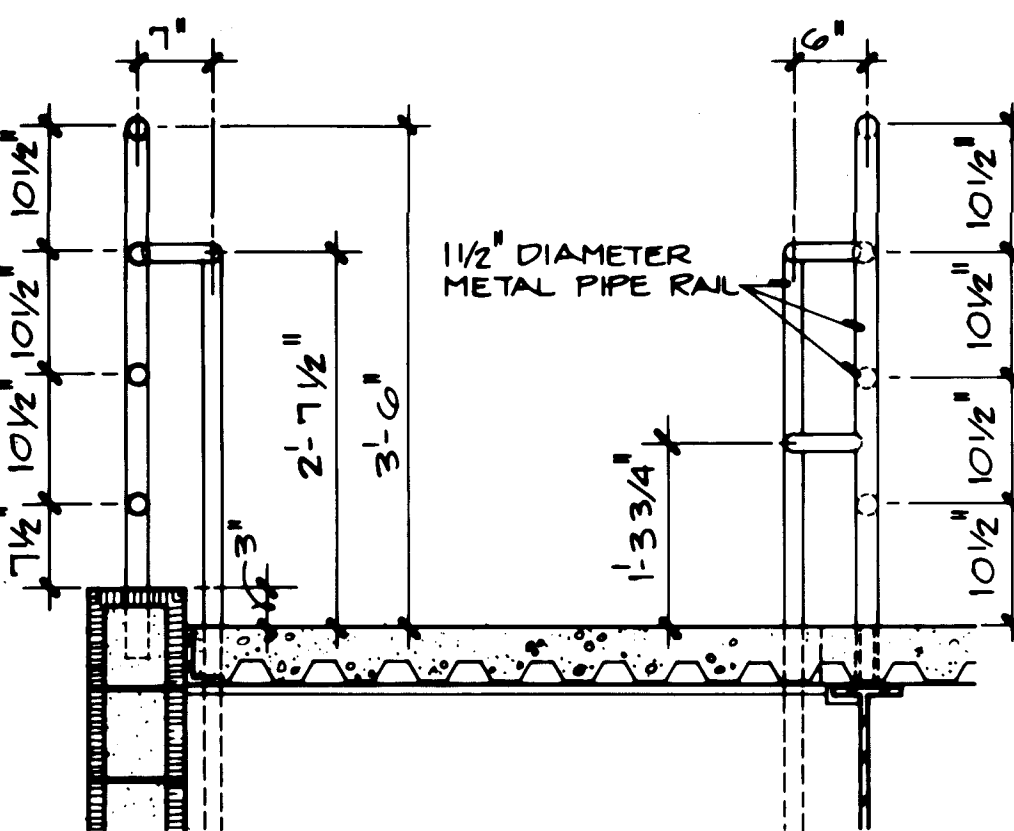


23 DETAIL - NEWEL
SCALE: 3'-1'-0"

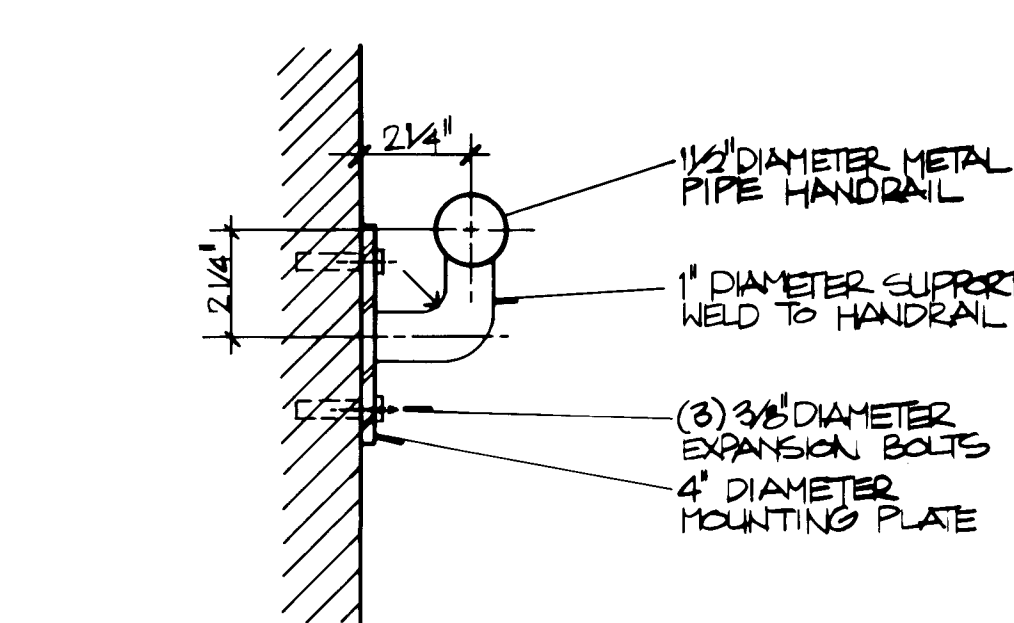


22 HANDRAIL BRACKET
SCALE: 3'-1'-0"

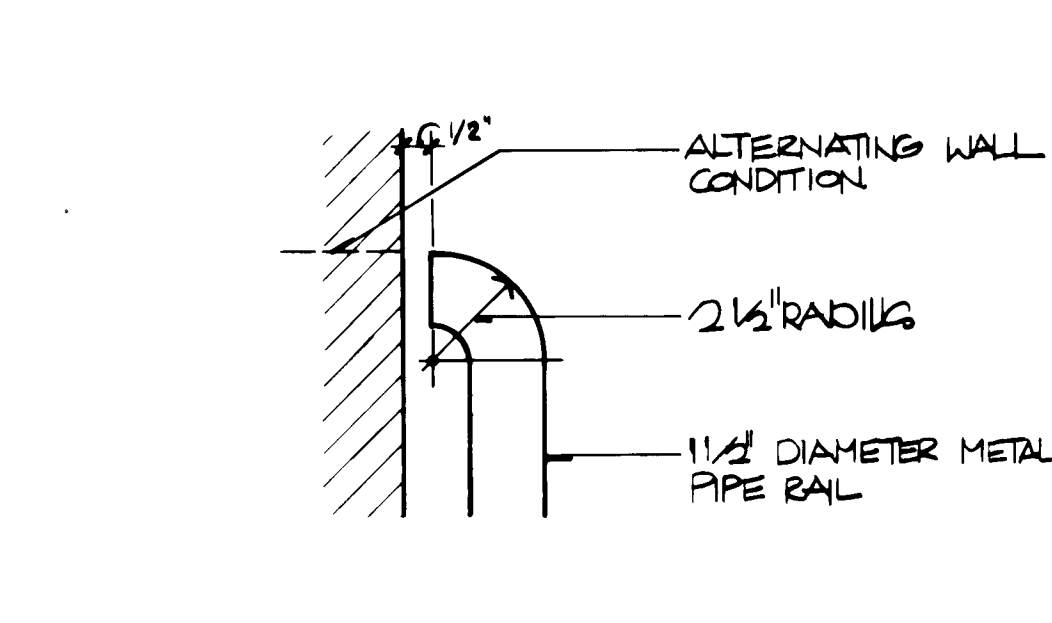


21 HANDRAIL END
SCALE: 3'-1'-0"

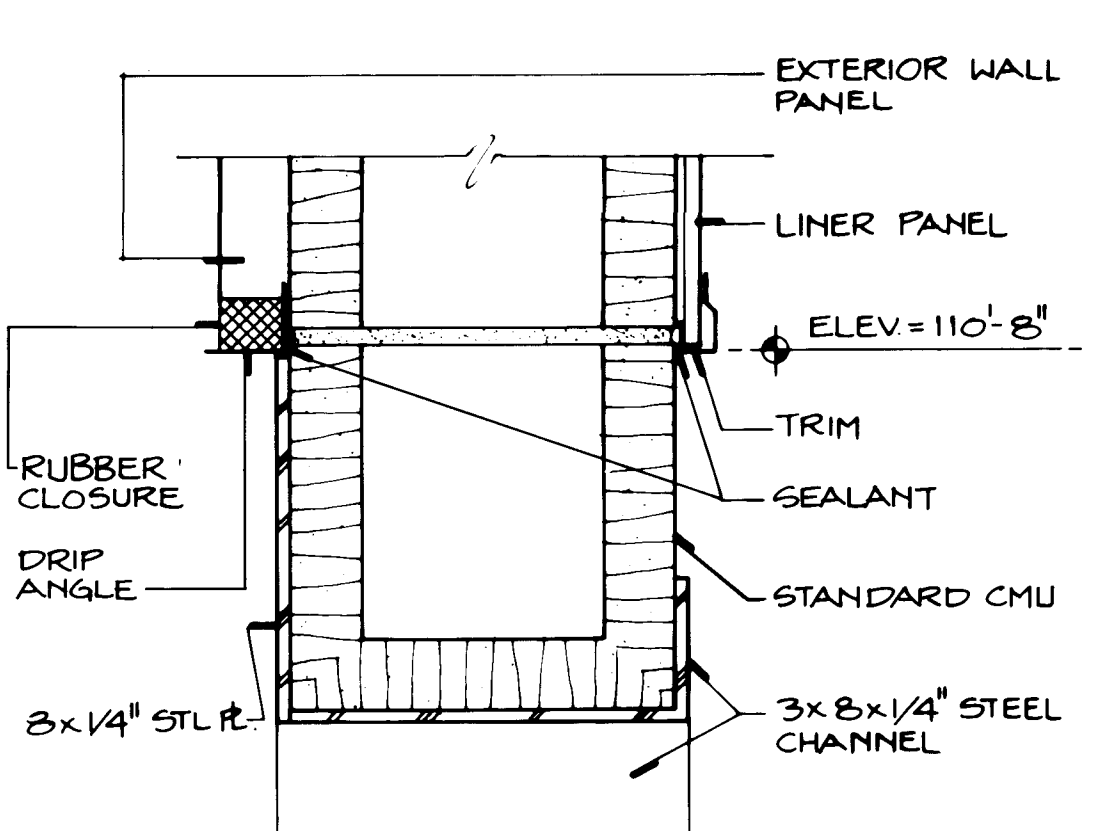


20 HEAD - OVERHEAD DOOR
SCALE: 3'-1'-0"

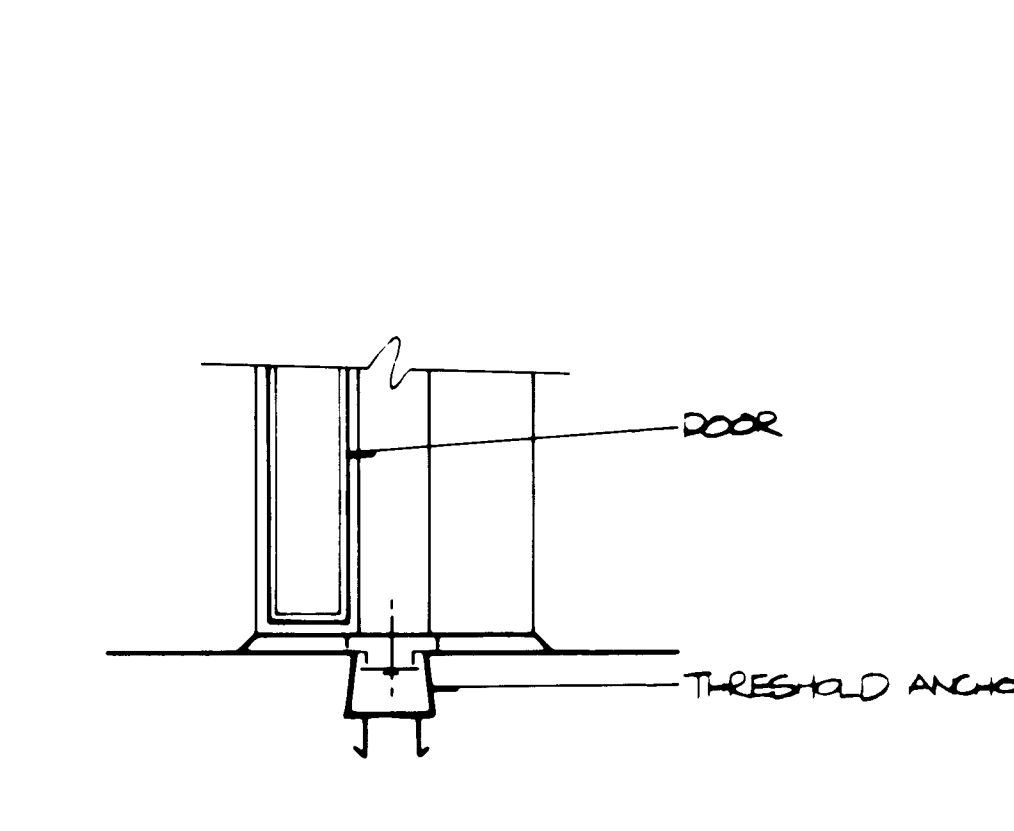


19 THRESHOLD
SCALE: 3'-1'-0"

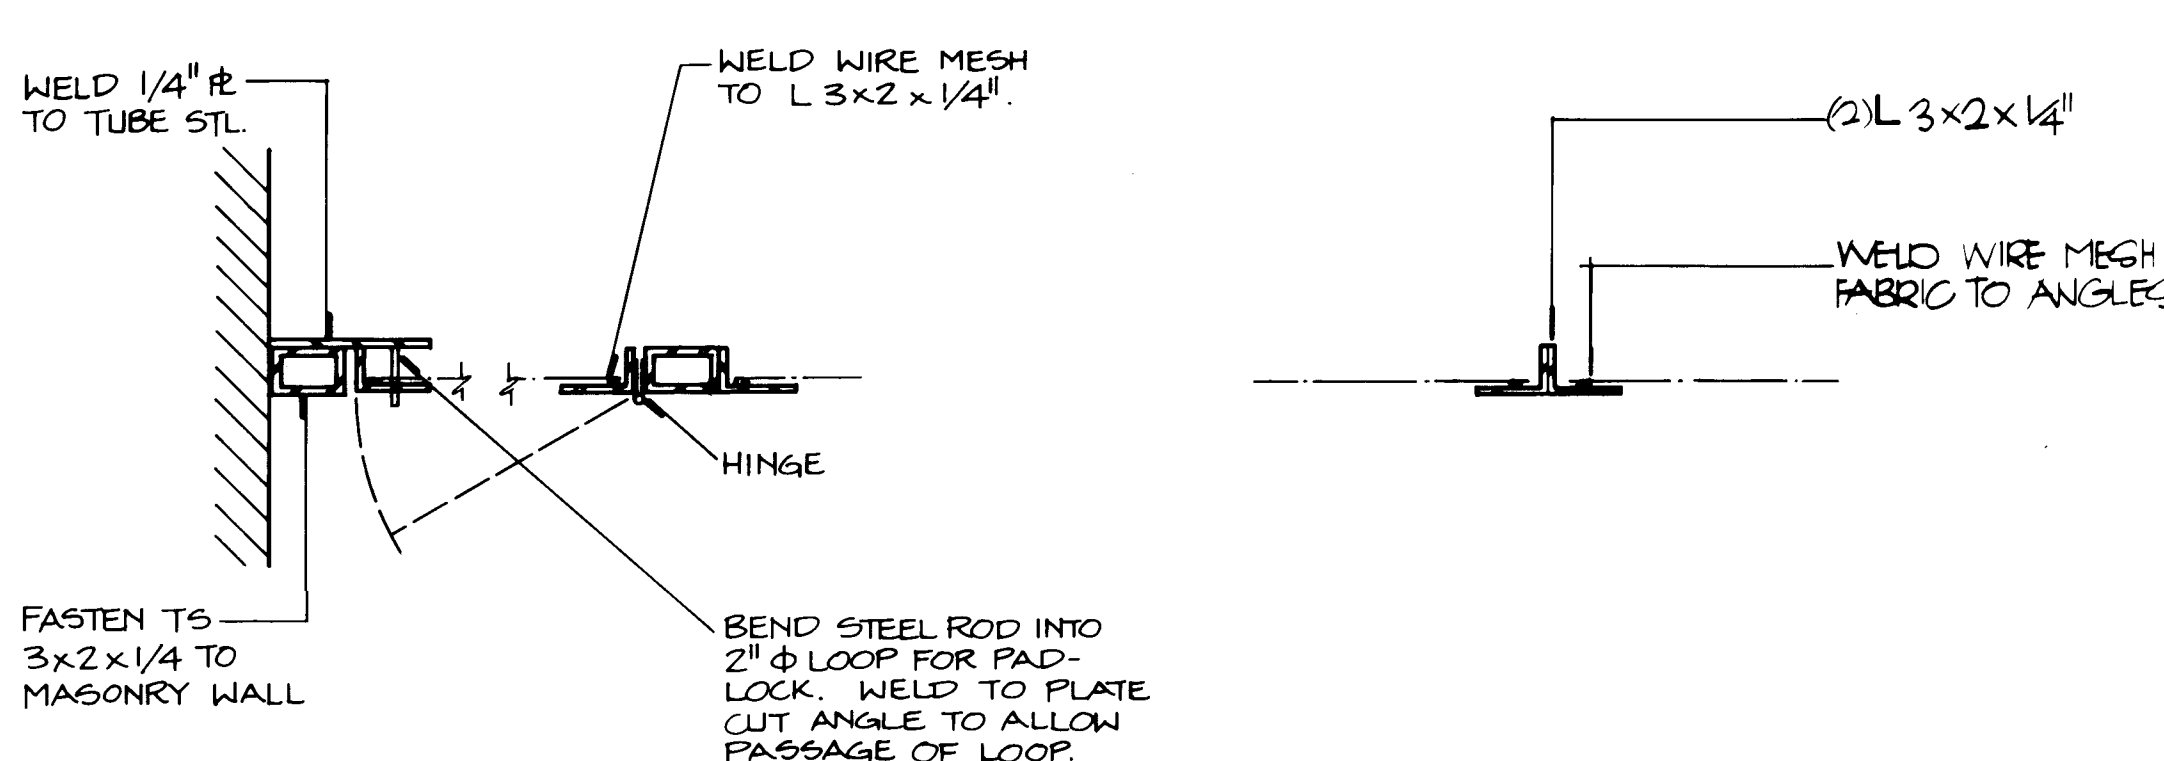


29 DOOR-MESH PARTITION
SCALE: 1'-1'-0"

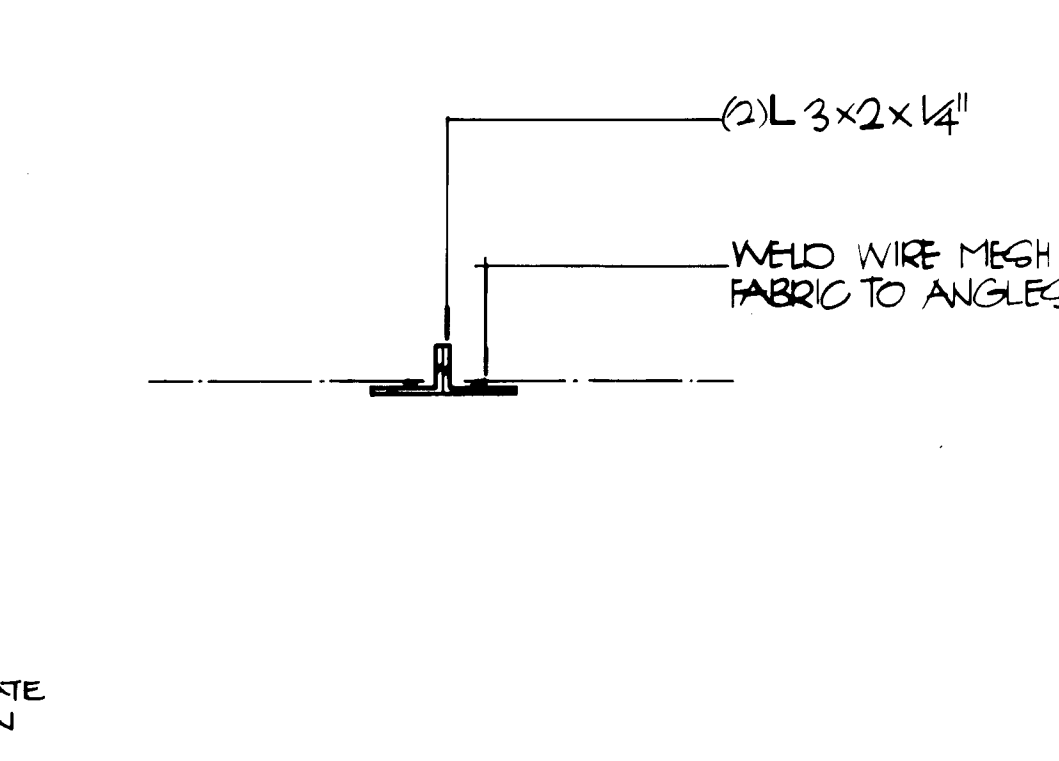


28 MESH PARTITION
SCALE: 1'-1'-0"

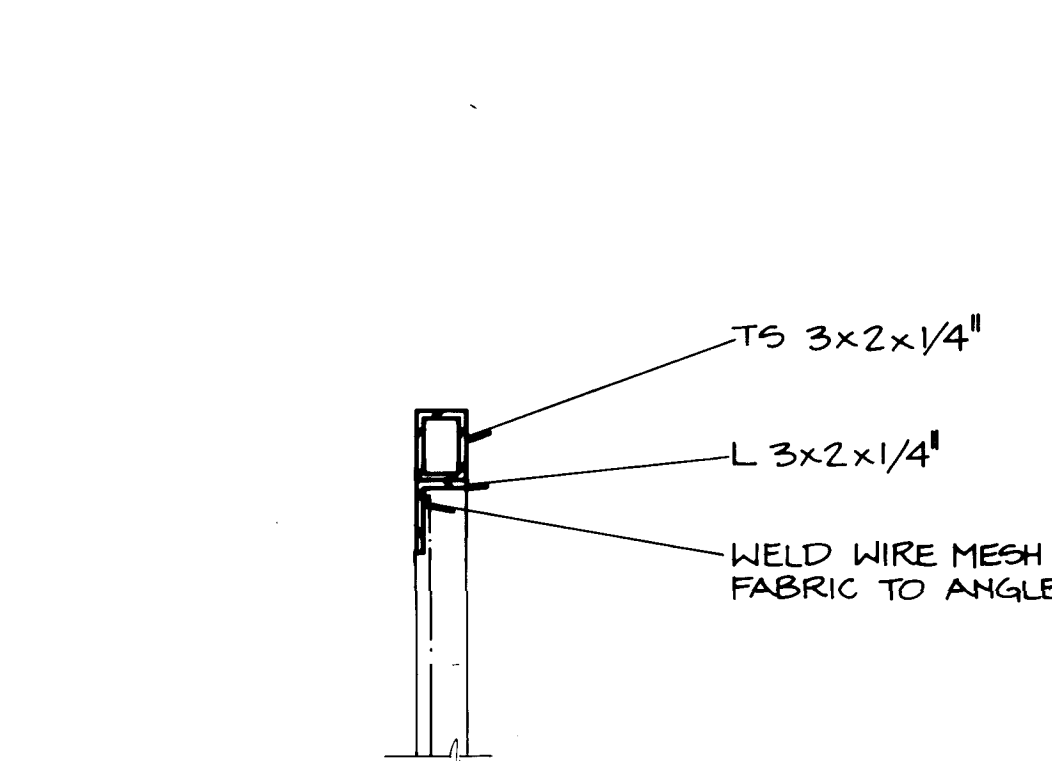

27 HEAD-MESH PARTITION
SCALE: 1'-1'-0"

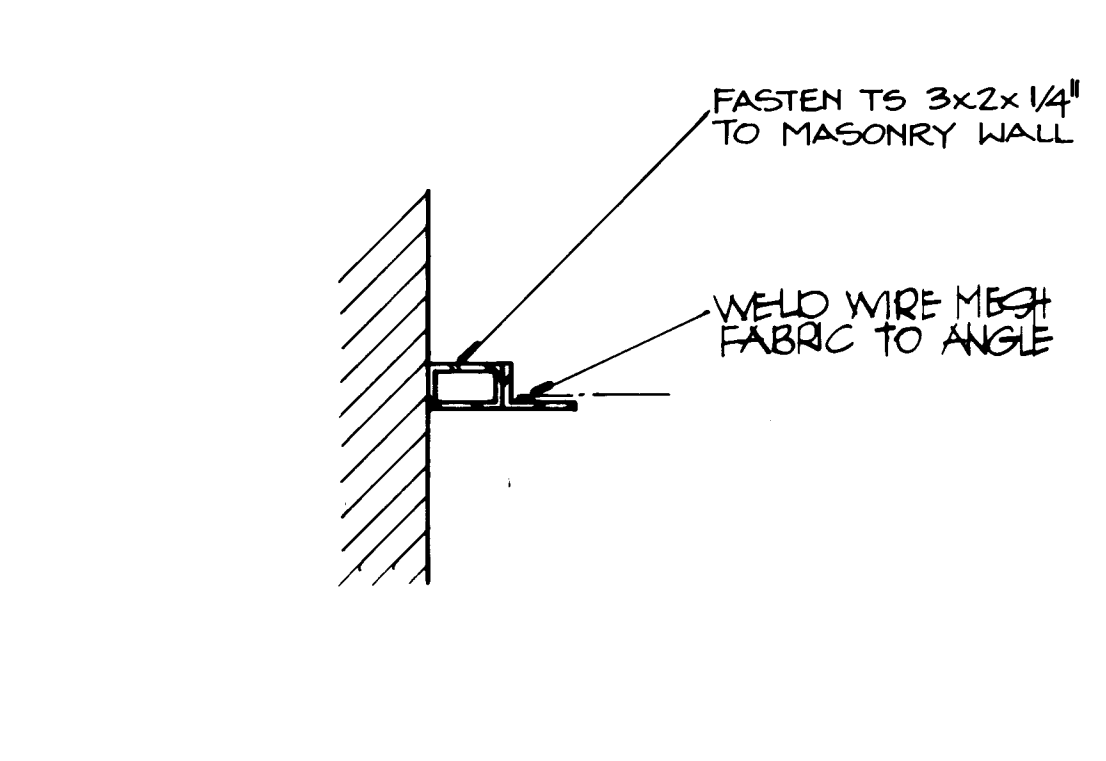

26 JAMB-MESH PARTITION
SCALE: 1'-1'-0"

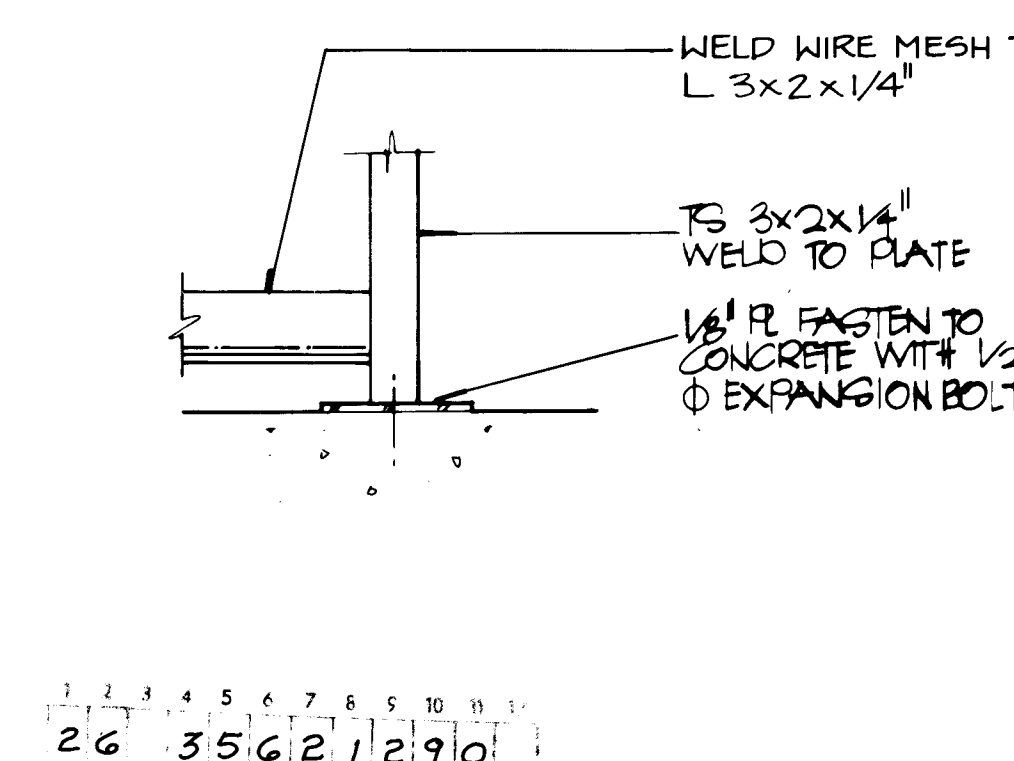

25 BASE-MESH PARTITION
SCALE: 1'-1'-0"

BPLW

Architects & Engineers, Inc.
Amer. 30 Financial Center #5
Suite 400
2400 Louisiana Blvd. NE
Albuquerque, New Mexico 87110
505-881-8100

Designing to shape the future

GENERAL NOTES

THE INTENT OF THE 8\"/>

KEYED NOTES

1. MANUFACTURER'S STANDARD GIRT; ANCHOR TO CMU WALL WITH 1/2\"/>

RECORD DRAWING

Information shown on this document has been edited from the construction record drawing provided to the architect by the general contractor, which show the reported location of changes in the work.

By: *[Signature]*
BPLW ARCHITECTS & ENGINEERS, INC.
Date: 12/22/89



ENGINEER ARCHITECT

VEHICLE STORAGE BUILDING
ALBUQUERQUE INTERNATIONAL AIRPORT
ALBUQUERQUE, NEW MEXICO


CITY PROJ. NO. 3562

PROJECT NO. 8525-23.01 DATE SEPT. 1988

DETAILS

DRAWING NO.

A9.1
SHEET OF

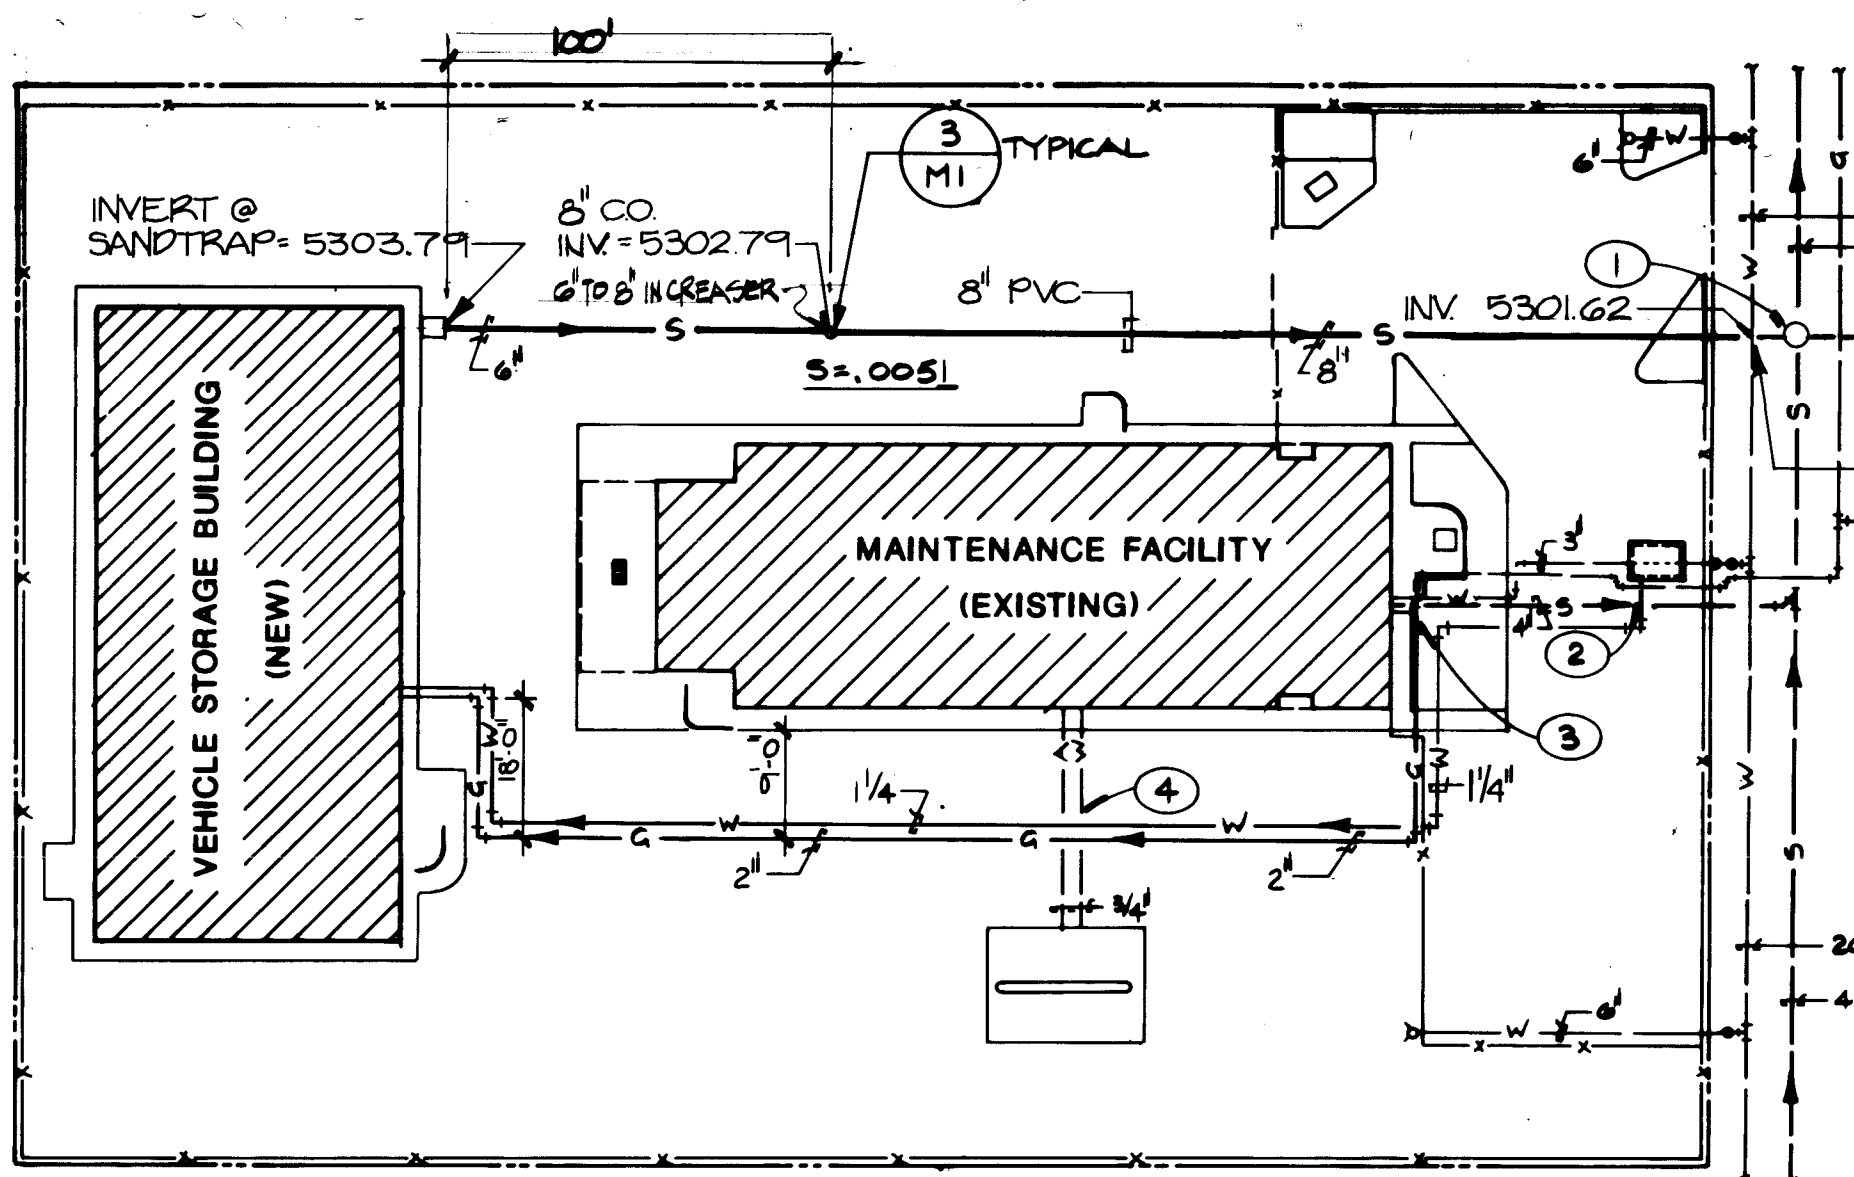

- NOTES:**
- CONNECT NEW 8" SOIL LINE TO MANHOLE INV. 5301.57
 - CONNECT NEW 1 1/2" CW TO EXISTING 1 1/2" SUBOUT AT PRESSURE REDUCING
 - CONNECT NEW 2" GAS LINE TO EXISTING (GAS LINE 18" BFG)
 - VERIFY EXISTING METER & SERVICE CAPACITY FOR AN ADDITIONAL 889 CFM @ 70 W.C. LEAVING PRESSURE. CONNECT NEW LINE DOWN STREET OF EXISTING WATER VALVE-IN-BOX. HAND DIG IN VICINITY OF EXISTING WATER AND AIR LINES.
- NOTE: PATCH & REPAIR ALL ASPHALT AND CONCRETE AFFECTED BY CONSTRUCTION.**




MECHANICAL EQUIPMENT SCHEDULE

ALL CAPACITIES AT 5683 FT. ELEVATION

SYMBOL	DESCRIPTION
1	AIR WASHERS WITH FAN SECTION: Factory fabricated and assembled. Air washer and fan section shall be fabricated of galvanized steel with stiffening and support members as required. Tank shall be fabricated of 14 ga. black iron with welded seams and coated cold tar epoxy. All supports shall be welded. Tank shall be leak tested at the factory. Fill shall be celek cellulose paper, (90% eff.), 12 in. deep with impregnated with insoluble anti-rust salts. Distribution headers shall be pvc pipe with drilled ports. Distribution pump shall be vertical submerged type located in the tank. Pump shall be cast iron and epoxy coated. Distribution pump shall have a capacity of 14 gpm at 10 ft. head 1/15 hp, 120-1-60 Hz. Furnish with 1/2" cold water make-up, float valve and overflow and drain connection. Furnish (2) removable panels on each side of the fan cabinets and a removable roof for maintenance access to all internal components. Fan shall be DMOI, with two speed, two winding, 1800/1200 rpm motor and rubber in shear isolation. Capacities as scheduled below. Sun Manufacturing, Alton, Ark and Refrigeration or approved equal. Model selection based on Alton Model HEDM-1250, color as selected by the Architect.
2	EXHAUST FAN: Propeller type, belt driven fan sidewall type exhaust fan. Fan housing and propellers shall be constructed of heavy gauge galvanized metal, primed for field painting. Unit shall be furnished with 18 gauge, galvanized steel intake enclosure. Enclosure shall be primed for field painting. Units shall have a capacity of 9,700 CFM @ 1/4" S.P., 1 HP motor and operate on 208V - 60 Hz. - single phase power. Carrier Model GWH-16, Type T, or approved equal.
3	GAS FIRED UNIT HEATERS: Natural gas fired, propeller type fan, ARA approved. Furnish complete with all required safety and operating controls including: low voltage transformer relay, fan time delay, high limit switch, fan controls, automatic 24 volt gas valve with lock safety pilot shut off, pressure regulator, main and pilot gas cocks, 24 volt thermostat. Totally enclosed motor with thermal overload protection, adjustable discharge louvers, gun filter to protect pilot orifice from clogging with dirt. Trane, Modine, Reznor or approved equal.
4	CARBON MONOXIDE DETECTOR: Provide and install a micro computerized CO detector. Detector shall be housed in a heavy gauge metal housing, primed and painted. Housing shall be provided with mounting holes and control status indicator lights. The detector shall be capable of self diagnostic/fault monitoring. The detector shall be capable of removing contaminants from the sensor by subjecting it to controlled current pulses. Sensor life shall be rated at 5 years. The detector shall be capable of compensating for temperature and humidity variations. CO levels shall be detected by averaging transient alarms. If CO levels exceed 50 ppm or if the micro computer detects a fault, the exhaust fan shall be activated and shall remain running for a minimum of 2-1/2 minutes until CO drops below 50 ppm or until the fault is cleared. If CO levels should rise above 200 ppm and remain there for 15 minutes, the detector shall alarm with an 85 dB continuous alarm. If CO level is detected at 400 ppm/hours (over an 8 hour period) and the current level exceeds 50 ppm, the detector shall alarm with an 85 dB pulsating alarm. The entire unit shall have two year warranty. Unit shall be Quantum CO Star or approved equal.
5	SEQUENCE OF OPERATION: The Carbon Monoxide detector shall be installed at the location shown on the plans. Upon detecting CO levels to be above 50 ppm, the detector shall energize contacts to start the exhaust fans. The exhaust fans shall remain running for a minimum of 2-1/2 minutes and until CO levels drop below 50 ppm. Upon starting, each fan shall open its respective intake and exhaust damper.
6	ALARM CONDITION INDICATOR LIGHT AUDIBLE ALARM
7	OPERATING CONDITIONS:
8	LOUVERS: Factory fabricated, fully welded, extruded aluminum louvers, primed for field painting. Furnish with rust resistive bird screen, extended sill and without flange. Louver for installation within ductwork. Furnish with parallel blade, motorized (120 VAC) damper. Ruskin Model CD40. Louver shall be Ruskin Model ELF-3750 or approved equal.
9	INSTANT WATER HEATER: Wall mounted, flow thru type water heater, 8.0 Kw heating element, 208V-1PH - 60HZ, 33 amp operating power, 54 deg. F temperature rise at 10 gpm. Furnish with 1.0 gpm inline flow controller. As manufactured by Chronomite Labs, Model 5801. Contact Barnett and Co., Albuquerque, New Mexico.
10	SERVICE SINK: American Standard No. 7602.055 enameled cast iron single compartment sink, black angle iron frame No. 7602.030, faucet with vacuum breaker and hose and No. 8341.075 with stops in shanks, P-trap and strainer.


PIPING ISOMETRIC

NO SCALE

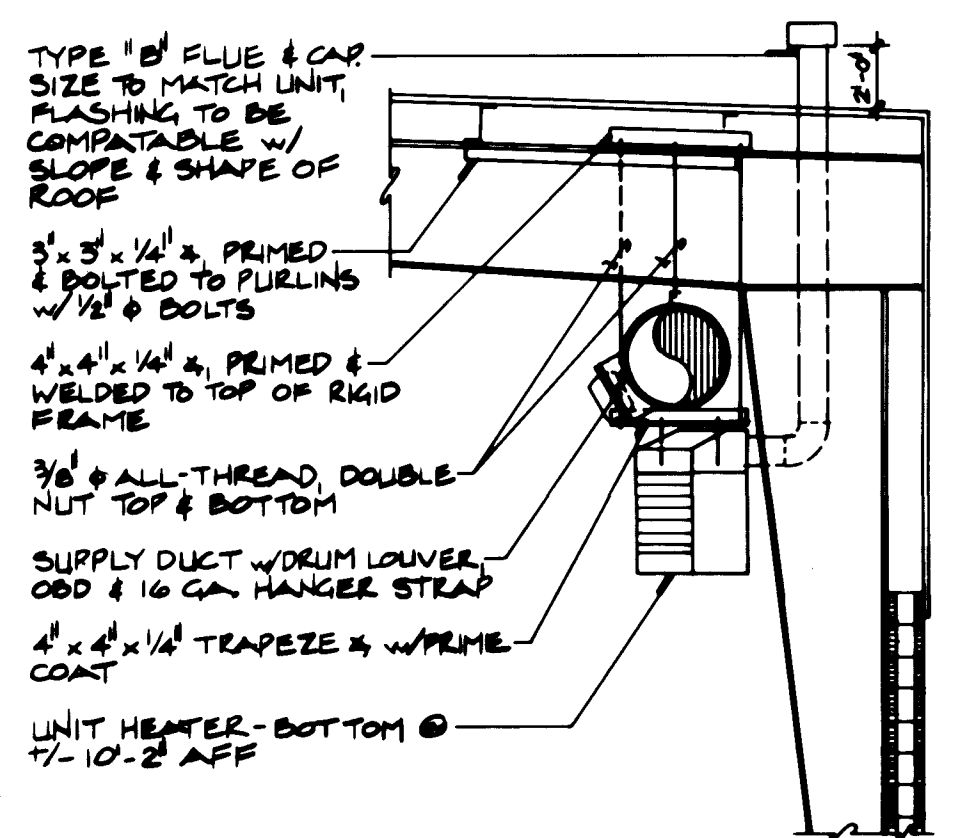


DETAIL

SCALE: 1/4" = 1'-0"

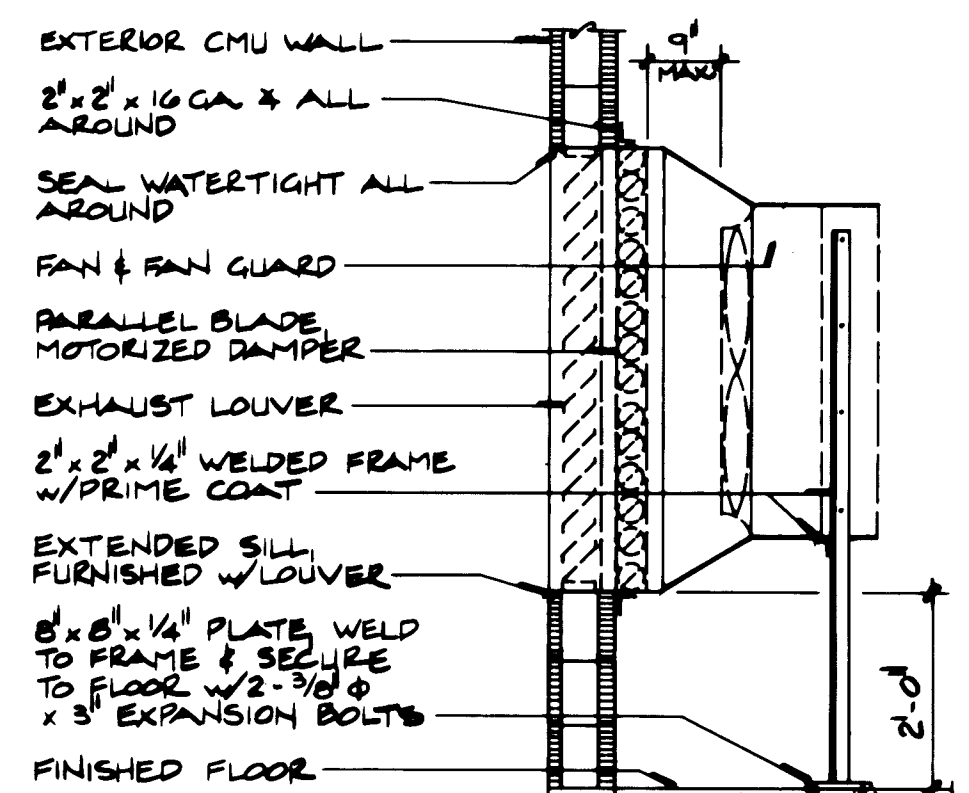


DETAIL

SCALE: 1/2" = 1'-0"

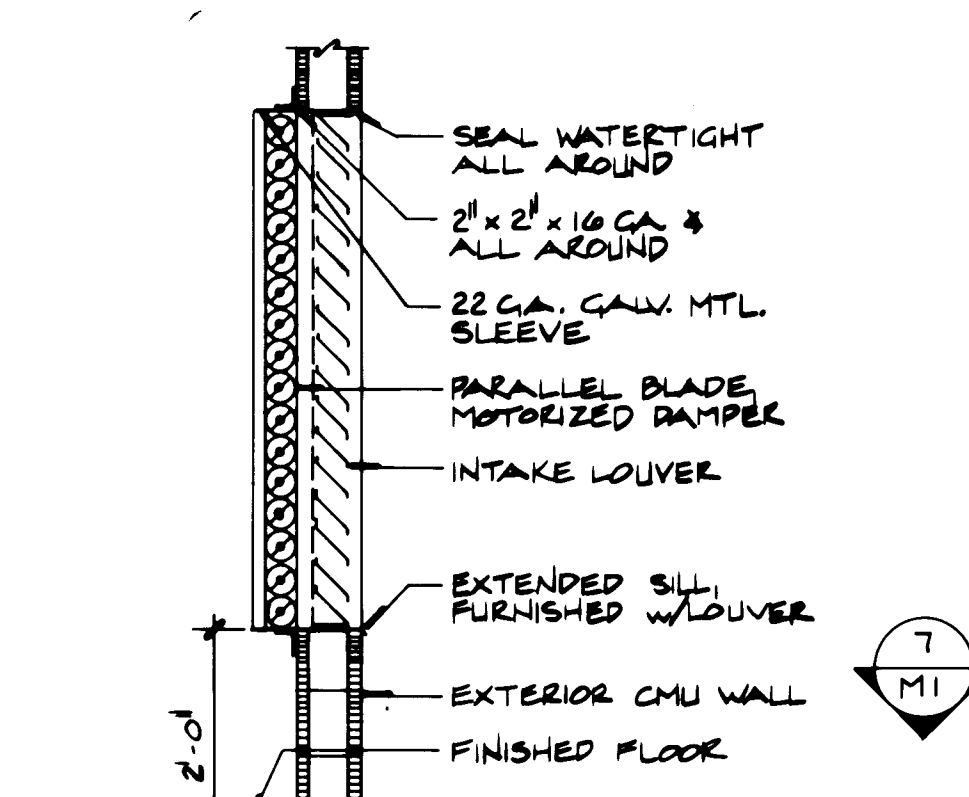

DETAIL

SCALE: 1/2" = 1'-0"

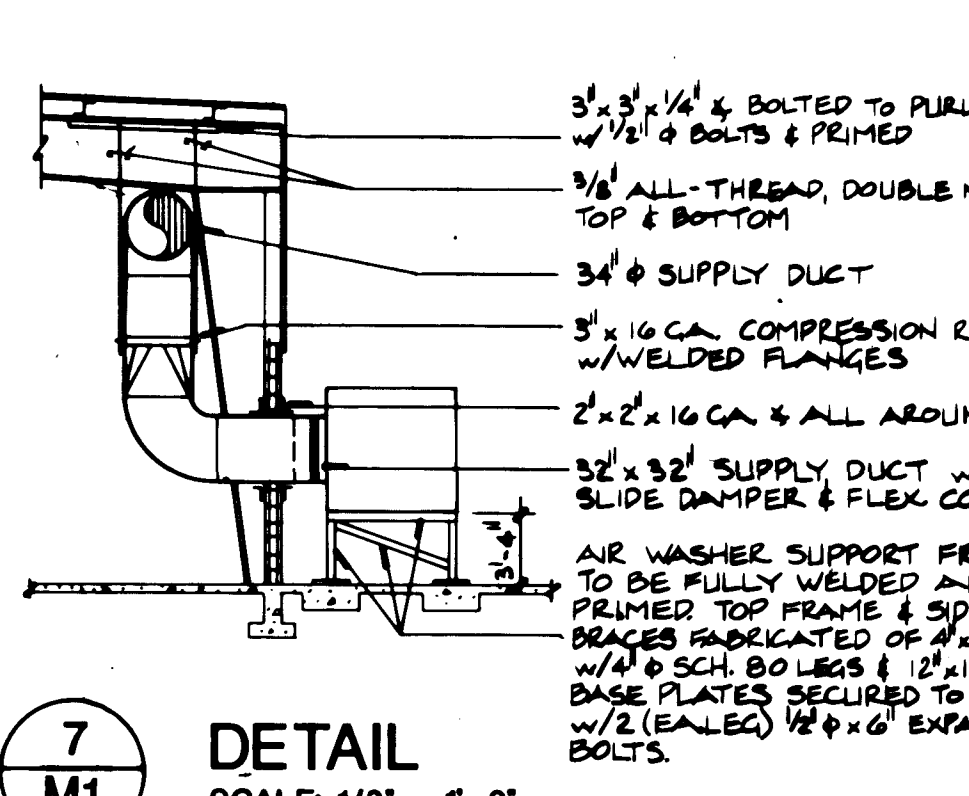

DETAIL

SCALE: 1/8" = 1'-0"


RECORD DRAWING

Information shown on this document has been compiled from the construction record drawing provided to the Architect by the General Contractor, which show the reported location of changes in the work.

By: *[Signature]*
BPLW ARCHITECTS & ENGINEERS, INC.
Date: 12/22/89

PLAN - MECHANICAL

SCALE: 1/8" = 1'-0"

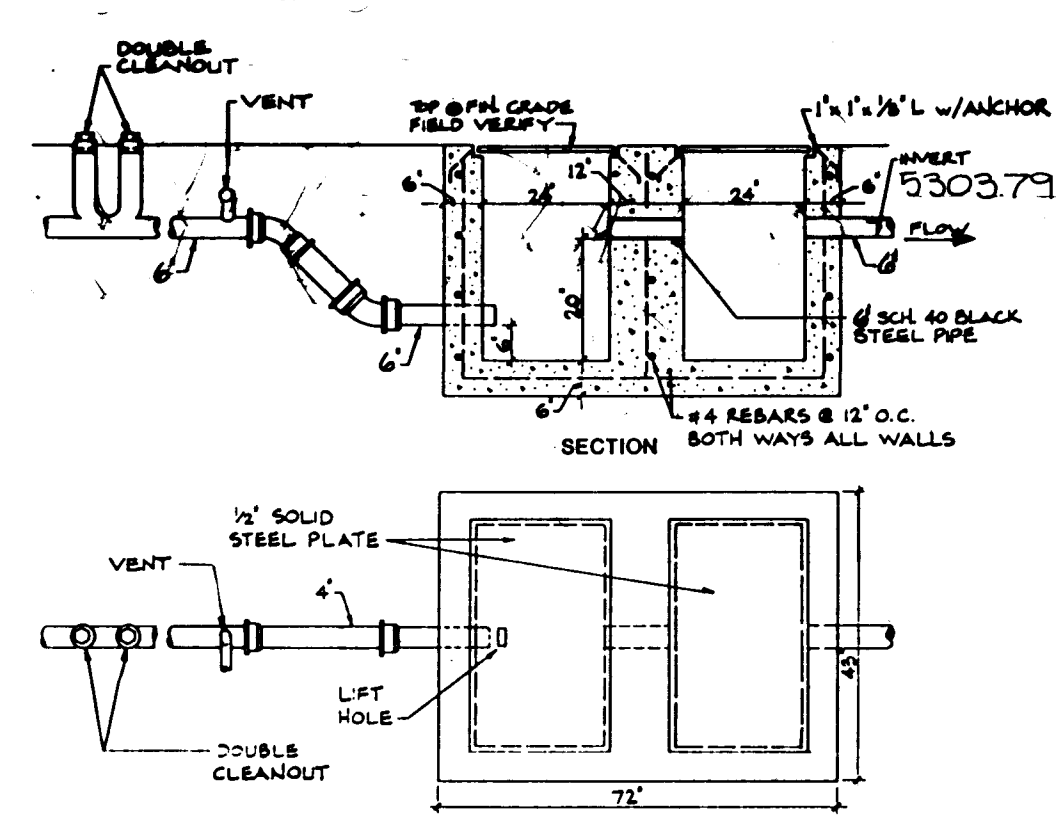

SAND TRAP DETAIL

NO SCALE

DOUBLE CLEANOUT DETAIL

NO SCALE



CLEANOUT DETAIL

NO SCALE



BPLW

Architects & Engineers, Inc.
American Financial Center #5
Suite 400
2400 Louisiana Blvd. NE
Albuquerque, New Mexico 87110
505/881-BPLW


Designing to Shape the Future

GENERAL NOTE

- FLASHINGS TO BE OF THE TYPE RECOMMENDED BY THE BUILDING MANUFACTURER AND BE COMPATIBLE TO THE SLOPE AND SHAPE OF THE ROOF.

SYMBOL LEGEND

SYMBOL	DESCRIPTION
1	ROUND DUCT-OPEN @ CUT LINE
2	SUPPLY DUCT UP
3	SUPPLY DUCT DOWN
4	SQUARE-TO-ROUND FITTING
5	DRUM LOUVER
6	FLEXIBLE DUCT CONNECT
7	LOUVER WITH BIRDSCREEN
8	MOTORIZED DAMPER
9	THERMOSTAT
10	RISE OR DROP IN PIPE
11	RISE IN PIPE TO NEXT LEVEL
12	DROP IN PIPE TO NEXT LEVEL
13	DRAIN LINE
14	CARBON MONOXIDE DETECTOR
15	DIRECTION OF FLOW
16	W.C. WALL CLEANOUT
17	W.H. WALL HYDRANT
18	PLUG COCK
19	SOIL LINE
20	FLOOR CLEANOUT
21	VENT LINE
22	COLD WATER
23	HOT WATER
24	GATE VALVE
25	RISE IN PIPE
26	EXISTING WATER (SITE)
27	EXISTING SEWER (SITE)
28	EXISTING GAS (SITE)
29	NEW WATER (SITE)
30	NEW SEWER (SITE)
31	NEW GAS (SITE)
32	DOUBLE CLEANOUT
33	CLEANOUT
34	HOSE BIB

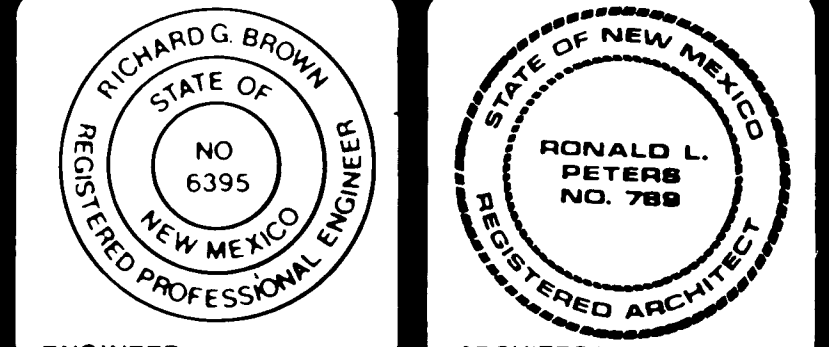

VEHICLE STORAGE BUILDING
ALBUQUERQUE INTERNATIONAL AIRPORT
ALBUQUERQUE, NEW MEXICO

CITY PROJ. NO. 3582
PROJECT NO. 8525-23.01
DATE SEPT. 1988

MECHANICAL FLOOR PLAN

DRAWING NO. M1

SHEET OF

BPLW

Architects & Engineers, Inc.

American Financial Center #5
Suite 400
2400 Louisiana Blvd. NE
Albuquerque, New Mexico 87110
505-881-8PLW

Designing to Shape the Future


KEYED NOTES

- HAND DIG BENEATH EXISTING CMU SCREEN WALL.
- SAW CUT AND TRENCH EXISTING CONCRETE WALK. PATCH TO MATCH EXISTING. COORDINATE INSTALLATION OF SECONDARY WITH EXISTING LANDSCAPING TO MINIMIZE DAMAGE TO TREES, SHRUBS, ETC.
- STUB SECONDARY CONDUIT UP FLUSH WITH EXISTING TRANSFORMER PAD.
- 4# 1/0 + 1#6 GRD. IN 2" C.
- 200A METER SOCKET PER PNM DRAWING #DS-19-11.4.
- 100A-3P+SN, 600V, FUSIBLE DISCONNECT SWITCH, FUSED AT 100 AMPS, NEMA 4 ENCLOSURE.
- 1#6 BSD C.U. GRD.
- 3#4 IN 1-1/4" C.
- 1#8 BSD C.U. GRD.
- 4# 1/0 IN 2" C.

RECORD DRAWING



Information shown on this document has been compiled from the construction record drawing provided to the Architect by the General Contractor, which show the reported location of changes in the work.

By: *[Signature]*
BPLW ARCHITECTS & ENGINEERS, INC.
Date: 12/22/89

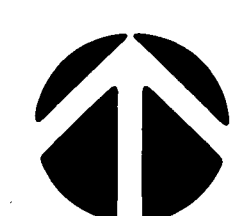

SITE PLAN - ELECTRICAL

SCALE: 1"=20'-0"

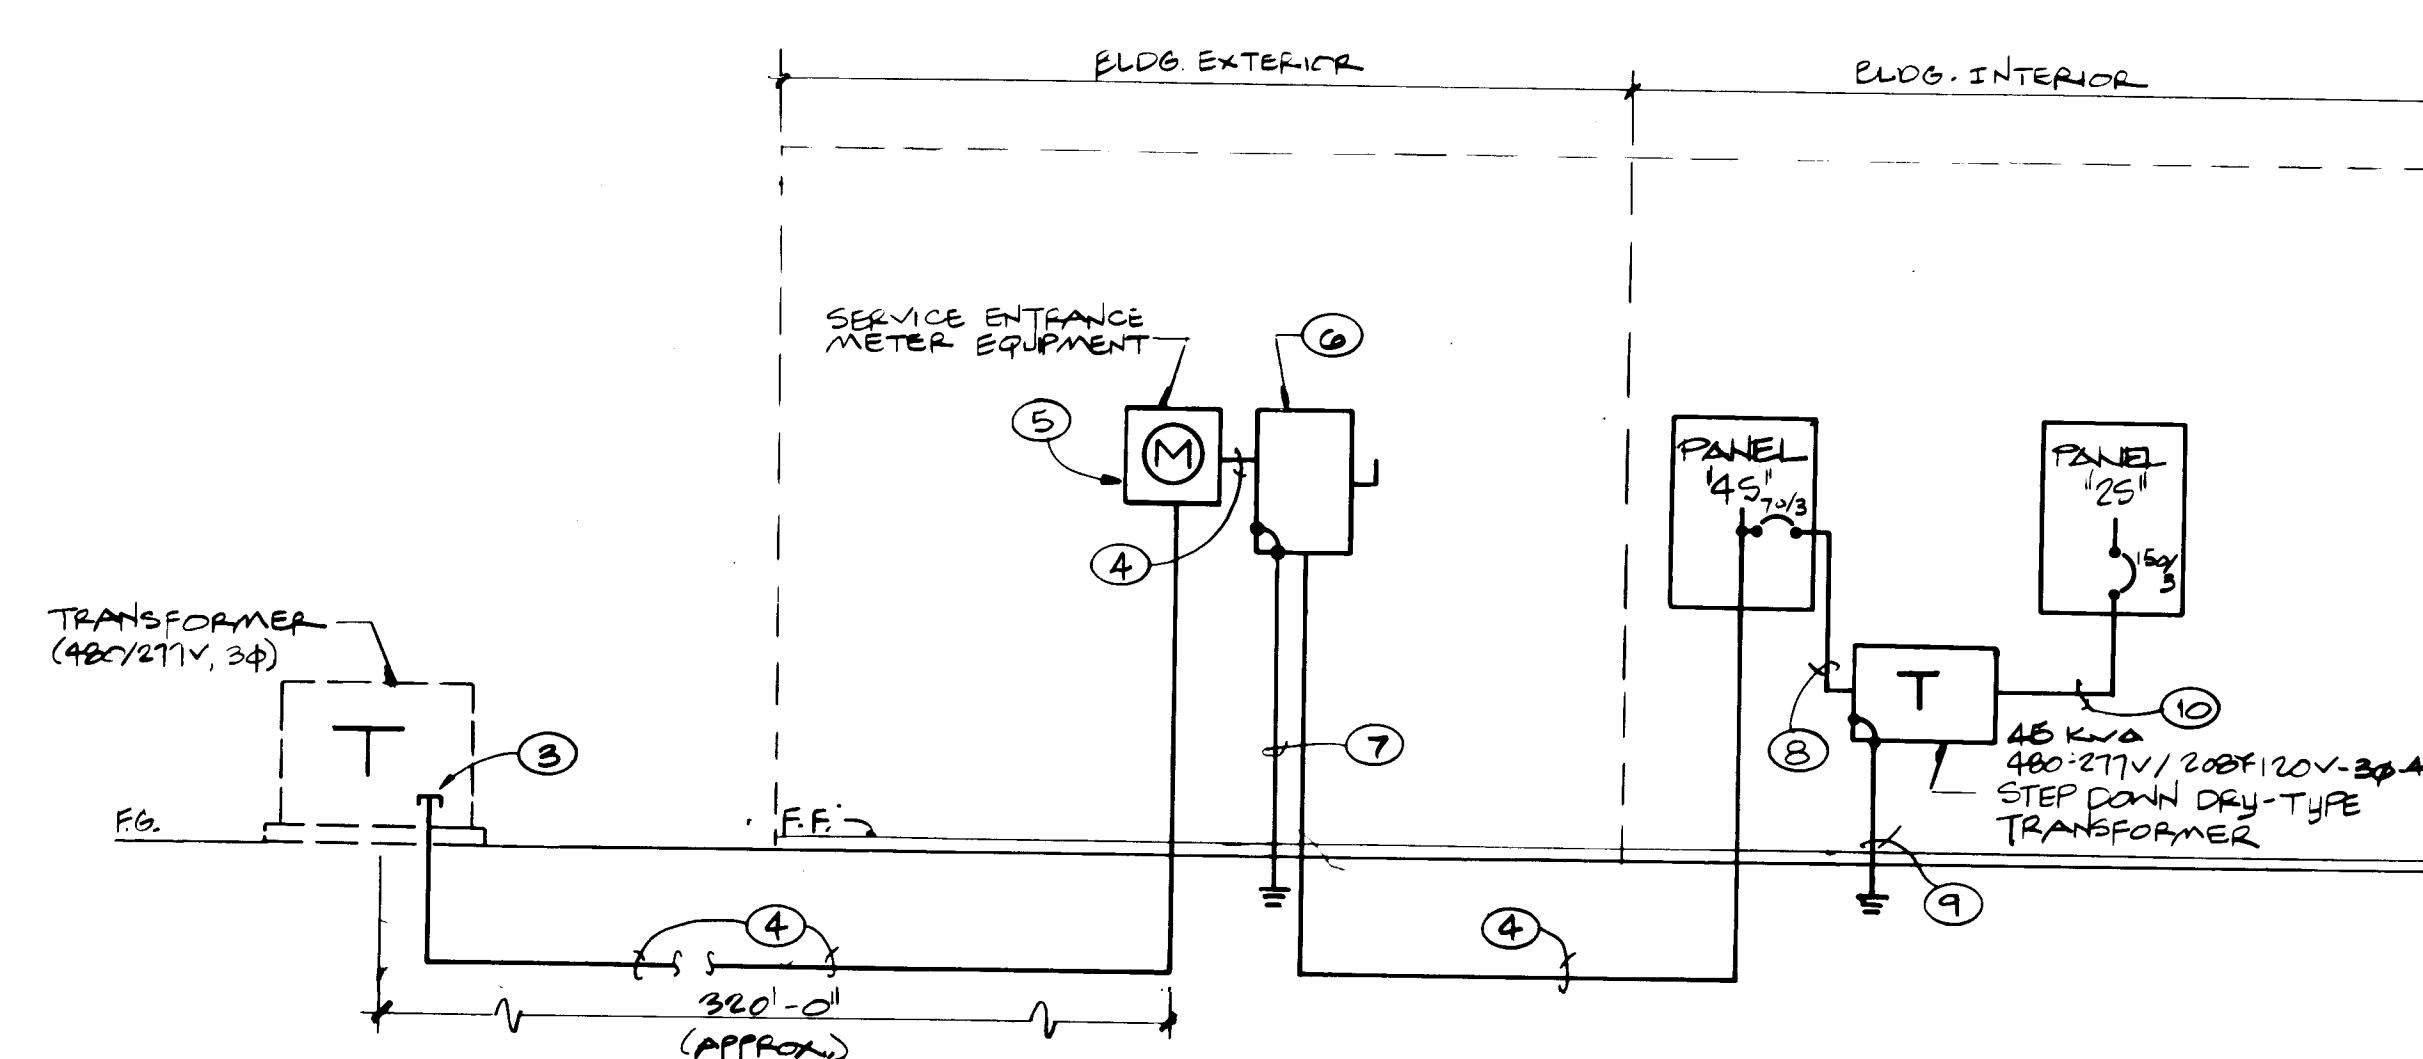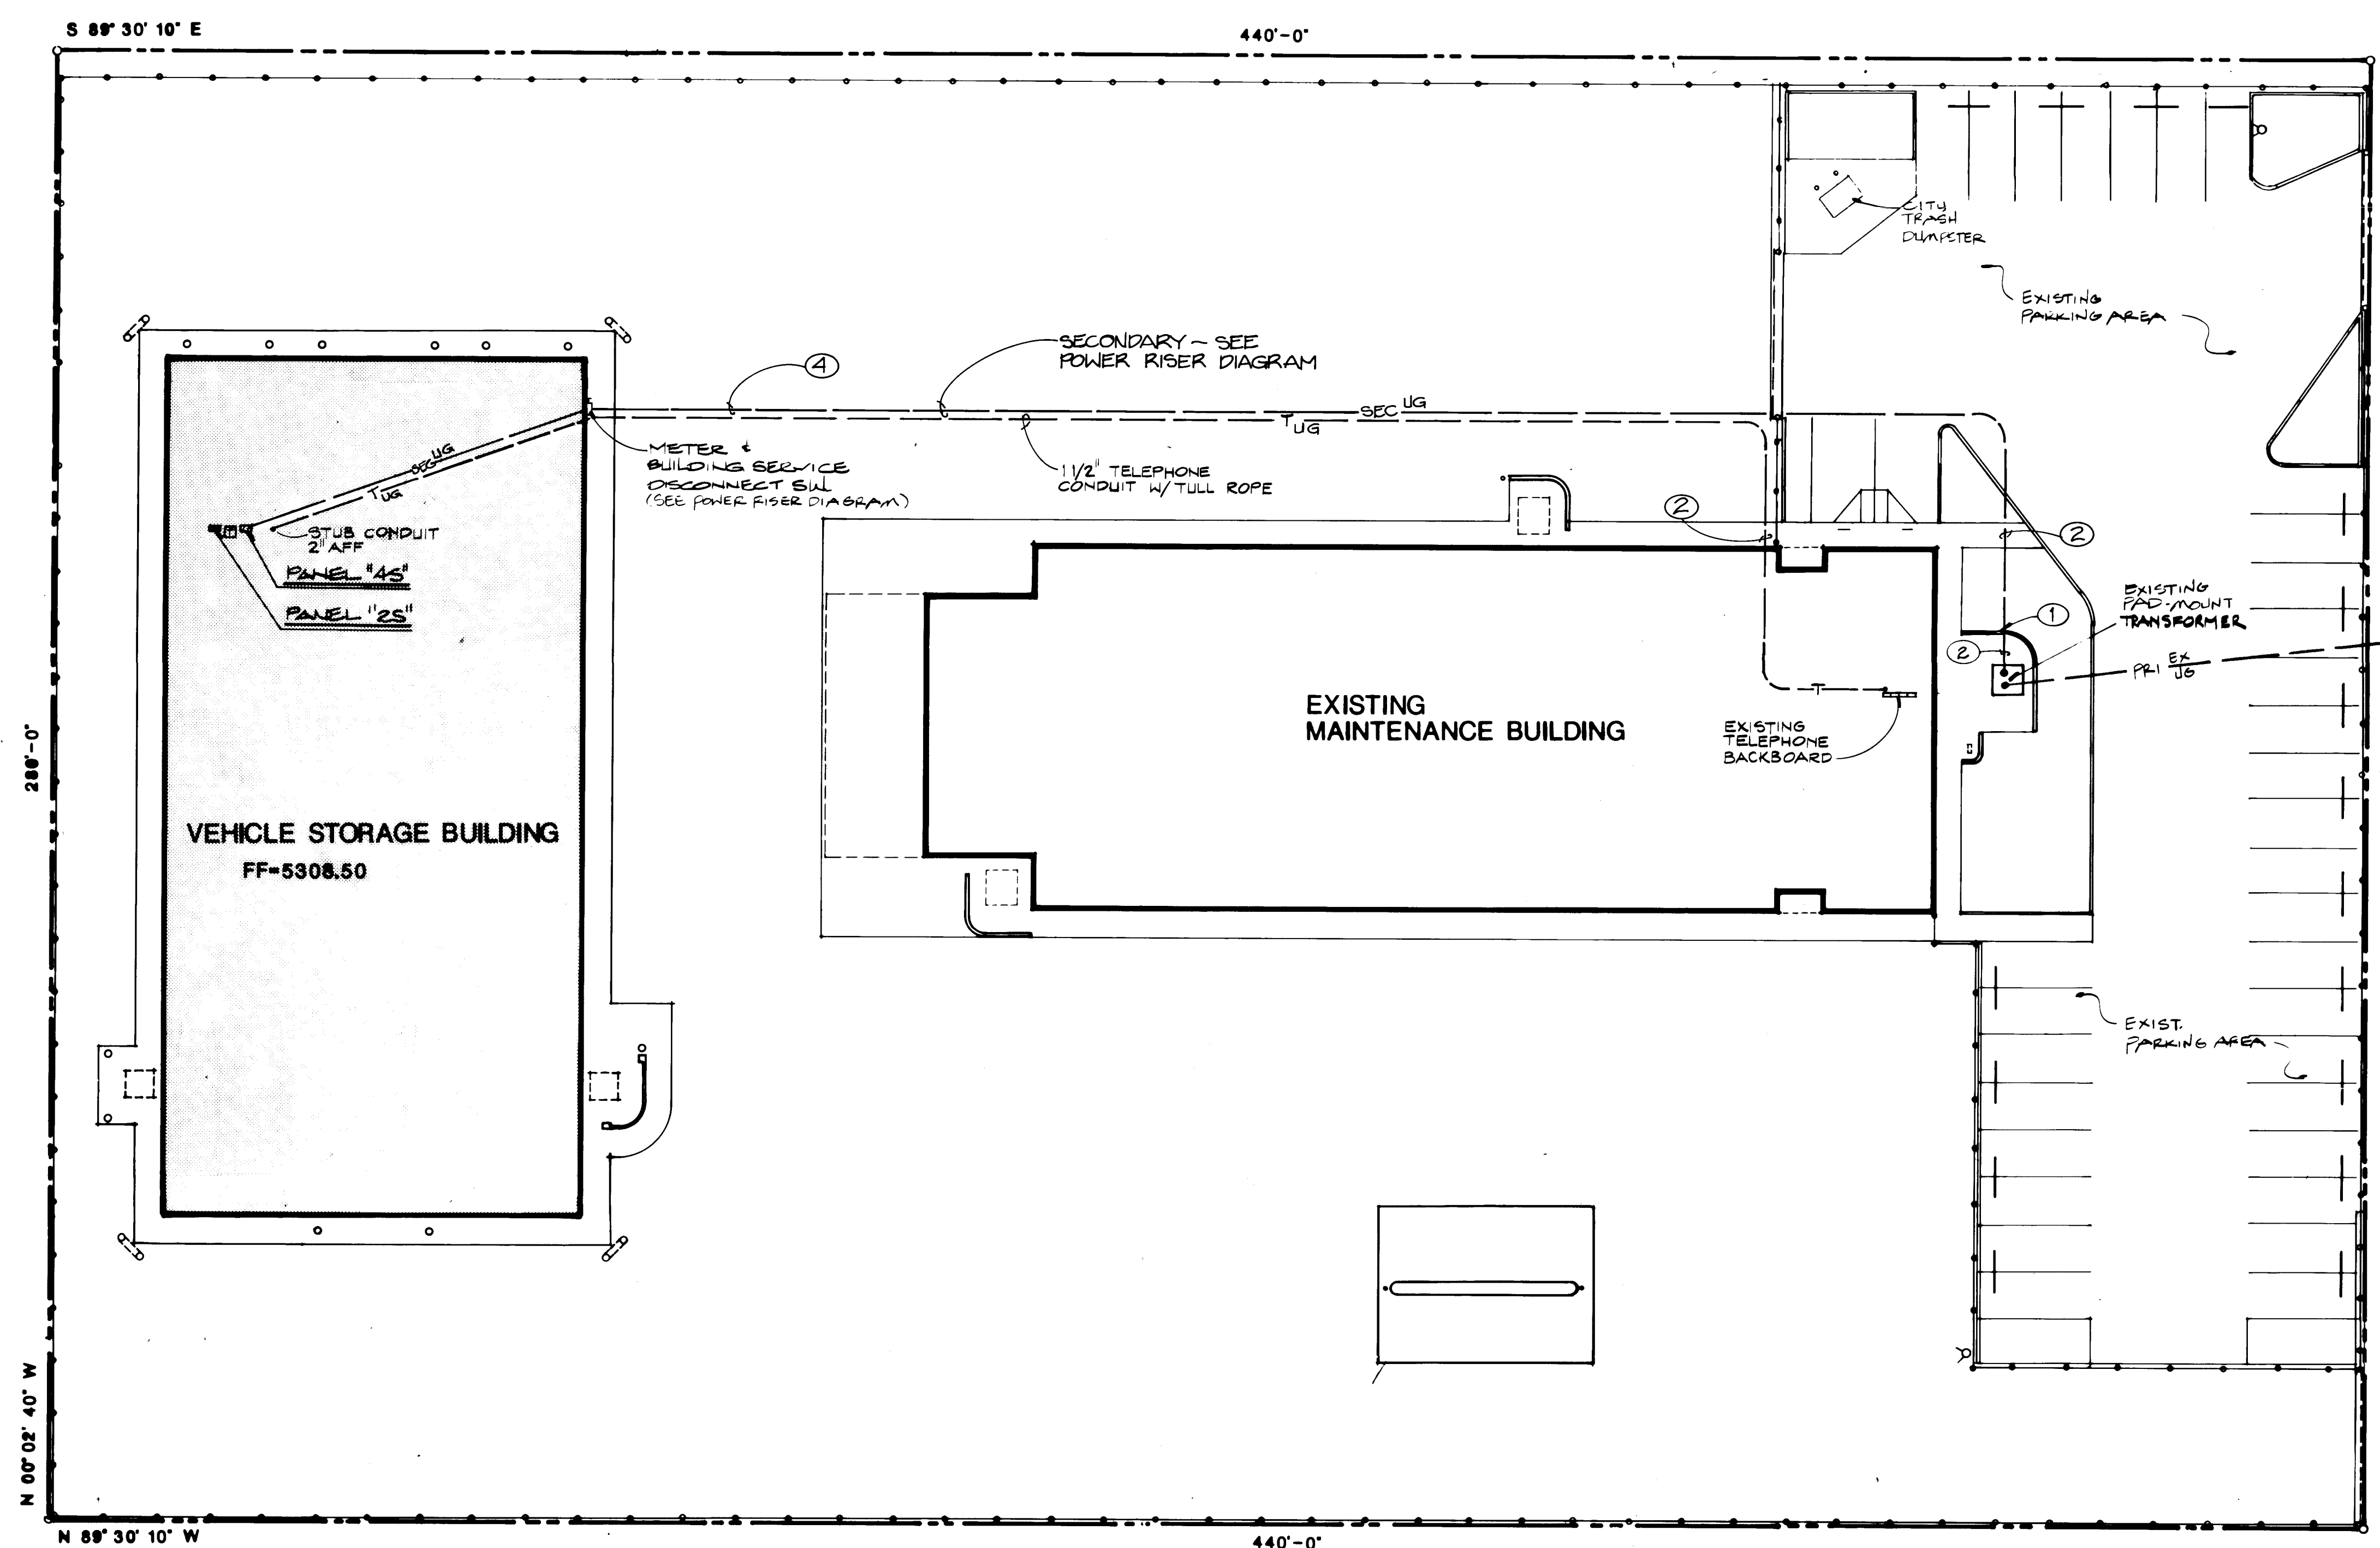

POWER RISER DIAGRAM
NO SCALE



LOAD SUMMARY - 277/480V, 3P, 4W

LOAD	CONNECTED VA	DEMAND	DEMAND VA
Lights	9,600	125%	12,000
Receptacles	2,700	100%	2,700
Mechanical	12,300	125%	15,375
Mechanical	12,650	100%	12,650
Special Equip.	12,900	80%	10,320
TOTAL	50,150		53,045
		+ 10% growth factor	
		= 58,349.5VA	

SHORT CIRCUIT ANALYSIS

Building Transformer = 150 KVA with 1.2% Z and unlimited primary SCA maximum fault at transformer secondary terminals = 15,083A (480V, 3P)
Use of current limiting fuses in main disconnect switch will limit fault at panel "48" to less than 14,000 A.I.C.
This design conforms with article 290 of the New Mexico Energy Code.

20 315621490

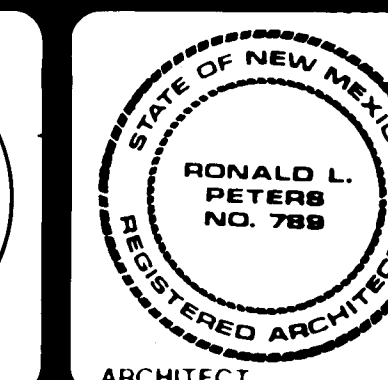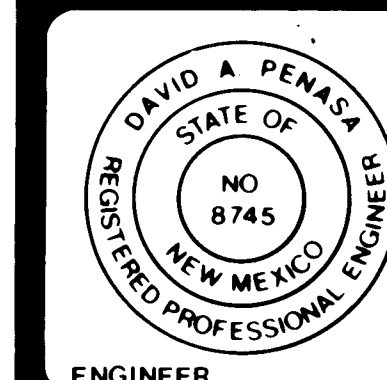

VEHICLE STORAGE BUILDING
ALBUQUERQUE INTERNATIONAL AIRPORT
ALBUQUERQUE, NEW MEXICO

QTY PROJ. NO. 3542

PROJECT NO.
8525-23.01

DATE
SEPT. 1988

SITE PLAN - ELECTRICAL
& RISER DIAGRAM

DRAWING NO.
E0.1
SHEET OF

Hand-drawn floor plan of a building with two rooms, 107 and 106, and a staircase. The plan includes dimensions and a note: "SEE FLOOR PLAN FOR CONT. (TYPE)".


- Room 107:** Located on the left side of the plan. It has a rectangular shape with a door on the left wall. The room number "107" is written inside a box.
- Room 106:** Located on the right side of the plan. It has a rectangular shape with a door on the right wall. The room number "106" is written inside a box.
- Staircase:** Located between Room 107 and Room 106. It is represented by a series of parallel lines indicating the steps.
- Dimensions:**
 - The width of Room 107 is marked as "24".
 - The width of Room 106 is marked as "24".
 - The total width of the building is marked as "48".
 - The depth of the building is marked as "12".
- Note:** "SEE FLOOR PLAN FOR CONT. (TYPE)" is written near the staircase.

 MEZZANINE PLAN – LIGHTING
SCALE: 1/8" = 1'-0"

LIGHT FIXTURE SCHEDULE			
TYPE	LAMPS	MOUNTING	DESCRIPTION
A	2-F96/ HO/WH1	PENDANT TO 12" A.F.F. SURFACE TO STRUCT, IN STOR. WAYS	8' OPEN INDUSTRIAL FLOORESCENT FIXTURE WITH TURNED REFLECTOR AND WIRE GUARD, 277V, ENERGY SAVING BALLAST, 20A UP/LIGHT: LITHONIA #AFI0236-8Q-277-85-SQ- 12MG3.
B	2-F40/LW/ RS/WH1	WALL, +B.C. A.F.F.	4' FLOURESCENT WALL FIXTURE WITH PRISMATIC ACRYLIC LENS, 277V, ENERGY SAVING BALLAST, LITHONIA #WS240-12-277-ES-DE.
C	1-100W- HPS	WALL, +B.C. HPS	H.I.D. WALLPACK FIXTURE WITH CAST ALUMINUM HOUSING, SPECULAR ALUMINUM PRISMATIC BOROSILICATE REFLECTOR, GLASS LENS, 877V HPS BALLAST, DARK BRONZE FINISH, LITHONIA #TWH-100S-277.
D	2-9W-HIT 6V	WALL, +B.C. A.F.F.	EMERGENCY BATTERY PACK UNIT WITH 2 DIRECTIONAL LIGHTING HEADS &V DISCONNECT, 6V NICKEL CADMIUM BATTERY. EMERGITTE #JSC1A-2(1A).
E	2-20W- 20TC 1/2 AND 2-3W-4V	WALL, +B.C. A.F.F.	SELF POWERED SINGLE FACE INCANDESCENT EXIT SIGN WITH DOWNLIGHT, RED LETTERS WITH BRUSHED ALUM. STENCIL PACK, DIE CAST ALUM. HOUSING, 120V/277V. EMERGITTE #BSEK72-F. -20W=20W-100V EXIT FIXTURE

LIGHT FIXTURE SCHEDULE NOTES:

- A. SUBMIT FOR APPROVAL, COMPLETE SHOP DRAWINGS, CATALOG CUTS, SPECIAL INSTALLATION INSTRUCTIONS, PHOTOMETRIC DATA AND DESCRIPTIVE LITERATURE. INCOMPLETE SUBMITTALS WILL BE RETURNED. WHEN SUBMITTALS ARE PROCESSED FOR SUBSTITUTION PRIOR APPROVAL HAS NOT BEEN ISSUED, THE SUBMITTAL FOR APPROVAL SHALL INCLUDE CATALOG CUTS OF BOTH THE SPECIFIED AND PROPOSED FIXTURES.
- B. VERIFY FIXTURE TYPES WITH SPECS TO ASSURE THAT ALL FEATURES IN FIXTURE DESCRIPTION ARE INCLUDED.
- C. VERIFY MOUNTING HEIGHTS OF ALL SUSPENDED AND WALL MOUNTED FIXTURES WITH ARCHITECT/ENGINEER.
- D. FURNISH PROPER CEILING FRAMES FOR THE CEILING IN WHICH RECESSED FIXTURES ARE TO BE INSTALLED. VERIFY PROTO QUANTITY.

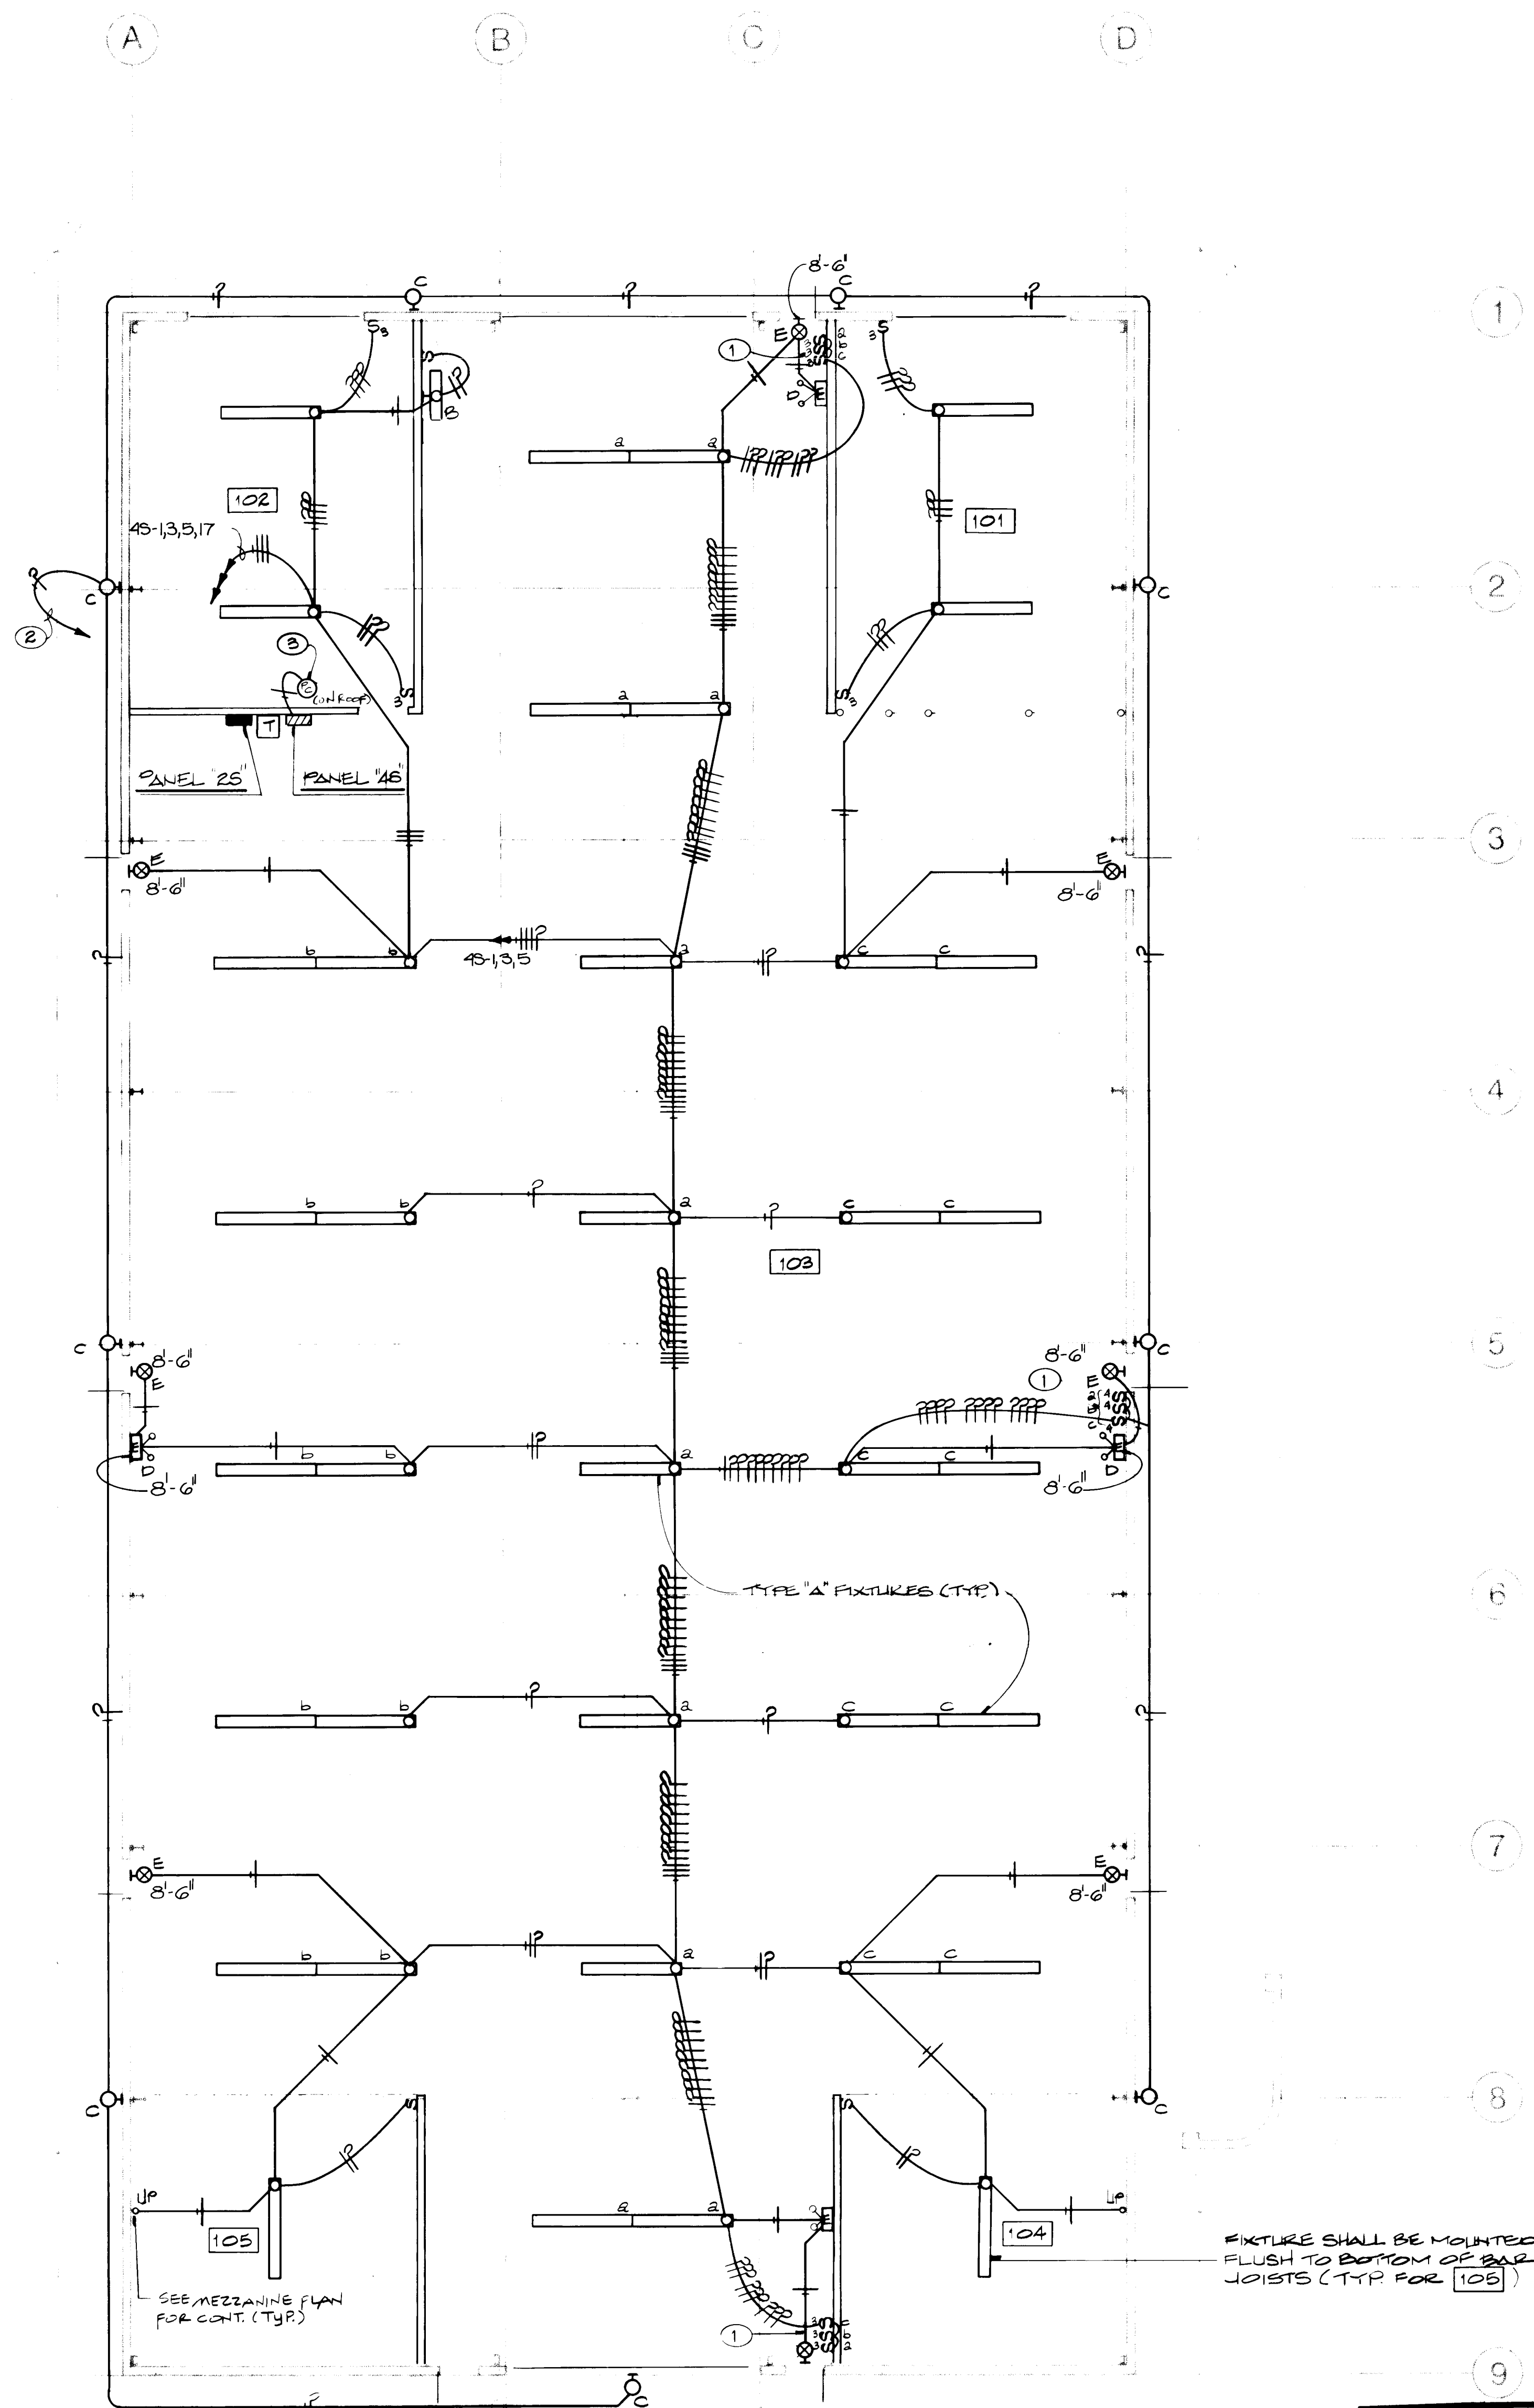

 FLOOR PLAN – LIGHTING
SCALE: 1/8" = 1'-0"

RECORD DRAWING

Information shown on this document has been compiled from the construction record drawing provided to the Architect by the General Contractor, which show the reported location of changes in the work.

By: Clyde Mason
BPLW ARCHITECTS & ENGINEERS, INC.
Date: 12/22/89

BPLW

Architects & Engineers, Inc.
American Financial Center #5
Suite 400
2400 Louisiana Blvd. NE
Albuquerque, New Mexico 871
505/881-BPLW



Designing to Shape the future

GENERAL NOTES

- GENERAL NOTES**
- A. ALL LIGHT FIXTURES THIS PLAN SHALL BE TYPE "A" UNLESS OTHERWISE INDICATED.
 - B. ALL LIGHTING CIRCUITS SHALL BE #10 AWG (TYPICAL).
 - C. THE CONDUIT RUNS AS SHOWN ON THE DRAWINGS INDICATE APPROXIMATE ROUTING. EXACT LOCATION OF CONDUIT RUNS SHALL BE PER FIELD CONDITIONS.

KEYED NOTES

1. THREE (3) SWITCHES OF TYPE INDICATED SHALL CONTROL FIXTURES AS INDICATED (a,b,c).
2. EXTEND CIRCUIT INDICATED THRU PHOTOCELL ON ROOF.
3. TORX #101 PHOTOCELL ON ROOF FOR CONTROL OF TYPE "C" FIXTURES.

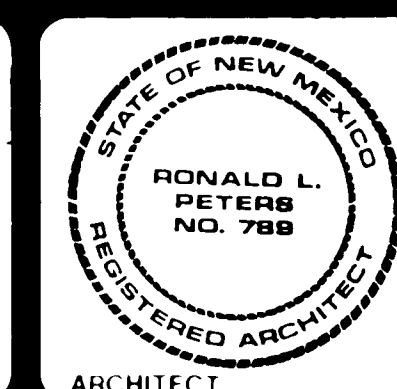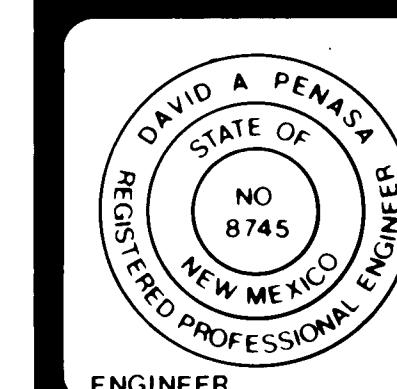

VEHICLE STORAGE BUILDING
ALBUQUERQUE INTERNATIONAL AIRPORT
ALBUQUERQUE, NEW MEXICO

CITY PROJ. NO. 3502

PROJECT NO.
8525-23.01

DATE
SEPT. 1988


LIGHTING PLAN

DRAWING NO.

DRAWING NO
E1.0
SHEET OF

E2.O	E2.C
------	------

NOTE:
SEE PANEL DIRECTORY BELOW
FOR AS BUILT PANEL CONDITION


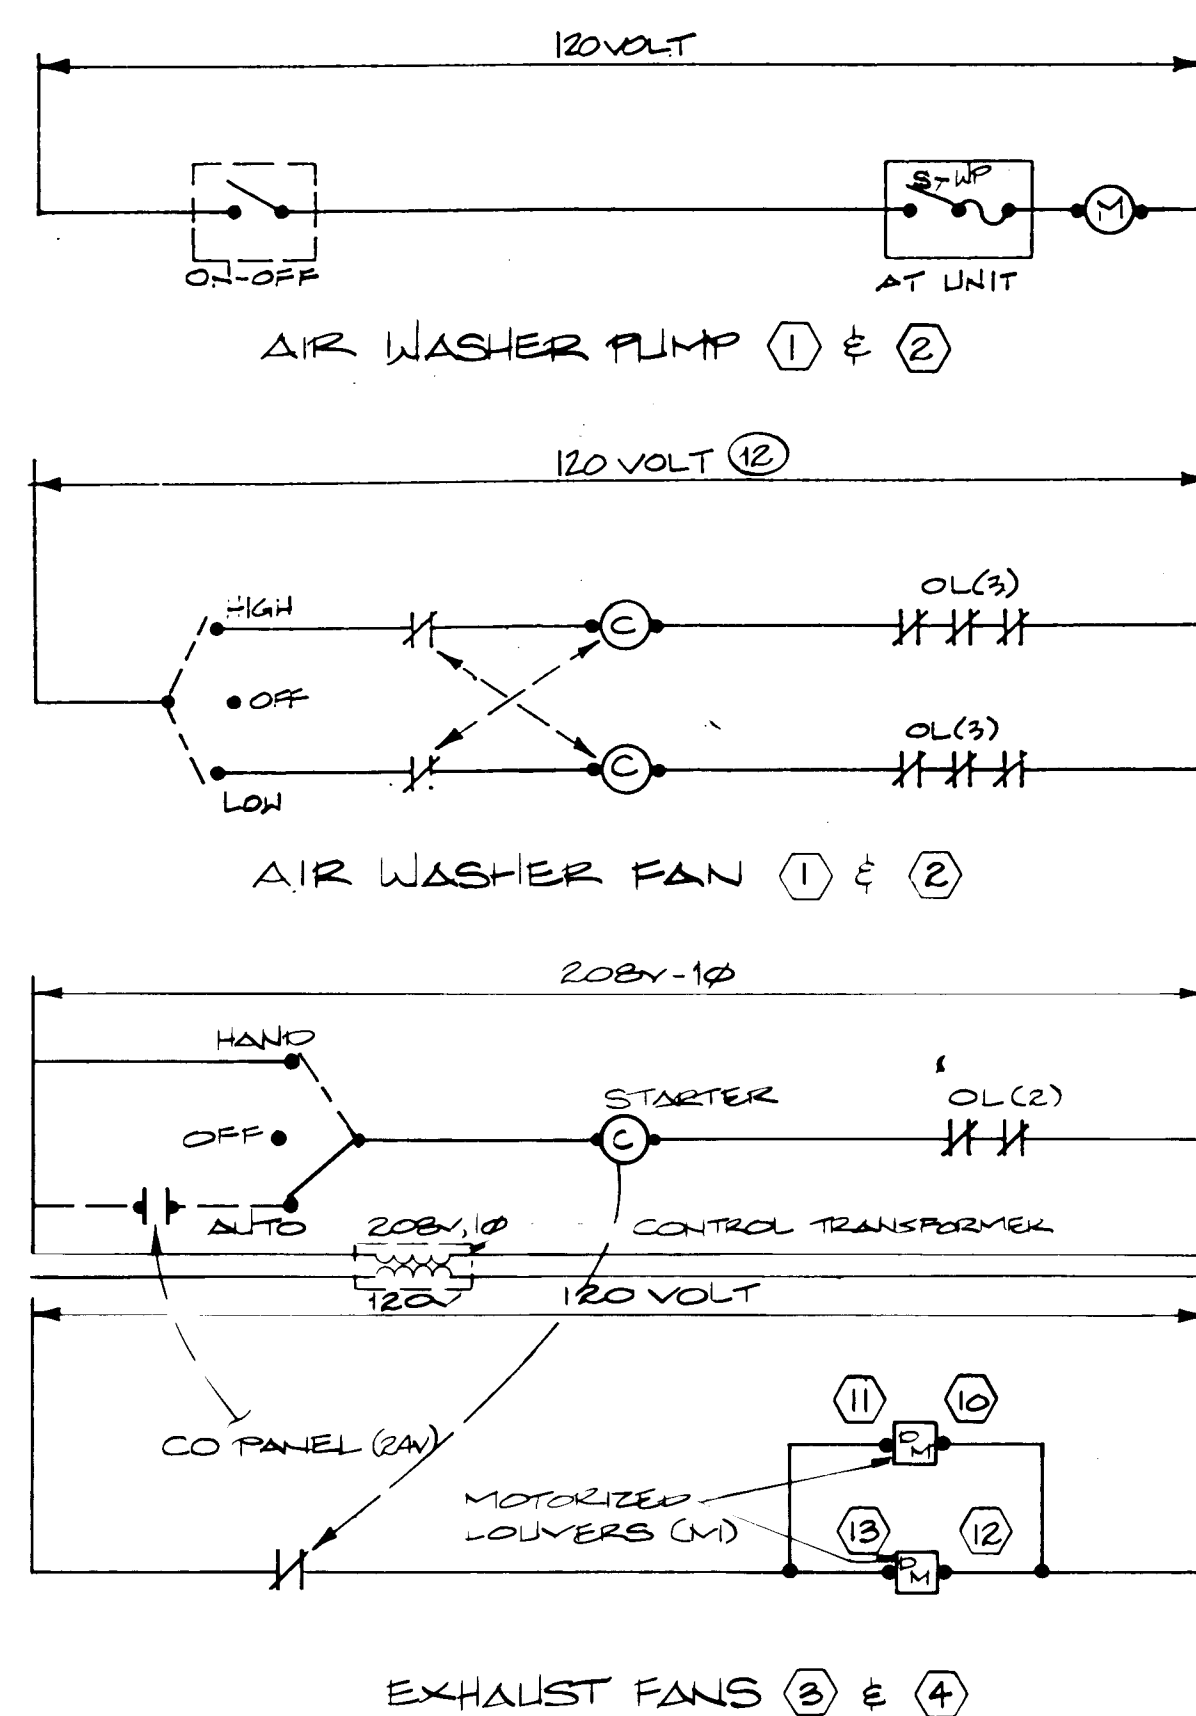


CONTROL DIAGRAMS

PANEL DIRECTORY			
PANEL '2S'			
CIRCUIT	NO.	NO.	CIRCUIT
RECEPTACLES	1	2	NORTH REARER
RECEPTACLES	3	4	SOUTH REARER
C.O. DETECTOR	5	6	EAST A/C
	7		
	8	10	
	9	12	
SOUTH EXHAUST FAN	13	14	
SOUTH EXHAUST FAN	15	16	
HOT WATER HEATER	17	18	NORTH EXHAUST FAN
HOT WATER HEATER	19	20	SOUTH EXHAUST FAN
PANEL '4S'			
CIRCUIT	NO.	NO.	CIRCUIT
MIDDLE LIGHTS	1	2	EAST CONVEYOR
EAST LIGHTS	3	4	EAST CONVEYOR
WEST LIGHTS	5	6	EAST CONVEYOR
MIDDLE NORTH DOOR	7	8	WEST CONVEYOR
MIDDLE NORTH DOOR	9	10	WEST CONVEYOR
MIDDLE NORTH DOOR	11	12	WEST CONVEYOR
	13		
	14	15	
LIGHT CONVEYOR ROOM	17	18	
EAST ELEVATOR	19	20	NORTHEAST DOOR
EAST ELEVATOR	21	22	NORTHEAST DOOR
EAST ELEVATOR	23	24	NORTHEAST DOOR
SOUTHEAST A/C	25	26	NORTHEAST DOOR
SOUTHEAST A/C	27	28	NORTHEAST DOOR
SOUTHEAST A/C	29	30	NORTHEAST DOOR
SOUTHEAST A/C	31	32	WEST ELEVATOR
SOUTHEAST A/C	33	34	WEST ELEVATOR
SOUTHEAST A/C	35	36	WEST ELEVATOR
SOUTH MIDDLE DOOR	37	38	SUB-FEED PANEL #28*
SOUTH MIDDLE DOOR	39	40	SUB-FEED PANEL #29*
SOUTH MIDDLE DOOR	41	42	SUB-FEED PANEL #30*

ELECTRICAL LEGEND	
SYMBOL	DESCRIPTION
	RECESSED ROUND LIGHT FIXTURE. SEE SCHEDULE FOR TYPE.
	WALL MOUNTED LIGHT FIXTURE.
	EXIT LIGHT FIXTURE. ARROWS AND FACES AS INDICATED.
	SURFACE MOUNTED FLUORESCENT LIGHT FIXTURE. SEE LIGHT FIXTURE SCHEDULE FOR MOUNTING HEIGHT.
	LAY-IN CEILING FLUORESCENT FIXTURE WITH J-B & FLEXIBLE CONDUIT.
	WALL SWITCH. SPST, 48" AFF UNLESS NOTED OTHERWISE. LETTER INDICATES CONTROL.
	3-WAY WALL SWITCH.
	MANUAL MOTOR STARTER WITH THERMAL OVERLOAD PROTECTION.
	DUPLEX CONVENIENCE RECEPTACLE .18" AFF UNLESS NOTED OTHERWISE.
	MOTOR OUTLET AND HP. SIZE.
	THERMOSTAT (M), .48" AFF UNLESS NOTED OTHERWISE.
	JUNCTION BOX AS NOTED AND/OR REQUIRED.
	ELECTRICAL KEYED NOTE.
	DISCONNECT SWITCH.
	ELECTRICAL PANEL, FLUSH MOUNTED.
	3/4" X 8"-O HIGH X LENGTH INDICATED PLYWOOD TELEPHONE TERMINAL BOARD.
	RACEWAY CONCEALED IN WALL OR CEILING UNLESS OTHERWISE NOTED.
	RACEWAY CONCEALED IN FLOOR.
	RACEWAY, UNDERGROUND.
	TELEPHONE RACEWAY.
	HOMERUN TO PANEL BOARD. NUMBERS & LETTERS INDICATED CIRCUIT & PANEL DESIGNATION.
	NEUTRAL, HOT, SWITCH AND GROUND CONDUCTORS RESPECTIVELY.
	CONDUIT TURNED DOWN.
	CONDUIT TURNED BUMP.
	GROUND CONNECTION.
	TELEPHONE OUTLET, .18" AFF UNLESS NOTED OTHERWISE.
	WALL TELEPHONE OUTLET, .48" AFF.
	CLOCK OUTLET, .75"-O AFF.
	WEATHERPROOF.
	MECHANICAL EQUIPMENT REFERENCE.
	GROUND FAULT CIRCUIT INTERRUPTER.
	EXISTING TELEPHONE J-BOX AS NOTED.
	EXISTING COMPUTER J-BOX AS NOTED.

NOTE: DISREGARD SYMBOLS NOT USED. SYMBOLS NOT INDICATED ON LEGEND ARE NOTED ON PLAN.

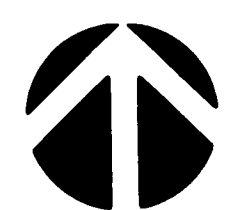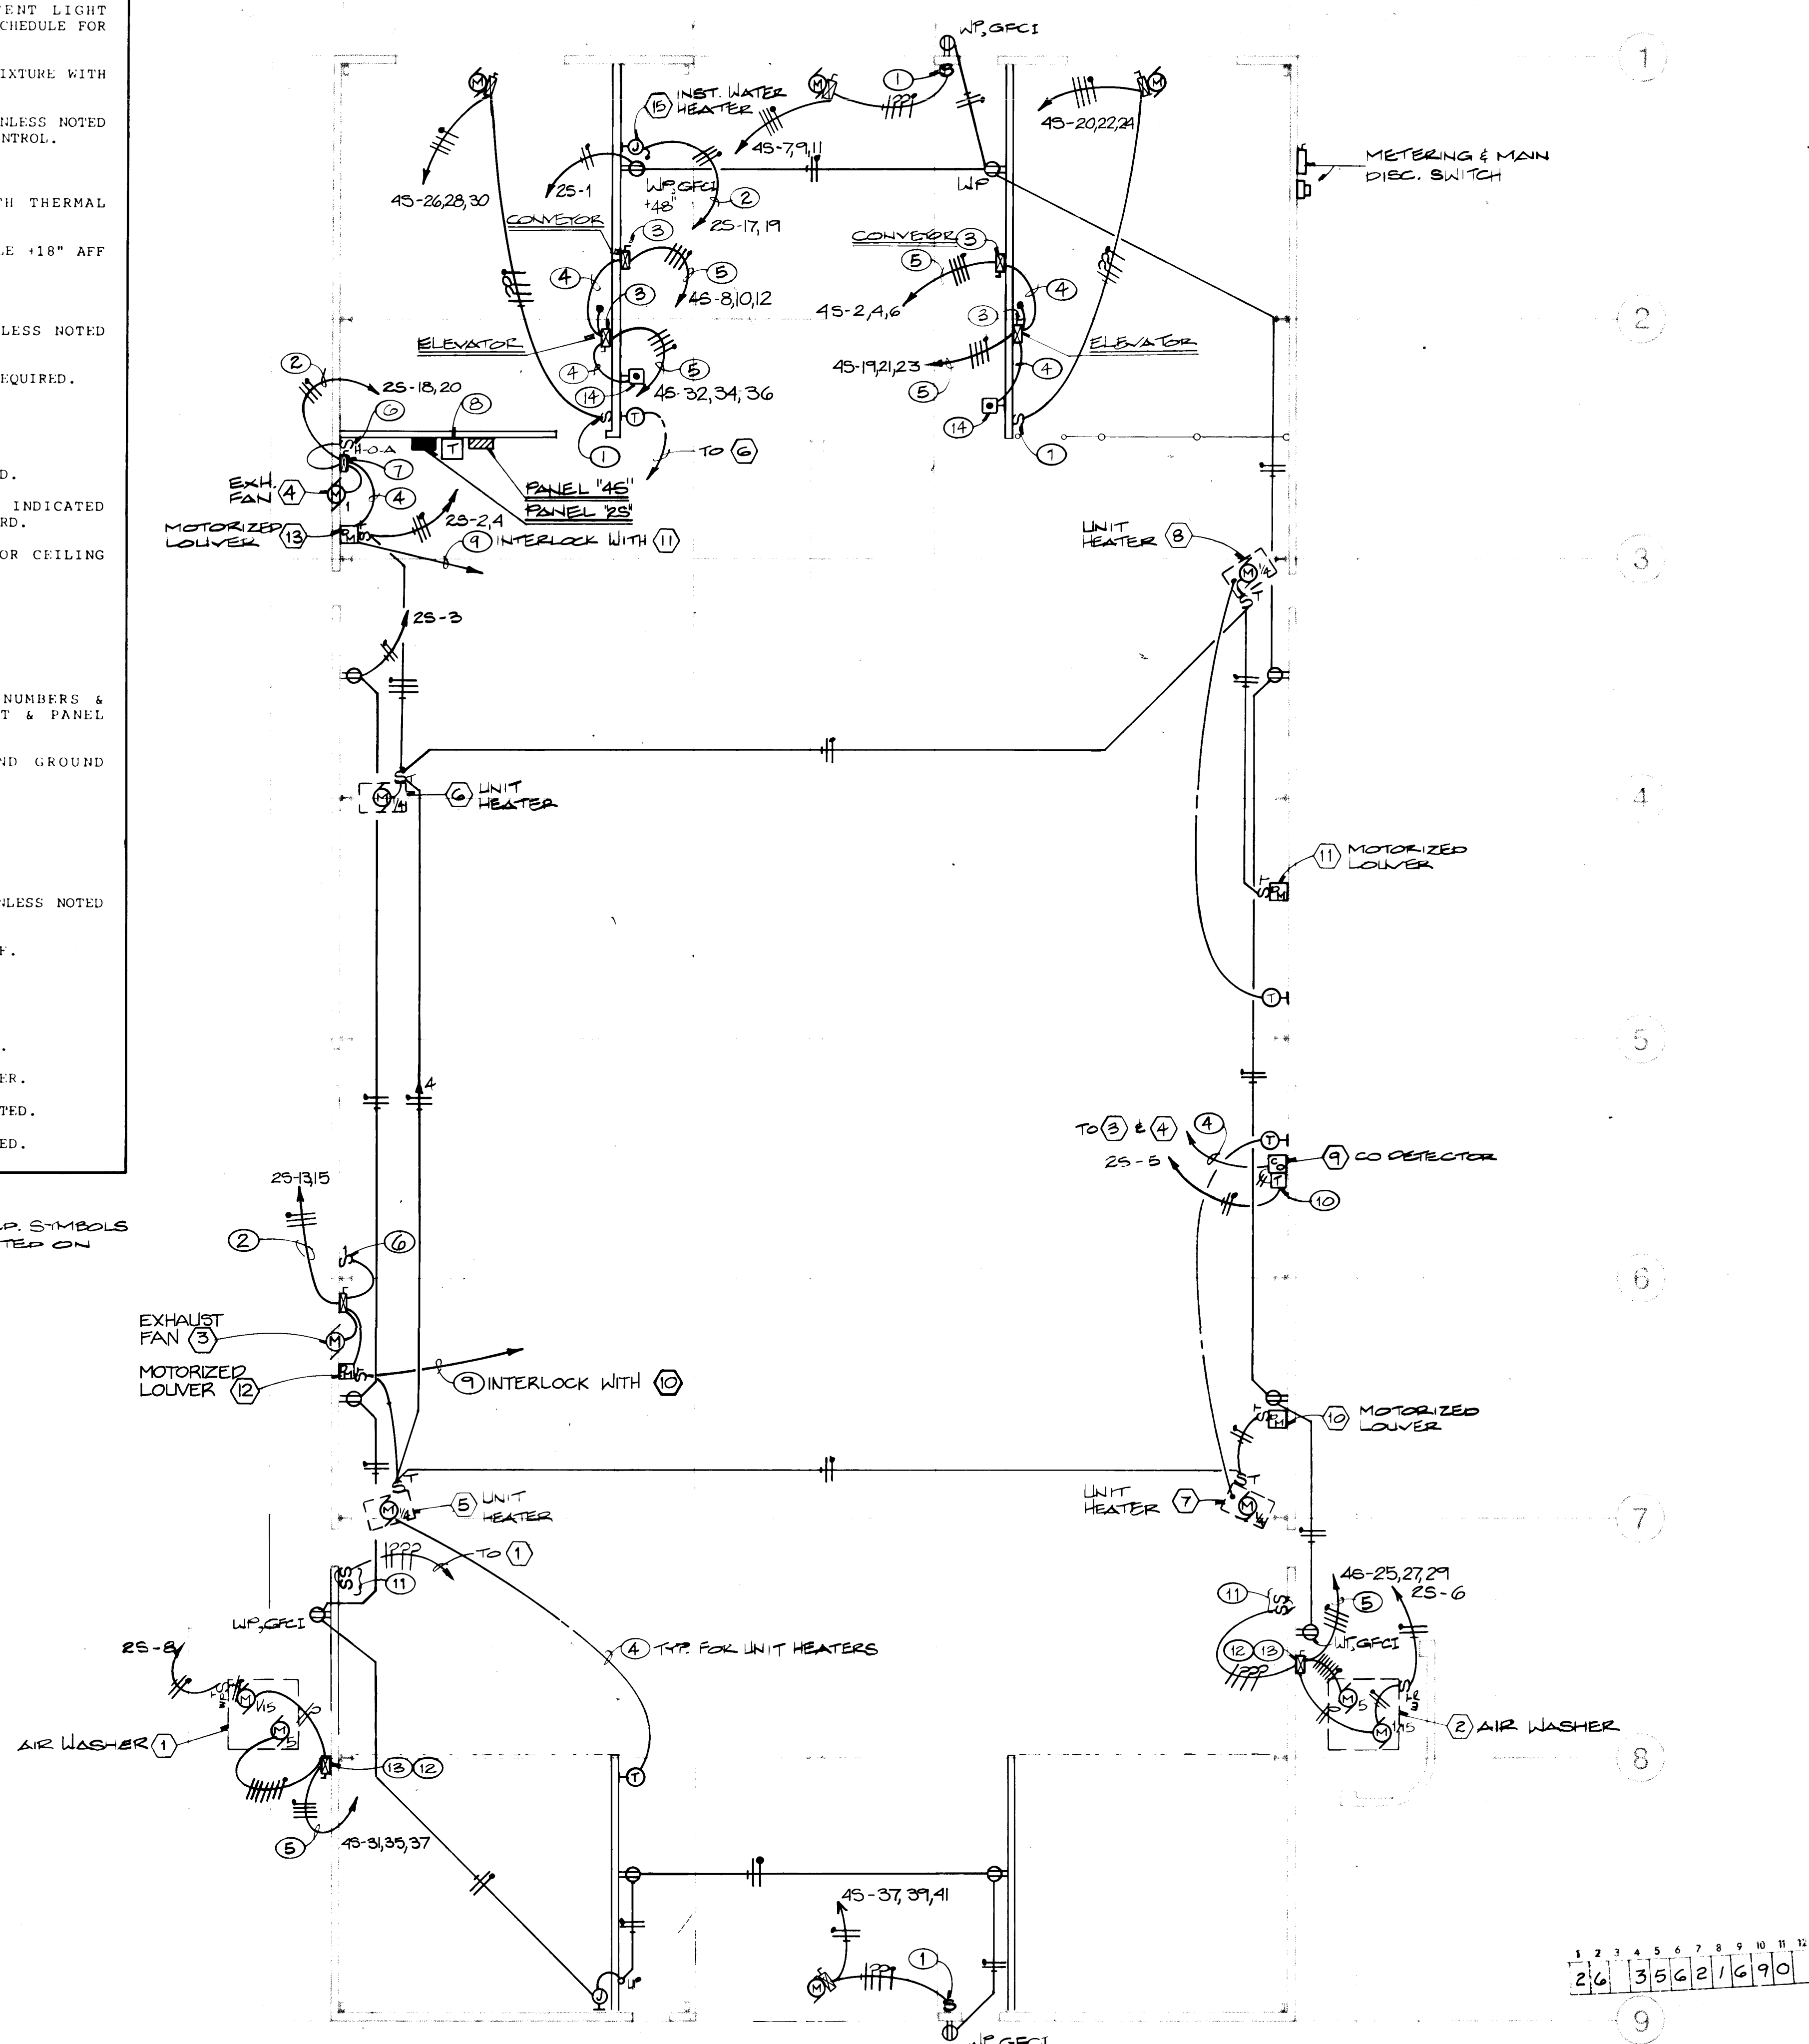

FLOOR PLAN – POWER

RECORD DRAWING

Information shown on this document has been compiled from the construction record drawing provided to the Architect by the General Contractor, which show the reported location of changes in the work.

By: [Signature]
BPLW ARCHITECTS & ENGINEERS, INC.
Date: 12/22/89

BPLW

Architects & Engineers, Inc.
American Financial Center #5
Suite 400
2400 Louisiana Blvd. NE
Albuquerque, New Mexico 871
505/881-BPIW



Designing to Shape the future

GENERAL NOTES

1. THIS CONTRACTOR SHALL COORDINATE WITH THE MECHANICAL CONTRACTOR TO PREVENT CONFLICTS RELATIVE TO LOCATION OF MECHANICAL EQUIPMENT AND CONDUIT ROUGH-IN. VERIFY IN FIELD.
2. LOCATION OF EQUIPMENT, DEVICES, AND FEEDERS AS SHOWN ON THE DRAWINGS ARE APPROXIMATE AND SHALL BE FIELD VERIFIED.
3. THE CONDUIT RUNS AS SHOWN ON THE DRAWINGS INDICATE APPROXIMATE ROUTING. EXACT LOCATION OF CONDUIT RUNS SHALL BE PER FIELD CONDITIONS.
4. ALL RECEPTABLES, SHALL BE INSTALLED UP +2" A.F.F. MINIMUM. CONDUITS AND CONDUCTORS SERVING RECEPTABLES SHALL BE EXTENDED FROM SOURCE.

KEYED NOTES ○

1. PROVIDE 3 POSITION CONTROL STATION (OPEN-CLOSE-STOP) FOR CONTROL OF ROLL UP/DOWN. CONNECT TO OPERATOR PER MANUFACTURER REQUIREMENTS.
2. 246 + 1/2 INCH GRD. IN 1" C.
3. 30A-3P+SN, COMBINATION STARTER/FUSEIBLE DISCONNECT SWITCH, 600V, NEMA SIZE 1 STARTER, NEMA 4 ENCLOSURE, FUSE AT 4 AMPS (CONVEYOR) 1.5 AMPS (ELEVATOR).
4. 1/2" C. WITH CONTROL WIRING AS REQUIRED.
5. 3/12 INCH AND 1/2 INCH GRD. IN 1/2" C.
6. "HAND-OFF-AUTO" SWITCH FOR CONTROL EXHAUST FAN.
7. 30A-3P+SN, COMBINATION STARTER/FUSEIBLE DISCONNECT SWITCH, 250V, NEMA SIZE 1 STARTER, NEMA 4 ENCLOSURE, FUSE AT 4 AMPS. PROVIDE AUXILIARY CONTACTS FOR CONTROL TRANSFORMER AS REQUIRED.
8. 45 KVA DRY TYPE STEP DOWN TRANSFORMER, 480-208/120V, 3P, 4W.
9. 1/2" C. + CONTROL WIRING AS REQUIRED FOR INTERLOCK TO MECH. ELECTRICKICKER.
10. 120V TO 24VAC STEP DOWN TRANSFORMER MOUNTED ADJACENT TO TWO (2) SYSTEM.
11. TWO (2) SWITCHES, 1 SMALL CONTROL PUMP "ON-OFF", THE OTHER SMALL CONTROL FAN "ON-OFF" SHALL COMPLY RESPECTIVELY.
12. PROVIDE 480V TO 120V CONTROL TRANSFORMER. SIZE AS REQUIRED.
13. 30A-3P+SN, COMBINATION 2 SPEED STARTER/FUSEIBLE DISCONNECT SWITCH, 600V, NEMA SIZE 1 STARTER, NEMA 4 ENCLOSURE, FUSE AT 4 AMPS. PROVIDE AUXILIARY CONTACTS AS REQUIRED.
14. CONTROL PUSHBUTTON "START-STOP" SWITCH WITH ADJUSTABLE TIME DELAY RELAY IN NEMA 4 ENCLOSURE FOR CONVEYOR. PROVIDE CONTROL SEQUENCE AS FOLLOWS:
"STOP" - CONVEYOR "ON" - 30 SEC.
"STOP" - ELEVATOR "ON".
"STOP" - ELEVATOR "OFF" - 30 SEC.
"STOP" - CONVEYOR "OFF" - 30 SEC.

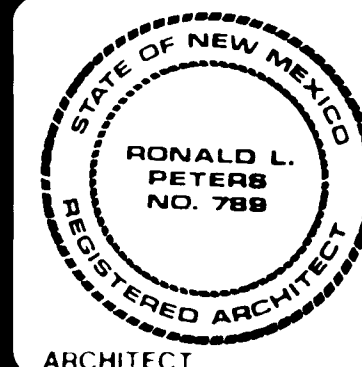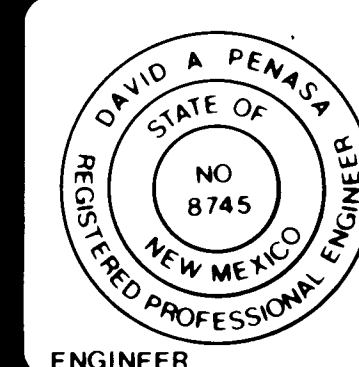

VEHICLE STORAGE BUILDING
ALBUQUERQUE INTERNATIONAL AIRPORT
ALBUQUERQUE, NEW MEXICO

CITY PROJ. NO. 358.

PROJECT NO. 8525-23.01

SEPT. 1988

POWER PLAN

DRAWING NO.

DRAWING NO
E2.0
 SHEET OF

File No. Z-1449-1 PHASE ONE

I certify that this Site Development Plan is in accordance with the Environmental Planning Commission's decision of March 4, 1986 and May 15, 1986 and that all conditions have been met.

Richard D. Dineen 11/14/86
Planning Director

Approved as to Requirements:

Frank J. Cugini 11-12-86
City Engineer

Joe E. Entegrand 11-12-86
City Engineer

James H. Shaw 11-12-86
Public Works Director

Richard D. Dineen 11-12-86
Planning Director

APPROVED

File No. Z-1449-1 PHASE TWO

I certify that this Site Development Plan is in accordance with the Environmental Planning Commission's decision of March 4, 1986, May 15, 1986, and June 11, 1987, and that all conditions have been met.

Frank C. Cugini 10/5/87
Planning Director

Approved as to Requirements:

Frank J. Cugini 10/5/87
City Engineer


James H. Shaw 9-22-87
City Engineer

James H. Shaw 9-22-87
Public Works Director

David W. Hamann 9/22/87
Planning Director

APPROVED

REVISION PER FILE: Z-1449-3
JUNE 11, 1987 EPC MEETING

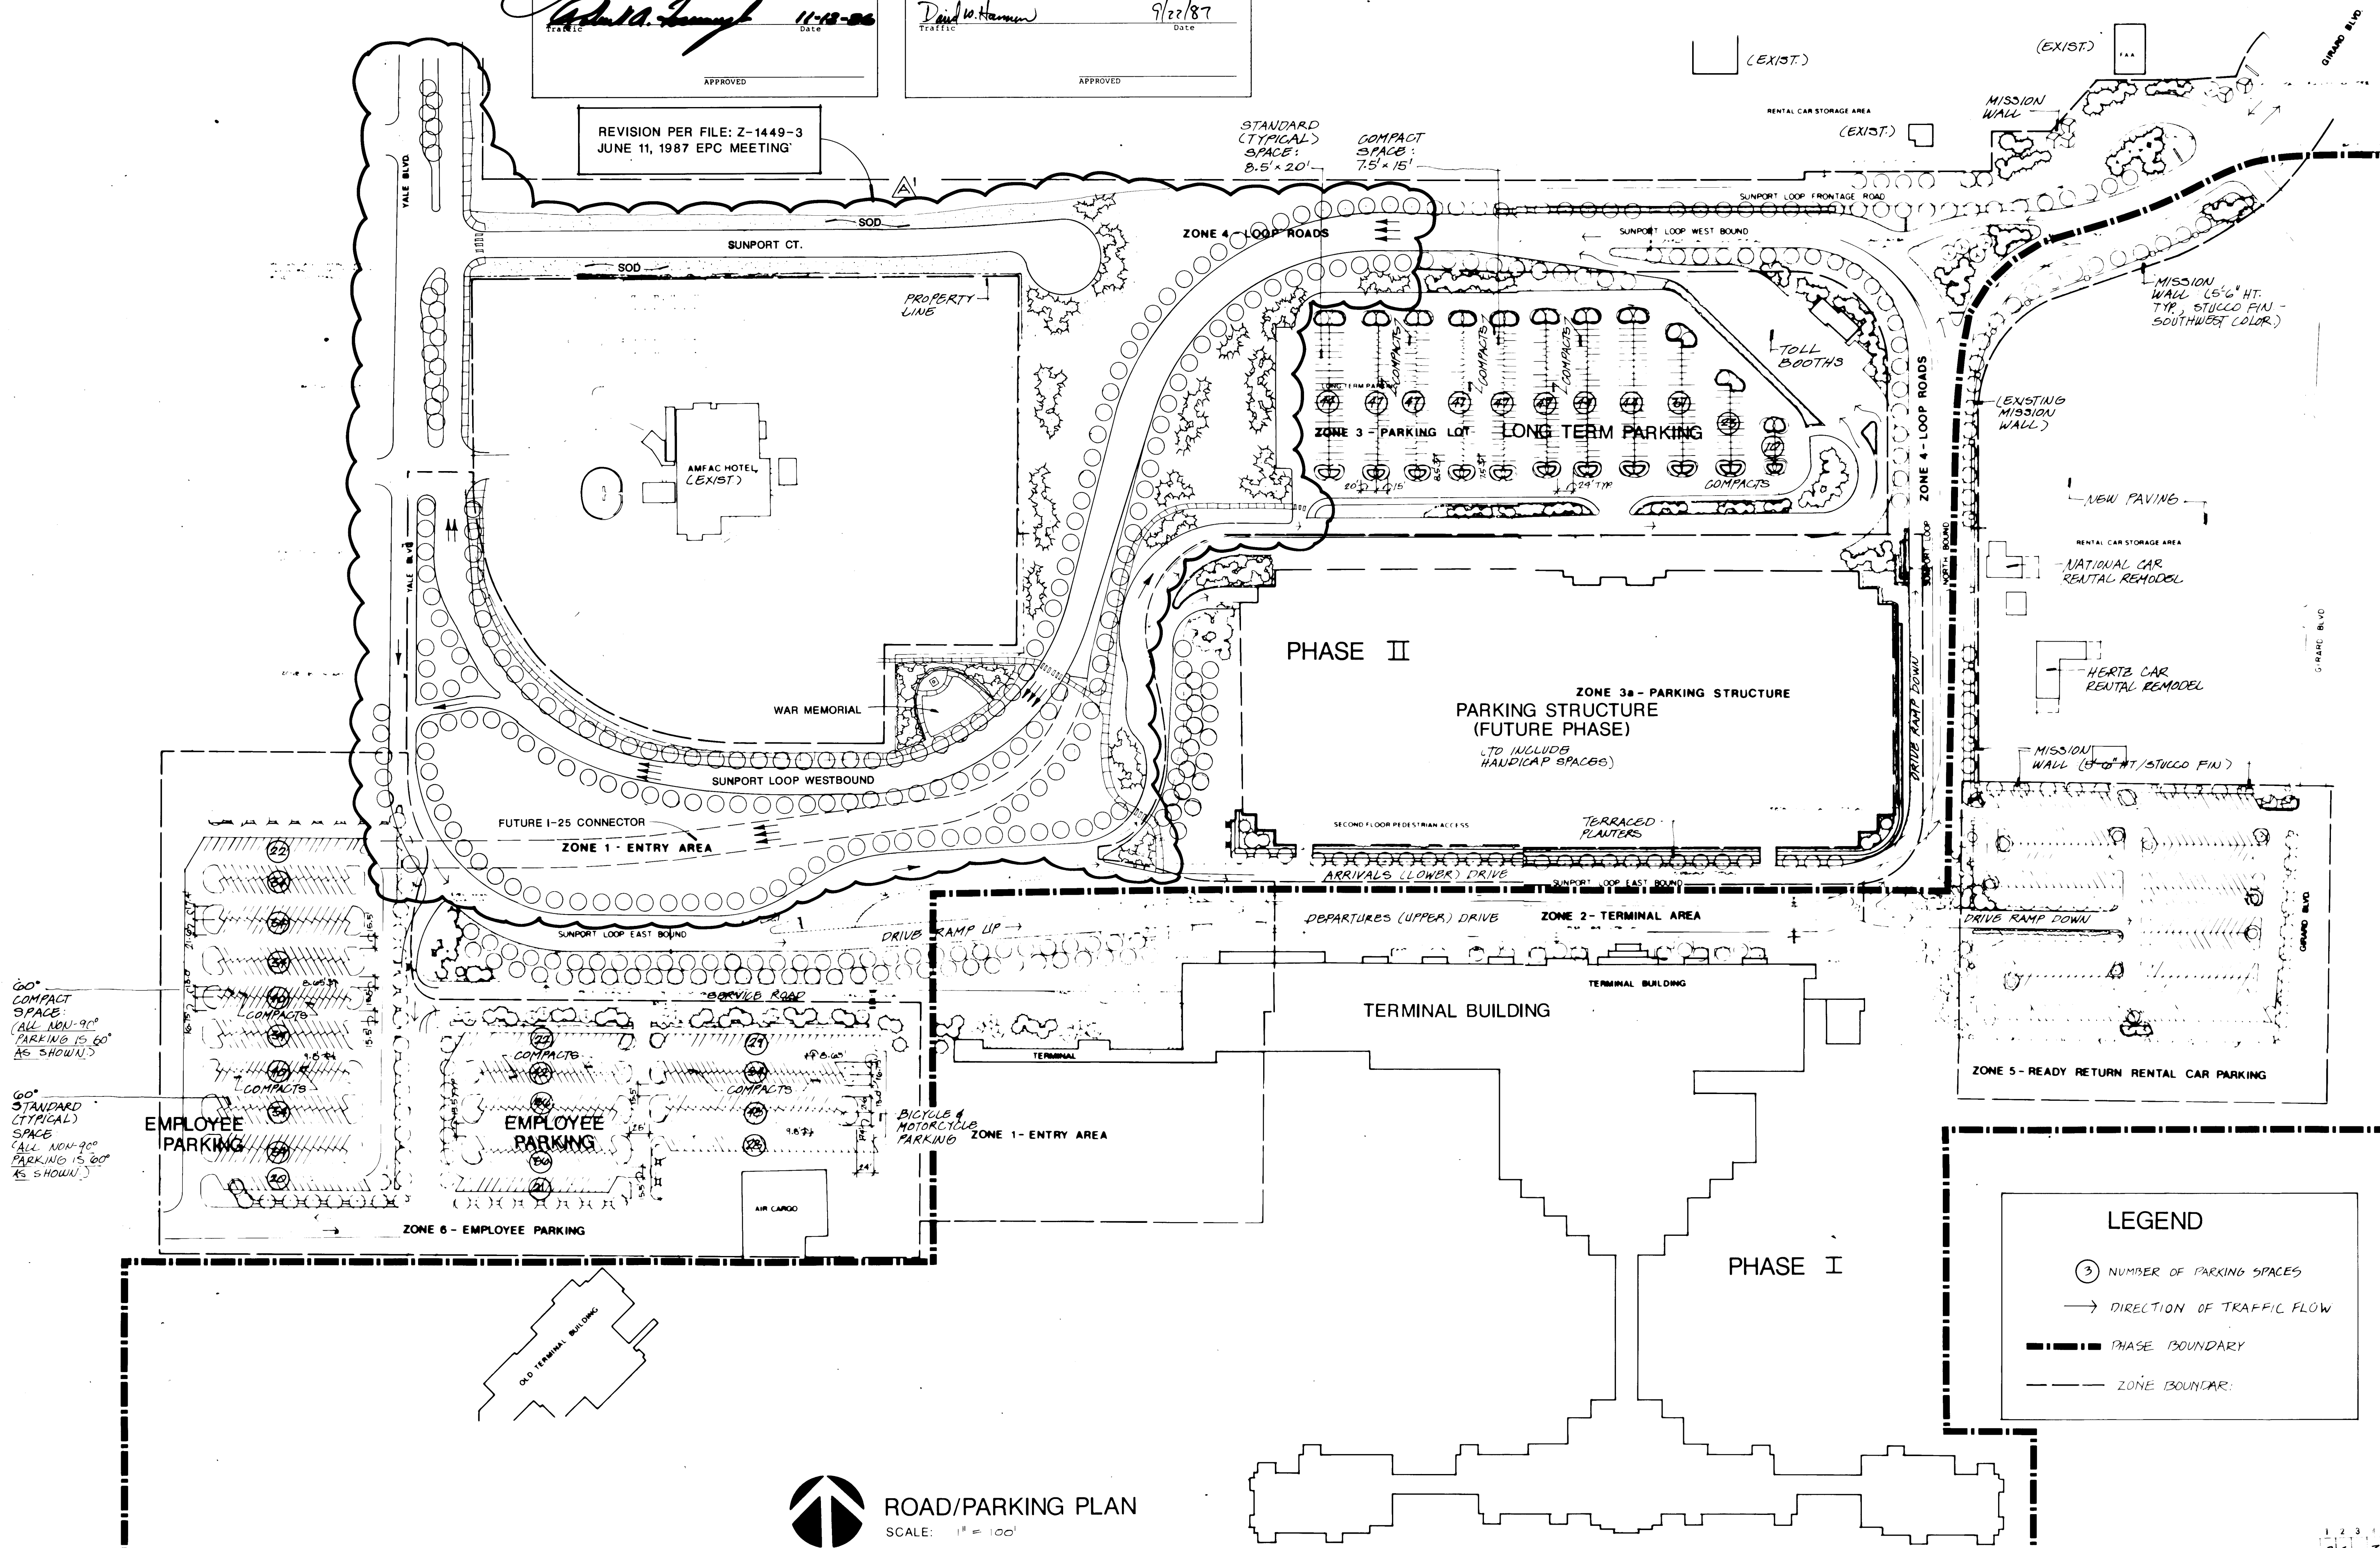

ROAD/PARKING PLAN
SCALE: 1" = 100'

NOTE: ZONE INDICATIONS APPLY TO LANDSCAPE PLANS (DRB-7 THRU DRB-9)

1 2 3 4 5 6 7 8 9 10 11 12
26 35 62 17 9 0

RECORD DRAWING

Information shown on this document has been compiled from the construction record drawing provided to the Architect by the General Contractor, which show the reported location of changes in the work.


By: *John M. ...*
BPLM ARCHITECTS & ENGINEERS, INC.
Date: 1-22-88

THE BURNS PETERS GROUP
ARCHITECTS PLANNERS

TRA Airport Consulting

210 Columbia
Seattle, WA
98101-4331
206-462-1133
FAX: 206-462-1134

REVISION AUGUST 20, 1987

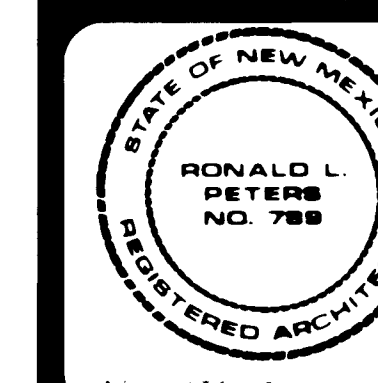


DESIGN AND CONSTRUCTION
OF AIRPORT MASTER PLAN
IMPROVEMENTS
ALBUQUERQUE INTERNATIONAL AIRPORT
2200 SUNPORT BLVD. SE
ALBUQUERQUE, NEW MEXICO 87106
CITY PROJECT NO. 5582


DATE: MAY 20, 1987

ROAD/PARKING PLAN

EPC-1
1 OF 8
SHEET 1 OF 3

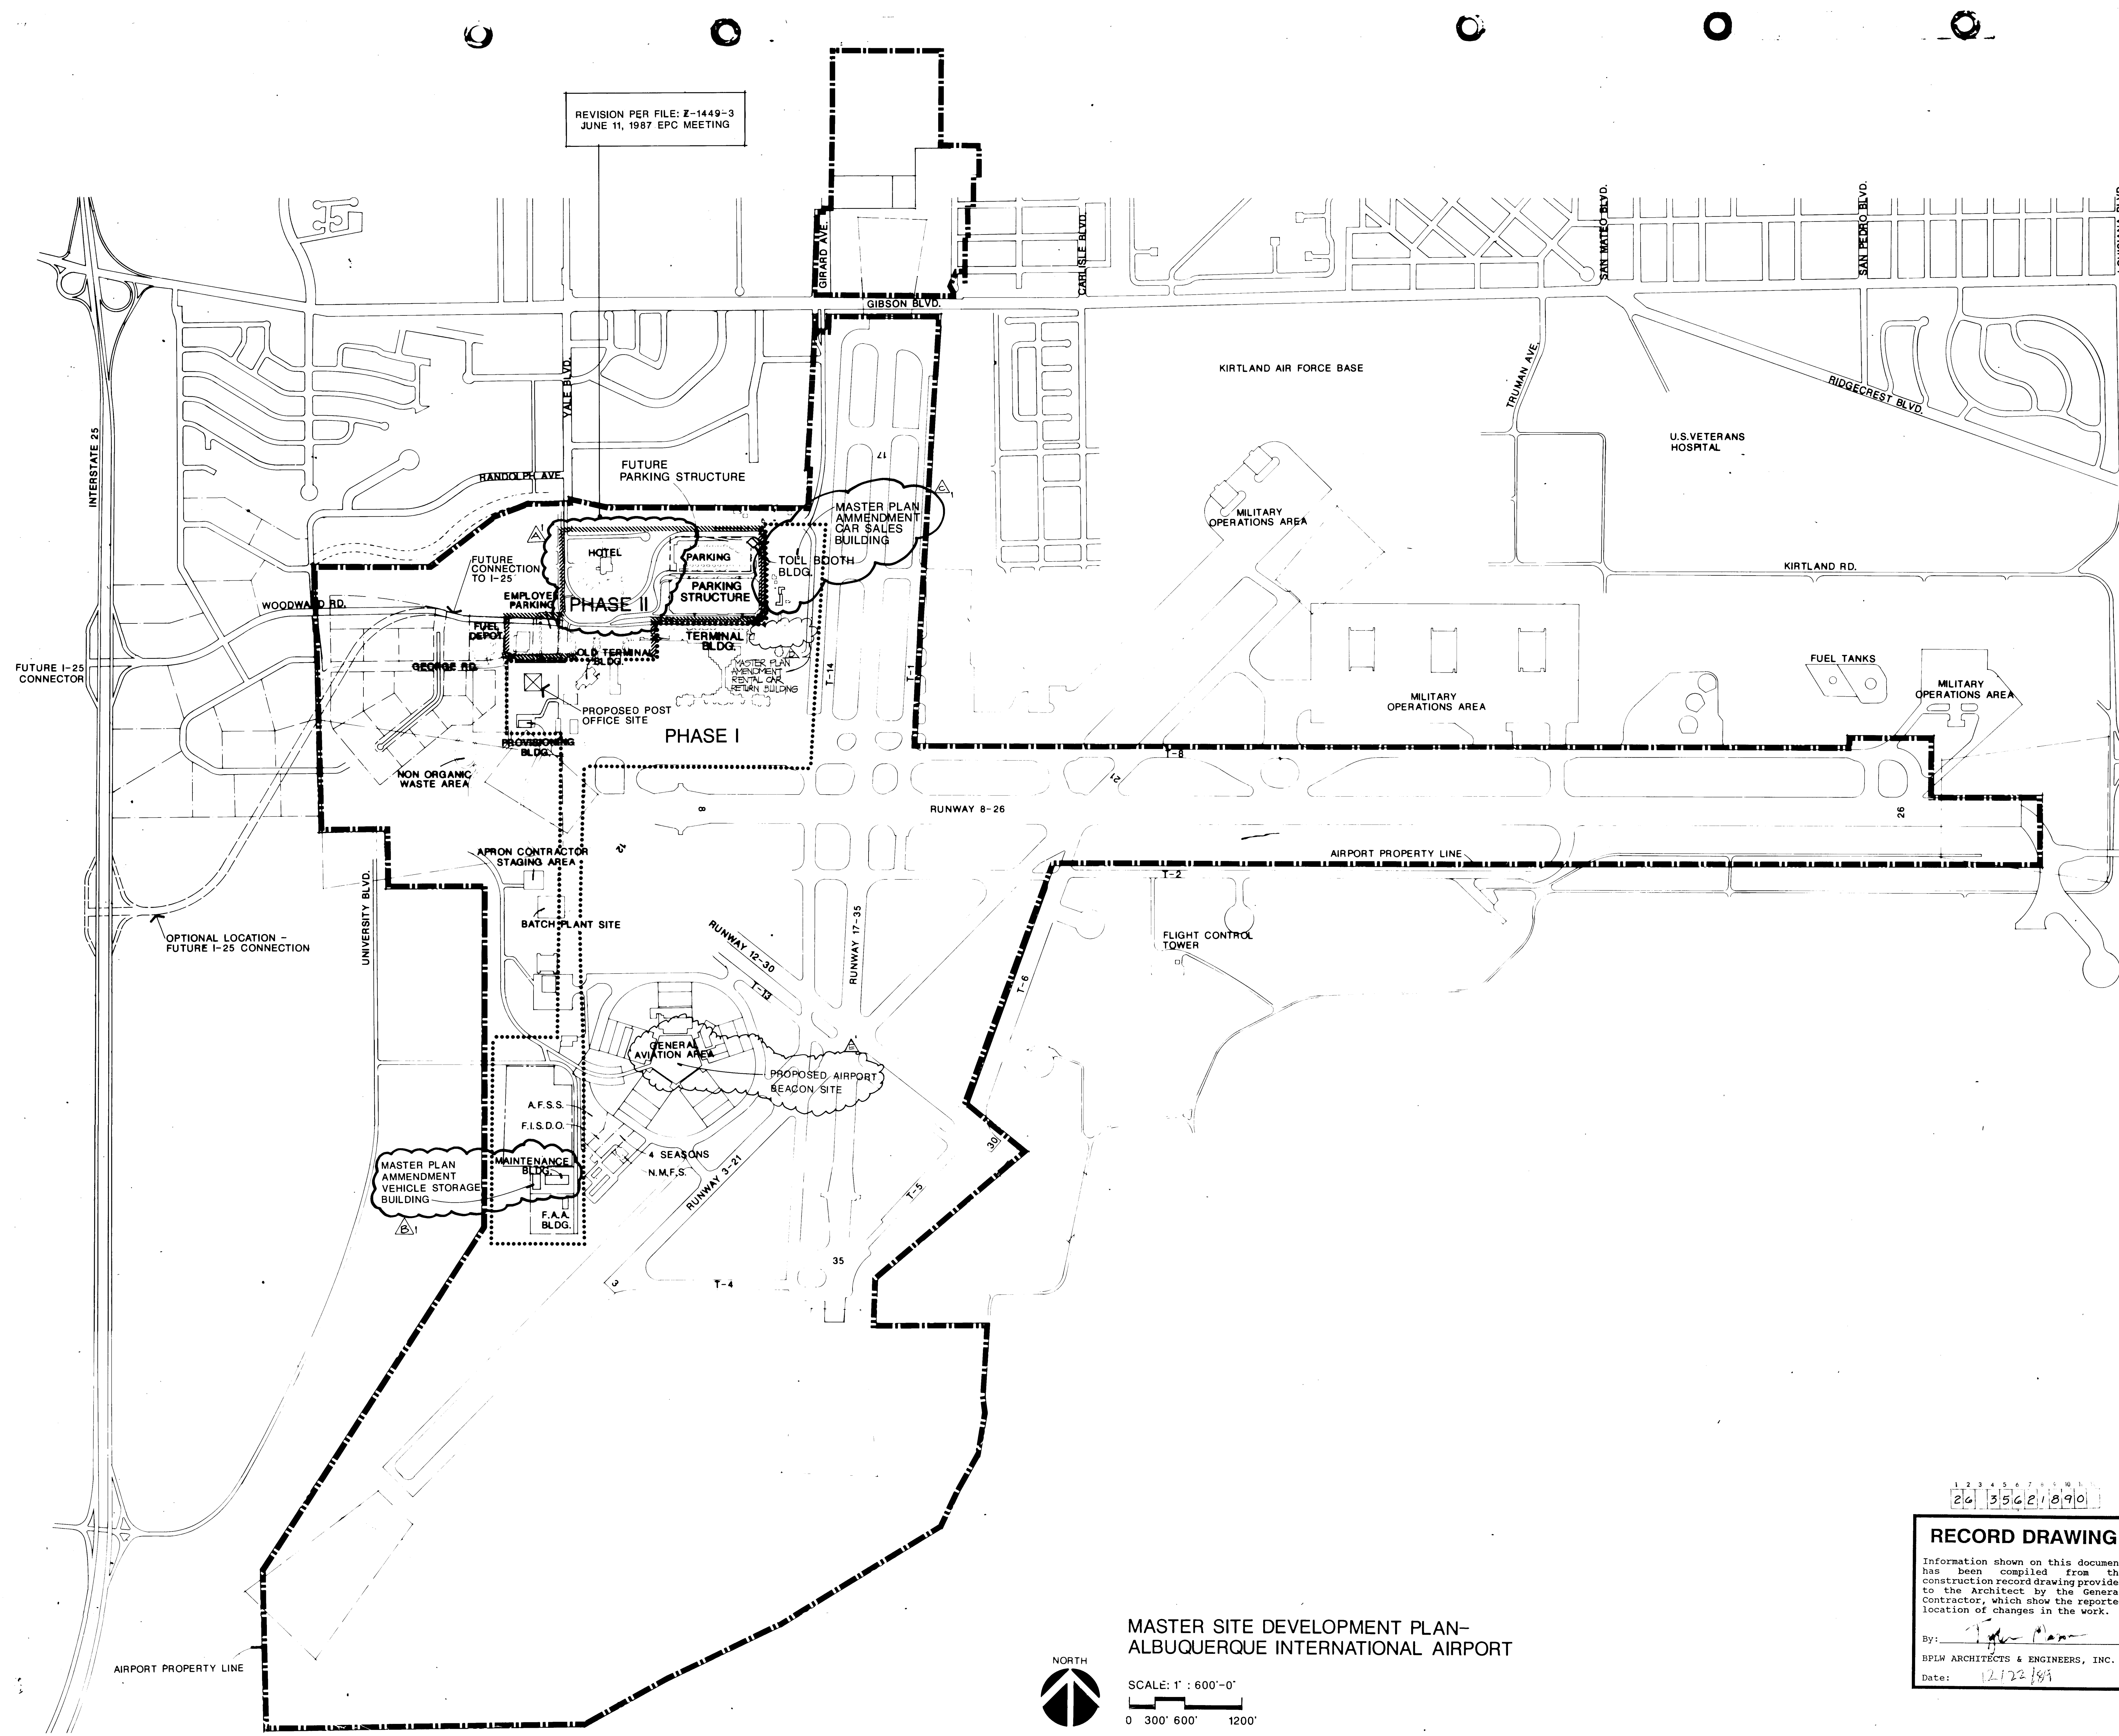

MASTER SITE DEVELOPMENT PLAN-
ALBUQUERQUE INTERNATIONAL AIRPORT

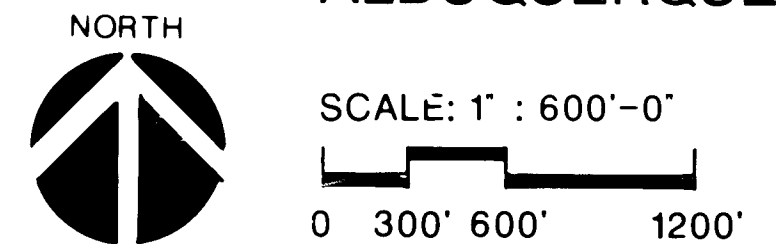

1 2 3 4 5 6 7 8 9 10
26 35621890

RECORD DRAWING

Information shown on this document has been compiled from the construction record drawing provided to the Architect by the General Contractor, which show the reported location of changes in the work.

By: *[Signature]*
BPLW ARCHITECTS & ENGINEERS, INC.
Date: 12/22/89

THE BURNS PETERS GROUP
ARCHITECTS PLANNERS

210 Columbia
Suite 100
Albuquerque, NM 87102
Tel. 845-2000
Toll Free 800-828-8288

TPCA Airport Consulting

- REVISION NOVEMBER 20, 1989
- REVISION OCTOBER 17, 1989
- REVISION JULY 15, 1988
- REVISION AUGUST 27, 1987
- REVISION JULY 5, 1986

ARCHITECT ENGINEER

**DESIGN AND CONSTRUCTION
OF AIRPORT MASTER PLAN
IMPROVEMENTS**


ALBUQUERQUE INTERNATIONAL AIRPORT
2200 SUNPORT BLVD. SE
ALBUQUERQUE, NEW MEXICO 87106
CITY PROJECT NO. 3562

PROJECT NO. 8525-16 DATE MAY 20, 1987

MASTER SITE DEVELOPMENT PLAN

DRAWING NO.

EPC-1
SHEET 2 OF 3

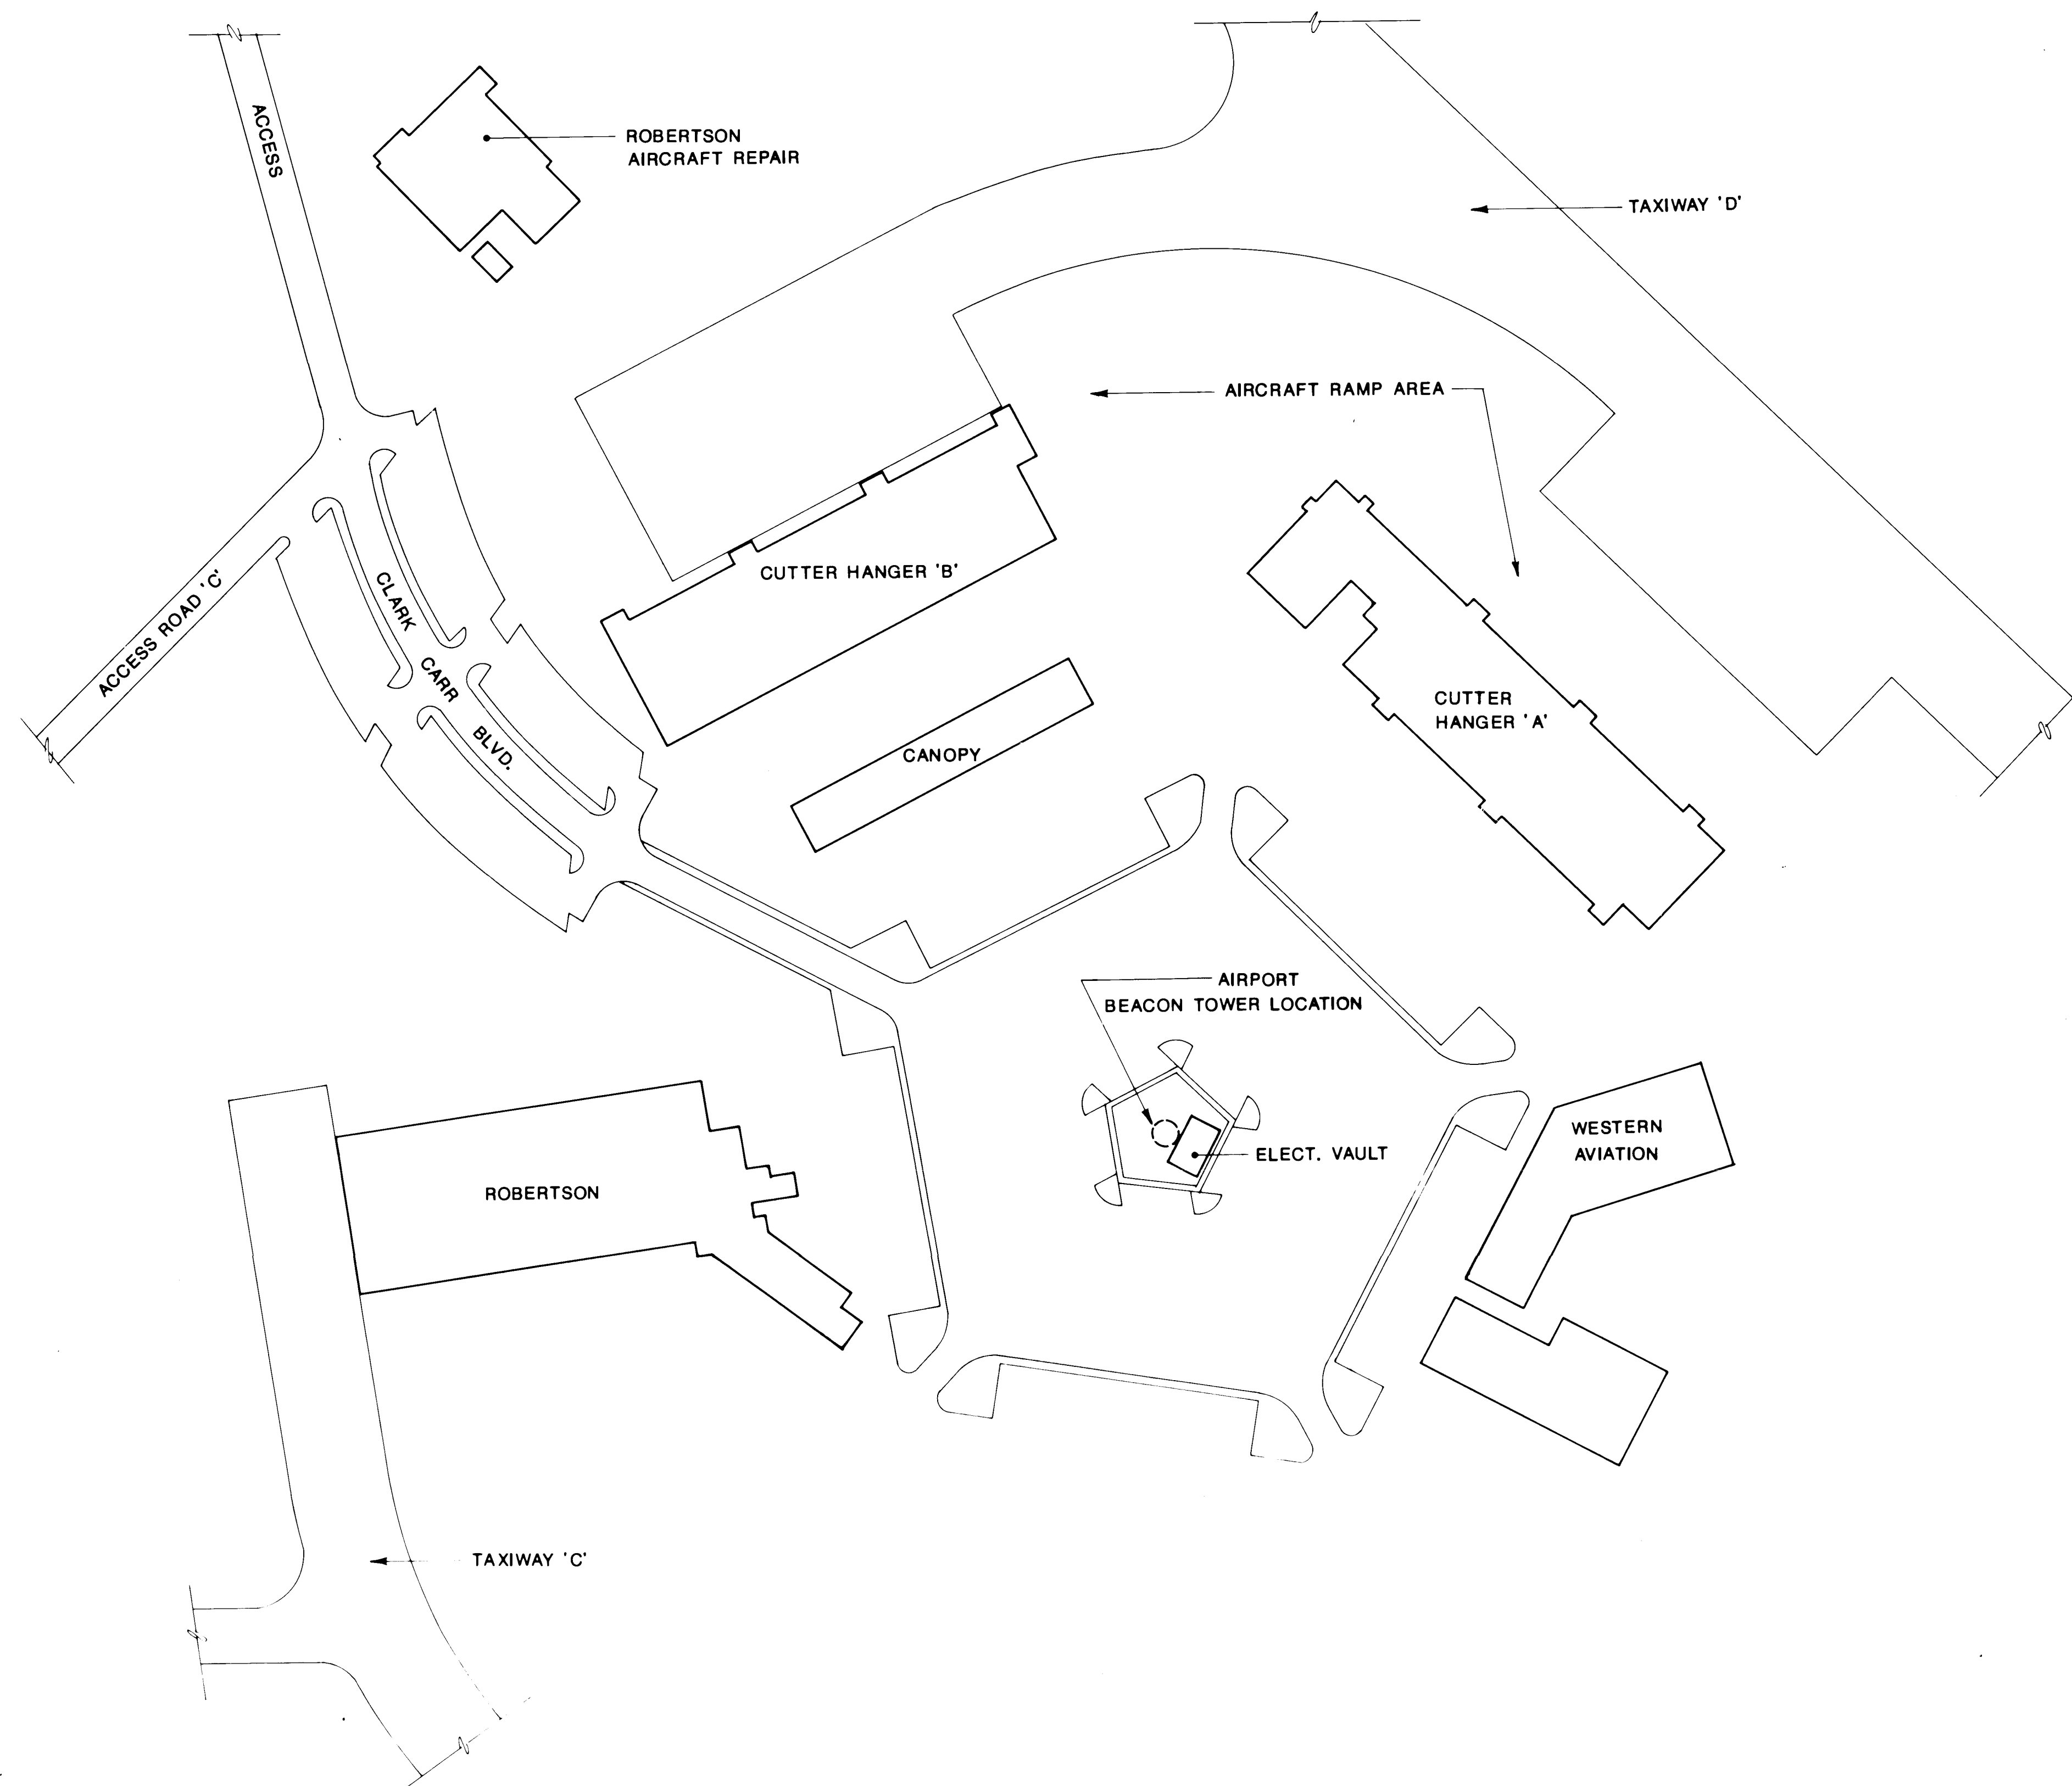


GENERAL AVIATION AREA

ALBUQUERQUE INTERNATIONAL AIRPORT

SCALE: 1" = 50'-0"

DATE: 10/26/89

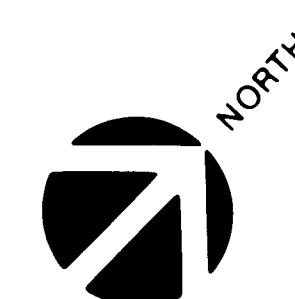

1 2 3 4 5 6 7 8 9 10
26 35 62 19 90

RECORD DRAWING

Information shown on this document has been compiled from the construction record drawing provided to the Architect by the General Contractor, which show the reported location of changes in the work.

By: *Ralph Mason*

BPLW ARCHITECTS & ENGINEERS, INC.

Date: 12/22/89

BPLW

ARCHITECT

ARCHITECT

CITY PROJECT NO. 3562

PROJECT NO.

DATE


DRAWING NO.

EPC-1

SHEET 3 OF 3

LEGEND

---	E	ELECTRICAL CONDUIT
---	G	GAS LINE
---	S	SANITARY SEWER
---	SS	STORM SEWER
---	T	TELEPHONE CONDUIT
---	W	WATER LINE
○		ELECTRICAL MANHOLE
□		SEWER MANHOLE
○		DROP NILET
●		POWER POLE
○		VALVE
↑		HYDRANT

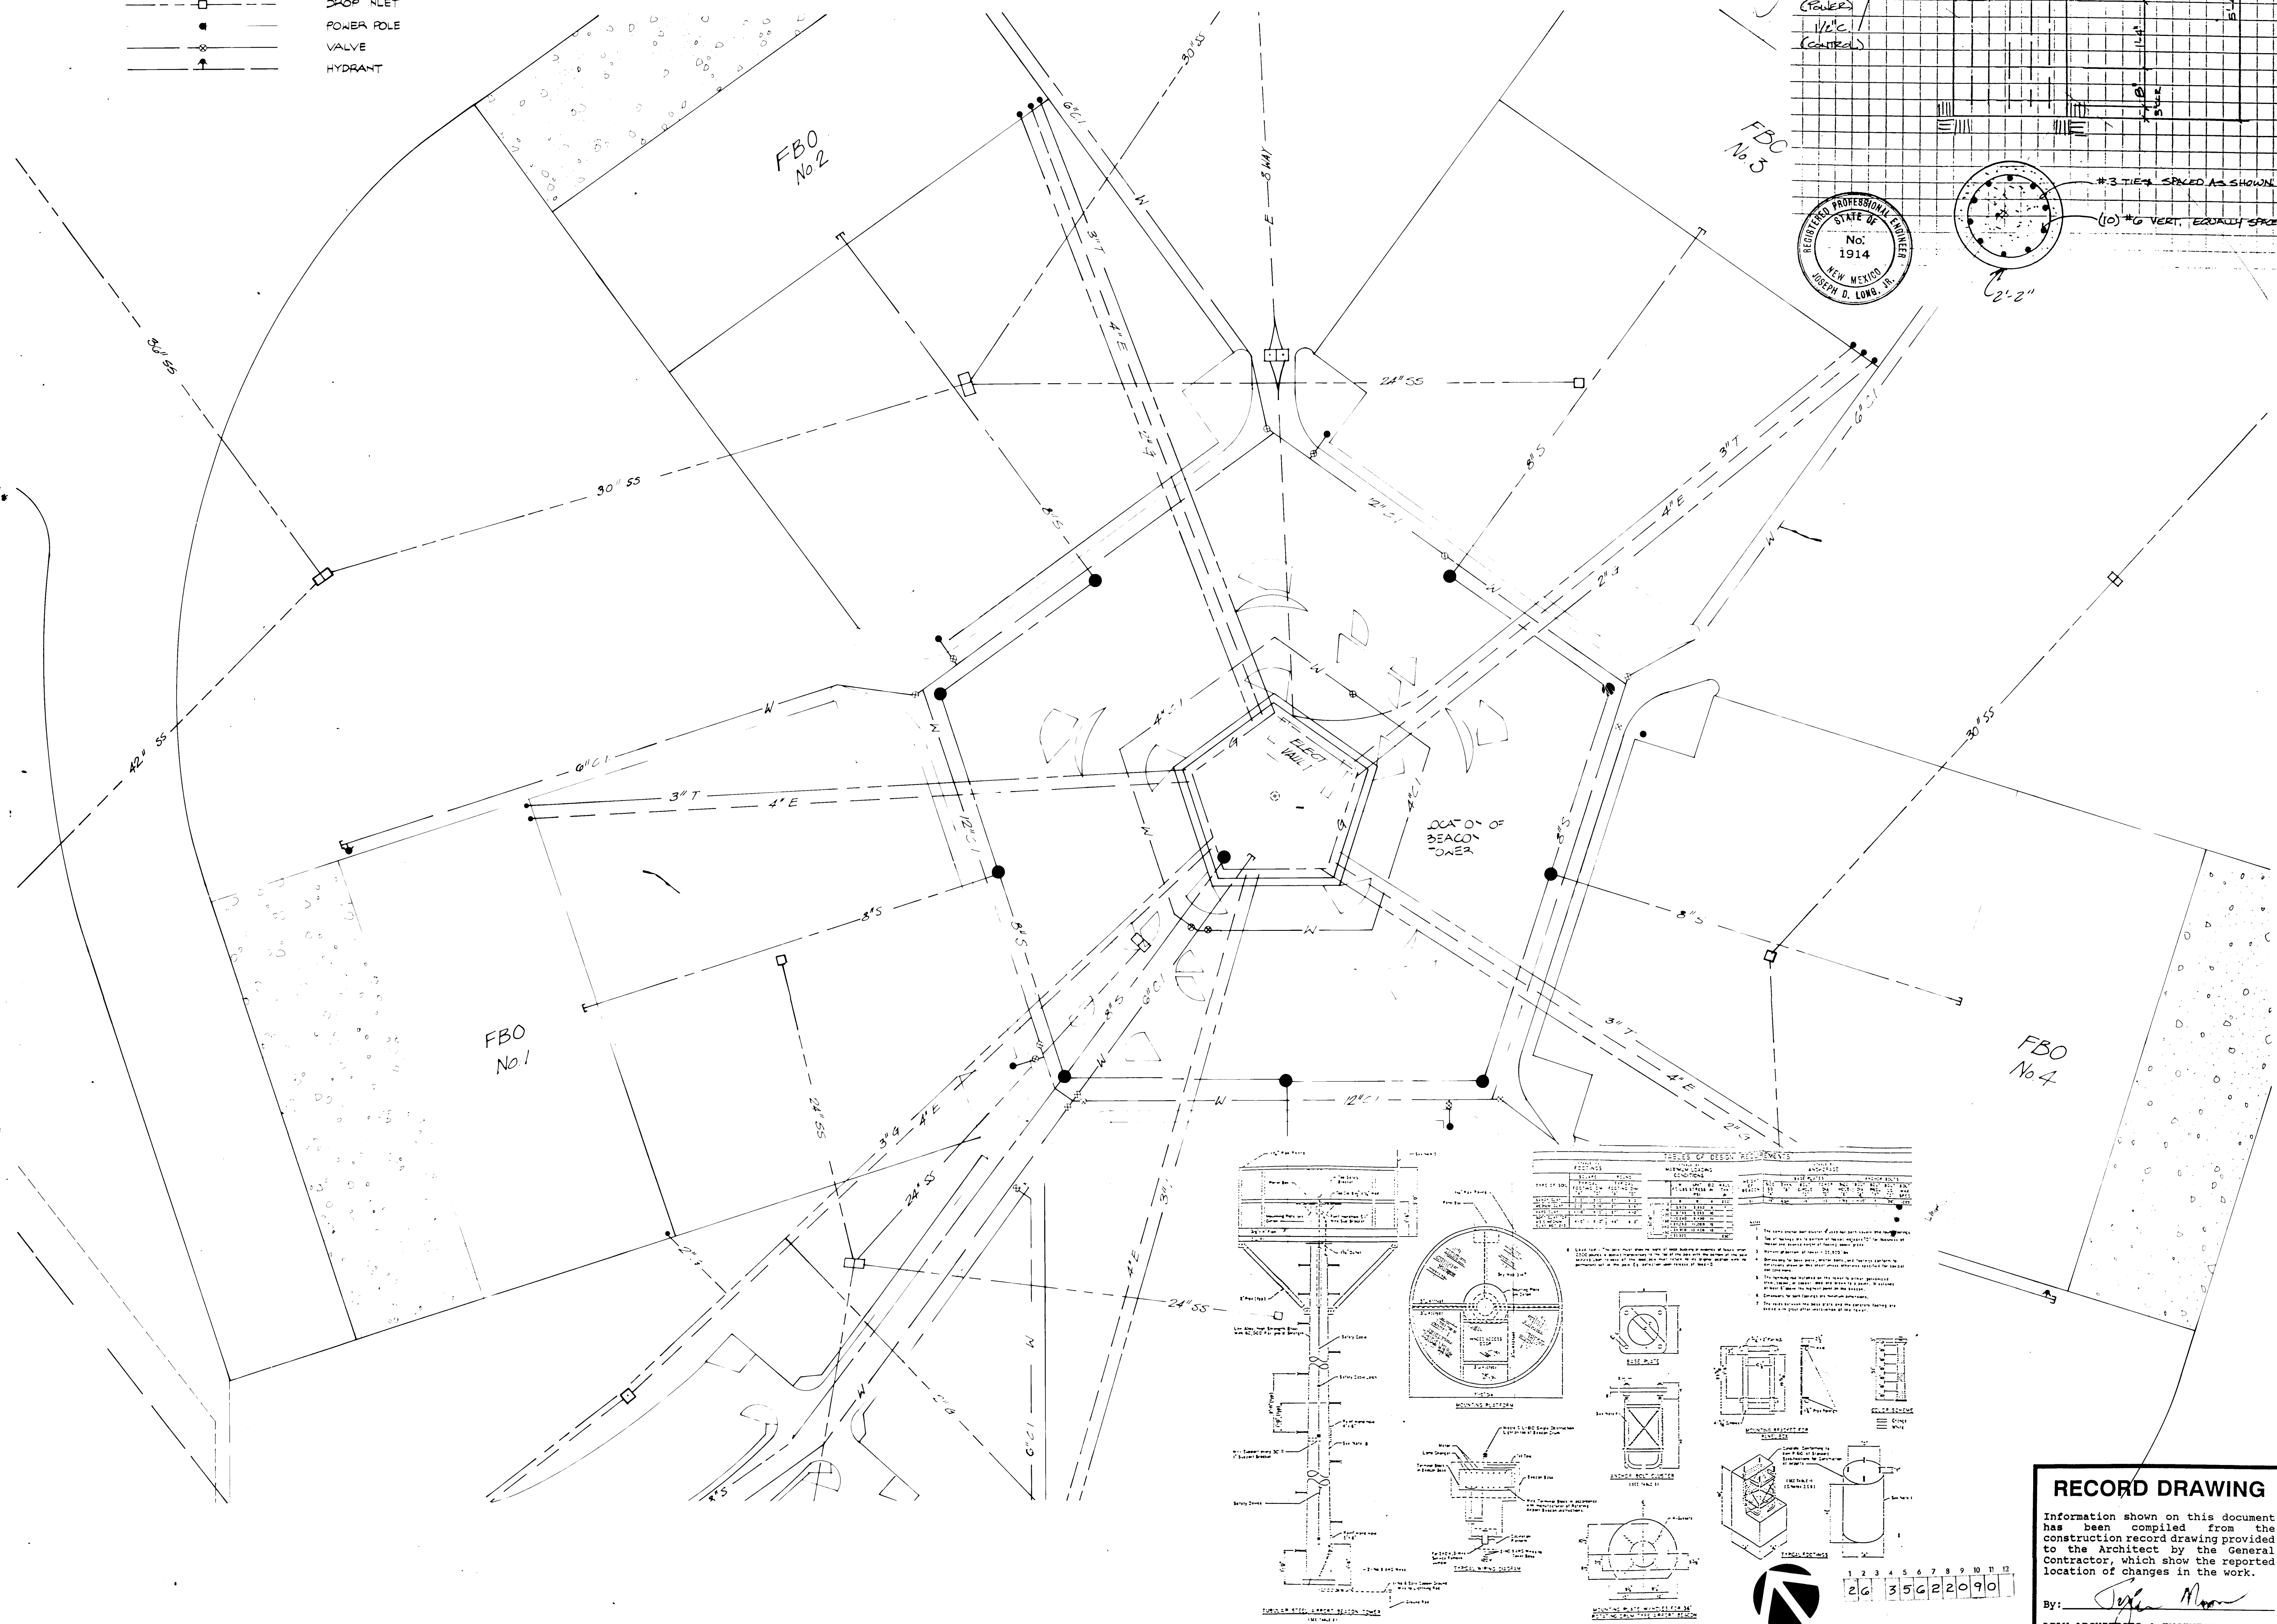


BPLW




ARCHITECTS & ENGINEERS
505 881 BPLW
ALBUQUERQUE, NEW MEXICO

Designing to Shape the Future

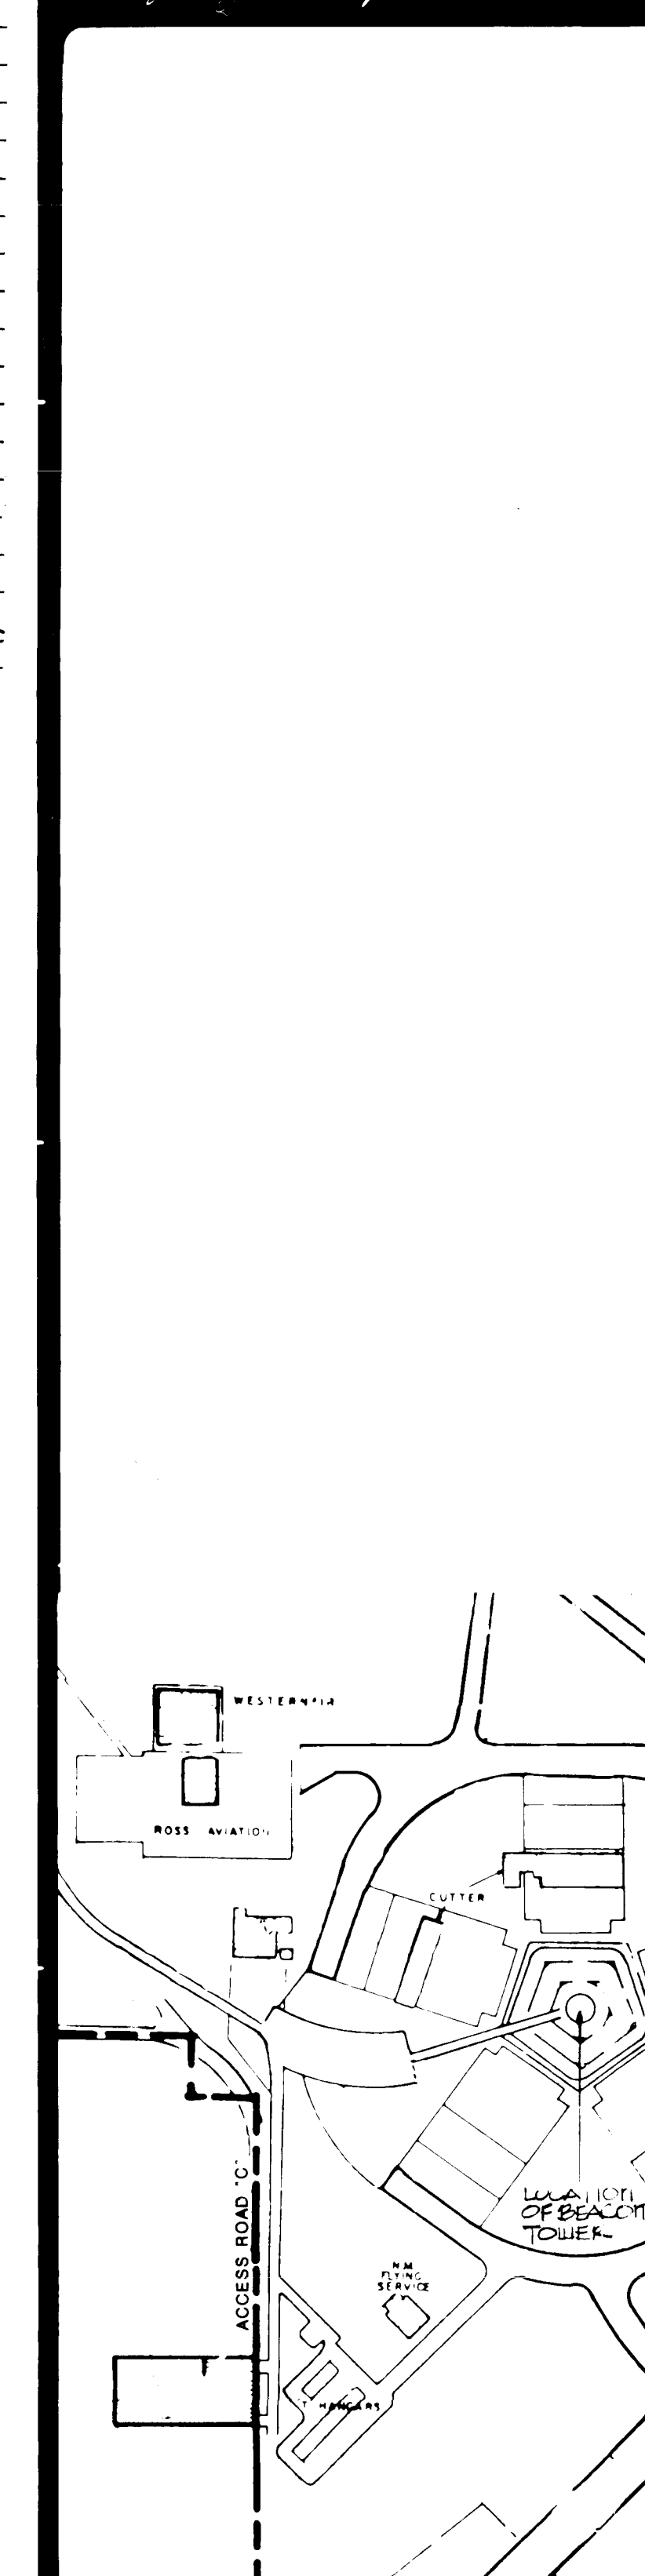

LOCATION MAP

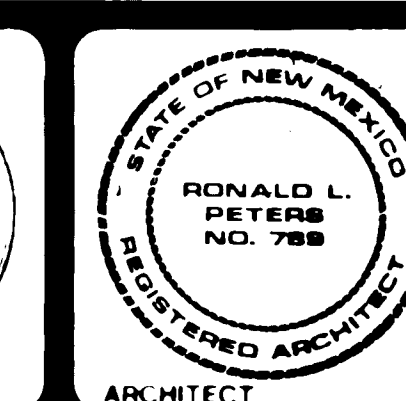

VEHICLE STORAGE BUILDING
ALBUQUERQUE INTERNATIONAL AIRPORT
ALBUQUERQUE, NEW MEXICO

CITY PROJ. No. 3352

PROJECT NO.
8525-23.01

DATE
MAY 15, 1989

BEACON TOWER

BY: *[Signature]*

BT-1

SHEET OF

RECORD DRAWING

Information shown on this document has been compiled from the construction record drawing provided to the Architect by the general contractor, which show the reported location of changes in the work.

By: *[Signature]*
BPLW ARCHITECTS & ENGINEERS, INC.
Date: 12/22/91

FIGURE 5. TUBULAR STEEL BEACON TOWER

SITE PLAN