

BEGIN PROJECT NO. 3568
Q STATION 9+28.80
NMSP GRID COORDINATES
CENTRAL ZONE
X=380,353.45
Y=1,493,808.56

SIXTH STREET NW

PLAN

SCALE: 1"=50'

PROFILE

SCALE: 1"=50' Horiz.
1"=5' Vert.

15'-N.W. RADIUS McKNIGHT

	P	T.C.
PCCR	59.83	60.50
1	59.76	60.43
2	59.70	59.74
3	59.63	60.30
PTCR	59.56	60.23

12'-S.W. RADIUS McKNIGHT

	P	T.C.
PCCR	59.47	60.14
1	59.45	60.12
2	59.42	59.46
3	59.40	60.07
PTCR	59.37	60.04

10'-S.E. RADIUS HAINES

	P	T.C.
PTCR	59.28	59.95
1	59.33	60.00
2	59.38	59.42
3	59.43	60.10
PCCR	59.48	60.15

10'-S.W. RADIUS HAINES

	P	T.C.
PCCR	59.39	60.06
1	59.34	60.01
2	59.29	59.33
3	59.24	59.91
PTCR	59.19	59.86

NOTES:

- STREET WIDTHS ARE SHOWN LIP TO LIP OF GUTTER.
- THE REMOVAL, STORAGE AND REPLACEMENT OF LANDSCAPE/SOD, DECORATOR LANDSCAPE, PATIO BLOCK OR BRICK NECESSARY FOR THE INSTALLATION OF CURB AND GUTTER WILL NOT BE CONSIDERED AS A SEPERATE BID ITEM FOR PAYMENT, BUT WILL BE CONSIDERED AS INCIDENTAL TO THE CONTRACT ITEM OF P.C.C. STANDARD CURB AND GUTTER.


RAILROAD TRACK CROSSING AND SIGNAL MODIFICATION TO BE DONE BY OTHERS. CONTRACTOR SHALL COORDINATE WITH RAILROAD FOR TRACK AND SIGNAL WORK TO COINCIDE WITH PAVEMENT RECONSTRUCTION.

SEE SHEETS 7A AND 7B FOR DETAILS THIS AREA

RAILROAD TRACKS TO BE REMOVED BY OTHERS. CONTRACTOR SHALL COORDINATE WITH THE RAILROAD FOR REMOVAL OF TRACKS TO COINCIDE WITH PAVEMENT RECONSTRUCTION.

LEGEND

- FLOW ARROWS
- 8" PCC PAVEMENT REMOVAL AND REPLACEMENT
- EXISTING DRIVEPAD
- DRIVEPAD TO BE REMOVED AND REPLACED
- CURB AND GUTTER REMOVAL AND REPLACEMENT
- NEW WHEELCHAIR RAMP
- UNTREATED ROADWAY
- ASPHALT PAVEMENT REMOVAL AND REPLACEMENT
- 5/8" PLANT MIX SEAL COAT SURFACE TREATMENT
- EXISTING C & G
- EXISTING SANITARY SEWER
- EXISTING WATER LINE
- EXISTING GAS LINE
- EXISTING STORM DRAIN
- EXISTING UNDERGROUND TELEPHONE LINE
- EXISTING UNDERGROUND ELECTRICAL LINE
- EXISTING UNDERGROUND CABLE TV LINE
- EXISTING TRAFFIC SIGNAL CONDUIT
- EXISTING TELEPHONE BOX
- EXISTING STORM DRAIN MANHOLE
- EXISTING SANITARY SEWER MANHOLE
- EXISTING WATER VALVE
- EXISTING WATER METER
- EXISTING GAS VALVE
- EXISTING GAS METER
- EXISTING FIRE HYDRANT
- PEDESTAL SIGNAL
- PULL BOX
- LIGHT POLE
- EXISTING STORM INLET
- EXISTING TREE/SHRUB

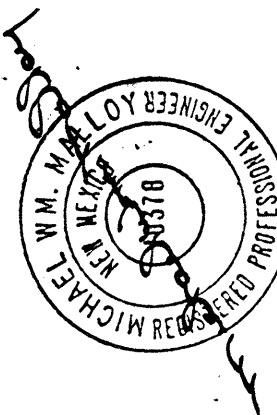
AS-BUILT INFORMATION				SURVEY INFORMATION				ENGINEER'S SEAL			
CONTRACT NO.	DATE	BY	DATE	NO.	DATE	BY	DATE				
PROJECT NO.	DATE	BY	DATE	NO.	DATE	BY	DATE				
PROJECT NAME	DATE	BY	DATE	NO.	DATE	BY	DATE	REVISIONS			
PROJECT LOCATION	DATE	BY	DATE	NO.	DATE	BY	DATE				
PROJECT DESCRIPTION	DATE	BY	DATE	NO.	DATE	BY	DATE	DESIGN			
PROJECT DRAWING NO.	DATE	BY	DATE	NO.	DATE	BY	DATE				
PROJECT DRAWING DATE	DATE	BY	DATE	NO.	DATE	BY	DATE	DESIGNED BY			
PROJECT DRAWING DATE	DATE	BY	DATE	NO.	DATE	BY	DATE				
PROJECT DRAWING DATE	DATE	BY	DATE	NO.	DATE	BY	DATE	DRAWN BY			
PROJECT DRAWING DATE	DATE	BY	DATE	NO.	DATE	BY	DATE				
PROJECT DRAWING DATE	DATE	BY	DATE	NO.	DATE	BY	DATE	CHECKED BY			
PROJECT DRAWING DATE	DATE	BY	DATE	NO.	DATE	BY	DATE				

CITY OF ALBUQUERQUE
PUBLIC WORKS DEPARTMENT

TITLE: **SIXTH STREET IMPROVEMENTS**
PAVING
10+00 TO STA. 21+00

APPROVALS	ENGINEER	DATE	APPROVALS	ENGINEER	DATE
City Engineer			Liquid Waste	Rebo	4/27/89
A.C.E.—Design			Traffic	Rebo	4/27/89
A.C.E.—Hydrology			Water		

DRAWING NO.	MAP NO.	SHEET OF
3568	J-14	7 22

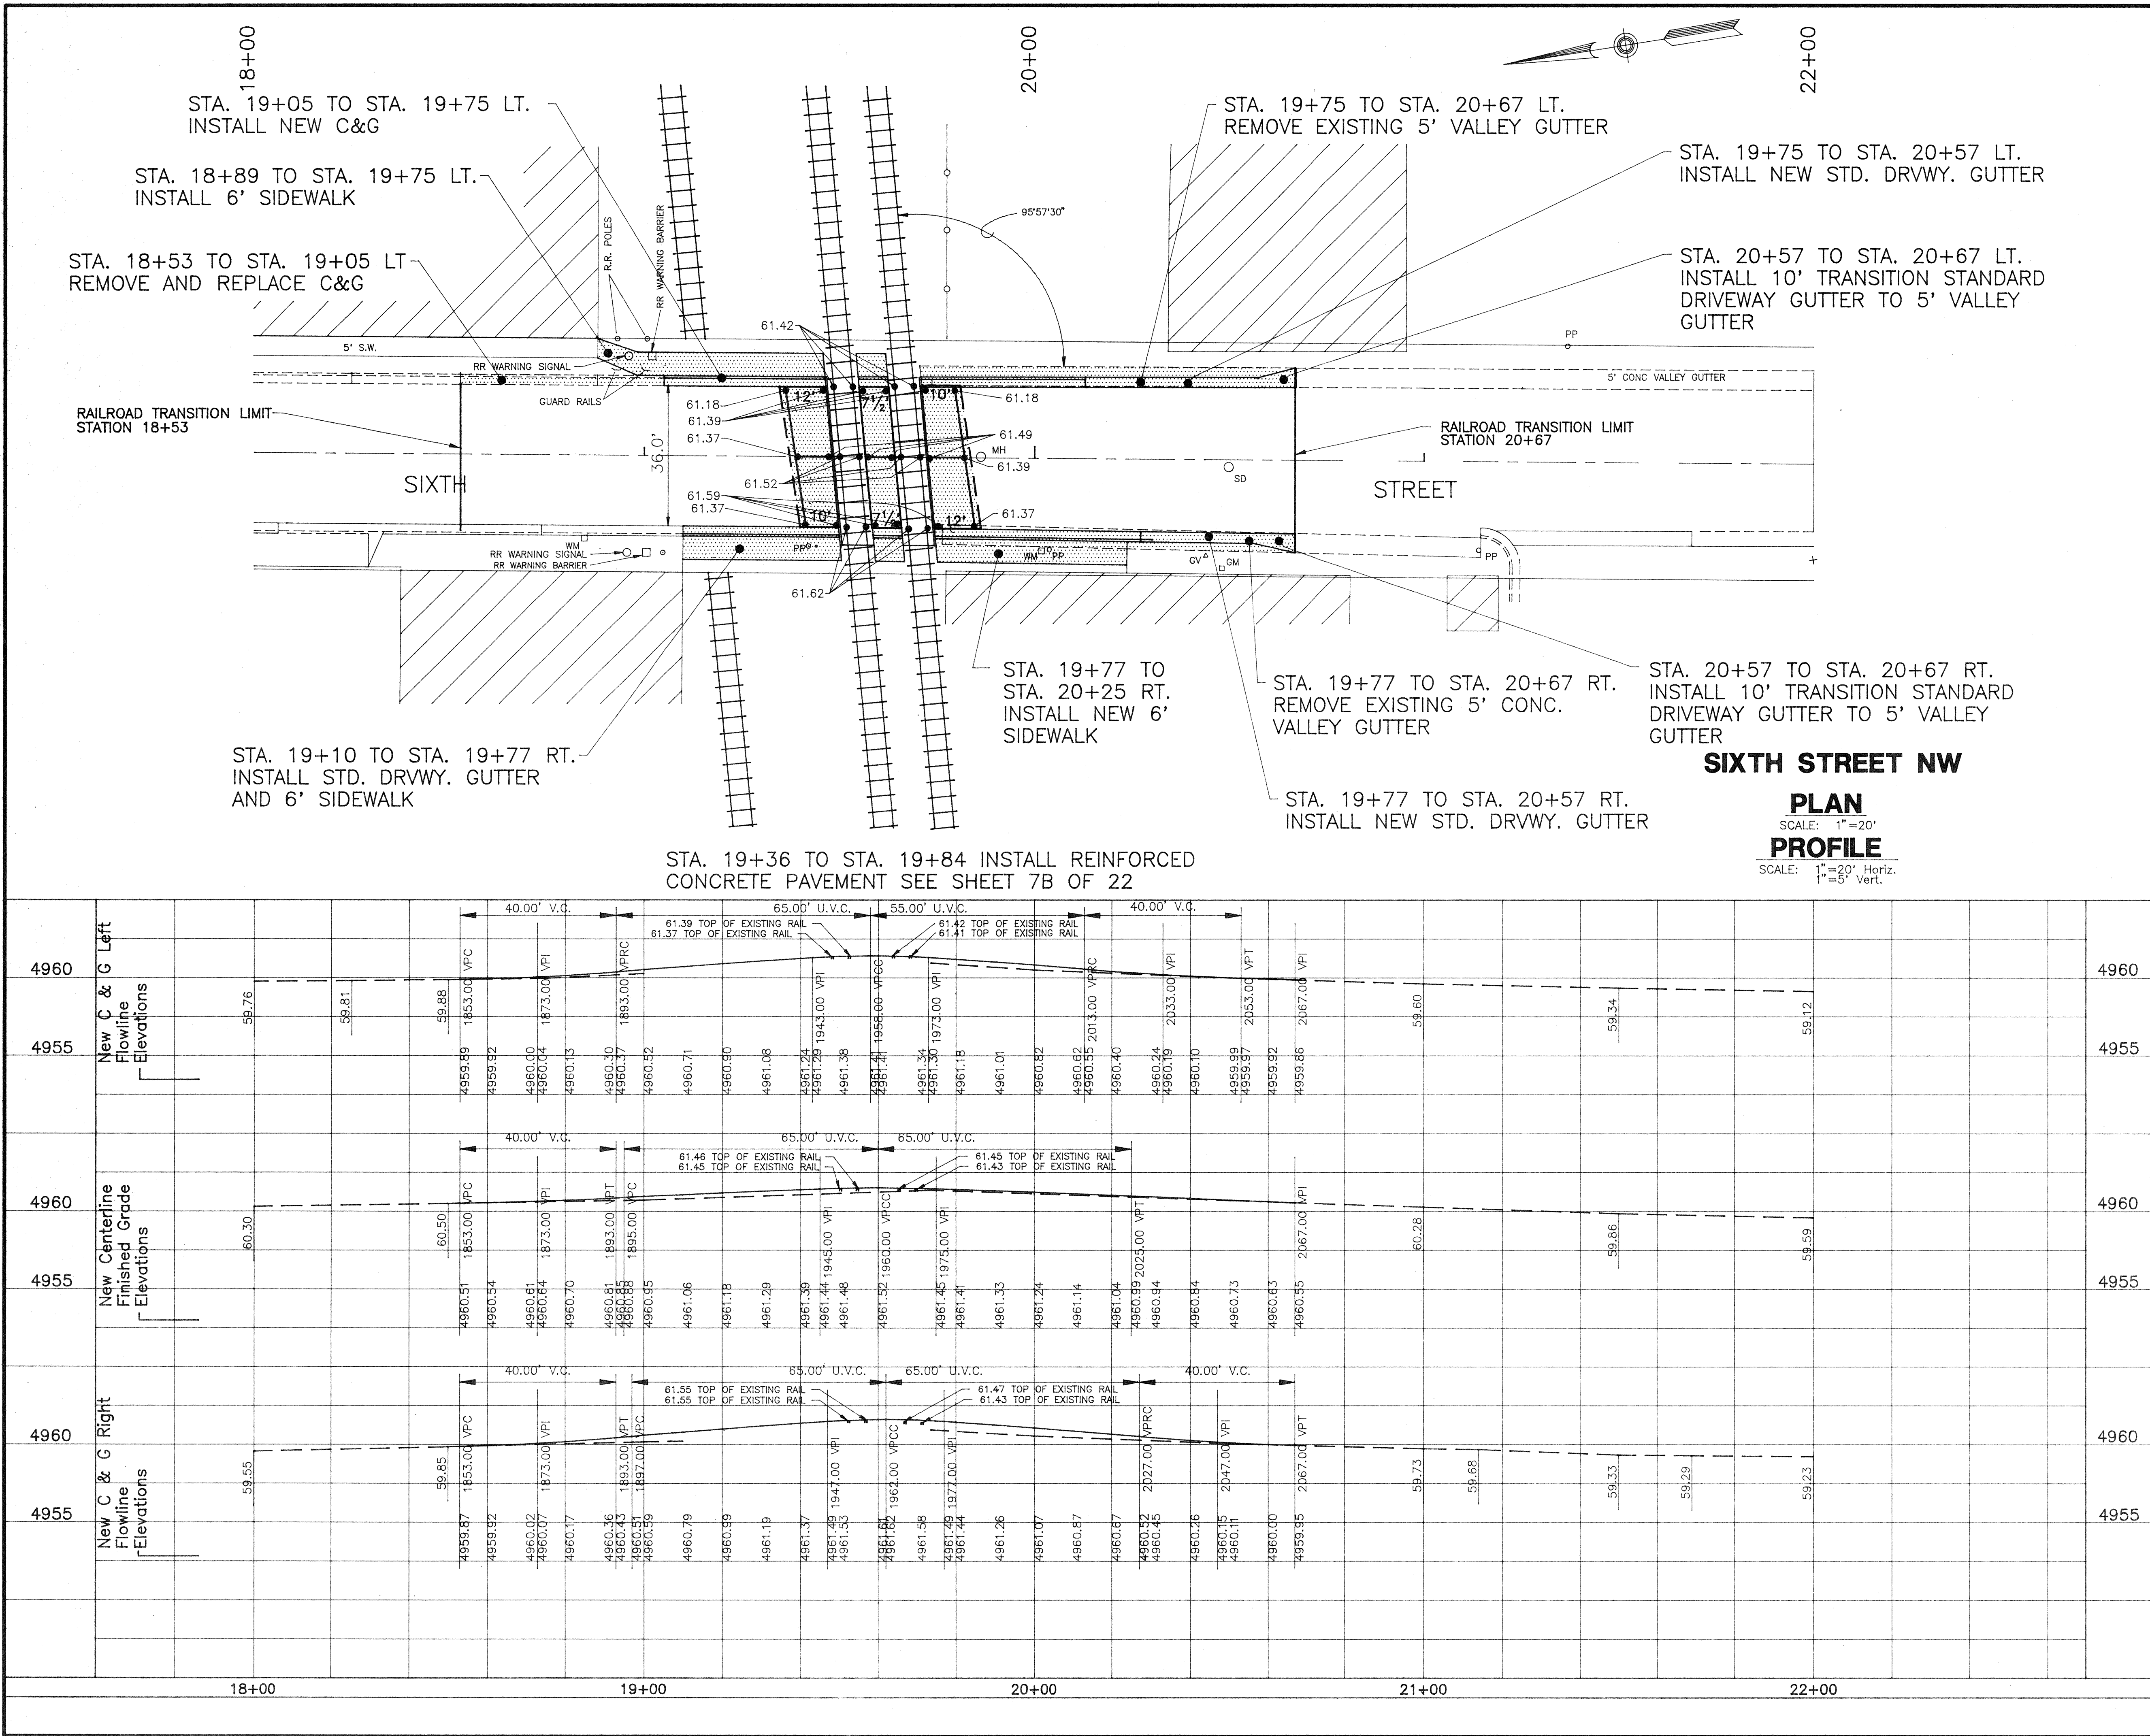

LEGEND

[Pattern]	NEW CONSTRUCTION THIS CHANGE ORDER
[Dashed]	EXISTING C & G
○SD	EXISTING STORM DRAIN MANHOLE
○MH	EXISTING SANITARY SEWER MANHOLE
□WM	EXISTING WATER METER
△GV	EXISTING GAS VALVE
□GM	EXISTING GAS METER
○PP	POWER POLE

AS BUILT INFORMATION	
CONTRACTOR	DATE
DESIGNED BY	DATE
CHECKED BY	DATE
APPROVED BY	DATE
RECORDED BY	DATE

SURVEY INFORMATION	
FIELD NOTES	DATE
NO.	BY

ENGINEER'S SEAL	
NO.	DATE
REVISIONS	BY
DESIGN	DATE
DESIGNED BY	DATE
DRAWN BY	DATE
CHECKED BY	DATE


CITY OF ALBUQUERQUE
PUBLIC WORKS DEPARTMENT

TITLE: **SIXTH STREET IMPROVEMENTS
R.R. CROSSING - CHANGE ORDER**

APPROVALS	ENGINEER	DATE	APPROVALS	ENGINEER	DATE
City Engineer			Liquid Waste		
A.C.E.-Design			Traffic		
A.C.E.-Hydrology			Water		

DRAWING NO.	MAP NO.	SHEET OF
3568	J-14	7A 22


SECTION

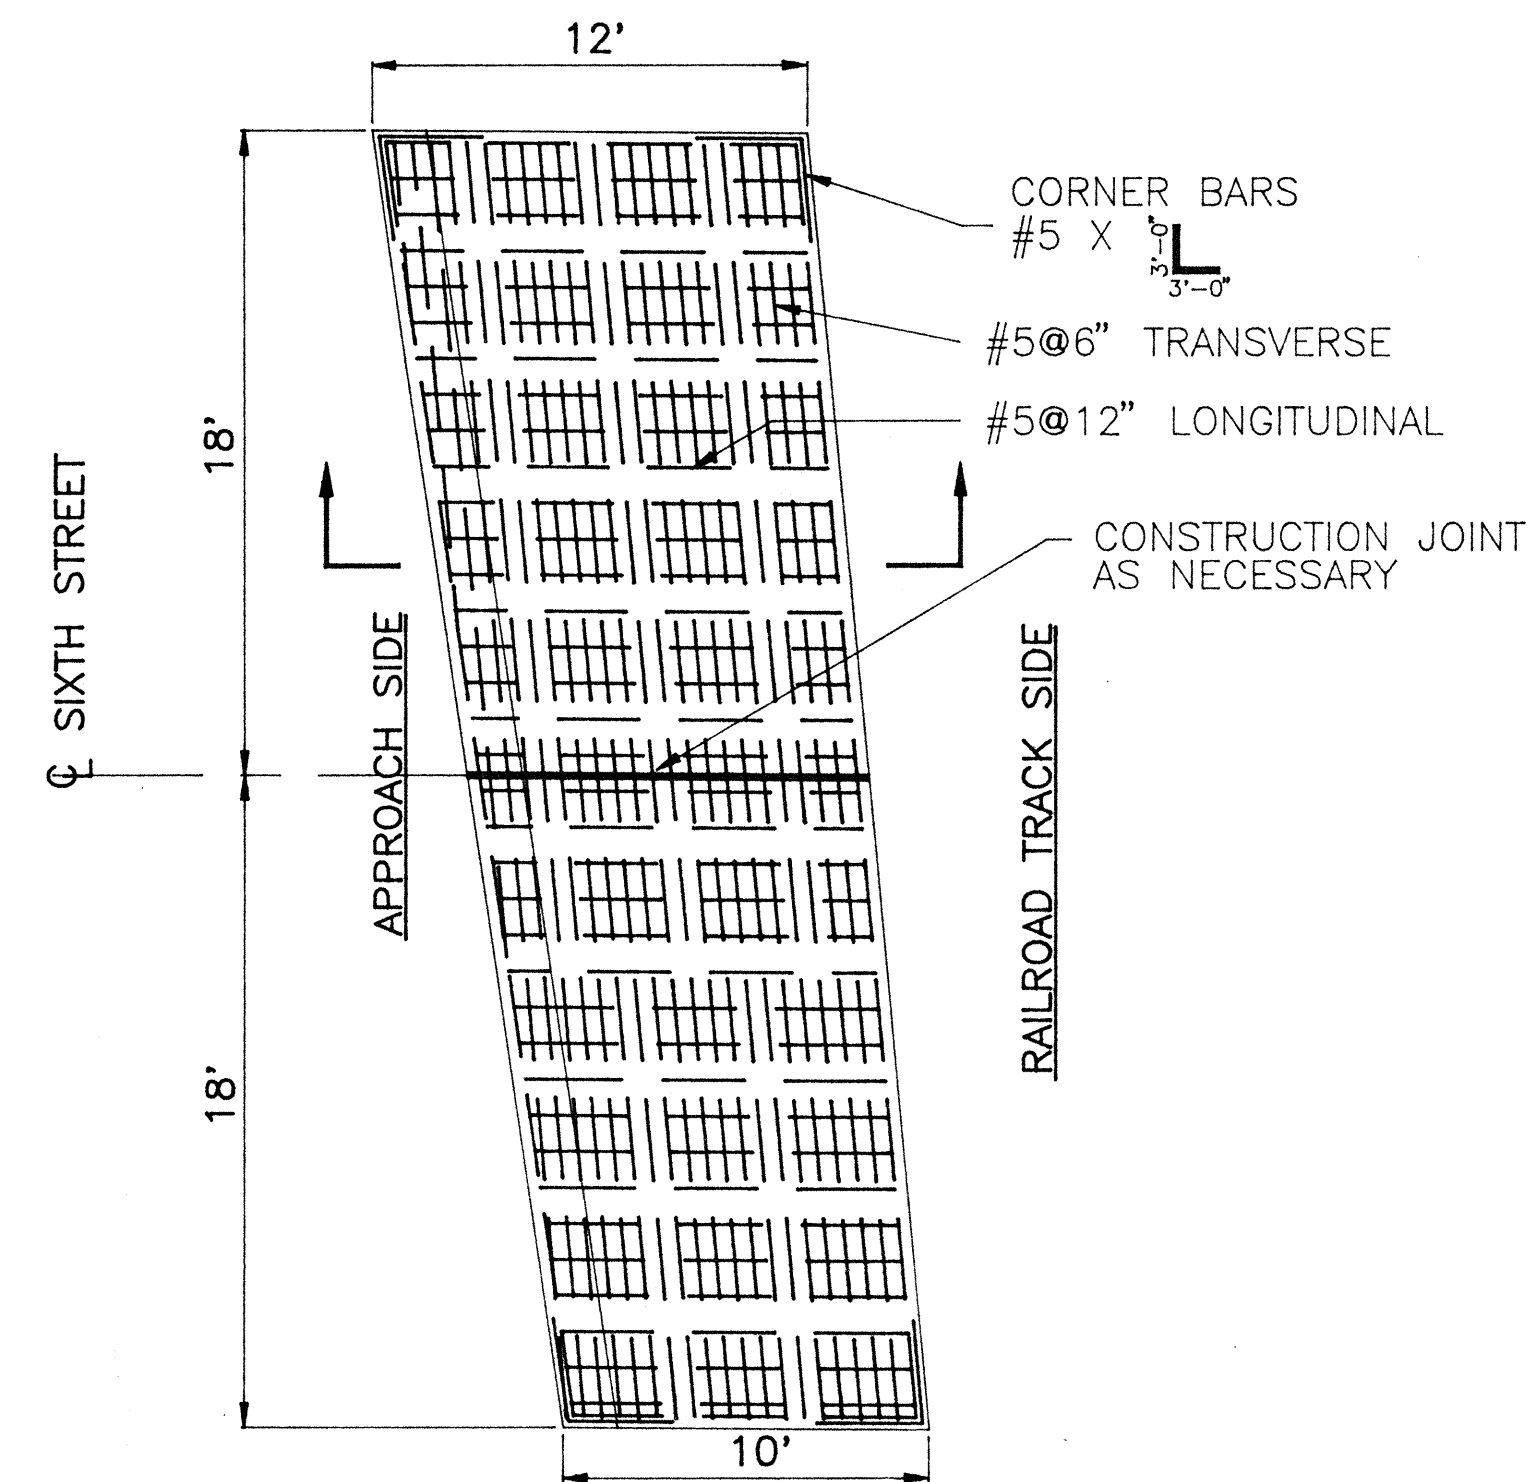


PLAN

DETAIL

TYPICAL CONCRETE APPROACH SLAB

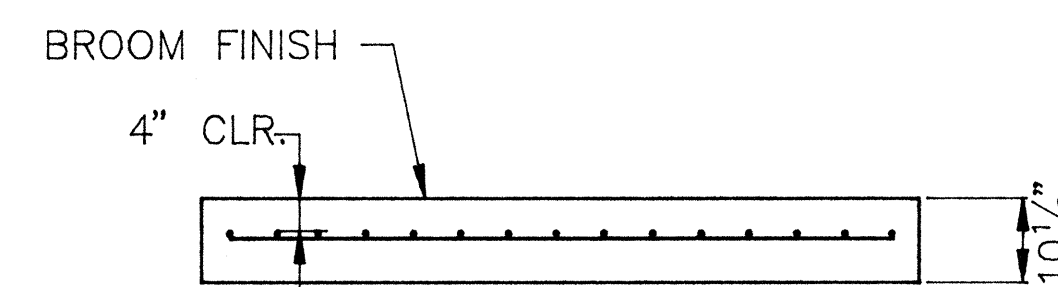


SECTION

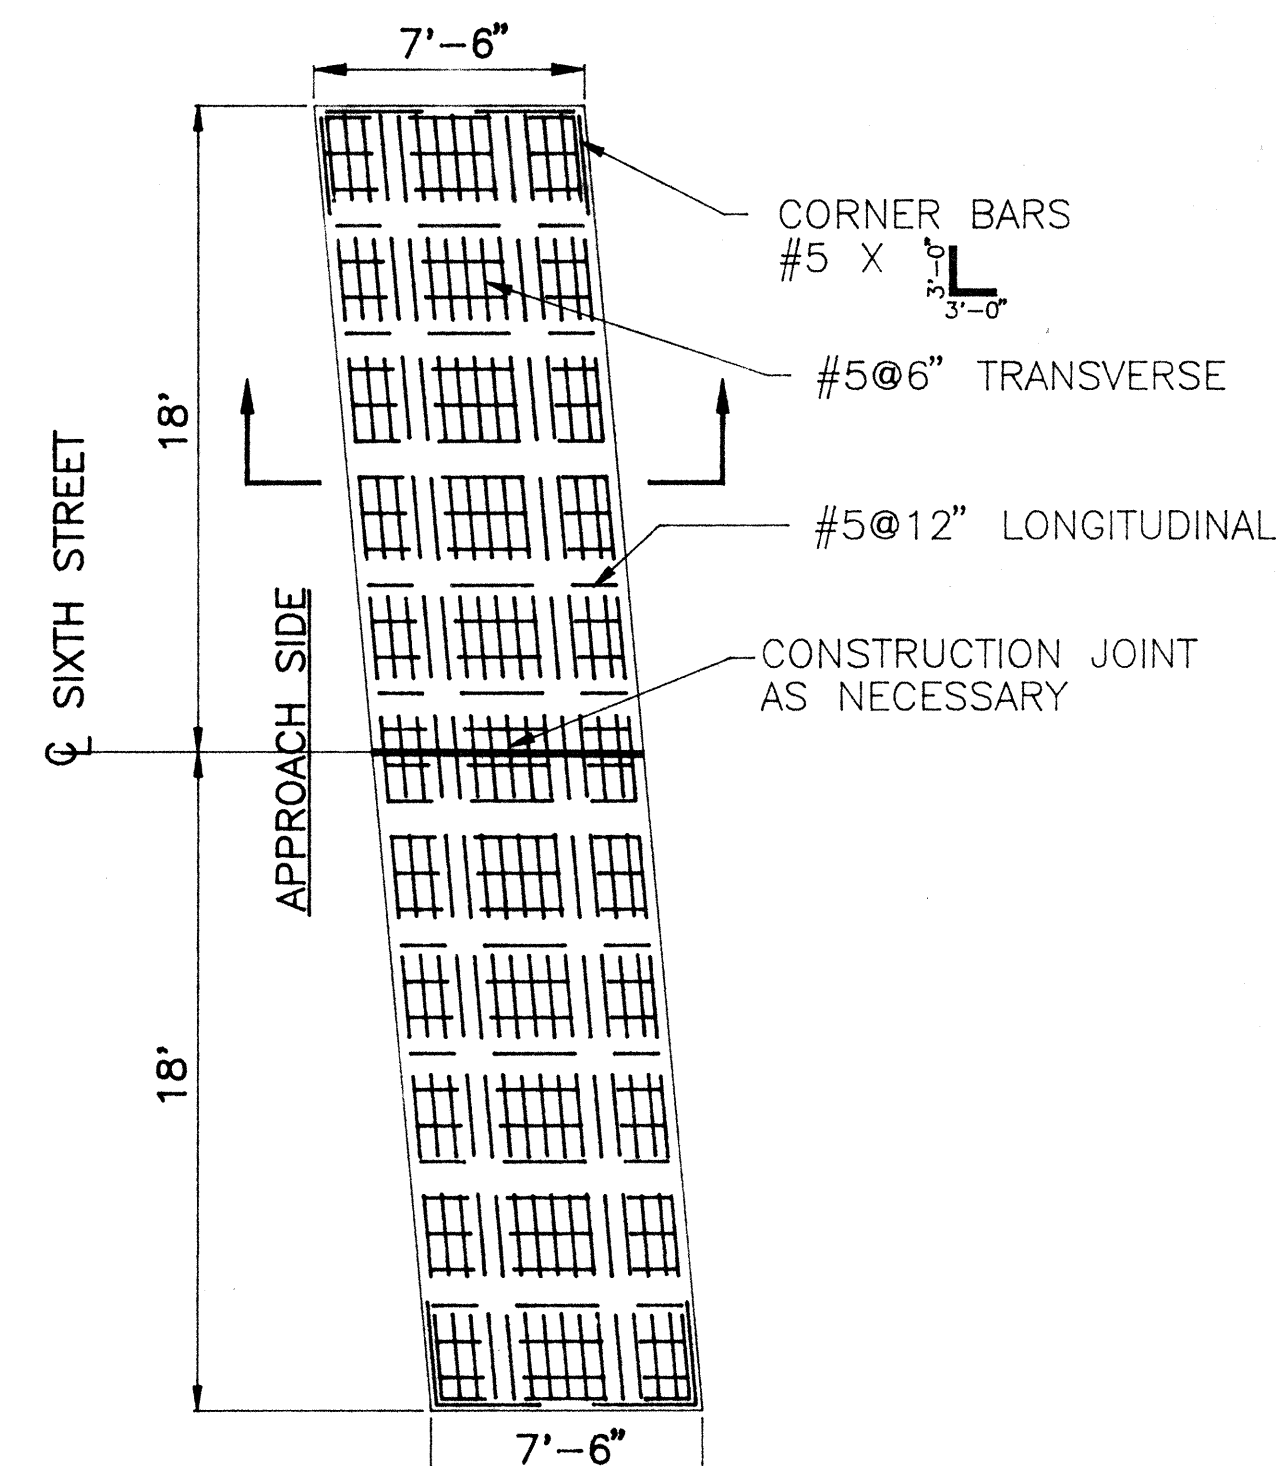


PLAN

DETAIL

TYPICAL CONCRETE CENTER SLAB

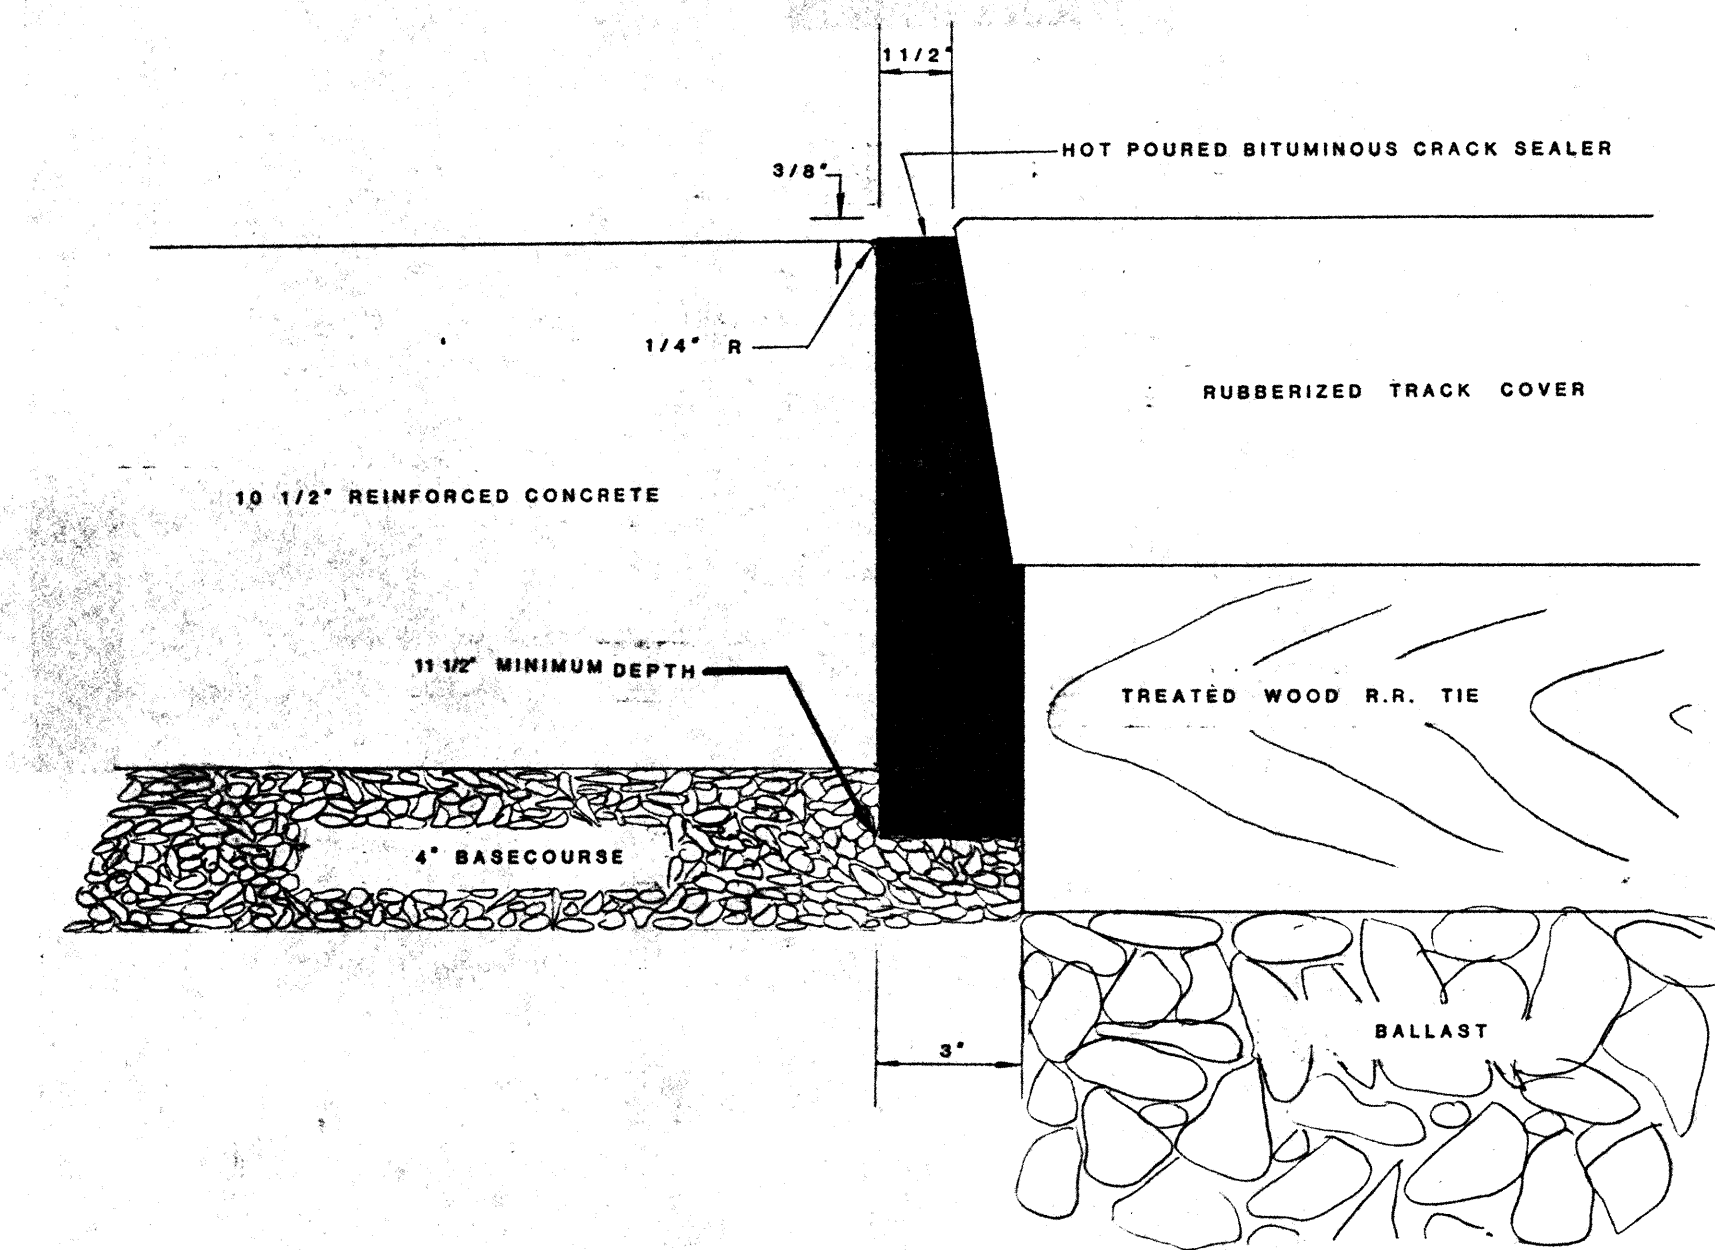

TYPICAL EXPANSION JOINT - CONCRETE TO TRACK

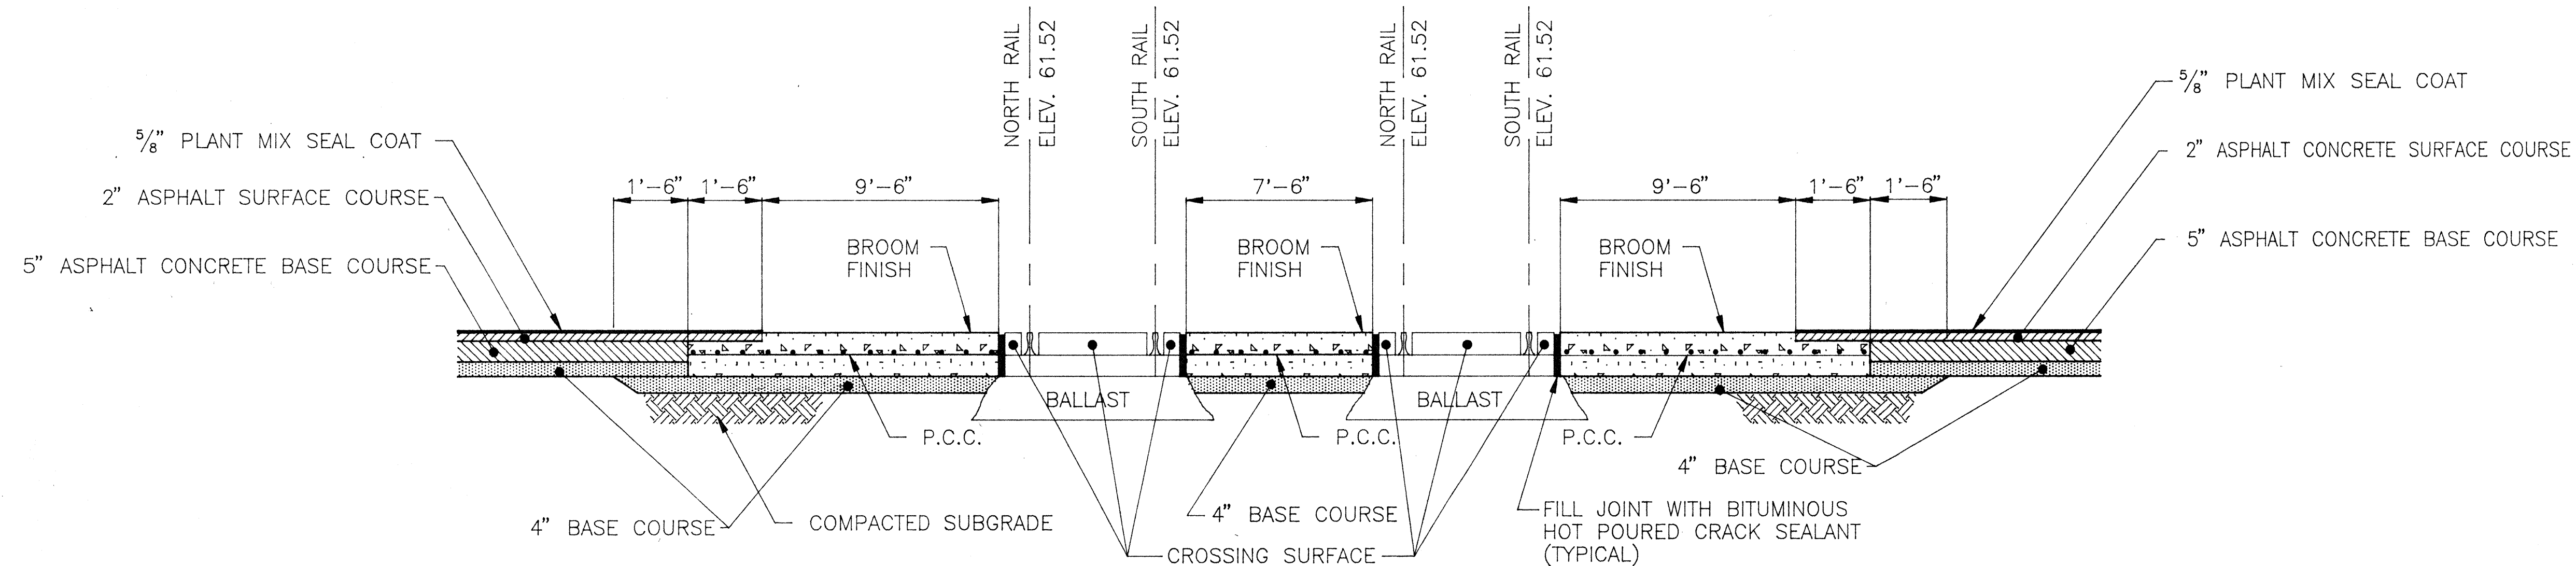

CROSSING SECTION
AT CENTERLINE OF SIXTH STREET

[illegible]

CITY OF ALBUQUERQUE PUBLIC WORKS DEPARTMENT					
TITLE: SIXTH STREET IMPROVEMENTS RR CROSSING - CHANGE ORDER					
APPROVALS	ENGINEER	DATE	APPROVALS	ENGINEER	DATE
City Engineer			Liquid Waste		
A.C.E. - Design			Traffic		
A.C.E. - Hydrology			Water		
DRAWING NO. 3568			MAP NO. J - 14	SHEET OF 7B 22	