
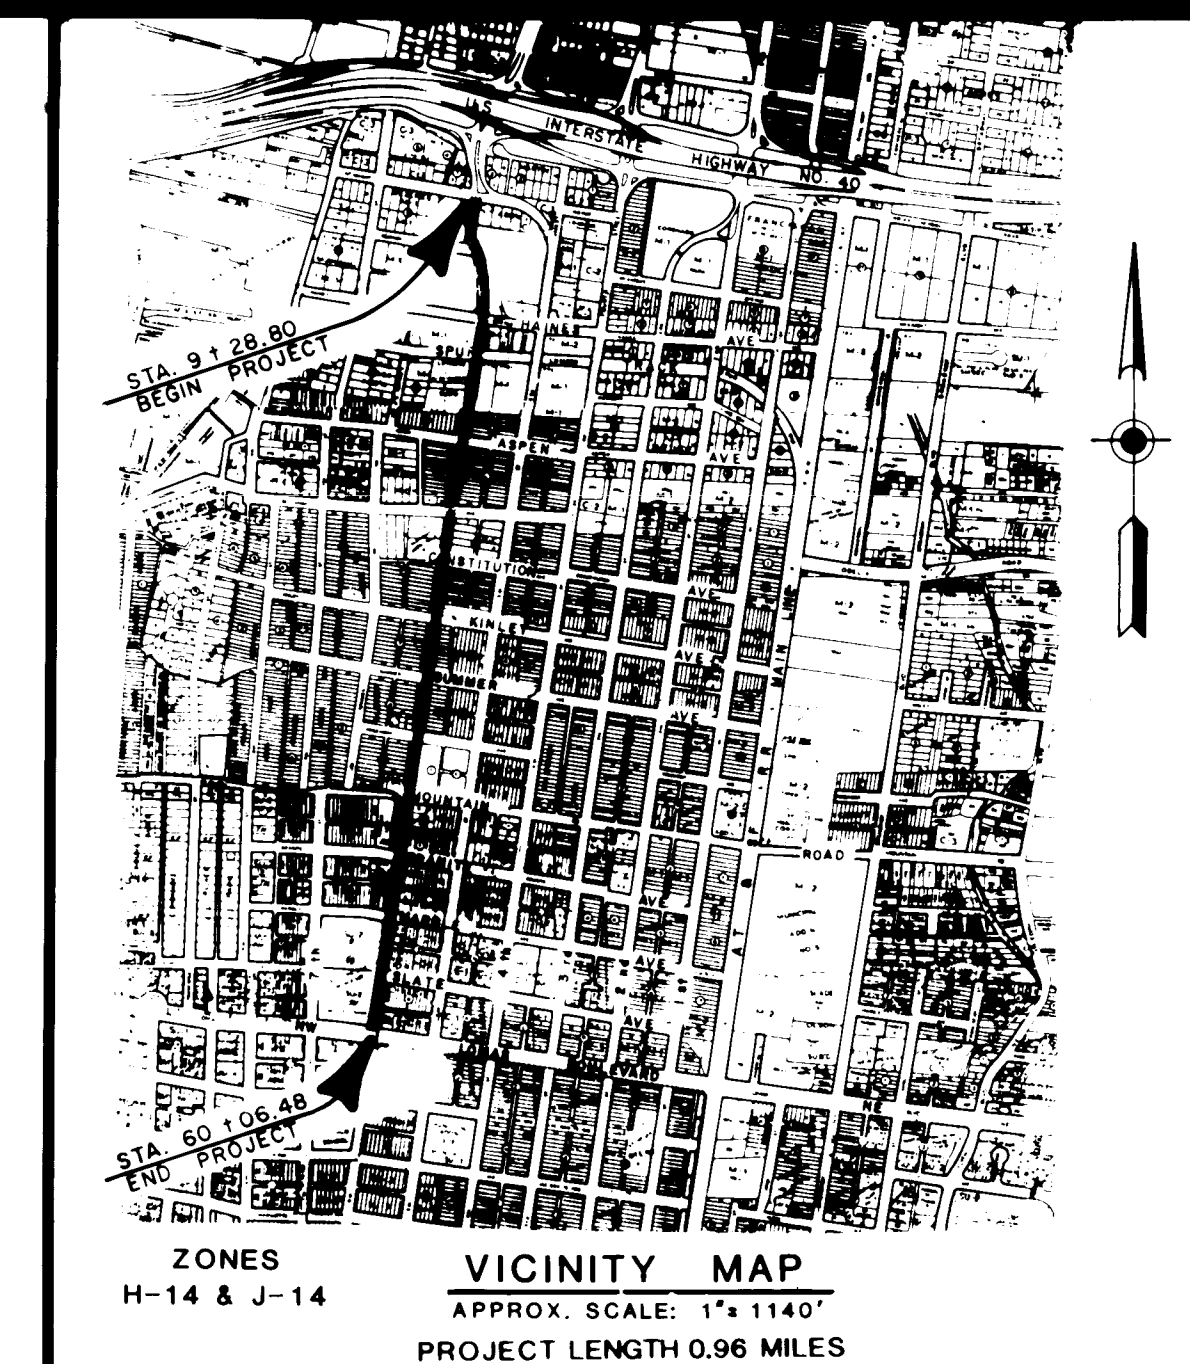


CITY OF ALBUQUERQUE
NEW MEXICO
PUBLIC WORKS ENGINEERING / TRANSPORTATION DEPARTMENT

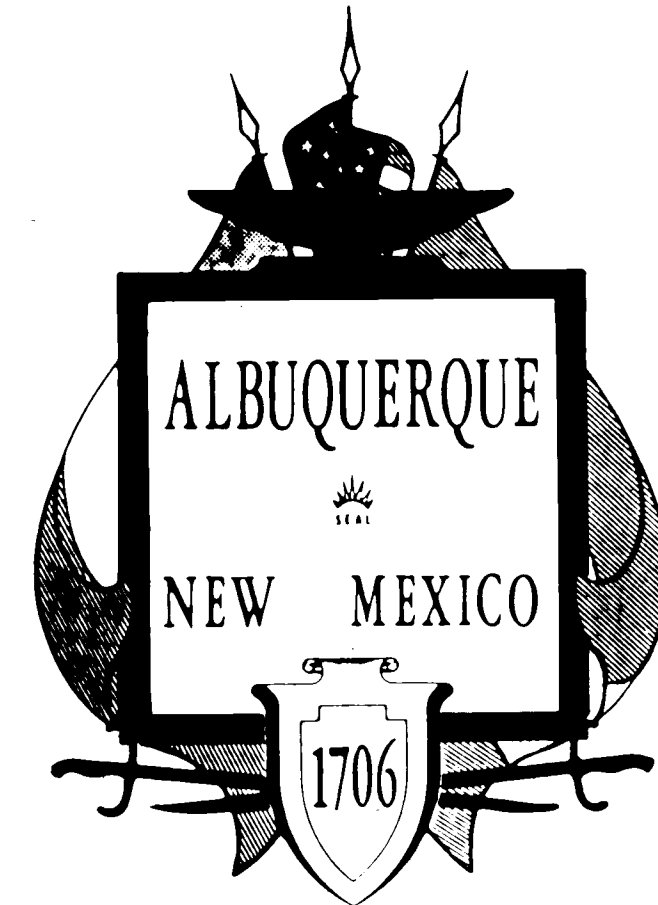

SIXTH STREET IMPROVEMENTS

FROM LOMAS TO MC KNIGHT


SP-3-89 (944)

C.O.A. PROJECT NO. 3568

INDEX OF DRAWINGS

SHEET NO.	DESCRIPTION
1	TITLE SHEET
2	GENERAL NOTES & MISCELLANEOUS DETAILS
3	SCHEMATIC OF CONSTRUCTION ACTIVITIES
4	SLIP LINING & POINT REPAIR DETAILS
5	QUANTITY SCHEDULES
6	TYPICAL SECTION - DETAILS
7	PAVING PLAN & PROFILE - STA. 9+28.80 TO 21+00
8	PAVING PLAN & PROFILE - STA. 21+00 TO 33+00
9	PAVING PLAN & PROFILE - STA. 33+00 TO 45+00
10	PAVING PLAN & PROFILE - STA. 45+00 TO 56+00
11	PAVING PLAN & PROFILE - STA. 56+00 TO 60+06.48
12	PERMANENT STRIPING PLAN
13	UTILITIES PLAN & PROFILE - STA. 9+28.80 TO 21+00
14	UTILITIES PLAN & PROFILE - STA. 21+00 TO 33+00
15	UTILITIES PLAN & PROFILE - STA. 33+00 TO 45+00
16	UTILITIES PLAN & PROFILE - STA. 45+00 TO 56+00
17	UTILITIES PLAN & PROFILE - STA. 56+00 TO 60+12
18	STORM DRAIN DETAILS
19	STORM DRAIN DETAILS
20	STORM DRAIN DETAILS
21	TRAFFIC CONTROL PLAN
22	TRAFFIC CONTROL PLAN

ENGINEER'S FILE NO. 26209

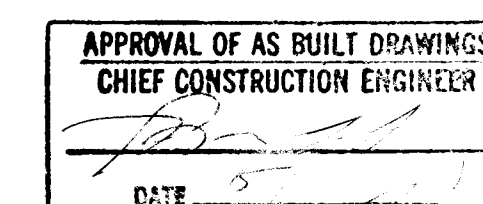

RECORD DRAWING
Drawings revised to reflect the
best information available. Do
not use without field verification

1 2 3 4 5 6 7 8 9 10 11 12 26 35 68 01 90							
BID SET NO.							
REV	SHEETS	CITY ENGINEER	DATE	USER DEPT	DATE	USER DEPT	DATE
APPROVAL OF REVISIONS							
		GANNETT FLEMING/MATOTAN, INC. ENGINEERS 230 TRUMAN N.E. ALBUQUERQUE, N.M. 87108 PHONE: 505 265-8468				APPROVED FOR CONSTRUCTION	
PROJECT NUMBER				3568			
SHEET				1 OF 22			

1. THE SPECIFICATIONS USED FOR THIS PROJECT ARE THE CITY OF ALBUQUERQUE STANDARD SPECIFICATIONS FOR PUBLIC WORKS CONSTRUCTION "1986".
2. DISPOSAL OF ALL WASTE MATERIALS SHALL BE IN CITY APPROVED WASTE AREAS SECURED BY AND AT THE EXPENSE OF THE CONTRACTOR.
3. THE CONTRACTOR SHALL INFORM THE CITY ONE WEEK IN ADVANCE OF ALL LANE CHANGES, LANE CLOSURES, DETOURS, AND OTHER CONSTRUCTION ACTIVITIES WHICH AFFECT NORMAL TRAFFIC FLOW.
4. THE FIRE DEPARTMENT SHALL BE NOTIFIED 48 HOURS IN ADVANCE BY THE CONTRACTOR WHENEVER A FIRE HYDRANT IS TO BE REMOVED OR IS TO BE OUT OF SERVICE.
5. THE AIR POLLUTION CONTROL REGULATIONS OF THE ALBUQUERQUE-BERNALILLO COUNTY AIR QUALITY CONTROL BOARD LIMIT EMISSION OF PARTICULATE MATTER AND THE USE OF CUT-BACK ASPHALT.
6. FIFTY (50) TON ROLLER OPERATION SHALL NOT BE USED IN THIS PROJECT. THE REQUIRED COMPACTION SHALL BE EFFECTED BY OTHER TYPE OF ROLLING EQUIPMENT.
7. ALL EXCAVATION FOR THE STORM DRAINS, AND OTHER EXCAVATIONS, SHALL BE GOVERNED BY FEDERAL, STATE AND LOCAL LAWS, RULES AND REGULATIONS CONCERNING CONSTRUCTION SAFETY AND HEALTH.
8. ALL SIGNS AND CODING WILL BE IN ACCORDANCE WITH THE "MANUAL OF UNIFORM TRAFFIC CONTROL DEVICES FOR STREETS AND HIGHWAYS" CURRENT EDITION, PUBLISHED BY THE U.S. DEPARTMENT OF TRANSPORTATION.
9. THE CONTRACTOR IS TO EXERCISE CARE WHEN REMOVING EXISTING PAVEMENT TO AVOID DISTURBING ANY EXISTING UNDERGROUND UTILITIES. IT SHALL BE HIS RESPONSIBILITY TO COORDINATE WITH THE UTILITY COMPANIES IN ORDER TO PREVENT ANY SERVICE DISRUPTION. ANY BROKEN WATER OR SEWER SERVICES RESULTING FROM CONTRACTOR'S CONSTRUCTION EFFORTS WILL BE REPAIRED BY THE CONTRACTOR AND NO SEPARATE MEASUREMENT NOR PAYMENT WILL BE MADE, BUT SHALL BE CONSIDERED INCIDENTAL TO THE CONSTRUCTION OF THE PROJECT.
10. CURB AND GUTTER, SIDEWALKS AND DRIVEPADS SHOWN AS EXISTING AND NOT TO BE REMOVED UNDER THIS CONTRACT, WHICH ARE DAMAGED OR DISPLACED BY THE CONTRACTOR, SHALL BE REMOVED AND REPLACED BY THE CONTRACTOR AT HIS EXPENSE.
11. WHEN ABUTTING NEW PAVEMENT TO EXISTING INTERSECTING STREETS, SAW CUT EXISTING PAVEMENT TO A STRAIGHT LINE AND AT RIGHT ANGLES TO REMOVE ANY BROKEN OR CRACKED PAVEMENT. NO DIRECT PAYMENT WILL BE MADE FOR SAW CUTTING.
12. ALL GAS VALVE BOXES, GAS MANHOLES, ELECTRICAL MANHOLES, TELEPHONE MANHOLES AND UTILITY POLES WILL BE ADJUSTED TO GRADE OR RELOCATED BY OTHERS.
13. WHEN REMOVAL OF EXISTING CURB AND GUTTER OR SIDEWALK IS REQUIRED, REMOVE BACK TO NEAREST SUITABLE JOINT UNLESS OTHERWISE NOTED.
14. THE CONTRACTOR SHALL NOTIFY THE UTILITY COMPANIES BY CALLING 765-1234 FORTY- EIGHT (48) HOURS BEFORE COMMENCING WORK IN AREAS NEAR UNDERGROUND UTILITY LINES.
15. THE CONTRACTOR IS RESPONSIBLE FOR ANY DAMAGE CAUSED BY HIM TO EXISTING VALVE BOXES, SIDEWALKS, TRAFFIC CONDUIT, MANHOLES AND CURB AND GUTTER DURING CONSTRUCTION AND SHALL REPAIR OR REPLACE SAME AT HIS OWN EXPENSE. THE CONTRACTOR SHALL PROTECT THE CURB AND GUTTER FROM INCIDENTAL SPLASHING DURING TRACK COAT APPLICATION AND CONTRACTOR SHALL BE RESPONSIBLE FOR CLEANING THE SAME AT HIS OWN EXPENSE IN THE EVENT OF SPLASHING.
16. CONTRACTOR SHALL MAKE ACCESSIBLE ALL WATER VALVES AND MANHOLES TO THE CITY UPON REQUEST, DURING CONSTRUCTION.
17. THE USE OF ADJUSTING RINGS WITHIN THE MANHOLE FRAMES TO ADJUST MANHOLE COVERS WILL NOT BE PERMITTED.
18. CAUTION - ALL EXISTING UTILITIES SHOWN REFLECT THE BEST INFORMATION AVAILABLE AND ARE APPROXIMATE ONLY. EXACT DEPTH OF UTILITIES IS UNKNOWN.
19. ALL MANHOLE FRAMES AND COVERS AND WATER VALVE FRAMES AND LIDS SHALL BE ADJUSTED WITH CONCRETE COLLARS IN ACCORDANCE WITH THE STANDARD AND ALL MANHOLE FRAMES AND COVERS AND WATER VALVE FRAMES AND LIDS ON FIFTH STREET WITHIN PROJECT LIMITS SHALL NOT BE ADJUSTED UNTIL AFTER THE TWO (2) INCH SURFACE COURSE HAS BEEN PLACED AND COMPACTED TO INSURE PROPER FINISHED GRADE.
20. ALL SUBGRADE MATERIAL ENCOUNTERED IN PAVEMENT REMOVAL AND REPLACEMENT AND DETERMINED BY THE ENGINEER TO MEET MOISTURE CONTENT AND PERCENT COMPACTION, AS REQUIRED BY THE SPECIFICATIONS, CAN BE LEFT IN PLACE.
21. SUBGRADE PREPARATION UNDER SIDEWALKS AND DRIVEPADS, AND SUBGRADE PREPARATION AND BASE COURSE INSTALLATION UNDER "STANDARD CURB AND GUTTER" SHALL BE CONSIDERED INCIDENTAL TO THE CONSTRUCTION OF SUCH AND NO DIRECT PAYMENT SHALL BE MADE FOR THOSE ITEMS OF WORK.
22. QUANTITIES SHOWN HEREIN, FOR THE VARIOUS BID ITEMS, ARE FOR THE CONTRACTOR'S INFORMATION ONLY. PAYMENT SHALL BE BASED ON ACTUAL QUANTITIES AS CONSTRUCTED.
23. THE CONTRACTOR SHALL COORDINATE WATER VALVE SHUT OFFS WITH THE WATER SYSTEM DIVISION NOT LESS THAN TWO WORKING DAYS PRIOR TO THE SHUT OFF. PHONE (505) 823-4200.
24. THE CONTRACTOR SHALL SUPPORT ALL EXPOSED UTILITIES WHICH ARE IN SERVICE DURING HIS CONSTRUCTION ACTIVITIES.
25. THE CONTRACTOR SHALL CONTACT TOM GRIMES OF P.N.M. PHONE (505) 848-3318 TWO WORKING DAYS PRIOR TO THE NEED TO SUPPORT A POWER POLE OR PROTECTION OF OVERHEAD POWER LINES. ANY SUPPORT OF A POLE NECESSARY BY P.N.M. BEYOND ONE WORKING DAY WILL BE AT THE CONTRACTOR'S EXPENSE.
26. A ONE MILLION DOLLAR (1,000,000) RAILROAD LIABILITY INSURANCE POLICY WILL BE REQUIRED OF THE CONTRACTOR FOR THIS PROJECT. AN ADDITIONAL COPY OF THE POLICY WILL BE FORWARDED TO MR. BRETT LOCKE, CHIEF, PROJECT DEVELOPMENT SECTION, CITY OF ALBUQUERQUE, ALBUQUERQUE, NEW MEXICO, 87103, (505) 768-2760. TWO WEEKS PRIOR TO COMMENCING WORK IN THE RAILROAD RIGHT-OF-WAY, THE CONTRACTOR WILL CONTACT MR. LARRY STOTTS OR MR. PETE EASTHAM AT 822-5026. THE CONTRACTOR WILL BE RESPONSIBLE FOR REIMBURSEMENT OF FLAGMAN THAT THE RAILROAD WILL REQUIRE DURING CONSTRUCTION.
27. SOIL BORINGS AND UTILITY POTHOLE INDICATE UNSUITABLE CLAY SUBGRADE FROM MCKINIGHT AVENUE TO ASPEN AVENUE AND BETWEEN MOUNTAIN ROAD AND GRANITE AVENUE. EXACT LIMITS OF REMOVAL OF THESE UNSUITABLE SUBGRADE SOILS WILL BE DETERMINED IN THE FIELD BY THE CITY'S REPRESENTATIVE AFTER THE EXISTING PAVEMENT HAS BEEN REMOVED.
28. LINE CLEANING AND TELEVISION INSPECTION WITH VIDEO TAPE OF THE 8" SANITARY SEWER WILL BE PERFORMED, ON SIXTH STREET, IN THE NON-SCHEDULED AREA OF UTILITY WORK FROM THE SANITARY M.H. #932 JUST SOUTH OF THE R.R. SPUR TO M.H. #325 AT ROSEMONT.

TYPICAL PAVEMENT SECTION
(SEE DETAIL SHEET 6 OF 22)

1'-0" 10'-0" 1'-0" 10'-0"

STA. 10 + 00

NEW 8" CONCRETE PAVEMENT


4" ACBC, 1500 LB. STAB.

6" GRAVEL BASE COURSE

6" COMPACTED SUBGRADE

NOT TO SCALE

1. CONTRACTOR SHALL MAKE ACCESSIBLE ALL WATER VALVES AND MANHOLE COVERS TO THE CITY UPON REQUEST, DURING CONSTRUCTION.
17. THE USE OF ADJUSTING RINGS WITHIN THE MANHOLE FRAMES TO ADJUST MANHOLE COVERS WILL NOT BE PERMITTED.
18. CAUTION - ALL EXISTING UTILITIES SHOWN REFLECT THE BEST INFORMATION AVAILABLE AND ARE APPROXIMATE ONLY. EXACT DEPTH OF UTILITIES IS UNKNOWN.
19. ALL MANHOLE FRAMES AND COVERS AND WATER VALVE FRAMES AND LIDS SHALL BE ADJUSTED WITH CONCRETE COLLARS IN ACCORDANCE WITH THE STANDARD DETAILS AND ALL MANHOLE FRAMES AND COVERS AND WATER VALVE FRAMES AND LIDS ON FIFTH STREET WITHIN PROJECT LIMITS SHALL NOT BE ADJUSTED UNTIL AFTER THE TWO (2) INCH SURFACE COURSE HAS BEEN PLACED AND COMPACTED TO INSURE PROPER FINISHED GRADE.
20. ALL SUBGRADE MATERIAL ENCOUNTERED IN PAVEMENT REMOVAL AND REPLACEMENT AND DETERMINED BY THE ENGINEER TO MEET MOISTURE CONTENT AND PERCENT COMPACTATION, AS REQUIRED BY THE SPECIFICATIONS, CAN BE LEFT IN PLACE.
21. SUBGRADE PREPARATION UNDER SIDEWALKS AND DRIVEPADS, AND SUBGRADE PREPARATION AND BASE COURSE INSTALLATION UNDER "STANDARD CURB AND GUTTER" SHALL BE CONSIDERED INCIDENTAL TO THE CONSTRUCTION OF SUCH AND NO DIRECT PAYMENT SHALL BE MADE FOR THOSE ITEMS OF WORK.
22. QUANTITIES SHOWN HEREIN, FOR THE VARIOUS BID ITEMS, ARE FOR THE CONTRACTOR'S INFORMATION ONLY. PAYMENT SHALL BE BASED ON ACTUAL QUANTITIES AS CONSTRUCTED.
23. THE CONTRACTOR SHALL COORDINATE WATER VALVE SHUT OFFS WITH THE WATER SYSTEM DIVISION NOT LESS THAN TWO WORKING DAYS PRIOR TO THE SHUT OFF. PHONE (505) 823-4200.
24. THE CONTRACTOR SHALL SUPPORT ALL EXPOSED UTILITIES WHICH ARE IN SERVICE DURING HIS CONSTRUCTION ACTIVITIES.
25. THE CONTRACTOR SHALL CONTACT TOM GRIMES OF P.N.M. PHONE (505) 823-3118 TWO WORKING DAYS PRIOR TO THE NEED TO SUPPORT A POWER POLE OR PROTECTION OF OVERHEAD POWER LINES. ANY SUPPORT OF A POLE NECESSARY BY P.N.M. BEYOND ONE WORKING DAY WILL BE AT THE CONTRACTOR'S EXPENSE.
26. A ONE MILLION DOLLAR (1,000,000) RAILROAD LIABILITY INSURANCE POLICY WILL BE REQUIRED OF THE CONTRACTOR FOR THIS PROJECT. AN ADDITIONAL COPY OF THE POLICY WILL BE FORWARDED TO MR. BRETT LOCKE, CHIEF, PROJECT DEVELOPMENT SECTION, CITY OF ALBUQUERQUE PUBLIC WORKS DEPARTMENT/ENGINEERING, POST OFFICE BOX 1293 ALBUQUERQUE, NEW MEXICO 87103, (505) 768-2760. TWO WEEKS PRIOR TO COMMENCING WORK IN THE RAILROAD RIGHT-OF-WAY, THE CONTRACTOR WILL CONTACT MR. LARRY STOTTS OR MR. PETE EASTMAN AT 822-5026. THE CONTRACTOR WILL BE RESPONSIBLE FOR REIMBURSEMENT OF FLAGMAN THAT THE RAILROAD WILL REQUIRE DURING CONSTRUCTION.
27. SOIL BORINGS AND UTILITY POTHOLES INDICATE UNSUITABLE CLAY SUBGRADE FROM MCKINLEY AVENUE TO ASPEN AVENUE AND BETWEEN MOUNTAIN ROAD AND GRANITE AVENUE. EXACT LIMITS OF REMOVAL OF THESE UNSUITABLE SUBGRADE SOILS WILL BE DETERMINED IN THE FIELD BY THE CITY'S REPRESENTATIVE AFTER THE EXISTING PAVEMENT HAS BEEN REMOVED.
28. LINE CLEANING AND TELEVISION INSPECTION WITH VIDEO TAPE OF THE SANITARY SEWER WILL BE PERFORMED, ON SIXTH STREET, IN THE NON-SCHEDULED AREA OF UTILITY WORK FROM THE SANITARY M.H. #933 JUST SOUTH OF THE R.R. SPUR TO M.H. #325 AT ROSEMONT.

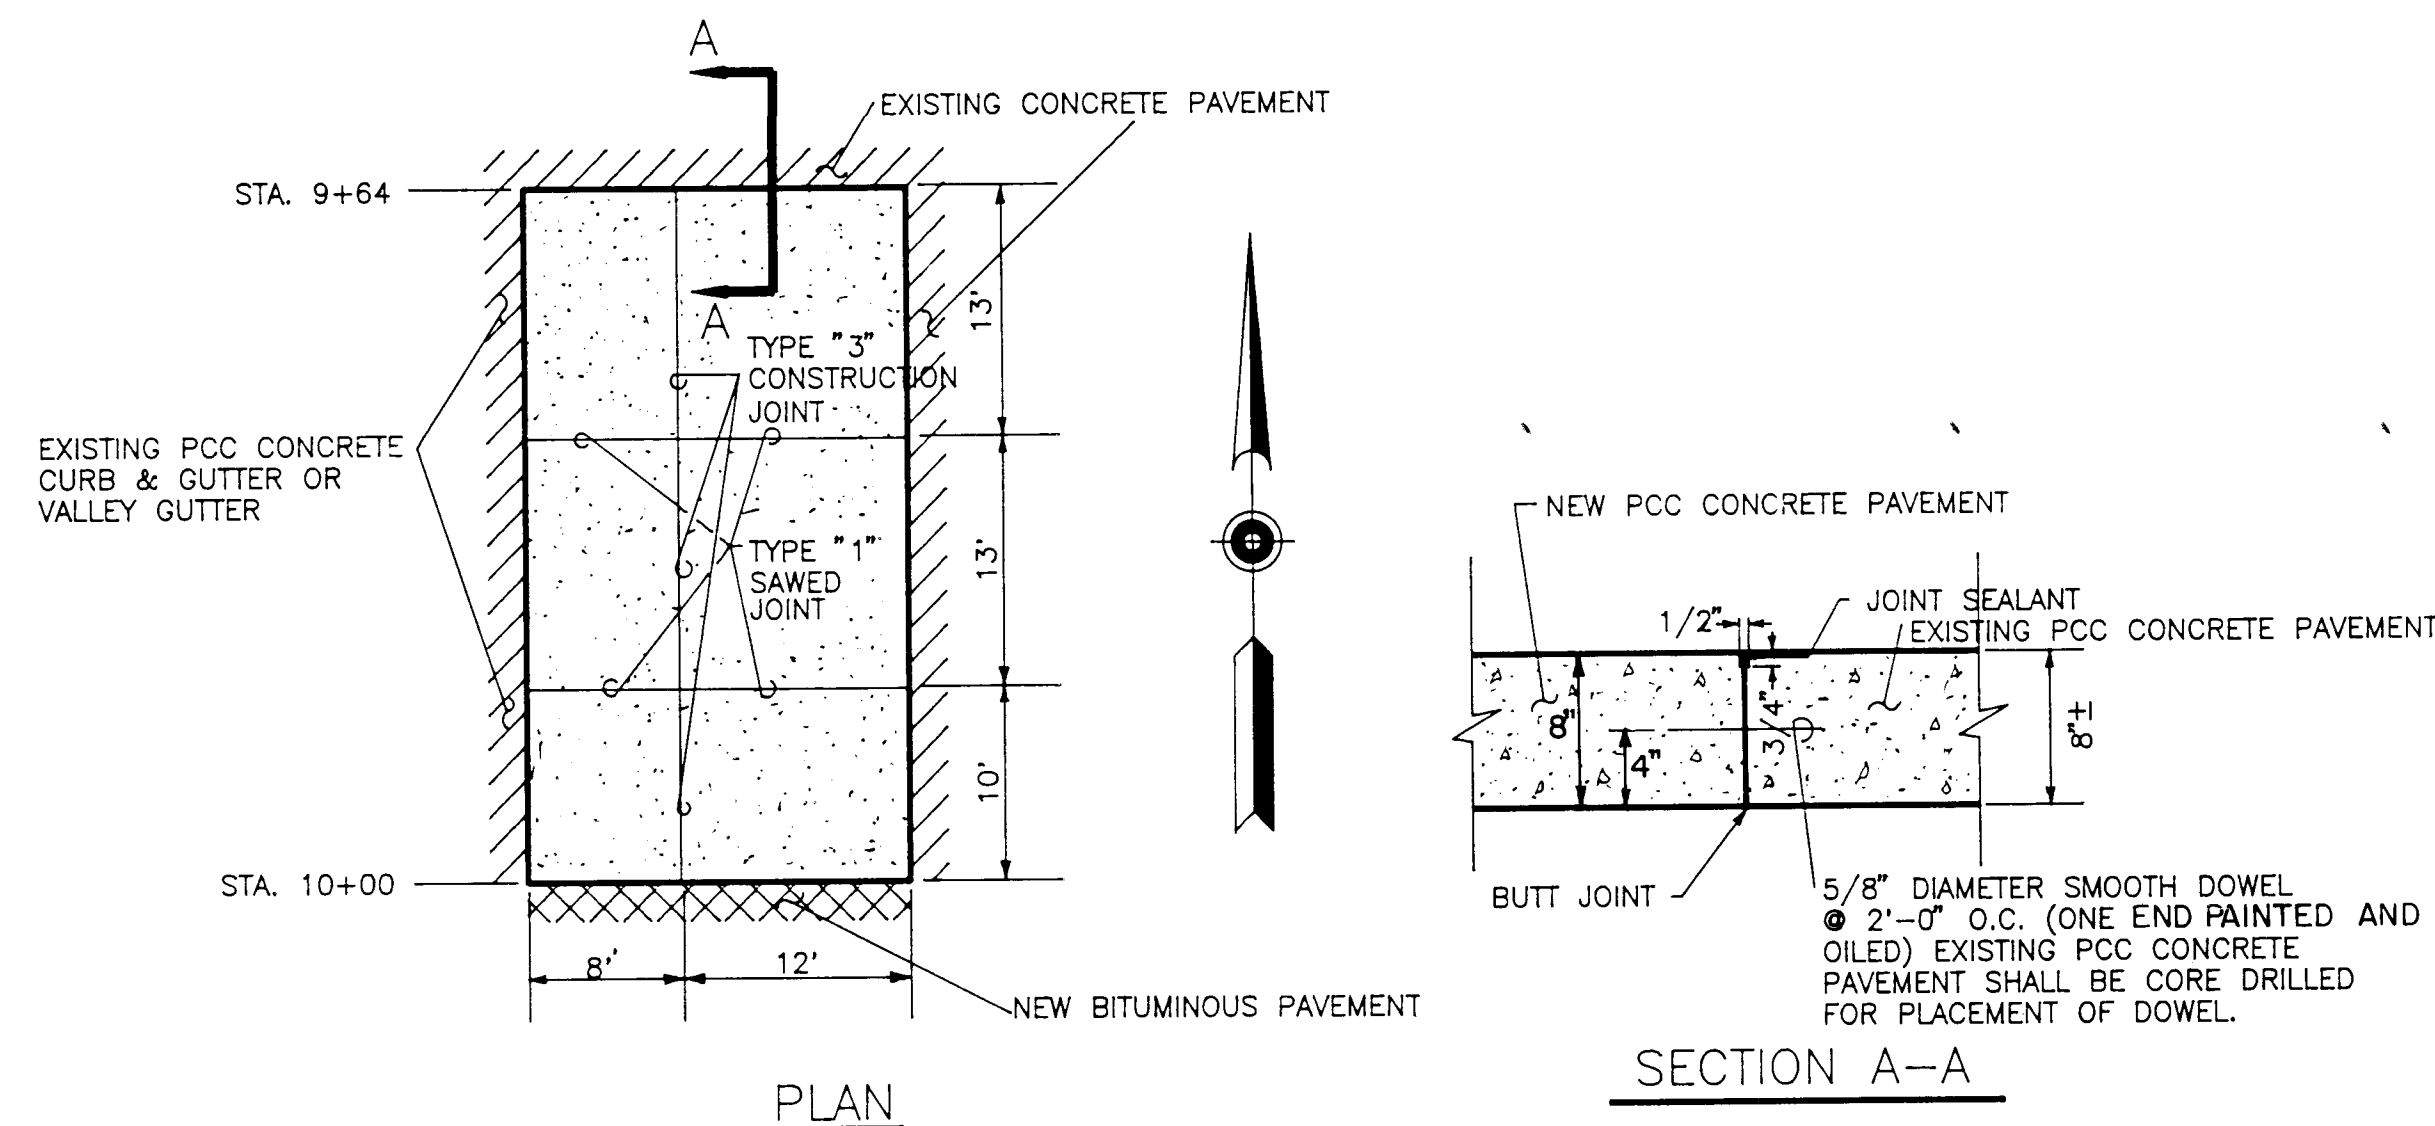

GANNETT FLEMING/MATOTAN, INC.
ENGINEERS - PLANNERS
ALBUQUERQUE, NEW MEXICO


RECORD DRAWING
Drawings revised to reflect the best information available. Do not use without field verification.

ENGINEER'S SEAL		SURVEY INFORMATION		BENCH MARKS		AS BUILT INFORMATION	
		FIELD NOTES					
		NO.	BY	DATE			
							CONTRACTOR: RUSS PITNEY
							SURVEY STARTED BY: CITY OF ALBUQUERQUE DATE: _____
							INSPECTOR'S FIELD CHECKED BY: DATE: _____
							VERIFICATION BY: DATE: _____
							DATE CORRECTED BY: GANNETT FLEMING DATE: _____
				MICRO-FILM INFORMATION			
						RECORDED BY: DATE: _____	
						NO: _____	

TITLE: **SIXTH STREET IMPROVEMENTS**
GENERAL NOTES

APPROVALS	ENGINEER	DATE	APPROVALS	ENGINEER	DATE
City Engineer	<i>Robert Shaw</i>	4-27-89	Liquid Waste	<i>PEGO</i>	4/27/89
A.C.E. Design	<i>4</i>	<i>4</i>	Traffic	<i>Robert Shaw</i>	4-27-89
A.C.F. Hydrology	<i>..</i>	<i>..</i>	Water	<i>PEGO</i>	4/27/89

DRAWING NO.	3568	MAP NO.	SHEET 2 OF 22
-------------	------	---------	---------------

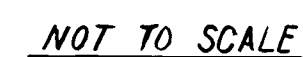

SCHEMATIC ONLY, NOT TO BE USED FOR CONSTRUCTION

LEGEND

Two-way traffic flow


 One-way traffic flow Northbound

 One-way traffic flow Southbound

Pavement removal & replacement areas

 Plant Mix Seal Coat - Surface Treatment Only

 8" PCC Pavement Removal & Replacement

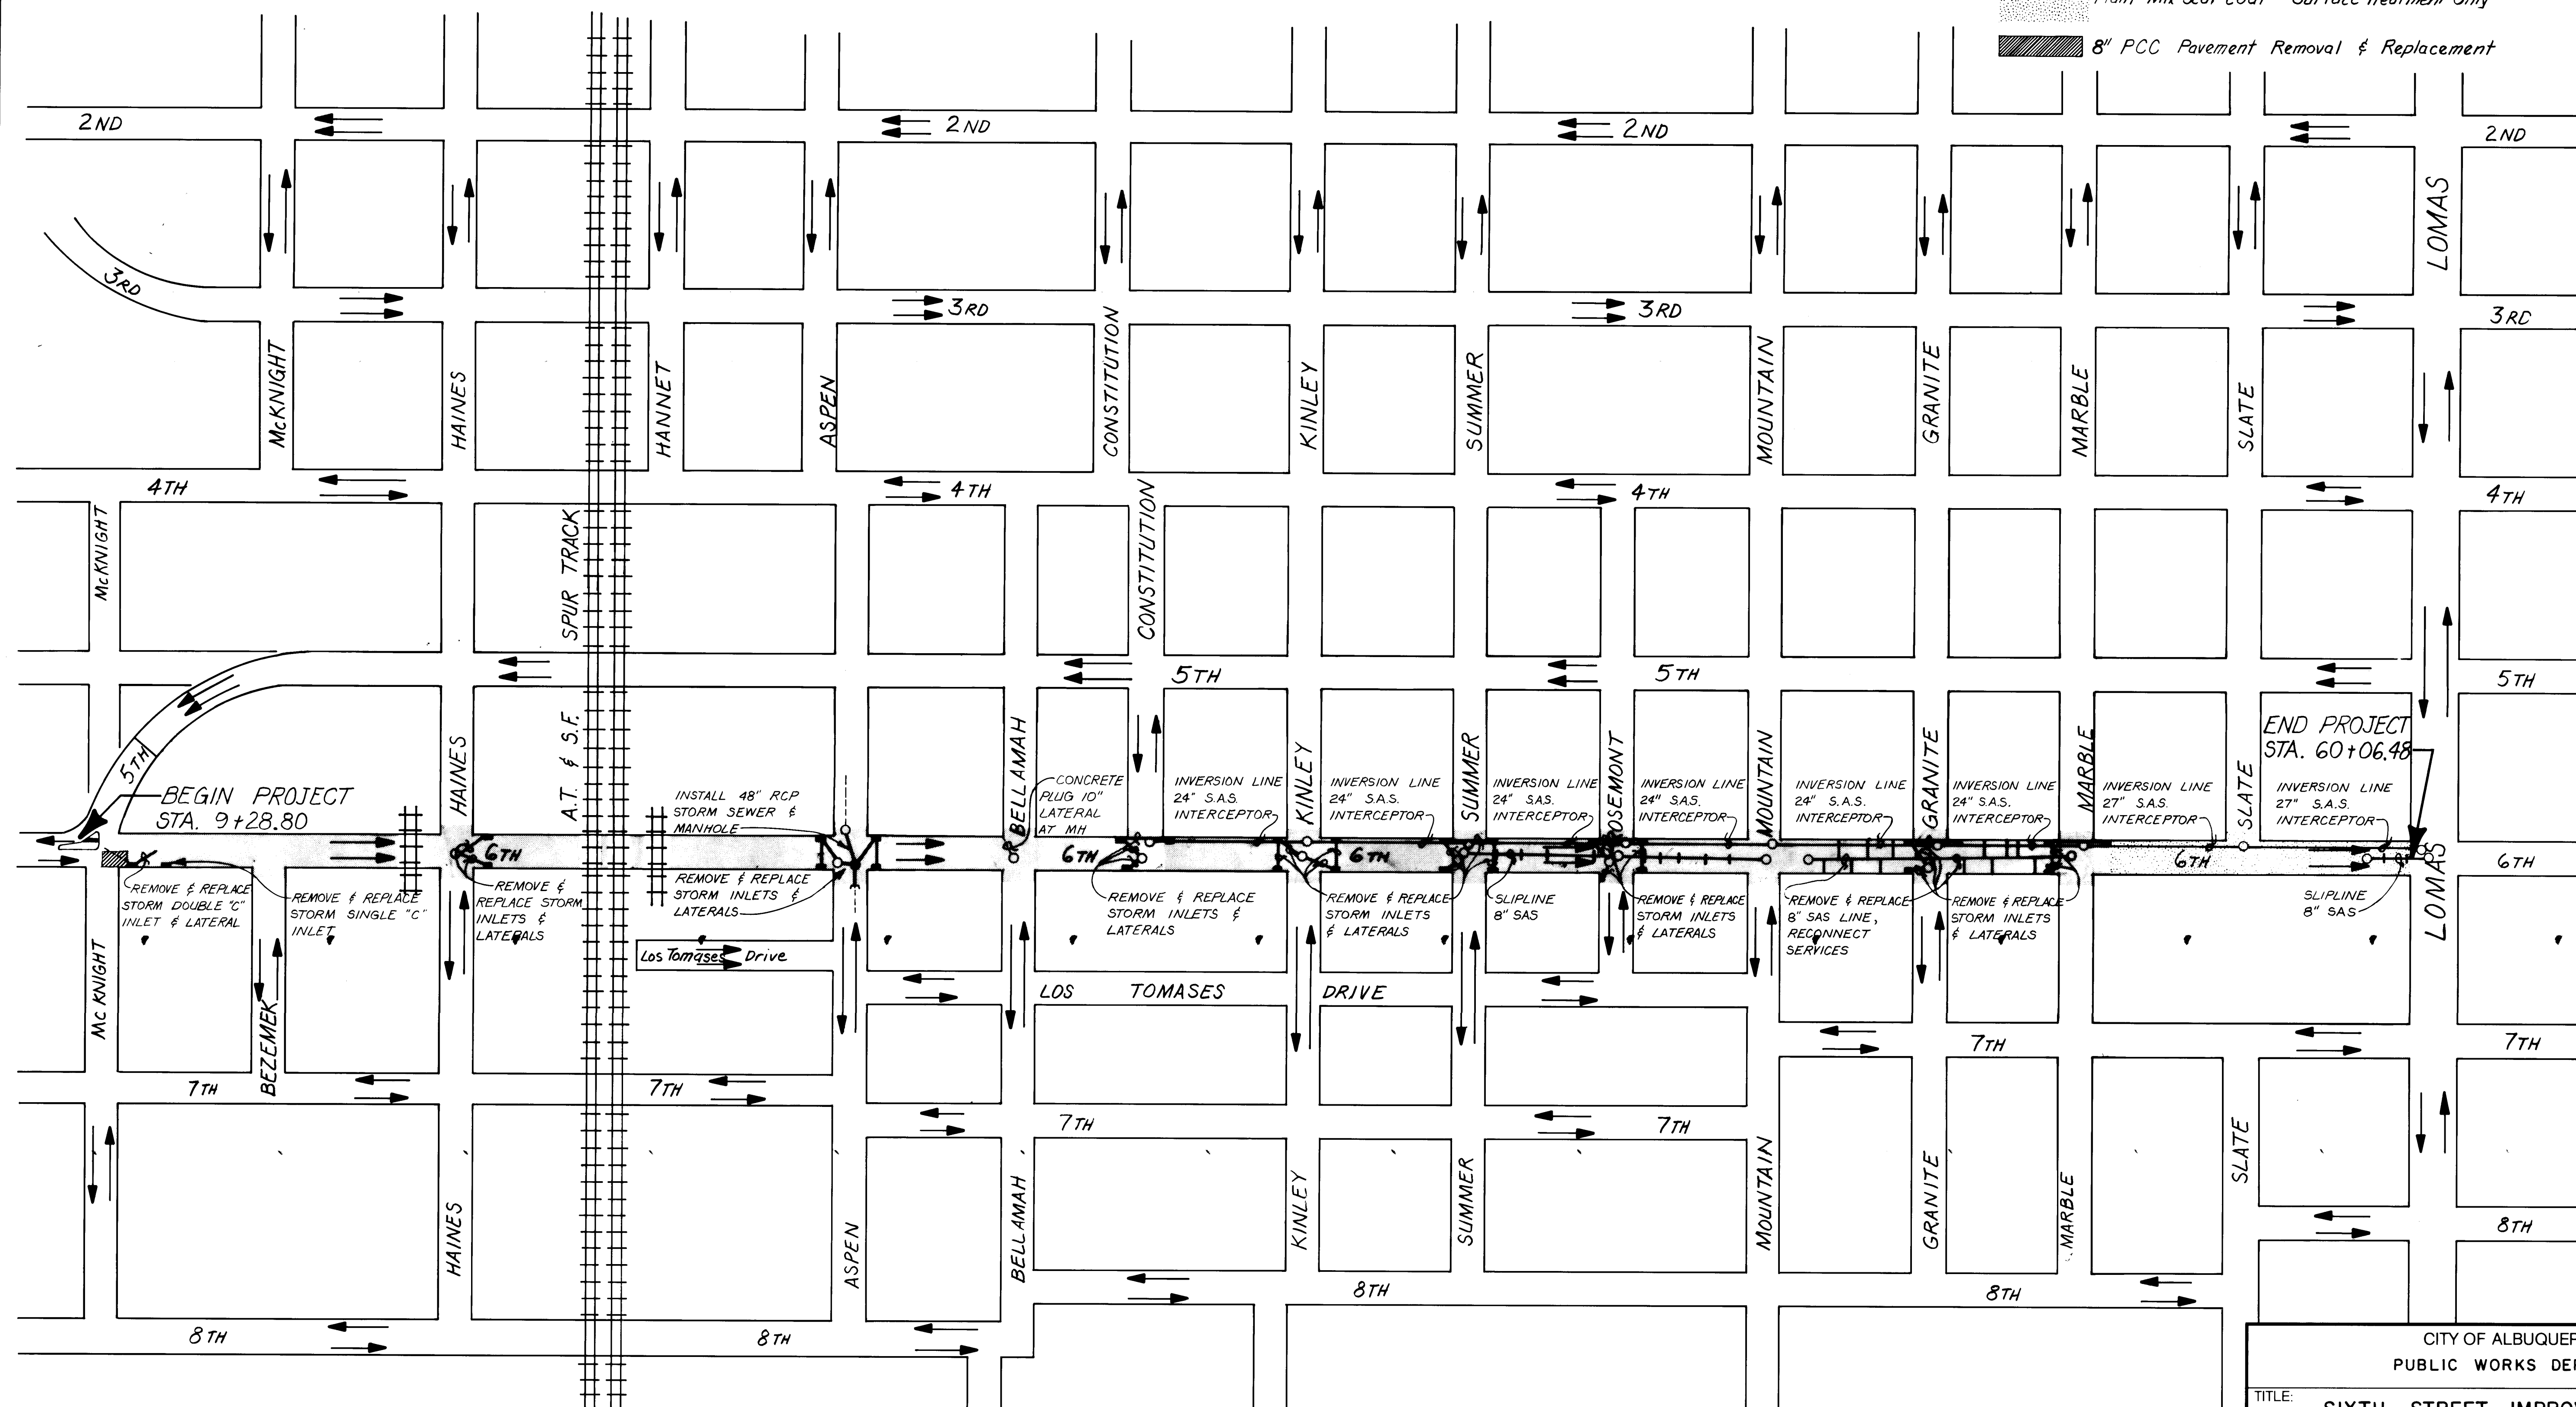

1	2	3	4	5	6	7	8	9	10	11	12
2	6		3	5	6	8	0	3	9	0	

RECORD DRAWING
Drawings revised to reflect the
best information available. Do
not use without field verification

CITY OF ALBUQUERQUE
PUBLIC WORKS DEPARTMENT

TITLE: SIXTH STREET IMPROVEMENTS
SCHEMATIC OF CONSTRUCTION ACTIVITIES

APPROVALS	ENGINEER	DATE	APPROVALS	ENGINEER	DATE
City Engineer	<i>Roger A. Giam</i>	4-27-89	Liquid Waste		
A.C.E. Design	"	"	Traffic	<i>Roger A. Giam</i>	4-27-89
A.C. E.-Hydrology	"	"	Water		

DRAWING NO.	3568	MAP NO.	SHEET 3 OF 22
-------------	------	---------	---------------

AS BUILT INFORMATION			
CONTRACTOR	RUSS PITNEY		
WORK	STAINED BY CITY OF ALBUQU.	DATE	
INSPECTOR'S	ACCEPTANCE BY	DATE	
FIELD	INFORMATION BY	DATE	
DRAWINGS	CORRECTED BY GANNETT FLEMING DATE		
MICRO-FILM INFORMATION			
RECORDED BY		DATE	
NO			

BENCH MARKS

SURVEY INFORMATION

ENGINEER'S SEAL

[illegible]

1

--	--

RQUE

OVALS

ffic

--	--

--	--

WORK STAKED BY	CITY OF ALBUQU.	DATE
INSPECTOR'S ACCEPTANCE BY		DATE
FIELD VERIFICATION BY		DATE
DRAWINGS CORRECTED BY	GANNETT FLEMING DATE	
MICRO—FILM INFORMATION		
RECORDED BY		DATE
NO.		

[illegible][illegible]


		Y			39	39	39
--	--	---	--	--	----	----	----

[illegible][illegible][illegible]


ENGINEER	DATE
----------	------

Koger A Green	4-27-88
---------------	---------


HEET OF

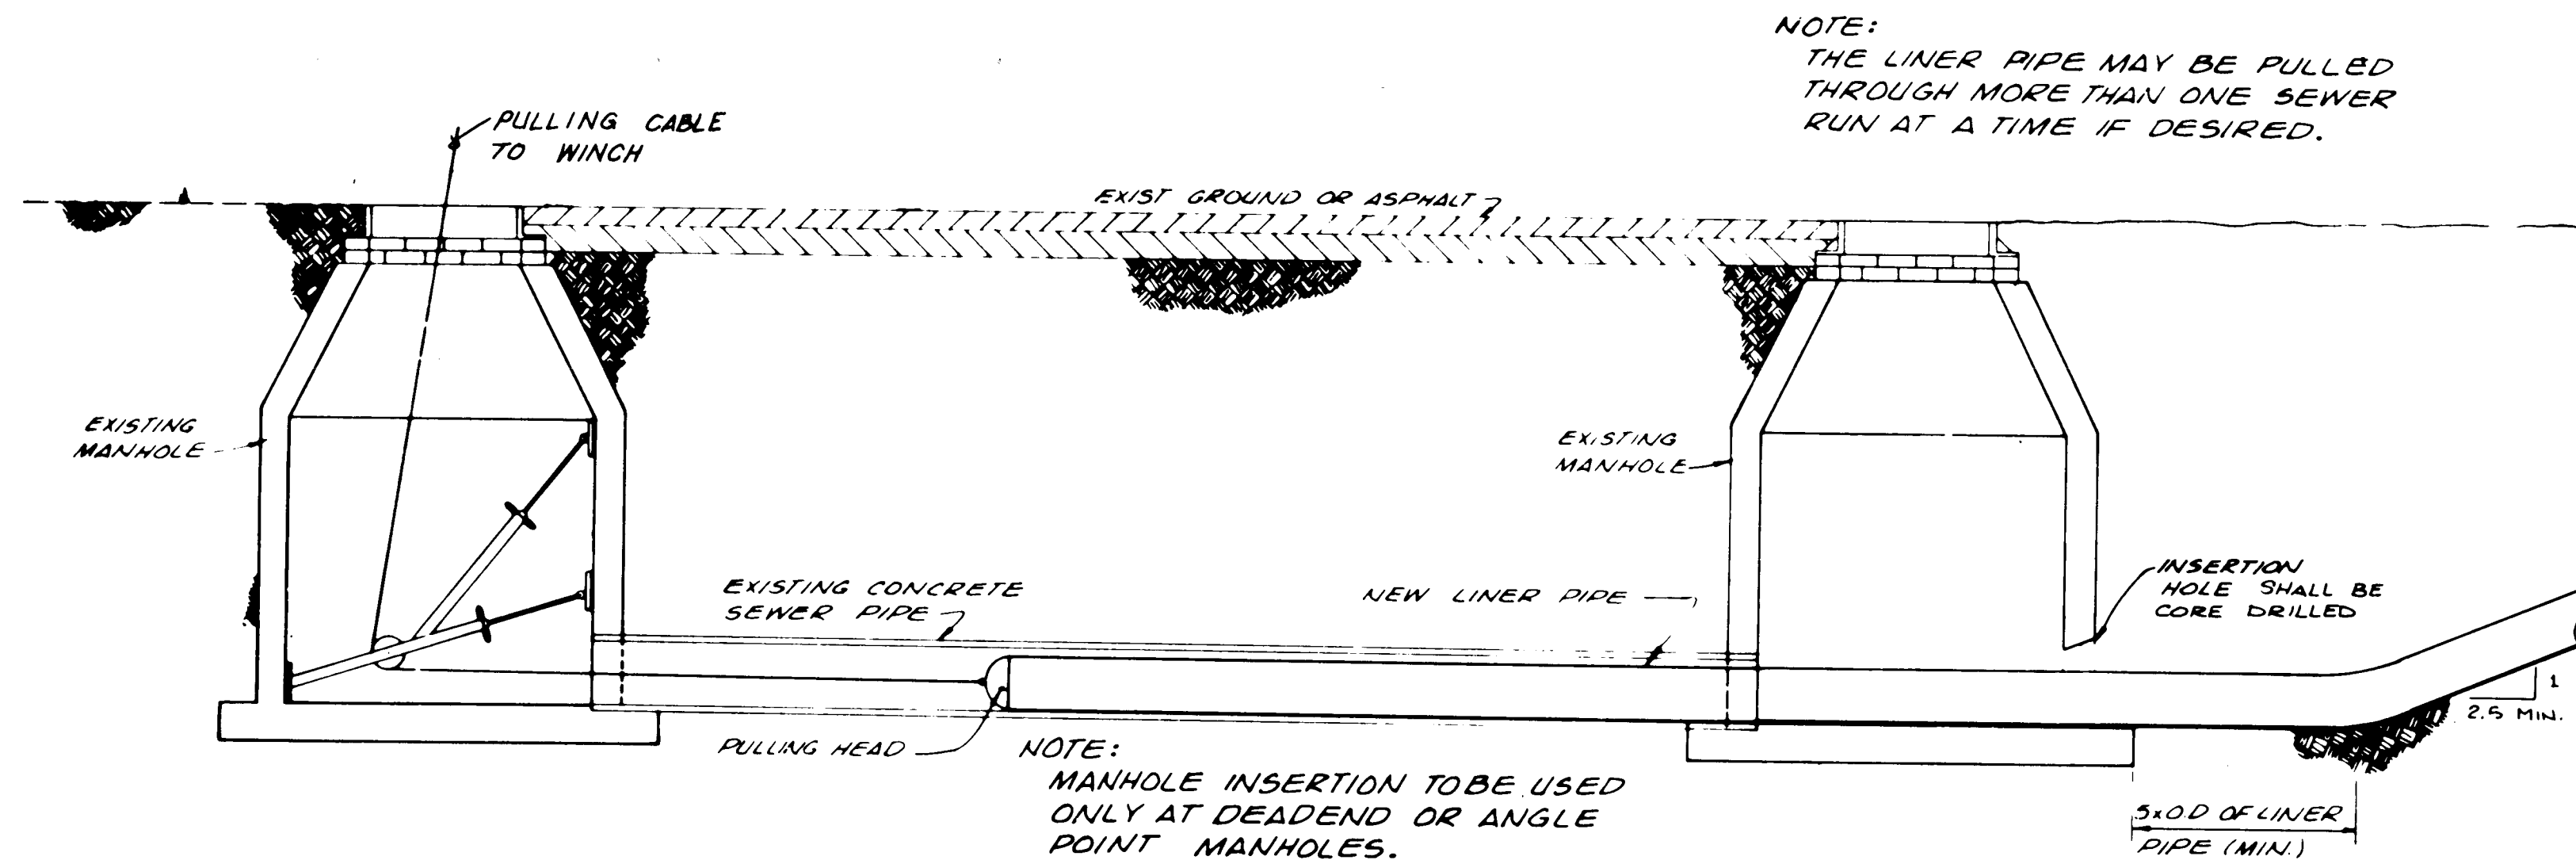


TYPICAL MANHOLE INSERTION PROFILE
NO SCALE

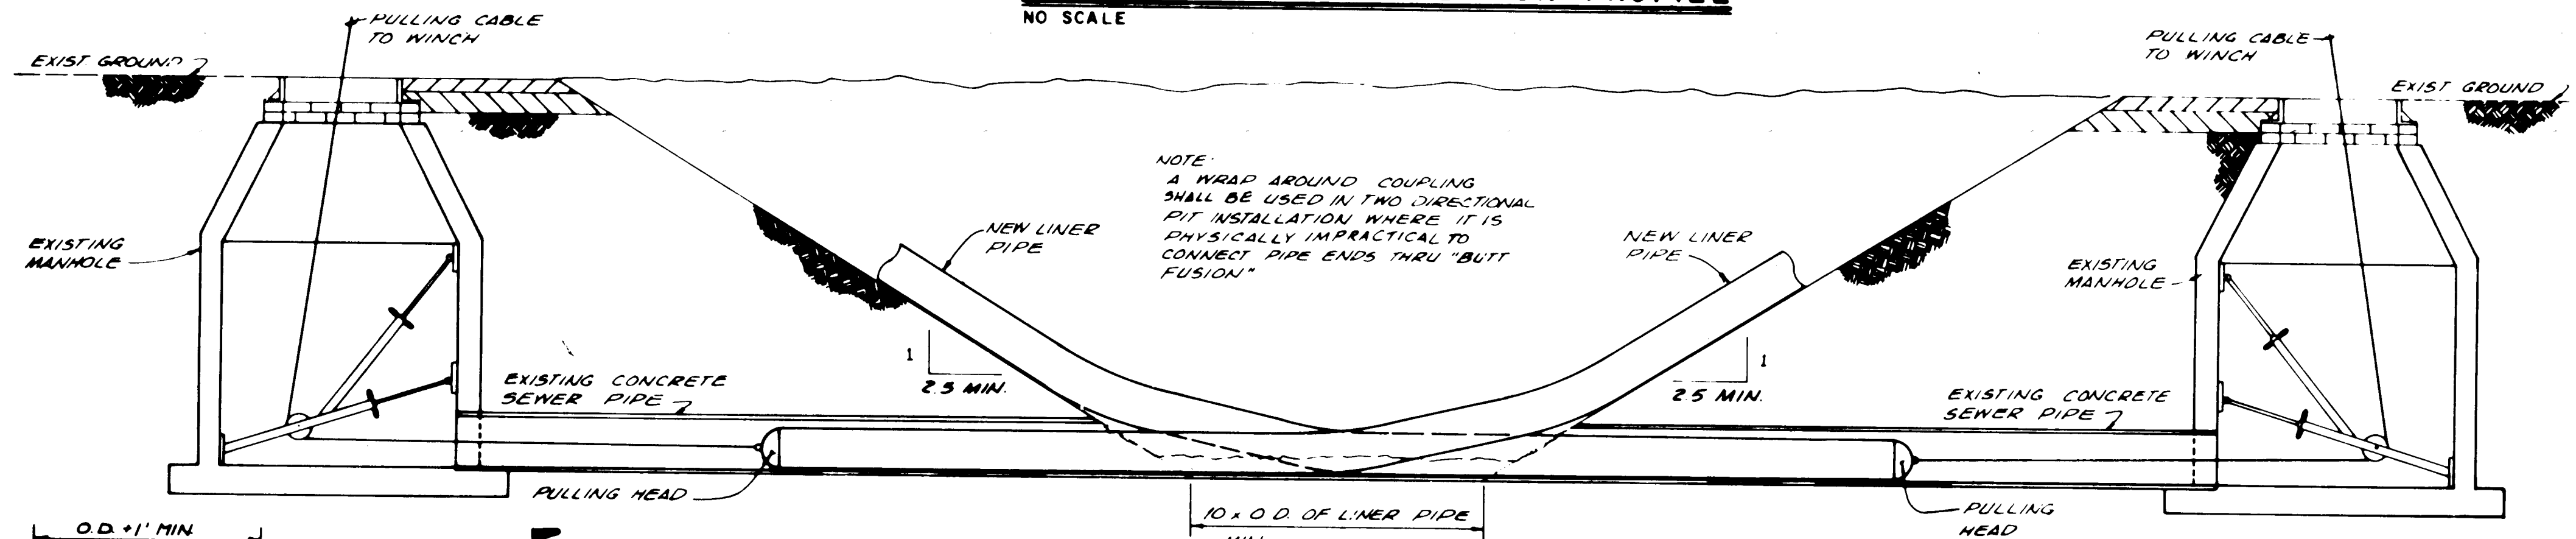


TYPICAL MID-LINE INSERTION PROFILE
NO SCALE

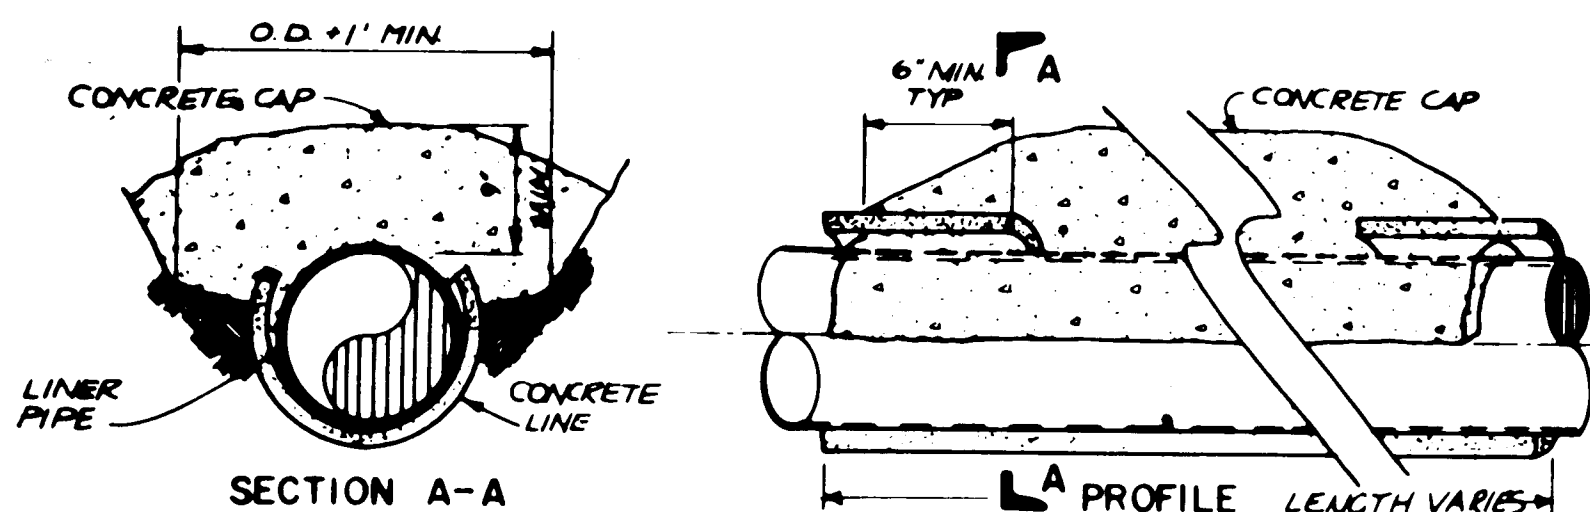


CONCRETE POINT REPAIR
NO SCALE

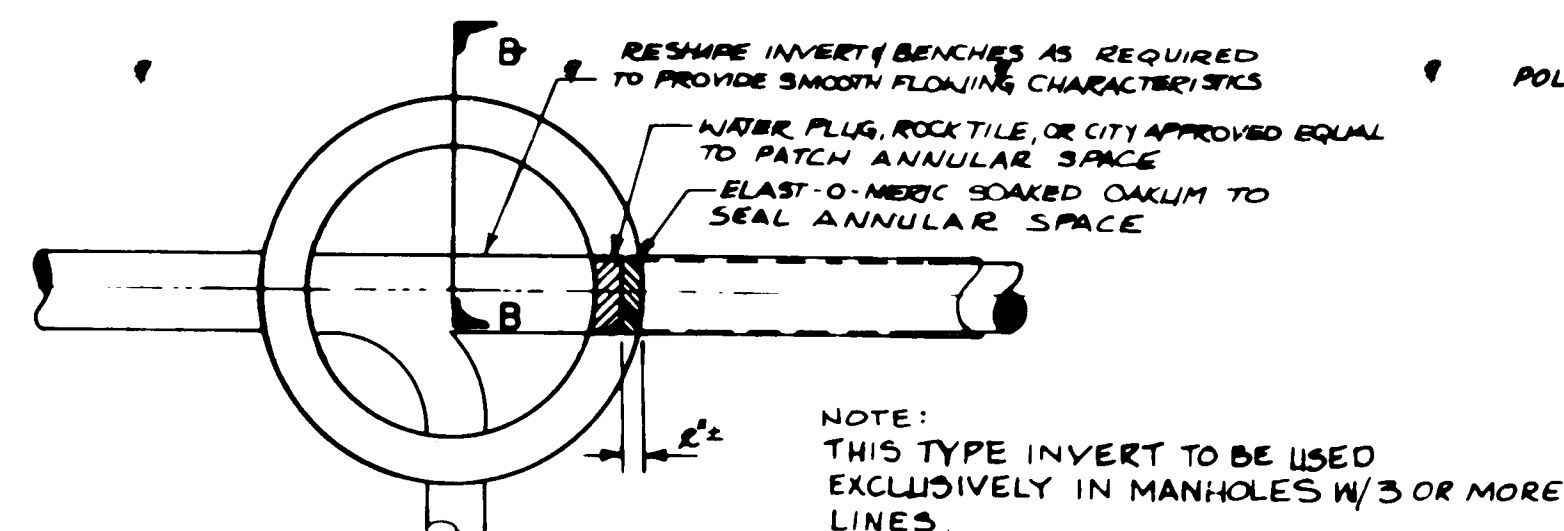


PLAN-VIEW OF MANHOLE - LINER CONNECTION WITH CONCRETE INVERT
NO SCALE

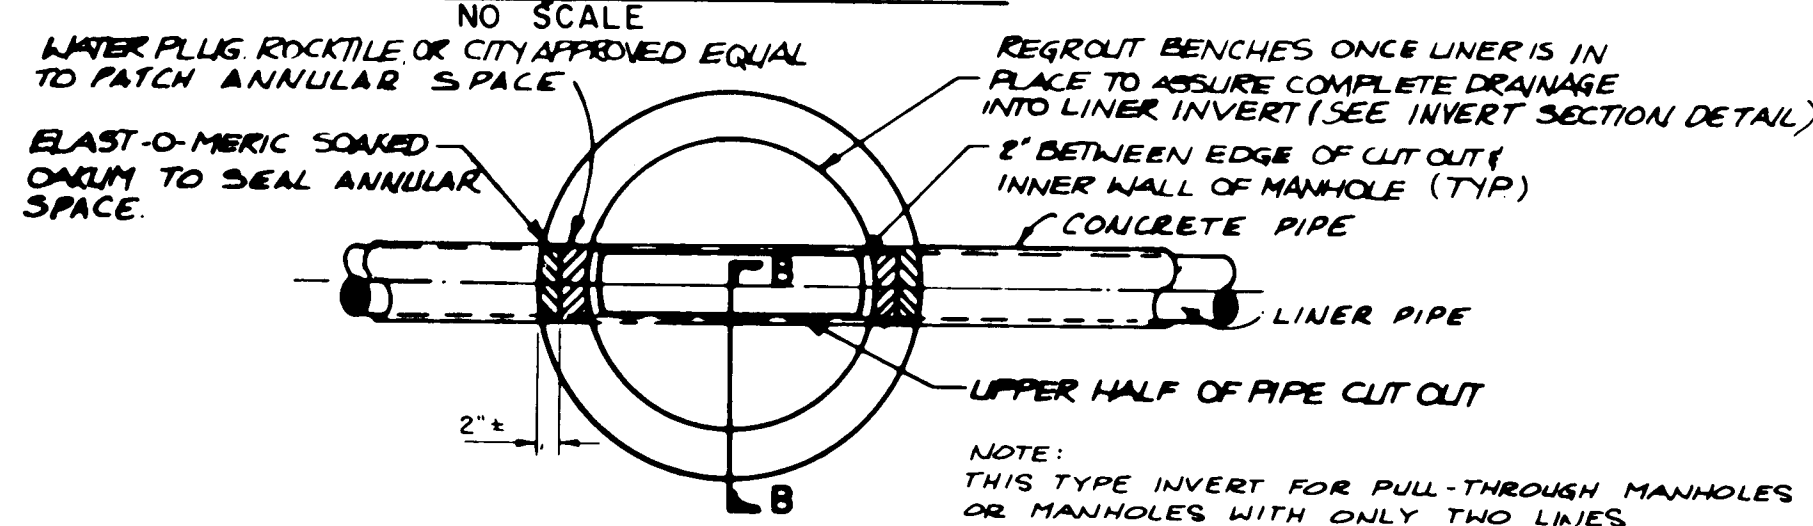


PLAN VIEW OF MANHOLE - INVERT DETAIL LINER PULLED THROUGH
NO SCALE

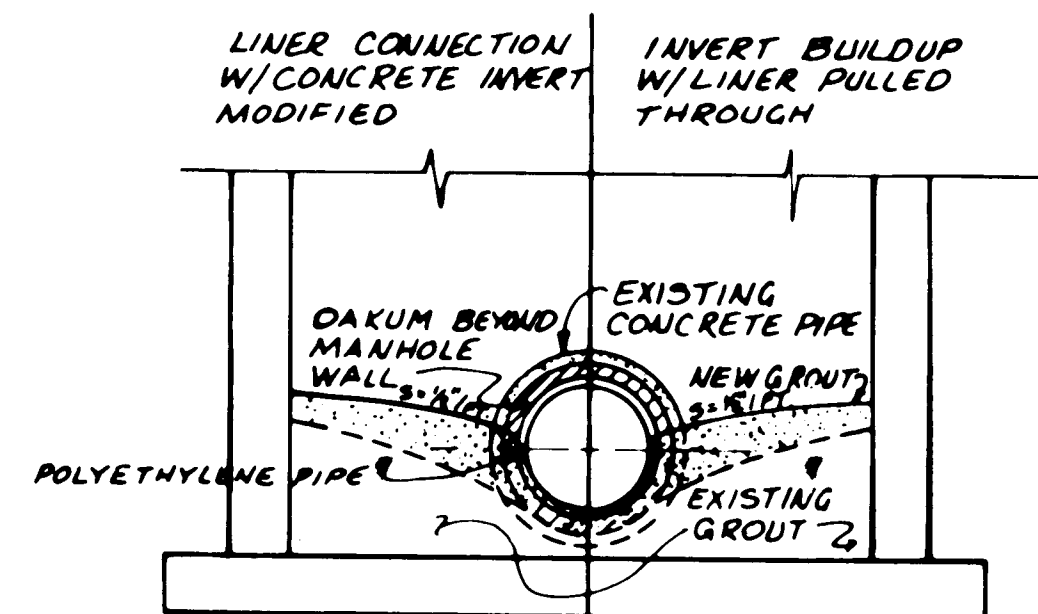

INVERT SECTION (B-B)
NO SCALE

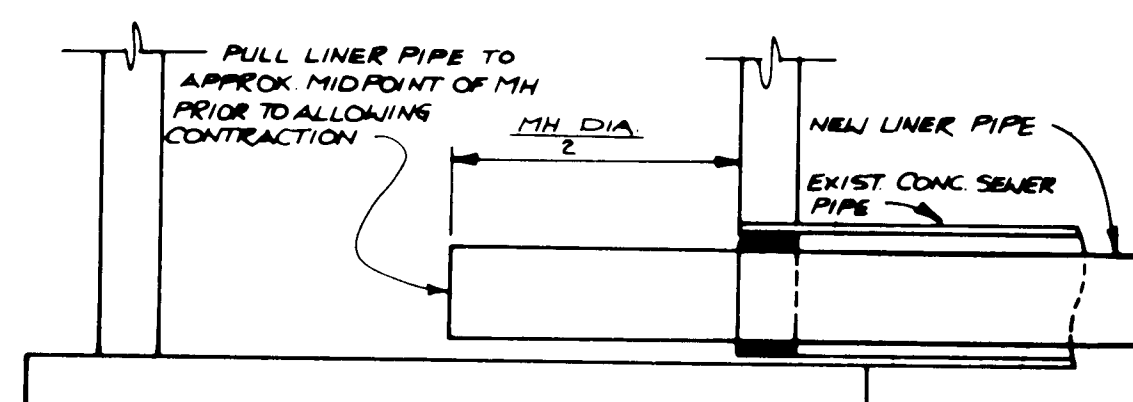


MANHOLE-LINER CONNECTION DETAIL
NO SCALE

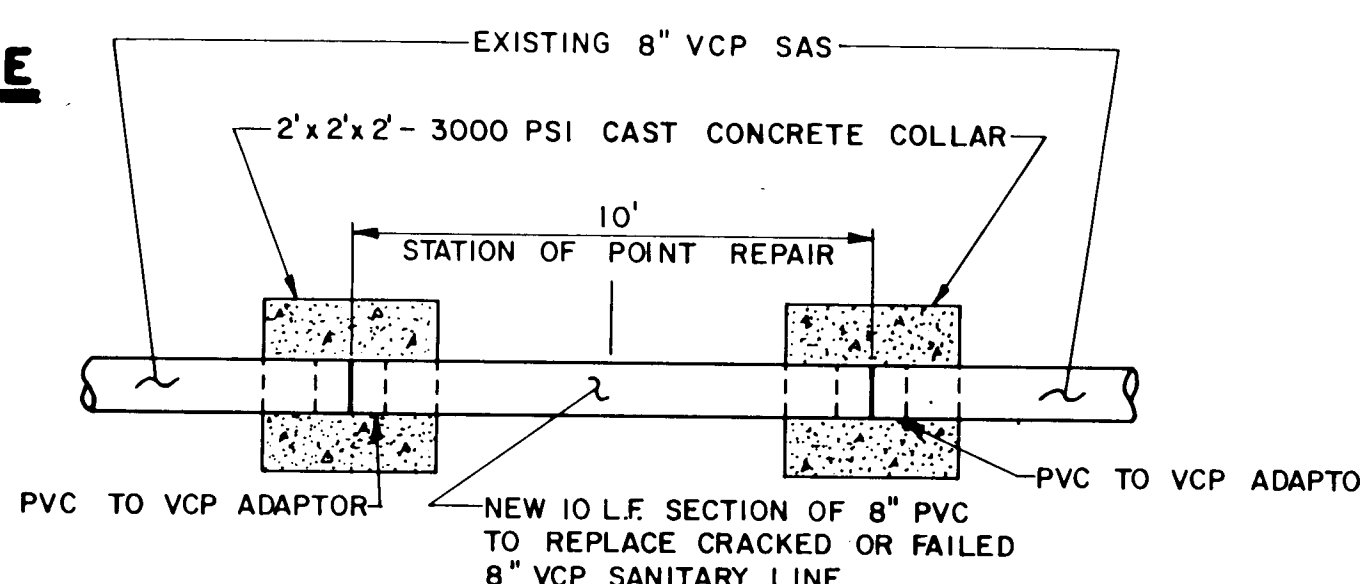


NON-SLIP LINE POINT REPAIR DETAIL
NOT TO SCALE

ITEM OF SANITARY SEWER POINT REPAIR
To include excavation of cracked or failed section of pipe, removal and disposal of ± 10 L.F. of the cracked or failed section of pipe, replacement with 8" SDR-32.5 PVC pipe, adaptors and cast concrete collars, backfill and compaction, complete in place, each.

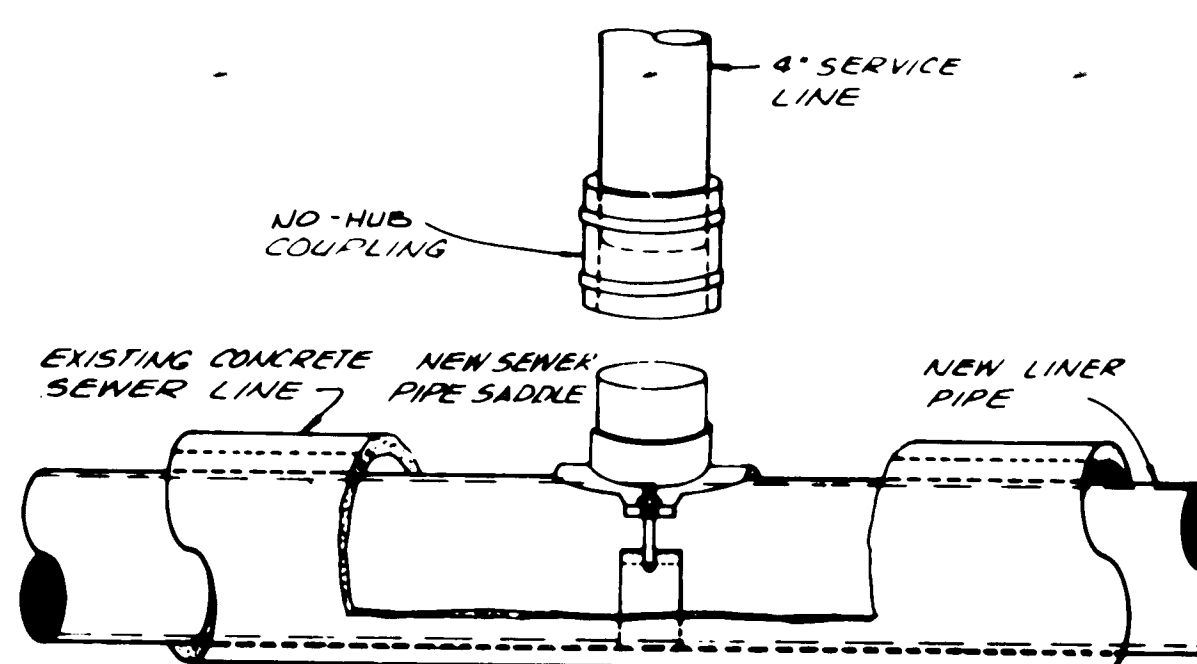


SERVICE RECONNECTION DETAIL
NO SCALE


- GENERAL NOTES**
1. INSERTION HOLES AT MANHOLES MUST BE CORE DRILLED.
 2. JOINTS AT MID-LINE INSERTION PITS SHALL BE MADE USING WRAP AROUND CLAMP COUPLINGS (SUPERIOR STYLE 121 OR CITY APPROVED EQUAL). ALL OTHER JOINTS SHALL BE MADE BY BUTT FUSION.
 3. AFTER PULLING THE LINER PIPE INTO PLACE, THE CONTRACTOR SHALL ALLOW AT LEAST 12 HOURS FOR PIPE CONTRACTION BEFORE TRIMMING PIPE ENDS AND SEALING THE ANNULAR SPACE AT MANHOLES.
 4. CITY APPROVED TAPPING SADDLES SUITABLE FOR USE ON POLYETHYLENE LINER PIPE, WITH STAINLESS STEEL STRAPS, SHALL BE USED TO RECONNECT SERVICE LINES TO STREET MAINS. SERVICE LINES SHALL BE REINSTALLED AS REQUIRED TO COMPLETE THE CONNECTION OF SERVICE LINES TO MAINS.
 5. SERVICE LINE ELBOW DEFLECTIONS SHALL BE A MAXIMUM OF 45° AS PER CITY OF ALBUQUERQUE STANDARD DRAWING 2134.

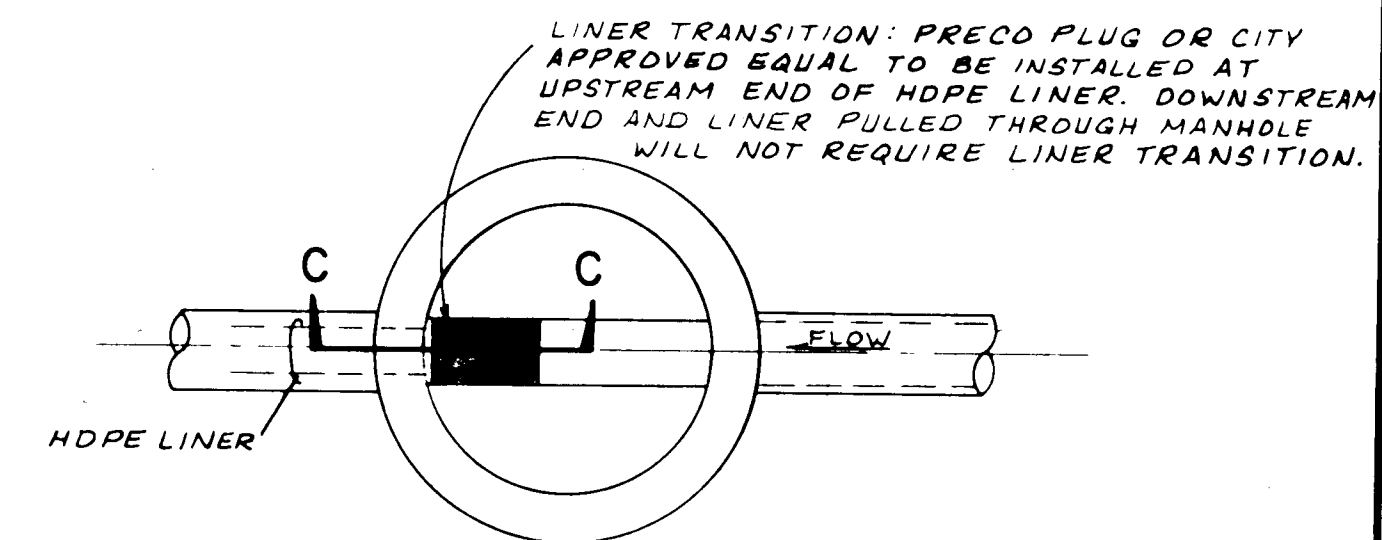

LINER TRANSITION DETAIL
NO SCALE

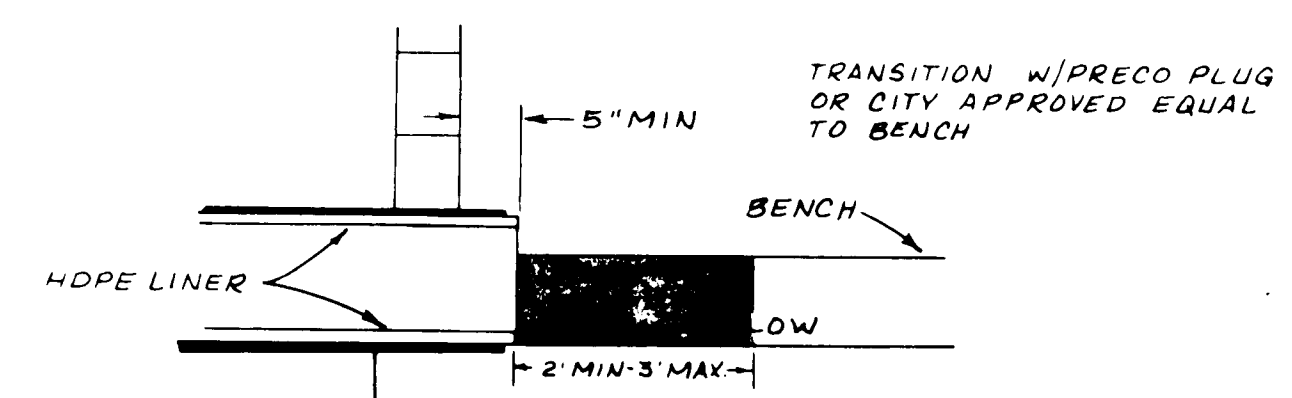

SECTION C-C

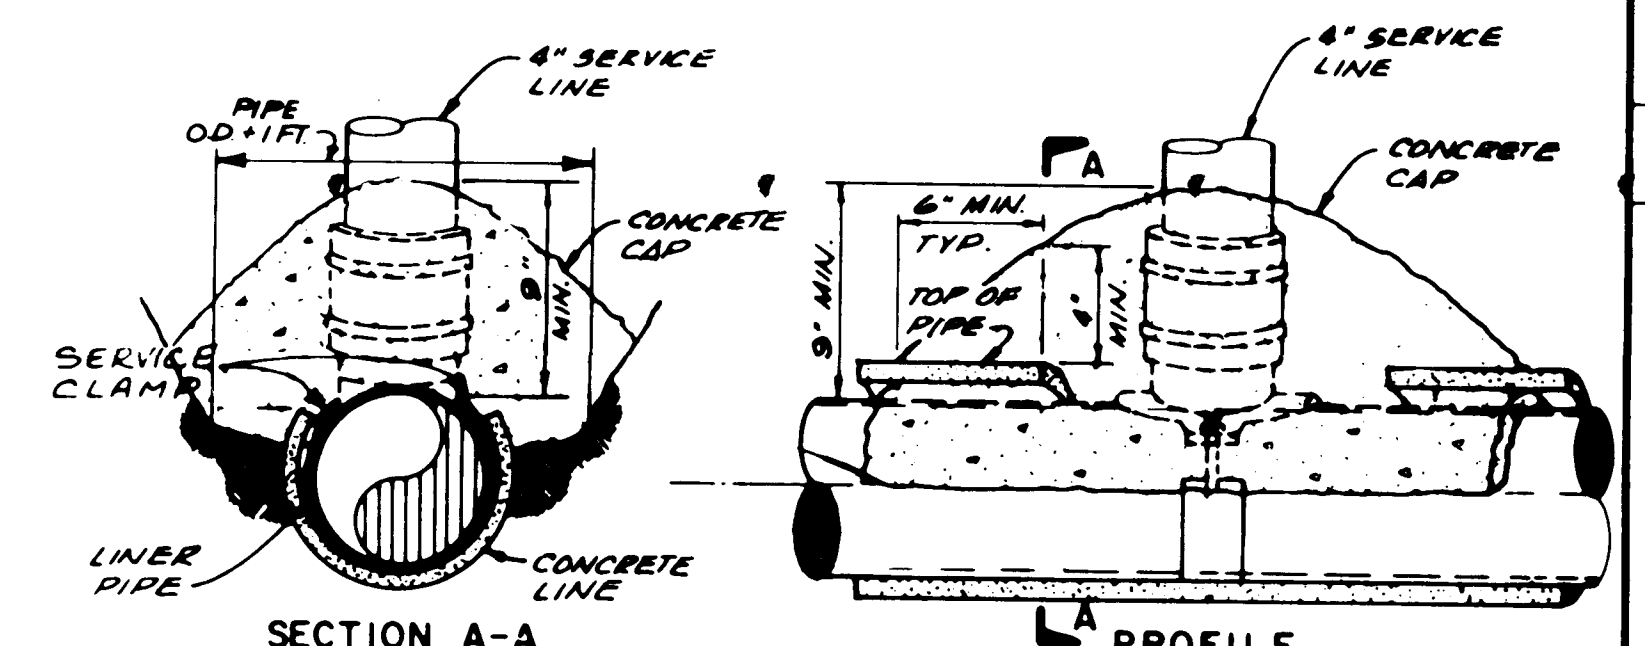

SECTION A-A SERVICE CONNECTION CONCRETE CAP
NO SCALE

1 2 3 4 5 6 7 8 9 10 11 12
26 35 68 04 90

CITY OF ALBUQUERQUE PUBLIC WORKS DEPARTMENT ENGINEERING DIVISION					
SIXTH STREET IMPROVEMENTS SLIPLINE DETAILS					
APPROVALS	ENGINEER	DATE	APPROVALS	ENGINEER	DATE
City Engineer	<i>Rogel Chen</i>	<i>4-27-07</i>	Liquid Waste	<i>Rogel Chen</i>	<i>4-27-07</i>
A.C.E. Design	"	"	Traffic	<i>Rogel Chen</i>	<i>4-27-07</i>
A.C.E. Hydrology	"	"	Water	<i>Rogel Chen</i>	<i>4-27-07</i>
DRAWING NO. 3068		MAP NO. <u> </u>		SHEET 4 OF 22	

RECORD DRAWING
Drawings revised to reflect the best information available. Do not use without field verification.

CONCRETE CURB & GUTTER
REMOVAL AND REPLACEMENT

LEFT

SIXTH STREET STATIONING	STANDARD C&G (FT)
STAS. 10+07 TO 10+19	12
STAS. 11+92 TO 12+28	36
STAS. 15+35 TO 15+77	42
STAS. 17+31 TO 17+41	20
STAS. 17+41 TO 17+53	12
STAS. 22+38 TO 22+42	16
STAS. 23+36 TO 24+11	75
STAS. 24+11 TO 24+20	25
STAS. 24+50 TO 24+60	20
STAS. 24+60 TO 24+83	23
STAS. 26+45 TO 27+18	73
STAS. 29+52 TO 29+64	12
STAS. 31+00 TO 31+36	36
STAS. 31+36 TO 31+48	20
STAS. 31+79 TO 31+91	20
STAS. 31+91 TO 32+50	59
STAS. 34+49 TO 34+89	40
STAS. 34+89 TO 35+01	20
STAS. 35+35 TO 35+48	20
STAS. 35+48 TO 38+49	301
STAS. 38+49 TO 38+63	23
STAS. 38+95 TO 39+08	22
STAS. 39+08 TO 39+77	69
STAS. 40+67 TO 40+73	6
STAS. 41+10 TO 42+10	100
STAS. 42+10 TO 42+22	30
STAS. 42+56 TO 42+68	23
STAS. 42+68 TO 45+76	308
STAS. 46+63 TO 47+89	126
STAS. 47+89 TO 47+94	9
STAS. 48+10 TO 48+15	9
STAS. 48+15 TO 49+53	138
STAS. 49+53 TO 49+65	22
STAS. 49+99 TO 50+12	22
STAS. 50+12 TO 51+50	138
STAS. 51+50 TO 51+55	9
STAS. 51+71 TO 51+76	15
STAS. 51+76 TO 53+14	138
STAS. 53+14 TO 53+27	22
STAS. 53+59 TO 53+73	23
STAS. 53+73 TO 55+10	137
STAS. 55+10 TO 55+15	15
STAS. 55+31 TO 55+36	15
STAS. 55+36 TO 56+67	131

Left Side Total = 2,408 LF

CONCRETE CURB & GUTTER
REMOVAL AND REPLACEMENT

RIGHT

SIXTH STREET STATIONING	STANDARD C&G (FT)
STAS. 9+28 TO 9+43	25
STAS. 9+76 TO 9+88	20
STAS. 9+88 TO 10+11	23
STAS. 17+31 TO 17+41	17
STAS. 17+41 TO 19+10	169
STAS. 23+39 TO 24+11	72
STAS. 24+11 TO 24+19	22
STAS. 24+51 TO 24+71	32
STAS. 24+71 TO 24+83	12
STAS. 26+74 TO 27+34	57
STAS. 30+63 TO 31+68	105
STAS. 31+84 TO 31+89	17
STAS. 31+89 TO 32+51	62
STAS. 33+53 TO 34+89	136
STAS. 34+89 TO 35+01	23
STAS. 35+35 TO 35+60	39
STAS. 35+60 TO 38+49	289
STAS. 38+49 TO 38+62	23
STAS. 38+95 TO 39+09	24
STAS. 39+09 TO 39+21	12
STAS. 40+26 TO 42+10	184
STAS. 42+10 TO 42+22	23
STAS. 42+56 TO 42+68	24
STAS. 42+68 TO 45+05	237
STAS. 46+29 TO 46+41	16
STAS. 46+41 TO 47+94	153
STAS. 47+94 TO 47+99	9
STAS. 48+15 TO 48+20	9
STAS. 48+20 TO 49+54	134
STAS. 49+54 TO 49+65	22
STAS. 50+11 TO 53+22	311
STAS. 53+22 TO 53+34	23
STAS. 54+55 TO 55+56	101
STAS. 56+00 TO 56+60	60

Right Side Total = 2,485 LF

GRAND TOTAL = 4,893 LF

REMOVAL AND DISPOSAL
OF EXISTING
4" CONCRETE SIDEWALK

RIGHT

6TH STREET STATIONING	DIMENSIONS	SY
STAS. 30+92 TO 30+95	3 X 6	2.0
STAS. 31+39 TO 31+42	3 X 6	2.0
STAS. 32+25 TO 32+28	3 X 6	2.0
STAS. 34+56 TO 34+59	3 X 6	2.0
STAS. 36+25 TO 36+30	5 X 6	3.3
STAS. 38+26 TO 38+29	3 X 6.3	2.1
STAS. 39+89 TO 39+93	4 X 6.5	2.9
STAS. 40+25 TO 40+28	3 X 6.5	2.2
STAS. 40+78 TO 40+81	3 X 6.5	2.2
STAS. 42+99 TO 43+02	3 X 6.4	2.1
STAS. 43+83 TO 43+86	3 X 6.4	2.1
STAS. 48+27 TO 48+30	3 X 6.5	2.2
STAS. 48+53 TO 48+56	3 X 6.5	2.2
STAS. 48+87 TO 48+90	3 X 6.4	2.1
STAS. 52+84 TO 53+09	6 X 2.5	1.7
STAS. 56+23 TO 56+29	6 X 6.5	2.2

Right Side Total = 35.3 SY

REMOVAL AND DISPOSAL
OF EXISTING
4" CONCRETE SIDEWALK

LEFT

6TH STREET STATIONING	DIMENSIONS	SY
STAS. 12+63 TO 12+68	8 X 5	4.4
STAS. 23+27 TO 23+30	3 X 6.5	2.2
STAS. 24+87 TO 24+89	2 X 6	1.3
STAS. 25+35 TO 25+38	3 X 6	2.0
STAS. 26+29 TO 26+32	4 X 6	2.7
STAS. 26+88 TO 26+91	3 X 6	2.0
STAS. 30+98 TO 31+02	4 X 6	2.7
STAS. 33+02 TO 33+05	3 X 6	2.0
STAS. 33+56 TO 33+59	3 X 6	2.0
STAS. 34+04 TO 34+07	3 X 6	2.0
STAS. 34+70 TO 34+73	3 X 6	2.0
STAS. 37+16 TO 37+19	3 X 6.5	2.2
STAS. 37+67 TO 37+71	4 X 6.5	2.9
STAS. 38+17 TO 38+21	4 X 6.5	2.9
STAS. 39+87 TO 39+90	3 X 6.5	2.2
STAS. 41+25 TO 41+28	3 X 6.5	2.2
STAS. 41+58 TO 41+61	3 X 6.5	2.2
STAS. 41+89 TO 41+92	3 X 6.5	2.2
STAS. 46+83 TO 46+84	1 X 6.5	0.7
STAS. 47+68 TO 47+71	3 X 6.5	2.2
STAS. 50+30 TO 50+34	4 X 6.5	2.9
STAS. 50+92 TO 50+95	3 X 6.5	2.2
STAS. 54+02 TO 54+05	3 X 6.5	2.2
STAS. 54+74 TO 54+78	4 X 6.5	2.9
STAS. 55+50 TO 55+53	3 X 6.5	2.2

Left Side Total = 57.4 SY

Grand Total = 92.7 SY

4" CONCRETE SIDEWALK
(WHEEL CHAIR RAMPS)

SIXTH STREET STATIONING	LOCATION	REMOVAL (SY)	REPLACEMENT (SF)
MCKNIGHT	NW	0	176.7
MCKNIGHT	SW	0	113.1
HAINES	SW	8.7	78.5
HAINES	SE	8.7	78.5
ASPEN	NE	12.6	113.1
ASPEN	NW	12.6	113.1
ASPEN	SE	12.6	113.1
ASPEN	SW	0	314.2
CONSTITUTION	NE	12.6	113.1
CONSTITUTION	SE	12.6	113.1
KINLEY	NE	12.6	113.1
KINLEY	NW	14.7	132.7
KINLEY	SE	12.6	113.1
KINLEY	SW	14.7	490.9
SUMMER	NE	17.1	153.9
SUMMER	NW	14.7	132.7
SUMMER	SE	14.7	132.7
SUMMER	SW	17.1	153.9
ROSEMONT	NE	14.7	132.7
ROSEMONT	NW	14.7	132.7
ROSEMONT	SW	17.1	153.9
ROSEMONT	NE	14.7	132.7
GRANITE	NW	12.6	113.1
GRANITE	SE	14.7	132.7
GRANITE	SW	12.6	113.1
MARBLE	NE	14.7	132.7
MARBLE	NW	14.7	132.7
MARBLE	SE	17.1	153.9
MARBLE	SW	17.1	153.9

Total = 363.3 SY 4,056.9 SF

REPLACEMENT
OF EXISTING
4" CONCRETE SIDEWALK

RIGHT

6TH STREET STATIONING	DIMENSIONS	SF
STAS. 30+92 TO 30+95	3 X 6	18.0
STAS. 31+39 TO 31+42	3 X 6	18.0
STAS. 32+25 TO 32+28	3 X 6	18.0
STAS. 34+56 TO 34+59	3 X 6	18.0
STAS. 36+25 TO 36+30	5 X 6	30.0
STAS. 38+26 TO 38+29	3 X 6.3	18.9
STAS. 39+89 TO 39+93	4 X 6.5	26.0
STAS. 40+25 TO 40+28	3 X 6.5	19.5
STAS. 40+78 TO 40+81	3 X 6.5	19.5
STAS. 42+99 TO 43+02	3 X 6.4	19.2
STAS. 43+83 TO 43+86	3 X 6.4	19.2
STAS. 48+27 TO 48+30	3 X 6.5	19.5
STAS. 48+53 TO 48+56	3 X 6.5	19.5
STAS. 48+87 TO 48+90	3 X 6.4	19.2
STAS. 52+84 TO 53+09	6 X 2.5	15.0
STAS. 56+23 TO 56+29	6 X 6.5	19.5

Right Side Total = 317.0 SF

REPLACEMENT
OF EXISTING
4" CONCRETE SIDEWALK

LEFT

6TH STREET STATIONING	DIMENSIONS	SF
STAS. 12+63 TO 12+68	8 X 5	40.0
STAS. 23+27 TO 23+30	3 X 6.5	19.5
STAS. 24+87 TO 24+89	2 X 6	12.0
STAS. 25+35 TO 25+38	3 X 6	18.0
STAS. 26+29 TO 26+32	4 X 6	24.0
STAS. 26+88 TO 26+91	3 X 6	18.0
STAS. 30+98 TO 31+02	4 X 6	24.0
STAS. 33+02 TO 33+05	3 X 6	18.0
STAS. 33+56 TO 33+59	3 X 6	18.0
STAS. 34+04 TO 34+07	3 X 6	18.0
STAS. 34+70 TO 34+73	3 X 6	18.0
STAS. 37+16 TO 37+19	3 X 6.5	19.5
STAS. 37+67 TO 37+71	4 X 6.5	26.0
STAS. 38+17 TO 38+21	4 X 6.5	26.0
STAS. 39+87 TO 39+90	3 X 6.5	19.5
STAS. 41+25 TO 41+28	3 X 6.5	19.5
STAS. 41+58 TO 41+61	3 X 6.5	19.5
STAS. 41+89 TO 41+92	3 X 6.5	19.5
STAS. 46+83 TO 46+84	1 X 6.5	6.5
STAS. 47+68 TO 47+71	3 X 6.5	19.5
STAS. 50+30 TO 50+34	4 X 6.5	26.0
STAS. 50+92 TO 50+95	3 X 6.5	19.5
STAS. 54+02 TO 54+05	3 X 6.5	19.5
STAS. 54+74 TO 54+78	4 X 6.5	26.0
STAS. 55+50 TO 55+53	3 X 6.5	19.5

Left Side Total = 513.5 SF

Grand Total = 830.5 SF

6" CONCRETE DRIVEPAD
REMOVAL AND REPLACEMENT

SIXTH STREET STATIONING	LENGTH X WIDTH	AREA (SY)
STAS. 15+35 TO 15+77	LT 42 X 5.0	23.3
STAS. 17+70 TO 18+30	RT 60 X 8.5	56.7
STAS. 23+40 TO 23+78	LT 38 X 6.2	26.2
STAS. 26+86 TO 26+96	RT 10 X 7.6	8.4
STAS. 26+98 TO 27+10	LT 12 X 6.4	8.5
STAS. 27+16 TO 27+30	RT 14 X 6.0	9.3
STAS. 31+02 TO 31+30	RT 28 X 12.2	38.0
STAS. 31+91 TO 32+03	RT 12 X 6.0	8.0
STAS. 33+77 TO 34+00	RT 23 X 6.5	16.6
STAS. 35+85 TO 35+98	LT 13 X 6.0	8.7
STAS. 36+30 TO 36+47	LT 17 X 6.5	12.3
STAS. 36+35 TO 36+61	RT 26 X 6.2	17.9
STAS. 36+86 TO 36+98	LT 12 X 6.5	8.7
STAS. 37+34 TO 37+46	LT 11 X 6.5	7.9
STAS. 37+89 TO 38+00	LT 14 X 6.3	9.8
STAS. 37+98 TO 38+12	RT 14 X 6.3	9.8
STAS. 40+40 TO 40+56	RT 16 X 6.5	11.6
STAS. 40+96 TO 41+08	RT 12 X 6.5	8.7
STAS. 41+22 TO 41+37	RT 15 X 6.5	10.8
STAS. 41+32 TO 41+48	LT 16 X 6.5	11.6
STAS. 41+58 TO 41+71	RT 13 X 6.5	9.4
STAS. 42+84 TO 42+97	RT 13 X 6.4	9.2
STAS. 44+19 TO 44+31	RT 12 X 6.4	8.5
STAS. 44+67 TO 44+78	RT 11 X 6.4	7.8
STAS. 46+44 TO 46+67	RT 23 X 6.4	16.4
STAS. 46+80 TO 46+93	RT 13 X 6.4	9.2
STAS. 46+96 TO 47+08	LT 12 X 6.5	8.7
STAS. 47+27 TO 47+52	RT 25 X 6.5	18.1
STAS. 47+35 TO 47+55	LT 20 X 6.5	14.4
STAS. 48+56 TO 48+66	LT 10 X 6.5	7.2
STAS. 50+63 TO 50+75	LT 12 X 6.5	8.7
STAS. 50+98 TO 51+10	RT 12 X 6.5	8.7
STAS. 51+55 TO 51+77	RT 22 X 6.5	15.9
STAS. 51+75 TO 51+86	LT 11 X 6.5	7.9
STAS. 51+78 TO 51+98	RT 20 X 6.5	14.4
STAS. 52+07 TO 52+33	RT 26 X 6.5	18.8
STAS. 52+21 TO 51+35	LT 14 X 6.5	10.1
STAS. 52+49 TO 52+61	RT 12 X 6.5	8.7
STAS. 54+25 TO 54+48	LT 23 X 6.5	16.6
STAS. 54+63 TO 54+94	RT 31 X 6.4	22.0
STAS. 55+04 TO 55+15	LT 11 X 6.5	7.9
STAS. 55+82 TO 56+06	LT 24 X 6.5	17.3
STAS. 55+82 TO 56+06	LT 24 X 6.5	17.3

TOTAL = 577.6 SY

WATER VALVE
COVER ADJUSTMENT

SIXTH STREET STATIONING	WATER VALVE COVER ADJUSTMENT (EA)
STAS. 16+96 RT	1
STAS. 16+99 RT	1
STAS. 24+11 RT	1
STAS. 28+53 RT	1
STAS. 28+58 LT	1
STAS. 29+23 RT	1
STAS. 34+88 RT	1
STAS. 35+09 LT	1
STAS. 39+09 RT	1
STAS. 45+09 RT	1
STAS. 46+08 RT	1
STAS. 53+83 RT	1
STAS. 59+70 RT	1
STAS. 59+96 RT	1

Total = 14

WATER METER
PAD ADJUSTMENT

SIXTH STREET STATIONING	WATER METER PAD ADJUSTMENT (EA)
STAS. 18+86 RT	1
STAS. 26+50 LT	1
STAS. 26+76 RT	1
STAS. 26+93 LT	1
STAS. 27+15 RT	1
STAS. 30+73 RT	1
STAS. 31+25 RT	1
STAS. 31+25 LT	1
STAS. 32+41 RT	1
STAS. 33+58 RT	1
STAS. 34+14 RT	1
STAS. 34+58 LT	1
STAS. 34+63 RT	1
STAS. 35+82 LT	1
STAS. 35+87 RT	1
STAS. 36+23 RT	1
STAS. 36+23 LT	1
STAS. 36+62 LT	1
STAS. 36+72 RT	1
STAS. 37+23 LT	1
STAS. 37+28 RT	1
STAS. 37+70 LT	1
STAS. 37+74 RT	1
STAS. 38+10 LT	1
STAS. 38+22 RT	1
STAS. 39+16 RT	1
STAS. 39+57 LT	1
STAS. 39+77 LT	1
STAS. 40+39 RT	1
STAS. 40+84 RT	1
STAS. 41+19 RT	1
STAS. 41+19 LT	1
STAS. 41+43 RT	1
STAS. 41+50 LT	1
STAS. 41+85 LT	1
STAS. 42+05 RT	1
STAS. 43+08 RT	1
STAS. 43+67 RT	1
STAS. 44+43 LT	1
STAS. 44+50 RT	1
STAS. 45+06 LT	1
STAS. 46+61 RT	1
STAS. 46+74 LT	1
STAS. 46+98 RT	1
STAS. 47+23 LT	1
STAS. 47+58 RT	1
STAS. 47+78 LT	1
STAS. 48+46 RT	1
STAS. 48+98 LT	1
STAS. 48+99 RT	1
STAS. 50+29 LT	1
STAS. 50+77 LT	1
STAS. 51+46 RT	1
STAS. 51+49 LT	1
STAS. 51+98 LT	1
STAS. 54+86 LT	1
STAS. 55+56 LT	1

STATION 10+00 TO STATION 53+79
TYPICAL SIXTH STREET NEW PAVEMENT SECTION

NOT TO SCALE

VARIES 28'± TO 44± SEE PLAN AND PROFILE SHEETS
REMOVE EXISTING PAVEMENT SECTION AND REPLACE WITH NEW PAVEMENT

4" WIDE BROKEN WHITE LANE DIVIDER.
10' STRIPE — 30' GAP. TO BE CENTERED
LIP TO LIP UNLESS OTHERWISE DIRECTED
BY PROJECT ENGINEER. TYPICAL B.O.P. TO E.O.P.
(SEE INTERSECTION DETAILS SHEET 12 OF 22)

— FOR NEW & FINISHED PAVEMENT
ELEVATIONS, SEE & PROFILE PLAN
AND PROFILE SHEETS

SLOPE VARIES

SLOPE VARIES

— EXISTING
CURB &
GUTTER

- 5/8" PLANT MIX SEAL COAT
- 2" ASPHALT CONCRETE SURFACE COURSE,
GRADATION TYPE "B", 1800 LB. STABILITY
- 5" ASPHALT CONCRETE, BASE COURSE,
GRADATION TYPE "A", 1500 LB. STABILITY;
TWO 2 1/2" LIFTS
- 4" GRAVEL BASE COURSE, CLASS II
- 6" COMPACTED SUBGRADE

CONSTRUCTION NOTES


1. EMULSIFIED ASPHALT TACK COAT BETWEEN LIFTS OF ASPHALT CONCRETE PAVEMENT SHALL BE APPLIED AS DIRECTED BY THE ENGINEER IN ACCORDANCE WITH SECTION 336.4 OF THE SPECIFICATIONS.
2. TACK COAT SHALL BE APPLIED TO ALL CONCRETE SURFACES AND EXISTING PAVEMENT ABUTTING NEW PAVEMENT. NOT A DIRECT PAY ITEM. CONSIDERED INCIDENTAL TO THE CONSTRUCTION OF NEW PAVEMENT SECTION.
3. IF TRAFFIC IS TO BE ALLOWED ON UNCOMPLETED PAVEMENT REPLACEMENT, TEMPORARY 12:1 LONGITUDINAL AND 20:1 TRANSVERSE ASPHALT TAPERS WILL BE INSTALLED.
4. SEE SHEET 4 FOR SCHEDULE OF CURB AND GUTTER, SIDEWALK AND DRIVEPAD REMOVAL AND REPLACEMENT.
5. IF CURB AND GUTTER REMOVAL AND REPLACEMENT IS NOT PERFORMED CONCURRENTLY WITH ROADWAY REMOVAL AND REPLACEMENT; ONE FOOT OF EXISTING PAVEMENT SHALL BE REMOVED TO PROVIDE FORMING ROOM.

AS BUILT INFORMATION	
CONTRACT NO.	RUSS PITNEY
OWNER	CITY OF ALBUQUERQUE
DESIGNED BY	ALBUQUERQUE
DATE	DATE
DESIGNED BY	DATE
CHECKED BY	DATE
CORRECTED BY	GANNETT FLEMING DATE
MICRO-FILM INFORMATION	
RECORDED BY	DATE
NO	

BENCH MARKS

SURVEY INFORMATION

ENGINEER'S SEAL

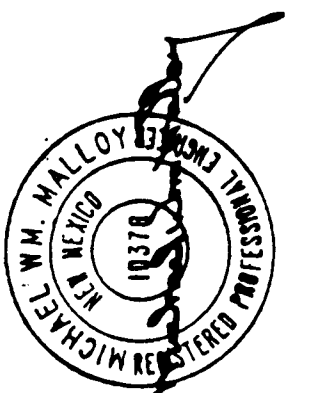

BY

REMARKS
/SIONS

NO.	DATE
-----	------

100

NEER

12

OF

' DETAIL '

CURB AND GUTTER REPLACEMENT

(NOT CONCURRENT WITH PAVEMENT REPLACEMENT)

NOT TO SCALE

COMPACTED
3GRADE

DETAIL

GUTTER AT DRIVEPAD REPLACEMENT

(NOT CONCURRENT WITH PAVEMENT REPLACEMENT)

NOT TO SCALE

DETAIL * TYPICAL FOR BOTH
OF RAILROAD CROS

PAVEMENT JOINT AT RAILROAD SPUR

* TYPICAL FOR BOTH SIDES
OF RAILROAD CROSSING

1	2	3	4	5	6	7	8	9	10	11	12
2	6		3	5	6	8	0	6	9	0	

RECORD DRAWING
Drawings revised to reflect the
best information available. Do
not use without field verification

CITY OF ALBUQUERQUE
PUBLIC WORKS DEPARTMENT

TITLE: **SIXTH STREET IMPROVEMENTS**
TYPICAL SECTION - DETAILS

APPROVALS	ENGINEER	DATE	APPROVALS	ENGINEER	DATE
City Engineer	<i>Roger L. Lee</i>	4-27-89	Liquid Waste	<i>REGO</i>	4/27/89
ACE Design	ll	4	Traffic	<i>Roger L. Lee</i>	4-27-89
ACE Hydrology	ll	4	Water	<i>REGO</i>	4/27/89

DRAWING NO.	3568	MAP NO.	SHEET 6 OF 22
-------------	------	---------	---------------





PLAN

SCALE: 1"=20'

PROFILE

SCALE: 1"=20' Horiz.
1"=5' Vert.

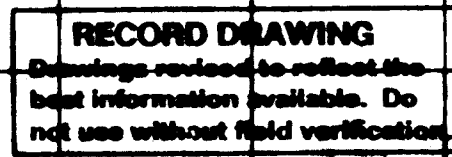

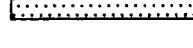	NEW CONSTRUCTION THIS CHANGE ORDER
-----	EXISTING C & G
 SD	EXISTING STORM DRAIN MANHOLE
 MH	EXISTING SANITARY SEWER MANHOLE
 WM	EXISTING WATER METER
 GV	EXISTING GAS VALVE
 GM	EXISTING GAS METER
 PP	POWER POLE
61.37	PROPOSED ELEVATION






AS BUILT INFORMATION	
CONTRACTOR	RUSS PITNEY
DATE	
WORK	
STAINED BY	CITY OF ALBUQUERQUE
DATE	
INSPECTOR'S	
ACCEPTANCE BY	
DATE	
*DATE	
VERIFICATION BY	
DATE	
REMARKS	
CORRECTED BY	GANNETT FLEMING
DATE	
MICRO-FILM INFORMATION	
RECORDED BY	
DATE	
NO.	

[illegible][illegible][illegible]

TITLE: **SIXTH STREET IMPROVEMENTS
R.R. CROSSING - CHANGE ORDER**


APPROVALS	ENGINEER	DATE	APPROVALS	ENGINEER	DATE
City Engineer			Liquid Waste		
A.C.E.—Design			Traffic		
A.C.E.—Hydrology			Water		

DRAWING NO.	MAP NO.	SHEET OF
3568	J-14	Δ 7A 22

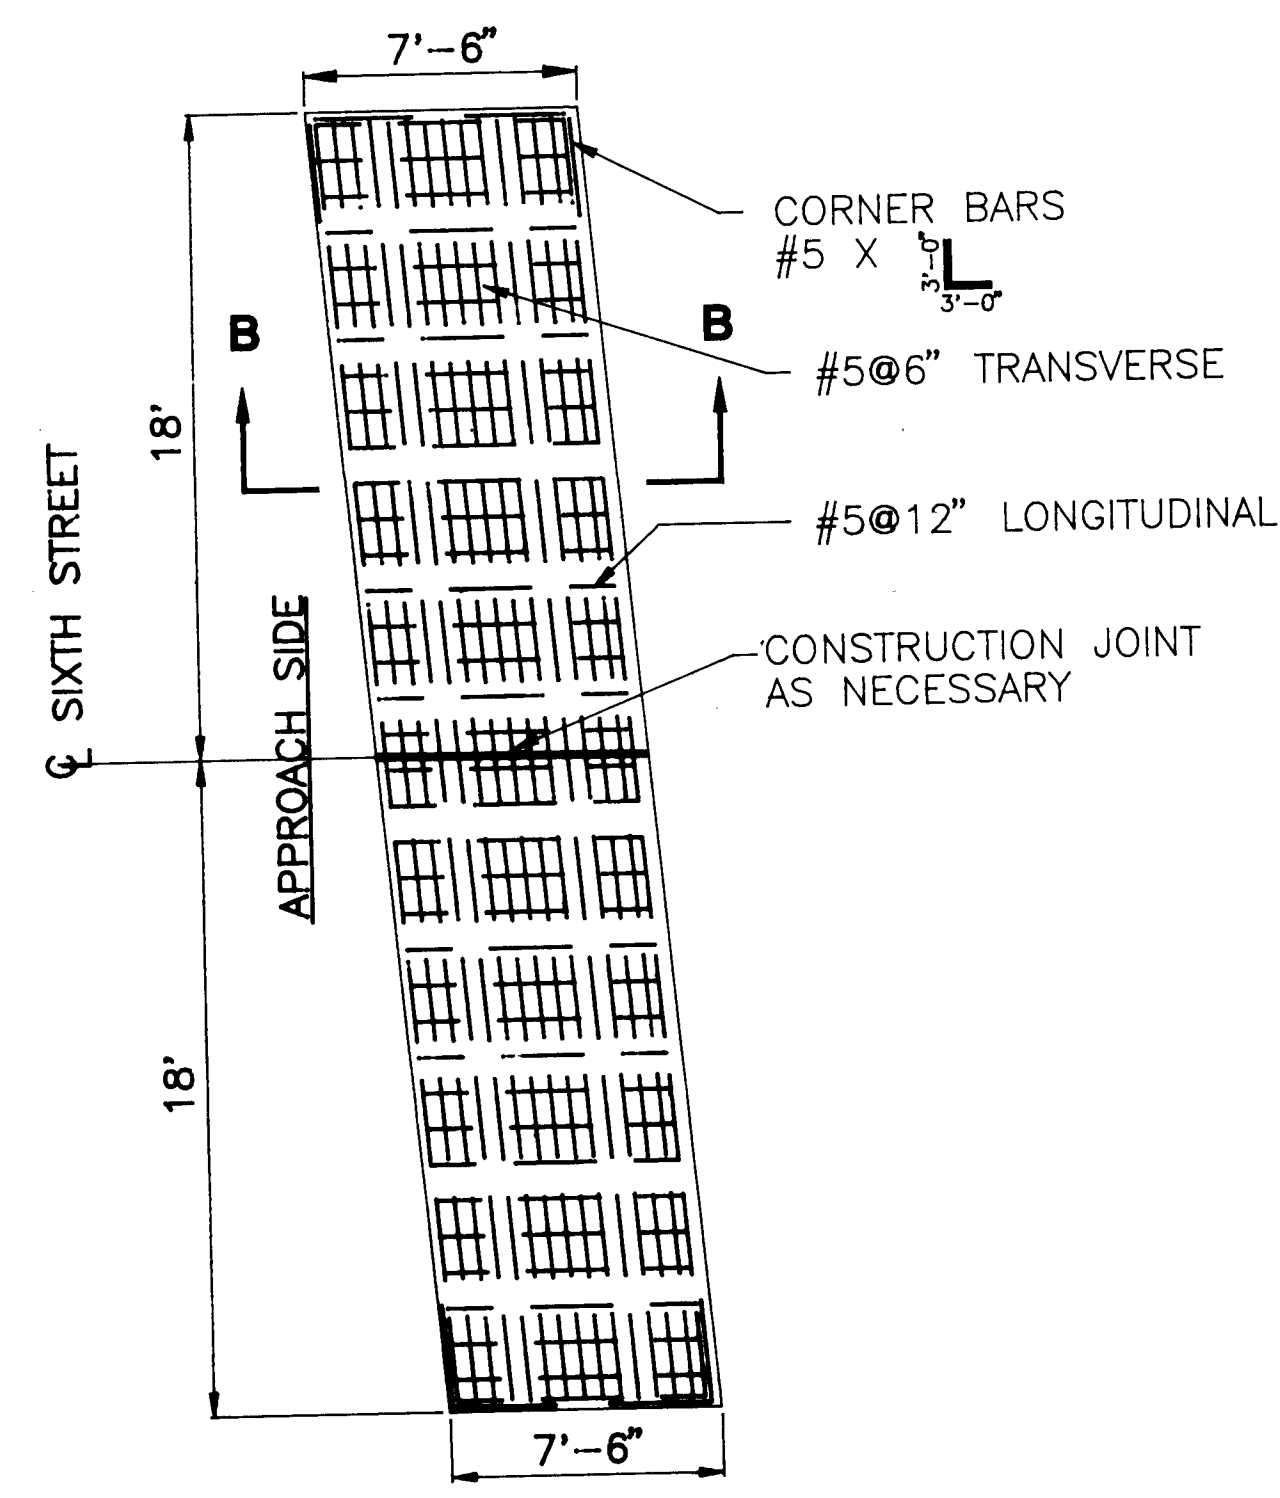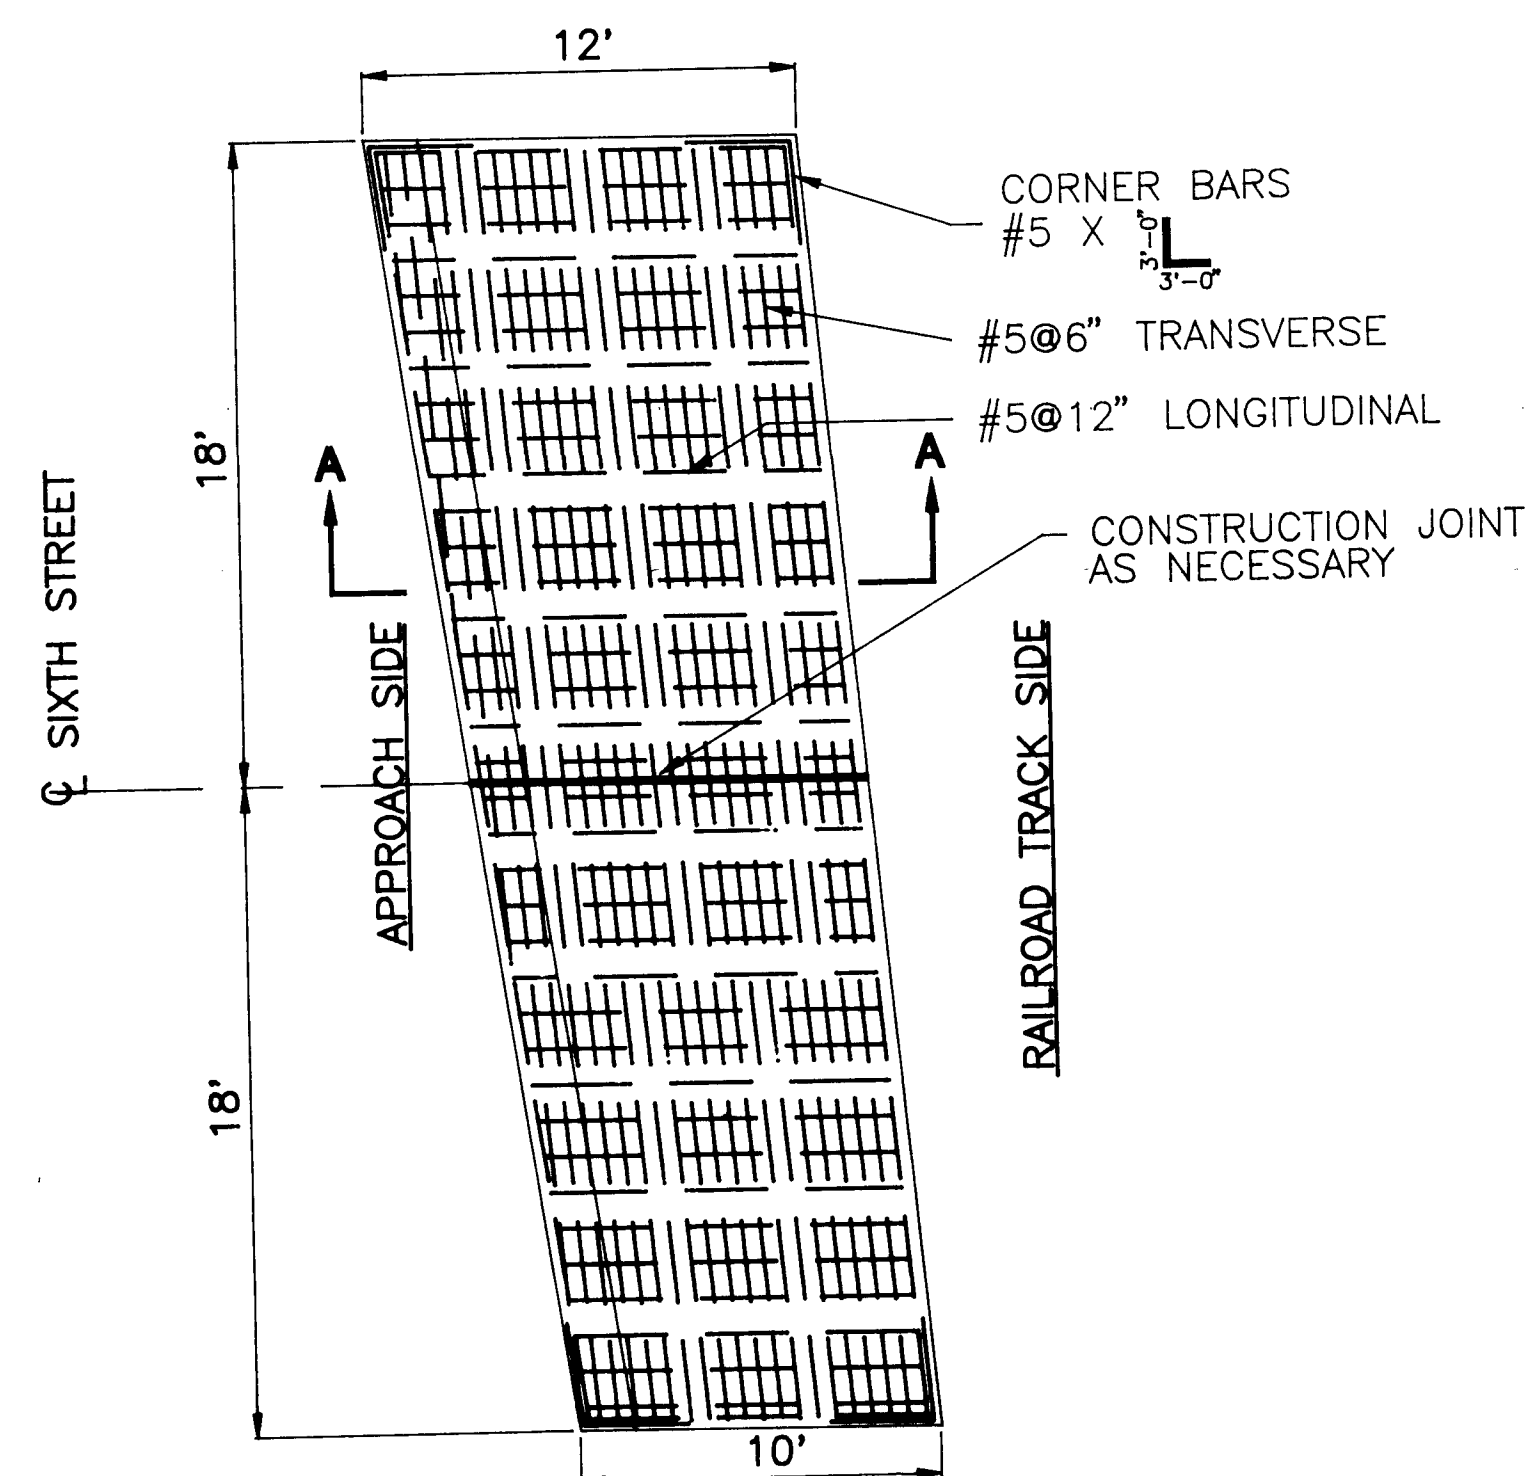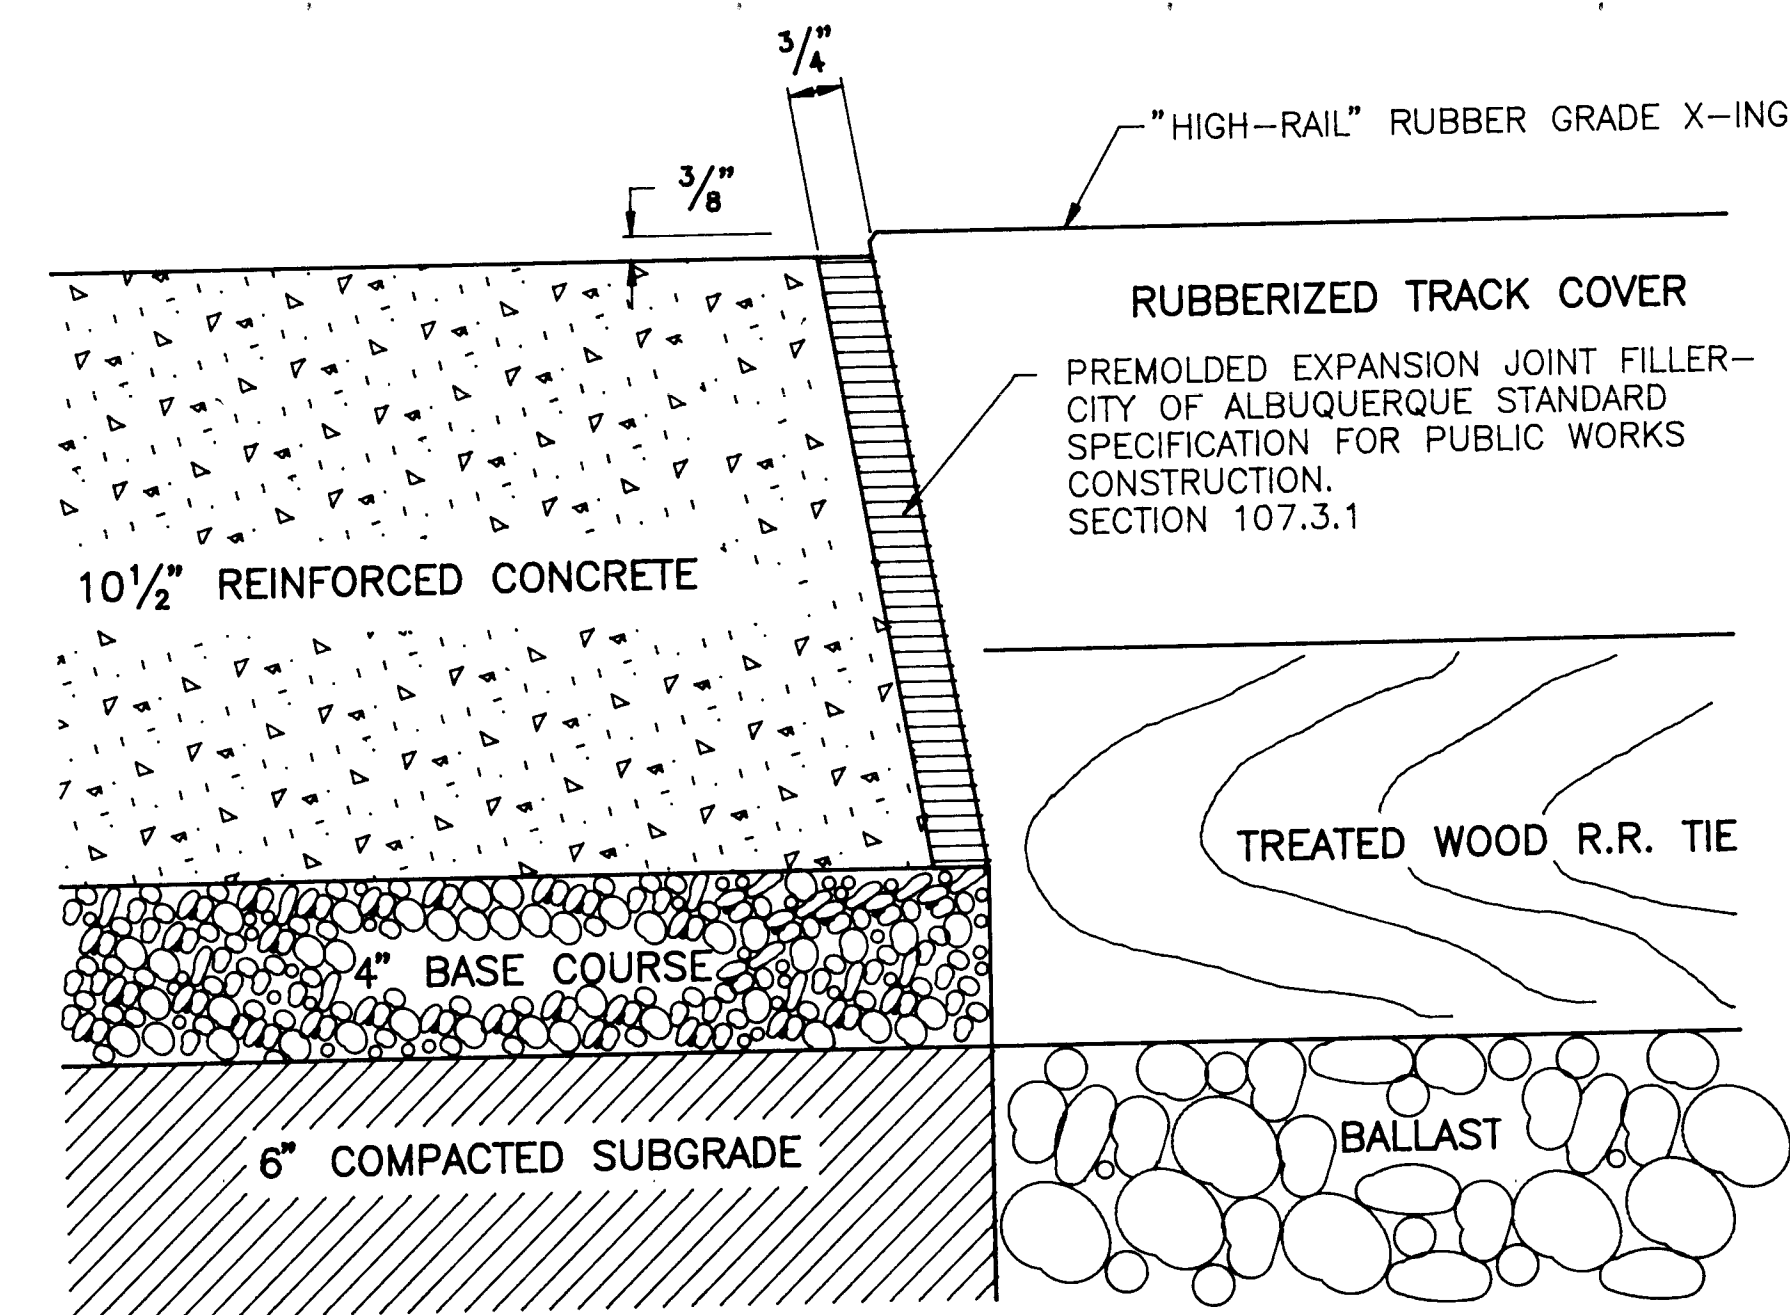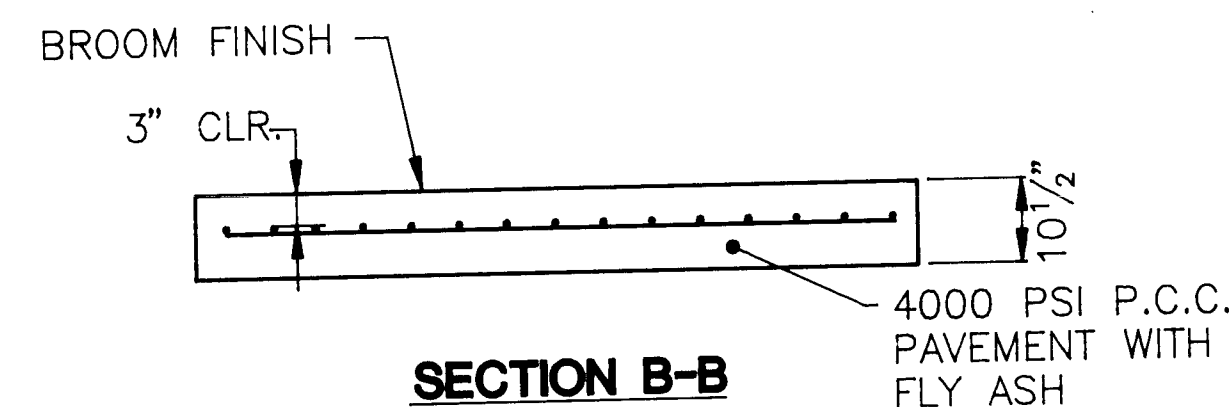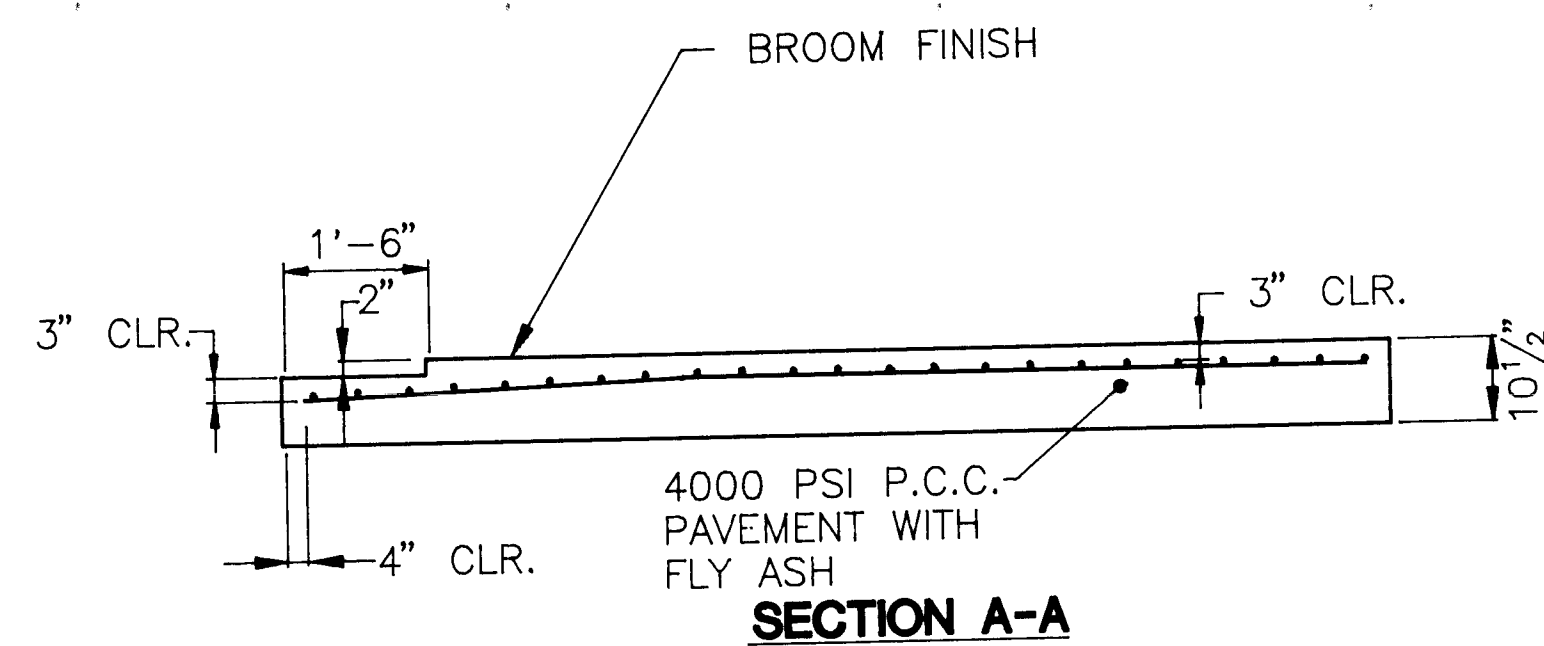

TYPICAL CONCRETE APPROACH SLAB

TYPICAL CONCRETE CENTER SLAB

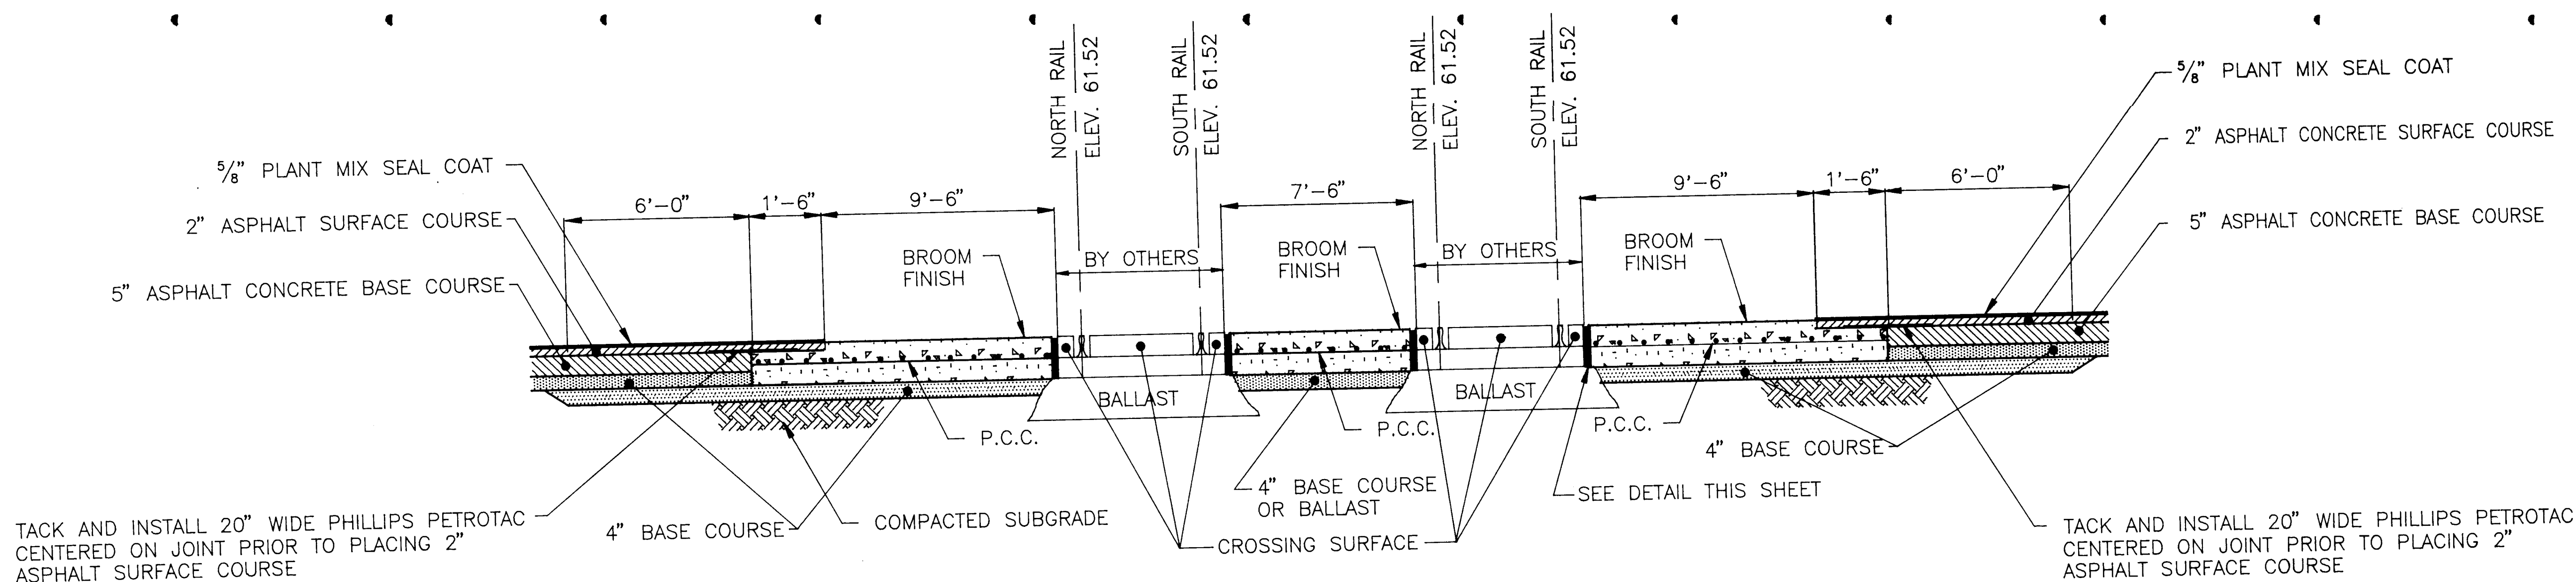

1 2 3 4 5 6 7 8 9 10 11 12
26 35 68 07 90 08

CITY OF ALBUQUERQUE PUBLIC WORKS DEPARTMENT					
TITLE: SIXTH STREET IMPROVEMENTS RR CROSSING - CHANGE ORDER					
APPROVALS	ENGINEER	DATE	APPROVALS	ENGINEER	DATE
City Engineer			Liquid Waste		
A.C.E.-Design			Traffic		
A.C.E.-Hydrology			Water		
DRAWING NO. 3568		MAP NO. J-14		SHEET OF 22	

RECORD DRAWING
Drawings revised to reflect the
best information available. Do
not use without field verification.

12'-N.E. RADIUS KINLEY		
PTCR	E	T.C.
1	56.57	57.24
2	56.54	57.21
3	56.52	56.56
3	56.50	57.17
PCCR	56.47	57.14

12'-S.E. RADIUS KINLEY		
PTCR	E	T.C.
1	56.78	57.45
2	56.80	57.47
3	56.81	56.85
3	56.83	57.50
PCCR	56.85	57.52

14'-N.E. RADIUS SUMMER		
PTCR	E	T.C.
1	56.39	57.06
2	56.35	57.02
3	56.31	56.35
3	56.28	56.95
PCCR	56.25	56.92

13'-S.E. RADIUS SUMMER		
PTCR	E	T.C.
1	56.23	56.90
2	56.25	56.92
3	56.27	56.31
3	56.30	56.97
PCCR	56.33	57.00

13'-N.E. RADIUS ROSEMONT		
PTCR	E	T.C.
1	56.61	57.28
2	56.65	57.32
3	56.70	56.74
3	56.75	57.42
PCCR	56.80	57.47

14'-S.E. RADIUS ROSEMONT		
PTCR	E	T.C.
1	56.70	57.37
2	56.68	57.35
3	56.67	56.71
3	56.65	57.32
PCCR	56.63	57.30

13'-N.W. RADIUS KINLEY		
PCCR	E	T.C.
1	56.50	57.17
2	56.53	57.20
2	56.55	56.59
3	56.58	57.25
PTCR	56.61	57.28

12'-S.W. RADIUS KINLEY		
PCCR	E	T.C.
1	57.00	57.67
2	56.95	57.62
2	56.90	56.94
3	56.84	57.51
PTCR	56.76	57.43

13'-N.W. RADIUS SUMMER		
PCCR	E	T.C.
1	56.25	56.92
2	56.29	56.96
2	56.32	56.36
3	56.36	57.03
PTCR	56.40	57.07

14'-S.W. RADIUS SUMMER		
PCCR	E	T.C.
1	56.40	57.07
2	56.36	57.05
2	56.32	56.36
3	56.29	56.96
PTCR	56.25	56.92

13'-N.W. RADIUS ROSEMONT		
PCCR	E	T.C.
1	56.86	57.53
2	56.82	57.49
2	56.78	56.82
3	56.74	57.41
PTCR	56.70	57.37

14'-S.W. RADIUS ROSEMONT		
PCCR	E	T.C.
1	56.70	57.37
2	56.74	57.41
2	56.77	56.81
3	56.81	57.48
PTCR	56.85	57.52

SIXTH STREET NW

PLAN

SCALE: 1"=50'


PROFILE

SCALE: 1"=50' Horiz.
1"=5' Vert.

STA. 38 + 60 - INSTALL 6" PVC CONDUIT
SEE NOTE ON SHEET 15 OF 22

NOTES:

- STREET WIDTHS ARE SHOWN LIP TO LIP OF GUTTER.
- THE REMOVAL, STORAGE AND REPLACEMENT OF LANDSCAPE/SOD, DECORATOR LANDSCAPE, PATIO BLOCK OR BRICK NECESSARY FOR THE INSTALLATION OF CURB AND GUTTER WILL NOT BE CONSIDERED AS A SEPARATE BID ITEM FOR PAYMENT, BUT WILL BE CONSIDERED AS INCIDENTAL TO THE CONTRACT ITEM OF P.C.C. STANDARD CURB AND GUTTER.

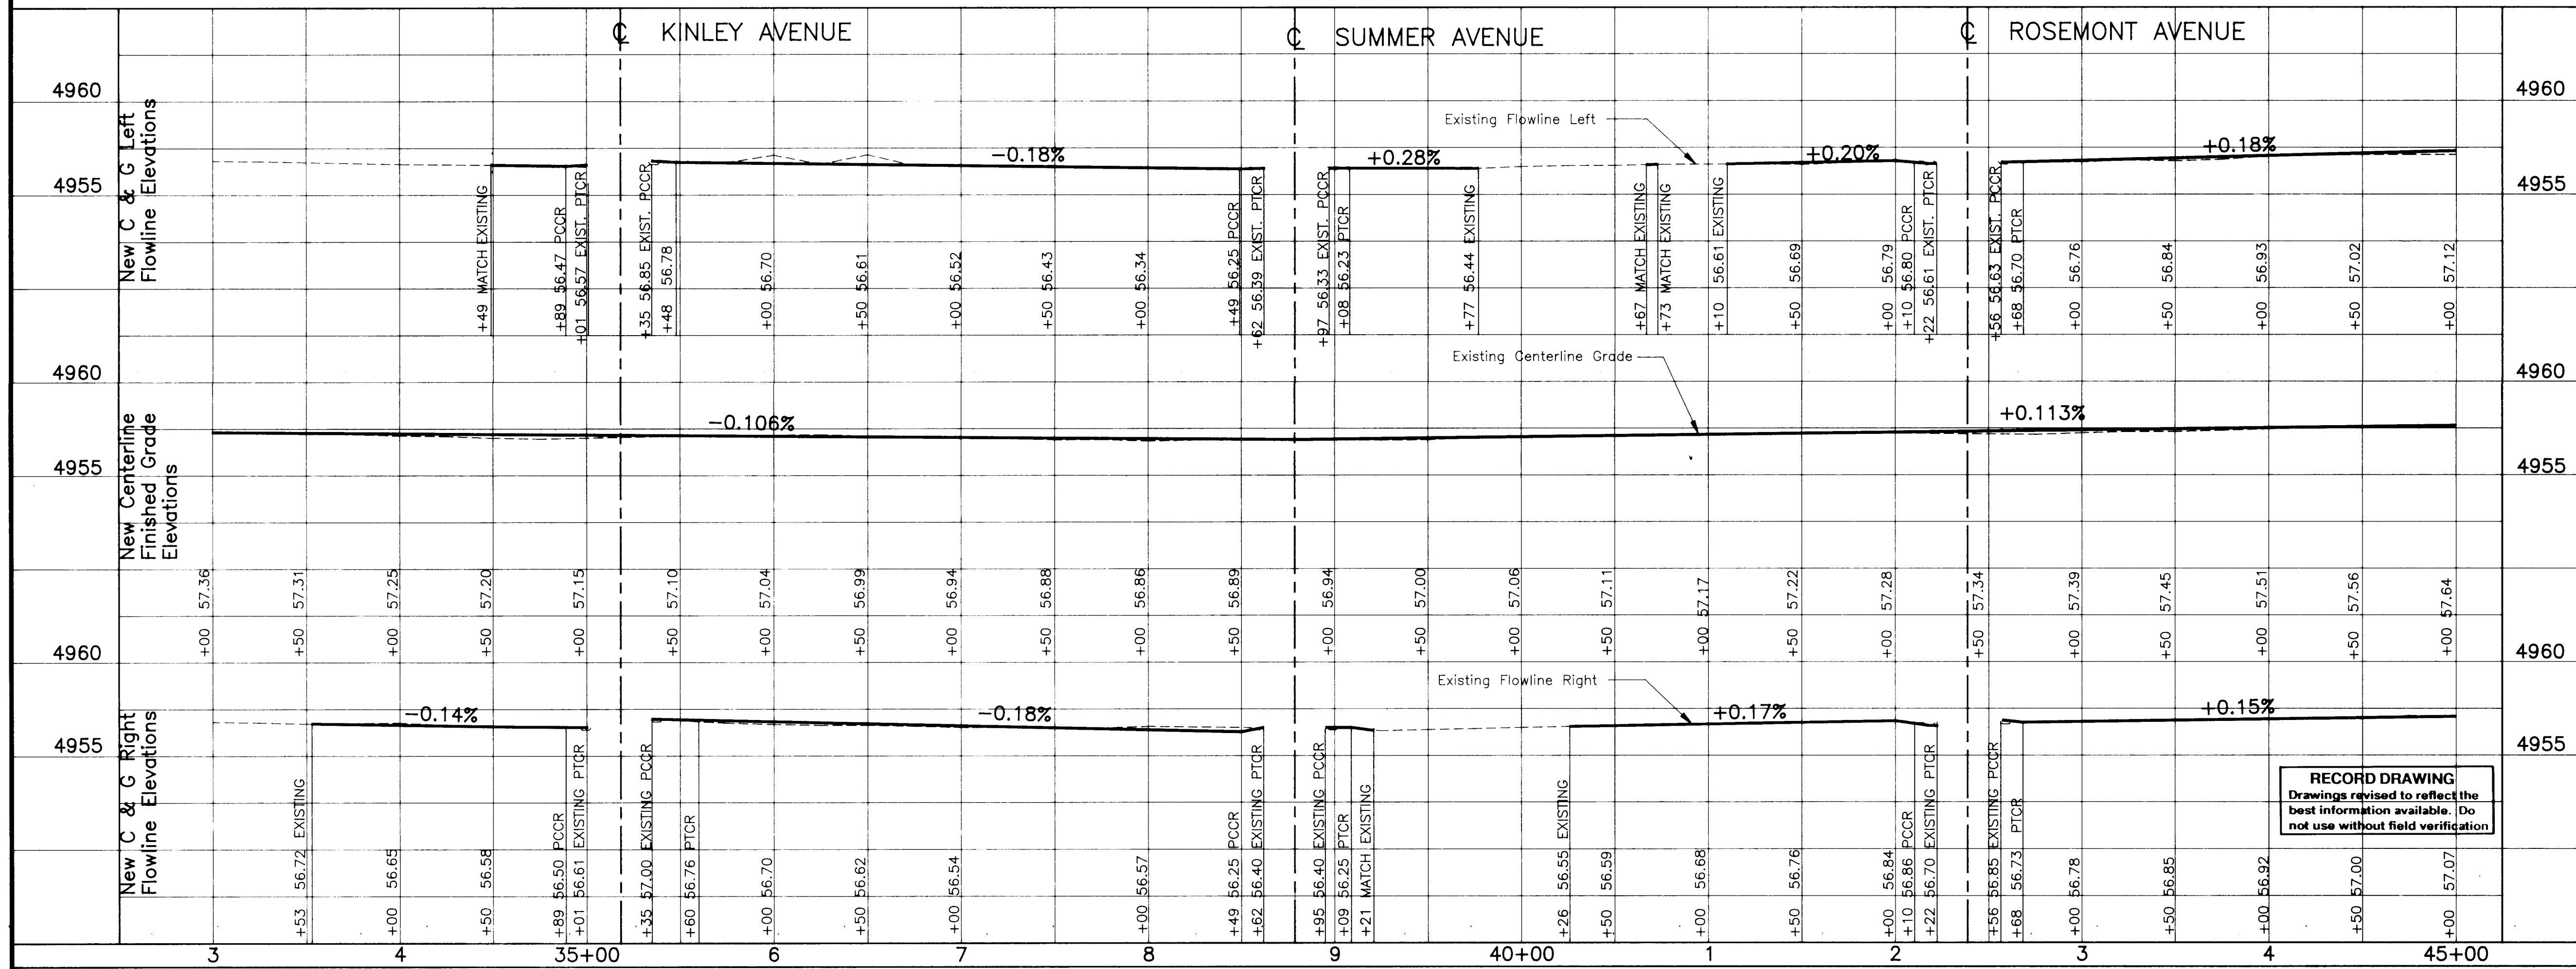

LEGEND



FLOW ARROWS



EXISTING DRIVEPAD



DRIVEPAD TO BE REMOVED AND REPLACED



CURB AND GUTTER REMOVAL AND REPLACEMENT




NEW WHEELCHAIR RAMP




UNTREATED ROADWAY



ASPHALT PAVEMENT REMOVAL AND REPLACEMENT

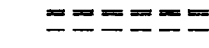

5/8" PLANT MIX SEAL COAT SURFACE TREATMENT

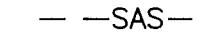

EXISTING C & G




EXISTING SANITARY SEWER




EXISTING WATER LINE



EXISTING GAS LINE

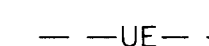

EXISTING STORM DRAIN

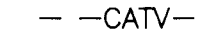

EXISTING UNDERGROUND TELEPHONE LINE




EXISTING UNDERGROUND ELECTRICAL LINE




EXISTING UNDERGROUND CABLE TV LINE



EXISTING TRAFFIC SIGNAL CONDUIT

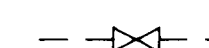

EXISTING TELEPHONE BOX

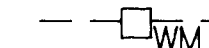

EXISTING STORM DRAIN MANHOLE




EXISTING SANITARY SEWER MANHOLE




EXISTING WATER VALVE




EXISTING WATER METER

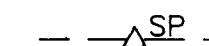

EXISTING GAS VALVE

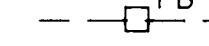


EXISTING GAS METER

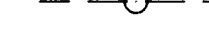

EXISTING FIRE HYDRANT




POWER POLE

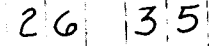


PEDESTAL SIGNAL




PULL BOX

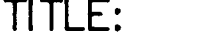

LIGHT POLE

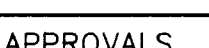

EXISTING STORM INLET

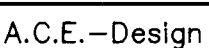

EXISTING TREE/SHRUB


AS BUILT INFORMATION		
CONTRACTOR	RUSS PITNEY	DATE
DESIGNED BY	CITY OF ALBUQUERQUE	DATE
CHECKED BY	INTERSECTION OF FOURTH & SIXTH	DATE
APPROVED BY	CONSTITUTION NW	DATE
REVISIONS	ELEV. = 4958.194	DATE
DESIGNED BY	TBM, CHISEL MARK 15' ± B/C ON	DATE
CHECKED BY	ENE CURB RETURN @ SIXTH AND	DATE
APPROVED BY	CONSTITUTION NW	DATE
REVISIONS	ELEV. = 4957.79	DATE

SURVEY INFORMATION		
NO.	FIELD NOTES	DATE
1	16-J4, CITY OF ALBUQUERQUE BM	DATE
2	ON NW CURB RETURN @	DATE
3	INTERSECTION OF FOURTH &	DATE
4	CONSTITUTION NW	DATE
5	ELEV. = 4958.194	DATE
6	TBM, CHISEL MARK 15' ± B/C ON	DATE
7	ENE CURB RETURN @ SIXTH AND	DATE
8	CONSTITUTION NW	DATE
9	ELEV. = 4957.79	DATE

ENGINEER'S SEAL		
NO.	REVISIONS	DATE
1	DESIGN	DATE MAY 1989
2	DESIGN	DATE MAY 1989
3	DESIGN	DATE MAY 1989

CITY OF ALBUQUERQUE		
PUBLIC WORKS DEPARTMENT		
TITLE: SIXTH STREET IMPROVEMENTS		
PAVING		
STA. 33+00 TO STA. 45+00		
APPROVALS	ENGINEER	DATE
City Engineer	4-1-89	4/27/89
A.C.E.-Design	Traffic	4/27/89
A.C.E.-Hydrology	Water	4/27/89

DRAWING NO.	MAP NO.	SHEET OF
3568	J-14	9 22

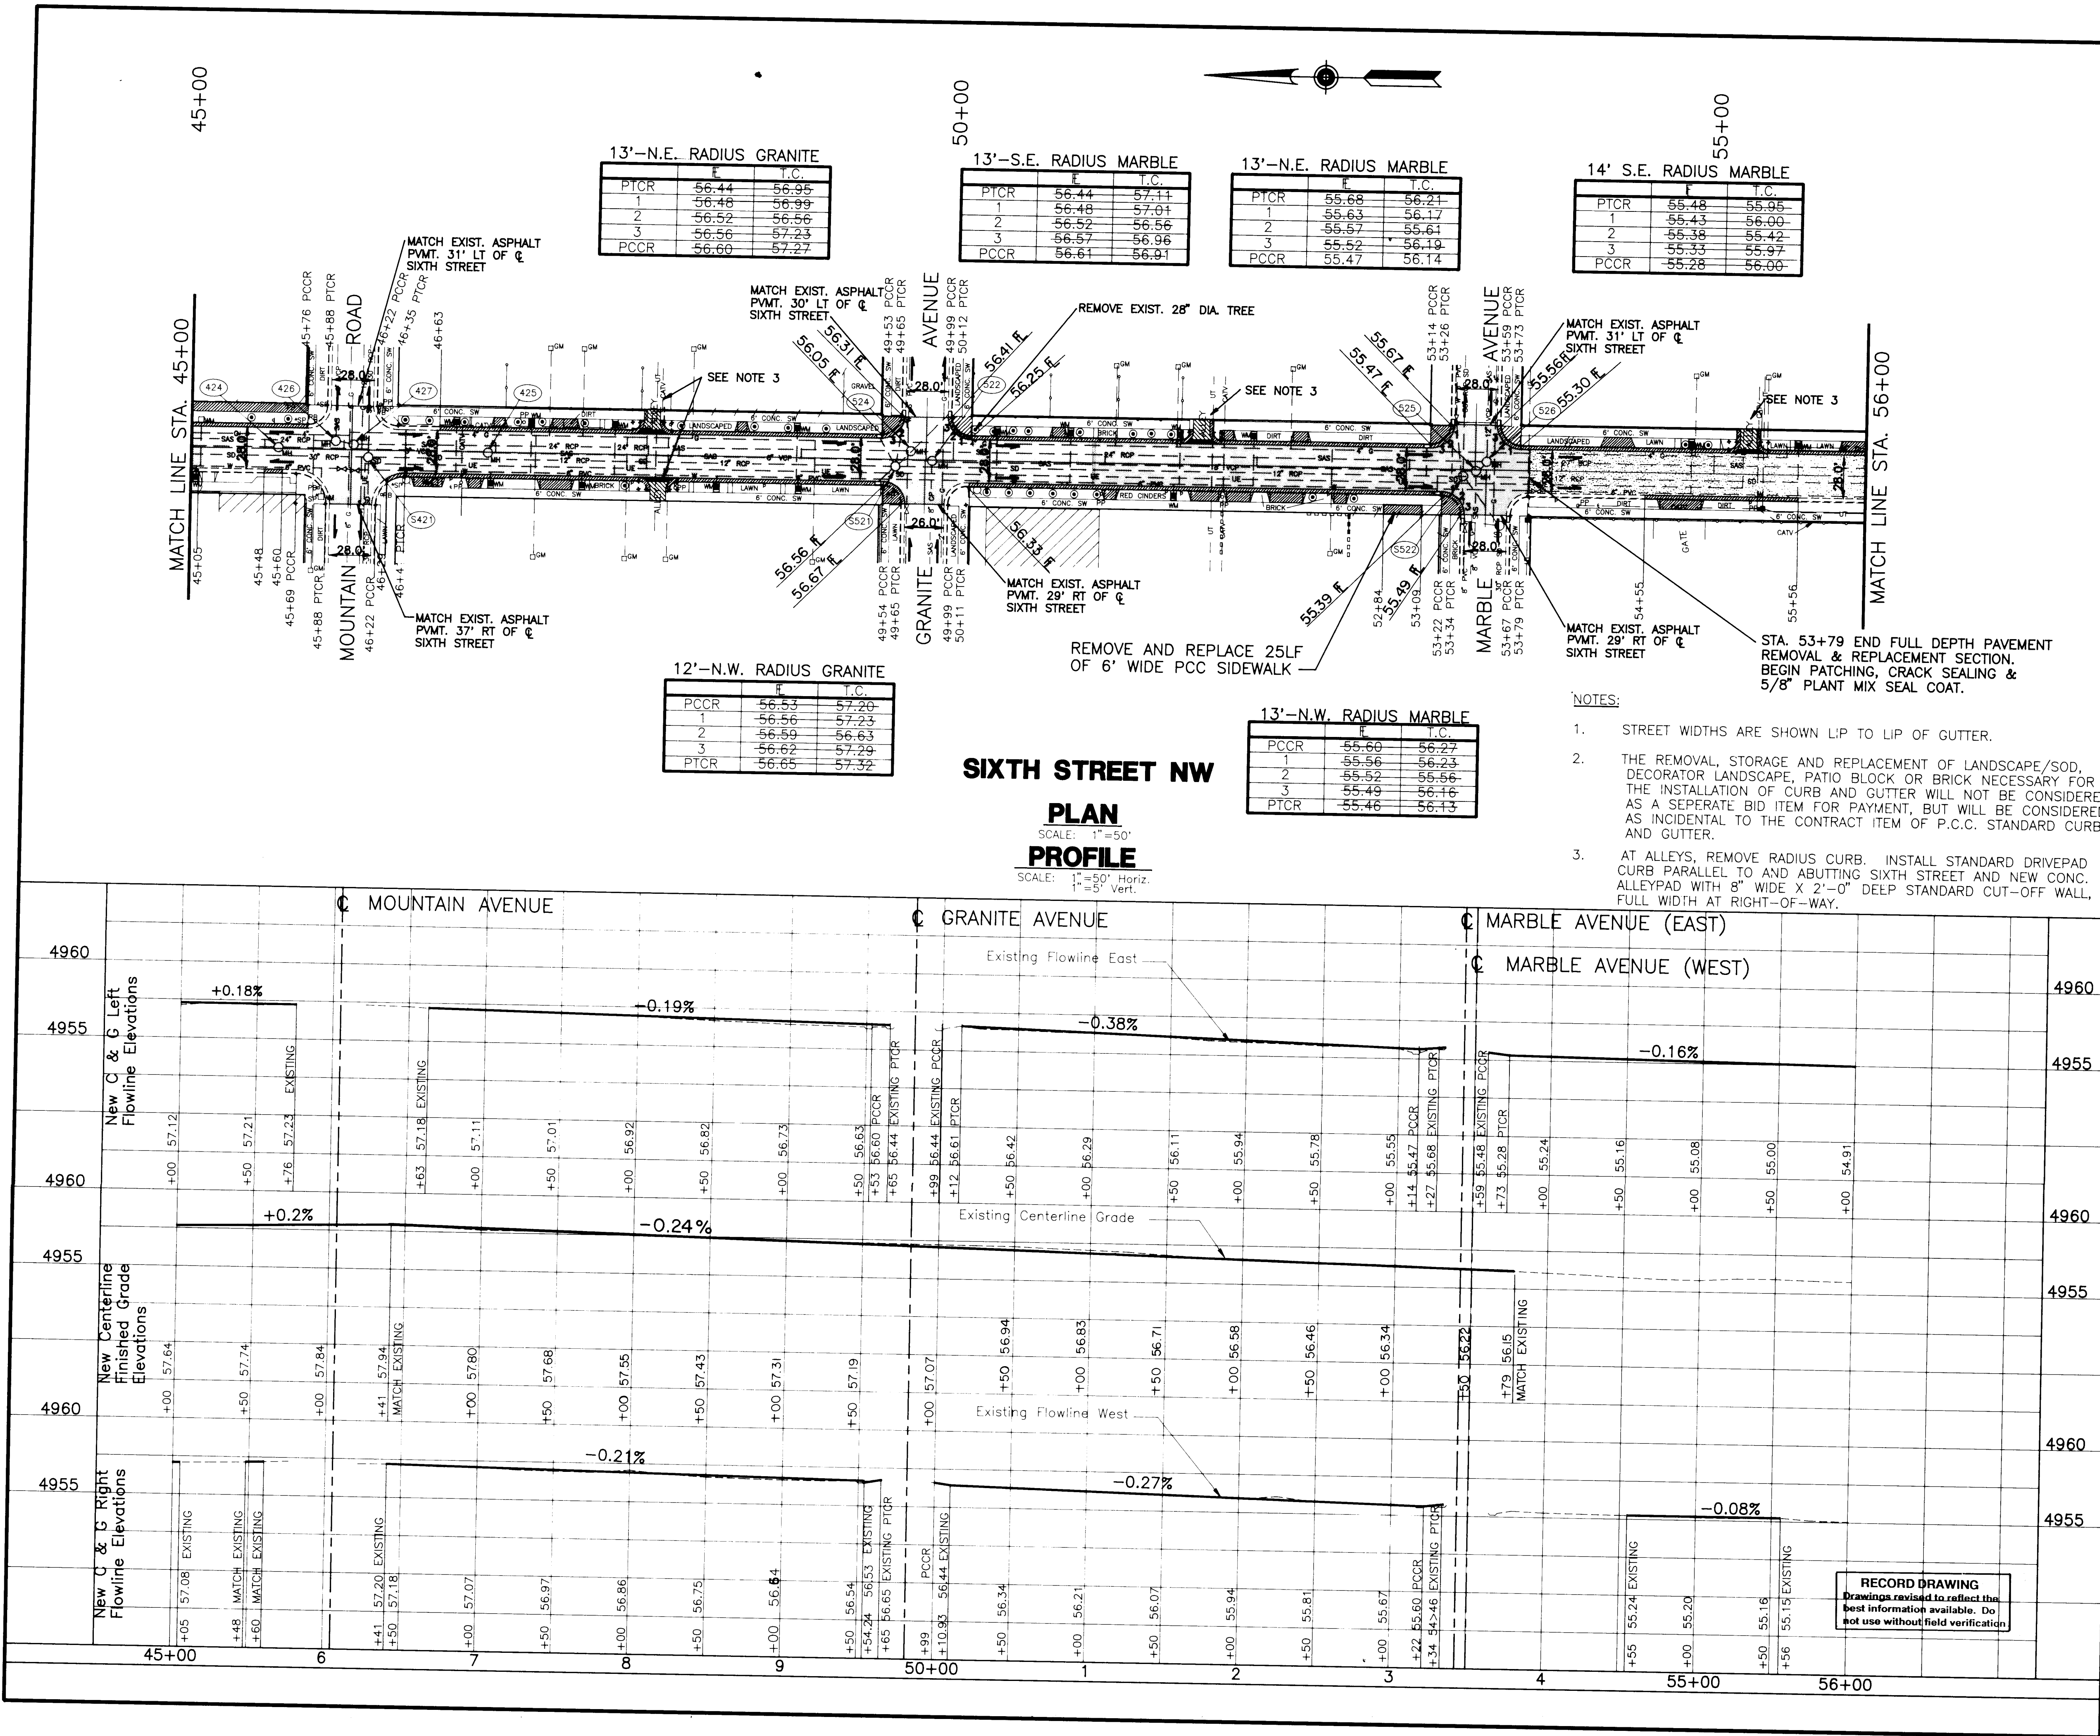

LEGEND

- FLOW ARROWS
- EXISTING DRIVEPAD
- DRIVEPAD TO BE REMOVED AND REPLACED
- CURB AND GUTTER REMOVAL AND REPLACEMENT
- NEW WHEELCHAIR RAMP
- UNTREATED ROADWAY
- ASPHALT PAVEMENT REMOVAL AND REPLACEMENT
- 5/8" PLANT MIX SEAL COAT SURFACE TREATMENT
- EXISTING C & G
- EXISTING SANITARY SEWER
- EXISTING WATER LINE
- EXISTING GAS LINE
- EXISTING STORM DRAIN
- EXISTING UNDERGROUND TELEPHONE LINE
- EXISTING UNDERGROUND ELECTRICAL LINE
- EXISTING UNDERGROUND CABLE TV LINE
- EXISTING TRAFFIC SIGNAL CONDUIT
- EXISTING TELEPHONE BOX
- EXISTING STORM DRAIN MANHOLE
- EXISTING SANITARY SEWER MANHOLE
- EXISTING WATER VALVE
- EXISTING WATER METER
- EXISTING GAS VALVE
- EXISTING GAS METER
- EXISTING FIRE HYDRANT
- POWER POLE
- PEDESTAL SIGNAL
- PULL BOX
- LIGHT POLE
- EXISTING STORM INLET
- EXISTING TREE/SHRUB

AS BUILT INFORMATION			
CONTRACTOR	RUSSELL PITNEY	DATE	
DESIGNED BY	CITY OF ALBUQUERQUE	DATE	
APPROVED BY		DATE	
REVISIONS			
NO.	DATE	BY	REMARKS
1			
2			
CITY OF ALBUQUERQUE
PUBLIC WORKS DEPARTMENT

TITLE: **SIXTH STREET IMPROVEMENTS**
PAVING
STA. 45+00 TO STA. 56+00

APPROVALS	ENGINEER	DATE	APPROVALS	ENGINEER	DATE
City Engineer			Liquid Waste		4/17/89
A.C.E.-Design			Traffic		4/17/89
A.C.E.-Hydrology			Water		4/17/89


DRAWING NO. 3568

MAP NO. J-14

SHEET 10 OF 22

LEGEND

- 1 FLOW ARROWS
- 8" PCC PAVEMENT REMOVAL AND REPLACEMENT
- EXISTING DRIVEPAD
- DRIVEPAD TO BE REMOVED AND REPLACED
- CURB AND GUTTER REMOVAL AND REPLACEMENT
- NEW WHEELCHAIR RAMP
- UNTREATED ROADWAY
- ASPHALT PAVEMENT REMOVAL AND REPLACEMENT
- 5/8" PLANT MIX SEAL COAT SURFACE TREATMENT
- EXISTING C & G
- SAS--- EXISTING SANITARY SEWER
- W--- EXISTING WATER LINE
- G--- EXISTING GAS LINE
- SD--- EXISTING STORM DRAIN
- UT--- EXISTING UNDERGROUND TELEPHONE LINE
- UE--- EXISTING UNDERGROUND ELECTRICAL LINE
- CATV--- EXISTING UNDERGROUND CABLE TV LINE
- TG--- EXISTING TRAFFIC SIGNAL CONDUIT
- TB--- EXISTING TELEPHONE BOX
- SD--- EXISTING STORM DRAIN MANHOLE
- MH--- EXISTING SANITARY SEWER MANHOLE
- V--- EXISTING WATER VALVE
- WM--- EXISTING WATER METER
- GV--- EXISTING GAS VALVE
- GM--- EXISTING GAS METER
- FH--- EXISTING FIRE HYDRANT
- PP--- POWER POLE
- SP--- PEDESTAL SIGNAL
- PB--- PULL BOX
- LP--- LIGHT POLE
- SI--- EXISTING STORM INLET
- TS--- EXISTING TREE/SHRUB

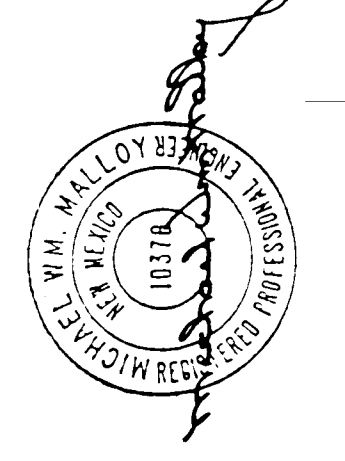
AS BUILT INFORMATION			BENCH MARKS			SURVEY INFORMATION			ENGINEER'S SEAL		
CONTRACTOR	RUS PITNEY	DATE	2-J14-R	CITY OF ALBUQUERQUE	DATE	NO.	BY	DATE			
DESIGNED BY	CITY OF ALBUQUERQUE	DATE	BRASS CAP LOCATED AT NE CORNER								
SUPERVISOR'S	OF FOURTH AND LOMAS NW	DATE									
ADJUSTED BY	ELEV. = 4954.40	DATE									
VERIFICATION BY	CONDUCTED BY GANNETT FLEMING	DATE							REVISIONS		
CORRECTED BY	TBM, CHISEL MARK " " ON WEST	DATE									
	SIDE OF MEDIAN NOSE AT	DATE									
	INTERSECTION OF SIXTH & LOMAS NW	DATE									
	ELEV. = 4955.57								DESIGNED BY	LDR-SAM-DW	DATE MAY 1989
									DRAWN BY	RKA-JTN	DATE MAY 1989
									CHECKED BY	MMW	DATE MAY 1989

CITY OF ALBUQUERQUE
PUBLIC WORKS DEPARTMENT

TITLE: **SIXTH STREET IMPROVEMENTS**
PAVING
STA. 56+00 TO STA. 60+06.48



APPROVALS	ENGINEER	DATE	APPROVALS	ENGINEER	DATE
City Engineer			Liquid Waste	PEAO	4/27/89
A.C.E.-Design			Traffic		
A.C.E.-Hydrology			Water	PEAO	4/27/89

DRAWING NO. 3568 MAP NO. J-14 SHEET 11 OF 22

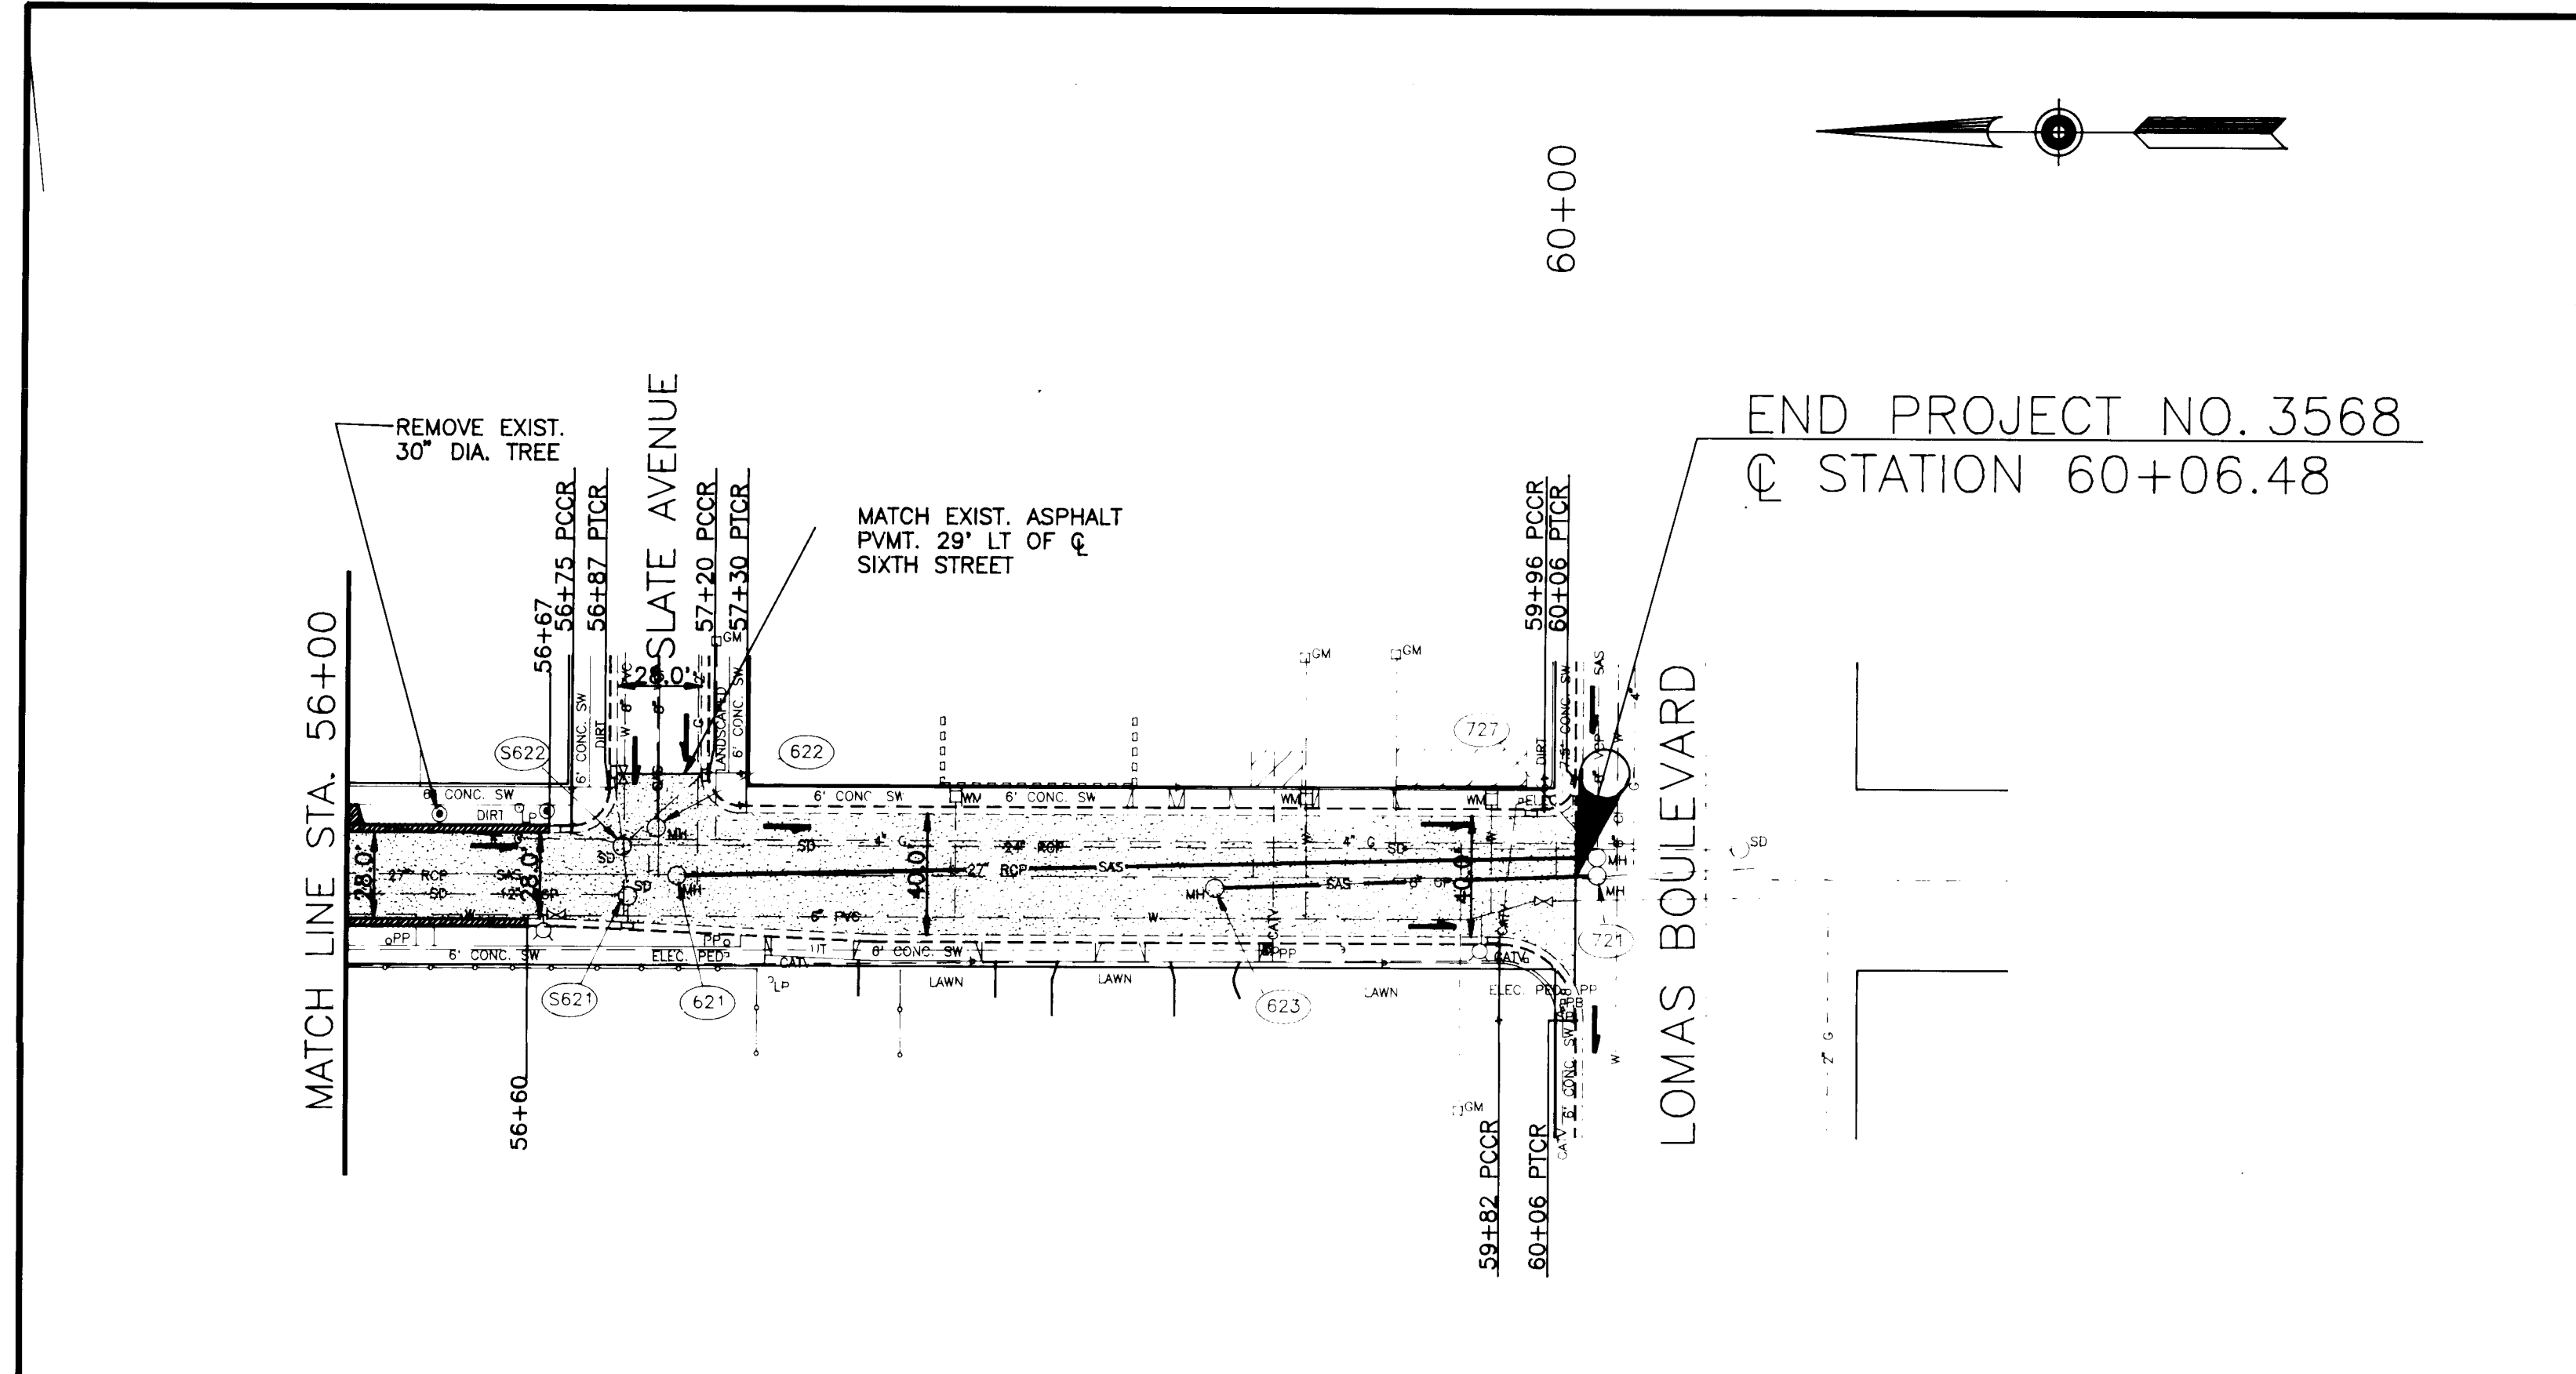


SIXTH STREET NW
PLAN
SCALE: 1"=50'
PROFILE
SCALE: 1"=50' Horiz.
1"=5' Vert.

- NOTES:
- STREET WIDTHS ARE SHOWN LIP TO LIP OF GUTTER.
 - THE REMOVAL, STORAGE AND REPLACEMENT OF LANDSCAPE/SOD, DECORATOR LANDSCAPE, PATIO BLOCK OR BRICK NECESSARY FOR THE INSTALLATION OF CURB AND GUTTER WILL NOT BE CONSIDERED AS A SEPARATE BID ITEM FOR PAYMENT, BUT WILL BE CONSIDERED AS INCIDENTAL TO THE CONTRACT ITEM OF P.C.C. STANDARD CURB AND GUTTER.




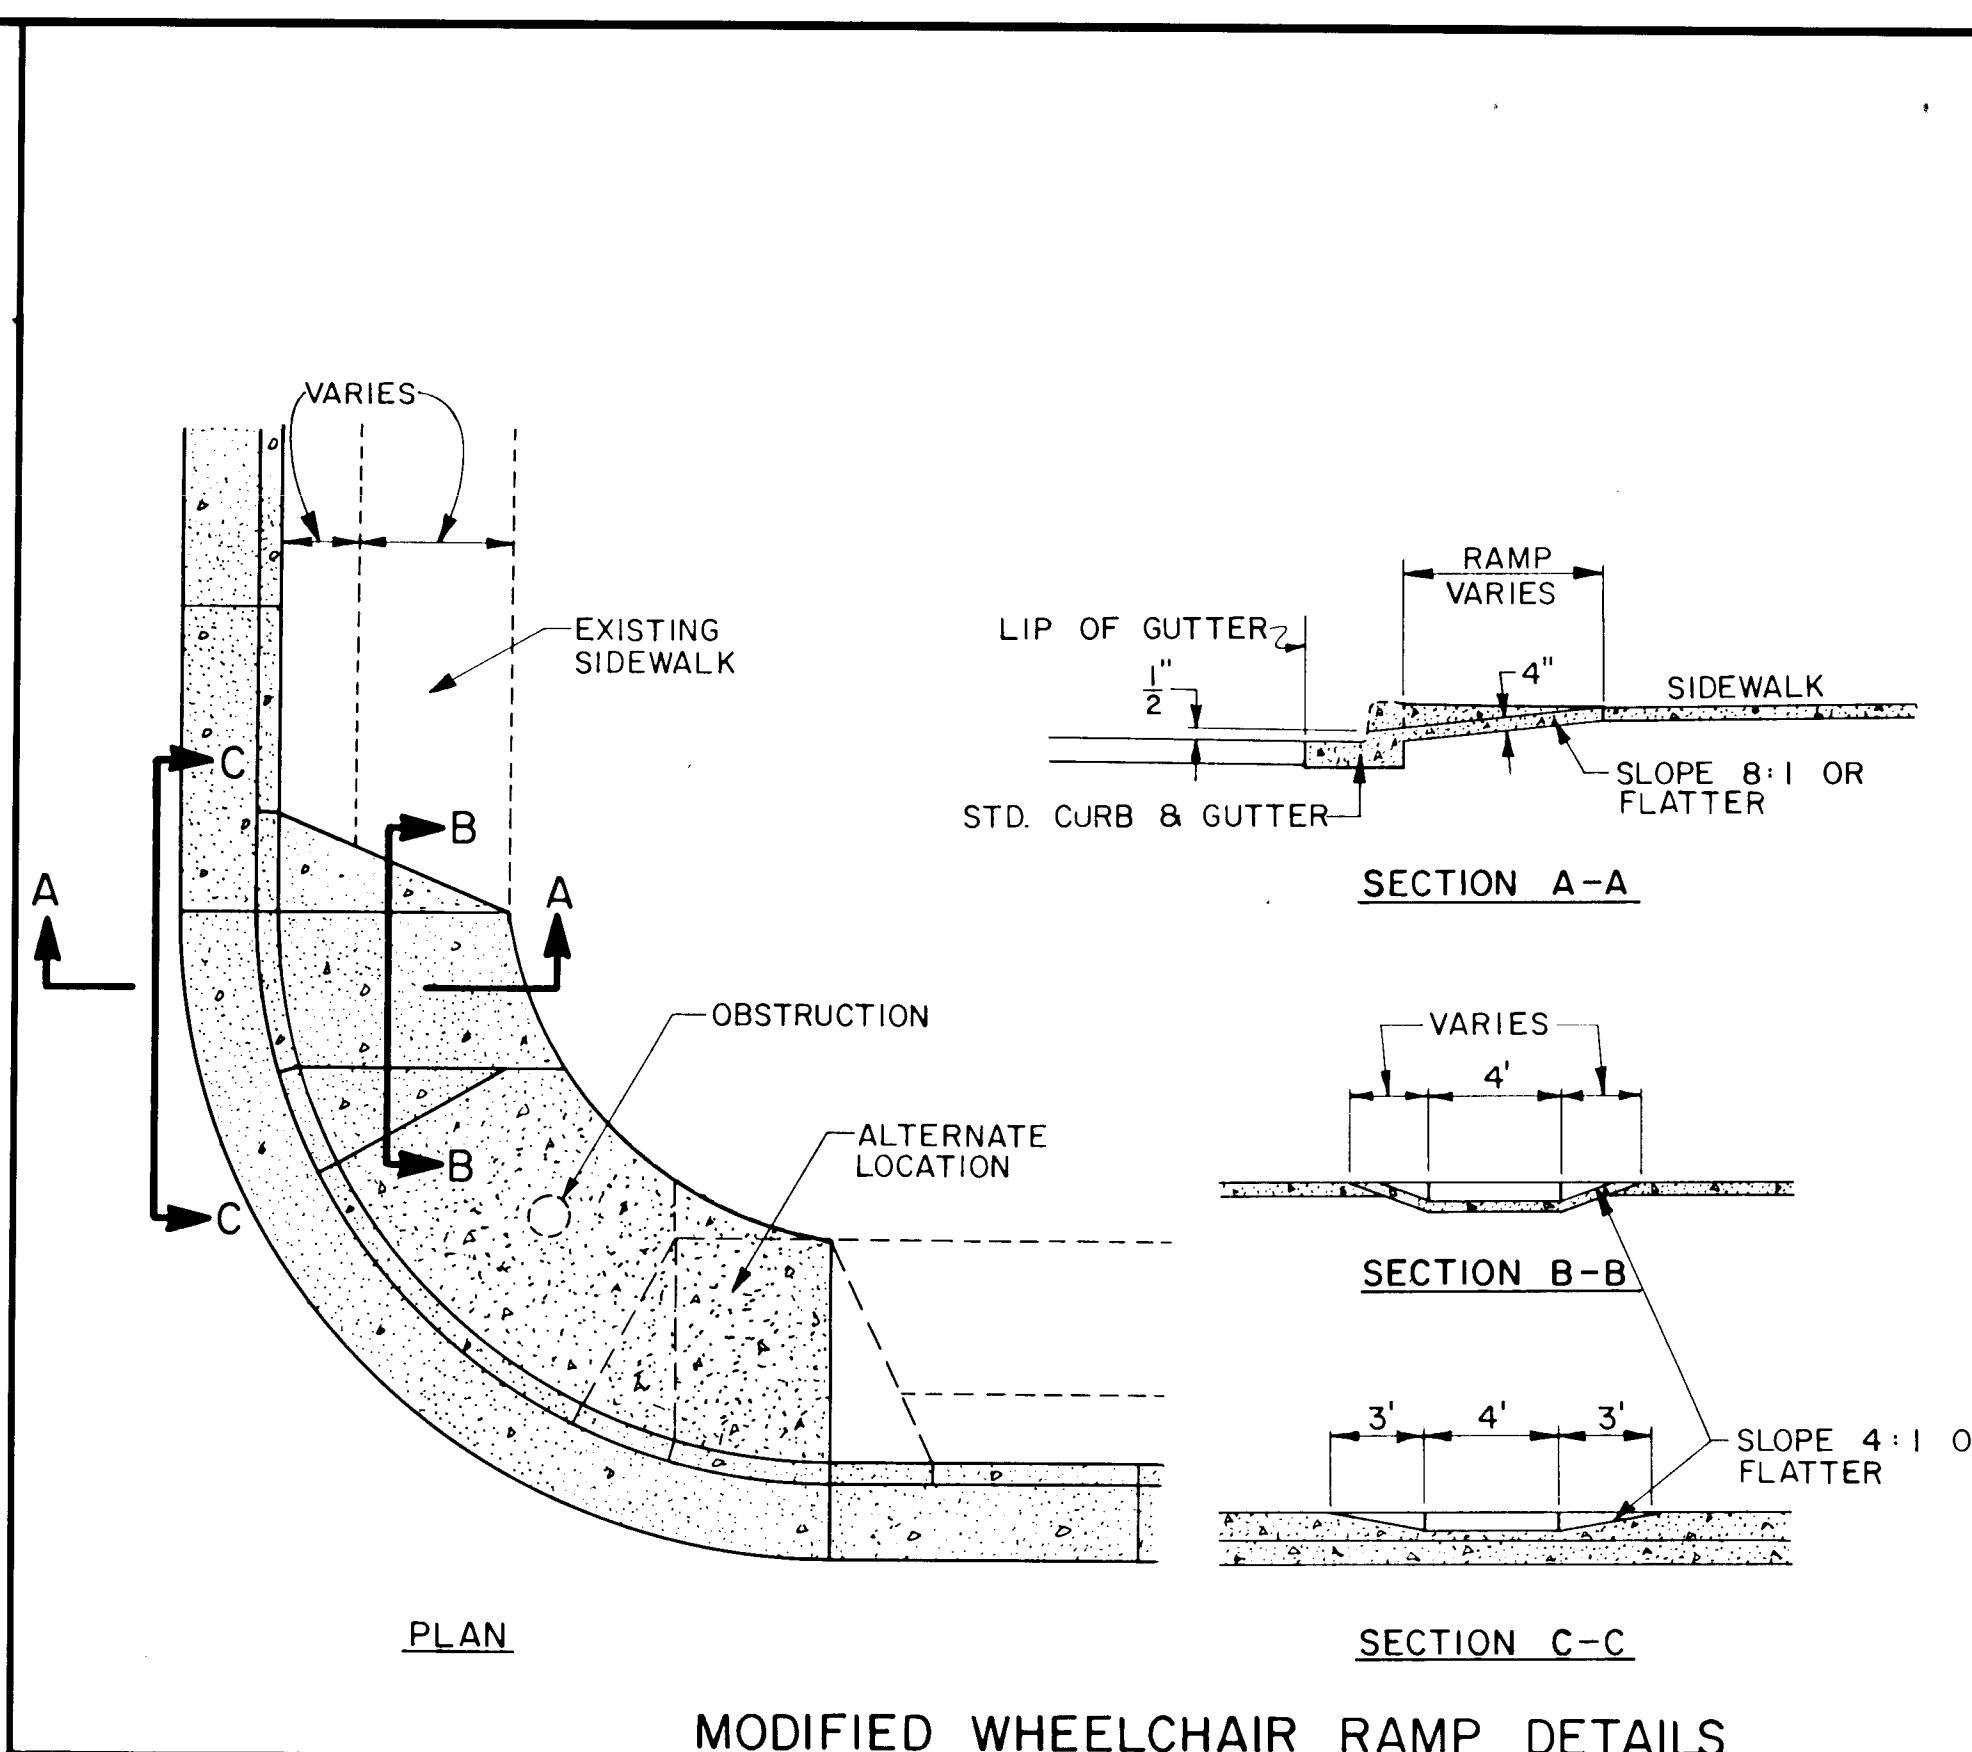
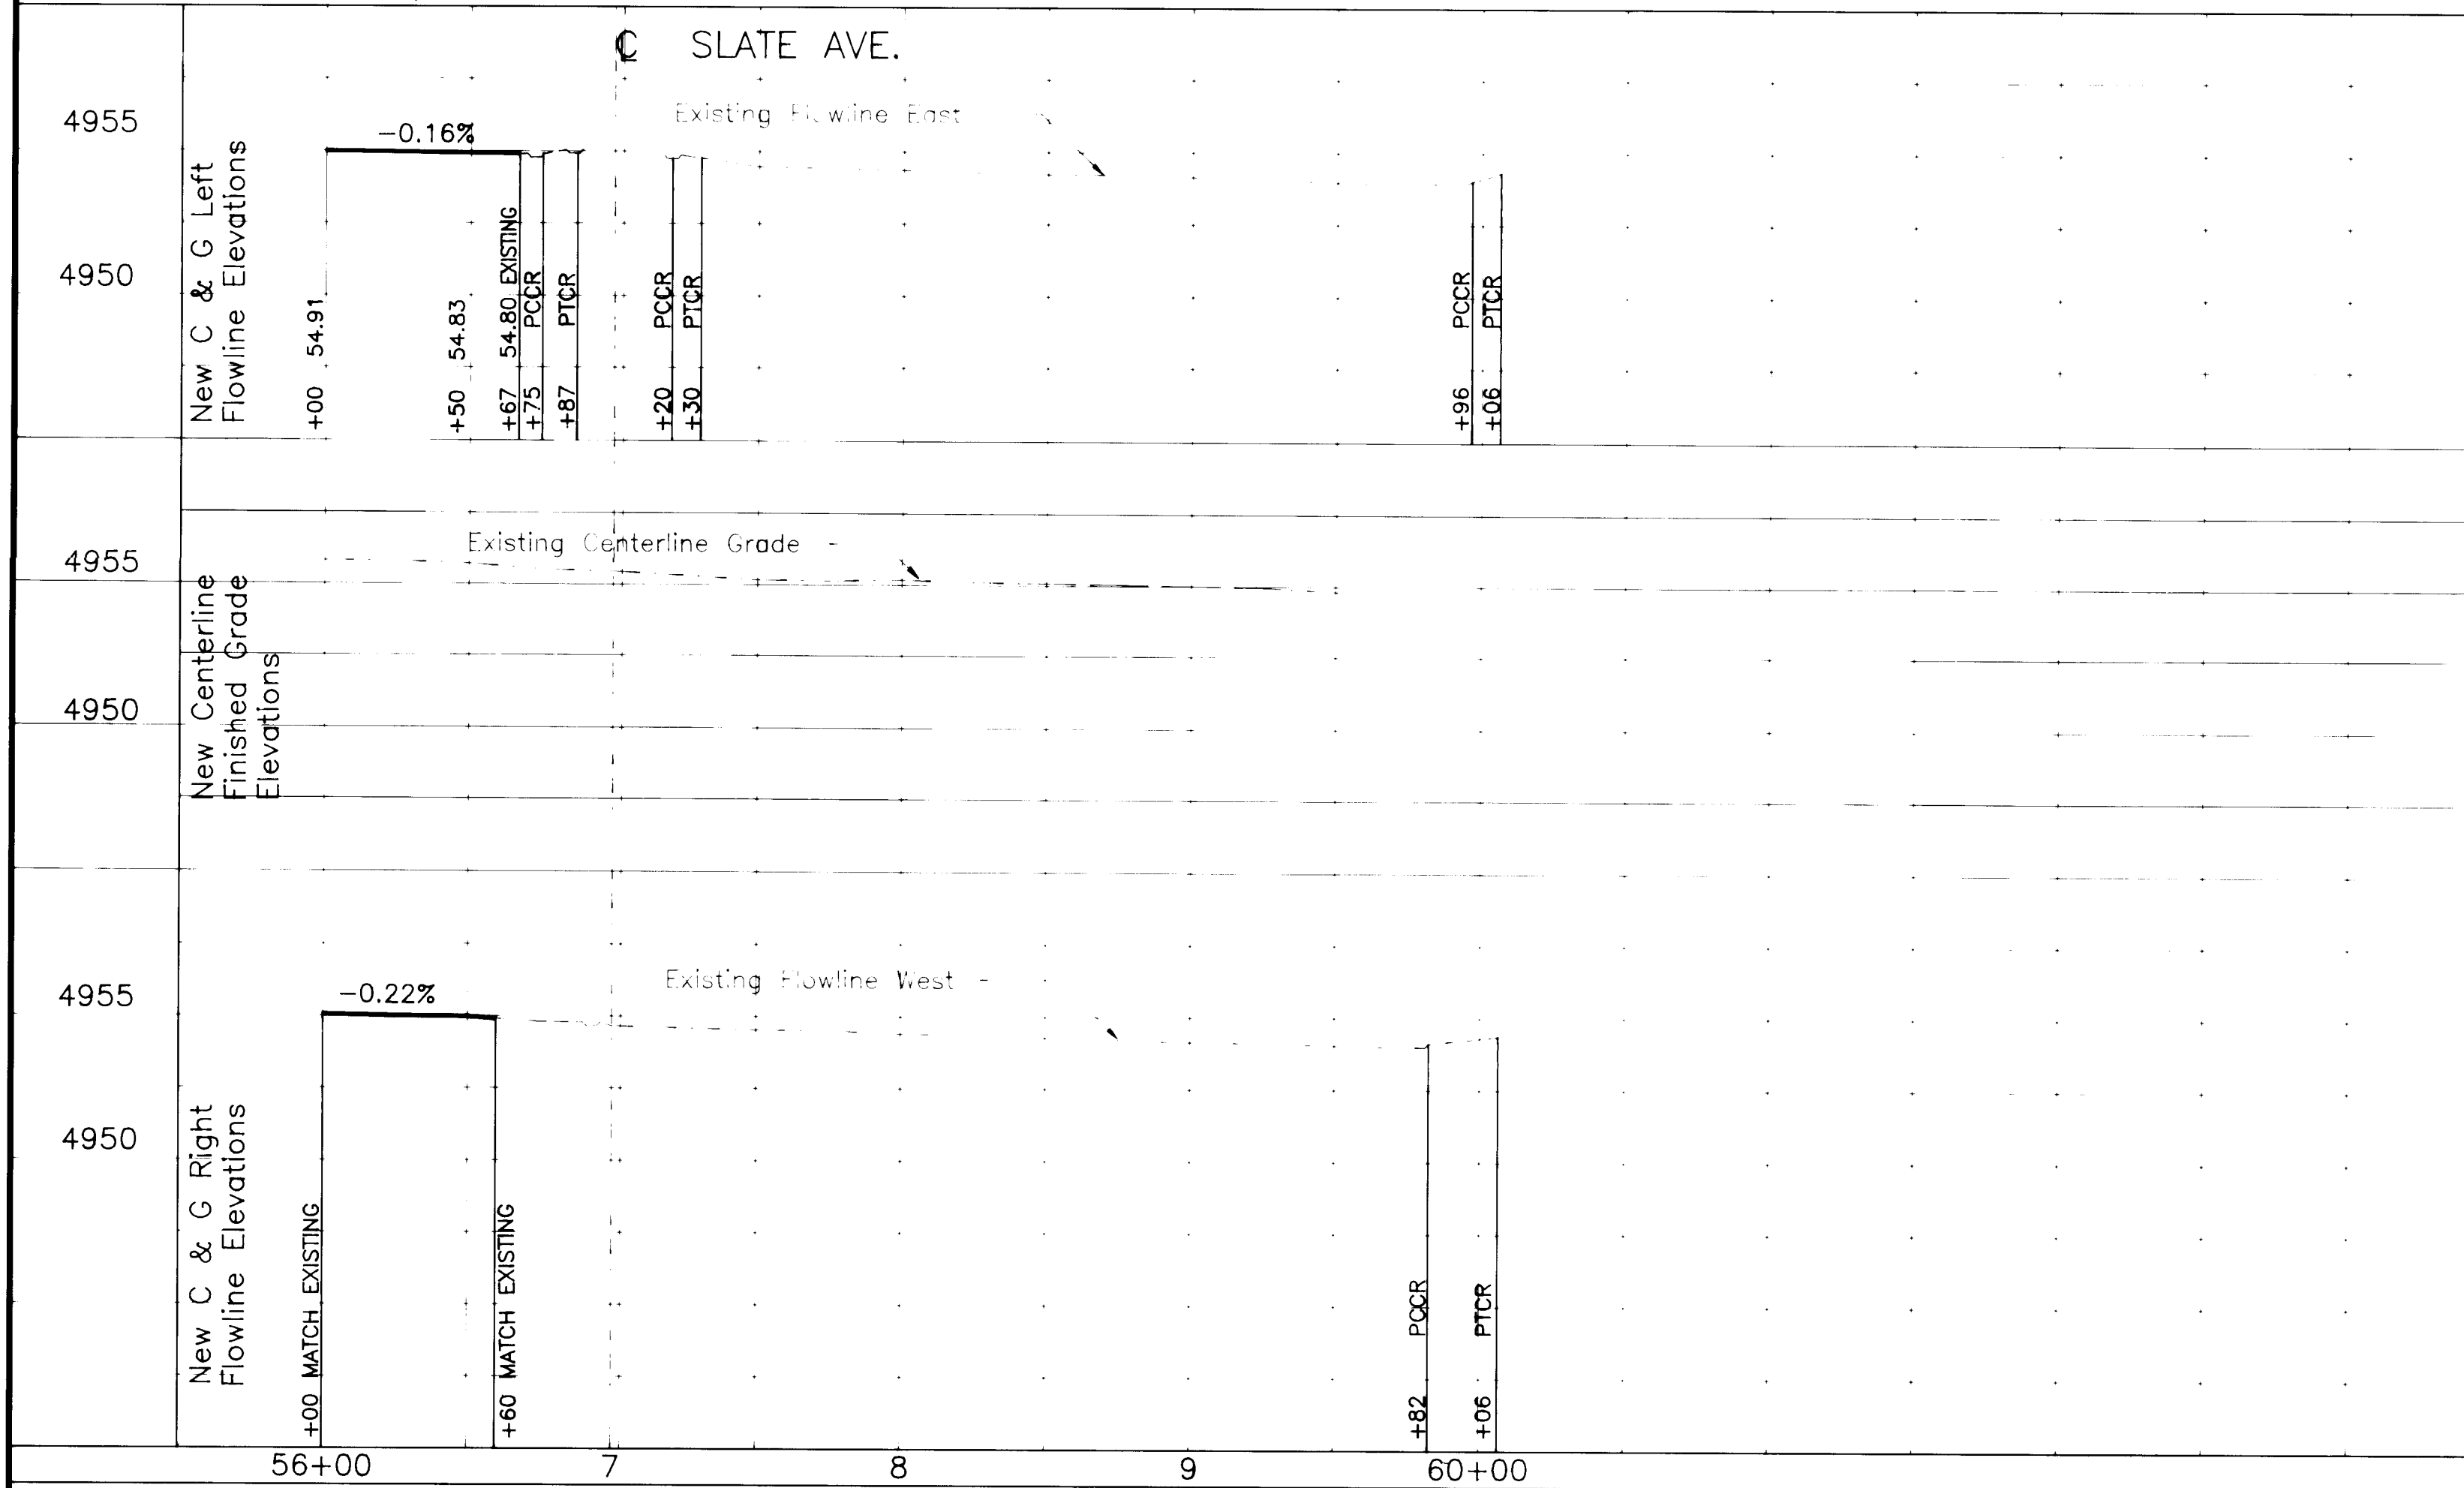


MODIFIED WHEELCHAIR RAMP DETAILS

NOTE: TO BE USED WHERE OBSTRUCTIONS PREVENT THE USE OF EITHER CASE I OR CASE II STANDARD WHEELCHAIR RAMPS AS DETERMINED BY THE ENGINEER IN THE FIELD.

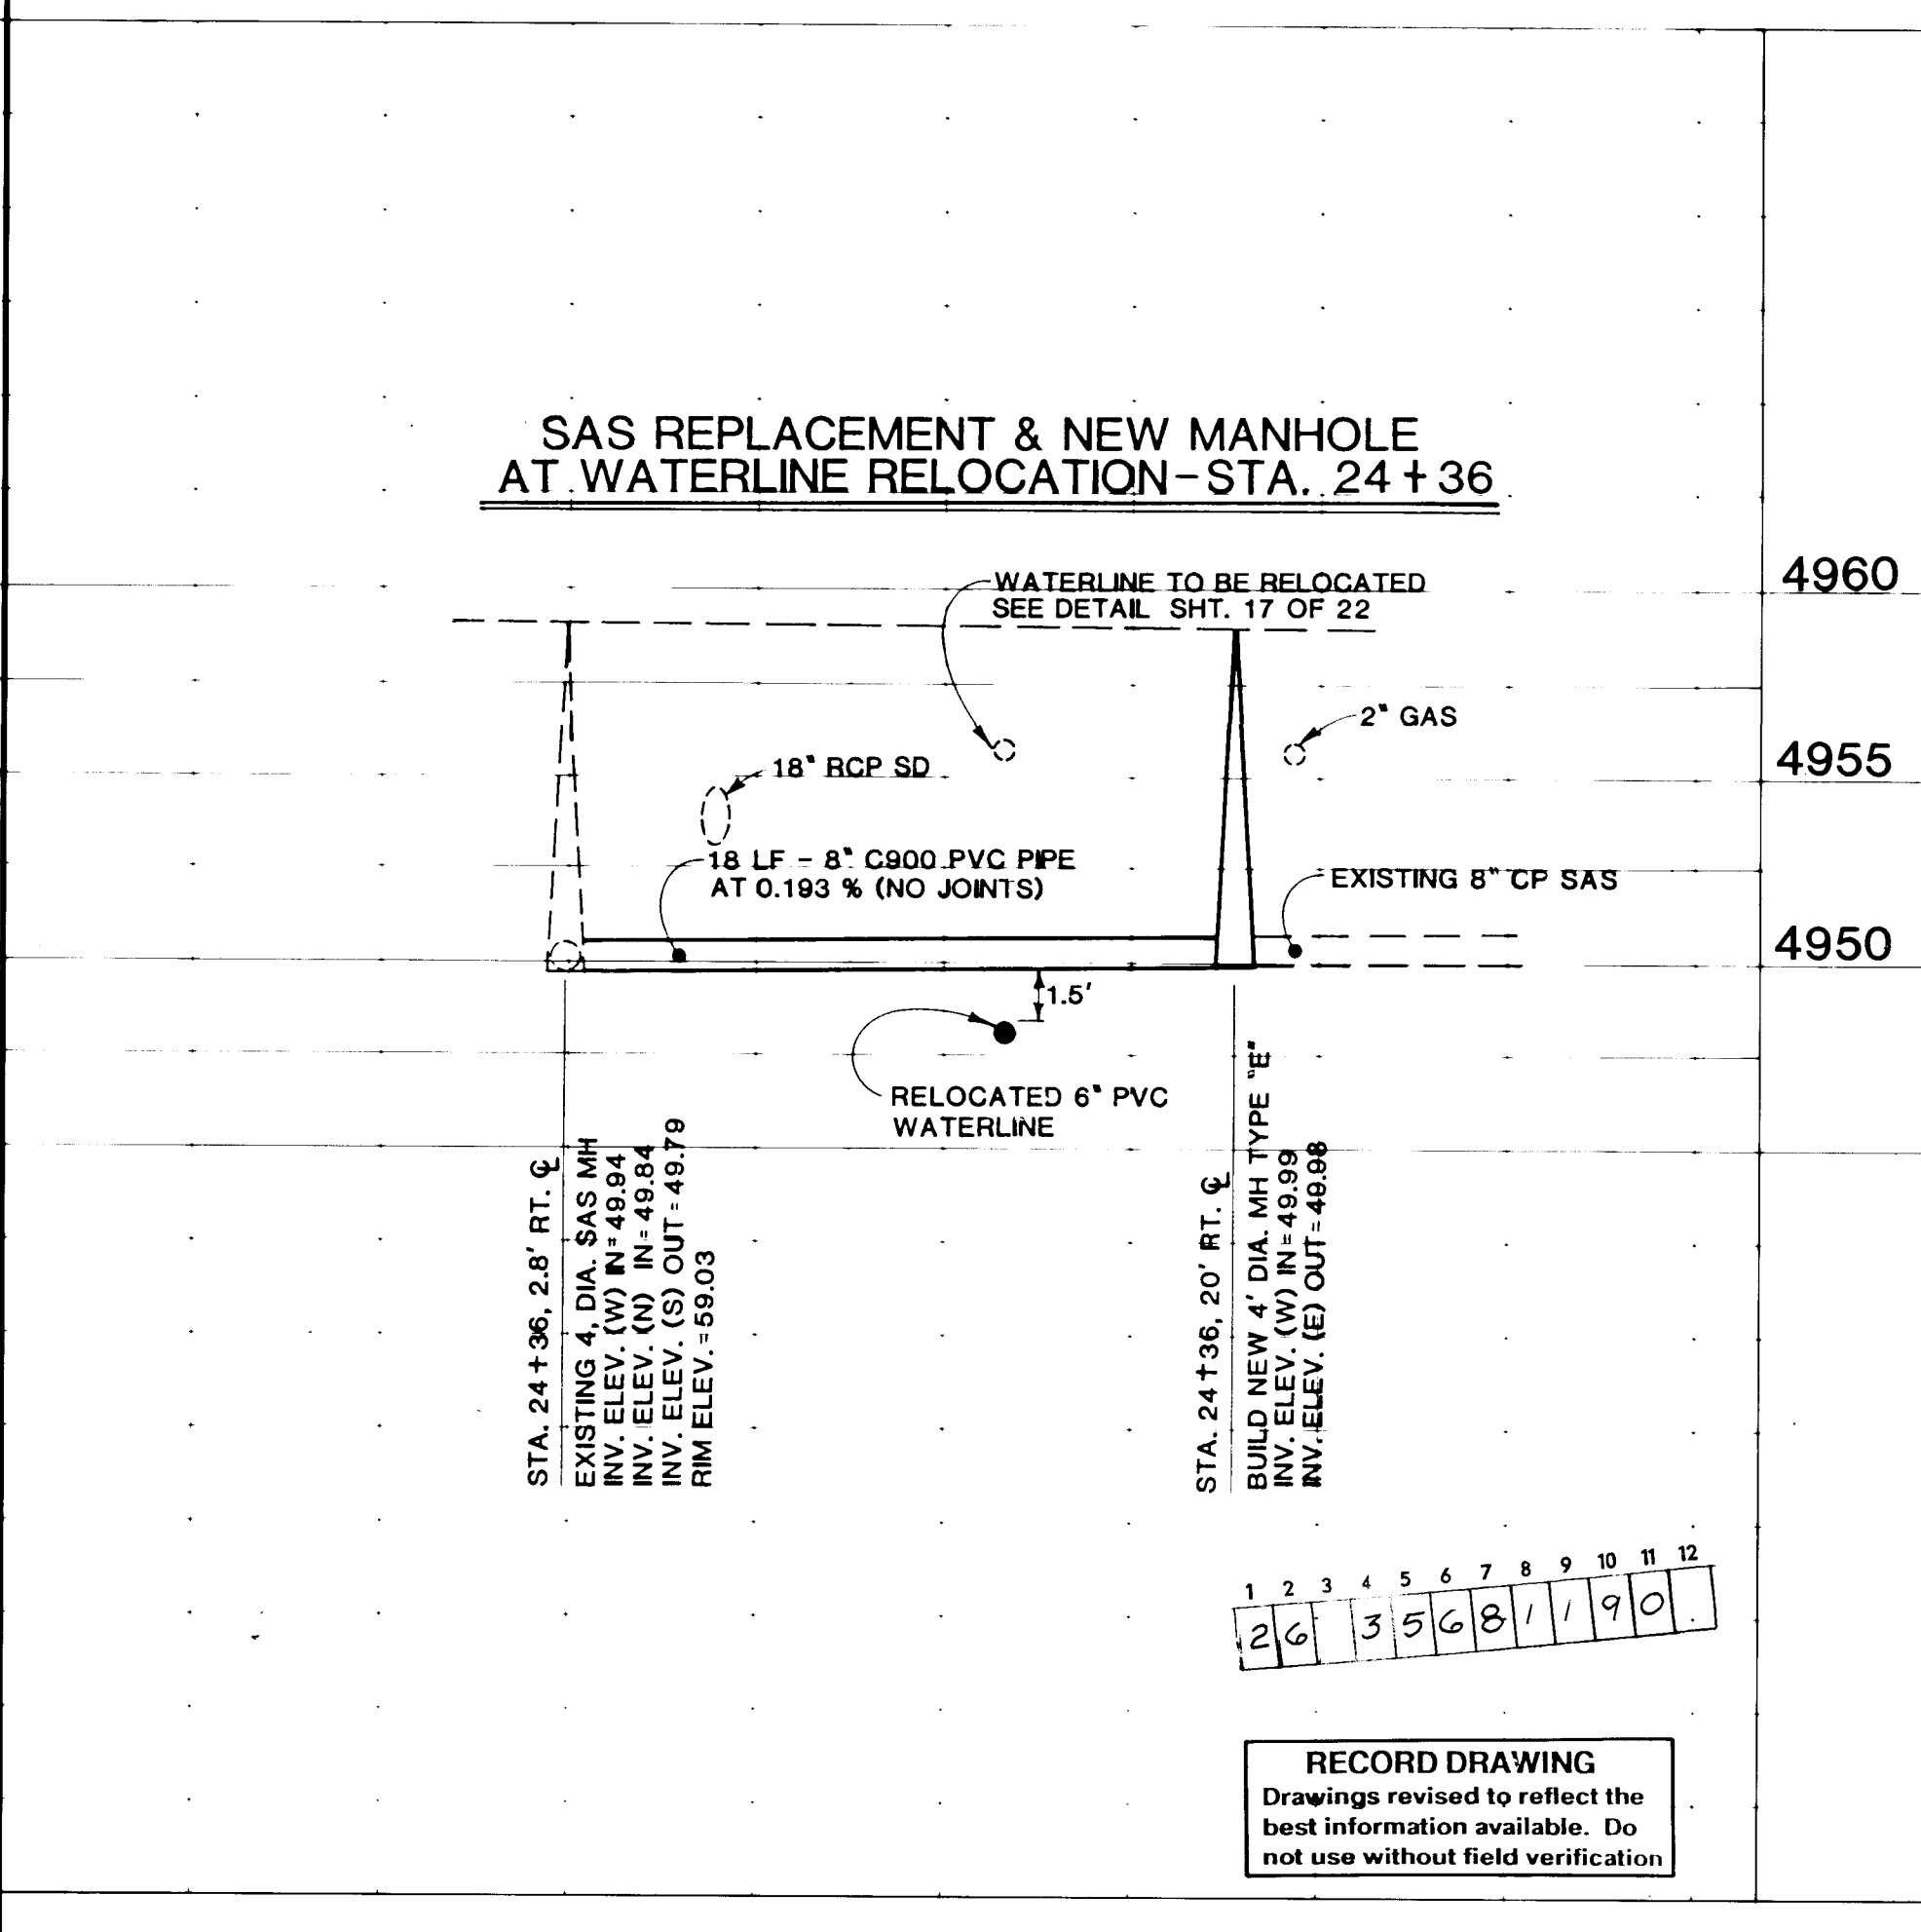

RECORD DRAWING
Drawings revised to reflect the best information available. Do not use without field verification.

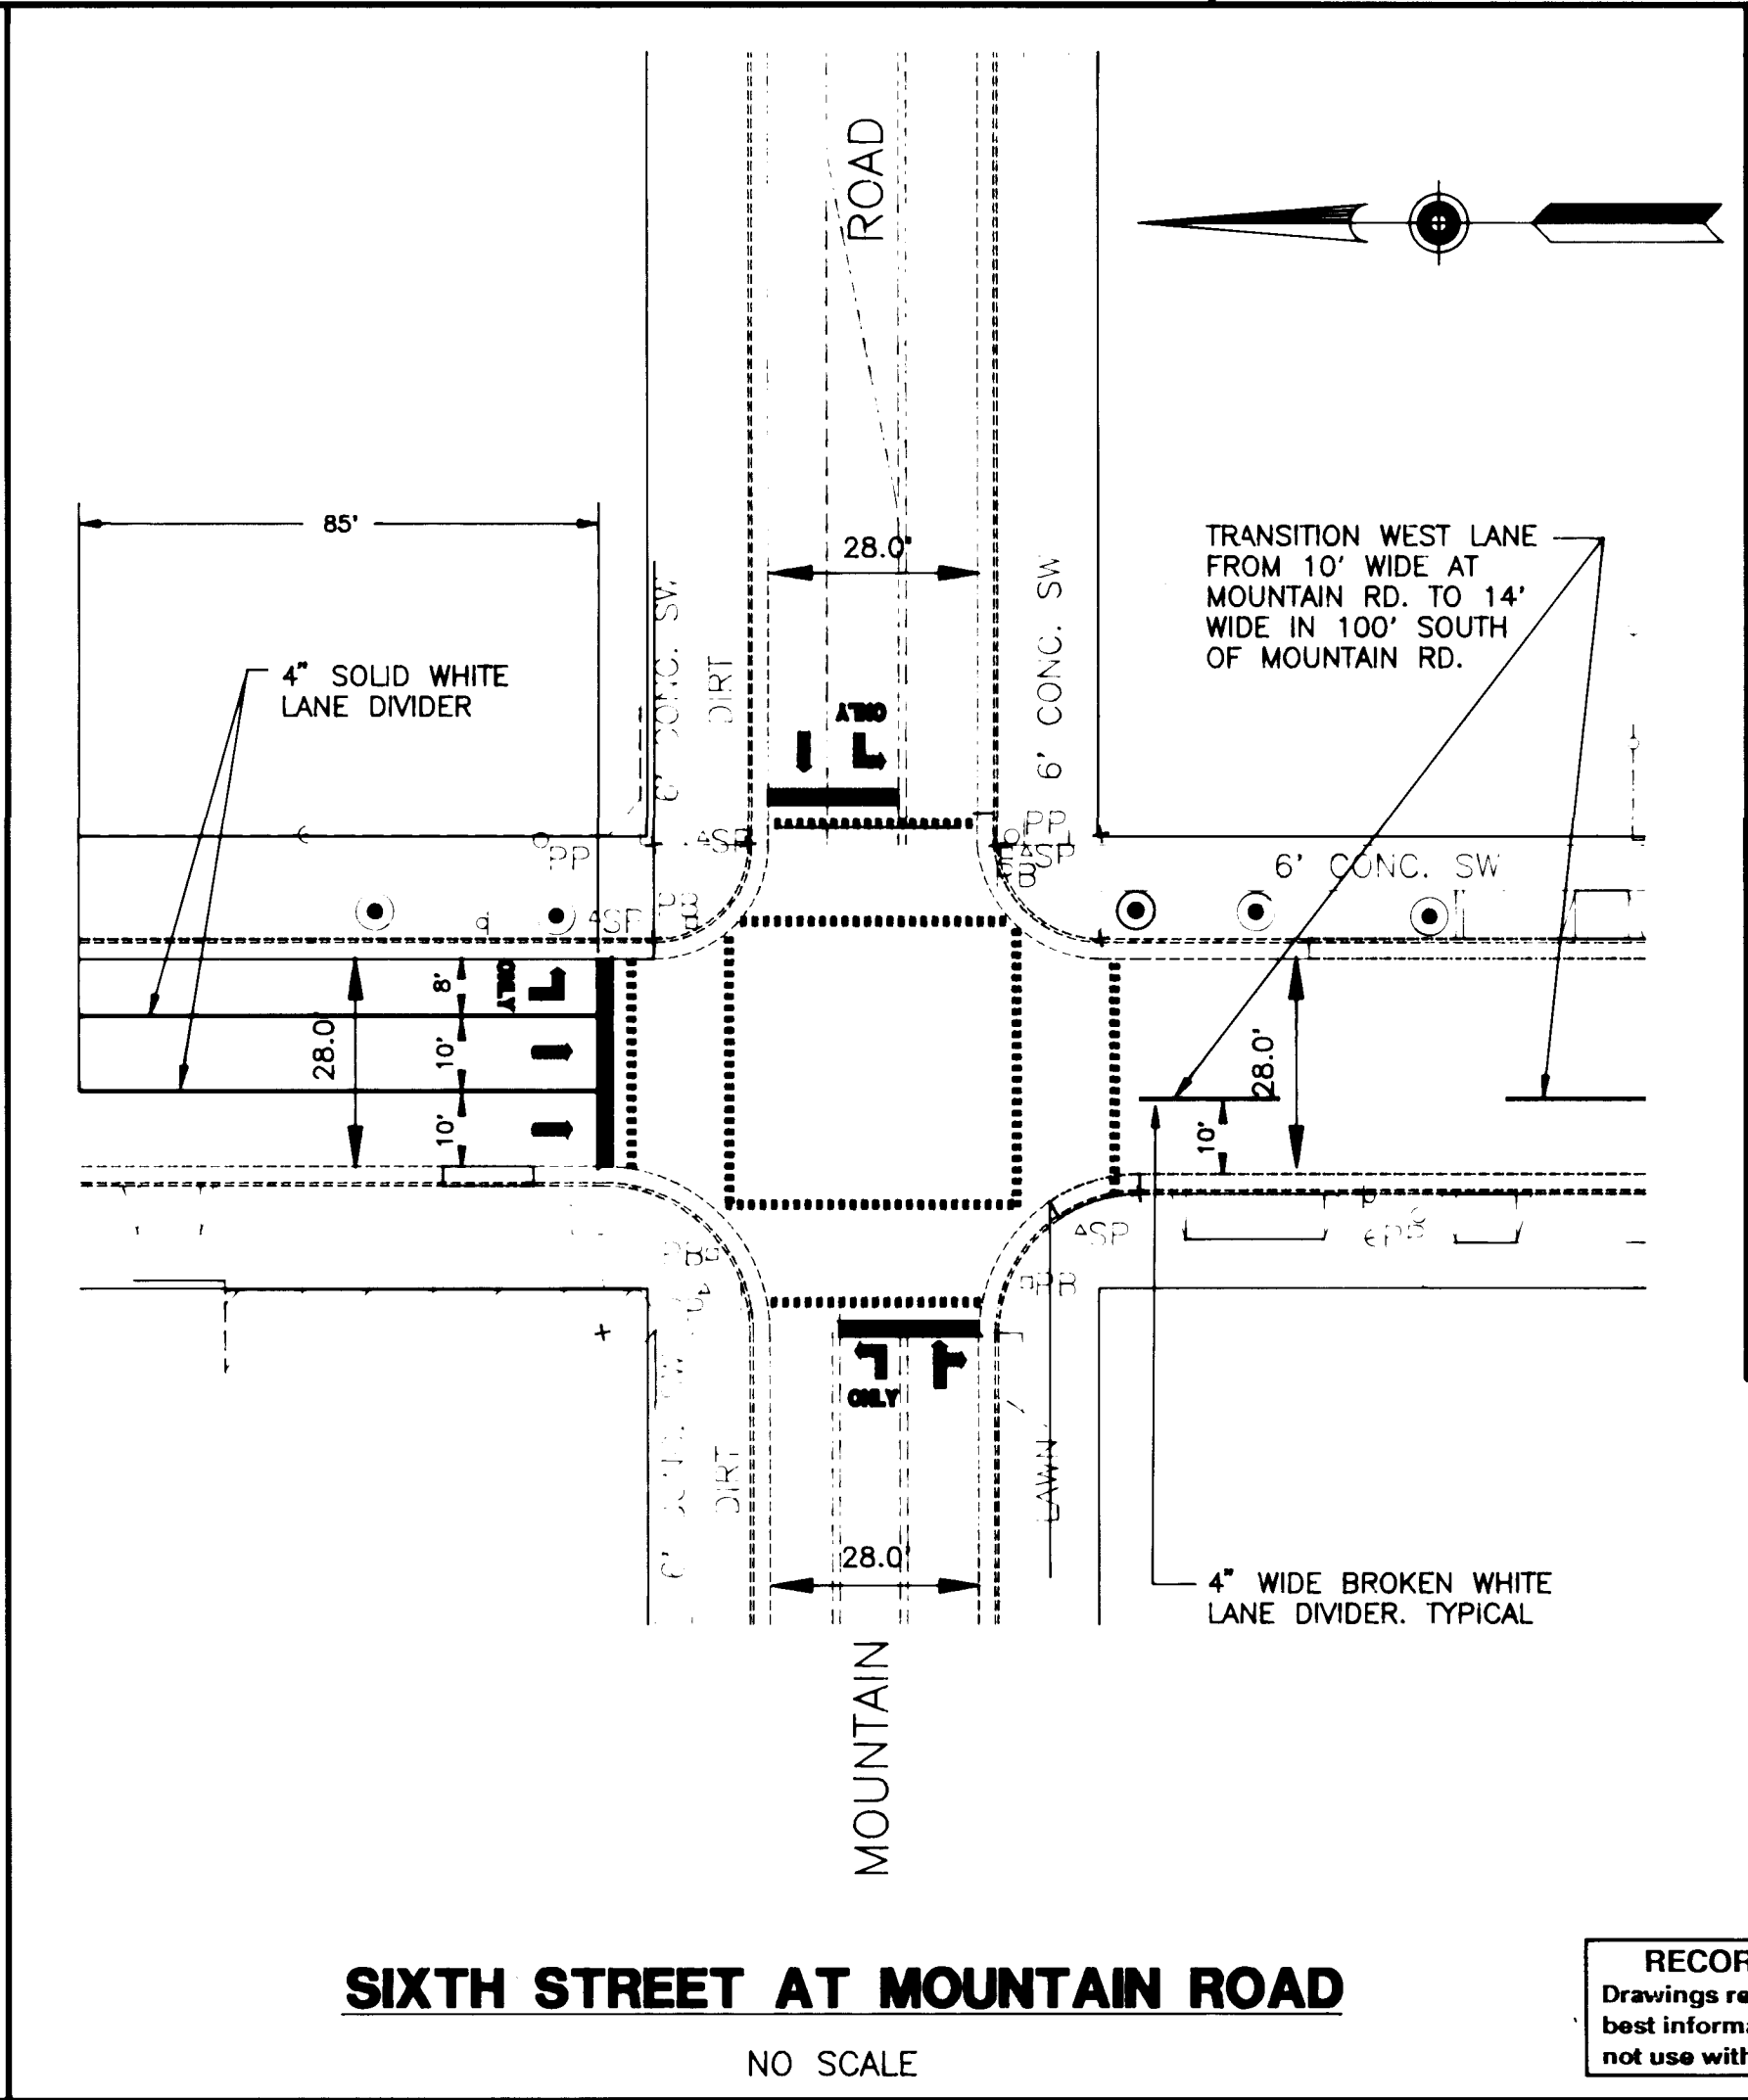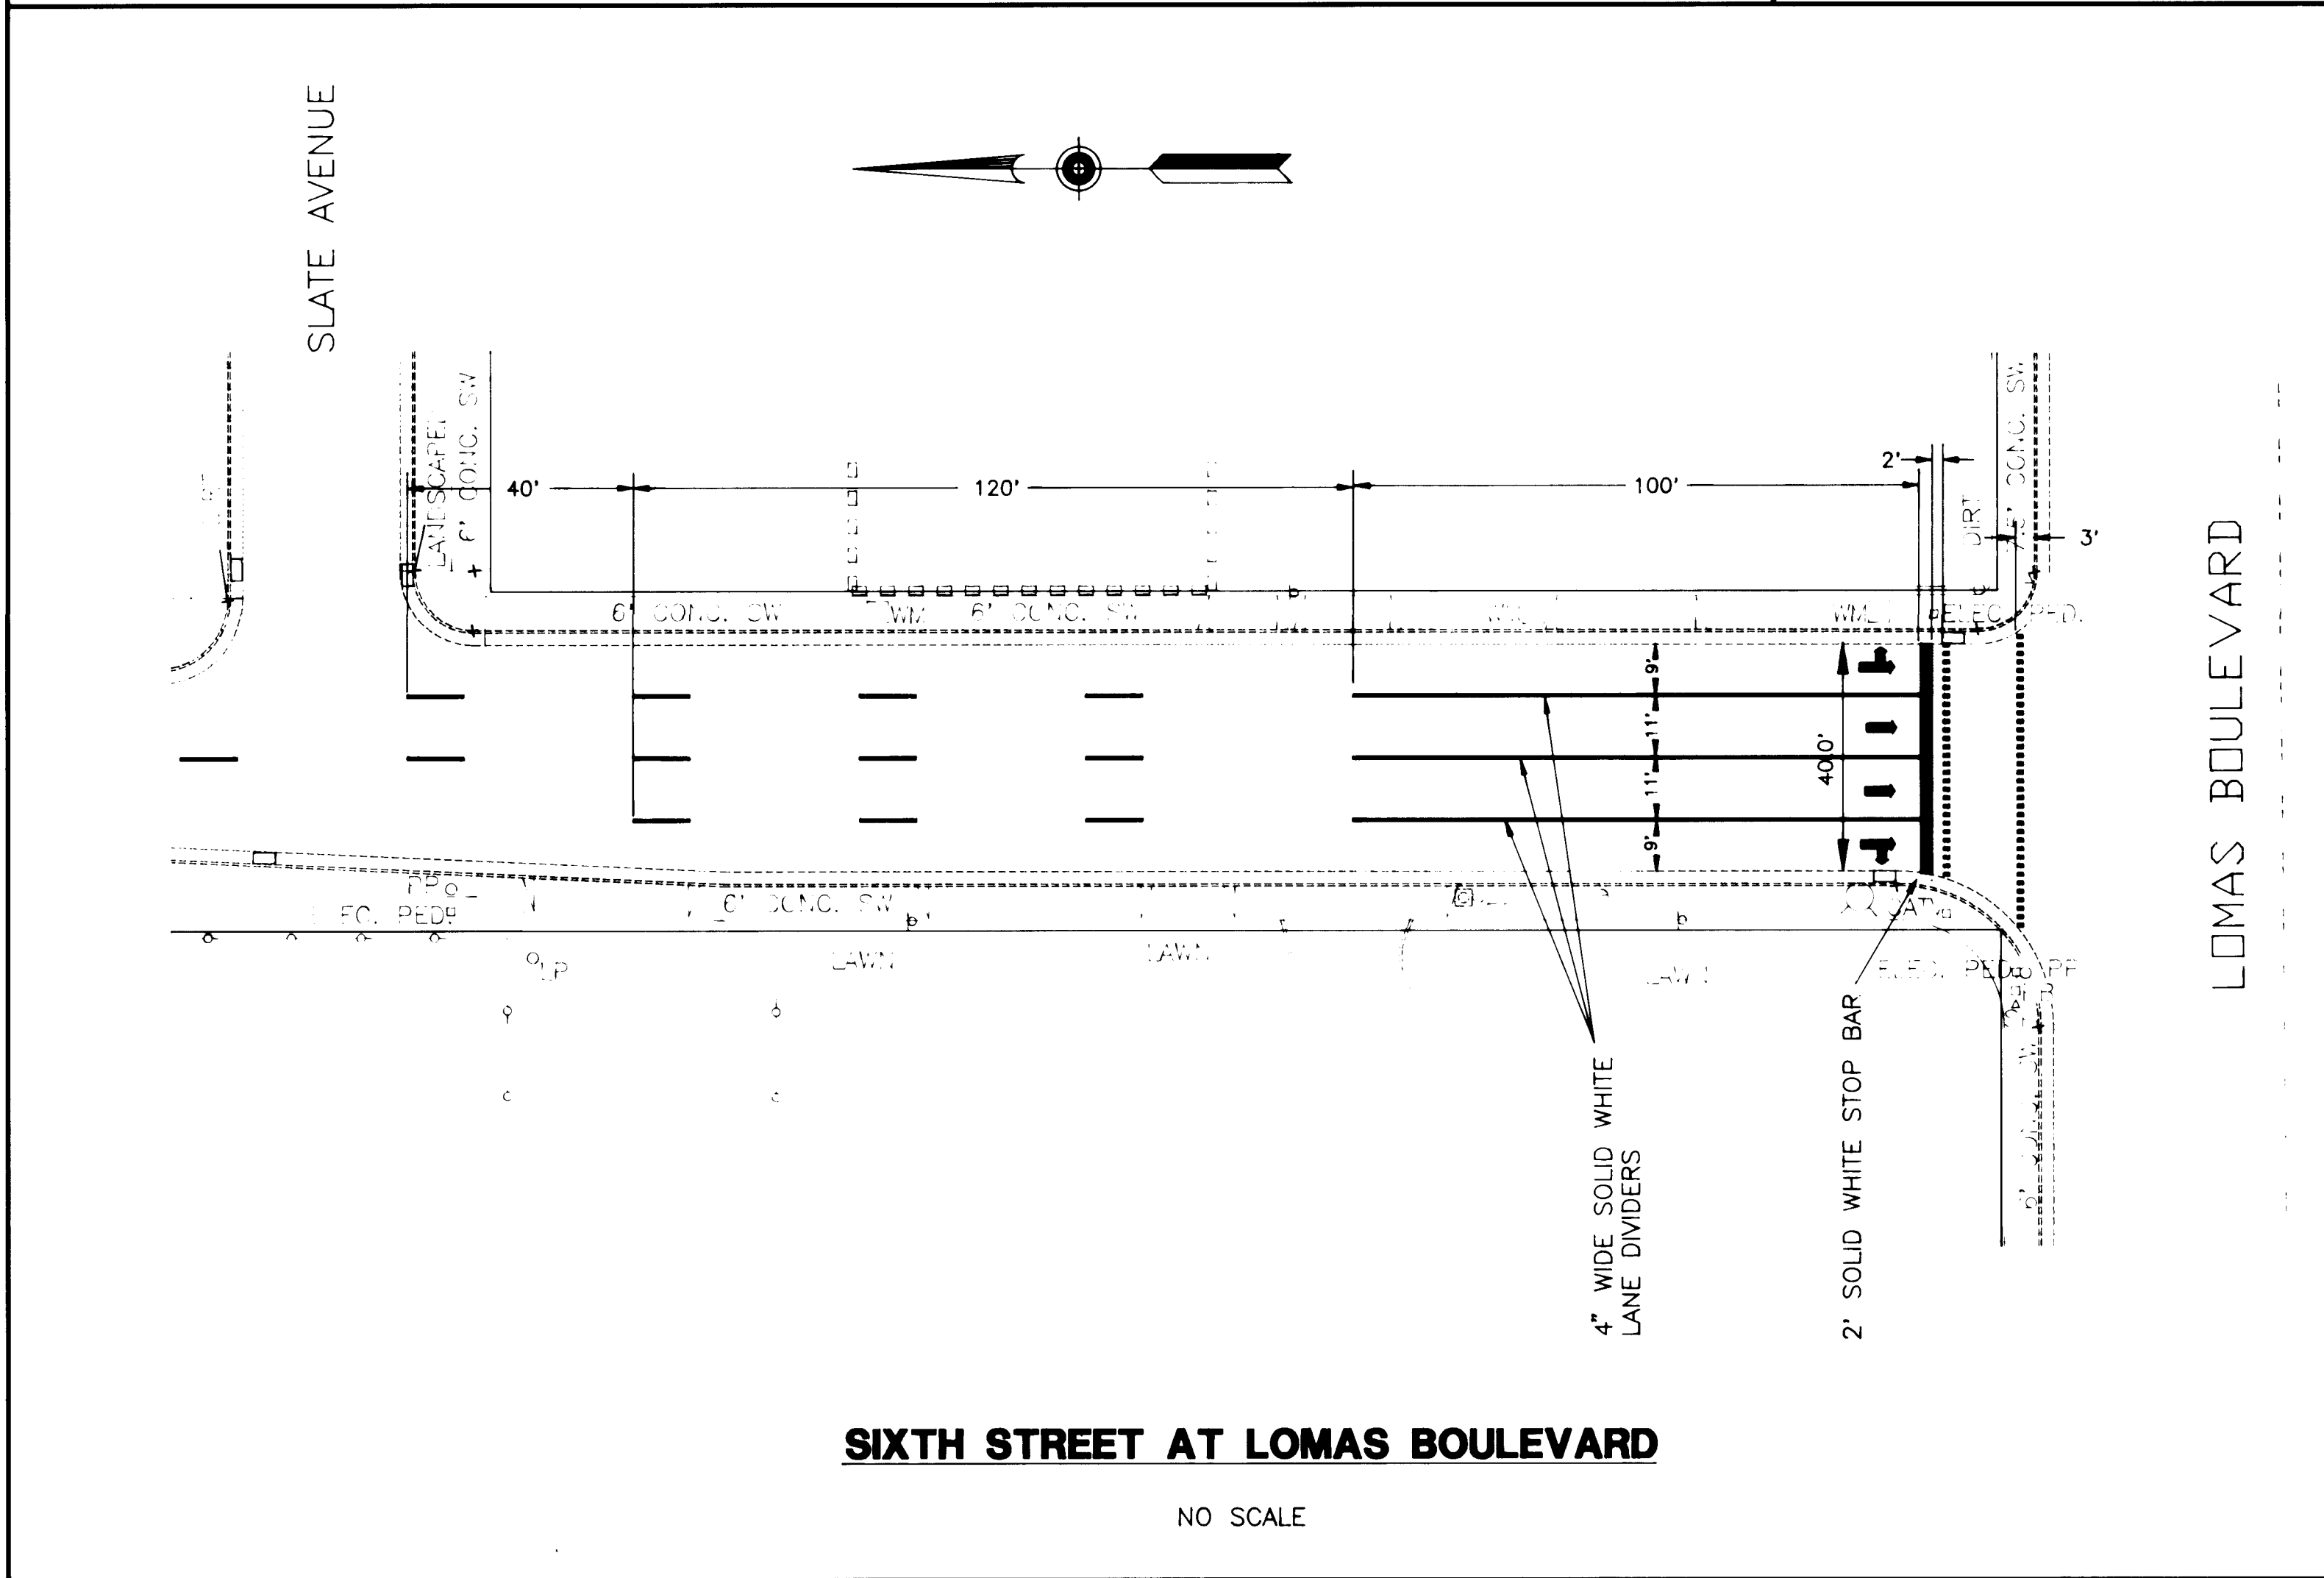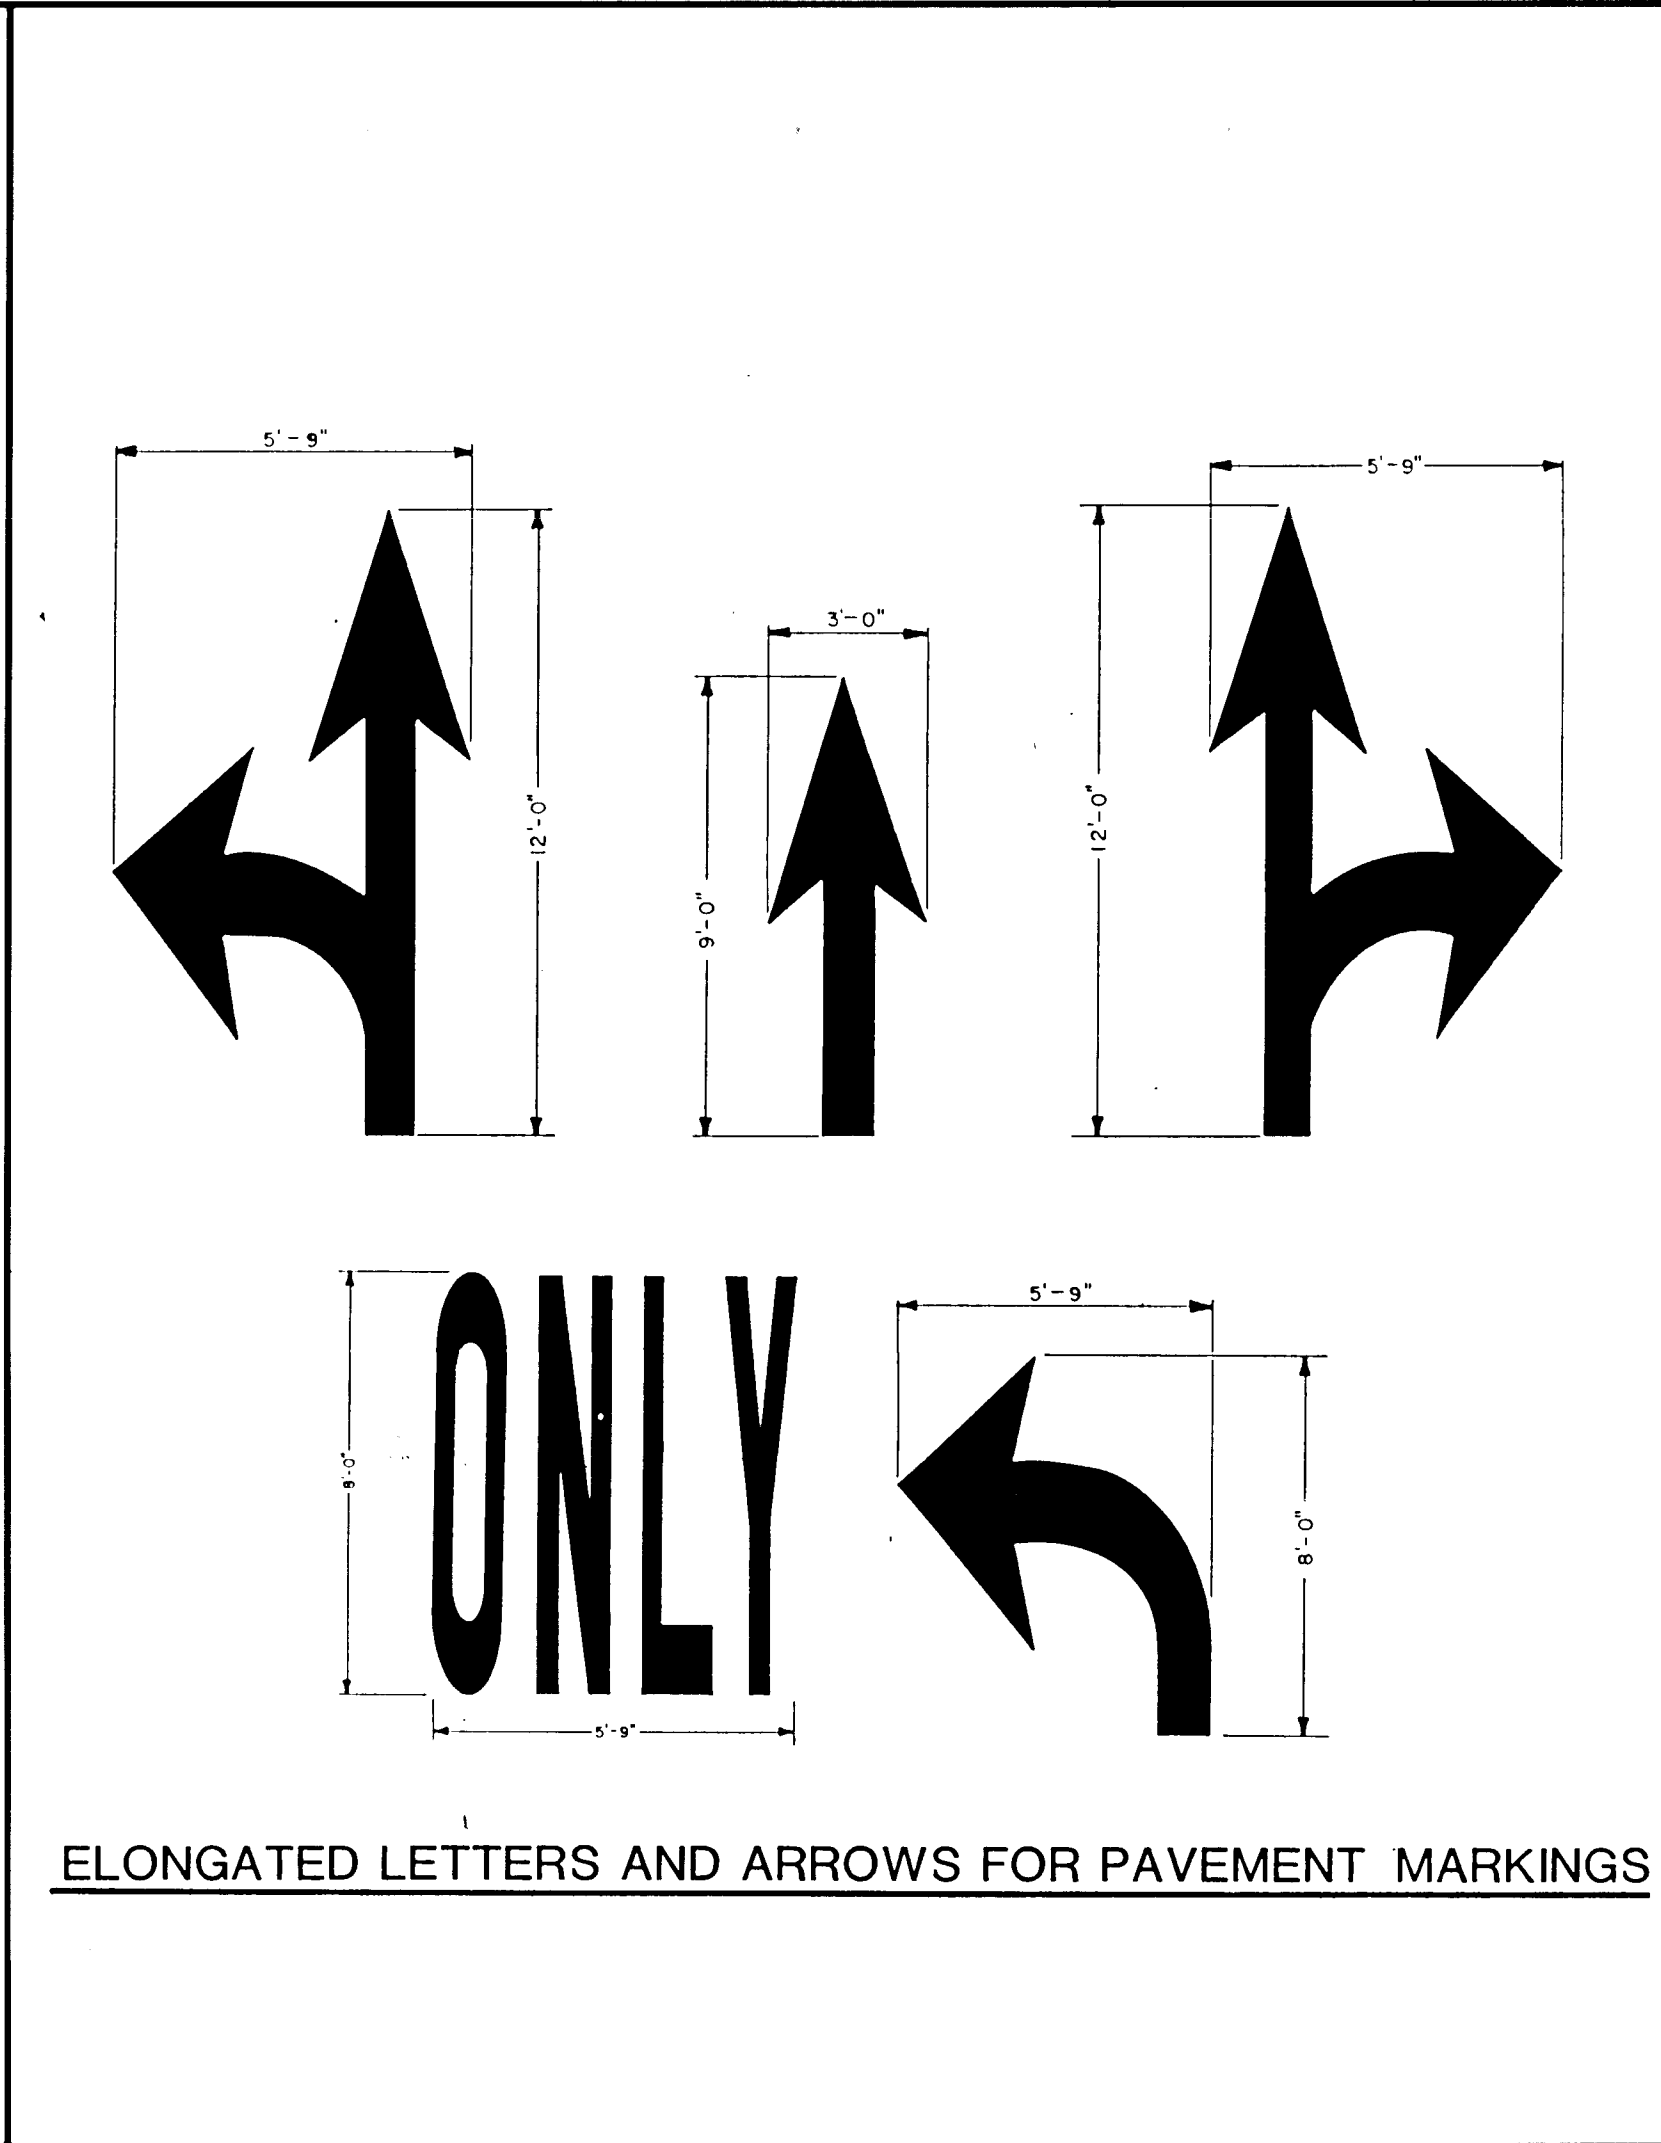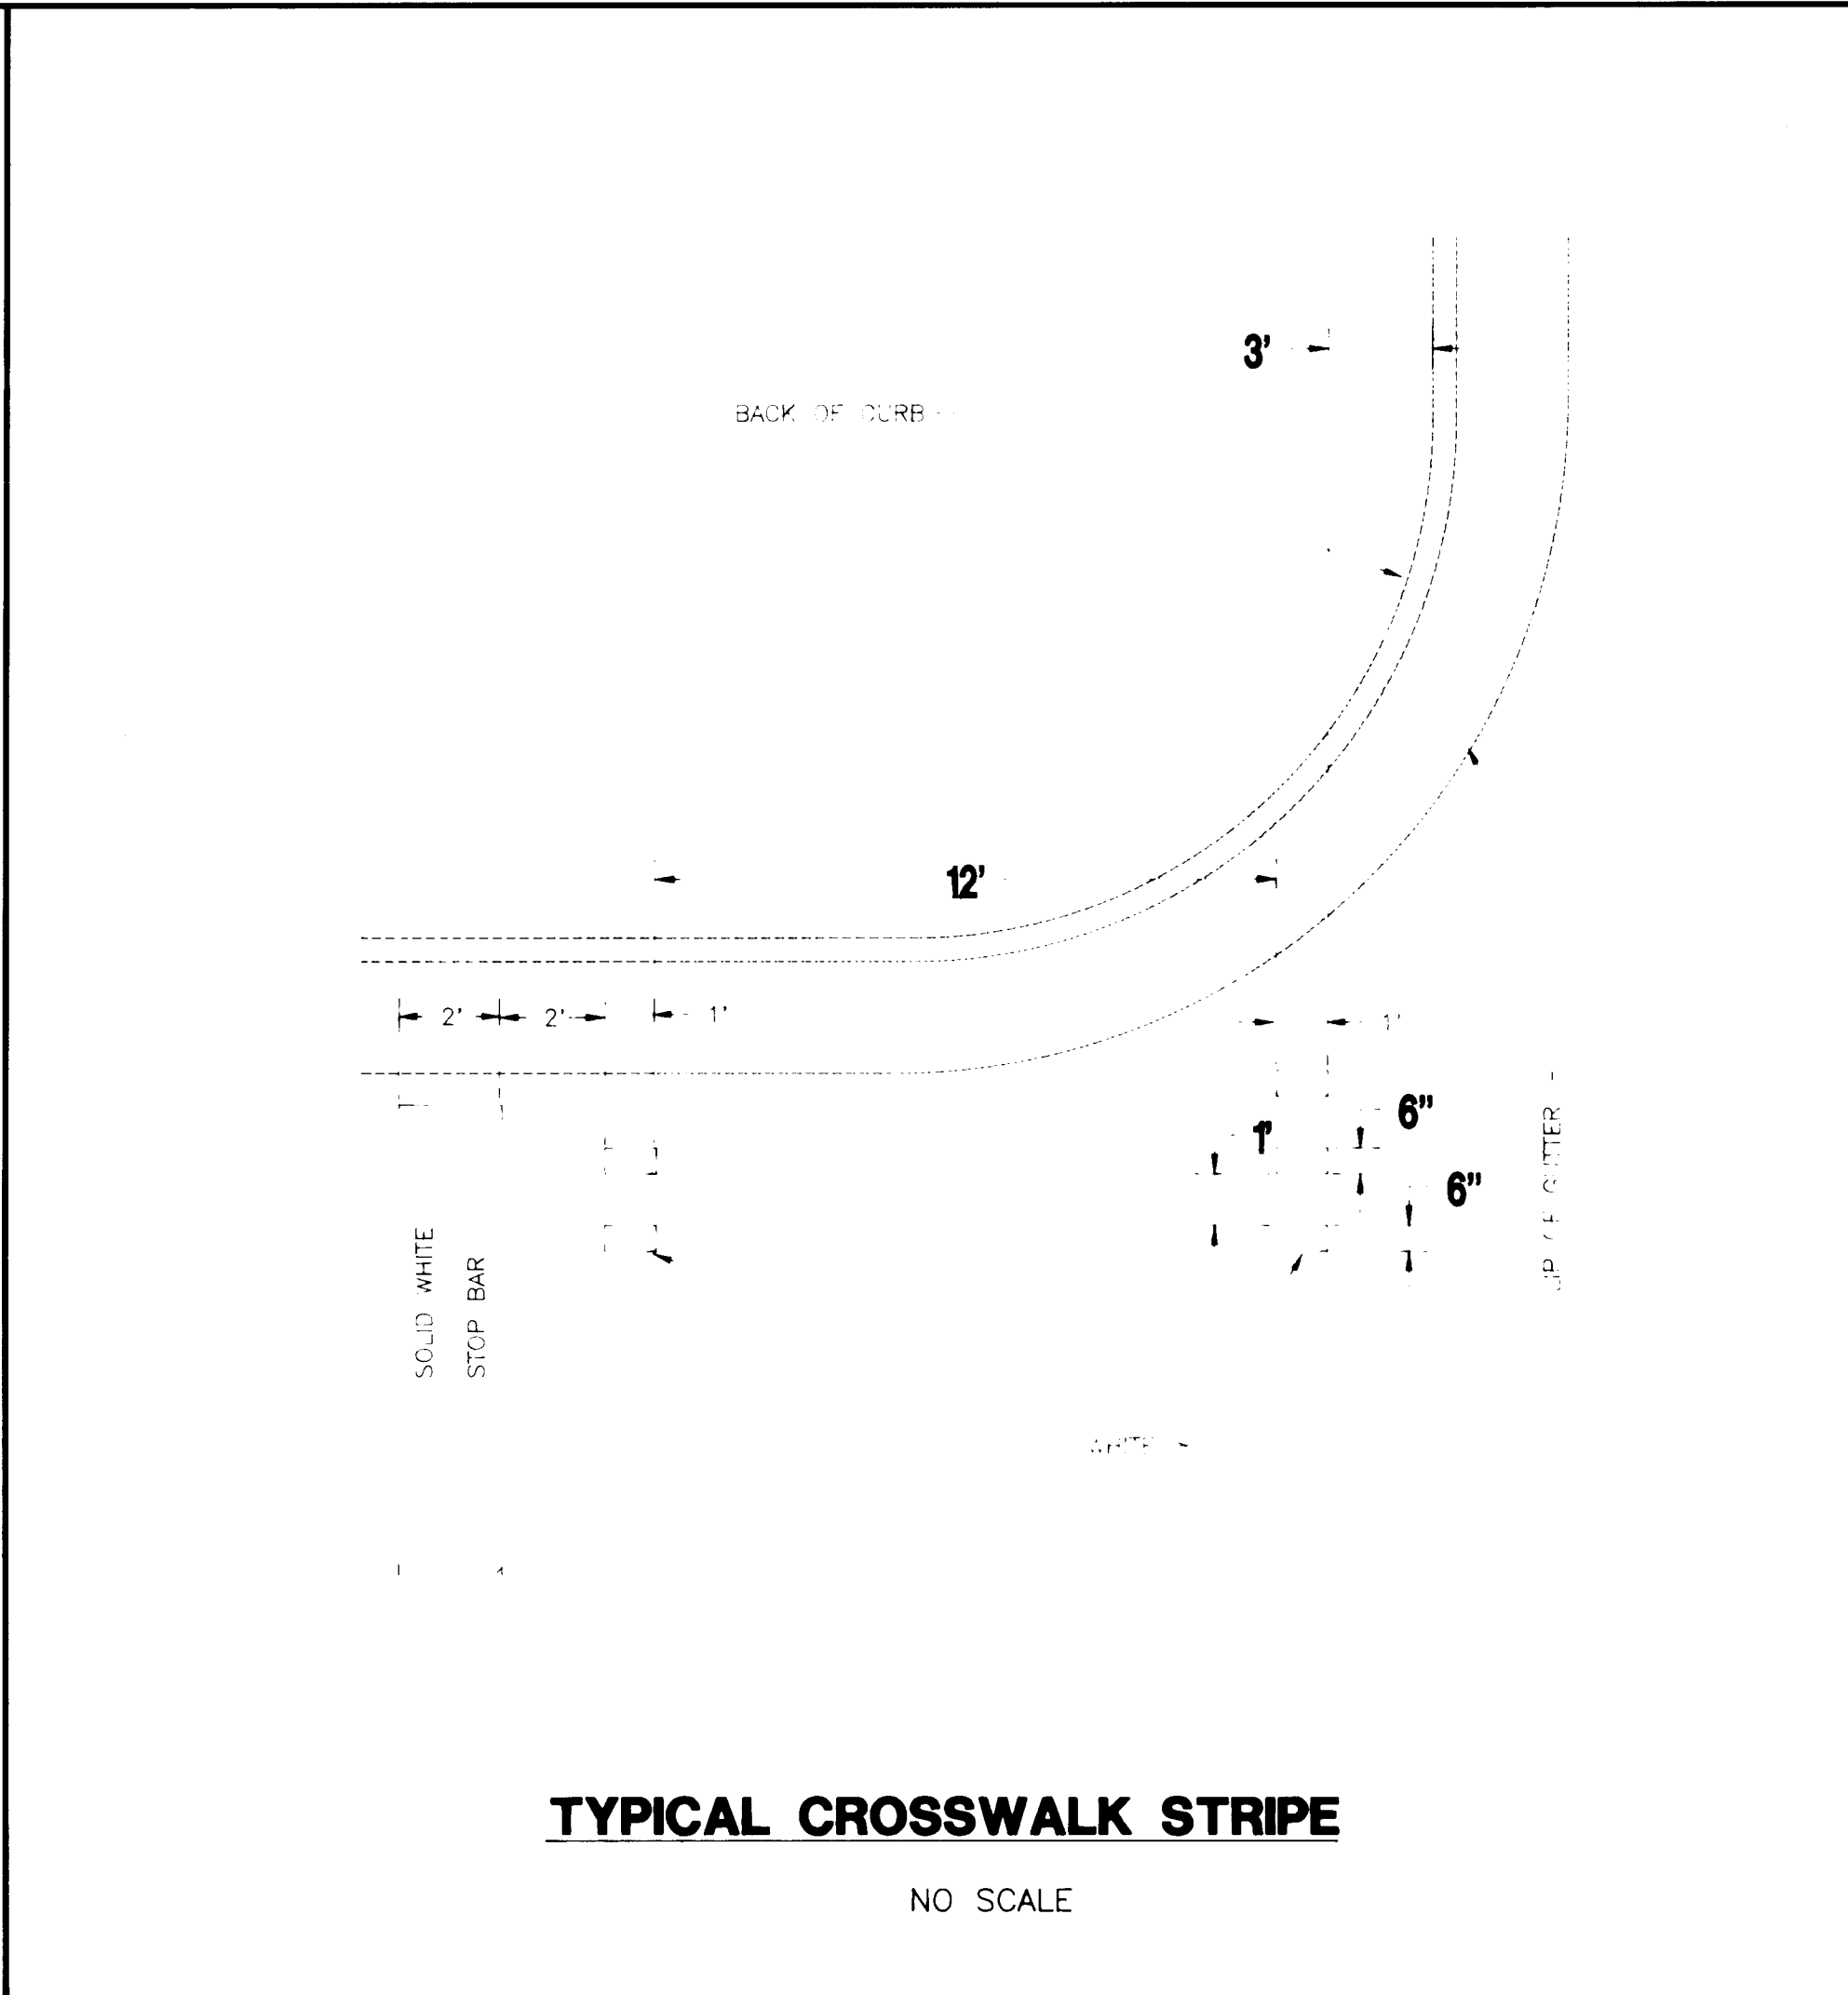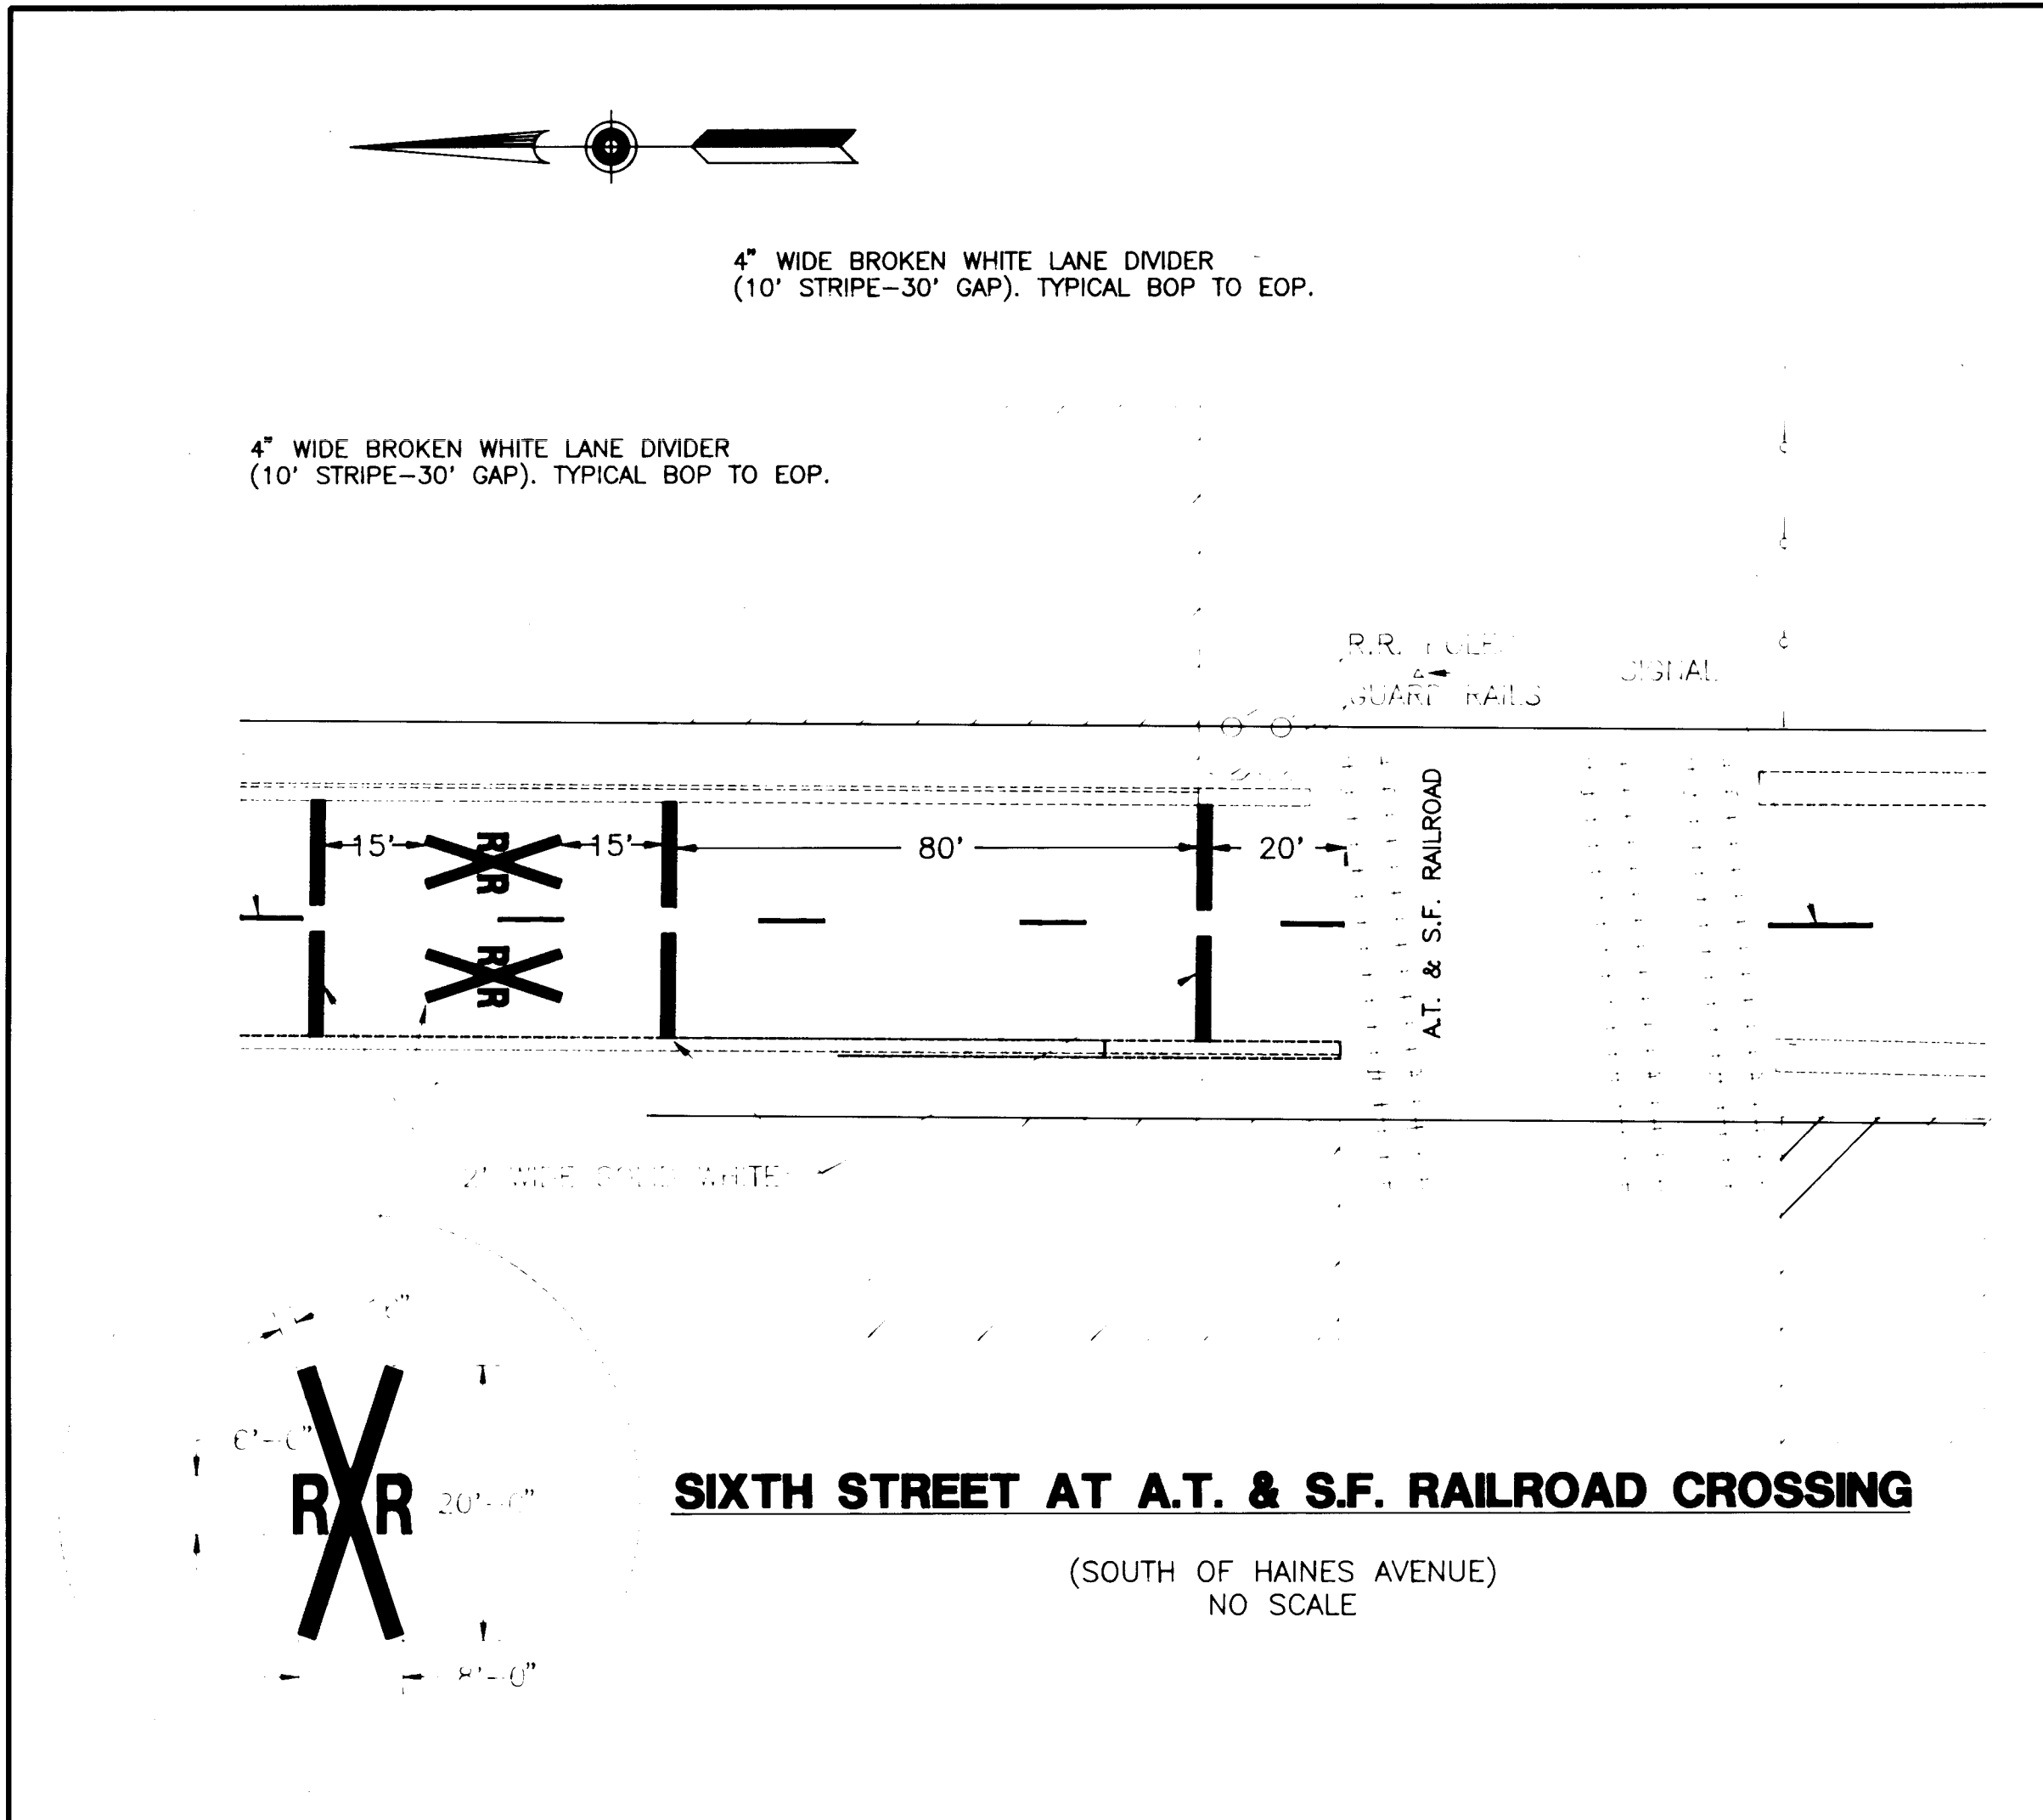

NOTES:

ALL PERMANENT PAVEMENT MARKINGS SHALL BE WHITE IN COLOR. IF PAINTED STRIPES ARE UTILIZED, THEY SHALL BE PAINTED TWICE IN ACCORDANCE WITH SECTION 704, NEW MEXICO STATE HIGHWAY DEPARTMENT "STANDARD SPECIFICATIONS FOR ROAD AND BRIDGE CONSTRUCTION"-1984 EDITION.

ALL PERMANENT PAVEMENT MARKINGS SHALL BE PLACED IN ACCORDANCE WITH THE "MANUAL OF UNIFORM TRAFFIC CONTROL DEVICES", 19TH OR LATEST EDITION.

THE CONTRACTOR WILL BE RESPONSIBLE FOR PLACING ALL PERMANENT PAVEMENT MARKINGS PRIOR TO OPENING ANY PORTION OF THE ROADWAY TO VEHICULAR TRAFFIC. THIS WILL INCLUDE THE REPLACEMENT OF ALL EXISTING PAVEMENT MARKINGS WHICH WERE IN PLACE AT THE TIME OF CONSTRUCTION COMMENCEMENT. THE CONTRACTOR WILL BE RESPONSIBLE FOR REMOVAL AND REPLACING OF ALL PERMANENT TRAFFIC CONTROL DEVICES AS APPROPRIATE DURING AND AFTER CONSTRUCTION, SUCH AS ONE WAY AND NO PARKING SIGNS.

RECORD DRAWING
Drawings revised to reflect the best information available. Do not use without field verification.

CITY OF ALBUQUERQUE
MUNICIPAL DEVELOPMENT DEPARTMENT
ENGINEERING DIVISION

TITLE: **SIXTH STREET IMPROVEMENTS**
PERMANENT STRIPING DETAILS

APPROVALS	ENGINEER	DATE	APPROVALS	ENGINEER	DATE
City Engineer	<i>[Signature]</i>	4/27/89	Liquid Waste	<i>[Signature]</i>	4/27/89
A.C.E.-Design	<i>[Signature]</i>	4/27/89	Traffic	<i>[Signature]</i>	4/27/89
A.C.E.-Hydrology	<i>[Signature]</i>	4/27/89	Water	<i>[Signature]</i>	4/27/89


DESIGNED BY	DATE	DATE	DATE
LDR-SAM-DW	MAY 1989	MAY 1989	MAY 1989
DRAWN BY	RKA-JTN		
CHECKED BY	MWW		

NO.	DATE	REMARKS	BY
1			
2			
3			
4			
5			
6			
7			
8			
9			
10			
11			
12			

AS BUILT INFORMATION	BENCH MARKS	SURVEY INFORMATION	ENGINEER'S SEAL
CONTRACTOR: RUS PITNEY WORKED BY: CITY OF ALBUQUERQUE ACCEPTANCE BY: [Signature] DATE: [Date] DRAWINGS: [Signature] DATE: [Date] CORRECTED BY: GANNETT FLEMING DATE: [Date] MICRO-FILM INFORMATION RECORDED BY: [Signature] DATE: [Date] NO. [Number]		FIELD NOTES NO. [Number] BY [Signature] DATE [Date]	ENGINEER'S SEAL [Signature] [Stamp]

DRAWING NO.	MAP NO.	SHEET	OF
3568	J-14	12	22


NOTE: GAS LINE WAS REPLACED BY GAS CO.
A 4' BURY WAS STANDARD UNLESS SAS
OR STORM SEWER CONFLICT WAS
ANTICIPATED. A LOCATER STRIP IS IN PLACE.

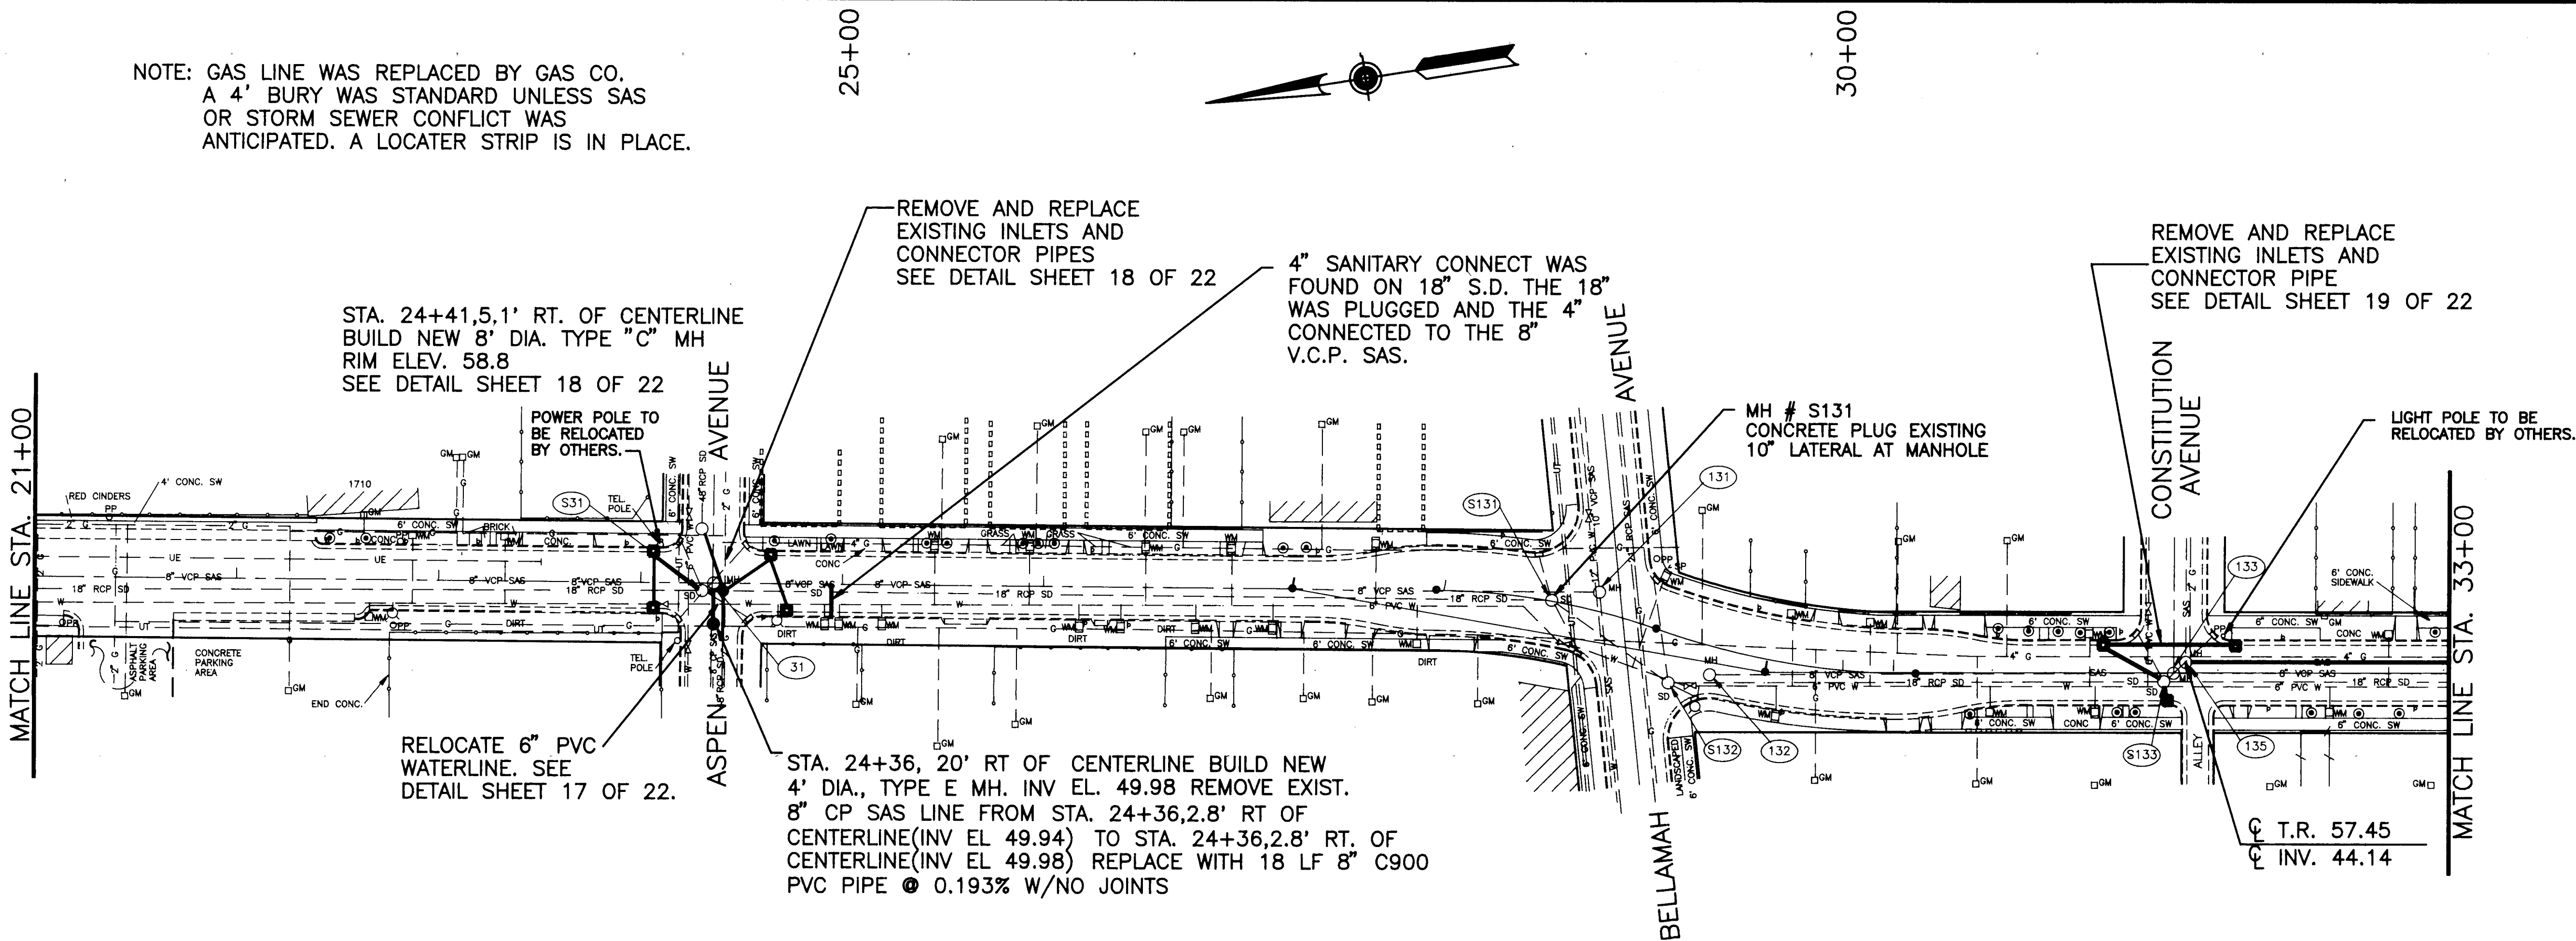

SIXTH STREET NW

PLAN
SCALE: 1"=50'
PROFILE
SCALE: 1"=50' Horiz.
1"=5' Vert.

NOTE
WHERE TWO OR MORE UTILITIES HAVE LESS THAN SIX INCHES
OF VERTICAL CLEARANCE, THE AREA BETWEEN THE UTILITIES SHALL BE
FILLED COMPLETELY WITH HIGH DENSITY EXPANSION JOINT
MATERIAL.

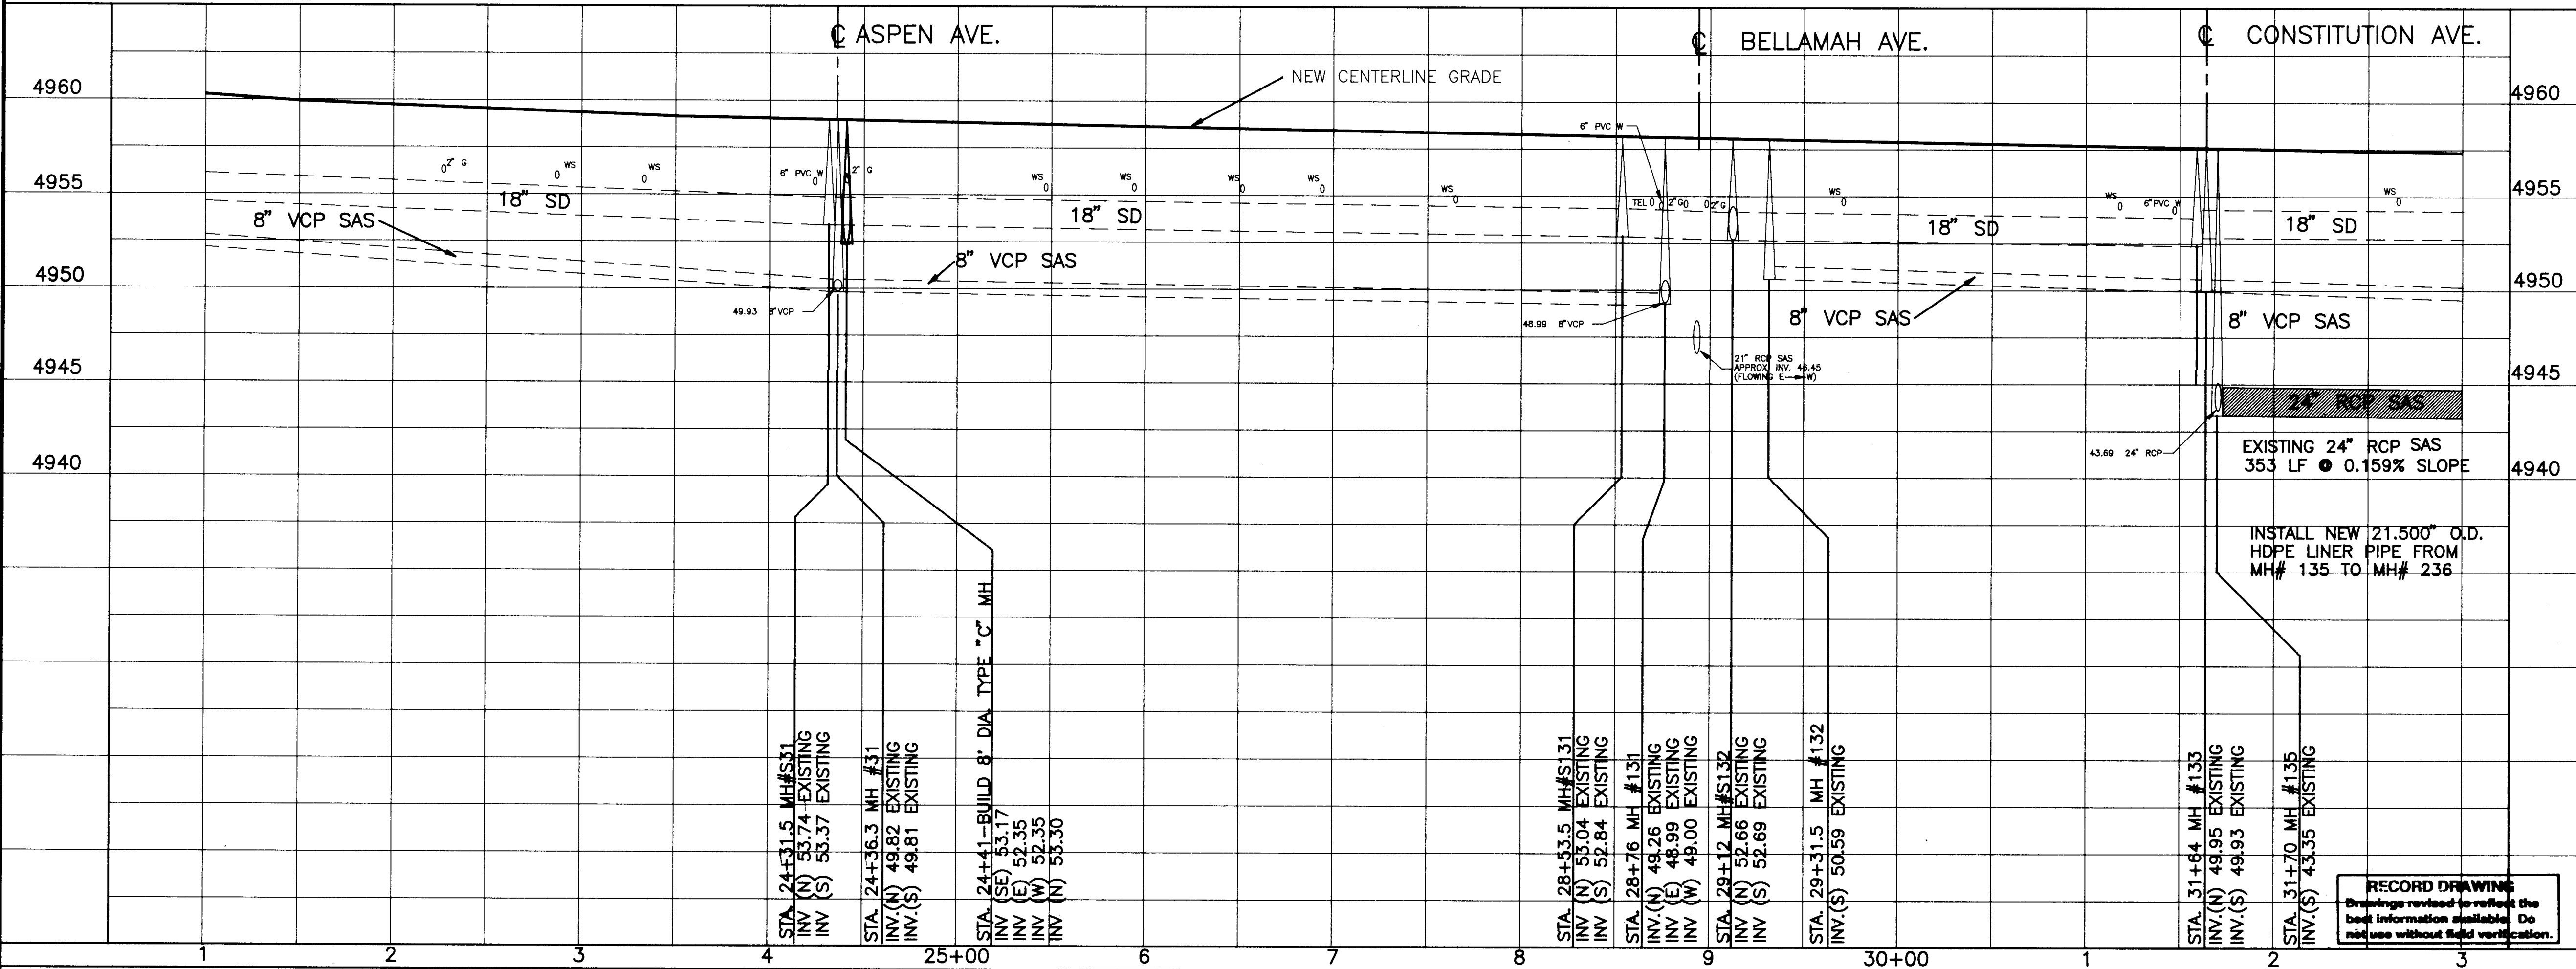

LEGEND

- REMOVAL AND REPLACEMENT OF SANITARY SEWER
- SLIPLINE OR INVERSION LINE SANITARY SEWER
- EXISTING WATER SERVICE (PROFILE)
- EXISTING C & G
- EXISTING SANITARY SEWER
- EXISTING WATER LINE
- EXISTING GAS LINE
- EXISTING STORM DRAIN
- EXISTING UNDERGROUND TELEPHONE LINE
- EXISTING UNDERGROUND ELECTRICAL LINE
- EXISTING UNDERGROUND CABLE TV LINE
- EXISTING TRAFFIC SIGNAL CONDUIT
- EXISTING TELEPHONE BOX
- EXISTING STORM DRAIN MANHOLE
- EXISTING SANITARY SEWER MANHOLE
- EXISTING WATER VALVE
- EXISTING WATER METER
- EXISTING GAS VALVE
- EXISTING GAS METER
- EXISTING FIRE HYDRANT
- POWER POLE
- PEDESTAL SIGNAL
- PULL BOX
- LIGHT POLE
- EXISTING STORM INLET
- EXISTING TREE/SHRUB

BENCH MARKS		AS BUILT INFORMATION	
16-J14, CITY OF ALBUQUERQUE	DATE	CONTRACTOR RUSS PITNEY	DATE
ON NW CURB RETURN	DATE	SUBMITTALS	DATE
INTERSECTION OF FOURTH AND CONSTITUTION NW	DATE	ACCEPTANCE BY	DATE
ELEV. = 4958.194	DATE	DESIGNED BY	DATE
TBM, NW BONNET BOLT ON FIRE HYDRANT @ SW CORNER OF SIXTH AND ASPEN NW	DATE	CHECKED BY	DATE
ELEV. = 4960.62	DATE	NO.	DATE

SURVEY INFORMATION		ENGINEER'S SEAL	
NO.	DATE	BY	DATE
BY	DATE	REVISIONS	DATE
DESIGNED BY	DATE	DESIGN	DATE
DRAWN BY	DATE	REVISIONS	DATE
CHECKED BY	DATE	REVISIONS	DATE


CITY OF ALBUQUERQUE
PUBLIC WORKS DEPARTMENT

TITLE: **SIXTH STREET IMPROVEMENTS**
UTILITIES
STA. 21+00 TO STA. 33+00

APPROVALS	ENGINEER	DATE	APPROVALS	ENGINEER	DATE
City Engineer	<i>[Signature]</i>	5/15/89	Liquid Waste	<i>[Signature]</i>	5/15/89
A.C.E.-Design	"	"	Traffic	<i>[Signature]</i>	5/15/89
A.C.E.-Hydrology	"	"	Water	<i>[Signature]</i>	5/15/89

DESIGNED BY: LDR-SAM-DW DATE: MAY 1989
DRAWN BY: RKA-JTN DATE: MAY 1989
CHECKED BY: MMW DATE: MAY 1989


DRAWING NO. 3568 MAP NO. J-14 SHEET 14 OF 22

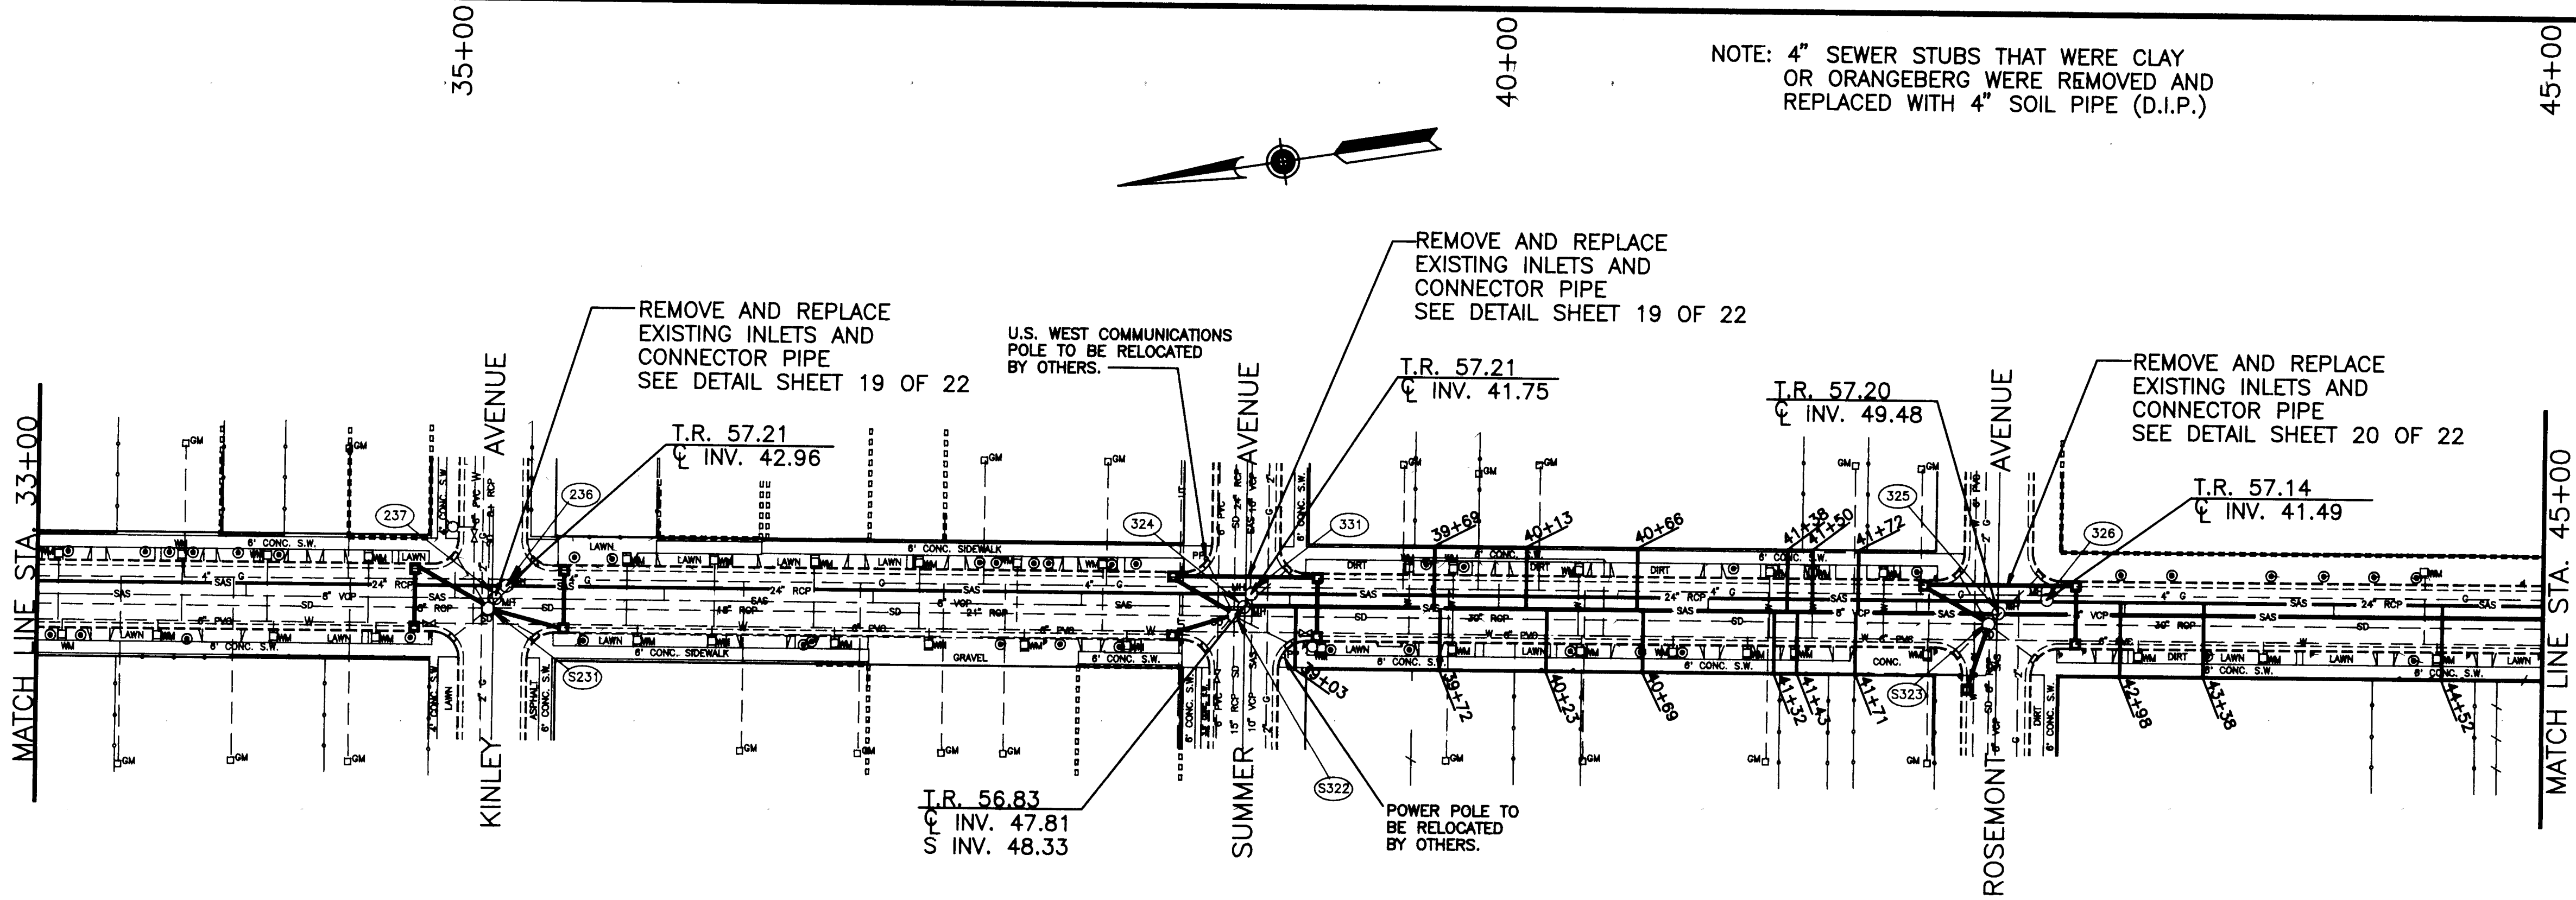

SIXTH STREET NW

PLAN
SCALE: 1"=50'
PROFILE
SCALE: 1"=50' Horiz.
1"=5' Vert.

NOTE
WHERE TWO OR MORE UTILITIES HAVE LESS THAN SIX INCHES
OF VERTICAL CLEARANCE, THE AREA BETWEEN THE UTILITIES SHALL BE
FILLED COMPLETELY WITH HIGH DENSITY EXPANSION JOINT
MATERIAL.

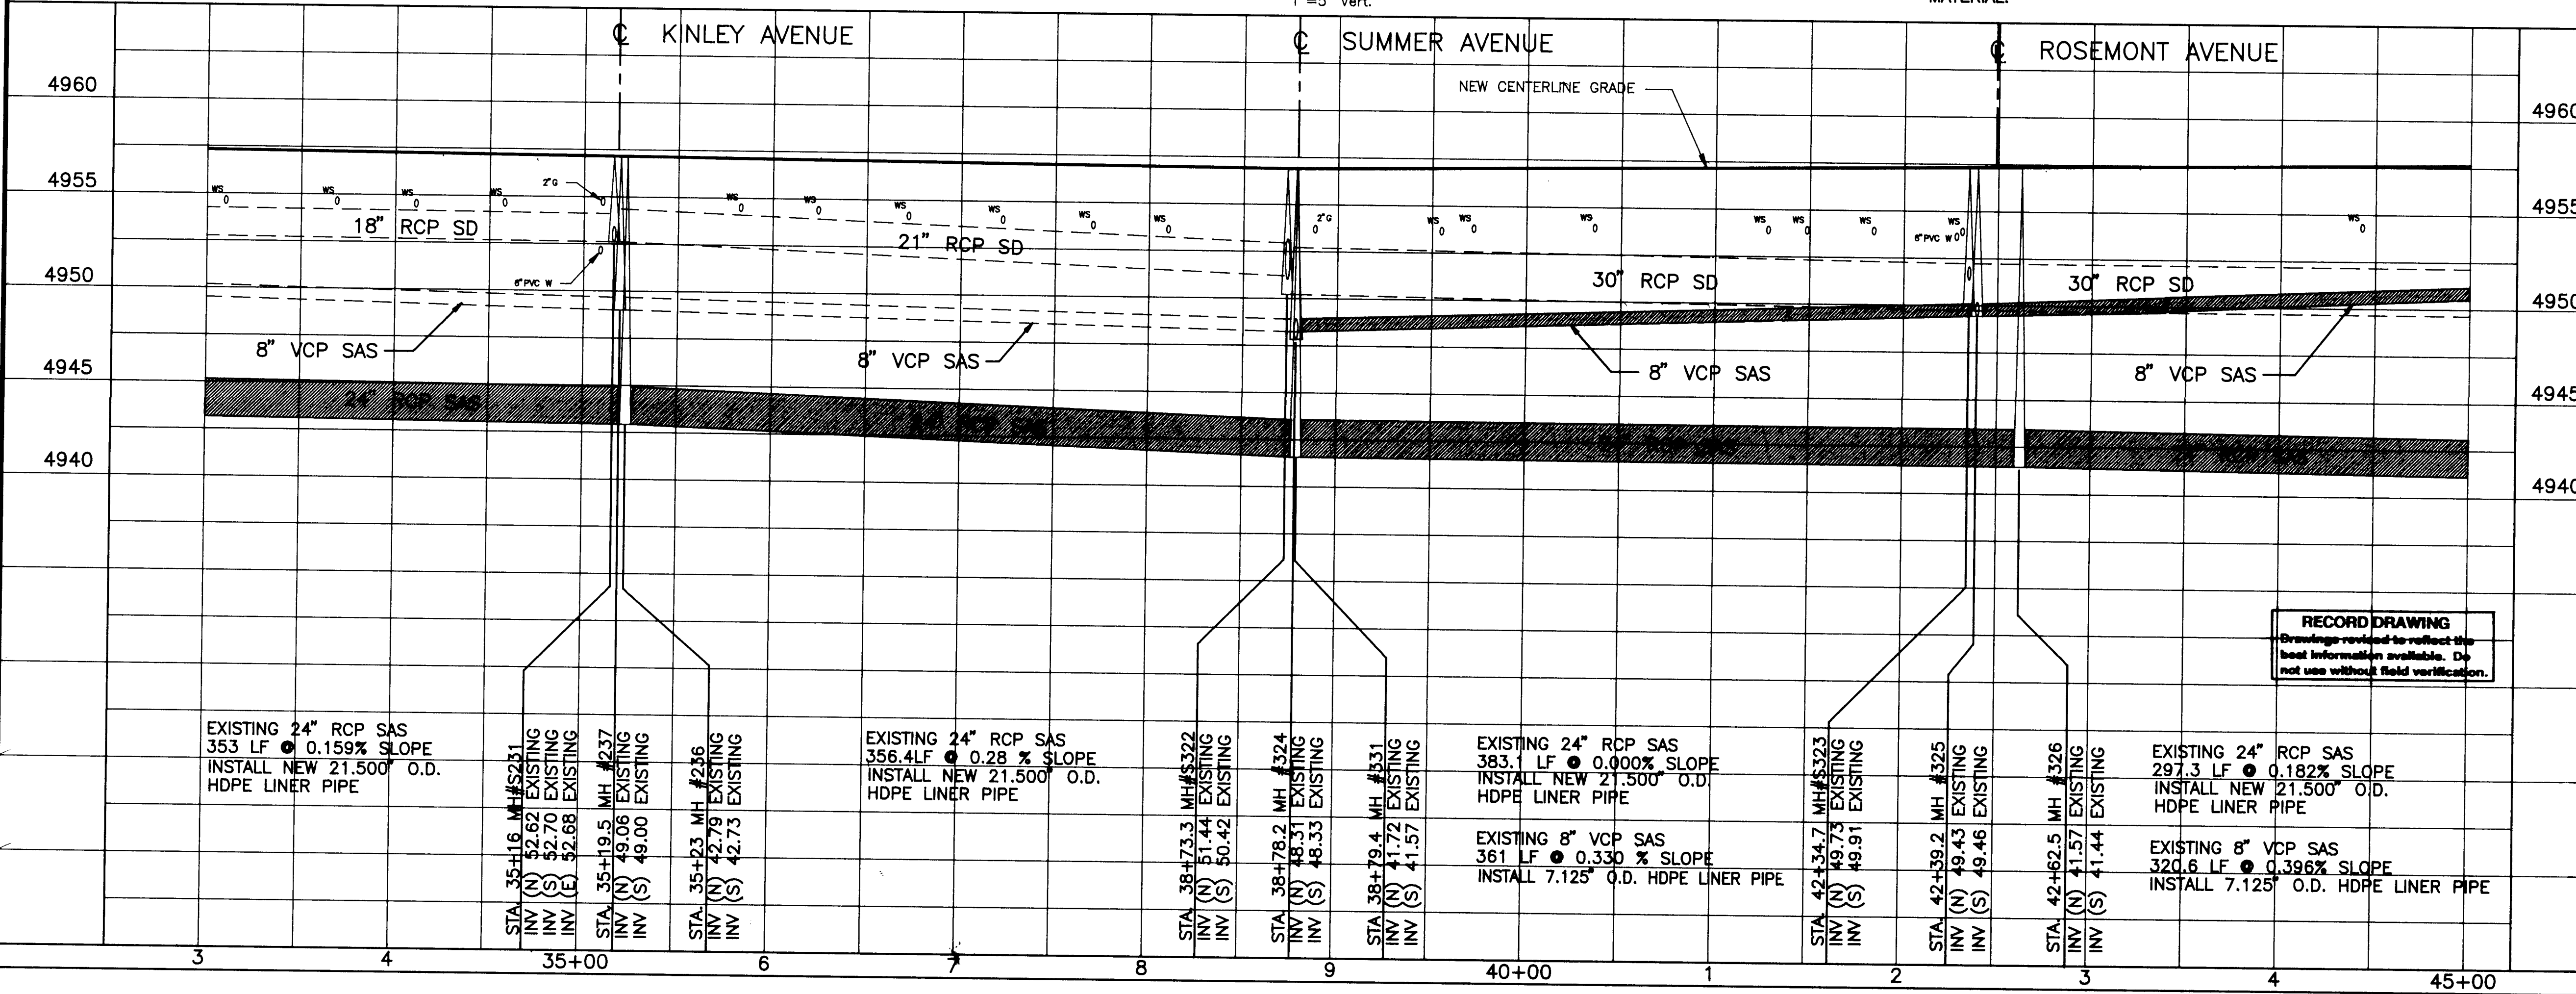

LEGEND

- REMOVAL AND REPLACEMENT OF SANITARY SEWER
- SUPLINE OR INVERSION LINE SANITARY SEWER
- WS₀ EXISTING WATER SERVICE (PROFILE)
- EXISTING C & G
- EXISTING SANITARY SEWER
- EXISTING WATER LINE
- EXISTING GAS LINE
- EXISTING STORM DRAIN
- EXISTING UNDERGROUND TELEPHONE LINE
- EXISTING UNDERGROUND ELECTRICAL LINE
- EXISTING UNDERGROUND CABLE TV LINE
- EXISTING TRAFFIC SIGNAL CONDUIT
- EXISTING TELEPHONE BOX
- EXISTING STORM DRAIN MANHOLE
- EXISTING SANITARY SEWER MANHOLE
- EXISTING WATER VALVE
- EXISTING WATER METER
- EXISTING GAS VALVE
- EXISTING GAS METER
- EXISTING FIRE HYDRANT
- POWER POLE
- PEDESTAL SIGNAL
- PULL BOX
- LIGHT POLE
- EXISTING STORM INLET

BENCH MARKS		AS BUILT INFORMATION	
16-14	CITY OF ALBUQUERQUE BM	CONTRACTOR	RUSSELL PITNEY
DATE	11/1/88	INSPECTOR	CITY OF ALBUQUERQUE
BY	INTERSECTION OF FOURTH & CONSTITUTION NW	DATE	DATE
NO.	ELEV. = 4958.194	DATE	DATE
TBM, CHISEL MARK 15'± B/C ON ENE CURB RETURN @ SIXTH AND CONSTITUTION NW		DATE	DATE
ELEV. = 4957.79		DATE	DATE


ENGINEER'S SEAL		REVISIONS	
W.M. MALLOY 83763 PROFESSIONAL ENGINEER		NO.	DATE
DESIGNED BY LDR-SAM-DW		DATE	MAY 1988
DRAWN BY RKA-JTN		DATE	MAY 1988
CHECKED BY MMW		DATE	MAY 1988

CITY OF ALBUQUERQUE
PUBLIC WORKS DEPARTMENT


TITLE: **SIXTH STREET IMPROVEMENTS UTILITIES**
STA. 33+00 TO STA. 45+00

APPROVALS	ENGINEER	DATE	APPROVALS	ENGINEER	DATE
City Engineer	Russell Pitney	4/2/88	Liquid Waste	Russell Pitney	4/2/88
A.C.E.-Design	"	"	Traffic	Russell Pitney	4/2/88
A.C.E.-Hydrology	"	"	Water	Russell Pitney	4/2/88

DRAWING NO. 3568 MAP NO. J-14 SHEET 15 OF 22

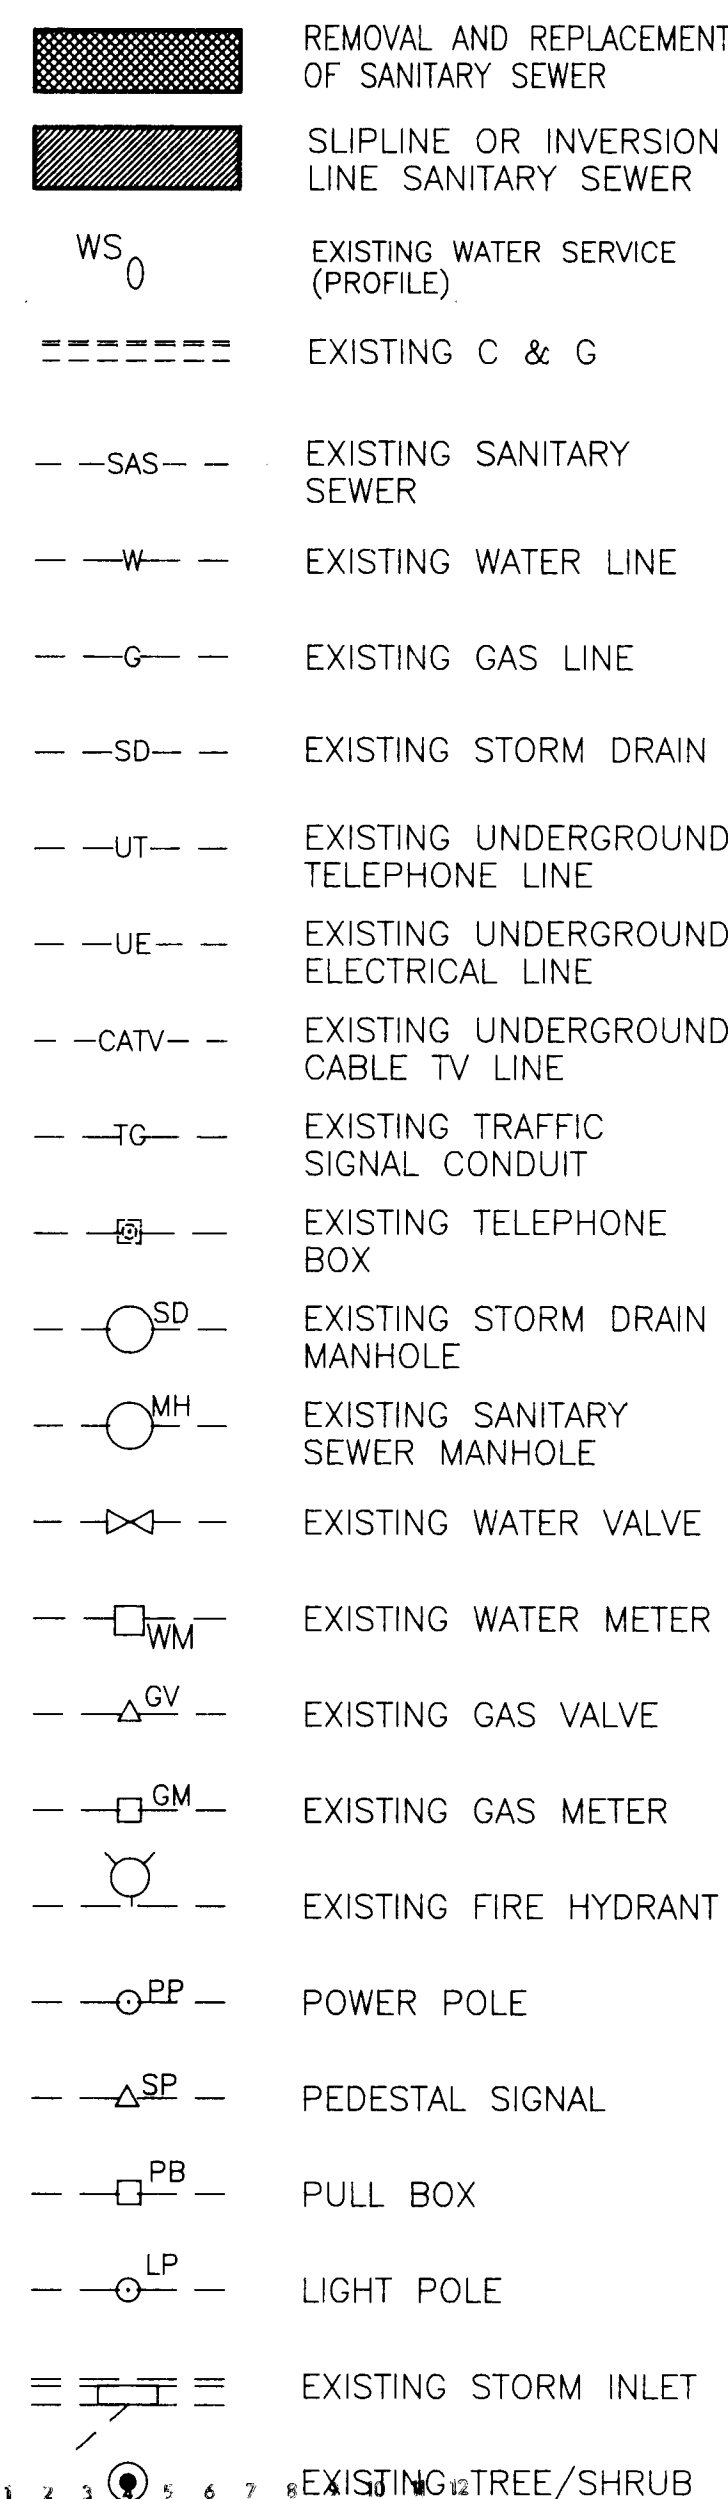

ENGINEER'S SEAL		SURVEY INFORMATION		BENCH MARKS		AS BUILT INFORMATION	
		FIELD NOTES		6-J14. ACS BRASS CAP LOCATED. ●		CONTRACTOR: RUSS PITNEY DATE:	
		BY		DATE		NE CORNER FOURTH & MARQUETTE	
						NW. ELEV. = 4953.129	
						FIELD ACCEPTANCE BY: DATE:	
						DRAWN BY: DATE:	
REMARKS				TBM, N. BONNET BOLT ON FIRE		CORRECTED BY: GANNETT FLEMING DATE:	
DESIGN				HYDRANT ● NW CORNER FIFTH &		MICRO-FILM INFORMATION	
DESIGNED BY LDR-SAM-DW		DATE MAY 1989		MARBLE NW, ELEV. 4957.28		RECORDED BY: DATE:	
DRAWN BY RKA-JTN		DATE MAY 1989				NO.	
CHECKED BY MMW		DATE MAY 1989					
APPROVE		PARTMENT					
MOVEMENTS							
56+00							
VALS	ENGINEER	DATE					
Waste	<i>[Signature]</i>	9/21/89					
	<i>[Signature]</i>	9/21/89					
	<i>[Signature]</i>	9/21/89					
SHEET		OF		16		22	

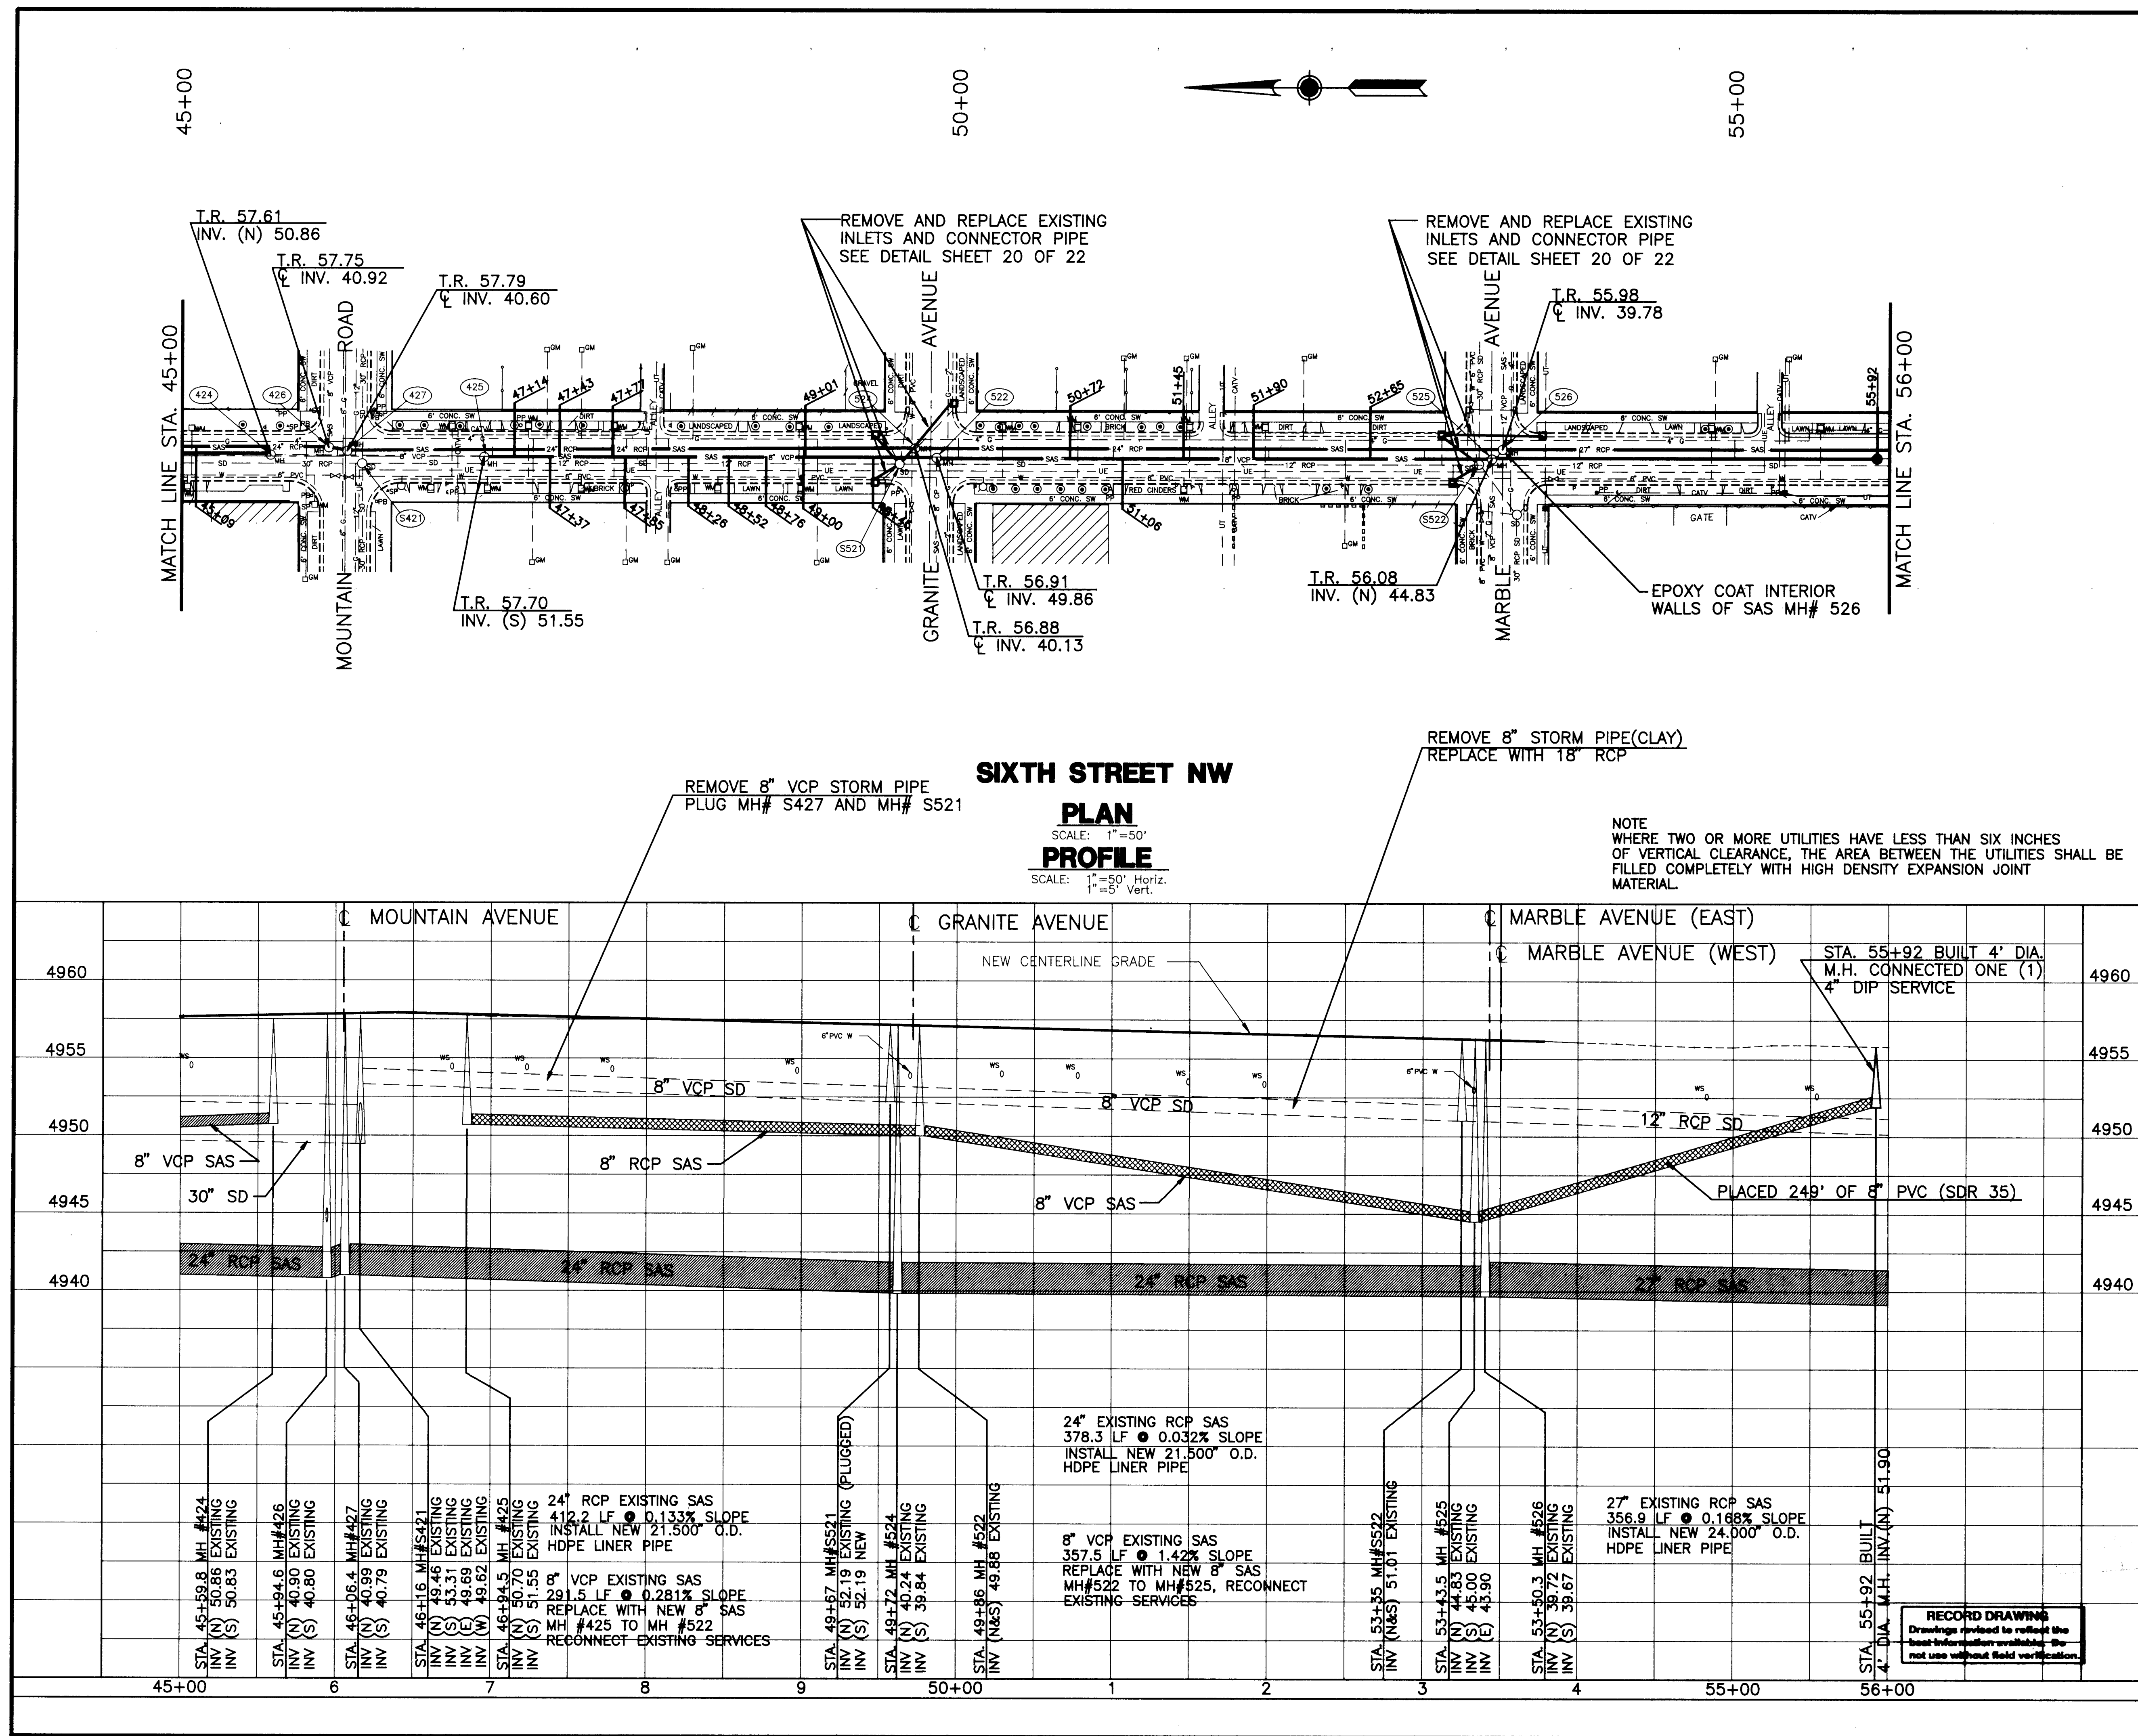

LEGEND

- REMOVAL AND REPLACEMENT OF SANITARY SEWER
- SPLITLINE OR INVERSION LINE SANITARY SEWER
- WS₀ EXISTING WATER SERVICE (PROFILE)
- EXISTING C & G
- EXISTING SANITARY SEWER
- EXISTING WATER LINE
- EXISTING GAS LINE
- EXISTING STORM DRAIN
- EXISTING UNDERGROUND TELEPHONE LINE
- EXISTING UNDERGROUND ELECTRICAL LINE
- EXISTING UNDERGROUND CABLE TV LINE
- EXISTING TRAFFIC SIGNAL CONDUIT
- EXISTING TELEPHONE BOX
- EXISTING STORM DRAIN MANHOLE
- EXISTING SANITARY SEWER MANHOLE
- EXISTING WATER VALVE
- EXISTING WATER METER
- EXISTING GAS VALVE
- EXISTING GAS METER
- EXISTING FIRE HYDRANT
- POWER POLE
- PEDESTAL SIGNAL
- PULL BOX
- LIGHT POLE
- EXISTING STORM INLET
- EXISTING TREE/SHRUB

BENCH MARKS		AS BUILT INFORMATION	
2-J14-R, CITY OF ALBUQUERQUE BRASS CAP LOCATED AT NE CORNER OF FOURTH AND LOMAS NW ELEV. = 4954.40		CONTRACTOR	RUSS PITNEY
		WORK STARTED BY	CITY OF ALBUQUERQUE
		DATE	
		FIELD ACCEPTANCE BY	
		DATE	
		RECORDED BY	
		DATE	
		CHECKED BY	
		DATE	
		NO.	
		DATE	
		REVISIONS	
		DESIGN	
		DATE	MAY 1989
		DRAWN BY	LDR-SAM-DWM
		CHECKED BY	RKA-JTN
		DATE	MAY 1989

CITY OF ALBUQUERQUE
PUBLIC WORKS DEPARTMENT


TITLE: **SIXTH STREET IMPROVEMENTS**
UTILITIES
STA. 56+00 TO STA. 60+06.48

APPROVALS	ENGINEER	DATE	APPROVALS	ENGINEER	DATE
City Engineer	<i>Russ Pitney</i>	5/2/89	Liquid Waste	<i>Russ Pitney</i>	5/2/89
A.C.E.-Design	"	"	Traffic	<i>Russ Pitney</i>	5/2/89
A.C.E.-Hydrology	"	"	Water	<i>Russ Pitney</i>	5/2/89

DRAWING NO.	3568	MAP NO.	J-14	SHEET OF	17 22
-------------	------	---------	------	----------	-------


RECORD DRAWING
Drawings revised to reflect the best information available. Do not use without field verification.

1 2 3 4 5 6 7 8 9 10 11 12
26 35 68 17 90

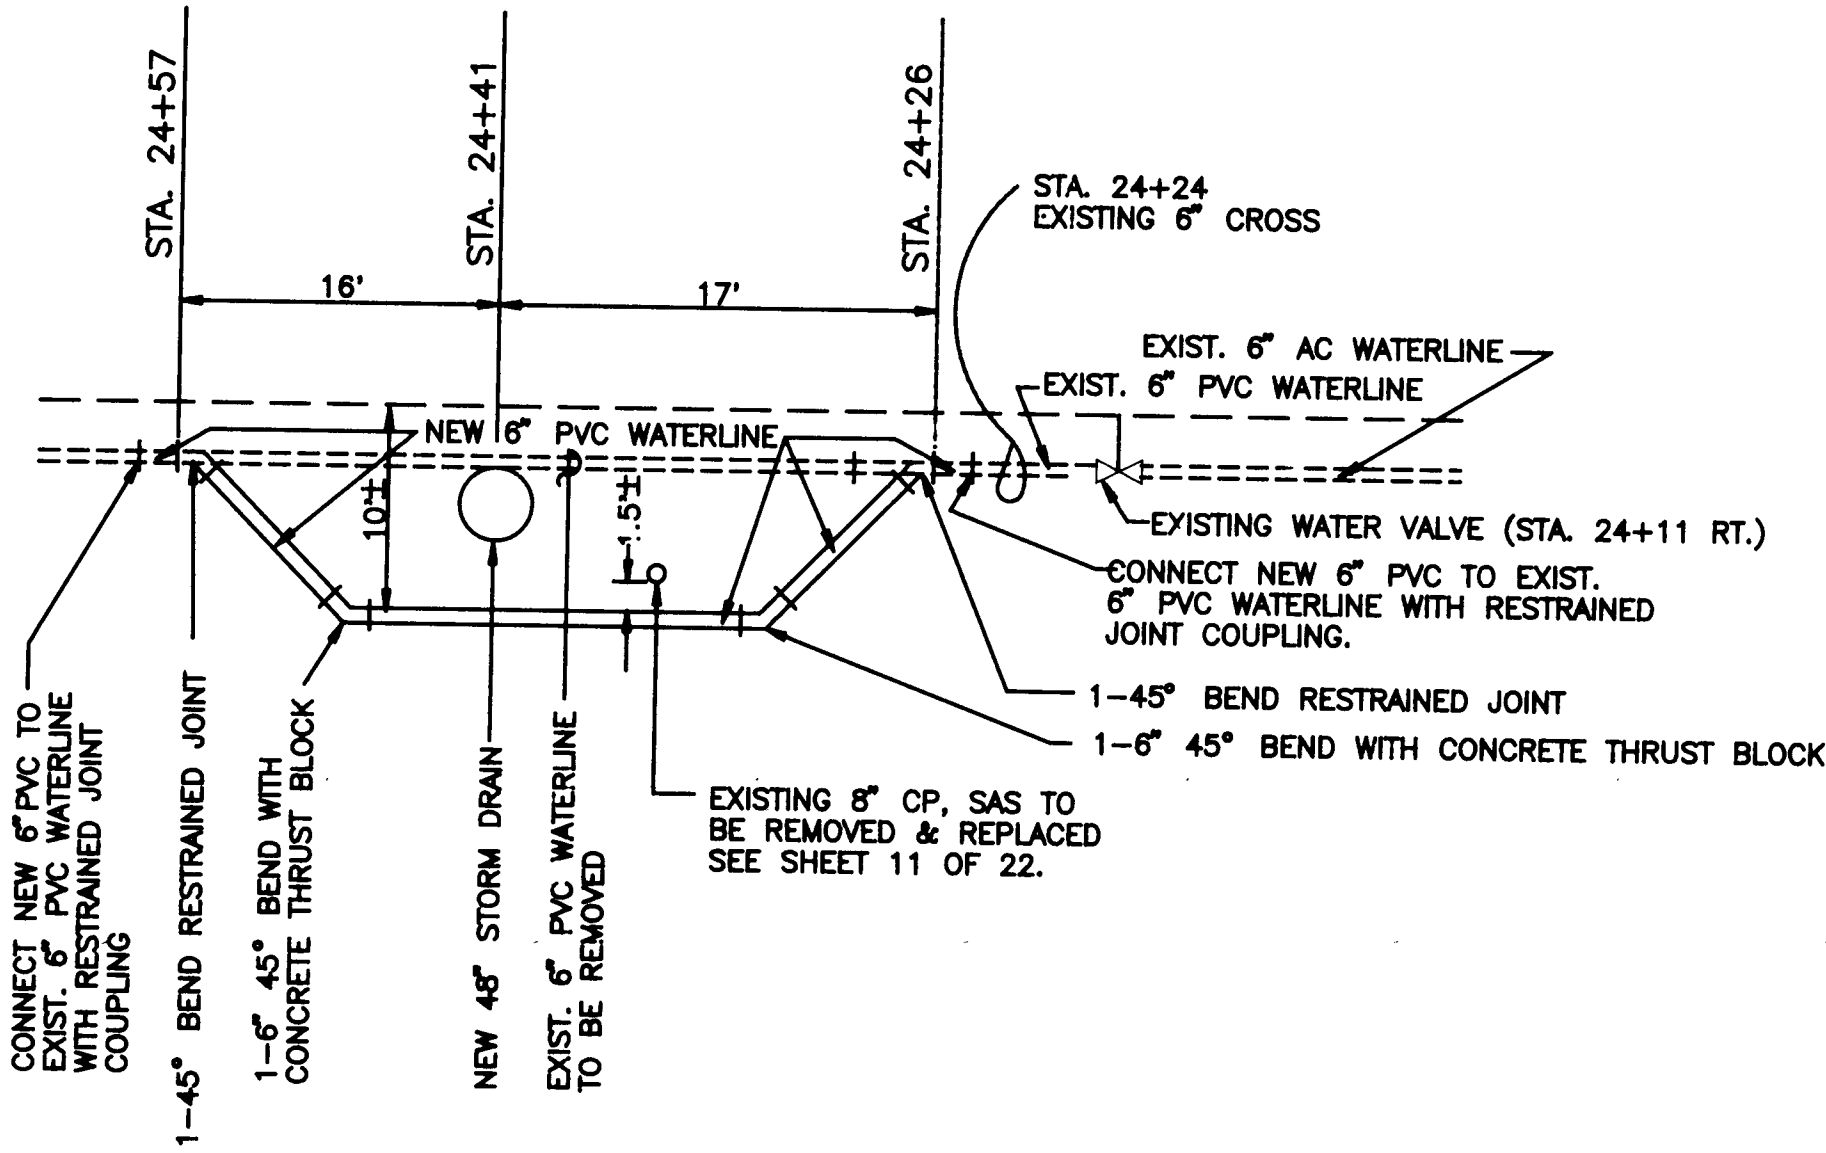

STA. 24+18 TO STA. 24+57 WATERLINE RELOCATION DETAIL


(FACING WEST)
NO SCALE


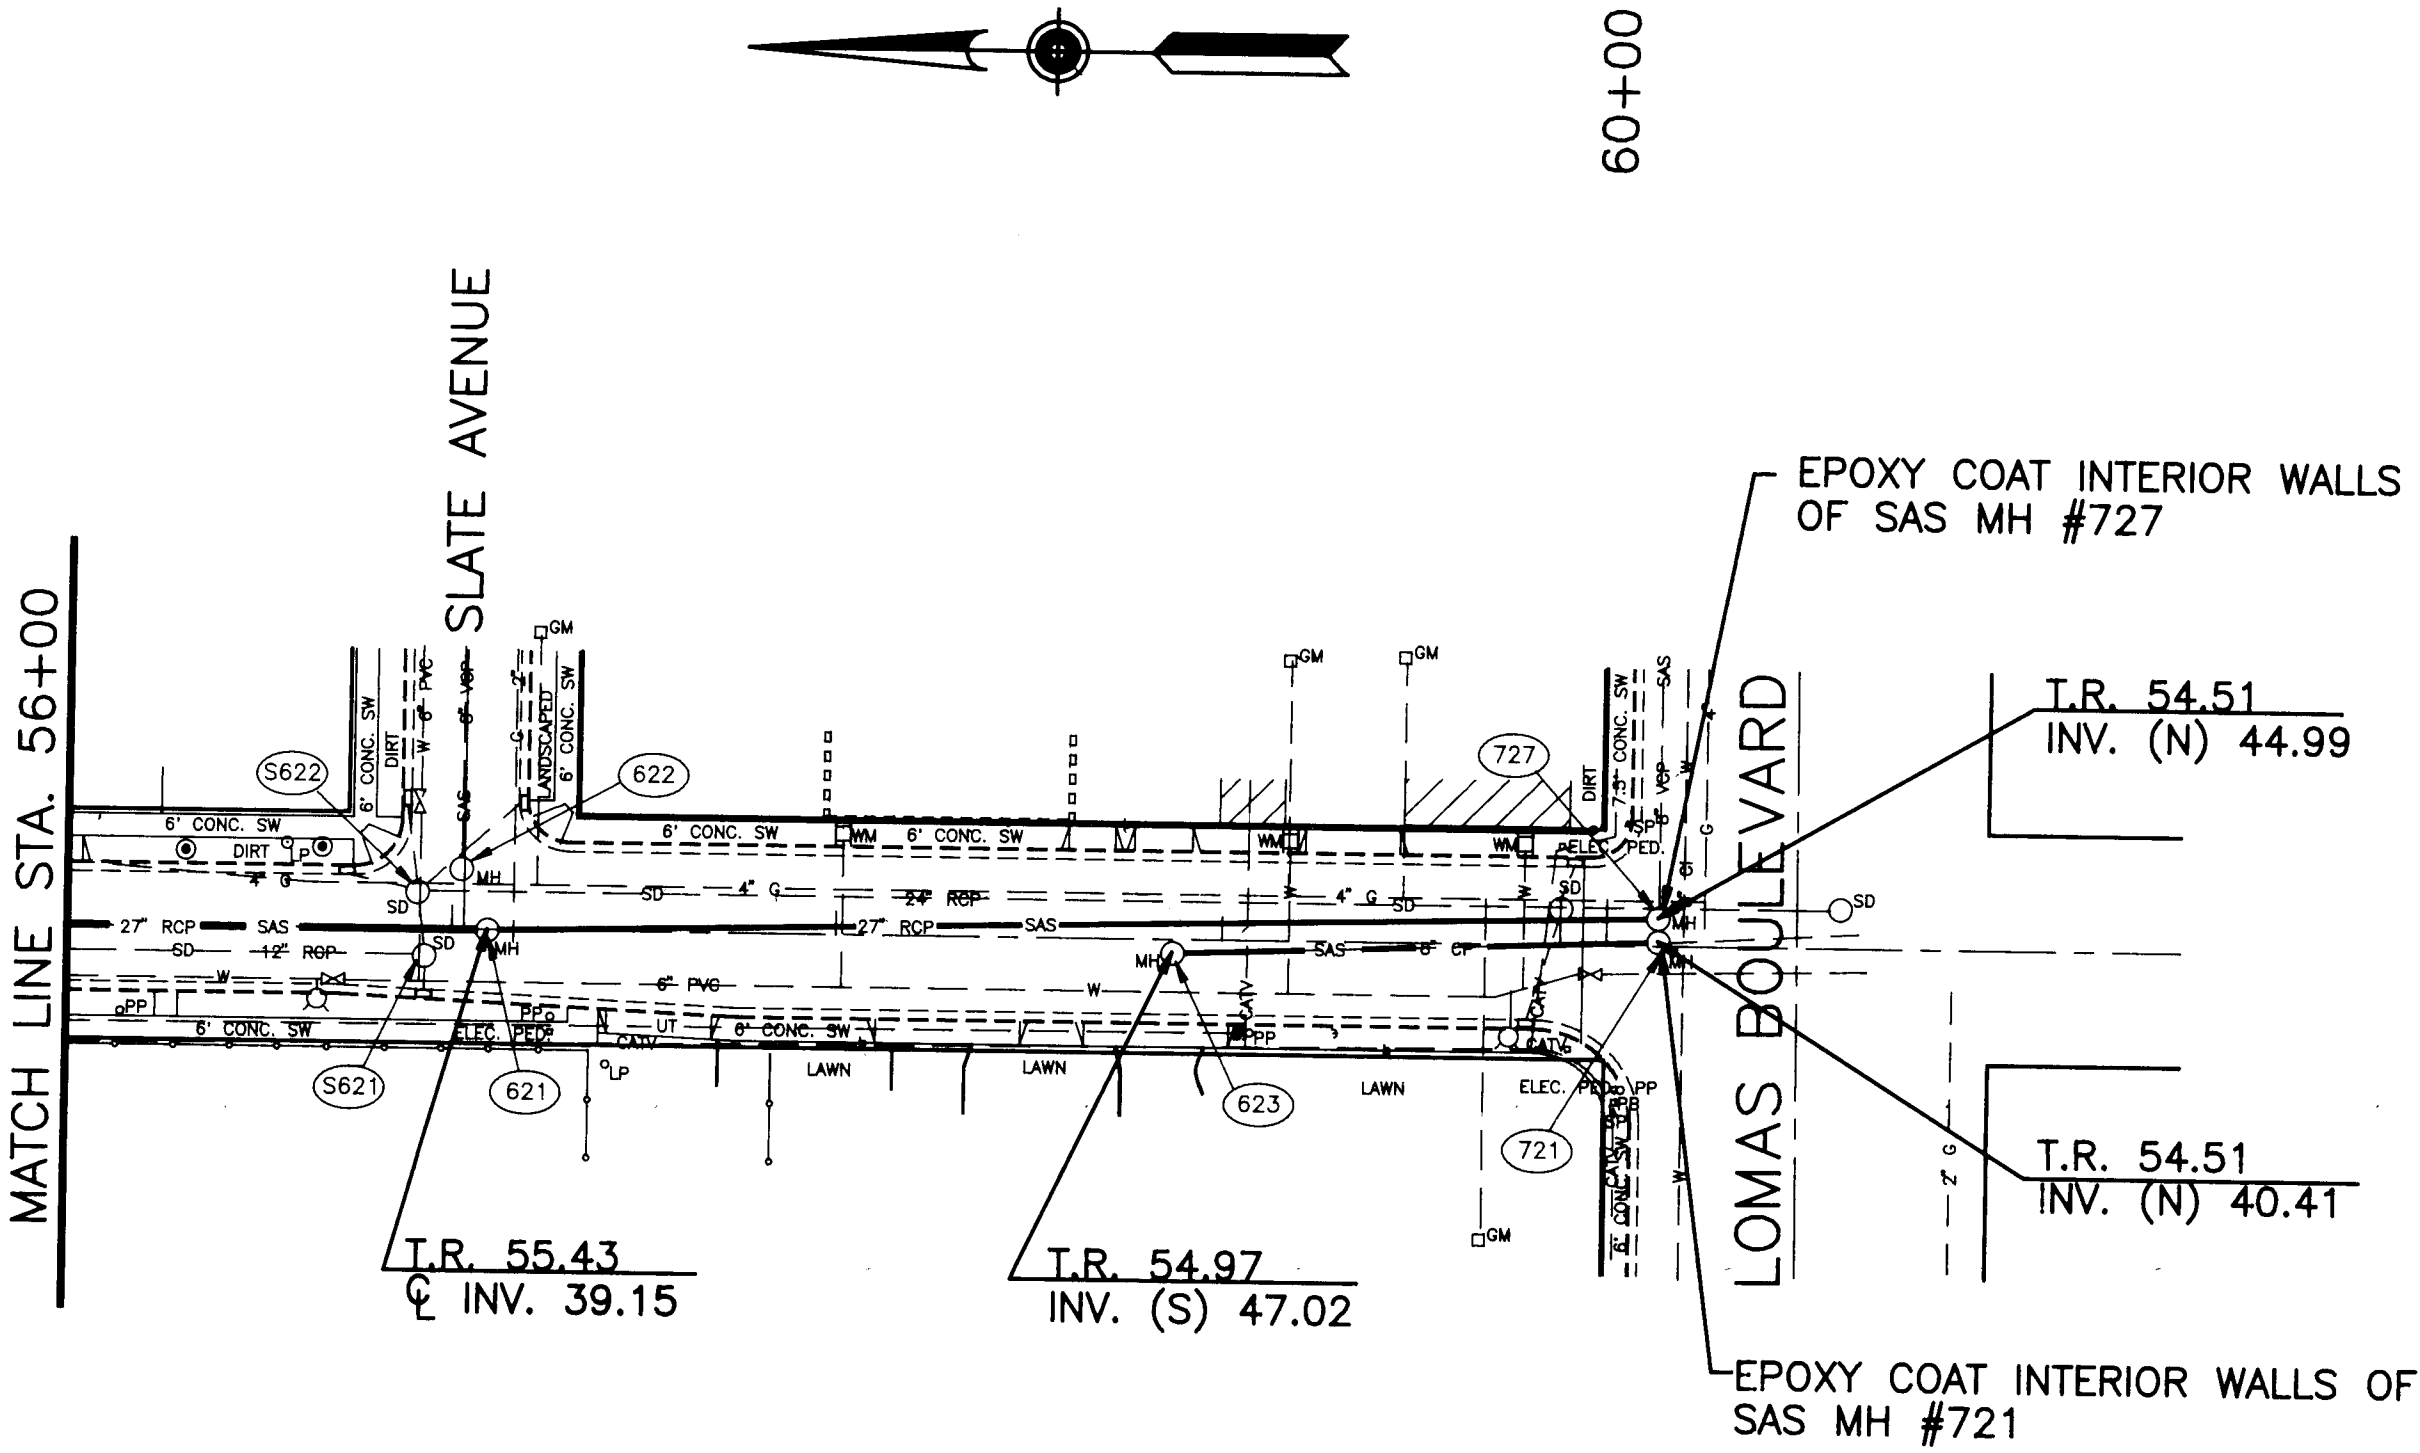



SIXTH STREET NW

PLAN
SCALE: 1"=50'
PROFILE
SCALE: 1"=50' Horiz.
1"=5' Vert.


NOTE
WHERE TWO OR MORE UTILITIES HAVE LESS THAN SIX INCHES OF VERTICAL CLEARANCE, THE AREA BETWEEN THE UTILITIES SHALL BE FILLED COMPLETELY WITH HIGH DENSITY EXPANSION JOINT MATERIAL.

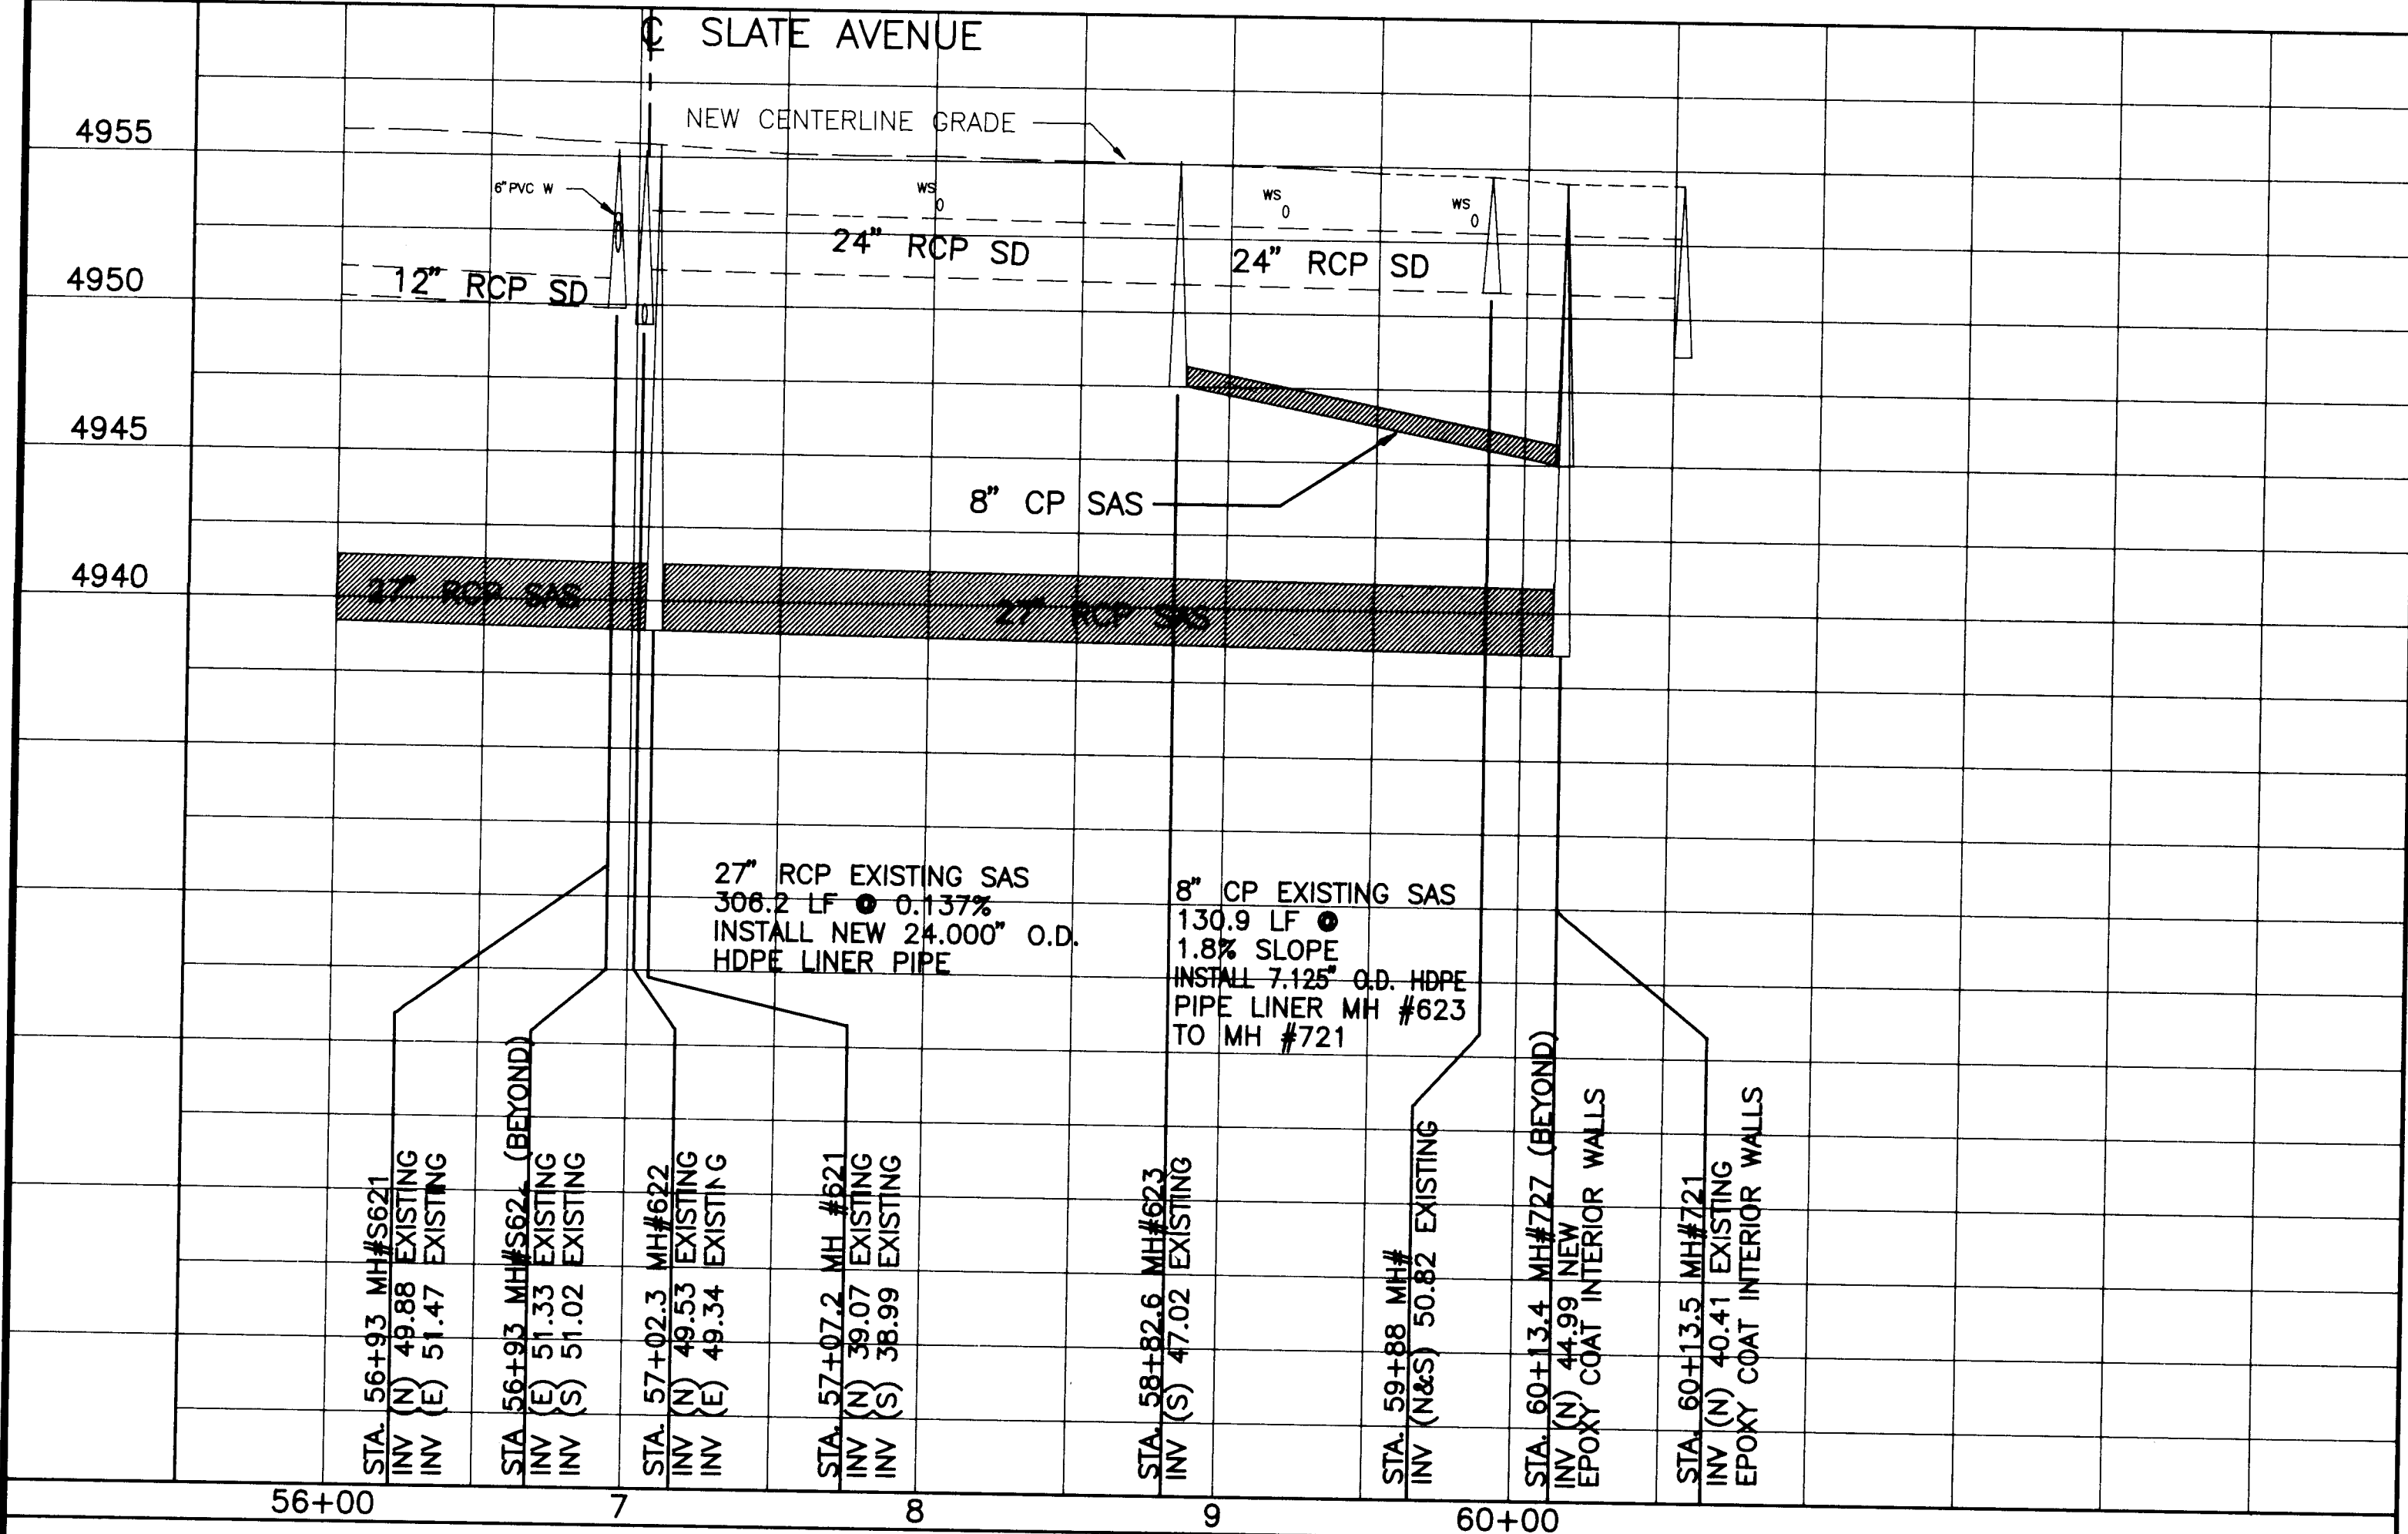

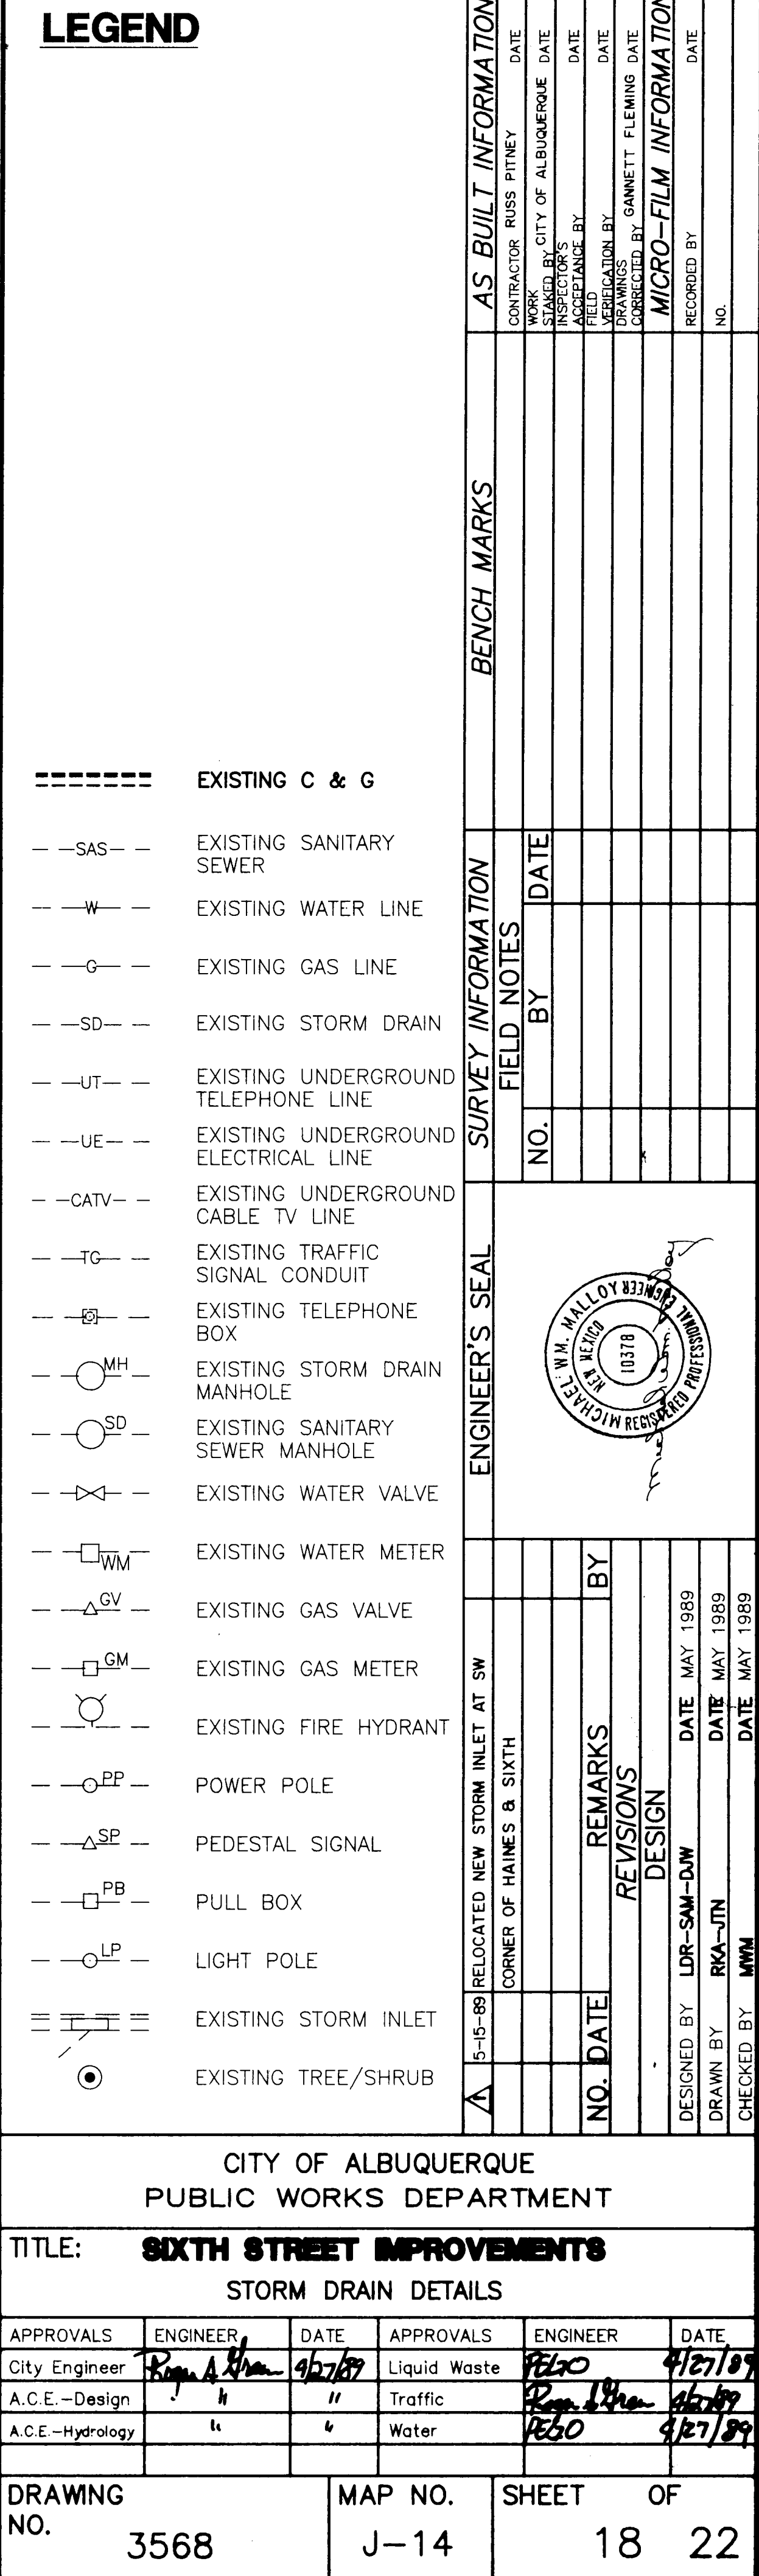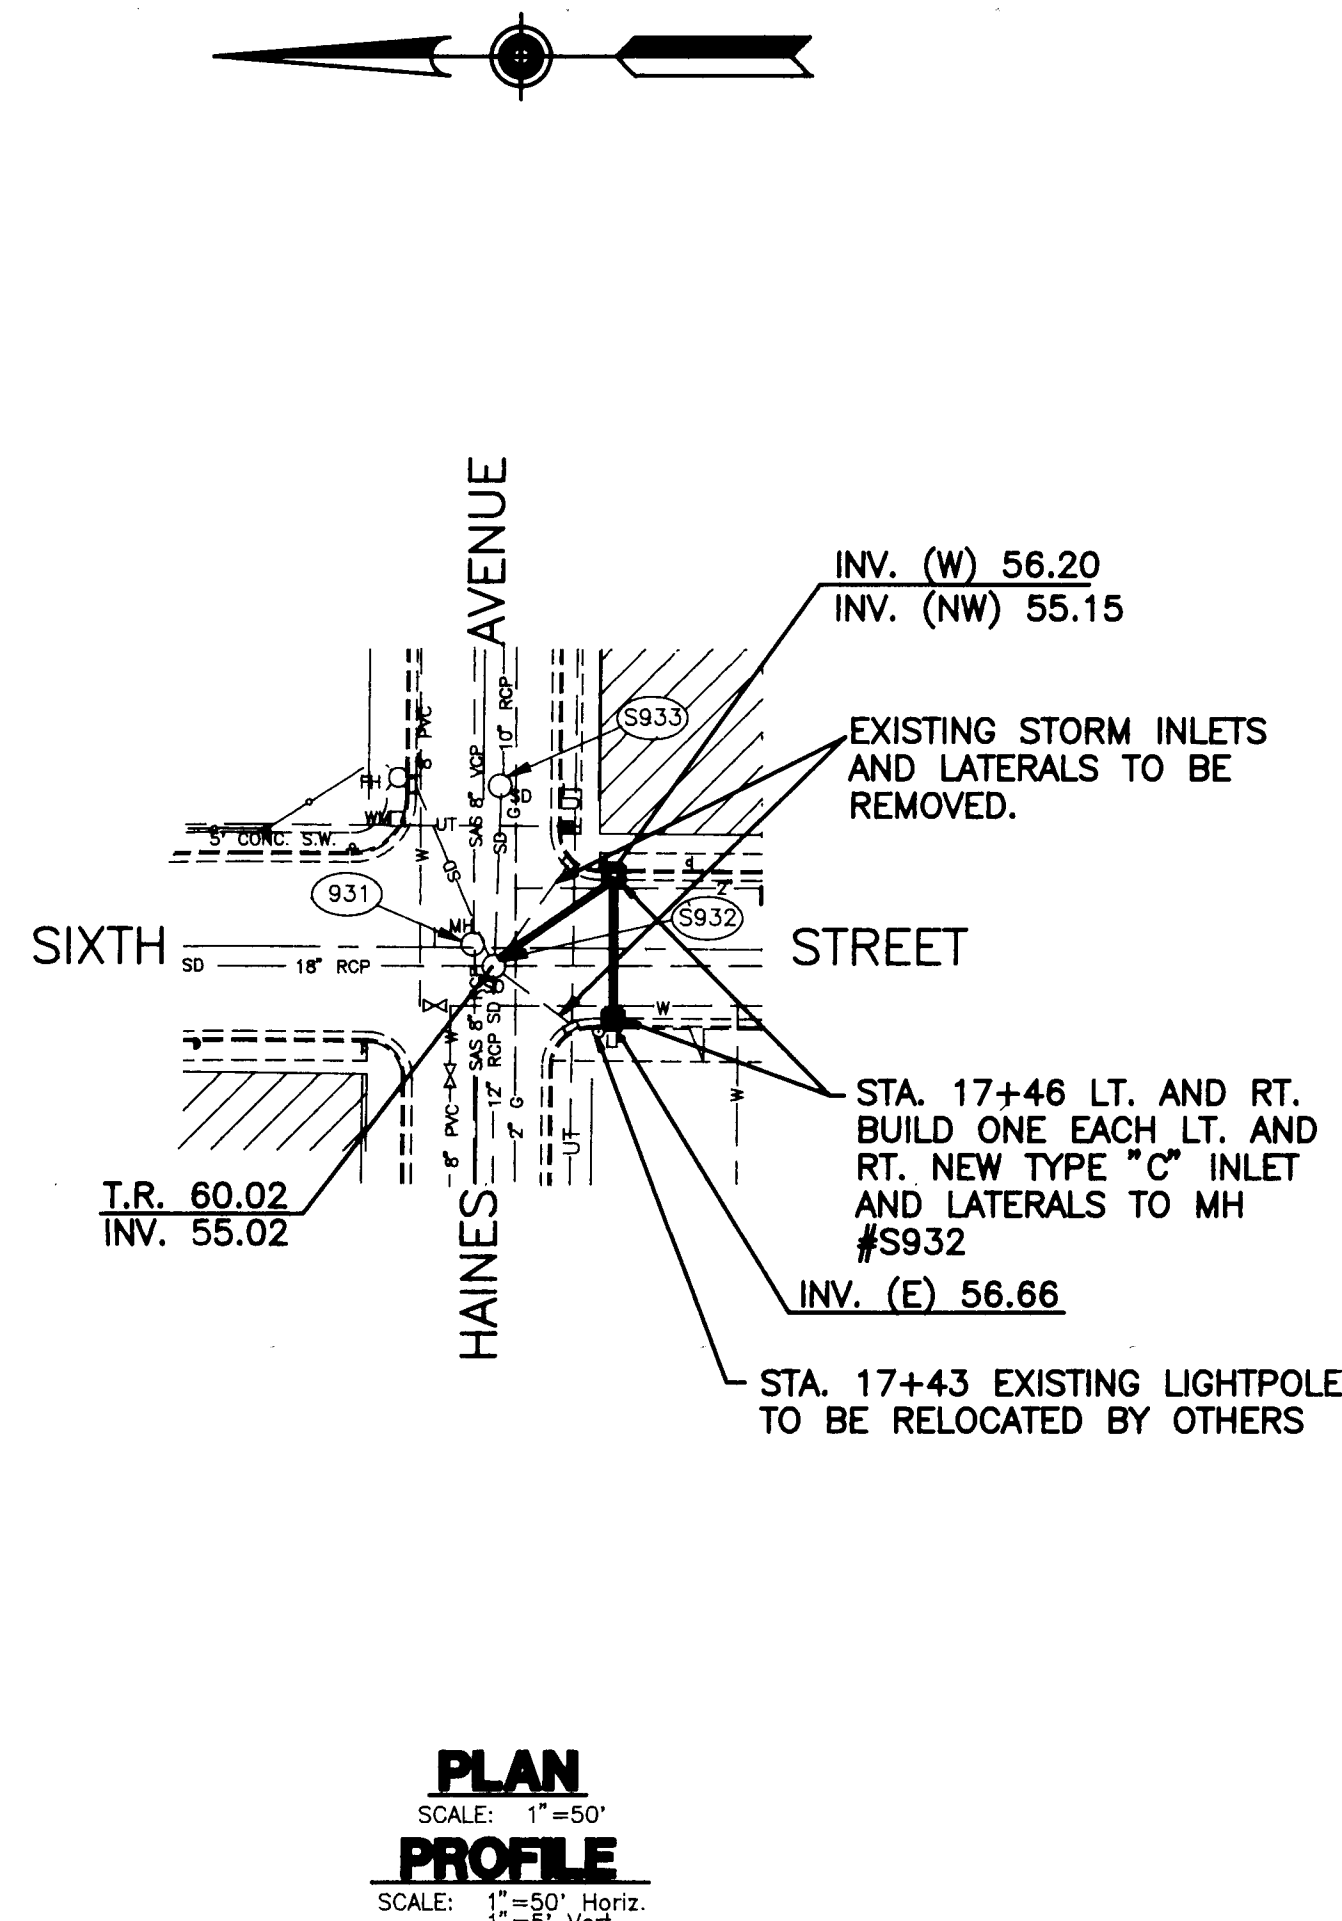


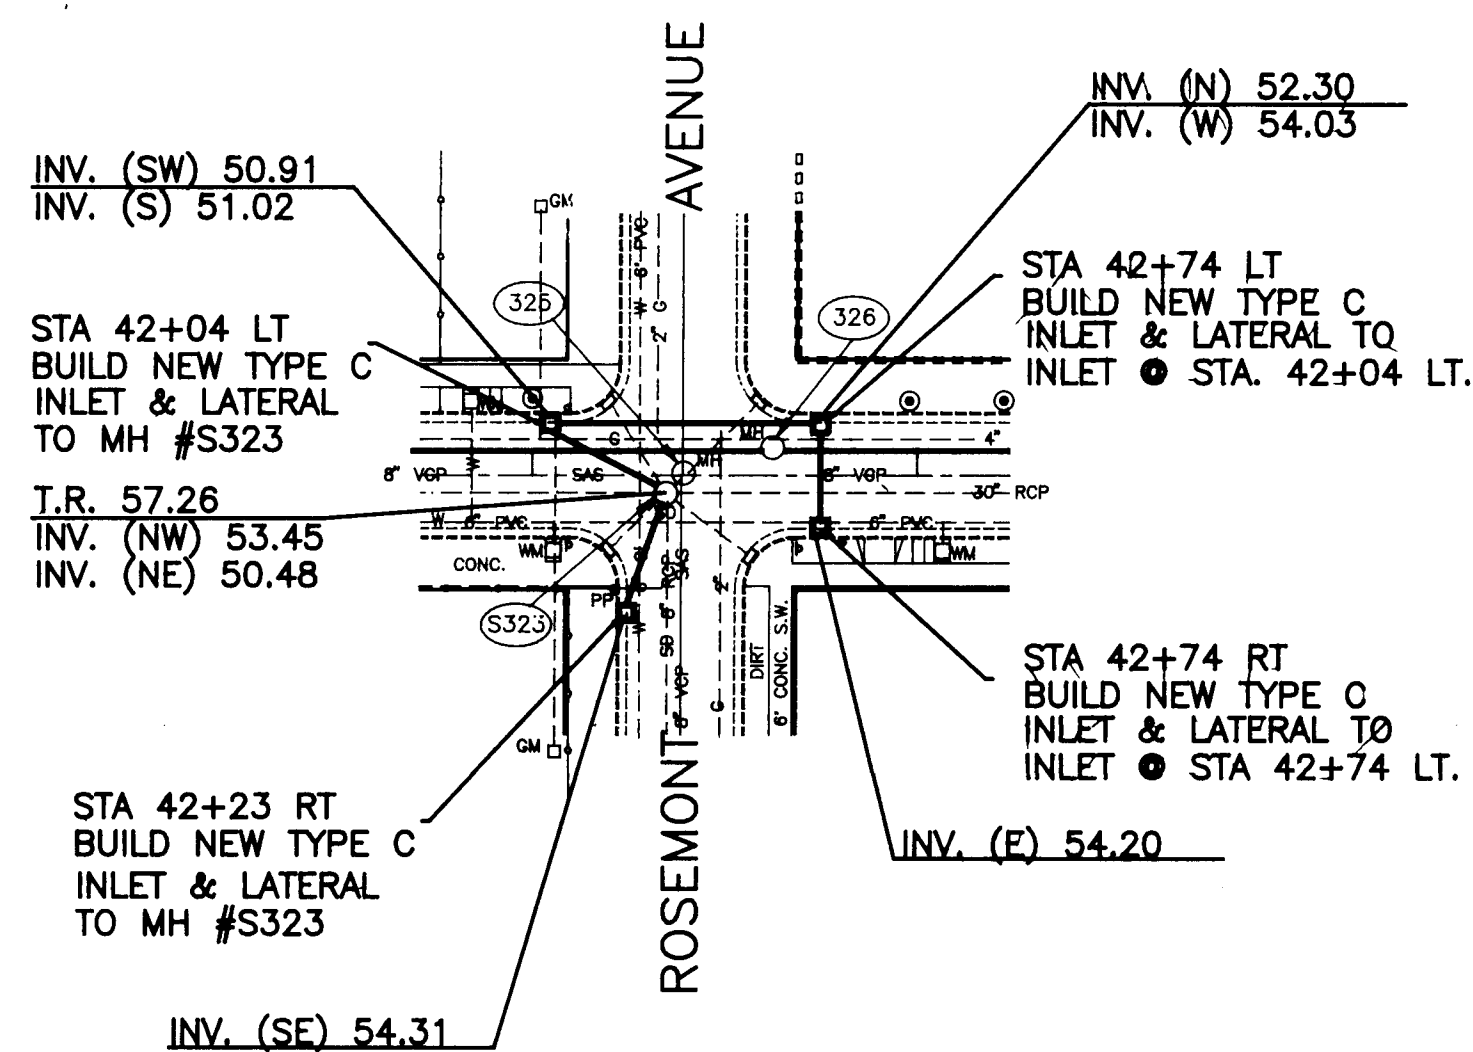

PLAN
SCALE: 1"=50'
PROFILE
SCALE: 1"=50' Horiz.
1"=5' Vert.

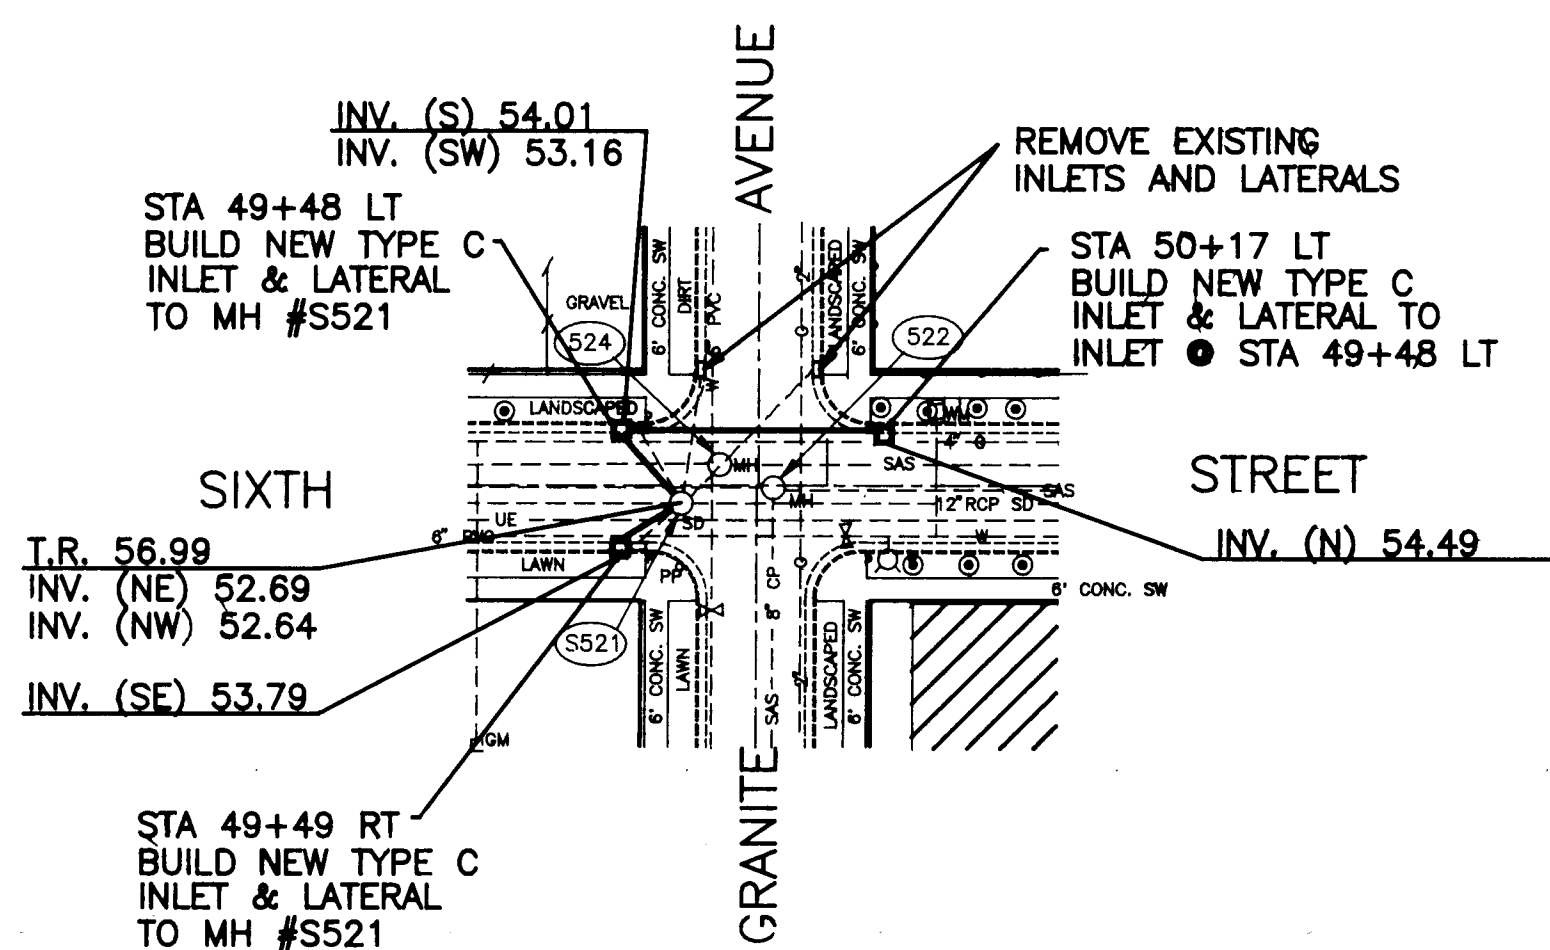

PLAN
SCALE: 1"=50'
PROFILE
SCALE: 1"=50' Horiz.
1"=5' Vert.



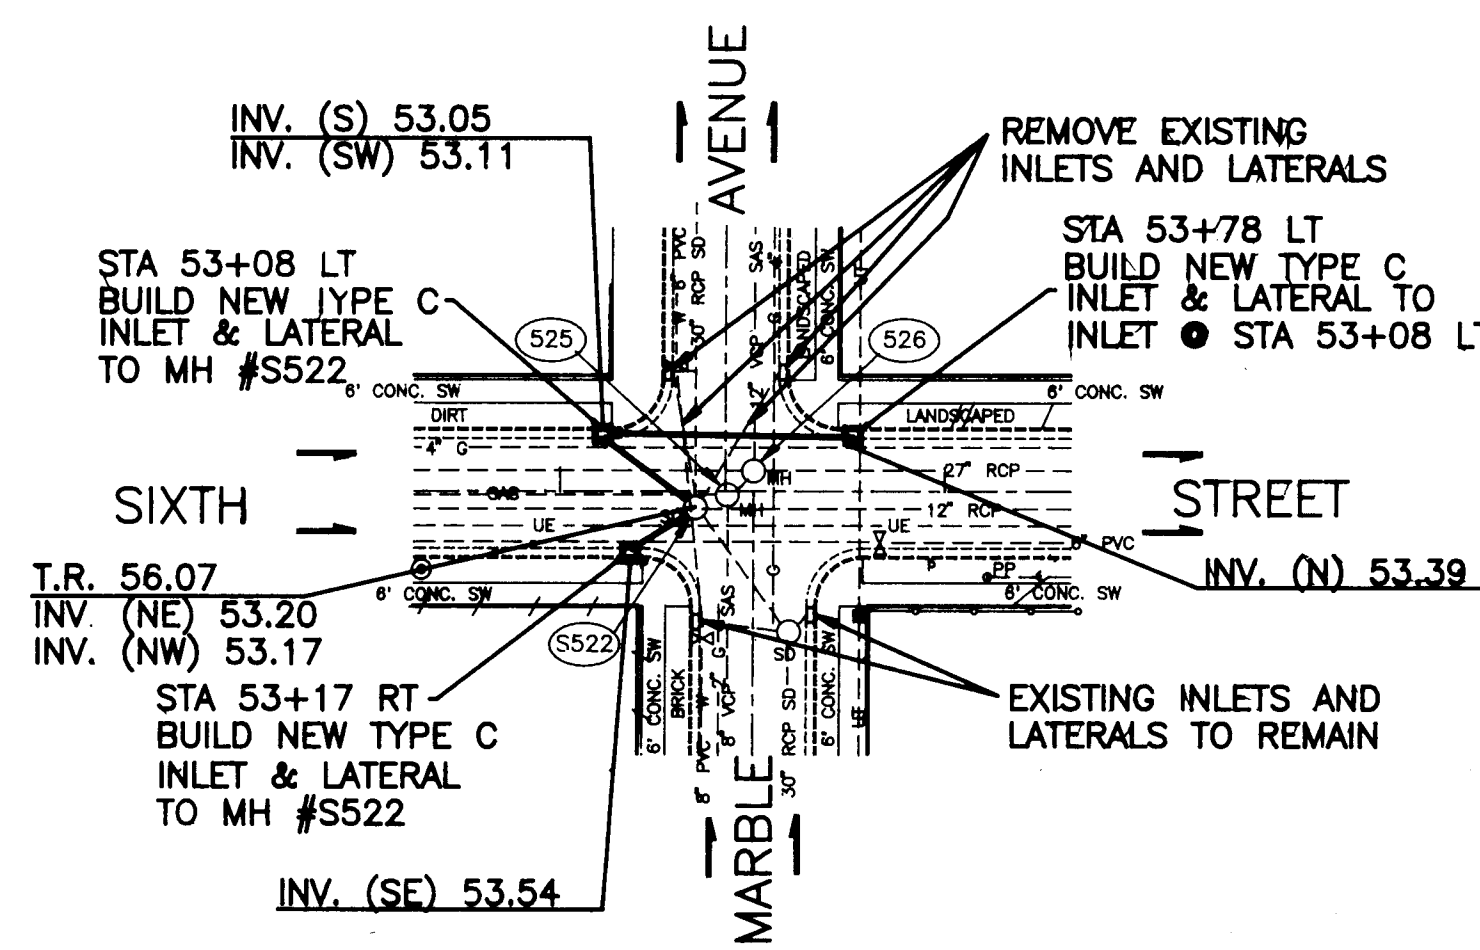


PLAN
SCALE: 1"=50'
PROFILE
SCALE: 1"=50' Horiz.
1"=5' Vert.

SIXTH AND ROSEMONT

SIXTH AND GRANITE


SIXTH AND MARBLE

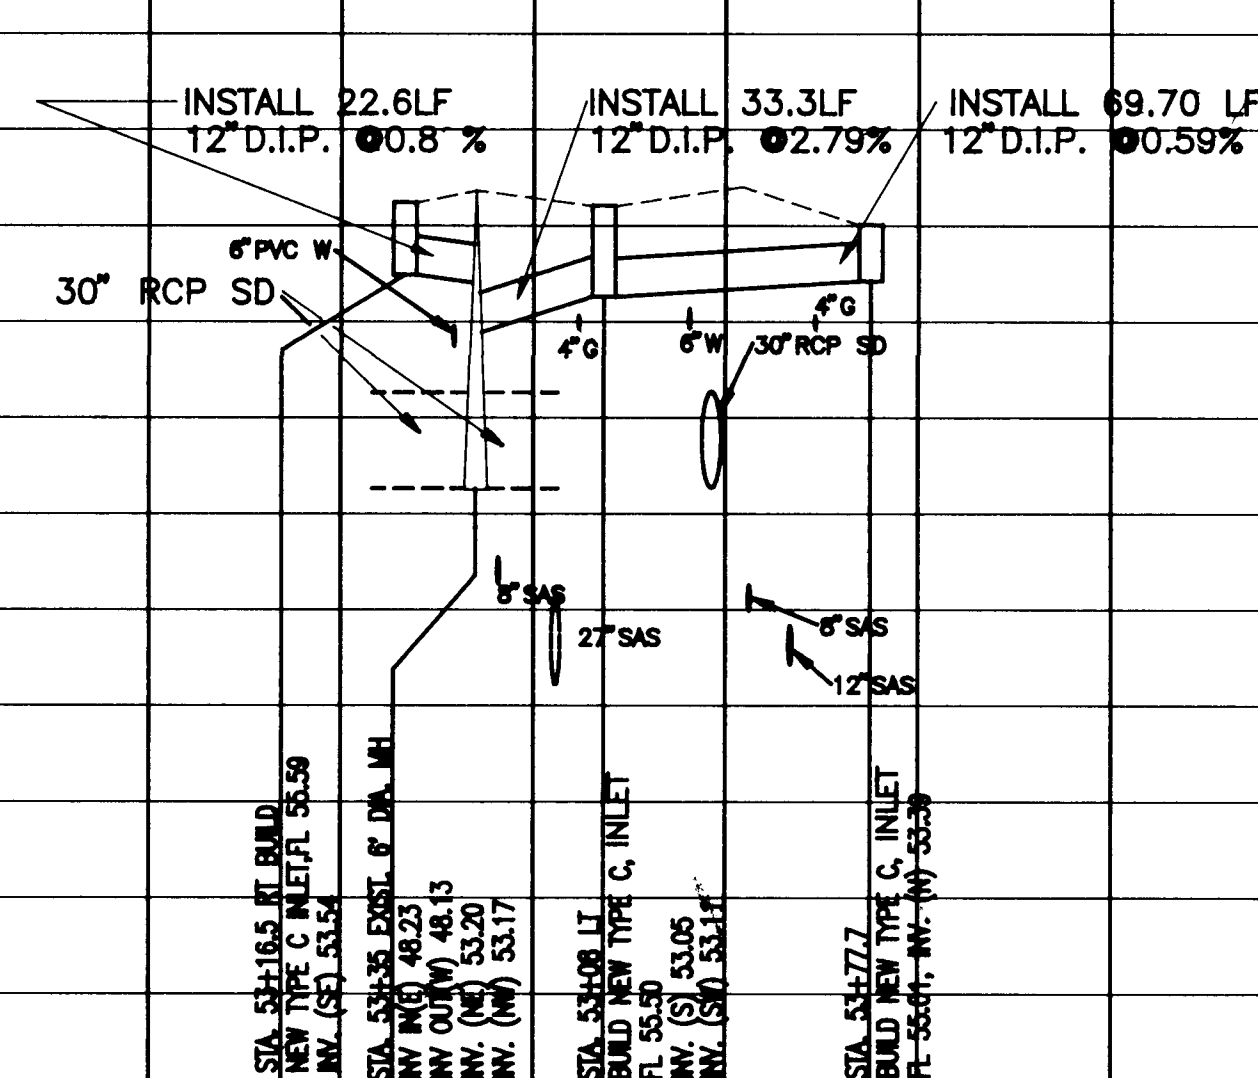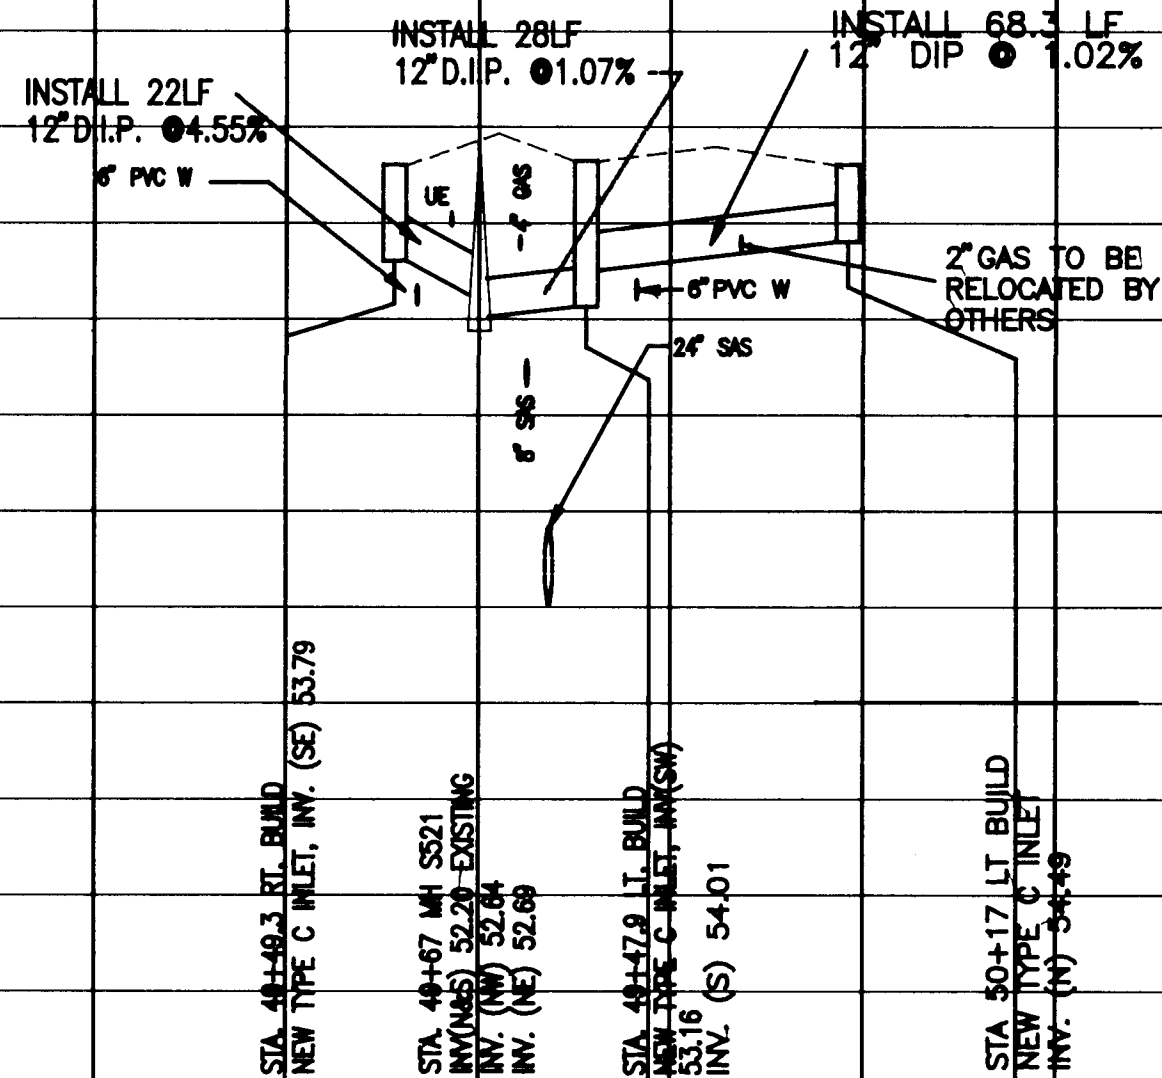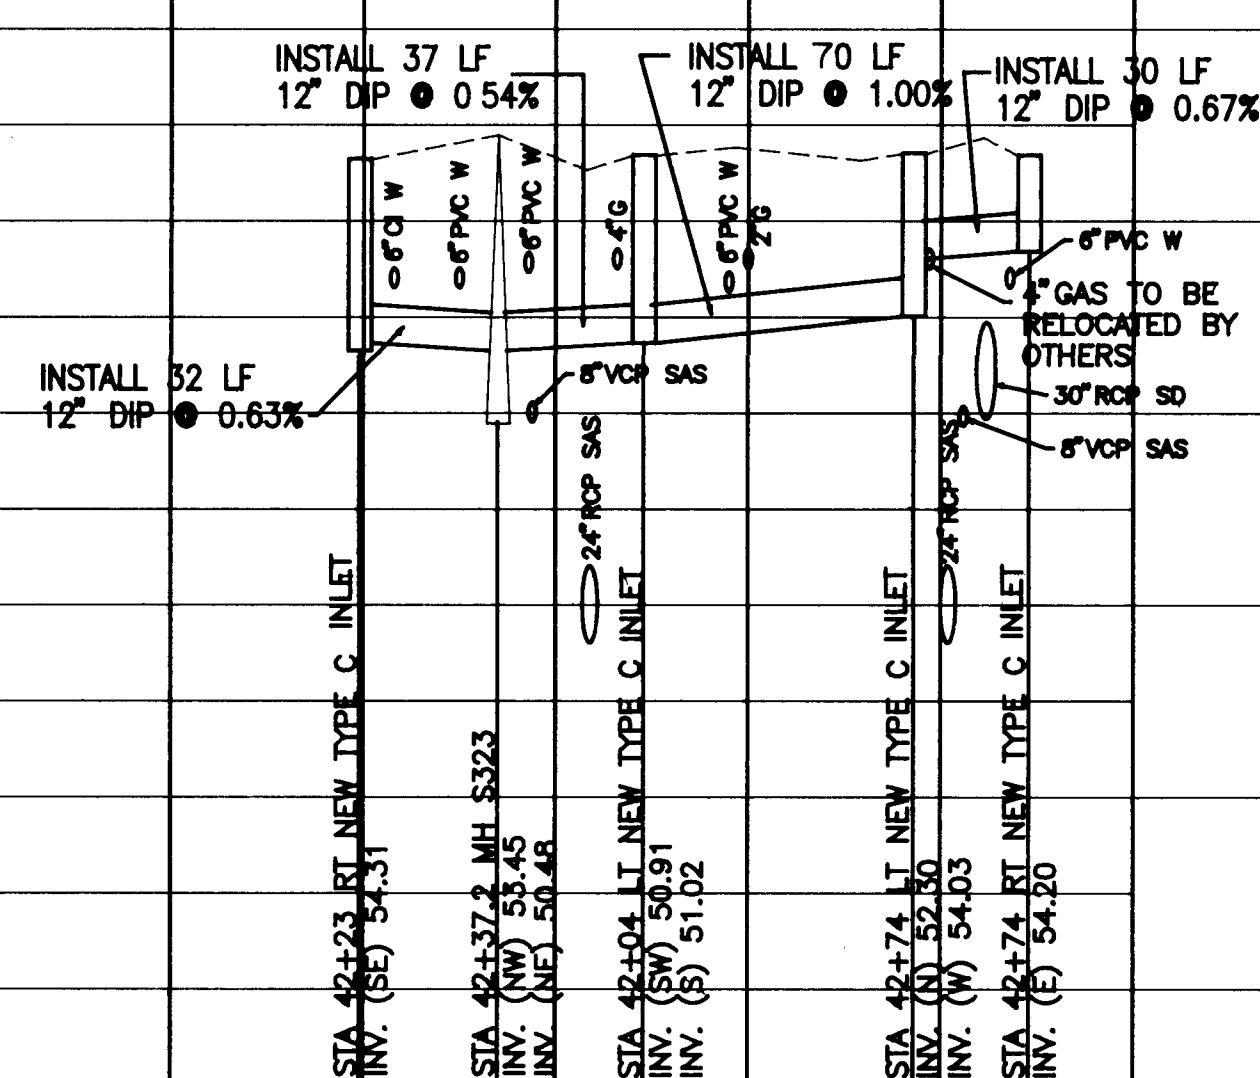

LEGEND

- SAS--- EXISTING C & G
- W--- EXISTING SANITARY SEWER
- G--- EXISTING WATER LINE
- SD--- EXISTING GAS LINE
- UT--- EXISTING STORM DRAIN
- UE--- EXISTING UNDERGROUND TELEPHONE LINE
- UE--- EXISTING UNDERGROUND ELECTRICAL LINE
- CATV--- EXISTING UNDERGROUND CABLE TV LINE
- TC--- EXISTING TRAFFIC SIGNAL CONDUIT
- E--- EXISTING TELEPHONE BOX
- MH--- EXISTING STORM DRAIN MANHOLE
- SD--- EXISTING SANITARY SEWER MANHOLE
- WV--- EXISTING WATER VALVE
- WM--- EXISTING WATER METER
- GV--- EXISTING GAS VALVE
- GM--- EXISTING GAS METER
- FH--- EXISTING FIRE HYDRANT
- PP--- POWER POLE
- SP--- PEDESTAL SIGNAL
- PB--- PULL BOX
- LP--- LIGHT POLE
- SI--- EXISTING STORM INLET
- TS--- EXISTING TREE/SHRUB

AS BUILT INFORMATION		BENCH MARKS		SURVEY INFORMATION		ENGINEERS SEAL	
CONTRACTOR	RUS PITNEY	DATE		NO.	DATE	NO.	DATE
WORKED BY	CITY OF ALBUQUERQUE	DATE		BY	DATE	REMARKS	BY
APPROVED BY		DATE			DATE	REVISIONS	DATE
DESIGNED BY		DATE			DATE	DESIGN	DATE
DRAWN BY		DATE			DATE		DATE
CHECKED BY		DATE			DATE		DATE

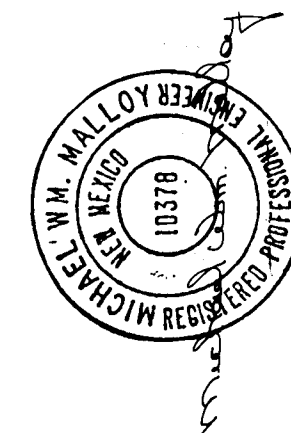










CITY OF ALBUQUERQUE
PUBLIC WORKS DEPARTMENT

TITLE: **SIXTH STREET IMPROVEMENTS**
STORM DRAIN DETAILS

APPROVALS	ENGINEER	DATE	APPROVALS	ENGINEER	DATE
City Engineer	Ryan A. Khan	9/27/07	Liquid Waste	REGO	9/27/07
A.C.E.—Design	"	"	Traffic	Ryan A. Khan	9/27/07
A.C.E.—Hydrology	"	"	Water	REGO	9/27/07

DRAWING NO. 3568 MAP NO. J-14 SHEET 20 OF 22

RECORD DRAWING
Drawings revised to reflect the best information available. Do not use without field verification.

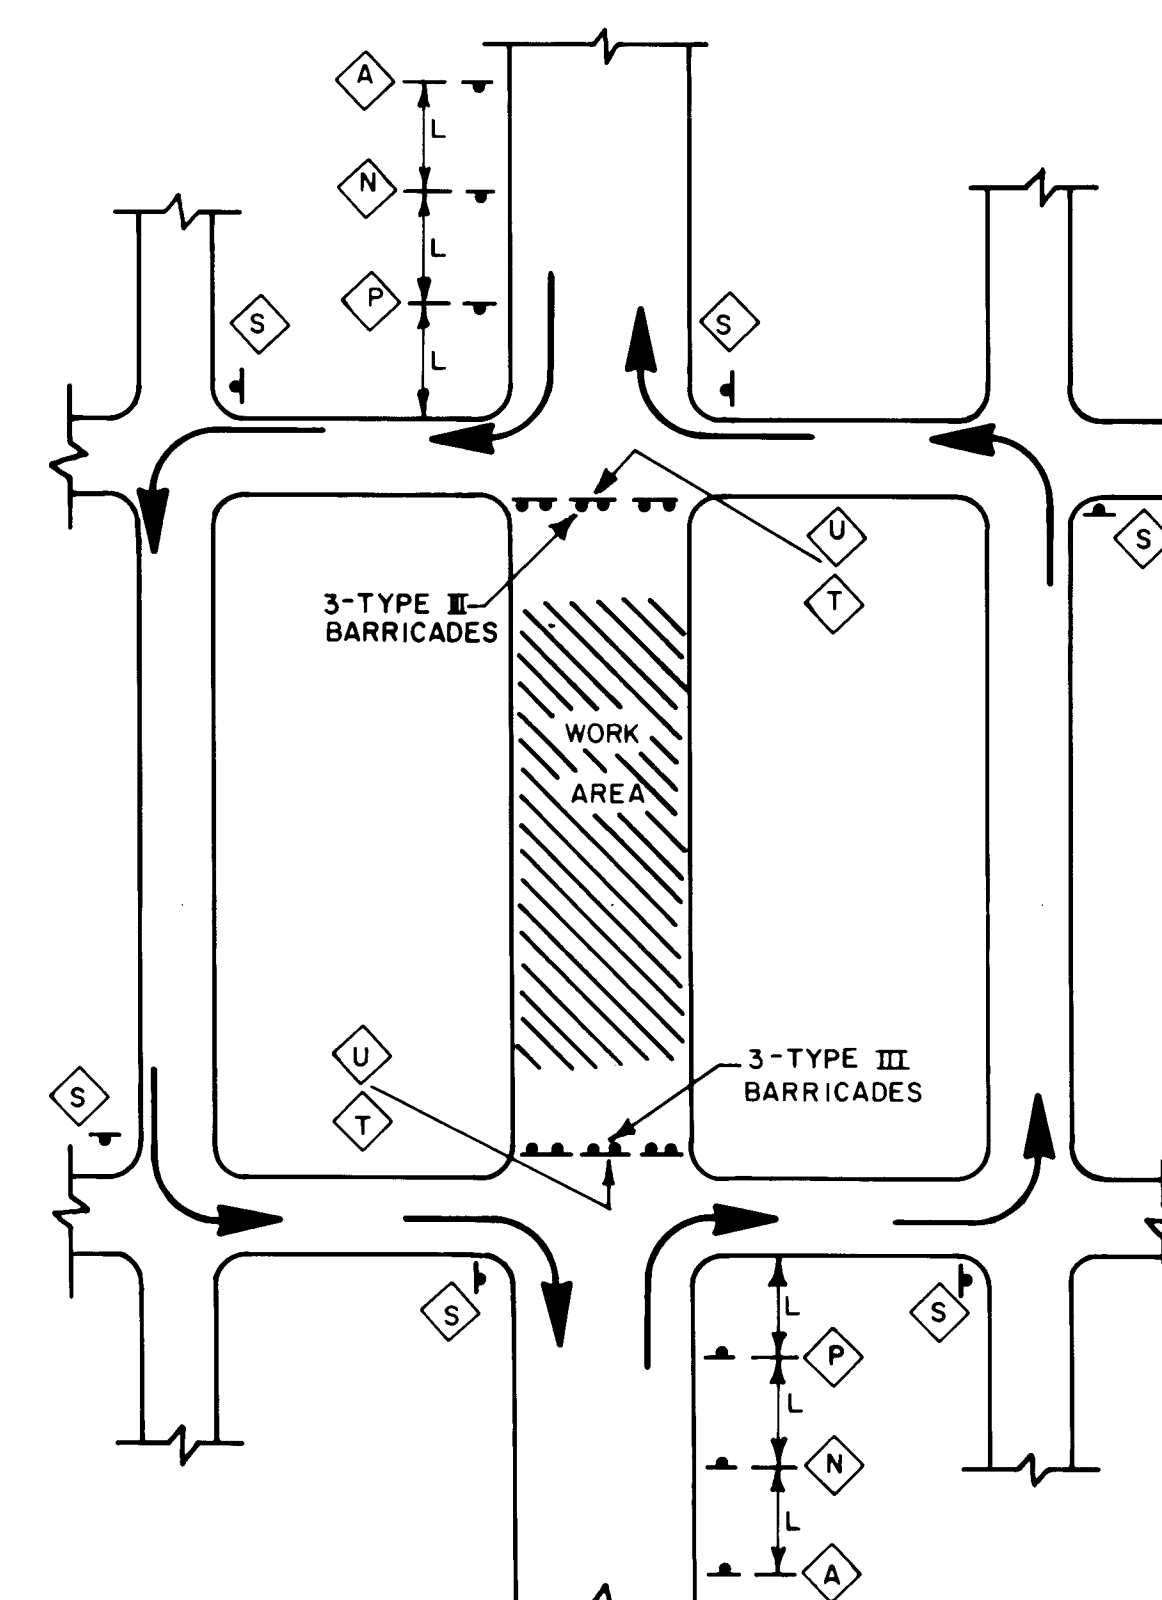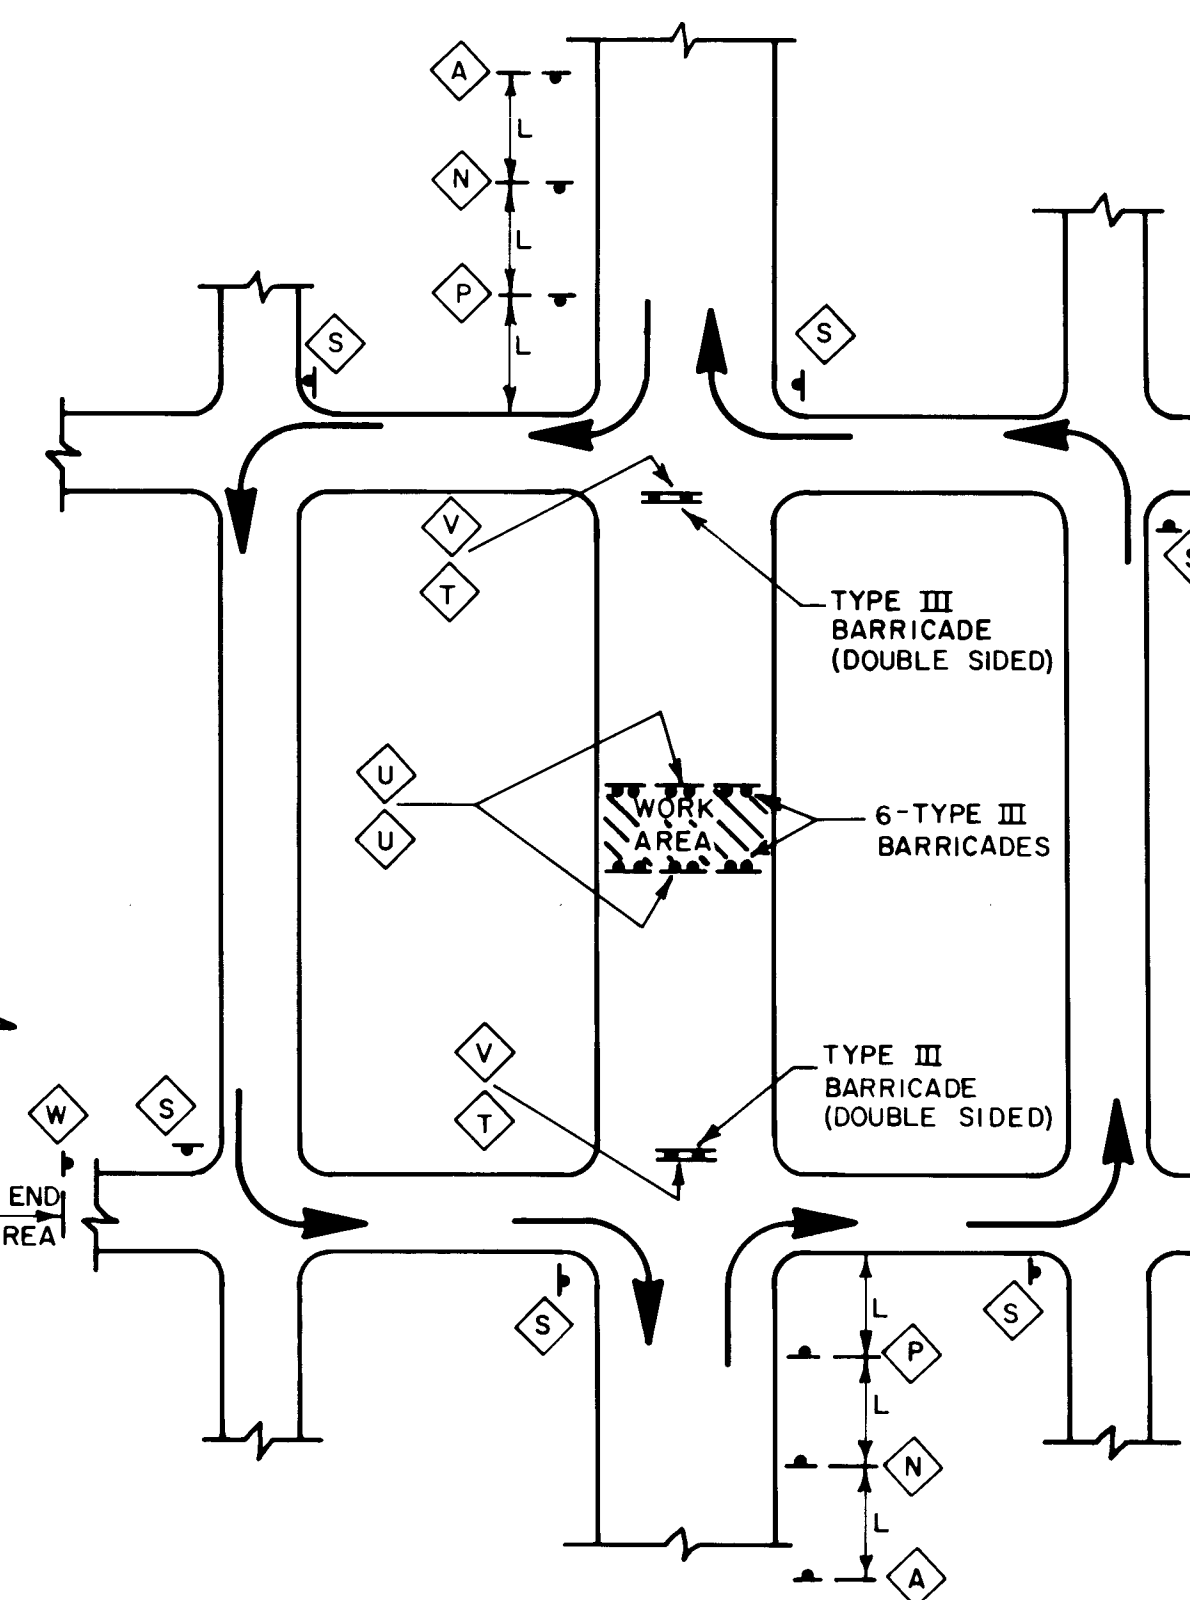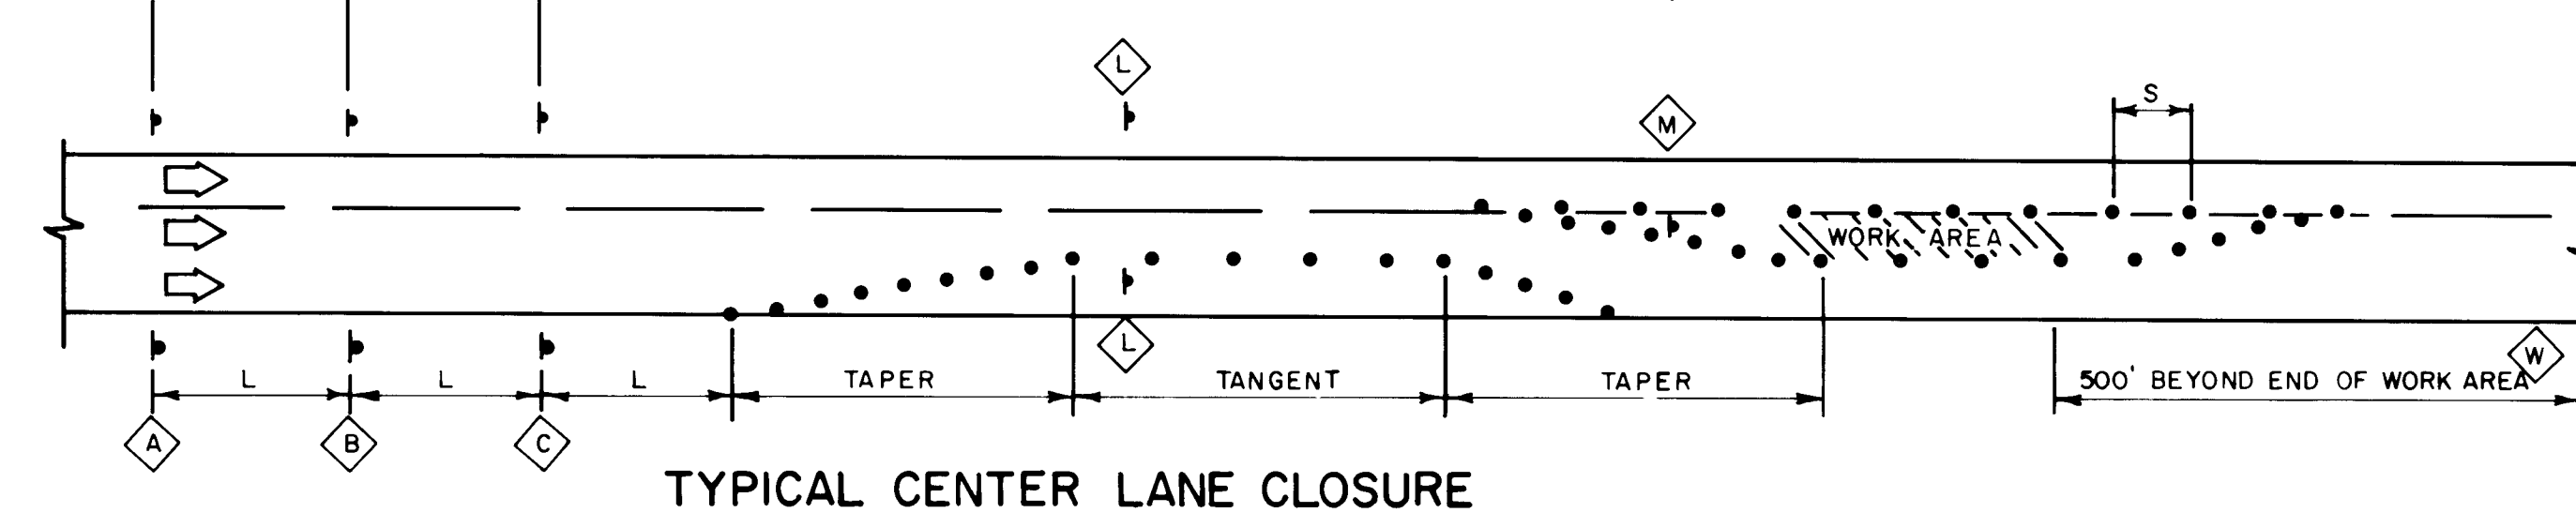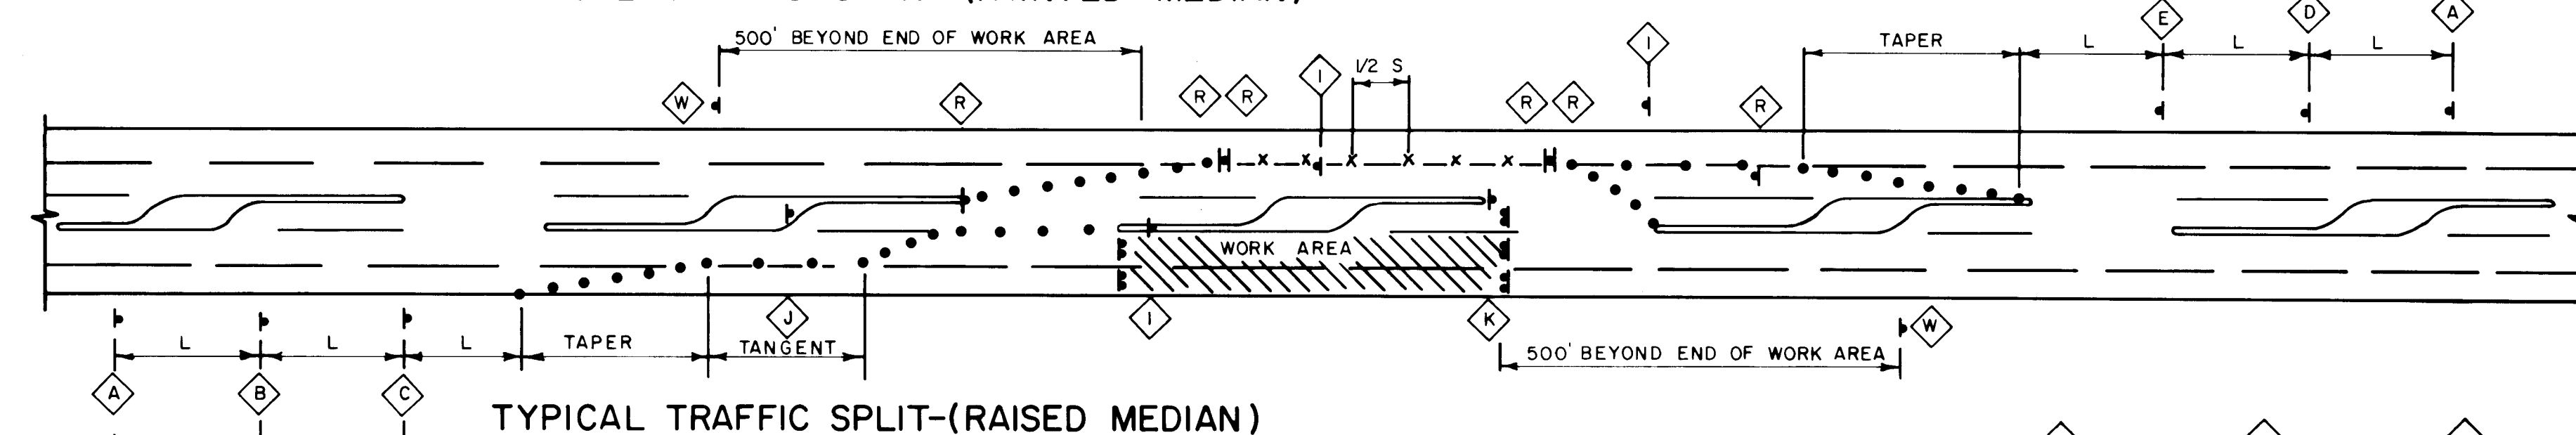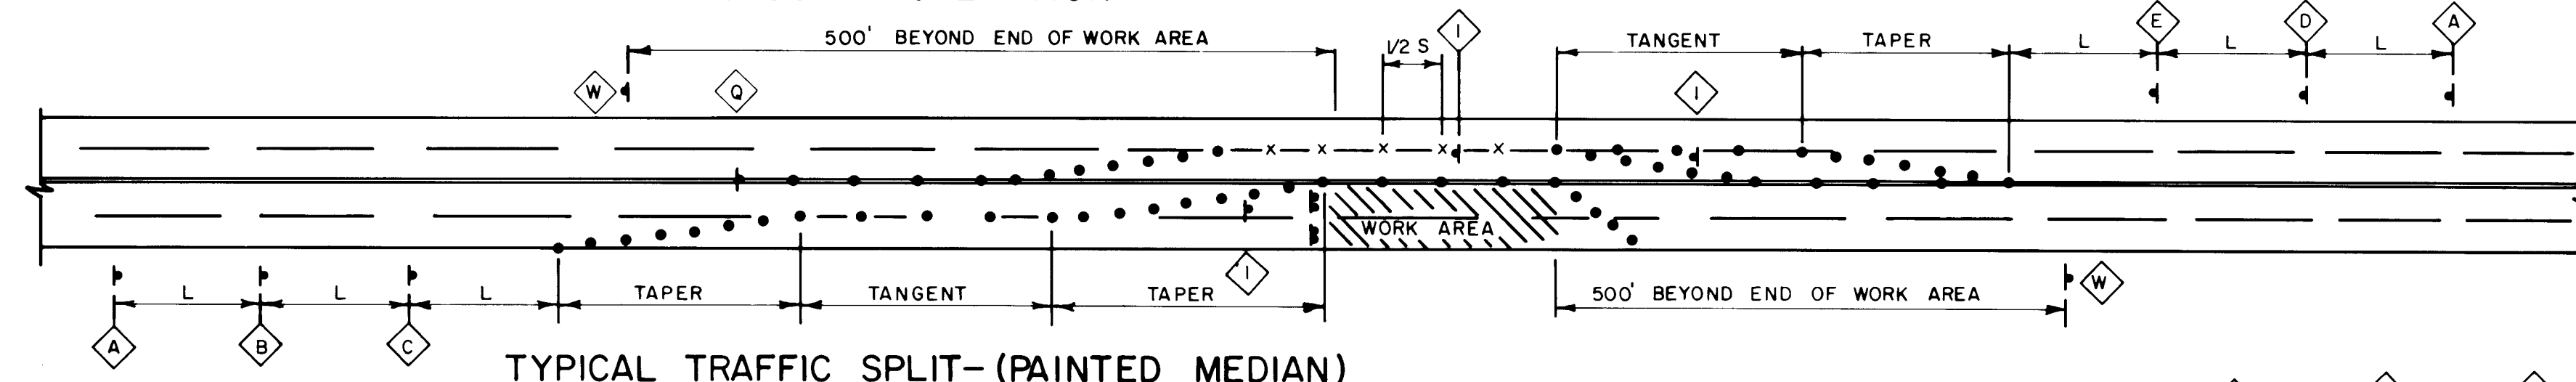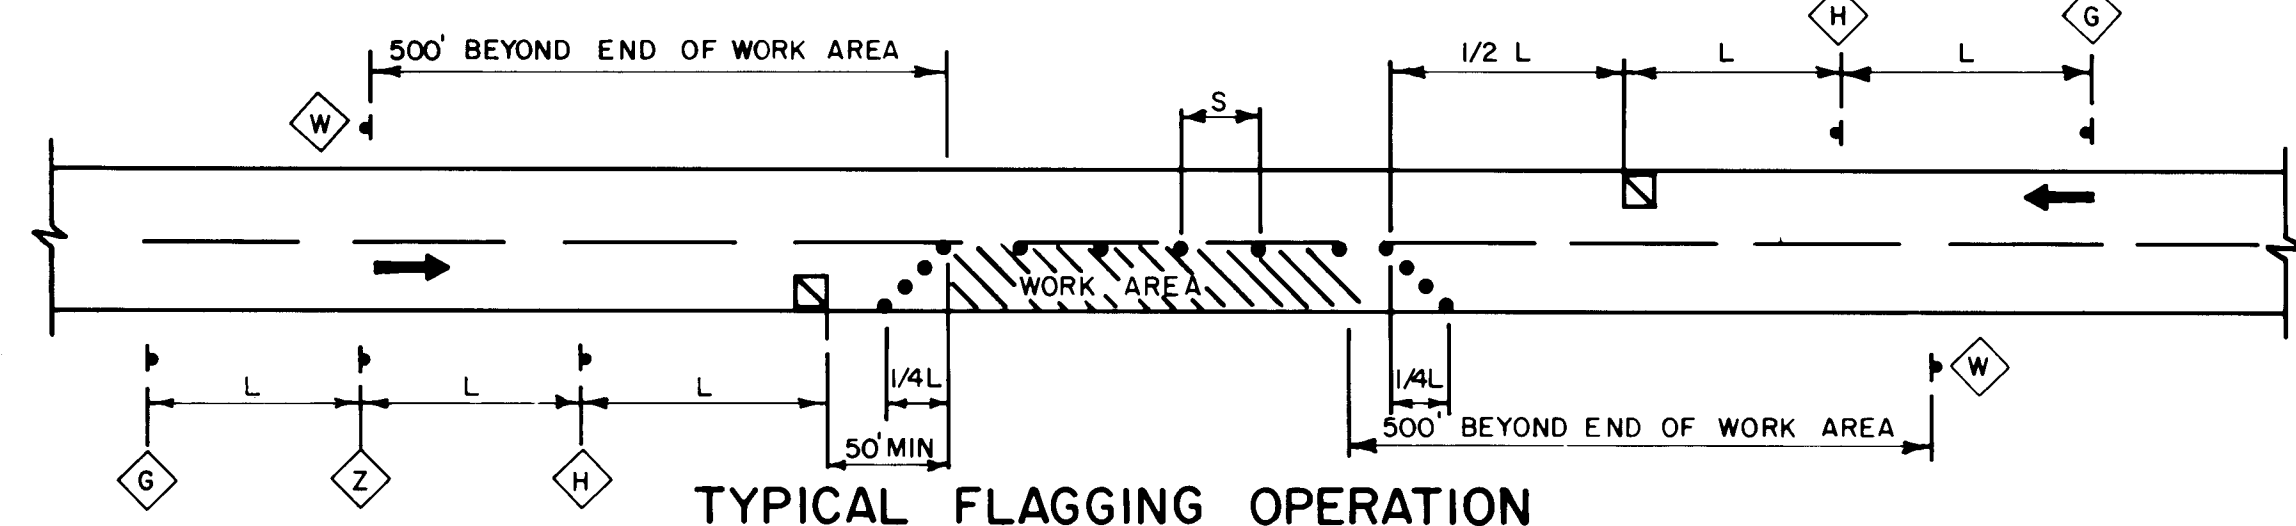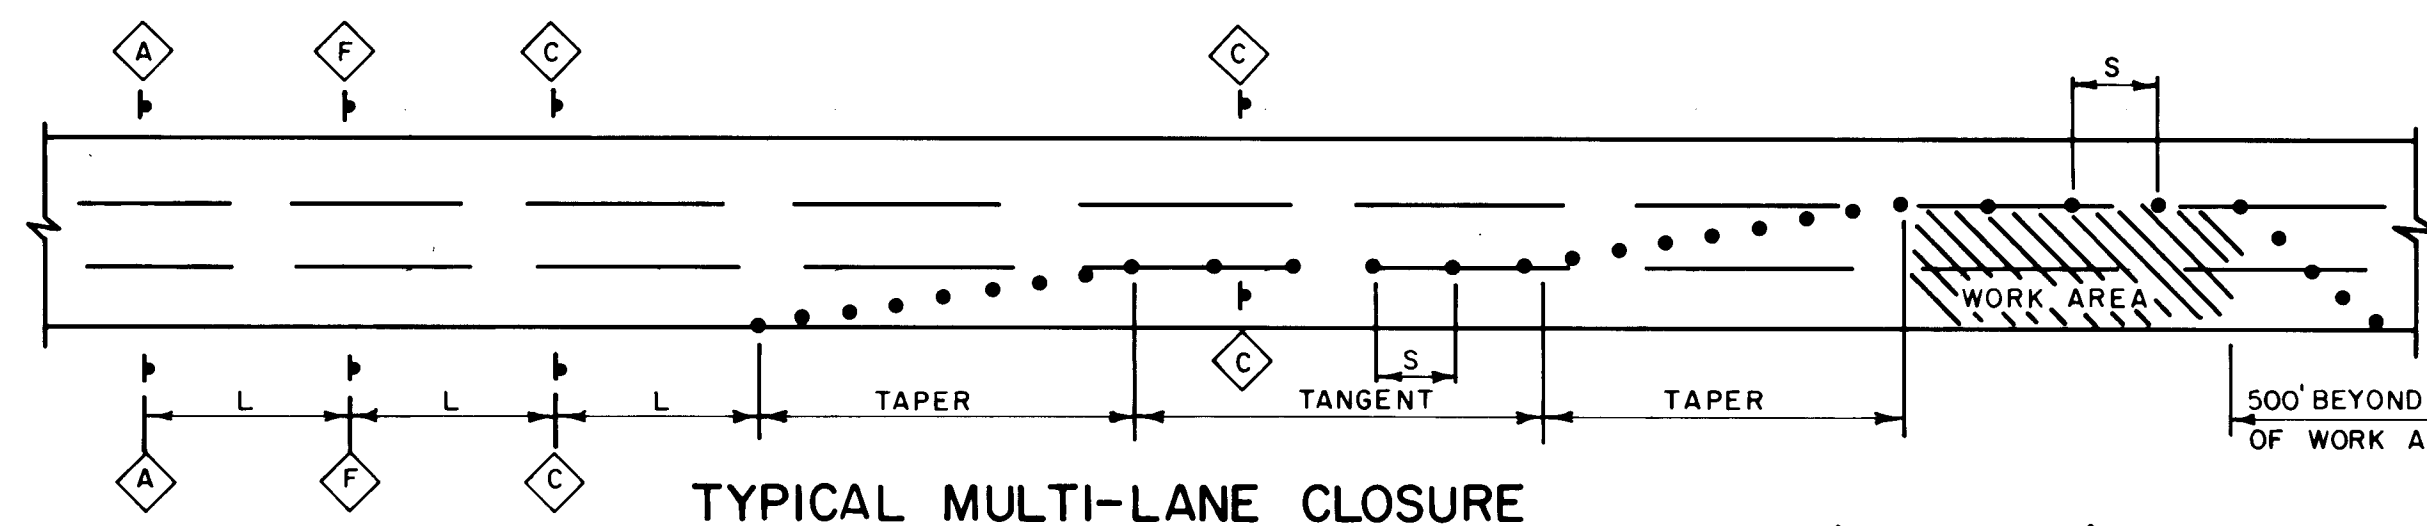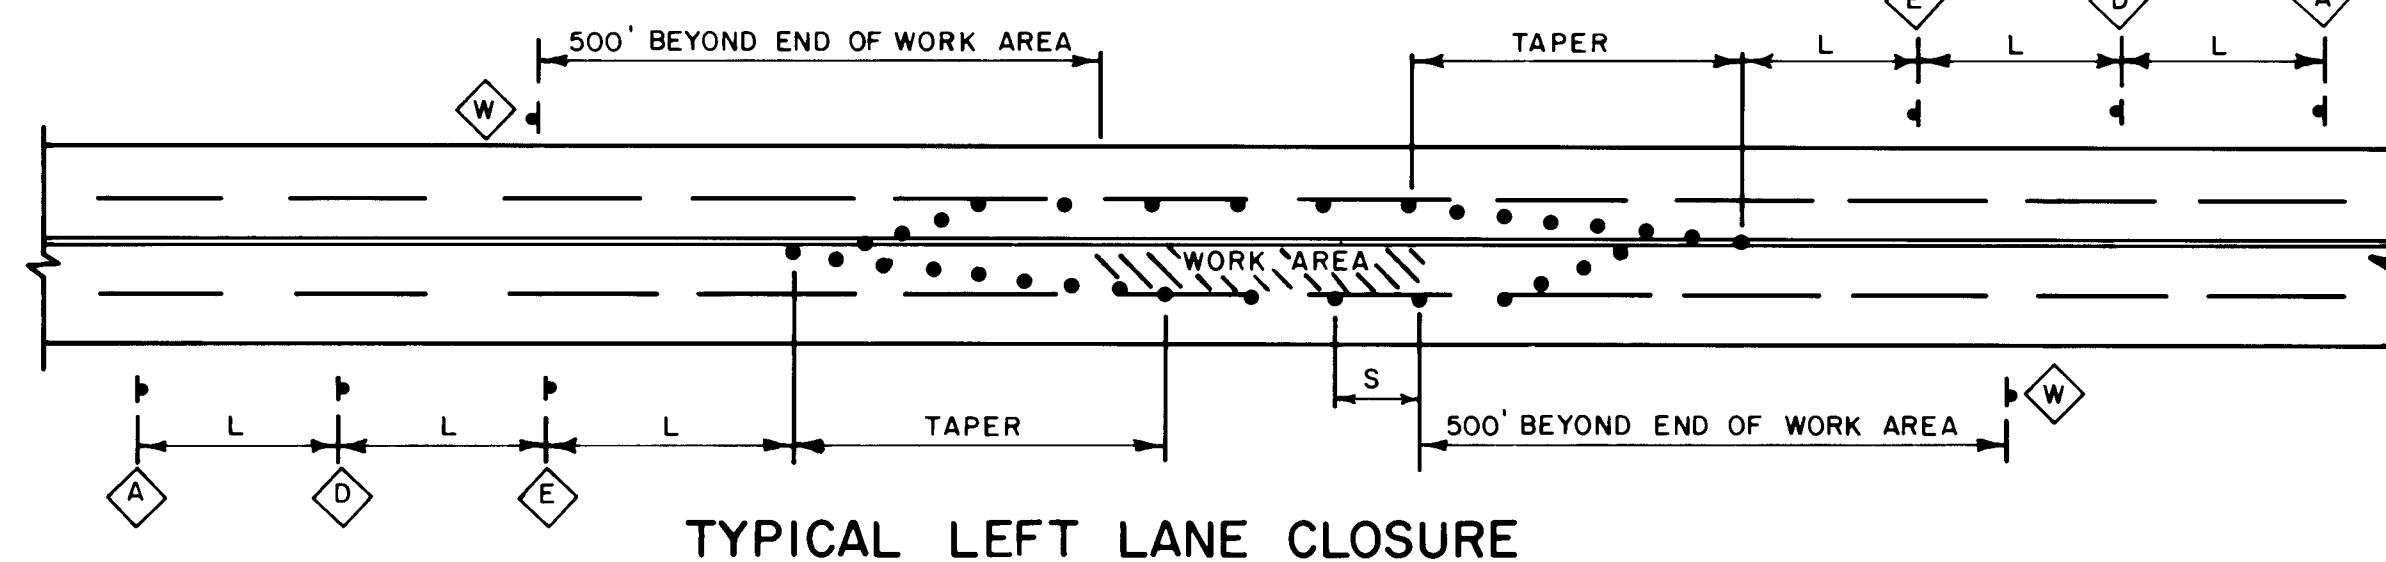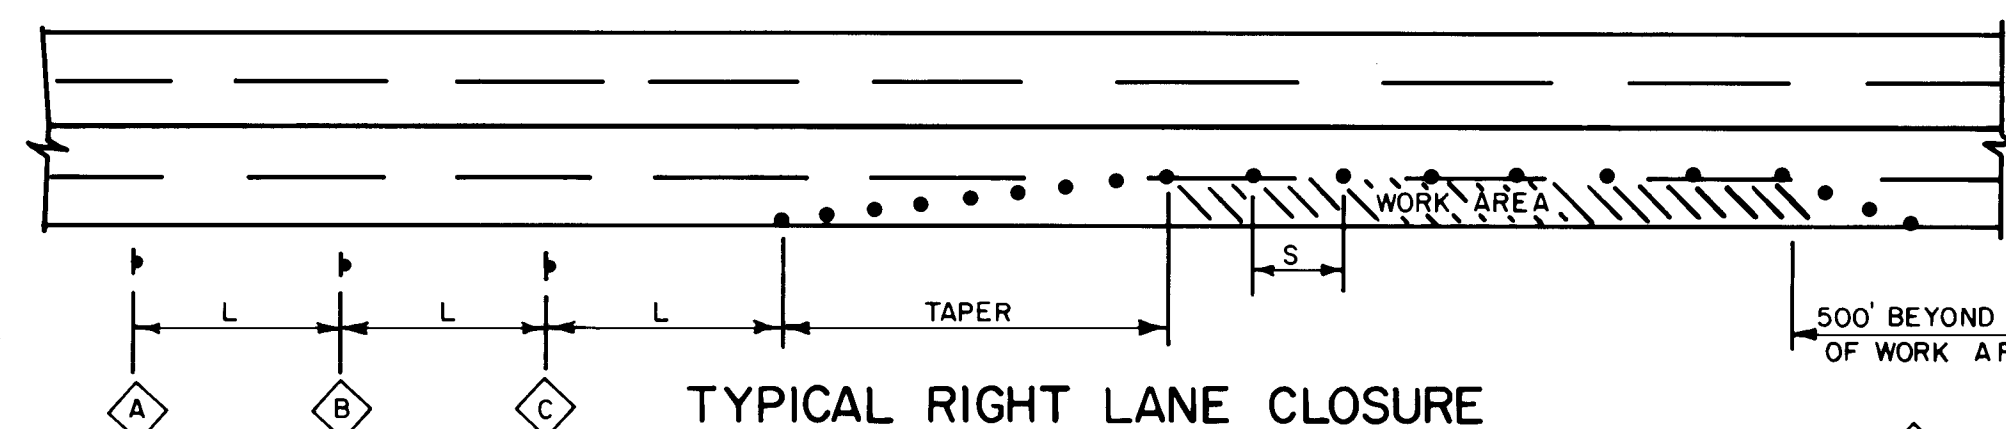


TAPER REQUIREMENTS					
SPEED LIMIT (MPH)	TAPER LENGTH (FEET)			MAXIMUM DISTANCE BETWEEN DEVICES (FEET)	MINIMUM NUMBER OF DEVICES REQUIRED
	10' LANE	11' LANE	12' LANE		
25	104	115	125	25	6
30	150	165	185	30	7
35	204	225	245	35	8
40	267	293	320	40	9
45	450	495	540	45	13
50	500	550	600	50	13
55	550	605	660	55	13

 WORK AREA

	TRAFFIC SIGN & QUANTITY (SEE THIS SHEET FOR DESIGNATION)
●	BARRICADE - TYPE I, TYPE II, OR BARREL
	BARRICADE - TYPE III
X	VERTICAL PANEL
	WARNING SIGN
L	DISTANCE BETWEEN SIGNS—A DISTANCE MEASURED IN FEET EQUAL TO A VALUE OF TEN TIMES THE SPEED LIMIT OF THE STREET
	FLAGMAN POSITION
S	SPACING BETWEEN BARRICADES—A DISTANCE MEASURED IN FEET EQUAL TO THE SPEED LIMIT OF THE STREET

TAPER LENGTH - SEE CHART AT LEFT

TANGENT LENGTH - IS EQUAL TO THE TAPER LENGTH FOR A GIVEN STREET

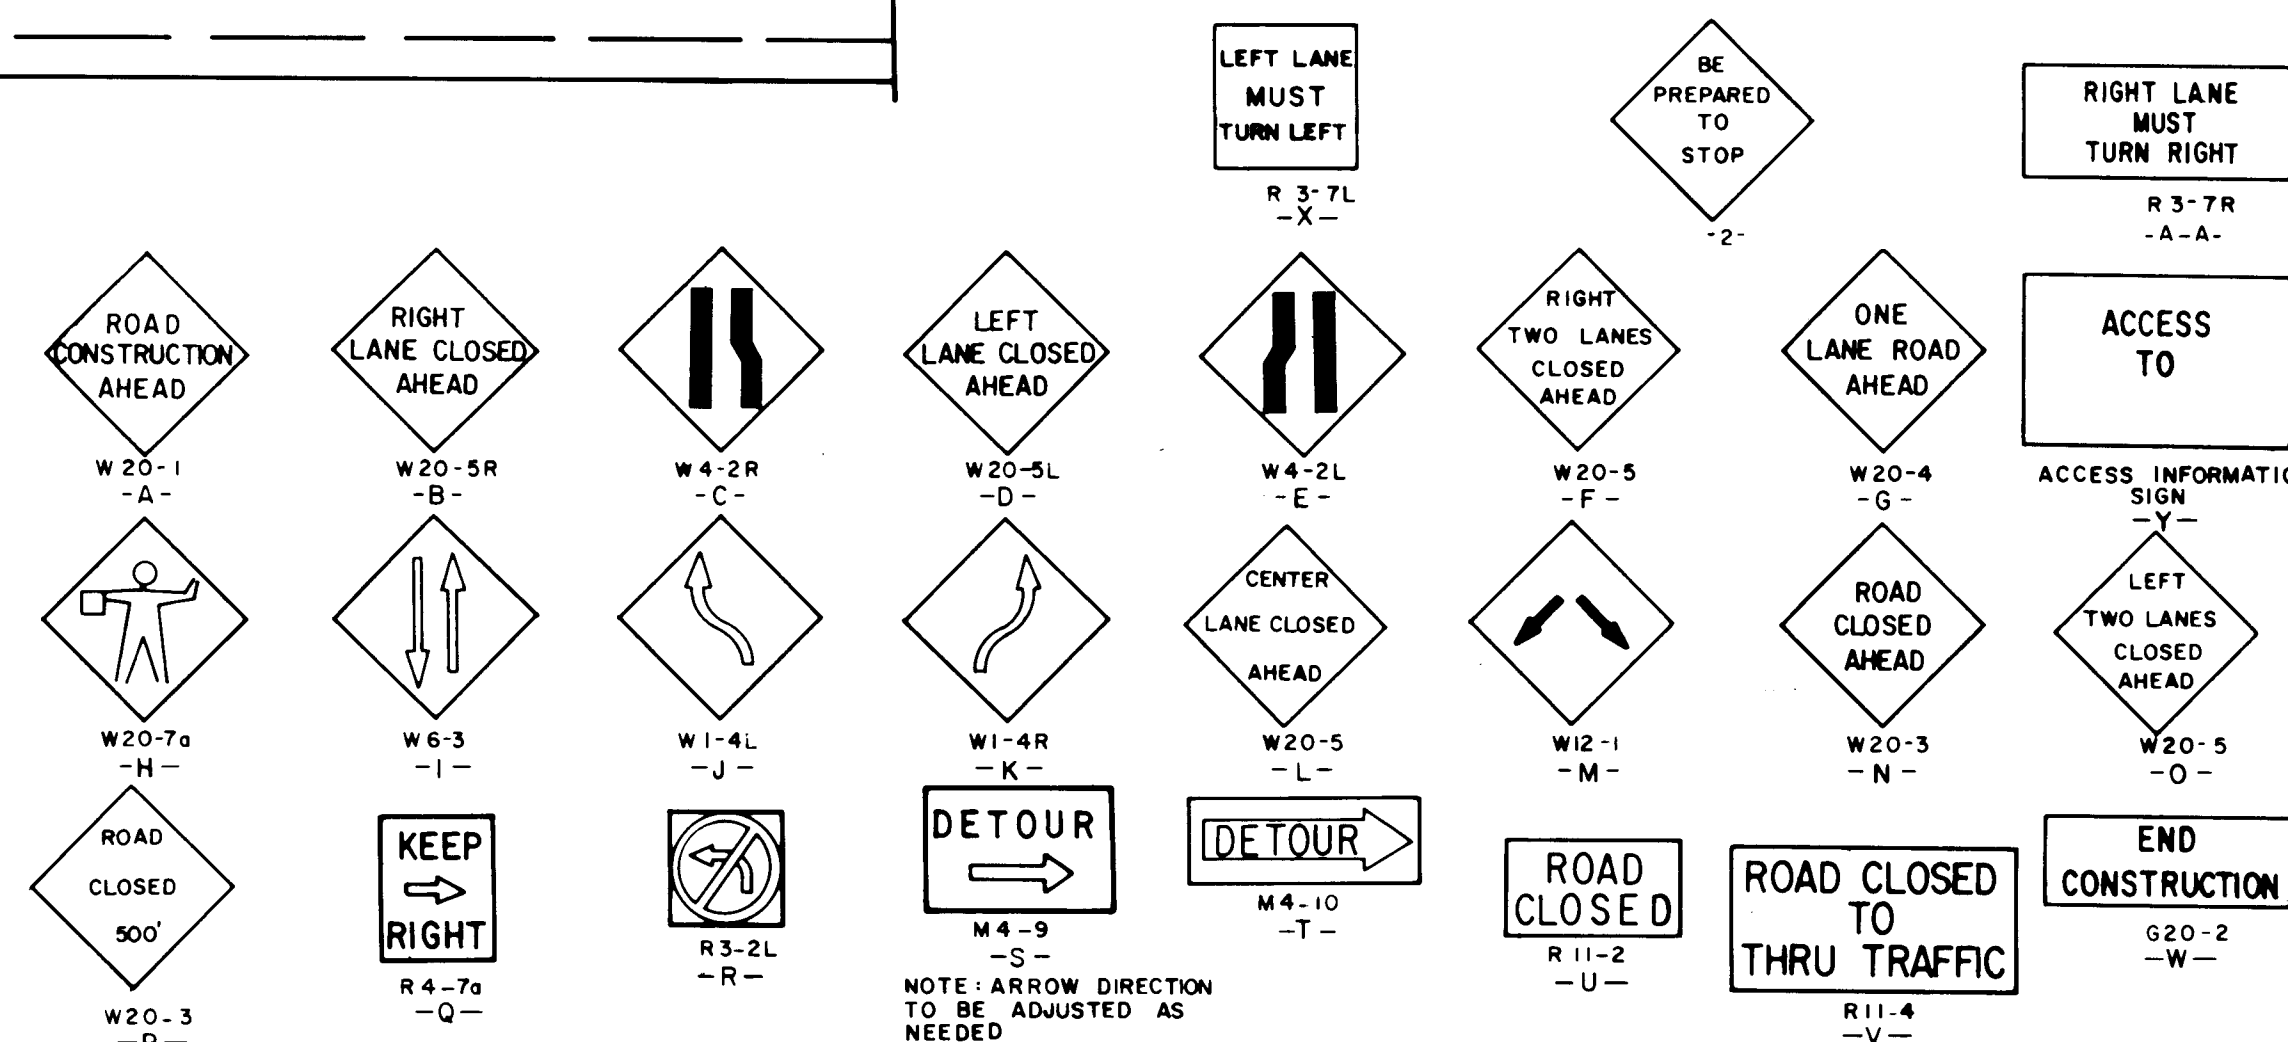

GENERAL TRAFFIC NOTES

1. CONTRACTOR SHALL ADHERE TO SECTION 19 OF THE CITY OF ALBUQUERQUE STANDARD SPECIFICATIONS FOR CONSTRUCTION, 1986.
 2. CONTRACTOR SHALL MAINTAIN ACCESS TO ALL FACILITIES, BUSINESSES, AND RESIDENTS AT ALL TIMES.
 3. CONTRACTOR SHALL PROVIDE ACCESS SIGNS AS DIRECTED BY THE TRAFFIC ENGINEER. ACCESS SIGNS SHALL HAVE BLUE REFLECTORIZED BACK GRUND WITH 5" WHITE LETTERING. SIGNS ARE TO BE CONSIDERED INCIDENTAL TO CONTRACT, AND ARE NOT PART OF BID.
 4. EQUIPMENT AND MATERIALS ARE NOT TO BE STORED WITHIN THE STREET RIGHT-OF-WAY.
 5. CONTRACTOR SHALL INSURE THAT ALL CONSTRUCTION SITES ARE INSPECTED AND MAINTAINED TWICE DAILY AND ONCE DURING THE HOURS OF DARKNESS.
 6. CONTRACTOR IS TO OPEN AND CLOSE TRENCHES ON THE SAME DAY, AS MUCH AS IS POSSIBLE.
 7. CONTRACTOR SHALL NOTIFY EACH FACILITY, BUSINESS, AND RESIDENT, BY WRITTEN LETTER ON 6TH STREET FROM LOMAS TO MCKNIGHT. THE LETTER SHALL INFORM OCCUPANT OF SCOPE OF WORK, TENTATIVE START UP DATE, TENTATIVE COMPLETION DATE, AND PROPOSED LENGTH OF ROAD CLOSURE.
 8. PRIOR TO CONSTRUCTION CONTRACTOR SHALL PROVIDE ADVISORY SIGN, DOUBLE INDICATED, TO BE PLACED SOUTH OF THE INTERSECTION OF 6TH STREET AND LOMAS. SIGNS SHOULD READ "ROAD CONSTRUCTION AHEAD, TRAFFIC DELAYS ANTICIPATED, SEEK ALTERNATE ROUTES, THRU 2ND, 4TH, OR 5TH STREET. 6TH STREET BETWEEN LOMAS AND MOUNTAIN ROAD UNDER CONSTRUCTION BETWEEN 'DATE' AND 'DATE'. (SIGN WILL CHANGE AS THE CONSTRUCTION AND PHASES PROGRESSES.)
 9. CONTRACTOR CANNOT PROGRESS TO FOLLOWING PHASE UNTIL PREVIOUS PHASE HAS ASPHALTIC SURFACE COURSE CONSTRUCTED.
 10. CONTRACTOR MUST PROVIDE RESIDENTS WITH EARTH RAMPS OR STEEL PLATES TO GAIN ENTRY INTO THEIR PERSONAL PROPERTY.
 11. ALL SIGNS TO BE FACING DIRECTION OR TRAFFIC.
 12. LANE CLOSURES AND OTHER INDIVIDUAL SITUATIONS WILL BE ADDRESSED AS THEY ARISE. NOT ALL BARRICADING WILL NECESSARILY BE REQUIRED AT ALL TIMES AND IS SUBJECT TO REVISION UPON APPROVAL OF THE ASSISTANT CITY ENGINEER FOR CONSTRUCTION COORDINATION.
- SEE SHEET 22 OF 22 FOR CONTINUATION OF GENERAL FACTORY NOTES.

SEE SHEET 22 OF 22 FOR CONTINUATION OF
GENERAL TRAFFIC NOTES.

[illegible]



GENERAL TRAFFIC NOTES (CONTINUED)

13. THE PHASES SHOWN ARE CONCEPTUAL ONLY AND DO NOT CONSTITUTE A COMPLETE TRAFFIC CONTROL PLAN.
14. THE CONTRACTOR SHALL SUBMIT TO THE ASSISTANT CITY ENGINEER FOR CONSTRUCTION COORDINATION, A TRAFFIC CONTROL PLAN FOR EACH PHASE AND SHALL NOT PROCEED INTO A PHASE PRIOR TO THE COORDINATOR'S APPROVAL.
15. THE CONTRACTOR SHALL BE RESPONSIBLE FOR ALL TEMPORARY STRIPING, SIGNING AND BARRICADEING REQUIRED DURING CONSTRUCTION OF THE PROJECT TO INCLUDE THE FIFTH STREET AND OTHER DETOURS AND THESE CONTROLS SHALL BE INCLUDED IN AND INCIDENTAL TO THE BID ITEM OF TRAFFIC CONTROL.
16. TEMPORARY DETOUR PAVEMENT MARKINGS SHALL NOT BE ALLOWED ON DETOUR ROUTING EXCEPT UNDER THE FOLLOWING CONDITIONS:
 - a.) THE MATERIAL TO BE APPLIED HAS BEEN APPROVED BY CITY TRAFFIC ENGINEERING OPERATIONS, OR
 - b.) THE DETOUR PAVEMENT IS TO BE RESURFACED AS PART OF THIS PROJECT
17. THE CONTRACTOR SHALL WORK WITHIN THE PHASES AS FOLLOWS:

PHASE I 6TH STREET FROM LOMAS BOULEVARD TO MOUNTAIN ROAD. MAJOR ITEMS OF WORK WILL BE PERFORMED FROM MOUNTAIN ROAD TO SLATE AVENUE UNDER FULL CLOSURE WITH THE FIFTH STREET DETOUR IN EFFECT. ONE LANE OF SOUTH BOUND TRAFFIC MUST BE MAINTAINED AT ALL TIMES ON 6TH STREET FROM SLATE AVENUE TO LOMAS BOULEVARD, AND WORK PERFORMED IN THE AREA WILL BE IN ACCORDANCE WITH TYPICAL LANE CLOSURES.

PHASE II 6TH STREET FROM BELLAMAH AVENUE TO MOUNTAIN ROAD.
MAJOR ITEMS OF WORK WILL BE PERFORMED WITHIN THIS AREA
UNDER FULL CLOSURE WITH THE FIFTH STREET DETOUR IN EFFECT.

PHASE III 6TH STREET FROM McKNIGHT AVENUE TO BELLAMAH AVENUE.
MAJOR ITEMS OF WORK WILL BE PERFORMED WITHIN THIS AREA
UNDER FULL CLOSURE WITH THE FIFTH STREET DETOUR IN EFFECT.

PHASE IV 6TH STREET AT THE INTERSECTION OF MOUNTAIN ROAD. DUE TO THE LARGE VOLUME OF TRAFFIC ON MOUNTAIN ROAD, THE CONTRACTOR WILL EXPEDITE ALL WORK IN THIS SECTION TO INCLUDE CONTINUOUS OPERATIONS AND HIGH EARLY STRENGTH CONCRETE FOR ADJUSTMENTS OF WATER VALVE BOXES AND MANHOLE FRAMES AND COVERS. THE PREMIUM COST FOR THIS WORK AND MATERIALS WILL NOT BE CONSIDERED FOR SEPARATE PAYMENT BUT SHALL BE CONSIDERED AS INCIDENTAL TO THE CONTRACT.

THE WORK ITEMS OF CLEANING, VIDEO TAPING AND INVERSION LINING OF SANITARY SEWERS WILL BE ALLOWED TO PROGRESS BEYOND PHASE LIMITS IF ONE LANE OF SOUTH BOUND TRAFFIC CAN BE MAINTAINED AT ALL TIMES ON 6TH STREET ADJACENT TO THESE WORK AREAS IN ACCORDANCE WITH TYPICAL LANE CLOSURES.

[illegible]

1	2	3	4	5	6	7	8	9	10	11	12
26			35	68	22	90					

RECORD DRAWING
Drawings revised to reflect the
best information available. Do
not use without field verification.

CITY OF ALBUQUERQUE					
PUBLIC WORKS DEPARTMENT					
TITLE: SIXTH STREET IMPROVEMENTS TRAFFIC CONTROL PLAN					
APPROVALS	ENGINEER	DATE	APPROVALS	ENGINEER	DATE
City Engineer	<i>Roger Sherman</i>	4/27/77	Liquid Waste	<i>Raso</i>	4/27/77
A.C.E. Design	<i>ll</i>	<i>ll</i>	Traffic	<i>Roger Sherman</i>	4/27/77
A.C. E -Hydrology	<i>ll</i>	<i>ll</i>	Water	<i>Raso</i>	4/27/77
DRAWING NO. 3568		MAP NO. H-14 & J-14		SHEET 22 OF 22	