


SCALE: 1" = 20' HORIZ.  
1" = 10' VERT.

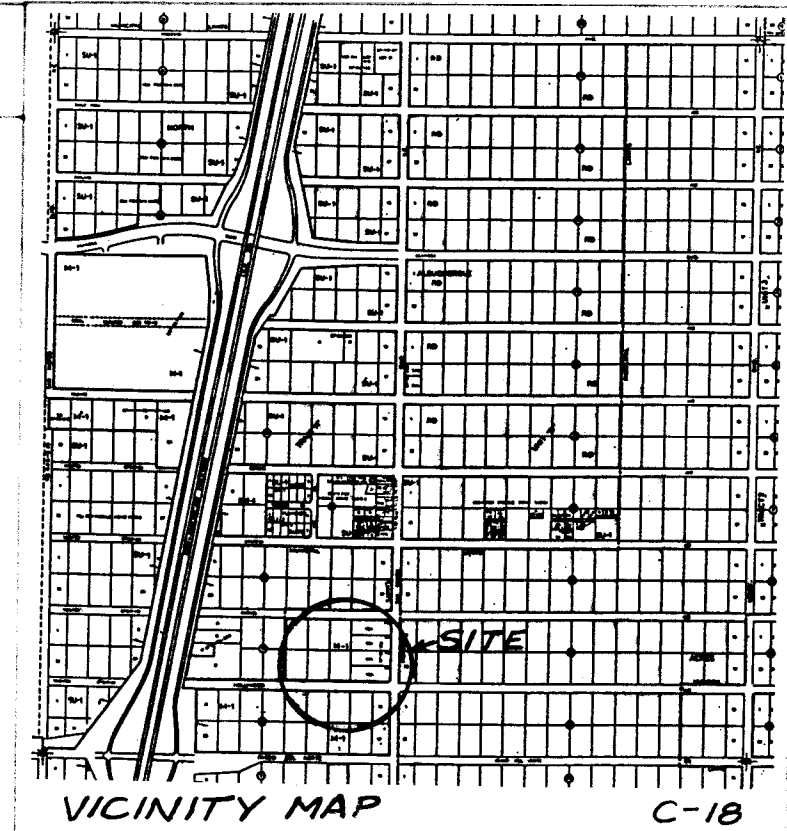

- CONSTRUCTION NOTES:**
1. TWO WORKING DAYS PRIOR TO ANY EXCAVATION, CONTRACTOR MUST CONTACT LINE LOCATING SERVICE 765-1834, FOR LOCATION OF EXISTING UTILITIES.
  2. PRIOR TO CONSTRUCTION, THE CONTRACTOR SHALL EXCAVATE AND VERIFY THE HORIZONTAL AND VERTICAL LOCATION OF ALL POTENTIAL OBSTRUCTIONS. SHOULD A CONFLICT EXIST, THE CONTRACTOR SHALL NOTIFY THE ENGINEER SO THAT THE CONFLICT CAN BE RESOLVED WITH A MINIMUM AMOUNT OF DELAY.
  3. ALL WORK ON THIS PROJECT SHALL BE PERFORMED IN ACCORDANCE WITH APPLICABLE FEDERAL, STATE AND LOCAL LAWS AND RULES AND REGULATIONS CONCERNING CONSTRUCTION SAFETY AND HEALTH.
  4. ALL CONSTRUCTION WITHIN PUBLIC RIGHT-OF-WAY SHALL BE PERFORMED IN ACCORDANCE WITH APPLICABLE CITY OF ALBUQUERQUE STANDARDS AND PROCEDURES.
  5. IF ANY UTILITY LINES, PIPELINES, OR UNDERGROUND UTILITY LINES ARE SHOWN ON THESE DRAWINGS, THEY ARE SHOWN IN AN APPROXIMATE MANNER ONLY, AND SUCH LINES MAY EXIST WHERE NONE ARE SHOWN. IF ANY SUCH EXISTING LINES ARE SHOWN, THE LOCATION IS BASED UPON INFORMATION PROVIDED BY THE OWNER OF SAID UTILITY, AND THE INFORMATION MAY BE INCOMPLETE, OR MAY BE OBSOLETE BY THE TIME CONSTRUCTION COMMENCES. THEREFORE, THE CONTRACTOR SHALL INFORM ITSELF OF THE LOCATION OF ANY UTILITY LINE, PIPELINE, OR UNDERGROUND UTILITY LINE IN OR NEAR THE AREA OF THE WORK IN ADVANCE OF AND DURING EXCAVATION WORK. THE CONTRACTOR IS FULLY RESPONSIBLE FOR ANY AND ALL DAMAGE CAUSED BY ITS FAILURE TO LOCATE, IDENTIFY AND PRESERVE ANY AND ALL EXISTING UTILITIES, PIPELINES, AND UNDERGROUND UTILITY LINES. IN PLANNING AND CONDUCTING EXCAVATION, THE CONTRACTOR SHALL COMPLY WITH STATE STATUTES, MUNICIPAL AND LOCAL ORDINANCES, AND RULES AND REGULATIONS, IF ANY, PERTAINING TO THE LOCATION OF THESE LINES AND FACILITIES.
  6. TOPOGRAPHIC SURVEY PREPARED BY SOUTHWEST SURVEYING CO., INC., AND PROVIDED BY OWNER OF THE PROJECT. ITS ADEQUACY AND ACCURACY IS HEREBY DISCLAIMED AS IT RELATED TO THIS DRAWING.
- PAVING NOTES:**
1. EXISTING PAVING ON HOLLYWOOD AVENUE IS A TEMPORARY PAVING SECTION.
  2. EXISTING TEMPORARY PAVING DESTROYED BY EXCAVATION FOR INSTALLATION OF THE WATERLINE TO BE REPLACED WITH CITY TEMPORARY PAVING SECTION, CITY STD. DRWG. NO. 24151.

APPROVAL OF AS BUILT SURVEYS  
GARY W. TIBLJAS  
10-28-88

GARY W. TIBLJAS & COMPANY  
CIVIL ENGINEERING  
ARCHITECTURE  
DEVELOPMENT SERVICES  
12 JUNIPER HILL RD. NE  
ALBUQUERQUE, NM 87128  
(505) 266-8285

WATERLINE EXTENSION  
600' HOLLYWOOD AVE. N.E.

11/88 Revised from As-Built information  
REMARKS  
4/1 VISIONS  
DESIGN  
BY  
DATE  
DATE

ENGINEER'S SEAL  
GARY W. TIBLJAS  
REGISTERED PROFESSIONAL ENGINEER  
NO. 11188  
11/88 Revised from As-Built information  
REMARKS  
4/1 VISIONS  
DESIGN  
BY  
DATE  
DATE

Handwritten note: 11/12/88