


CONSTRUCTION PLANS
FOR
INFRASTRUCTURE IMPROVEMENTS
MARKET CENTER WEST
(PHASE 1)
ALBUQUERQUE, NEW MEXICO

SHEET NO.	DESCRIPTION
1	TITLE SHEET
2	PLAT
3	DRAINAGE PLAN
4	KEY SHEET
5-6	EAGLE RANCH ROAD PLAN AND PROFILE SHEETS
7	IRVING BOULEVARD PLAN AND PROFILE SHEET
8-9	COORS BOULEVARD PLAN AND PROFILE SHEETS
10	STORM SEWER PLAN AND PROFILE SHEET
11	STORM SEWER DETAILS
12-17	SIGNALIZATION DETAILS

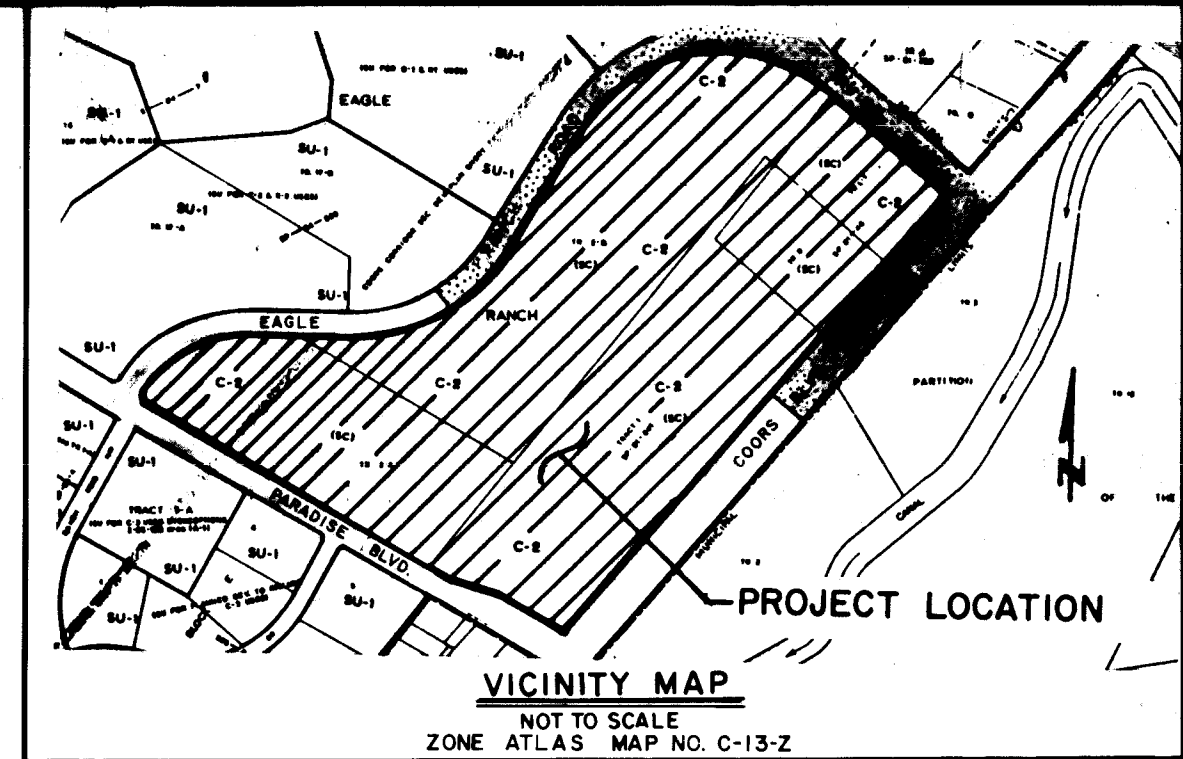


GENERAL NOTES

NOTICE TO CONTRACTORS

- ALL WORK DETAILED ON THESE PLANS TO BE PERFORMED UNDER CONTRACT SHALL, EXCEPT AS OTHERWISE STATED OR PROVIDED FOR HEREON, BE CONSTRUCTED IN ACCORDANCE WITH CITY OF ALBUQUERQUE STANDARD SPECIFICATIONS FOR PUBLIC WORKS CONSTRUCTION, 1986 EDITION
- TWO WORKING DAYS PRIOR TO ANY EXCAVATION, CONTRACTOR MUST CONTACT LINE LOCATING SERVICE, 765-1234, FOR LOCATION OF EXISTING UTILITIES.
- PRIOR TO CONSTRUCTION, THE CONTRACTOR SHALL EXCAVATE AND VERIFY THE HORIZONTAL AND VERTICAL LOCATIONS OF ALL OBSTRUCTIONS. SHOULD A CONFLICT EXIST, THE CONTRACTOR SHALL NOTIFY THE ENGINEER OR SURVEYOR SO THAT THE CONFLICT CAN BE RESOLVED WITH A MINIMUM AMOUNT OF DELAY.

THE FOLLOWING NOTES ALSO APPLY WHEN CHECKED

- ☒ ALL UTILITIES AND UTILITY SERVICE LINES SHALL BE INSTALLED PRIOR TO PAVING.
- ☒ BACKFILL COMPACTION SHALL BE ACCORDING TO SPECIFIED STREET USE.
- ☒ TACK COAT REQUIREMENTS SHALL BE DETERMINED BY THE CITY ENGINEER.
- ☒ SIDEWALKS AND WHEELCHAIR RAMPS WITHIN THE CURB RETURNS SHALL BE CONSTRUCTED WHEREVER A NEW CURB RETURN IS CONSTRUCTED.
- ☐ IF CURB IS DEPRESSED FOR A DRIVEPAD, THE DRIVEPAD SHALL BE CONSTRUCTED PRIOR TO ACCEPTANCE OF CURB AND GUTTER.
- ☒ ALL STORM DRAINAGE FACILITIES SHALL BE COMPLETED PRIOR TO FINAL ACCEPTANCE.
- ☒ THE REQUESTOR OR DEVELOPER SHALL BE RESPONSIBLE FOR REPAIR OR REPLACEMENT OF ALL CURB AND GUTTER OR SIDEWALK DAMAGED AFTER APPROVAL BY THE CITY ENGINEER OF WORK COMPLETED BY THE CONTRACTOR.

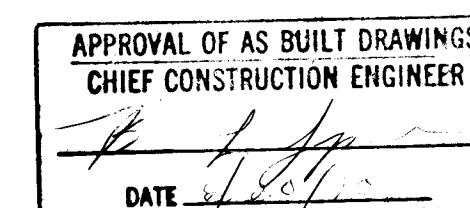

1	2	3	4	5	6	7	8	9	10	11	12
2	6	3	5	7	5	0	1	9	0		


△	7, 8, 9	Roger A. Kheen	4/7/99	David W. Hummer	4/18/99	N/A					
△	10, 11	Roger A. Kheen	4/18/99	N/A		N/A					
△	8, 9	Roger A. Kheen	4/18/99	N/A		N/A					
△	8, 10	Roger A. Kheen	4/27/99	N/A		N/A					
REV	SHEETS	CITY ENGINEER	DATE	USER	DEPT.	DATE	USER	DEPT.	DATE		

APPROVAL OF REVISIONS

		APPROVED FOR CONSTRUCTION 5/16/99 C.E.
PROJECT NUMBER 3575		JOB NO. 8821905 SHEET 1 OF 17

CONSTRUCTION PLANS FOR INFRASTRUCTURE IMPROVEMENTS MARKET CENTER WEST (PHASE 1) ALBUQUERQUE, NEW MEXICO

SHEET NO.	DESCRIPTION
1	TITLE SHEET
2	PLAT
3	DRAINAGE PLAN
4	KEY SHEET
5-6	EAGLE RANCH ROAD PLAN AND PROFILE SHEETS
7	IRVING BOULEVARD PLAN AND PROFILE SHEET
8-9	COORS BOULEVARD PLAN AND PROFILE SHEETS
10	STORM SEWER PLAN AND PROFILE SHEET
11	STORM SEWER DETAILS
12-17	SIGNALIZATION DETAILS

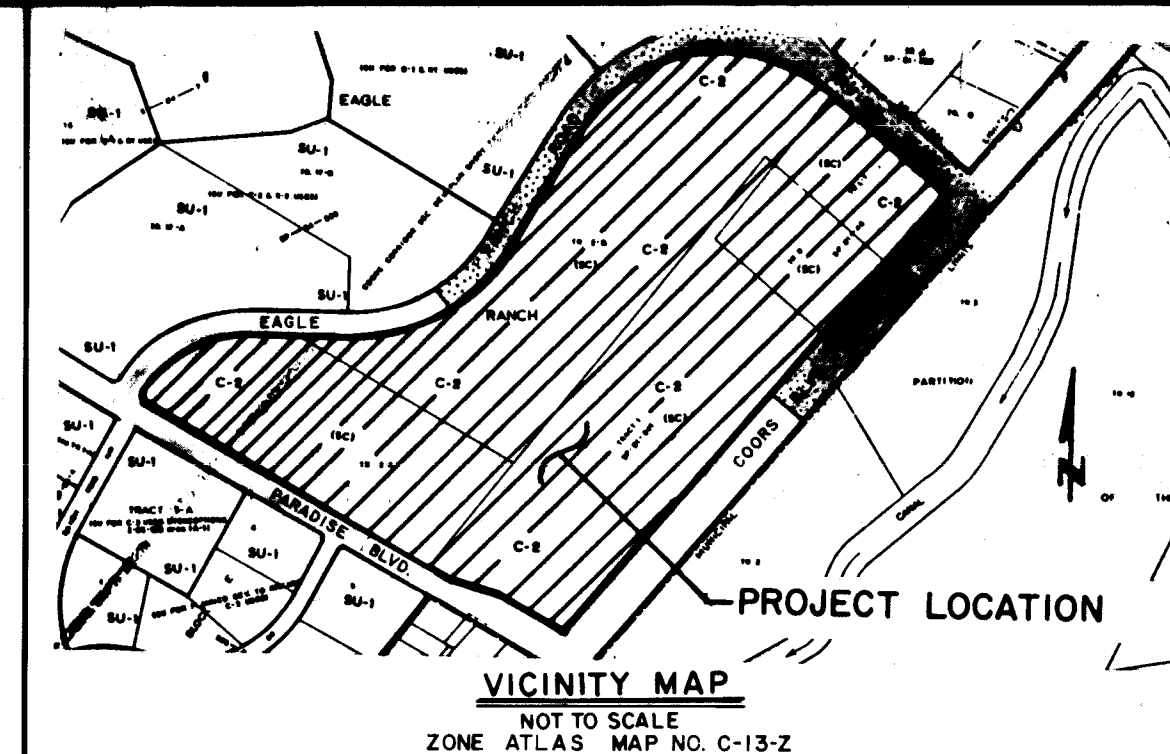


GENERAL NOTES

NOTICE TO CONTRACTORS

- ALL WORK DETAILED ON THESE PLANS TO BE PERFORMED UNDER CONTRACT SHALL, EXCEPT AS OTHERWISE STATED OR PROVIDED FOR HEREON, BE CONSTRUCTED IN ACCORDANCE WITH CITY OF ALBUQUERQUE STANDARD SPECIFICATIONS FOR PUBLIC WORKS CONSTRUCTION, 1986 EDITION.
- TWO WORKING DAYS PRIOR TO ANY EXCAVATION, CONTRACTOR MUST CONTACT LINE LOCATING SERVICE, 765-1234, FOR LOCATION OF EXISTING UTILITIES.
- PRIOR TO CONSTRUCTION, THE CONTRACTOR SHALL EXCAVATE AND VERIFY THE HORIZONTAL AND VERTICAL LOCATIONS OF ALL OBSTRUCTIONS. SHOULD A CONFLICT EXIST, THE CONTRACTOR SHALL NOTIFY THE ENGINEER OR SURVEYOR SO THAT THE CONFLICT CAN BE RESOLVED WITH A MINIMUM AMOUNT OF DELAY.

THE FOLLOWING NOTES ALSO APPLY WHEN CHECKED

- ☒ ALL UTILITIES AND UTILITY SERVICE LINES SHALL BE INSTALLED PRIOR TO PAVING.
- ☒ BACKFILL COMPACTION SHALL BE ACCORDING TO SPECIFIED STREET USE.
- ☒ TACK COAT REQUIREMENTS SHALL BE DETERMINED BY THE CITY ENGINEER.
- ☒ SIDEWALKS AND WHEELCHAIR RAMPS WITHIN THE CURB RETURNS SHALL BE CONSTRUCTED WHEREVER A NEW CURB RETURN IS CONSTRUCTED.
- ☐ IF CURB IS DEPRESSED FOR A DRIVEPAD, THE DRIVEPAD SHALL BE CONSTRUCTED PRIOR TO ACCEPTANCE OF CURB AND GUTTER.
- ☒ ALL STORM DRAINAGE FACILITIES SHALL BE COMPLETED PRIOR TO FINAL ACCEPTANCE.
- ☒ THE REQUESTOR OR DEVELOPER SHALL BE RESPONSIBLE FOR REPAIR OR REPLACEMENT OF ALL CURB AND GUTTER OR SIDEWALK DAMAGED AFTER APPROVAL BY THE CITY ENGINEER OF WORK COMPLETED BY THE CONTRACTOR.

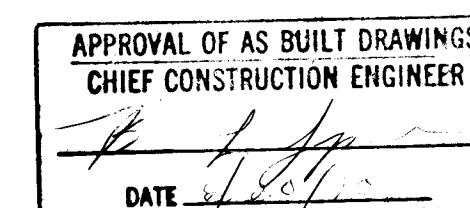

1	2	3	4	5	6	7	8	9	10	11	12
2	6	3	5	7	5	0	1	9	0		

△	7, 8, 9	Roger A. Kheen	4/17/99	David W. Hummer	4/18/99	N/A					
△	10, 11	Roger A. Kheen	4/17/99	N/A		N/A					
△	8, 9	Roger A. Kheen	4/17/99	N/A		N/A					
△	8, 10	Roger A. Kheen	4/17/99	N/A		N/A					
REV	SHEETS	CITY ENGINEER	DATE	USER	DEPT.	DATE	USER	DEPT.	DATE		

APPROVAL OF REVISIONS

		APPROVED FOR CONSTRUCTION
PROJECT NUMBER 3575		JOB NO. 8821905 SHEET 1 OF 17

FIRST REPLAT MAP OF MARKET CENTRE WEST

 ALBUQUERQUE, NEW MEXICO
 SEPTEMBER 1988

Free Consent and Dedication

The foregoing replat of that certain tract of land situate within the Town of Alameda Grant and projected Section 18, Township 11 North, Range 3 East, New Mexico Principal Meridian, City of Albuquerque, Bernalillo County, New Mexico, being Market Centre West, as the same is shown and designated on the plat filed for record in the office of the County Clerk of Bernalillo County, New Mexico, on July 25, 1988, in Volume C37, Folio 124, and now herein shown and designated on this replat, is hereby dedicated to the public use of the County of Los Angeles, California, and the undersigned owner(s) and/or proprietor(s) thereof and said owner(s) and/or proprietor(s) do hereby dedicate the 0.0523 easements shown on this plat. Electrical, Power, and Communication easements are reserved for overhead distribution lines for pole type utilities, and buried distribution lines, conduits, and pipes for underground utilities and other related equipment where shown or indicated, including the right of ingress and egress for construction and maintenance, and the right to trim interfering trees and shrubs.

The owners of lots A-1, B, C, D and E hereby grant to each other and their successors and assigns of interest reciprocal easements for parking, access, drainage, and utilities.

OWNER:

 MARKET CENTER WEST ASSOCIATES
 A California General Partnership

 See [Signature]
 SES/Beck & Associates, Inc.

 [Signature]
 GLENFED Development Corporation

 State of California)
 County of Los Angeles) ss.

The foregoing instrument was acknowledged before me this 26th day of September 1988, by LEC A. Shapiro on behalf of SES/Beck & Associates, Inc., a Delaware Corporation.

 By: [Signature] My commission expires: 2004/1990
 Notary Public

 State of California)
 County of Los Angeles) ss.

The foregoing instrument was acknowledged before me this 23rd day of September 1988, by MICHAEL J. KENNEDY on behalf of GLENFED Development Corporation, a California Corporation.

 By: [Signature] My commission expires: April 10, 1990
 Notary Public

SURVEYOR'S CERTIFICATION

I, A. DWAIN WEAVER, A REGISTERED PROFESSIONAL NEW MEXICO SURVEYOR, CERTIFY THAT THIS PLAT WAS PREPARED BY ME OR UNDER MY SUPERVISION, SHOWS ALL EASEMENTS OF RECORD, MEETS THE MINIMUM REQUIREMENTS FOR MONUMENTATION AND SURVEYS CONTAINED IN THE ALBUQUERQUE SUBDIVISION ORDINANCE, AND IS TRUE AND ACCURATE TO THE BEST OF MY KNOWLEDGE AND BELIEF.

 A. DWAIN WEAVER
 A DWAIN WEAVER & ASSOCIATES
 NMLS NO. 6544

 BOHANNAN-HUSTON, INC.
 7500 JEFFERSON STREET, N.E.
 ALBUQUERQUE, NM 87109

 STATE OF NEW MEXICO) ss.
 COUNTY OF BERNALILLO)

THE FOREGOING INSTRUMENT WAS ACKNOWLEDGED BEFORE ME THIS 19th DAY OF September 1988, BY A. DWAIN WEAVER.

 MY COMMISSION EXPIRES: 2-23-91 [Signature] Dine G. Agan
 Notary Public

JOB NO. 88219.08

SHEET 1 OF 2 SHEETS

C-37, Folio 124

1654-1

DESCRIPTION

A certain tract of land situate within the Town of Alameda Grant, within projected Section 18, Township 11 North, Range 3 East, New Mexico, Principal Meridian, City of Albuquerque, Bernalillo County, New Mexico, being and comprising all of Tract "A" and two (2) easterly portions of Eagle Ranch Road, N.W., right-of-way of MARKET CENTRE WEST, as the same are shown and designated on the plat filed for record in the office of the County Clerk of Bernalillo County, New Mexico, on July 25, 1988, in Volume C37, Folio 12, and being more particularly described by New Mexico State Plane Grid Bearings (Central Zone) and ground distances as follows:

BEGINNING at a point of curvature at the northeast corner of said Tract "A", said corner being also a point on the southerly right-of-way of Irving Boulevard, N.W., from whence the USCGS Monument R. Alameda A-3 (having New Mexico State Plane Grid Coordinates, Central Zone, X = 377,094.67 and Y = 1,523,108.34) bears S59°25'17"E, 410.86 feet, and from said point of beginning running thence along the easterly boundary of said Tract "A" and also along said right-of-way 133.57 feet along the arc of a curve to the right having a radius of 85.00 feet, a central angle of 90°02'13", and a long chord which bears S04°04'21"E, 120.25 feet to a point of tangency on the westerly right-of-way of the New Mexico State Road No. 448 (Coors Road, N.W.); thence, running southwesterly along said State Road right-of-way and also along the easterly boundary of said Tract "A"

S40°56'46"W, 61.00 feet to a point of curvature; thence, 58.09 feet along the arc of a curve to the right having a radius of 38.00 feet, a central angle of 87°35'05", and a long chord which bears S84°44'19"W, 52.60 feet to a point of non-tangency; thence, S38°36'19"W, 44.00 feet to a point of curvature; thence, 61.29 feet along the arc of a curve to the right having a radius of 38.00 feet, a central angle of 92°24'55", and a long chord which bears S05°15'41"E, 54.86 feet to a point of tangency; thence, S40°56'46"W, 60.23 feet to a point of curvature; thence, S54°58'56"W, 20.62 feet to a point of curvature; thence, S40°56'46"W, 40.00 feet to a point of curvature; thence, S49°03'14"E, 12.00 feet to a point of tangency; thence, S40°56'46"W, 40.00 feet to a point of tangency; thence, S26°54'36"W, 20.62 feet to a point of tangency; thence, S40°56'46"W, 52.23 feet to a point of tangency; thence, S49°04'34"W, 35.36 feet to a point of tangency; thence, S40°56'46"W, 101.60 feet to a point of curvature; thence, 58.09 feet along the arc of a curve to the right having a radius of 38.00 feet, a central angle of 87°35'05", and a long chord which bears S84°44'19"W, 52.60 feet to a point of non-tangency; thence, S38°36'19"W, 44.00 feet to a point of curvature; thence, 61.29 feet along the arc of a curve to the right having a radius of 38.00 feet, a central angle of 92°24'55", and a long chord which bears S05°15'41"E, 54.86 feet to a point of tangency; thence, S40°56'46"W, 218.19 feet to a point of tangency; thence, S49°04'34"W, 35.36 feet to a point of tangency; thence, S40°56'46"W, 165.41 feet to a point of curvature; thence, 58.09 feet along the arc of a curve to the right having a radius of 38.00 feet, a central angle of 87°35'05", and a long chord which bears S84°44'19"W, 52.60 feet to a point of non-tangency; thence, S38°36'19"W, 44.00 feet to a point of curvature; thence, 61.29 feet along the arc of a curve to the right having a radius of 38.00 feet, a central angle of 92°24'55", and a long chord which bears S05°15'41"E, 54.86 feet to a point of tangency; thence, S40°56'46"W, 429.43 feet to a point of curvature; thence, S43°48'31"W, 440.55 feet to a point of curvature; thence, 102.17 feet along the arc of a curve to the right having a radius of 197.00 feet, a central angle of 29°42'56", and a long chord which bears S55°48'15"W, 101.03 feet to a point of tangency on the southerly boundary of said Tract "A" and also being a point on the northerly right-of-way of Paradise Boulevard, N.W.; thence running northwesterly along said Paradise Boulevard, N.W., right-of-way, and also along the southerly boundary of said Tract "A"

N60°52'41"W, 246.68 feet to a point of tangency; thence, N74°03'16"W, 199.96 feet to a point of tangency; thence, N60°53'47"W, 1,365.25 feet to a point of curvature; thence, 39.27 feet along the arc of a curve to the right having a radius of 25.00 feet, a central angle of 90°00'00", and a long chord which bears N15°53'47"W, 35.36 feet to a point of compound curvature on the easterly right-of-way of Eagle Ranch Road, N.W., and also being a point on the westerly boundary of said Tract "A"; thence running northeasterly along said Eagle Ranch Road, N.W., right-of-way, and also along the westerly boundary of said Tract "A", 28.23 feet along the arc of a curve to the right having a radius of 465.05 feet, a central angle of 03°28'41", and a long chord which bears N30°50'33"E, 28.23 feet to a point of non-tangency; thence, N59°17'48"E, 20.87 feet to a point of curvature; thence, 40.00 feet along the arc of a curve to the right having a radius of 456.05 feet, a central angle of 05°01'31", and a long chord which bears N37°26'13"E, 39.99 feet to a point of non-tangency; thence, S48°47'40"E, 12.00 feet to a point of tangency; thence, N41°12'21"E, 20.00 feet to a point of tangency; thence, N48°47'38"W, 12.00 feet to a point of curvature; thence, 40.00 feet along the arc of a curve to the right having a radius of 456.05 feet, a central angle of 05°01'31", and a long chord which bears N44°50'30"E, 39.99 feet to a point of non-tangency; thence, N23°06'55"E, 20.87 feet to a point of curvature; thence, 330.47 feet along the arc of a curve to the right having a radius of 465.05 feet, a central angle of 40°42'52", and a long chord which bears N70°11'15"E, 323.56 feet to a point of tangency; thence, S89°27'19"E, 389.28 feet to a point of curvature; thence, 479.73 feet along the arc of a curve to the left having a radius of 688.00 feet, a central angle of 39°57'04", and a long chord which bears N70°34'09"E, 470.07 feet to a point of non-tangency; thence, N63°27'51"E, 36.36 feet to a point of curvature; thence, 100.00 feet along the arc of a curve to the left having a radius of 697.00 feet, a central angle of 08°13'13", and a long chord which bears N43°34'07"E, 99.91 feet to a point of reverse curvature; thence, 46.64 feet along the arc of a curve to the right having a radius of 30.00 feet, a central angle of 89°04'21", and a long chord which bears

N03°59'41"E, 42.08 feet to a point of non-tangency; thence, N38°31'51"E, 56.00 feet to a point of tangency; thence, N51°28'09"W, 16.51 feet to a point of curvature; thence, 42.75 feet along the arc of a curve to the right having a radius of 30.00 feet, a central angle of 91°39'11", and a long chord which bears N10°38'34"W, 39.23 feet to a point of tangency; thence, N30°11'02"E, 552.97 feet to a point of curvature; thence, 643.55 feet along the arc of a curve to the right having a radius of 664.03 feet, a central angle of 55°31'43", and a long chord which bears N57°56'53"E, 618.66 feet to a point of compound curvature; thence, 498.24 feet along the arc of a curve to the right having a radius of 631.08 feet, a central angle of 45°14'08", and a long chord which bears S71°41'26"E, 485.40 feet to a point of tangency on the southerly right-of-way of Irving Boulevard, N.W., and also being a point on the northeasterly boundary of said Tract "A", thence running along said southerly right-of-way, and also along the northeasterly boundary of said Tract "A"

Tract contains 73.1549 acres, more or less.

LOCATION MAP

 ZONE ATLAS MAP C-13-Z
 Not To Scale
 SUBDIVISION DATA

1. DRB NUMBER 88-418
2. ZONE ATLAS INDEX NUMBER C-13-Z
3. GROSS SUBDIVISION ACRES: 73.1549 ACRES
4. NUMBER OF TRACTS CREATED: FIVE (5) TRACTS
5. TOTAL MILEAGE OF PARTIAL WIDTH STREET (BUS TRANSFER RIGHT-OF-WAY) CREATED: 0.042 MILES
TOTAL MILEAGE OF PARTIAL WIDTH STREET (BUS BAY RIGHT-OF-WAY) VACATED: 0.053 MILES
6. THESE PROPERTIES ARE WITHIN THE NEW MEXICO UTILITIES, INC. (N.M.U.I.) FRANCHISE AREA. WATER AND SANITARY SEWER CAPABILITIES ARE BASED ON THE N.M.U.I. FACILITIES, NOT THE CITY OF ALBUQUERQUE. WATER AND SANITARY SEWER INFRASTRUCTURE IMPROVEMENTS MUST, HOWEVER, BE BOTH THE CITY OF ALBUQUERQUE AND N.M.U.I.

NOTES

1. BEARINGS ARE BASED ON NEW MEXICO STATE PLANE GRID BEARINGS (CENTRAL ZONE)
2. ALL DISTANCES ARE GROUND DISTANCES.
3. THE PURPOSE & INTENT OF THIS PLAT IS TO CREATE 5 TRACTS, VACATE & DEDICATE R.O.W.
4. CENTERLINE (IN LIEU OF R/W) MONUMENTS TO BE INSTALLED AT ALL CENTERLINE P.C.'S, P.T.'S, ANGLE POINTS AND STREET INTERSECTIONS PRIOR TO ACCEPTANCE OF SUBDIVISION STREET IMPROVEMENTS AND WILL CONSIST OF A FOUR-INCH (4") ALUMINUM ALLOY CAP (WITH MAGNET ATTACHED) STAMPED "CITY OF ALBUQUERQUE", "CENTERLINE MONUMENT", "DO NOT DISTURB", PLS. # 6544"

APPROVALS

PLAT NO. **SP-88-295**

DATE **10/18/88**

PLAT DIRECTOR **[Signature]** DATE **10/11/88**

CITY ENGINEER **[Signature]** DATE **10/11/88**

A.R.A.F.C.A. **[Signature]** DATE **10/7/88**

TRAFFIC ENGINEER **[Signature]** DATE **9/27/88**

CITY SURVEYOR **[Signature]** DATE **9/27/88**

PROPERTY MANAGEMENT **[Signature]** DATE **10-11-88**


NEW MEXICO UTILITIES, INC. **[Signature]** DATE **9-27-88**

PARK & RECREATION DEPARTMENT **[Signature]** DATE **9-20-88**


PUBLIC SERVICE COMPANY OF NEW MEXICO **[Signature]** DATE **9-20-88**

U.S. WEST COMMUNICATIONS **[Signature]** DATE **9-19-88**

U.S. COMPANY OF NEW MEXICO **[Signature]** DATE **9-27-88**

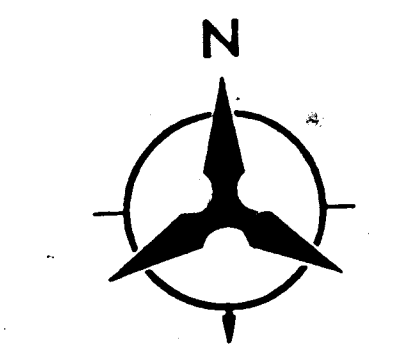 ACS BRASS TABLET STAMPED "ACS 4-B13, 1986"
 N.M. STATE PLANE COORDINATES (CENTRAL ZONE)
 X = 375,489.27 Y = 1,525,104.55
 GROUND TO GRID FACTOR = 0.9996705
 A.C. = 00°04'13"
 ELEV. = 5169.511


SCALE: 1" = 200'

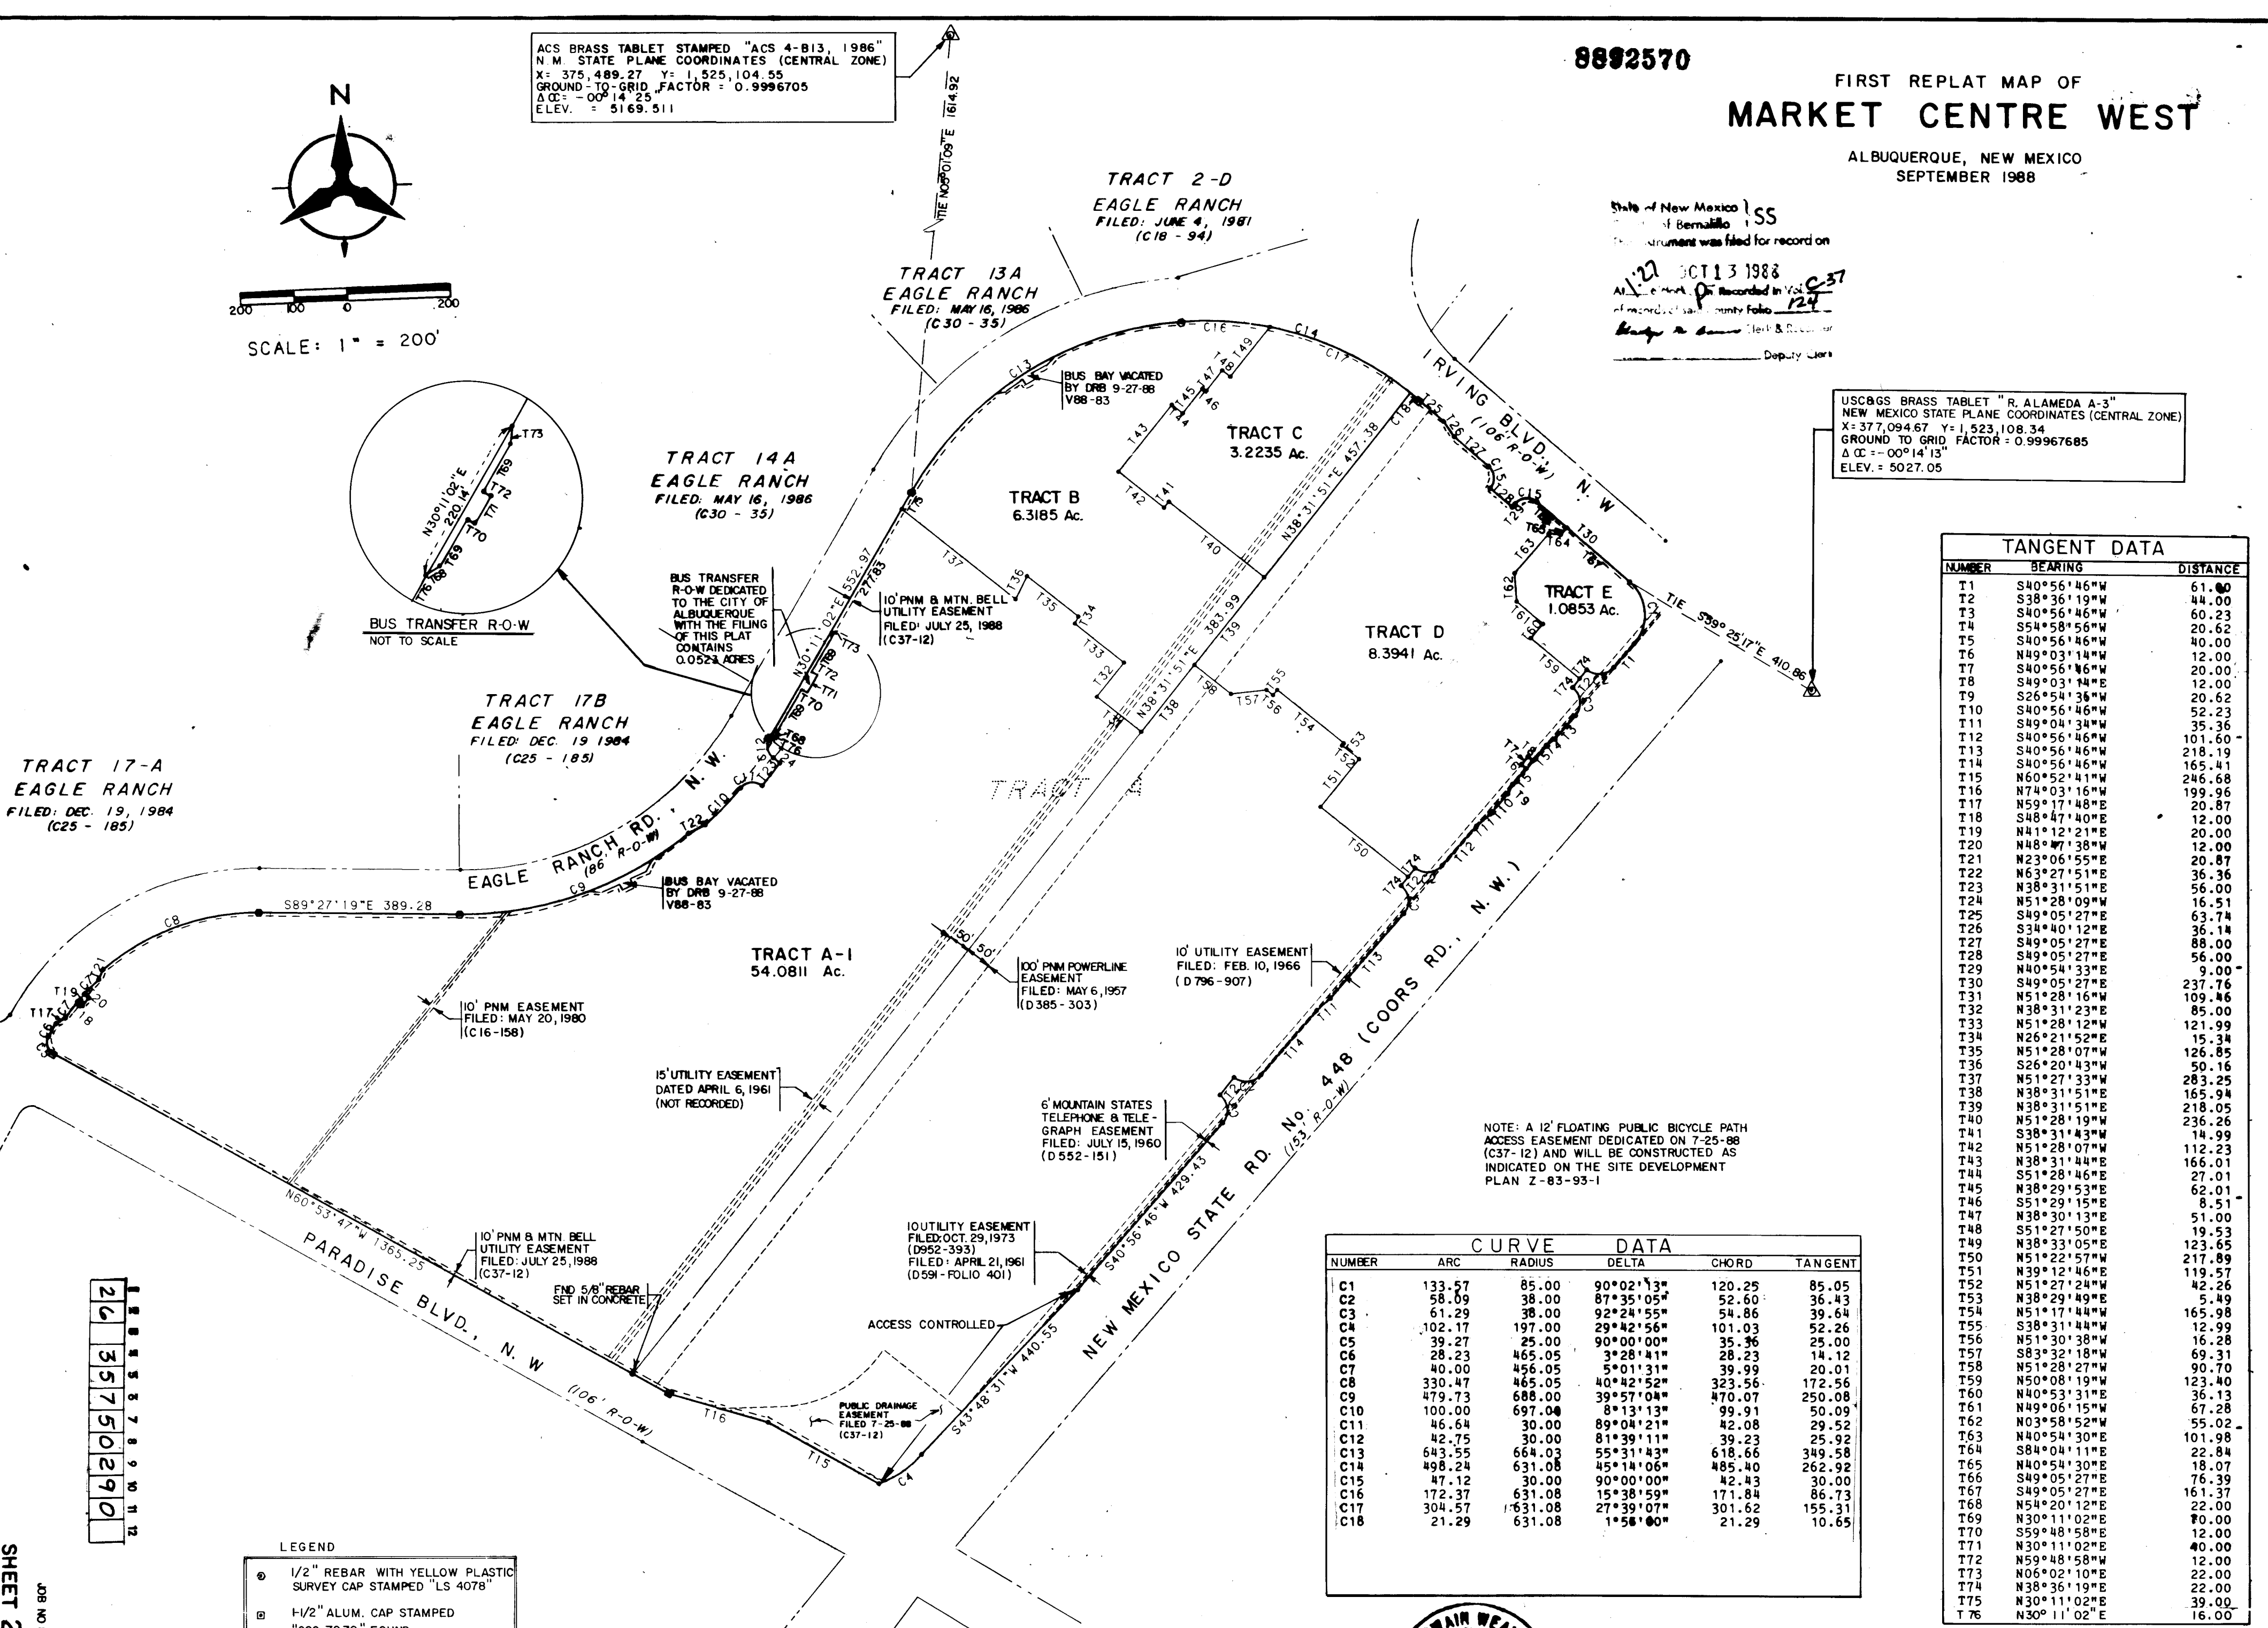

FIRST REPLAT MAP OF MARKET CENTRE WEST

 ALBUQUERQUE, NEW MEXICO
 SEPTEMBER 1988

 State of New Mexico) ss.
 County of Bernalillo)

The foregoing instrument was acknowledged before me this 13th day of September 1988, by [Signature] on behalf of [Signature] and [Signature].

 By: [Signature] My commission expires: 12/31/90
 Notary Public

 USCGS BRASS TABLET "R. ALAMEDA A-3"
 NEW MEXICO STATE PLANE COORDINATES (CENTRAL ZONE)
 X = 377,094.67 Y = 1,523,108.34
 GROUND TO GRID FACTOR = 0.99967685
 A.C. = 00°04'13"
 ELEV. = 5027.05

TANGENT DATA

NUMBER	BEARING	DISTANCE
T1	S40°56'46"W	61.00
T2	S38°36'19"W	44.00
T3	S40°56'46"W	60.23
T4	S40°56'46"W	20.62
T5	S40°56'46"W	40.00
T6	N49°03'14"W	12.00
T7	S40°56'46"W	35.36
T8	S49°03'14"E	12.00
T9	S26°54'36"W	20.62
T10	S40°56'46"W	52.23
T11	S40°56'46"W	35.36
T12	S40°56'46"W	101.60
T13	S40°56'46"W	218.19
T14	S40°56'46"W	165.41
T15	N60°52'41"W	246.68
T16	N74°03'16"W	199.96
T17	N59°17'48"E	20.87
T18	S48°47'40"E	12.00
T19	N41°12'21"E	20.00
T20	N48°47'38"W	12.00
T21	N23°06'55"E	20.87
T22	N63°27'51"E	36.36
T23	N38°31'51"E	56.00
T24	N38°31'51"E	16.51
T25	S49°05'27"E	63.74
T26	S34°40'12"E	36.14
T27	S40°56'46"W	68.00
T28	S40°56'46"W	56.00
T29	N40°54'33"E	9.00
T30	S49°05'27"E	237.76
T31	N51°28'09"W	109.86
T32	N38°31'23"E	85.00
T33	N51°28'12"W	121.99
T34	N26°11'52"E	19.53
T35	N51°28'07"W	126.85
T36	S26°20'43"W	50.16
T37	N51°28'13"W	263.25
T38	N38°31'51"E	18.07
T39	N38°31'51"E	218.05
T40	N51°28'19"W	236.26
T41	S40°56'46"W	165.00
T42	N51°28'07"W	112.23
T43	N38°31'44"W	166.01
T44	S51°28'16"E	22.00
T45	N38°29'53"E	62.01
T46	S51°29'15"E	8.51
T47	N38°31'13"E	51.00
T48	S51°27'50"E	123.65
T49	N38°33'05"E	217.89
T50	N51°22'57"W	42.26
T51	N51°27'24"W	5.49
T52	N38°29'49"E	165.00
T53	N51°11'02"E	12.99
T54	S38°31'44"W	16.28
T55	N51°30'38"W	69.31
T56	S38°32'18"W	109.86
T57	N51°28'16"W	123.40
T58	N50°08'19"W	36.13
T59	N40°53'31"E	22.00
T60	N51°28'16"W	55.02
T61	N03°58'52"W	101.98
T62	N40°54'30"E	22.84
T63	S48°40'11"E	18.07
T64	N40°54'30"E	76.39
T65	S49°05'27"E	161.37
T66	S49°05'27"E	22.00
T67	N51°28'12"E	39.00
T68	N30°11'02"E	12.00
T69	S59°48'58"E	12.00
T70	S59°48'58"E	12.00
T71	N51°11'02"E	22.00
T72	N59°48'58"E	12.00
T73	N06°02'10"E	22.00
T74	N36°56'19"E	22.00
T75	N30°11'02"E	12.00
T76	N30°11'02"E	16.00

NUMBER	ARC	RADIUS	DELTA	CHORD	TANGENT
C1	133.57	85.00	90°02'13"	120.25	85.05
C2	58.09	38.00	87°35'05"	52.60	36.43
C3	61.29	38.00	92°24'55"	54.86	39.64
C4	102.17	197.00	29°42'56"	101.03	52.26
C5	39.27	25.00	90°00'00"	35.36	25.00
C6	28.23	465.05	3°28'41"	28.23	14.12
C7	40.00	456.05	5°01'31"	39.99	20.01
C8	330.47	465.05	40°42'52"	323.56	172.56
C9	479.73	688.00	39°57'04"	470.07	250.08
C10	100.00	697.00	8°13'13"	99.91	50.09
C11	46.64	30.00	89°04'21"	42.08	29.52
C12	42.75	30.00	81°39'11"	39.23	25.92
C13	643.55	664.03	55°31'43"	618.66	349.58
C14	498.24	631.08	45°14'08"	485.40	262.92
C15	47.12	30.00	90°00'00"	42.43	30.00
C16	172.37	631.08	15°38'59"	171.84	86.73
C17	304.57	631.08	27°59'07"	301.1	155.31
C18	21.29	631.08	1°58'40"	21.29	10.65

NOTE: A 12" FLOATING PUBLIC BICYCLE PATH ACCESS EASEMENT DEDICATED ON 7-25-88 (C37-101) AND WILL BE CONSTRUCTED AS INDICATED ON THE SITE DEVELOPMENT PLAN Z-83-93-1

 A. DWAIN WEAVER
 A DWAIN WEAVER & ASSOCIATES
 NMLS NO. 6544

SHEET 2 OF 2 SHEETS

C-37, Folio 124

1654-2

FIRST REPLAT MAP OF MARKET CENTRE WEST

 ALBUQUERQUE, NEW MEXICO
 SEPTEMBER 1988

Free Consent and Dedication

The foregoing replat of that certain tract of land situate within the Town of Alameda Grant and projected Section 18, Township 11 North, Range 3 East, New Mexico Principal Meridian, City of Albuquerque, Bernalillo County, New Mexico, being Market Centre West, as the same is shown and designated on the plat filed for record in the office of the County Clerk of Bernalillo County, New Mexico, on July 25, 1988, in Volume C37, Folio 124, and now herein shown and designated on this replat, is hereby dedicated to the use of the undersigned owner(s) and/or proprietor(s) thereof and said owner(s) and/or proprietor(s) do hereby dedicate the 0.0523 easements shown on this plat. Electrical, Power, and Communication easements are reserved for overhead distribution lines for pole type utilities, and buried distribution lines, conduits, and pipes for underground utilities and other related equipment where shown or indicated, including the right of ingress and egress for construction and maintenance, and the right to trim interfering trees and shrubs.

The owners of lots A-1, B, C, D and E hereby grant to each other and their successors and assigns of interest reciprocal easements for parking, access, drainage, and utilities.

OWNER:

 MARKET CENTRE WEST ASSOCIATES
 A California General Partnership

 See [Signature]
 SES/Beck & Associates, Inc.

 [Signature]
 GLENFED Development Corporation

 State of California)
 County of Los Angeles) ss.

The foregoing instrument was acknowledged before me this 26th day of September 1988, by LEC A. Shapiro on behalf of SES/Beck & Associates, Inc., a Delaware Corporation.

 By: [Signature] My commission expires: 2004/1990
 Notary Public

 State of California)
 County of Los Angeles) ss.

The foregoing instrument was acknowledged before me this 23rd day of September 1988, by MICHAEL J. KENNEDY on behalf of GLENFED Development Corporation, a California Corporation.

 By: [Signature] My commission expires: April 10, 1990
 Notary Public

SURVEYOR'S CERTIFICATION

I, A. DWAIN WEAVER, A REGISTERED PROFESSIONAL NEW MEXICO SURVEYOR, CERTIFY THAT THIS PLAT WAS PREPARED BY ME OR UNDER MY SUPERVISION, SHOWS ALL EASEMENTS OF RECORD, MEETS THE MINIMUM REQUIREMENTS FOR MONUMENTATION AND SURVEYS CONTAINED IN THE ALBUQUERQUE SUBDIVISION ORDINANCE, AND IS TRUE AND ACCURATE TO THE BEST OF MY KNOWLEDGE AND BELIEF.

 A. DWAIN WEAVER
 A DWAIN WEAVER & ASSOCIATES
 NMLS NO. 6544

 BOHANNAN-HUSTON, INC.
 7500 JEFFERSON STREET, N.E.
 ALBUQUERQUE, NM 87109

 STATE OF NEW MEXICO) ss.
 COUNTY OF BERNALILLO)

THE FOREGOING INSTRUMENT WAS ACKNOWLEDGED BEFORE ME THIS 19th DAY OF September 1988, BY A. DWAIN WEAVER.

 MY COMMISSION EXPIRES: 2-23-91 [Signature] Dine G. Agan
 Notary Public

JOB NO. 88219.08

SHEET 1 OF 2 SHEETS

C-37, Folio 124

1654-1

DESCRIPTION

A certain tract of land situate within the Town of Alameda Grant, within projected Section 18, Township 11 North, Range 3 East, New Mexico, Principal Meridian, City of Albuquerque, Bernalillo County, New Mexico, being and comprising all of Tract "A" and two (2) easterly portions of Eagle Ranch Road, N.W., right-of-way of MARKET CENTRE WEST, as the same are shown and designated on the plat filed for record in the office of the County Clerk of Bernalillo County, New Mexico, on July 25, 1988, in Volume C37, Folio 12, and being more particularly described by New Mexico State Plane Grid Bearings (Central Zone) and ground distances as follows:

BEGINNING at a point of curvature at the northeast corner of said Tract "A", said corner being also a point on the southerly right-of-way of Irving Boulevard, N.W., from whence the USCGS Monument R. Alameda A-3 (having New Mexico State Plane Grid Coordinates, Central Zone, X = 377,094.67 and Y = 1,523,108.34) bears S59°25'17"E, 410.86 feet, and from said point of beginning running thence along the easterly boundary of said Tract "A" and also along said right-of-way 133.57 feet along the arc of a curve to the right having a radius of 85.00 feet, a central angle of 90°02'13", and a long chord which bears S04°04'21"E, 120.25 feet to a point of tangency on the westerly right-of-way of the New Mexico State Road No. 448 (Coors Road, N.W.); thence, running southwesterly along said State Road right-of-way and also along the easterly boundary of said Tract "A"

S40°56'46"W, 61.00 feet to a point of curvature; thence, 58.09 feet along the arc of a curve to the right having a radius of 38.00 feet, a central angle of 87°35'05", and a long chord which bears S84°44'19"W, 52.60 feet to a point of non-tangency; thence, S38°36'19"W, 44.00 feet to a point of curvature; thence, 61.29 feet along the arc of a curve to the right having a radius of 38.00 feet, a central angle of 92°24'55", and a long chord which bears S05°15'41"E, 54.86 feet to a point of tangency; thence, S40°56'46"W, 60.23 feet to a point of curvature; thence, S54°58'56"W, 20.62 feet to a point of curvature; thence, S40°56'46"W, 40.00 feet to a point of curvature; thence, S49°03'14"E, 12.00 feet to a point of tangency; thence, S40°56'46"W, 40.00 feet to a point of tangency; thence, S26°54'36"W, 20.62 feet to a point of tangency; thence, S40°56'46"W, 52.23 feet to a point of tangency; thence, S49°04'34"W, 35.36 feet to a point of tangency; thence, S40°56'46"W, 101.60 feet to a point of curvature; thence, 58.09 feet along the arc of a curve to the right having a radius of 38.00 feet, a central angle of 87°35'05", and a long chord which bears S84°44'19"W, 52.60 feet to a point of non-tangency; thence, S38°36'19"W, 44.00 feet to a point of curvature; thence, 61.29 feet along the arc of a curve to the right having a radius of 38.00 feet, a central angle of 92°24'55", and a long chord which bears S05°15'41"E, 54.86 feet to a point of tangency; thence, S40°56'46"W, 218.19 feet to a point of tangency; thence, S49°04'34"W, 35.36 feet to a point of tangency; thence, S40°56'46"W, 165.41 feet to a point of curvature; thence, 58.09 feet along the arc of a curve to the right having a radius of 38.00 feet, a central angle of 87°35'05", and a long chord which bears S84°44'19"W, 52.60 feet to a point of non-tangency; thence, S38°36'19"W, 44.00 feet to a point of curvature; thence, 61.29 feet along the arc of a curve to the right having a radius of 38.00 feet, a central angle of 92°24'55", and a long chord which bears S05°15'41"E, 54.86 feet to a point of tangency; thence, S40°56'46"W, 429.43 feet to a point of tangency; thence, S43°48'31"W, 440.55 feet to a point of curvature; thence, 102.17 feet along the arc of a curve to the right having a radius of 191.00 feet, a central angle of 29°42'56", and a long chord which bears S55°48'15"W, 101.03 feet to a point of tangency on the southerly boundary of said Tract "A" and also being a point on the northerly right-of-way of Paradise Boulevard, N.W.; thence running northwesterly along said Paradise Boulevard, N.W., right-of-way, and also along the southerly boundary of said Tract "A"

N60°52'41"W, 246.68 feet to a point of tangency; thence, N74°03'16"W, 199.96 feet to a point of tangency; thence, N60°53'47"W, 1,365.25 feet to a point of curvature; thence, 39.27 feet along the arc of a curve to the right having a radius of 25.00 feet, a central angle of 90°00'00", and a long chord which bears N15°53'47"W, 35.36 feet to a point of compound curvature on the easterly right-of-way of Eagle Ranch Road, N.W., and also being a point on the westerly boundary of said Tract "A"; thence running northeasterly along said Eagle Ranch Road, N.W., right-of-way, and also along the westerly boundary of said Tract "A", 28.23 feet along the arc of a curve to the right having a radius of 465.05 feet, a central angle of 03°28'41", and a long chord which bears N30°50'33"E, 28.23 feet to a point of non-tangency; thence, N59°17'48"E, 20.87 feet to a point of curvature; thence, 40.00 feet along the arc of a curve to the right having a radius of 456.05 feet, a central angle of 05°01'31", and a long chord which bears N37°26'13"E, 39.99 feet to a point of non-tangency; thence, S48°47'40"E, 12.00 feet to a point of tangency; thence, N41°12'21"E, 20.00 feet to a point of tangency; thence, N48°47'38"W, 12.00 feet to a point of curvature; thence, 40.00 feet along the arc of a curve to the right having a radius of 456.05 feet, a central angle of 05°01'31", and a long chord which bears N44°50'30"E, 39.99 feet to a point of non-tangency; thence, N23°06'55"E, 20.87 feet to a point of curvature; thence, 330.47 feet along the arc of a curve to the right having a radius of 465.05 feet, a central angle of 40°42'52", and a long chord which bears N70°11'15"E, 323.56 feet to a point of tangency; thence, S89°27'19"E, 389.28 feet to a point of curvature; thence, 479.73 feet along the arc of a curve to the left having a radius of 688.00 feet, a central angle of 39°57'04", and a long chord which bears N70°34'09"E, 470.07 feet to a point of non-tangency; thence, N63°27'51"E, 36.36 feet to a point of curvature; thence, 100.00 feet along the arc of a curve to the left having a radius of 697.00 feet, a central angle of 08°13'13", and a long chord which bears N43°34'07"E, 99.91 feet to a point of reverse curvature; thence, 46.64 feet along the arc of a curve to the right having a radius of 30.00 feet, a central angle of 89°04'21", and a long chord which bears

N03°59'41"E, 42.08 feet to a point of non-tangency; thence, N38°31'51"E, 56.00 feet to a point of tangency; thence, N51°28'09"W, 16.51 feet to a point of curvature; thence, 42.75 feet along the arc of a curve to the right having a radius of 30.00 feet, a central angle of 91°39'11", and a long chord which bears N10°38'34"W, 39.23 feet to a point of tangency; thence, N30°11'02"E, 552.97 feet to a point of curvature; thence, 643.55 feet along the arc of a curve to the right having a radius of 664.03 feet, a central angle of 55°31'43", and a long chord which bears N57°56'53"E, 618.66 feet to a point of compound curvature; thence, 498.24 feet along the arc of a curve to the right having a radius of 631.08 feet, a central angle of 45°14'08", and a long chord which bears S71°41'26"E, 485.40 feet to a point of tangency on the southerly right-of-way of Irving Boulevard, N.W., and also being a point on the northeasterly boundary of said Tract "A", thence running along said southerly right-of-way, and also along the northeasterly boundary of said Tract "A"

Tract contains 73.1549 acres, more or less.

LOCATION MAP

 ZONE ATLAS MAP C-13-Z
 Not To Scale
 SUBDIVISION DATA

1. DRB NUMBER 88-418
2. ZONE ATLAS INDEX NUMBER C-13-Z
3. GROSS SUBDIVISION ACREAGE = 73.1549 ACRES
4. NUMBER OF TRACTS CREATED = FIVE (5) TRACTS
5. TOTAL MILEAGE OF PARTIAL WIDTH STREET (BUS TRANSFER RIGHT-OF-WAY) CREATED = 0.042 MILES
TOTAL MILEAGE OF PARTIAL WIDTH STREET (BUS BAY RIGHT-OF-WAY) VACATED = 0.053 MILES
6. THESE PROPERTIES ARE WITHIN THE NEW MEXICO UTILITIES, INC. (N.M.U., INC.) FRANCHISE AREA. WATER AND SANITARY SEWER CAPABILITIES ARE BASED ON THE N.M.U., INC. FACILITIES, NOT THE CITY OF ALBUQUERQUE. WATER AND SANITARY SEWER INFRASTRUCTURE IMPROVEMENTS MUST, HOWEVER, BE BOTH THE CITY OF ALBUQUERQUE AND N.M.U., INC.


NOTES

1. BEARINGS ARE BASED ON NEW MEXICO STATE PLANE GRID BEARINGS (CENTRAL ZONE)
2. ALL DISTANCES ARE GROUND DISTANCES.
3. THE PURPOSE & INTENT OF THIS PLAT IS TO CREATE 5 TRACTS, VACATE & DEDICATE R.O.W.
4. CENTERLINE (IN LIEU OF R/W) MONUMENTS TO BE INSTALLED AT ALL CENTERLINE P.C.'S, P.T.'S, ANGLE POINTS AND STREET INTERSECTIONS PRIOR TO ACCEPTANCE OF SUBDIVISION STREET IMPROVEMENTS AND WILL CONSIST OF A FOUR-INCH (4") ALUMINUM ALLOY CAP (WITH MAGNET ATTACHED) STAMPED "CITY OF ALBUQUERQUE", "CENTERLINE MONUMENT", "DO NOT DISTURB", PLS. # 6544"


APPROVALS

PLAT NO. 52-88-295
 10/18/88
 DATE
 10/11/88
 DATE
 10/11/88
 DATE
 10/17/88
 DATE
 9/27/88
 DATE
 9/27/88
 DATE
 10-11-88
 DATE
 9-27-88
 DATE
 9-20-88
 DATE
 9-19-88
 DATE
 9-27-88
 DATE

ACS BRASS TABLET STAMPED "ACS 4-B13, 1986"
 N.M. STATE PLANE COORDINATES (CENTRAL ZONE)
 X = 375,489.27 Y = 1,525,104.55
 GROUND TO GRID FACTOR = 0.9996705
 A.C. = 00°04'13"
 ELEV. = 5169.511

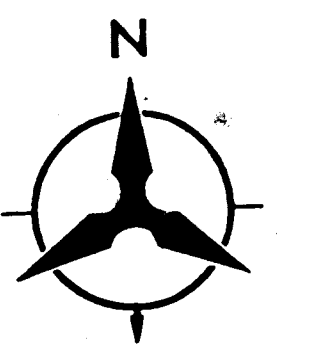

SCALE: 1" = 200'

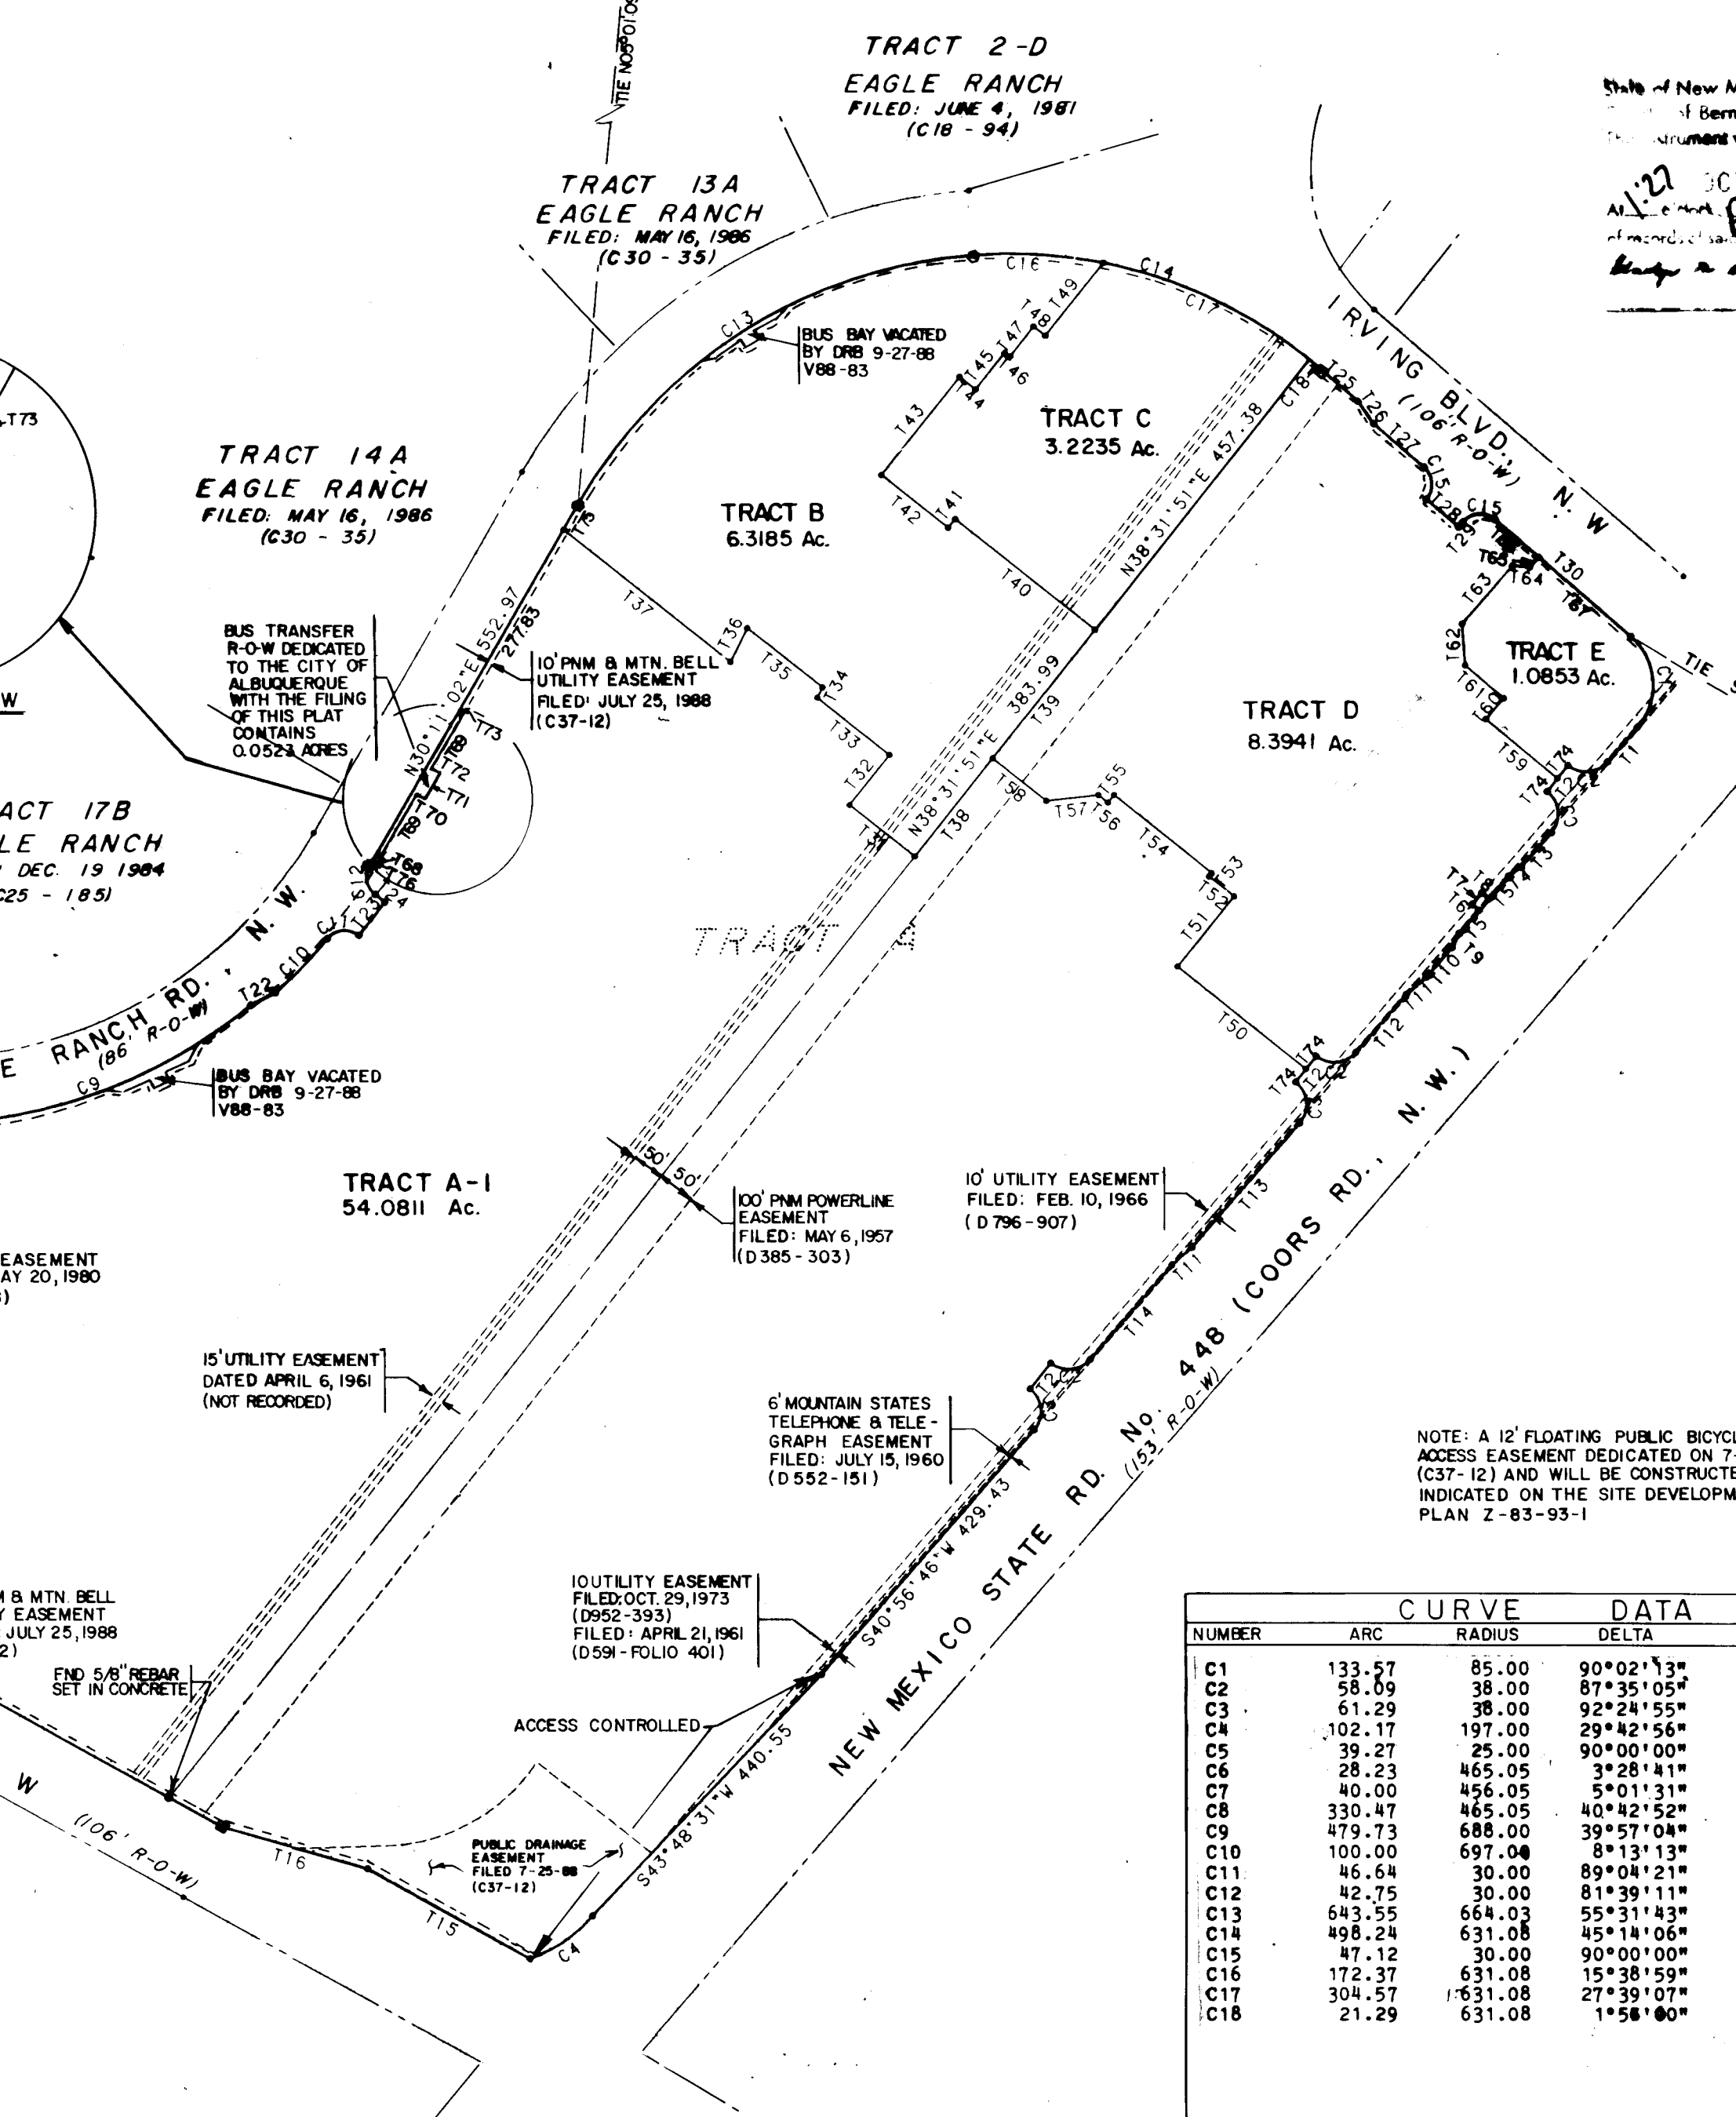

8892570

FIRST REPLAT MAP OF MARKET CENTRE WEST

 ALBUQUERQUE, NEW MEXICO
 SEPTEMBER 1988

State of New Mexico) ss.
 County of Bernalillo)
 The foregoing instrument was filed for record on
 OCT 13 1988
 A. DWAIN WEAVER
 Notary Public

USCGS BRASS TABLET "R. ALAMEDA A-3"
 NEW MEXICO STATE PLANE COORDINATES (CENTRAL ZONE)
 X = 377,094.67 Y = 1,523,108.34
 GROUND TO GRID FACTOR = 0.99967685
 A.C. = 00°04'13"
 ELEV. = 5027.05

TANGENT DATA

NUMBER	BEARING	DISTANCE
T1	S40°56'46"W	61.00
T2	S38°36'19"W	44.00
T3	S40°56'46"W	60.23
T4	S54°58'56"W	20.62
T5	S40°56'46"W	40.00
T6	N49°03'14"E	12.00
T7	S40°56'46"W	35.36
T8	S49°03'14"E	12.00
T9	S26°54'36"W	20.62
T10	S40°56'46"W	52.23
T11	S40°56'46"W	35.36
T12	S40°56'46"W	101.60
T13	S40°56'46"W	218.19
T14	S40°56'46"W	165.41
T15	N60°52'41"E	246.68
T16	N74°03'16"E	199.96
T17	N59°17'48"E	20.87
T18	S48°47'40"E	12.00
T19	N41°12'21"E	20.00
T20	N48°47'38"E	12.00
T21	N23°06'55"E	20.87
T22	N63°27'51"E	36.36
T23	N38°31'51"E	56.00
T24	N38°31'51"E	16.51
T25	S49°05'27"E	63.74
T26	S34°40'12"E	36.14
T27	S40°56'46"W	68.00
T28	S40°56'46"W	56.00
T29	N40°54'33"E	9.00
T30	S49°05'27"E	237.76
T31	N51°28'09"W	109.96
T32	N38°31'23"E	85.00
T33	N51°28'12"W	121.99
T34	N26°11'52"E	19.53
T35	N51°28'07"W	126.85
T36	S26°20'43"W	50.16
T37	N51°28'13"E	263.25
T38	N38°31'51"E	18.07
T39	N38°31'51"E	218.05
T40	N51°28'19"W	236.26
T41	S40°56'46"W	165.00
T42	N51°28'07"W	112.23
T43	N38°31'44"E	166.01
T44	S51°28'16"E	22.00
T45	N38°29'53"E	62.01
T46	S51°29'15"E	8.51
T47	N38°31'13"E	51.00
T48	S51°27'50"E	123.65
T49	N38°33'05"E	217.89
T50	N51°22'57"W	42.26
T51	N51°27'24"W	5.49
T52	N38°29'49"E	165.00
T53	N51°11'02"E	12.99
T54	S38°31'44"W	16.28
T55	S15°30'38"W	69.31
T56	S38°32'18"W	90.70
T57	N51°28'16"W	123.40
T58	N50°08'19"E	36.13
T59	N40°53'31"E	22.00
T60	N51°28'16"E	55.02
T61	N03°58'52"W	101.98
T62	N40°54'30"E	22.84
T63	S40°56'46"W	18.07
T64	N40°54'30"E	76.39
T65	S49°05'27"E	161.37
T66	S49°05'27"E	22.00
T67	N51°28'12"E	39.00
T68	N30°11'02"E	12.00
T69	S59°48'58"E	12.00
T70	S59°48'58"E	12.00
T71	N59°48'58"E	12.00
T72	N59°48'58"E	12.00
T73	N06°02'10"E	22.00
T74	N36°56'19"E	22.00
T75	N30°11'02"E	12.00
T76	N30°11'02"E	16.00

NUMBER	ARC	RADIUS	DELTA	CHORD	TANGENT
C1	133.57	85.00	90°02'13"	120.25	85.05
C2	58.09	38.00	87°35'05"	52.60	36.43
C3	61.29	38.00	92°24'55"	54.86	39.64
C4	102.17	191.00	29°42'56"	101.03	52.26
C5	39.27	25.00	90°00'00"	35.36	25.00
C6	28.23	465.05	3°28'41"	28.23	14.12
C7	40.00	456.05	5°01'31"	39.99	20.01
C8	330.47	465.05	40°42'52"	323.56	172.56
C9	479.73	688.00	39°57'04"	470.07	250.08
C10	100.00	697.00	8°13'13"	99.91	50.09
C11	46.64	30.00	89°04'21"	42.08	29.52
C12	42.75	30.00	81°39'11"	39.23	25.92
C13	643.55	664.03	55°31'43"	618.66	349.58
C14	498.24	631.08	45°14'08"	485.40	262.92
C15	47.12	30.00	90°00'00"	42.43	30.00
C16	172.37	631.08	15°38'59"	171.84	86.73
C17	304.57	631.08	27°59'07"	301.1	155.31
C18	21.29	631.08	1°58'40"	21.29	10.65


NOTE: A 12" FLOATING PUBLIC BICYCLE PATH ACCESS EASEMENT DEDICATED ON 7-25-88 (C37-101) AND WILL BE CONSTRUCTED AS INDICATED ON THE SITE DEVELOPMENT PLAN Z-83-93-1

 A. DWAIN WEAVER
 Notary Public


SHEET 2 OF 2 SHEETS

C-37, Folio 124

1654-2

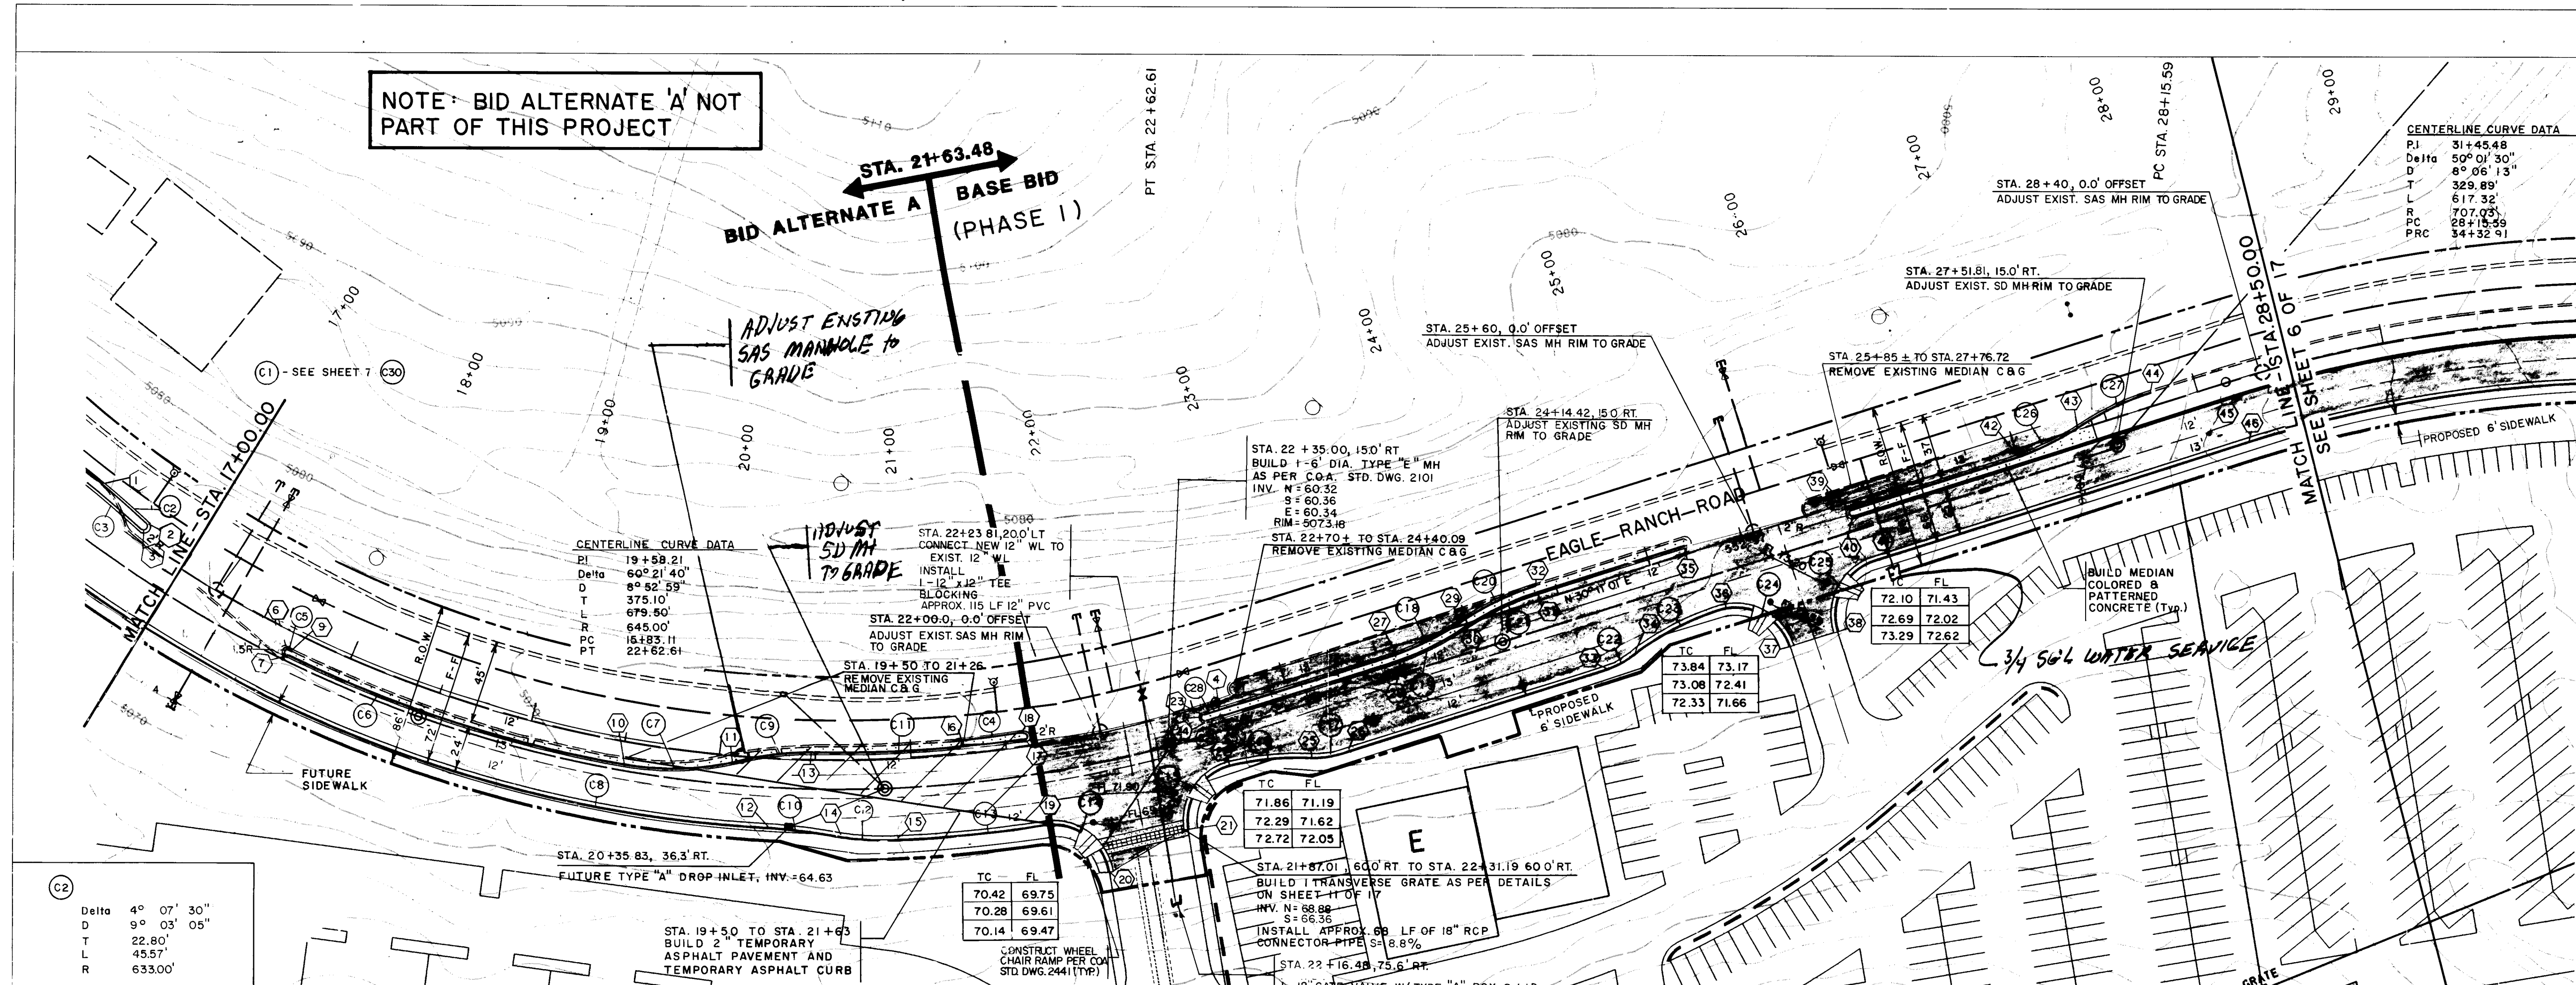

C2	Delta 4° 07' 30"	D 9° 03' 05"	T 22.80'	L 45.57'	R 633.00'
C3	Delta 6° 58' 30"	D 8° 59' 41"	T 38.82'	L 77.55'	R 637.00'
C4	Delta 3° 12' 22"	D 8° 59' 41"	T 17.83'	L 35.65'	R 637.00'
C5	Delta 0° 17' 02"	D 8° 45' 39"	T 1.62'	L 3.25'	R 654.00'
C6	Delta 16° 18' 54"	D 8° 45' 39"	T 94.18'	L 187.08'	R 657.00'
C7	Delta 23° 39' 32"	D 38° 11' 50"	T 31.42'	L 242.49'	R 150.00'
C8	Delta 39° 12' 00"	D 8° 24' 48"	T 242.49'	L 465.92'	R 681.00'
C9	Delta 14° 54' 22"	D 38° 11' 50"	T 19.62'	L 39.03'	R 150.00'
C10	Delta 8° 28' 37"	D 19° 5' 55"	T 22.23'	L 44.39'	R 300.00'
C11	Delta 15° 31' 52"	D 38° 11' 50"	T 20.46'	L 40.66'	R 150.00'
C12	Delta 8° 31' 48"	D 19° 59' 10"	T 29.75'	L 46.88'	R 30.00'
C13	Delta 5° 12' 00"	D 8° 18' 13"	T 31.33'	L 62.62'	R 690.00'
C14	Delta 15° 30' 50"	D 38° 11' 50"	T 20.43'	L 40.61'	R 150.00'
C15	Delta 16° 15' 36"	D 37° 12' 18"	T 22.00'	L 43.71'	R 154.00'
C16	Delta 16° 15' 36"	D 37° 12' 18"	T 22.00'	L 43.71'	R 154.00'
C17	Delta 19° 55' 46"	D 114° 35' 30"	T 8.79'	L 17.39'	R 50.00'
C18	Delta 16° 15' 36"	D 37° 12' 18"	T 22.00'	L 43.71'	R 154.00'
C19	Delta 16° 15' 36"	D 37° 12' 18"	T 22.00'	L 43.71'	R 154.00'
C20	Delta 19° 55' 46"	D 114° 35' 30"	T 8.79'	L 17.39'	R 50.00'
C21	Delta 16° 15' 36"	D 37° 12' 18"	T 22.00'	L 43.71'	R 154.00'
C22	Delta 16° 15' 36"	D 37° 12' 18"	T 22.00'	L 43.71'	R 154.00'
C23	Delta 19° 55' 46"	D 114° 35' 30"	T 8.79'	L 17.39'	R 50.00'
C24	Delta 16° 15' 36"	D 37° 12' 18"	T 22.00'	L 43.71'	R 154.00'
C25	Delta 16° 15' 36"	D 37° 12' 18"	T 22.00'	L 43.71'	R 154.00'
C26	Delta 19° 55' 46"	D 114° 35' 30"	T 8.79'	L 17.39'	R 50.00'
C27	Delta 16° 15' 36"	D 37° 12' 18"	T 22.00'	L 43.71'	R 154.00'
C28	Delta 16° 15' 36"	D 37° 12' 18"	T 22.00'	L 43.71'	R 154.00'
C29	Delta 19° 55' 46"	D 114° 35' 30"	T 8.79'	L 17.39'	R 50.00'
C30	Delta 16° 15' 36"	D 37° 12' 18"	T 22.00'	L 43.71'	R 154.00'
C31	Delta 16° 15' 36"	D 37° 12' 18"	T 22.00'	L 43.71'	R 154.00'
C32	Delta 19° 55' 46"	D 114° 35' 30"	T 8.79'	L 17.39'	R 50.00'
C33	Delta 16° 15' 36"	D 37° 12' 18"	T 22.00'	L 43.71'	R 154.00'
C34	Delta 16° 15' 36"	D 37° 12' 18"	T 22.00'	L 43.71'	R 154.00'
C35	Delta 19° 55' 46"	D 114° 35' 30"	T 8.79'	L 17.39'	R 50.00'
C36	Delta 16° 15' 36"	D 37° 12' 18"	T 22.00'	L 43.71'	R 154.00'
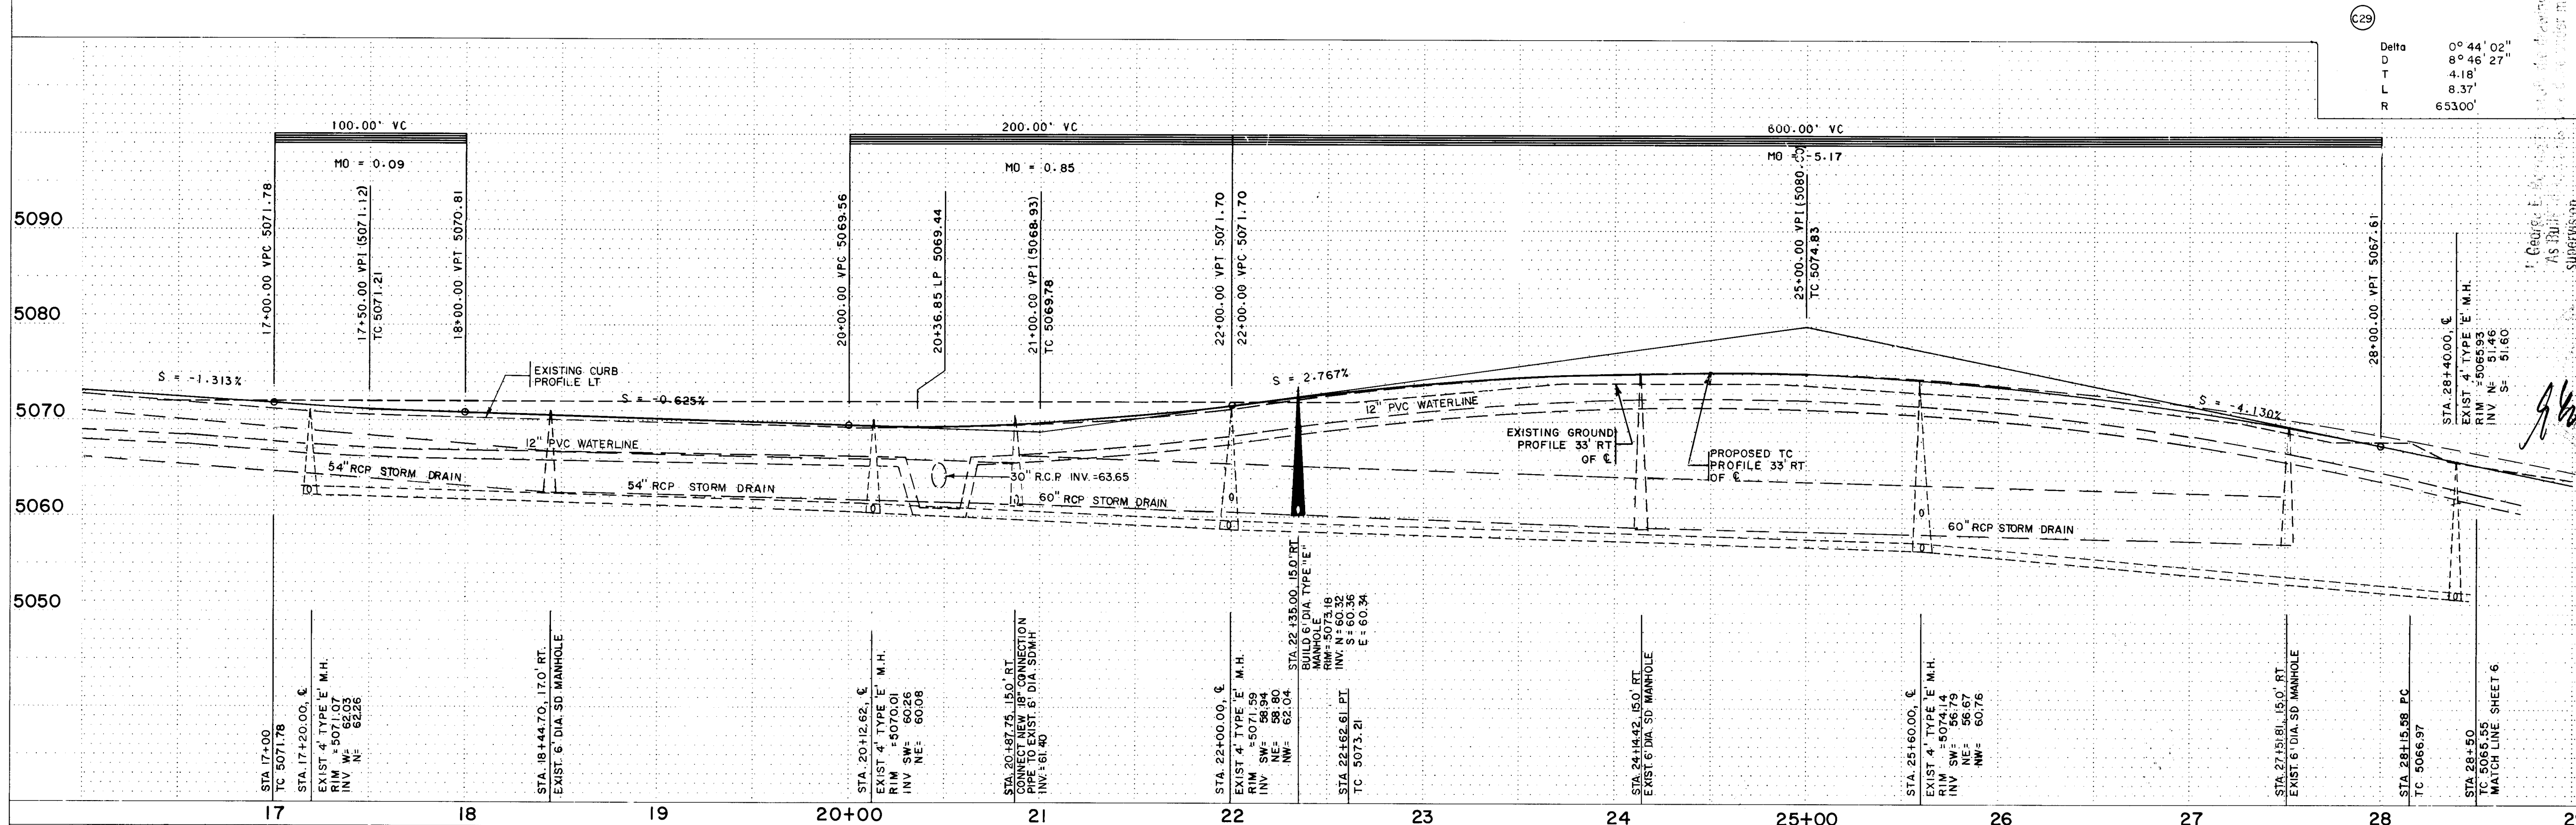

PT.	STATION	OFFSET	TC ELEV.
1	16+34.00	12.00' LT	72.27 *
2	16+80.44	8.00' LT	71.74
3	16+80.44	12.00' LT	71.66
4	22+62.61	4.00' RT	73.79
5	22+62.61	8.00' RT	73.71
6	17+67.74	9.00' RT	71.35
7	17+67.74	12.00' RT	71.47
8			
9	17+70.93	9.00' RT	71.32 *
10	19+51.40	12.00' RT	70.28
11	20+11.47	2.20' RT	70.12
12	20+25.51	36.00' RT	69.40
13	20+49.96	4.00' LT	69.89
14	20+67.14	40.70' RT	69.37
15	21+04.95	45.00' RT	69.60
16	21+26.09	8.00' LT	70.51 *
17	21+60.36	4.00' LT	71.32
18	21+60.36	8.00' LT	71.24
19	21+63.48	45.00' RT	70.56
20	21+90.36	75.38 RT	70.00
21	22+31.19	59.86' RT	71.43
22	22+60.38	33.47' RT	73.15
23	22+54.36	4.00' RT	73.61
24	22+54.36	8.00' RT	73.53
25	22+99.86	42.00' RT	73.71
26	23+16.90	45.00' RT	73.91
27	23+54.99	4.00' RT	74.90
28	23+54.99	8.00' RT	75.11
29	23+96.99	1.85' LT	75.20
30	23+98.11	2.00' RT	75.36
31	24+40.11	4.00' LT	75.61
32	24+40.11	8.00' LT	75.51 *
33	24+60.22	45.00' RT	74.77
34	24+77.27	42.00' RT	74.77
35	25+20.10	4.00' LT	75.30 *
36	25+28.44	33.00' RT	74.59
37	25+57.03	63.00' RT	71.57
38	25+82.94	63.00' RT	71.50
39	26+10.03	4.00' RT	73.96
40	26+10.03	8.00' RT	73.88
41	26+12.95	33.00' RT	73.33
42	26+94.93	4.00' RT	71.90
43	27+35.32	1.53' LT	70.11
44	27+76.72	7.21' LT	68.28 *
45	28+15.59	8.00' RT	67.47
46	28+15.59	33.00' RT	66.97

*MATCH EXISTING CURB & GUTTER

LEGEND


- EXISTING CURB & GUTTER
- PROPOSED CURB & GUTTER
- NEW PAVEMENT
- REMOVE EXISTING PAVEMENT

CITY OF ALBUQUERQUE
INFRASTRUCTURE IMPROVEMENTS
MARKET CENTER WEST


TITLE: EAGLE RANCH ROAD
STA. 17+00.00 - STA. 28+50.00

APPROVALS	ENGINEER	DATE	APPROVALS	ENGINEER	DATE
City Engineer	Rogelio	4/11/17	Liquid Waste	N/A	4/11/17
A.C.E. - Design	"	"	Traffic	Rogelio	4/11/17
A.C.E. - Hydrology	"	"	Water	N/A	"
			N.M. Utilities	"	"

DRAWING NO. 3575 MAP NO. C-13 SHEET 5 OF 17

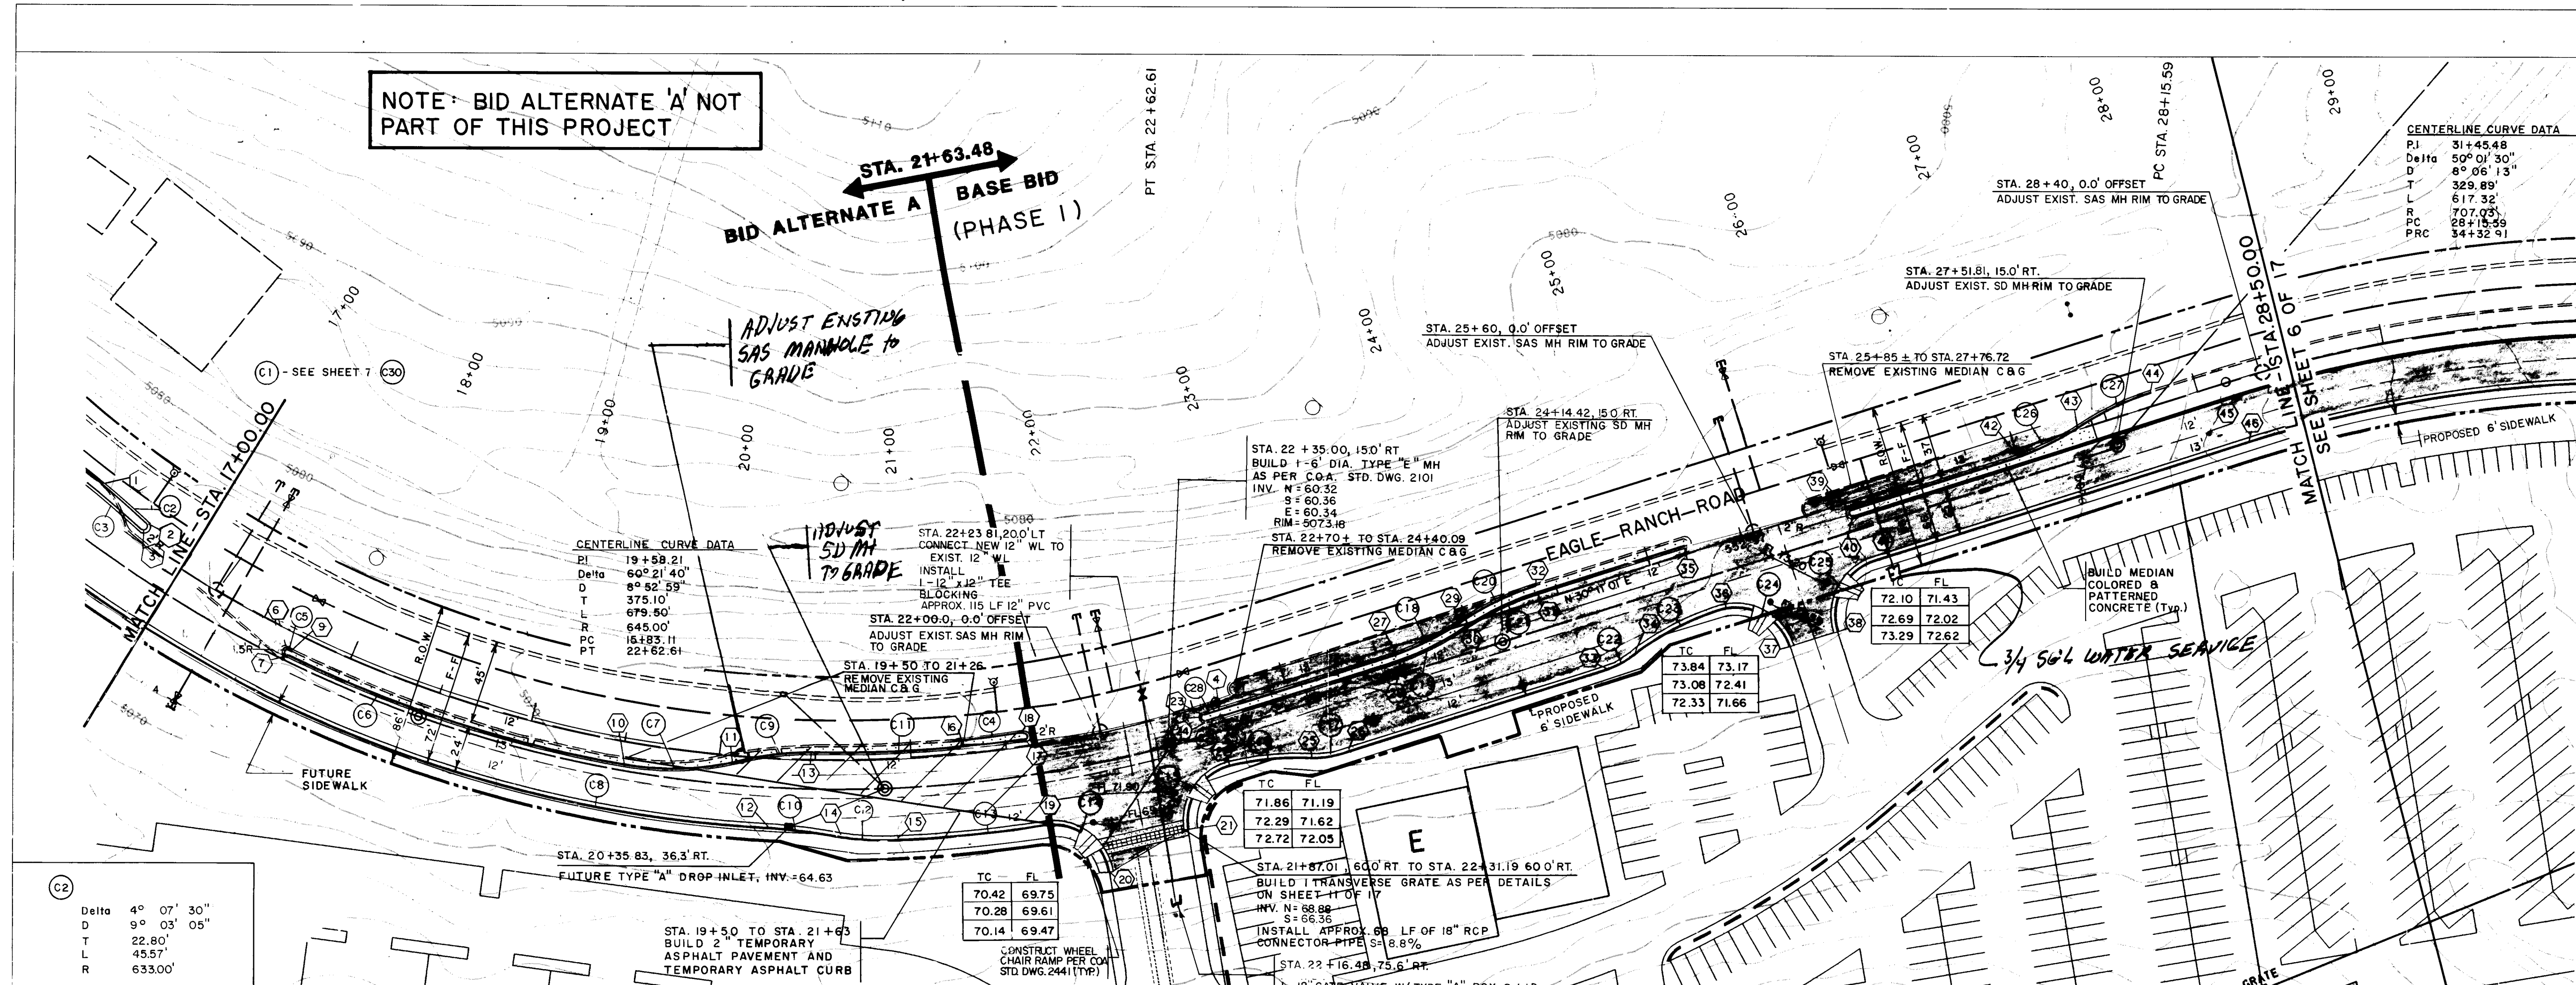

C2	Delta 4° 07' 30"	D 9° 03' 05"	T 22.80'	L 45.57'	R 633.00'
C3	Delta 6° 58' 30"	D 8° 59' 41"	T 38.82'	L 77.55'	R 637.00'
C4	Delta 3° 12' 22"	D 8° 59' 41"	T 17.83'	L 35.65'	R 637.00'
C5	Delta 0° 17' 02"	D 8° 45' 39"	T 1.62'	L 3.25'	R 654.00'
C6	Delta 16° 18' 54"	D 8° 45' 39"	T 94.18'	L 187.08'	R 657.00'
C7	Delta 23° 39' 32"	D 38° 11' 50"	T 31.42'	L 242.49'	R 150.00'
C8	Delta 39° 12' 00"	D 8° 24' 48"	T 242.49'	L 465.92'	R 681.00'
C9	Delta 14° 54' 22"	D 38° 11' 50"	T 19.62'	L 39.03'	R 150.00'
C10	Delta 8° 28' 37"	D 19° 5' 55"	T 22.23'	L 44.39'	R 300.00'
C11	Delta 15° 31' 52"	D 38° 11' 50"	T 20.46'	L 40.66'	R 150.00'
C12	Delta 8° 31' 48"	D 19° 59' 10"	T 29.75'	L 46.88'	R 30.00'
C13	Delta 5° 12' 00"	D 8° 18' 13"	T 31.33'	L 62.62'	R 690.00'
C14	Delta 15° 30' 50"	D 38° 11' 50"	T 20.43'	L 40.61'	R 150.00'
C15	Delta 16° 15' 36"	D 37° 12' 18"	T 22.00'	L 43.71'	R 154.00'
C16	Delta 16° 15' 36"	D 37° 12' 18"	T 22.00'	L 43.71'	R 154.00'
C17	Delta 19° 55' 46"	D 114° 35' 30"	T 8.79'	L 17.39'	R 50.00'
C18	Delta 16° 15' 36"	D 37° 12' 18"	T 22.00'	L 43.71'	R 154.00'
C19	Delta 16° 15' 36"	D 37° 12' 18"	T 22.00'	L 43.71'	R 154.00'
C20	Delta 19° 55' 38"	D 38° 11' 50"	T 26.37'	L 52.21'	R 150.00'
C21	Delta 90° 0' 04"	D 191° 59' 10"	T 30.01'	L 47.13'	R 30.00'
C22	Delta 15° 35' 53"	D 87° 49' 42"	T 21.09'	L 41.92'	R 154.00'
C23	Delta 0° 44' 02"	D 8° 49' 42"	T 4.16'	L 8.32'	R 649.00'
C24	Delta 0° 44' 02"	D 8° 49' 42"	T 4.16'	L 8.32'	R 649.00'
C25	Delta 0° 44' 02"	D 8° 49' 42"	T 4.16'	L 8.32'	R 649.00'
C26	Delta 15° 37' 01"	D 38° 11' 50"	T 20.57'	L 40.89'	R 150.00'
C27	Delta 0° 44' 02"	D 8° 49' 42"	T 4.16'	L 8.32'	R 649.00'
C28	Delta 0° 44' 02"	D 8° 49' 42"	T 4.16'	L 8.32'	R 649.00'
C29	Delta 0° 44' 02"	D 8° 49' 42"	T 4.16'	L 8.32'	R 649.00'

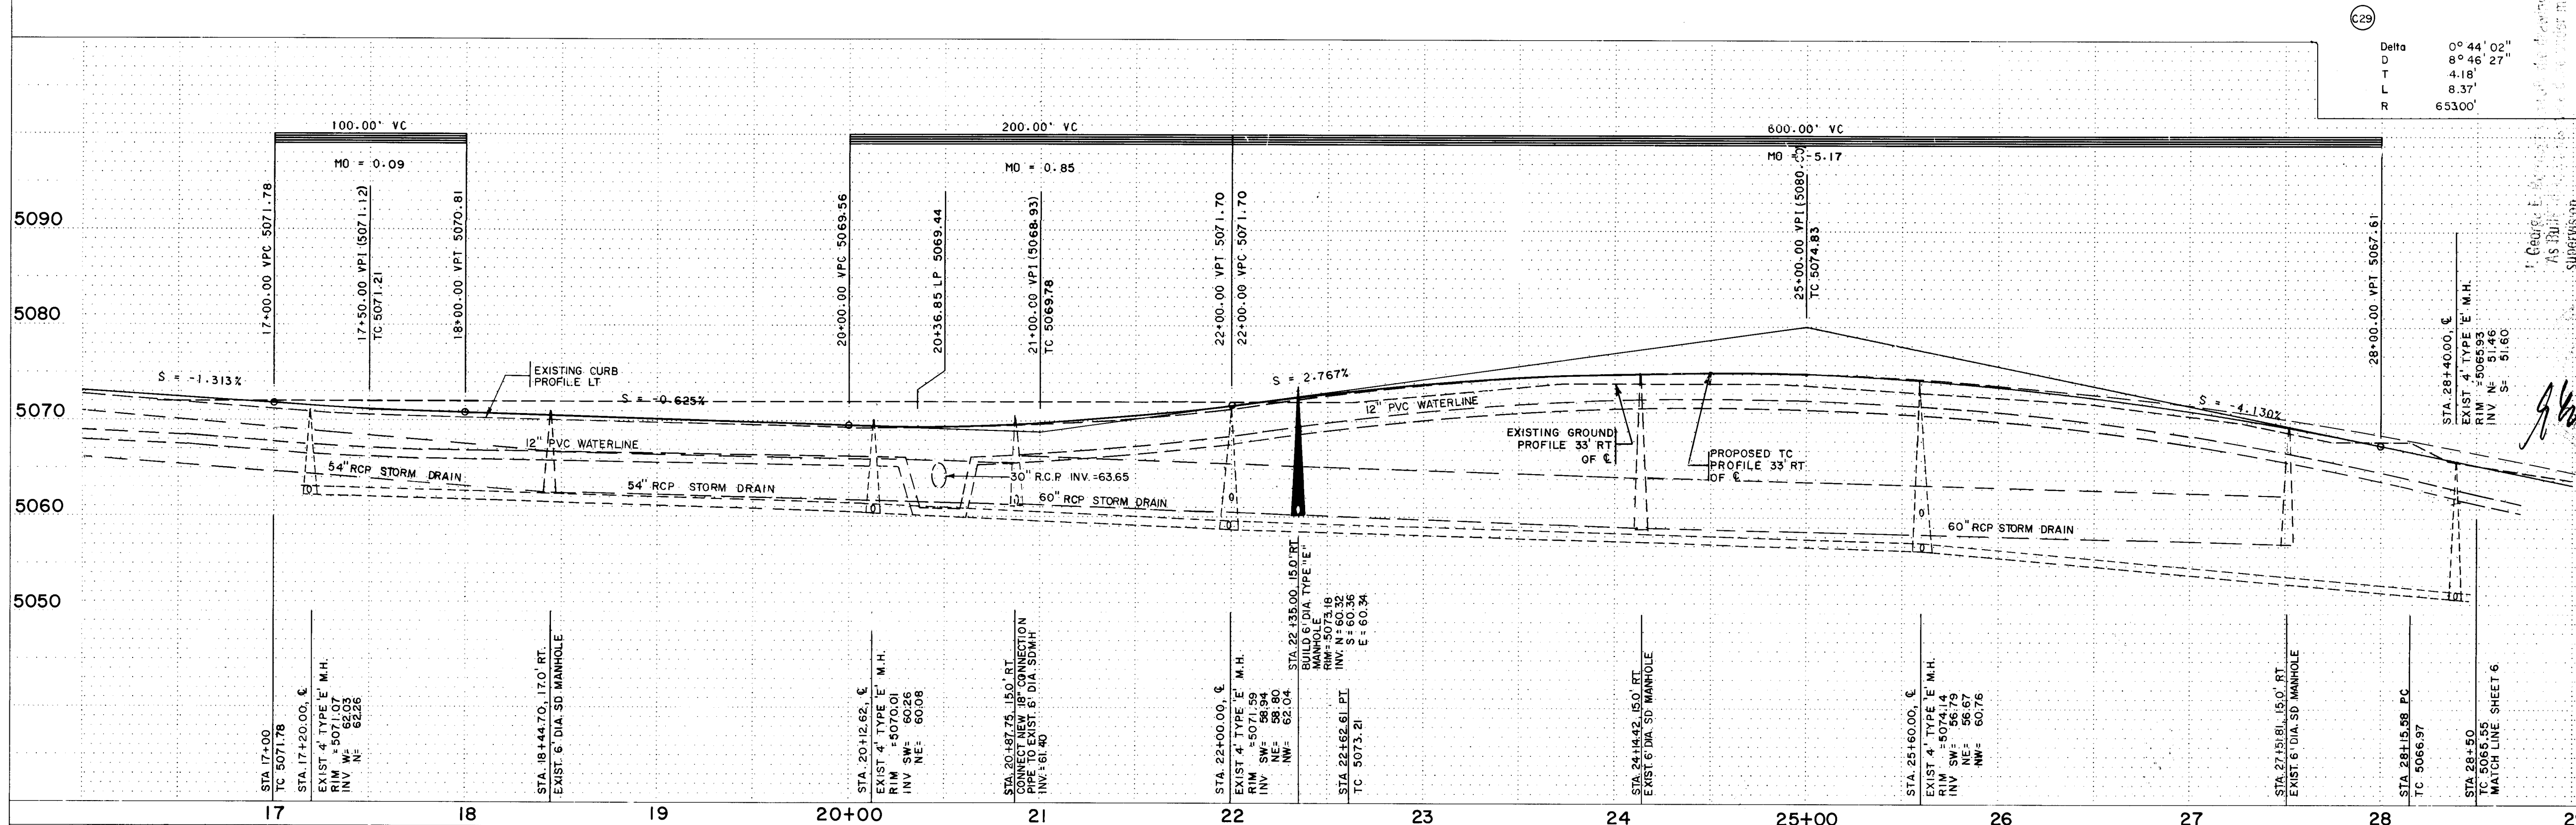

PT.	STATION	OFFSET	TC ELEV.
1	16+34.00	12.00' LT	72.27 *
2	16+80.44	8.00' LT	71.74
3	16+80.44	12.00' LT	71.66
4	22+62.61	4.00' RT	73.79
5	22+62.61	8.00' RT	73.71
6	17+67.74	9.00' RT	71.35
7	17+67.74	12.00' RT	71.47
8			
9	17+70.93	9.00' RT	71.32 *
10	19+51.40	12.00' RT	70.28
11	20+11.47	2.20' RT	70.12
12	20+25.51	36.00' RT	69.40
13	20+49.96	4.00' LT	69.89
14	20+67.14	40.70' RT	69.37
15	21+04.95	45.00' RT	69.60
16	21+26.09	8.00' LT	70.51 *
17	21+60.36	4.00' LT	71.32
18	21+60.36	8.00' LT	71.24
19	21+63.48	45.00' RT	70.56
20	21+90.36	75.38 RT	70.00
21	22+31.19	59.86' RT	71.43
22	22+60.38	33.47' RT	73.15
23	22+54.36	4.00' RT	73.61
24	22+54.36	8.00' RT	73.53
25	22+99.86	42.00' RT	73.71
26	23+16.90	45.00' RT	73.91
27	23+54.99	4.00' RT	74.90
28	23+54.99	8.00' RT	75.11
29	23+96.99	1.85' LT	75.20
30	23+98.11	2.00' RT	75.36
31	24+40.11	4.00' LT	75.61
32	24+40.11	8.00' LT	75.51 *
33	24+60.22	45.00' RT	74.77
34	24+77.27	42.00' RT	74.77
35	25+20.10	4.00' LT	75.30 *
36	25+28.44	33.00' RT	74.59
37	25+57.03	63.00' RT	71.57
38	25+82.94	63.00' RT	71.50
39	26+10.03	4.00' RT	73.96
40	26+10.03	8.00' RT	73.88
41	26+12.95	33.00' RT	73.33
42	26+94.93	4.00' RT	71.90
43	27+35.32	1.53' LT	70.11
44	27+76.72	7.21' LT	68.28 *
45	28+15.59	8.00' RT	67.47
46	28+15.59	33.00' RT	66.97

*MATCH EXISTING CURB & GUTTER

LEGEND

- EXISTING CURB & GUTTER
- PROPOSED CURB & GUTTER
- NEW PAVEMENT
- REMOVE EXISTING PAVEMENT

CITY OF ALBUQUERQUE
INFRASTRUCTURE IMPROVEMENTS
MARKET CENTER WEST

TITLE: EAGLE RANCH ROAD
STA. 17+00.00 - STA. 28+50.00

APPROVALS	ENGINEER	DATE	APPROVALS	ENGINEER	DATE
City Engineer	Rogelio	4/11/17	Liquid Waste	N/A	4/11/17
A.C.E. - Design	u	u	Traffic	Rogelio	4/11/17
A.C.E. - Hydrology	u	u	Water	N/A	u
			N.M. Utilities	u	4/11/17

DRAWING NO. 3575 MAP NO. C-13 SHEET 5 OF 17

OFFSITE Q=12.5 CFS
(SEE SHEET 3)

PARADISE HILLS
INDUSTRIAL PARK

BASIN L

EAGLE
RANCH
SUBDIVISION

BASIN K

BASIN J

BASIN H

BASIN G

BASIN F

BASIN E

BASIN D3

BASIN D

BASIN C

BASIN A

BASIN B

OFFSITE BASIN # 3

OFFSITE
BASIN
5

OFFSITE BASIN # 4

ROLANDS
NURSERY

CITY
LIGHTS

EXISTING 18" CULVERT
TO BE EXTENDED

INSTALL TYPE 'A'
INLET/JUNCTION BOX
18" CULVERT ACROSS
COORS BLVD.

SECTION A-A
PARADISE BLVD.
NO SCALE

SECTION B-B
NO SCALE

SECTION C-C
COBBLED
SWALE AT COORS BLVD.
SCALE: 1"=10'

SECTION D-D
NO SCALE



SECTION E-E
SECTION THROUGH UPPER POND BERM
NO SCALE

- LEGEND
- PROJECT BOUNDARY
 - BASIN BOUNDARY
 - SUB-BASIN BOUNDARY
 - PROPOSED STORM DRAIN
 - PROPOSED STORM DRAIN MANHOLE
 - PROPOSED STORM DRAIN INLET
 - EXISTING STORM DRAIN
 - BASIN DISCHARGE
 - TOTAL FLOW
 - FLOW BY RATIONAL METHOD
 - DIRECTION OF FLOW
 - EXISTING CONTOUR
 - PROPOSED CONTOUR
 - PROPOSED SPOT ELEVATION
 - EXISTING MANHOLE
 - PROPOSED SANITARY SEWER MANHOLE
 - PROPOSED STORM DRAIN MANHOLE
 - PROPOSED FIRE HYDRANT
 - EXISTING OVERHEAD POWER POLES
 - WATER BLOCK

NOTE:
THIS SHEET FOR INFORMATION
ONLY NOT PART OF THIS
PROJECT.

1 2 3 4 5 6 7 8 9 10 11 12
26 35 75 03 90

Master Drainage Plan
Market Center West

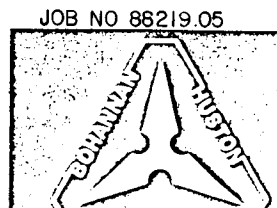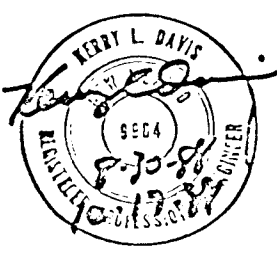

OFFSITE Q=12.5 CFS
(SEE SHEET 3)

PARADISE HILLS
INDUSTRIAL PARK

BASIN L

EAGLE
RANCH
SUBDIVISION

BASIN K

BASIN J

BASIN H

BASIN G

BASIN F

BASIN E

BASIN D3

BASIN D

BASIN C

BASIN A

BASIN B

OFFSITE BASIN #3

OFFSITE
BASIN
#5

OFFSITE BASIN #4

ROLANDS
NURSERY

CITY
LIGHTS

EXISTING 18" CULVERT
TO BE EXTENDED

INSTALL TYPE 'A'
INLET/JUNCTION BOX
18" CULVERT ACROSS
COORS BLVD.

SECTION A-A
PARADISE BLVD.
NO SCALE

SECTION B-B
NO SCALE

SECTION C-C
COBBLED
SWALE AT COORS BLVD.
SCALE: 1"=10'

SECTION D-D
NO SCALE



SECTION E-E
SECTION THROUGH UPPER POND BERM
NO SCALE



- LEGEND
- PROJECT BOUNDARY
 - BASIN BOUNDARY
 - SUB-BASIN BOUNDARY
 - PROPOSED STORM DRAIN
 - PROPOSED STORM DRAIN MANHOLE
 - PROPOSED STORM DRAIN INLET
 - EXISTING STORM DRAIN
 - BASIN DISCHARGE
 - TOTAL FLOW
 - FLOW BY RATIONAL METHOD
 - DIRECTION OF FLOW
 - EXISTING CONTOUR
 - PROPOSED CONTOUR
 - PROPOSED SPOT ELEVATION
 - EXISTING MANHOLE
 - PROPOSED SANITARY SEWER MANHOLE
 - PROPOSED STORM DRAIN MANHOLE
 - PROPOSED FIRE HYDRANT
 - EXISTING OVERHEAD POWER POLES
 - WATER BLOCK

NOTE:
THIS SHEET FOR INFORMATION
ONLY NOT PART OF THIS
PROJECT.

1 2 3 4 5 6 7 8 9 10 11 12
26 35 75 03 90

Master Drainage Plan
Market Center West

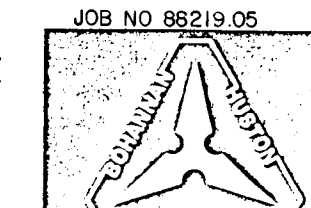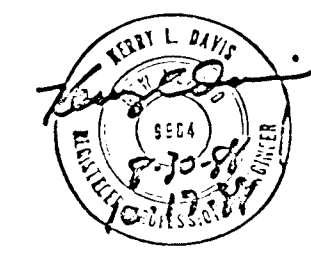

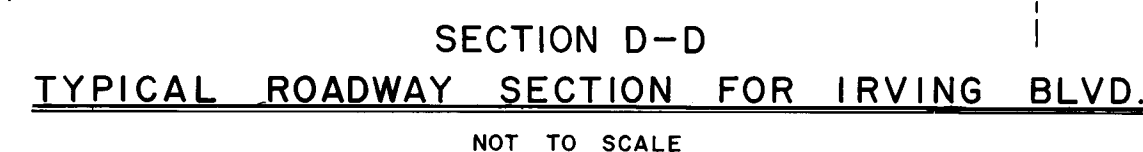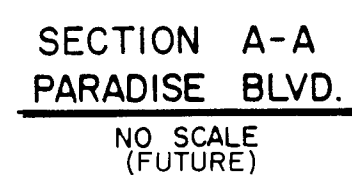

1. CURBS, GUTTERS & CUT-OFF WALL TO BE CONSTRUCTED OF P.C.C
2. FOUR STANDARDS AND MEDIAN C&G PROVIDE CONTRACTIONS JTS 6" O.C. MAX, ALSO PROVIDE 1/2" EXPOSED 48" O.C. MAX AT CURB RETURNS & AT EACH SIDE OF DRIVEWAY
3. FOR EXTERIOR C&G PROVIDE CONTRACTIONS JTS AT 10" O.C. PROVIDE EXPOSED JTS 50 O.C. @ ADJOINING TO BUILDINGS & WALLS
4. EDGES NOT SPECIFIC DIMENSIONED SHALL BE EDGED WITH A 3/8" EDGING TOOL
5. STD. C & G SHALL BE USED FOR NEW CONSTRUCTION. OTHERWISE APPROVED BY THE ENGINEER
6. REMOVE & REPLACE 12" WIDE STRIP OF PAVEMENT 10' O.C. OF CURB OR GUTTER ADJOINING C & G. ADJOINING TO EXIST. A.C. PAVEMENT
7. STD. C & G REQUIRE FULL FORM ON ALL FACES EXCEPT WITH PRIOR APPROVAL OF ENGINEER


CONSTRUCTION NOTES:

- A PROVIDE CONC. CHANNEL LINING, OR CUT-OUT WALL
- B REQUIRED 2' EXP. JT. BETWEEN BACK OF CURB & CONC. LINING OR WALL
- B VARIABLE, DEPRESS AS NEEDED.
- C DRIVE NO. 4 BARS IN DEEP IN HOLES DRILLED 2' DEEP IN EXIST. PAVEMENT, SEAL. WITH EPOXY.
- D EXIST. A/C OR P/C PAVEMENT.
- E THEORETICAL FACE OF CURB OR FLOWLINE
- F TRAFFIC SIDE
- G 3/4" RADIUS
- H 1 1/2" RADIUS
- J 2" RADIUS
- K 24" RADIUS
- L TRACK CORDS
- M DIMENSIONS AT ROUNDED CORNERS, MEASURED TO INTERSECTION OF STRAIGHT LINES.
- N 2" A/C COMPACTED (COURSE 1500 LBS. STABILITY, P. 6)
- O SURFACE SUBGRADE 90% COMPACTION



CURB & GUTTER DETAIL

NOT TO SCALE
COA DWG NO. 2415

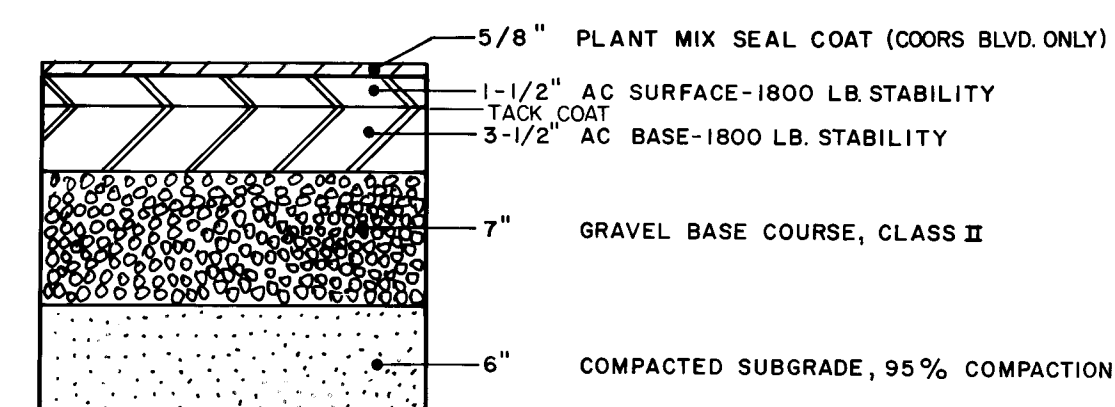

TYPICAL ARTERIAL PAVEMENT SECTION

NOT TO SCALE

GENERAL NOTES

ALL WORK DETAILED ON THESE PLANS TO BE PERFORMED UNDER THIS CONTRACT, AND UNLESS STATED OTHERWISE OR PROVIDED FOR HEREON, SHALL BE CONSTRUCTED IN ACCORDANCE WITH THE CITY OF ALBUQUERQUE STANDARD SPECIFICATIONS, PUBLIC WORKS CONSTRUCTION, 1986 (REFERRED HEREIN AS "STANDARD SPECIFICATIONS").

TWO (2) WORKING DAYS PRIOR TO ANY EXCAVATION, CONTRACTOR MUST CONTACT LINE LOCATING SERVICE, 765-1234, FOR LOCATION OF EXISTING UTILITIES.

PRIOR TO CONSTRUCTION, THE CONTRACTOR SHALL EXCAVATE AND VERIFY THE HORIZONTAL AND VERTICAL LOCATIONS OF ALL POTENTIAL OBSTRUCTIONS. SHOULD A CONFLICT EXIST, THE CONTRACTOR SHALL NOTIFY THE ENGINEER SO THAT THE CONFLICT CAN BE RESOLVED WITH A MINIMUM AMOUNT OF DELAY.

ALL WORK ON THIS PROJECT SHALL BE PERFORMED IN ACCORDANCE WITH APPLICABLE FEDERAL, STATE, AND LOCAL LAWS, RULES AND REGULATIONS GOVERNING CONSTRUCTION SAFETY AND HEALTH.

ALL GAS, ELECTRICAL, TELEPHONE, CABLE TV
LINES, CABLES, AND APPURTENANCES
ENCOUNTERED DURING CONSTRUCTION THAT
REQUIRE RELOCATION, SHALL BE COORDINATED
WITH THAT UTILITY. CONTRACTOR SHALL BE
RESPONSIBLE FOR COORDINATION OF ALL
NECESSARY UTILITY ADJUSTMENTS.

IT WILL BE CONTRACTOR'S RESPONSIBILITY TO PROTECT AND MAINTAIN IN SERVICE ALL EXISTING UTILITIES.

THE CONTRACTOR WILL BE REQUIRED TO CONFIN
HIS WORK WITHIN THE CONSTRUCTION LIMITS
AND/OR PUBLIC RIGHT-OF-WAY TO PRESERVE
EXISTING VEGETATION AND PRIVATE PROPERTY.
OVERNIGHT PARKING OF CONSTRUCTION EQUIP-
MENT SHALL NOT OBSTRUCT DRIVEWAYS OR
DESIGNATED TRAFFIC LANES.

A DISPOSAL SITE FOR ALL EXCESS EXCAVATION MATERIAL, ASPHALTIC PAVING, CONCRETE CURBS AND SIDEWALKS, ETC. SHALL BE OBTAINED BY THE CONTRACTOR IN COMPLIANCE WITH APPLICABLE ENVIRONMENTAL REGULATIONS AND APPROVED BY THE PROJECT ENGINEER. ALL COSTS INCURRED IN OBTAINING A DISPOSAL SITE AND HAUL THERE TO SHALL BE CONSIDERED INCIDENTAL TO THE PROJECT AND NO SEPARATE MEASUREMENT OR PAYMENT SHALL BE MADE.

WHEN ABUTTING NEW PAVEMENT TO EXISTING, SAWCUT 1" BELOW SURFACE OF EXISTING PAVEMENT TO A STRAIGHT EDGE AND AT A RIGHT ANGLE, OR AS APPROVED BY THE PROJECT ENGINEER, TO REMOVE ANY BROKEN OR CRACKED PAVEMENT.

ALL SAWCUT PAVEMENT SHALL HAVE A UNIFORM
EDGE AND BE SPRAYED WITH TACK.

WHEN ABUTTING NEW CURB AND GUTTER TO EXISTING PAVEMENT, A 1' WIDE SECTION OF EXISTING PAVEMENT ADJACENT TO THE CURB SHALL BE SAWCUT, REMOVED, AND REPLACED AS PER STANDARD SPECIFICATIONS.

ALL TRENCH BACKFILL SHALL BE COMPACTED TO A MINIMUM 90% MAXIMUM DENSITY AS PER ASTM D-1557. THE UPPER PORTION OF THE FINAL BACKFILL MAY REQUIRE 95% COMPACTION IN ORDER TO PROVIDE A SUITABLE FOUNDATION FOR PAVEMENT, CURB AND GUTTER, SIDEWALK OR OTHER TYPE OF STRUCTURE.

ALL CATCH BASIN CONNECTOR PIPES SHALL BE CLASS III RCP. ALL RCP STORM SEWER PIPE TRENCHED TO A DEPTH GREATER THAN 8' SHALL BE CLASS IV.

MANHOLE STEPS WILL BE INSTALLED IN ALL STORM DRAIN MANHOLES, AND CATCH BASINS AS PER STANDARD SPECIFICATIONS. PAYMENT SHALL BE CONSIDERED INCIDENTAL TO OTHER CONTRACT ITEMS.

IT SHALL BE THE CONTRACTOR'S RESPONSIBILITY TO OBTAIN ALL PERMITS (SUCH AS BARRICADING, TOPSOIL DISTURBANCE AND EXCAVATION PERMITS) NECESSARY FOR THIS PROJECT PRIOR TO COMMENCING CONSTRUCTION.

ALL SUBGRADE PREPERATION SHALL BE
COMPACTED TO 95% MAXIMUM DENSITY AS PER
ASTM D-1557 UNLESS NOTED OTHERWISE.


CONT ABOVE 1 2 3 4 5 6 7 8 9 10 11

CITY OF ALBUQUERQUE
INFRASTRUCTURE IMPROVEMENTS
MARKET CENTER WEST


TITLE :

KEY SHEET


APPROVALS	ENGINEER	DATE	APPROVALS	ENGINEER	DATE
City Engineer	<i>Roger A. Shreen</i>	<i>4/11/89</i>	Liquid Waste	<i>N/A</i>	
A.C.E. - Design	"	"	Traffic	<i>Roger A. Shreen</i>	<i>4/11/89</i>
A.C.E. - Hydrology	"	"	Water	<i>N/A</i>	
			N.M. Utilities	<i>N/A</i>	<i>4-20-89</i>
DRAWING NO.	3575	MAP NO.	C-13	SHEET 4	OF 17

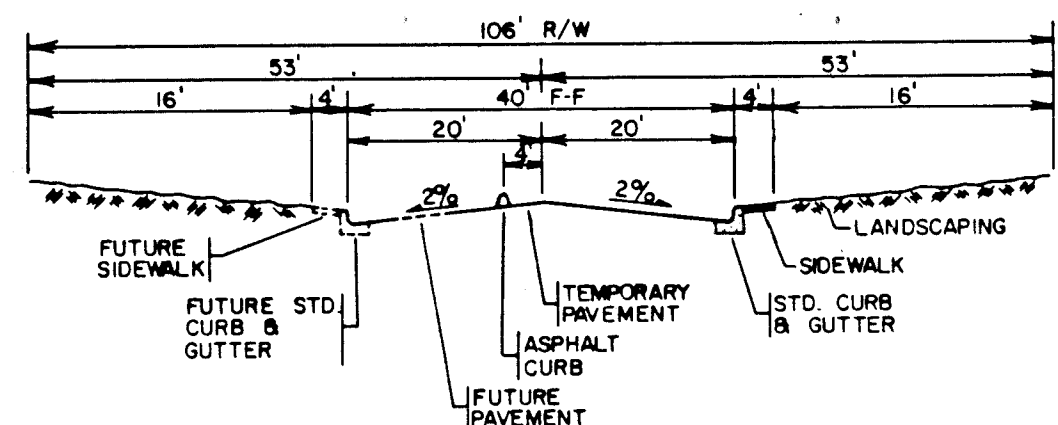


SECTION A-A
PARADISE BLVD.
NO SCALE
(FUTURE)

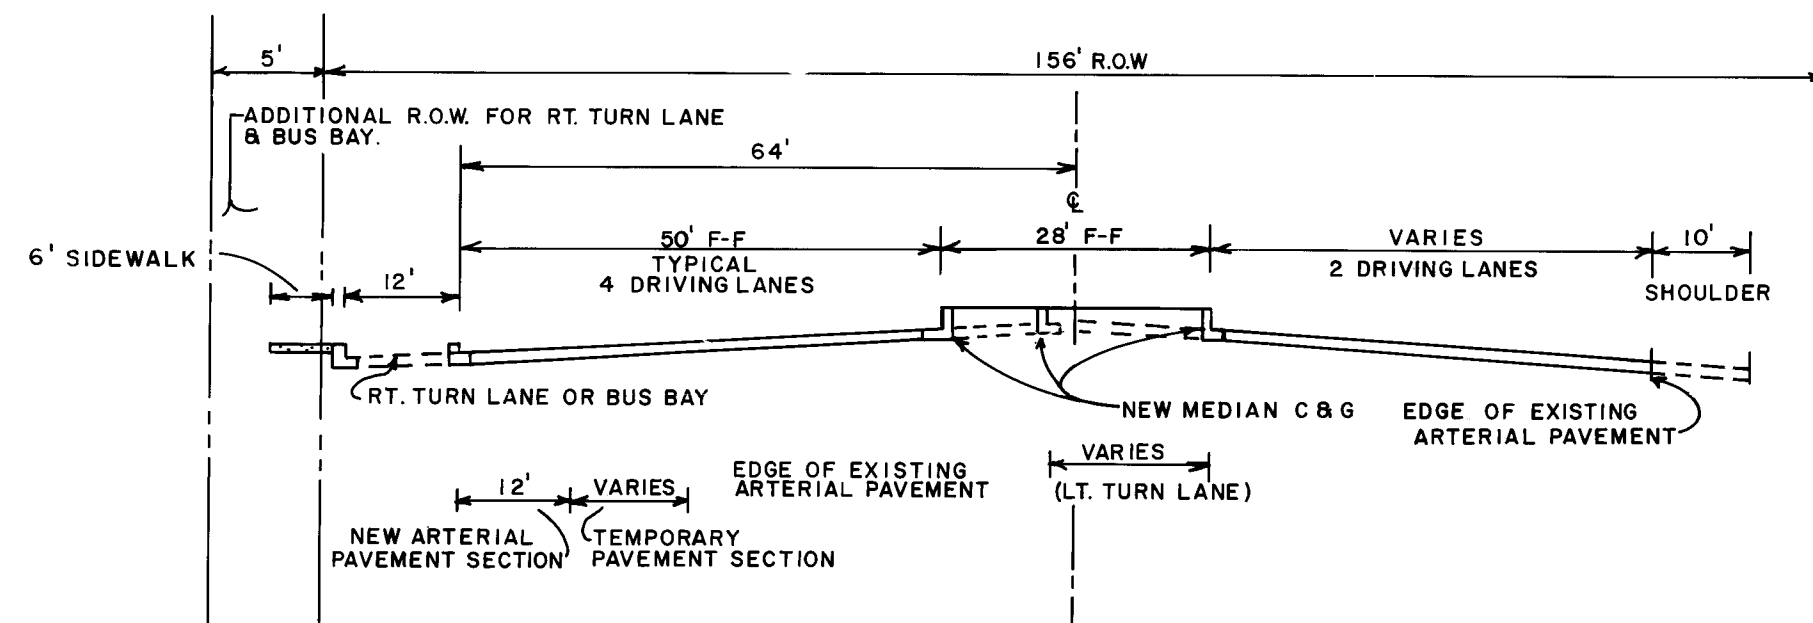

SECTION B-B
TYPICAL ROADWAY SECTION FOR COORS BLVD.
NOT TO SCALE

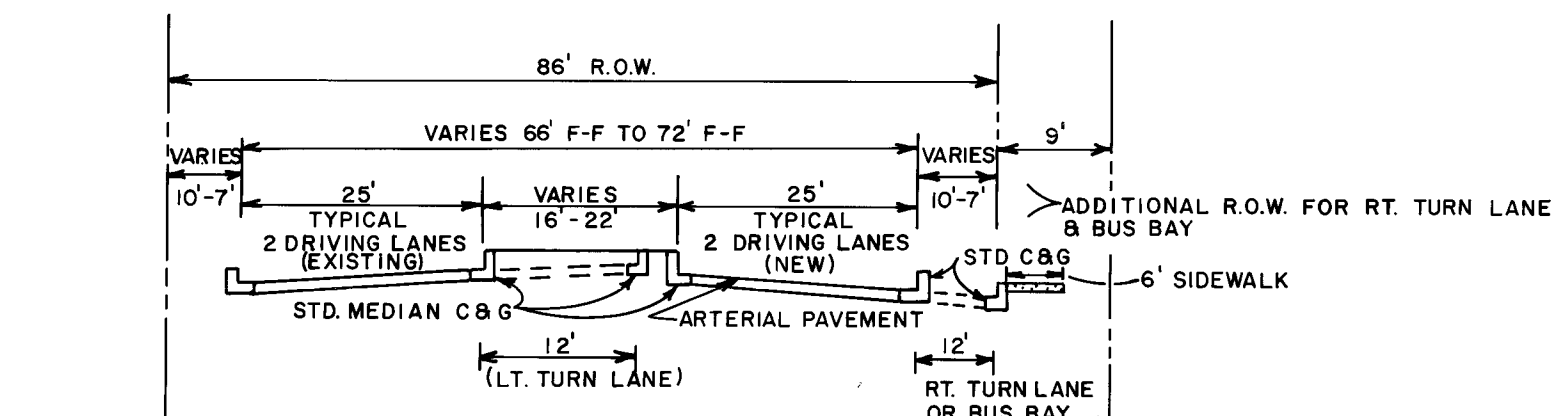


SECTION C-C
TYPICAL ROADWAY SECTION FOR EAGLE RANCH ROAD
NOT TO SCALE

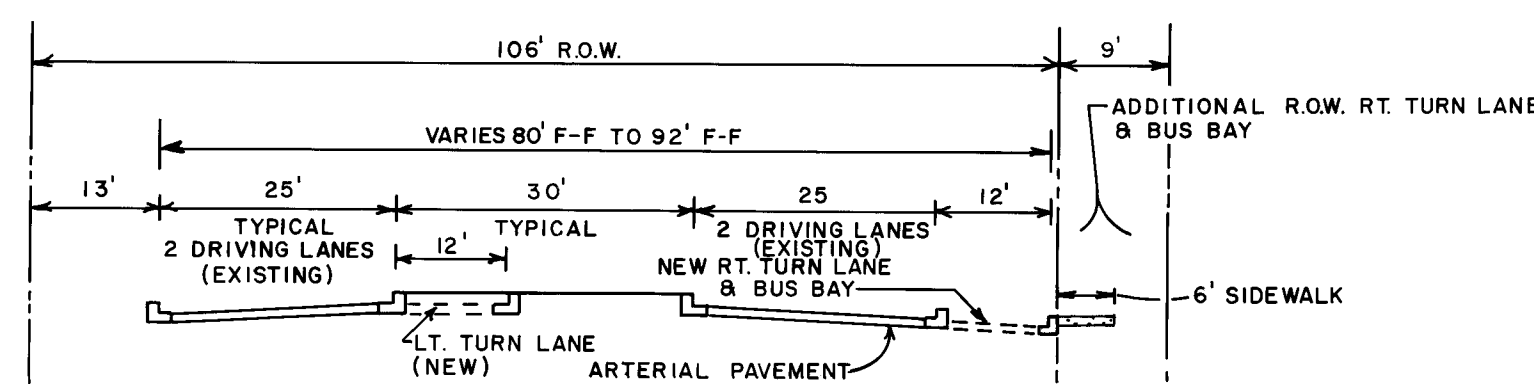

SECTION D-D
TYPICAL ROADWAY SECTION FOR IRVING BLVD.
NOT TO SCALE

STA. 5+71.04 EAGLE RANCH ROAD=
STA. 0+00.00 PARADISE BLVD.

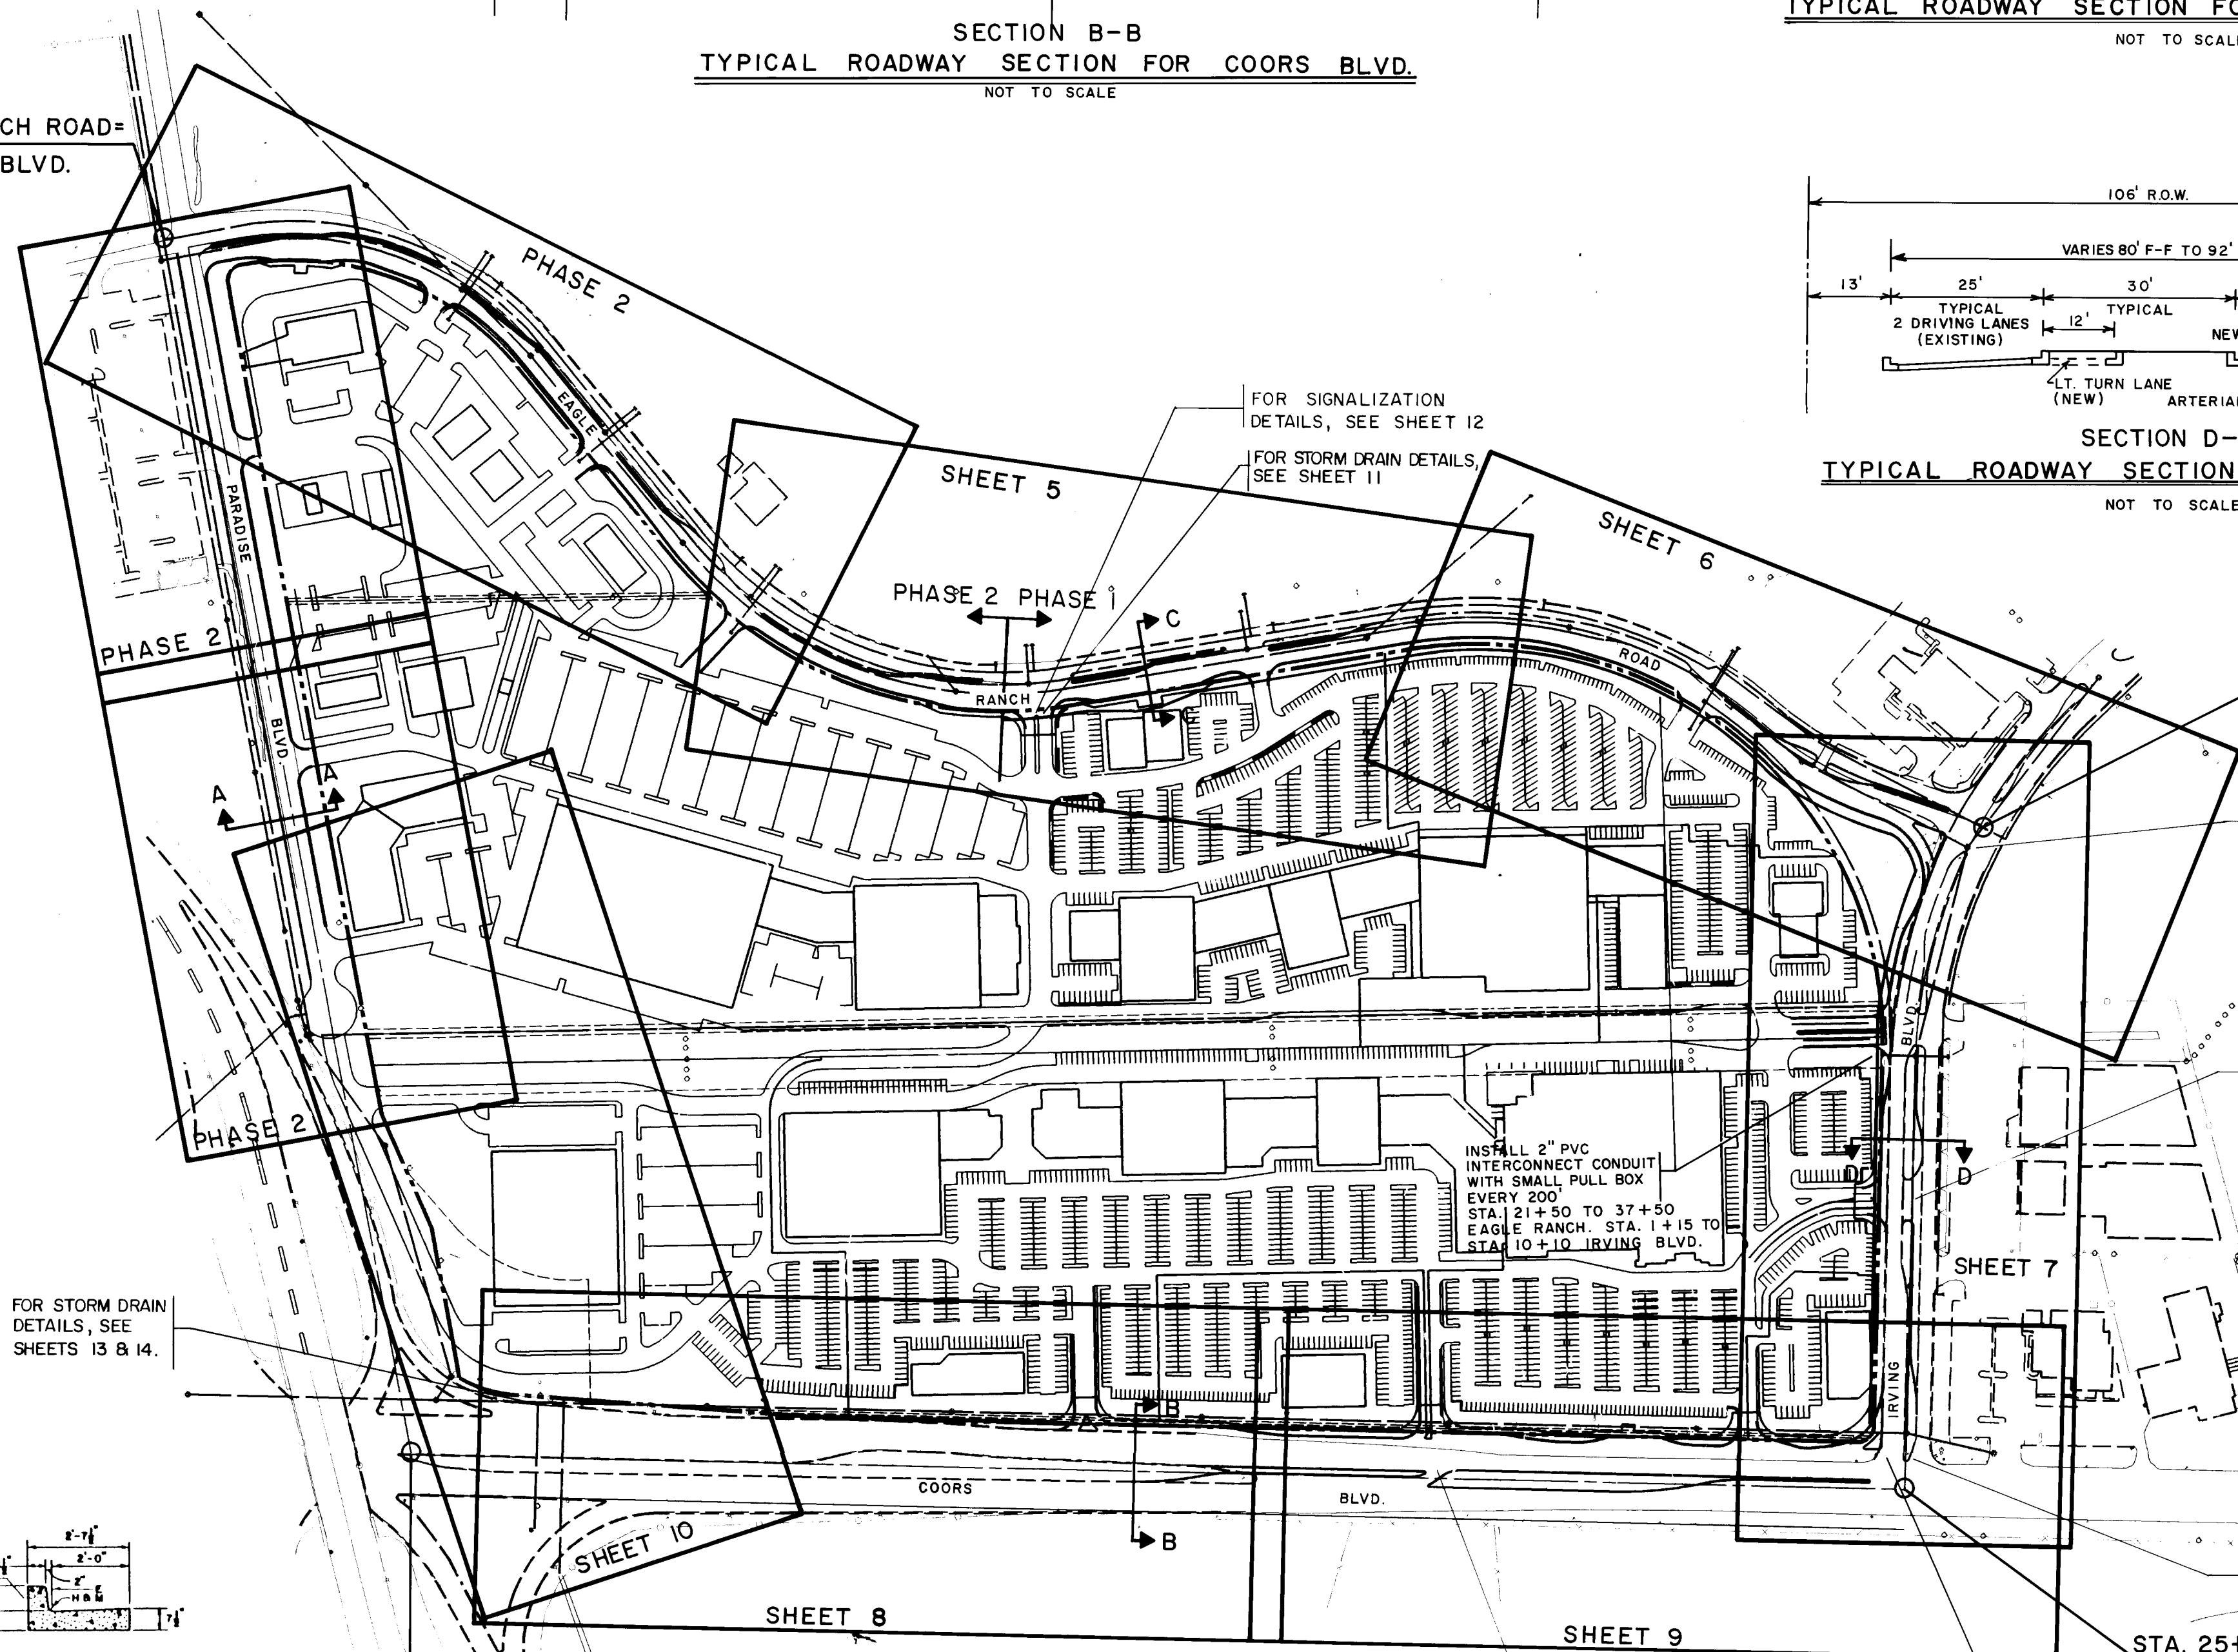

STA. 38+24.11 EAGLE RANCH ROAD
STA. 10+91.83 IRVING BLVD.

FOR SIGNALIZATION
DETAILS, SEE SHEET 3

FOR SIGNALIZATION
DETAILS, SEE SHEET 14


GENERAL NOTES CONT.:
ONE JOINT (20') OF WATERLINE PIPE IS TO
BE INSTALLED BEYOND THE VALVE ON ALL
DEAD END WATERLINE EXTENSIONS.

THE CONTRACTOR MUST NOTIFY NEW MEXICO
UTILITIES INC. (888-2661) 48 HOURS
PRIOR TO CONSTRUCTION AFFECTING ANY
EXISTING OR PROPOSED WATER AND SEWER
FACILITIES.

FOR SIGNALIZATION
DETAILS, SEE SHEET 15

FOR SIGNALIZATION
DETAILS, SEE SHEET 16

FOR STORM DRAIN DETAILS,
SEE SHEET 9

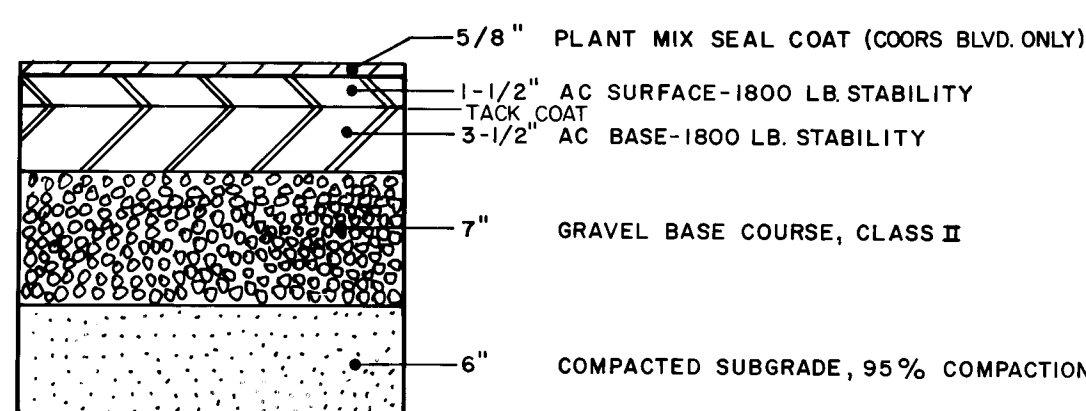


TYPICAL ARTERIAL PAVEMENT SECTION
NOT TO SCALE

GENERAL NOTES:


1. CURBS, GUTTERS & CUT-OFF WALL TO BE CON-
STRUCTED OF P.C.C.
2. FOR STAIRWAY AND MEDIAN C&G PROVIDE CON-
STRUCTION JTS. 6" O.C. MAX. ALSO PROVIDE 1/2"
EXP. JTS. 48" O.C. MAX. AT CURB RETURNS & AT
EACH SIDE OF DRIVEWAY.
3. FOR ALL OTHER C&G PROVIDE CONTR. JTS. AT
10' O.C. PROVIDE EXP. JTS. 50' O.C. & ADJACENT
TO BUILDINGS & WALLS.
4. EDGES NOT SPEC. DIMENSIONED SHALL BE EDGED
WITH A 3/8" EDGING TOOL.
5. STD. C & G SHALL BE USED FOR NEW CONSTR. UN-
LESS OTHERWISE APPROVED BY THE ENGINEER.
6. REMOVE & REPLACE 12" WIDE STRIP OF PAVEMENT
BEHIND LIP OF GUTTER WHEN CONSTRUCTING
C & G. ADJACENT TO EXIST. AC PAVEMENT.
7. STD. C & G REQUIRE FULL FORM ON ALL FACES
EXCEPT WITH PRIOR APPROVAL OF ENGINEER.

CONSTRUCTION NOTES:

- A. REG. CONC. CHANNEL LINING, OR CUT-OFF WALL,
PROVIDE 1/2" EXP. JTS. BETWEEN BACK OF CURB
& CONC. LINING OR WALL.
- B. VARIABLE, DEPRESS AS NEEDED.
- C. DRIVE NO. 4 BARS 18" DEEP IN HOLES DRILLED 2"
O.C. IN EXIST. PAVEMENT, SEAL WITH EPOXY.
- D. EXIST. A.C. OR P.C.C. PAVEMENT.
- E. THEORETICAL FACE OF CURB OR FLOWLINE.
- F. TRAFFIC SIDE.
- G. 3/4" RADIUS.
- H. 1 1/2" RADIUS.
- I. 2" RADIUS.
- J. 24" RADIUS.
- K. TACK COAT.
- L. DIMENSIONS AT ROUNDED CORNERS MEASURED
TO INTERSECTION OF STRAIGHT LINES.
- N. 2" AC SURFACE COURSE 1800 LBS. STABILITY.
- P. 6" COMPACTED SUBGRADE 90% COMPACTION.

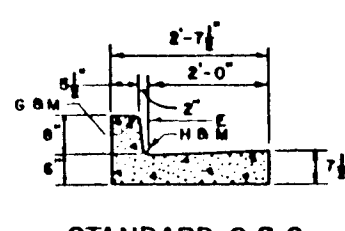

STANDARD C&G.

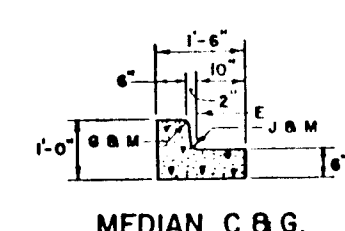

MEDIAN C&G.

STA. 0+92.29 COORS BLVD. THIS PROJECT =
STA. 16+05.25 COORS BLVD. NMSHD PROJECT
SP- (M)-4054 (201)

CURB & GUTTER DETAIL

NOT TO SCALE
C&G DWG NO. 2415

GENERAL NOTES

ALL WORK DETAILED ON THESE PLANS TO BE
PERFORMED UNDER THIS CONTRACT, AND UNLESS
STATED OTHERWISE OR PROVIDED FOR HEREON,
SHALL BE CONSTRUCTED IN ACCORDANCE WITH
THE CITY OF ALBUQUERQUE STANDARD SPECI-
FICATIONS, PUBLIC WORKS CONSTRUCTION, 1986
(REFERRED HEREIN AS "STANDARD SPECIFI-
CATIONS").

TWO (2) WORKING DAYS PRIOR TO ANY EXCAVA-
TION, CONTRACTOR MUST CONTACT LINE
LOCATING SERVICE, 765-1234, FOR LOCATION
OF EXISTING UTILITIES.

PRIOR TO CONSTRUCTION, THE CONTRACTOR
SHALL EXCAVATE AND VERIFY THE HORIZONTAL
AND VERTICAL LOCATIONS OF ALL POTENTIAL
OBSTRUCTIONS. SHOULD A CONFLICT EXIST,
THE CONTRACTOR SHALL NOTIFY THE ENGINEER
SO THAT THE CONFLICT CAN BE RESOLVED WITH
A MINIMUM AMOUNT OF DELAY.

ALL WORK ON THIS PROJECT SHALL BE PER-
FORMED IN ACCORDANCE WITH APPLICABLE
FEDERAL, STATE, AND LOCAL LAWS, RULES AND
REGULATIONS GOVERNING CONSTRUCTION SAFETY
AND HEALTH.

ALL GAS, ELECTRICAL, TELEPHONE, CABLE TV
LINES, CABLES, AND APPURTENANCES
ENCOUNTERED DURING CONSTRUCTION THAT
REQUIRE RELOCATION, SHALL BE COORDINATED
WITH THAT UTILITY. CONTRACTOR SHALL BE
RESPONSIBLE FOR COORDINATION OF ALL
NECESSARY UTILITY ADJUSTMENTS.

IT WILL BE CONTRACTOR'S RESPONSIBILITY TO
PROTECT AND MAINTAIN IN SERVICE ALL
EXISTING UTILITIES.

THE CONTRACTOR WILL BE REQUIRED TO CONFIN-
E HIS WORK WITHIN THE CONSTRUCTION LIMITS
AND/OR PUBLIC RIGHT-OF-WAY TO PRESERVE
EXISTING VEGETATION AND PRIVATE PROPERTY.
OVERNIGHT PARKING OF CONSTRUCTION EQUIP-
MENT SHALL NOT OBSTRUCT DRIVEWAYS OR
DESIGNATED TRAFFIC LANES.

A DISPOSAL SITE FOR ALL EXCESS EXCAVATION
MATERIAL, ASPHALTIC PAVING, CONCRETE CURBS
AND SIDEWALKS, ETC. SHALL BE OBTAINED BY
THE CONTRACTOR IN COMPLIANCE WITH APPLICA-
BLE ENVIRONMENTAL REGULATIONS AND APPROVED
BY THE PROJECT ENGINEER. ALL COSTS
INCURRED IN OBTAINING A DISPOSAL SITE AND
HAUL THERE TO BE CONSIDERED INCIDENTAL
TO THE PROJECT AND NO SEPARATE
MEASUREMENT OR PAYMENT SHALL BE MADE.

WHEN ABUTTING NEW PAVEMENT TO EXISTING,
SAWCUT 1" BELOW SURFACE OF EXISTING
PAVEMENT TO A STRAIGHT EDGE AND AT A RIGHT
ANGLE, OR AS APPROVED BY THE PROJECT
ENGINEER, TO REMOVE ANY BROKEN OR CRACKED
PAVEMENT.

ALL SAWCUT PAVEMENT SHALL HAVE A UNIFORM
EDGE AND BE SPRAYED WITH TACK.

WHEN ABUTTING NEW CURB AND GUTTER TO
EXISTING PAVEMENT, A 1' WIDE SECTION OF
EXISTING PAVEMENT ADJACENT TO THE CURB
SHALL BE SAWCUT, REMOVED, AND REPLACED AS
PER STANDARD SPECIFICATIONS.

ALL TRENCH BACKFILL SHALL BE COMPACTED TO
A MINIMUM 90% MAXIMUM DENSITY AS PER ASTM
D-1557. THE UPPER PORTION OF THE FINAL
BACKFILL MAY REQUIRE 95% COMPACTION IN
ORDER TO PROVIDE A SUITABLE FOUNDATION FOR
PAVEMENT, CURB AND GUTTER, SIDEWALK OR
OTHER TYPE OF STRUCTURE.

ALL CATCH BASIN CONNECTOR PIPES SHALL BE
CLASS III RCP. ALL RCP STORM SEWER PIPE
TRENCHED TO A DEPTH GREATER THAN 8' SHALL
BE CLASS IV.

MANHOLE STEPS WILL BE INSTALLED IN ALL
STORM DRAIN MANHOLES, AND CATCH BASINS AS
PER STANDARD SPECIFICATIONS. PAYMENT
SHALL BE CONSIDERED INCIDENTAL TO OTHER
CONTRACT ITEMS.

IT SHALL BE THE CONTRACTOR'S RESPONSIBILI-
TY TO OBTAIN ALL PERMITS (SUCH AS
BARRICADING, TOPSOIL DISTURBANCE AND
EXCAVATION PERMITS) NECESSARY FOR THIS
PROJECT PRIOR TO COMMENCING CONSTRUCTION.


ALL SUBGRADE PREPARATION SHALL BE
COMPACTED TO 95% MAXIMUM DENSITY AS PER
ASTM D-1557 UNLESS NOTED OTHERWISE.

CONT. ABOVE 1 2 3 4 5 6 7 8 9 10 11 12
26 35 75 04 90

CITY OF ALBUQUERQUE
INFRASTRUCTURE IMPROVEMENTS
MARKET CENTER WEST


TITLE: KEY SHEET

APPROVALS	ENGINEER	DATE	APPROVALS	ENGINEER	DATE
City Engineer	Royce A. Brown	4/1/89	Liquid Waste	N/A	
A.C.E. - Design	"	"	Traffic	Royce A. Brown	4/1/89
A.C.E. - Hydrology	"	"	Water	N/A	
			N.M. Utilities	10/24/89	4-7-89
DRAWING NO.	3575	MAP NO.	C-13	SHEET	4 OF 17

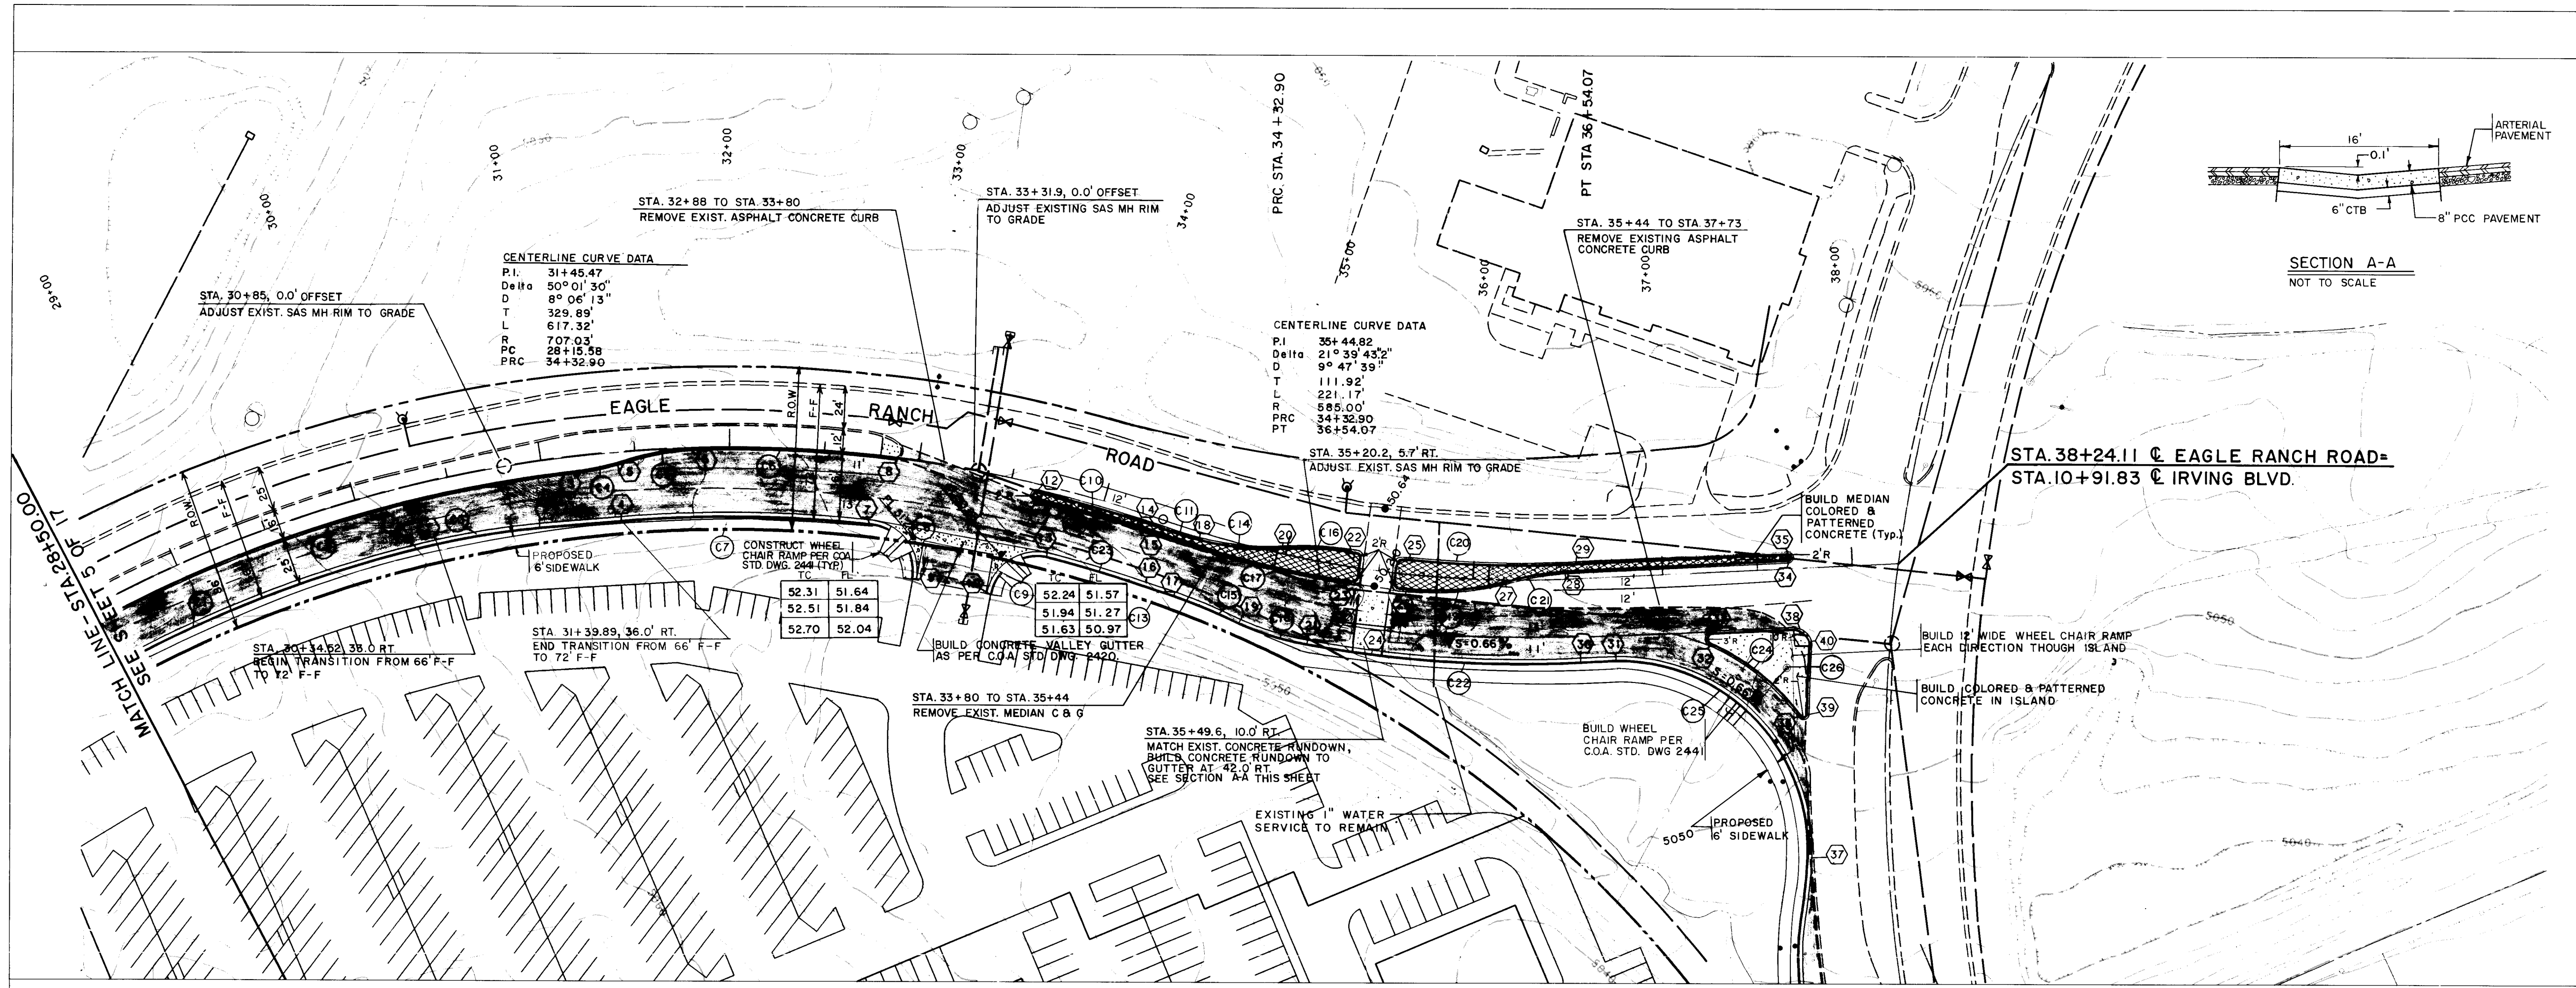

C1	Delta 17° 44' 31"	C3	Delta 8° 32' 20"	C5	Delta 16° 21' 58"	C7	Delta 11° 16' 41"	C9	Delta 94° 4' 23"	C11	Delta 1° 47' 20"	C13	Delta 1° 2' 10"	C15	Delta 7° 45' 54"	C17	Delta 10° 20' 35"	C19	Delta 23° 20' 15"	C21	Delta 12° 25' 48"	C23	Delta 4° 18' 00"	C25	Delta 96° 3' 54"
D	105.20'	D	30.11'	D	21.57'	D	66.26'	D	229.91'	D	9.20'	D	5.61'	D	53.67'	D	38.11'	D	38.11'	D	16.33'	D	25.19'	D	8° 32' 19"
L	208.72'	L	60.11'	L	42.84'	L	132.09'	L	41.04'	L	18.39'	L	11.23'	L	40.66'	L	102.05'	L	61.10'	L	32.54'	L	50.36'	L	111.18'
R	674.03'	R	403.36'	R	150.00'	R	671.03'	R	25.00'	R	589.00'	R	621.00'	R	300.00'	R	593.00'	R	150.00'	R	150.00'	R	671.03'	R	100.00'

C2	Delta 24° 22' 16"	C4	Delta 10° 36' 11"	C6	Delta 8° 6' 14"	C8	Delta 94° 5' 35"	C10	Delta 5° 06' 36"	C12	Delta 5° 06' 36"	C14	Delta 21° 4' 12"	C16	Delta 12° 32' 10"	C18	Delta 15° 3' 36"	C20	Delta 9° 08' 56"	C22	Delta 13° 19' 59"	C24	Delta 28° 09' 22"	C26	Delta 2° 05' 56"
D	150.95'	D	37.12'	D	50.09'	D	229.91'	D	31.37'	D	31.19'	D	27.90'	D	18.48'	D	19.83'	D	46.17'	D	73.32'	D	29.84'	D	6° 30' 05"
L	297.32'	L	28.50'	L	100.00'	L	41.06'	L	62.70'	L	62.35'	L	55.16'	L	32.82'	L	39.43'	L	92.14'	L	146.37'	L	58.48'	L	32.29'
R	699.03'	R	154.00'	R	707.03'	R	25.00'	R	703.03'	R	699.03'	R	150.00'	R	150.00'	R	150.00'	R	577.00'	R	629.00'	R	119.00'	R	881.29'

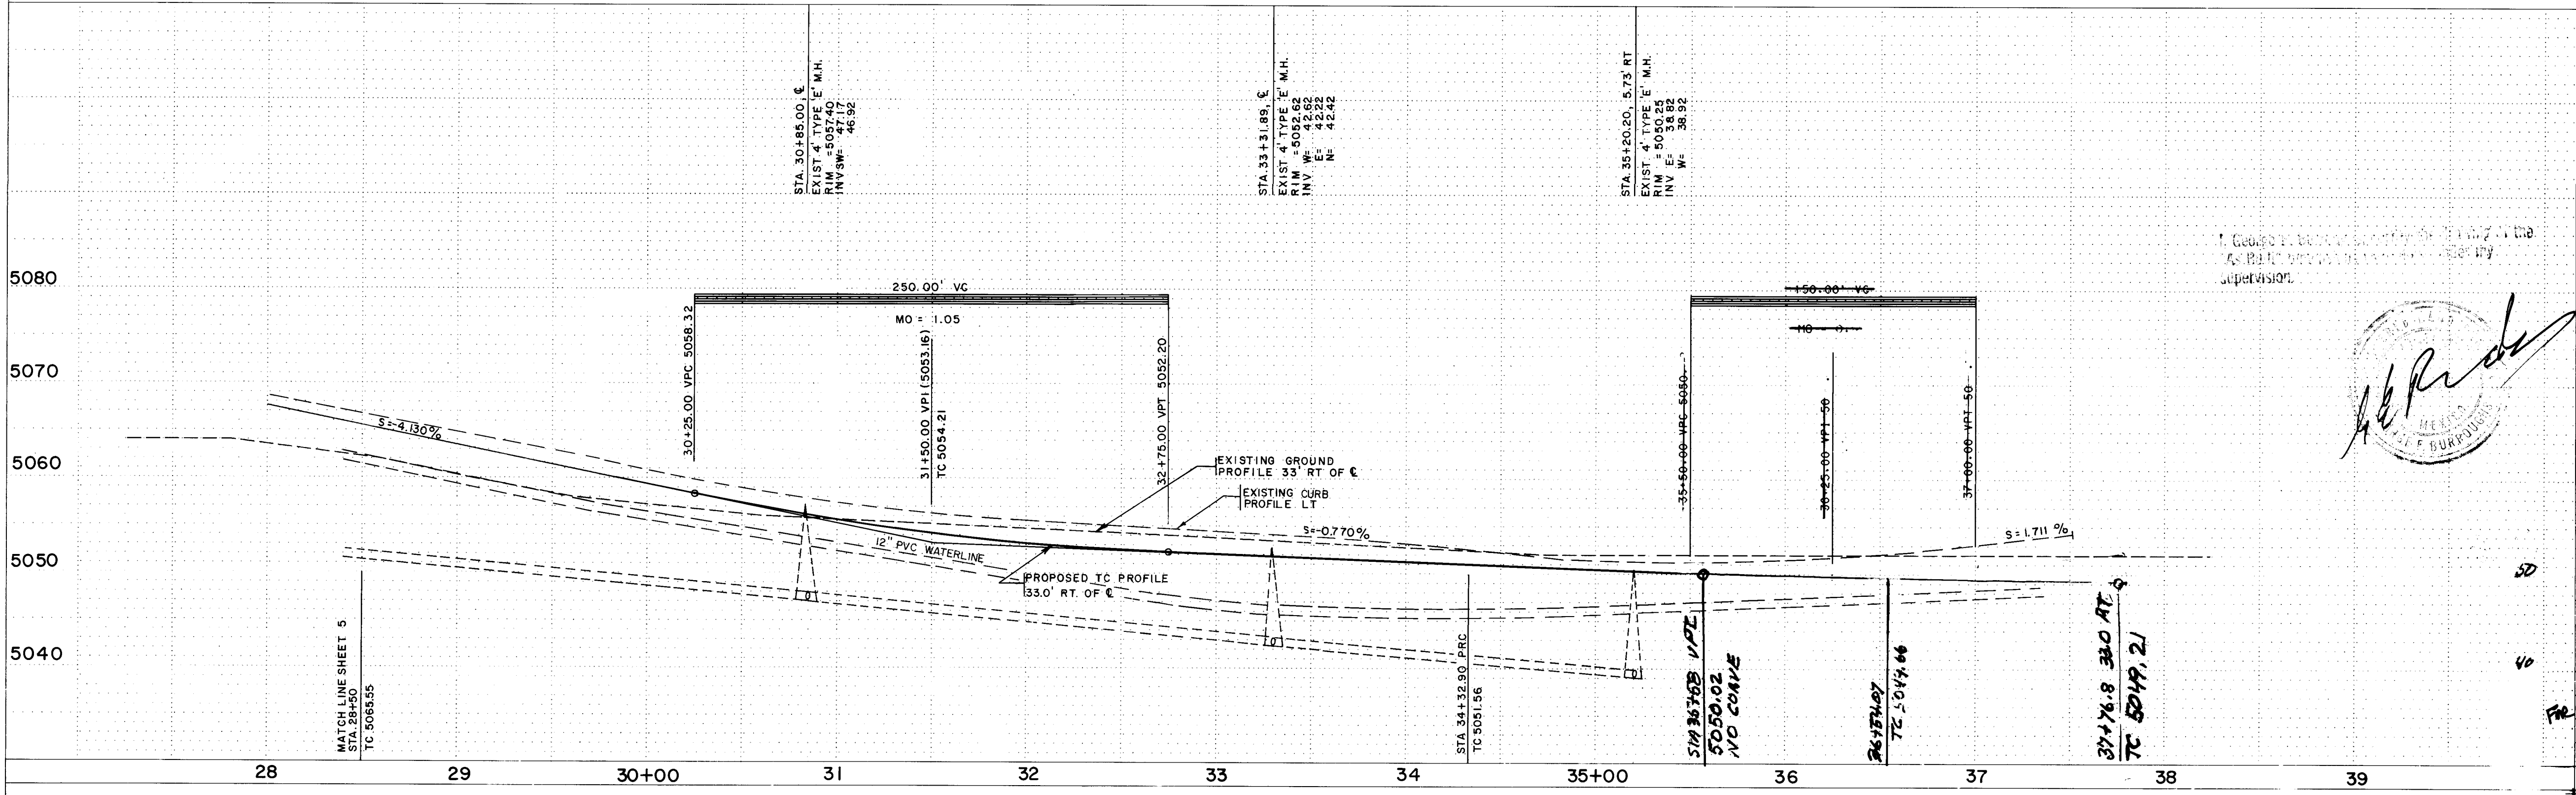

PT.	STATION	OFFSET	TC ELEV.
1	30+34.52	33.00' RT	57.93
2	30+97.59	34.79' RT	55.64
3	31+16.31	8.00' RT	55.61
4	31+39.89	36.00' RT	54.40
5	31+44.85	4.80' RT	54.90
6	31+87.43	0.00'	54.04
7	32+79.06	36.00' RT	52.11
8	32+87.43	0.00'	53.57 *
9	33+06.42	62.31' RT	52.90
10	33+52.48	62.29' RT	52.54
11	33+69.85	8.00' RT	52.49
12	33+69.85	4.00' RT	52.57
13	33+79.83	36.00' RT	51.33
14	34+32.90	4.00' RT	51.77
15	34+32.90	8.00' RT	51.61
16	34+32.90	36.00' RT	50.92
17	34+43.48	36.00' RT	50.84
18	34+51.18	4.00' RT	51.54
19	34+81.44	40.06' RT	50.47
20	35+05.50	3.51' LT	51.13
21	35+17.95	44.00' RT	50.11
22	35+38.28	8.00' LT	50.89
23	35+38.52	8.00' RT	50.76
24	35+50.00	44.00' RT	49.86
25	35+60.67	8.00' LT	51.08
26	35+60.44	8.00' RT	50.91
27	36+20.24	0.50' RT	51.60
28	36+52.51	4.00' LT	51.96
29	36+54.07	8.00' LT	52.06
30	36+54.07	44.00' RT	49.72 49.66
31	36+70.11	44.00' RT	49.60
32	37+25.48	38.65' RT	51.41
33	37+26.88	33.00' RT	51.54
34	37+66.30	4.00' LT	53.45
35	37+66.30	8.00' LT	53.65
36	37+68.63	77.24' RT	50.23
37	37+69.54	154.57' RT	47.91
38	37+65.49	33.00' RT	51.90
39	37+72.29	76.29' RT	50.35
40	37+75.43	44.16' RT	51.65

* MATCH EXISTING C & G

LEGEND

- EXISTING CURB & GUTTER
- PROPOSED CURB & GUTTER
- NEW PAVEMENT
- REMOVE EXISTING PAVEMENT

SCALE: 1" = 50'


26 35750690

CITY OF ALBUQUERQUE
INFRASTRUCTURE IMPROVEMENTS
MARKET CENTER WEST

TITLE: EAGLE RANCH ROAD
STA. 28+50.00 - STA. 38+24.11


APPROVALS	ENGINEER	DATE	APPROVALS	ENGINEER	DATE
City Engineer	Raymond A. Shaw	4/1/07	Liquid Waste	N/A	
A.C.E. - Design	"	"	Traffic	Raymond A. Shaw	4/1/07
A.C.E. - Hydrology	"	"	Water	N/A	
			N.M. Utilities	L. P. Shaw	4-2-07

DRAWING NO. 3575 MAP NO. C-13 SHEET 6 OF 17

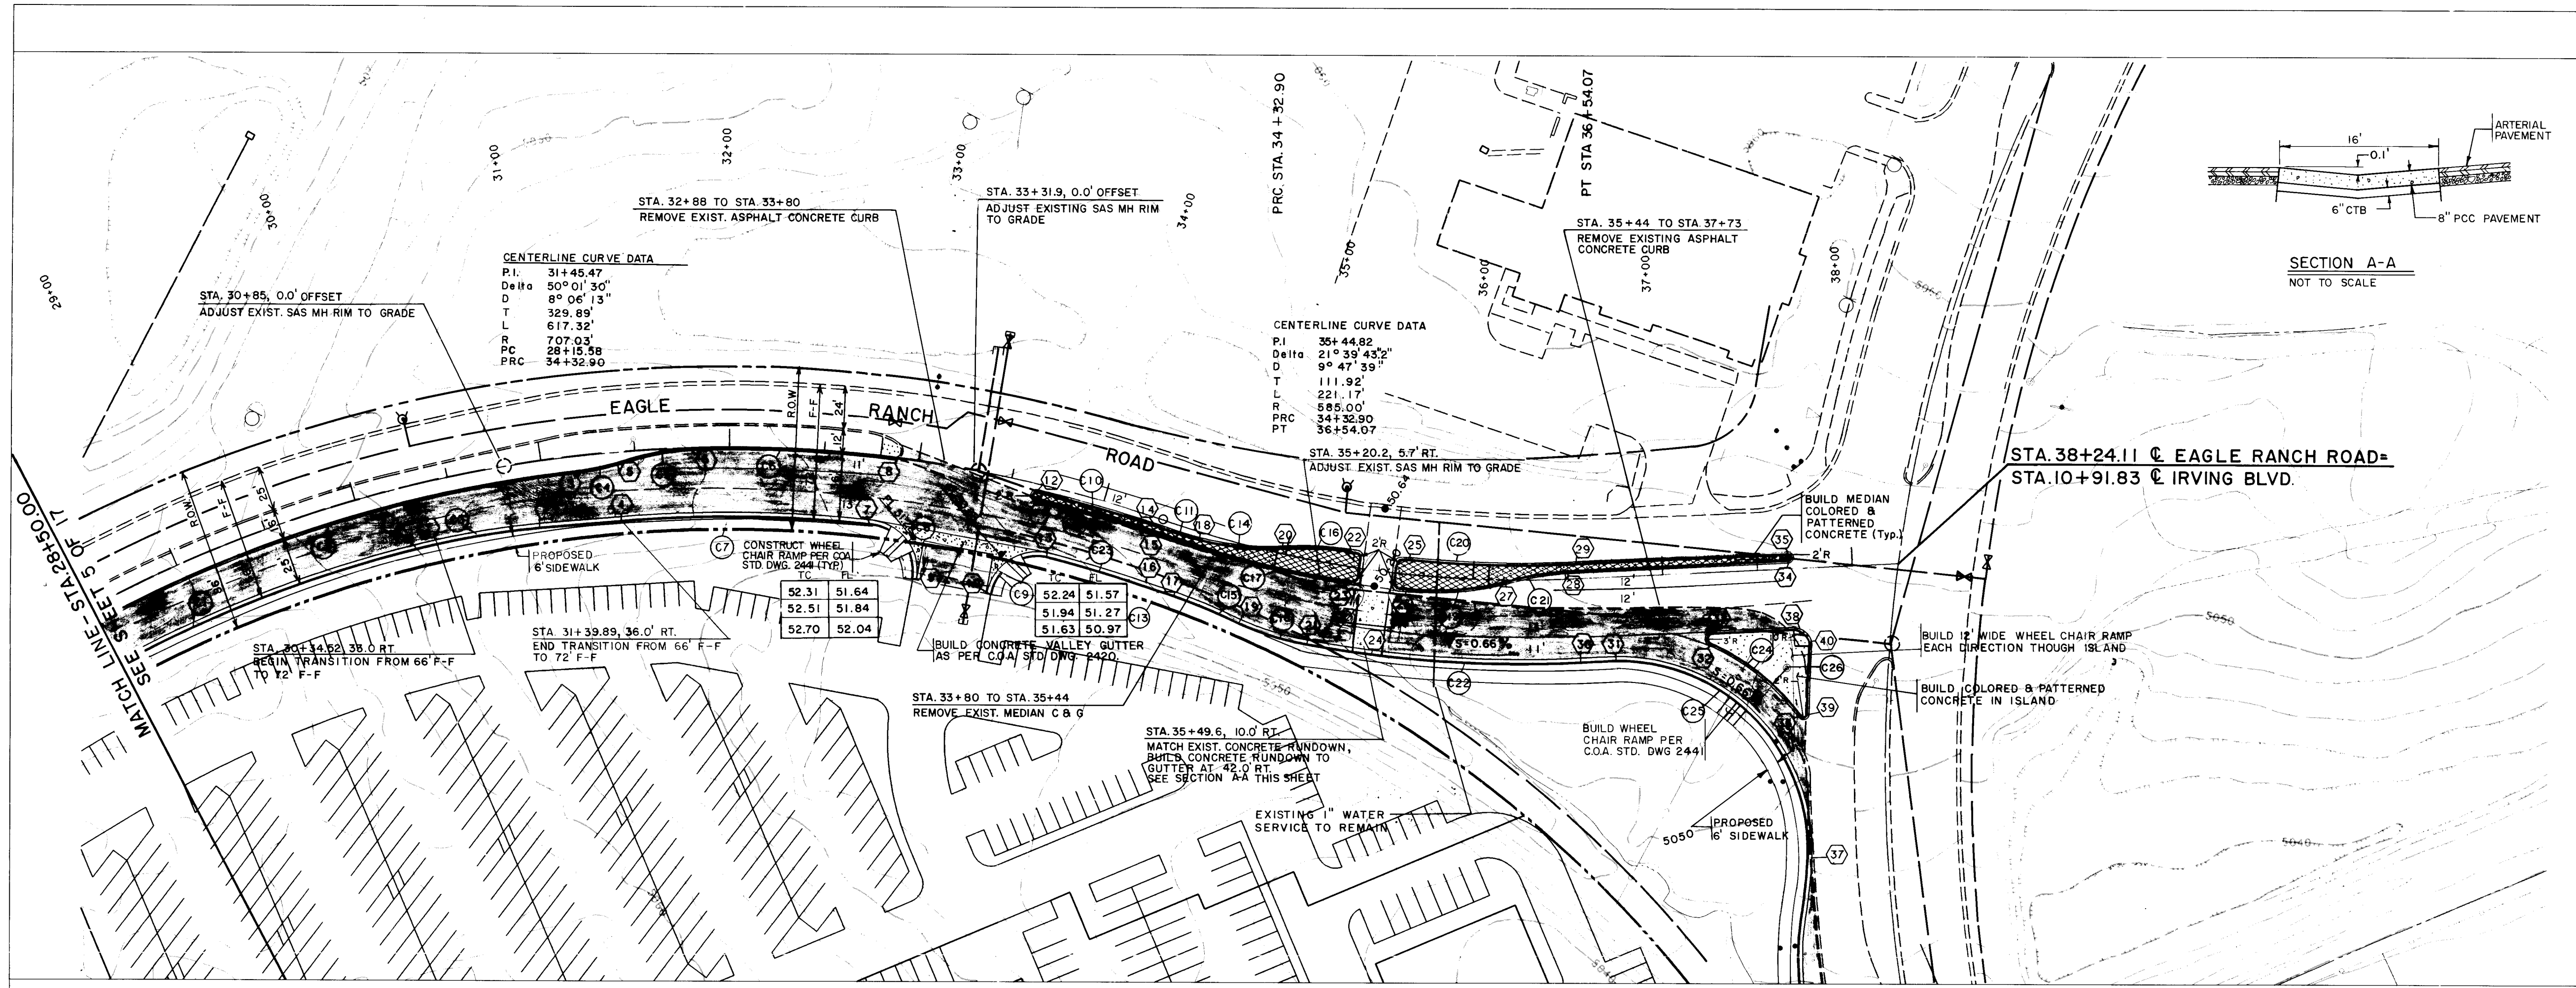

C1	Delta 17° 44' 31"	C3	Delta 8° 32' 20"	C5	Delta 16° 21' 58"	C7	Delta 11° 16' 41"	C9	Delta 94° 4' 23"	C11	Delta 1° 47' 20"	C13	Delta 1° 2' 10"	C15	Delta 7° 45' 54"	C17	Delta 10° 20' 35"	C19	Delta 23° 20' 15"	C21	Delta 12° 25' 48"	C23	Delta 4° 18' 00"	C25	Delta 96° 3' 54"
D	105.20'	D	30.11'	D	21.57'	D	66.26'	D	229.91'	D	9.20'	D	5.61'	D	53.67'	D	38.11'	D	38.11'	D	16.33'	D	25.19'	D	8° 32' 19"
L	208.72'	L	60.11'	L	42.84'	L	132.09'	L	26.84'	L	18.39'	L	11.23'	L	40.66'	L	102.05'	L	61.10'	L	32.54'	L	50.36'	L	57° 17' 45"
R	674.03'	R	403.36'	R	150.00'	R	671.03'	R	25.00'	R	589.00'	R	621.00'	R	300.00'	R	593.00'	R	150.00'	R	150.00'	R	671.03'	R	100.00'

C2	Delta 24° 22' 16"	C4	Delta 10° 36' 11"	C6	Delta 8° 6' 14"	C8	Delta 94° 5' 35"	C10	Delta 5° 06' 36"	C12	Delta 5° 06' 36"	C14	Delta 21° 4' 12"	C16	Delta 12° 32' 10"	C18	Delta 15° 3' 36"	C20	Delta 9° 08' 56"	C22	Delta 13° 19' 59"	C24	Delta 28° 09' 22"	C26	Delta 2° 05' 56"
D	150.95'	D	37.12' 18"	D	50.09'	D	229.91' 00"	D	31.37'	D	31.19'	D	27.90'	D	18.48'	D	19.83'	D	46.17'	D	73.32' 32"	D	29.84'	D	6° 30' 05"
L	297.32'	L	28.50'	L	100.00'	L	41.06'	L	62.70'	L	62.35'	L	55.16'	L	32.82'	L	39.43'	L	92.14'	L	146.37'	L	58.48'	L	32.29'
R	699.03'	R	154.00'	R	707.03'	R	25.00'	R	703.03'	R	699.03'	R	150.00'	R	150.00'	R	150.00'	R	577.00'	R	629.00'	R	119.00'	R	881.29'

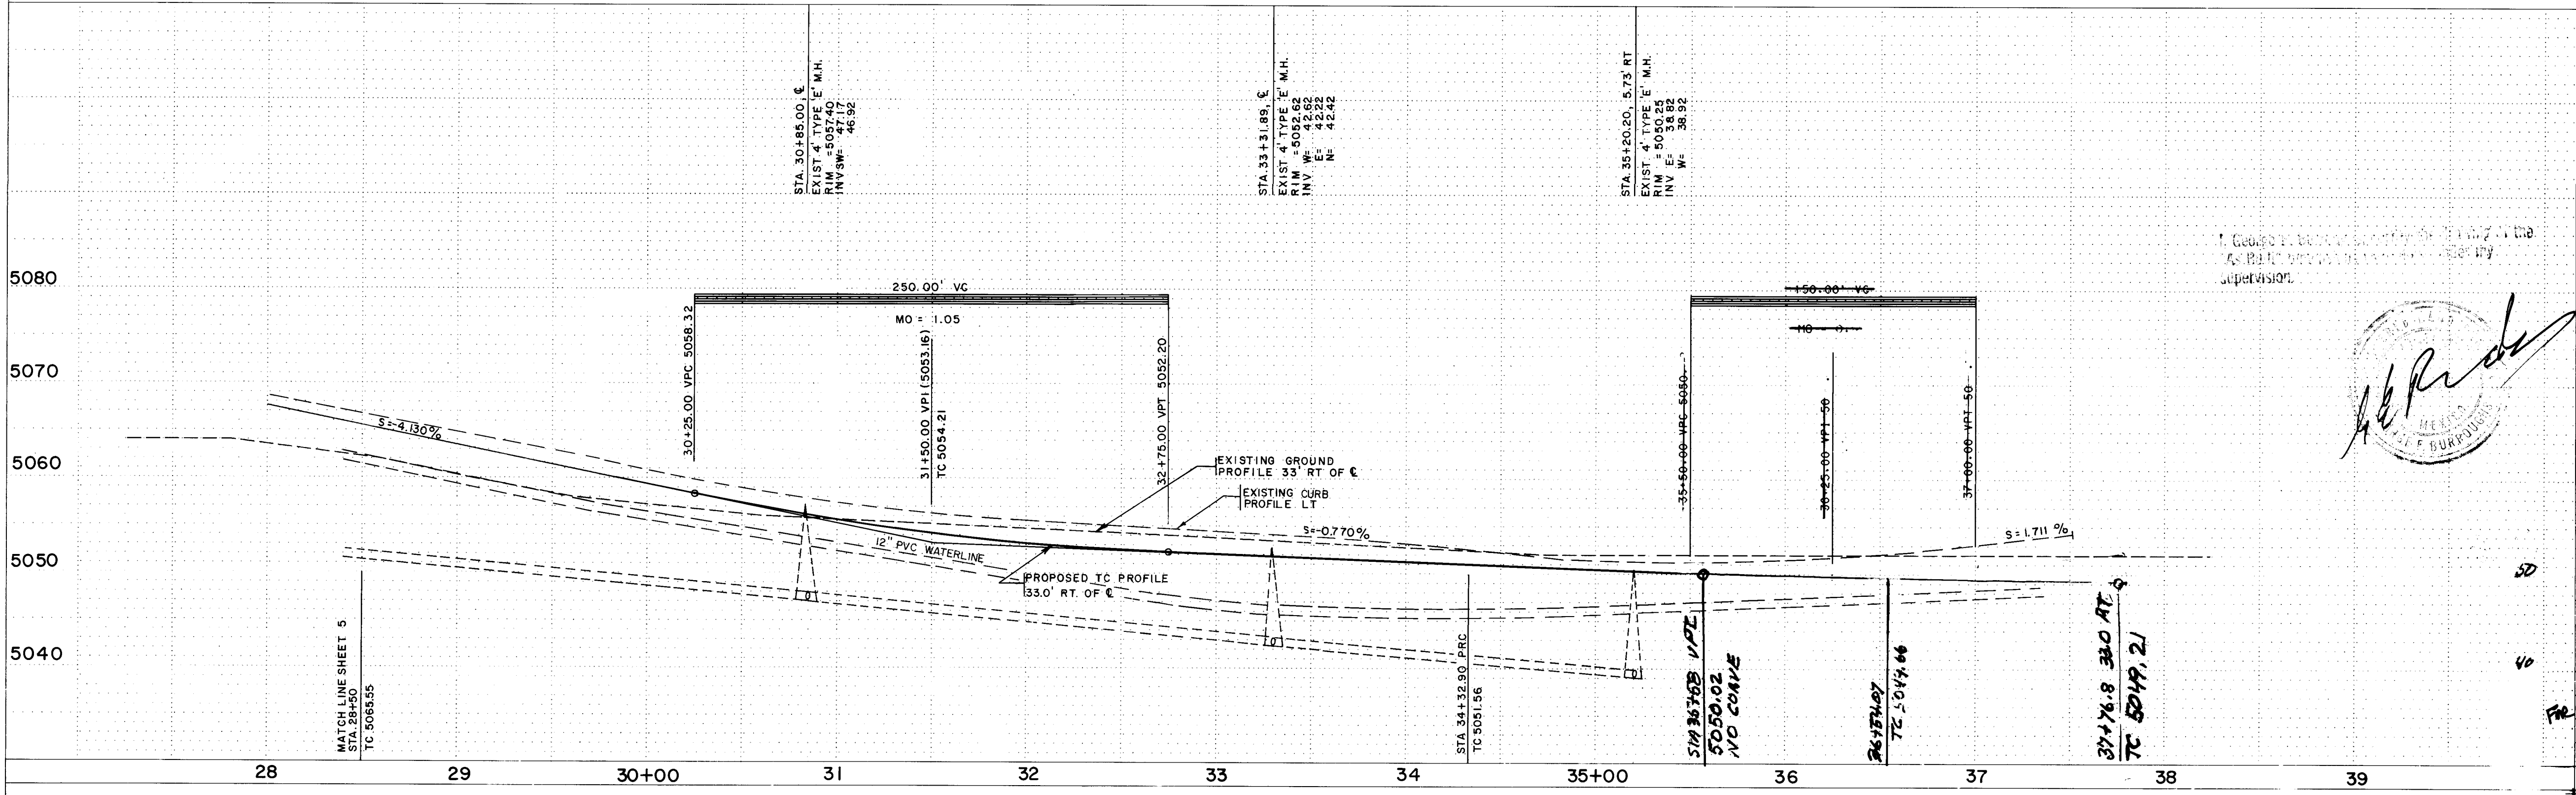

PT.	STATION	OFFSET	TC ELEV.
1	30+34.52	33.00' RT	57.93
2	30+97.59	34.79' RT	55.64
3	31+16.31	8.00' RT	55.61
4	31+39.89	36.00' RT	54.40
5	31+44.85	4.80' RT	54.90
6	31+87.43	0.00'	54.04
7	32+79.06	36.00' RT	52.11
8	32+87.43	0.00'	53.57 *
9	33+06.42	62.31' RT	52.90
10	33+52.48	62.29' RT	52.54
11	33+69.85	8.00' RT	52.49
12	33+69.85	4.00' RT	52.57
13	33+79.83	36.00' RT	51.33
14	34+32.90	4.00' RT	51.77
15	34+32.90	8.00' RT	51.61
16	34+32.90	36.00' RT	50.92
17	34+43.48	36.00' RT	50.84
18	34+51.18	4.00' RT	51.54
19	34+81.44	40.06' RT	50.47
20	35+05.50	3.51' LT	51.13
21	35+17.95	44.00' RT	50.11
22	35+38.28	8.00' LT	50.89
23	35+38.52	8.00' RT	50.76
24	35+50.00	44.00' RT	49.86
25	35+60.67	8.00' LT	51.08
26	35+60.44	8.00' RT	50.91
27	36+20.24	0.50' RT	51.60
28	36+52.51	4.00' LT	51.96
29	36+54.07	8.00' LT	52.06
30	36+54.07	44.00' RT	49.72 49.66
31	36+70.11	44.00' RT	49.60
32	37+25.48	38.65' RT	51.41
33	37+26.88	33.00' RT	51.54
34	37+66.30	4.00' LT	53.45
35	37+66.30	8.00' LT	53.65
36	37+68.63	77.24' RT	50.23
37	37+69.54	154.57' RT	47.91
38	37+65.49	33.00' RT	51.90
39	37+72.29	76.29' RT	50.35
40	37+75.43	44.16' RT	51.65

* MATCH EXISTING C & G

LEGEND

- EXISTING CURB & GUTTER
- PROPOSED CURB & GUTTER
- NEW PAVEMENT
- REMOVE EXISTING PAVEMENT

SCALE: 1" = 50'

26 35750690

CITY OF ALBUQUERQUE
INFRASTRUCTURE IMPROVEMENTS
MARKET CENTER WEST

TITLE: EAGLE RANCH ROAD
STA. 28+50.00 - STA. 38+24.11

APPROVALS	ENGINEER	DATE	APPROVALS	ENGINEER	DATE
City Engineer	Ray A. Shaw	4/1/07	Liquid Waste	N/A	
A.C.E. - Design	"	"	Traffic	Ray A. Shaw	4/1/07
A.C.E. - Hydrology	"	"	Water	N/A	
			N.M. Utilities	L. Shaw	4-2-07

DRAWING NO. 3575 MAP NO. C-13 SHEET 6 OF 17

AS BUILT INFORMATION

SWANANCE
KALKER SURVEY
RAY BACA 2/16/90

BENCH MARKS

USC & GS BRASS TABLET R. ALAMEDA A-3" NEW MEXICO
STATE PLANE COORDINATES (CENTRAL ZONE)
X=377,094.67 Y=1523,108.34
GROUND TO GRID FACTOR=0.99967685
Δ CC=00° 14' 13"
Δ CL.FY.=5027.05

ENGINEER'S SEAL


NO. DATE REMARKS REVISIONS DESIGN

NO. DATE

DATE




DATE

DATE

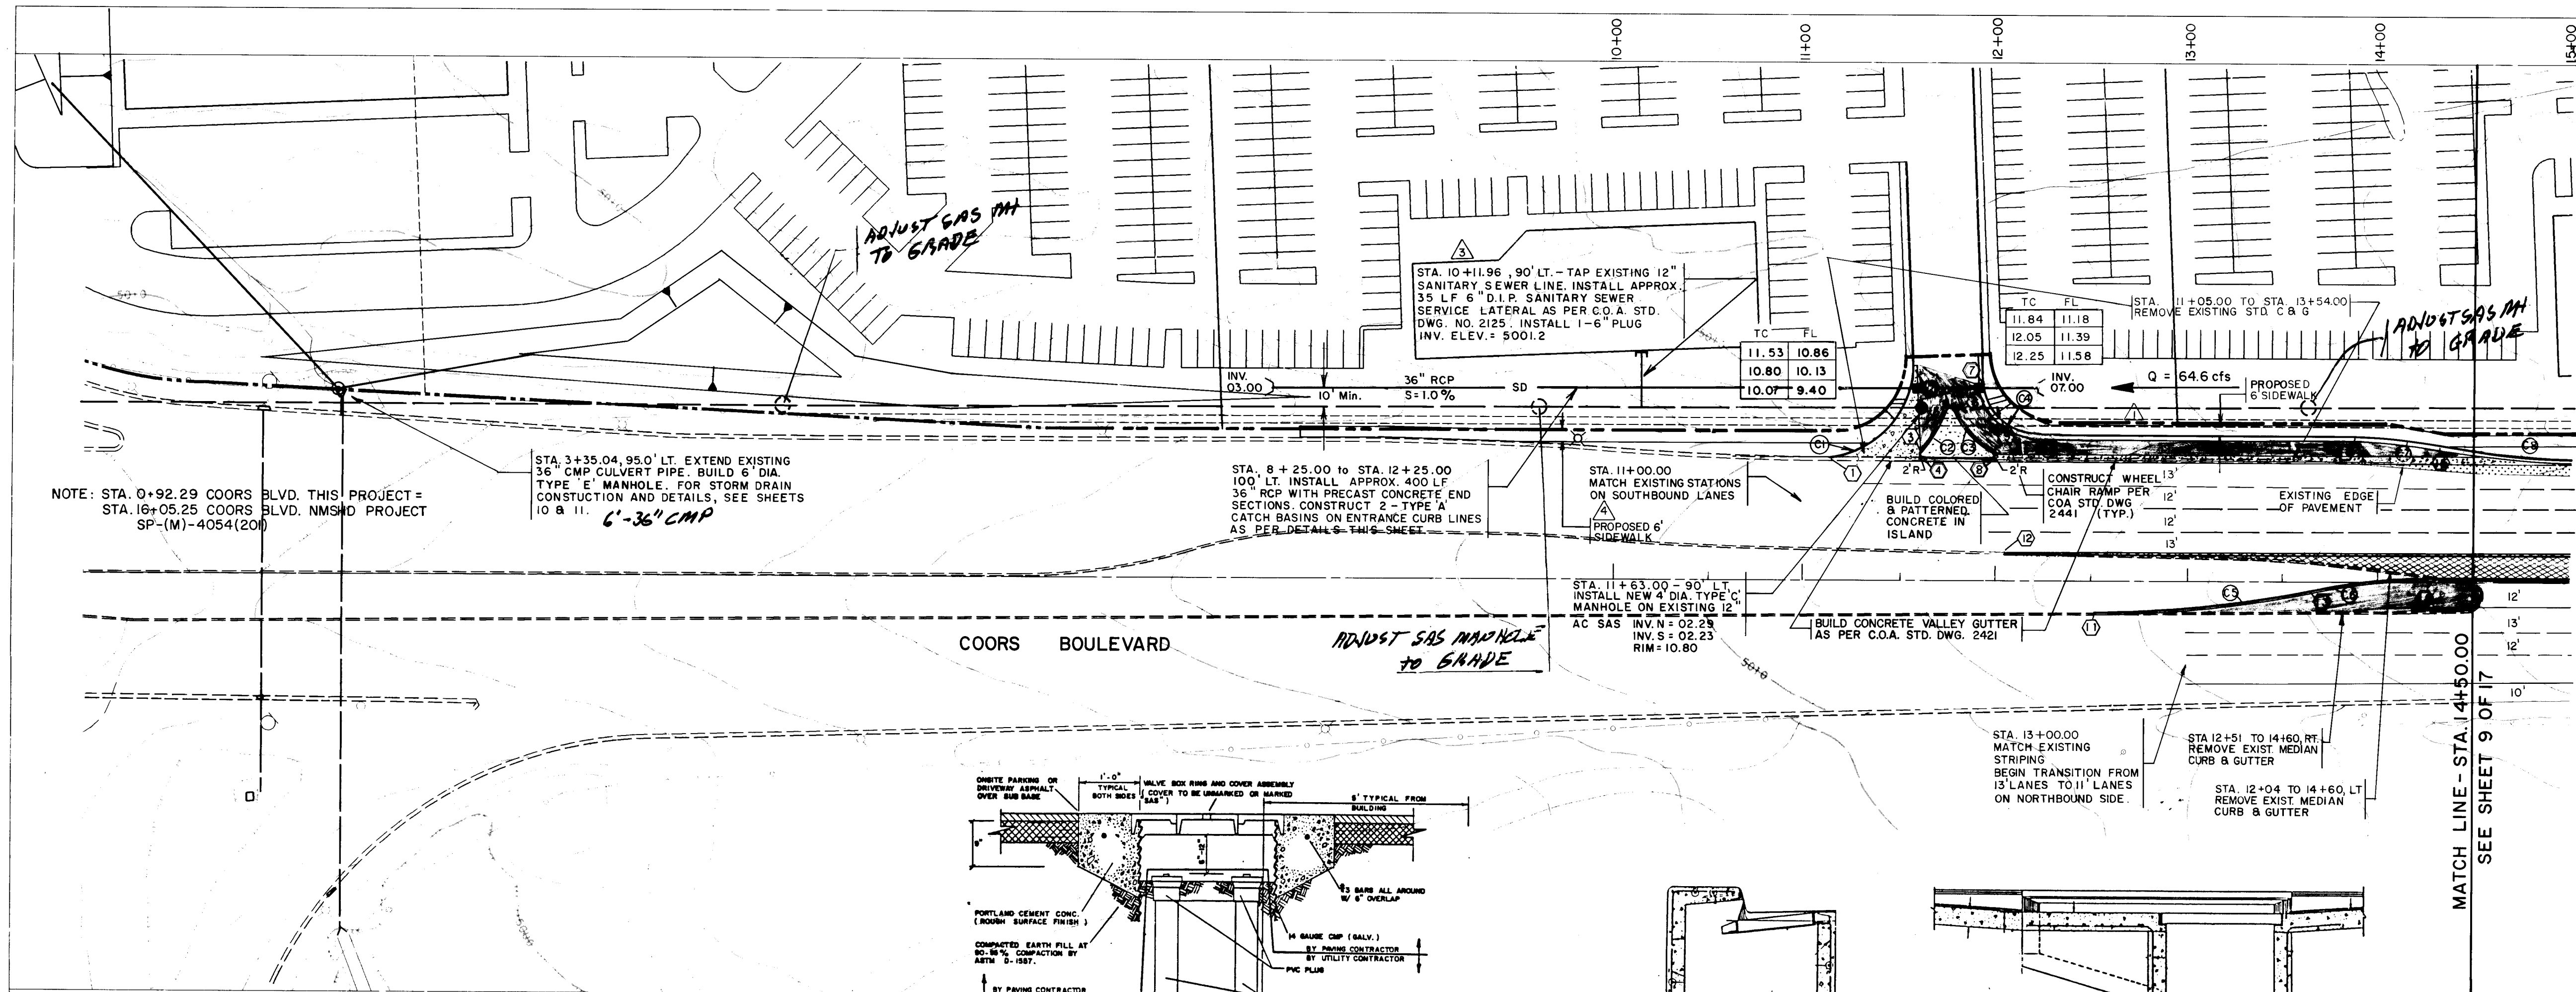


①	Delta 92° 30' 22"	③	Delta 33° 21' 11"	⑤	Delta 11° 13' 08"	⑦	Delta 9° 22' 12"
D	114° 35' 30"	D	119° 21' 59"	D	9° 32' 58"	D	19° 05' 55"
T	52.24'	T	14.38'	T	58.93'	T	24.58'
L	80.73'	L	27.94'	L	117.49'	L	49.06'
R	50.00'	R	48.00'	R	600.00'	R	300.00'

②	Delta 22° 48' 52"	④	Delta 87° 35' 13"	⑥	Delta 11° 39' 11"	⑧	Delta 9° 22' 05"
D	79° 34' 39"	D	191° 59' 10"	D	19° 05' 55"	D	9° 32' 58"
T	14.52'	T	28.76'	T	30.61'	T	49.16'
L	28.66'	L	45.85'	L	61.02'	L	98.10'
R	72.00'	R	30.00'	R	300.00'	R	600.00'

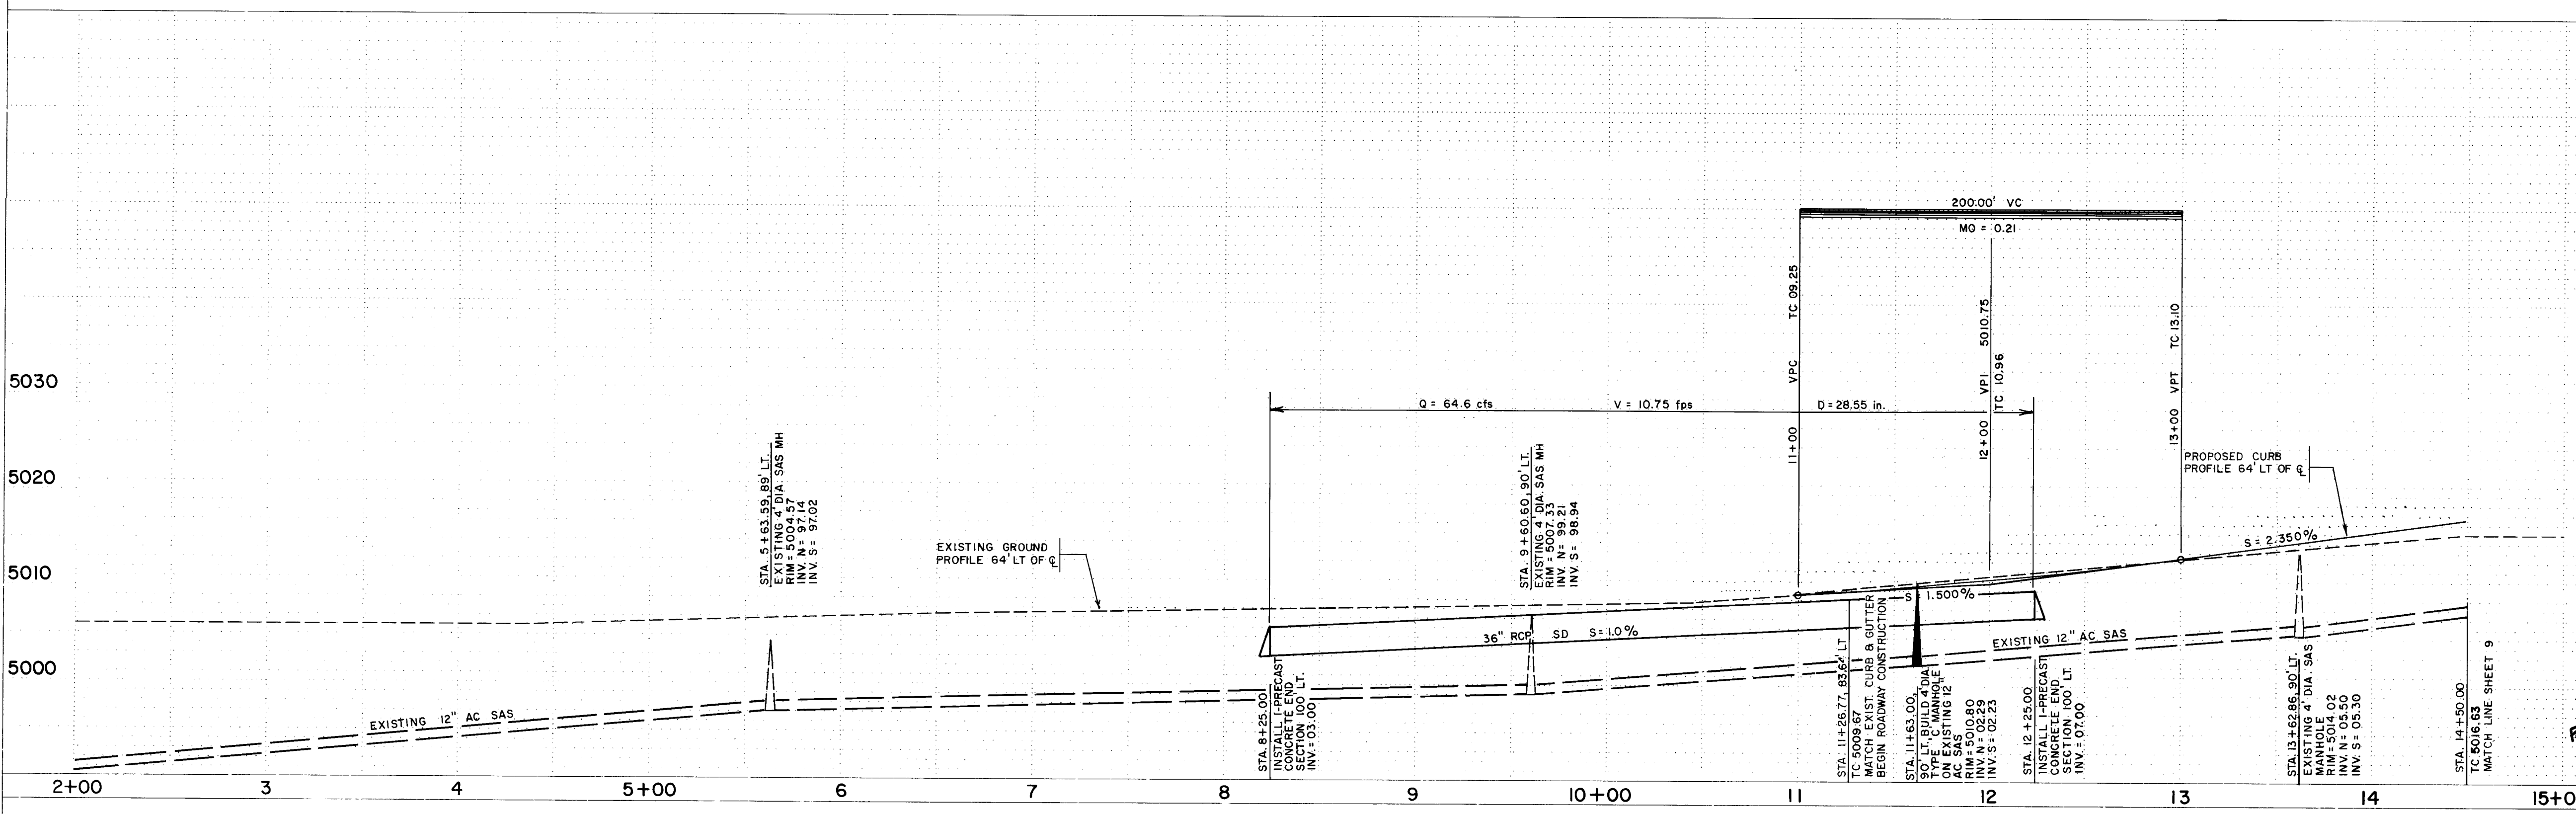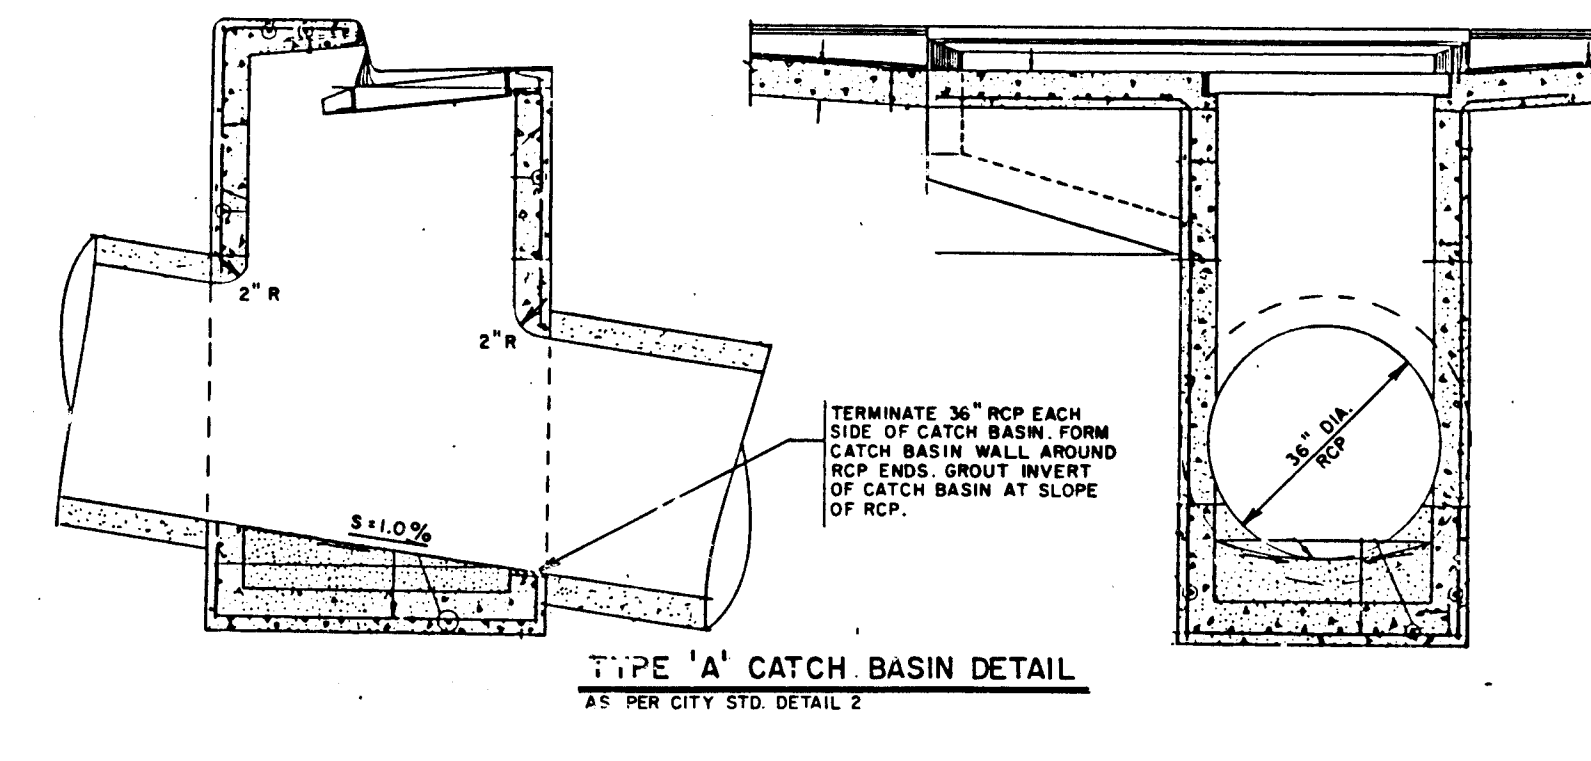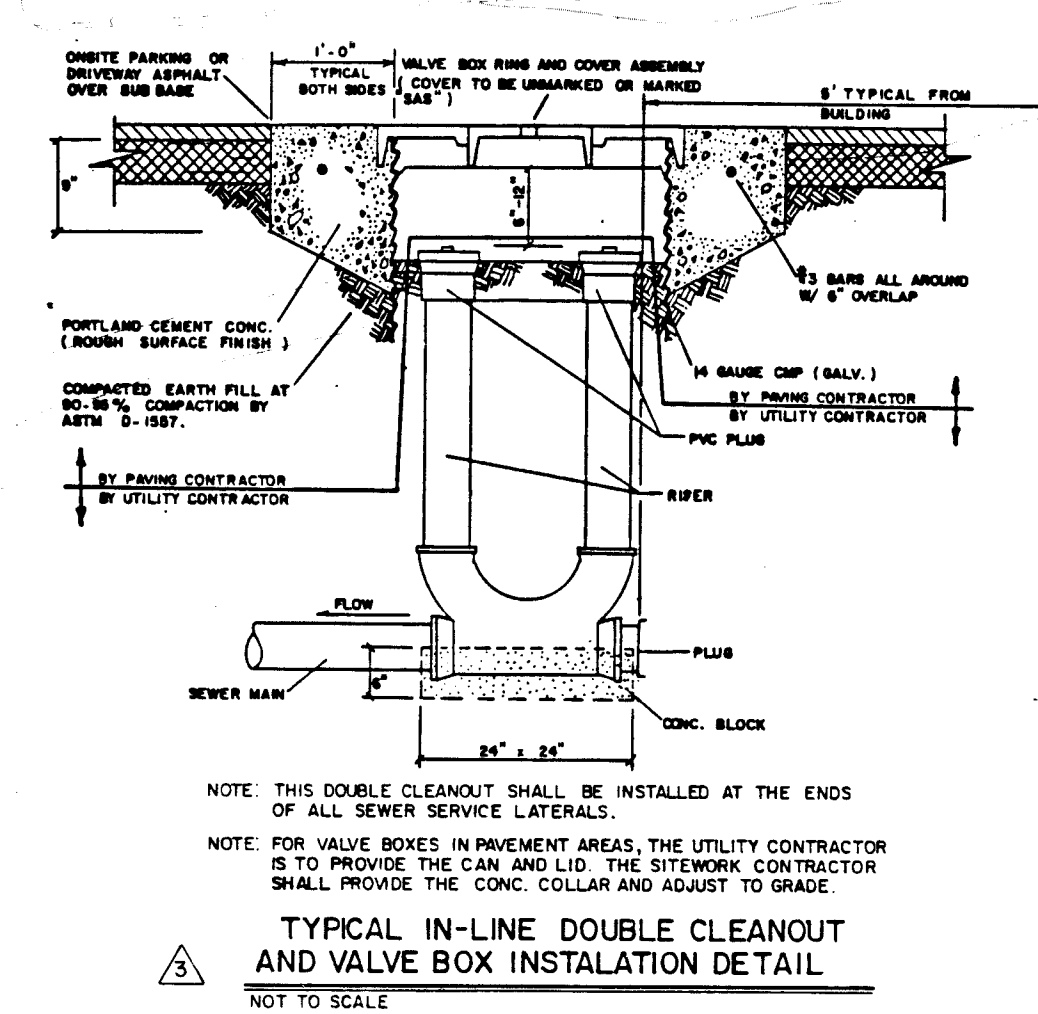


PT.	STATION	OFFSET	TC ELEV.
①	11+05.86	64.00' LT	09.34 *
②	11+55.90	116.79' LT	12.26
③	11+60.16	67.32' LT	10.36
④	11+61.67	64.00' LT	10.18
⑤	11+73.50	89.79' LT	11.50
⑥	11+77.25	89.77' LT	11.57
⑦	11+92.46	104.73' LT	12.45
⑧	11+92.41	64.00' LT	10.82
⑨	11+93.61	67.60' LT	10.98
⑩	12+22.43	76.00' LT	11.64
⑪	12+51.39	13.00' RT	13.26 *
⑫	12+03.93	14.00' LT	12.04 *
⑬	13+68.04	4.24' RT	15.89
⑭	13+77.38	76.00' LT	15.16
⑮	14+26.22	72.00' LT	16.23
⑯	14+28.64	2.00' LT	17.36
*	MATCH EXISTING C & G		

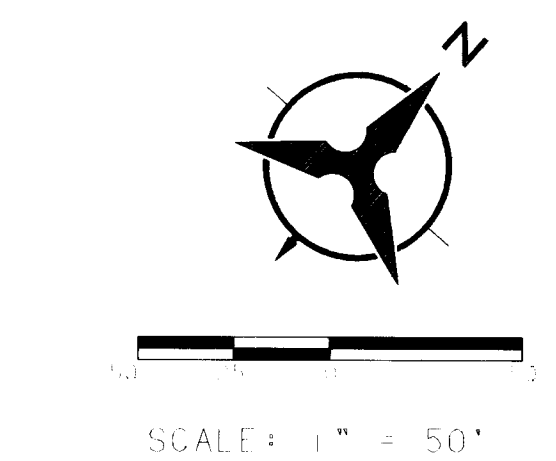


I, Carlos F. [Signature], hereby certify that the above information was prepared by me or under my supervision.

26	35	75	50	89	0
----	----	----	----	----	---



 
LEGEND	
	EXISTING CURB & GUTTER
	PROPOSED CURB & GUTTER
	NEW PAVEMENT - DEVELOPER
	REMOVE EXISTING PAVEMENT
	NEW PAVEMENT - NOT PART OF THIS CONTRACT TO BE DONE BY OTHER

CITY OF ALBUQUERQUE INFRASTRUCTURE IMPROVEMENTS MARKET CENTER WEST					
TITLE: COORS BOULEVARD STA. 2+00.00 - STA. 14+50.00					
APPROVALS	ENGINEER	DATE	APPROVALS	ENGINEER	DATE
City Engineer	[Signature]	4/1/89	Liquid Waste	N/A	
A.C.E. - Design	"	"	Traffic	[Signature]	4-11-89
A.C.E. - Hydrology	"	"	Water	N/A	
			N.M. Utilities	[Signature]	4-17-89
DRAWING NO.	3575	MAP NO.	C-13	SHEET	8 OF 17

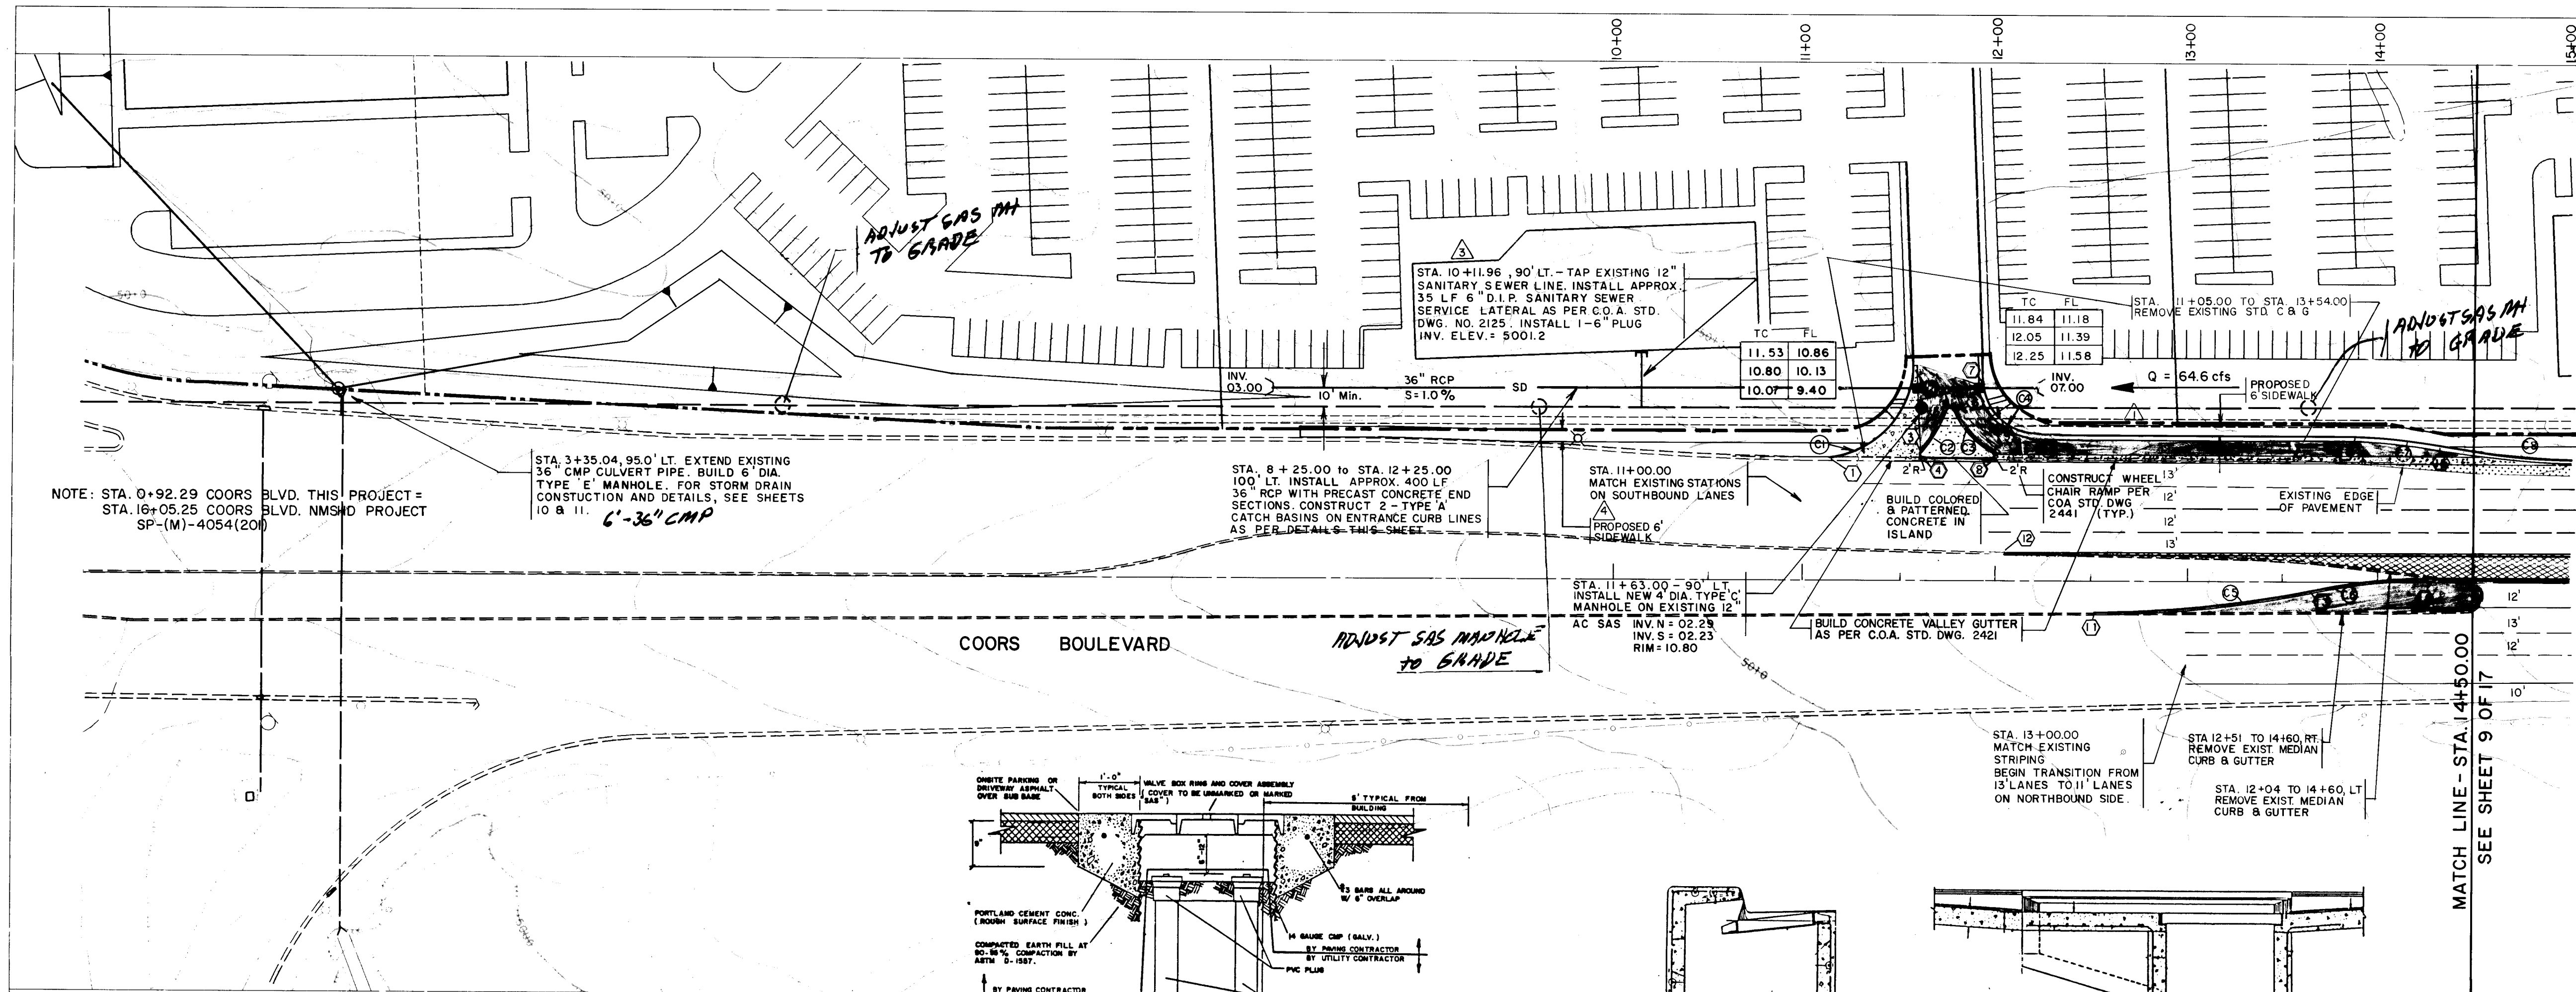


①	Delta 92° 30' 22"	③	Delta 33° 21' 11"	⑤	Delta 11° 13' 08"	⑦	Delta 9° 22' 12"
D	114° 35' 30"	D	119° 21' 59"	D	9° 32' 58"	D	19° 05' 55"
T	52.24'	T	14.38'	T	58.93'	T	24.58'
L	80.73'	L	27.94'	L	117.49'	L	49.06'
R	50.00'	R	48.00'	R	600.00'	R	300.00'

②	Delta 22° 48' 52"	④	Delta 87° 35' 13"	⑥	Delta 11° 39' 11"	⑧	Delta 9° 22' 05"
D	79° 34' 39"	D	191° 59' 10"	D	19° 05' 55"	D	9° 32' 58"
T	14.52'	T	28.76'	T	30.61'	T	49.16'
L	28.66'	L	45.85'	L	61.02'	L	98.10'
R	72.00'	R	30.00'	R	300.00'	R	600.00'

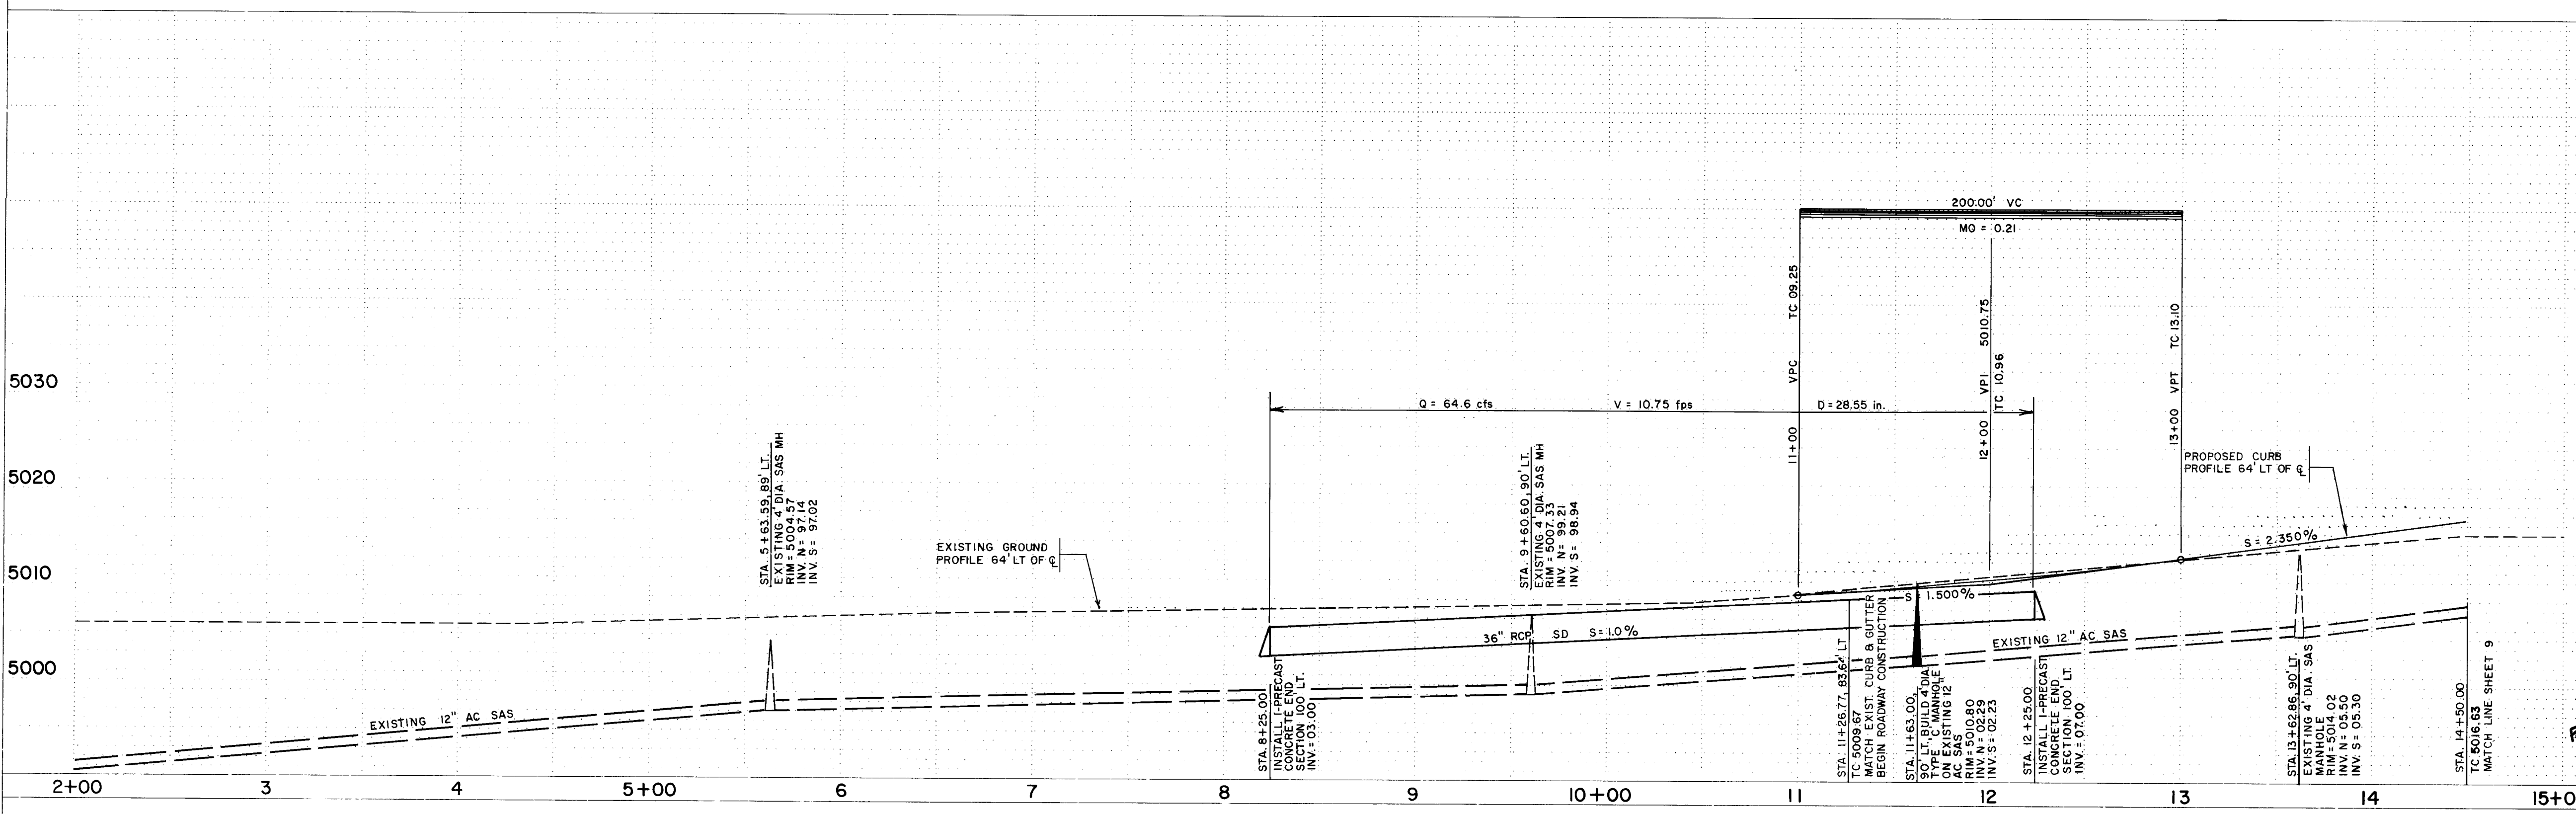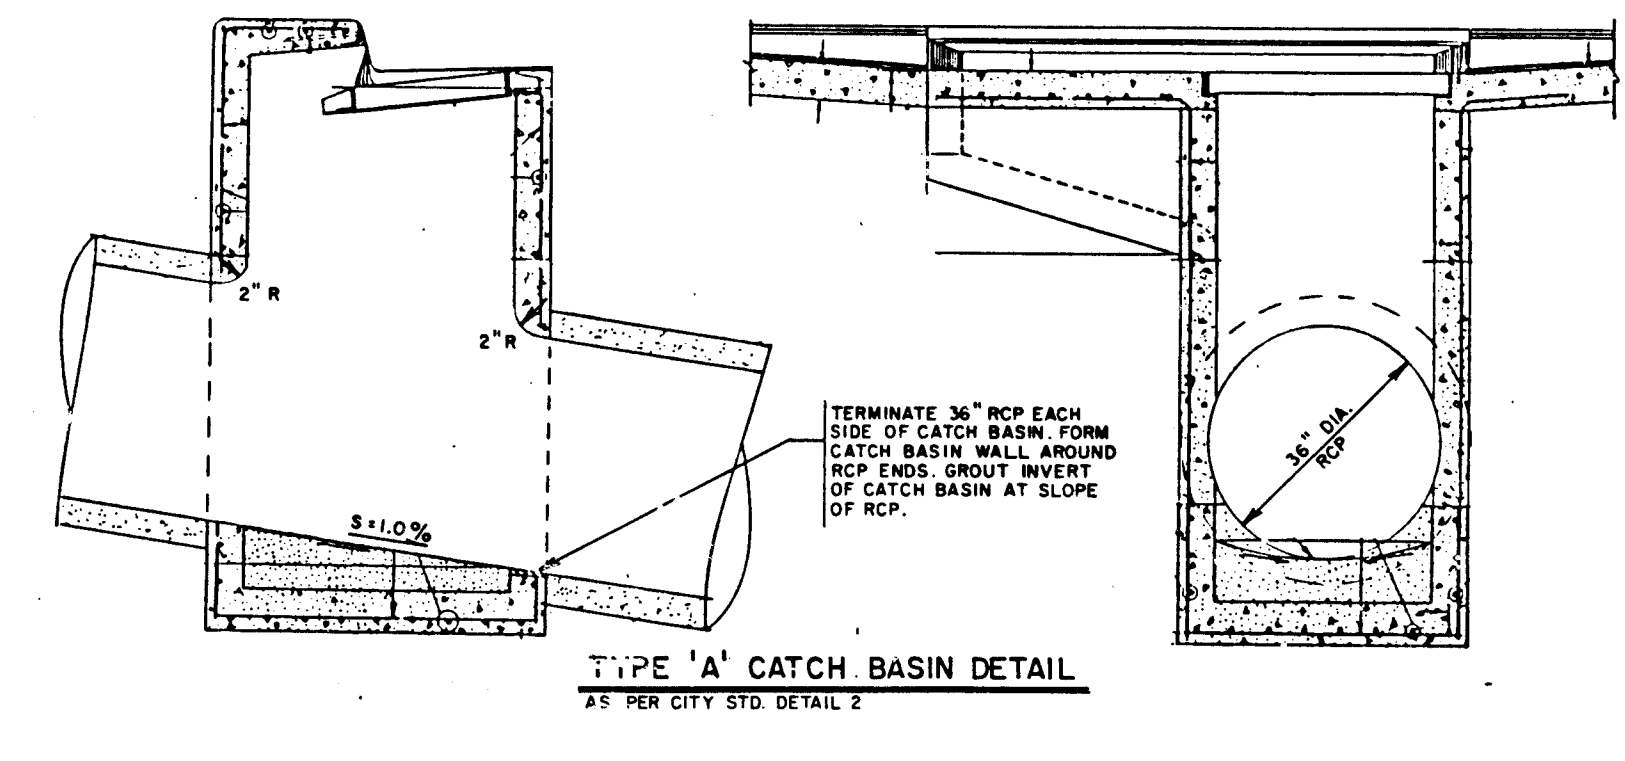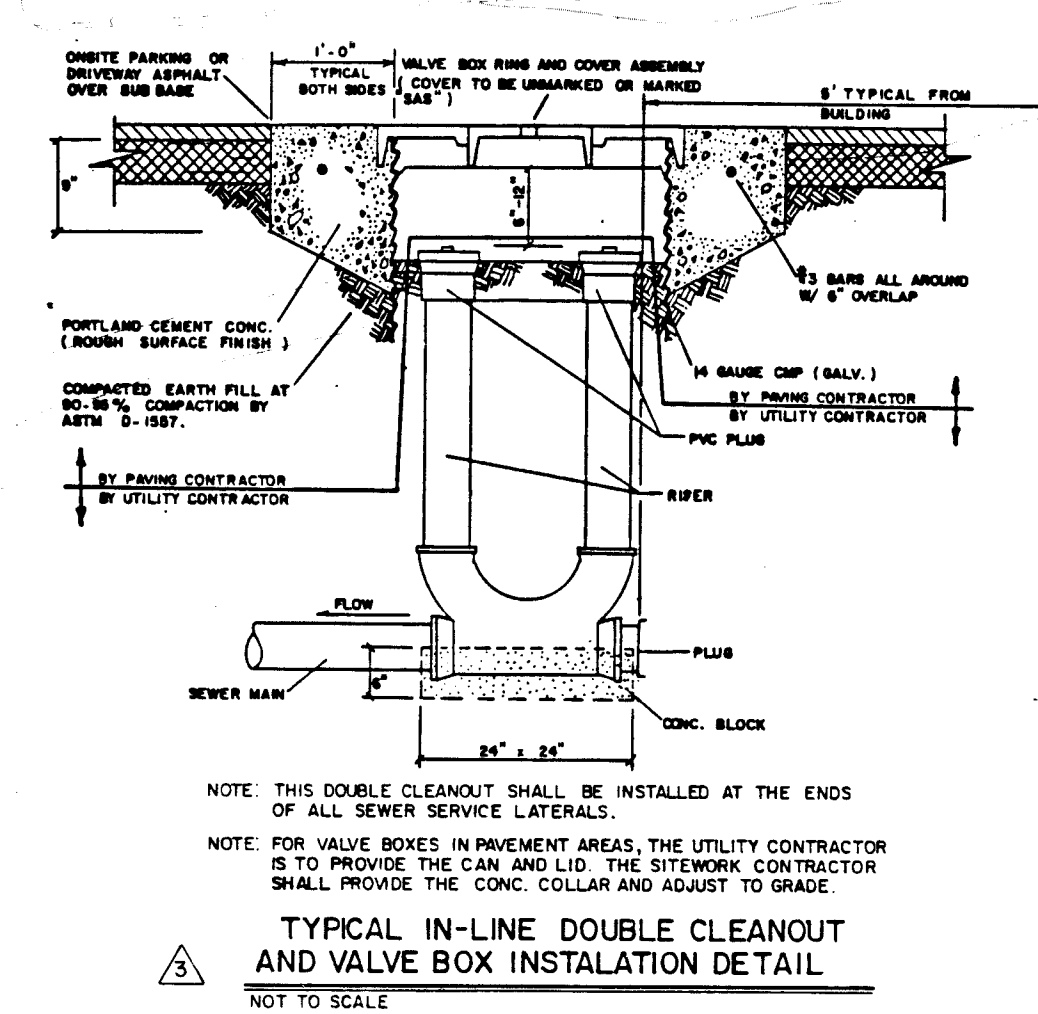


PT.	STATION	OFFSET	TC ELEV.
①	11+05.86	64.00' LT	09.34 *
②	11+55.90	116.79' LT	12.26
③	11+60.16	67.32' LT	10.36
④	11+61.67	64.00' LT	10.18
⑤	11+73.50	89.79' LT	11.50
⑥	11+77.25	89.77' LT	11.57
⑦	11+92.46	104.73' LT	12.45
⑧	11+92.41	64.00' LT	10.82
⑨	11+93.61	67.60' LT	10.98
⑩	12+22.43	76.00' LT	11.64
⑪	12+51.39	13.00' RT	13.26 *
⑫	12+03.93	14.00' LT	12.04 *
⑬	13+68.04	4.24' RT	15.89
⑭	13+77.38	76.00' LT	15.16
⑮	14+26.22	72.00' LT	16.23
⑯	14+28.64	2.00' LT	17.36
*	MATCH EXISTING C & G		

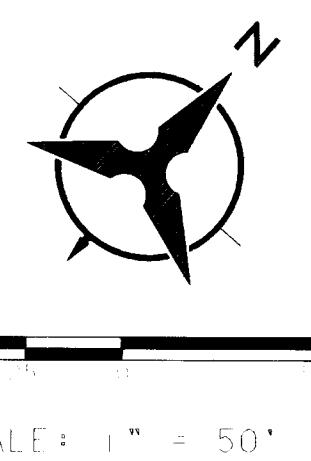


I, Carlos F. [Signature], hereby certify that the above information was prepared by me or under my supervision.

26	35	75	50	89	0
----	----	----	----	----	---

 
LEGEND	
	EXISTING CURB & GUTTER
	PROPOSED CURB & GUTTER
	NEW PAVEMENT - DEVELOPER
	REMOVE EXISTING PAVEMENT
	NEW PAVEMENT - NOT PART OF THIS CONTRACT TO BE DONE BY OTHER

CITY OF ALBUQUERQUE INFRASTRUCTURE IMPROVEMENTS MARKET CENTER WEST					
TITLE: COORS BOULEVARD STA. 2+00.00 - STA. 14+50.00					
APPROVALS	ENGINEER	DATE	APPROVALS	ENGINEER	DATE
City Engineer	Roger A. [Signature]	4/1/89	Liquid Waste	N/A	
A.C.E. - Design	"	"	Traffic	Roger A. [Signature]	4-11-89
A.C.E. - Hydrology	"	"	Water	N/A	
			N.M. Utilities	[Signature]	4-17-89
DRAWING NO.	3575	MAP NO.	C-13	SHEET	8 OF 17

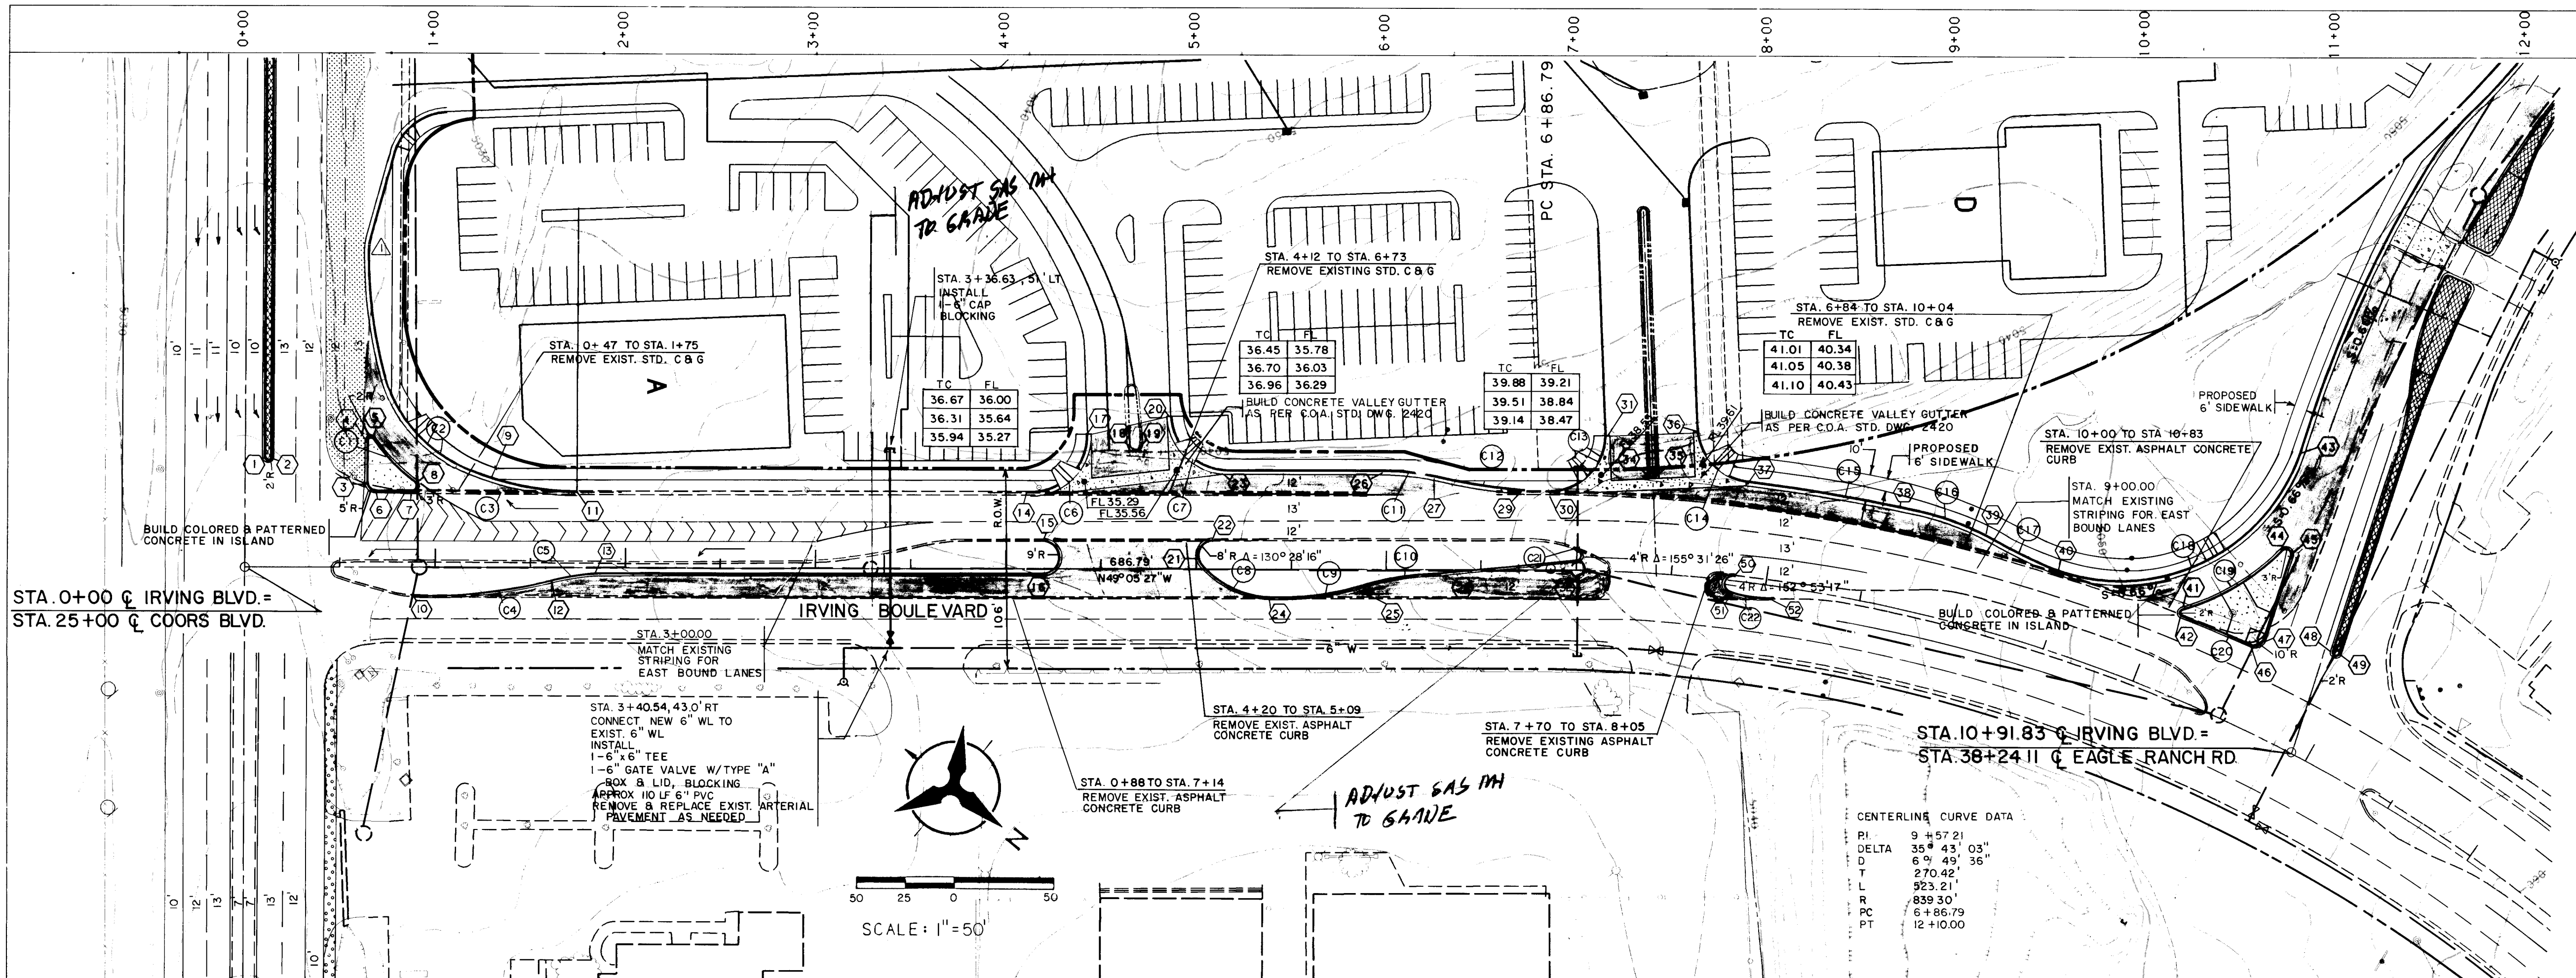

C1	Delta 18° 53' 13"	C3	Delta 23° 3' 29"	C5	Delta 13° 59' 02"	C7	Delta 87° 37' 19"	C9	Delta 16° 39' 54"	C11	Delta 12° 39' 43"	C13	Delta 92° 54' 54"	C15	Delta 5° 56' 42"	C17	Delta 5° 17' 31"	C19	Delta 28° 09' 22"	C21	Delta 38° 59' 10"
D	60° 57' 11"	D	39° 11' 50"	D	38° 11' 50"	D	191° 59' 10"	D	38° 11' 50"	D	38° 11' 50"	D	190° 59' 10"	D	6° 25' 42"	D	19° 05' 55"	D	48° 08' 52"	D	114° 59' 16"
L	15.63'	L	30.60'	L	12.88'	L	28.78'	L	21.97'	L	16.64'	L	46.28'	L	42.48'	L	58.48'	L	58.48'	L	17.70'
R	30.99'	R	60.37'	R	25.63'	R	45.87'	R	43.63'	R	33.15'	R	48.65'	R	89.30'	R	277.1'	R	119.00'	R	34.03'

C2	Delta 51° 52' 41"	C4	Delta 13° 58' 59"	C6	Delta 92° 21' 58"	C8	Delta 49° 18' 07"	C10	Delta 12° 08' 06"	C12	Delta 8° 26' 53"	C14	Delta 80° 59' 28"	C16	Delta 16° 25' 48"	C18	Delta 96° 3' 54"	C20	Delta 2° 05' 56"	C22	Delta 24° 21' 22"
D	76° 23' 40"	D	19° 5' 55"	D	31.26'	D	114° 35' 30"	D	38° 11' 50"	D	19° 05' 55"	D	190° 59' 10"	D	38° 11' 50"	D	57° 17' 45"	D	6° 30' 05"	D	114° 59' 16"
L	36.48'	L	36.79'	L	48.36'	L	22.95'	L	15.94'	L	22.16'	L	25.62'	L	21.65'	L	111.18'	L	16.15'	L	10.79'
R	67.90'	R	73.22'	R	48.36'	R	43.02'	R	31.77'	R	44.24'	R	42.40'	R	43.01'	R	167.66'	R	32.29'	R	21.25'

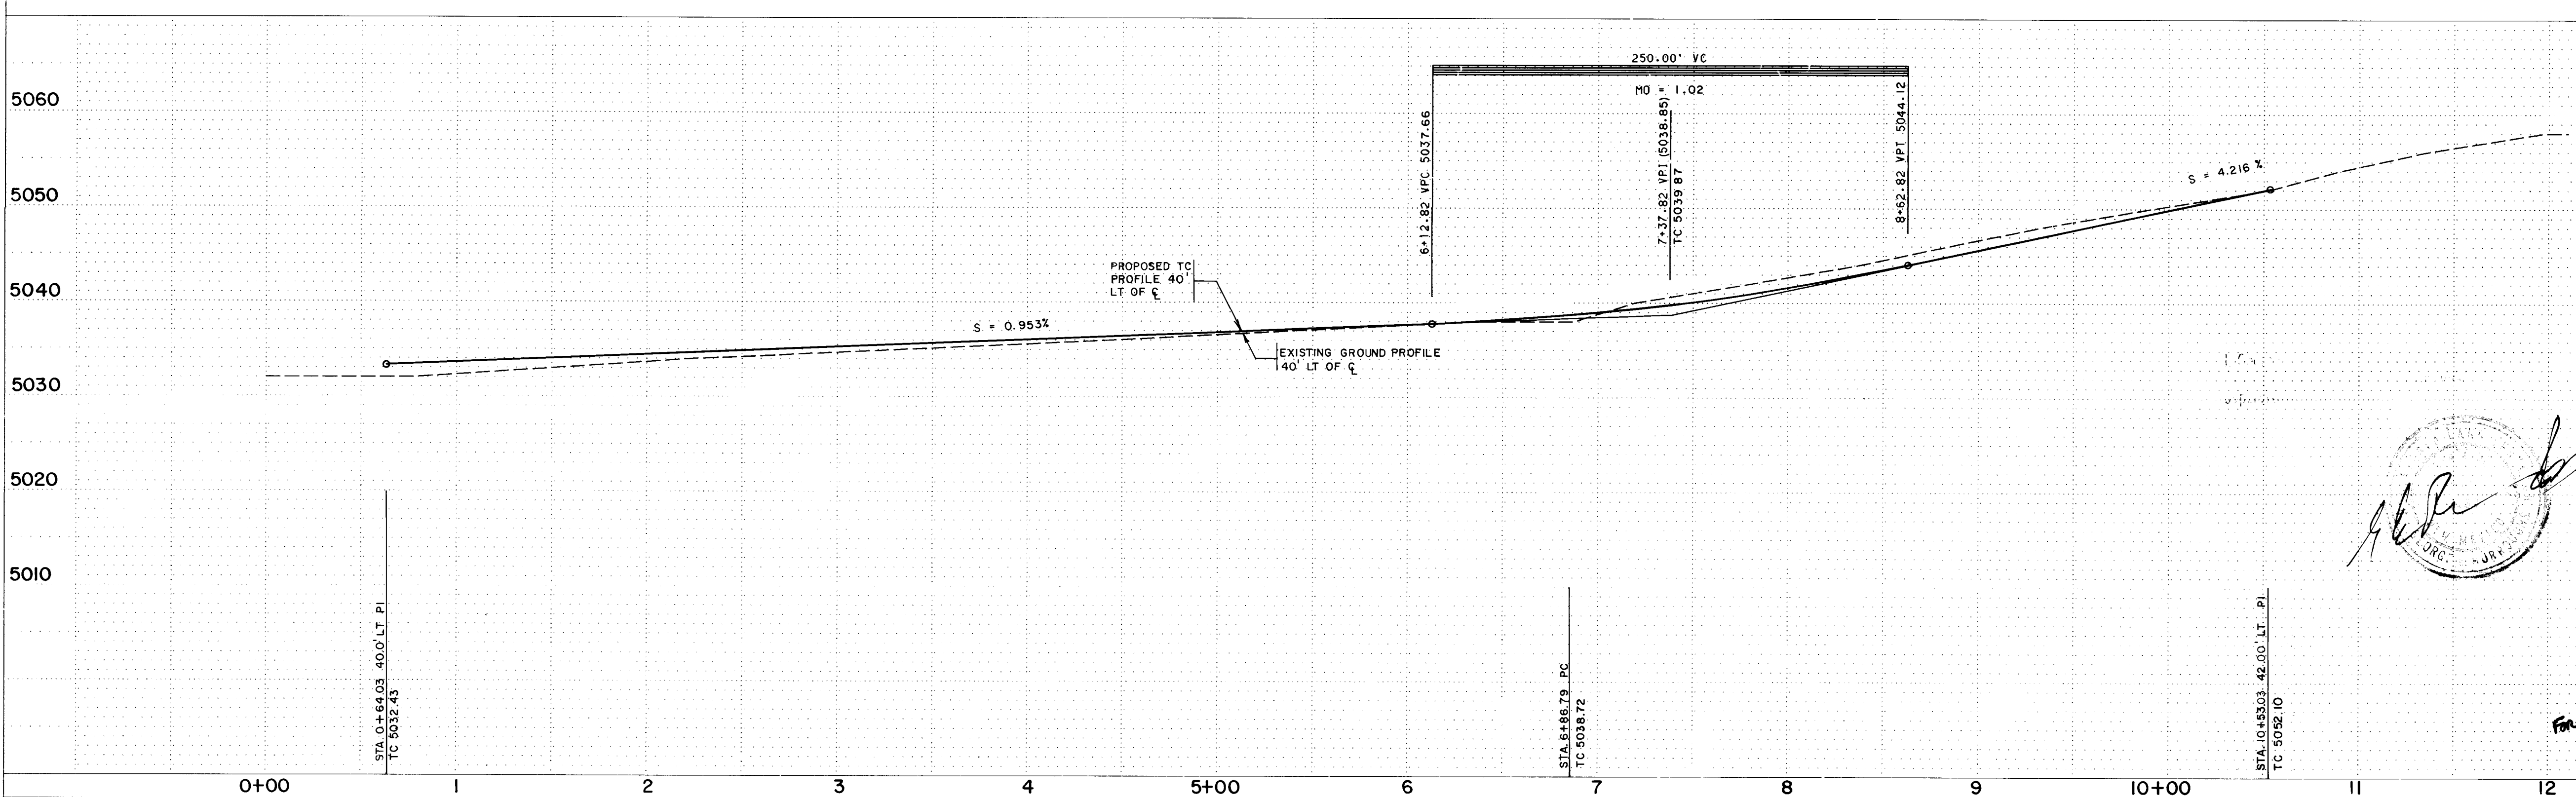

PT.	STATION	OFFSET	TC ELEV.
1	0+10.04	58.18' LT	32.20
2	0+14.04	58.18' LT	32.22
3	0+64.03	45.14' LT	32.34
4	0+64.05	66.58' LT	31.96
5	0+67.69	67.72' LT	31.87
6	0+69.02	40.00' LT	32.31
7	0+87.36	40.00' LT	32.83
8	0+89.13	45.53' LT	32.56
9	1+15.63	52.10' LT	32.68
10	0+88.73	15.00' RT	33.17 *
11	1+74.38	40.00' LT	33.59 *
12	1+61.22	6.11' RT	34.03
13	1+86.59	3.00' RT	34.33
14	4+12.70	40.00' LT	35.57 *
15	4+19.89	15.00' LT	36.01 *
16	4+20.34	3.00' RT	36.57
17	4+42.66	71.53' LT	37.04
18	4+64.91	65.98' LT	FUTURE
19	4+70.89	66.07' LT	FUTURE
20	4+86.32	80.75' LT	37.21
21	5+02.75	2.25' LT	36.95
22	5+08.75	15.00' LT	36.83 *
23	5+16.29	52.00' LT	36.19
24	5+40.70	15.00' RT	37.22
25	5+87.60	8.64' RT	37.66
26	5+96.29	52.00' LT	37.26
27	6+29.17	48.34' LT	37.67
28	6+18.75	2.72' LT	38.46
29	6+72.89	41.00' LT	38.47 *
30	6+84.83	41.00' LT	38.77 *
31	7+12.85	72.82' LT	40.25
32	6+99.51	4.00' RT	39.70
33	7+00.41	11.75' LT	39.56 *
34	7+35.06	51.77' LT	FUTURE
35	7+38.81	52.19' LT	FUTURE
36	7+56.66	77.79' LT	41.14
37	7+83.78	52.00' LT	40.96
38	8+70.87	52.00' LT	44.23
39	9+110.6	46.88' LT	46.02
40	9+36.96	42.00' LT	47.91
41	10+10.40	45.56' LT	50.23
42	10+11.58	42.00' LT	50.35
43	10+32.10	146.68' LT	49.02
44	10+42.05	92.25' LT	51.41
45	10+47.25	91.52' LT	51.54
46	10+42.32	42.00' LT	51.65
47	10+51.66	53.21' LT	51.90
48	10+86.09	57.84' LT	53.45
49	10+89.79	58.51' LT	53.65
50	7+84.14	3.00' LT	41.95 *
51	7+83.52	4.80' RT	41.89
52	8+04.68	6.70' RT	42.56 *

* MATCH EXISTING CURB & GUTTER											
1	2	3	4	5	6	7	8	9	10	11	12
26	35	7	5	0	7	9	0				


LEGEND	
---	EXISTING CURB & GUTTER
---	PROPOSED CURB & GUTTER
---	NEW PAVEMENT
---	REMOVE EXISTING PAVEMENT
---	NEW PAVEMENT **
---	TEMPORARY PAVEMENT **
** NOT PART OF THIS CONTRACT-TO BE DONE BY OTHERS.	

CITY OF ALBUQUERQUE
INFRASTRUCTURE IMPROVEMENTS
MARKET CENTER WEST

TITLE: IRVING BOULEVARD PLAN & PROFILE
STA. 0+00.00 - STA. 12+00.00


APPROVALS	ENGINEER	DATE	APPROVALS	ENGINEER	DATE
City Engineer	Ronald S. ...	4/1/89	Liquid Waste	N/A	
A.C.E.-Design	"	"	Traffic	Ronald S. ...	4/1/89
A.C.E.-Hydrology	"	"	Water	N/A	
			N.M. Utilities	"	4-7-89

DRAWING NO. 3575 MAP NO. C-13 SHEET 7 OF 17

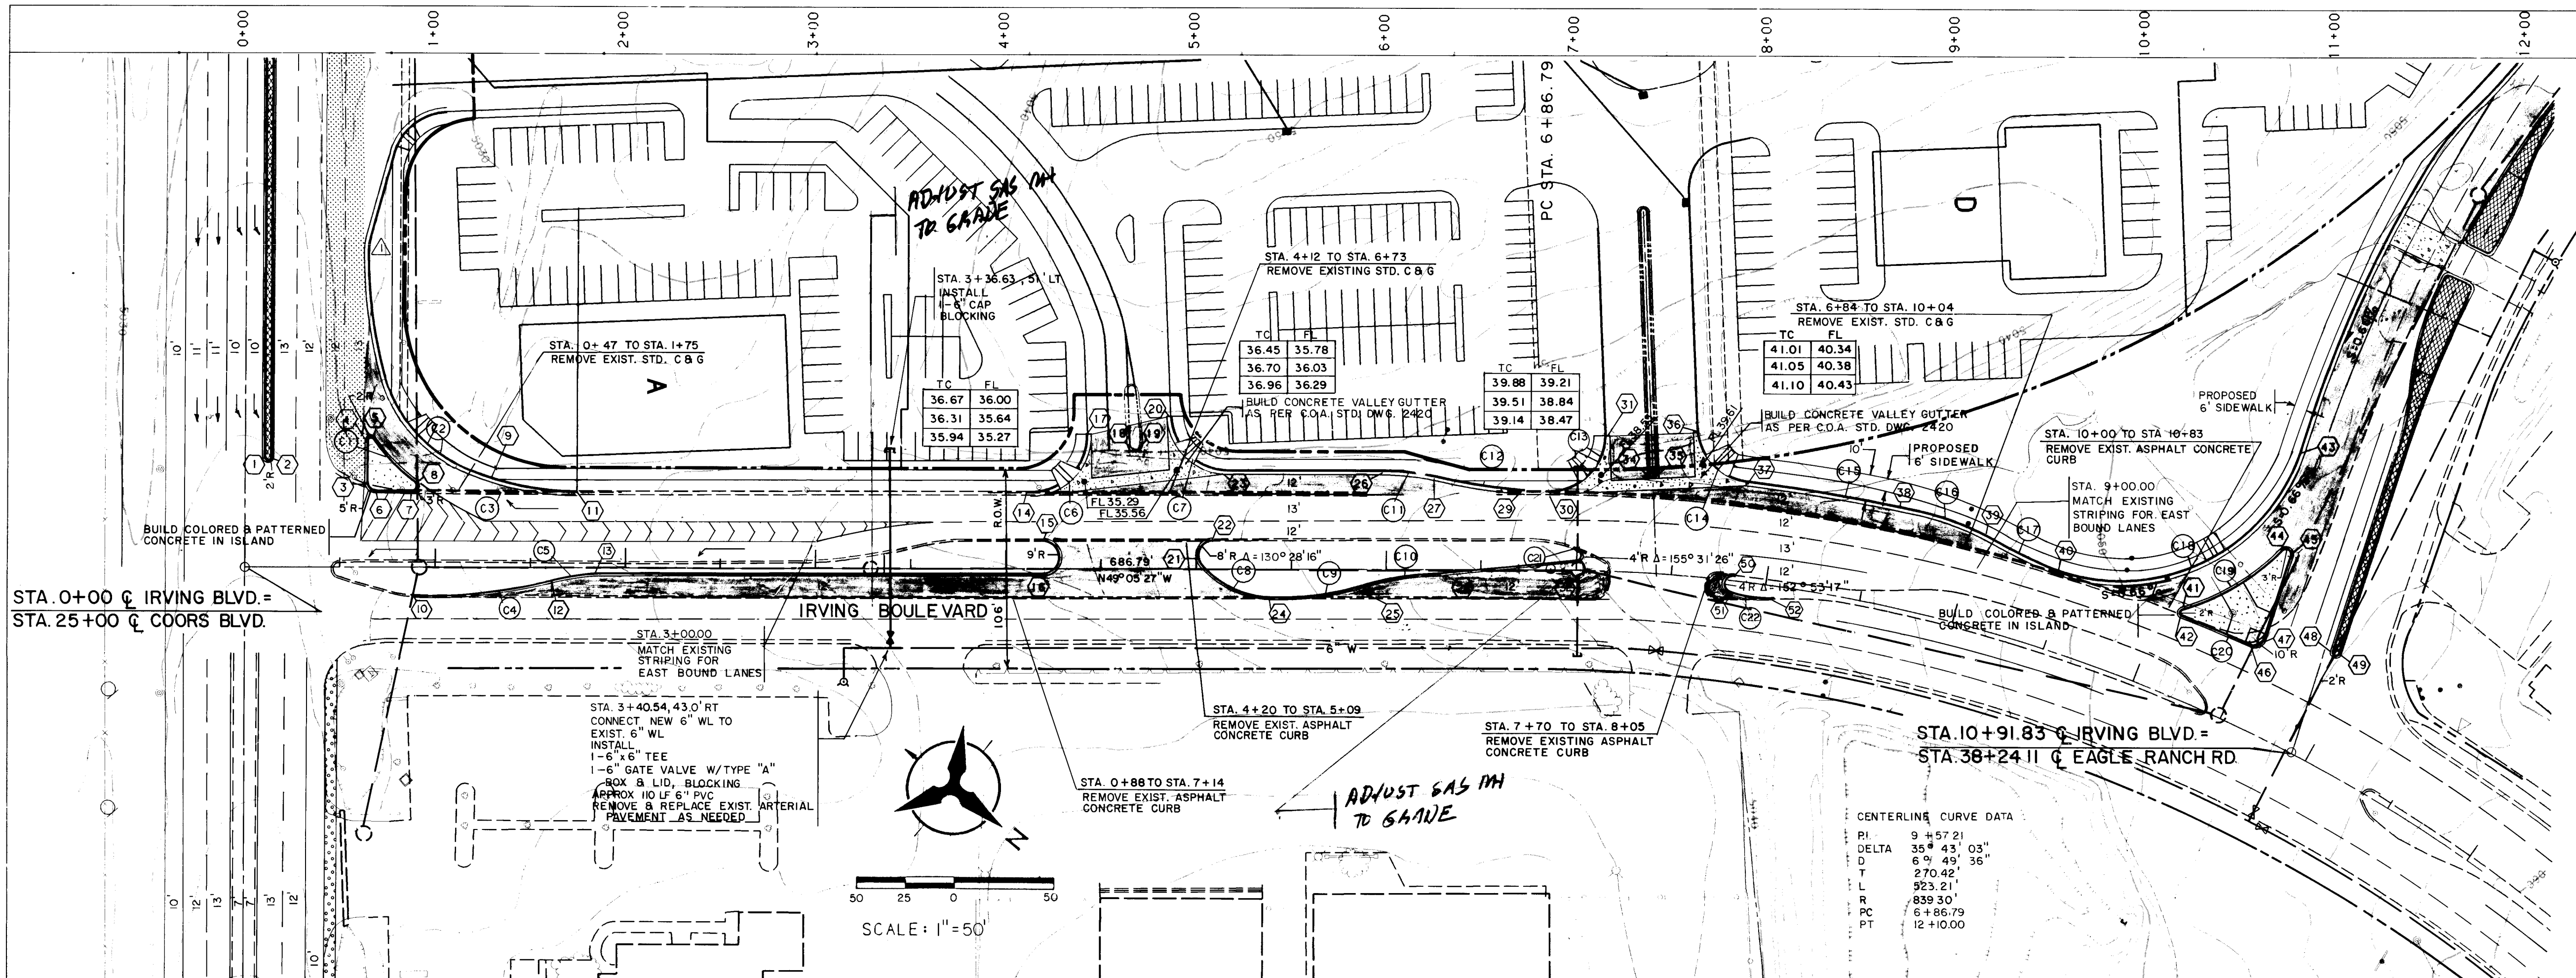

C1	Delta 18° 53' 13"	C3	Delta 23° 3' 29"	C5	Delta 13° 59' 02"	C7	Delta 87° 37' 19"	C9	Delta 16° 39' 54"	C11	Delta 12° 39' 43"	C13	Delta 92° 54' 54"	C15	Delta 5° 56' 42"	C17	Delta 5° 17' 31"	C19	Delta 28° 09' 22"	C21	Delta 38° 59' 10"
D	60° 57' 11"	D	39° 11' 50"	D	38° 11' 50"	D	191° 59' 10"	D	38° 11' 50"	D	38° 11' 50"	D	190° 59' 10"	D	6° 25' 42"	D	19° 05' 55"	D	48° 08' 52"	D	114° 59' 16"
L	15.63'	L	30.60'	L	12.88'	L	28.78'	L	21.97'	L	16.64'	L	46.28'	L	42.48'	L	58.48'	L	58.48'	L	17.70'
R	30.99'	R	60.37'	R	25.63'	R	45.87'	R	43.63'	R	33.15'	R	48.65'	R	89.130'	R	277.1'	R	119.00'	R	34.03'

C2	Delta 51° 52' 41"	C4	Delta 13° 58' 59"	C6	Delta 92° 21' 58"	C8	Delta 49° 18' 07"	C10	Delta 12° 08' 06"	C12	Delta 8° 26' 53"	C14	Delta 80° 59' 28"	C16	Delta 16° 25' 48"	C18	Delta 96° 3' 54"	C20	Delta 2° 05' 56"	C22	Delta 24° 21' 22"
D	76° 23' 40"	D	19° 5' 55"	D	31.26'	D	114° 35' 30"	D	38° 11' 50"	D	19° 05' 55"	D	190° 59' 10"	D	38° 11' 50"	D	57° 17' 45"	D	6° 30' 05"	D	114° 59' 16"
L	36.48'	L	36.79'	L	48.36'	L	22.95'	L	15.94'	L	22.16'	L	25.62'	L	21.65'	L	111.18'	L	16.15'	L	10.79'
R	67.90'	R	73.22'	R	48.36'	R	43.02'	R	31.77'	R	44.24'	R	42.40'	R	43.01'	R	167.66'	R	32.29'	R	21.25'

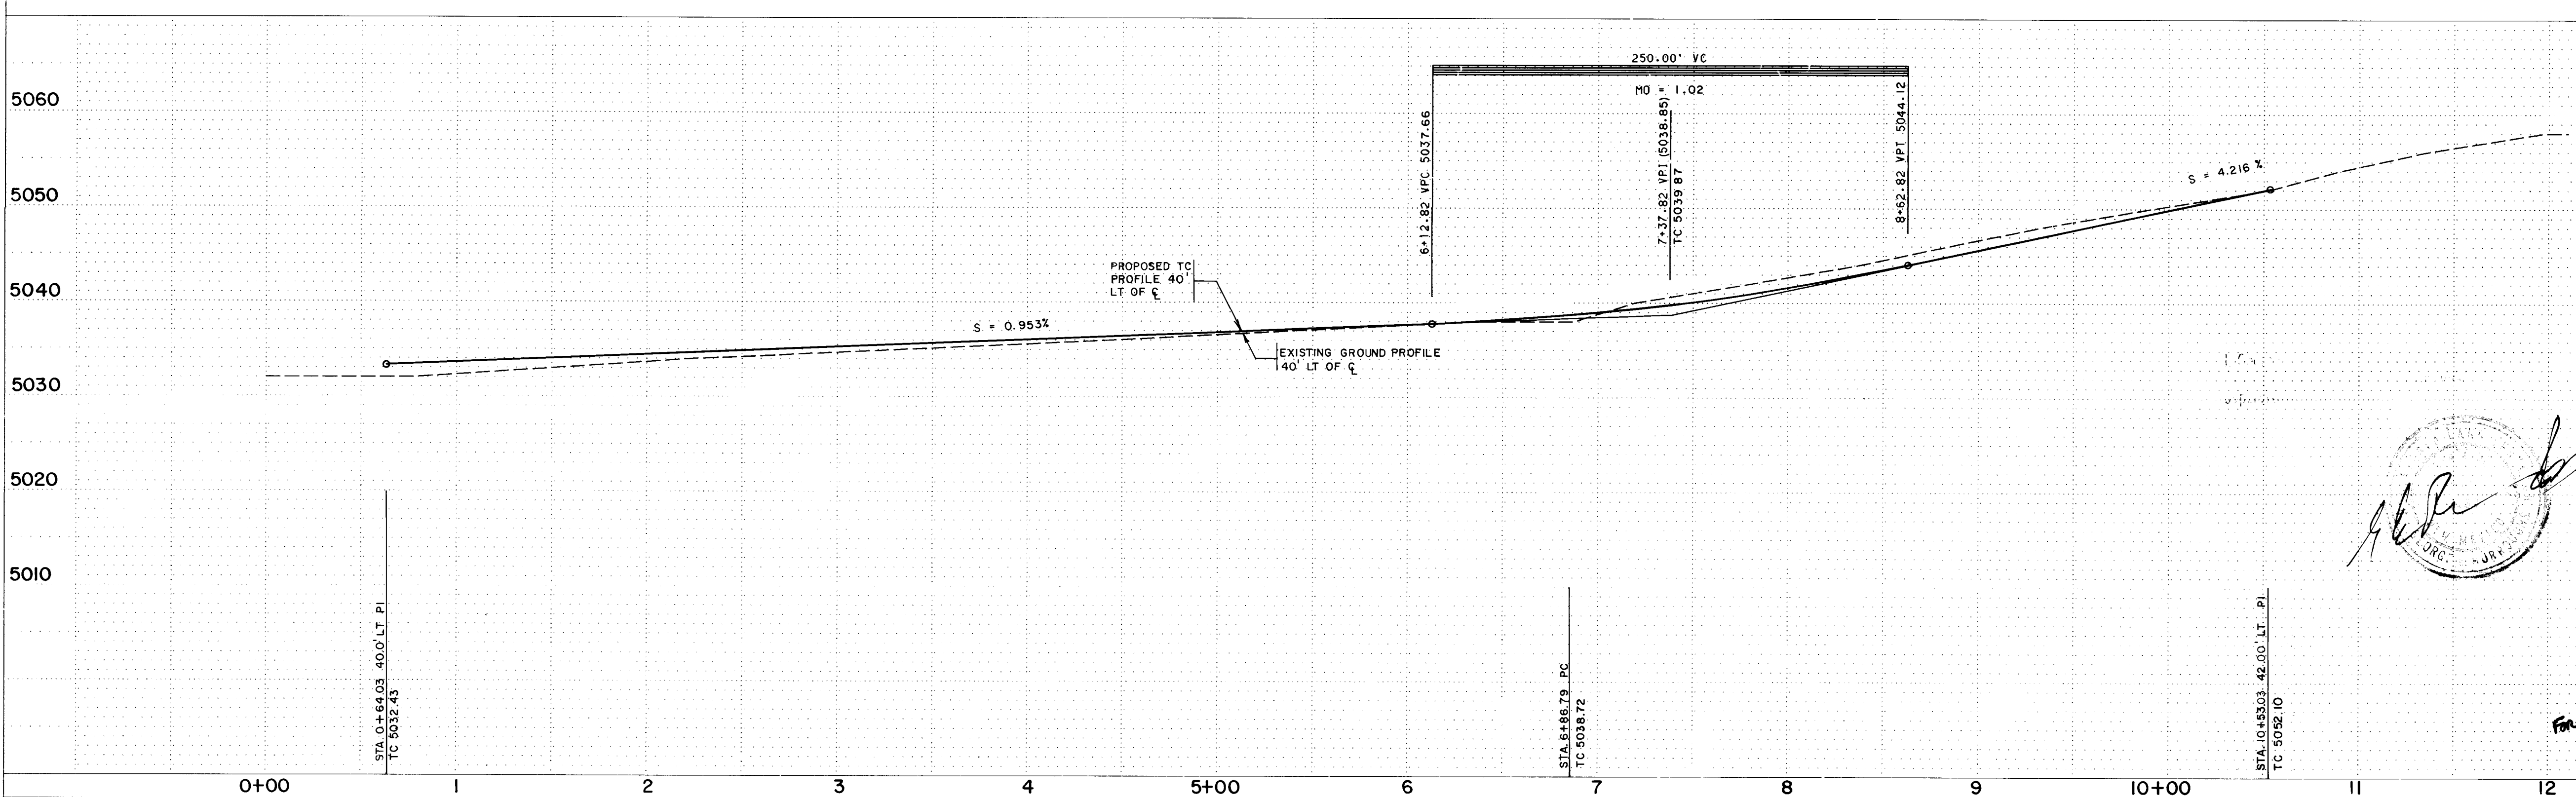

PT.	STATION	OFFSET	TC ELEV.
1	0+10.04	58.18' LT	32.20
2	0+14.04	58.18' LT	32.22
3	0+64.03	45.14' LT	32.34
4	0+64.05	66.58' LT	31.96
5	0+67.69	67.72' LT	31.87
6	0+69.02	40.00' LT	32.31
7	0+87.36	40.00' LT	32.83
8	0+89.13	45.53' LT	32.56
9	1+15.63	52.10' LT	32.68
10	0+88.73	15.00' RT	33.17 *
11	1+74.38	40.00' LT	33.59 *
12	1+61.22	6.11' RT	34.03
13	1+86.59	3.00' RT	34.33
14	4+12.70	40.00' LT	35.57 *
15	4+19.89	15.00' LT	36.01 *
16	4+20.34	3.00' RT	36.57
17	4+42.66	71.53' LT	37.04
18	4+64.91	65.98' LT	FUTURE
19	4+70.89	66.07' LT	FUTURE
20	4+86.32	80.75' LT	37.21
21	5+02.75	2.25' LT	36.95
22	5+08.75	15.00' LT	36.83 *
23	5+16.29	52.00' LT	36.19
24	5+40.70	15.00' RT	37.22
25	5+87.60	8.64' RT	37.66
26	5+96.29	52.00' LT	37.26
27	6+29.17	48.34' LT	37.67
28	6+18.75	2.72' LT	38.46
29	6+72.89	41.00' LT	38.47 *
30	6+84.83	41.00' LT	38.77 *
31	7+12.85	72.82' LT	40.25
32	6+99.51	4.00' RT	39.70
33	7+00.41	11.75' LT	39.56 *
34	7+35.06	51.77' LT	FUTURE
35	7+38.81	52.19' LT	FUTURE
36	7+56.66	77.79' LT	41.14
37	7+83.78	52.00' LT	40.96
38	8+70.87	52.00' LT	44.23
39	9+110.6	46.88' LT	46.02
40	9+36.96	42.00' LT	47.91
41	10+10.40	45.56' LT	50.23
42	10+11.58	42.00' LT	50.35
43	10+32.10	146.68' LT	49.02
44	10+42.05	92.25' LT	51.41
45	10+47.25	91.52' LT	51.54
46	10+42.32	42.00' LT	51.65
47	10+51.66	53.21' LT	51.90
48	10+86.09	57.84' LT	53.45
49	10+89.79	58.51' LT	53.65
50	7+84.14	3.00' LT	41.95 *
51	7+83.52	4.80' RT	41.89
52	8+04.68	6.70' RT	42.56 *

* MATCH EXISTING CURB & GUTTER											
1	2	3	4	5	6	7	8	9	10	11	12
26	35	7	5	0	7	9	0				


LEGEND	
	EXISTING CURB & GUTTER
	PROPOSED CURB & GUTTER
	NEW PAVEMENT
	REMOVE EXISTING PAVEMENT
	NEW PAVEMENT **
	TEMPORARY PAVEMENT **
** NOT PART OF THIS CONTRACT - TO BE DONE BY OTHERS.	

CITY OF ALBUQUERQUE
INFRASTRUCTURE IMPROVEMENTS
MARKET CENTER WEST


TITLE: IRVING BOULEVARD PLAN & PROFILE
STA. 0+00.00 - STA. 12+00.00

APPROVALS	ENGINEER	DATE	APPROVALS	ENGINEER	DATE
City Engineer	Reginald S. Serna	4/1/89	Liquid Waste	N/A	
A.C.E. - Design	"	"	Traffic	Reginald S. Serna	4/1/89
A.C.E. - Hydrology	"	"	Water	N/A	
			N.M. Utilities	Reginald S. Serna	4/1/89

DRAWING NO. 3575 MAP NO. C-13 SHEET 7 OF 17

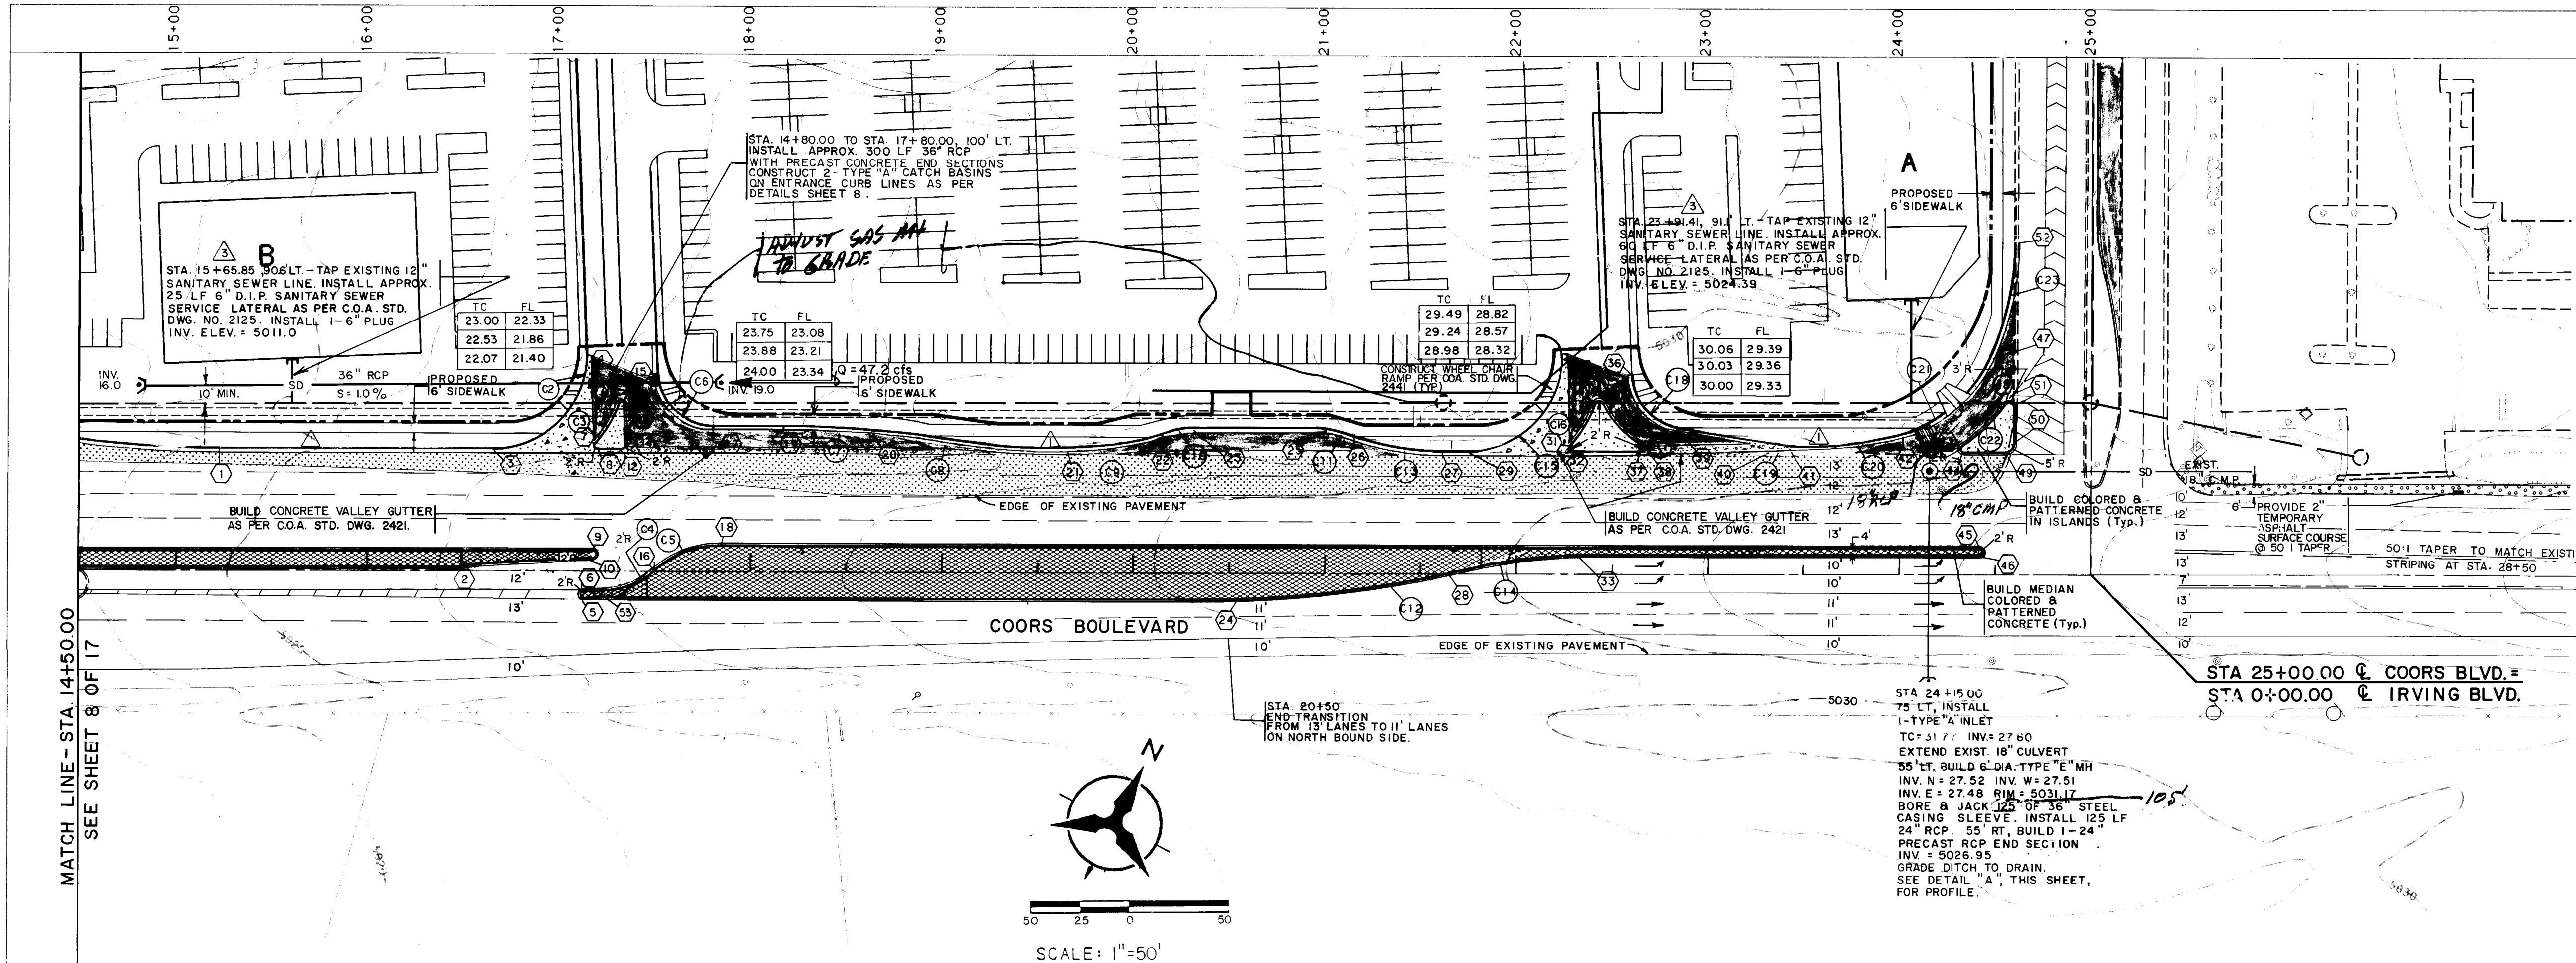

C2 Delta 92° 25' 01" D 114° 35' 30" T 52.15' L 80.65' R 50.00'	C4 Delta 42° 24' 18" D 114° 35' 30" T 19.39' L 37.00' R 50.00'	C6 Delta 87° 34' 48" D 190° 59' 10" T 28.76' L 45.86' R 30.00'	C8 Delta 8° 33' 07" D 9° 32' 57" T 44.86' L 69.55' R 60.00'	C10 Delta 18° 12' 11" D 114° 35' 30" T 8.01' L 15.89' R 50.00'	C12 Delta 13° 15' 36" D 9° 32' 57" T 69.74' L 138.86' R 300.00'	C14 Delta 13° 15' 22" D 19° 05' 55" T 34.86' L 17.99' R 300.00'	C16 Delta 14° 19' 12" D 79° 34' 29" T 9.04' L 17.99' R 72.00'	C18 Delta 78° 30' 47" D 190° 59' 10" T 24.51' L 41.10' R 30.00'	C20 Delta 10° 48' 32" D 22° 55' 06" T 23.65' L 47.16' R 250.00'	C22 Delta 18° 53' 13" D 60° 57' 11" T 15.63' L 30.99' R 94.00'
C3 Delta 15° 56' 35" D 79° 34' 39" T 10.08' L 20.03' R 72.00'	C5 Delta 40° 32' 13" D 114° 35' 30" T 18.46' L 35.38' R 50.00'	C7 Delta 8° 33' 50" D 19° 05' 55" T 22.46' L 44.84' R 300.00'	C9 Delta 18° 11' 31" D 38° 11' 50" T 24.02' L 47.63' R 150.00'	C11 Delta 19° 55' 34" D 114° 35' 30" T 8.78' L 17.39' R 50.00'	C13 Delta 19° 56' 17" D 38° 11' 50" T 26.36' L 52.20' R 150.00'	C15 Delta 89° 58' 59" D 114° 35' 30" T 9.55' L 18.93' R 50.00'	C17 Delta 22° 35' 56" D 119° 21' 55" T 9.55' L 18.93' R 48.00'	C19 Delta 8° 51' 18" D 190° 59' 10" T 2.32' L 4.64' R 30.00'	C21 Delta 56° 19' 12" D 76° 23' 40" T 40.15' L 73.72' R 75.00'	C23 Delta 23° 03' 29" D 38° 11' 50" T 30.60' L 60.37' R 150.00'

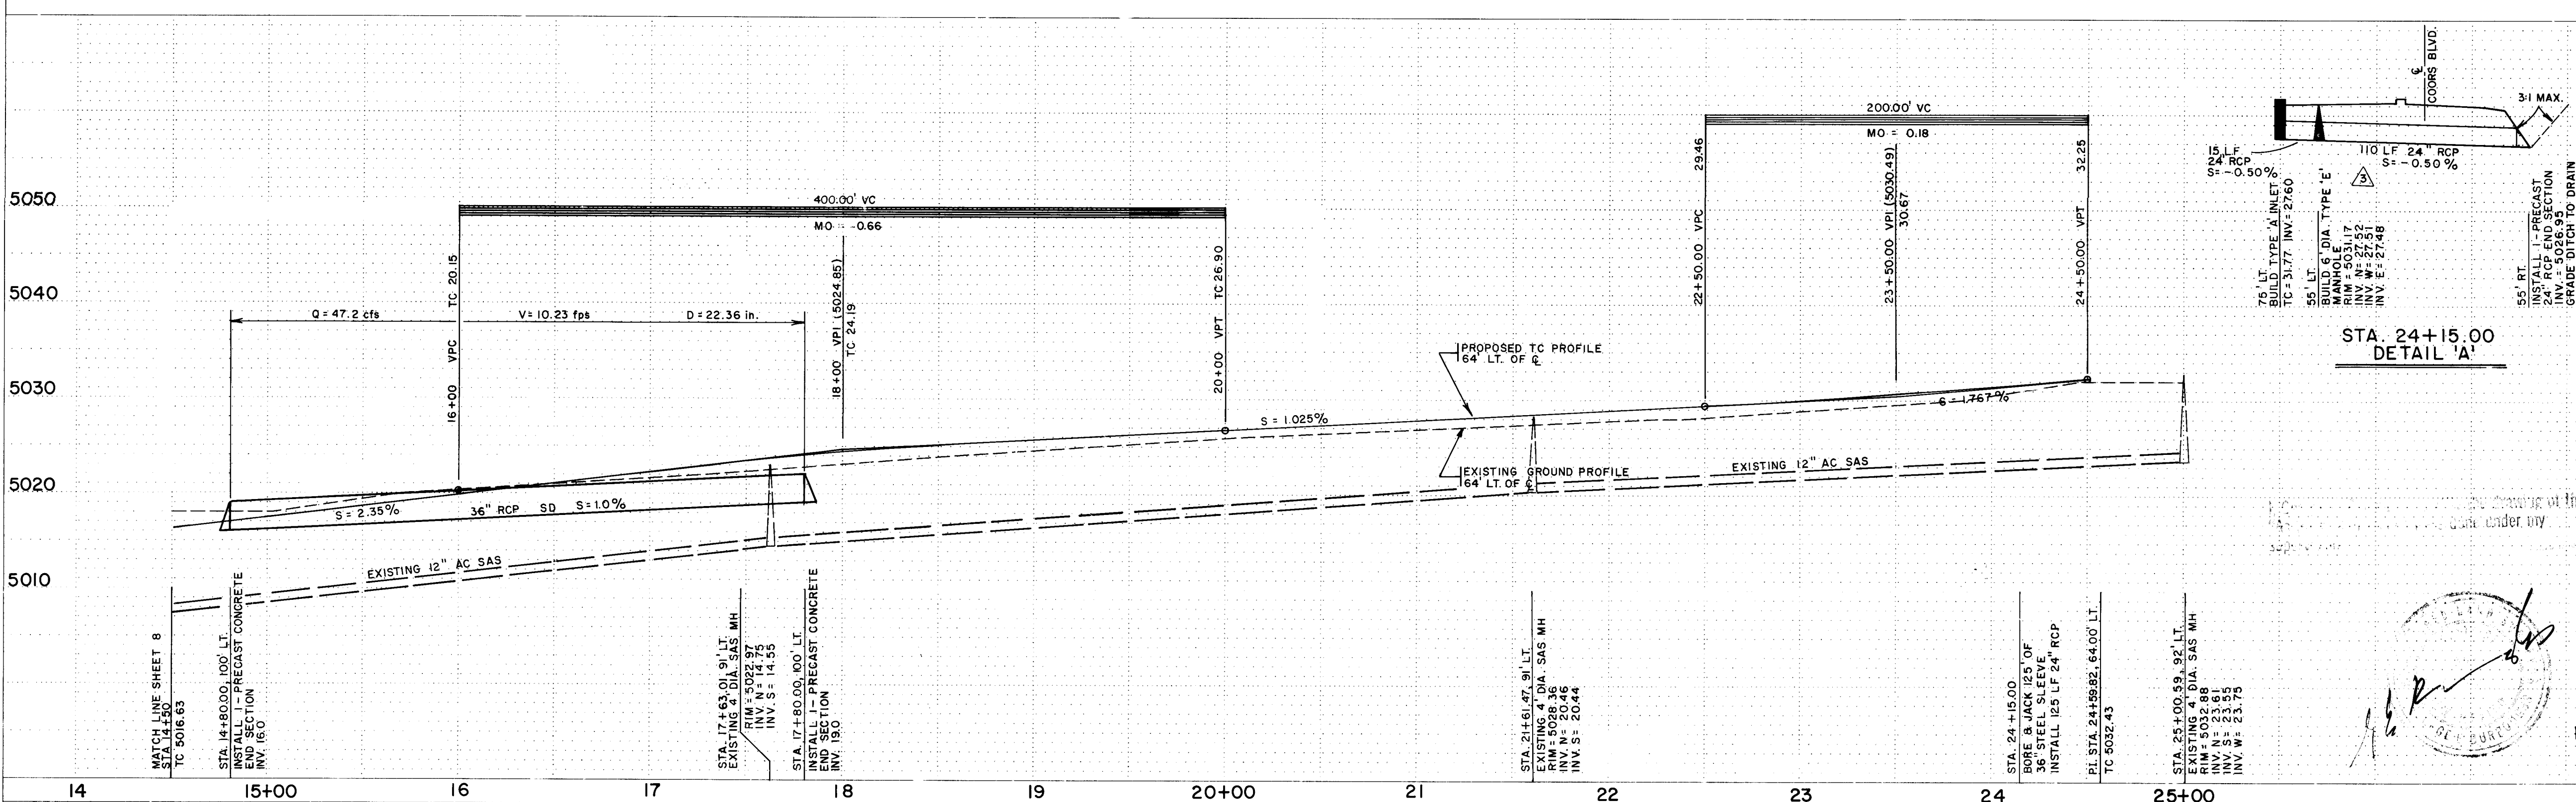

PT.	STATION	OFFSET	TC ELEV.
1	15+23.87	64.00' LT	18.36
2	16+44.92	2.00' LT	22.24
3	16+64.46	64.00' LT	21.60
4	17+14.42	116.10' LT	23.46
5	17+12.02	14.00' RT	23.40
6	17+12.09	10.00' RT	23.49
7	17+19.27	67.31' LT	22.77
8	17+20.79	64.00' LT	22.75
9	17+17.94	14.00' LT	23.52
10	17+13.16	10.00' LT	23.61
11	17+29.99	84.16' LT	23.25
12	17+32.55	64.00' LT	22.97
13	17+33.81	83.42' LT	23.31
14	17+34.56	66.07' LT	23.05
15	17+50.93	104.72' LT	24.13
16	17+51.21	2.00' LT	24.39
17	17+80.91	76.00' LT	23.62
18	17+83.72	14.00' LT	24.74
19	18+36.00	76.00' LT	25.01
20	18+80.67	72.66' LT	25.61
21	19+69.89	66.00' LT	26.54
22	20+16.72	73.50' LT	26.88
23	20+32.35	76.00' LT	26.99
24	20+35.40	14.00' RT	28.09
25	20+93.81	76.00' LT	27.62
26	21+10.86	73.00' LT	27.86
27	21+62.00	64.00' LT	28.56
28	21+73.03	2.00' LT	29.63
29	21+78.49	64.00' LT	28.73
30	22+28.50	113.97' LT	29.74
31	22+33.91	68.03' LT	29.34
32	22+35.49	64.75' LT	29.32
33	22+41.82	10.00' LT	30.33
34	22+43.56	83.16' LT	29.59
35	22+47.13	83.25' LT	29.62
36	22+59.43	104.73' LT	29.97
37	22+57.90	65.21' LT	29.55
38	22+59.12	68.76' LT	29.60
39	22+84.67	76.38' LT	30.09
40	23+41.13	67.38' LT	30.48
41	23+45.75	67.00' LT	30.55
42	23+92.64	71.27' LT	31.15
43	24+32.24	67.64' LT	31.87
44	24+33.38	64.00' LT	31.96
45	24+41.82	14.00' LT	32.22
46	24+41.82	10.00' LT	32.20
47	24+47.85	115.60' LT	32.68
48	24+54.41	89.09' LT	32.56
49	24+54.82	64.00' LT	32.34
50	24+59.82	69.00' LT	32.31
51	24+59.83	87.33' LT	32.83
52	24+59.85	174.35' LT	33.59 *
53	17+17.09	10.00' RT	23.58

26

35

75

09

90

LEGEND

EXISTING CURB & GUTTER

PROPOSED CURB & GUTTER

NEW PAVEMENT - DEVELOPER

REMOVE EXISTING PAVEMENT

NEW PAVEMENT - NOT PART OF THIS CONTRACT TO BE DONE BY OTHERS

TEMPORARY PAVING - NOT PART OF THIS CONTRACT TO BE DONE BY OTHERS

APPROVALS

ENGINEER

DATE

APPROVALS

ENGINEER

DATE

City Engineer

Regan & Shaw

4/11/89

Liquid Waste

II

Regan & Shaw

4/11/89

A.C.E. - Design

II

II

Traffic

II

II

A.C.E. - Hydrology

II

II

Water

II

II

A.C.E. - Utilities

II

II

N.M. Utilities

II

II

DRAWING NO.

3575

MAP NO.

C-13

SHEET

9

OF

17

AS BUILT INFORMATION

USC & GS BRASS TABLE "R" ALAMEDA A-3" NEW MEXICO

STATE PLANE COORDINATES (CENTRAL ZONE)

X=377,094.67 Y=1523,108.34

GROUND TO GRID FACTOR=0.99967685

Δ CC=00° 14' 13"

ELEV=5027.05

ENGINEER'S SEAL

NO.

DATE

REVISIONS

DESIGN

CITY OF ALBUQUERQUE


INFRASTRUCTURE IMPROVEMENTS

MARKET CENTER WEST


TITLE:

COORS BOULEVARD

STA. 14+50.00 - STA. 25+00.00

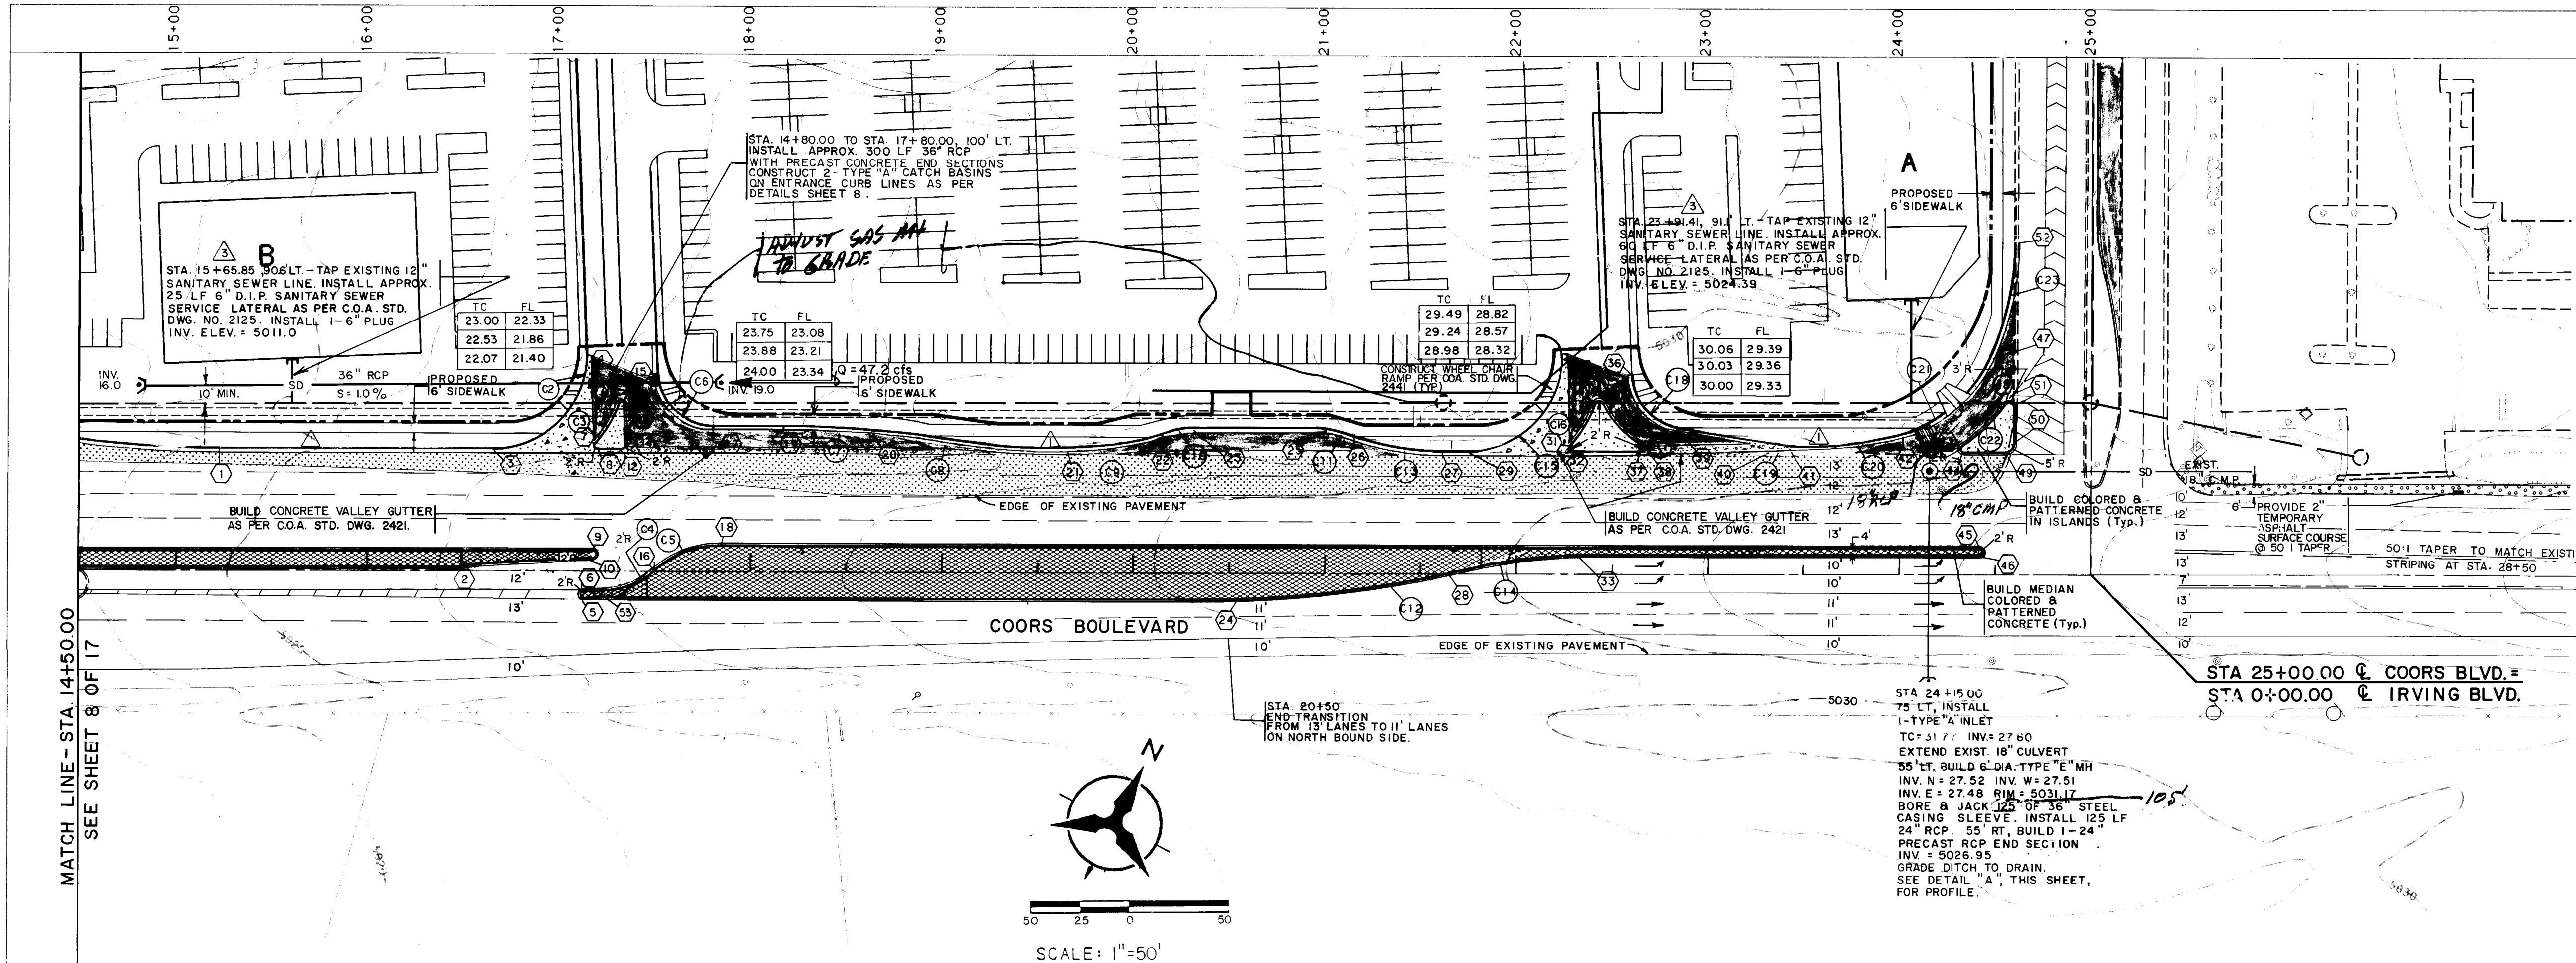

C2 Delta 92° 25' 01" D 114° 35' 30" T 52.15' L 80.65' R 50.00'	C4 Delta 42° 24' 18" D 114° 35' 30" T 19.39' L 37.00' R 50.00'	C6 Delta 87° 34' 48" D 190° 59' 10" T 28.76' L 45.86' R 30.00'	C8 Delta 8° 33' 07" D 9° 32' 57" T 44.86' L 69.55' R 60.00'	C10 Delta 18° 12' 11" D 114° 35' 30" T 8.01' L 15.89' R 50.00'	C12 Delta 13° 15' 36" D 9° 32' 57" T 69.74' L 138.86' R 300.00'	C14 Delta 13° 15' 22" D 19° 05' 55" T 34.86' L 69.41' R 300.00'	C16 Delta 14° 19' 12" D 79° 34' 29" T 9.04' L 17.99' R 72.00'	C18 Delta 78° 30' 47" D 190° 59' 10" T 24.51' L 41.10' R 30.00'	C20 Delta 10° 48' 32" D 22° 55' 06" T 23.65' L 47.16' R 250.00'	C22 Delta 18° 53' 13" D 60° 57' 11" T 15.63' L 30.99' R 94.00'
C3 Delta 15° 56' 35" D 79° 34' 39" T 10.08' L 20.03' R 72.00'	C5 Delta 40° 32' 13" D 114° 35' 30" T 18.46' L 35.38' R 50.00'	C7 Delta 8° 33' 50" D 19° 05' 55" T 22.46' L 44.84' R 300.00'	C9 Delta 18° 11' 31" D 38° 11' 50" T 24.02' L 47.63' R 150.00'	C11 Delta 19° 55' 34" D 114° 35' 30" T 8.78' L 17.39' R 50.00'	C13 Delta 19° 56' 17" D 38° 11' 50" T 26.36' L 52.20' R 150.00'	C15 Delta 89° 58' 59" D 114° 35' 30" T 9.55' L 18.93' R 50.00'	C17 Delta 22° 35' 56" D 119° 21' 55" T 9.55' L 18.93' R 48.00'	C19 Delta 8° 51' 18" D 190° 59' 10" T 2.32' L 4.64' R 30.00'	C21 Delta 56° 19' 12" D 76° 23' 40" T 40.15' L 73.72' R 75.00'	C23 Delta 23° 03' 29" D 38° 11' 50" T 30.60' L 60.37' R 150.00'

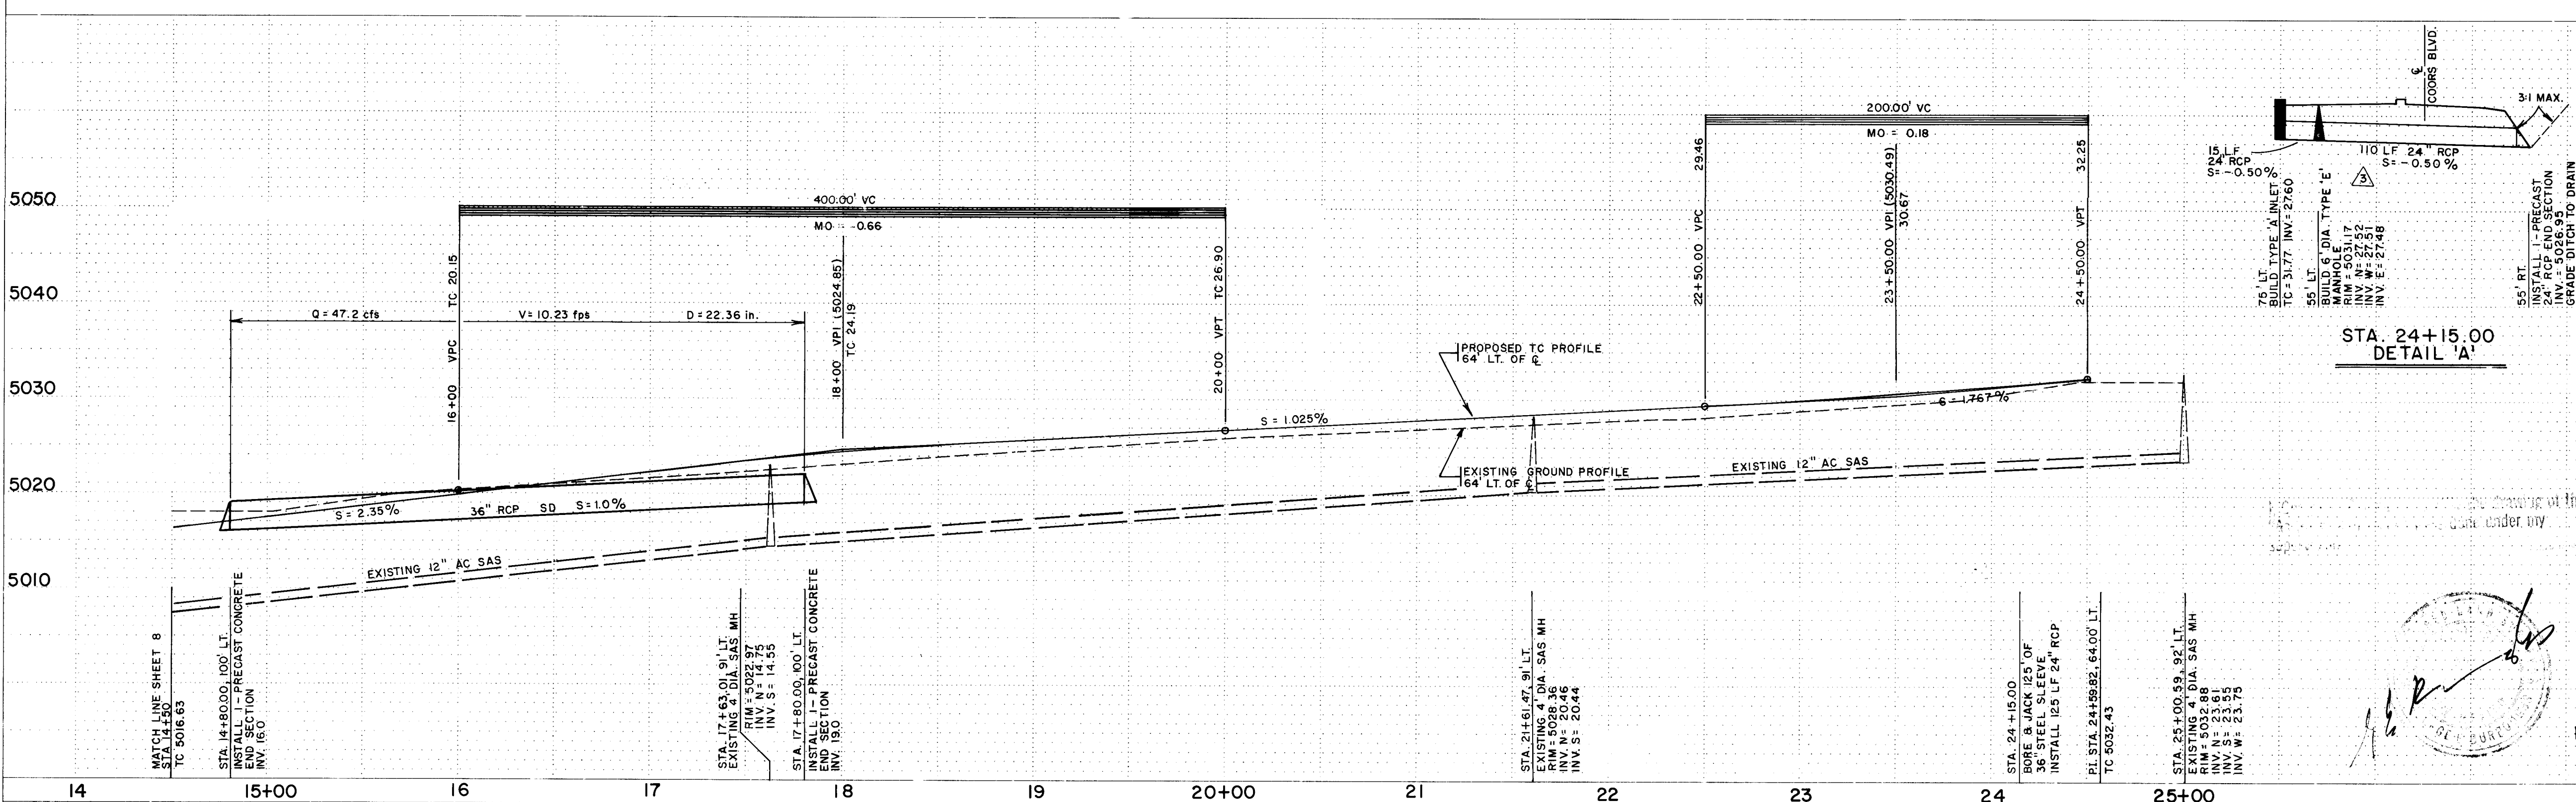

PT.	STATION	OFFSET	TC ELEV.
1	15+23.87	64.00' LT	18.36
2	16+44.92	2.00' LT	22.24
3	16+64.46	64.00' LT	21.60
4	17+14.42	116.10' LT	23.46
5	17+12.02	14.00' RT	23.40
6	17+12.09	10.00' RT	23.49
7	17+19.27	67.31' LT	22.77
8	17+20.79	64.00' LT	22.75
9	17+17.94	14.00' LT	23.52
10	17+13.16	10.00' LT	23.61
11	17+29.99	84.16' LT	23.25
12	17+32.55	64.00' LT	22.97
13	17+33.81	83.42' LT	23.31
14	17+34.56	66.07' LT	23.05
15	17+50.93	104.72' LT	24.13
16	17+51.21	2.00' LT	24.39
17	17+80.91	76.00' LT	23.62
18	17+83.72	14.00' LT	24.74
19	18+36.00	76.00' LT	25.01
20	18+80.67	72.66' LT	25.61
21	19+69.89	66.00' LT	26.54
22	20+16.72	73.50' LT	26.88
23	20+32.35	76.00' LT	26.99
24	20+35.40	14.00' RT	28.09
25	20+93.81	76.00' LT	27.62
26	21+10.86	73.00' LT	27.86
27	21+62.00	64.00' LT	28.56
28	21+73.03	2.00' LT	29.63
29	21+78.49	64.00' LT	28.73
30	22+28.50	113.97' LT	29.74
31	22+33.91	68.03' LT	29.34
32	22+35.49	64.75' LT	29.32
33	22+41.82	10.00' LT	30.33
34	22+43.56	83.16' LT	29.59
35	22+47.13	83.25' LT	29.62
36	22+59.43	104.73' LT	29.97
37	22+57.90	65.21' LT	29.55
38	22+59.12	68.76' LT	29.60
39	22+84.67	76.38' LT	30.09
40	23+41.13	67.38' LT	30.48
41	23+45.75	67.00' LT	30.55
42	23+92.64	71.27' LT	31.15
43	24+32.24	67.64' LT	31.87
44	24+33.38	64.00' LT	31.96
45	24+41.82	14.00' LT	32.22
46	24+41.82	10.00' LT	32.20
47	24+47.85	115.60' LT	32.68
48	24+54.41	89.09' LT	32.56
49	24+54.82	64.00' LT	32.34
50	24+59.82	69.00' LT	32.31
51	24+59.83	87.33' LT	32.83
52	24+59.85	174.35' LT	33.59 *
53	17+17.09	10.00' RT	23.58

LEGEND

EXISTING CURB & GUTTER

PROPOSED CURB & GUTTER

NEW PAVEMENT - DEVELOPER

REMOVE EXISTING PAVEMENT

NEW PAVEMENT - NOT PART OF THIS CONTRACT TO BE DONE BY OTHERS

TEMPORARY PAVING - NOT PART OF THIS CONTRACT TO BE DONE BY OTHERS

REVISIONS

NO.	DATE	REMARKS
1	4/11/89	DESIGN

APPROVALS

ENGINEER	DATE	APPROVALS	ENGINEER	DATE
City Engineer	4/11/89	Liquid Waste	N/A	4/11/89
A.C.E. - Design	"	Traffic	N/A	"
A.C.E. - Hydrology	"	Water	N/A	"
		N.M. Utilities	N/A	"

TITLE

COORS BOULEVARD

STA. 14+50.00 - STA. 25+00.00

DRAWING NO.

3575

MAP NO.

C-13

SHEET

9

OF

17

AS BUILT INFORMATION

USC & GS BRASS TABLE "R" ALAMEDA A-3" NEW MEXICO

STATE PLANE COORDINATES (CENTRAL ZONE)

X=377,094.67 Y=1523,108.34

GROUND TO GRID FACTOR=0.99967685

Δ CC=00° 14' 13"

ELEV=5027.05

ENGINEER'S SEAL

3-2-89

REVISIONS

NO.	DATE	REMARKS
1	4/11/89	DESIGN

APPROVALS

ENGINEER	DATE	APPROVALS	ENGINEER	DATE
City Engineer	4/11/89	Liquid Waste	N/A	4/11/89
A.C.E. - Design	"	Traffic	N/A	"
A.C.E. - Hydrology	"	Water	N/A	"
		N.M. Utilities	N/A	"

TITLE

COORS BOULEVARD

STA. 14+50.00 - STA. 25+00.00

DRAWING NO.

3575

MAP NO.


C-13

SHEET


9

OF


17

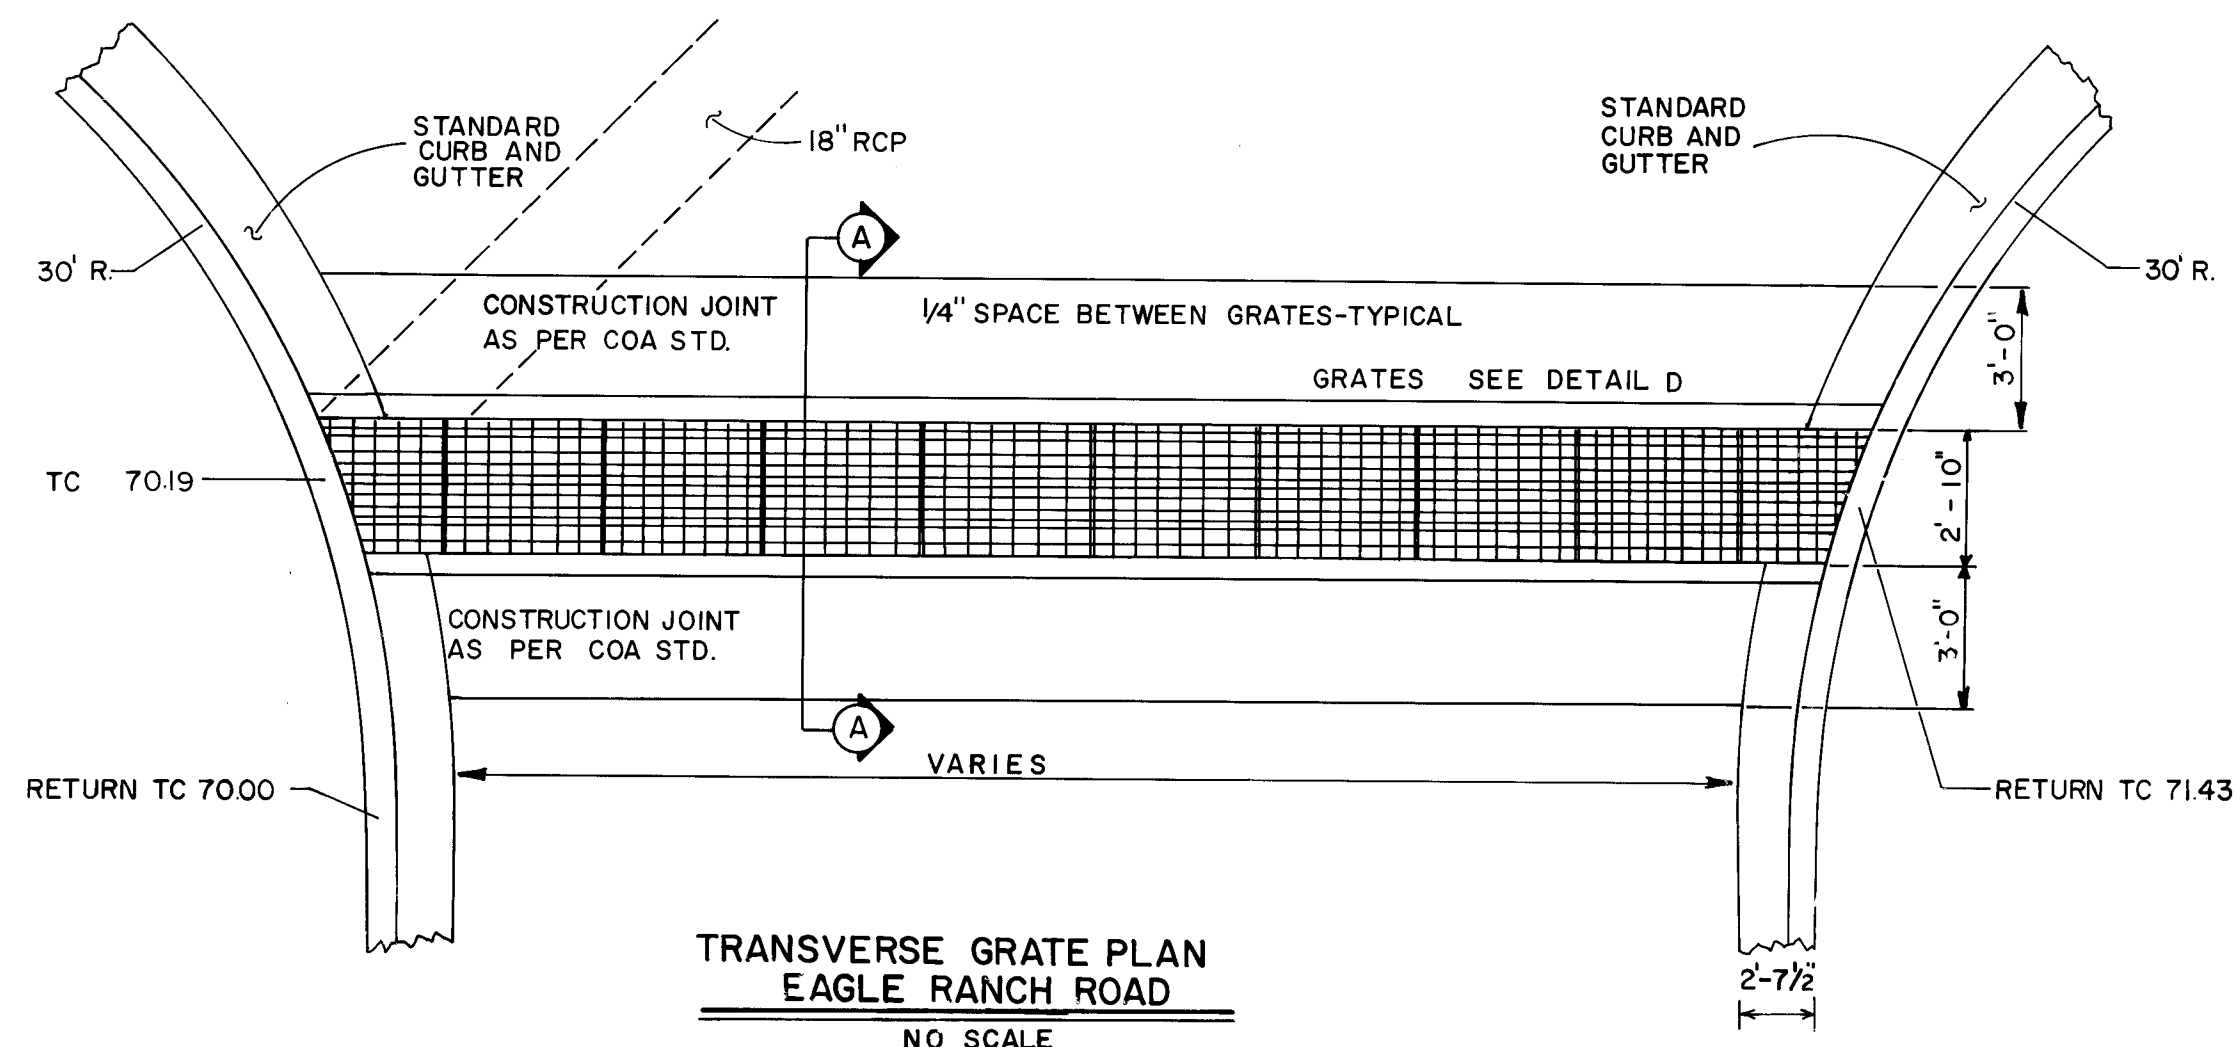

TRANSVERSE GRATE PLAN
EAGLE RANCH ROAD
NO SCALE

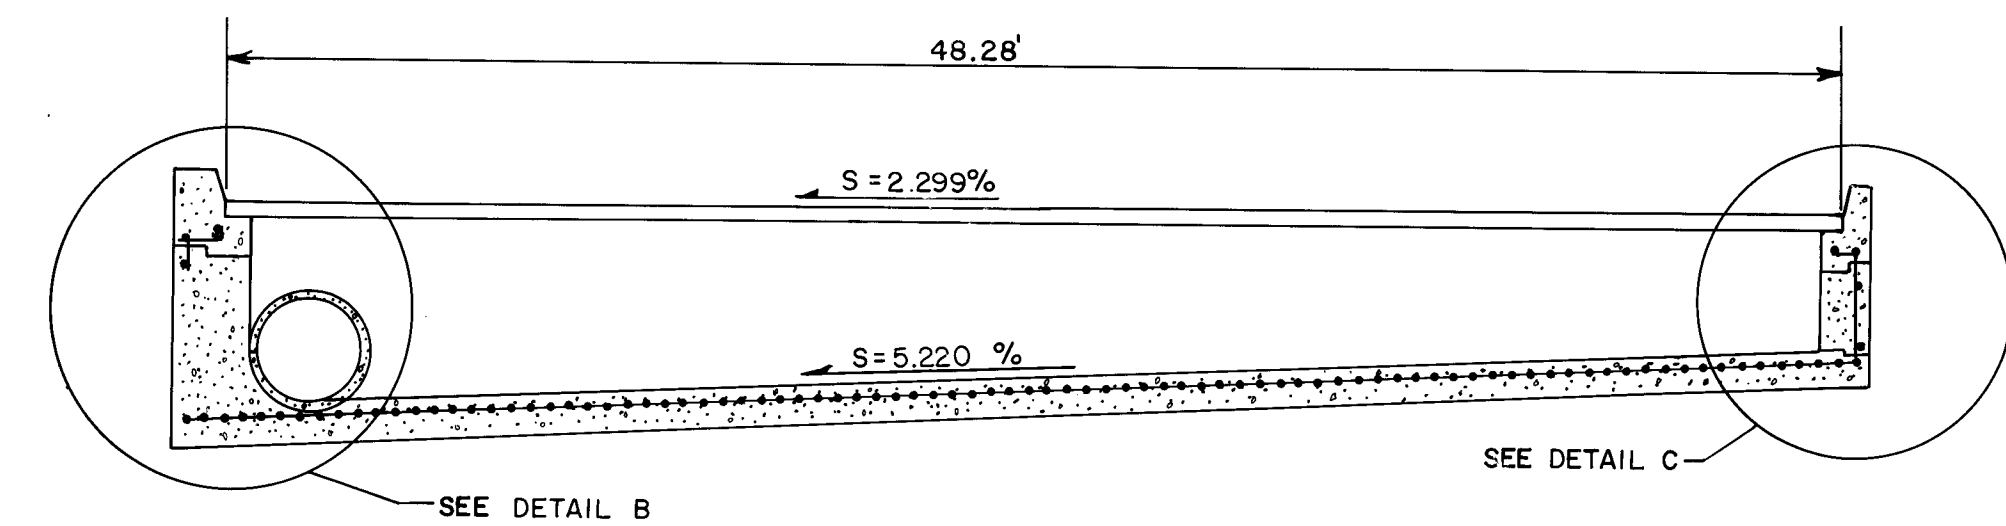

TRANSVERSE GRATE PROFILE
EAGLE RANCH ROAD
NO SCALE

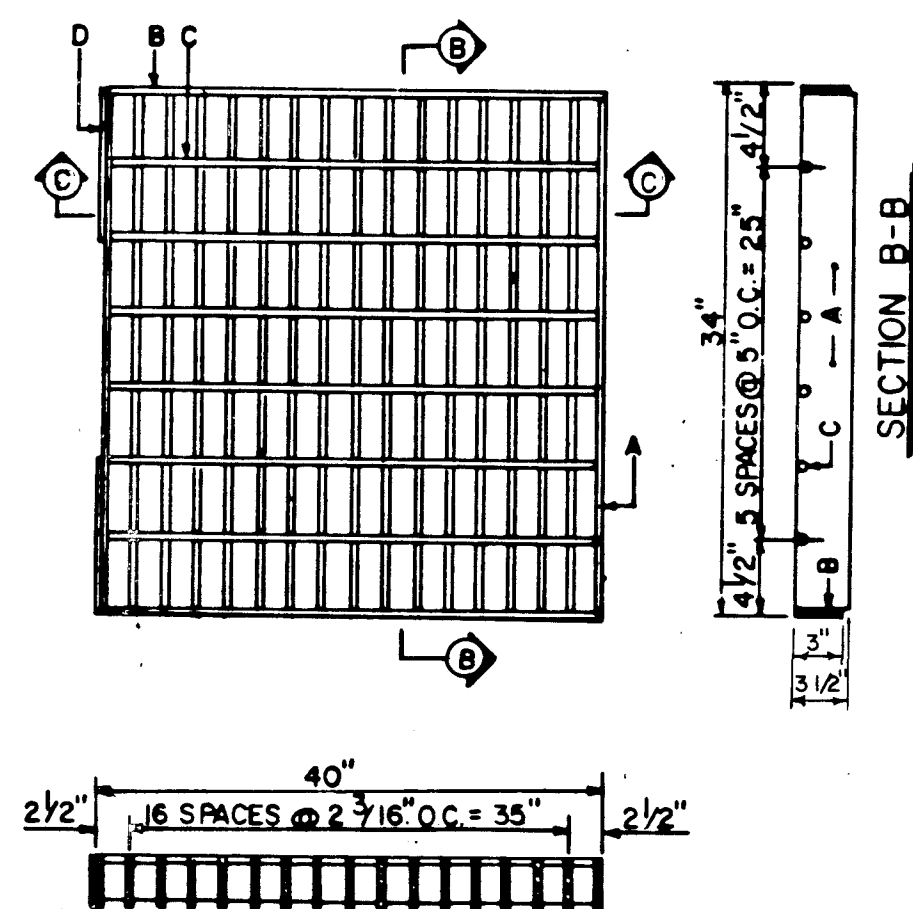


SECTION C-C


DETAIL D
NO SCALE

- GENERAL NOTES:
1. FINISHED DIMENSIONS, 3 1/2\"/>


- CONSTRUCTION NOTES:
- A. BEARING DIMS. (13) 1/2\"/>

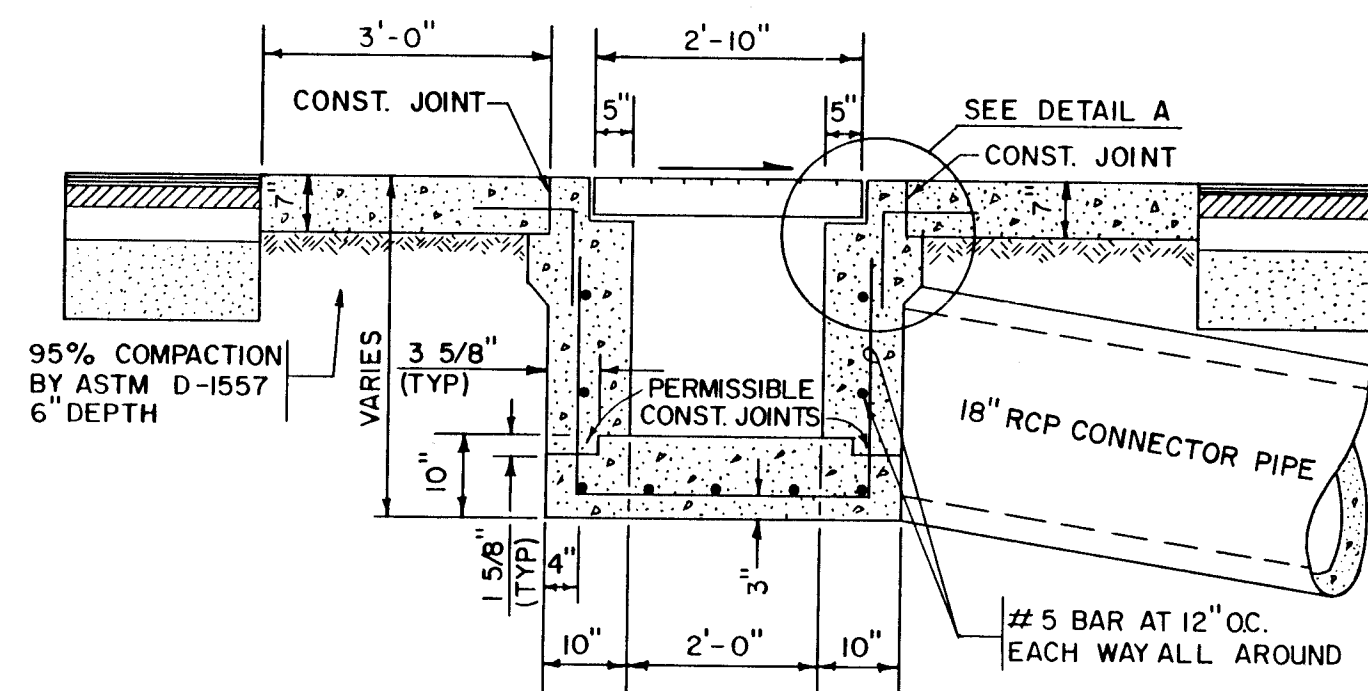


SECTION A-A
NOT TO SCALE

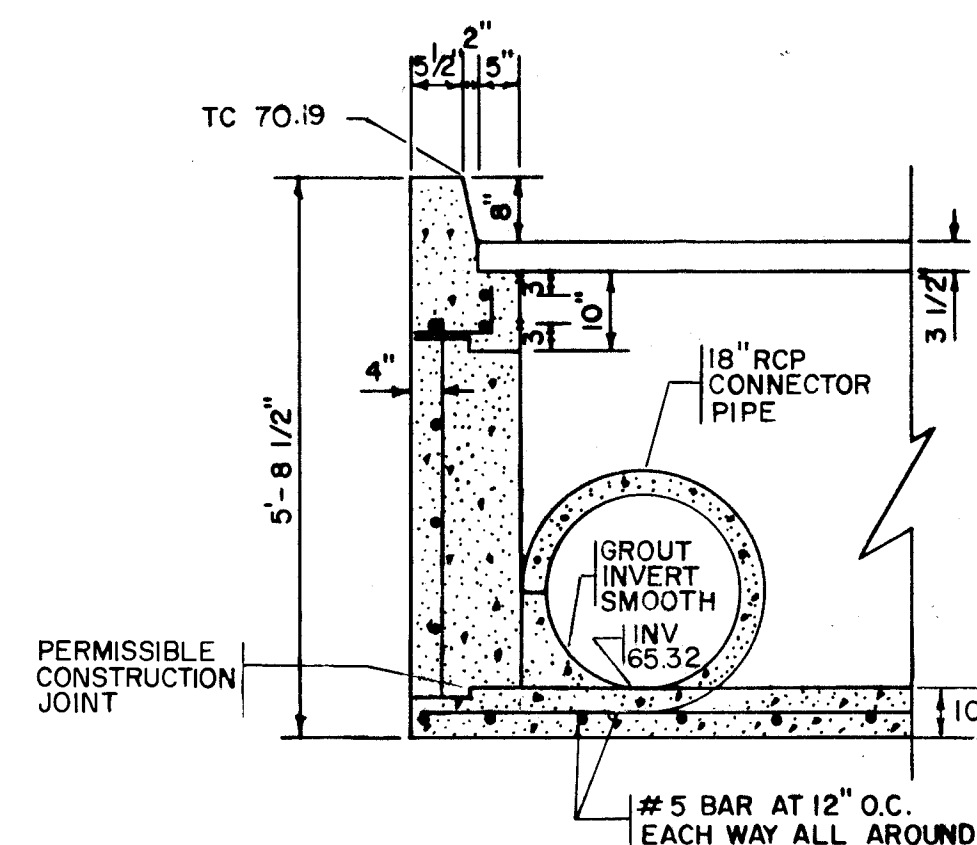


DETAIL B
SCALE: 1/2\"/>

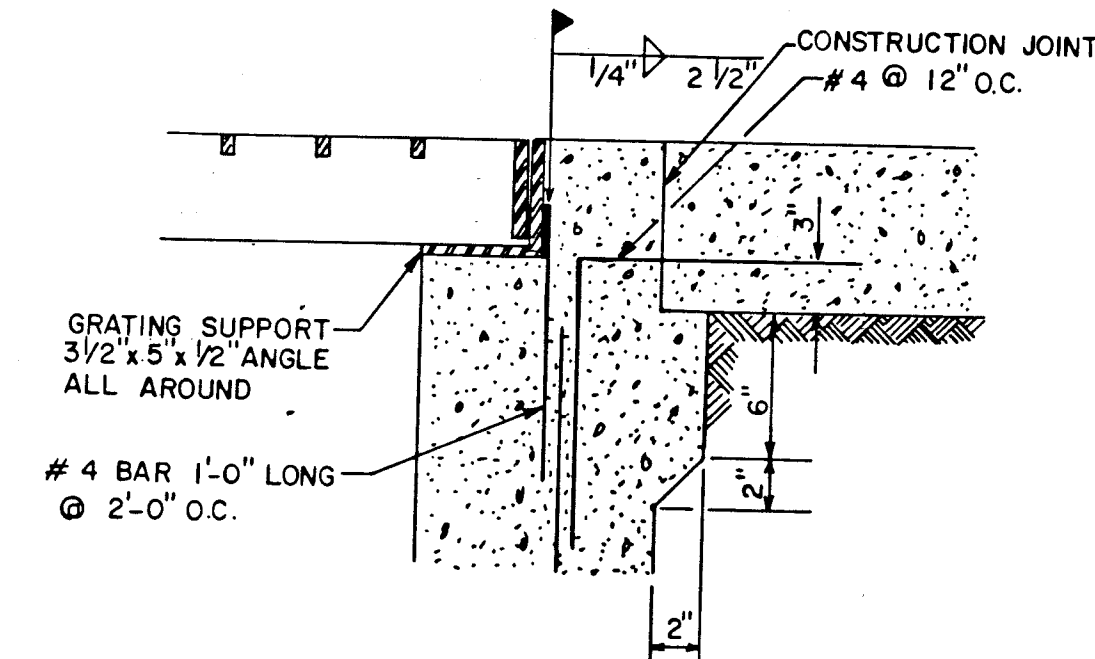


DETAIL A
SCALE: 1/2\"/>

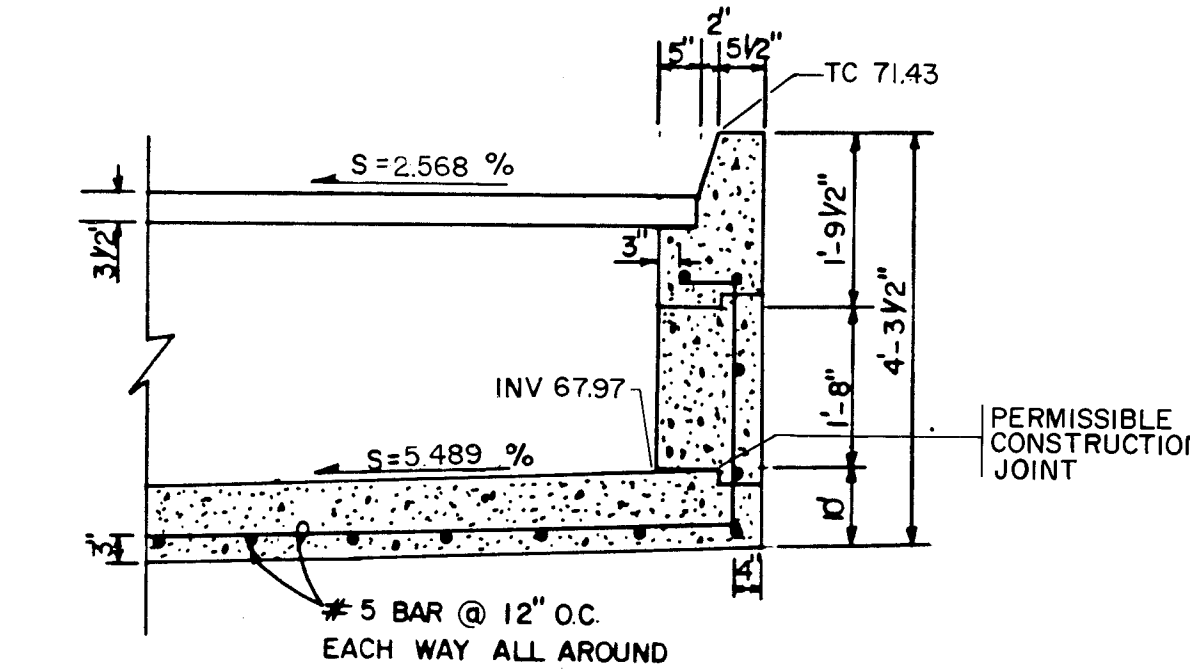


DETAIL C
SCALE: 1/2\"/>

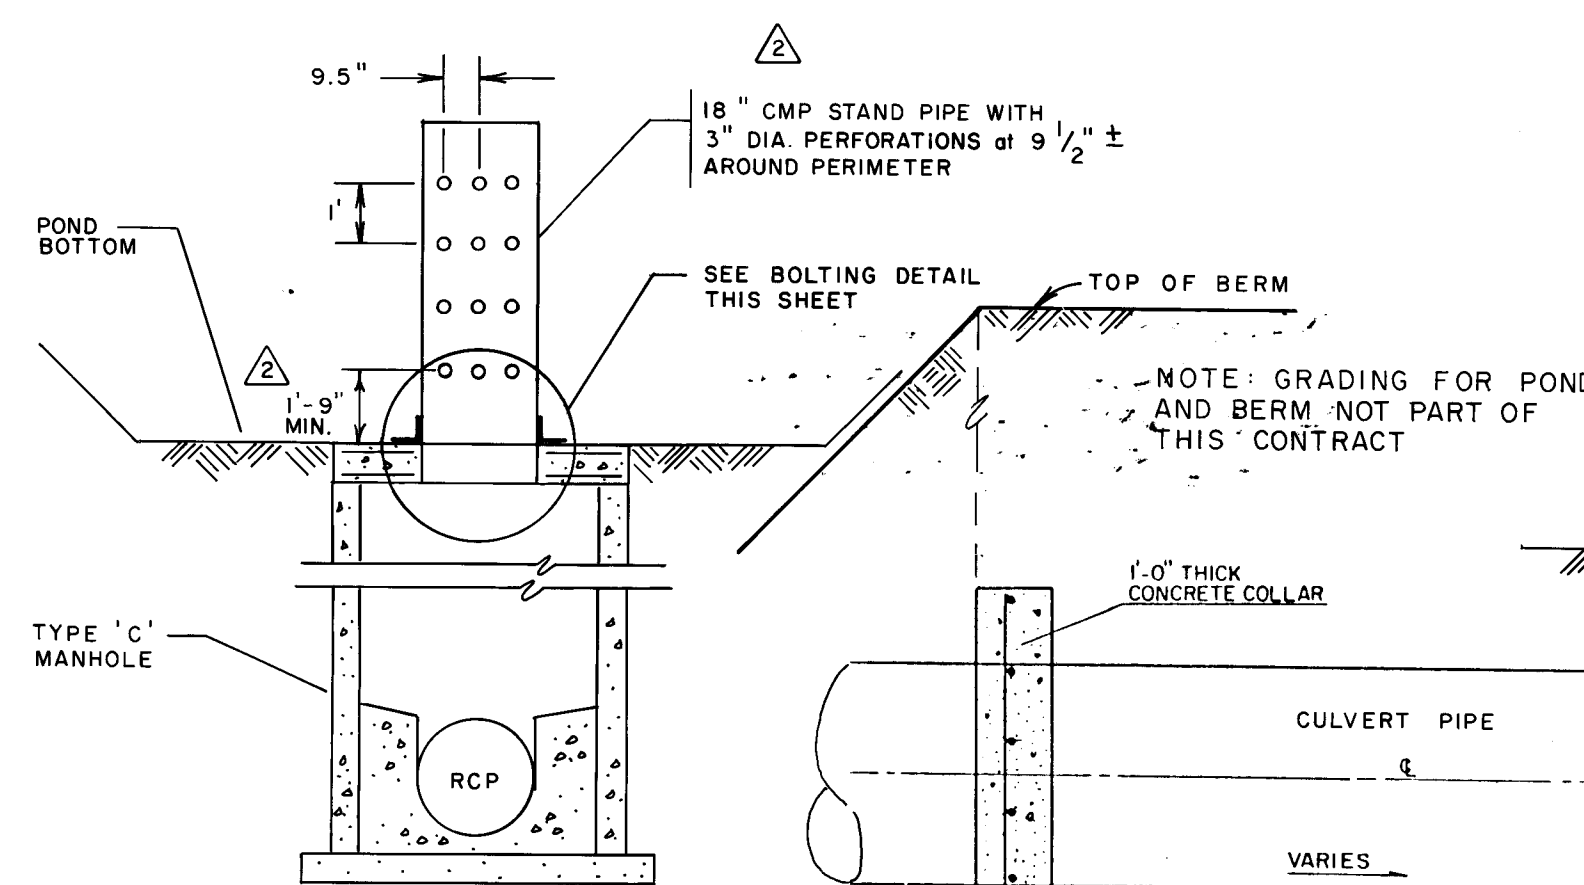


STAND PIPE DETAIL
NO SCALE

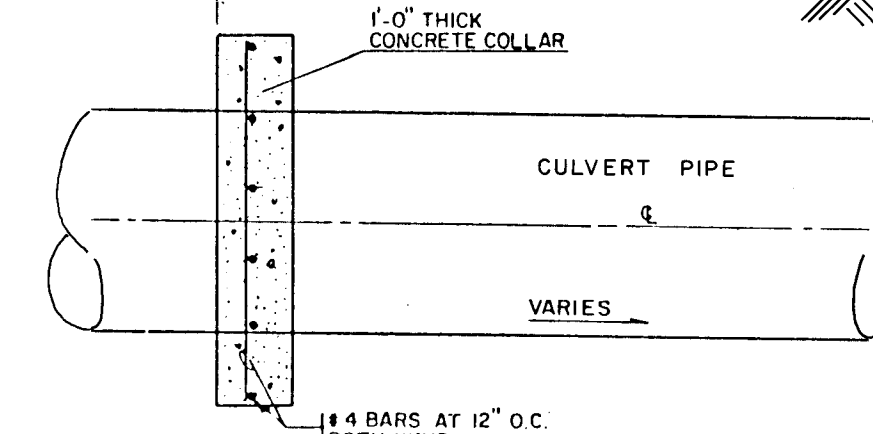

CONCRETE COLLAR DETAIL

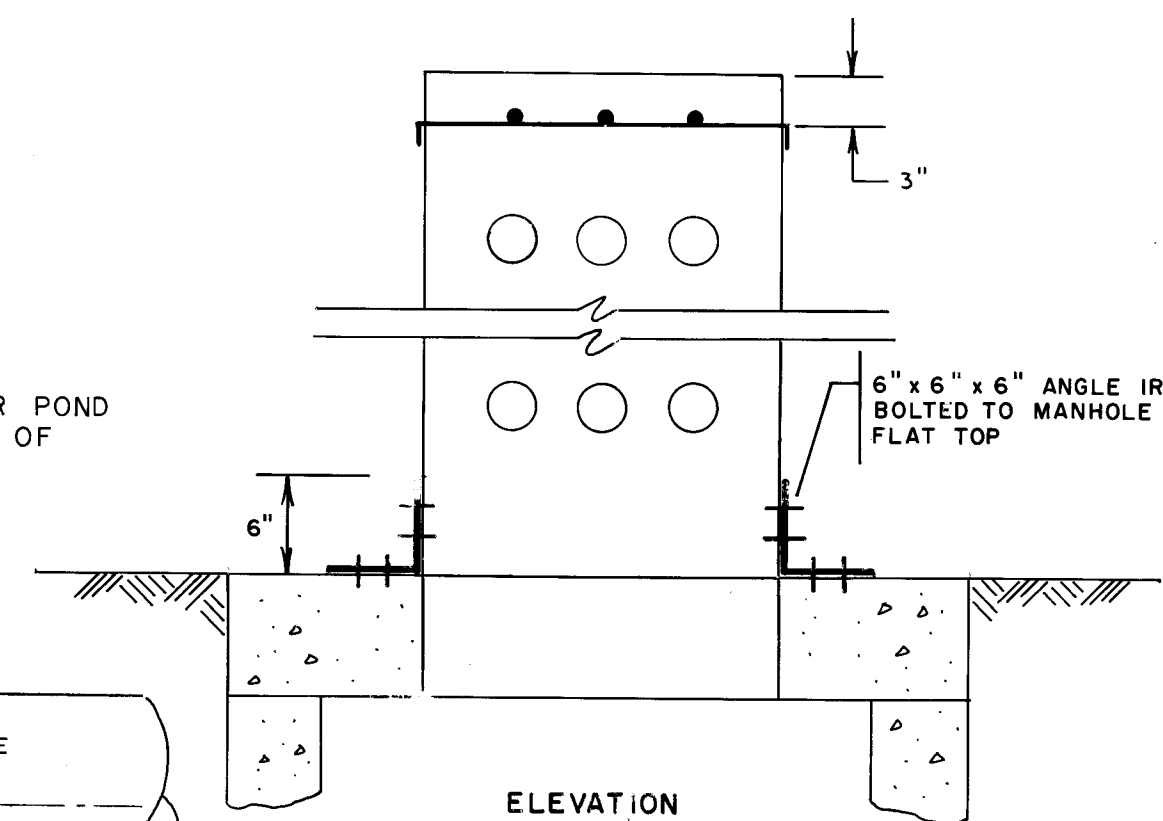


ELEVATION

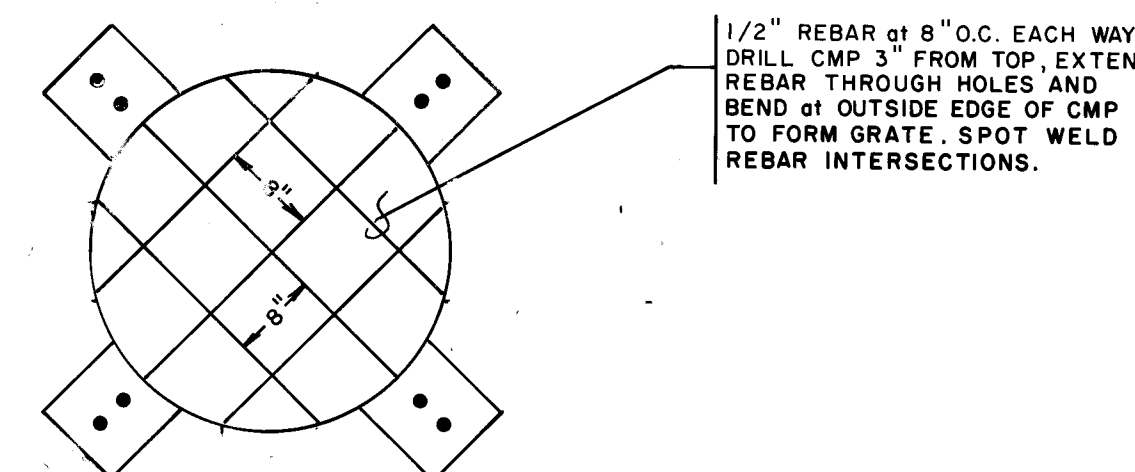


PLAN

STAND PIPE
BOLTING DETAIL
NO SCALE

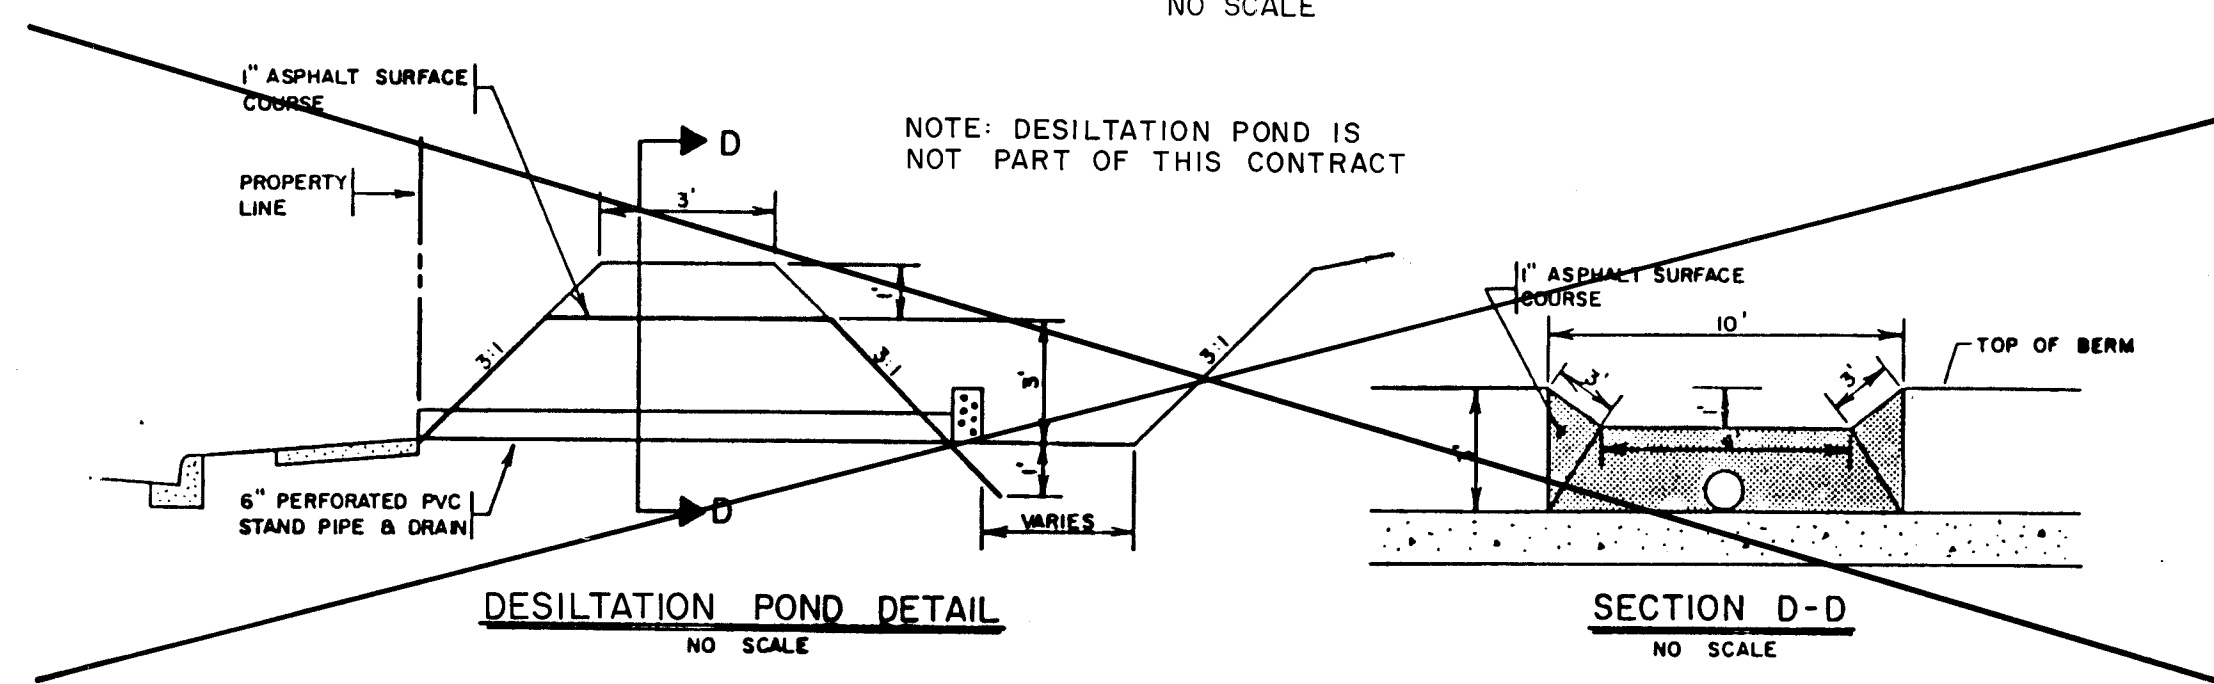

DESILTATION POND DETAIL
NO SCALE

SECTION D-D
NO SCALE

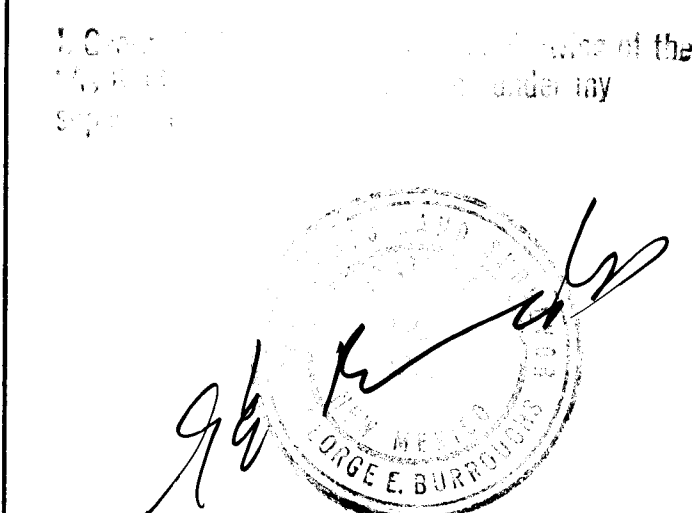


LEGEND


- SUBGRADE (95% COMPACTION)
- CONCRETE
- REBAR

26 3575 190


CITY OF ALBUQUERQUE INFRASTRUCTURE IMPROVEMENTS MARKET CENTER WEST					
TITLE: STORM SEWER DETAILS					
APPROVALS	ENGINEER	DATE	APPROVALS	ENGINEER	DATE
City Engineer	R. A. BACA	4/11/89	Liquid Waste	N/A	
A.C.E. - Design	"	"	Traffic	R. A. BACA	4/11/89
A.C.E. - Hydrology	"	"	Water	N/A	
			N.M. Utilities	N/A	4-2-89
DRAWING NO.	3575	MAP NO.	C-13	SHEET	OF 11 17

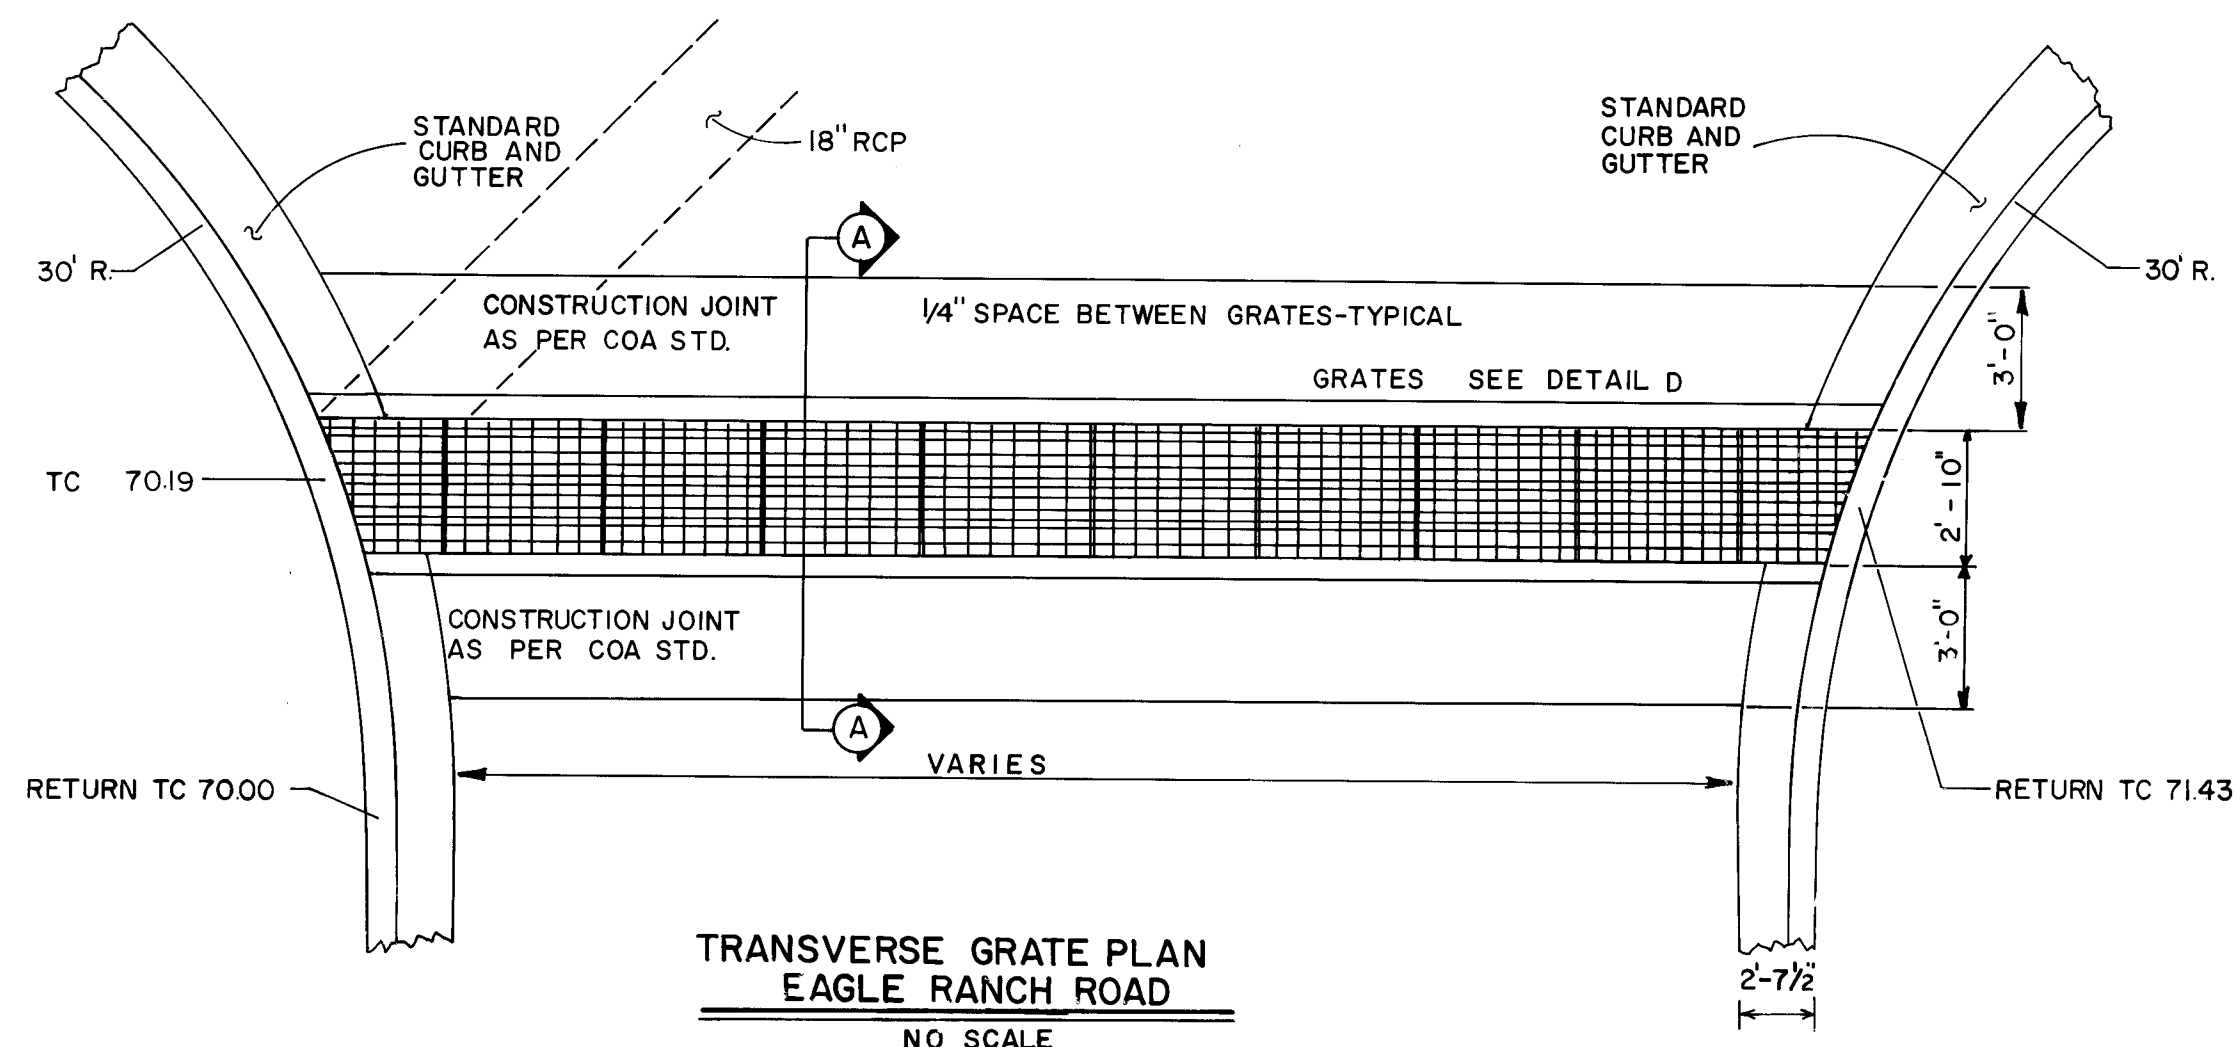


TRANSVERSE GRATE PLAN
EAGLE RANCH ROAD
NO SCALE

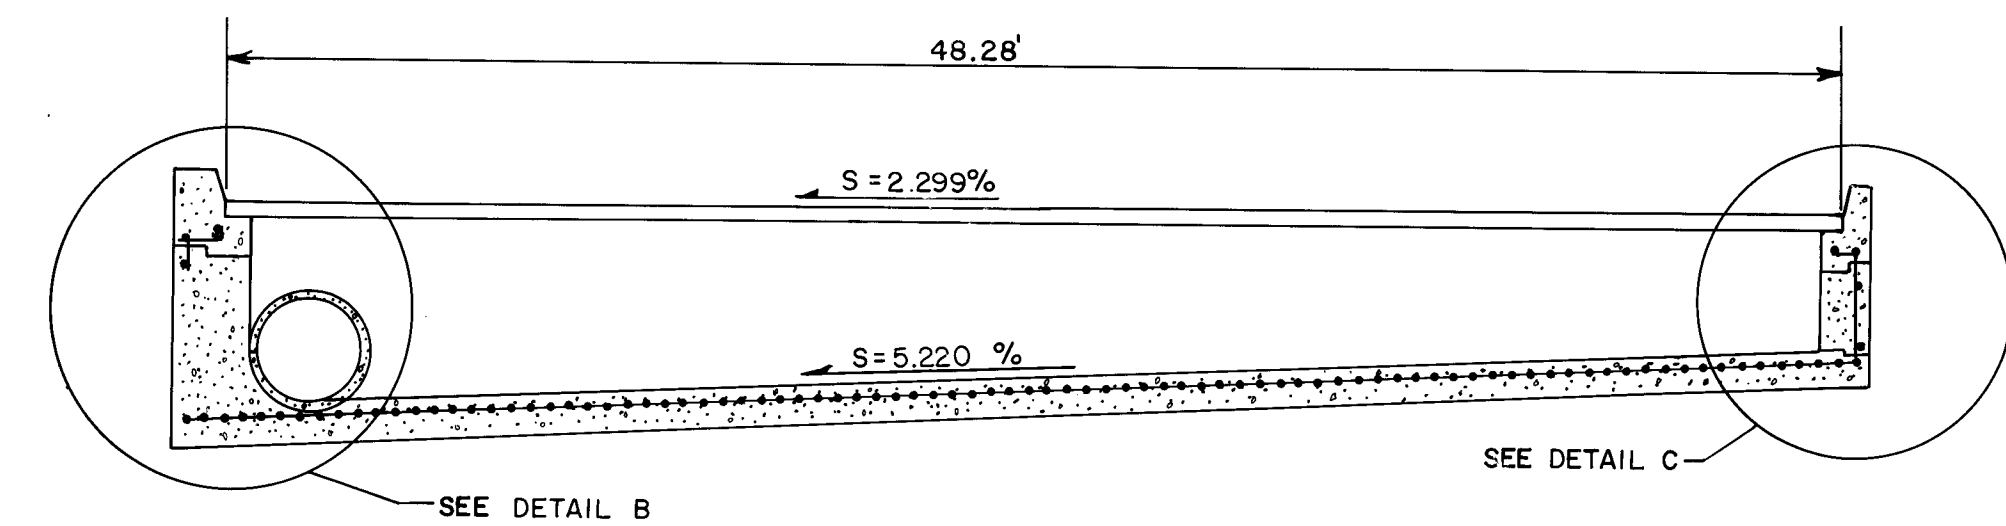

TRANSVERSE GRATE PROFILE
EAGLE RANCH ROAD
NO SCALE

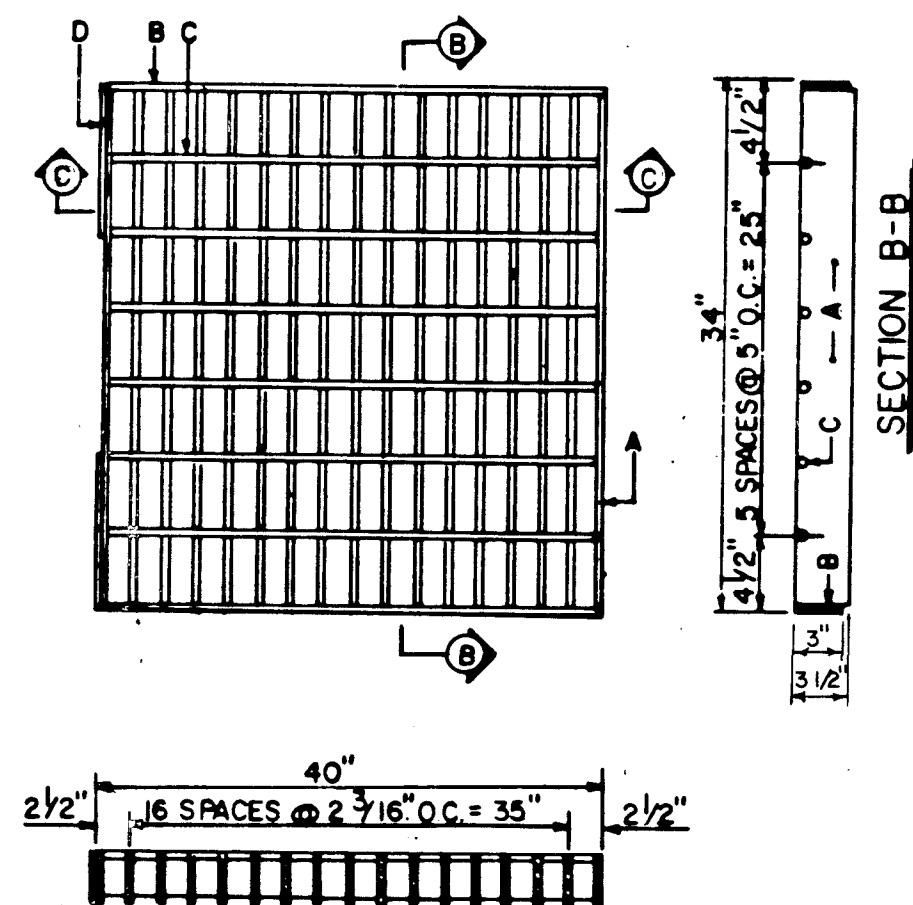

SECTION B-B

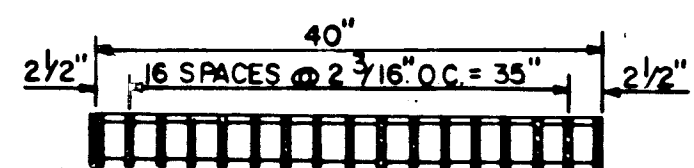


SECTION C-C


DETAIL D
NO SCALE

- GENERAL NOTES:
1. FINISHED DIMENSIONS, 3' 1/2\"/>


- CONSTRUCTION NOTES:
- A. BEARING DIMS. (13) 1/2\"/>

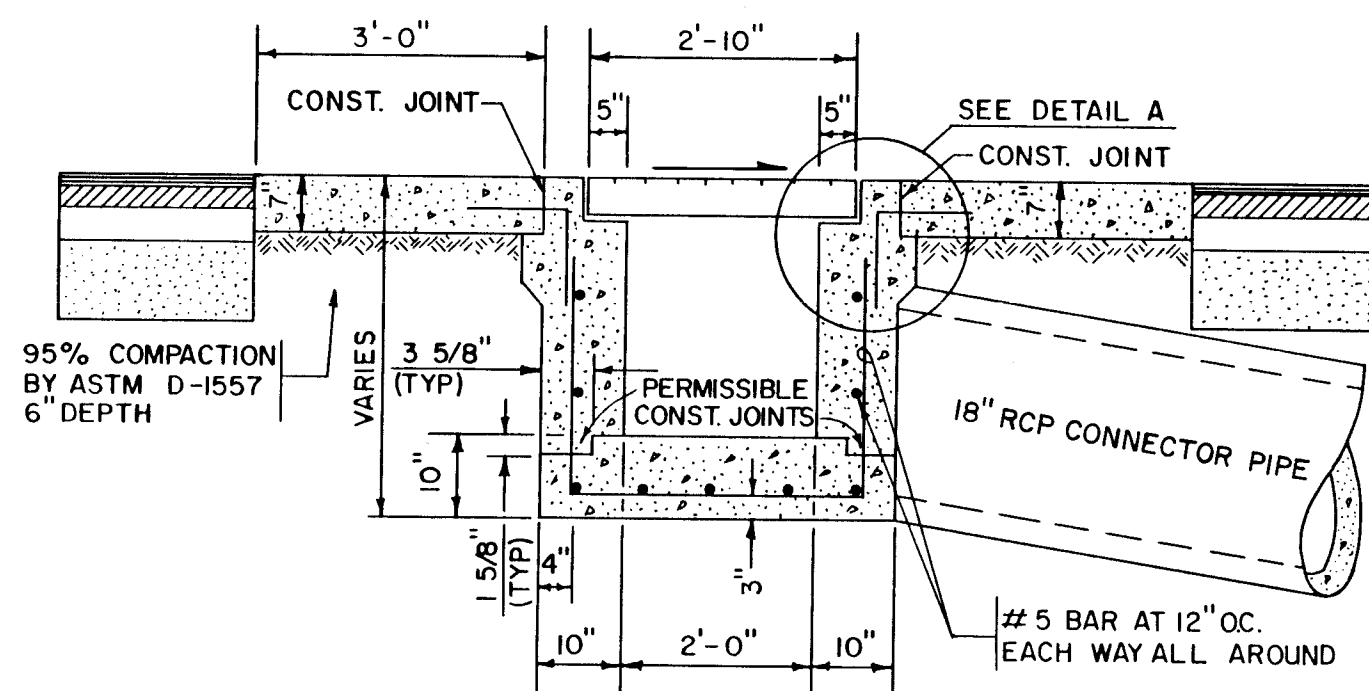


SECTION A-A
NOT TO SCALE

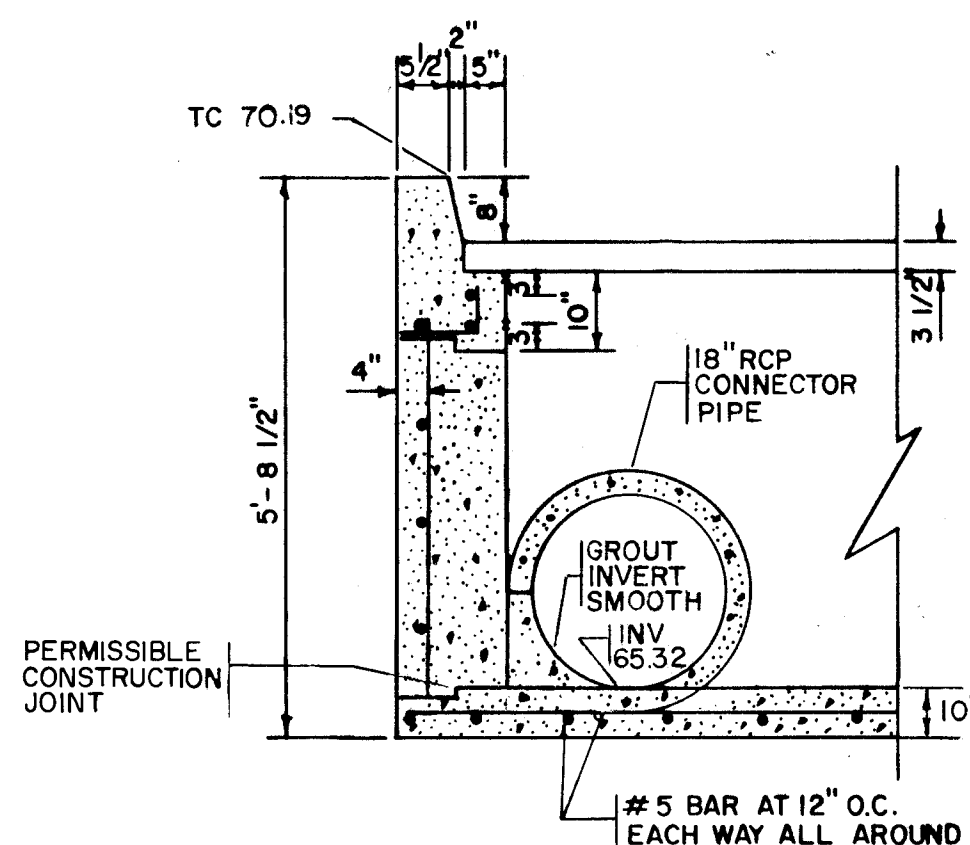


DETAIL B
SCALE: 1/2\"/>

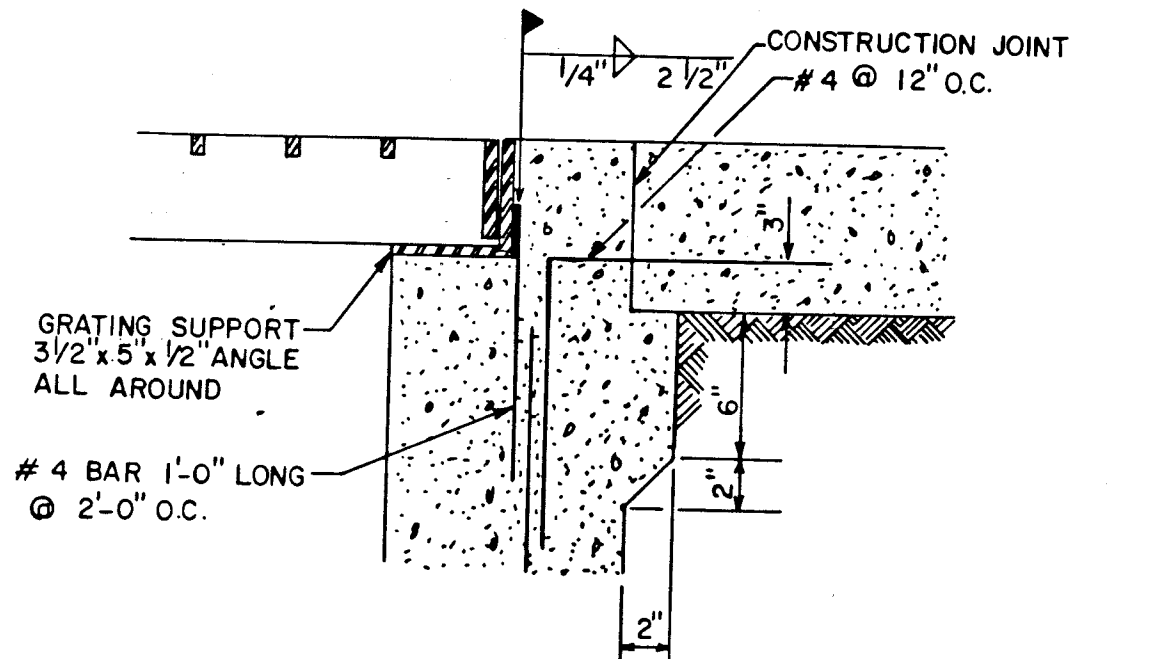


DETAIL A
SCALE: 1/2\"/>

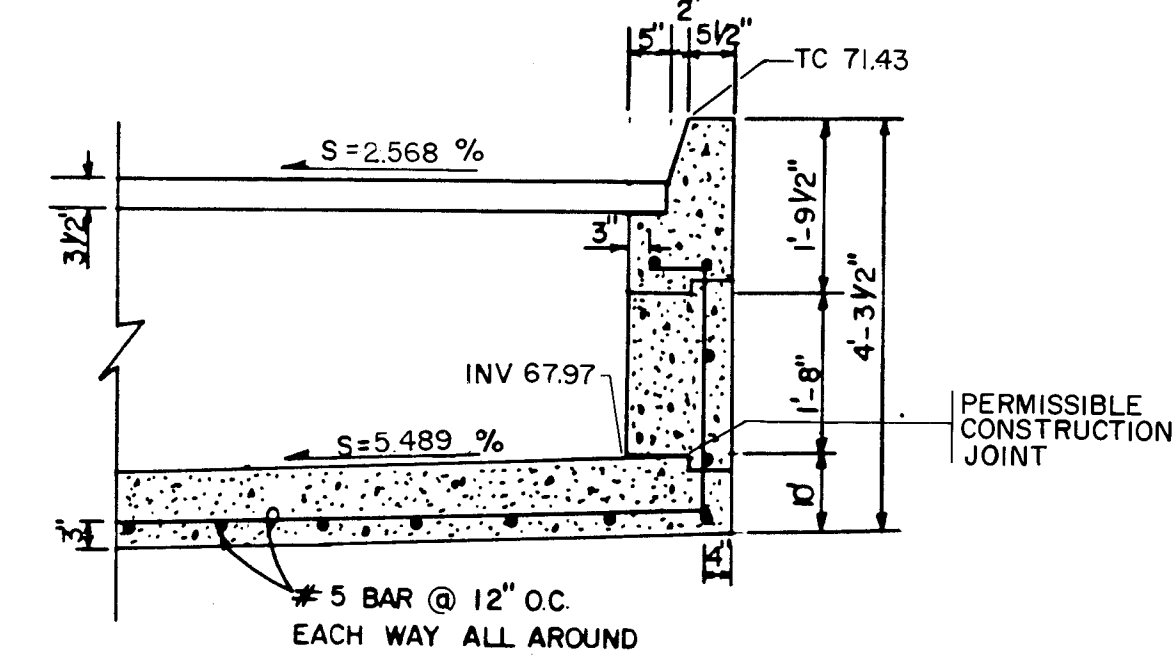


DETAIL C
SCALE: 1/2\"/>

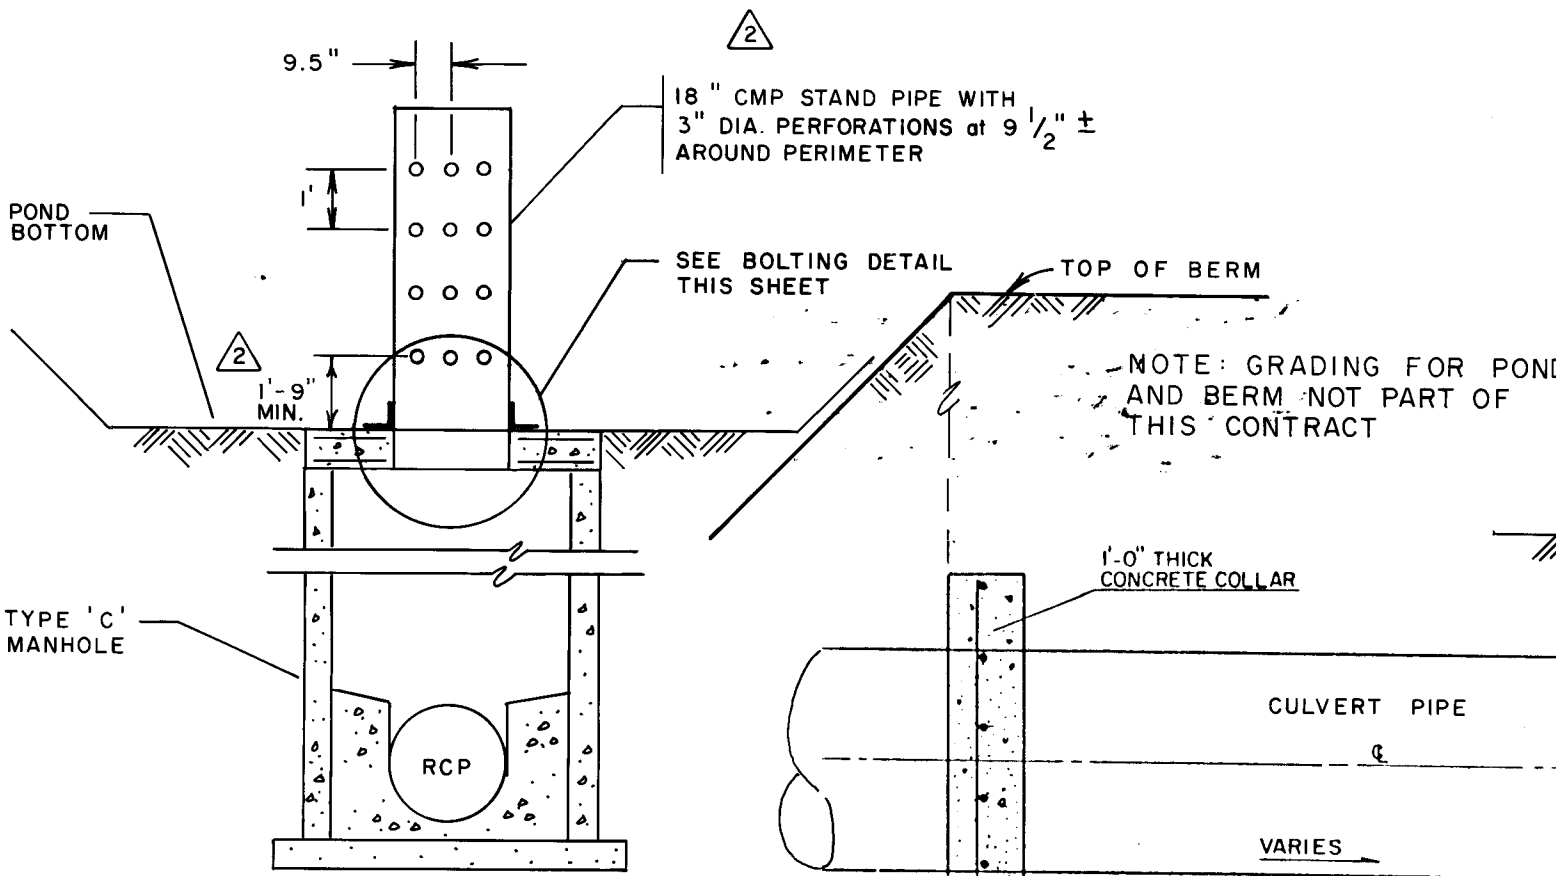


STAND PIPE DETAIL
NO SCALE

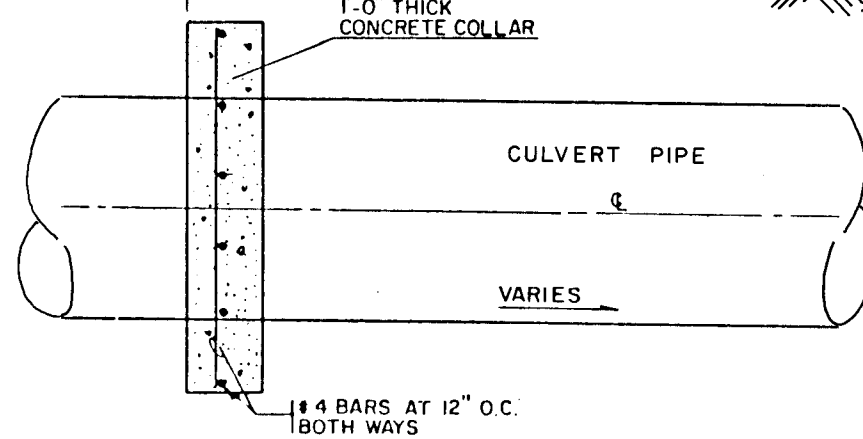

CONCRETE COLLAR DETAIL

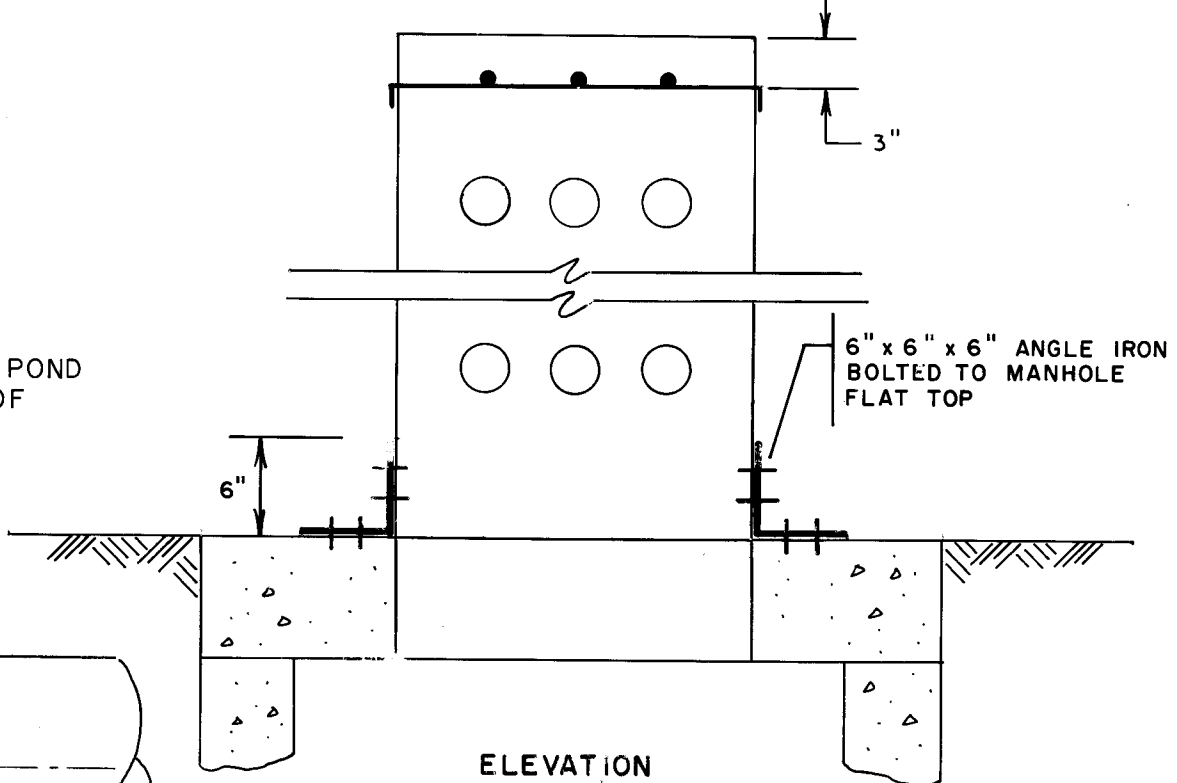


ELEVATION

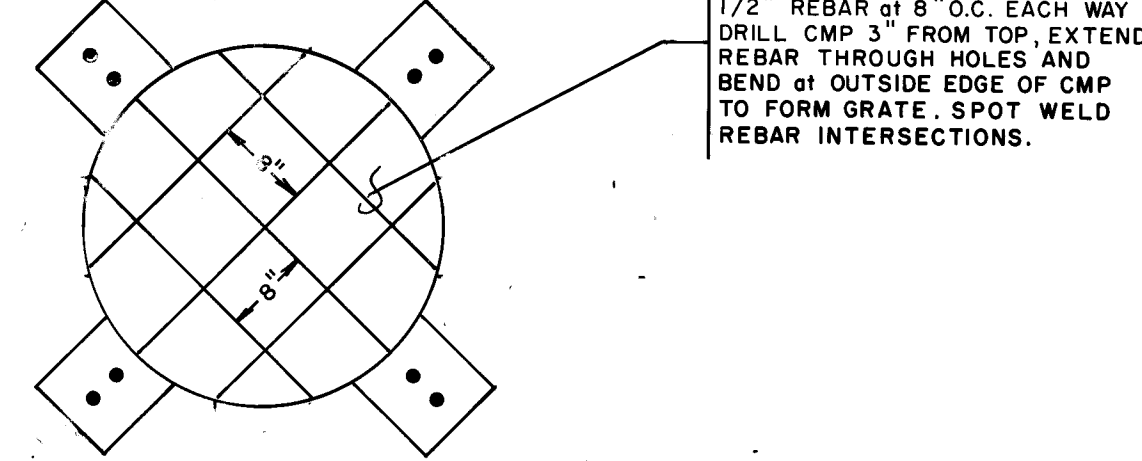


PLAN

STAND PIPE
BOLTING DETAIL
NO SCALE

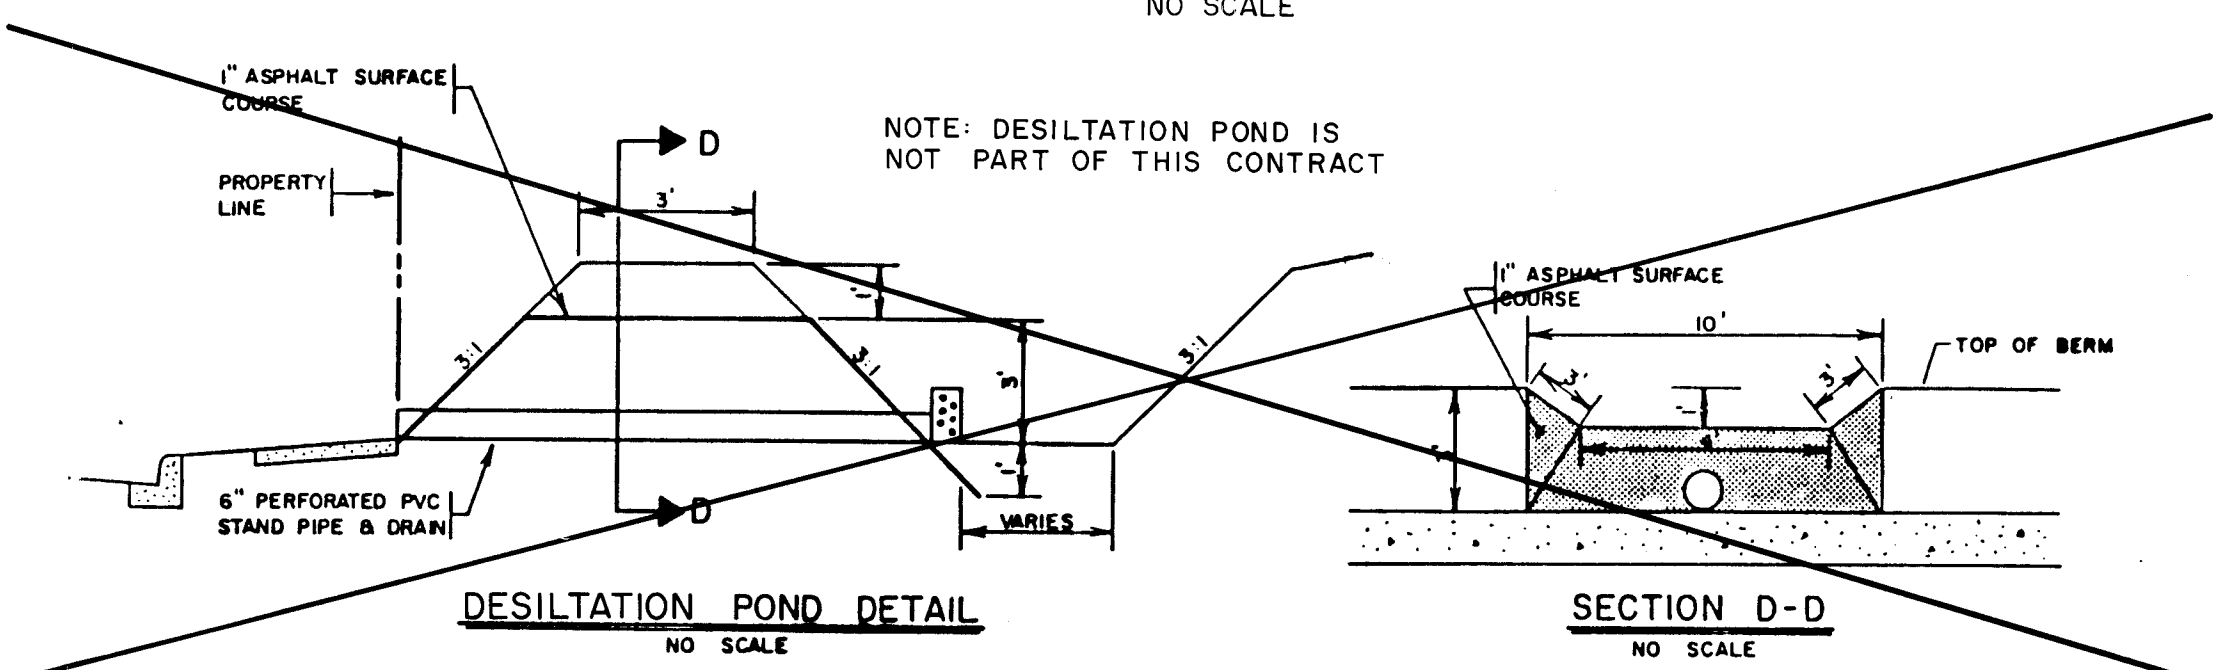

DESILTATION POND DETAIL
NO SCALE

SECTION D-D
NO SCALE

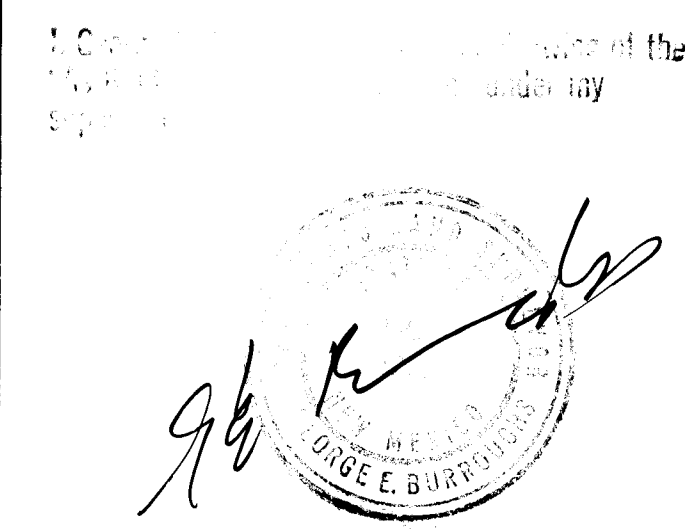

- LEGEND
- SUBGRADE (95% COMPACTION)
 - CONCRETE
 - REBAR

26 3575 190

CITY OF ALBUQUERQUE INFRASTRUCTURE IMPROVEMENTS MARKET CENTER WEST					
TITLE: STORM SEWER DETAILS					
APPROVALS	ENGINEER	DATE	APPROVALS	ENGINEER	DATE
City Engineer	Roger A. Berra	4/11/89	Liquid Waste	N/A	
A.C.E. - Design	"	"	Traffic	Roger A. Berra	4/11/89
A.C.E. - Hydrology	"	"	Water	N/A	
			N.M. Utilities	Mike	4-28-89
DRAWING NO.	3575	MAP NO.	C-13	SHEET	OF 11 17


* FUNCTION CHART

CON- DUCTOR	BASE COLOR	TRACER	(RING 1) FUNCTION	FIELD CONNECTION	(RING 2) FUNCTION	FIELD CONNECTION
1.	BLACK	--	SPARE	----	----	----
2.	WHITE	--	SPARE	----	----	----
3.	RED	--	01 RED	----	05 RED	----
4.	GREEN	--	01 GREEN	1 LT GREEN ARROW	05 GREEN	----
5.	ORANGE	--	01 YELLOW	3 LT GREEN ARROW	05 YELLOW	----
6.	BLUE	--	01 WALK	3 LT YELLOW ARROW	----	----
7.	WHITE	BLACK	01 DONT WALK	----	----	----
8.	RED	BLACK	02 RED	4, 5, M5	06 RED	1, 2, M2
9.	GREEN	BLACK	02 GREEN	4, 5, M5	06 GREEN	1, 2, M2
10.	ORANGE	BLACK	02 YELLOW	4, 5, M5	06 YELLOW	1, 2, M2
11.	BLUE	BLACK	02 WALK	P3, P6	06 WALK	P2, P9
12.	BLACK	WHITE	02 DONT WALK	P3, P6	06 DONT WALK	P2, P9
13.	RED	WHITE	03 RED	----	07 RED	----
14.	GREEN	WHITE	03 GREEN	----	07 GREEN	----
15.	BLUE	WHITE	03 YELLOW	----	07 YELLOW	----
16.	BLACK	RED	04 RED	----	08 RED	3, M3
17.	WHITE	RED	04 GREEN	----	08 GREEN	3, M3
18.	ORANGE	RED	04 YELLOW	----	08 YELLOW	3, M3
19.	RED	RED	04 WALK	----	08 WALK	P2, P3, P6, P9
20.	BLUE	GREEN	04 DONT WALK	----	08 DONT WALK	P2, P3, P6, P9
21.	ORANGE	GREEN	SPARE	----	----	----


1.	BLACK	--	02 PPB	PPB P3, P6
2.	WHITE	--	COMMON	PPB P1 THRU P9
3.	RED	--	04 PPB	----
4.	GREEN	--	06 PPB	PPB P2, P9
5.	ORANGE	--	08 PPB	PPB P2, P3, P6, P9

SIGNALS	ARM LENGTH	POLE TYPE	FOUNDATION TYPE	OVERHEAD SIGNAL (MASTARM)	POST MOUNT SIGNAL	PEDESTRIAN HEAD AND PUSH BUTTONS
I	---	I	STD. POST-I	---	5	---
M2	25'	II-B	MASTARM-II	3	3	2 at 90°
M3	25'	II-B	MASTARM-II	3	5	2 at 90°
4	---	I	STD. POST-I	---	3	---
M5	25'	II-B	MASTARM-II	3	3	---
P6	---	I	STD. POST-I	---	---	2 at 90°
7	---	I	STD. POST-I	---	3	---
M8	20'	II-B	MASTARM-II	3	3	---
P9	---	I	STD. POST-I	---	---	2 at 90°

* NOT PART OF THIS PROJECT

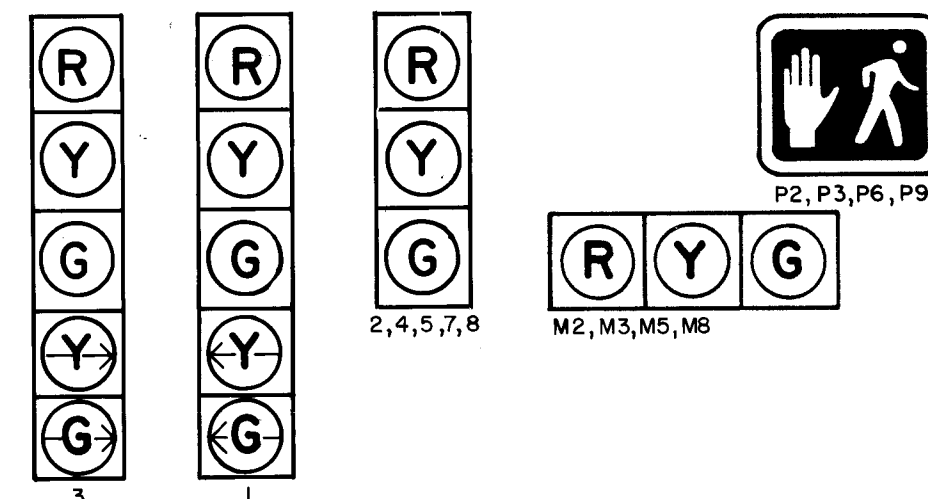

* SIGNAL HEADS

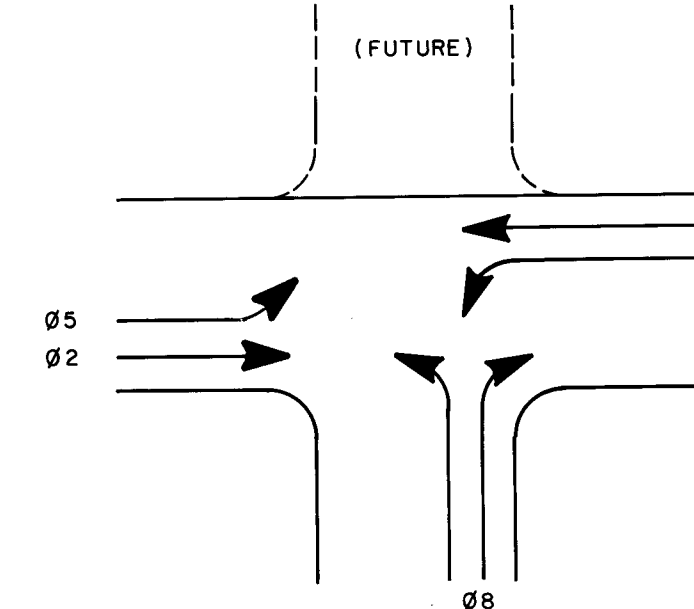

* PHASING DIAGRAM

GENERAL NOTES:

- ALL CONDUIT TO BE PVC, HEAVY-DUTY, SCHEDULE 40.
- ALL CONDUIT CONNECTIONS TO BE MADE OF THE SOLVENT WELD TYPE ACCORDING TO THE RECOMMENDATIONS OF THE PVC CONDUIT MANUFACTURER.
- ALL CONDUIT TO BE RUN IN STRAIGHT-LINE FASHION FROM TERMINAL TO TERMINAL AS MUCH AS POSSIBLE. SOME MAY HAVE TO FOLLOW CURVATURE TO STAY WITHIN RIGHT-OF-WAY.
- ALL CONDUIT RUNS TO BE CLEARLY LABELED AT END POINTS INSIDE PULL BOXES, MANHOLES, SIGNAL FOUNDATIONS, ETC. LABEL BOTH ENDS OF SAME CONDUIT RUN AS "AA", "BB", "CC", ETC.
- LOOP DETECTOR WIRING NEEDS TO BE 14 STRANDED WIRE WITH SLIDING SLEEVE.
- USE 1-INCH GALVANIZED STEEL RISER FOR UTILITY POWER POLE WHICH PROVIDES ELECTRICAL SERVICE TO SIGNALS. TERMINATE IN STANDARD SIZE PULL BOX AT BASE OF POLE WITH UNDER-GROUND CONDUIT.
- CONTRACTOR SHALL PROVIDE 2-INCH CONDUIT FOR ELECTRICAL SERVICE FROM SERVICE POLE TO PHM POWER SOURCE.
- CONTRACTOR TO CONTACT PUBLIC SERVICE COMPANY OF NEW MEXICO TO VERIFY SERVICE POLE CONNECTION.
- THE CONTRACTOR WILL FURNISH AND INSTALL THE SIGNAL CONTROLLER/CABINET. SIGNAL CONTROLLER/CABINET SIZE AND TYPE TO BE DETERMINED BY CURRENT/FUTURE PHASING REQUIREMENTS AS DETERMINED BY THE CITY OF ALBUQUERQUE TRANSPORTATION DEPARTMENT. ACCEPTABLE CONTROLLERS ARE ECONOLITE ASC 8000, EAGLE EXAC 300, MULTISONICS 820. CONTROLLERS NEED TO INCLUDE NEMA PLUS CONFLICT MONITOR, LOAD SWITCHES, RELAYS AND AMPLIFIERS.
- ADJUST SIGNAL POLE FOUNDATIONS SO AS TO PERMIT GOOD VISIBILITY OF SIGNAL INDICATIONS. CHECK FOR CONFLICT WITH STREET LIGHT POLES, STORE SIGNS, TREE BRANCHES, ETC.
- MOUNT ALL CONTROLLERS SO DOORS FACE AWAY FROM TRAFFIC.
- ALL SPLICES FOR TRAFFIC SIGNAL MULTI-CONDUCTOR CABLE SHALL BE MADE ABOVE GROUND (IN CABINET OR STANDARD BASE). NO SPLICING OF MCC WILL BE PERMITTED IN PULL BOXES.
- CONTRACTOR SHALL FURNISH AND INSTALL ALL CONDUCTOR WIRE FOR TRAFFIC SIGNALS, SUCH THAT SIGNALIZATION IS COMPLETE AND OPERATIONAL. ALL WIRING WILL BE INCIDENTAL TO THE CONTRACT AND APPROVED BY THE ENGINEER.
- ALL WIRE ON THIS PROJECT TO BE COPPER.

KEYED NOTES

- CONTROLLER FOUNDATION, TYPE I C.O.A. 2527
- MASTARM FOUNDATION, TYPE II C.O.A. DWG. 2526
- PEDESTAL FOUNDATION, C.O.A. DWG. 2525
- TRAFFIC SIGNAL MANHOLE, C.O.A. DWG. 2524
- PULL BOX, LARGE 17" X 30" C.O.A. 2521
- 3" CONDUIT PVC
- 2" CONDUIT PVC
- PULL BOX, SMALL 13" X 24" C.O.A. 2521
- PULL BOX DETECTOR C.O.A. DWG. 2522
- SERVICE POLE

1	2	3	4	5	6	7	8	9	10	11	12
26	35	75	12	9	0						

LEGEND

- PULL BOX TO BE INSTALLED
- PEDESTAL FOUNDATION TYPE I
- MASTARM FOUNDATION TYPE II
- CONTROLLER FOUNDATION TYPE I
- SERVICE PEDESTAL TO BE INSTALLED (METERING)
- TRAFFIC SIGNAL MANHOLE

CITY OF ALBUQUERQUE
INFRASTRUCTURE IMPROVEMENTS
MARKET CENTER WEST

TITLE: EAGLE RANCH ROAD SIGNALIZATION

APPROVALS	ENGINEER	DATE	APPROVALS	ENGINEER	DATE
City Engineer	Ronald Shuman	4/1/89	Liquid Waste	N/A	
A.C.E.-Design	"	"	Traffic	Ronald Shuman	4/6/89
A.C.E.-Hydrology	"	"	Water	N/A	
			N.M. Utilities	4/2/89	

DRAWING NO.	3575	MAP NO.	C-13	SHEET	12	OF	17
-------------	------	---------	------	-------	----	----	----


NOTE: BID ALTERNATE 'B' - ABOVE
GROUND SIGNAL INSTALLATION -
NOT PART OF THIS PROJECT

* FUNCTION CHART						
CON- DUCTOR	BASE COLOR	TRACER	(RING 1) FUNCTION	FIELD CONNECTION	(RING 2) FUNCTION	FIELD CONNECTION
1.	BLACK	--	SPARE	----	----	----
2.	WHITE	--	SPARE	----	----	----
3.	RED	--	01 RED	----	05 RED	----
4.	GREEN	--	01 GREEN	1 LT GREEN ARROW	05 GREEN	----
5.	ORANGE	--	01 YELLOW	3 LT GREEN ARROW	05 YELLOW	----
6.	BLUE	--	01 WALK	3 LT YELLOW ARROW	----	----
7.	WHITE	BLACK	01 DONT WALK	----	----	----
8.	RED	BLACK	02 RED	4, 5, M5	06 RED	1, 2, M2
9.	GREEN	BLACK	02 GREEN	4, 5, M5	06 GREEN	1, 2, M2
10.	ORANGE	BLACK	02 YELLOW	4, 5, M5	06 YELLOW	1, 2, M2
11.	BLUE	BLACK	02 WALK	P3, P6	06 WALK	P2, P9
12.	BLACK	WHITE	02 DONT WALK	P3, P6	06 DONT WALK	P2, P9
13.	RED	WHITE	03 RED	----	07 RED	----
14.	GREEN	WHITE	03 GREEN	----	07 GREEN	----
15.	BLUE	WHITE	03 YELLOW	----	07 YELLOW	----
16.	BLACK	RED	04 RED	----	08 RED	3, M3
17.	WHITE	RED	04 GREEN	----	08 GREEN	3, M3
18.	ORANGE	RED	04 YELLOW	----	08 YELLOW	3, M3
19.	RED	RED	04 WALK	----	08 WALK	P2, P3, P6, P9
20.	BLUE	GREEN	04 DONT WALK	----	08 DONT WALK	P2, P3, P6, P9
21.	ORANGE	GREEN	SPARE	----	----	----


1.	BLACK	--	02 PPB	PPB P3, P6
2.	WHITE	--	COMMON	PPB P1 THRU P9
3.	RED	--	04 PPB	----
4.	GREEN	--	06 PPB	PPB P2, P9
5.	ORANGE	--	08 PPB	PPB P2, P3, P6, P9

SIGNALS	ARM LENGTH	POLE TYPE	FOUNDATION TYPE	OVERHEAD SIGNAL (MASTARM)	POST MOUNT SIGNAL	PEDESTRIAN HEAD AND PUSH BUTTONS
I	---	I	STD. POST-I	---	5	---
M2	25'	II-B	MASTARM-II	3	3	2 at 90°
M3	25'	II-B	MASTARM-II	3	5	2 at 90°
4	---	I	STD. POST-I	---	3	---
M5	25'	II-B	MASTARM-II	3	3	---
P6	---	I	STD. POST-I	---	---	2 at 90°
7	---	I	STD. POST-I	---	3	---
M8	20'	II-B	MASTARM-II	3	3	---
P9	---	I	STD. POST-I	---	---	2 at 90°


* NOT PART OF THIS PROJECT

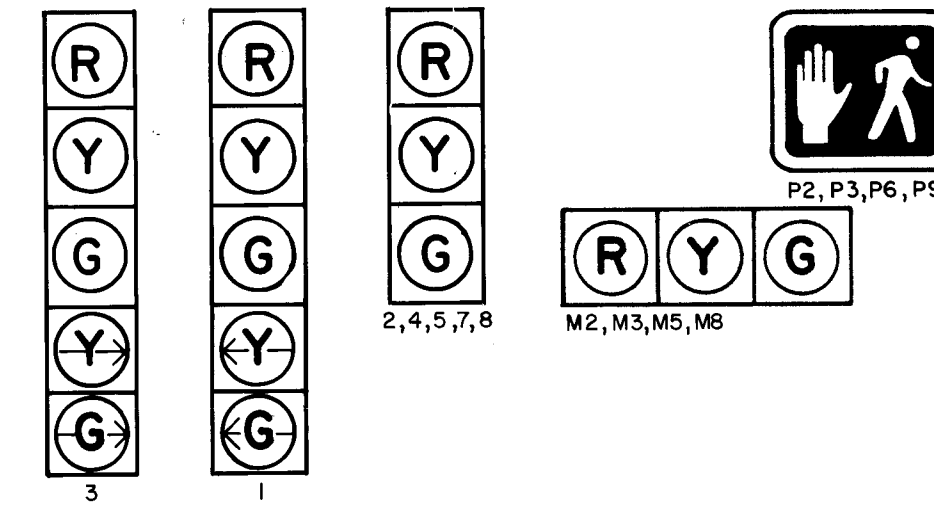

* SIGNAL HEADS

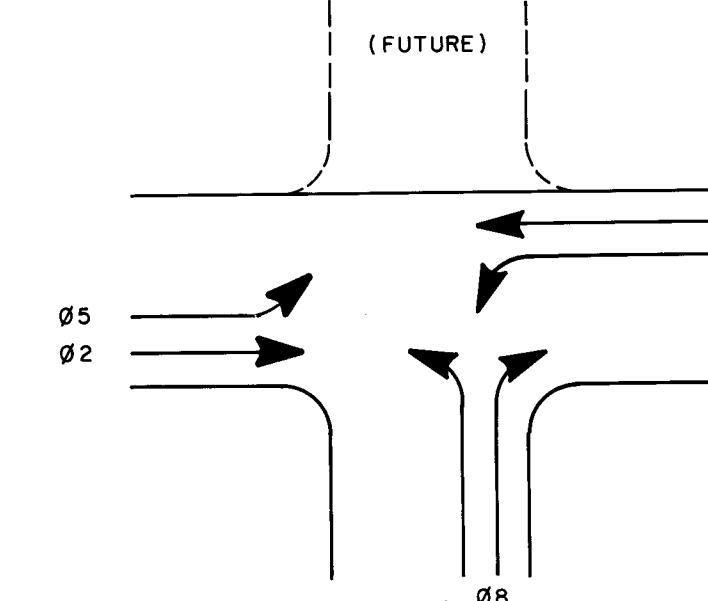

* PHASING DIAGRAM

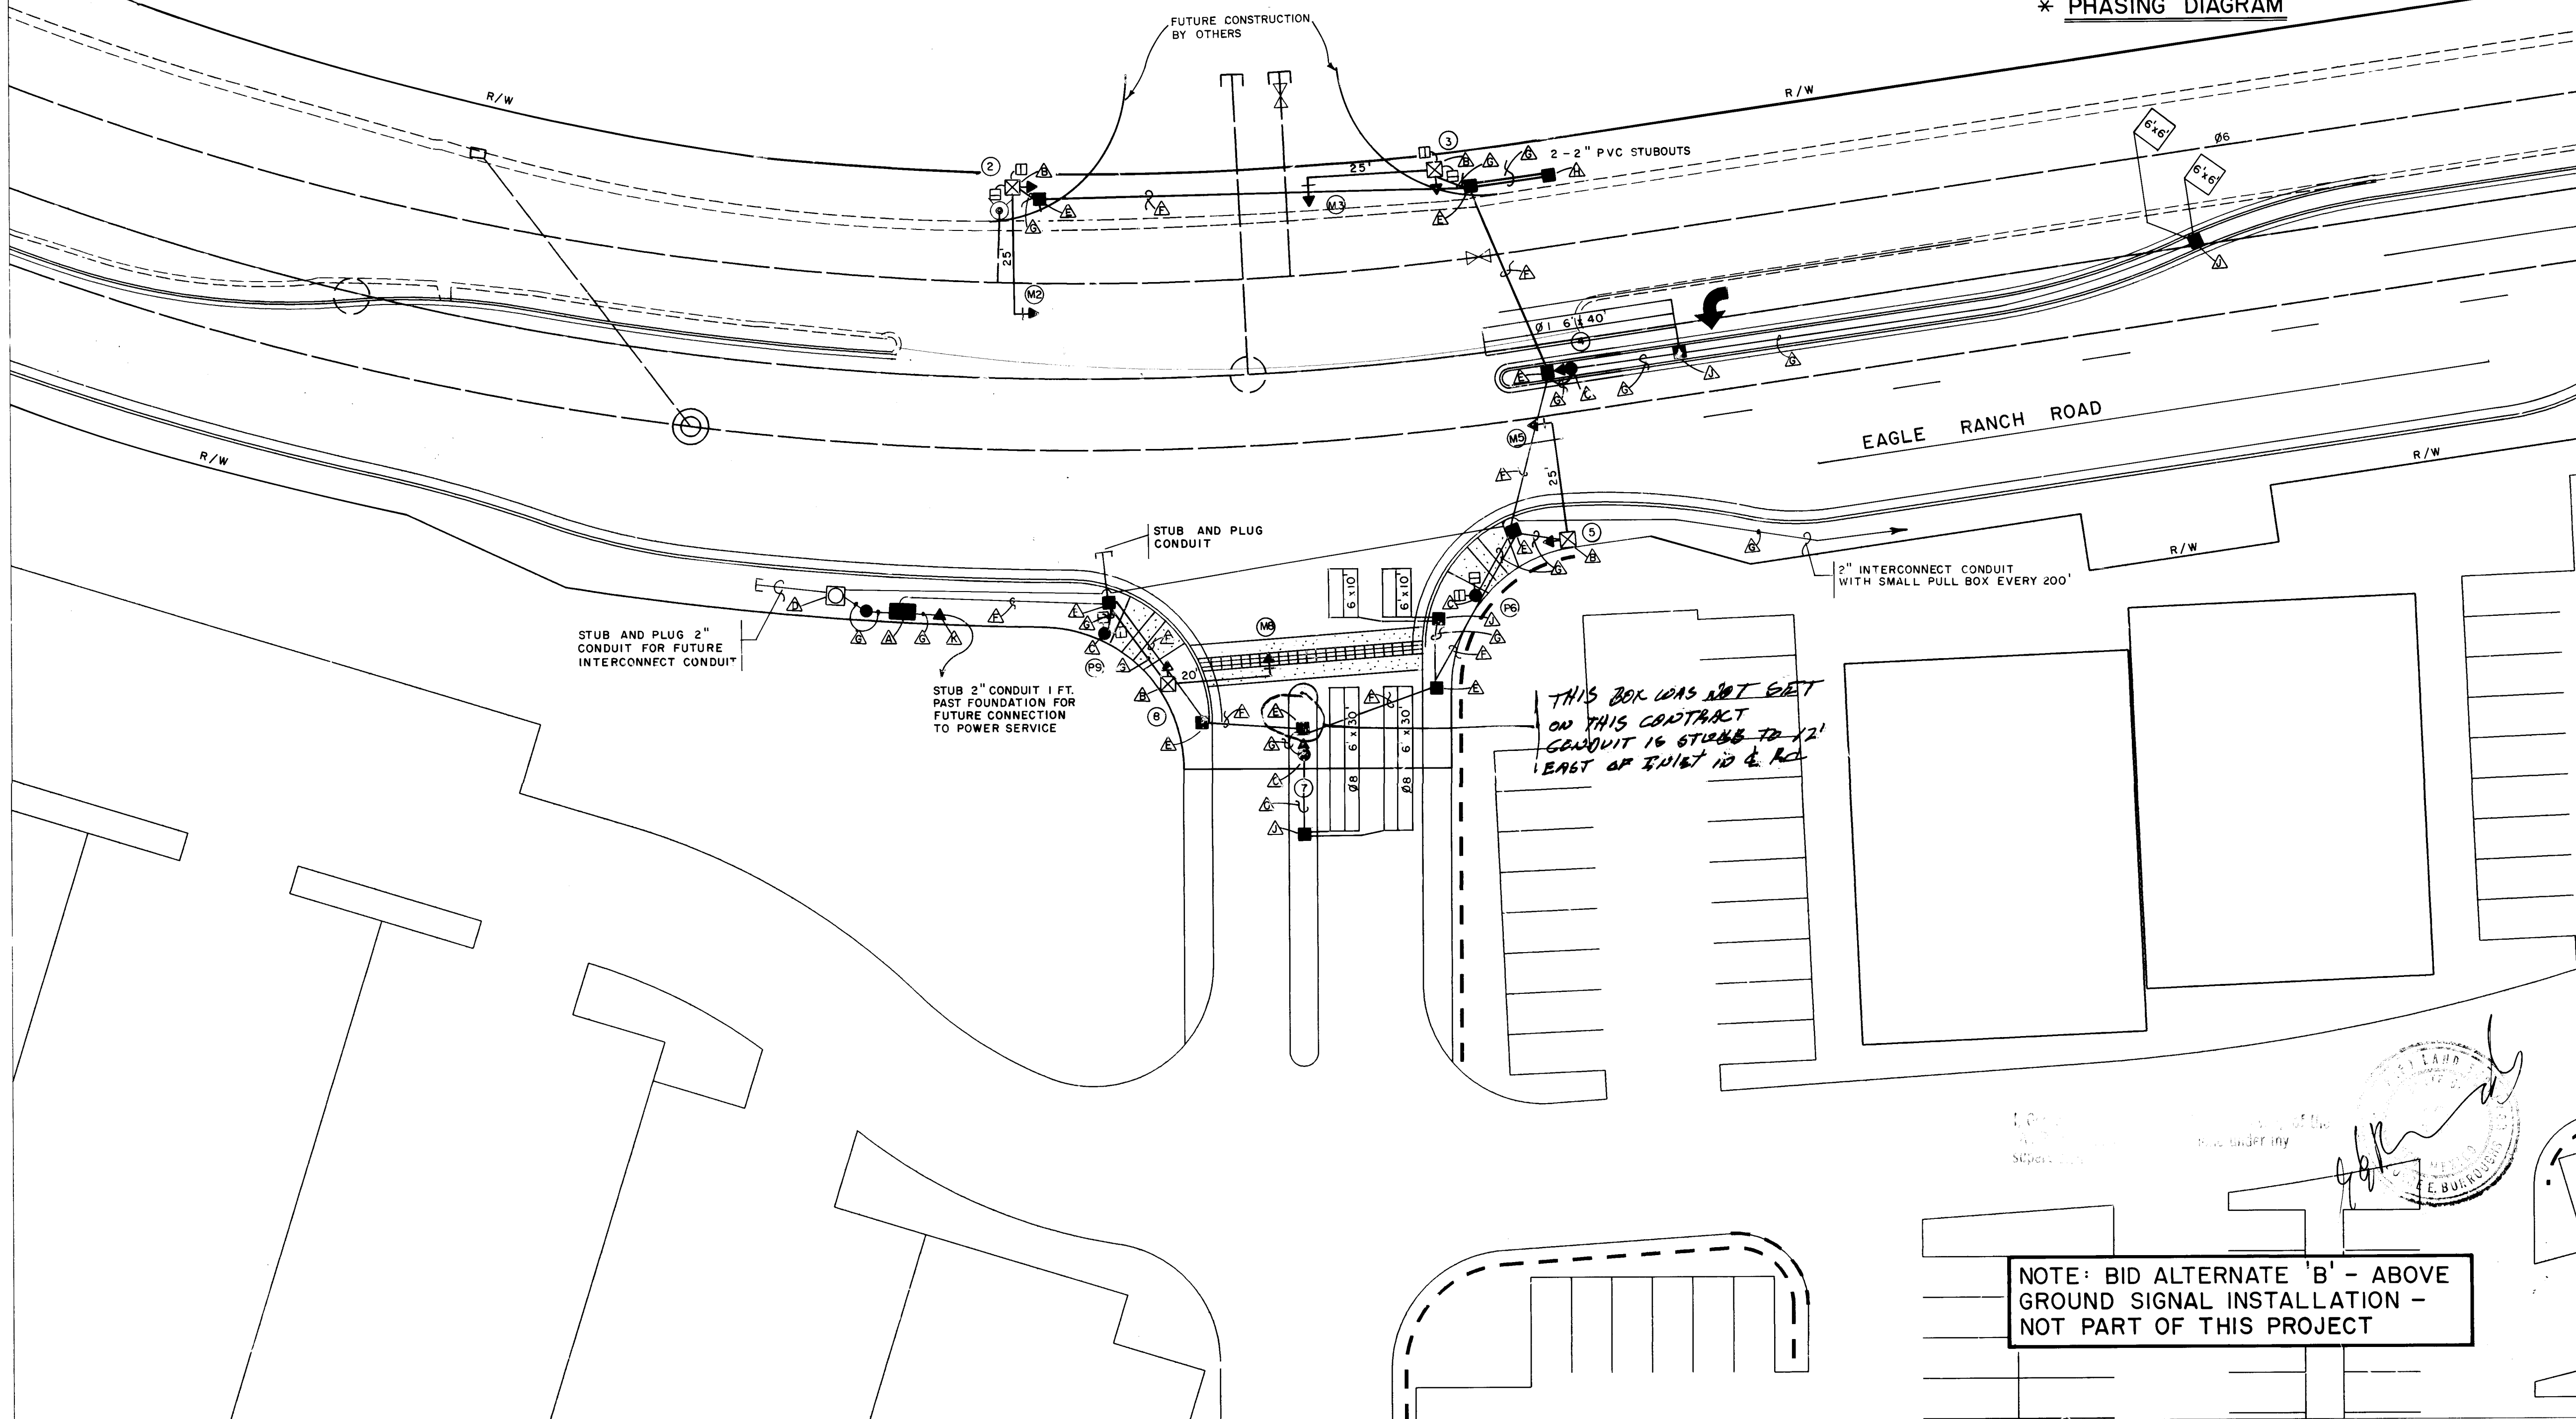

- GENERAL NOTES:
- ALL CONDUIT TO BE PVC, HEAVY-DUTY, SCHEDULE 40.
 - ALL CONDUIT CONNECTIONS TO BE MADE OF THE SOLVENT WELD TYPE ACCORDING TO THE RECOMMENDATIONS OF THE PVC CONDUIT MANUFACTURER.
 - ALL CONDUIT RUNS TO BE CLEARLY LABELED AT END POINTS INSIDE PULL BOXES, MANHOLES, SIGNAL FOUNDATIONS, ETC. LABEL BOTH ENDS OF SAME CONDUIT RUN AS "AA", "BB", "CC", ETC.
 - ALL CONDUIT RUNS TO BE CLEARLY LABELED AT END POINTS INSIDE PULL BOXES, MANHOLES, SIGNAL FOUNDATIONS, ETC. LABEL BOTH ENDS OF SAME CONDUIT RUN AS "AA", "BB", "CC", ETC.
 - LOOP DETECTOR WIRING NEEDS TO BE 14 STRANDED WIRE WITH SLIDING SLEEVE.
 - USE 1-INCH GALVANIZED STEEL RISER FOR UTILITY POWER POLE WHICH PROVIDES ELECTRICAL SERVICE TO SIGNALS. TERMINATE IN STANDARD SIZE PULL BOX AT BASE OF POLE WITH UNDER-GROUND CONDUIT.
 - CONTRACTOR SHALL PROVIDE 2-INCH CONDUIT FOR ELECTRICAL SERVICE FROM SERVICE POLE TO PNM POWER SOURCE.
 - CONTRACTOR TO CONTACT PUBLIC SERVICE COMPANY OF NEW MEXICO TO VERIFY SERVICE POLE CONNECTION.
 - THE CONTRACTOR WILL FURNISH AND INSTALL THE SIGNAL CONTROLLER/CABINET. SIGNAL CONTROLLER/CABINET SIZE AND TYPE TO BE DETERMINED BY CURRENT/FUTURE PHASING REQUIREMENTS AS DETERMINED BY THE CITY OF ALBUQUERQUE TRANSPORTATION DEPARTMENT. ACCEPTABLE CONTROLLERS ARE ECONOLITE ASC 8000, EAGLE EXAC 300, MULTISONICS 820. CONTROLLERS NEED TO INCLUDE NEMA PLUS CONFLICT MONITOR, LOAD SWITCHES, RELAYS AND AMPLIFIERS.
 - ADJUST SIGNAL POLE FOUNDATIONS SO AS TO PERMIT GOOD VISIBILITY OF SIGNAL INDICATIONS. CHECK FOR CONFLICT WITH STREET LIGHT POLES, STORE SIGNS, TREE BRANCHES, ETC.
 - MOUNT ALL CONTROLLERS SO DOORS FACE AWAY FROM TRAFFIC.
 - ALL SPLICES FOR TRAFFIC SIGNAL MULTI-CONDUCTOR CABLE SHALL BE MADE ABOVE GROUND (IN CABINET OR STANDARD BASE). NO SPLICING OF MCC WILL BE PERMITTED IN PULL BOXES.
 - CONTRACTOR SHALL FURNISH AND INSTALL ALL CONDUCTOR WIRE FOR TRAFFIC SIGNALS, SUCH THAT SIGNALIZATION IS COMPLETE AND OPERATIONAL. ALL WIRING WILL BE INCIDENTAL TO THE CONTRACT AND APPROVED BY THE ENGINEER.
 - ALL WIRE ON THIS PROJECT TO BE COPPER.

- KEYED NOTES
- CONTROLLER FOUNDATION, TYPE I C.O.A. 2527
 - MASTARM FOUNDATION, TYPE II C.O.A. DWG. 2526
 - PEDESTAL FOUNDATION, C.O.A. DWG. 2525
 - TRAFFIC SIGNAL MANHOLE, C.O.A. DWG. 2524
 - PULL BOX, LARGE 17" X 30" C.O.A. 2521
 - 3" CONDUIT PVC
 - 2" CONDUIT PVC
 - PULL BOX, SMALL 13" X 24" C.O.A. 2521
 - PULL BOX DETECTOR C.O.A. DWG. 2522
 - SERVICE POLE
- LEGEND
- PULL BOX TO BE INSTALLED
 - PEDESTAL FOUNDATION TYPE I
 - MASTARM FOUNDATION TYPE II
 - CONTROLLER FOUNDATION TYPE I
 - SERVICE PEDESTAL TO BE INSTALLED (METERING)
 - TRAFFIC SIGNAL MANHOLE



CITY OF ALBUQUERQUE
INFRASTRUCTURE IMPROVEMENTS
MARKET CENTER WEST

TITLE: **EAGLE RANCH ROAD SIGNALIZATION**

APPROVALS	ENGINEER	DATE	APPROVALS	ENGINEER	DATE
City Engineer	Ronald Shuman	4/1/89	Liquid Waste	N/A	
A.C.E.-Design	"	"	Traffic	Ronald Shuman	4/6/89
A.C.E.-Hydrology	"	"	Water	N/A	
			N.M. Utilities	4/2/89	

DRAWING NO. **3575** MAP NO. **C-13** SHEET **12** OF **17**

NOTE: BID ALTERNATE 'B' - ABOVE GROUND SIGNAL INSTALLATION - NOT PART OF THIS PROJECT

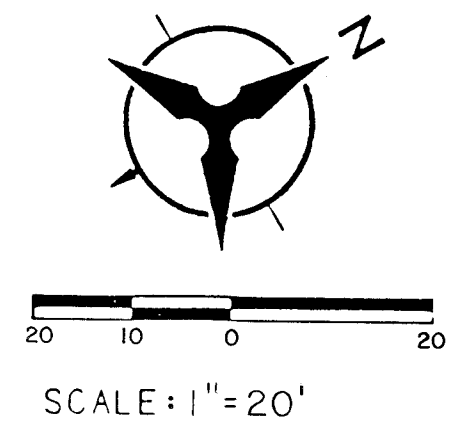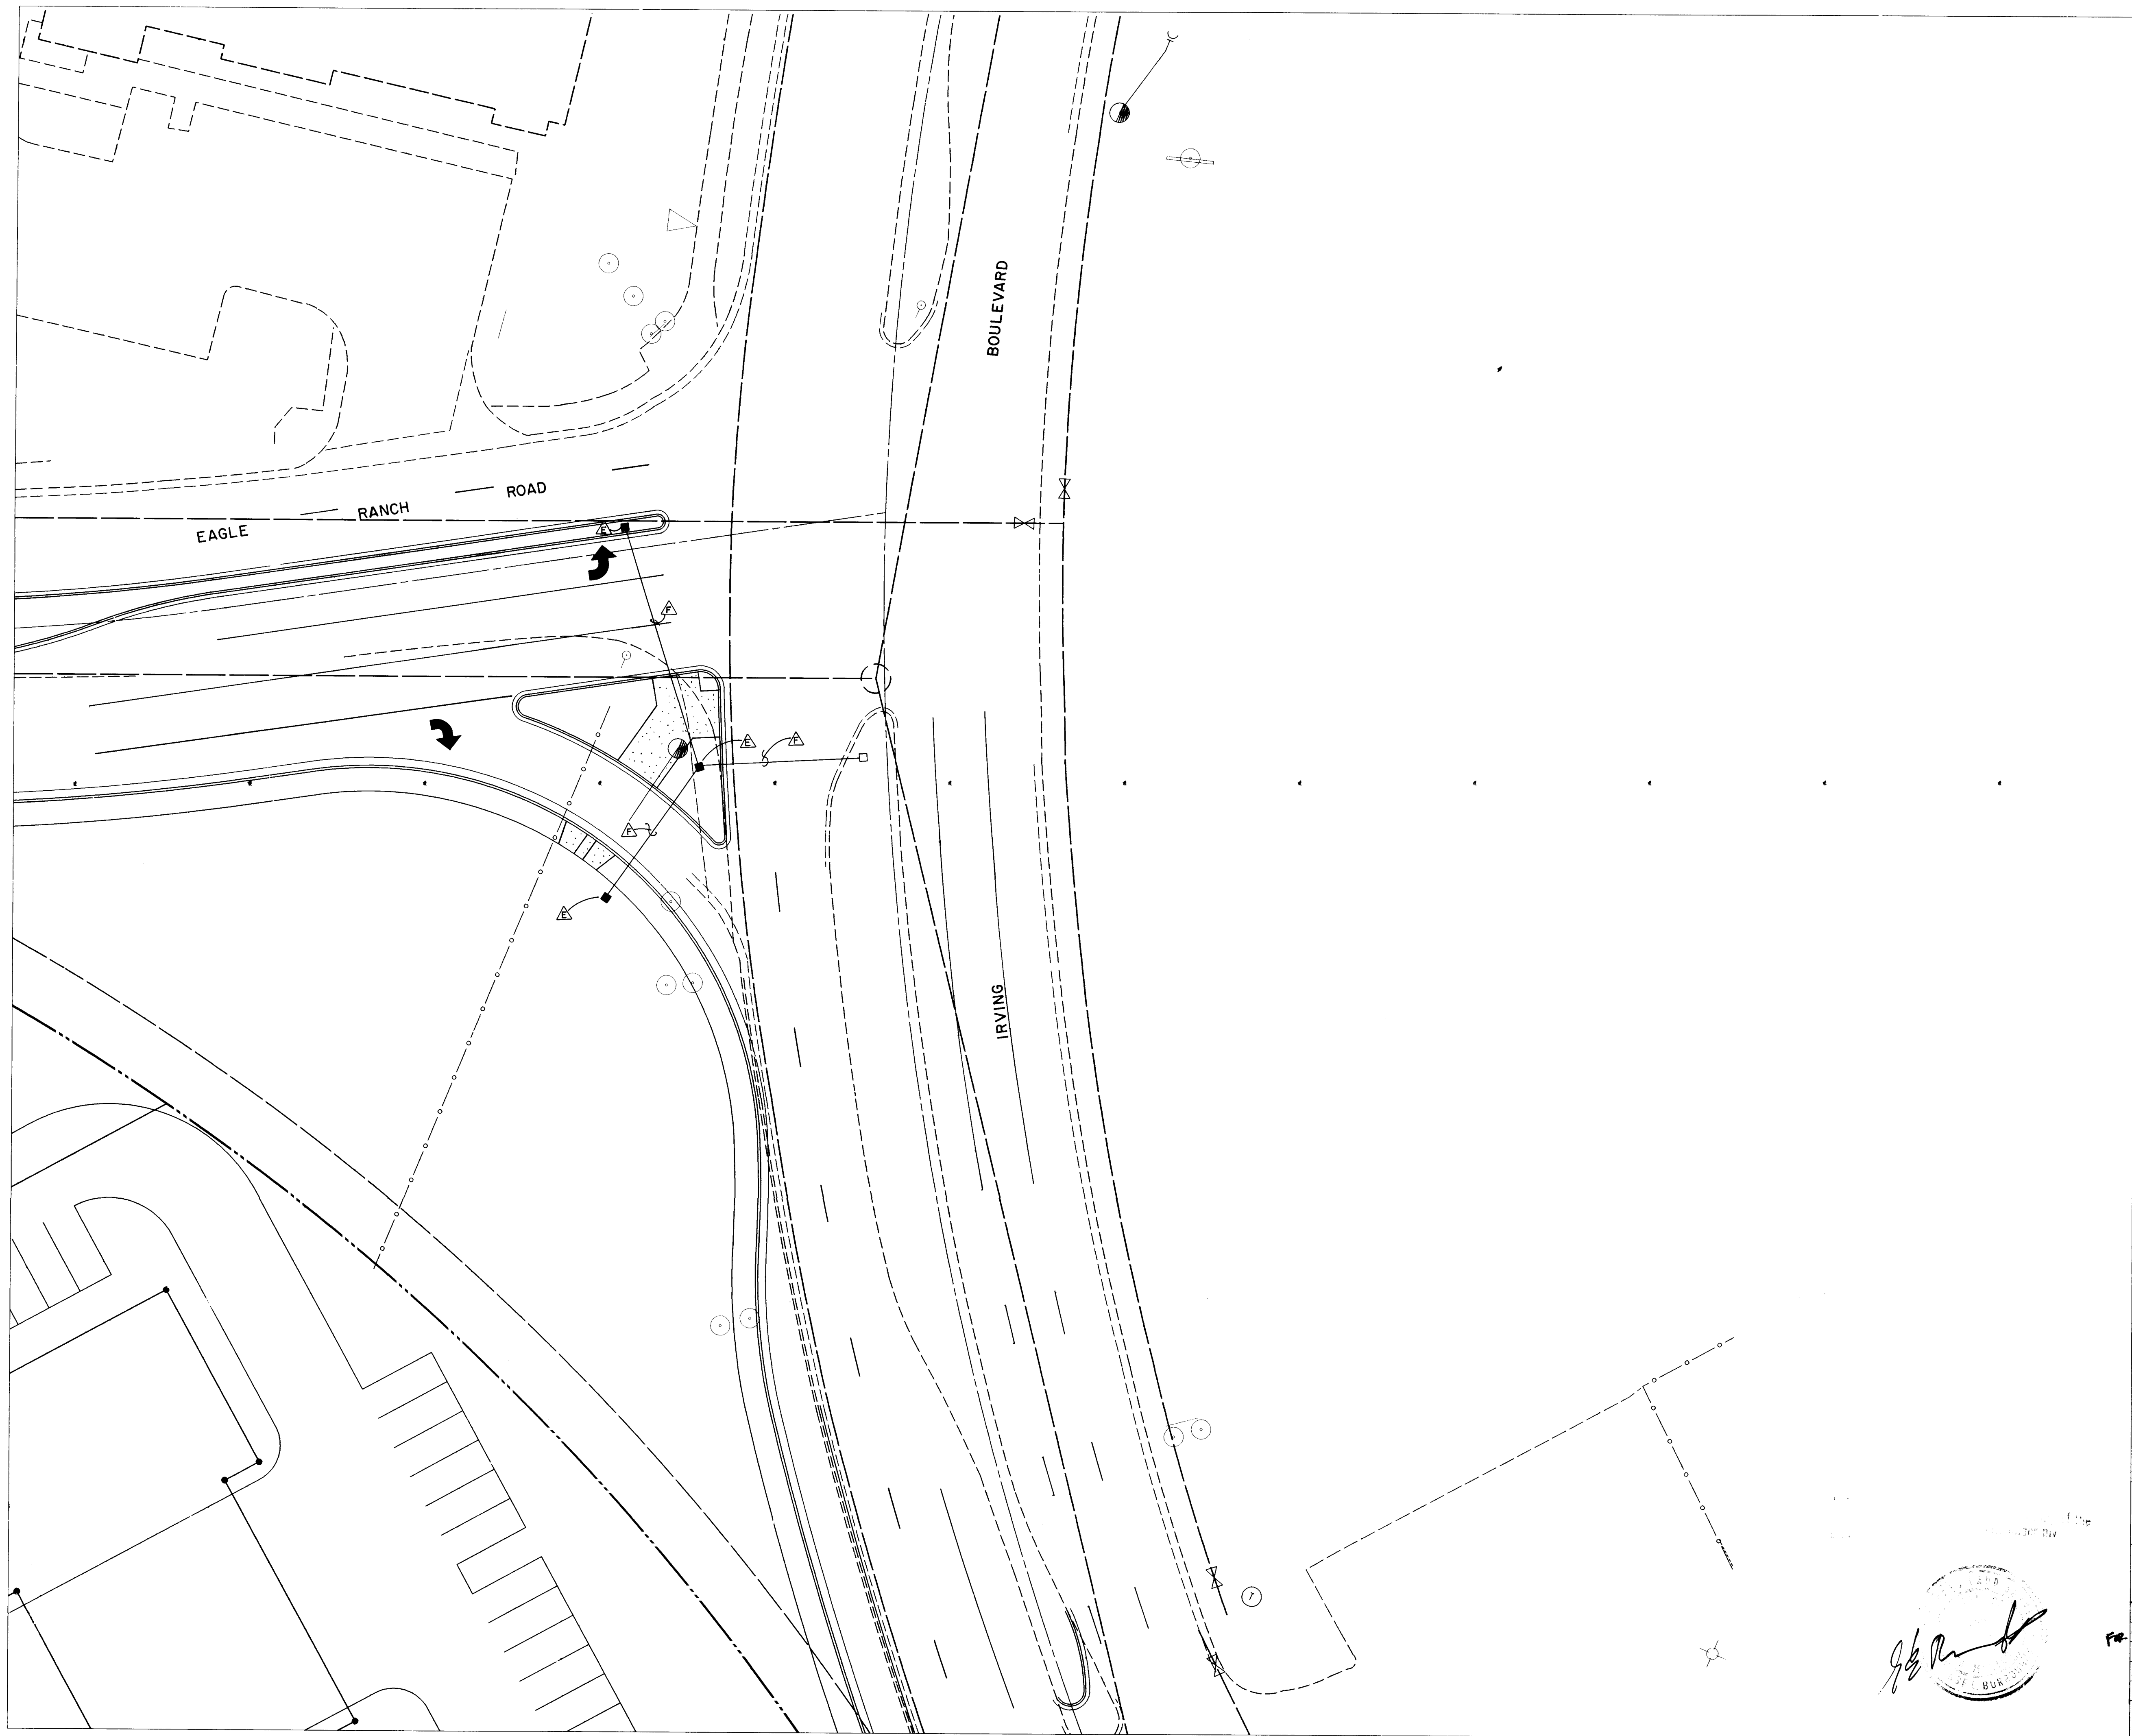

- GENERAL NOTES:
1. ALL CONDUIT TO BE PVC, HEAVY-DUTY, SCHEDULE 40.
 2. ALL CONDUIT CONNECTIONS TO BE MADE OF THE SOLVENT WELD TYPE ACCORDING TO THE RECOMMENDATIONS OF THE PVC CONDUIT MANUFACTURER.
 3. ALL CONDUIT TO BE RUN IN STRAIGHT-LINE FASHION FROM TERMINAL TO TERMINAL AS MUCH AS POSSIBLE. SOME MAY HAVE TO FOLLOW CURVATURE TO STAY WITHIN RIGHT-OF-WAY.
 4. ALL CONDUIT RUNS TO BE CLEARLY LABELED AT END POINTS INSIDE PULL BOXES, MANHOLES, SIGNAL FOUNDATIONS, ETC. LABEL BOTH ENDS OF SAME CONDUIT RUN AS "AA", "BB", "CC", ETC.
 5. USE 1-INCH GALVANIZED STEEL RISER FOR UTILITY POWER POLE WHICH PROVIDES ELECTRICAL SERVICE TO SIGNALS. TERMINATE IN STANDARD SIZE PULL BOX AT BASE OF POLE WITH UNDERGROUND CONDUIT.
 6. PROVIDE 2-INCH CONDUIT FOR ELECTRICAL SERVICE FROM PULL BOX AT BASE OF POWER POLE TO LARGE PULL BOX ON CLOSEST CORNER.
 7. ADJUST SIGNAL POLE FOUNDATIONS SO AS TO PERMIT GOOD VISIBILITY OF SIGNAL INDICATIONS. CHECK FOR CONFLICT WITH STREET LIGHT POLES, STORE SIGNS, TREE BRANCHES, ETC.
 8. ABOVE GROUND TRAFFIC SIGNAL EQUIPMENT FOR THIS INTERSECTION NOT PART OF THIS CONTRACT, SHALL BE FURNISHED AND INSTALLED BY THE CITY OF ALBUQUERQUE WHEN NEEDS WARRANT.
 9. 2" INTERCONNECT CONDUIT WITH PULL BOX EVERY 200' SHALL BE INSTALLED ALONG THE WEST SIDE OF COORS BLVD., AND THE SOUTH SIDE OF IRVING BLVD. SEE SHEET 4 OF 20.

KEYED NOTES

- △ CONTROLLER FOUNDATION, TYPE I C.O.A. 2527
- △ MASTARM FOUNDATION, TYPE II C.O.A. DWG. 2526
- △ PEDESTAL FOUNDATION, C.O.A. DWG. 2523
- △ TRAFFIC SIGNAL MANHOLE, C.O.A. DWG. 2524
- △ PULL BOX, LARGE 17" x 30" C.O.A. 2521
- △ 3" CONDUIT PVC
- △ 2" CONDUIT PVC
- △ PULL BOX, SMALL 13" x 24" C.O.A. 2521
- △ PULL BOX DETECTOR C.O.A. DWG. 2522
- △ SERVICE POLE


26 35751390

LEGEND

- PULL BOX TO BE INSTALLED
- PEDESTAL FOUNDATION TYPE I
- ☒ MASTARM FOUNDATION TYPE II
- CONTROLLER FOUNDATION TYPE I
- ▲ SERVICE PEDESTAL TO BE INSTALLED (METERING)
- EXISTING PULL BOX

ENGINEER'S SEAL			SURVEY INFORMATION			BENCH MARKS			AS BUILT INFORMATION		
			NO.	DATE	BY	FIELD NOTES	USC & GS BRASS TABLET "R. ALAMEDA A-3" NEW MEXICO	STATE PLANE COORDINATES (CENTRAL ZONE)	DATE	BY	AS BUILT INFORMATION
								X=377,094.67 Y=1,523,108.34			SWDANCE
								GROUND TO GRID FACTOR = 0.99967685			WALKER SURVEY
								A GC=00° 14' 13"			R. BACA 2/16/90
								ELEV=502705			MICRO-FILM INFORMATION

CITY OF ALBUQUERQUE INFRASTRUCTURE IMPROVEMENTS MARKET CENTER WEST						JOB NO. 88219.05
TITLE: EAGLE RANCH/IRVING SIGNALIZATION						
APPROVALS	ENGINEER	DATE	APPROVALS	ENGINEER	DATE	
City Engineer	R. BACA	4/11/89	Liquid Waste	N/A		
A.C.E. - Design		"	Traffic	R. BACA	4/11/89	
A.C.E. - Hydrology		"	Water	N/A		
			N.M. Utilities		4-7-89	
DRAWING NO.	3575	MAP NO.	C-13	SHEET	13 OF 17	

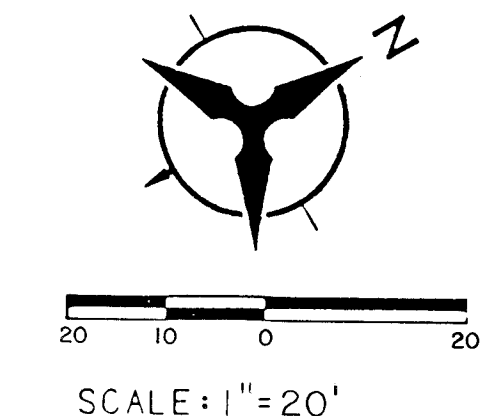

- ## KEYED NOTES

- | | |
|---|--|
|  | CONTROLLER FOUNDATION , TYPE I C.O.A 2527 |
|  | MASTARM FOUNDATION , TYPE II C.O.A DWG. 2526 |
|  | PEDESTAL FOUNDATION , C.O.A. DWG. 2525 |
|  | TRAFFIC SIGNAL MANHOLE , C.O.A. DWG. 2524 |
|  | PULL BOX , LARGE 17" x 30" C.O.A. 2521 |
|  | 3" CONDUIT PVC |
|  | 2" CONDUIT PVC |
|  | PULL BOX , SMALL 13" x 24" C.O.A. 2521 |
|  | PULL BOX DETECTOR C.O.A. DWG. 2522 |
|  | SERVICE POLE |

1	2	3	4	5	6	7	8	9	10	11	12
2	6		3	5	7	5	1	3	9	0	


LEGEND

- ☐ PULL BOX TO BE INSTALLED
- ☐ PEDESTAL FOUNDATION TYPE I
- ☒ MASTARM FOUNDATION TYPE II
- ☐ CONTROLLER FOUNDATION TYPE I
- ☐ SERVICE PEDESTAL TO BE INSTALLED (METERING)
- ☐ EXISTING PULL BOX

CITY OF ALBUQUERQUE
INFRASTRUCTURE IMPROVEMENTS
MARKET CENTER WEST

TITLE: EAGLE RANCH/IRVING SIGNALIZATION

APPROVALS		ENGINEER	DATE	APPROVALS		ENGINEER	DATE
City Engineer		<i>Rogers & Shown</i>	4/11/89	Liquid Waste		<i>N/A</i>	
A.C.E. - Design				Traffic		<i>Rogers & Shown</i>	4/11/89
A.C.E. - Hydrology		"	"	Water		<i>N/A</i>	
				N.M. Utilities		<i>N/A</i>	4-7-89
DRAWING NO.		3575	MAP NO.		C-13	SHEET 13 OF 17	

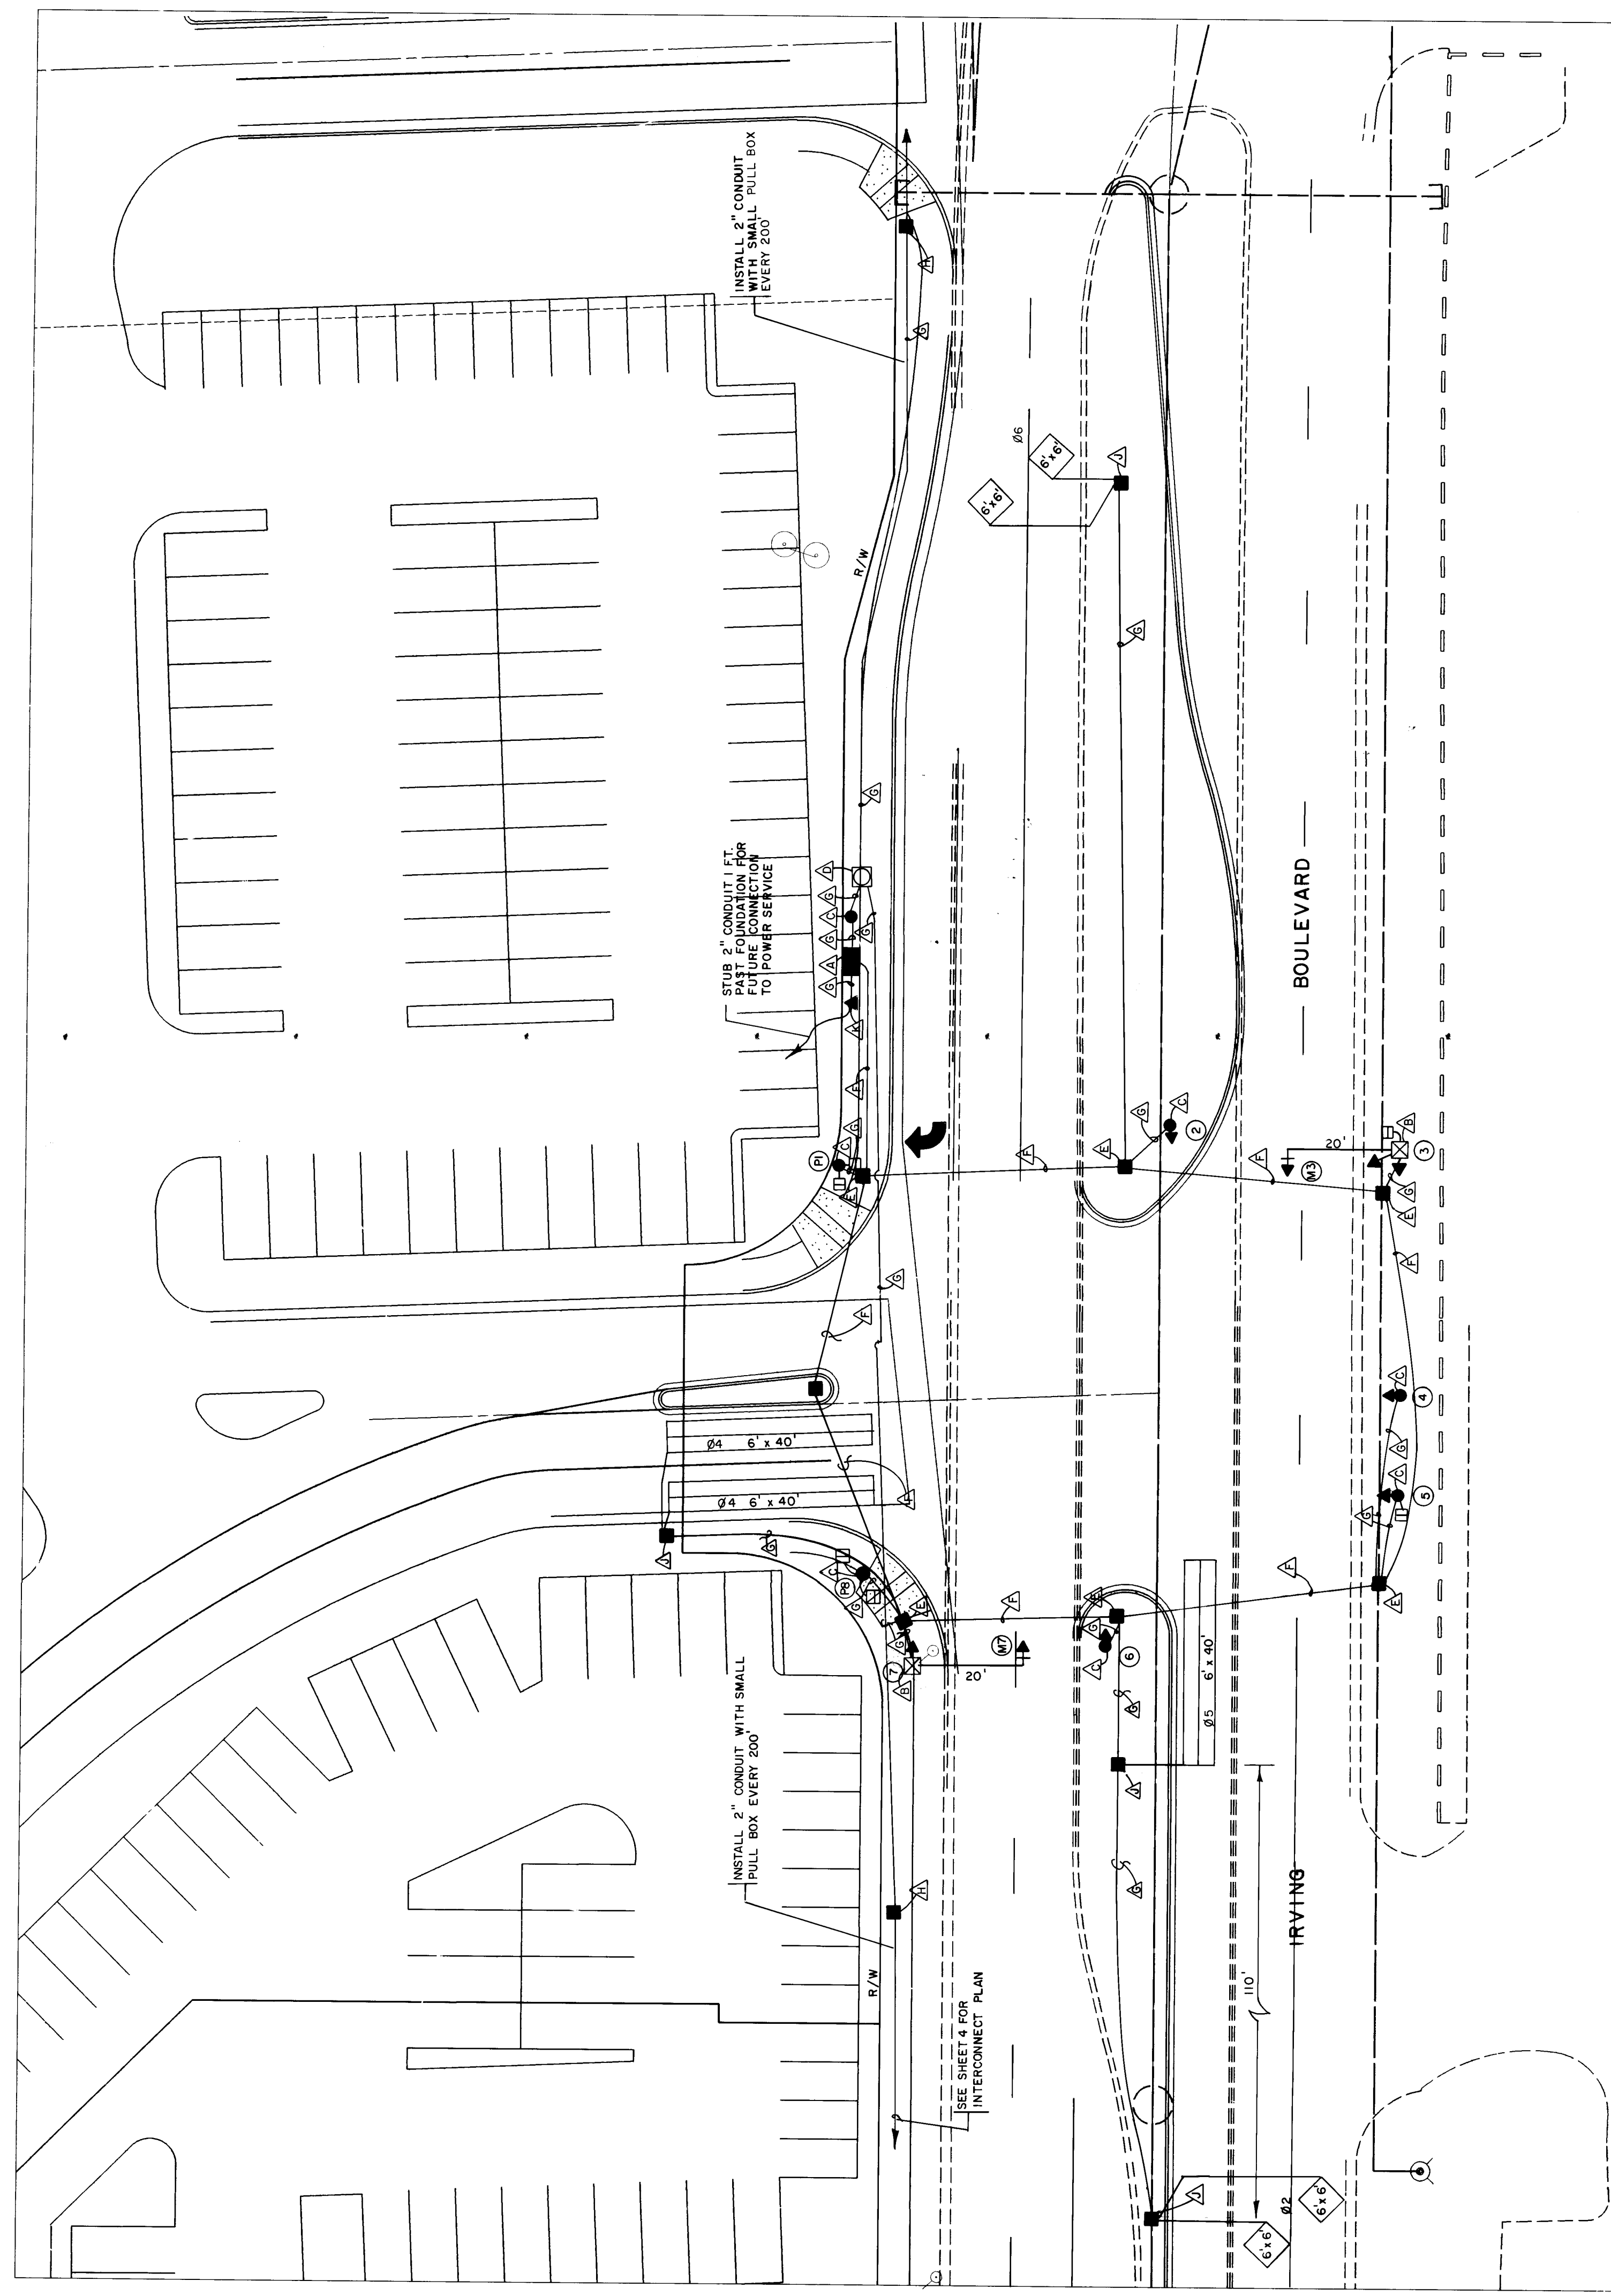

* FUNCTION CHART



CON- DUCTOR	BASE COLOR	TRACER	(RING 1) FUNCTION	FIELD CONNECTION	(RING 2) FUNCTION	FIELD CONNECTION
1.	BLACK	--	SPARE	---	---	---
2.	WHITE	--	SPARE	---	---	---
3.	RED	--	01 RED	---	05 RED	---
4.	GREEN	--	01 GREEN	---	05 GREEN	2 LT GREEN ARROW
5.	ORANGE	--	01 YELLOW	---	05 YELLOW	2 LT YELLOW ARRO
6.	BLUE	--	01 WALK	---	---	---
7.	WHITE	BLACK	01 DONT WALK	---	---	---
8.	RED	BLACK	02 RED	2, 3, M3	06 RED	6, 7, M7
9.	GREEN	BLACK	02 GREEN	2, 3, M3	06 GREEN	6, 7, M7
10.	ORANGE	BLACK	02 YELLOW	2, 3, M3	06 YELLOW	6, 7, M7
11.	BLUE	BLACK	02 WALK	P1	06 WALK	---
12.	BLACK	WHITE	02 DONT WALK	P1	06 DONT WALK	P7
13.	RED	WHITE	03 RED	---	07 RED	---
14.	GREEN	WHITE	03 GREEN	---	07 GREEN	---
15.	BLUE	WHITE	03 YELLOW	---	07 YELLOW	---
16.	BLACK	RED	04 RED	3, 4, 5	08 RED	---
17.	WHITE	RED	04 GREEN	3, 4, 5	08 GREEN	---
18.	ORANGE	RED	04 YELLOW	3, 4, 5	08 YELLOW	---
19.	BLUE	RED	04 WALK	P1, P3, P5, P7	08 WALK	---
20.	RED	GREEN	04 DONT WALK	P1, P3, P5, P7	08 DONT WALK	---
21.	ORANGE	GREEN	SPARE	---	---	---

* FUNCTION CHART (Continued)

1.	BLACK	--	02 PPB	PPB P1
2.	WHITE	--	COMMON	PPB P1 THRU P
3.	RED	--	04 PPB	PPB P1, P3, P5,
4.	GREEN	--	06 PPB	PPB P7
5.	ORANGE	--	08 PPB	---

* SIGNAL HEADS

SIGNALS	ARM LENGTH	POLE TYPE	FOUNDATION TYPE	OVERHEAD SIGNAL (MASTARM)	POST MOUNT SIGNAL	PEDESTRIAN HEAD AND PUSH BUTTONS
*P1	---	*I	STD. POST-I	*---	---	2 at 90°
2	---	I	STD. POST-I	---	5	---
M3	20'	II-B	MASTARM-II	3	3,3	1 at 90°
4	---	I	STD. POST-I	---	3	---
5	---	I	STD. POST-I	---	3	1 at 90°
6	---	I	STD. POST-I	---	3	---
M7	20'	II-B	MASTARM-II	3	3	---
P8	---	I	STD. POST-I	---	---	2 at 90°

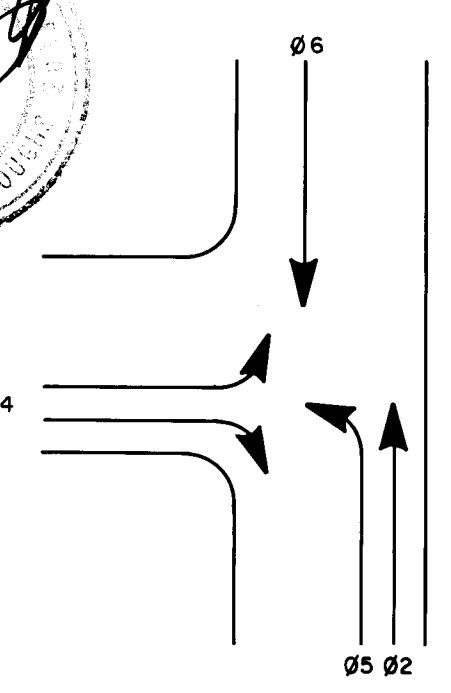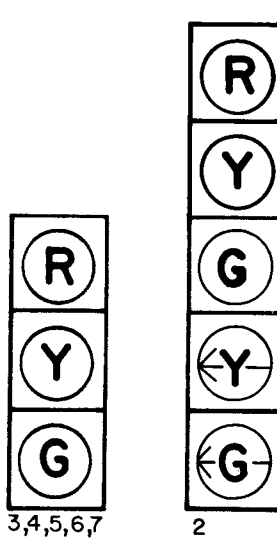


* SIGNAL HEADS

* PHASING DIAGRAM

* NOT PART OF THIS PROJECT

NOTE: BID ALTERNATE 'B' - ABOVE
GROUND SIGNAL INSTALLATION -
NOT PART OF THIS PROJECT

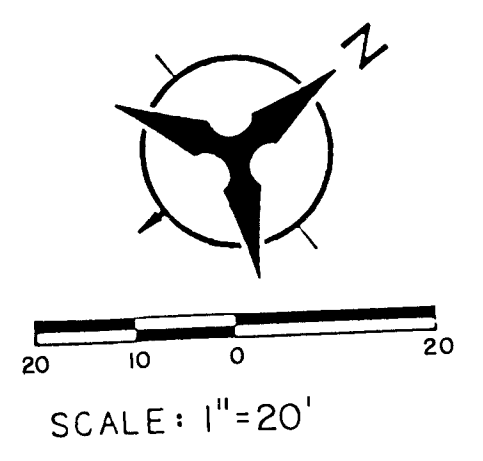

- GENERAL NOTES:
1. ALL CONDUIT TO BE PVC, HEAVY-DUTY, SCHEDULE 40.
 2. ALL CONDUIT CONNECTIONS TO BE MADE OF THE SOLVENT WELD TYPE ACCORDING TO THE RECOMMENDATIONS OF THE PVC CONDUIT MANUFACTURER.
 3. ALL CONDUIT TO BE RUN IN STRAIGHT-LINE FASHION FROM TERMINAL TO TERMINAL AS MUCH AS POSSIBLE. SOME MAY HAVE TO FOLLOW CURVATURE TO STAY WITHIN RIGHT-OF-WAY.
 4. ALL CONDUIT RUNS TO BE CLEARLY LABELED AT END POINTS INSIDE PULL BOXES, MANHOLES, SIGNAL FOUNDATIONS, ETC. LABEL BOTH ENDS OF SAME CONDUIT RUN AS "AA", "BB", "CC", ETC.
 - *5. LOOP DETECTOR WIRING NEEDS TO BE 14 STRANDED WIRE WITH SLIDING SLEEVE.
 6. USE 1-INCH GALVANIZED STEEL RISER FOR UTILITY POWER POLE WHICH PROVIDES ELECTRICAL SERVICE TO SIGNALS. TERMINATE IN STANDARD SIZE PULL BOX AT BASE OF POLE WITH UNDERGROUND CONDUIT.
 - *7. CONTRACTOR SHALL PROVIDE 2-INCH CONDUIT FROM ELECTRICAL SERVICE FROM SERVICE POLE TO PNM POWER SOURCE.
 8. CONTRACTOR TO CONTACT PUBLIC SERVICE COMPANY OF NEW MEXICO TO VERIFY SERVICE POLE CONNECTION.
 - *9. THE CONTRACTOR WILL FURNISH AND INSTALL THE SIGNAL CONTROLLER/CABINET. SIGNAL CONTROLLER/CABINET SIZE AND TYPE TO BE DETERMINED BY CURRENT/FUTURE PHASING REQUIREMENTS AS DETERMINED BY THE CITY OF ALBUQUERQUE TRANSPORTATION DEPARTMENT. ACCEPTABLE CONTROLLERS ARE ECNOLITE ASC 8000, EAGLE SPAC 300, MULTISOURCE 420. CONTROLLERS NEED TO INCLUDE NEMA PLUS CONFLICT MONITOR, LOAD SWITCHES, RELAYS AND AMPLIFIERS.
 10. ADJUST SIGNAL POLE FOUNDATIONS SO AS TO PERMIT GOOD VISIBILITY OF SIGNAL INDICATIONS. CHECK FOR CONFLICT WITH STREET LIGHT POLES, STORE SIGNS, TREE BRANCHES, ETC.
 - *11. MOUNT ALL CONTROLLERS SO DOORS FACE AWAY FROM TRAFFIC.
 - *12. ALL SPLICES FOR TRAFFIC SIGNAL MULTI-CONDUCTOR COBLE SHALL BE MADE ABOVE GROUND (IN CABINET OR STANDARD BASE). NO SPLICING OF MCC WILL BE PERMITTED IN PULL BOXES.
 - *13. CONTRACTOR SHALL FURNISH AND INSTALL ALL CONDUCTOR WIRE FOR TRAFFIC SIGNALS, SUCH THAT SIGNALIZATION IS COMPLETE AND OPERATIONAL. ALL WIRING WILL BE INCIDENTAL TO THE CONTRACT AND APPROVED BY THE ENGINEER.
 - *14. ALL WIRE ON THIS PROJECT TO BE COPPER.
 - * NOT PART OF THIS PROJECT.

KEYED NOTES

- CONTROLLER FOUNDATION, TYPE I C.O.A. 2527
- MASTARM FOUNDATION, TYPE II C.O.A. DWG. 2526
- PEDESTAL FOUNDATION, C.O.A. DWG. 2525
- TRAFFIC SIGNAL MANHOLE, C.O.A. DWG. 2524
- PULL BOX, LARGE 17" X 30" C.O.A. 2521
- 3" CONDUIT PVC
- 2" CONDUIT PVC
- PULL BOX, SMALL 13" X 24" C.O.A. 2521
- PULL BOX DETECTOR C.O.A. DWG. 2522
- SERVICE POLE

LEGEND


■	PULL BOX TO BE INSTALLED
●	PEDESTAL FOUNDATION TYPE I
■	MASTARM FOUNDATION TYPE II
■	CONTROLLER FOUNDATION TYPE I
▲	SERVICE PEDESTAL TO BE INSTALLED (METERING)
□	TRAFFIC SIGNAL MANHOLE

CITY OF ALBUQUERQUE
INFRASTRUCTURE IMPROVEMENTS
MARKET CENTER WEST

TITLE: IRVING BOULEVARD SIGNALIZATION

APPROVALS	ENGINEER	DATE	APPROVALS	ENGINEER	DATE
City Engineer	Rogelio Serna	4/1/07	Liquid Waste	N/A	
A.C.E.-Design	"	"	Traffic	Rogelio Serna	4/1/07
A.C.E.-Hydrology	"	"	Water	N/A	
			N.M. Utilities	Alvin	4-2-07

DRAWING NO. 3575 MAP NO. C-13 SHEET 14 OF 17

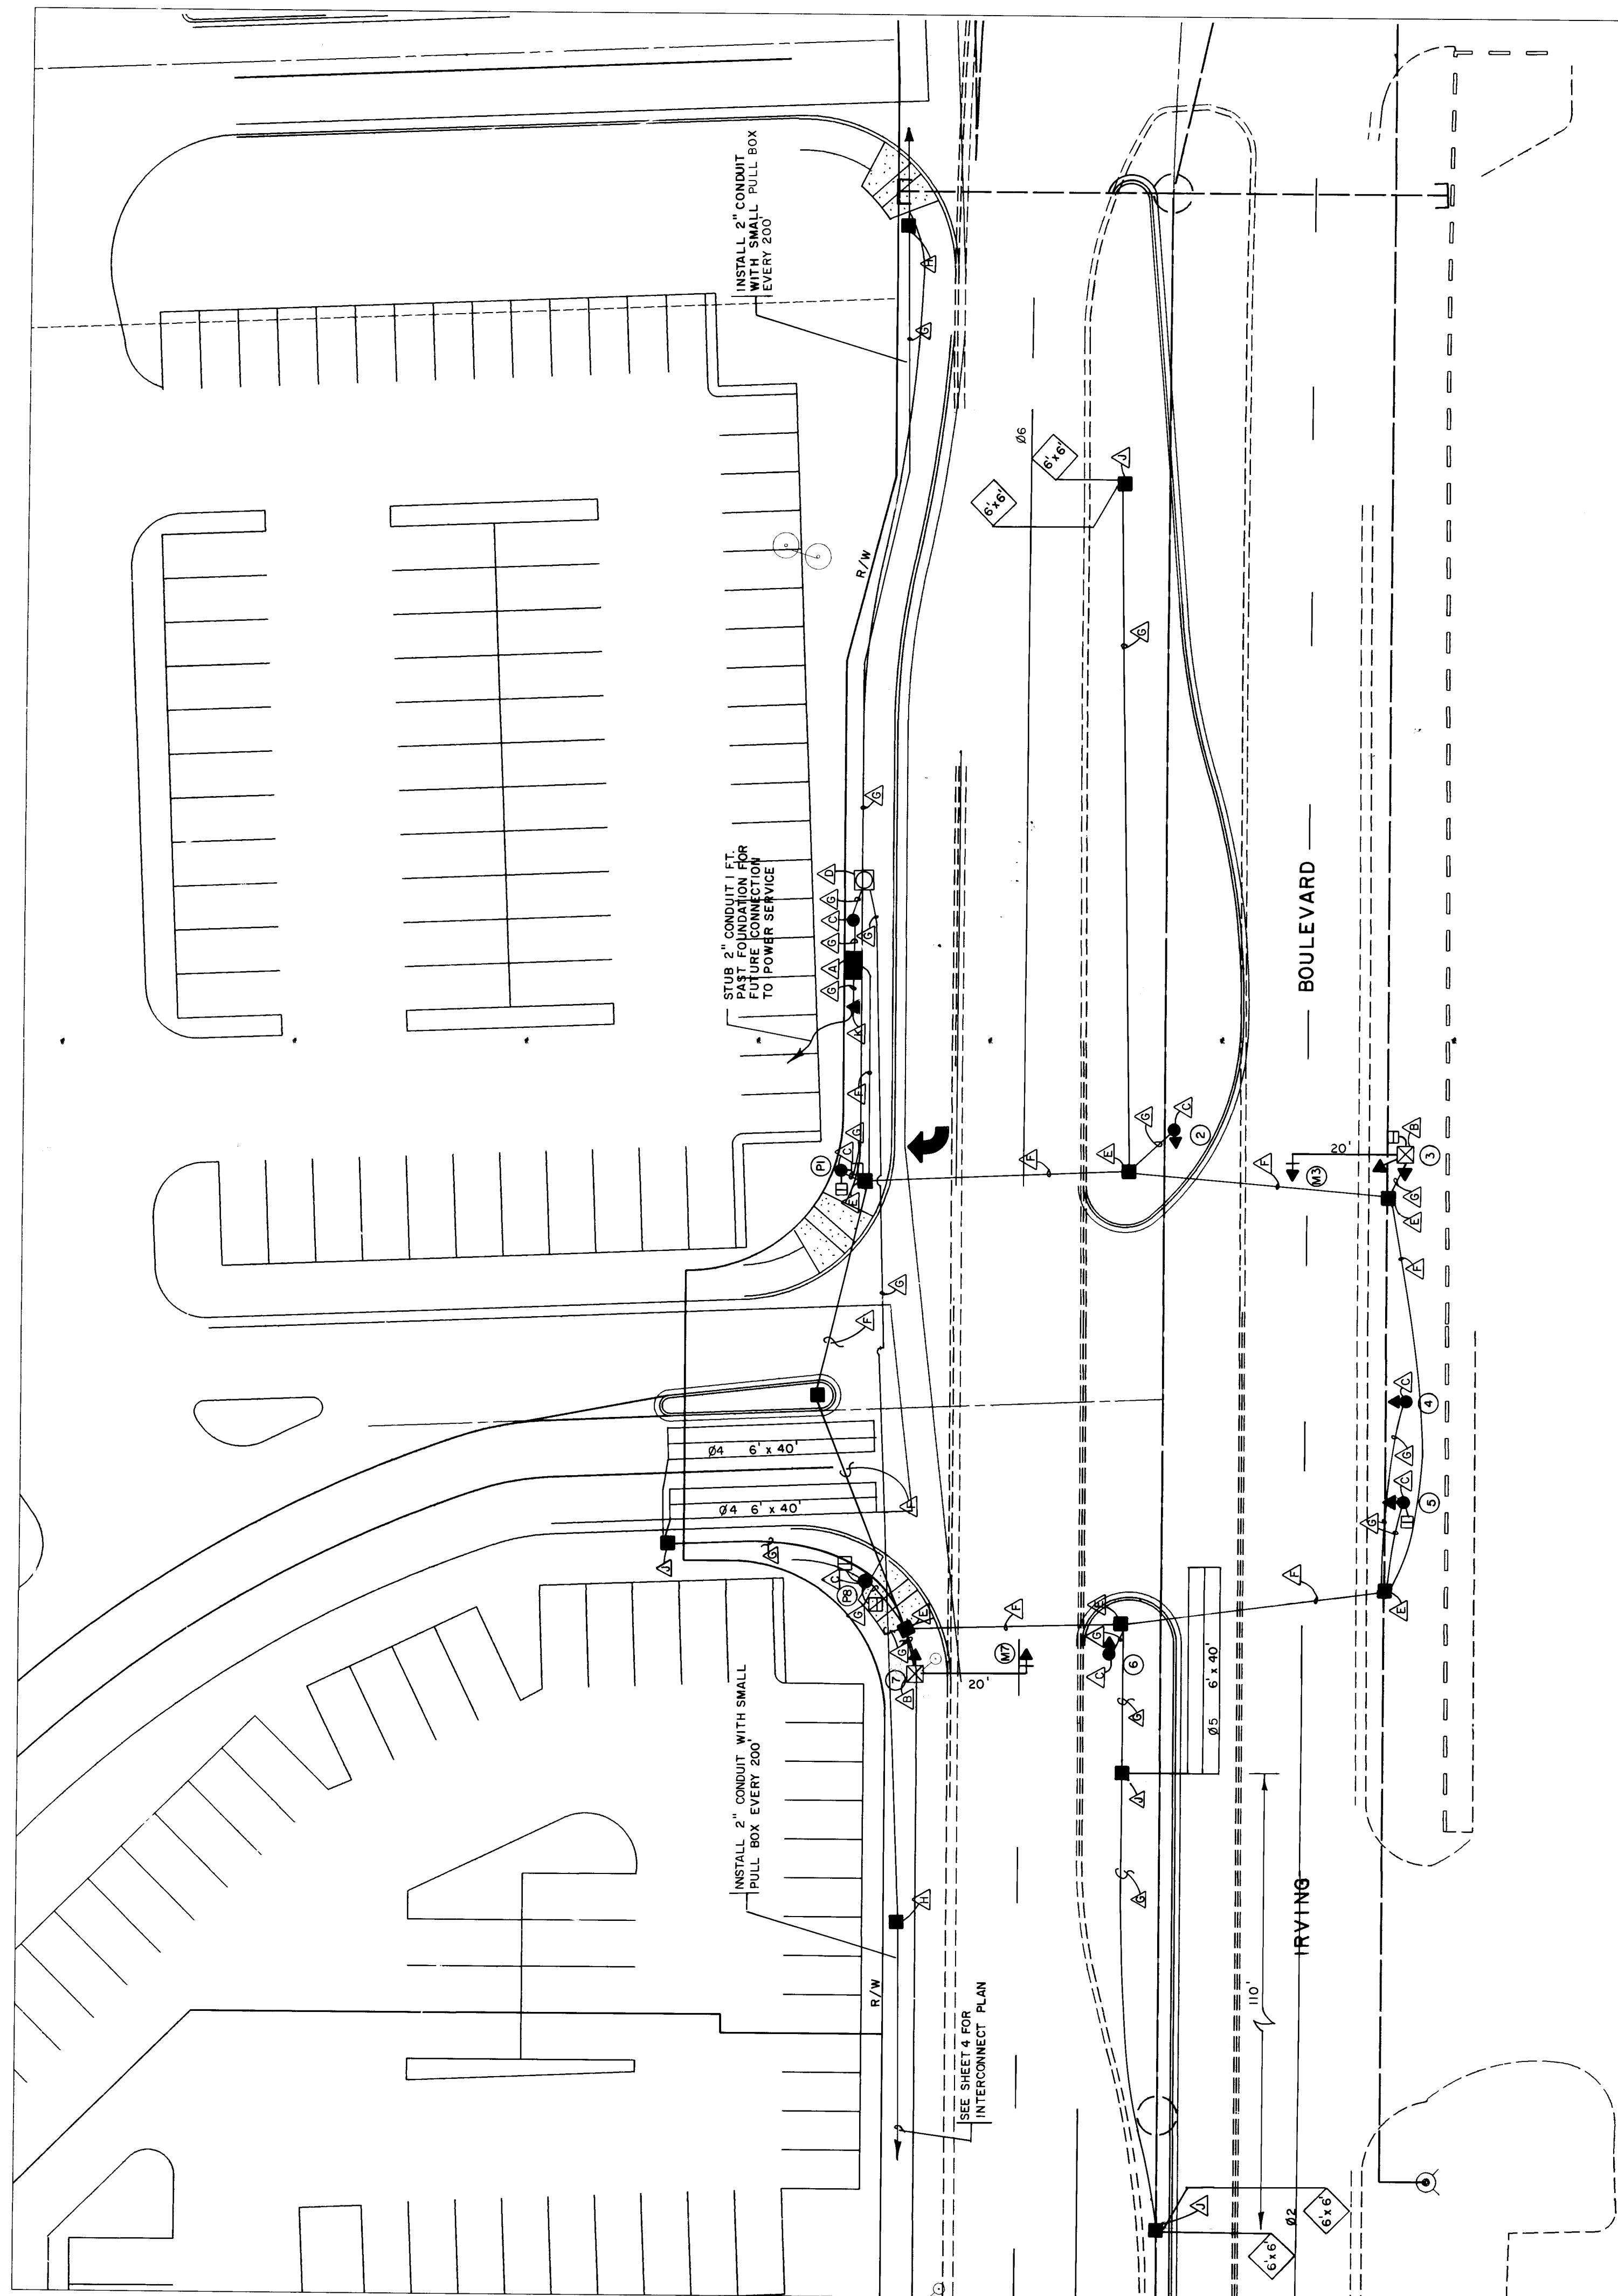

* FUNCTION CHART



CON- DUCTOR	BASE COLOR	TRACER	(RING 1) FUNCTION	FIELD CONNECTION	(RING 2) FUNCTION	FIELD CONNECTION
1.	BLACK	--	SPARE	---	---	---
2.	WHITE	--	SPARE	---	---	---
3.	RED	--	01 RED	---	05 RED	---
4.	GREEN	--	01 GREEN	---	05 GREEN	2 LT GREEN ARROW
5.	ORANGE	--	01 YELLOW	---	05 YELLOW	2 LT YELLOW ARRO
6.	BLUE	--	01 WALK	---	---	---
7.	WHITE	BLACK	01 DONT WALK	---	---	---
8.	RED	BLACK	02 RED	2, 3, M3	06 RED	6, 7, M7
9.	GREEN	BLACK	02 GREEN	2, 3, M3	06 GREEN	6, 7, M7
10.	ORANGE	BLACK	02 YELLOW	2, 3, M3	06 YELLOW	6, 7, M7
11.	BLUE	BLACK	02 WALK	P1	06 WALK	---
12.	BLACK	WHITE	02 DONT WALK	P1	06 DONT WALK	P7
13.	RED	WHITE	03 RED	---	07 RED	---
14.	GREEN	WHITE	03 GREEN	---	07 GREEN	---
15.	BLUE	WHITE	03 YELLOW	---	07 YELLOW	---
16.	BLACK	RED	04 RED	3, 4, 5	08 RED	---
17.	WHITE	RED	04 GREEN	3, 4, 5	08 GREEN	---
18.	ORANGE	RED	04 YELLOW	3, 4, 5	08 YELLOW	---
19.	BLUE	RED	04 WALK	P1, P3, P5, P7	08 WALK	---
20.	RED	GREEN	04 DONT WALK	P1, P3, P5, P7	08 DONT WALK	---
21.	ORANGE	GREEN	SPARE	---	---	---

* FUNCTION CHART (Continued)

1.	BLACK	--	02 PPB	PPB P1
2.	WHITE	--	COMMON	PPB P1 THRU P
3.	RED	--	04 PPB	PPB P1, P3, P5,
4.	GREEN	--	06 PPB	PPB P7
5.	ORANGE	--	08 PPB	---

* SIGNAL HEADS

SIGNALS	ARM LENGTH	POLE TYPE	FOUNDATION TYPE	OVERHEAD SIGNAL (MASTARM)	POST MOUNT SIGNAL	PEDESTRIAN HEAD AND PUSH BUTTONS
*P1	---	*I	STD. POST-I	*---	---	2 at 90°
2	---	I	STD. POST-I	---	5	---
M3	20'	II-B	MASTARM-II	3	3,3	1 at 90°
4	---	I	STD. POST-I	---	3	---
5	---	I	STD. POST-I	---	3	1 at 90°
6	---	I	STD. POST-I	---	3	---
M7	20'	II-B	MASTARM-II	3	3	---
P8	---	I	STD. POST-I	---	---	2 at 90°

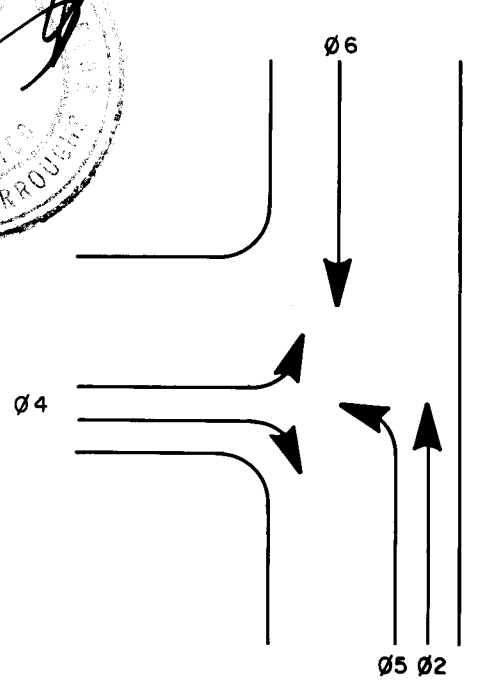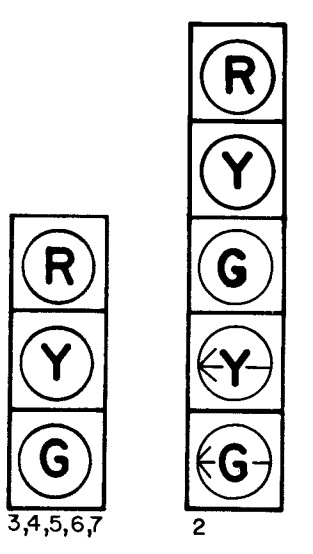


* SIGNAL HEADS

* PHASING DIAGRAM

* NOT PART OF THIS PROJECT

NOTE: BID ALTERNATE 'B' - ABOVE GROUND SIGNAL INSTALLATION - NOT PART OF THIS PROJECT

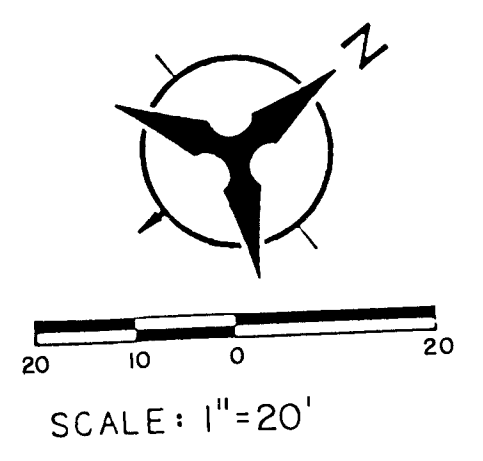

- GENERAL NOTES:
1. ALL CONDUIT TO BE PVC, HEAVY-DUTY, SCHEDULE 40.
 2. ALL CONDUIT CONNECTIONS TO BE MADE OF THE SOLVENT WELD TYPE ACCORDING TO THE RECOMMENDATIONS OF THE PVC CONDUIT MANUFACTURER.
 3. ALL CONDUIT TO BE RUN IN STRAIGHT-LINE FASHION FROM TERMINAL TO TERMINAL AS MUCH AS POSSIBLE. SOME MAY HAVE TO FOLLOW CURVATURE TO STAY WITHIN RIGHT-OF-WAY.
 4. ALL CONDUIT RUNS TO BE CLEARLY LABELED AT END POINTS INSIDE PULL BOXES, MANHOLES, SIGNAL FOUNDATIONS, ETC. LABEL BOTH ENDS OF SAME CONDUIT RUN AS "AA", "BB", "CC", ETC.
 - *5. LOOP DETECTOR WIRING NEEDS TO BE 14 STRANDED WIRE WITH SLIDING SLEEVE.
 6. USE 1-INCH GALVANIZED STEEL RISER FOR UTILITY POWER POLE WHICH PROVIDES ELECTRICAL SERVICE TO SIGNALS. TERMINATE IN STANDARD SIZE PULL BOX AT BASE OF POLE WITH UNDERGROUND CONDUIT.
 7. CONTRACTOR SHALL PROVIDE 2-INCH CONDUIT FROM ELECTRICAL SERVICE FROM SERVICE POLE TO PNM POWER SOURCE.
 8. CONTRACTOR TO CONTACT PUBLIC SERVICE COMPANY OF NEW MEXICO TO VERIFY SERVICE POLE CONNECTION.
 - *9. THE CONTRACTOR WILL FURNISH AND INSTALL THE SIGNAL CONTROLLER/CABINET. SIGNAL CONTROLLER/CABINET SIZE AND TYPE TO BE DETERMINED BY CURRENT/FUTURE PHASING REQUIREMENTS AS DETERMINED BY THE CITY OF ALBUQUERQUE TRANSPORTATION DEPARTMENT. ACCEPTABLE CONTROLLERS ARE ECNOLITE ASC 8000, EAGLE SPAC 300, MULTISOURCE 420. CONTROLLERS NEED TO INCLUDE NEMA PLUS CONFLICT MONITOR, LOAD SWITCHES, RELAYS AND AMPLIFIERS.
 10. ADJUST SIGNAL POLE FOUNDATIONS SO AS TO PERMIT GOOD VISIBILITY OF SIGNAL INDICATIONS. CHECK FOR CONFLICT WITH STREET LIGHT POLES, STORE SIGNS, TREE BRANCHES, ETC.
 - *11. MOUNT ALL CONTROLLERS SO DOORS FACE AWAY FROM TRAFFIC.
 - *12. ALL SPLICES FOR TRAFFIC SIGNAL MULTI-CONDUCTOR COBLE SHALL BE MADE ABOVE GROUND (IN CABINET OR STANDARD BASE). NO SPLICING OF MCC WILL BE PERMITTED IN PULL BOXES.
 - *13. CONTRACTOR SHALL FURNISH AND INSTALL ALL CONDUCTOR WIRE FOR TRAFFIC SIGNALS, SUCH THAT SIGNALIZATION IS COMPLETE AND OPERATIONAL. ALL WIRING WILL BE INCIDENTAL TO THE CONTRACT AND APPROVED BY THE ENGINEER.
 - *14. ALL WIRE ON THIS PROJECT TO BE COPPER.
 - * NOT PART OF THIS PROJECT.

KEYED NOTES

- CONTROLLER FOUNDATION, TYPE I C.O.A. 2527
- MASTARM FOUNDATION, TYPE II C.O.A. DWG. 2526
- PEDESTAL FOUNDATION, C.O.A. DWG. 2525
- TRAFFIC SIGNAL MANHOLE, C.O.A. DWG. 2524
- PULL BOX, LARGE 17" X 30" C.O.A. 2521
- 3" CONDUIT PVC
- 2" CONDUIT PVC
- PULL BOX, SMALL 13" X 24" C.O.A. 2521
- PULL BOX DETECTOR C.O.A. DWG. 2522
- SERVICE POLE

LEGEND


- PULL BOX TO BE INSTALLED
- PEDESTAL FOUNDATION TYPE I
- MASTARM FOUNDATION TYPE II
- CONTROLLER FOUNDATION TYPE I
- SERVICE PEDESTAL TO BE INSTALLED (METERING)
- TRAFFIC SIGNAL MANHOLE

CITY OF ALBUQUERQUE
INFRASTRUCTURE IMPROVEMENTS
MARKET CENTER WEST

TITLE: IRVING BOULEVARD SIGNALIZATION

APPROVALS	ENGINEER	DATE	APPROVALS	ENGINEER	DATE
City Engineer	Rogelio Serna	4/1/07	Liquid Waste	N/A	
A.C.E.-Design	"	"	Traffic	Rogelio Serna	4/1/07
A.C.E.-Hydrology	"	"	Water	N/A	
			N.M. Utilities	Mike	4-2-07

DRAWING NO. 3575 MAP NO. C-13 SHEET 14 OF 17

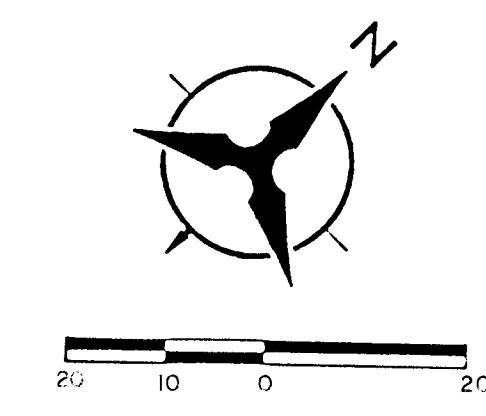

10. CONTRACTOR SHALL BORE AND JACK 3-INCH CONDUIT UNDER EXISTING PAVEMENT IN COORS BLVD.

	CONTROLLER FOUNDATION, TYPE I C.O.A. 2527
	MASTARM FOUNDATION, TYPE II C.O.A. DWG. 2526
	PEDESTAL FOUNDATION, C.O.A. DWG. 2525
	TRAFFIC SIGNAL MANHOLE, C.O.A. DWG. 2524
	PULL BOX, LARGE 17" x 30" C.O.A. 2521
	3" CONDUIT PVC
	2" CONDUIT PVC
	PULL BOX, SMALL 13" x 24" C.O.A. 2521
	PULL BOX DETECTOR C.O.A. DWG. 2522
	SERVICE POLE
	MASTARM FOUNDATION, TYPE II

26 35751590
LEGEND

- ☐ PULL BOX TO BE INSTALLED
- ☐ PEDESTAL FOUNDATION TYPE I
- ☒ MASTARM FOUNDATION TYPE II
- ☐ CONTROLLER FOUNDATION TYPE I
- ☐ SERVICE PEDESTAL TO BE INSTALLED (METERING)
- ☐ EXISTING PULL BOX



CITY OF ALBUQUERQUE

INFRASTRUCTURE IMPROVEMENTS

MARKET CENTER WEST



JOB NO. 88219.05

TITLE:	COORS/IRVING SIGNALIZATION
--------	----------------------------

	APPROVALS	ENGINEER	DATE	APPROVALS	ENGINEER	DATE
For City Engineer		<i>Roger A. Shuman</i>	4/11/89	Liquid Waste	N/A	
A.C.E. - Design		"	"	Traffic	<i>Roger A. Shuman</i>	4/11/89
A.C.E. - Hydrology		"	"	Water	N/A	
				N.M. Utilities	<i>N.M. Utilities</i>	4-7-89

DRAWING NO. 3575		MAP NO. C-13	SHEET 15 OF 17
------------------	--	--------------	----------------

[illegible]

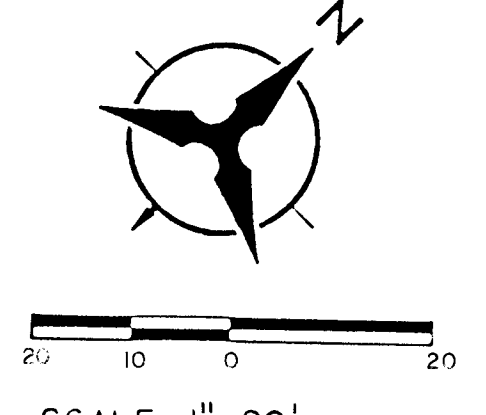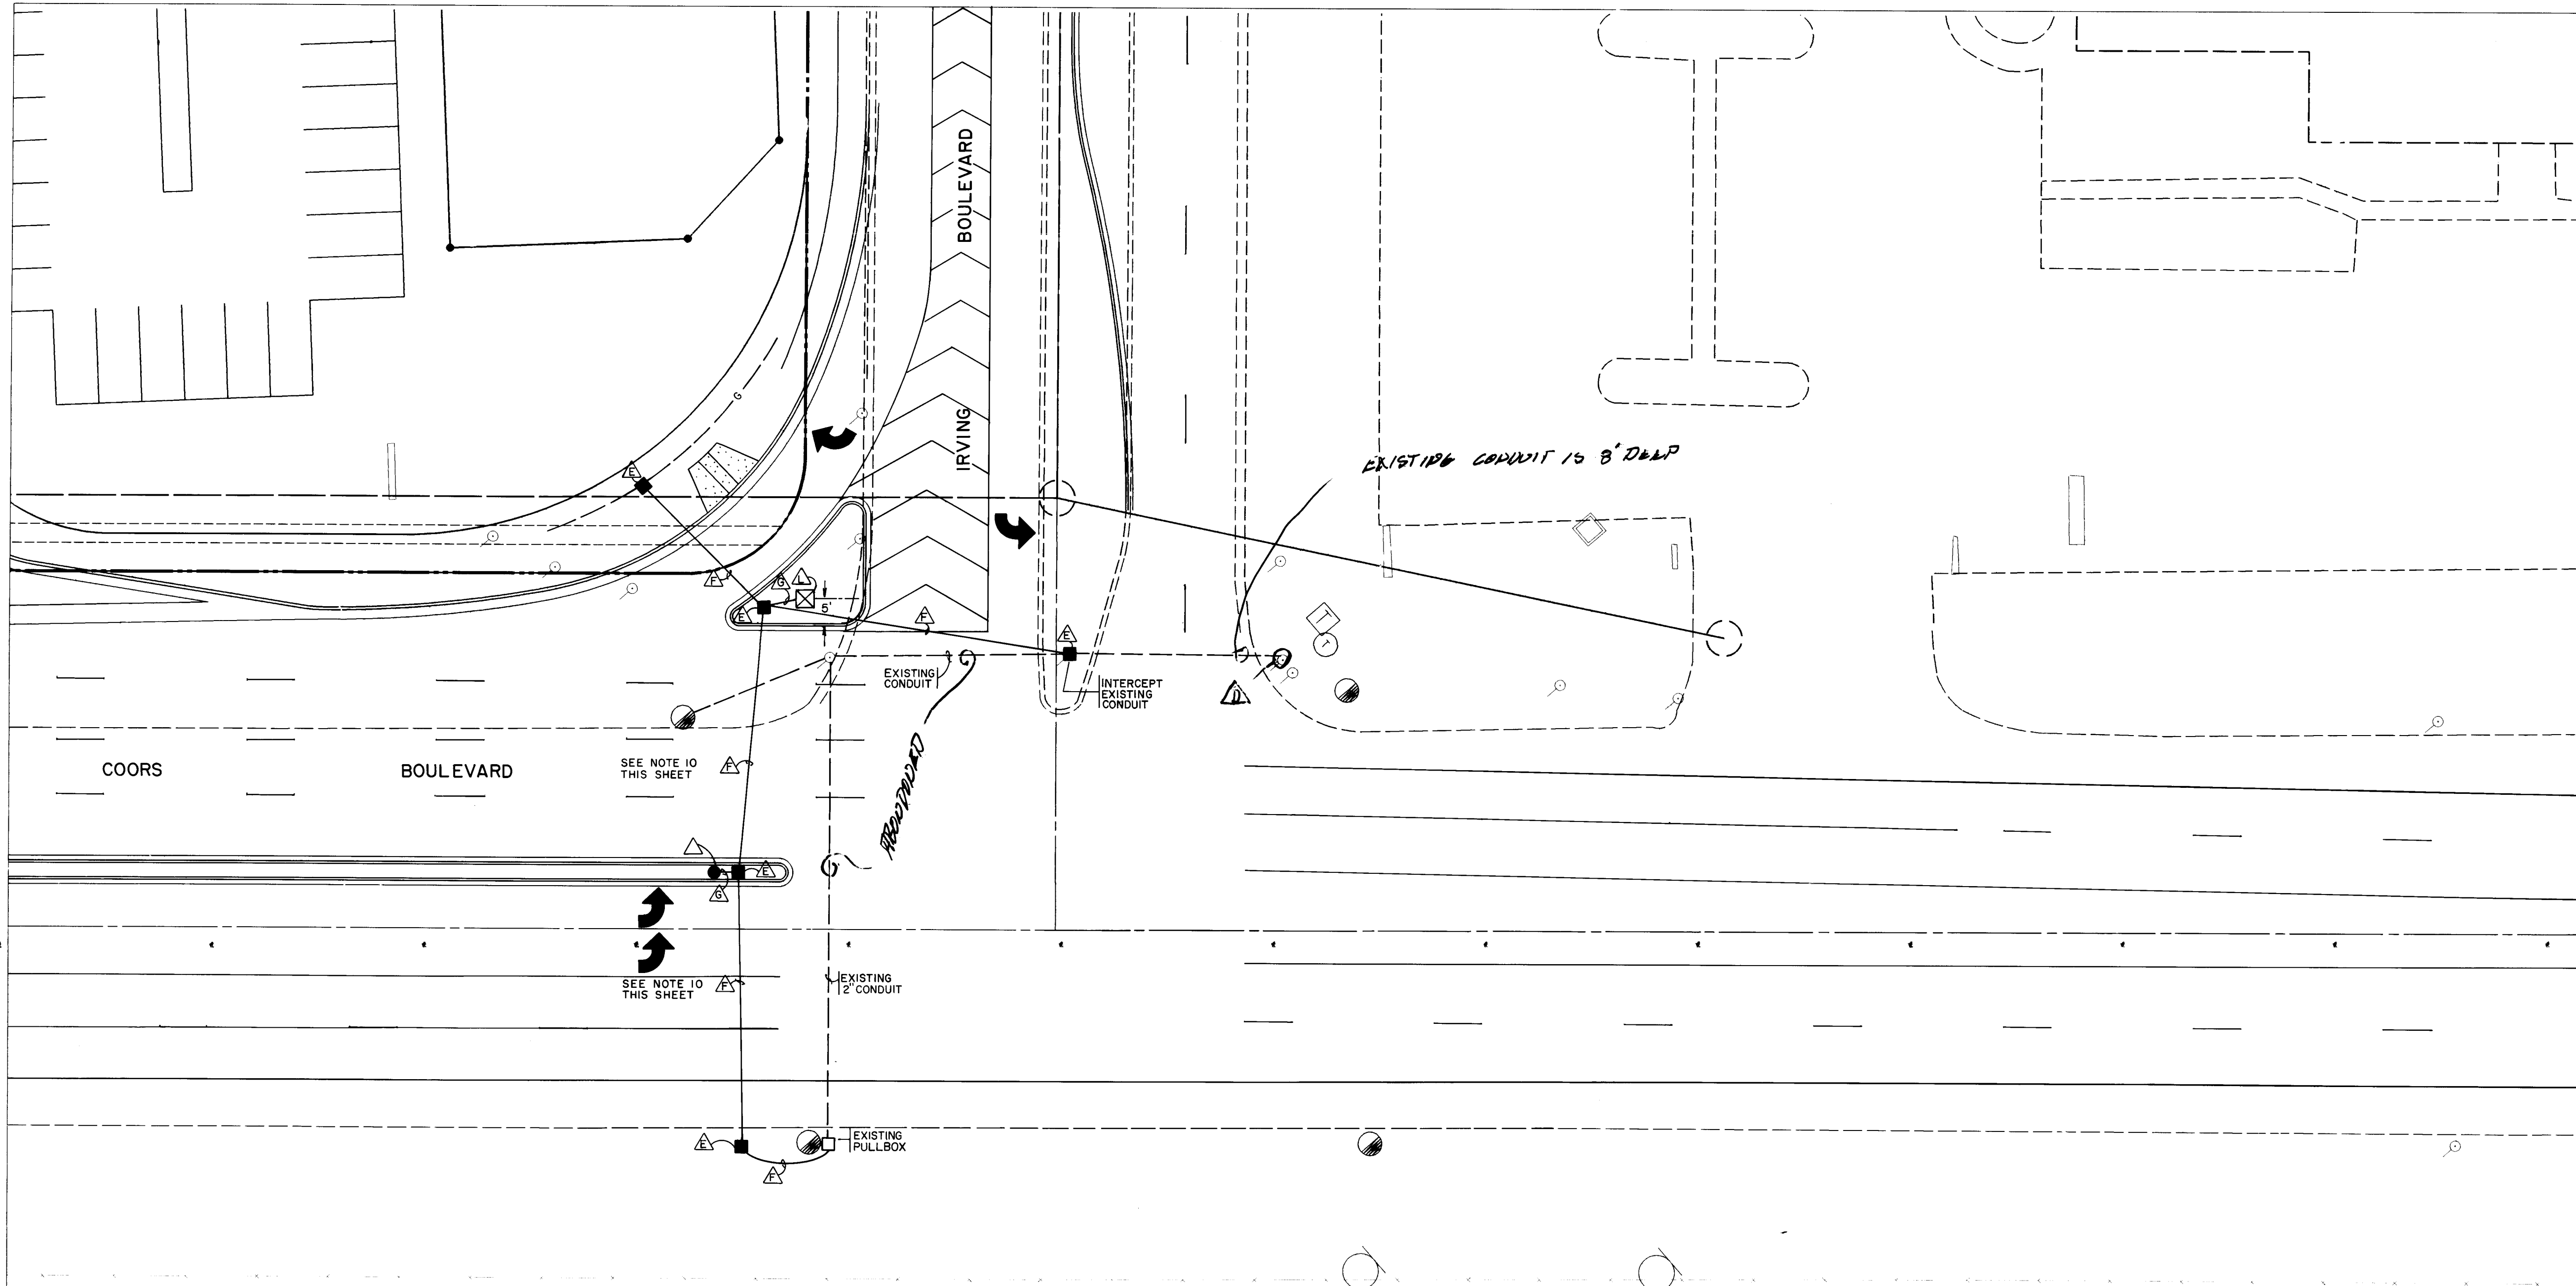

- GENERAL NOTES:
1. ALL CONDUIT TO BE PVC, HEAVY-DUTY, SCHEDULE 40.
 2. ALL CONDUIT CONNECTIONS TO BE MADE OF THE SOLVENT WELD TYPE ACCORDING TO THE RECOMMENDATIONS OF THE PVC CONDUIT MANUFACTURER.
 3. ALL CONDUIT TO BE RUN IN STRAIGHT-LINE FASHION FROM TERMINAL TO TERMINAL AS MUCH AS POSSIBLE. SOME MAY HAVE TO FOLLOW CURVATURE TO STAY WITHIN RIGHT-OF-WAY.
 4. ALL CONDUIT RUNS TO BE CLEARLY LABELED AT END POINTS INSIDE PULL BOXES, MANHOLES, SIGNAL FOUNDATIONS, ETC. LABEL BOTH ENDS OF SAME CONDUIT RUN AS "AA", "BB", "CC", ETC.
 5. USE 1-INCH GALVANIZED STEEL RISER FOR UTILITY POWER POLE WHICH PROVIDES ELECTRICAL SERVICE TO SIGNALS. TERMINATE IN STANDARD SIZE PULL BOX AT BASE OF POLE WITH UNDERGROUND CONDUIT.
 6. PROVIDE 2-INCH CONDUIT FOR ELECTRICAL SERVICE FROM PULL BOX AT BASE OF POWER POLE TO LAMP BOX ON CLOSEST CORNER.
 7. ADJUST SIGNAL POLE FOUNDATIONS SO AS TO PERMIT GOOD VISIBILITY OF SIGNAL INDICATORS. CHECK FOR CONFLICT WITH STREET LIGHT POLES, STORE SIGNS, TREE BRANCHES, ETC.
 8. ABOVE GROUND TRAFFIC SIGNAL EQUIPMENT FOR THIS INTERSECTION NOT PART OF THIS CONTRACT. SHALL BE FURNISHED AND INSTALLED BY THE CITY OF ALBUQUERQUE WHEN NEEDS WARRANT.
 9. 2" INTERCONNECT CONDUIT WITH PULL BOX EVERY 200' SHALL BE INSTALLED ALONG THE WEST SIDE OF COORS BLVD., AND THE SOUTH SIDE OF IRVING BLVD. SEE SHEET 4 OF 20.
 10. CONTRACTOR SHALL BORE AND JACK 3-INCH CONDUIT UNDER EXISTING PAVEMENT IN COORS BLVD.

- KEYED NOTES
- △ CONTROLLER FOUNDATION, TYPE I COA 2527
 - △ MASTARM FOUNDATION, TYPE II COA DWG. 2526
 - △ PEDESTAL FOUNDATION, C.O.A. DWG. 2525
 - △ TRAFFIC SIGNAL MANHOLE, C.O.A. DWG. 2524
 - △ PULL BOX, LARGE 17" X 30" COA 2521
 - △ 3" CONDUIT PVC
 - △ 2" CONDUIT PVC
 - △ PULL BOX, SMALL 13" X 24" C.O.A. 2521
 - △ PULL BOX DETECTOR C.O.A. DWG. 2522
 - △ SERVICE POLE
 - △ MASTARM FOUNDATION, TYPE II
- 26 3575 1590
- LEGEND
- PULL BOX TO BE INSTALLED
 - PEDESTAL FOUNDATION TYPE I
 - ⊠ MASTARM FOUNDATION TYPE II
 - CONTROLLER FOUNDATION TYPE I
 - ▲ SERVICE PEDESTAL TO BE INSTALLED (METERING)
 - EXISTING PULL BOX

ENGINEER'S SEAL			SURVEY INFORMATION		FIELD NOTES		BENCH MARKS		AS BUILT INFORMATION	
	NO.	DATE	BY	DATE	NO.	BY	USC & GS BRASS TABLET "R. ALAMEDA A-3" NEW MEXICO	STATE PLANE COORDINATES (CENTRAL ZONE) X=377,094.67 Y=1,523,108.34 GROUND TO GRID FACTOR = 0.99967685 Δ CO = 00° 4' 13" ELEV = 5027.05	SURVANCE WALKER SURVEY R. BACA	MICRO-FILM INFORMATION

CITY OF ALBUQUERQUE
INFRASTRUCTURE IMPROVEMENTS
MARKET CENTER WEST

JOB NO. 88219.05



TITLE:
COORS / IRVING SIGNALIZATION

APPROVALS	ENGINEER	DATE	APPROVALS	ENGINEER	DATE
City Engineer	R. BACA	4/1/89	Liquid Waste	N/A	
A.C.E. - Design		"	Traffic	R. BACA	4/1/89
A.C.E. - Hydrology		"	Water	N/A	
			N.M. Utilities		4-7-89

DRAWING NO. 3575

MAP NO. C-13

SHEET 15 OF 17

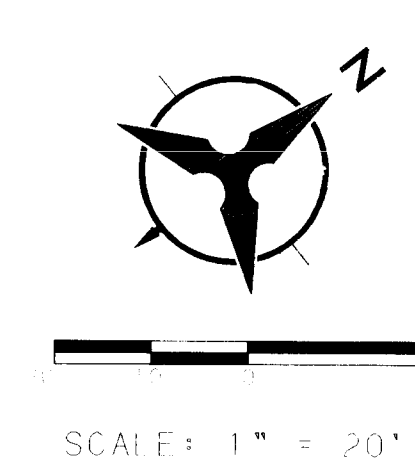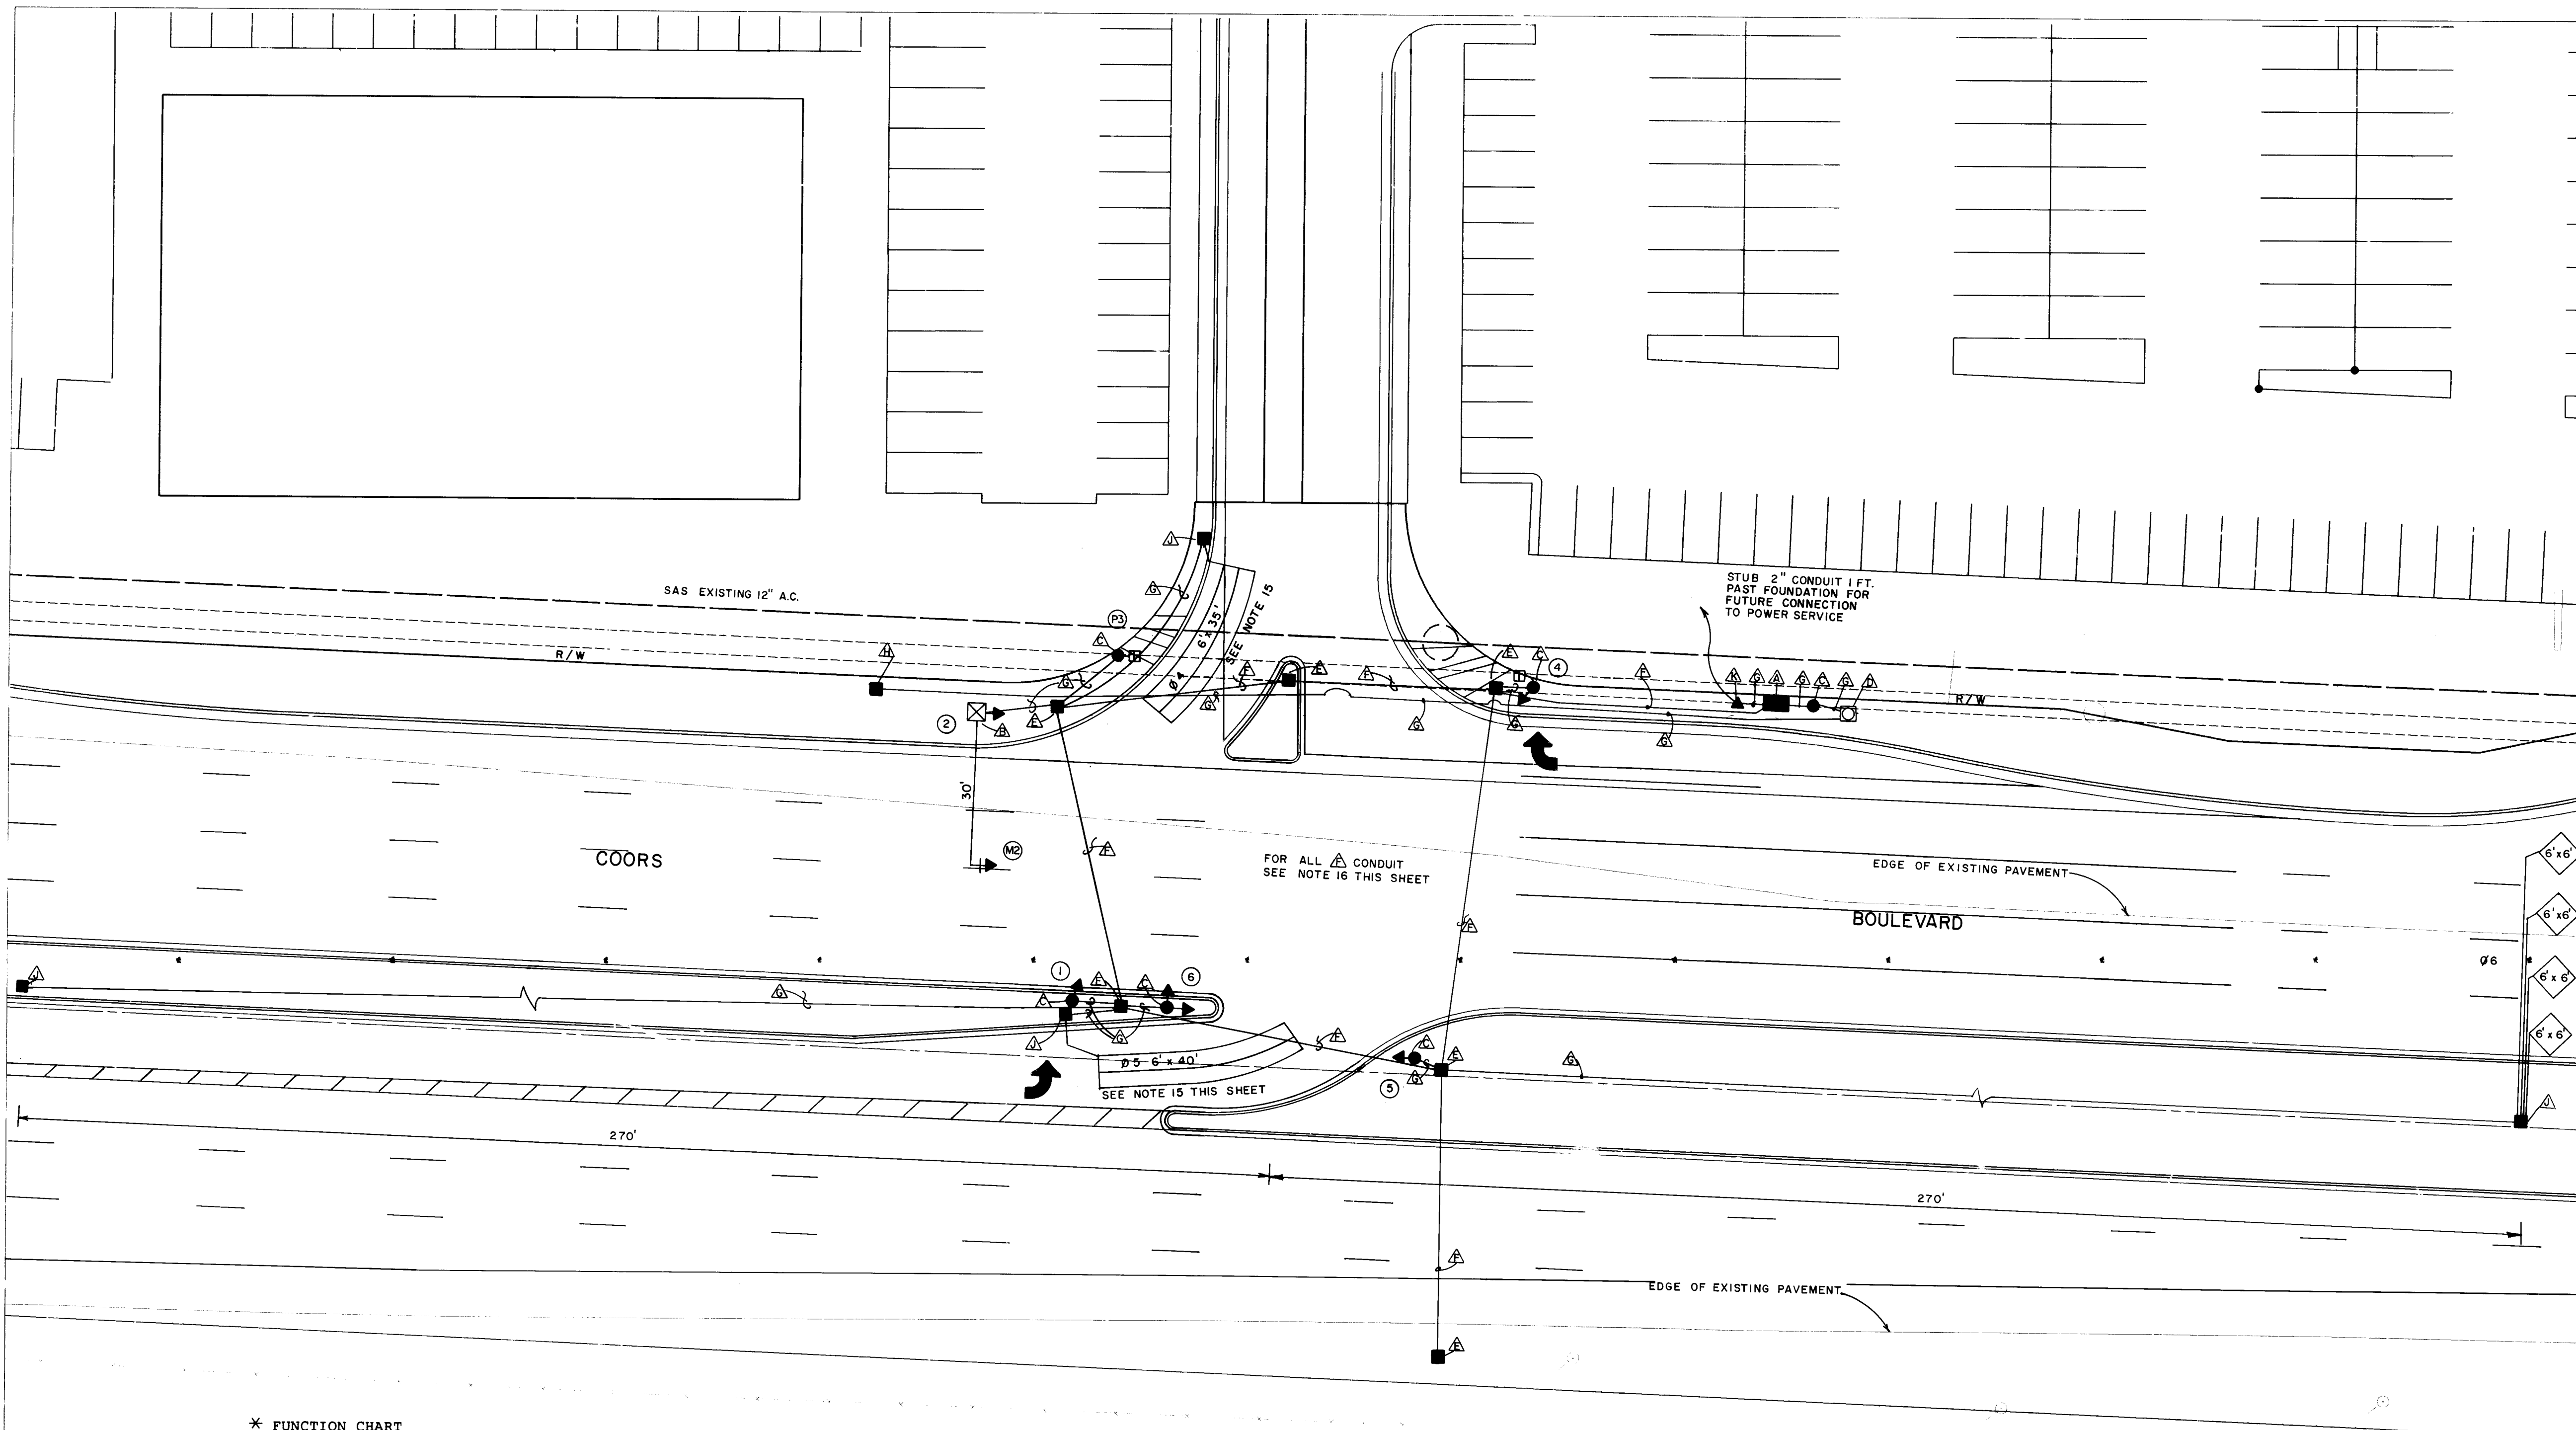

- GENERAL NOTES:**
1. ALL CONDUIT TO BE PVC, HEAVY-DUTY, SCHEDULE 40.
 2. ALL CONDUIT CONNECTIONS TO BE MADE OF THE SOLVENT WELD TYPE ACCORDING TO THE RECOMMENDATIONS OF THE PVC CONDUIT MANUFACTURER.
 3. ALL CONDUIT TO BE RUN IN STRAIGHT-LINE FASHION FROM TERMINAL TO TERMINAL AS MUCH AS POSSIBLE. SOME MAY HAVE TO FOLLOW CURVATURE TO STAY WITHIN RIGHT-OF-WAY.
 4. ALL CONDUIT RUNS TO BE CLEARLY LABELED AT END POINTS INSIDE PULL BOXES, MANHOLES, SIGNAL FOUNDATIONS, ETC. LABEL BOTH ENDS OF SAME CONDUIT RUN AS "AA", "BB", "CC", ETC.
 5. LOOP DETECTOR WIRING NEEDS TO BE 14 STRANDED WIRE WITH SLIDING SLEEVE.
 6. USE 1-INCH GALVANIZED STEEL RISER FOR UTILITY POWER POLE WHICH PROVIDES ELECTRICAL SERVICE TO SIGNALS. TERMINATE IN STANDARD SIZE PULL BOX AT BASE OF POLE WITH UNDERGROUND CONDUIT.
 7. CONTRACTOR SHALL PROVIDE 2-INCH CONDUIT FOR ELECTRICAL SERVICE FROM DETECTOR POLE TO PNM POWER SOURCE.
 8. CONTRACTOR TO COORDINATE WITH UTILITY COMPANY OF NEW MEXICO FOR SERVICE POLE CONNECTION.
 9. THE CONTRACTOR WILL FURNISH AND INSTALL THE SIGNAL CONTROLLER/CABINET. SIGNAL CONTROLLER/CABINET SIZE AND TYPE TO BE DETERMINED BY CURRENT/FUTURE PHASING REQUIREMENTS AS DETERMINED BY THE CITY OF ALBUQUERQUE TRANSPORTATION DEPARTMENT. ACCEPTABLE CONTROLLERS ARE ECONOLITE ASC 8000, EAGLE SPEC 300, MULTISONICS 820. CONTROLLERS NEED TO INCLUDE VERA PLUS CONFLICT MONITOR, LOAD SWITCHES, RELAYS AND AMPLIFIERS.
 10. ADJUST SIGNAL POLE FOUNDATIONS SO AS TO PERMIT GOOD VISIBILITY OF SIGNAL INDICATIONS. CHECK FOR CONFLICT WITH STREET LIGHT POLES, STORE SIGNS, TREE BRANCHES, ETC.
 11. MOUNT ALL CONTROLLERS SO DOORS FACE AWAY FROM TRAFFIC.
 12. ALL SPLICES FOR TRAFFIC SIGNAL MULTI-CONDUCTOR CABLE SHALL BE MADE ABOVE GROUND (IN CABINET OR STANDARD BASE), NO SPLICING OF MCC WILL BE PERMITTED IN PULL BOXES.
 13. CONTRACTOR SHALL FURNISH AND INSTALL ALL CONDUCTOR WIRE FOR TRAFFIC SIGNALS, SUCH THAT SIGNALIZATION IS COMPLETE AND OPERATIONAL. ALL WIRING WILL BE INCIDENTAL TO THE CONTRACT AND APPROVED BY THE ENGINEER.
 14. ALL WIRE ON THIS PROJECT TO BE COPPER.
 15. DETECTOR LOOP LEAD-IN WIRE RUNS FOR #4 AND #5 SHALL BE SEPARATE. CONNECT RIGHT TURN DETECTOR LOOP TO AMPLIFIER WITH DELAY CALL FUNCTION.
 16. CONTRACTOR SHALL BORE AND JACK 3-INCH CONDUIT UNDER EXISTING PAVEMENT IN COORS BLVD.
 - * NOT PART OF THIS PROJECT.

- KEYED NOTES**
- △ CONTROLLER FOUNDATION, TYPE I C.O.A. 2527
 - △ MASTARM FOUNDATION, TYPE II C.O.A. DWG. 2526
 - △ PEDESTAL FOUNDATION, C.O.A. DWG. 2525
 - △ TRAFFIC SIGNAL MANHOLE, C.O.A. DWG. 2524
 - △ PULL BOX, LARGE 17" X 30" C.O.A. 2521
 - △ 3" CONDUIT PVC
 - △ 2" CONDUIT PVC
 - △ PULL BOX, SMALL 13" X 24" C.O.A. 2521
 - △ PULL BOX DETECTOR C.O.A. DWG. 2522
 - △ SERVICE POLE
- LEGEND**
- PULL BOX TO BE INSTALLED
 - PEDESTAL FOUNDATION TYPE I
 - MASTARM FOUNDATION TYPE II
 - CONTROLLER FOUNDATION TYPE I
 - ▲ SERVICE PEDESTAL TO BE INSTALLED (METERING)
 - ⊗ TRAFFIC SIGNAL MANHOLE

*** FUNCTION CHART**


CON-DUCTOR	BASE COLOR	TRACER	(RING 1) FUNCTION	FIELD CONNECTION	(RING 2) FUNCTION	FIELD CONNECTION
1.	BLACK	--	SPARE	----	----	----
2.	WHITE	--	SPARE	----	05 RED	5, M5 LT RED ARROW
3.	RED	--	01 RED	----	05 GREEN	5, M5 LT GREEN ARROW
4.	GREEN	--	01 GREEN	----	05 YELLOW	5, M5 LT YELLOW ARROW
5.	ORANGE	--	01 YELLOW	----	----	----
6.	BLUE	--	01 WALK	----	----	----
7.	WHITE	BLACK	01 DONT WALK	----	06 RED	2, M2, 6
8.	RED	BLACK	02 RED	----	06 GREEN	2, M2, 6
9.	GREEN	BLACK	02 GREEN	----	06 YELLOW	2, M2, 6
10.	ORANGE	BLACK	02 YELLOW	----	06 WALK	P3, P4
11.	BLUE	BLACK	02 WALK	----	06 DONT WALK	P3, P4
12.	BLACK	WHITE	02 DONT WALK	----	07 RED	----
13.	RED	WHITE	03 RED	----	07 GREEN	----
14.	GREEN	WHITE	03 GREEN	----	07 YELLOW	----
15.	BLUE	WHITE	03 YELLOW	----	08 RED	----
16.	BLACK	RED	04 RED	----	08 GREEN	----
17.	WHITE	RED	04 GREEN	1, 6 RT RED ARROW	08 YELLOW	----
18.	ORANGE	RED	04 YELLOW	1, 6 RT GREEN ARROW	----	----
19.	BLUE	RED	04 WALK	1, 6 RT YELLOW ARROW	08 WALK	----
20.	RED	GREEN	04 DONT WALK	----	08 DONT WALK	----
21.	ORANGE	GREEN	SPARE	----	----	----

1.	BLACK	--	02 PPB	----
2.	WHITE	--	COMMON	PPB P3, P4
3.	RED	--	04 PPB	----
4.	GREEN	--	06 PPB	PPB P3, P4
5.	ORANGE	--	08 PPB	----


NOTE: BID ALTERNATE 'B' - ABOVE GROUND SIGNAL INSTALLATION - NOT PART OF THIS PROJECT

SIGNALS	ARM LENGTH	POLE TYPE	FOUNDATION TYPE	OVERHEAD SIGNAL (MASTARM)	POST MOUNT SIGNAL	PEDESTRIAN HEAD AND PUSH BUTTONS
I	---	I	STD. POST-I	---	3	---
M2	30'	II-B	MASTARM-II	3	3	---
P3	---	I	STD. POST-I	---	---	1 at 90°
4	---	I	STD. POST-I	---	3	1 at 90°
5	---	I	STD. POST-I	---	* * 3	---
6	---	I	STD. POST-I	---	3,3	---

** OPTICALLY PROGRAMED SIGNAL
* NOT PART OF THIS PROJECT

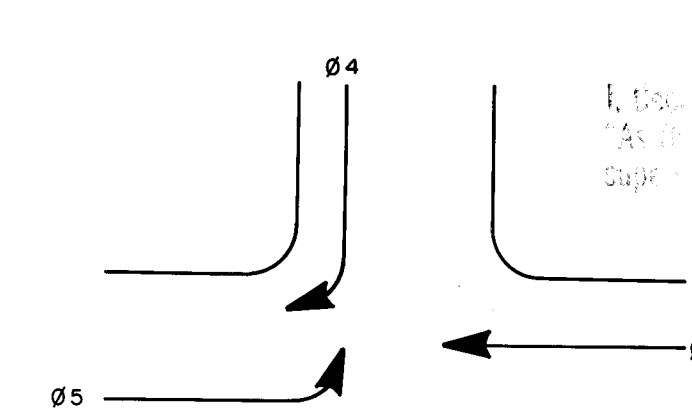

* PHASING DIAGRAM

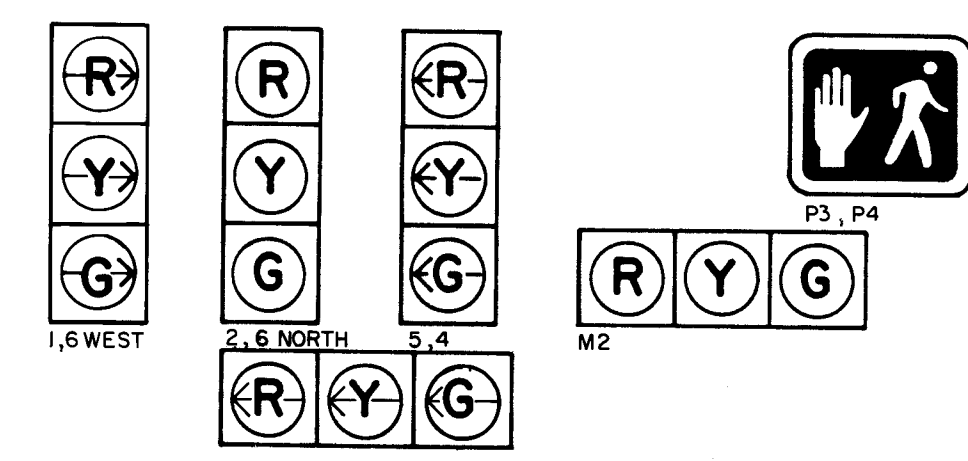


* SIGNAL HEADS

CITY OF ALBUQUERQUE
INFRASTRUCTURE IMPROVEMENTS
MARKET CENTER WEST

TITLE: COORS BOULEVARD SIGNALIZATION

APPROVALS	ENGINEER	DATE	APPROVALS	ENGINEER	DATE
City Engineer	Randy Brown	4/11/99	Liquid Waste	N/A	
A.C.E.-Design			Traffic	Randy Brown	4/1/99
A.C.E.-Hydrology			Water	N/A	
			N.M. Utilities	W. Williams	4-7-99

DRAWING NO. 3575 MAP NO. C-13 SHEET 16 OF 17

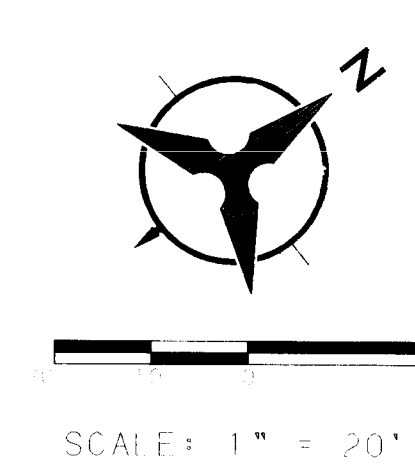

1. ALL CONDUIT TO BE PVC, HEAVY-DUTY, SCHEDULE 40.
2. ALL CONDUIT CONNECTIONS TO BE MADE OF THE SOLVENT WELD TYPE ACCORDING TO THE RECOMMENDATIONS OF THE PVC CONDUIT MANUFACTURER.
3. ALL CONDUIT TO BE RUN IN STRAIGHT-LINE FASHION FROM TERMINAL TO TERMINAL AS CLOSE AS POSSIBLE. SOME MAY HAVE TO USE CONDUITE TO MAKE THE CONNECTIONS.
4. ALL CONDUIT RUNS TO BE CLEARLY LABELED AT END POINTS INSIDE PULL BOXES, MANHOLES, SIGNAL FOUNDATIONS, ETC. LABEL BOTH ENDS OF SAME CONDUIT RUN AS "AA", "BB", "CC", ETC.
5. PULL DETECTOR WIRING NEEDS TO BE 14 STRANDED WIRE WITH SLIDING GALVANIZED.
6. USE 1-INCH GALVANIZED STEEL RISER FOR UTILITY POWER POLE WHICH PROVIDES ELECTRICAL SERVICE TO SIGNALS. TERMINATE IN STANDARD SIZE PULL BOX AT BASE OF POLE WITH UNDER-GROUND CONDUIT.
7. CONTRACTOR SHALL PROVIDE 2-INCH CONDUITS FOR ELECTRICAL SERVICE FROM SERVICE POLE TO PNM POWER SOURCE.
8. CONTRACTOR TO CONTACT PUBLIC SERVICE COMPANY OF NEW MEXICO TO VERIFY SERVICE POLE CONNECTION.
9. CONTRACTOR TO ORDER AND INSTALL THE SIGNAL CONTROLLER/CABINET. SIGNAL CONTROLLER/CABINET TYPE TO BE DETERMINED BY CURRENT/FUTURE PHASING REQUIREMENTS AS DETERMINED BY THE CITY OF ALBUQUERQUE TRANSPORTATION DEPARTMENT. ACCEPTABLE CONTROLLERS ARE SCODERLITZ 800, SIGNAL PACE 300, MULTISYNCS 820. CONTROLLERS NEED TO INCLUDE AND AMPLIFIERS.
10. ADJUST SIGNAL PILE FOUNDATIONS SO AS TO PERMIT GOOD VIEW OF SIGNALS FROM ALL APPROACHES. NO INTERFERENCE WITH STREET LIGHT POLES, STORE SIGNS, TREE BRANCHES, ETC.
11. MOUNT ALL CONTROLLERS SO DOORS FACE AWAY FROM TRAFFIC.
12. ALL SPIRES FOR TRAFFIC SIGNAL MULTI-CONDUCTOR CABLE SHALL BE MADE ABOVE GROUND (EN CABLE OR STANDARD BASE), NO SPLICING OF MCC WILL BE PERMITTED IN PULL BOXES.
13. CONTRACTOR SHALL FURNISH AND INSTALL ALL CONDUCTOR WIRE FOR TRAFFIC SIGNALS, SUCH THAT SIGNALIZATION IS COMPLETE AND OPERATIONAL. ALL WIRING WILL BE INCIDENTAL TO THE CONTRACT AND APPROVED BY THE ENGINEER.
14. ALL WIRE ON THIS PROJECT TO BE COPPER.
15. DETECTOR LOUL LEAD-IN WIRE RUNS FOR #00 AND #5 SHALL BE SEPARATE. DETECTOR LEAD IN WIRE RUN DETECTOR LOUL TO AMPLIFIER WITH CABLE JUNCTION FUNCTION.
16. CONTRACTOR SHALL BORE AND JACK 3-INCH CONDUIT UNDER EXISTING PAVEMENT IN COORS BLVD.
- * NOT PART OF THIS PROJECT.

 CONTROLLER FOUNDATION, TYPE I C.O.A. 2527
 MASTARM FOUNDATION, TYPE II C.O.A. DWG. 2526
 PEDESTAL FOUNDATION, C.O.A. DWG. 2525
 TRAFFIC SIGNAL MANHOLE, C.O.A. DWG. 2524
 PULL BOX, LARGE 17" X 30" C.O.A. 2521
 3" CONDUIT PVC
 2" CONDUIT PVC
 PULL BOX, SMALL 13" X 24" C.O.A. 2521
 PULL BOX DETECTOR C.O.A. DWG. 2522
 SERVICE POLE

	1	2	3	4	5	6	7	8	9	10	11	12
26	35	75	16	90								


LEGEND

 PULL BOX TO BE INSTALLED
 PEDESTAL FOUNDATION TYPE I
 MASTARM FOUNDATION TYPE II
 CONTROLLER FOUNDATION TYPE I
 SERVICE PEDESTAL TO BE INSTALLED (METERING)
 TRAFFIC SIGNAL MANHOLE

APPROVALS	ENGINEER	DATE	APPROVALS	ENGINEER	DATE
For City Engineer	<i>Rogers & Khan</i>	<i>4/1/89</i>	Liquid Waste	<i>N/A</i>	
A.C.E. - Design	"	"	Traffic	<i>Rogers & Khan</i>	<i>4/1/89</i>
A.C.E. - Hydrology	"	"	Water	<i>N/A</i>	
			N.M. Utilities	<i>W. J. ...</i>	<i>4-7-89</i>
DRAWING NO.	3575	MAP NO.	C-13	SHEET	OF 16 17


NOTE: BID ALTERNATE 'B' - ABOVE
GROUND SIGNAL INSTALLATION -
NOT PART OF THIS PROJECT

* * OPTICALLY PROGRAMED SIGNAL
* NOT PART OF THIS PROJECT

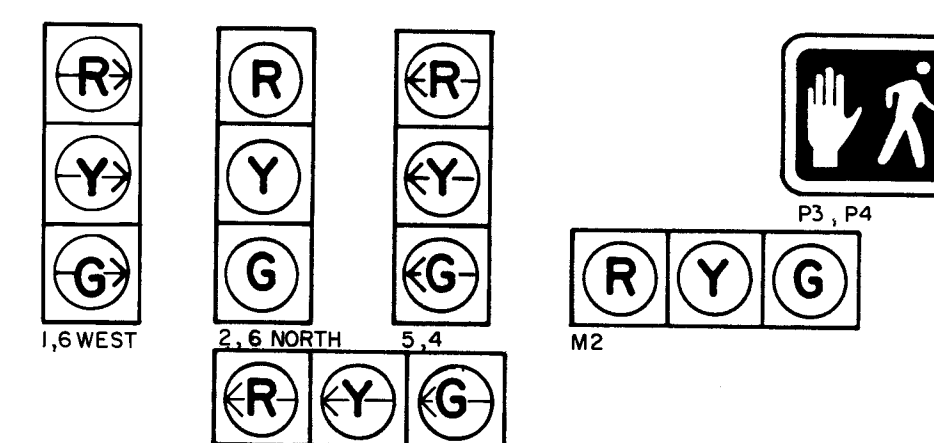

* SIGNAL HEADS

NOTE -
ALL TRAFFIC HEADS 12 INCH WITH SQUARE DOOR HOUSING.

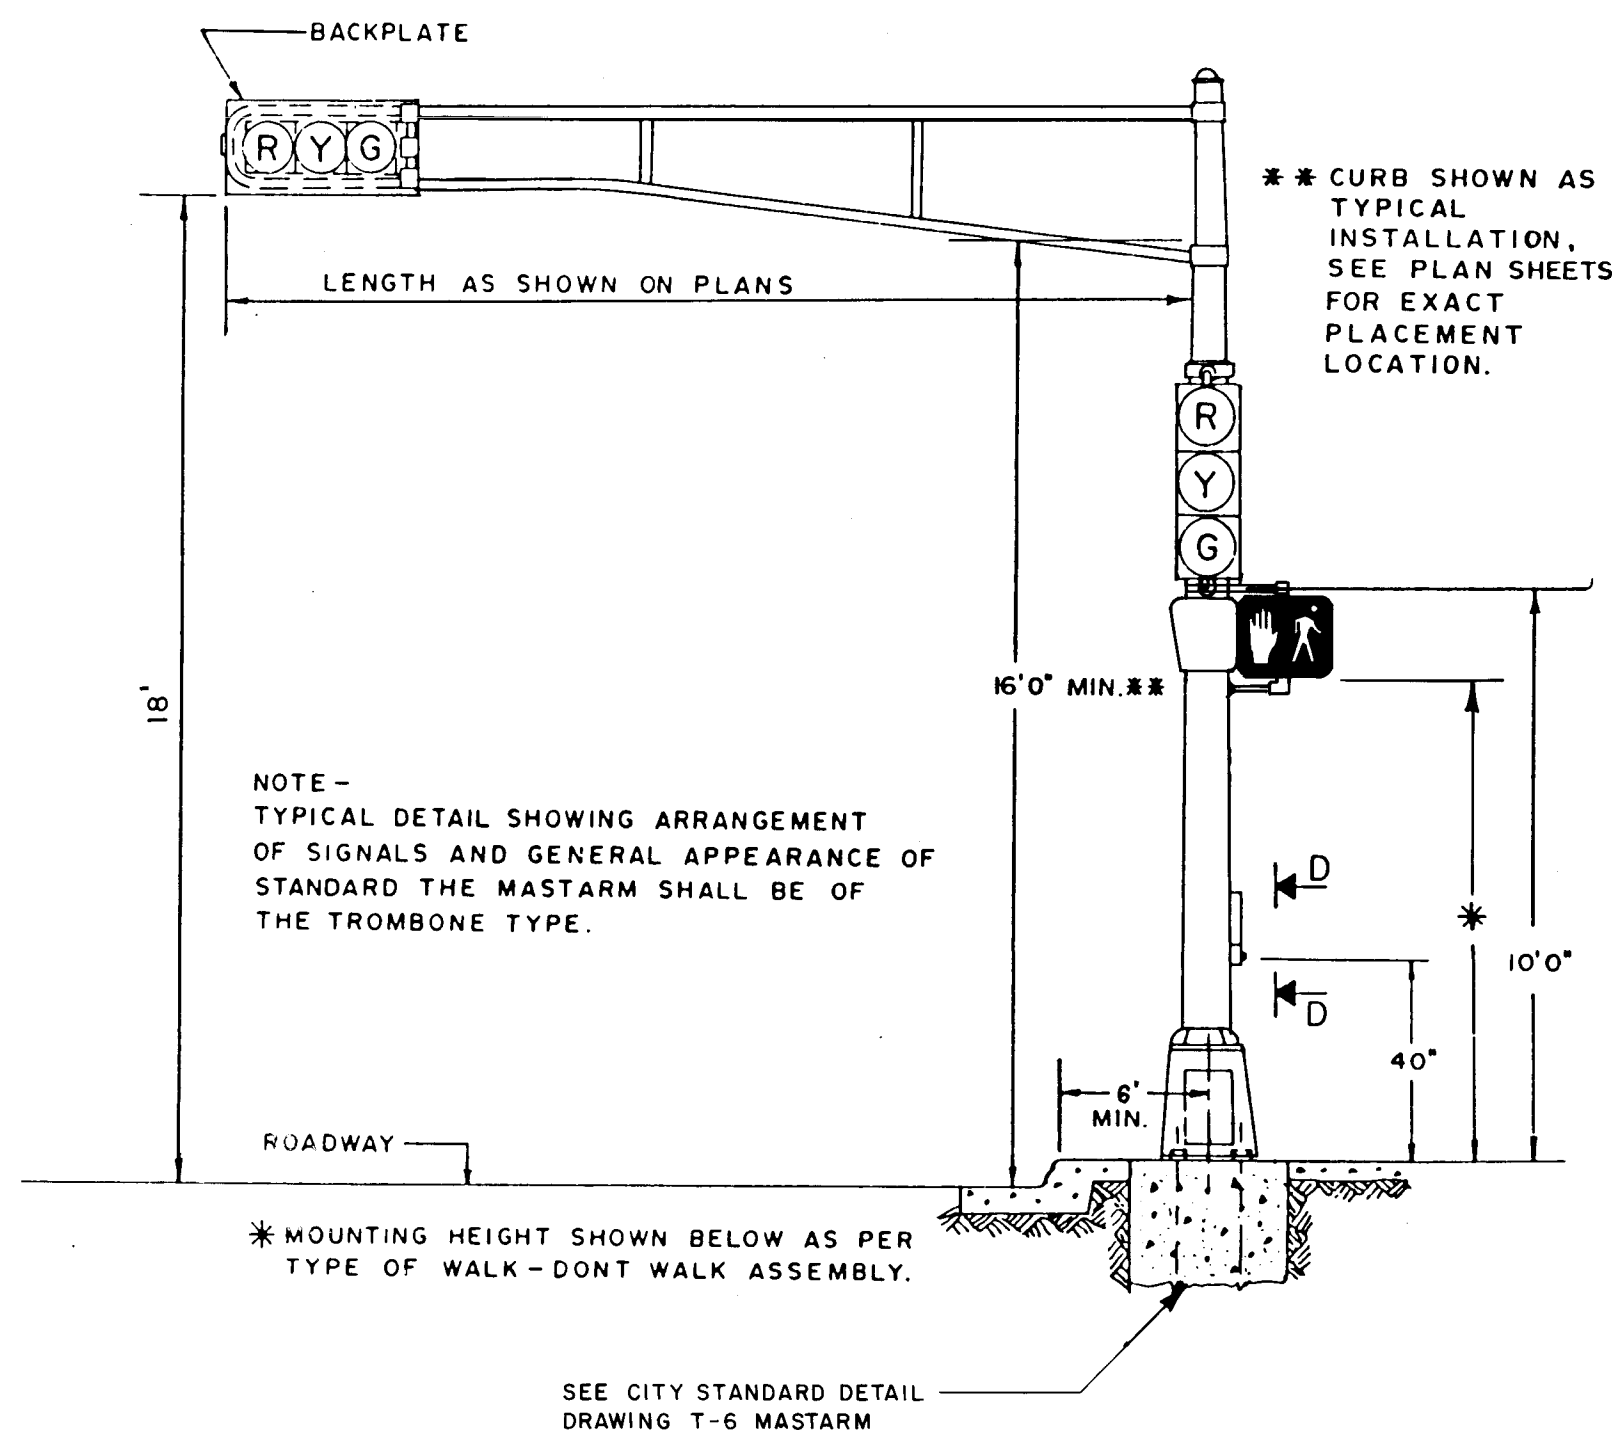


TRAFFIC SIGNAL STANDARD DETAIL - TYPE II (TYPE "B" ARM)


LEFT OR RIGHT ARROW TO
POINT IN DIRECTION OF
APPLICABLE CROSS WALK.

PUSH BUTTON

PEDESTRIAN PUSH BUTTON DETAIL

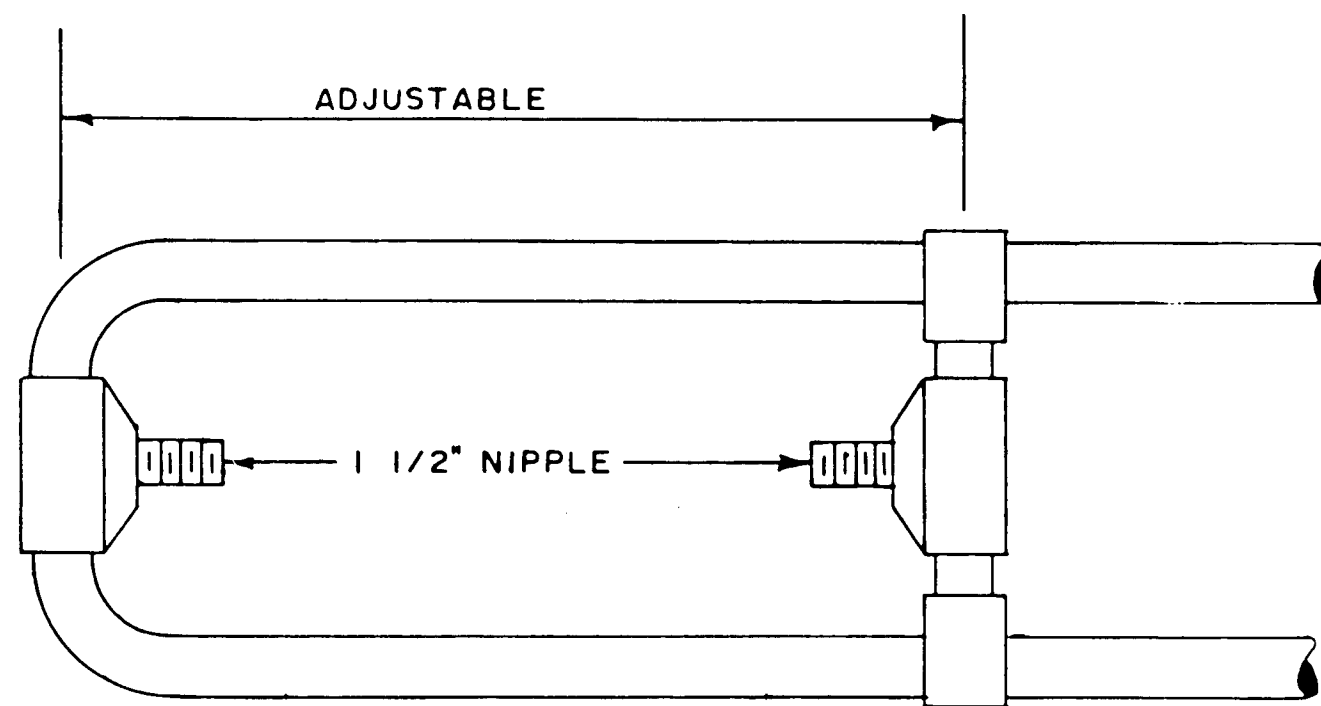

HORIZONTAL MOUNTING DETAIL

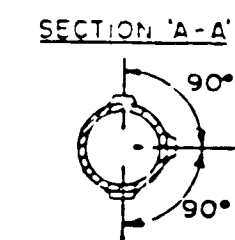


MASTARM
DIRECTION

HUBS NOT IN USE
TO BE PLUGGED


SEE CITY STANDARD DETAIL
DRAWING T-5 PEDESTAL

SHAFT OUTLET DETAILS
(TYPE II AND III STANDARDS)

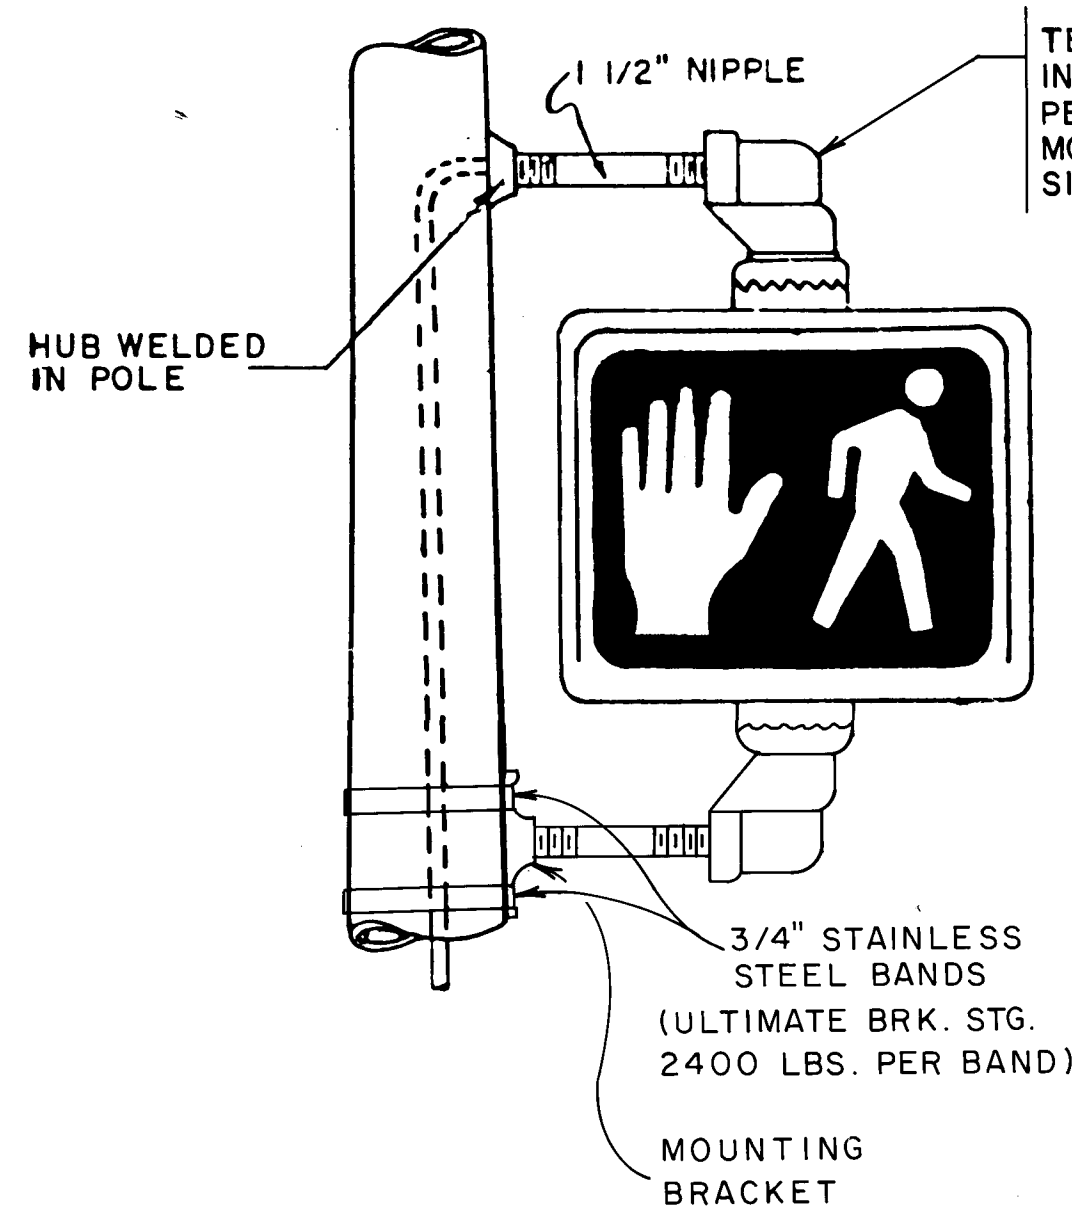


PEDESTRIAN SIGNAL

MOUNTING DETAIL
(TOP OF TYPE I STANDARD)

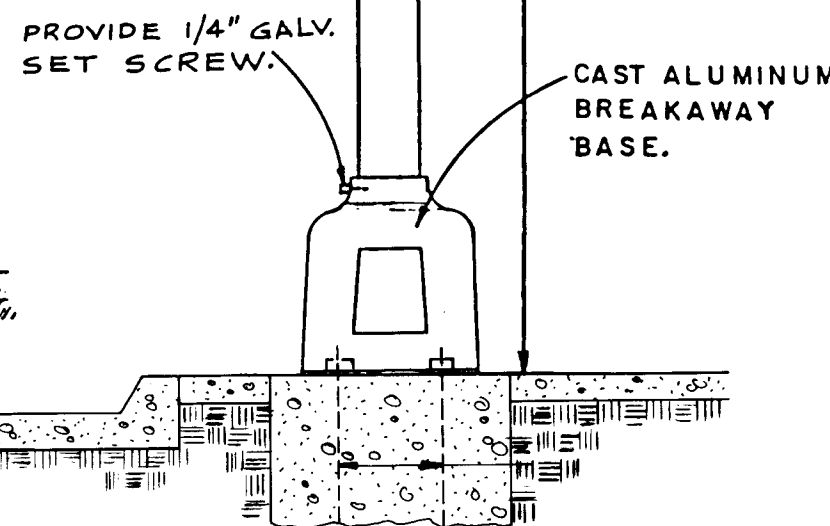

3/4" STAINLESS STEEL BANDS
(ULTIMATE BREAKING STRENGTH
2400 LBS. PER BAND).

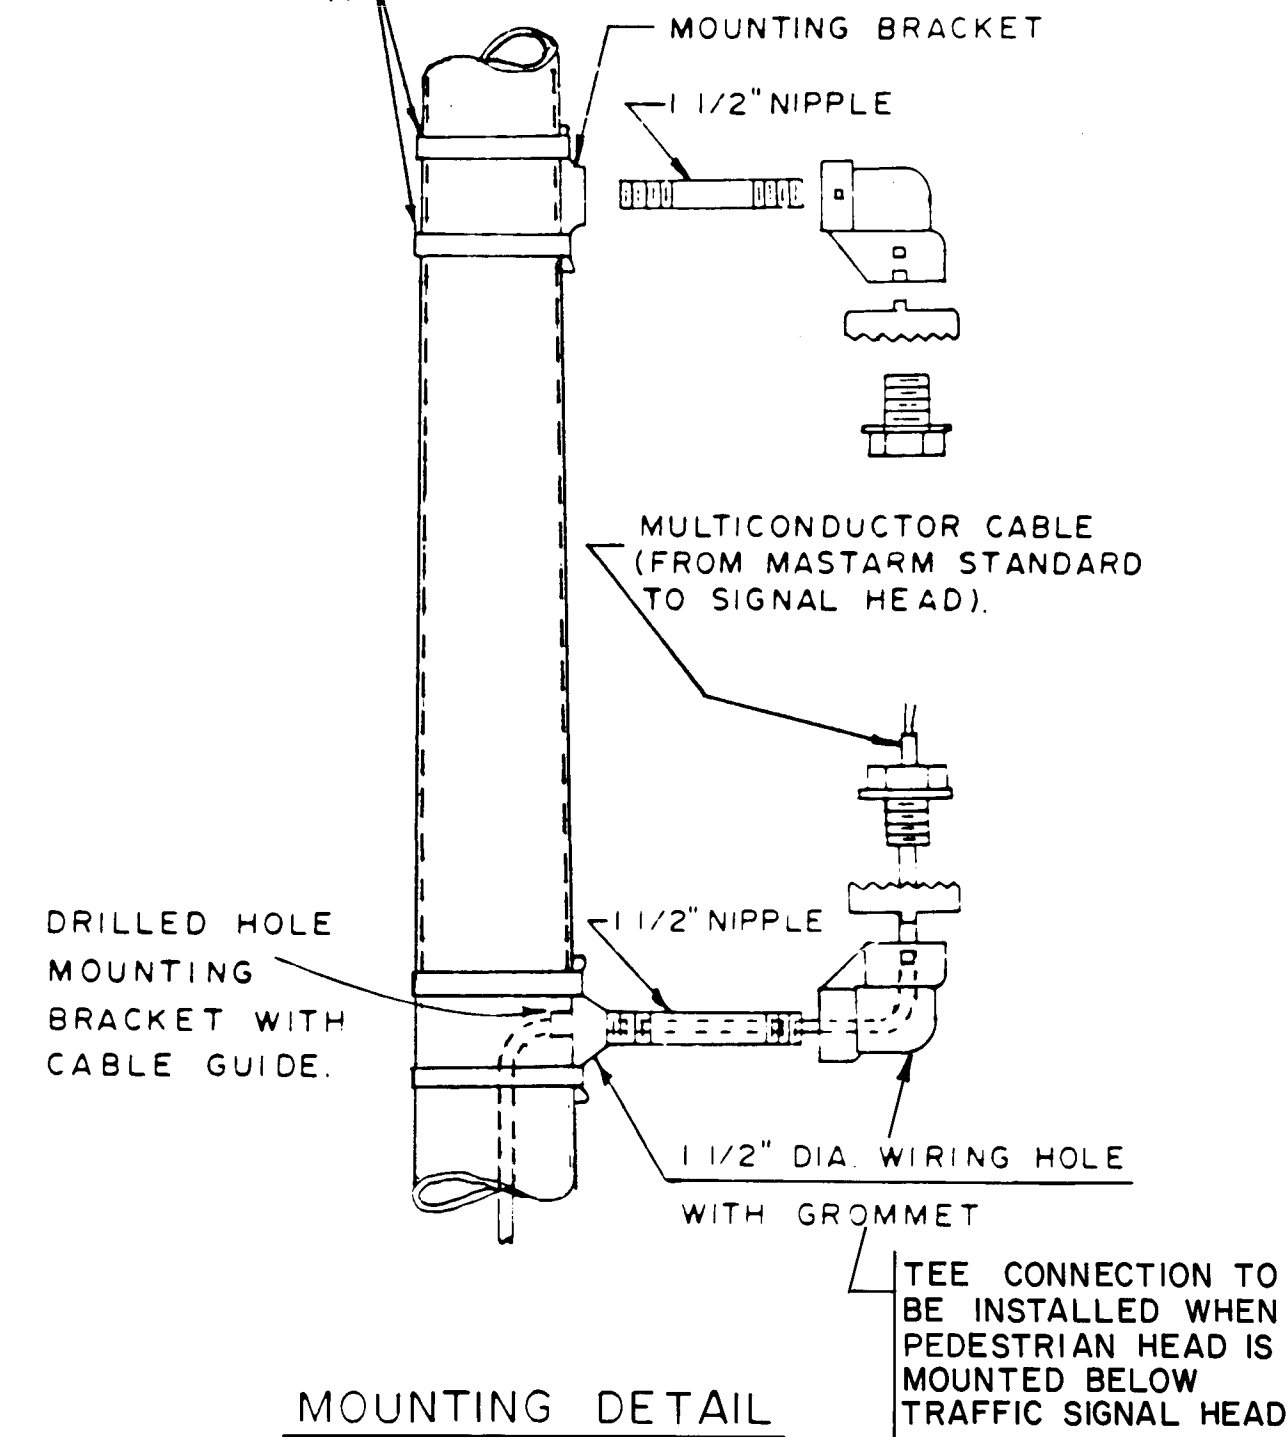


MOUNTING DETAIL
(SIDE OF SHAFT)

EPOXY RESIN
TURNS OF WIRE
(AS REQUIRED)

SECTION A-A

NOTE:
ALL LOOP DETECTORS TO BE INDIVIDUALLY
WIRED TO THE CONTROLLER. WIRING TO
BE SLIDING SLEEVE # 14AWG X HHW STD.
WIRING.

TYPICAL ROADWAY LOOP SAWCUT DETAIL

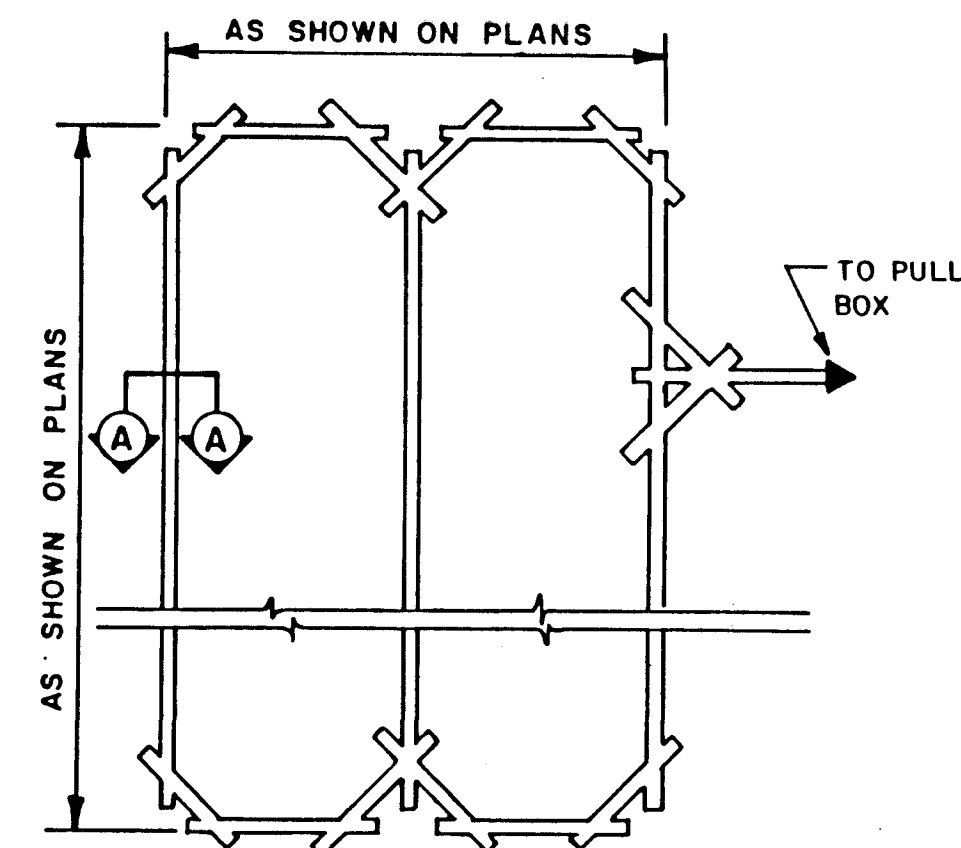

I, George T. Burt, do hereby certify the drawing of the
"As Shown" condition was done under my
supervision.




NOTE: BID ALTERNATE 'B' - ABOVE
GROUND SIGNAL INSTALLATION -
NOT PART OF THIS PROJECT

- GENERAL NOTES:
1. ALL CONDUIT TO BE PVC, HEAVY-DUTY, SCHEDULE 40.
 2. ALL CONDUIT CONNECTIONS TO BE MADE OF THE SOLVENT WELD TYPE ACCORDING TO THE RECOMMENDATIONS OF THE PVC CONDUIT MANUFACTURER.
 3. ALL CONDUIT TO BE RUN IN STRAIGHT-LINE FASHION FROM TERMINAL TO TERMINAL AS MUCH AS POSSIBLE. SOME MAY HAVE TO FOLLOW CURVATURE TO STAY WITHIN RIGHT-OF-WAY.
 4. ALL CONDUIT RUNS TO BE CLEARLY LABELED AT END POINTS INSIDE PULL BOXES, MANHOLES, SIGNAL FOUNDATIONS, ETC. LABEL BOTH ENDS OF SAME CONDUIT RUN AS "AA", "BB", "CC", ETC.
 5. LOOP DETECTOR WIRING NEEDS TO BE 14 STRANDED WIRE WITH SLIDING SLEEVE.
 6. USE 1-INCH GALVANIZED STEEL RISER FOR UTILITY POWER POLE WHICH PROVIDES ELECTRICAL SERVICE TO SIGNALS. TERMINATE IN STANDARD SIZE PULL BOX AT BASE OF POLE WITH UNDERGROUND CONDUIT.
 7. CONTRACTOR SHALL PROVIDE 2-INCH CONDUIT FOR ELECTRICAL SERVICE FROM SERVICE POLE TO PNM POWER SOURCE.
 8. CONTRACTOR TO CONTACT PUBLIC SERVICE COMPANY OF NEW MEXICO TO VERIFY SERVICE POLE CONNECTION.
 9. THE CONTRACTOR WILL FURNISH AND INSTALL THE SIGNAL CONTROLLER/CABINET. SIGNAL CONTROLLER/CABINET SIZE AND TYPE TO BE DETERMINED BY CURRENT/FUTURE PEASING REQUIREMENTS AS DETERMINED BY THE CITY OF ALBUQUERQUE TRANSPORTATION DEPARTMENT. ACCEPTABLE CONTROLLERS ARE: ECOLITE ASC 8000, EAGLE SPAC 300, MULTISONICS 820. CONTROLLERS NEED TO INCLUDE NEMA PLUS CONFLICT MONITOR, LOAD SWITCHES, RELAYS AND AMPLIFIERS.
 10. ADJUST SIGNAL POLE FOUNDATIONS SO AS TO PERMIT GOOD VISIBILITY OF SIGNAL INDICATIONS. CHECK FOR CONFLICT WITH STREET LIGHT POLES, STORE SIGNS, TREE BRANCHES, ETC.
 11. MOUNT ALL CONTROLLERS SO DOORS FACE AWAY FROM TRAFFIC.
 12. ALL SPLICES FOR TRAFFIC SIGNAL MULTI-CONDUCTOR CABLE SHALL BE MADE ABOVE GROUND (IN CABINET OR STANDARD BASE). NO SPLICING OF MCC WILL BE PERMITTED IN PULL BOXES.
 13. CONTRACTOR SHALL FURNISH AND INSTALL ALL CONDUCTOR WIRE FOR TRAFFIC SIGNALS, SUCH THAT SIGNALIZATION IS COMPLETE AND OPERATIONAL. ALL WIRING WILL BE INCIDENTAL TO THE CONTRACT AND APPROVED BY THE ENGINEER.
 14. ALL WIRE ON THIS PROJECT TO BE COPPER.
- * NOT PART OF THIS PROJECT


NOTE:
WIRES MUST BE WOUND IN
THE DIRECTION SHOWN.

QUADRAPOLE LOOP DETAIL

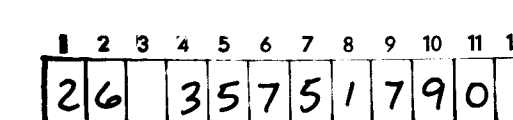

CITY OF ALBUQUERQUE INFRASTRUCTURE IMPROVEMENTS MARKET CENTER WEST					
SIGNALIZATION DETAILS					
APPROVALS	ENGINEER	DATE	APPROVALS	ENGINEER	DATE
City Engineer	Ryan A. Hara	4/11/19	Liquid Waste	N/A	
A.C.E. - Design	"	"	Traffic	Ryan A. Hara	4/11/19
A.C.E. - Hydrology	"	"	Water	N/A	
			N.M. Utilities	Theresa...	4/22/19
DRAWING NO.	3575	MAP NO.	C-13	SHEET	17 OF 17

NOTE -
ALL TRAFFIC HEADS 12 INCH WITH SQUARE DOOR HOUSING.

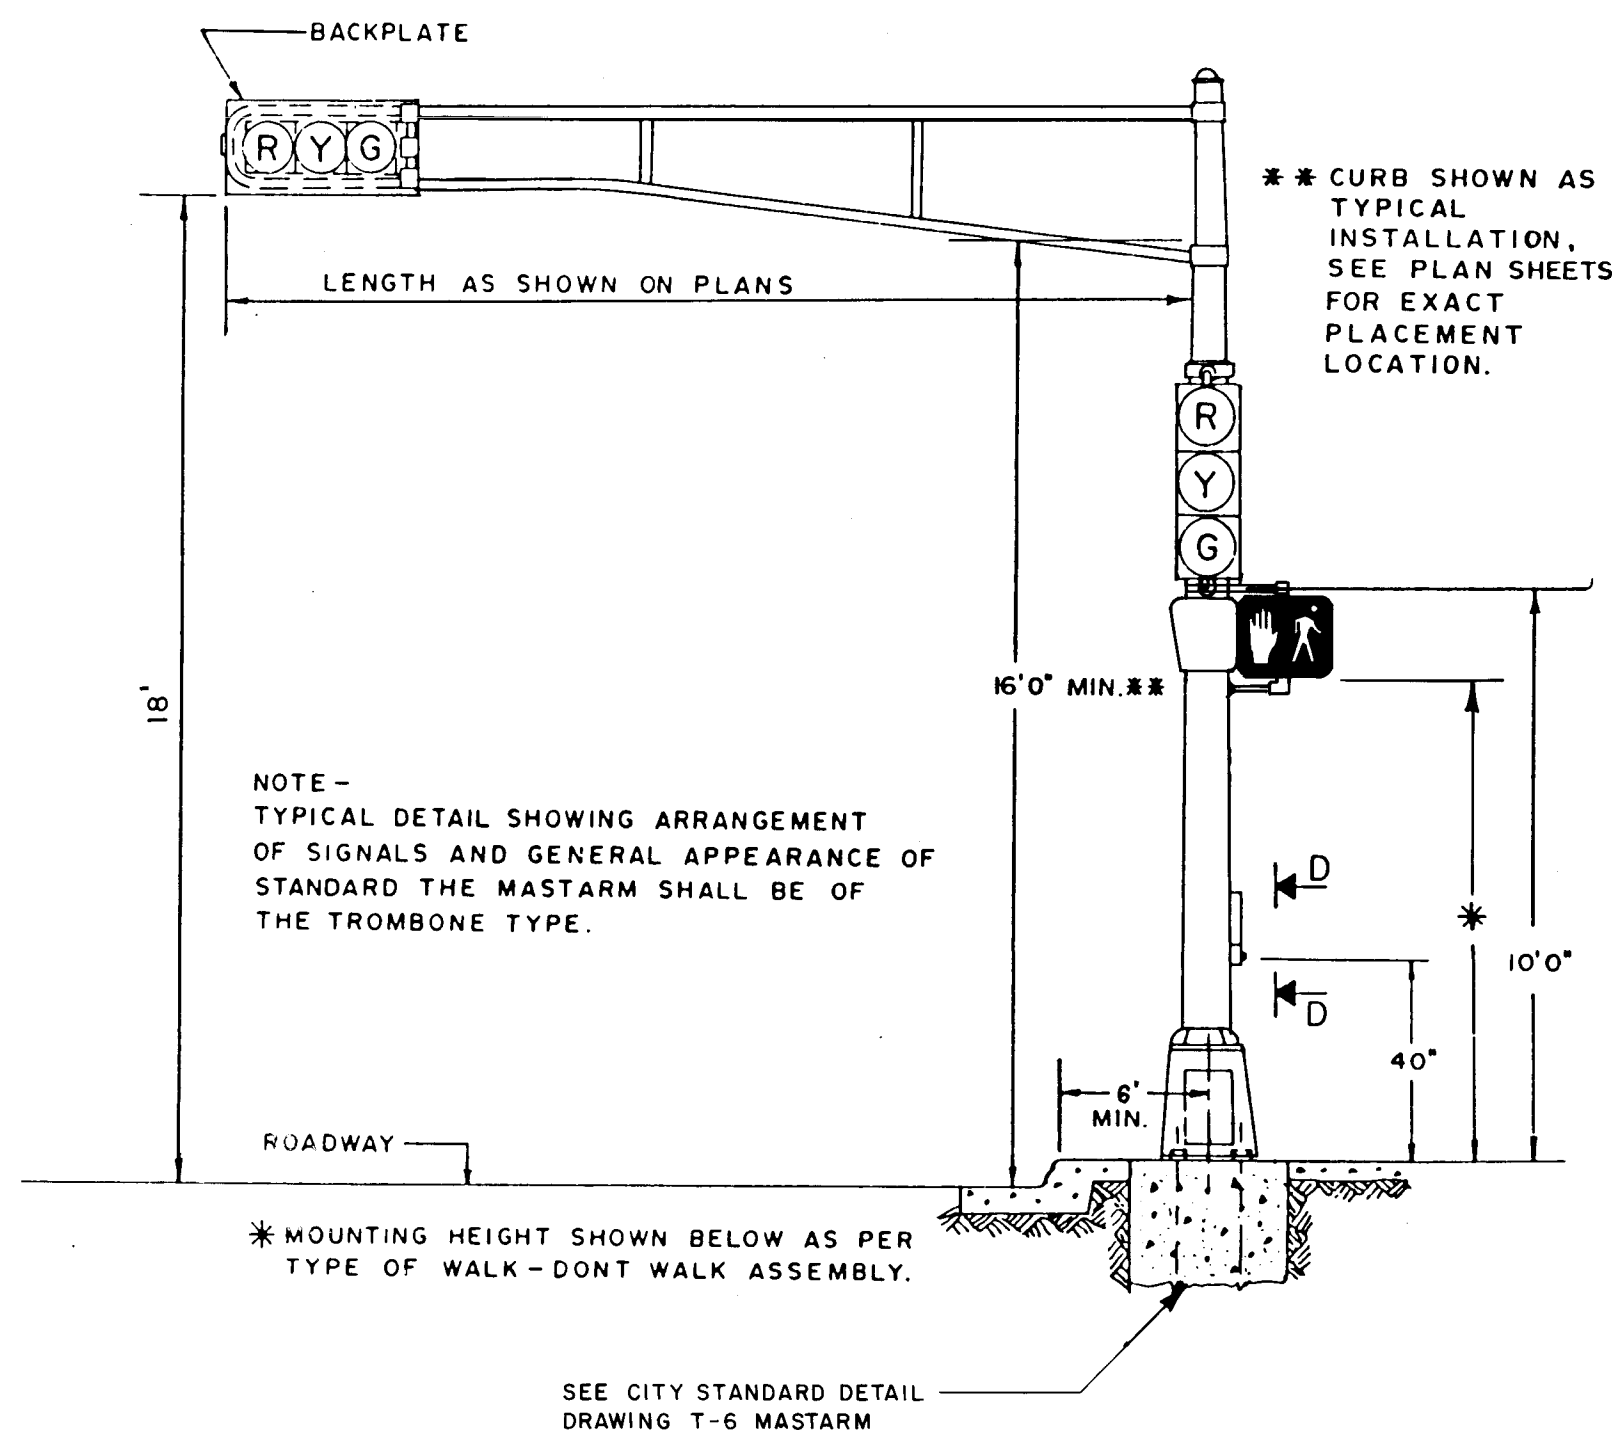


TRAFFIC SIGNAL STANDARD DETAIL - TYPE II (TYPE "B" ARM)


LEFT OR RIGHT ARROW TO
POINT IN DIRECTION OF
APPLICABLE CROSS WALK.

PUSH BUTTON

PEDESTRIAN PUSH BUTTON DETAIL

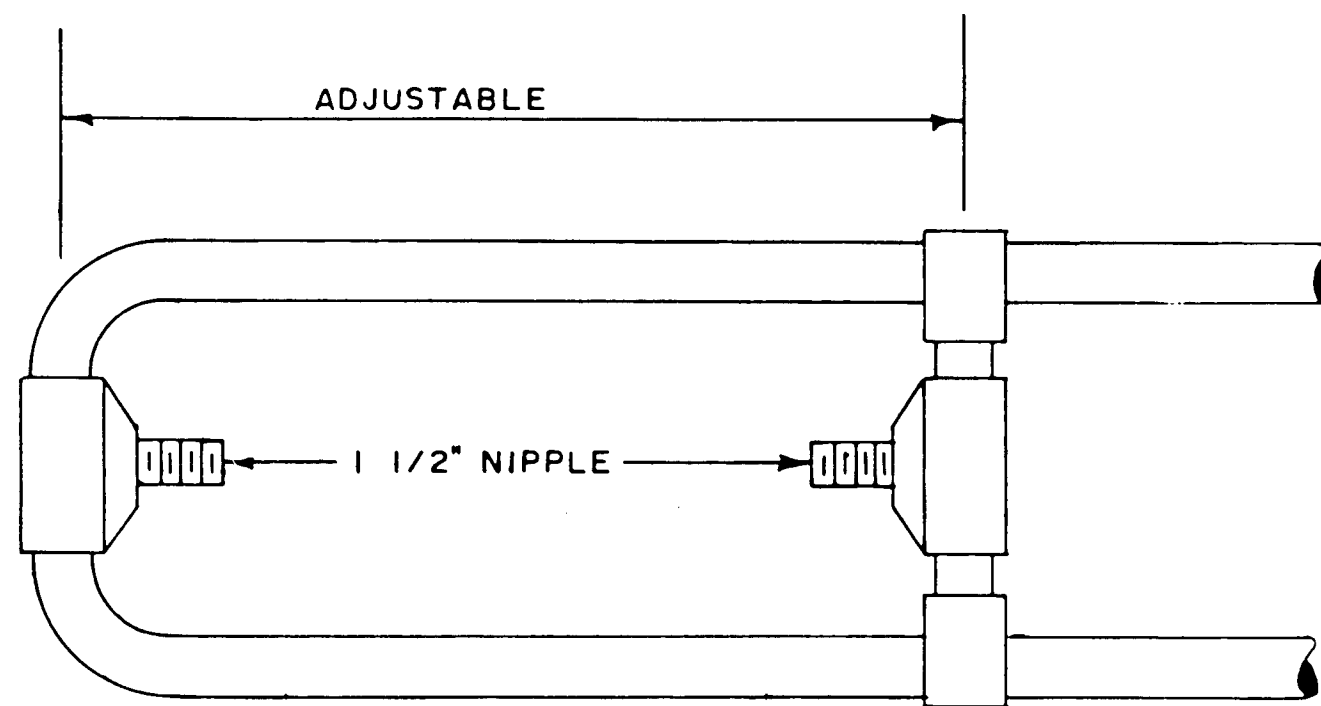

HORIZONTAL MOUNTING DETAIL

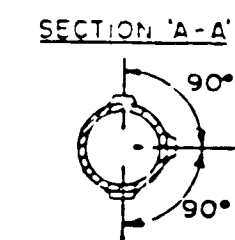


MASTARM
DIRECTION

HUBS NOT IN USE
TO BE PLUGGED


SEE CITY STANDARD DETAIL
DRAWING T-5 PEDESTAL

SHAFT OUTLET DETAILS
(TYPE II AND III STANDARDS)

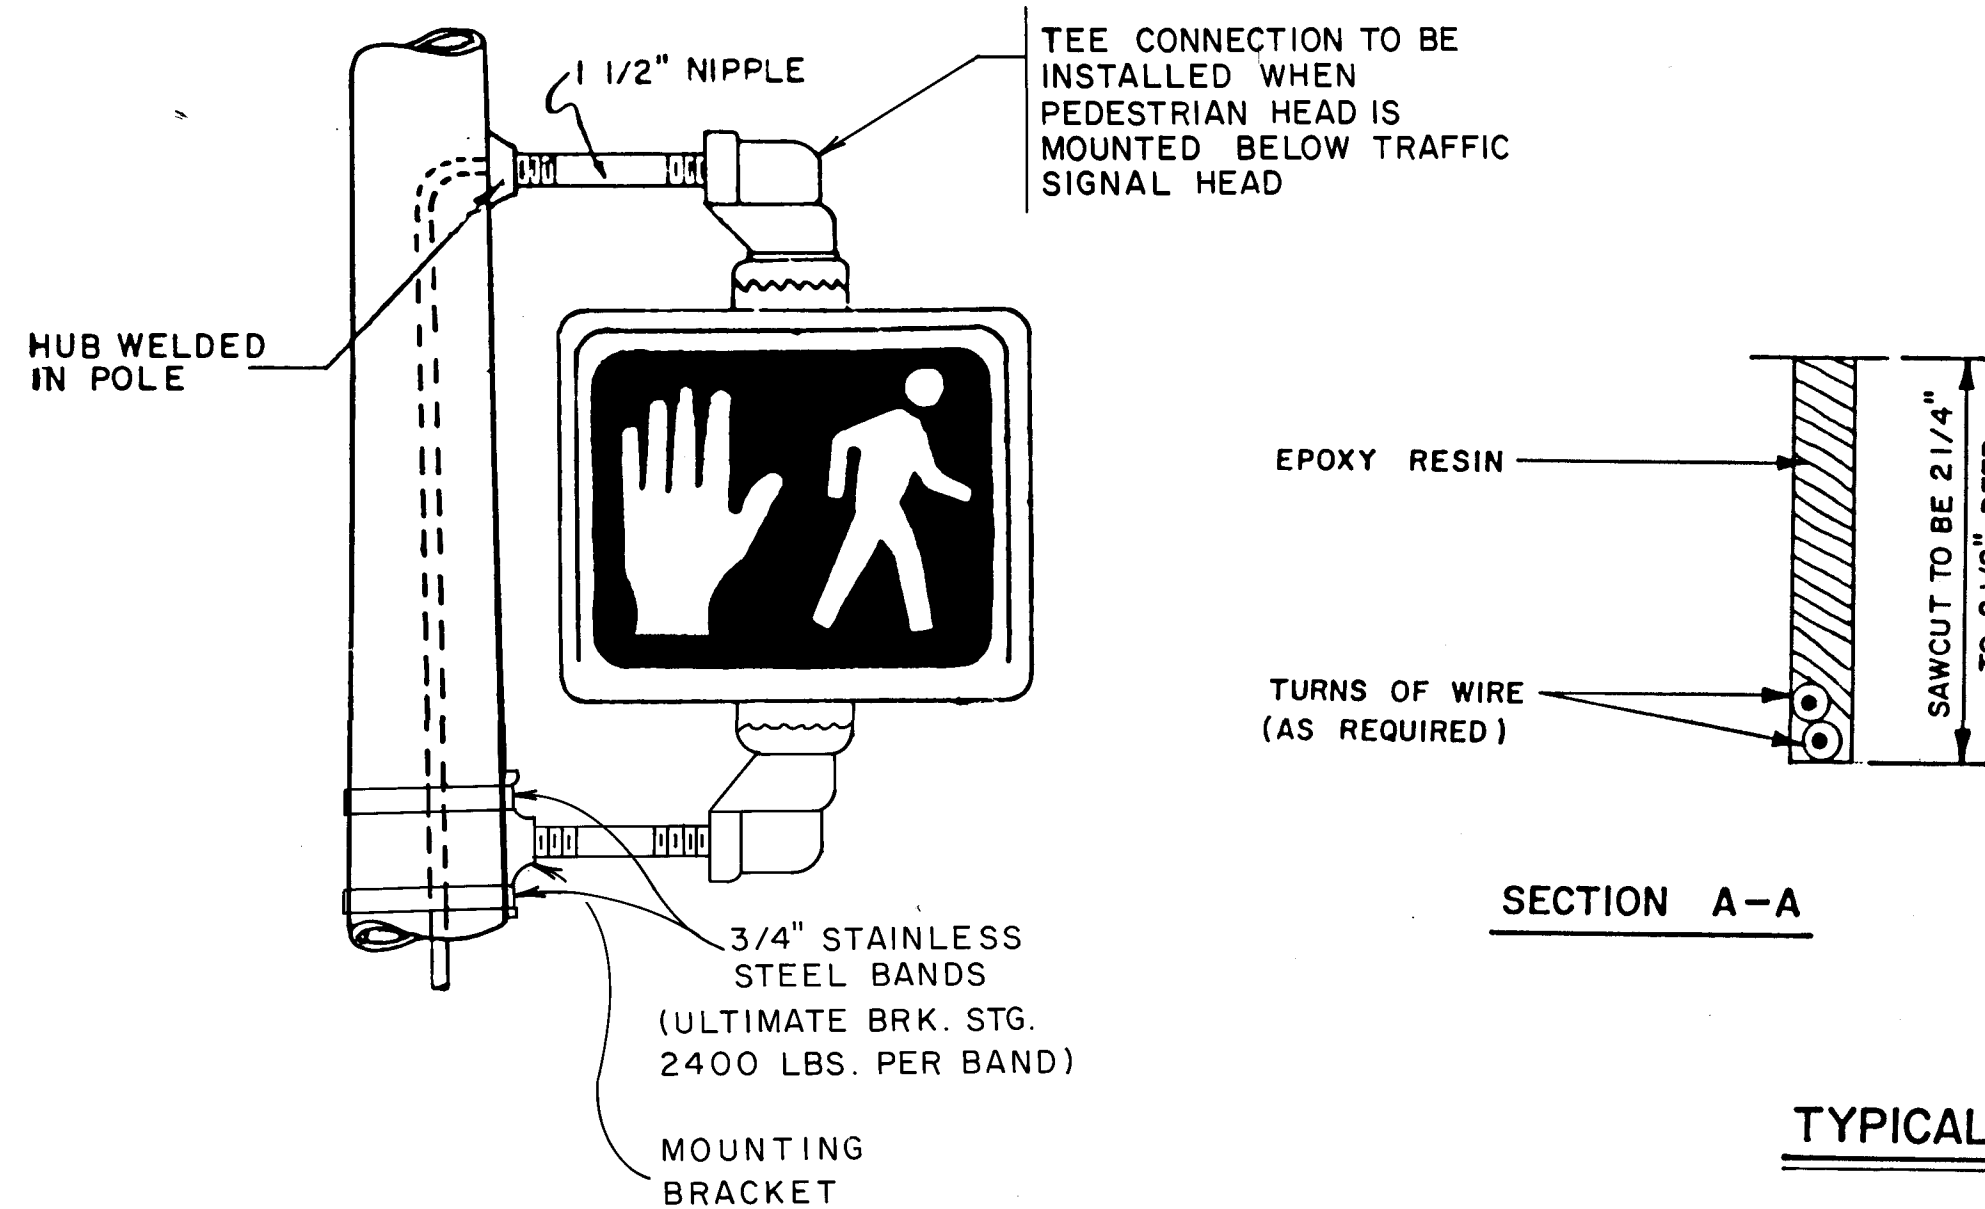


PEDESTRIAN SIGNAL

3/4" STAINLESS STEEL BANDS
(ULTIMATE BREAKING STRENGTH
2400 LBS. PER BAND).

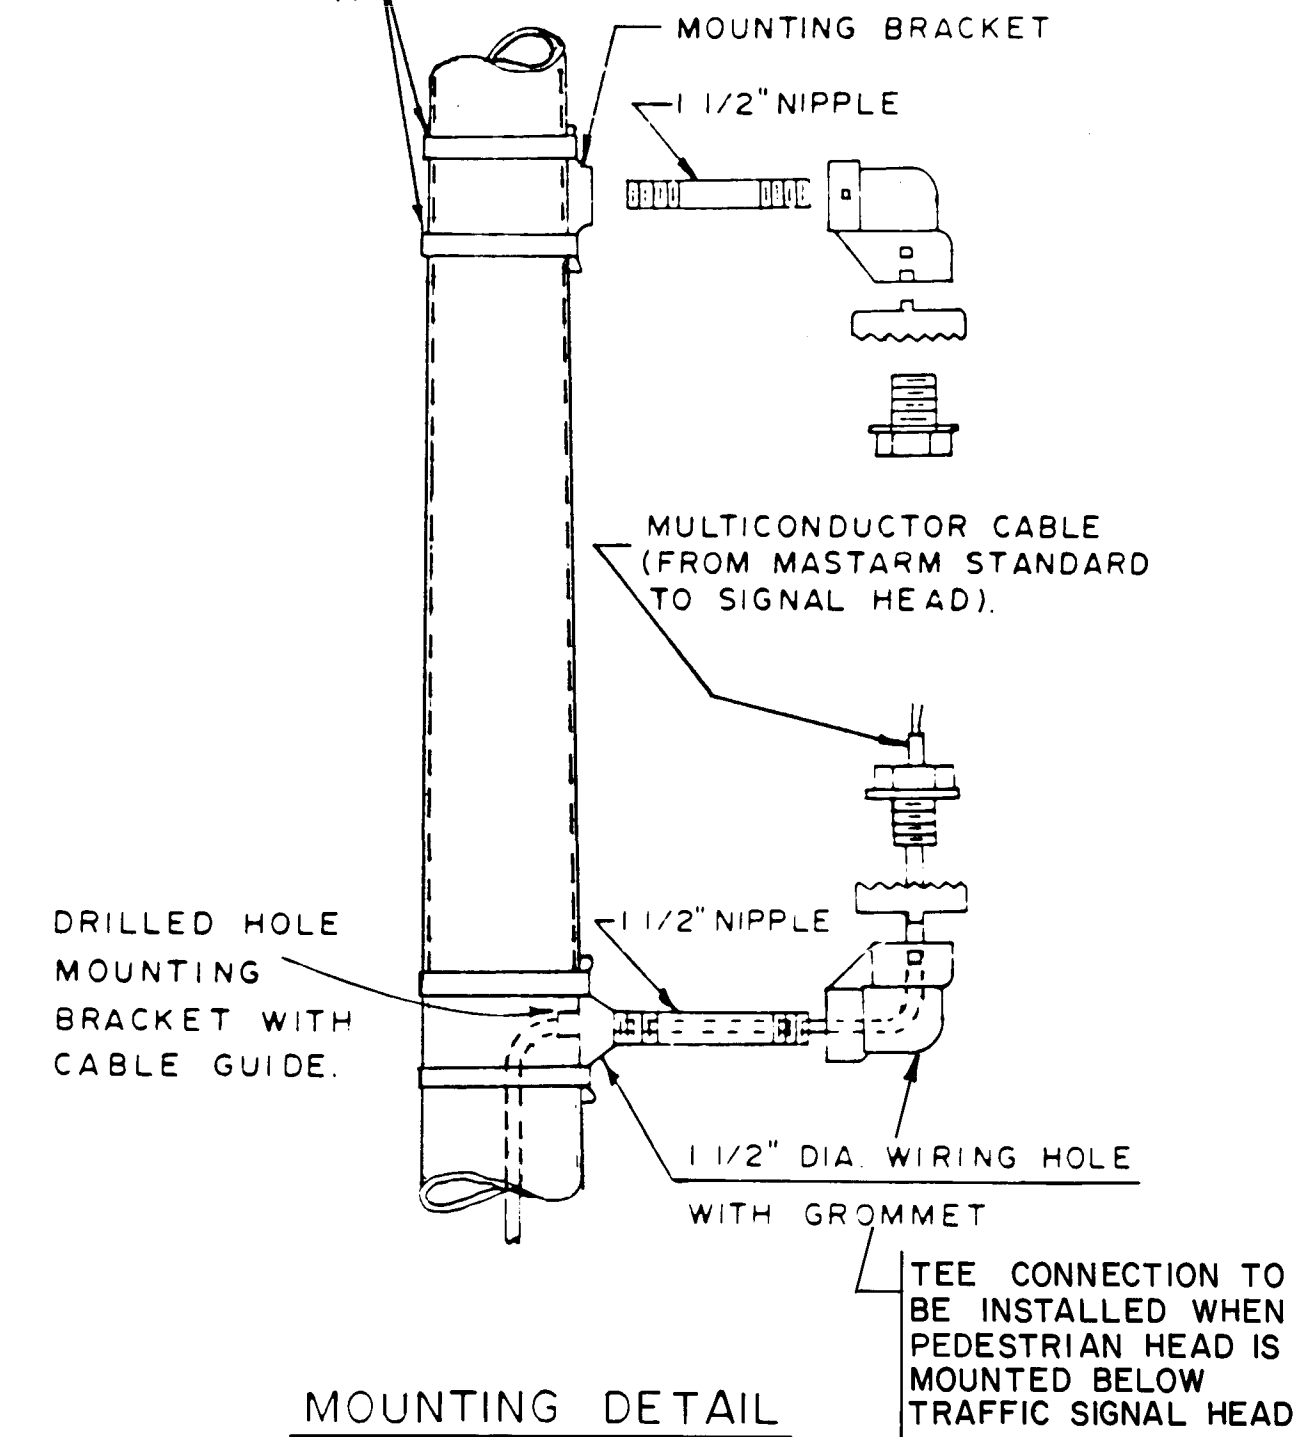

MOUNTING DETAIL
(SIDE OF SHAFT)

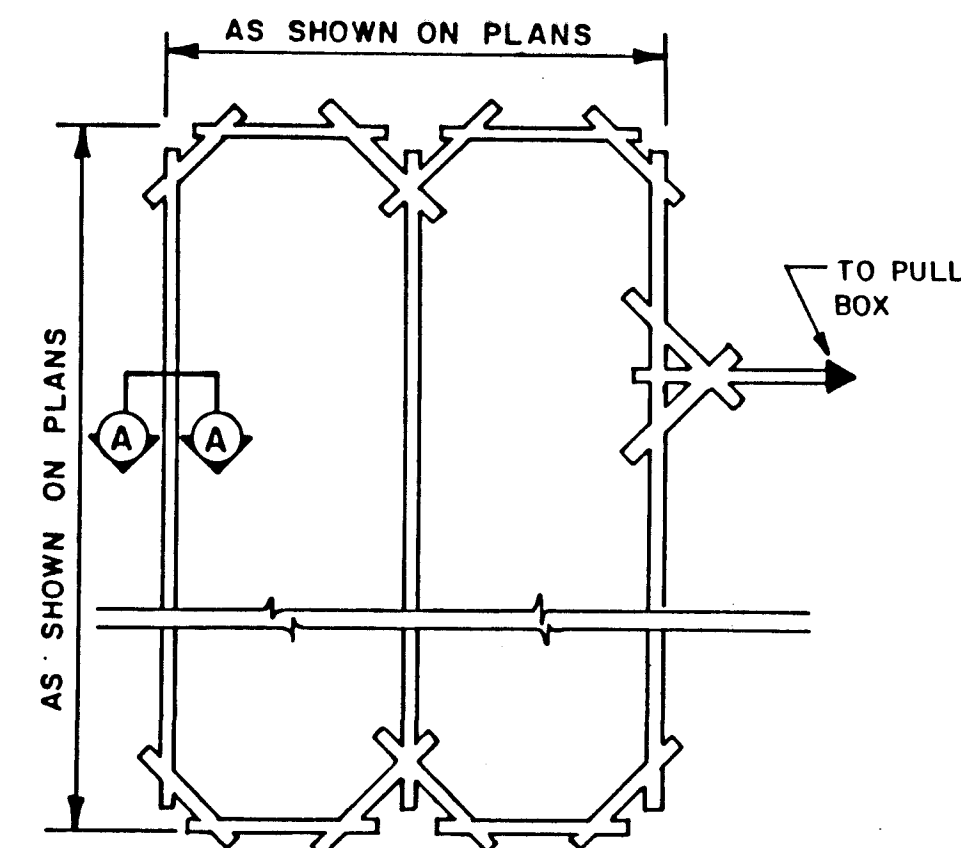

TYPICAL ROADWAY LOOP SAWCUT DETAIL


NOTE: ALL LOOP DETECTORS TO BE INDIVIDUALLY
WIRED TO THE CONTROLLER. WIRING TO
BE SLIDING SLEEVE #14AWG X HHW STD.
WIRING.

NOTE: BID ALTERNATE 'B' - ABOVE
GROUND SIGNAL INSTALLATION -
NOT PART OF THIS PROJECT

- GENERAL NOTES:
1. ALL CONDUIT TO BE PVC, HEAVY-DUTY, SCHEDULE 40.
 2. ALL CONDUIT CONNECTIONS TO BE MADE OF THE SOLVENT WELD TYPE ACCORDING TO THE RECOMMENDATIONS OF THE PVC CONDUIT MANUFACTURER.
 3. ALL CONDUIT TO BE RUN IN STRAIGHT-LINE FASHION FROM TERMINAL TO TERMINAL AS MUCH AS POSSIBLE. SOME MAY HAVE TO FOLLOW CURVATURE TO STAY WITHIN RIGHT-OF-WAY.
 4. ALL CONDUIT RUNS TO BE CLEARLY LABELED AT END POINTS INSIDE PULL BOXES, MANHOLES, SIGNAL FOUNDATIONS, ETC. LABEL BOTH ENDS OF SAME CONDUIT RUN AS "AA", "BB", "CC", ETC.
 5. LOOP DETECTOR WIRING NEEDS TO BE 14 STRANDED WIRE WITH SLIDING SLEEVE.
 6. USE 1-INCH GALVANIZED STEEL RISER FOR UTILITY POWER POLE WHICH PROVIDES ELECTRICAL SERVICE TO SIGNALS. TERMINATE IN STANDARD SIZE PULL BOX AT BASE OF POLE WITH UNDERGROUND CONDUIT.
 7. CONTRACTOR SHALL PROVIDE 2-INCH CONDUIT FOR ELECTRICAL SERVICE FROM SERVICE POLE TO PNM POWER SOURCE.
 8. CONTRACTOR TO CONTACT PUBLIC SERVICE COMPANY OF NEW MEXICO TO VERIFY SERVICE POLE CONNECTION.
 9. THE CONTRACTOR WILL FURNISH AND INSTALL THE SIGNAL CONTROLLER/CABINET. SIGNAL CONTROLLER/CABINET SIZE AND TYPE TO BE DETERMINED BY CURRENT/FUTURE PEASING REQUIREMENTS AS DETERMINED BY THE CITY OF ALBUQUERQUE TRANSPORTATION DEPARTMENT. ACCEPTABLE CONTROLLERS ARE: ECOLITE ASC 8000, EAGLE SPAC 300, MULTISONICS 820. CONTROLLERS NEED TO INCLUDE NEMA PLUS CONFLICT MONITOR, LOAD SWITCHES, RELAYS AND AMPLIFIERS.
 10. ADJUST SIGNAL POLE FOUNDATIONS SO AS TO PERMIT GOOD VISIBILITY OF SIGNAL INDICATIONS. CHECK FOR CONFLICT WITH STREET LIGHT POLES, STORE SIGNS, TREE BRANCHES, ETC.
 11. MOUNT ALL CONTROLLERS SO DOORS FACE AWAY FROM TRAFFIC.
 12. ALL SPLICES FOR TRAFFIC SIGNAL MULTI-CONDUCTOR COBLE SHALL BE MADE ABOVE GROUND (IN CABINET OR STANDARD BASE). NO SPLICING OF MCC WILL BE PERMITTED IN PULL BOXES.
 13. CONTRACTOR SHALL FURNISH AND INSTALL ALL CONDUCTOR WIRE FOR TRAFFIC SIGNALS, SUCH THAT SIGNALIZATION IS COMPLETE AND OPERATIONAL. ALL WIRING WILL BE INCIDENTAL TO THE CONTRACT AND APPROVED BY THE ENGINEER.
 14. ALL WIRE ON THIS PROJECT TO BE COPPER.

* NOT PART OF THIS PROJECT

AS-BUILT INFORMATION		BENCH MARKS		SURVEY INFORMATION	
CONTRACTOR	DATE	NO.	DATE	NO.	DATE
WORK	DATE	NO.	DATE	NO.	DATE
STAKED BY	DATE	NO.	DATE	NO.	DATE
ACCEPTED BY	DATE	NO.	DATE	NO.	DATE
FIELD	DATE	NO.	DATE	NO.	DATE
REVISIONS	DATE	NO.	DATE	NO.	DATE
DESIGN	DATE	NO.	DATE	NO.	DATE
CHECKED BY	DATE	NO.	DATE	NO.	DATE
RECORDED BY	DATE	NO.	DATE	NO.	DATE

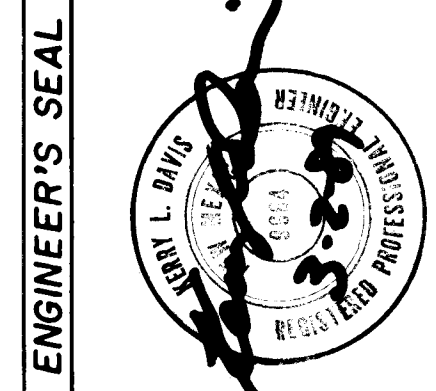

REVISIONS		DESIGN		CHECKED BY	
NO.	DATE	NO.	DATE	NO.	DATE
1	4/1/99	1	4/1/99	1	4/1/99
2	4/1/99	2	4/1/99	2	4/1/99
3	4/1/99	3	4/1/99	3	4/1/99
4	4/1/99	4	4/1/99	4	4/1/99
5	4/1/99	5	4/1/99	5	4/1/99
6	4/1/99	6	4/1/99	6	4/1/99
7	4/1/99	7	4/1/99	7	4/1/99
8	4/1/99	8	4/1/99	8	4/1/99
9	4/1/99	9	4/1/99	9	4/1/99
10	4/1/99	10	4/1/99	10	4/1/99
11	4/1/99	11	4/1/99	11	4/1/99
12	4/1/99	12	4/1/99	12	4/1/99

NOTE: WIRES MUST BE WOUND IN
THE DIRECTION SHOWN.

QUADRAPOLE LOOP DETAIL

CITY OF ALBUQUERQUE
INFRASTRUCTURE IMPROVEMENTS
MARKET CENTER WEST

TITLE: SIGNALIZATION DETAILS

APPROVALS	ENGINEER	DATE	APPROVALS	ENGINEER	DATE
City Engineer	Robert A. Hara	4/1/99	Liquid Waste	N/A	
A.C.E. - Design	"	"	Traffic	Robert A. Hara	4/1/99
A.C.E. - Hydrology	"	"	Water	N/A	
			N.M. Utilities	Theresa	4/2/99

DRAWING NO. 3575 MAP NO. C-13 SHEET 17 OF 17

NO SCALE