
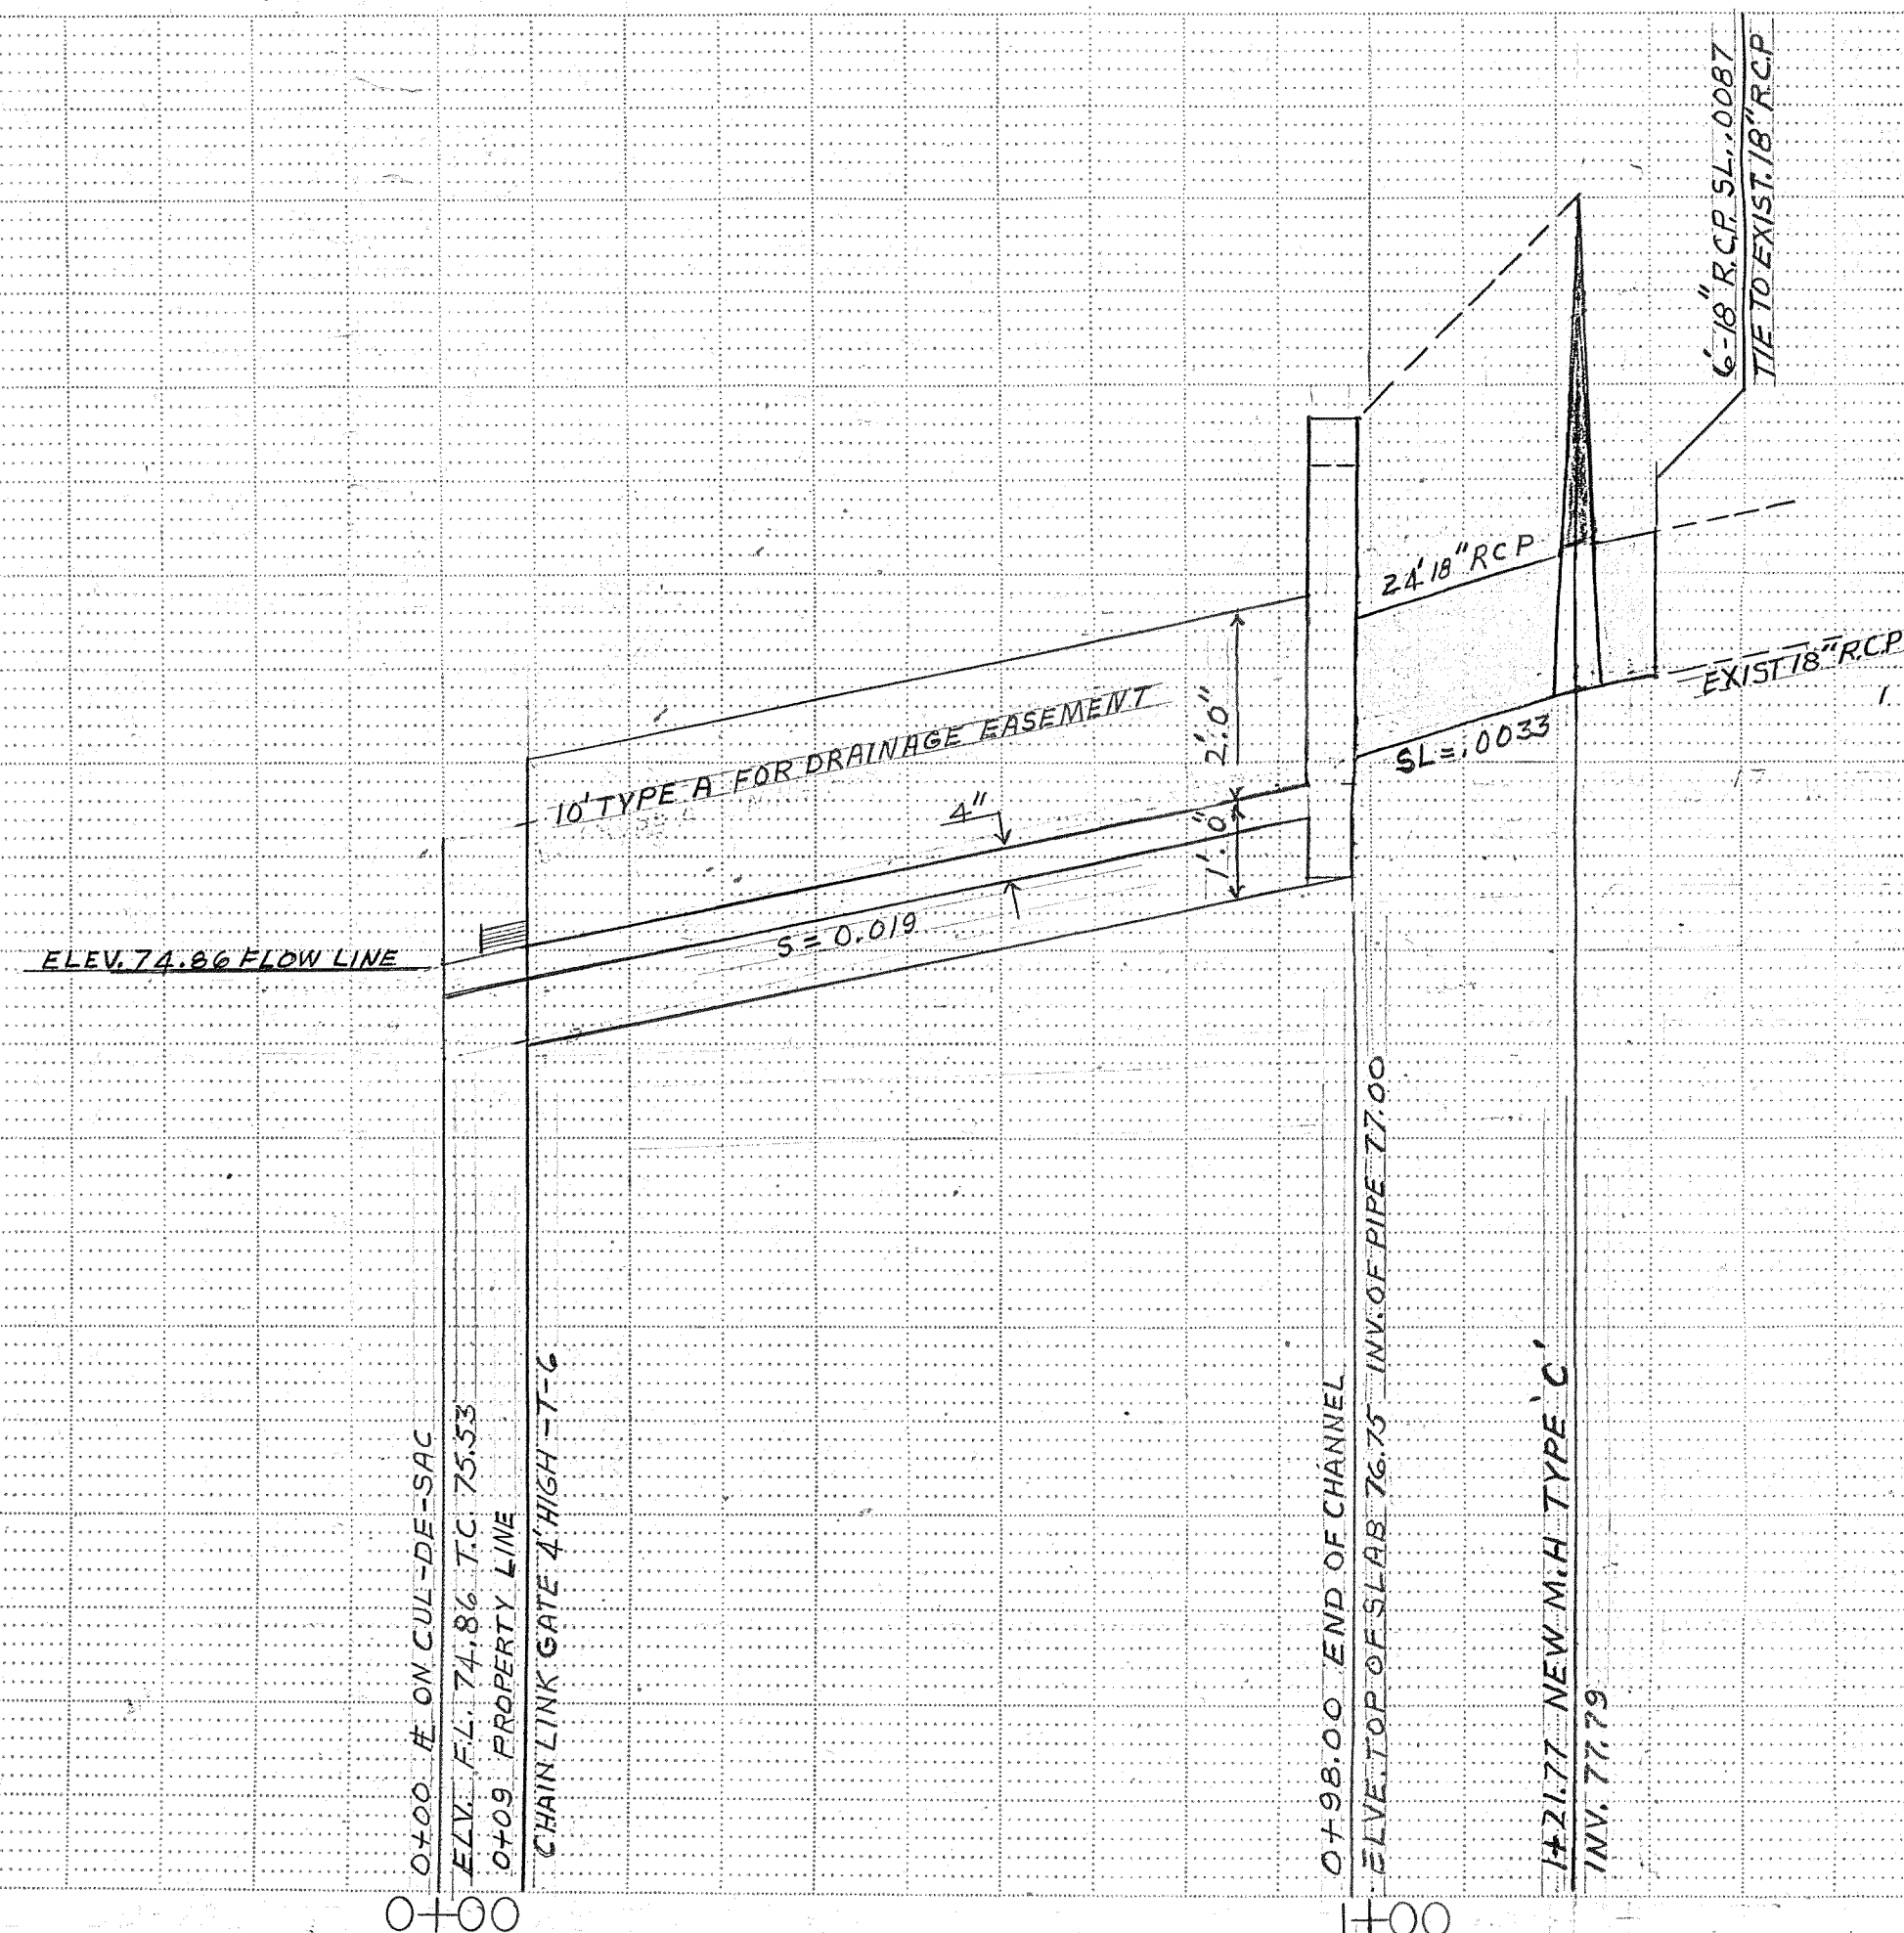
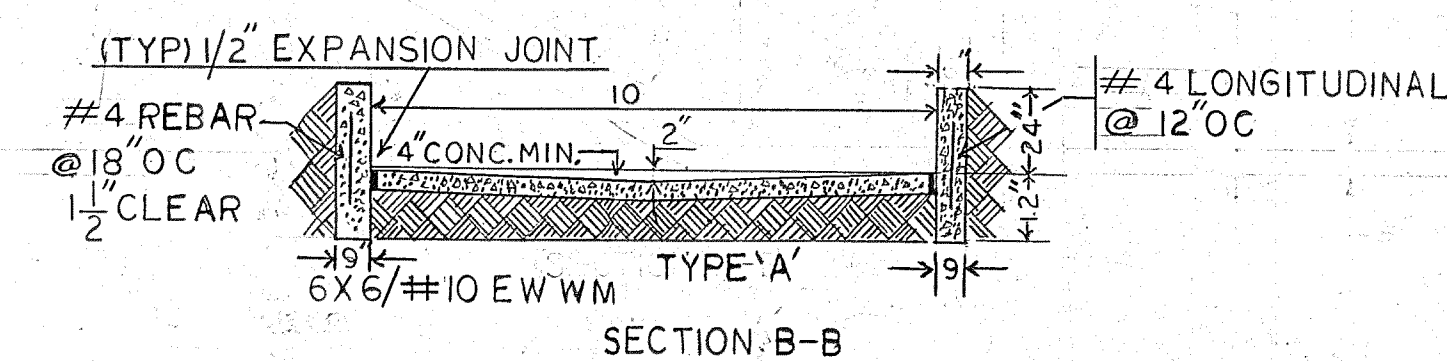


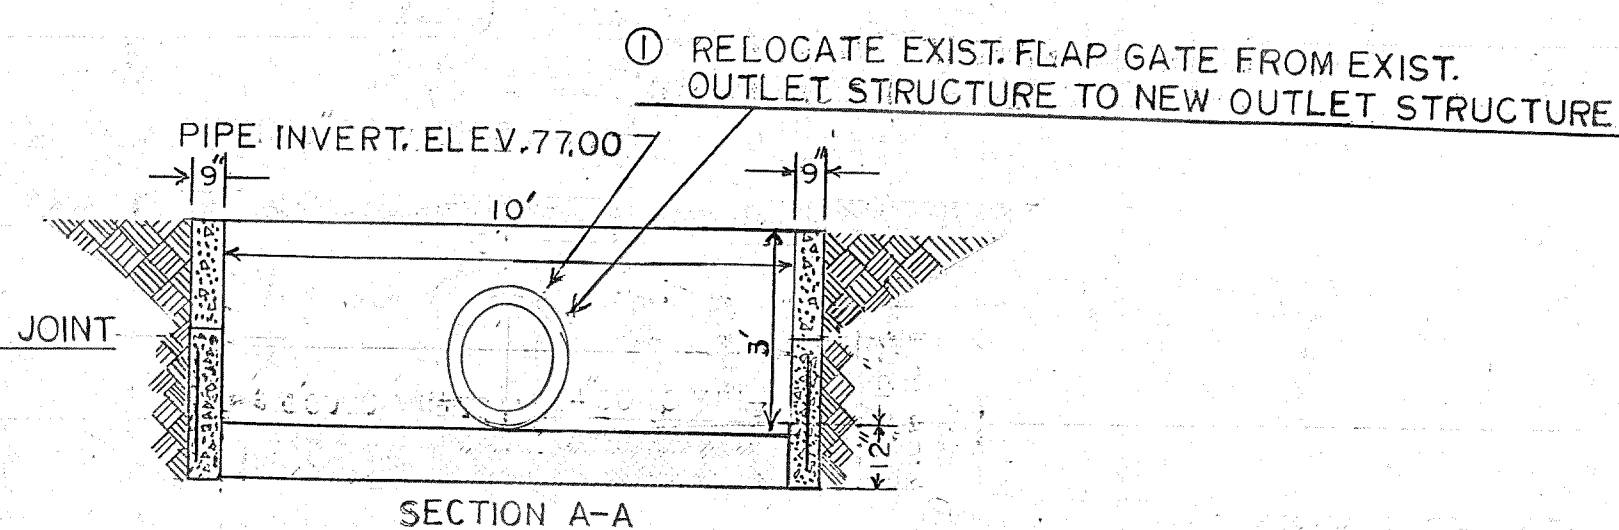

NOTE: ① RELOCATE EXIST. FLAP GATE FROM EXIST. OUTLET STRUCTURE TO NEW OUTLET STRUCTURE

NOTE: ② METAL FENCE POST SHALL BE CENTER IN CHANNEL WALL

③ TIE NEW FENCE INTO EXIST. FENCE

④ REMOVE 18" R.C.P. LINE FROM MANHOLE TO OLD OUTLET STRUCTURE

⑤ PLUG & BLOCK EXIST. 18" R.C.P. AT M.H.

APPROVAL OF AS BUILT DRAWING
ASST. CITY ENGINEER - FIELD
[Signature]
DATE 12-8-88

1	2	3	4	5	6	7	8	9	10
2	2	0	3	5	0	1	7		

CITY OF ALBUQUERQUE
PUBLIC WORKS DEPARTMENT
ENGINEERING DIVISION

10¹ TYPE A LINING FOR DRAINAGE EASEMENT

APPROVALS	ENGINEER	DATE	APPROVALS	ENGINEER	DATE
City Engineer	<i>[Signature]</i>	12-5-77	Liquid Waste		
A.C.E. - Design	<i>[Signature]</i>	10 Nov 77	Traffic		
A.C.E. - Hydrology			Water		

DRAWING NO. SS-35-77

SHEET 1 OF 1

AS BUILT INFORMATION	DATE
CONTRACTOR	DATE
WORK MADE BY	DATE
INSPECTOR'S ACCEPTANCE BY	DATE
FIELD ELECTION BY	DATE
DRAWINGS CORRECTED BY	DATE
MICRO-FILM INFORMATION	DATE
RECORDED BY	DATE
NO.	

BENCH MARKS

B.M. NAIL IN P.P. POLE LOCATED 300' SOUTH
OF TANK ON 86TH, ST. ELEV. 5083.27

[illegible]

30	REFERENCES	
	MAP NO. M-9 <i>85</i>	
	EST. NO.	W/O. NO.
	SS-35-77	

[illegible]