


NOTES:
1) For gate installation see Traffic Standard Chain Link Gate Dwg. T-6

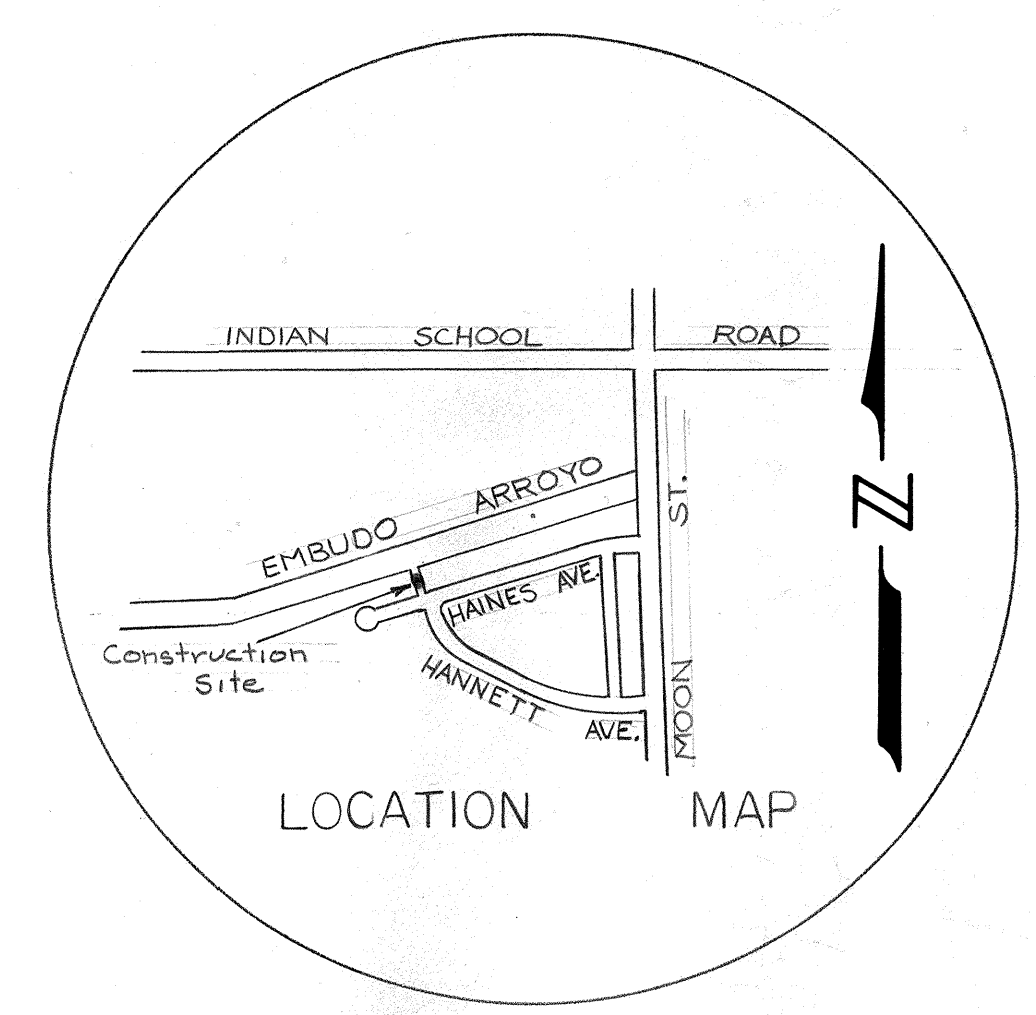

APPROVAL OF AS BUILT DRAWINGS
ASST. CITY ENGINEER - FIELD
[Signature]
DATE 10-7-82

1	2	3	4	5	6	7	8	9	10	11	12
22	035	0178									

APPROVED FOR CONSTRUCTION
[Signature]
CITY ENGINEER DATE 9/24/82

CITY OF ALBUQUERQUE PUBLIC WORKS DEPARTMENT ENGINEERING DIVISION					
TITLE: CHAIN LINK FENCE ACROSS DRAINAGE EASEMENT OFF HAINES AVE. N.E.					
APPROVALS	ENGINEER	DATE	APPROVALS	ENGINEER	DATE
City Engineer	<i>[Signature]</i>	9/24/82	Liquid Waste		
A.C.E.-Design	<i>[Signature]</i>	10 Sep 82	Traffic		
A.C.E.-Hydrology			Water		
DRAWING NO. SS-35-78			SHEET 1 OF 1		

SURVEY INFORMATION		BENCH MARKS		AS BUILT INFORMATION	
NO.	BY	DATE		CONTRACTOR	
				WORK	
				STAKED BY	
				DATE	
				FIELD	
				ACCEPTANCE BY	
				DATE	
				REVISIONS	
				CORRECTED BY	
				DATE	
				MICRO-FILM INFORMATION	
				RECORDED BY	
				DATE	
				NO.	