

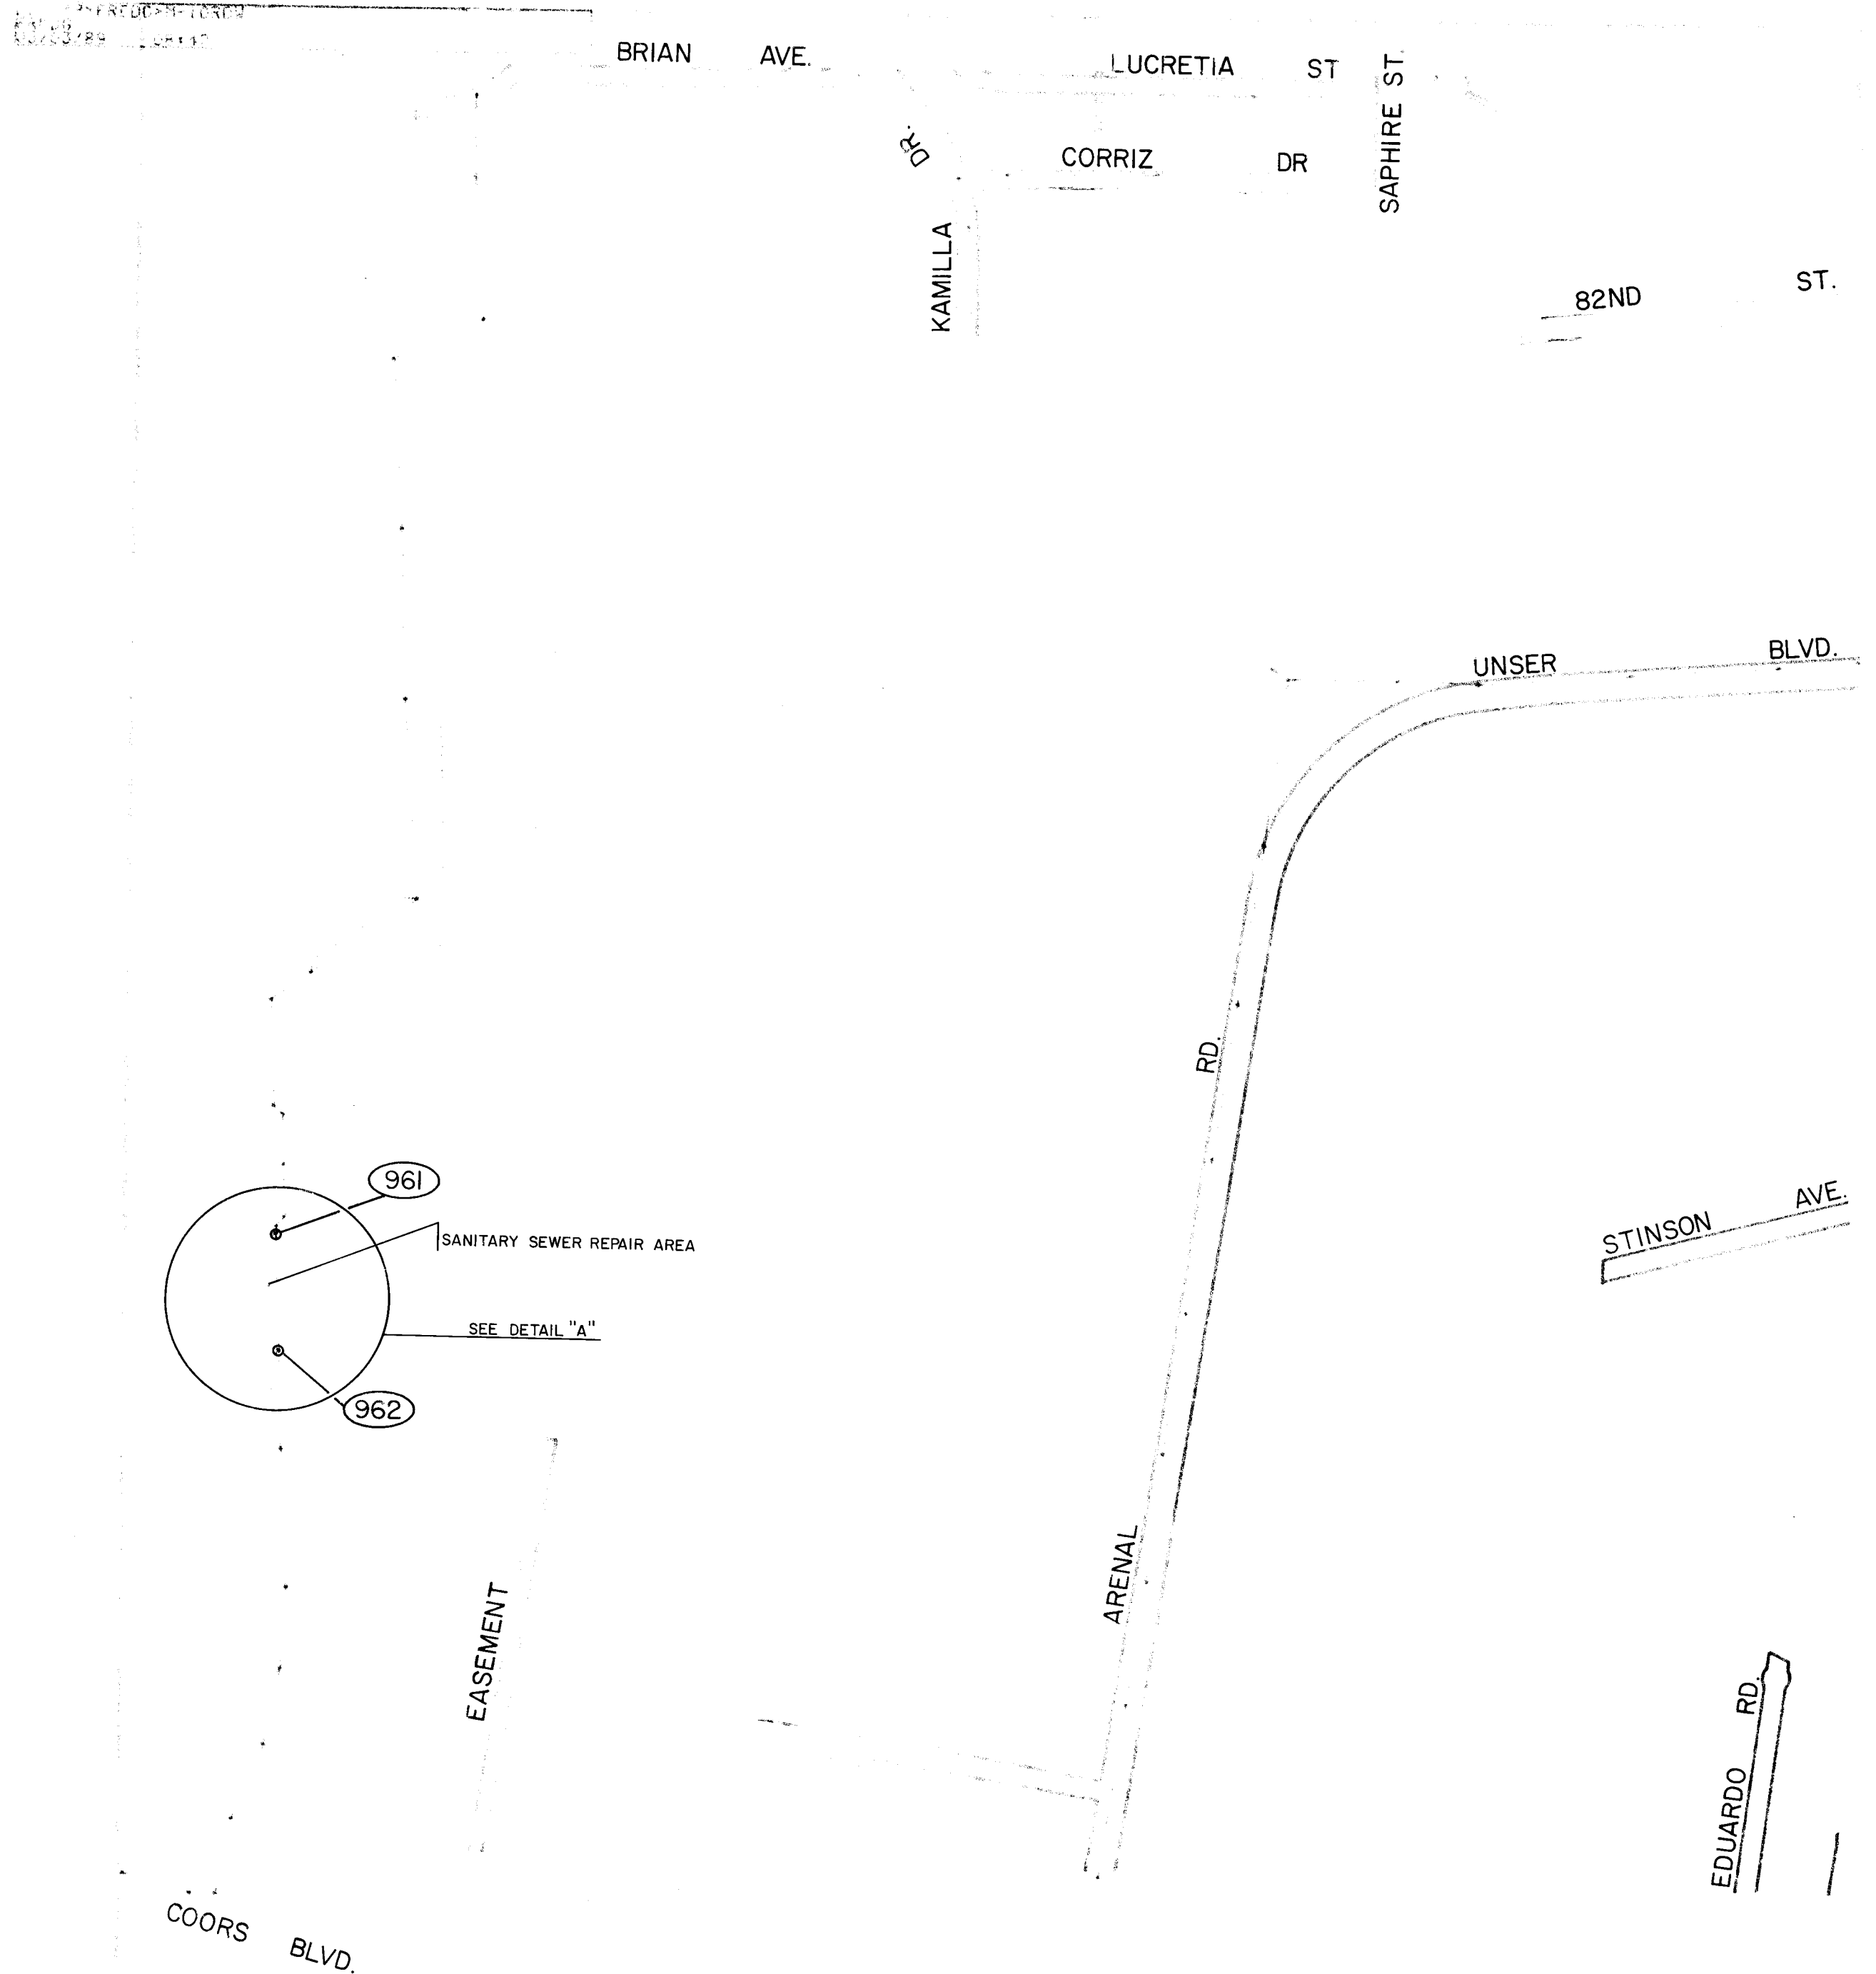


LOCATION MAP
SCALE 1" = 400'

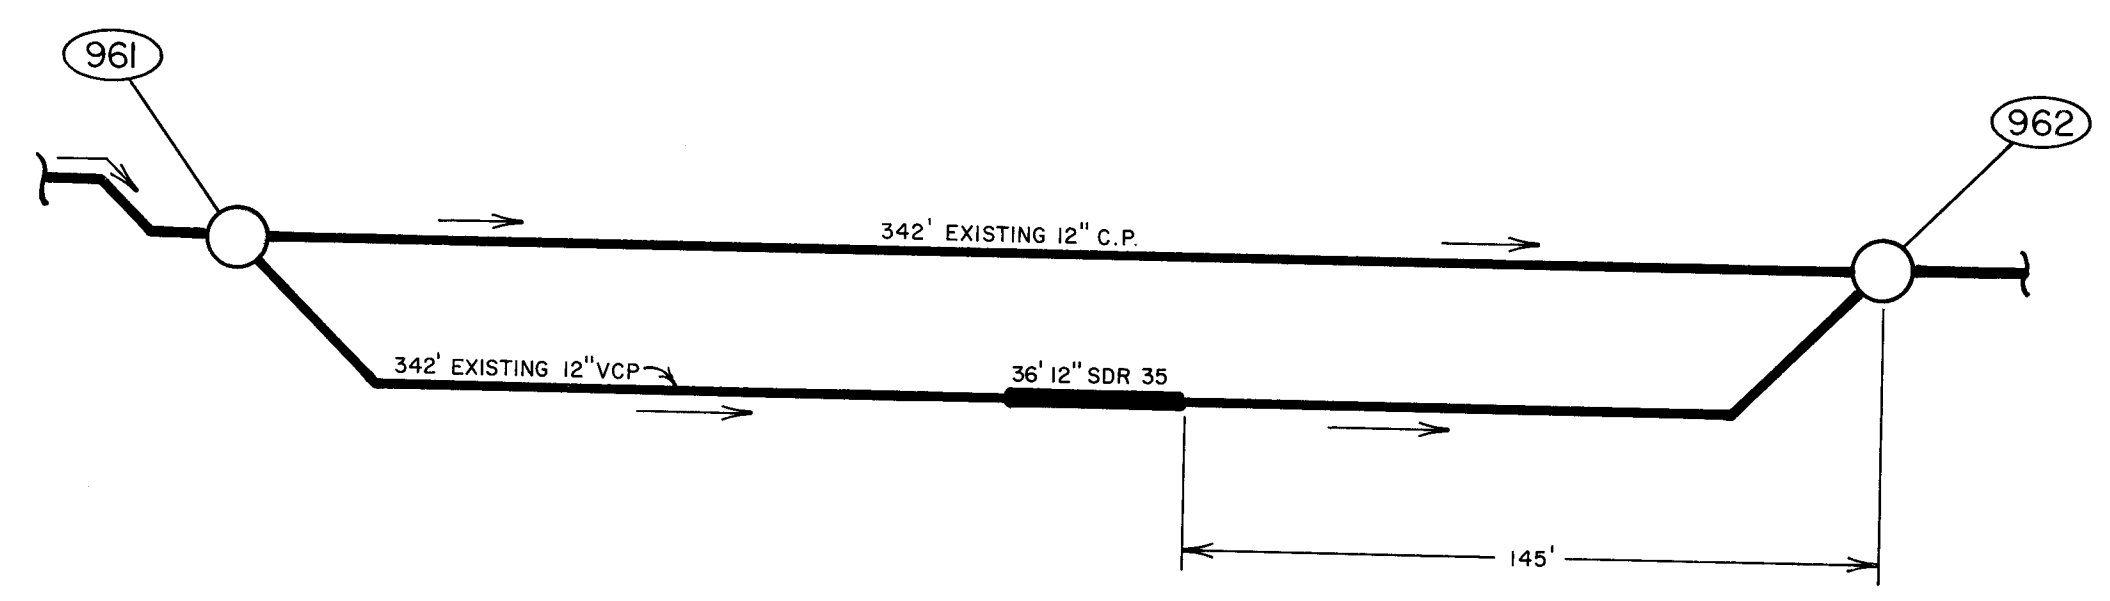

DETAIL "A"
SANITARY SEWER REPAIR
QUANTITIES
36' 12" S.D.R. 35
2" CT ADAPTORS
640 C.Y. BACKFILL & COMPACTION

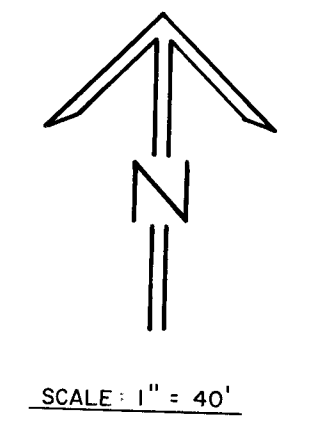

SCALE: 1" = 40'

1	2	3	4	5	6	7	8	9	10	11	12
26	3	5	7	8	0	1	8	9			

APPROVAL OF AS BUILT DRAWING
DATE 8/14/89

EMERGENCY SANITARY SEWER LINE REPAIR, WEST OF COORS BLVD.

M-10-Z

MCC, Inc.
TONY ARCHULETA
9-6-88

PAUL A. YANNONI
FRED GOMEZ
3-6-89
3-6-89