
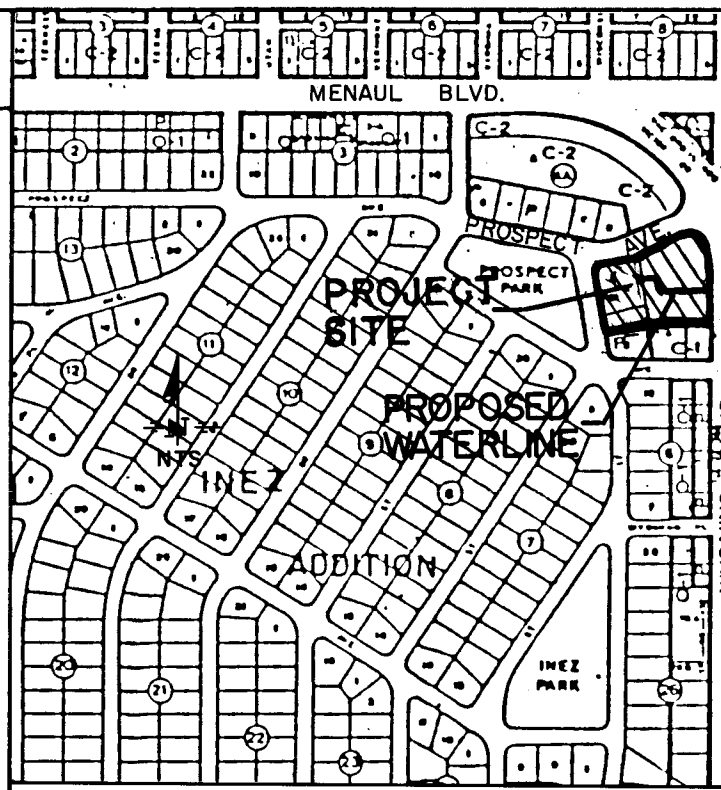
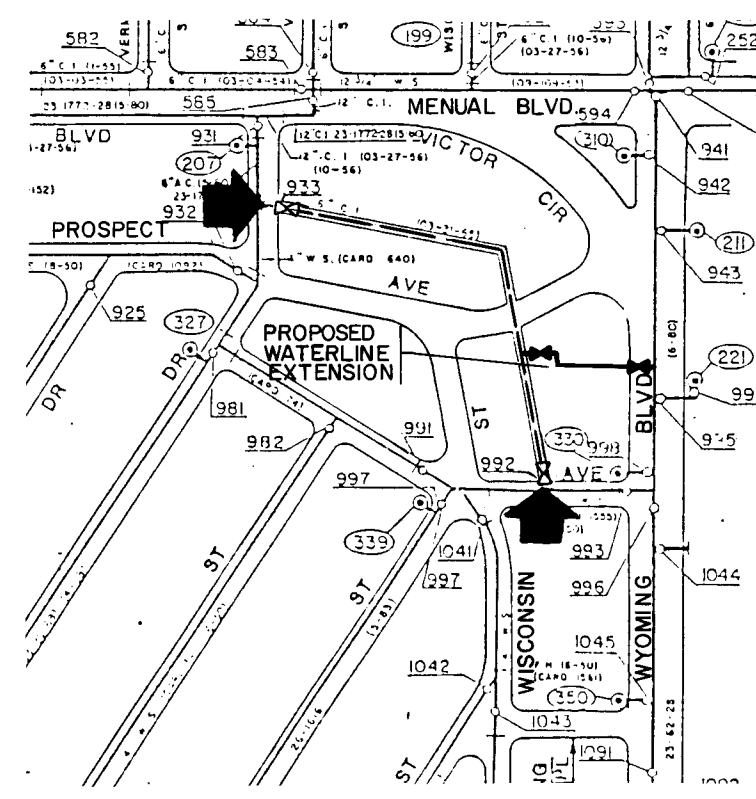
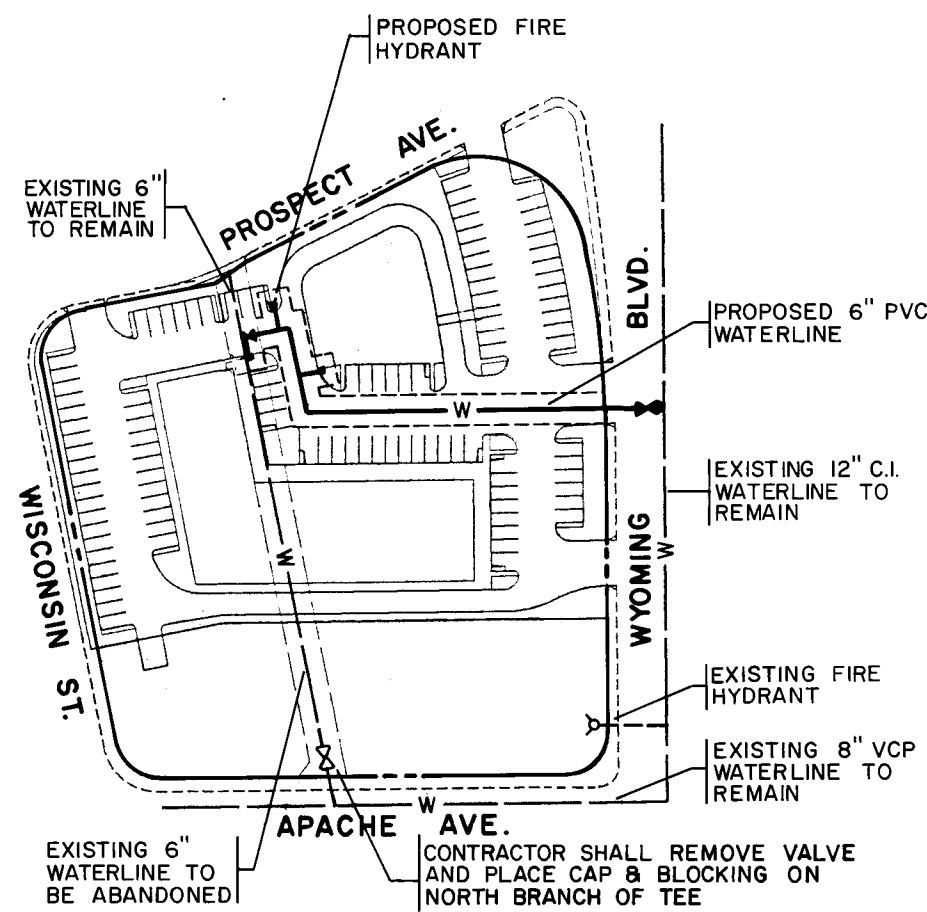


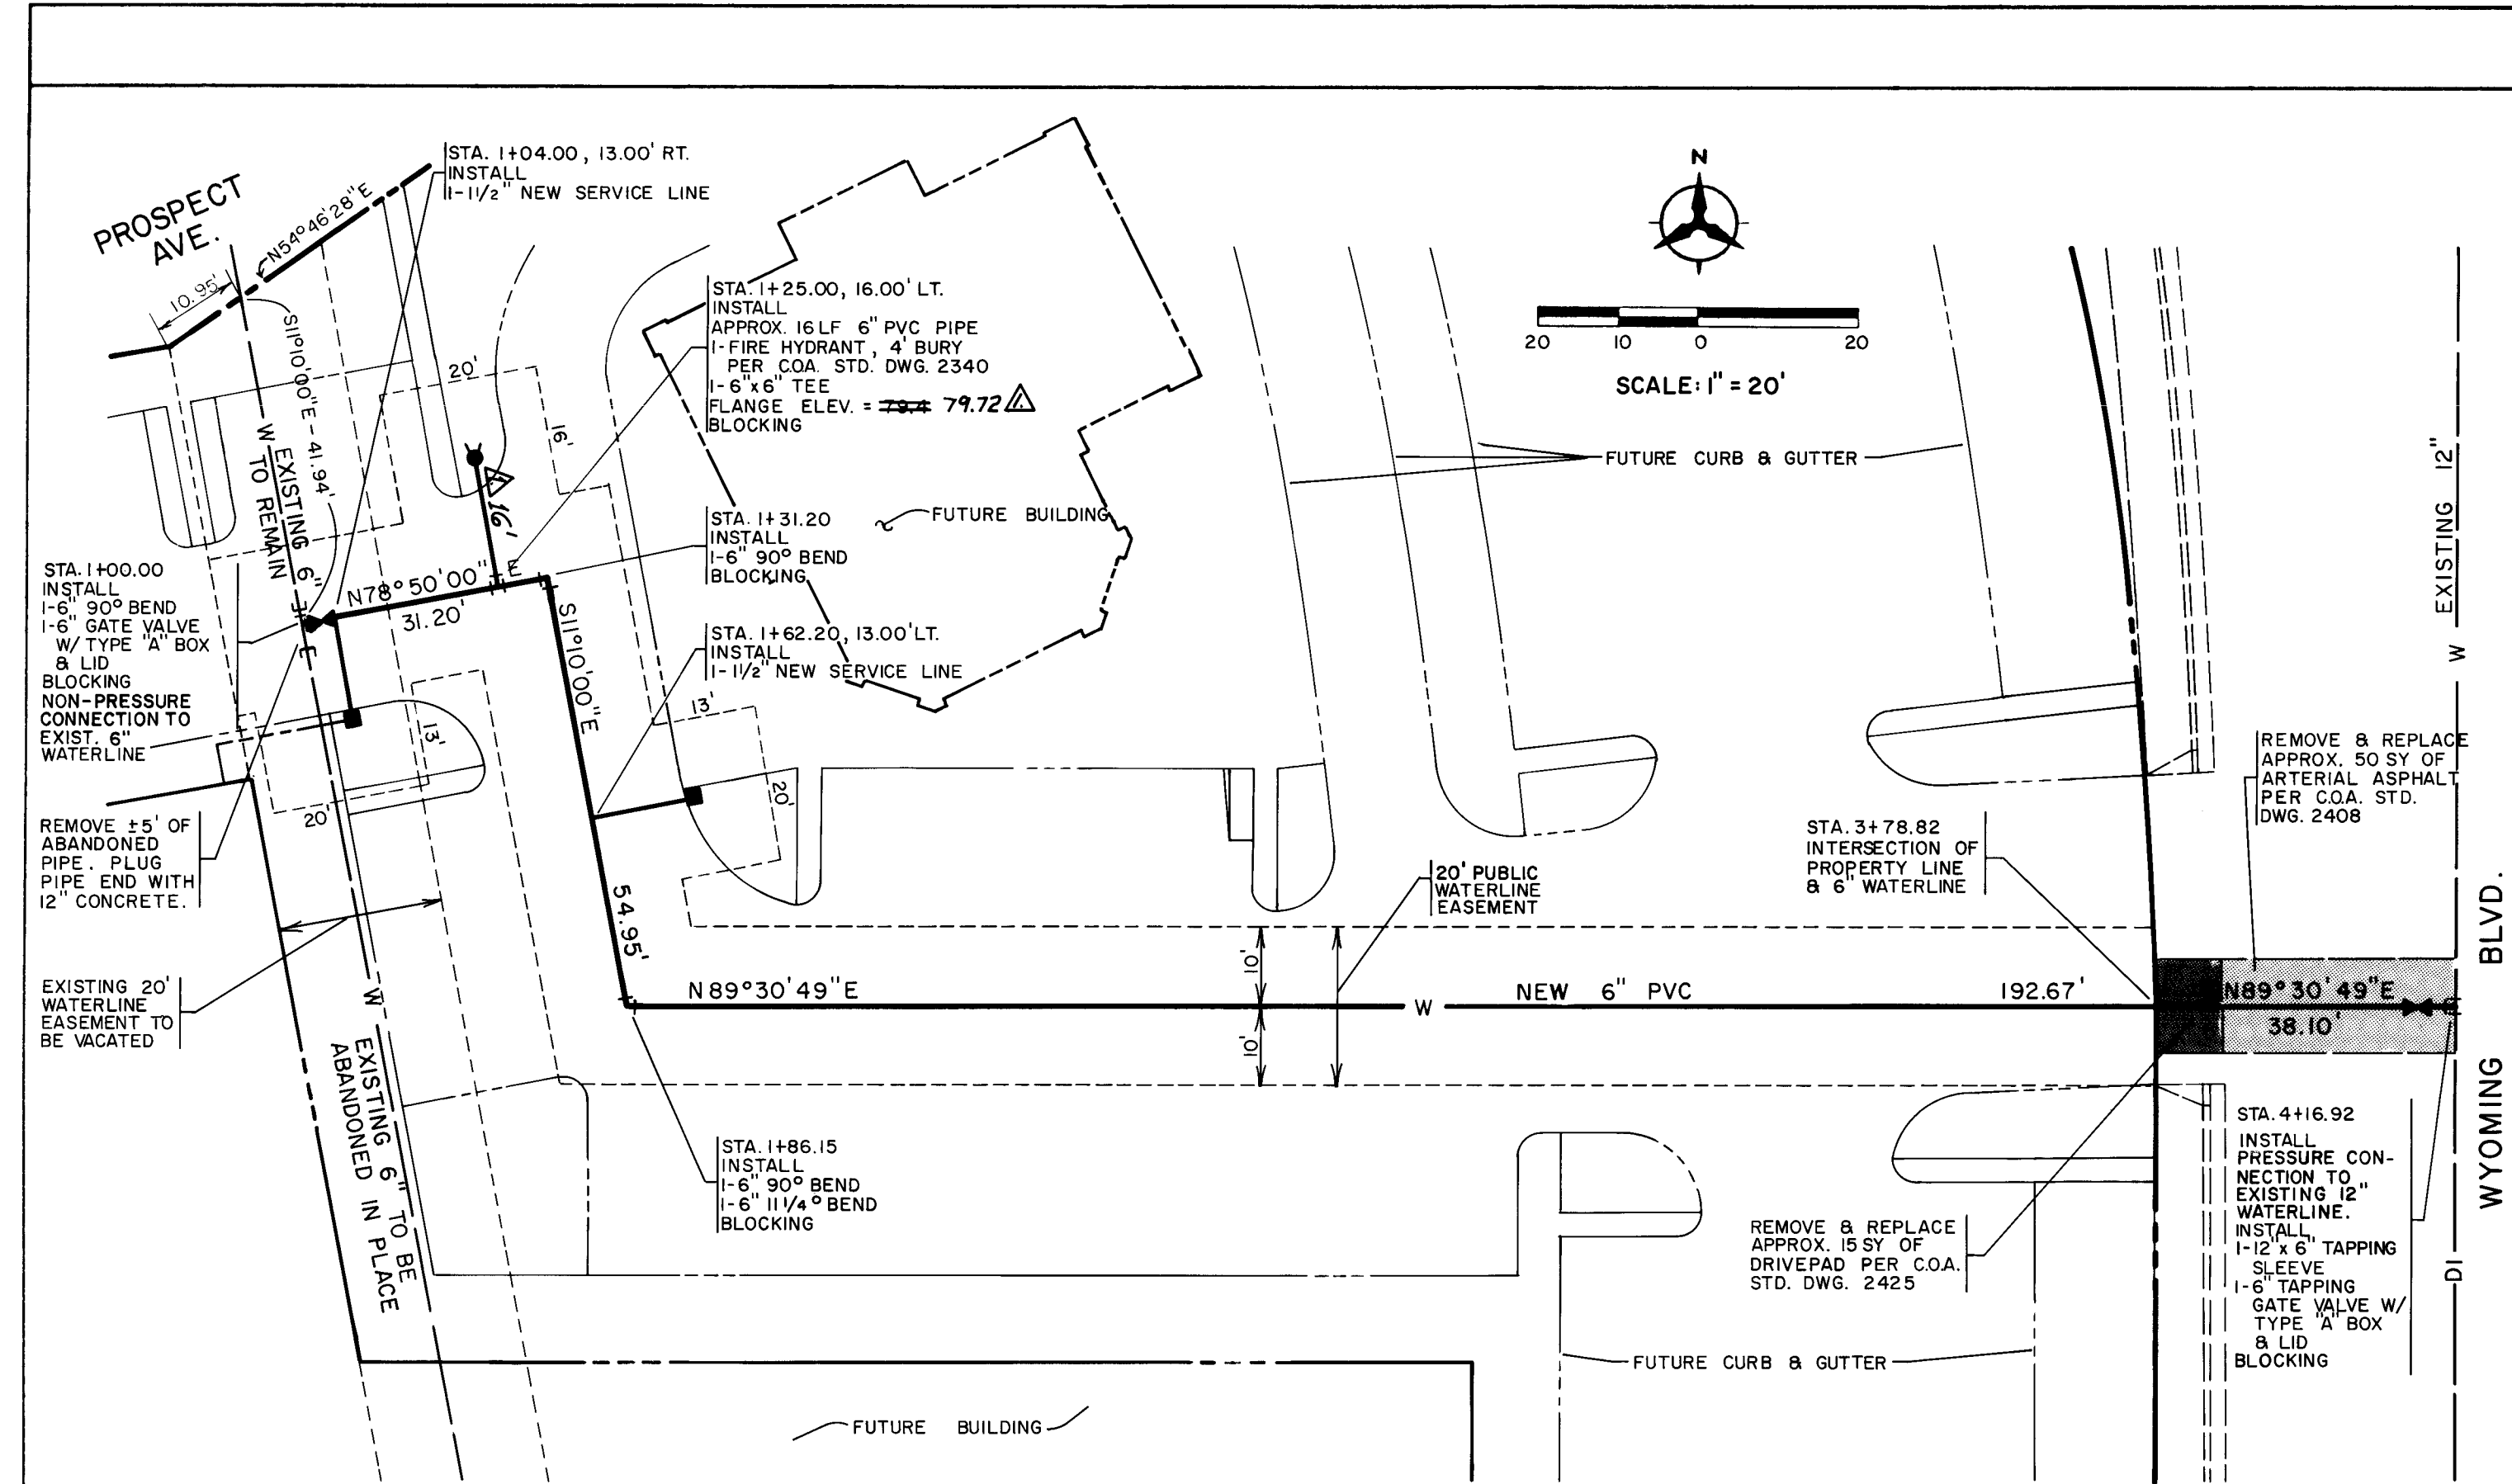

LOCATION MAP
ZONE ATLAS MAP NO. H-19

- NOTICE TO CONTRACTORS
- ALL WORK DETAILED ON THESE PLANS TO BE PERFORMED UNDER CONTRACT SHALL EXCEPT AS OTHERWISE STATED OR PROVIDED FOR HEREON, BE CONSTRUCTED IN ACCORDANCE WITH CITY OF ALBUQUERQUE STANDARD SPECIFICATIONS FOR PUBLIC WORKS CONSTRUCTION, 1986 EDITION.
 - TWO WORKING DAYS PRIOR TO ANY EXCAVATION, CONTRACTOR MUST CONTACT LINE LOCATING SERVICE, 765-1234, FOR LOCATION OF EXISTING UTILITIES.
 - PRIOR TO CONSTRUCTION, THE CONTRACTOR SHALL EXCAVATE AND VERIFY THE HORIZONTAL AND VERTICAL LOCATIONS OF ALL OBSTRUCTIONS. SHOULD A CONFLICT EXIST, THE CONTRACTOR SHALL NOTIFY THE ENGINEER OR SURVEYOR, SO THAT THE CONFLICT CAN BE RESOLVED WITH A MINIMUM AMOUNT OF DELAY.

- THE FOLLOWING NOTES ALSO APPLY WHEN CHECKED
- ☒ ALL UTILITIES AND UTILITY SERVICE LINES SHALL BE INSTALLED PRIOR TO PAVING.
 - ☒ BACKFILL COMPACTION SHALL BE ACCORDING TO SPECIFIED STREET USE.
 - ☐ TACK COAT REQUIREMENTS SHALL BE DETERMINED BY THE CITY ENGINEER.
 - ☐ SIDEWALKS AND WHEELCHAIR RAMPS WITHIN THE CURB RETURNS SHALL BE CONSTRUCTED WHEREVER A NEW CURB RETURN IS CONSTRUCTED.
 - ☐ IF CURB IS DEPRESSED FOR A DRIVEPAD, THE DRIVEPAD SHALL BE CONSTRUCTED PRIOR TO ACCEPTANCE OF CURB AND GUTTER.
 - ☐ ALL STORM DRAINAGE FACILITIES SHALL BE COMPLETED PRIOR TO FINAL ACCEPTANCE.
 - ☒ THE REQUESTOR OR DEVELOPER SHALL BE RESPONSIBLE FOR REPAIR OR REPLACEMENT OF ALL CURB AND GUTTER OR SIDEWALK DAMAGED AFTER APPROVAL BY THE CITY ENGINEER OF WORK COMPLETED BY THE CONTRACTOR.

- WATER NOTES
- FIRE HYDRANTS SHALL BE 4' BURY AND INSTALLED PER CITY STD. DWG. 2340.
 - GATE VALVES SHALL BE RESILIENT SEAT VALVES.
 - PARKING LOT SHALL BE GRADED $\pm 1.0'$ PRIOR TO INSTALLATION OF UTILITIES.
 - ELECTRONIC MARKER DISKS (EMD'S) SHALL BE INSTALLED PER SECTION 131 OF THE PROJECT TECHNICAL SPECIFICATIONS.
 - NO DEFLECTION AT JOINTS SHALL BE PERMITTED FOR PVC PIPE.
 - CONTRACTOR SHALL COORDINATE VALVE SHUT-OFF OPERATIONS WITH WATER SYSTEMS DIVISION (823-4000) NO LESS THAN 72 HOURS IN ADVANCE TO INITIATING ANY WORK INCLUDING PUBLIC WATER UTILITIES.
 - ALL STATIONING IS BASED ON THE CENTERLINE OF THE WATERLINE, UNLESS OTHERWISE NOTED.

- LEGEND
- PROJECT BOUNDARY
 - W- PROPOSED WATERLINE
 - W- EXISTING WATERLINE
 - W- PROPOSED GATE VALVE
 - W- PROPOSED FIRE HYDRANT
 - W- PROPOSED SERVICE LINE
 - FUTURE CURB & GUTTER
 - EXISTING CURB & GUTTER

APPROVAL OF AS-BUILT DRAWINGS
CHIEF CONSTRUCTION ENGINEER
[Signature]
DATE 3-5-89

NOTE:
ANY REQUIRED TRAFFIC CONTROL
SHALL BE INCIDENTAL TO
PROJECT COST.

1 2 3 4 5 6 7 8 9 10 11 12
26 35870189

BHI JOB NO 88178.07

SCALE: 1" = 20' (HORIZ.)
1" = 5' (VERT.)

APPROVED FOR
CONSTRUCTION
[Signature]
CITY ENGINEER 3-5-89

CITY OF ALBUQUERQUE
PUBLIC WORKS
ENGINEERING

TITLE: HOFFMANTOWN SQUARE
PUBLIC WATERLINE

APPROVALS	ENGINEER	DATE	APPROVALS	ENGINEER	DATE
City Engineer	<i>[Signature]</i>	10/13/88	Liquid Waste	PEGO	10/19/88
ACE-Design	H	11	Traffic	<i>[Signature]</i>	10/19/88
ACE-Hydrology	N/A	10/19/88	Water	<i>[Signature]</i>	10/19/88

DRAWING NO. 3587 MAP NO. H-19 SHEET 1 OF 1