

CONSTRUCTION PLANS FOR


ODELIA DAM OUTFALL EXTENSION

STORM DRAINAGE, STREET PAVING, WATER, AND SANITARY SEWER IMPROVEMENTS

FOR

**CITY OF ALBUQUERQUE
PUBLIC WORKS DEPARTMENT**

SHEET INDEX	
SHEET NO.	DESCRIPTION
1	COVER SHEET
2	STORM SEWER, WATER, SANITARY SEWER, AND PAVING OVERALL PLANS
3	STORM SEWER PLAN & PROFILE STA. 10+00 TO STA. 14+00
4	STORM SEWER PLAN & PROFILE STA. 14+00 TO STA. 22+50
5	STORM SEWER PLAN & PROFILE STA. 22+50 TO STA. 28+93.59
6	WATER AND SANITARY SEWER PLAN & PROFILE STA. 14+99.09 TO STA. 22+50
7	WATER AND SANITARY SEWER PLAN & PROFILE STA. 22+50 TO STA. 23+55
8	PAVING PLAN & PROFILE STA. 10+00 TO STA. 14+00
9	PAVING PLAN & PROFILE STA. 14+00 TO STA 22+50
10	PAVING PLAN & PROFILE STA. 22+50 TO STA. 24+65.50
11	DETAILS AND WATER SHUT-OFF PLAN
12	DETAILS

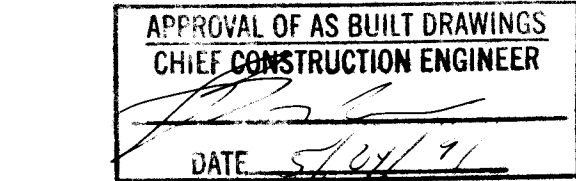

Record Drawing

This drawing as modified shows public improvements as constructed. These modifications have been made using information and measurements obtained by the City's field survey crew, the Contractor and City inspector. The modifications conform to the minimum requirements for record drawings criteria as required by the City of Albuquerque per Development Process Manual Section 27.4 to the best of my knowledge and belief.



Paul T. Brasher P.E. 7282

4-22-91
Date



C of A PWD Maps & Records

1	2	3	4	5	6	7	8	9	10	11	12
2	6	3	6	0	7	0	1	9	1		

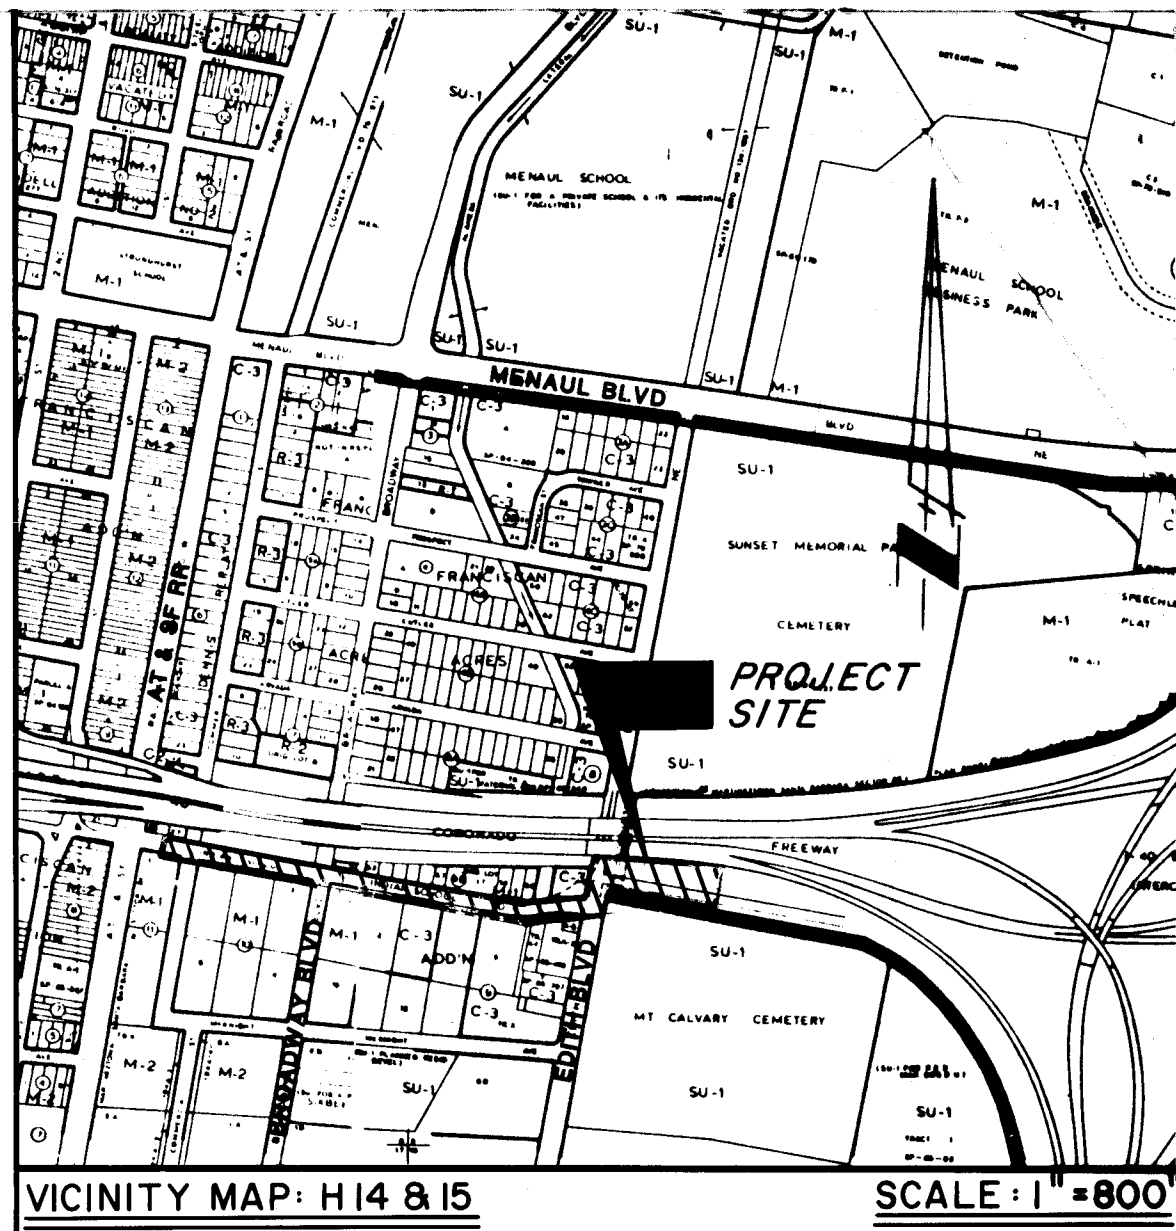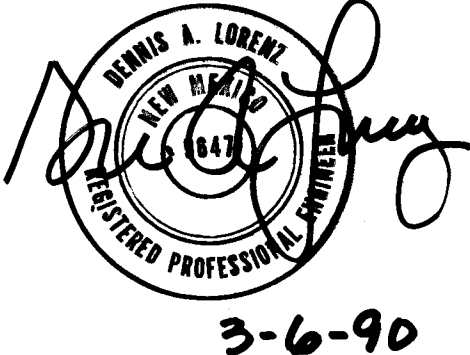


GENERAL NOTES


- All work detailed on these plans to be performed under contract, and unless stated otherwise or provided for hereon, shall be constructed in accordance with the City of Albuquerque Standard Specifications, Public Works Construction, 1986 (referred herein as "Standard Specification").
- Two (2) working days prior to any excavation, Contractor must contact New Mexico One Call System, 260-1990 for location of existing utilities.
- Prior to construction, the Contractor shall excavate and verify the horizontal and vertical locations of all potential obstructions. Should a conflict exist, the Contractor shall notify the Engineer so that the conflict can be resolved with a minimum amount of delay.
- All work on this project shall be performed in accordance with applicable Federal, State and Local laws, rules, and regulations concerning construction safety and health.
- Contractor shall maintain access to adjacent properties during construction.
- All gas, electric, telephone lines, cables, and appurtenances encountered during construction that require relocation, shall be coordinated with that utility. Contractor shall be responsible for coordination of all necessary utility adjustments.
- It will be Contractor's responsibility to protect and maintain in service all existing utilities.
- The Contractor will be required to confine his work within the construction limits and/or public right-of-way to preserve existing vegetation and private property. Overnight parking of construction equipment shall not obstruct driveways or designated traffic lanes.
- A disposal site for all excess excavation material, asphaltic paving, concrete curbs and sidewalks, etc., shall be obtained by the Contractor in compliance with applicable environmental regulations and approved by the Field Engineer. All costs incurred in obtaining a disposal site and haul thereto shall be considered incidental to the project and no separate measurement or payment shall be made.
- When abutting new pavement to existing, sawcut 1" below surface of existing pavement to a straight edge and at a right angle, or as approved by the Project Engineer, to remove any broken or cracked pavement.
- Backfill compaction shall be according to specified street use.
- All trench backfill shall be compacted to a minimum 90% maximum density as per ASTM D-1557.
- Three (3) working days prior to beginning construction the Contractor shall submit to Construction Coordination Division a detailed construction schedule. Two (2) working days prior to construction the Contractor shall obtain a barricading permit from the Construction Coordination Division. Contractor shall notify Barricading Engineer (768-2551) prior to occupying an intersection.
- Contractor shall notify the ENGINEER not less than seven (7) days prior to starting work in order that the Engineer may take necessary measures to insure the preservation of survey monuments. Contractor shall not disturb permanent survey monuments without the consent of the Engineer and shall notify the Engineer and bear the expense of replacing any that may be disturbed without permission. Replacement shall be done only by the Engineer. When a change is made in the finished elevation of the pavement of any roadway in which a permanent survey monument is located, Contractor shall, at his own expense, adjust the monument cover to the new grade unless otherwise specified.

eh

Paul T. Brasher
5-11-90

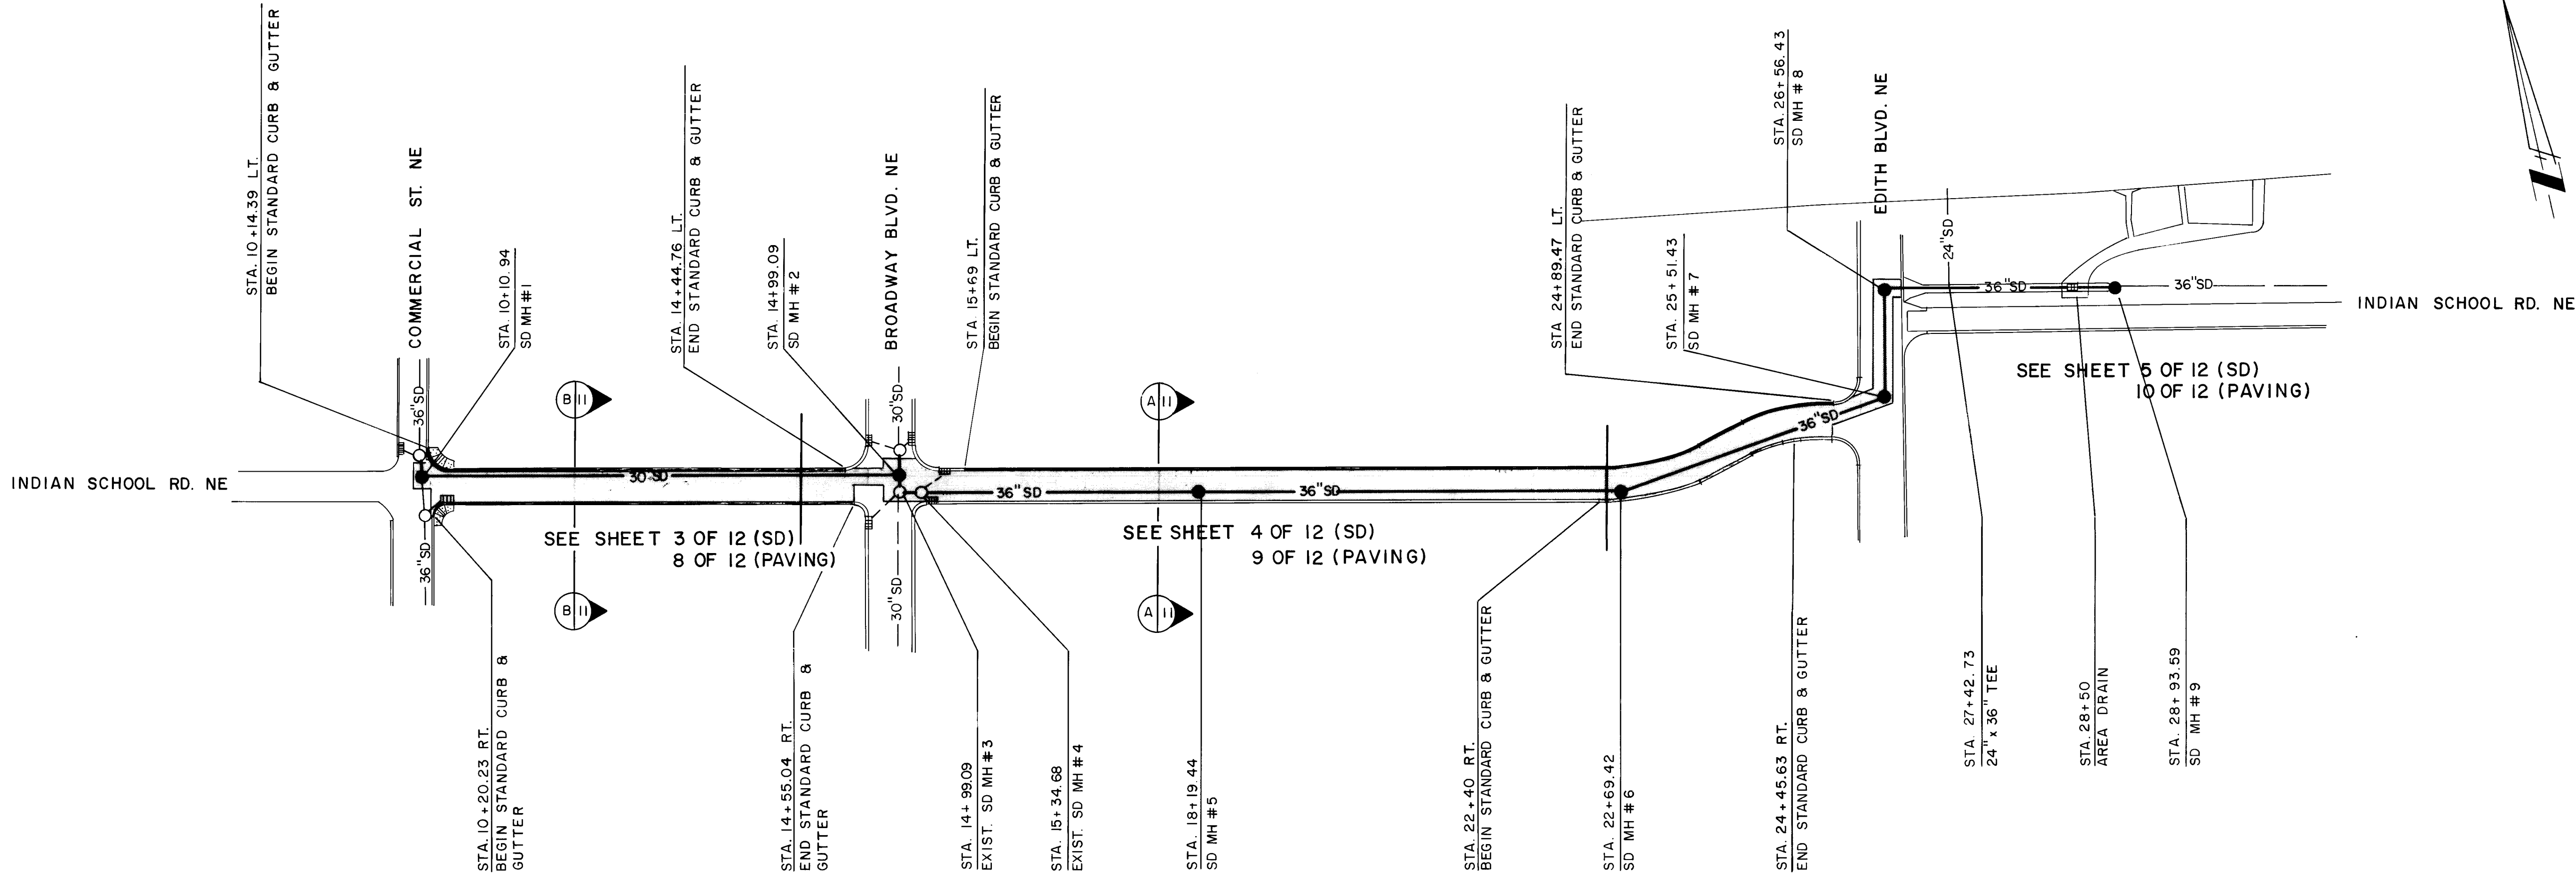

STORM SEWER AND PAVING PLAN
1" = 100'

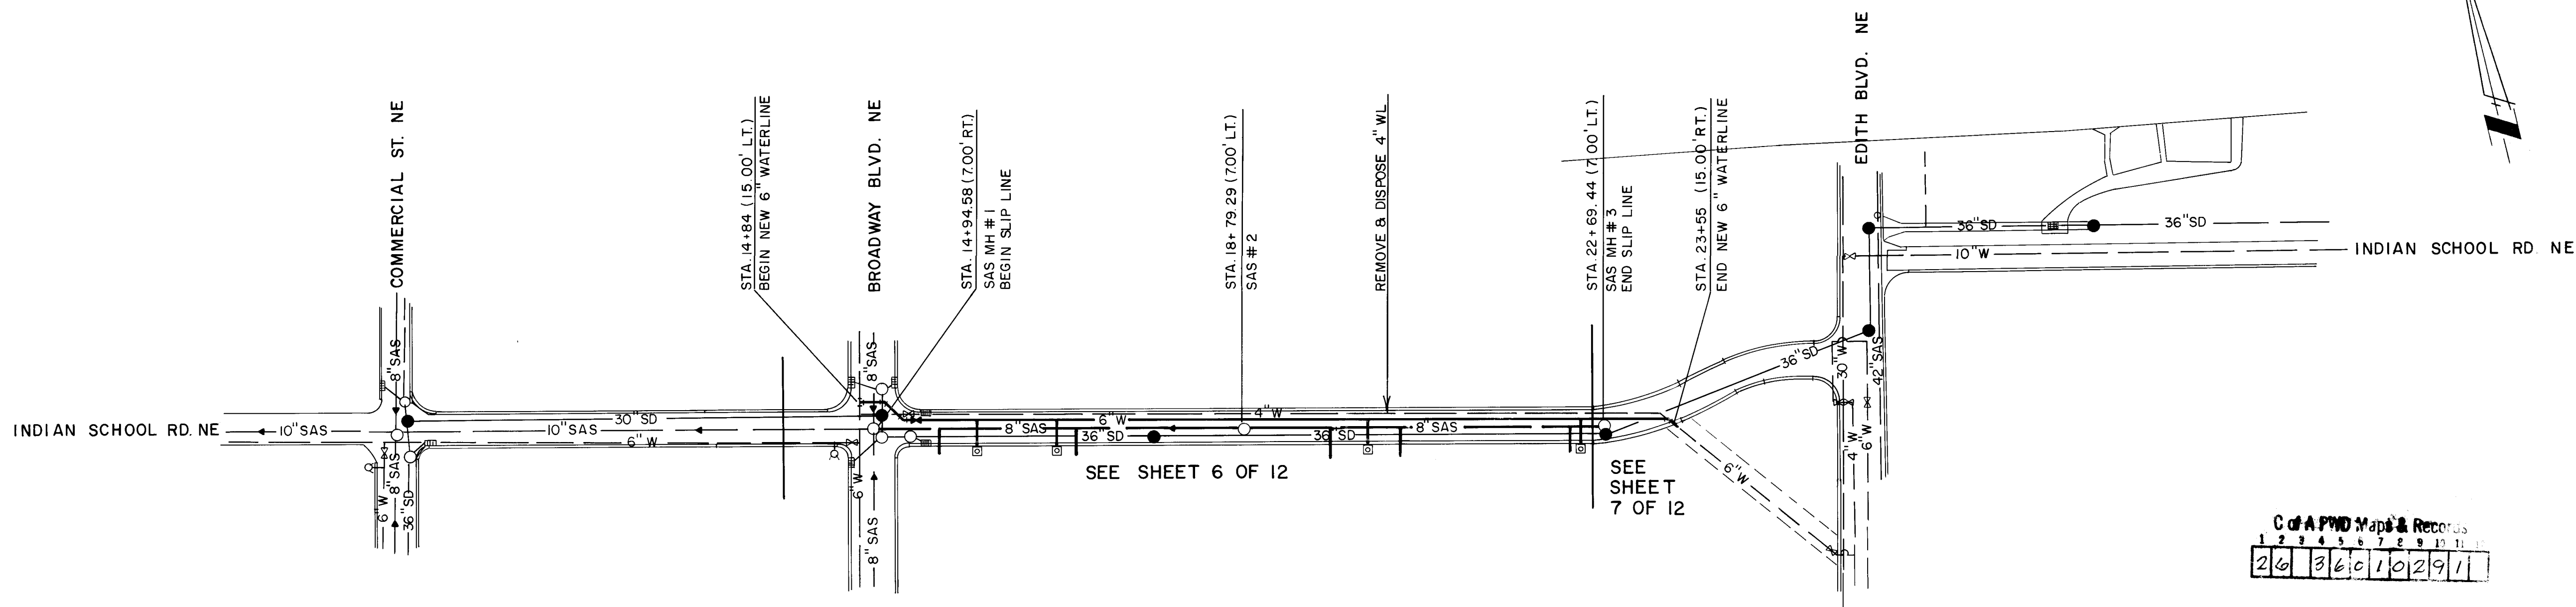

WATER AND SANITARY SEWER PLAN
1" = 100'

- LEGEND
- 36" SD — EXISTING STORM DRAIN
 - O — EXISTING STORM DRAIN MANHOLE
 - — EXISTING STORM DRAIN INLET
 - 36" SD — PROPOSED STORM DRAIN
 - ● — PROPOSED STORM DRAIN MANHOLE
 - — PROPOSED STANDARD CURB & GUTTER
 - — PROPOSED PAVING LIMITS

- LEGEND
- 10" W — EXISTING WATER LINE
 - — EXISTING GATE VALVE
 - — EXISTING FIRE HYDRANT
 - 8" SAS — EXISTING SANITARY SEWER
 - O — EXISTING SANITARY SEWER MANHOLE
 - 6" W — PROPOSED WATER LINE
 - — PROPOSED GATE VALVE
 - — PROPOSED TEE FITTING
 - — PROPOSED WATER METER SERVICE
 - 8" SAS — PROPOSED SANITARY SEWER
 - ● — PROPOSED SANITARY SEWER MANHOLE

ESPEY,
HUSTON &
ASSOCIATES, INC.
Engineering & Environmental Consultants
317 COMMERCIAL ST. N.E.
ALBUQUERQUE, NEW MEXICO 87102
PHONE: (505) 242-1909

C of APWD Maps & Records
26 36 0 1 0 2 9 1

ENGINEER'S SEAL		SURVEY INFORMATION		AS BUILT INFORMATION	
 3-6-90		FIELD NOTES		CONTRACTING SURVEYING MECHANICAL	
		NO.	BY	DATE	DATE
REMARKS		DATE		DATE	
DESIGN		DATE		DATE	
DRAWN BY		DATE		DATE	
CHECKED BY		DATE		DATE	

CITY OF ALBUQUERQUE PUBLIC WORKS DEPARTMENT ENGINEERING GROUP					
TITLE: ODELIA DAM OUTFALL EXTENSION STORM SEWER, PAVING, WATER AND SANITARY SEWER OVERALL PLANS					
APPROVALS	ENGINEER	DATE	APPROVALS	ENGINEER	DATE
D.R.C. Chairman	<i>R.W. Kane</i>	5/11/90	Water	<i>R.W. Kane</i>	3-21-90
Transportation	<i>R.W. Kane</i>	4/19/90	Wastewater	<i>R.W. Kane</i>	3-21-90
Hydrology	<i>R.W. Kane</i>	4/19/90			
DRAWING NO.	3601	MAP NO.	H14815	SHEET	2 OF 12

1. All stationing shown hereon is based on the centerline of the storm sewer. All offset distances are measured from the stationing baseline.
2. The contractor shall properly support all utilities exposed during the construction. All trenches shall be backfilled in accordance with project specifications.


Jim Vann, PNM
761-3426
Wayne Hemsing, U.S. West
245-6674
Tim Cynova, Gas Co.
889-2538
Yvette Suavo, Jones
Intercable
761-6221

5. The following trench widths shall be used for 30" and 36" RCP storm drain:

30" Class III; W=4.75 ft
36" Class III; W=5.75 ft
36" Class IV; W=5.75 ft

All bedding shall be Class "B".
See bedding detail, sheet 12 of
12

6. All U.S. West manholes shall be adjusted to grade by others. Contractor shall contact Irene Olivas at U.S. West, 888-8733, 5 working days prior to needing rime adjusted.

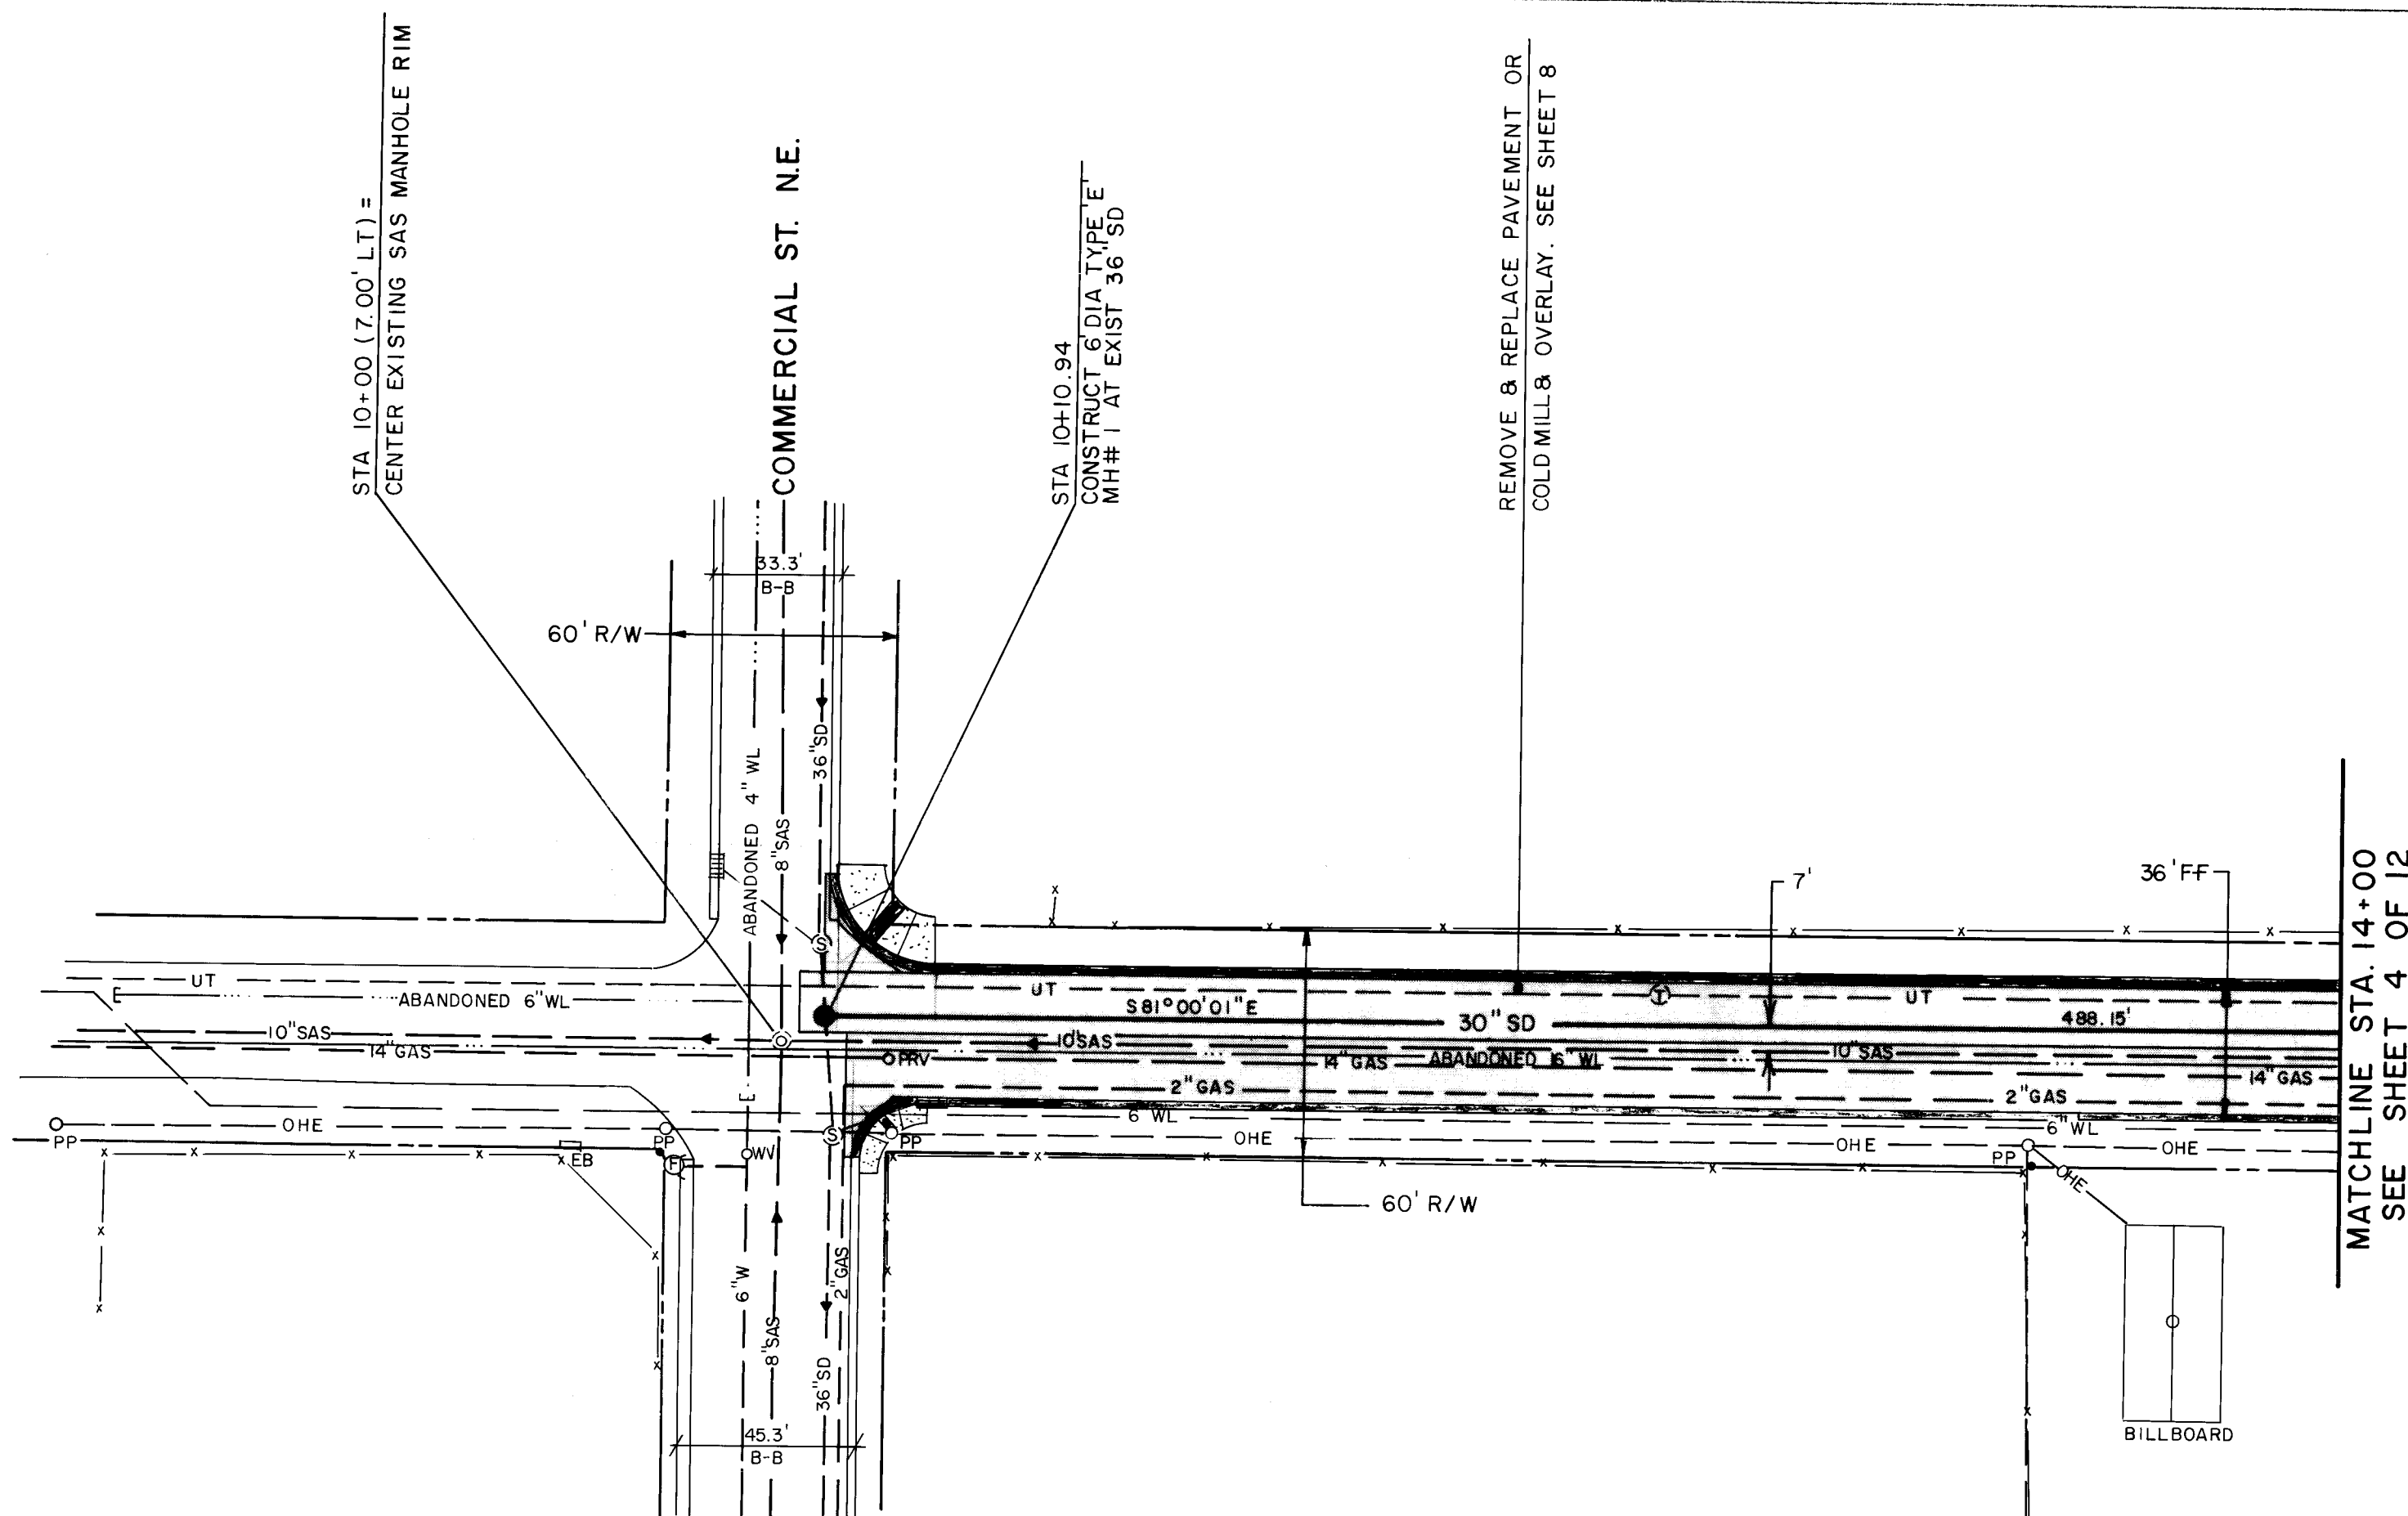[illegible]

SCALE
HORIZONTAL: 1" = 40'
VERTICAL : 1" = 05'

-- 6" W -- EXISTING WATER LINE
 -- 2" GAS -- EXISTING GAS LINE
 -- 10" GAS -- EXISTING SANITARY SEWER
 -- UT -- EXISTING UNDERGROUND TELEPHONE
 -- (T) -- EXISTING UNDERGROUND TELEPHONE MANHOLE
 -- (S) -- EXISTING SANITARY SEWER MANHOLE
 -- (S) -- EXISTING STORM DRAIN MANHOLE
 oPRV EXISTING PRESSURE RELEASE VALVE/GAS
 -- (H) -- EXISTING STORM DRAIN INLET
 -- OHE -- EXISTING OVERHEAD ELECTRIC
 -- X -- X -- EXISTING FENCE (CHAINLINK)
 (F) EXISTING FIRE HYDRANT
 oPP EXISTING POWER POLE
 □ EB EXISTING ELECTRIC BOX
 oWM EXISTING WATER METER
 ∅LP EXISTING LIGHT POLE
 [CONCRETE] EXISTING CONCRETE
 -- (WOODEN) -- EXISTING WOODEN FENCE
 [CMU WALL] EXISTING CMU WALL
 -- 6" WL -- ABANDONED WATER LINE
 -- 30" SD -- PROPOSED STORM DRAIN
 -- (S) -- PROPOSED STORM DRAIN MANHOLE
 -- 6" W -- PROPOSED WATER LINE
 (GATE VALVE) PROPOSED GATE VALVE
 (TEE FITTING) PROPOSED TEE FITTING
 [C&G] PROPOSED STANDARD CURB & GUTTER

3-6-90

NO.	DATE	REMARKS
REVISIONS		
DESIGN		
DESIGNED BY	DL	DATE 2-90
DRAWN BY		DATE
CHECKED BY	DL	DATE 3-6-00

**ESPEY,
HUSTON &
ASSOCIATES, INC.**
Engineering & Environmental Consultant


**317 COMMERCIAL ST. N.E.
ALBUQUERQUE, NEW MEXICO 8
PHONE: (505) 242-1909**

CITY OF ALBUQUERQUE
PUBLIC WORKS DEPARTMENT
ENGINEERING GROUP

TITLE: **ODELIA DAM OUTFALL EXTENSION**
STORM SEWER PLAN & PROFILE
STA. 10+00 TO STA. 14+00

APPROVAL	ENGINEER	DATE	APPROVAL	DATE
DRC Chairman	<i>Roger A. Kane</i>	5/11/90	Water	<i>R.W. Kane</i> 3-21-90
Transportation	<i>R. J. Smith</i>	4/10/90	Wastewater	<i>R.W. Kane</i> 3-21-90
Hydrology	<i>Glenn</i>	4/15/90		

DRAWING NO.	3601	MAP NO.	H-14815	SHEET	3	OF	12
-------------	------	---------	---------	-------	---	----	----

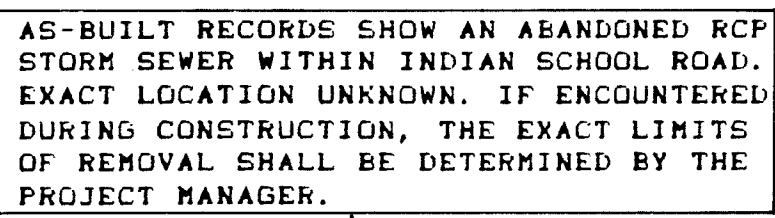


THE HYDRAULIC GRADE LINE SHOWN HEREON ASSUMES A CONTROL ELEVATION LOCATED AT THE TOP OF THE 30 INCH STORM DRAIN AT MH #3, ELEV.=4963.90. FLOWRATES ARE PER THE "DESIGN ANALYSIS REPORT FOR ODELIA DAM OUTFALL EXTENSION".

SCALE
HORIZONTAL: 1" = 40'
VERTICAL : 1" = 05'

6. All U.S. West manholes shall be adjusted to grade by others. Contractor shall contact Irene Olivas at U.S. West, 888-8733, 5 working days prior to needing rims adjusted.

All bedding shall be Class "B".
See bedding detail, sheet 12 of
12.

[illegible]
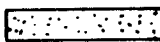
<u>LEGEND</u>	
-- 6" W --	EXISTING WATER LINE
-- 2" GAS --	EXISTING GAS LINE
-- 10" SAS --	EXISTING SANITARY SEWER
-- UT --	EXISTING UNDERGROUND TELEPHONE
	EXISTING UNDERGROUND TELEPHONE MANHOLE
	EXISTING SANITARY SEWER MANHOLE
	EXISTING STORM DRAIN MANHOLE
OPRV	EXISTING PRESSURE RELEASE VALVE/GAS
	EXISTING STORM DRAIN INLET
— OHE —	EXISTING OVERHEAD ELECTRIC
— X — X —	EXISTING FENCE (CHAINLINK)
	EXISTING FIRE HYDRANT
OPP	EXISTING POWER POLE
	EXISTING ELECTRIC BOX
o WM	EXISTING WATER METER
ø LP	EXISTING LIGHT POLE
	EXISTING CONCRETE
	EXISTING WOODEN FENCE
	EXISTING CMU WALL
— 6" WL —	ABANDONED WATER LINE
— 30" SD —	PROPOSED STORM DRAIN
	PROPOSED STORM DRAIN MANHOLE
— 6" W —	PROPOSED WATER LINE
	PROPOSED GATE VALVE
	PROPOSED TEE FITTING
	PROPOSED STANDARD CURB & GUTTER

**ESPEY,
HUSTON &
ASSOCIATES, INC.**
Engineering & Environmental Consultants

**317 COMMERCIAL ST. N.E.
ALBUQUERQUE, NEW MEXICO 87102
PHONE: (505) 242-1909**

CITY OF ALBUQUERQUE
PUBLIC WORKS DEPARTMENT
ENGINEERING GROUP

TITLE: **ODELIA DAM OUTFALL EXTENSION**
STORM SEWER PLAN & PROFILE
STA. 14+00 TO STA. 22+50

APPROVALS	ENGINEER	DATE	APPROVALS	ENGINEER	DATE
O.R.C. Chairman	Roger A. Khan	5/11/90	Water	R.W. Kane	3-21-90
Transportation	L. Davis	4-19-90	Wastewater	R.W. Kane	3-21-90
Hydrology	J. Murray	4/19/90			

DRAWING NO.	3601	MAP NO.	H-14815	SHEET	4	OF	12
-------------	------	---------	---------	-------	---	----	----

BENCH MARKS	The station is located at the intersection of Edith and McKnight NE at the Northwest quadrant of the intersection. The station mark is a square, ☒, chiseled on the top of the NW curb return. MSLD Elevation = 4988.82	AS BUILT INFORMATION
SWANWICK MECHANICAL	DATE: 01/11/2010 DRAWN BY: J. ARCHULETA DATE: 12/9/09 CHECKED BY: J. ARCHULETA DATE: 12/9/09	DATE: 01/11/2010
MICRO-FILM INFORMATION		

SURVEY	INFORMATION
NO.	FIELD NOTES
BY	DATE

ENGINEER'S SEAL



San G. P.

3-6-90

NO	DATE	REMARKS	BY
		DESIGN	
		DLC	
	DATE	3-6-90	
	DATE	3-6-90	

ROQUE ARTMENT SOUP	
LL EXTENSION	
A PROFILE	
. 22+50	
DATE	DATE
ter	R.W. Kane 3-21-90
	R.W. Kane 3-21-90
SHEET	OF
15	4 12

AS-BUILT RECORDS SHOW AN ABANDONED RCP
PIPE UNDER INDIAN SCHOOL ROAD.
EXISTING RECORDS SHOW IT ENCOUNTERED
DURING CONSTRUCTION. THE LOCATION
OF REMOVAL SHALL BE DETERMINED BY THE
PROJECT MANAGER.

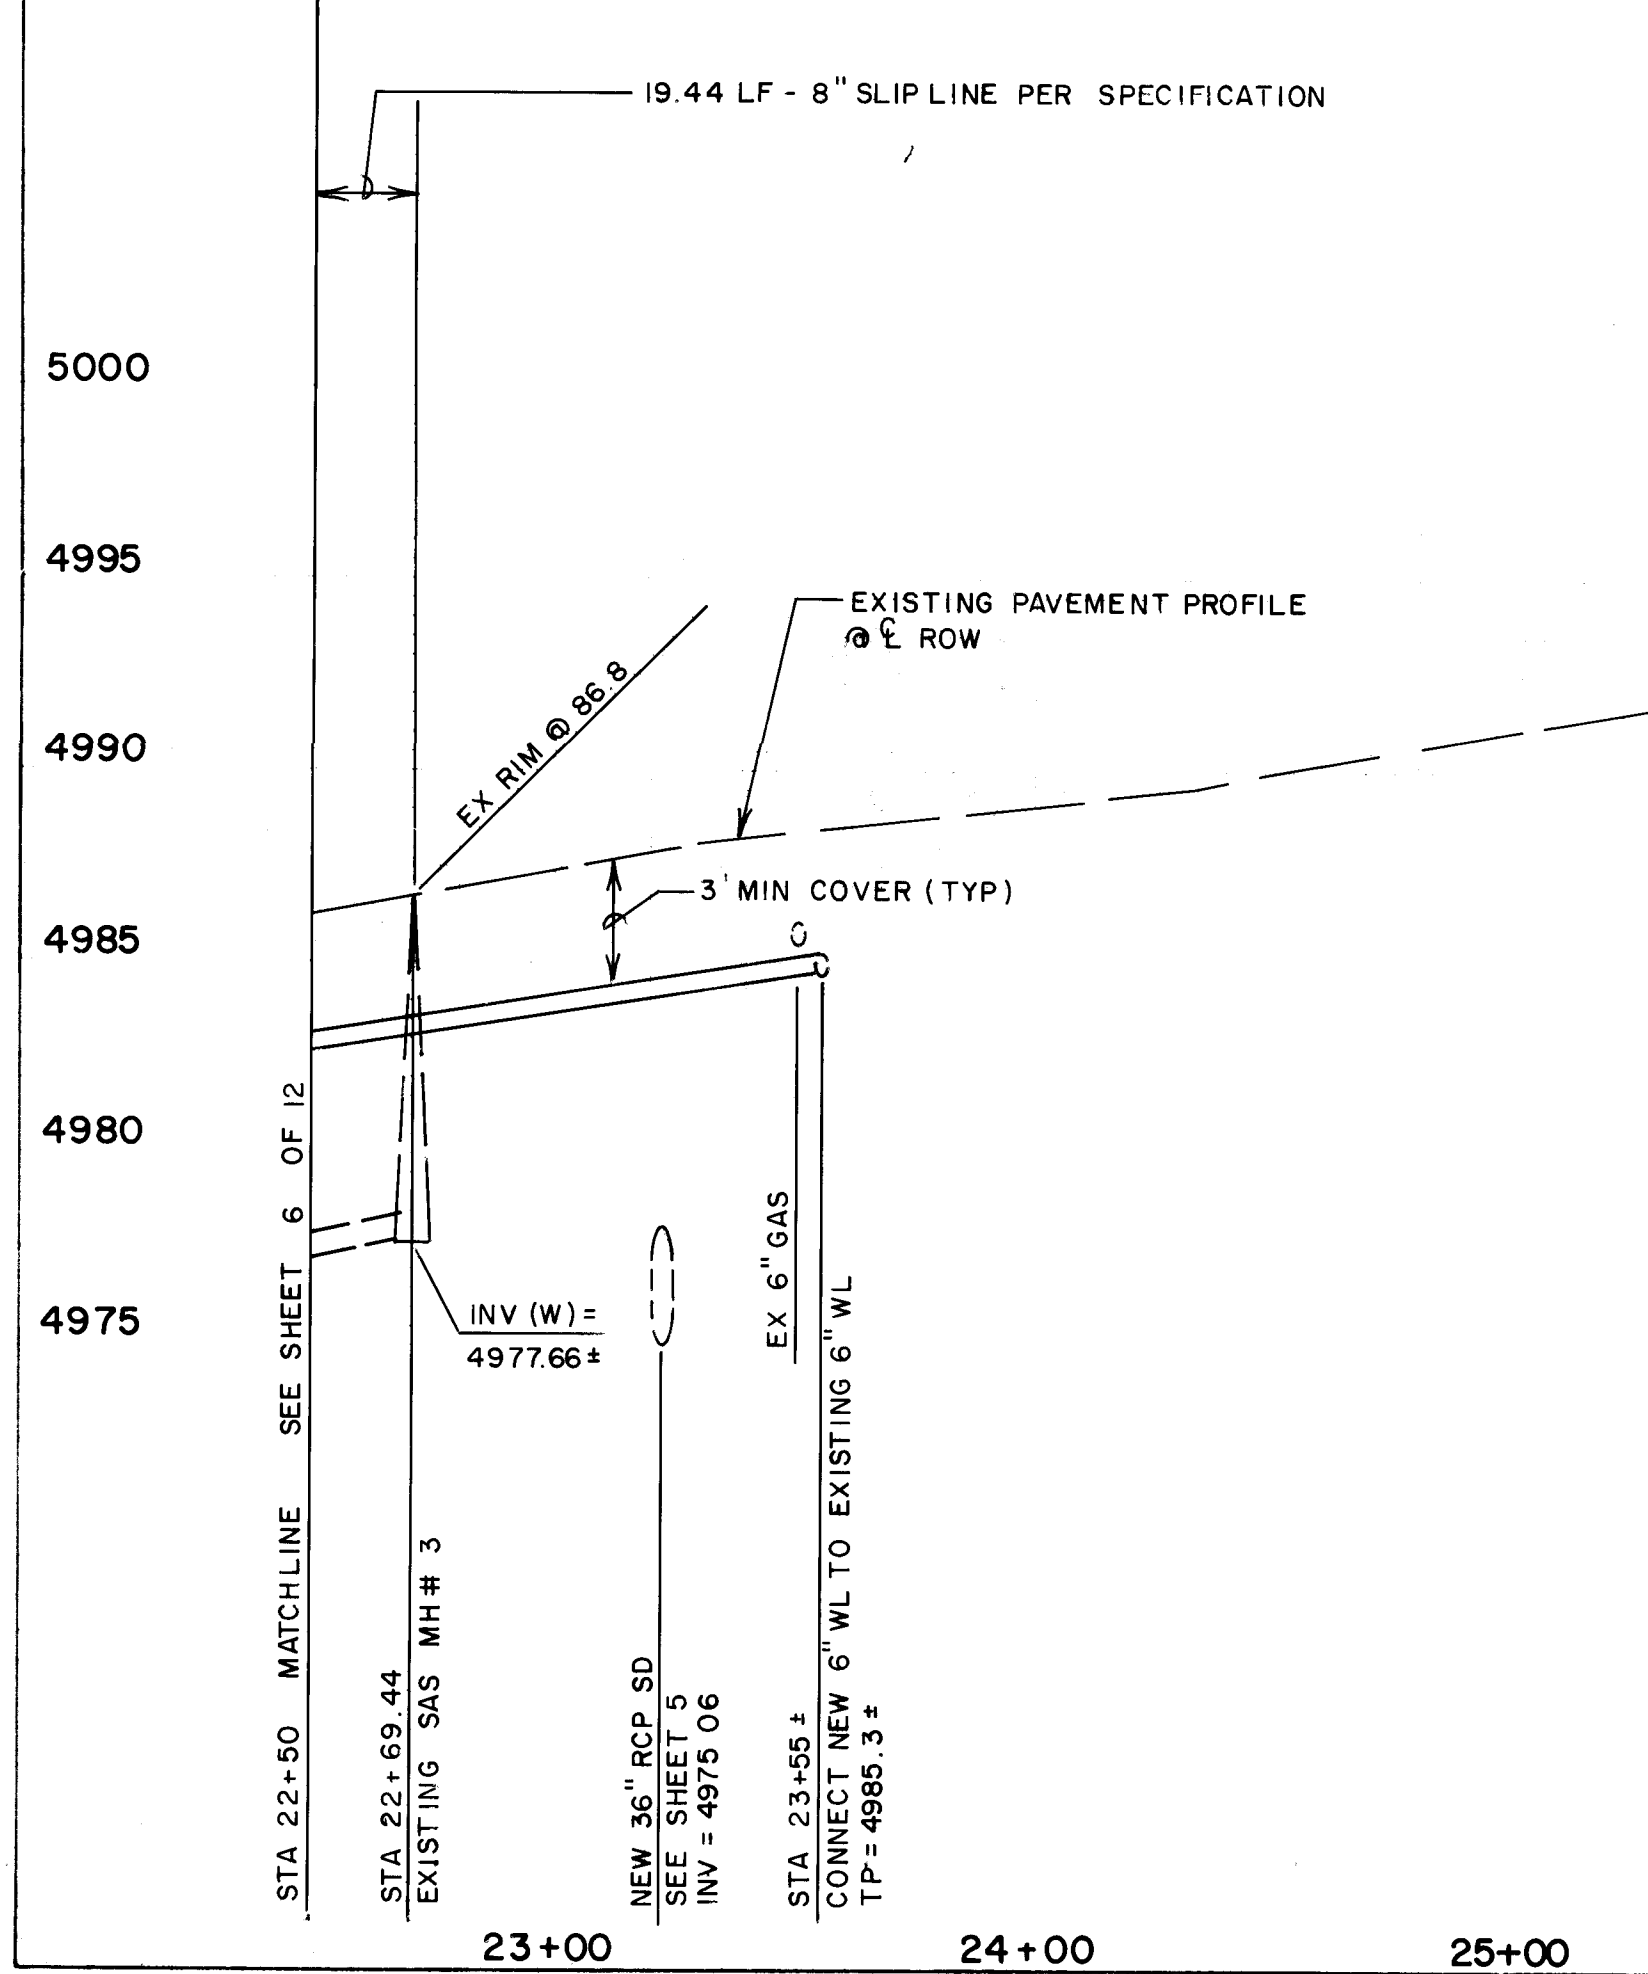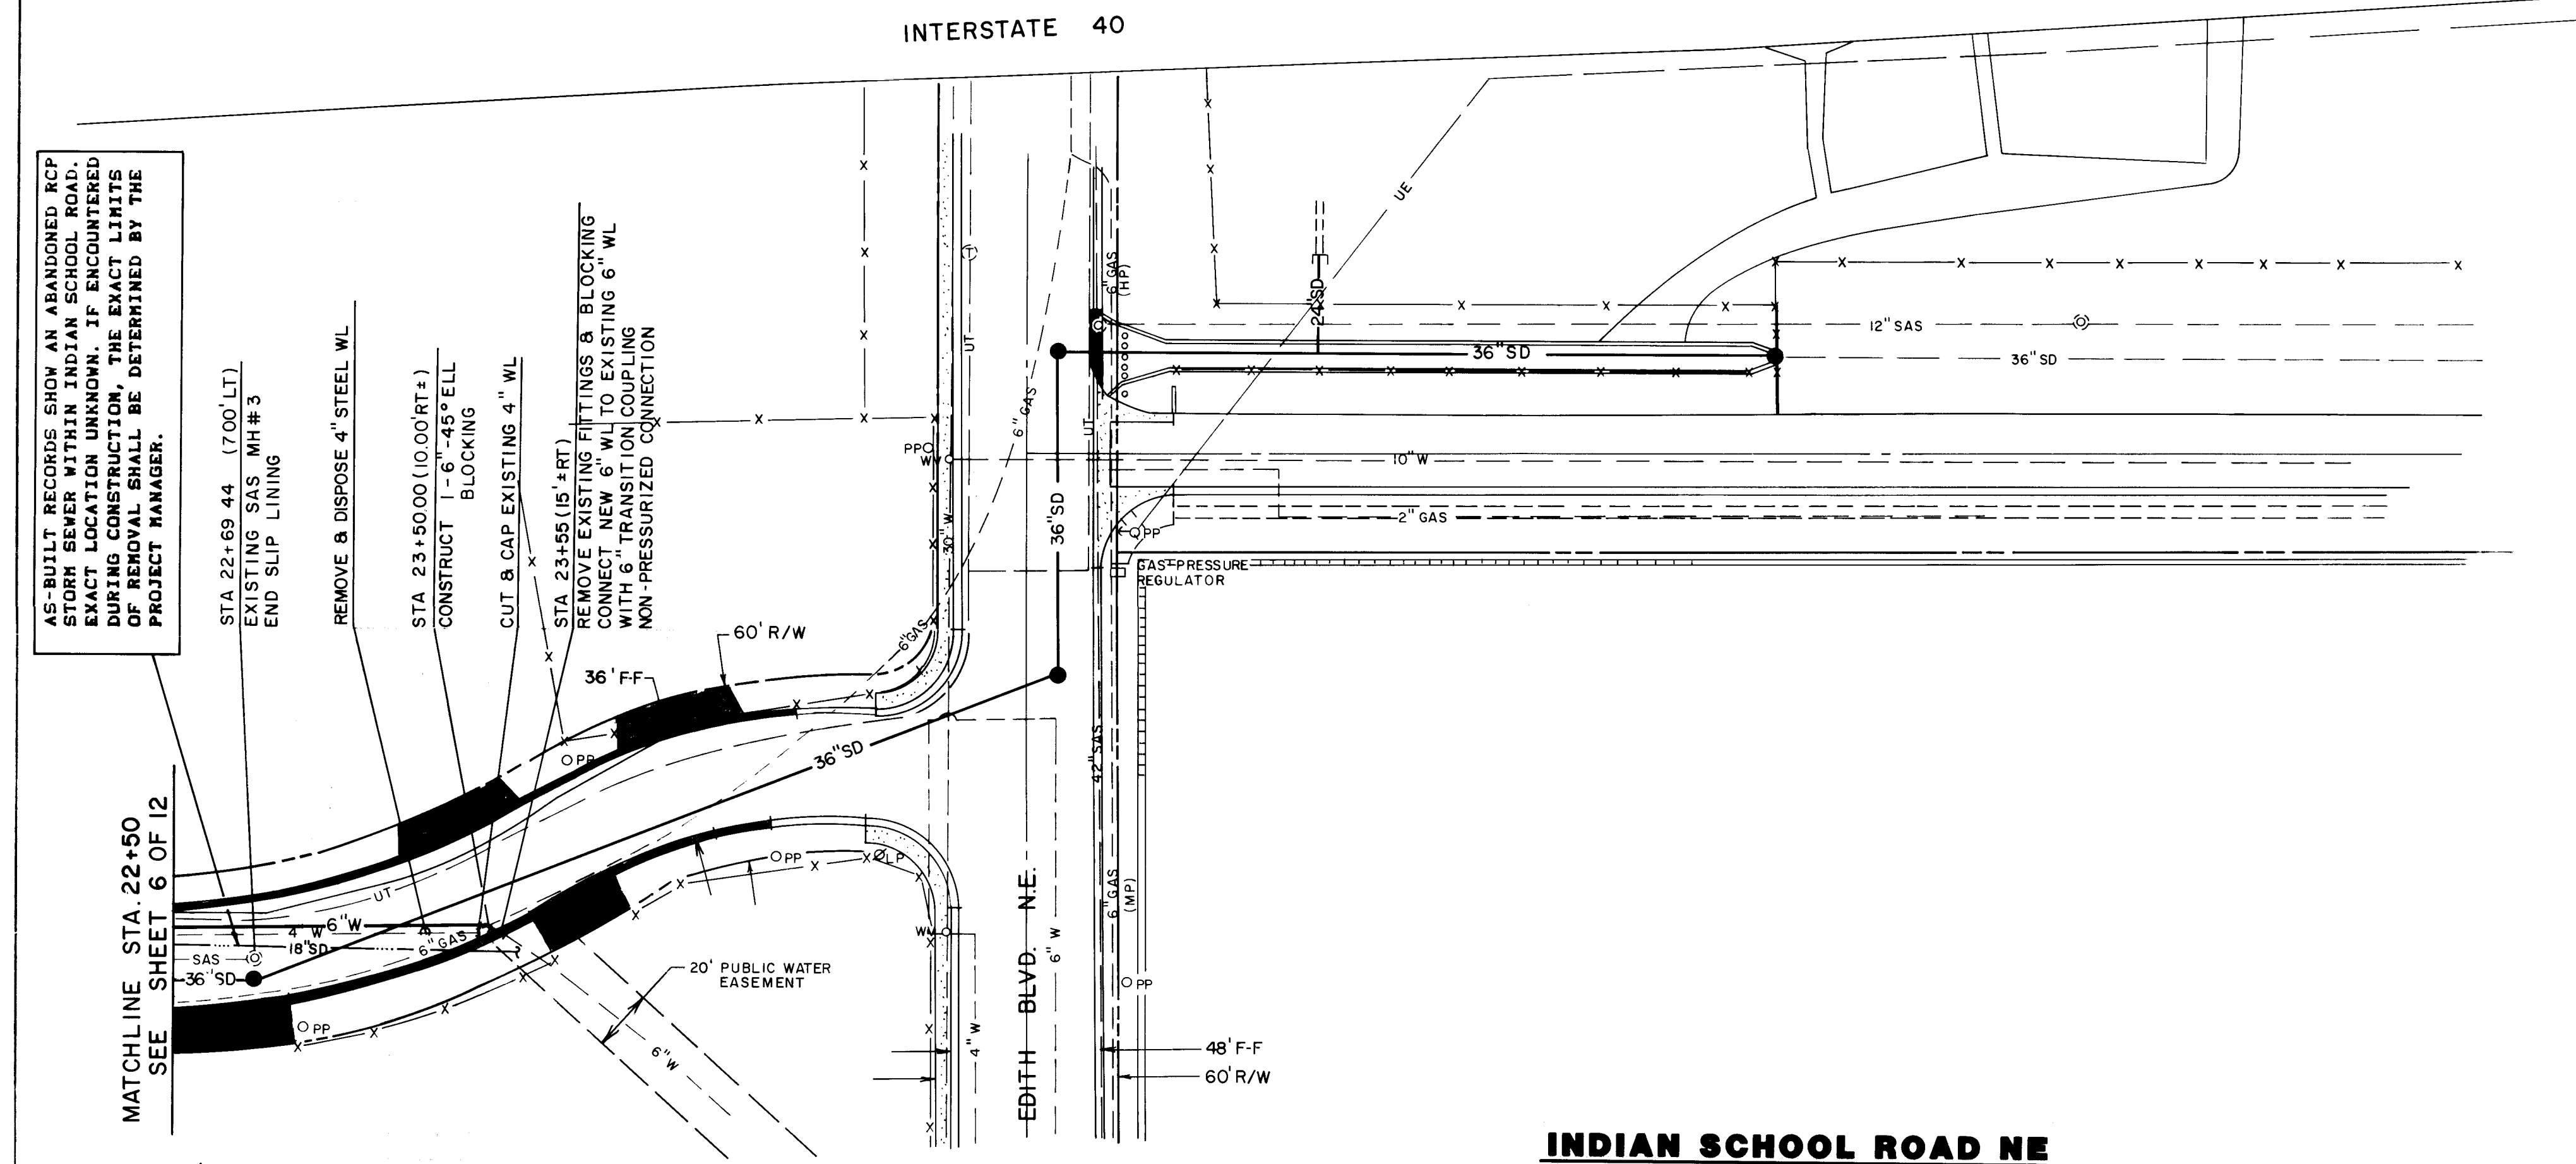

INDIAN SCHOOL ROAD NE

NOTES:

- All stationing shown hereon is based on the centerline of the storm sewer. All offset distances are measured from the stationing baseline.
- The contractor shall properly support all utilities exposed during the construction. All trenches shall be backfilled in accordance with project specifications.
- Where vertical clearances less than 12 inches occur between proposed and existing utility lines the lower utility line shall be protected by a 3/4 inch thick polyurethane pad.
- The contractor is responsible for coordinating utility relocations and conflicts with the local utility companies. The following representatives are available for assistance:
Jim Vann, PNM
761-3426
Wayne Hensing, U.S. West
245-6674
Tim Cynova, Gas Co.
889-2538
Yvette Suavo, Jones
Interchange
761-6221
- The existing sanitary sewer services to be reconnected to the slip lined sewer shown hereon represent approximate locations. It is the contractor's responsibility to verify the location of active services. No extra payment shall be made for verification of active services.
- All U.S. West manholes shall be adjusted to grade by others. Contractor shall contact Irene Olivas at U.S. West, 888-8733, 5 working days prior to needing rims adjusted.

SCALE
HORIZONTAL: 1" = 40'
VERTICAL: 1" = 05'

- LEGEND
- 6" W --- EXISTING WATER LINE
 - 2" GAS --- EXISTING GAS LINE
 - 10" SAS --- EXISTING SANITARY SEWER
 - UT --- EXISTING UNDERGROUND TELEPHONE
 - EXISTING UNDERGROUND TELEPHONE MANHOLE
 - EXISTING SANITARY SEWER MANHOLE
 - EXISTING STORM DRAIN MANHOLE
 - OPRV --- EXISTING PRESSURE RELEASE VALVE/GAS INLET
 - OHE --- EXISTING OVERHEAD ELECTRIC
 - EXISTING FENCE (CHAINLINK)
 - EXISTING FIRE HYDRANT
 - OPP --- EXISTING POWER POLE
 - EB --- EXISTING ELECTRIC BOX
 - OWM --- EXISTING WATER METER
 - LP --- EXISTING LIGHT POLE
 - EXISTING CONCRETE
 - EXISTING WOODEN FENCE
 - EXISTING CMU WALL
 - 6" WL --- ABANDONED WATER LINE
 - 30" SD --- PROPOSED STORM DRAIN
 - PROPOSED STORM DRAIN MANHOLE
 - 6" W --- PROPOSED WATER LINE
 - PROPOSED GATE VALVE
 - PROPOSED TEE FITTING
 - PROPOSED STANDARD CURB & GUTTER

C of A PWD Maps & Records
1 2 3 4 5 6 7 8 9 10 11 12
2 6 3 6 0 1 0 7 9 1

CITY OF ALBUQUERQUE PUBLIC WORKS DEPARTMENT ENGINEERING GROUP	
TITLE ODELIA DAM OUTFALL EXTENSION WATER AND SANITARY SEWER PLAN AND PROFILE STA. 22+50 TO STA. 23+55	
APPROVALS	DATE
DESIGNED BY: <i>Rogel</i> 5/11/90	Water
CHECKED BY: <i>Rogel</i> 1-19-90	Wastewater
Hydrology	
REVISIONS	
NO.	DATE
1	DATE
2	DATE
3	DATE
4	DATE
5	DATE
6	DATE
7	DATE
8	DATE
9	DATE
10	DATE
11	DATE
12	DATE
DRAWING NO. 3601	
MAP NO. H-14815	
SHEET 7 OF 12	

- NOTES:
- All stationing shown hereon is based on the centerline of the storm sewer. All offset distances are measured from the stationing baseline.
 - The contractor shall properly support all utilities exposed during the construction. All trenches shall be backfilled in accordance with project specifications.
 - Where vertical clearances less than 12 inches occur between proposed and existing utility lines the lower utility line shall be protected by a 3/4 inch thick polyurethane pad.
 - The contractor is responsible for coordinating utility relocations and conflicts with the local utility companies. The following representatives are available for assistance:

Jim Vann, PNM
761-3426
Wayne Hemming, U.S. West
245-6674
Tim Cynova, Gas Co.
889-2538
Yvette Suavo, Jones
Interconnect
761-6221
 - The following trench widths shall be used for 30" and 36" RCP storm drain:


30" Class III; W=4.75 ft.
36" Class III; W=5.75 ft.
36" Class IV; W=5.75 ft.

All bedding shall be Class "B". See bedding detail, sheet 12 of 12.
 - All U.S. West manholes shall be adjusted to grade by others. Contractor shall contact Irene Olivas at U.S. West, 888-8733, 5 working days prior to needing rims adjusted.


Record Drawing

This drawing as modified shows public improvements as constructed. These modifications have been made using information and measurements obtained by the City's field survey crew, the Contractor and City Inspector. The modifications conform to the minimum requirements for record drawings criteria as required by the City of Albuquerque per Development Process Manual Section 27.4 to the best of my knowledge and belief.

Paul T. Brasher
Paul T. Brasher P.E. 7282 Date 4-22-91

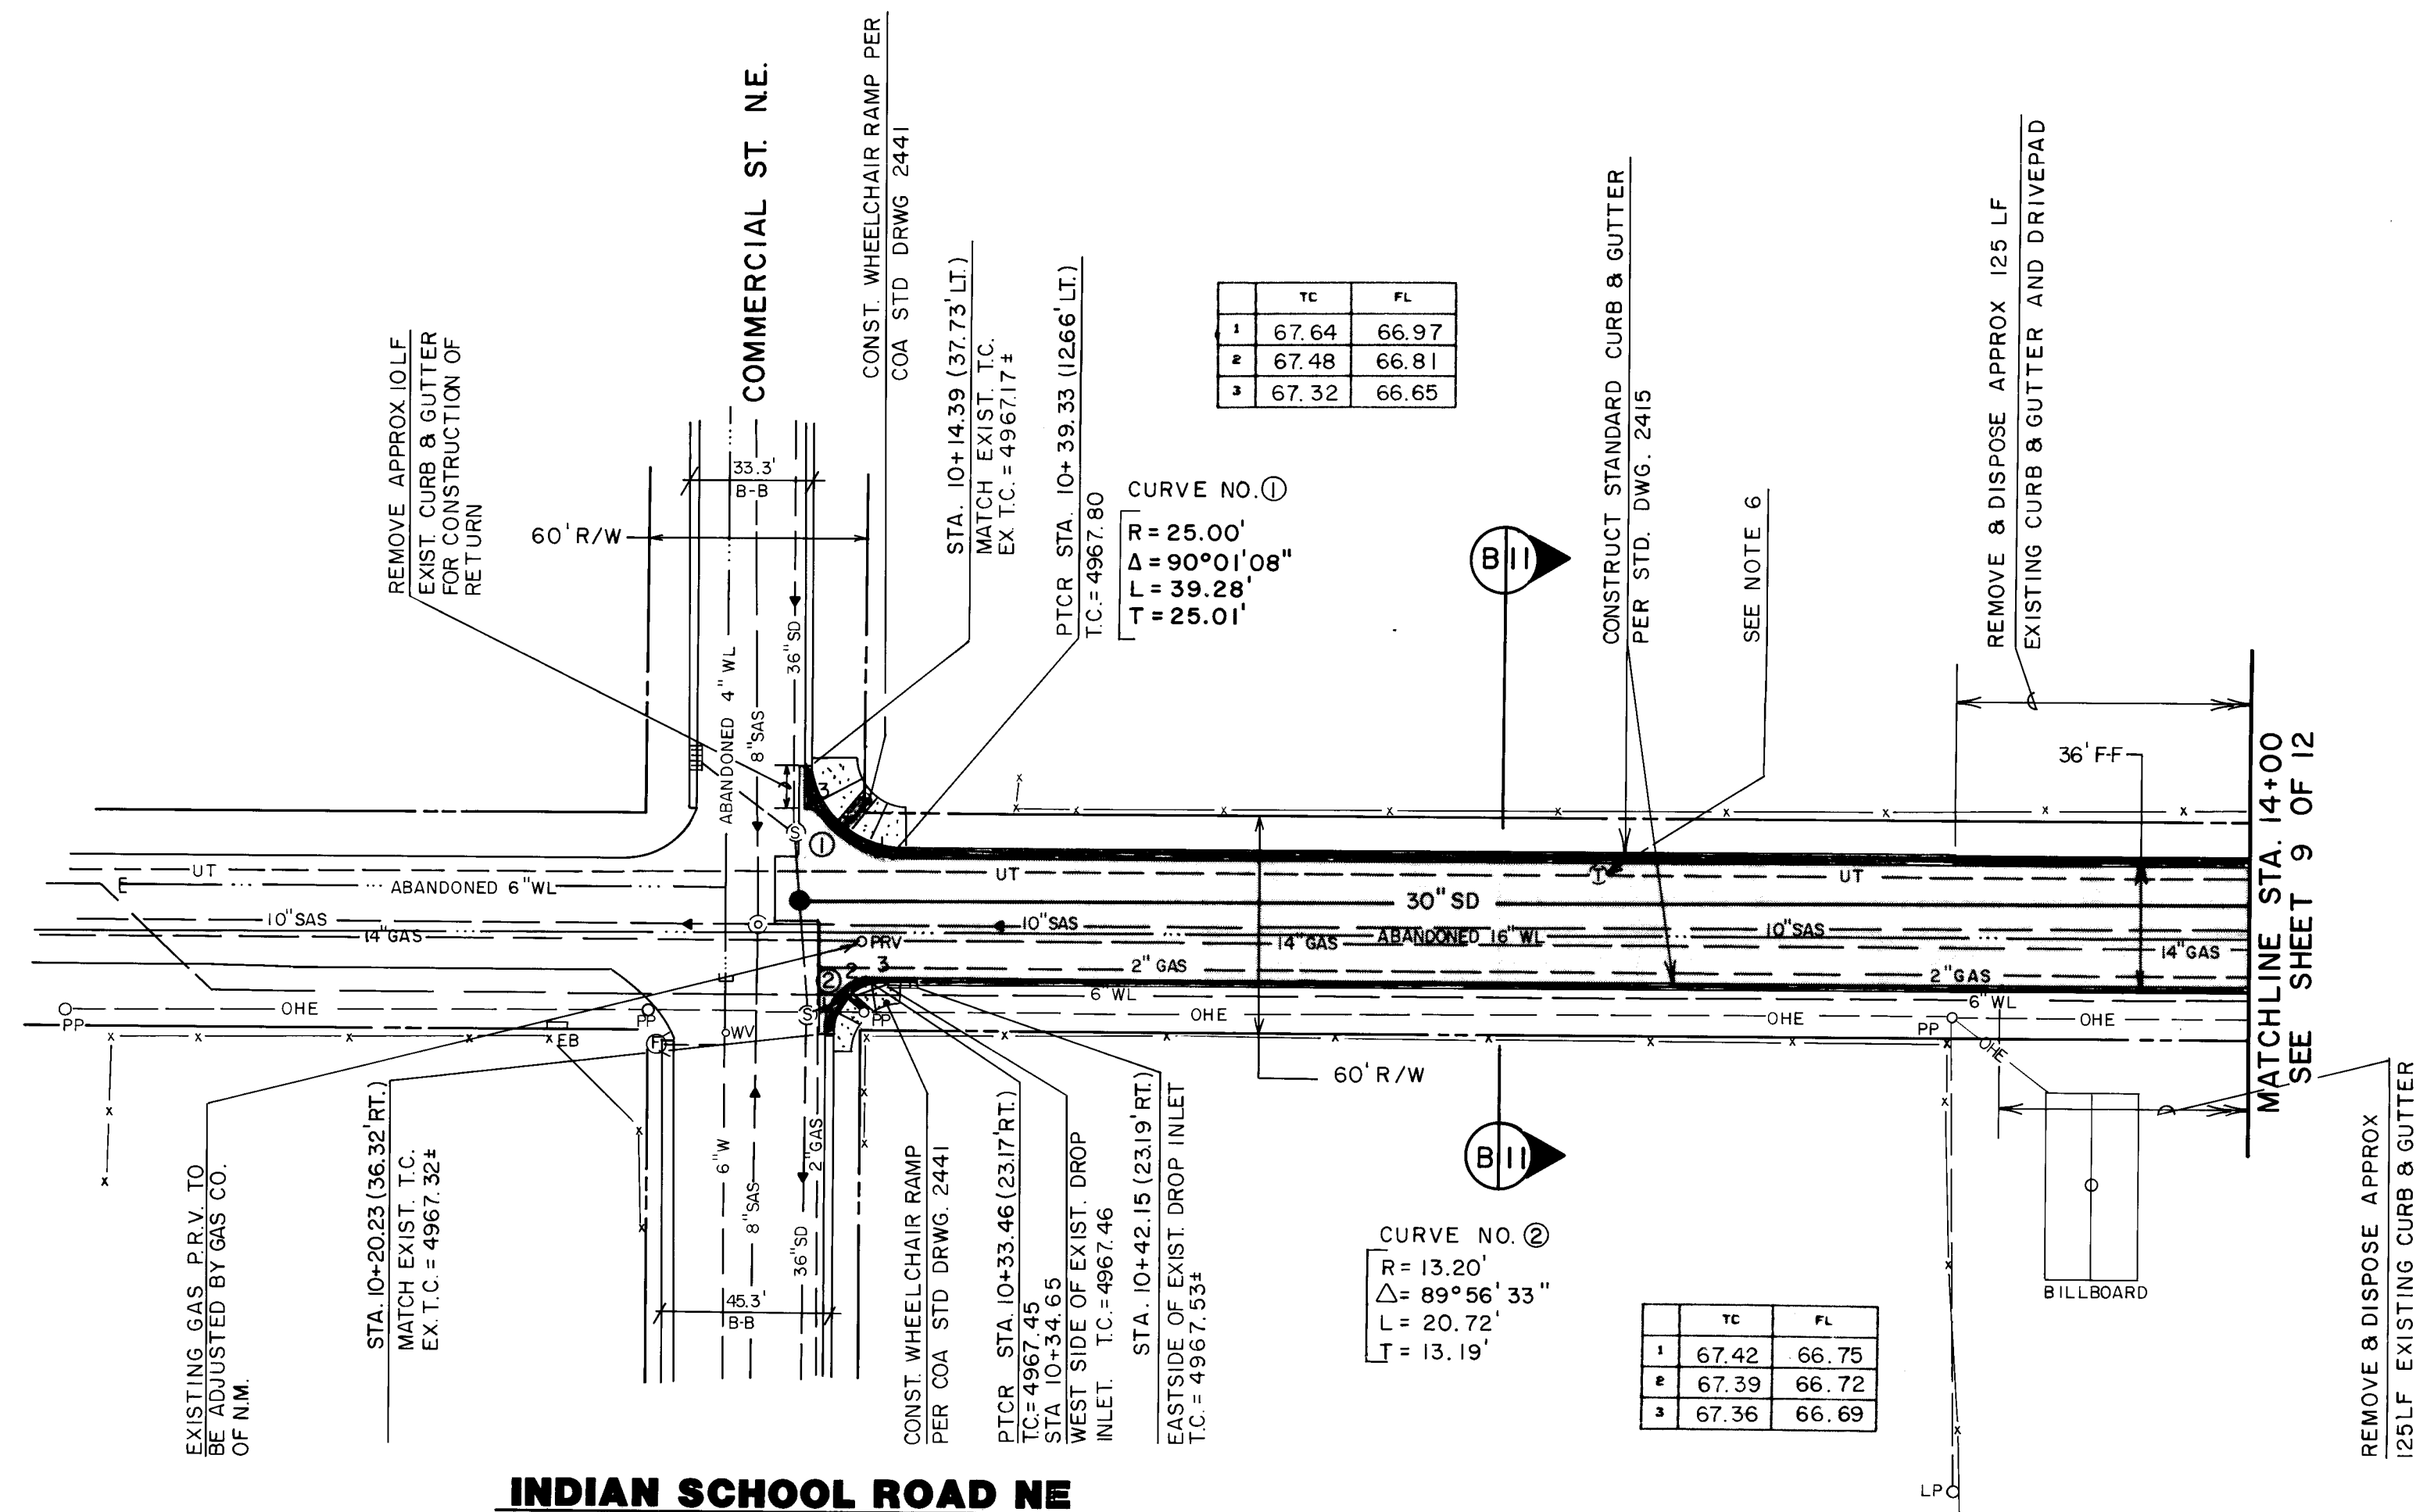

INDIAN SCHOOL ROAD NE

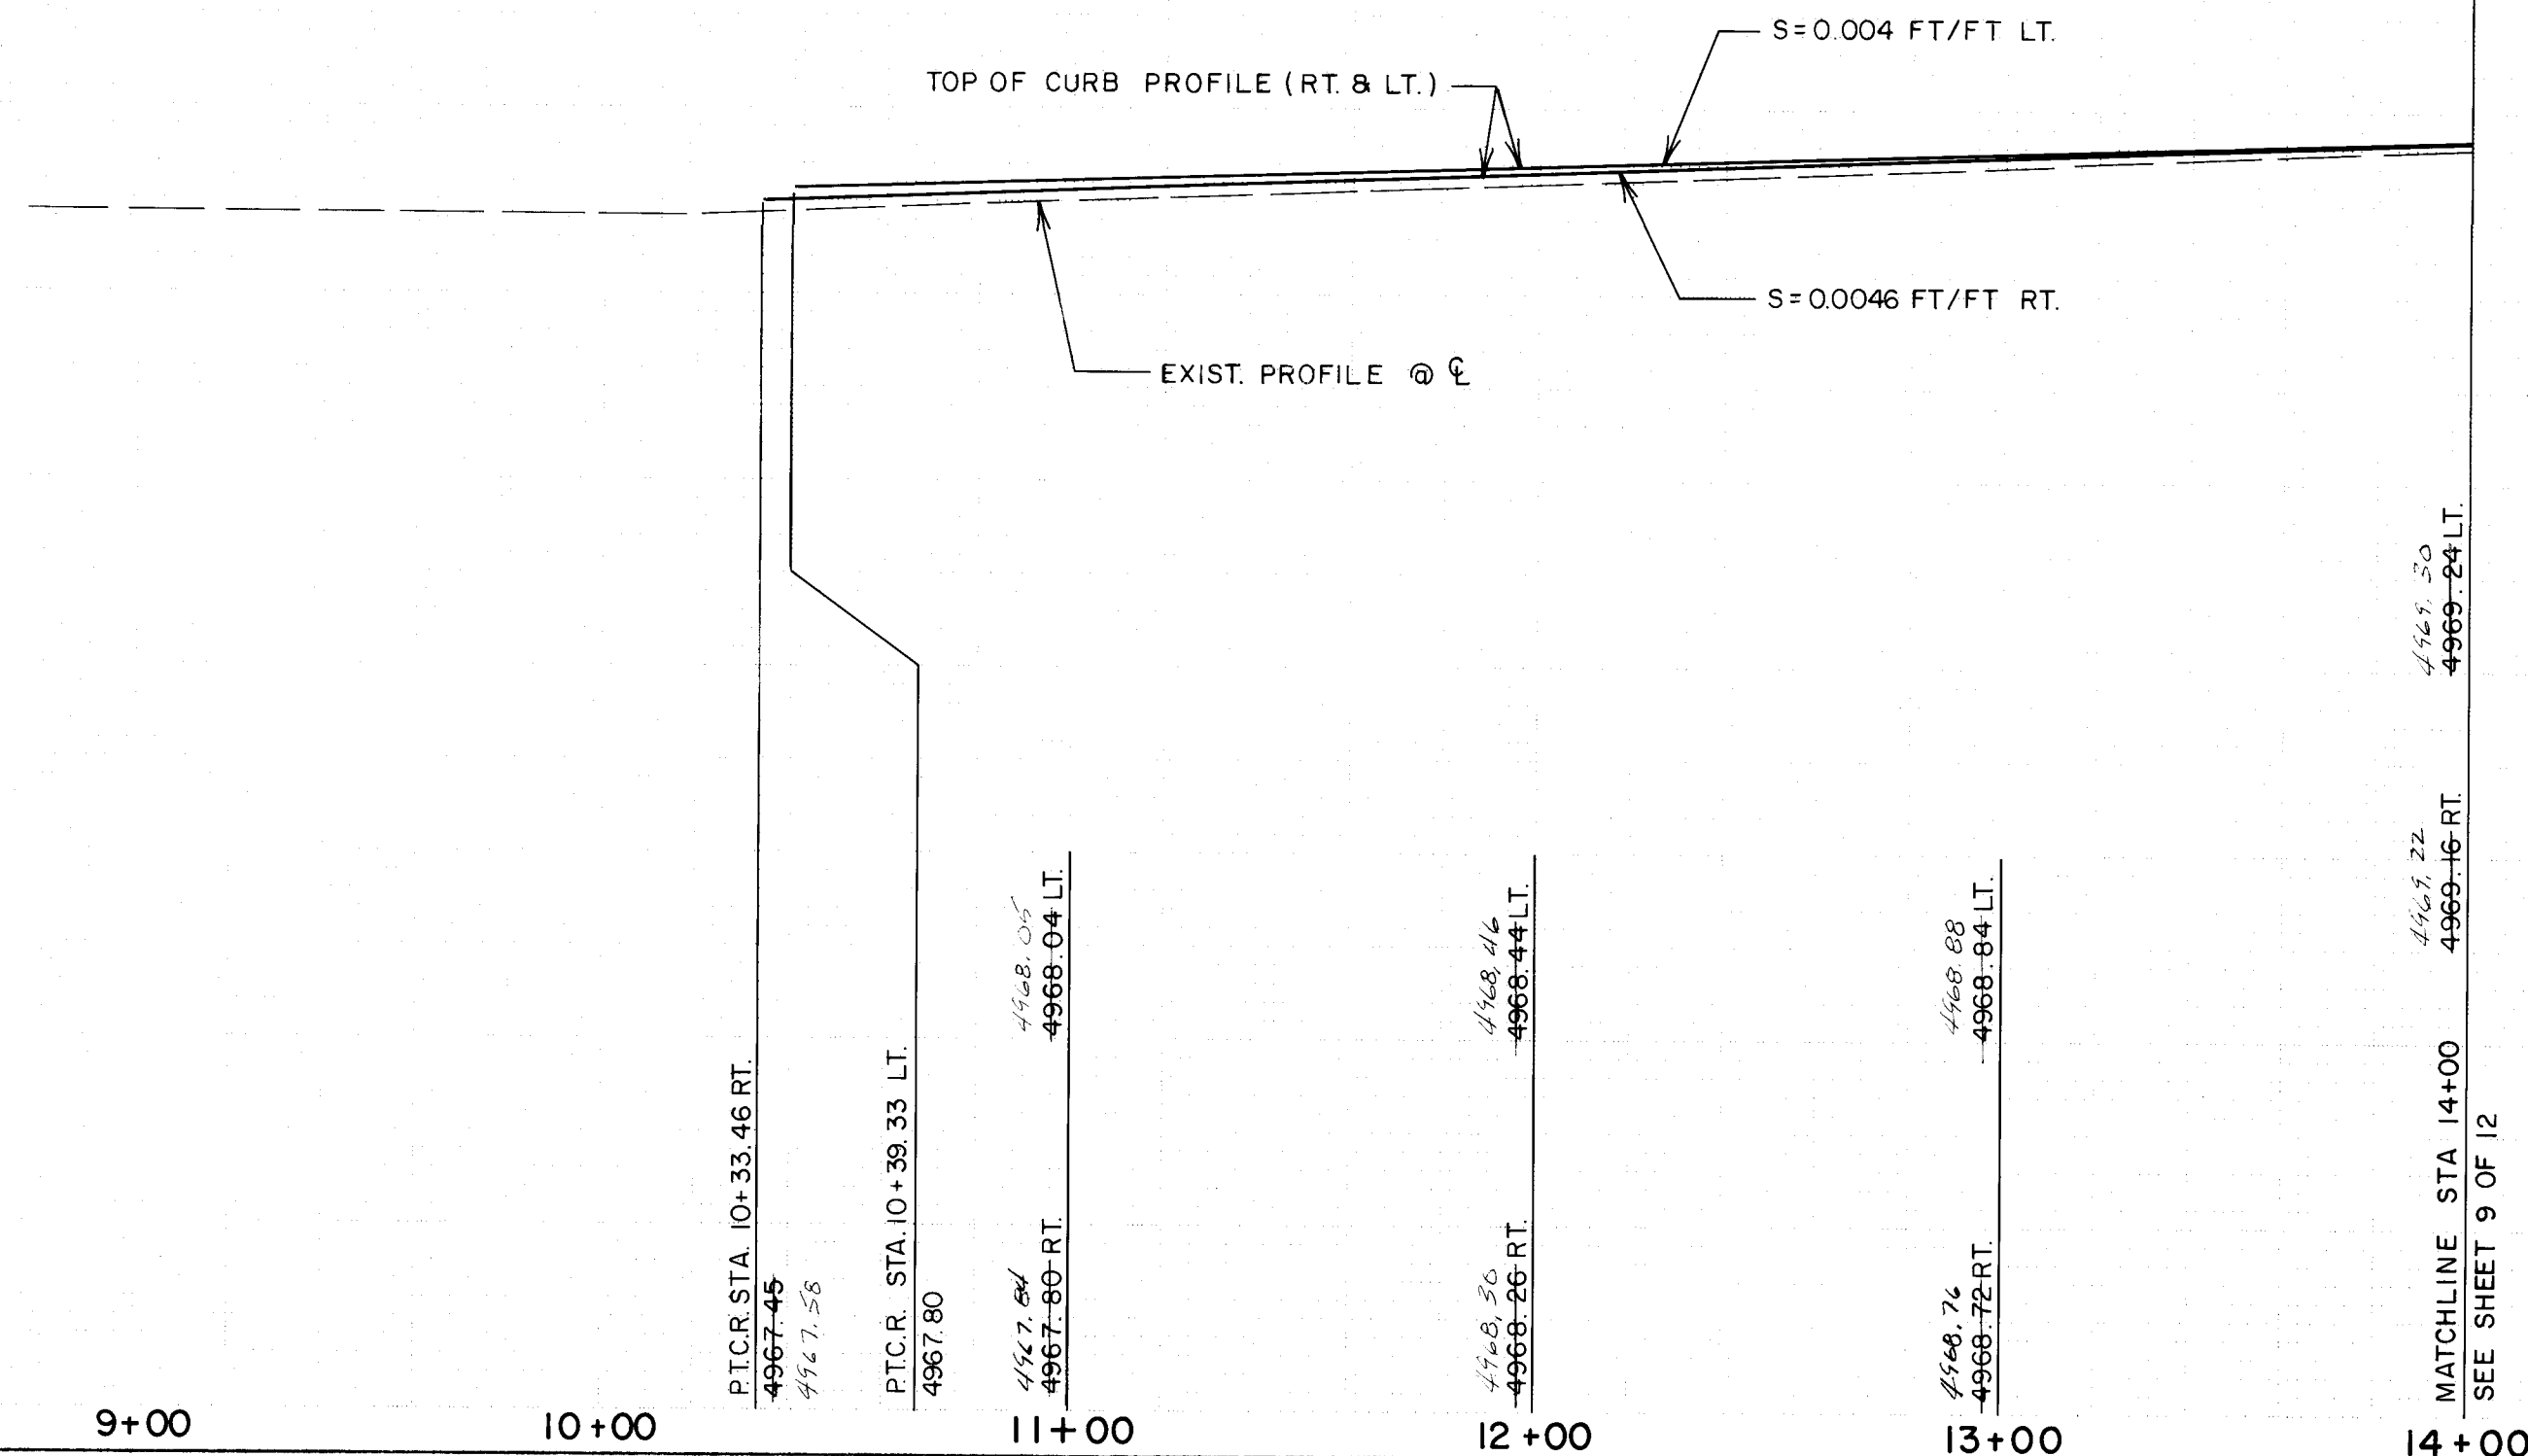

SCALE
HORIZONTAL: 1" = 40'
VERTICAL: 1" = 10'

- LEGEND
- 6" W --- EXISTING WATER LINE
 - 2" GAS --- EXISTING GAS LINE
 - 10" SAS --- EXISTING SANITARY SEWER
 - UT --- EXISTING UNDERGROUND TELEPHONE
 - EXISTING UNDERGROUND TELEPHONE MANHOLE
 - EXISTING SANITARY SEWER MANHOLE
 - EXISTING STORM DRAIN MANHOLE
 - OPRV --- EXISTING PRESSURE RELEASE VALVE/GAS
 - EXISTING STORM DRAIN INLET
 - OHE --- EXISTING OVERHEAD ELECTRIC
 - EXISTING FENCE (CHAINLINK)
 - EXISTING FIRE HYDRANT
 - OPP --- EXISTING POWER POLE
 - EB --- EXISTING ELECTRIC BOX
 - OWM --- EXISTING WATER METER
 - PLP --- EXISTING LIGHT POLE
 - EXISTING CONCRETE
 - EXISTING WOODEN FENCE
 - EXISTING CHU WALL
 - 6" WL --- ABANDONED WATER LINE
 - 30" SD --- PROPOSED STORM DRAIN
 - PROPOSED STORM DRAIN MANHOLE
 - 6" W --- PROPOSED WATER LINE
 - PROPOSED GATE VALVE
 - PROPOSED TEE FITTING
 - PROPOSED STANDARD CURB & GUTTER

ESPEY,
HUSTON &
ASSOCIATES, INC.
Engineering & Environmental Consultants
317 COMMERCIAL ST. N.E.
ALBUQUERQUE, NEW MEXICO 87102
PHONE: (505) 242-1909

CITY OF ALBUQUERQUE
PUBLIC WORKS DEPARTMENT
ENGINEERING GROUP


TITLE: **ODELIA DAM OUTFALL EXTENSION**
PAVING PLAN AND PROFILE
STA. 10+00 TO STA. 14+00

NO.	DATE	REVISIONS	DESIGN	CHECKED BY	DATE
1	5/1/90				
2	5/19/90				
3	4/19/90				

DRAWING NO. 3601 MAP NO. H-14 8/15 SHEET 8 OF 12

DESIGNED BY: R.W. Kane 3-21-90
CHECKED BY: R.W. Kane 3-21-90

AS BUILT INFORMATION
The station is located at the intersection of Edith and McKnight NE at the Northwest quadrant of the intersection. The station mark is a square, chiseled on the top of the HWY curb return. HELD Elevation = 4988.82
SURNAME MECHANICAL
P.O. A.
J. H. HARRIS
CORPORATE
MICRO FILM INFORMATION

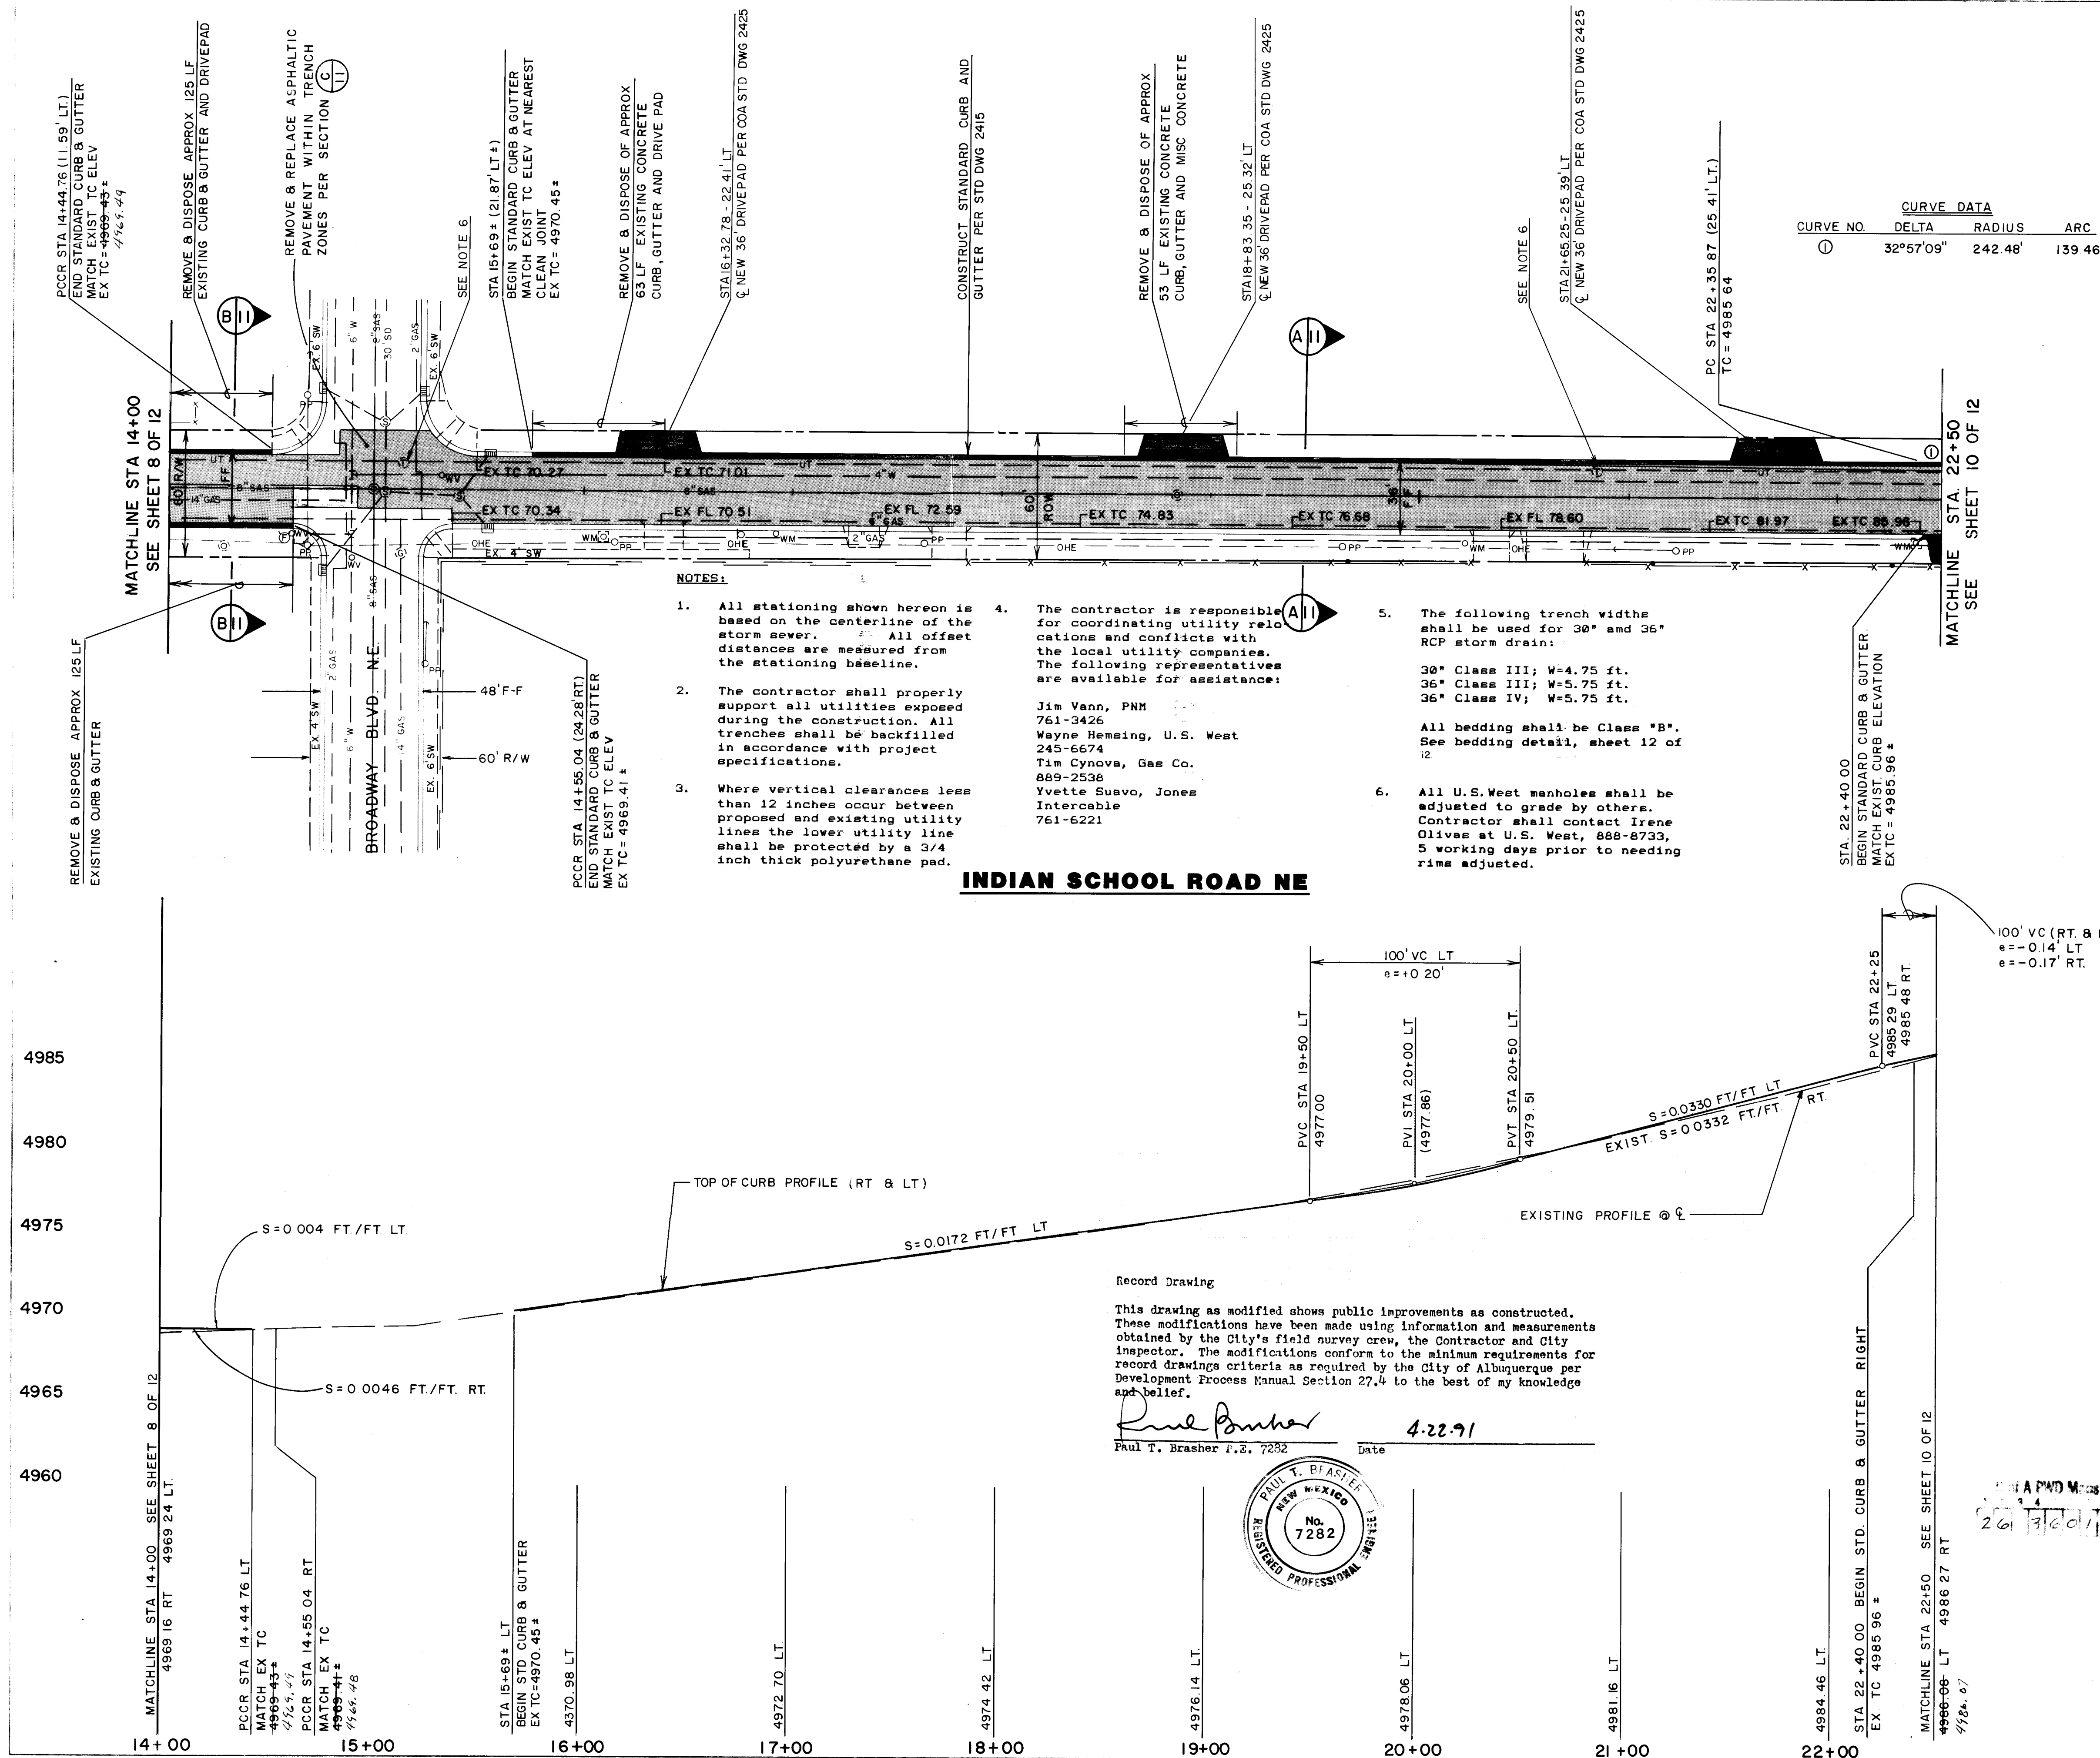

SCALE
HORIZONTAL 1" = 40'
VERTICAL 1" = 5'

ENGINEER'S INFORMATION

The station is located at the intersection of Indian School Road NE and Broadway Blvd. NE. The station mark is a square, 2' x 2', chiseled on the top of the NW curb return. MSLD Elevation = 4988.62

ENGINEER'S SIGNATURE

DATE 3-6-90

REMARKS

4/1/90
4/19/90
4/19/90


DESIGN DATE 2-90
DATE 3-6-90

ESPEY, HUSTON & ASSOCIATES, INC.
317 COMMERCIAL ST. N.E.
ALBUQUERQUE, NEW MEXICO 87102
PHONE (505) 242-1909

CITY OF ALBUQUERQUE
PUBLIC WORKS DEPARTMENT
ENGINEER

ODELIA DAM OUTFALL EXTENSION
PAVING PLAN & PROFILE
STA. 14+00 TO STA. 22+50

DRAWING NO. 3601 **MAP NO.** H-14&15 **SHEET** 9 **OF** 12

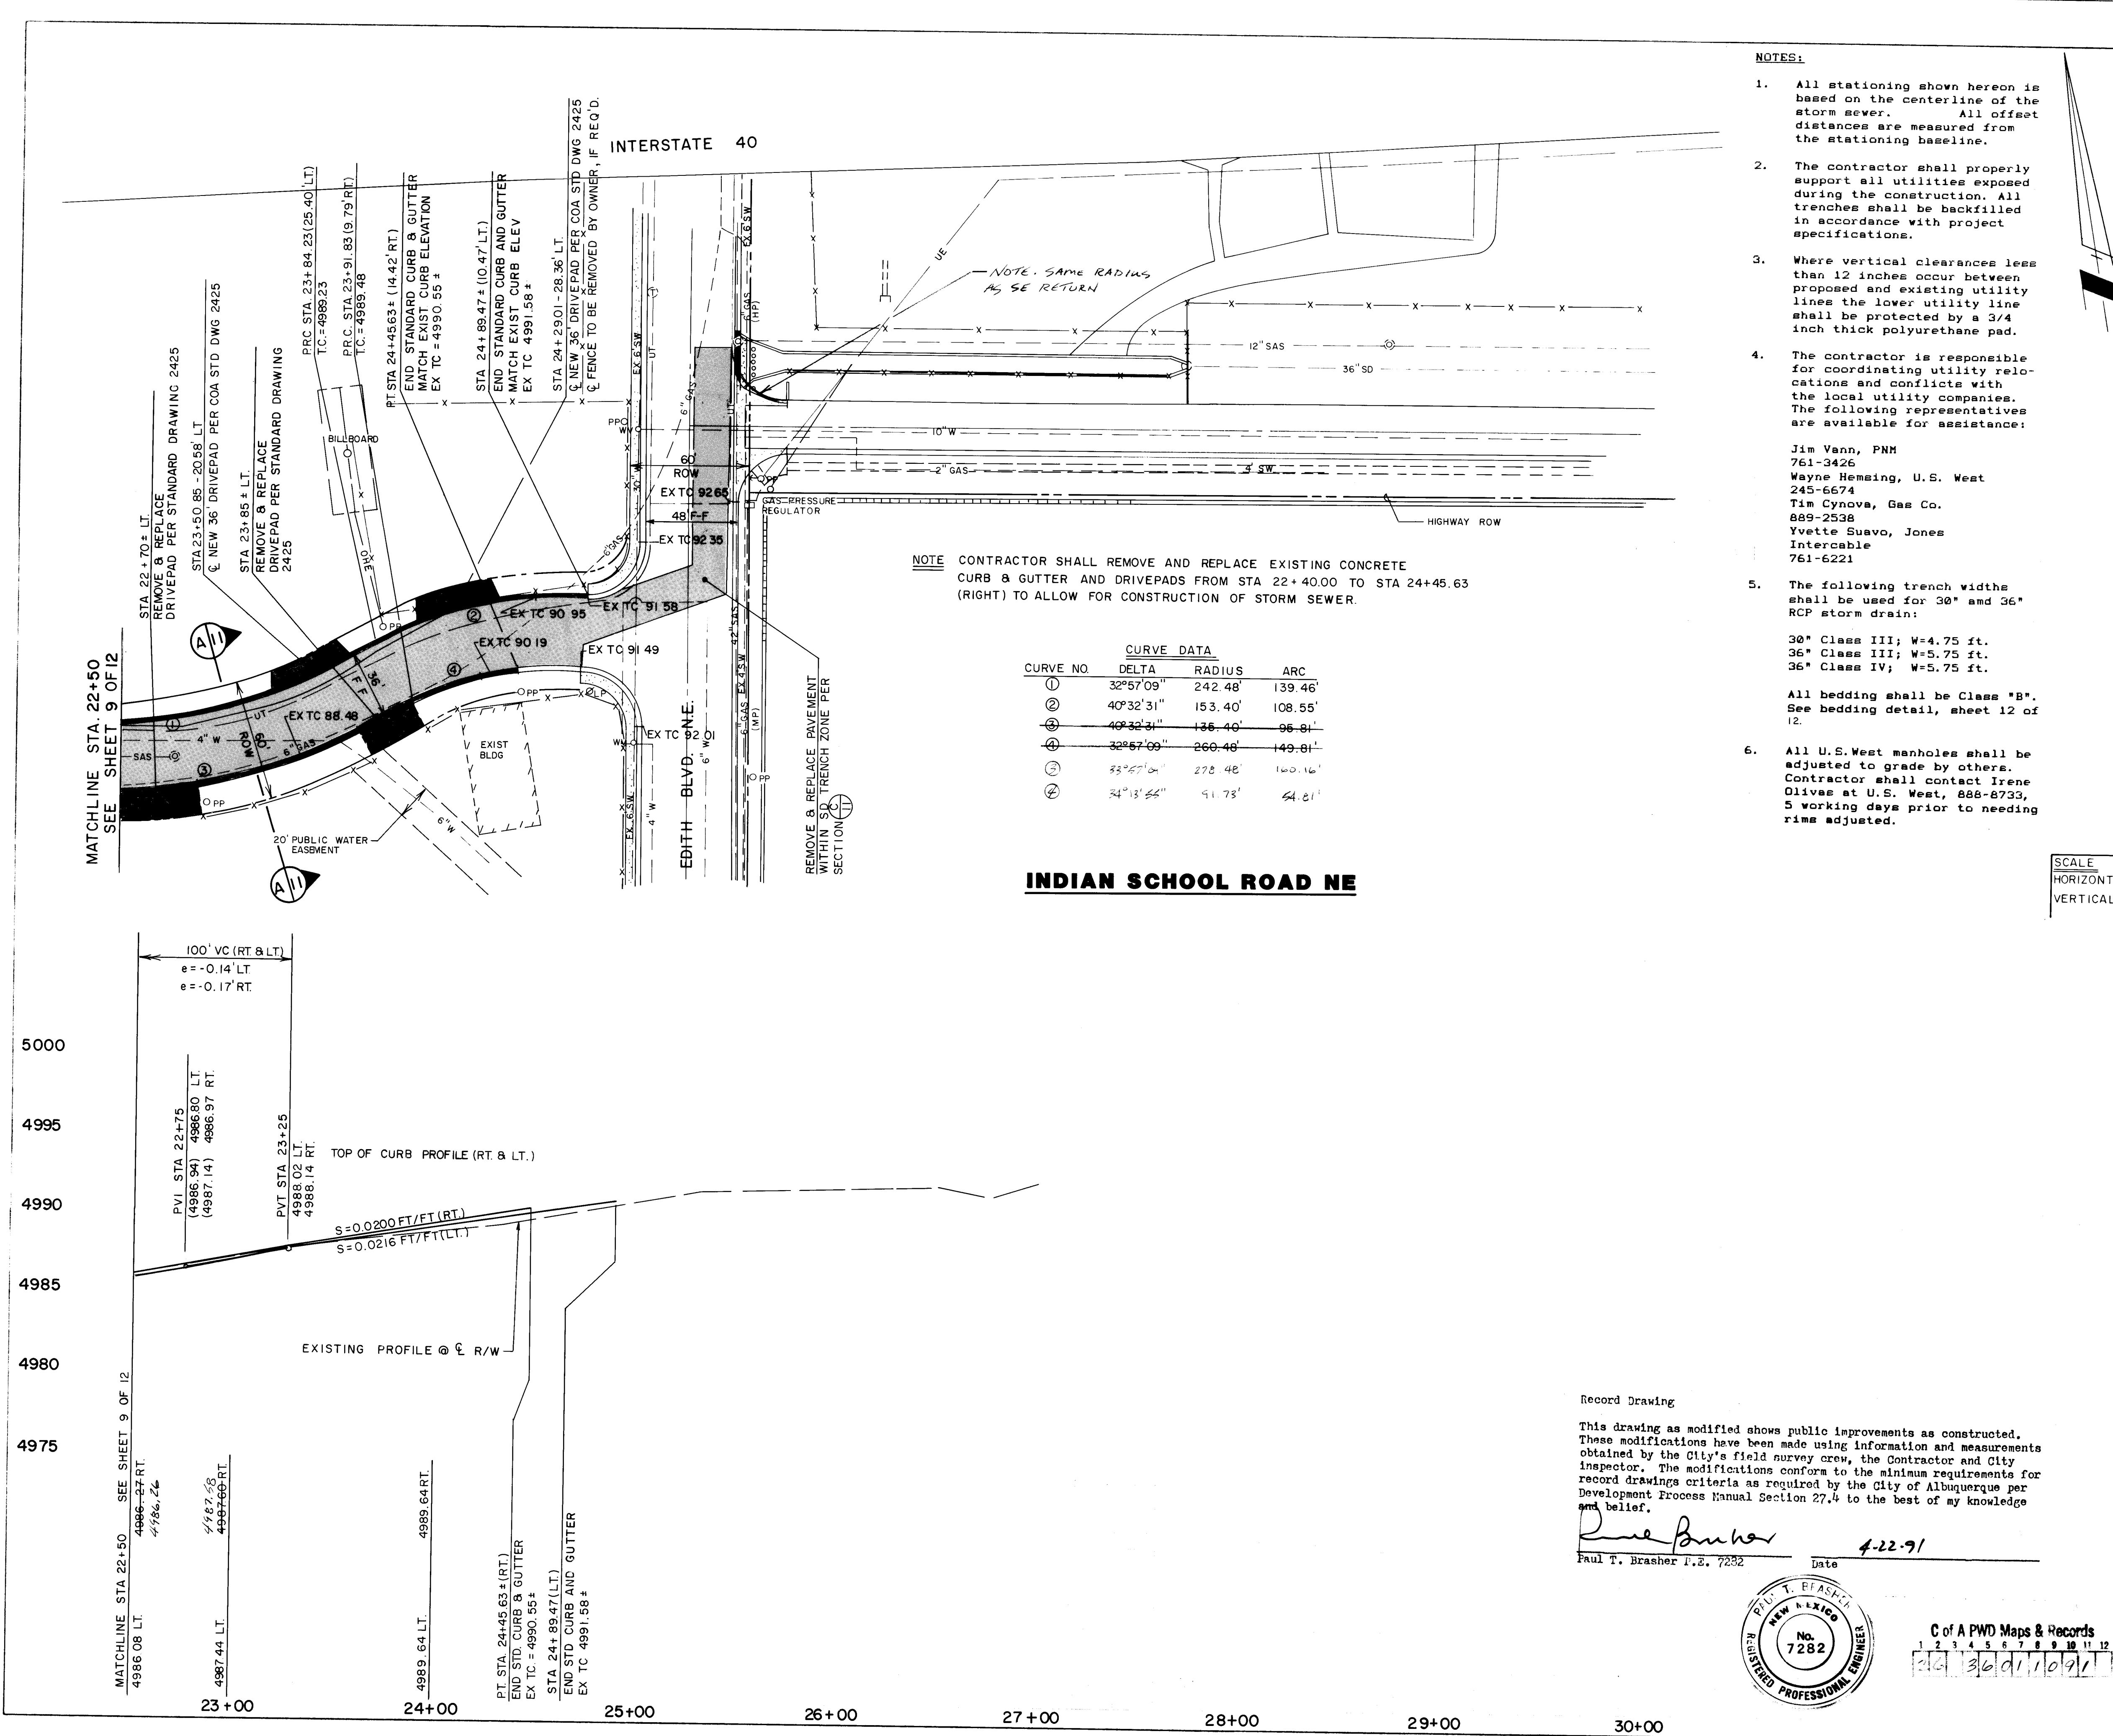

- NOTES:**
- All stationing shown hereon is based on the centerline of the storm sewer. All offset distances are measured from the stationing baseline.
 - The contractor shall properly support all utilities exposed during the construction. All trenches shall be backfilled in accordance with project specifications.
 - Where vertical clearances less than 12 inches occur between proposed and existing utility lines the lower utility line shall be protected by a 3/4 inch thick polyurethane pad.
 - The contractor is responsible for coordinating utility relocations and conflicts with the local utility companies. The following representatives are available for assistance:
Jim Vann, PNM 761-3426
Wayne Hemsing, U.S. West 245-6674
Tim Cynova, Gas Co. 889-2538
Yvette Suavo, Jones Intercable 761-6221
 - The following trench widths shall be used for 30" and 36" RCP storm drain:
30" Class III; W=4.75 ft.
36" Class III; W=5.75 ft.
36" Class IV; W=5.75 ft.
All bedding shall be Class "B". See bedding detail, sheet 12 of 12.
 - All U.S. West manholes shall be adjusted to grade by others. Contractor shall contact Irene Olivas at U.S. West, 888-8733, 5 working days prior to needing rime adjusted.


CURVE DATA			
CURVE NO.	DELTA	RADIUS	ARC
①	32°57'09"	242.48'	139.46'
②	40°32'31"	153.40'	108.55'
③	40°32'31"	136.40'	96.81'
④	32°57'09"	260.48'	149.81'
⑤	33°57'04"	278.48'	160.16'
⑥	34°13'56"	91.73'	64.81'

NOTE CONTRACTOR SHALL REMOVE AND REPLACE EXISTING CONCRETE CURB & GUTTER AND DRIVEPADS FROM STA 22+40.00 TO STA 24+45.63 (RIGHT) TO ALLOW FOR CONSTRUCTION OF STORM SEWER.

Record Drawing


This drawing as modified shows public improvements as constructed. These modifications have been made using information and measurements obtained by the City's field survey crew, the Contractor and City Inspector. The modifications conform to the minimum requirements for record drawings criteria as required by the City of Albuquerque per Development Process Manual Section 27.4 to the best of my knowledge and belief.

Paul T. Brasher
Paul T. Brasher P.E. 7232 Date 4-22-91

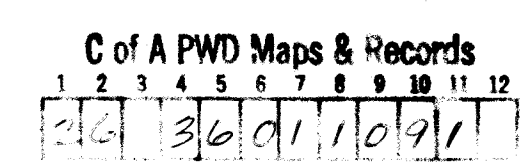

- LEGEND**
- 6" W --- EXISTING WATER LINE
 - 2" GAS --- EXISTING GAS LINE
 - 10" SAS --- EXISTING SANITARY SEWER
 - UT --- EXISTING UNDERGROUND TELEPHONE
 - ① --- EXISTING UNDERGROUND TELEPHONE MANHOLE
 - ② --- EXISTING SANITARY SEWER MANHOLE
 - ③ --- EXISTING STORM DRAIN MANHOLE
 - OPRV --- EXISTING PRESSURE RELEASE VALVE/GAS
 - EXISTING STORM DRAIN INLET
 - OHE --- EXISTING OVERHEAD ELECTRIC
 - X --- EXISTING FENCE (CHAINLINK)
 - ⊕ --- EXISTING FIRE HYDRANT
 - OPP --- EXISTING POWER POLE
 - EB --- EXISTING ELECTRIC BOX
 - OWM --- EXISTING WATER METER
 - LP --- EXISTING LIGHT POLE
 - EXISTING CONCRETE
 - EXISTING WOODEN FENCE
 - EXISTING CHU WALL
 - 6" WL --- ABANDONED WATER LINE
 - 30" SD --- PROPOSED STORM DRAIN
 - --- PROPOSED STORM DRAIN MANHOLE
 - 6" W --- PROPOSED WATER LINE
 - PROPOSED GATE VALVE
 - PROPOSED TEE FITTING
 - PROPOSED STANDARD CURB & GUTTER

AS BUILT INFORMATION		BENCH MARKS		INFORMATION	
The station is located at the intersection of Edith and McKnight NE. The benchmark is a square, 4" x 4", chiseled on the top of the NW curb return. MSLD Elevation = 4986.02		DATE: 4/22/91 BY: [Signature]		NO. DATE: 4/22/91	
MICRO-FILM INFORMATION		DESIGNED BY: DL		DATE: 2-90	
DATE: 4/22/91		DRAWN BY: DL		DATE: 3-6-90	
CHECKED BY: DL		DATE: 3-6-90		REVISIONS	
CITY OF ALBUQUERQUE PUBLIC WORKS DEPARTMENT ENGINEERING GROUP		TITLE: ODELIA DAM OUTFALL EXTENSION		PAVING PLAN & PROFILE STA. 22+50 TO STA. 24+65.50	
APPROVALS	ENGINEER	DATE	APPROVALS	ENGINEER	DATE
D.R.C. Chairman	Paul T. Brasher	4/11/90	Water	R.W. Kane	3-21-90
Transportation	Paul T. Brasher	4-12-90	Wastewater	R.W. Kane	3-21-90
Hydrology	Paul T. Brasher	4-12-90			
DRAWING NO.	3601	MAP NO.	H-14815	SHEET	10 OF 12

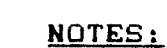

- | C of A PWD Maps & Records | | | | | | | | | | | |
|---------------------------|---|---|---|---|---|---|---|---|----|----|----|
| 1 | 2 | 3 | 4 | 5 | 6 | 7 | 8 | 9 | 10 | 11 | 12 |
| 1 | 2 | 3 | 4 | 5 | 6 | 7 | 8 | 9 | 10 | 11 | 12 |
| 1 | 2 | 3 | 4 | 5 | 6 | 7 | 8 | 9 | 10 | 11 | 12 |

Paul T. Brasher 4-22-91
Paul T. Brasher P.E. 7292 Date

CITY OF ALBUQUERQUE
PUBLIC WORKS DEPARTMENT
ENGINEERING GROUP

APPROVALS	ENGINEER	DATE	APPROVALS	ENGINEER	DATE
D.R.C. Chairman	<i>Roger J. Lane</i>	<i>5/11/90</i>	Water	<i>R.W. Kame</i>	<i>3-21-90</i>
Transportation	<i>W. J. Lane</i>	<i>4-19-90</i>	Wastewater	<i>R.W. Kame</i>	<i>3-21-90</i>
Hydrology	<i>W. J. Lane</i>	<i>4/19/90</i>			

DRAWING NO.	3601	MAP NO.	H14815	SHEET	11	OF	12
-------------	------	---------	--------	-------	----	----	----

NO INFORMATION
CONTRACTOR SWANANCE MECHANICAL
WORK STARTED BY P.O.A. DATE 10/90
INSPECTOR'S FIELD VERIFICATION BY ARCHULETA DATE 11/90
COMPLAINT OR DISCREPANCY OBSERVED BY EVERETT DATE 12/90
NO MICRO-FILM INFORMATION
RECORDED BY DATE

The station is located at the intersection of 56th and McKnight, NE at the Northwest quadrant of the intersection. The station mark is a square, ☒, chiseled on the top of the NNW curb return.

MSBD Elevation = 4966.62

FIELD NOTES	
NO	BY

1

1


IONS

1138

1


ENS

Kant

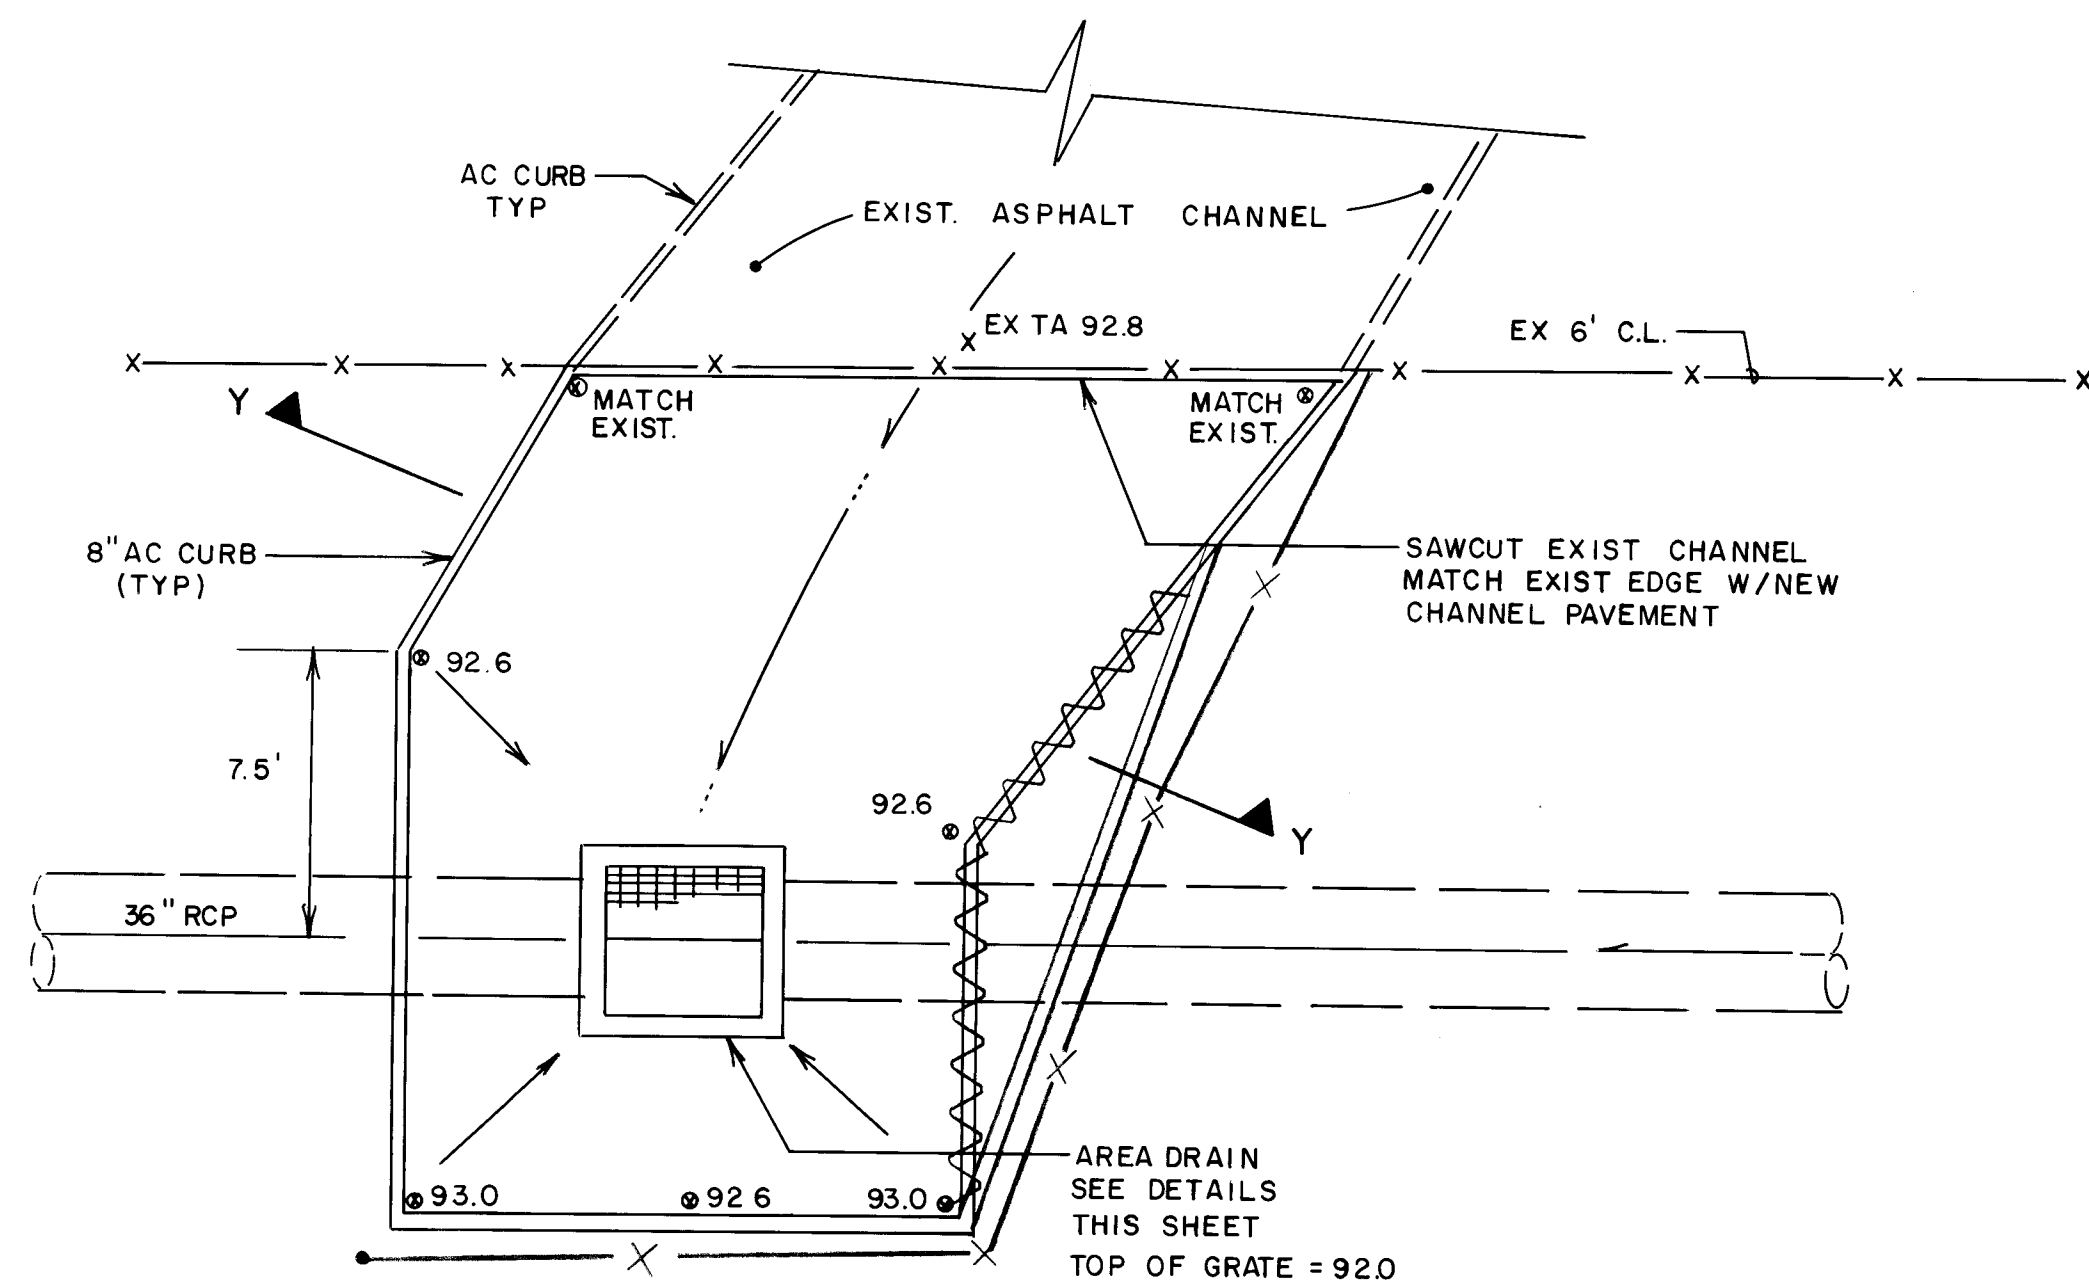


AREA DRAIN DETAIL (A/12)

1" = 5'

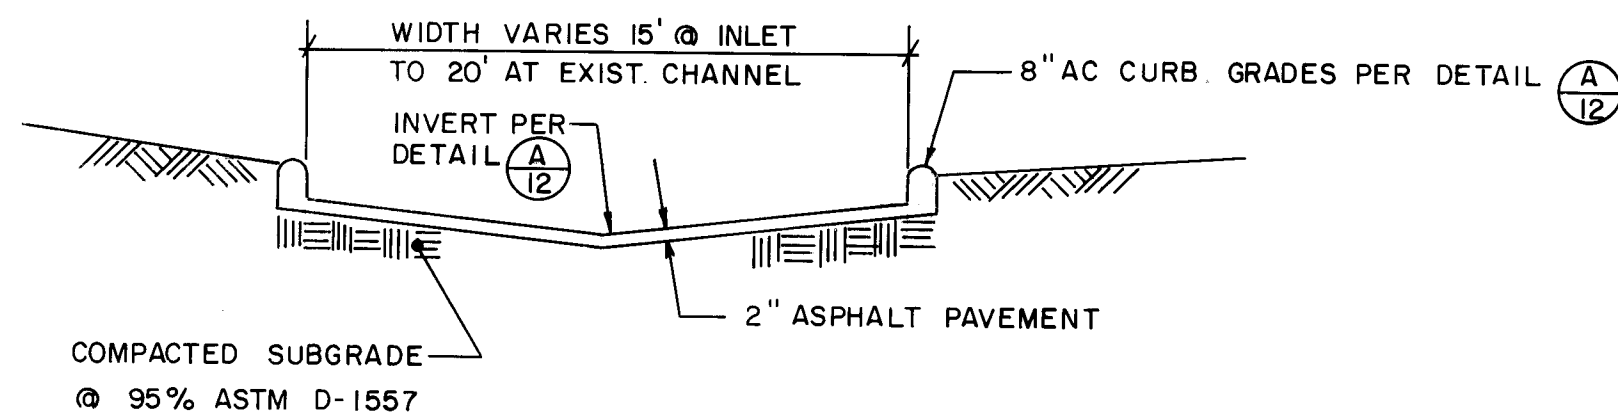


CHANNEL SECTION Y-Y

1" = 5'

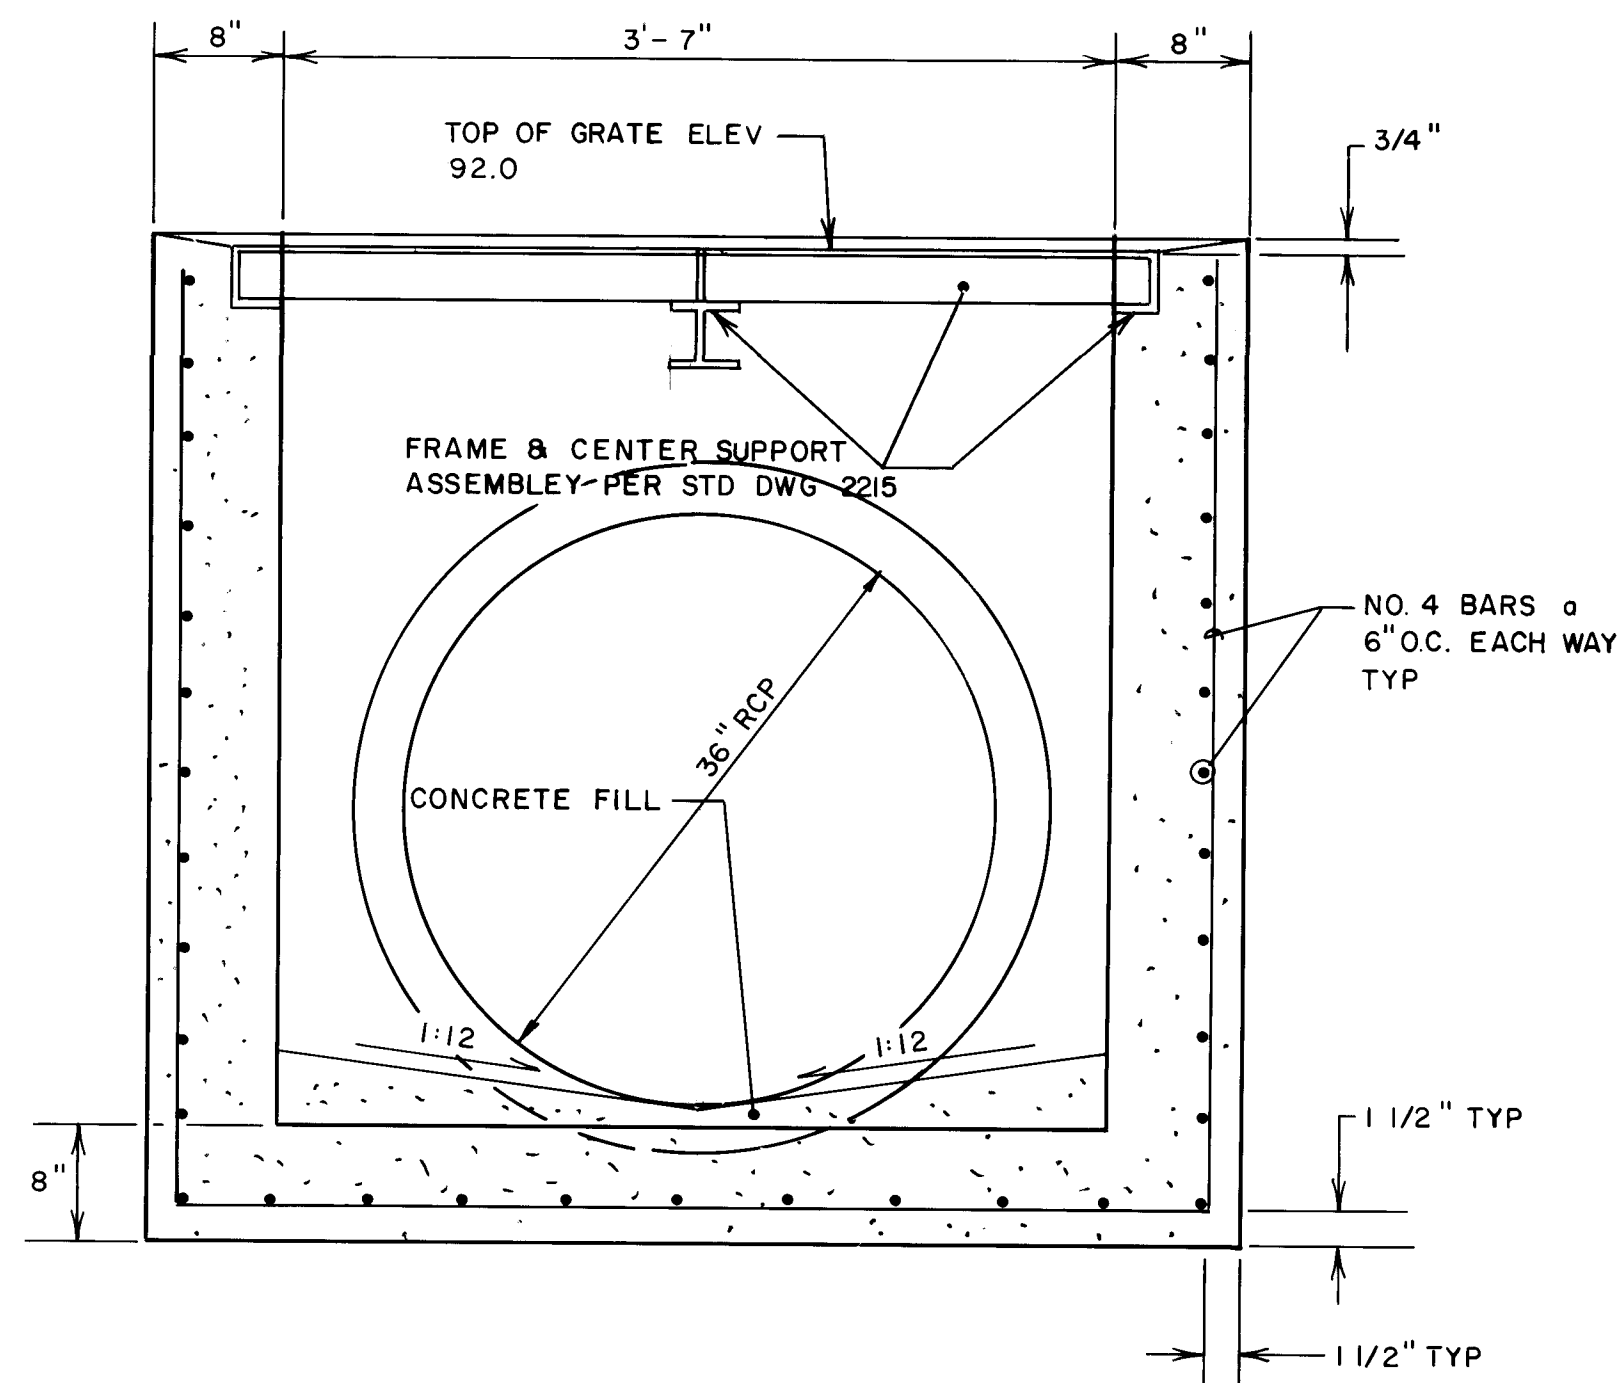


SECTION B-B

1" = 1'-0"

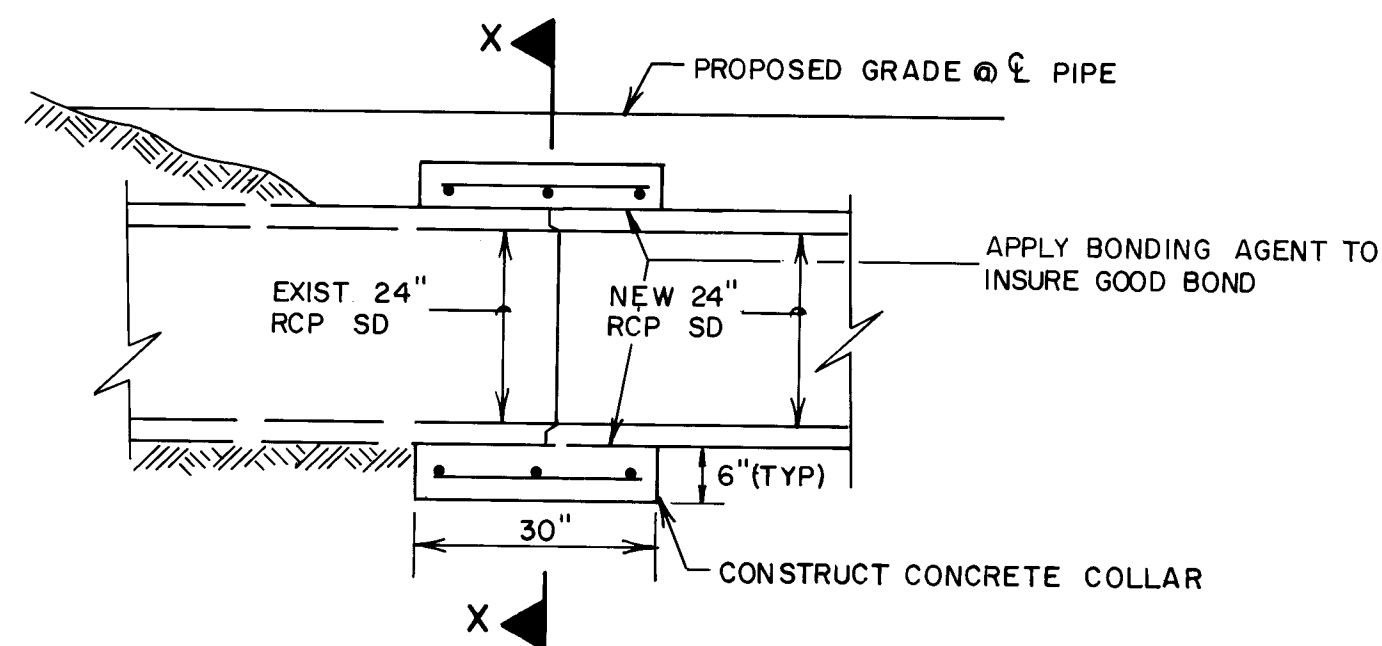

24" STORM DRAIN CONNECTION DETAIL (B/12)

1" = 2'

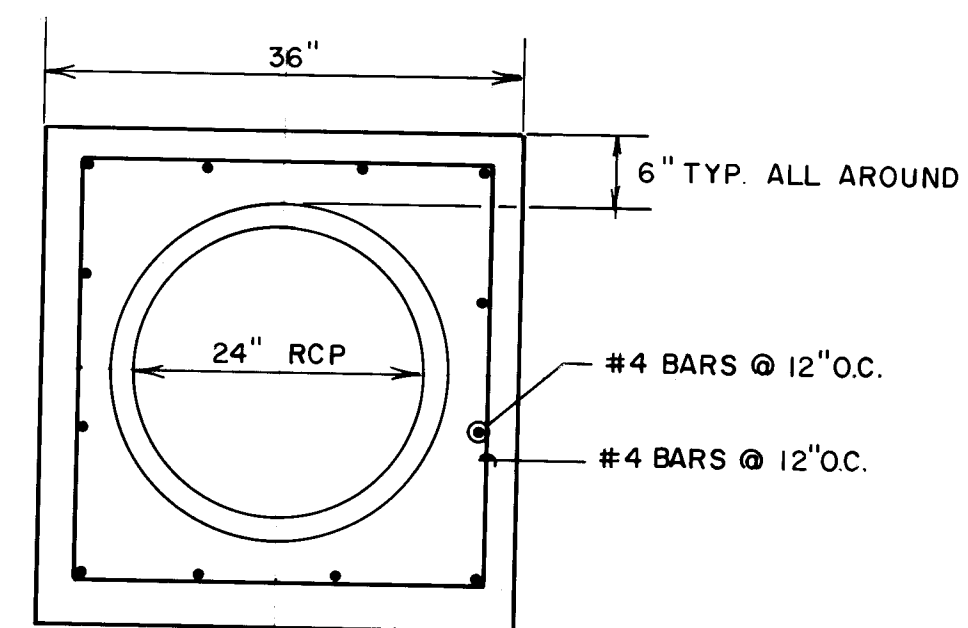


SECTION X-X

NTS

Record Drawing


This drawing as modified shows public improvements as constructed. These modifications have been made using information and measurements obtained by the City's field survey crew, the Contractor and City Inspector. The modifications conform to the minimum requirements for record drawings criteria as required by the City of Albuquerque per Development Process Manual Section 27.4 to the best of my knowledge and belief.

Paul T. Brasher I.S. 7282 Date 4.22.91

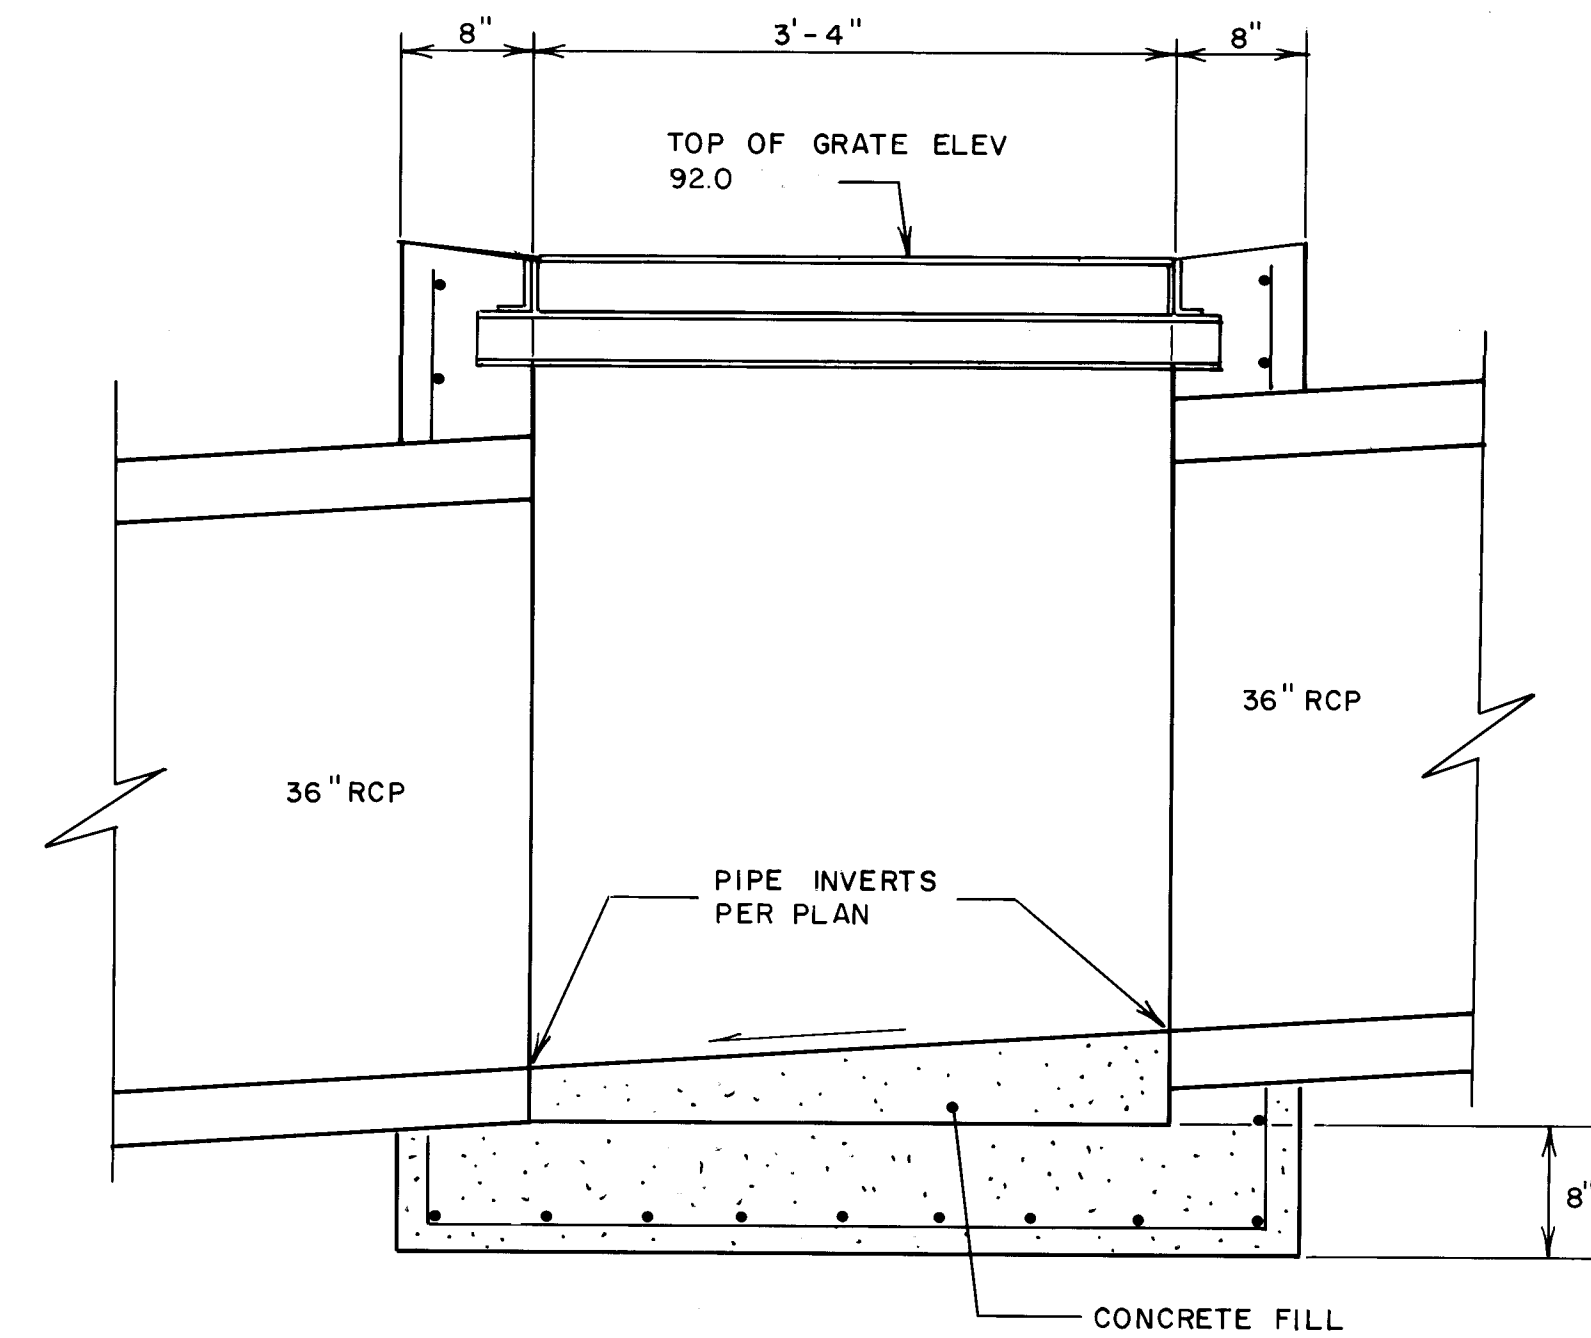


SECTION A-A

1" = 1'-0"

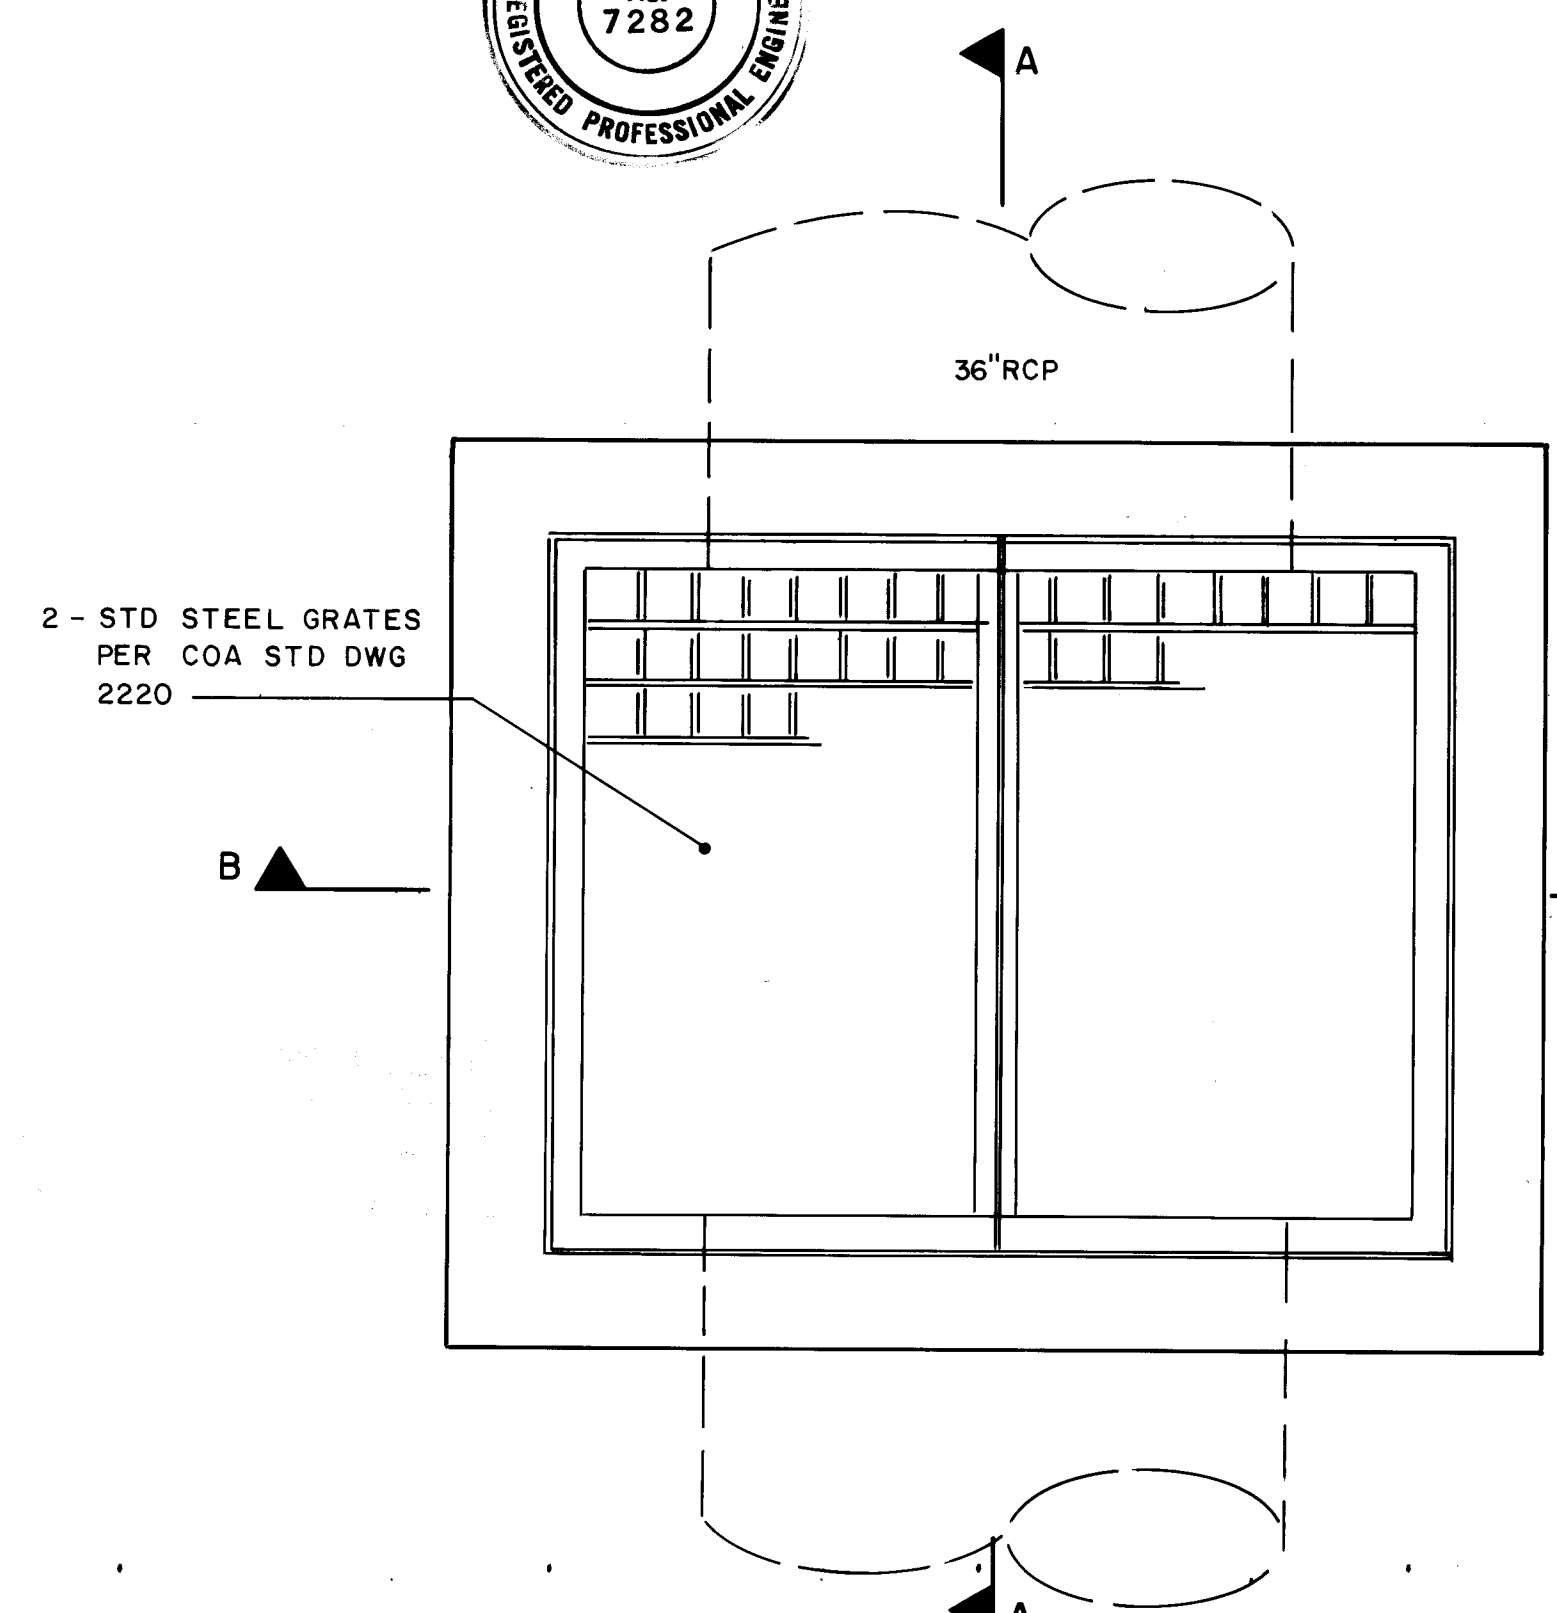

AREA DRAIN PLAN

1" = 1'-0"

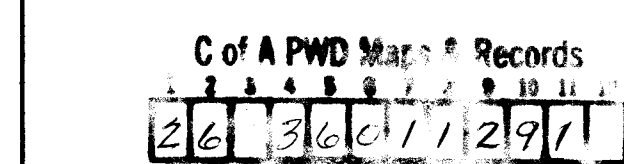

ESPEY, HUSTON & ASSOCIATES, INC.
Engineering & Environmental Consultants
317 COMMERCIAL ST. N.E.
ALBUQUERQUE, NEW MEXICO 87102
PHONE: (505) 242-1909

CITY OF ALBUQUERQUE
PUBLIC WORKS DEPARTMENT
ENGINEERING GROUP

TITLE **ODELIA DAM OUTFALL EXTENSION**

DETAILS					
APPROVALS	ENGINEER	DATE	APPROVA	ENGINEER	DATE
B.R.C. Chairman	R.W. Kane	5/11/90	Water	R.W. Kane	3-21-90
Transportation	R.W. Kane	1-19-90	Wastewater	R.W. Kane	3-21-90
Hydrology					

DRAWING NO. **3601** MAP NO. **H14&15** SHEET **12** OF **12**

AS BUILT INFORMATION
Source Manual
C.O.A.
DATE 10/90
DRAWN BY
CHECKED BY
MICRO FILM INFORMATION
DATE

BENCH MARKS
The station is located at the intersection of Edith and McKnight NE at the Northwest quadrant of the intersection. The station mark is a square, 4" x 4", chiseled on the top of the NIN curb return.
FIELD Elevation = 4966.82

SURVEY INFORMATION
FIELD NOTES
DATE
BY
NO

ENGINEER'S SEAL
PAUL T. BRASHER
REGISTERED PROFESSIONAL ENGINEER
No. 7282
NEW MEXICO

REVISIONS
NO. DATE
DESIGN
DATE
CHECKED BY
DATE