


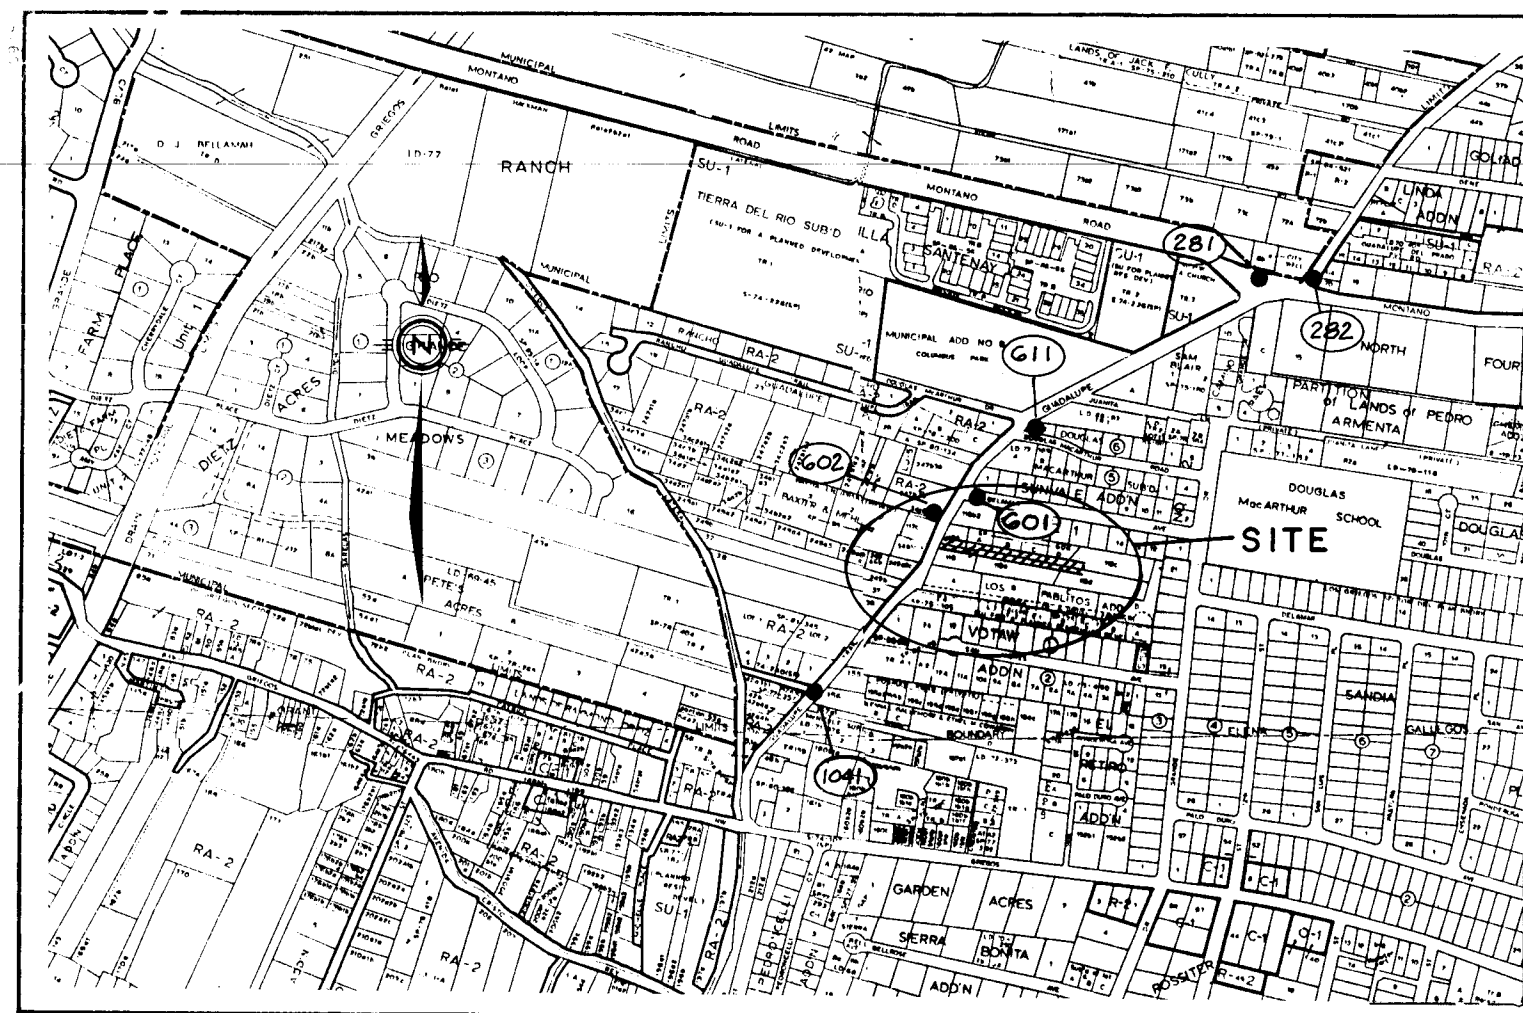

VICINITY MAP

LEGEND


APPROXIMATE LOCATION OF GATE VALVES TO BE SHUT DURING NON-PRESSURE CONNECTION.

TRAFFIC CONTROL NOTES

1. CONTRACTOR SHALL ADHERE TO SECTION 19 OF THE CITY OF ALBUQUERQUE STANDARD SPECIFICATIONS FOR CONSTRUCTION, 1986.
2. CONTRACTOR SHALL LIMIT OPERATION WITHIN ROADWAY TO THE HOURS SPECIFIED BY THE BARRICADING OR CONSTRUCTION COORDINATION ENGINEER AT 768-2552.


GENERAL NOTES:

1. ALL WORK DETAILED ON THESE PLANS TO BE PERFORMED UNDER CONTRACT SHALL, EXCEPT AS OTHERWISE STATED OR PROVIDED FROM HEREON, BE CONSTRUCTED IN ACCORDANCE WITH THE CITY OF ALBUQUERQUE STANDARD SPECIFICATIONS PUBLIC WORKS CONSTRUCTION, 1986.
2. TWO (2) WORKING DAYS PRIOR TO ANY EXCAVATION, CONTRACTOR MUST CONTACT LINE LOCATING SERVICE, 765-1234, FOR LOCATION OF EXISTING UTILITIES.
3. PRIOR TO CONSTRUCTION, THE CONTRACTOR SHALL EXCAVATE AND VERIFY THE HORIZONTAL AND VERTICAL LOCATIONS OF ALL OBSTRUCTIONS AND EXISTING PAVEMENT. SHOULD A CONFLICT EXIST, THE CONTRACTOR SHALL NOTIFY THE ENGINEER OR SURVEYOR SO THAT THE CONFLICT CAN BE RESOLVED WITH MINIMUM AMOUNT OF DELAY.
4. CONTRACTOR SHALL COORDINATE VALVE SHUT-OFFS WITH WATER SYSTEMS DIVISION (823-4200) TWO (2) WORKING DAYS PRIOR TO ANY WORK AFFECTING THE EXISTING PUBLIC WATER UTILITIES.

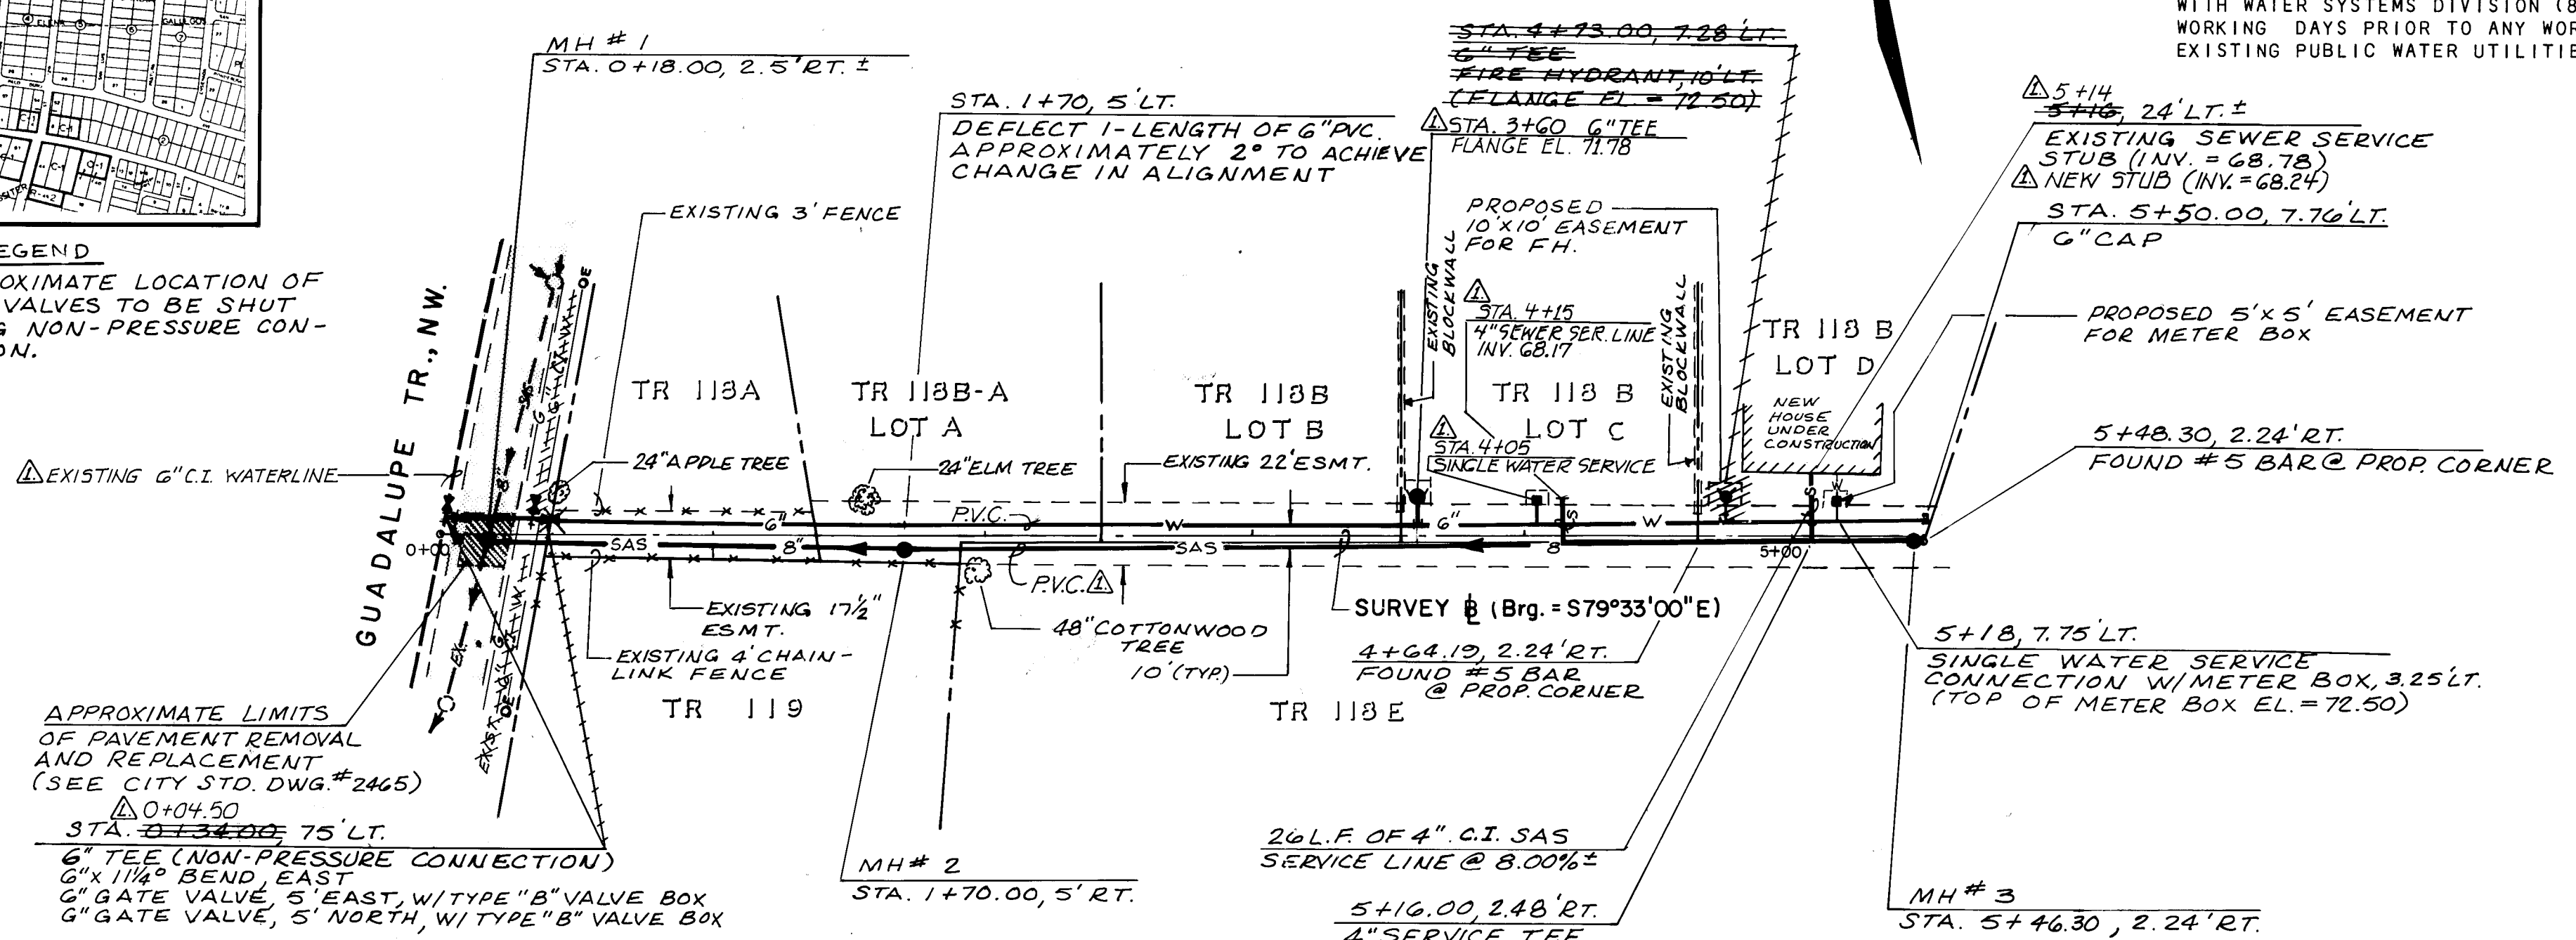

APPROXIMATE LIMITS OF PAVEMENT REMOVAL AND REPLACEMENT (SEE CITY STD. DWG #2465)

STA. 0+04.50
STA. 0+13.00, 75' LT.
6" TEE (NON-PRESSURE CONNECTION)
6" x 1 1/4" BEND, EAST
6" GATE VALVE, S. EAST, W/ TYPE "B" VALVE BOX
6" GATE VALVE, S. NORTH, W/ TYPE "B" VALVE BOX

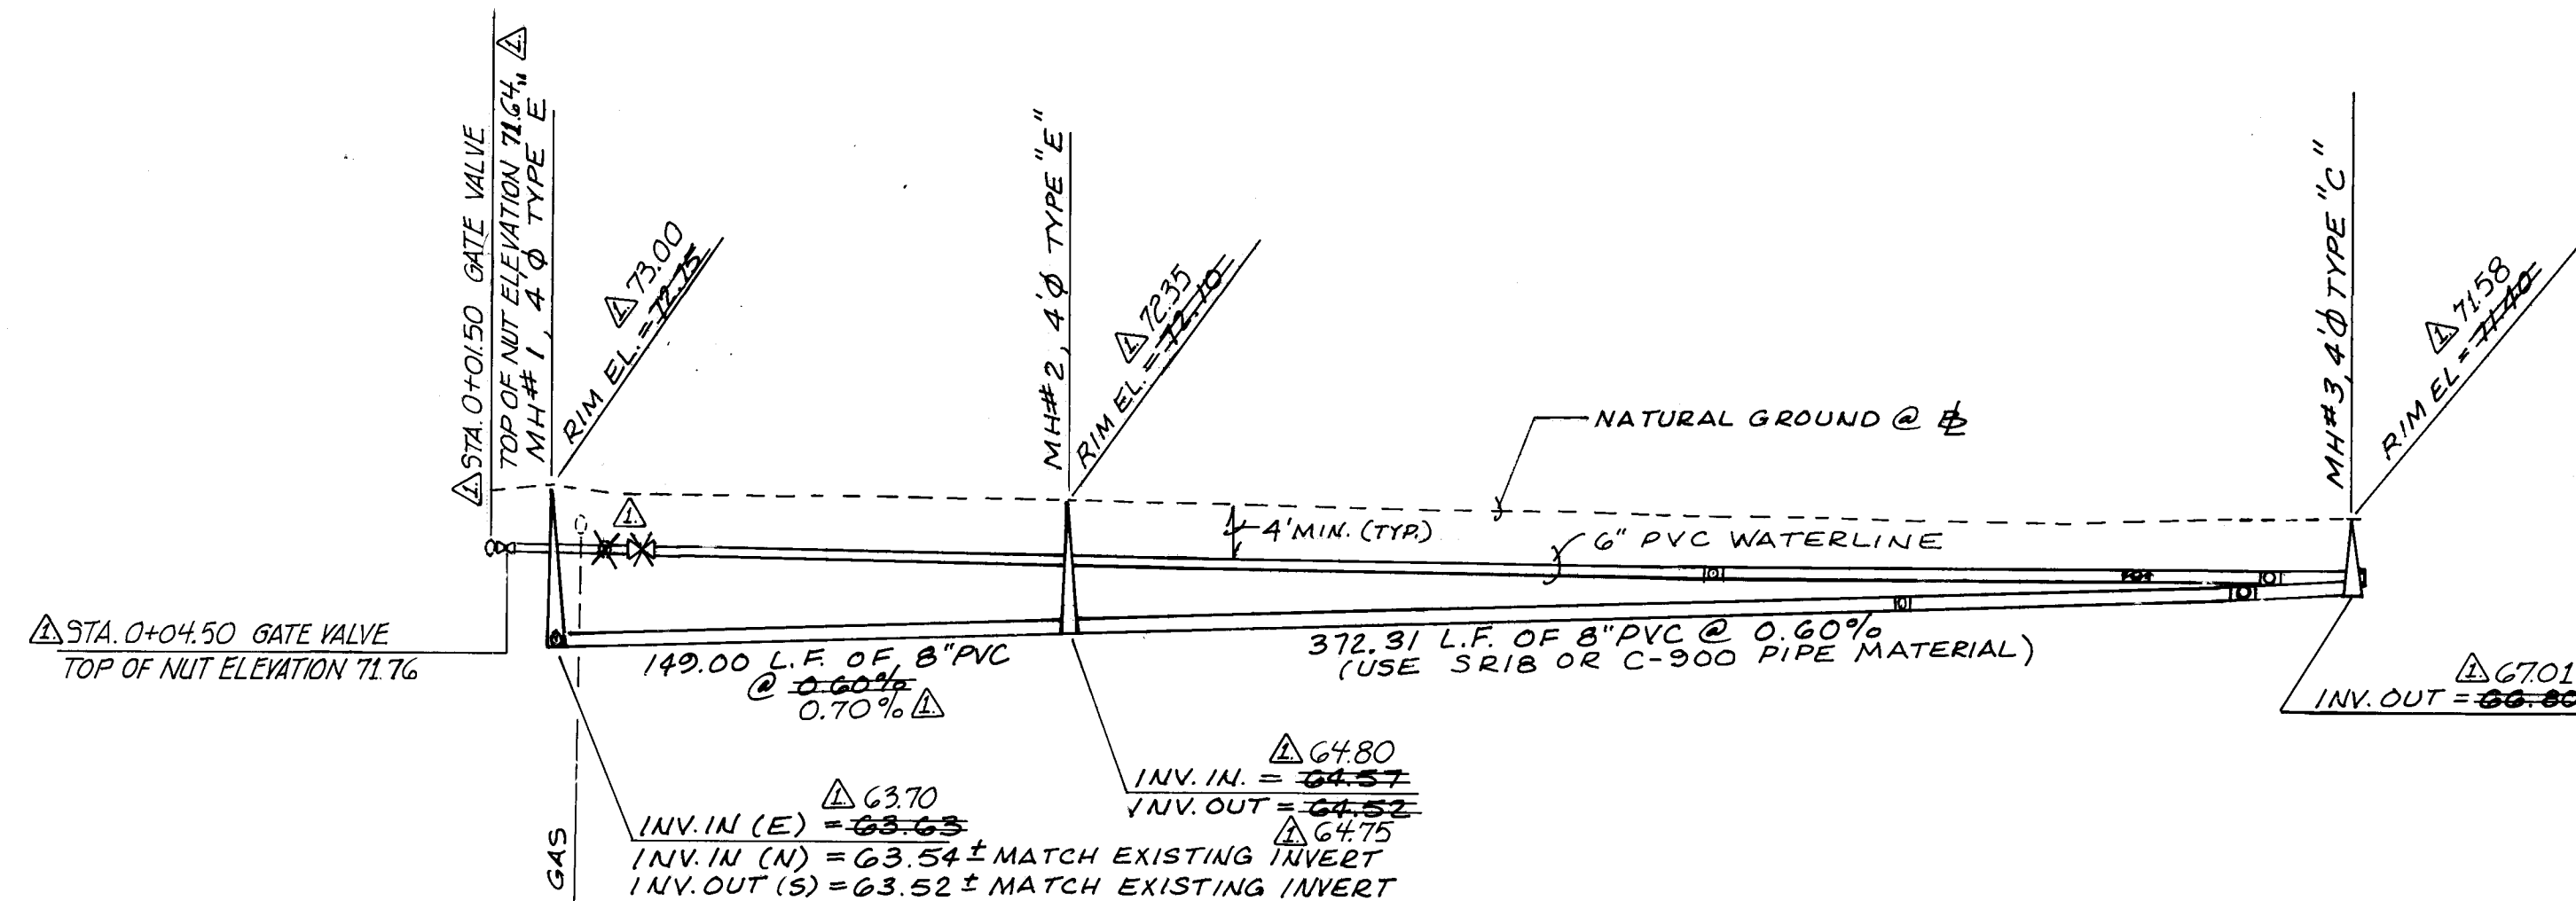

APPROVAL OF AS BUILT DRAWINGS
CHIEF CONSTRUCTION ENGINEER
DATE 11/18/88

26 36 40 01 18 9

SCALE:
1" = 50' HOR.
1" = 10' VER.

CITY OF ALBUQUERQUE
PUBLIC WORKS DEPARTMENT
ENGINEERING GROUP

TITLE
WATER AND SEWER MAIN EXTENSION
FOR TRACT 118B, ORVILLE PADILLA REPLAT

APPROVAL	DATE	APPROVAL	DATE
DRC Chief	11/18/88	ENGINEER	
Trans. Div.			
Utility Div.	11/18/88		

DRAWING NO. 3640
MAP NO. F-14
SHEET 1 OF 1

AS BUILT INFORMATION
NORTH BONNET BOLT OF FIRE HYDRANT @ NORTHWEST CORNER OF BAYITA LANE AND GUADALUPE TRAIL. (ELEV. = 4975.57)

SURVEY INFORMATION
FILED NOTES
NO. BY DATE

ENGINEER'S SEAL
MICHAEL J. YOST
8668
PROFESSIONAL ENGINEER
11/17/88

Revised from as-built information
REMARKS
DESIGN
DATE 9-27-88
DATE 9-27-88
DATE 10-17-88