


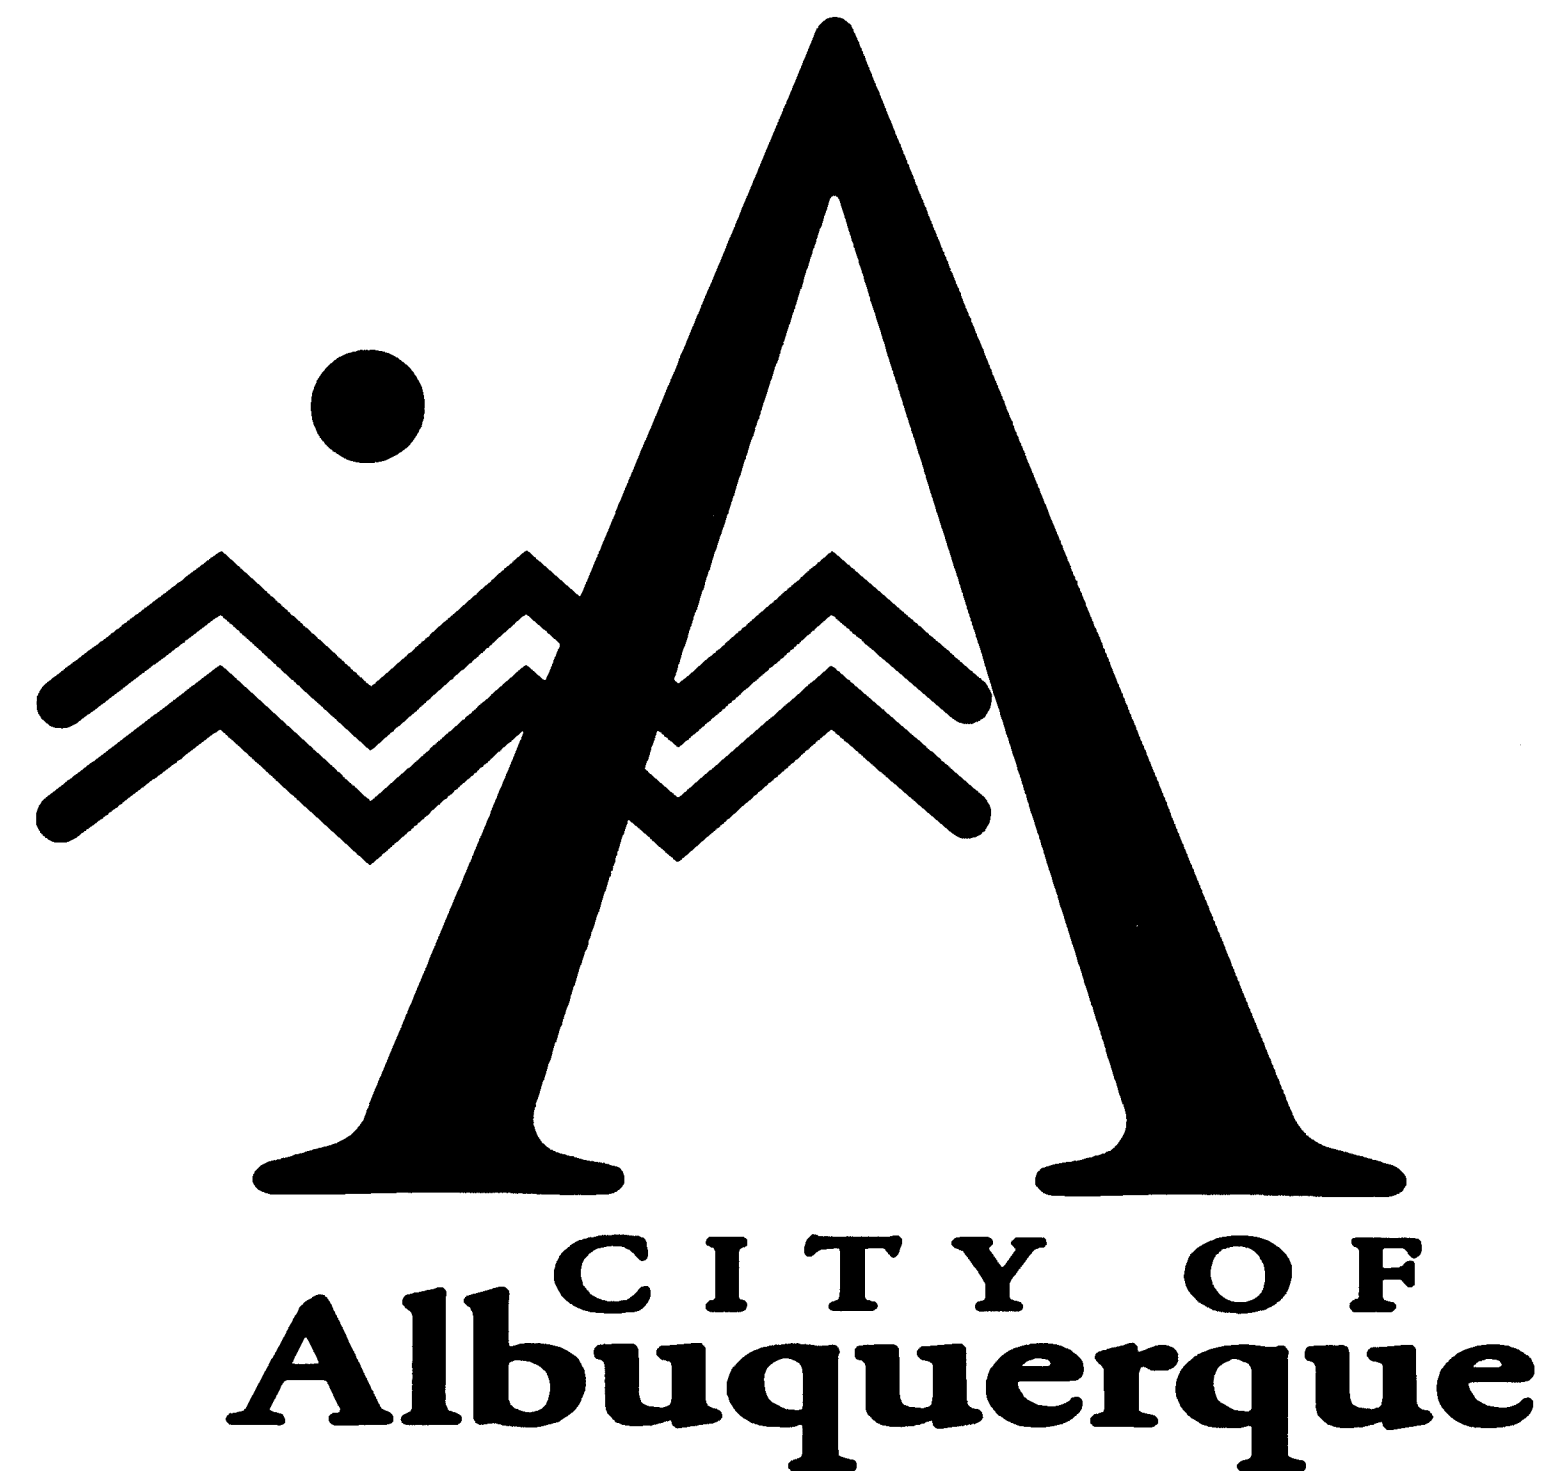


SUPER 8 MOTEL INFRASTRUCTURE IMPROVEMENTS

SANITARY SEWER EXTENSION


TO SERVE TRACT 261-A,
TOWN OF ATRISCO GRANT, AIRPORT UNIT

INDEX OF DRAWINGS

SHEET	TITLE
1	TITLE SHEET, INDEX, GENERAL NOTES, LEGEND, AND ABBREVIATIONS
2	HANOVER ROAD SANITARY SEWER

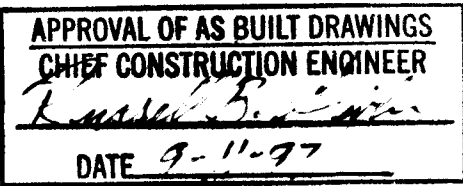

DRB 89-424

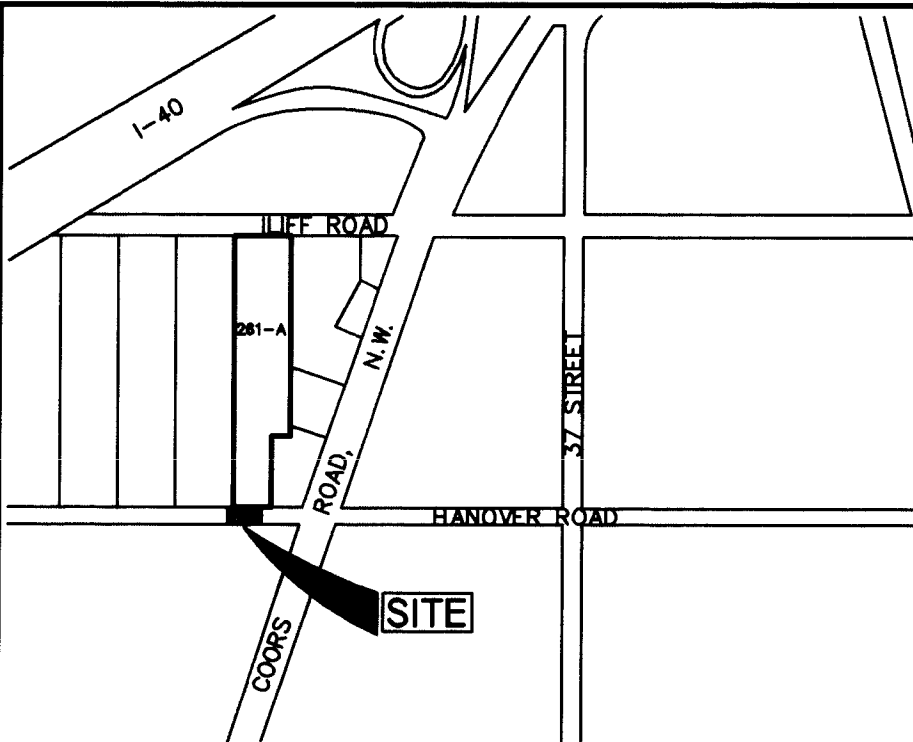

VICINITY MAP

GENERAL NOTES


1. AN EXCAVATION/CONSTRUCTION PERMIT WILL BE REQUIRED BEFC BEGINNING ANY WORK WITHIN CITY RIGHT-OF-WAY.
2. ALL WORK DETAILED ON THESE PLANS TO BE PERFORMED, EXCE OTHERWISE STATED OR PROVIDED HEREON, SHALL BE CONSTRUCTI ACCORDANCE WITH CITY OF ALBUQUERQUE STANDARD SPECIFIC/ FOR PUBLIC WORKS CONSTRUCTION, 1986 EDITION AS REVISED THROUGH UPDATE #6.
3. TWO WORKING DAYS PRIOR TO ANY EXCAVATION, CONTRACTOR I CONTACT LINE LOCATING SERVICE, (260-1990) FOR LOCATION C EXISTING UTILITIES.
4. PRIOR TO CONSTRUCTION, THE CONTRACTOR SHALL EXCAVATE / VERIFY THE HORIZONTAL AND VERTICAL LOCATIONS OF ALL PER EXISTING UTILITIES. SHOULD A CONFLICT EXIST, THE CONTRACTI SHALL NOTIFY THE ENGINEER SO THAT THE CONFLICT CAN BE F WITH A MINIMUM AMOUNT OF DELAY.
5. THREE WORKING DAYS PRIOR TO BEGINNING CONSTRUCTION THE CONTRACTOR SHALL SUBMIT TO THE CONSTRUCTION COORDINATI DIVISION A DETAILED CONSTRUCTION SCHEDULE. TWO WORKING PRIOR TO CONSTRUCTION, THE CONTRACTOR SHALL OBTAIN A BARRICADING PERMIT FROM THE CONSTRUCTION COORDINATION DIVISION. CONTRACTOR SHALL NOTIFY BARRICADE ENGINEER (765-2551) PRIOR TO OCCUPYING PUBLIC RIGHT-OF-WAY. SEE SECTION 19 OF THE SPECIFICATIONS.
6. ALL STREET STRIPING ALTERED OR DESTROYED SHALL BE REPLA PLASTIC REFLECTORIZED PAVEMENT MARKINGS BY CONTRACTOR LOCATION AS EXISTING, OR AS INDICATED BY THIS PLAN SET.
7. CONTRACTOR SHALL COORDINATE WITH WATER SYSTEMS DIVISION FIVE WORKING DAYS IN ADVANCE OF ANY WORK THAT MAY AFPE PUBLIC WATER OR SEWER UTILITIES. EXISTING VALVES TO BE OPE PERSONNEL ONLY. CONTRACTOR SHALL CONTACT THE WATER SY
8. CONTRACTOR SHALL RECORD DATA ON ALL UTILITY LINES AND / AS REQUIRED BY THE CITY OF ALBUQUERQUE FOR THE PREPARA CONSTRUCTED" DRAWINGS. CONTRACTOR SHALL NOT COVER UTIL AND ACCESSORIES UNTIL ALL DATA HAS BEEN RECORDED.
9. CONTRACTOR SHALL NOTIFY THE ENGINEER NOT LESS THAN SEV PRIOR TO STARTING WORK IN ORDER THAT THE CITY SURVEYOR NECESSARY MEASURES TO INSURE THE PRESERVATION OF SURVEY CONTRACTOR SHALL NOT DISTURB PERMANENT SURVEY MONUME/ THE CONSENT OF THE CITY SURVEYOR AND SHALL NOTIFY THE C AND BEAR THE EXPENSE OF REPLACING ANY THAT MAY BE DIST
10. ANY WORK AFFECTING AN ARTERIAL ROADWAY REQUIRES TWENTY HOUR CONSTRUCTION.

LEGEND

DESCRIPTION	EXISTING
SANITARY SEWER	— SAS —
STORM DRAIN	— SD —
WATER LINE	— W —
CURB & GUTTER	=====
PROPERTY LINE	-----


ABBREVIATIONS

LF = LINEAR FEET	STA = STATION
L = LEFT	RAD. = RADIUS
R = RIGHT	TYP. = TYPICAL
TC = TOP OF CURB	PC = POINT OF
FL = FLOWLINE	PT = POINT OF
EXIST = EXISTING	TA = TOP OF

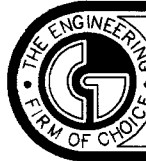



CHAVEZ • GRIEVE
CONSULTING ENGINEERS, INC.

5639 JEFFERSON STREET N.E. • ALBUQUERQUE, NEW MEXICO 871
PHONE (505) 344-4080 • FAX (505) 343-8759

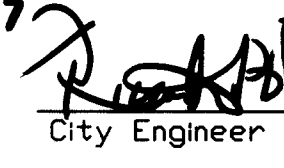REV.	SHEETS	CITY ENGINEER	DATE	USER DEPARTMENT	DATE	USER DEPARTM			
ENGINEER'S STAMP & SIGNATURE			APPROVALS	ENGINEER	DATE	*****	APPROVED FOR C		
			DRC Chairman	<i>Silly & Co.</i>	3-13-97	 City Engineer			
			Transportation		2-4-97				
			Water/Wastewater	<i>R.W. Kane</i>	2-31-97				
			Hydrology	<i>NA</i>	2-11-97				
			Parks						
			Constr. Mngmt.						
City Project No.					Sheet				
394181					1				

26-3941-81 0197


REV: 01-16-97 (BT)

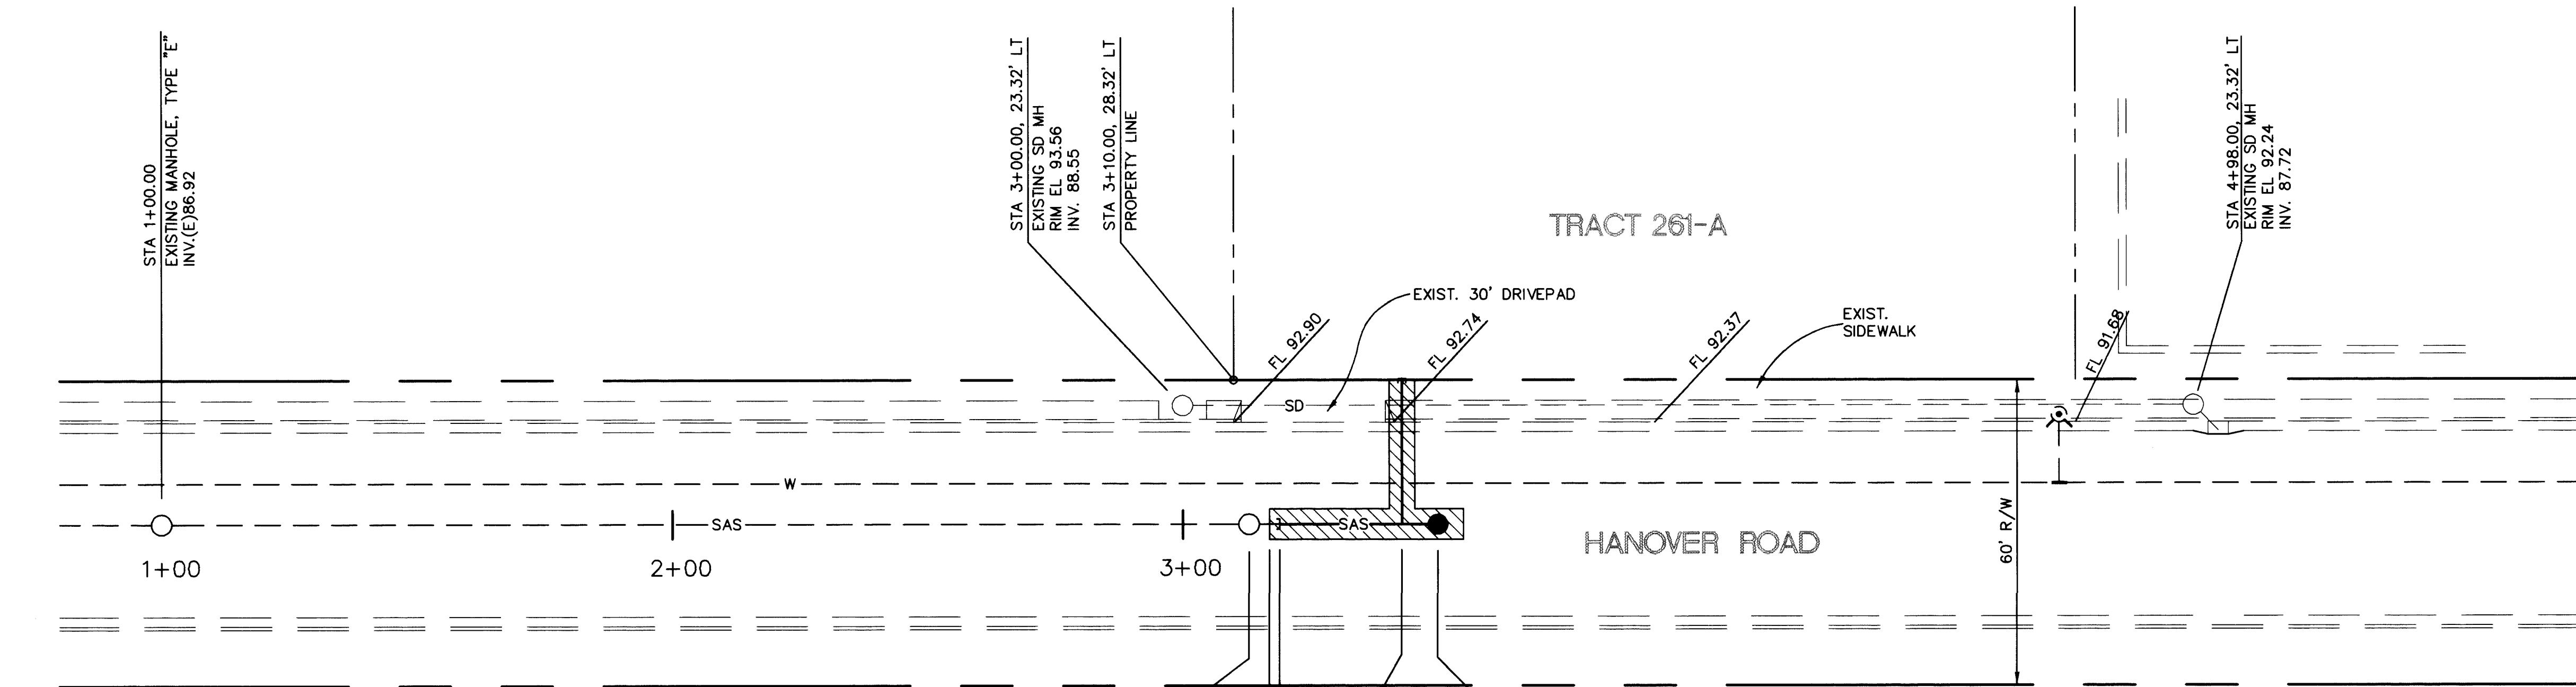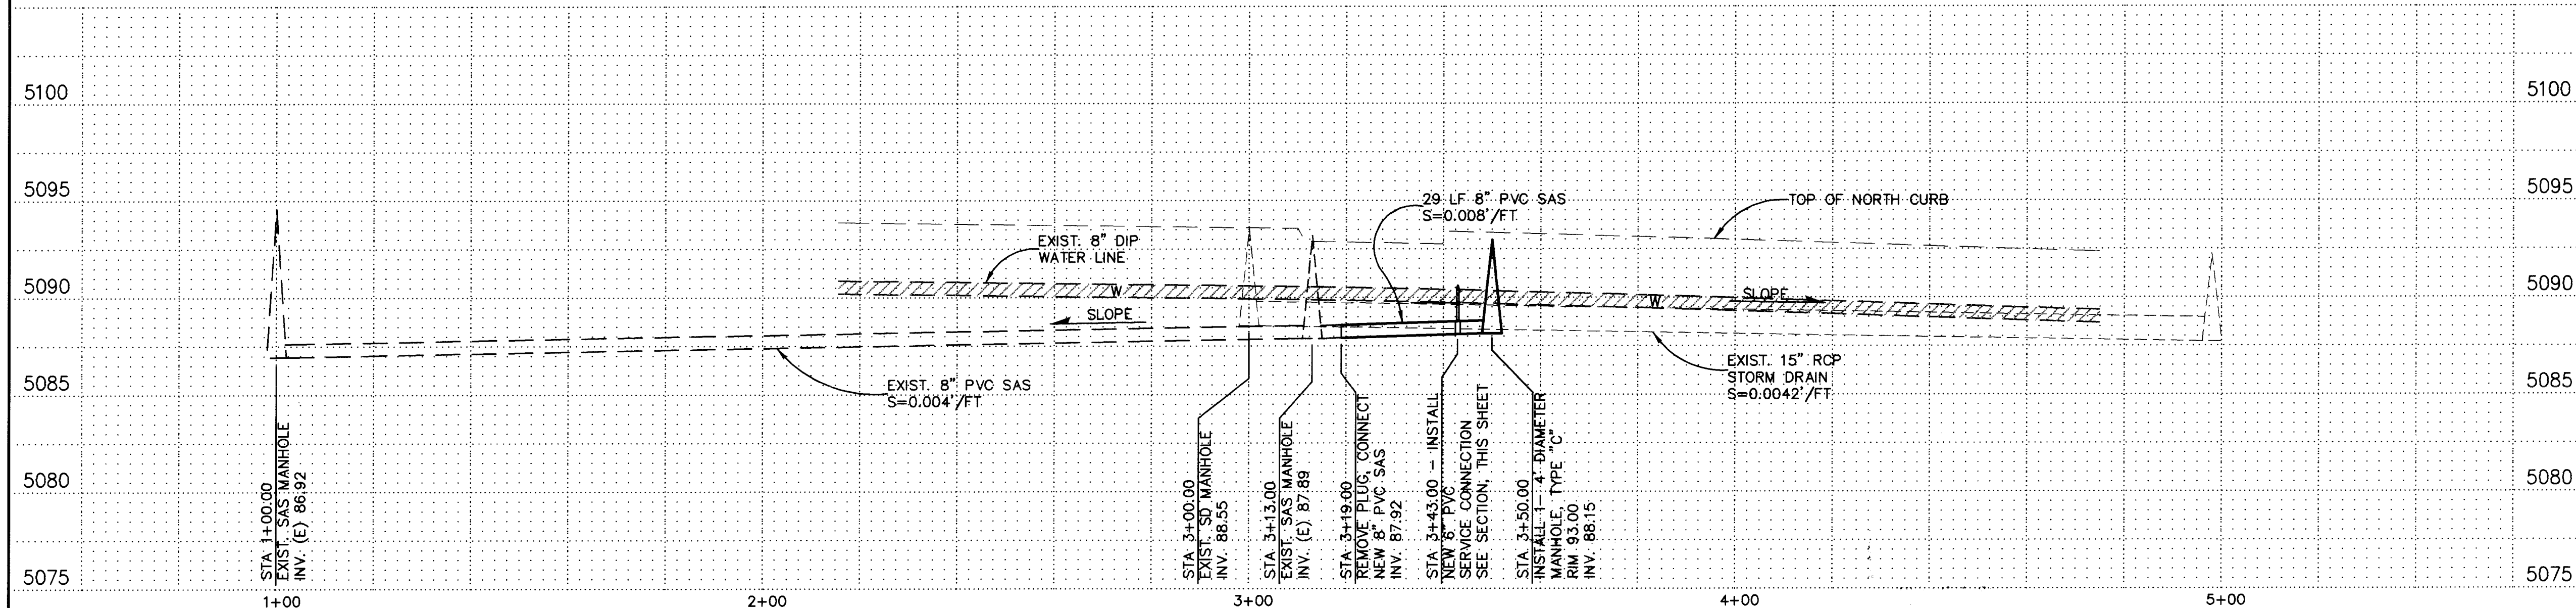

SECTION @ STA 3+43.00
SCALE HORIZ: 1"=10'
VERT: 1"=5'

THE 8" SANITARY SEWER EXTENSION, MANHOLE, AND 6" SERVICE LINE HAVE BEEN INSTALLED AS INDICATED ON THIS SHEET.

Joe P. Kelley
JOE P. KELLEY
9/8/97
DATE

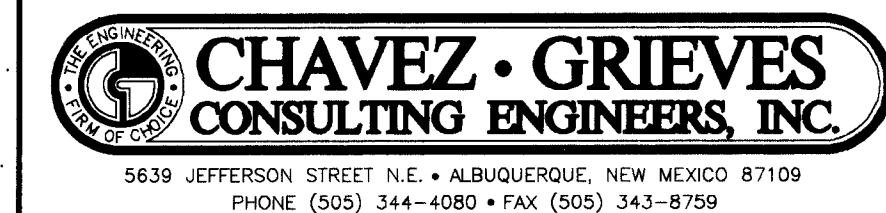

CITY OF ALBUQUERQUE PUBLIC WORKS DEPARTMENT ENGINEERING DEVELOPMENT GROUP	
TITLE: SUPER 8 MOTEL HANOVER ROAD SANITARY SEWER	
Design Review Committee APPROVED DATE: 13 1997	City Engineer Approval Last Design Update
City Project No. 394181	Zone Map No. J-11
Sheet 2	Of 2

ENGINEER'S SEAL		SURVEY INFORMATION		BENCH MARKS		AS BUILT INFORMATION	
NO. DATE		FIELD NOTES		EDIT OR ERASE THIS TEXT		CONTRACTOR J. R. HALE CONTR. CO. INC.	
REMARKS		BY		EDIT OR ERASE THIS TEXT		INSPECTOR'S	
DESIGN		DATE		EDIT OR ERASE THIS TEXT		STANDARD BY CHAVEZ-GRIEVES DATE 7/97	
DRAWN BY J. P. KELLEY		DATE 01/14/97		EDIT OR ERASE THIS TEXT		FIELD	
CHECKED BY W. M. TOWERS		DATE 01/15/97		EDIT OR ERASE THIS TEXT		VERIFICATION BY CHAVEZ-GRIEVES DATE 8/97	
				EDIT OR ERASE THIS TEXT		CORRECTED BY CHAVEZ-GRIEVES DATE 9/97	
				EDIT OR ERASE THIS TEXT		MICRO-FILM INFORMATION	
				EDIT OR ERASE THIS TEXT		RECORDED BY	
				EDIT OR ERASE THIS TEXT		NO.	

NOTE

EXISTING PUBLIC IMPROVEMENTS WHICH ARE DAMAGED OR DISPLACED BY THE CONTRACTOR SHALL BE REMOVED AND REPLACED BY THE CONTRACTOR, PER COA STANDARDS, AT THE CONTRACTOR'S OWN EXPENSE.

26-394181-0207