


2408

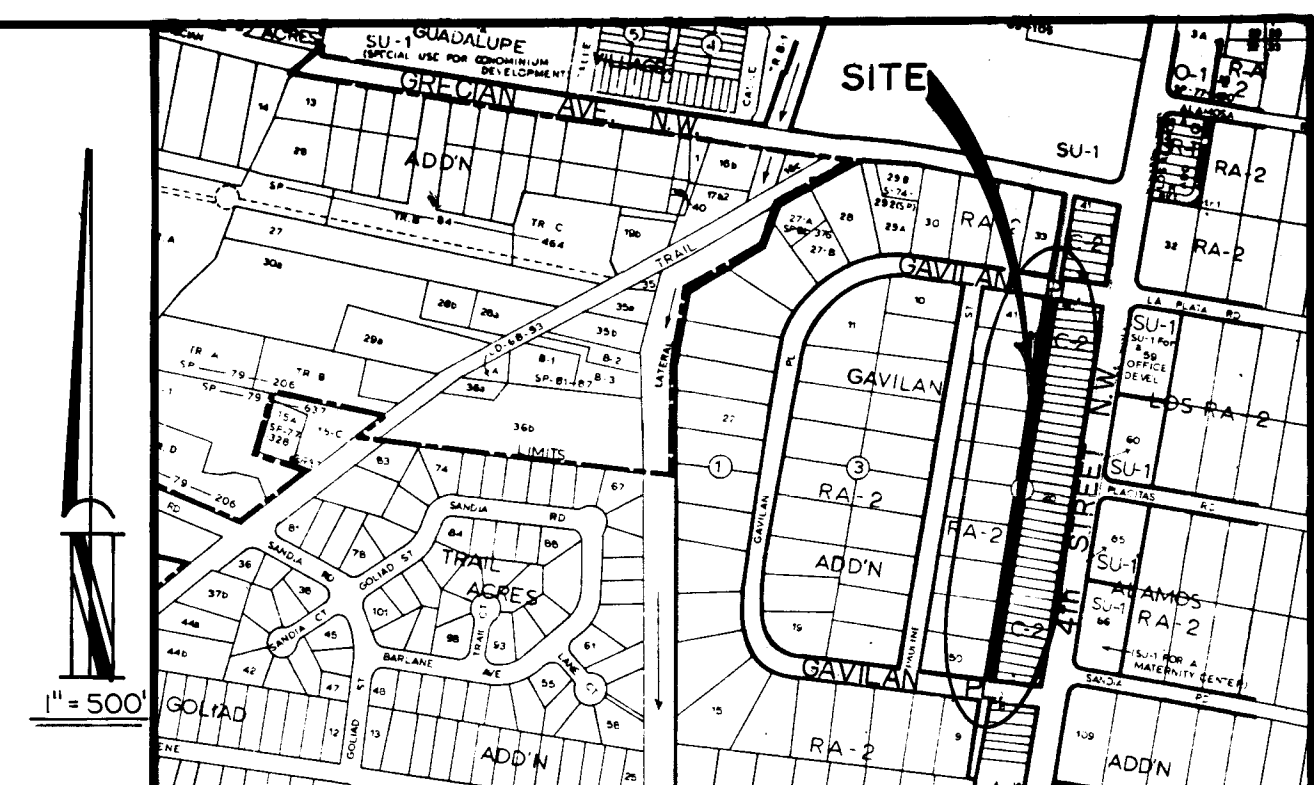

VICINITY MAP
ZONE ATLAS N^o F-14

ALLEY GRADES
BETWEEN LOTS 1-33 & 43-50 FUTURE
BETWEEN LOTS 34-40 & 41-42 THIS PROJECT
BLOCK 2
GAVILAN ADDITION
ALBUQUERQUE, NEW MEXICO

INDEX

<u>SHEET NO.</u>	<u>DESCRIPTION</u>
1	TITLE
2-6	16' ALLEY PLAN & PROFILE

APPROVAL OF AS BUILT DRAWINGS
CHIEF CONSTRUCTION ENGINEER
DATE: 11/10/92

26 3646 01 92




LG LOGAN/GROSS & ASSOC., INC.
Consulting Civil Engineers
925 6th Street N.W., Suite 3
Albuquerque, N. Mex. 87102
(505) 243-6353

APPROVED FOR
CONSTRUCTION
John H. H. H.
11/10/92 C.E.

3646

SHEET 1 OF 6

2408

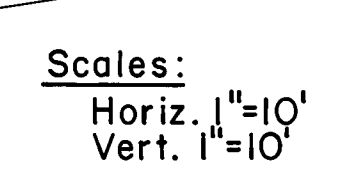

- ### NOTES
1. TWO (2) working days prior to any excavation, contractor must contact Line Locating Service at 765-1234.
 2. All items shall be constructed in accordance with City of Albuquerque Standard Specifications for Public Works Construction, 1986. (Amendments 1, 2 & 3)
 3. Contractor shall conform to the City of Albuquerque Standard Dvgs. 2495, 2511 & 2415.
 4. Contractor shall obtain Barricading Permit from City of Albuquerque and submit a Traffic Control Plan Three (3) days in advance of starting construction.
 5. Contractor shall adhere to Section 19 of The City of Albuquerque Standard Specifications for Public Works, 1986. (Amendments 1, 2 & 3)
 6. Contractor must allow one lane open on Gavilan Place N. W. open during construction.
 7. Contractor shall be responsible for the coordination with the Water Systems Division. This coordination must be done not less than two (2) working days in advance of any work that may affect the existing water utilities.


CITY OF ALBUQUERQUE
PUBLIC WORKS DEPARTMENT
ENGINEERING DIVISION

APPROVAL	DATE	TIME
APPROVED	10/26/88	11:26
TRANS. DIV.		
COMPL. DIV.	10/26/88	11:26
Hydro. Div.	10/26/88	11:26


4	SHEET	2	OF	6	ROUTE DEPARTMENT GROUP	NO. DATE.	REMARKS REVISIONS	BY		ENGINEER'S SEAL	SURVEY INFORMATION FIELD NOTES	BENCH MARKS BENCHMARK "3-F14" Located at the Intersection of 4th & Placitas N.W. in the Southwest Quadrant of the Intersection. Mark with a Square Chiseled on top of the SSE Curb Return. Elevation = 4974.768	AS BUILT INFORMATION
						NO. DATE.	REMARKS REVISIONS	BY	NO. DATE.	BENCHMARK "3-F14" Located at the Intersection of 4th & Placitas N.W. in the Southwest Quadrant of the Intersection. Mark with a Square Chiseled on top of the SSE Curb Return. Elevation = 4974.768	AS BUILT INFORMATION		

FUTURE

Scales:
 Horiz. 1"=10'
 Vert. 1"=10'

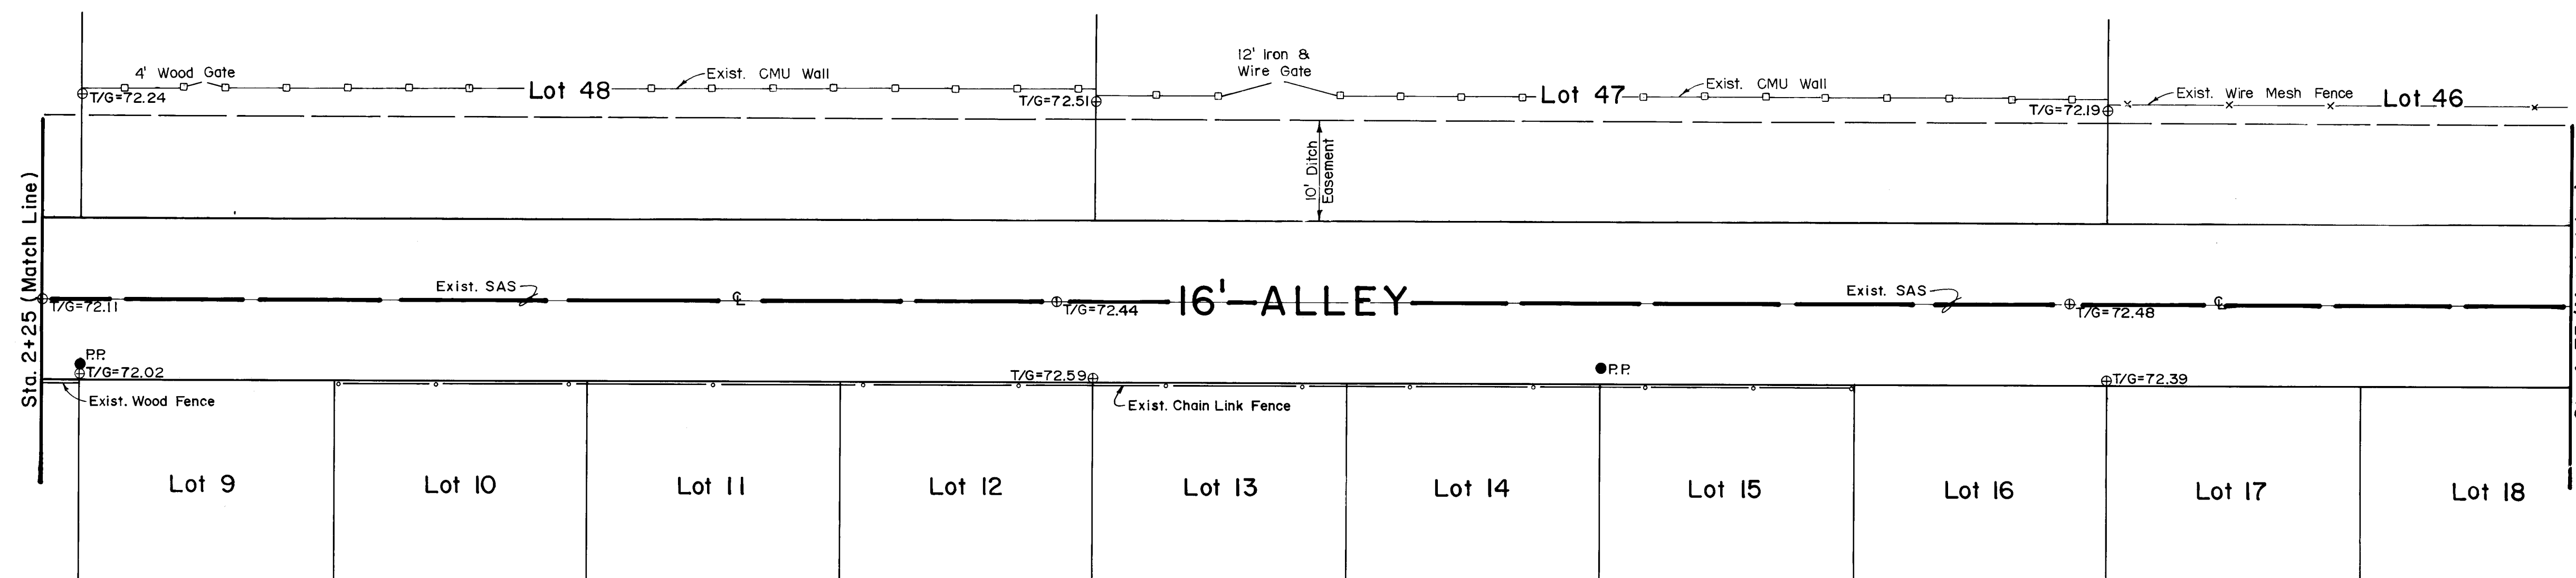


Existing spot elevations
Proposed spot elevations
Top of ground
Top of pavement
Top of concrete
Top of curb
Flowline Gutter or swale

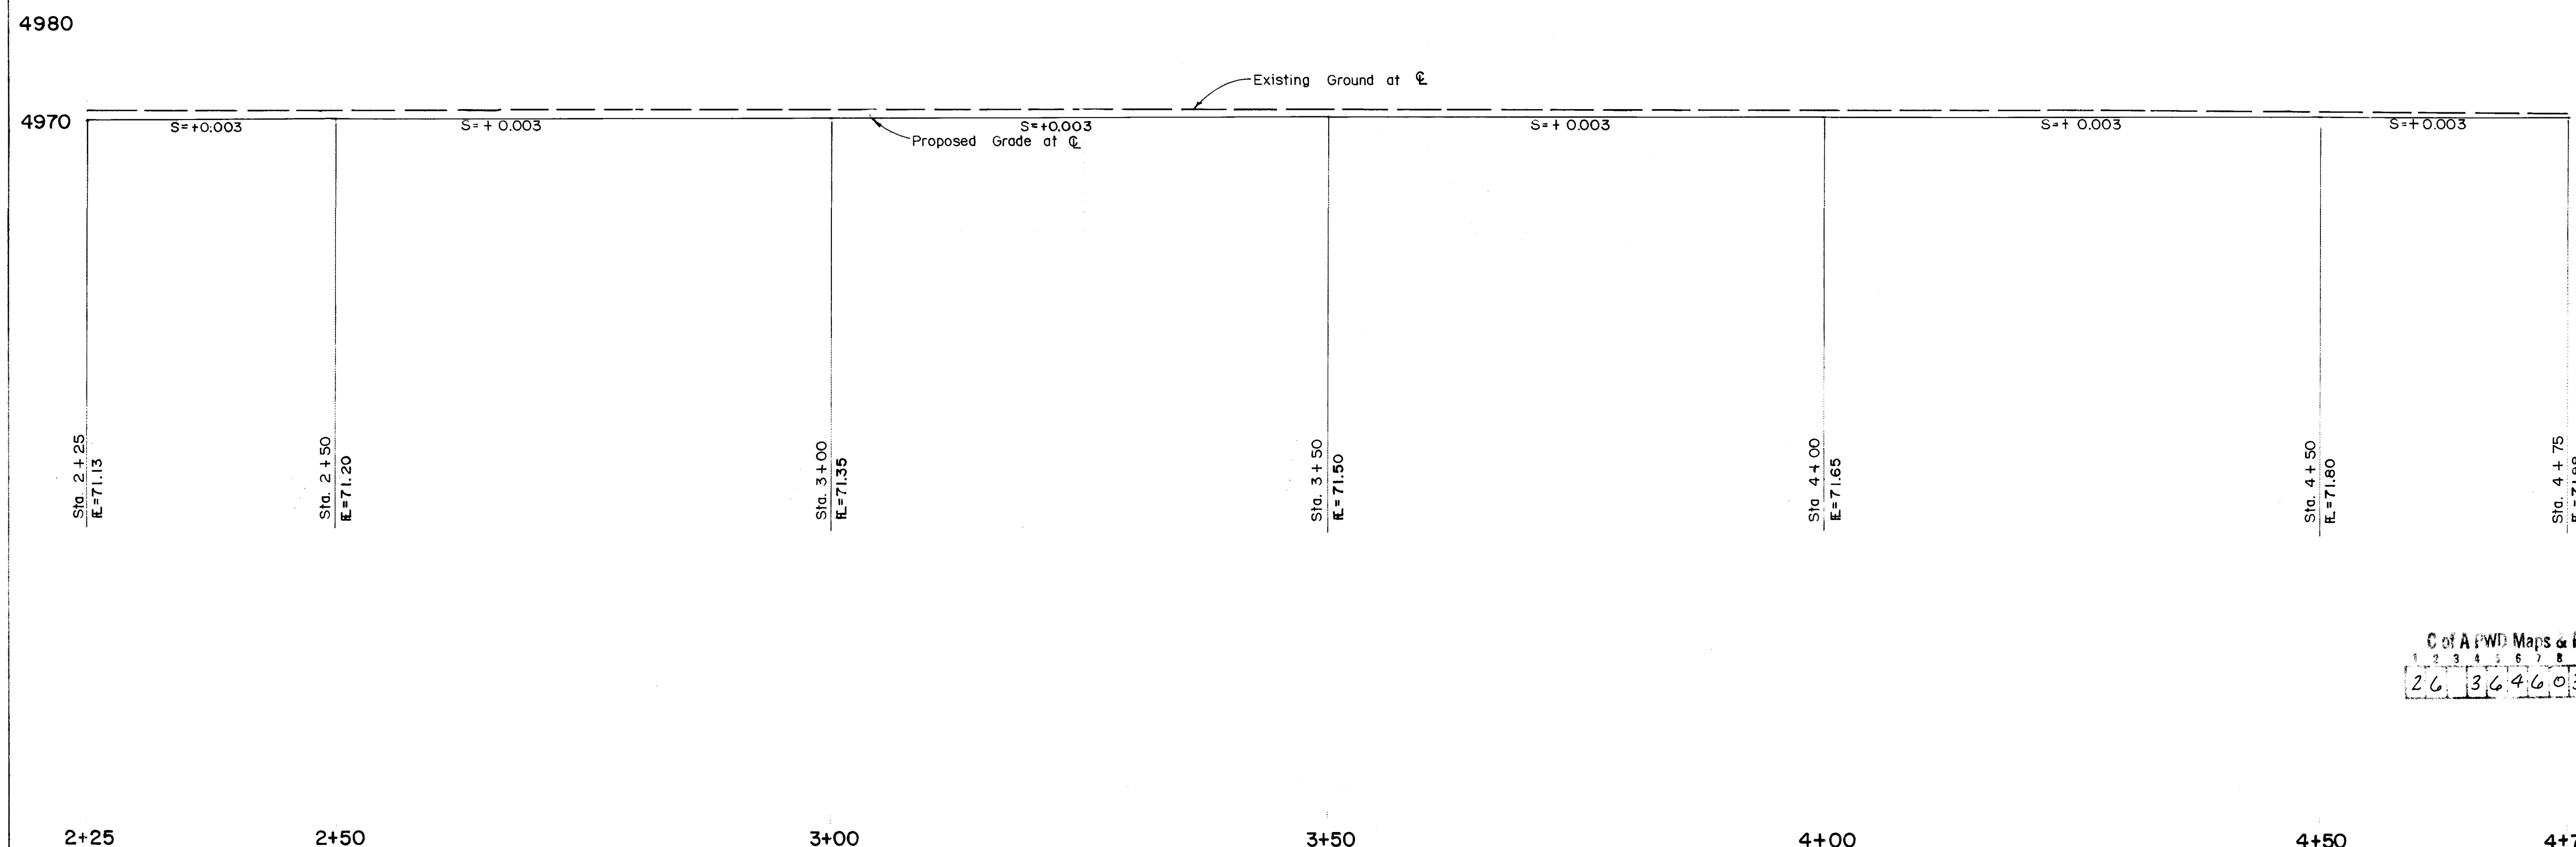

C of A FWD Maps & Records

1	2	3	4	5	6	7	8	9	10	11
2	6		3	6	4	6	0	3	9	2

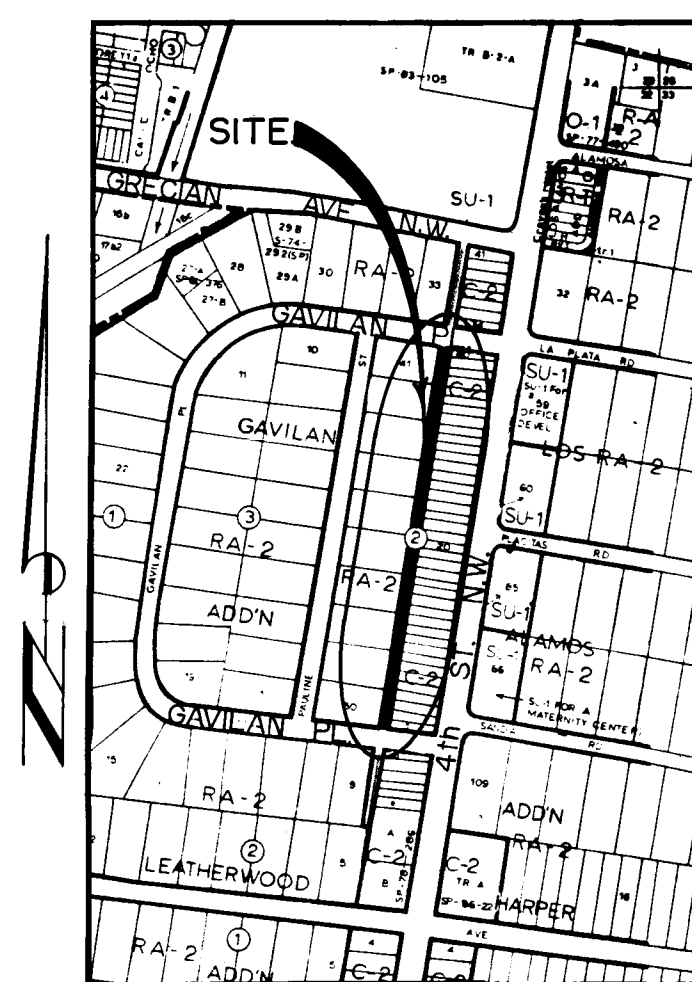

VICINITY MAP

Scale: 1" = 500'

LEGEND

- | | |
|---|------------------------|
|  | Existing Curb & Gutter |
|  | Proposed Curb & Gutter |
|  | Existing SAS |
|  | Proposed SAS |
|  | Existing Manhole |
|  | Proposed Manhole |
|  | Existing Water Line |
|  | Proposed Water Line |
|  | Proposed Tee |
|  | Proposed Fire Hydrant |
|  | Proposed Gate Valve |
|  | Proposed Reducer |

NOTES

1. TWO (2) working days prior to any excavation, contractor must contact Line Locating Service at 765-1234.
2. All items shall be constructed in accordance with City of Albuquerque Standard Specifications for Public Works Construction, 1986. (Amendments 1, 2 & 3)
3. Contractor shall conform to the City of Albuquerque Standard Dvgs. 2405, 2511 & 2415.
4. Contractor shall obtain Barricading Permit from City of Albuquerque and submit a Traffic Control Plan Three (3) days in advance of starting construction.
5. Contractor shall adhere to Section 19 of The City of Albuquerque Standard Specifications for Public Works, 1986. (Amendments 1, 2 & 3)
6. Contractor must allow one lane open on Gavilan Place N. W. open during construction.
7. Contractor shall be responsible for the coordination with the Water Systems Division. This coordination must be done not less than two (2) working days in advance of any work that may affect the existing water utilities.

ENGINEER'S SEAL

9

REMARKS

DATE

—C—

DE

Age Group	1970	1980	1990	2000	2010	2020
0-14	25	22	18	15	12	10
15-24	18	16	14	12	10	8
25-34	15	14	13	12	11	10
35-44	12	11	10	9	8	7
45-54	10	9	8	7	6	5
55-64	8	7	6	5	4	3
65-74	10	11	12	13	15	18
75+	5	6	7	8	10	12

10. *Journal of the American Medical Association*, 2000; 284: 2689-2695.

OF

LG LOGAN/GROSS & ASSOC., INC.
Consulting Civil Engineers
925 6th Street N.W., Suite 3
Albuquerque, N. Mex. 87102
(505) 243-6353

CITY OF ALBUQUERQUE
PUBLIC WORKS DEPARTMENT
ENGINEERING GROUP

TITLE ALLEY GRADES
GAVILAN ADDITION

[Handwritten:] 7/6/80
PEBO 10-26-88
[Stamp:] HYDROLOGIC REGIONAL OFFICE
Reno, NV
10-26-88

Hydrology Page 1 Nov. 10-26-98			
DRAWING NO	3646	MAP NO	F-14


SHEET 3 OF 6

I /G Job N° 394

0403

FUTURE

Scales:
 Horiz. 1" = 10'
 Vert. 1" = 10'

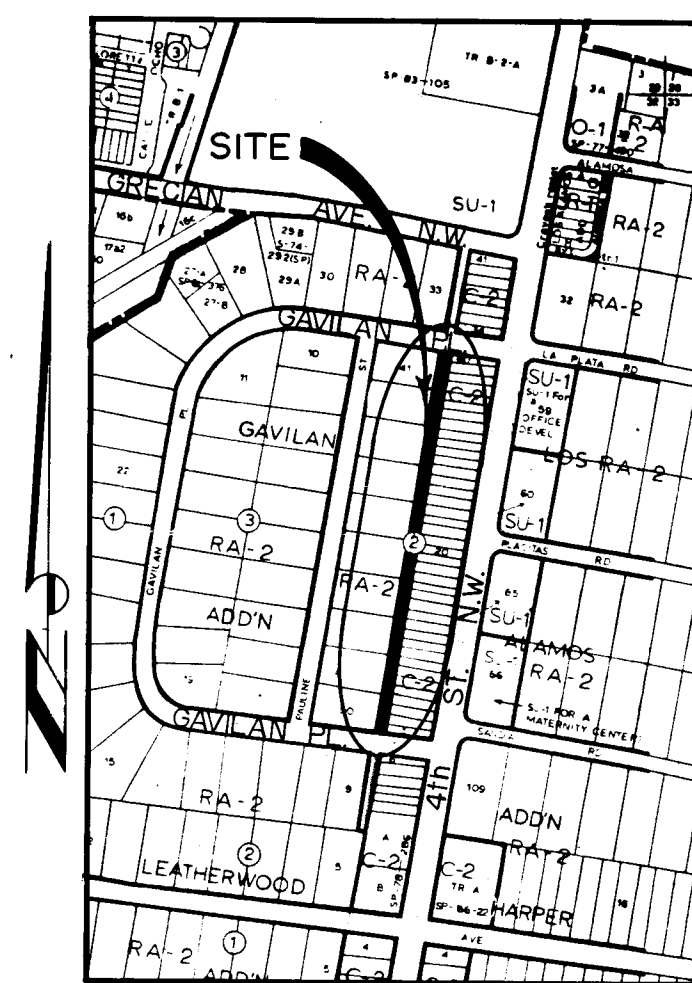

VICINITY MAP

Scale: 1" = 500'

LEGEND

- | | |
|---|------------------------|
|  | Existing Curb & Gutter |
|  | Proposed Curb & Gutter |
|  | Existing SAS |
|  | Proposed SAS |
|  | Existing Manhole |
|  | Proposed Manhole |
|  | Existing Water Line |
|  | Proposed Water Line |
|  | Proposed Tee |
|  | Proposed Fire Hydrant |
|  | Proposed Gate Valve |
|  | Proposed Reducer |

NOTES

1. TWO (2) working days prior to any excavation, contractor must contact Line Locating Service at 765-1234.
2. All items shall be constructed in accordance with City of Albuquerque Standard Specifications for Public Works Construction, 1986. (Amendments 1, 2 & 3)
3. Contractor shall conform to the City of Albuquerque Standard Dvgs. 2405, 2511 & 2415.
4. Contractor shall obtain Barricading Permit from City of Albuquerque and submit a Traffic Control Plan Three (3) days in advance of starting construction.
5. Contractor shall adhere to Section 19 of The City of Albuquerque Standard Specifications for Public Works, 1986. (Amendments 1, 2 & 3)
6. Contractor must allow one lane open on Gavilan Place N. W. open during construction.
7. Contractor shall be responsible for the coordination with the Water Systems Division. This coordination must be done not less than two (2) working days in advance of any work that may affect the existing water utilities.

LG LOGAN/GROSS & ASSOC., INC.
Consulting Civil Engineers
925 6th Street N.W., Suite 3
Albuquerque, N. Mex. 87102
(505) 243-6353

TITLE ALLEY GRADES
GAVILAN ADDITION

DATE	10-26-88
TIME	
BY	10/26/88
RECEIVED	10-26-88

DRAWING NO	3646	MAP NO.	F-14	SHEET	4	OF	6
---------------	------	---------	------	-------	---	----	---

BENCH MARK "3-F14"
 Located at the intersection of 4th & Placitas N.W. in the Southwest Quadrant of the intersection. Mark with a Square Chiseled on top of the SSE Curb Return. Elevation = 4374.768

SURVEY INFORMATION

t\$

REMARKS

DESIGN		
NAME	L.W.G.	DATE
NAME	L.C.G./C.L.L.	DATE

200

Sta. 4+75 (Match Line)

			Sta 7+25 (Match line)
--	--	--	-----------------------

4980

4980

4970

4970

Sta. 4 + 75
E = 71.88
Sta. 4 + 79 Exist. M.H.
Adjusted Rim = 71.89

Sta. 5 + 00
E = 71.95

Sta. 5 + 50
R = 72.10Sta. 6+00
H = 72.25

Sta 6 + 50

Sta. 7+00
E = 72.55Sta. 7 + 25
H = 72.62

4+75

5+00

5+50

6+00

$$6+50$$


7+00

$$7+25$$

2423

L/G Job N° 394




THIS PROJECT

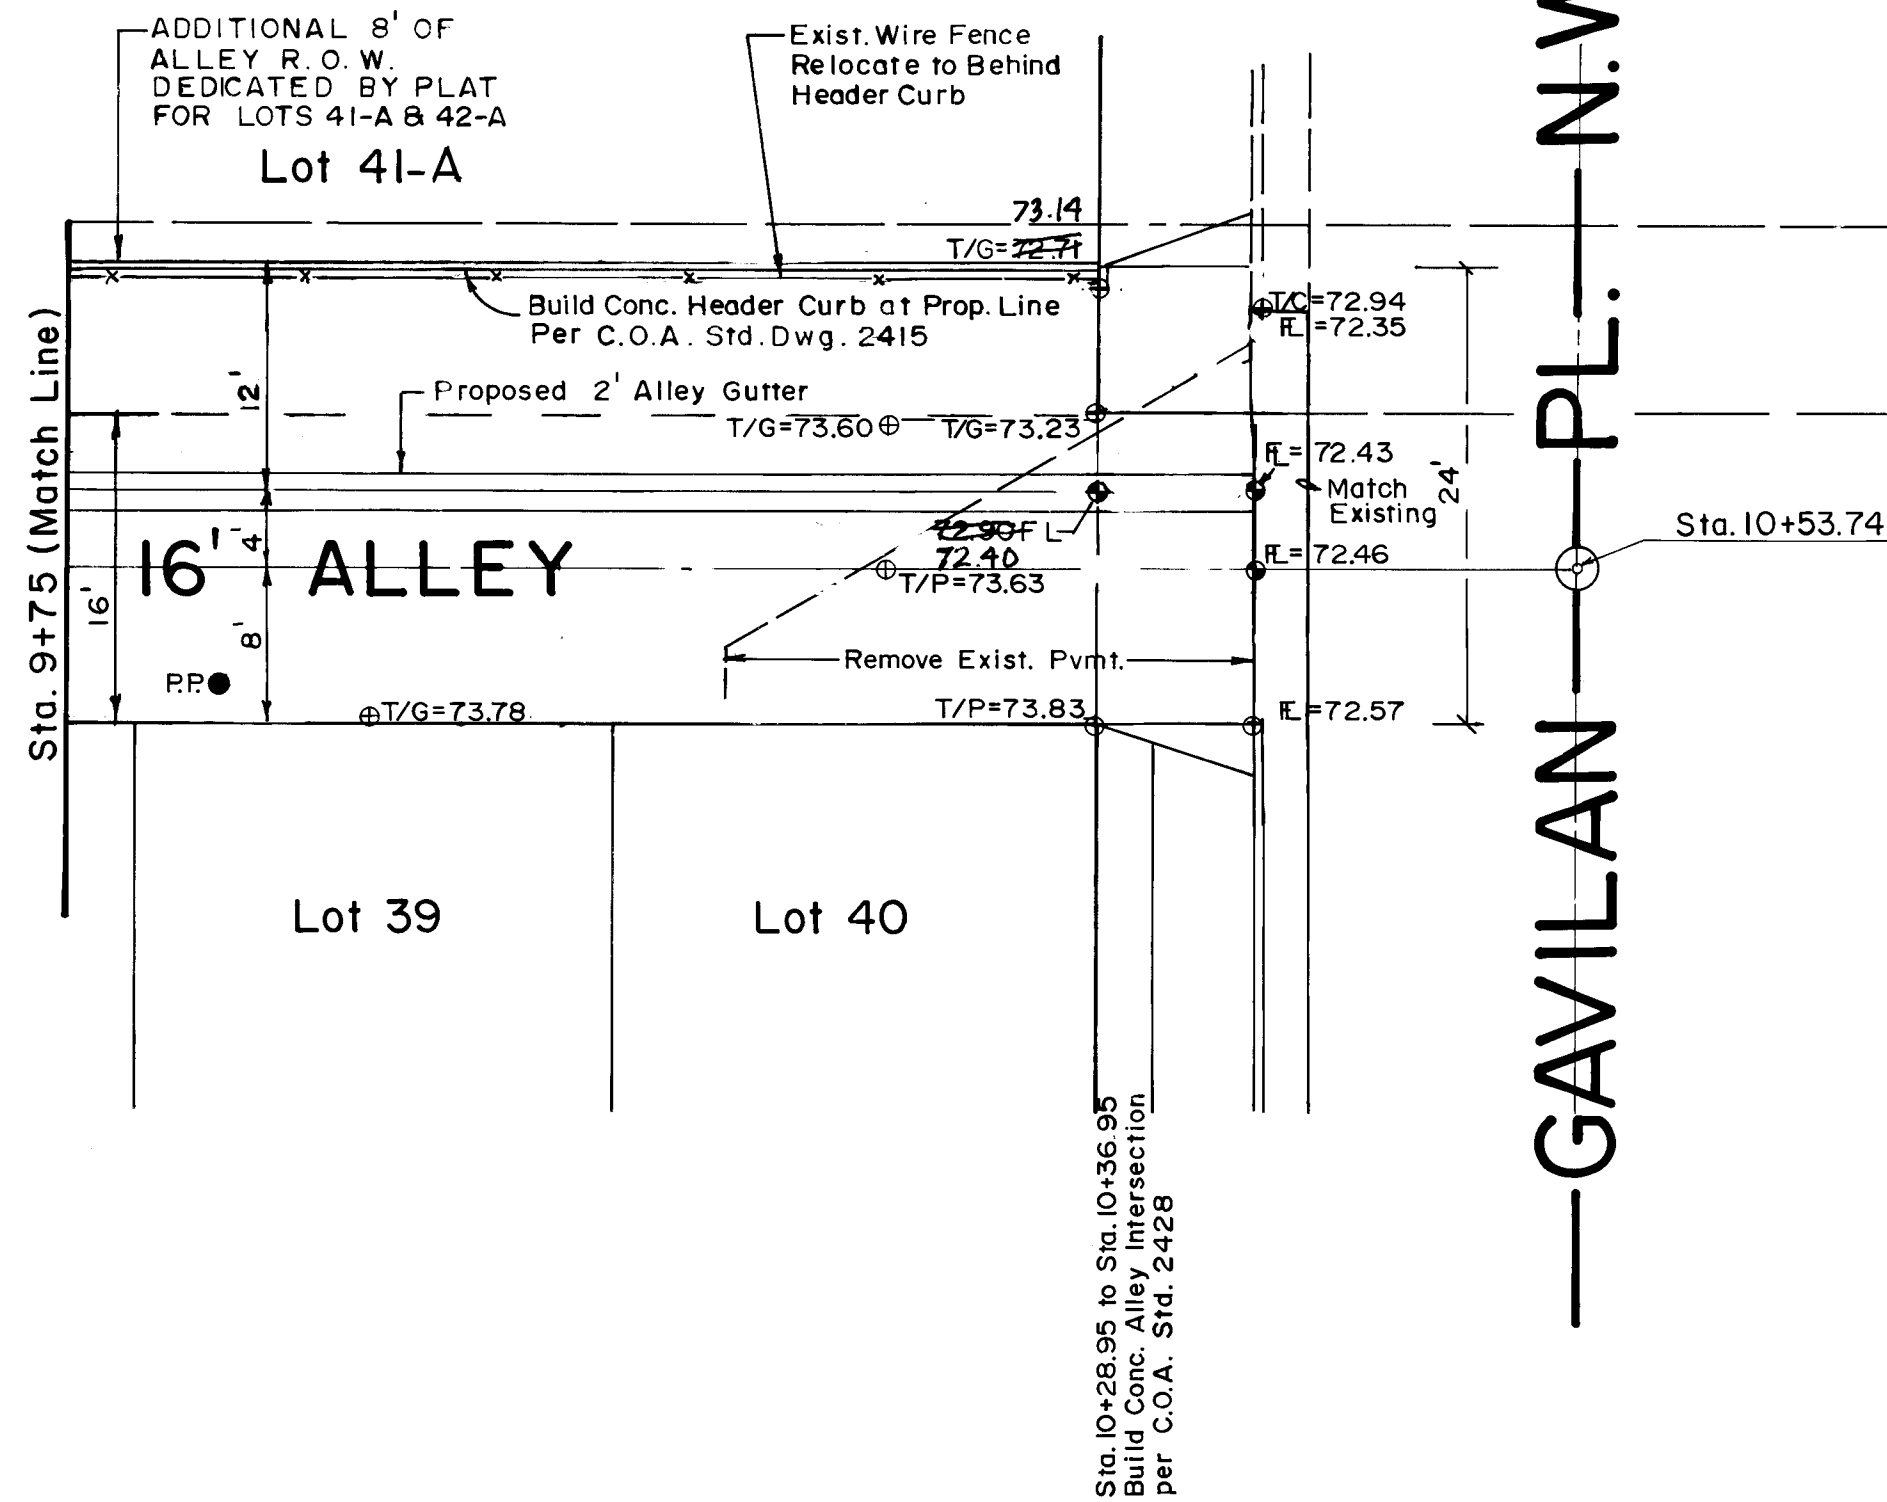

STATION TO STATION	W _L	W _R
0+25	8+53.96	8'
8+53.96	9+21.46	16'
9+21.46	9+61.26	VARIES
9+61.26	10+28.95	12'
		TOTAL 24'

Existing spot elevations	⊕
Proposed spot elevations	⊙
Top of ground	T/G
Top of pavement	T/P
Top of concrete	T/C
Top of curb	T/C
Flowline Gutter or avale	E

Scales:
Horiz. 1"=10'
Vert. 1"=10'

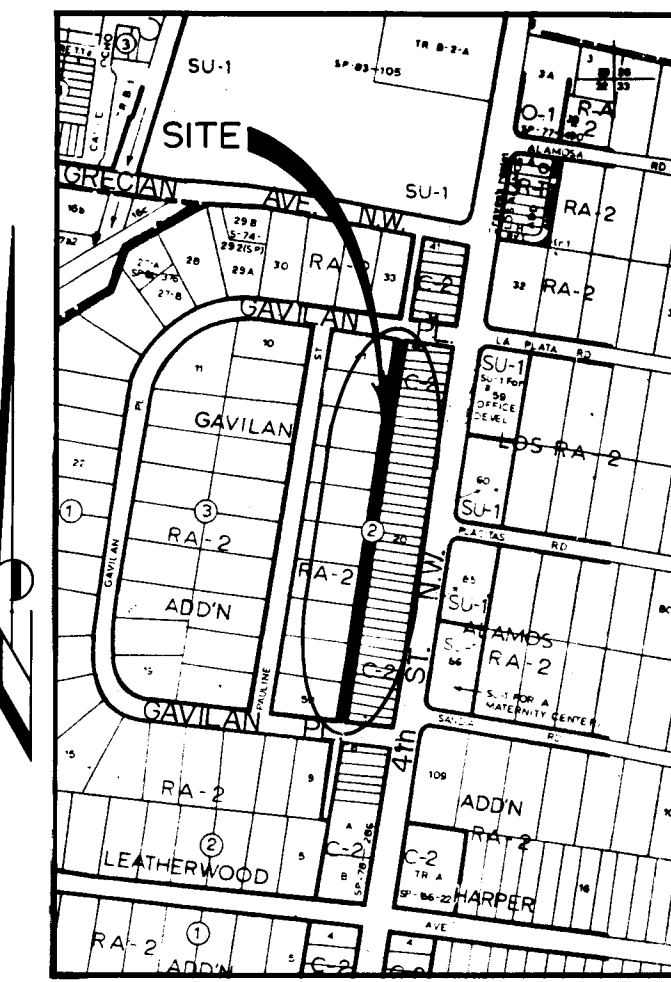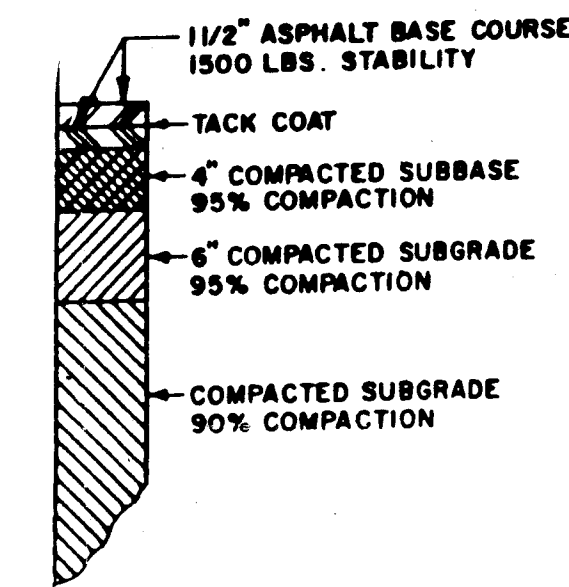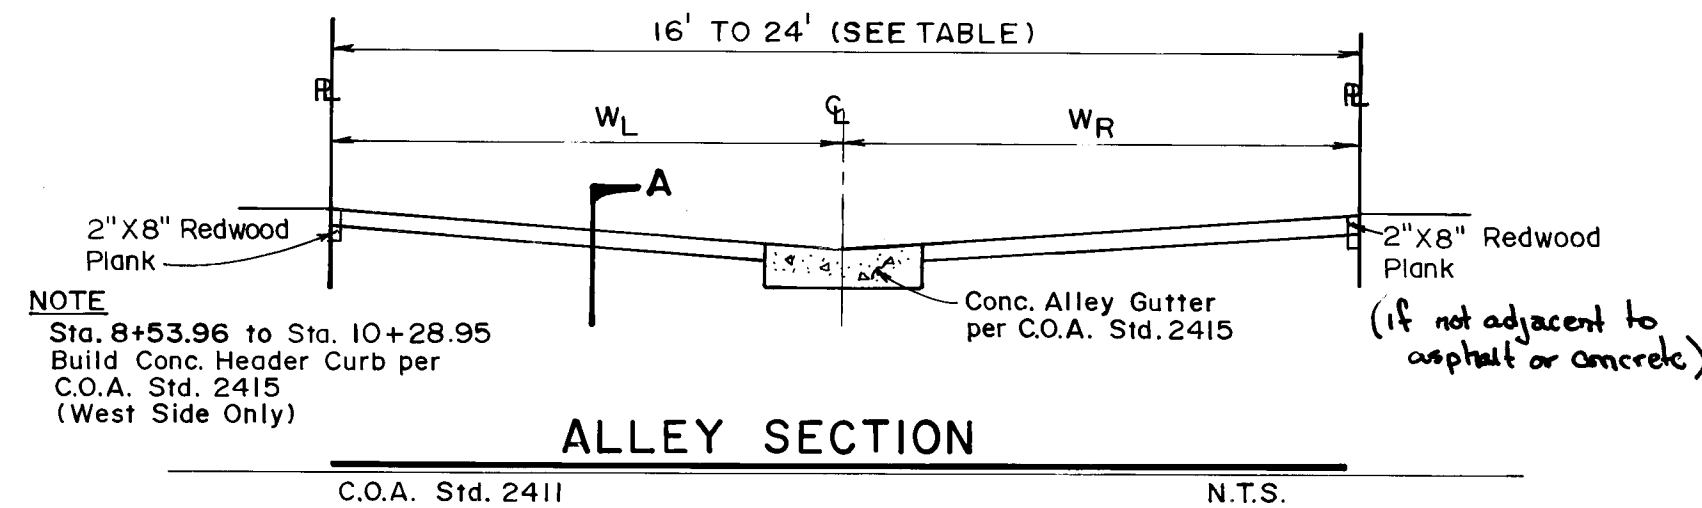

LEGEND

- Existing Curb & Gutter
- Proposed Curb & Gutter
- Existing SAS
- Proposed SAS
- Existing Manhole
- Proposed Manhole
- Existing Water Line
- Proposed Water Line
- Proposed Tee
- Proposed Fire Hydrant
- Proposed Gate Valve
- Proposed Reducer

NOTES

- Two (2) working days prior to any excavation, contractor must contact New Mexico One Call System, Inc. (260-1990) for location of existing utilities.
- All items shall be constructed in accordance with City of Albuquerque Standard Specifications for Public Works Construction, 1986. (Amendments 1, 2 & 3).
- Contractor shall conform to the City of Albuquerque Standard Drawings 2102, 2111, 2405, 2415 & 2511.
- Contractor shall adhere to Section 19 of the City of Albuquerque Standard Specifications for Public Works, 1986. (Amendments 1, 2 & 3).
- Contractor must allow one lane open on Gavilan Place N.W. open during construction.
- Contractor shall be responsible for coordination with the Water Systems Division (857-8200). This coordination must be done not less than three (3) working days in advance of any work that may affect the existing water utilities.

TRAFFIC CONTROL

Three (3) working days prior to beginning construction the Contractor shall submit to the Construction Co-ordination Division a detailed construction schedule. Two (2) working days prior to construction the Contractor shall obtain a barricading permit from the Construction Co-ordination Division. Contractor shall notify Barricade Engineer (768-2551) prior to occupying an intersection. See section 19 of the specifications.

All Street striping altered or destroyed shall be replaced in kind by Contractor to location and in kind as existing or as indicated by this plan set.

CITY OF ALBUQUERQUE
PUBLIC WORKS DEPARTMENT
ENGINEERING GROUP

TITLE
ALLEY GRADES
GAVILAN ADDITION

NO.	DATE	REVISIONS	DESIGN	DATE	BY	DATE	BY
1	12-12-91						
2	12-11-91						
3	12-4-91						
4	11-26-91						
5							
6							
