


CITY OF ALBUQUERQUE, NEW MEXICO
PUBLIC WORKS DEPARTMENT

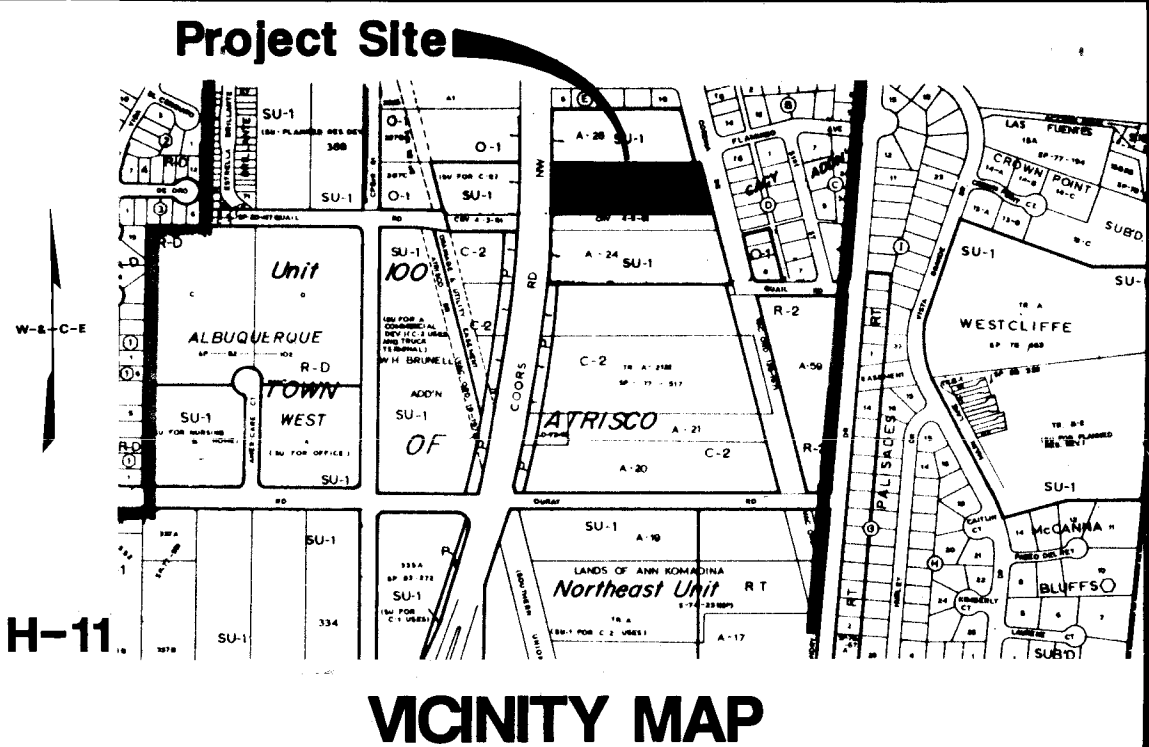

GIANT SERVICE STATION 625
2930 COORS BLVD. NW
CONNECTION TO PUBLIC STORM DRAIN
SANITARY SEWER IMPROVEMENTS

INDEX

DESCRIPTION
TITLE SHEET AND INDEX
PLAN & PROFILE - STORM DRAIN
PLAN & PROFILE - SANITARY SEWER


SHEET NO.
1
2
3

NOTES

- 1 ALL WORK DETAILED ON THESE PLANS TO BE PERFORMED UNDER CONTRACT SHALL, EXCEPT AS OTHERWISE STATED OR PROVIDED FOR HEREON, BE CONSTRUCTED IN ACCORDANCE WITH THE C.O.A. STANDARD SPECIFICATIONS FOR PUBLIC WORKS CONSTRUCTION - 1986 EDITION (REFERRED TO HEREIN AS THE STANDARD SPECIFICATIONS).
- 2 TWO (2) WORKING DAYS PRIOR TO ANY EXCAVATION, CONTRACTOR MUST CONTACT LINE LOCATING SERVICE, 765-1234, FOR LOCATION OF EXISTING UTILITIES
- 3 PRIOR TO CONSTRUCTION, THE CONTRACTOR SHALL EXCAVATE AND VERIFY THE HORIZONTAL AND VERTICAL LOCATIONS OF ALL OBSTRUCTIONS. SHOULD A CONFLICT EXIST, THE CONTRACTOR SHALL NOTIFY THE ENGINEER OR SURVEYOR SO THAT THE CONFLICT CAN BE RESOLVED WITH MINIMUM AMOUNT OF DELAY.
- 4 REFERENCE MADE TO STANDARD DRAWINGS REFER TO CITY OF ALBUQUERQUE STANDARD DRAWINGS.
- 5 ALL UTILITIES AND UTILITY SERVICE LINES SHALL BE INSTALLED PRIOR TO PAVING.
- 6 CONTRACTOR SHALL ADHERE TO SECTION 19 OF THE CITY OF ALBUQUERQUE STANDARD SPECIFICATIONS FOR CONSTRUCTION, 1986.
- 7 BACKFILL COMPACTION SHALL BE ACCORDING TO SPECIFIED STREET USE.
- 8 TACK COAT REQUIREMENTS SHALL BE DETERMINED BY THE CITY ENGINEER.
- 9 ALL STORM DRAINAGE FACILITIES SHALL BE COMPLETED PRIOR TO FINAL ACCEPTANCE.

LEGAL DESCRIPTION

Lot B-1 McBark Subdivision Albuquerque, New Mexico

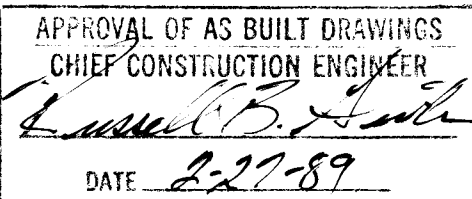

1 2 3 4 5 6 7 8 9 10 11 12
26 36 51 01 89


REV	SHEETS	CITY ENGR.	DATE	USER DEPT.	DATE	USER DEPT.	DATE
APPROVAL OF REVISIONS							



WILSON
COMPANY
ENGINEERS
ARCHITECTS
ALBUQUERQUE, NEW MEXICO


APPROVED FOR
CONSTRUCTION
Robert W. Johnson
1/12/89

PROJECT No. 3651 SHEET 1 OF 3

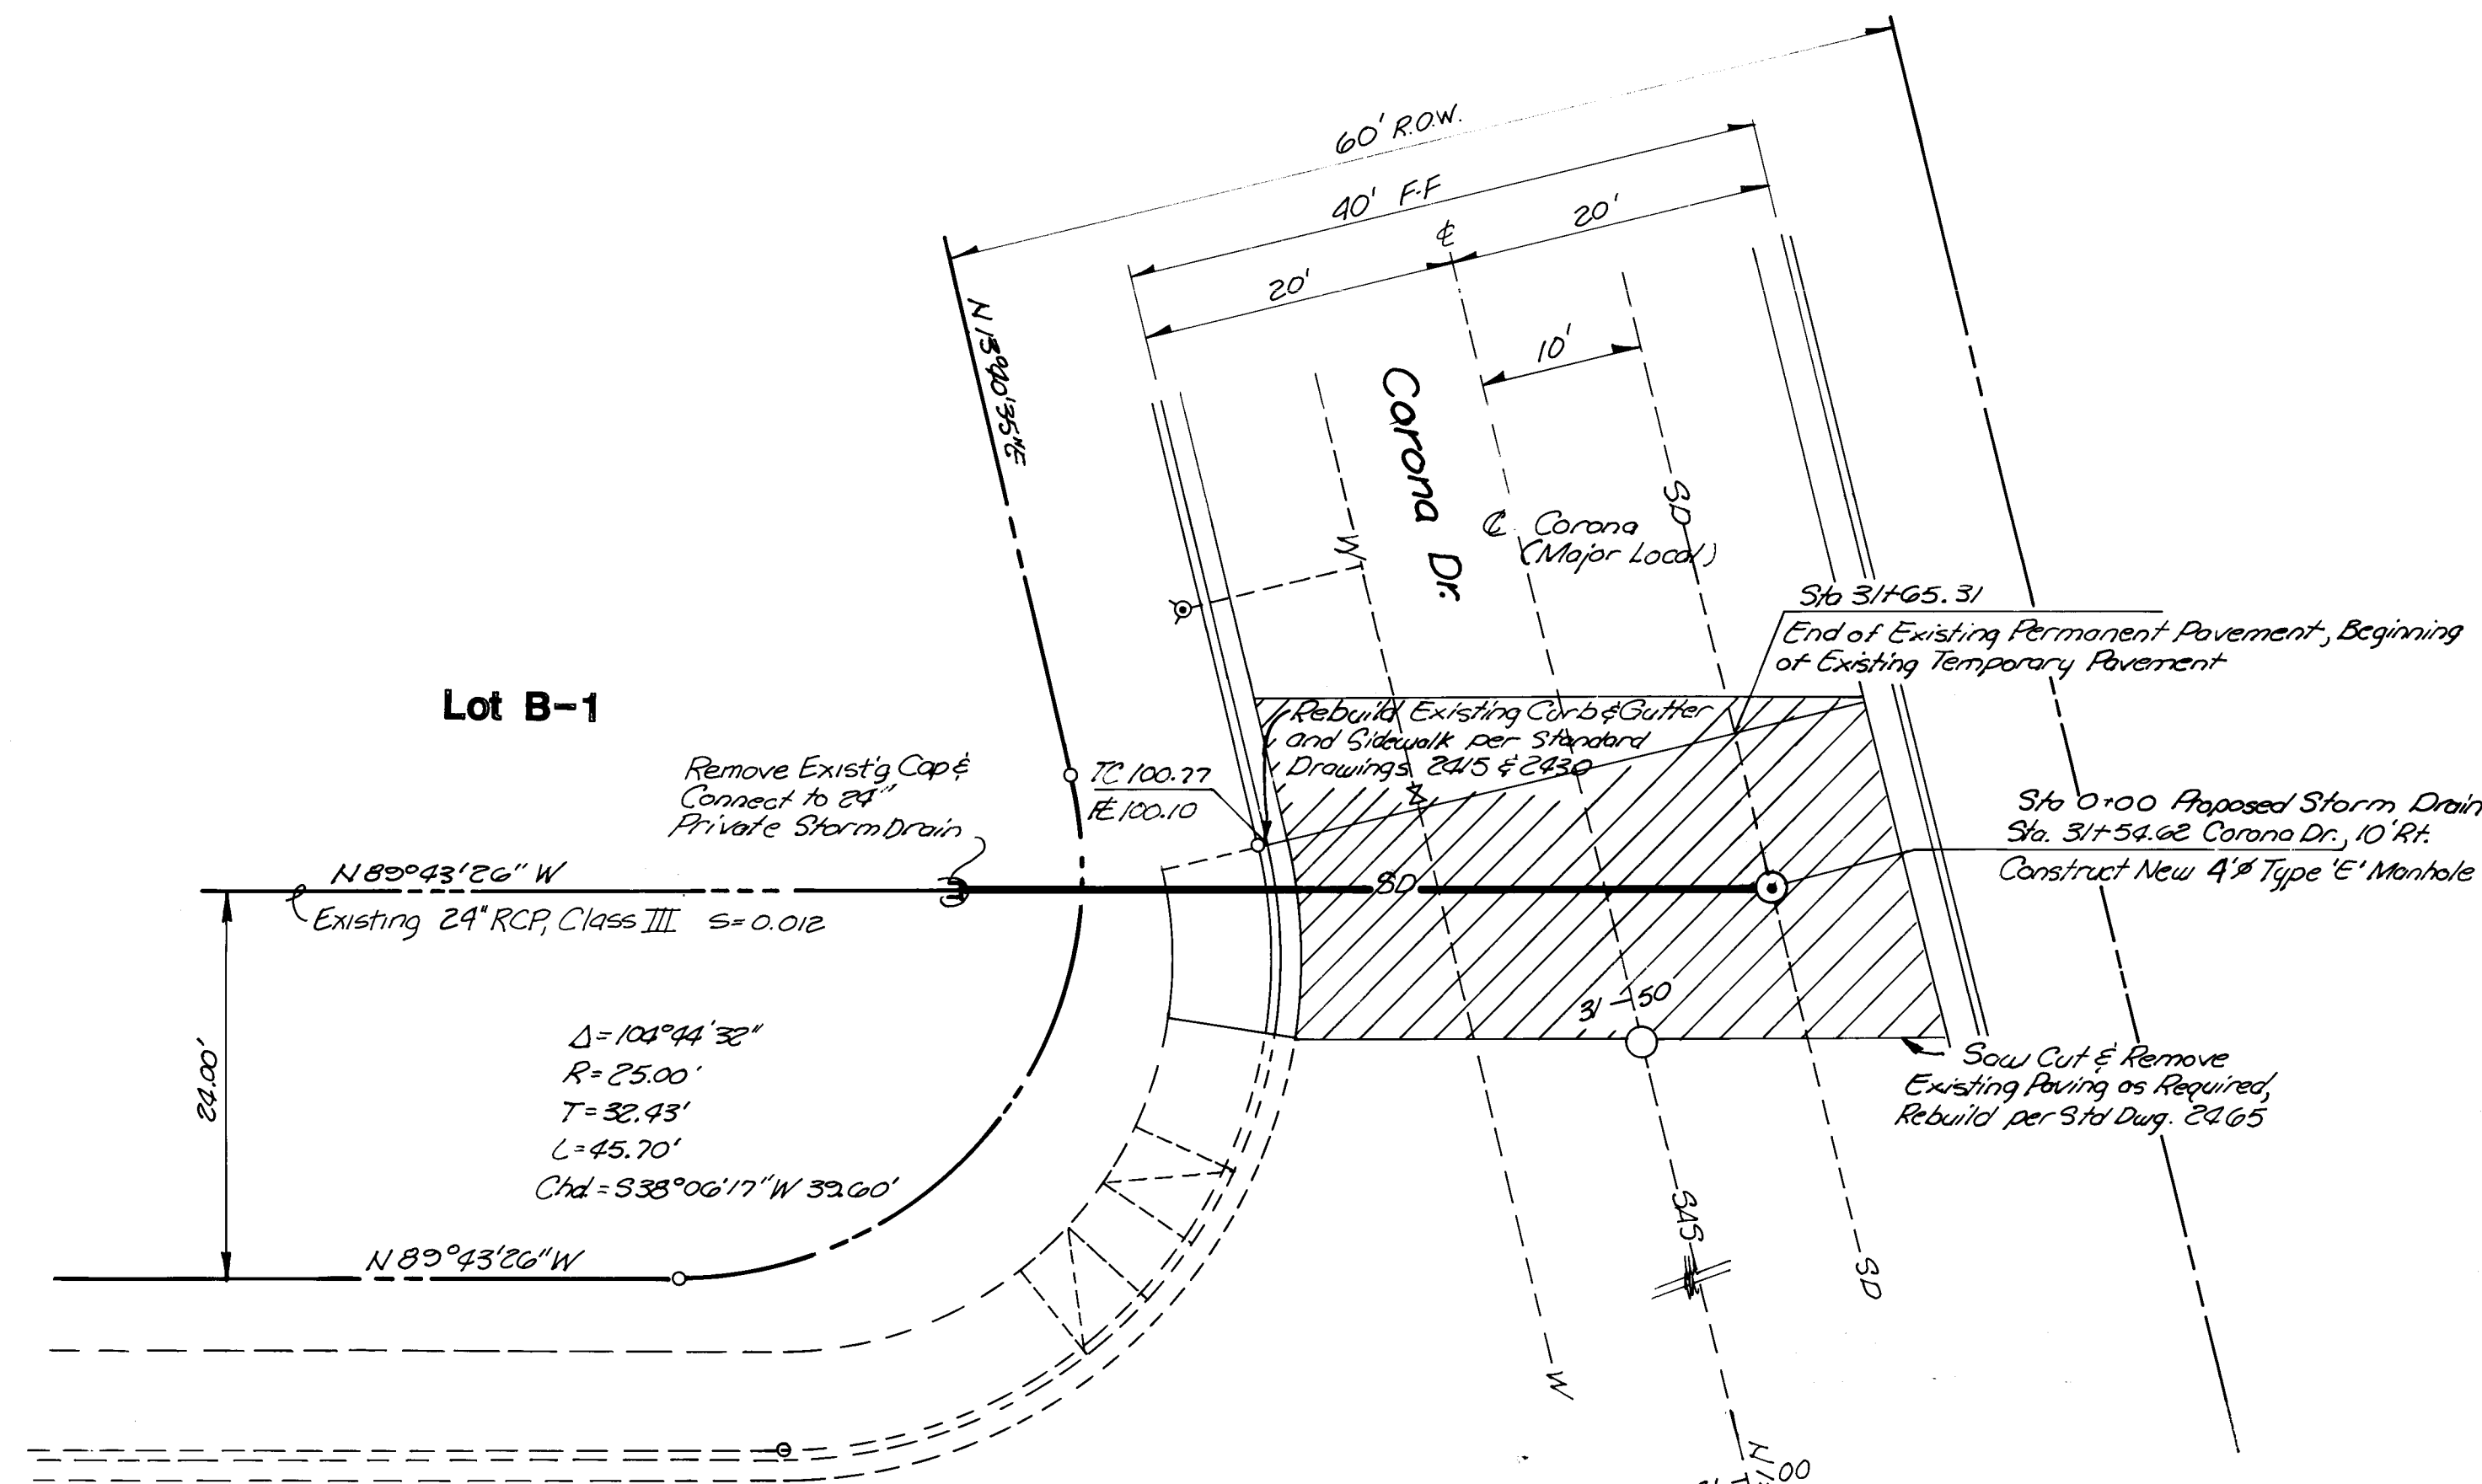

Quail Rd.

ACS "NM 448-N3"
N/M State Plane Coordinate
X=14911.002.42
Y=365.125.22
Q-B=0.99967849
A-B=-00°15'34"
Elev.=5099.27


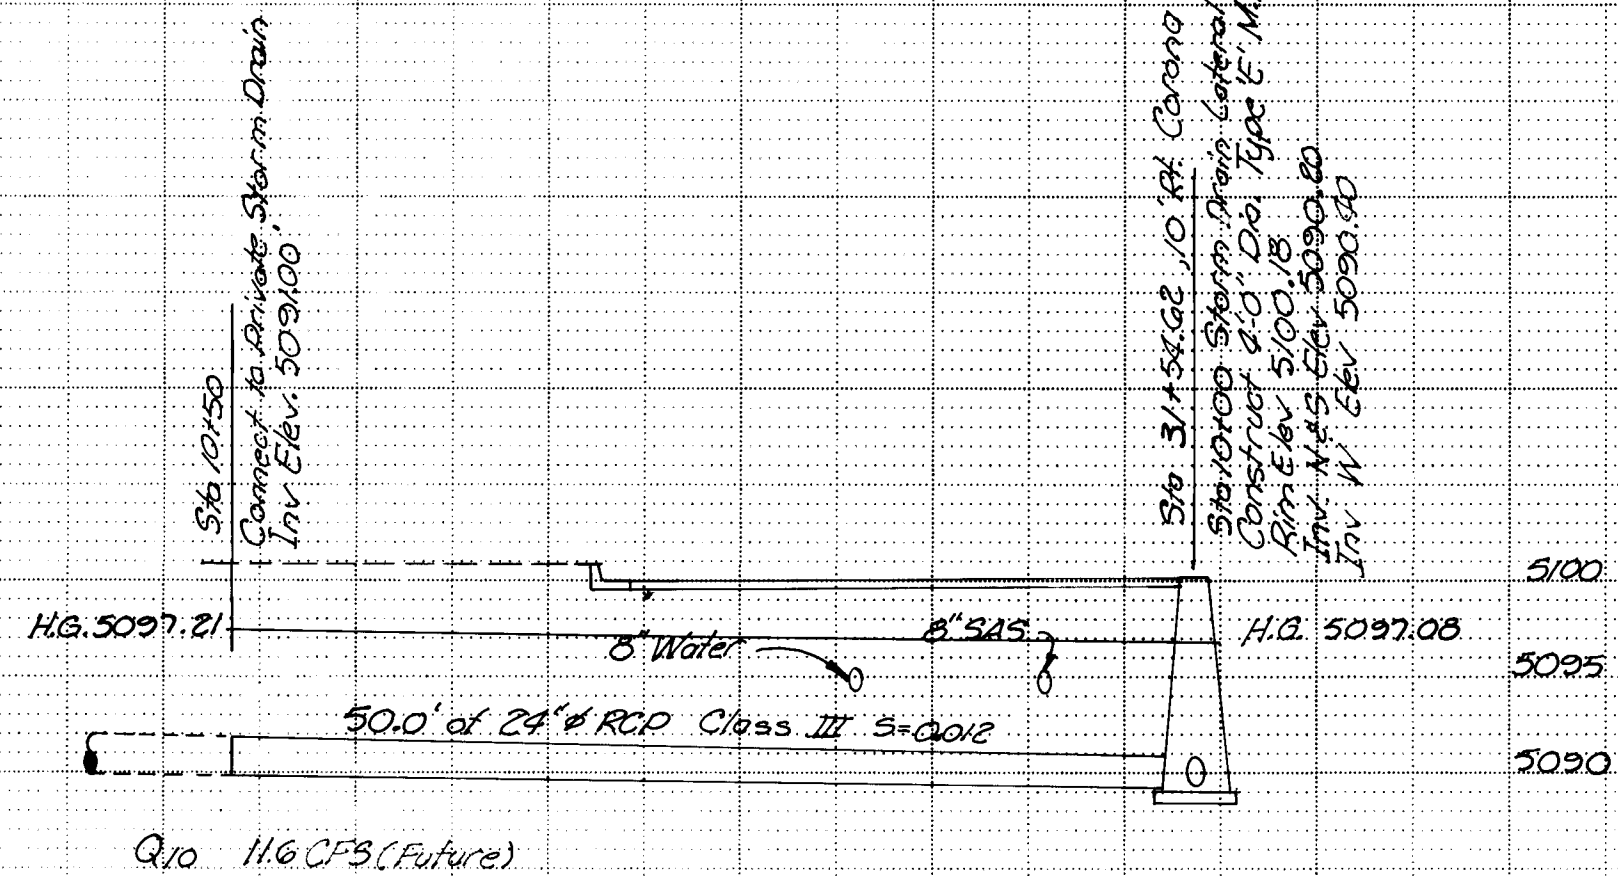


- Legend
- SD— Proposed SD
 - - -SD- - Existing SD
 - ⊙ Proposed SD Manhole
 - Existing Manhole
 - Right of Way
 - - -W- - Existing Waterline
 - - -SAS- - Existing SAS
 - Profile:
- - - Existing Grade

1	2	3	4	5	6	7	8	9	10	11	12
26	36	51	02	89							

CITY OF ALBUQUERQUE STORM DRAIN PLAN & PROFILE					
GIANT SERVICE STATION #625 STORM DRAIN IMPROVEMENTS					
APPROVALS	ENGINEER	DATE	APPROVALS	ENGINEER	DATE
City Engineer	<i>[Signature]</i>	11/1/08	Liquid Waste	<i>[Signature]</i>	11/4/08
ACE - Design	<i>[Signature]</i>	11/1/08	Traffic	<i>[Signature]</i>	11/9/08
ACE - Hydrology	<i>[Signature]</i>	11/1/08	Water	<i>[Signature]</i>	11/4/08
DRAWING NO.	3651	MAP NO.	H-11	SHEET	OF 3

**TRACT A-26
TOWN OF ATRISCO GRANT**

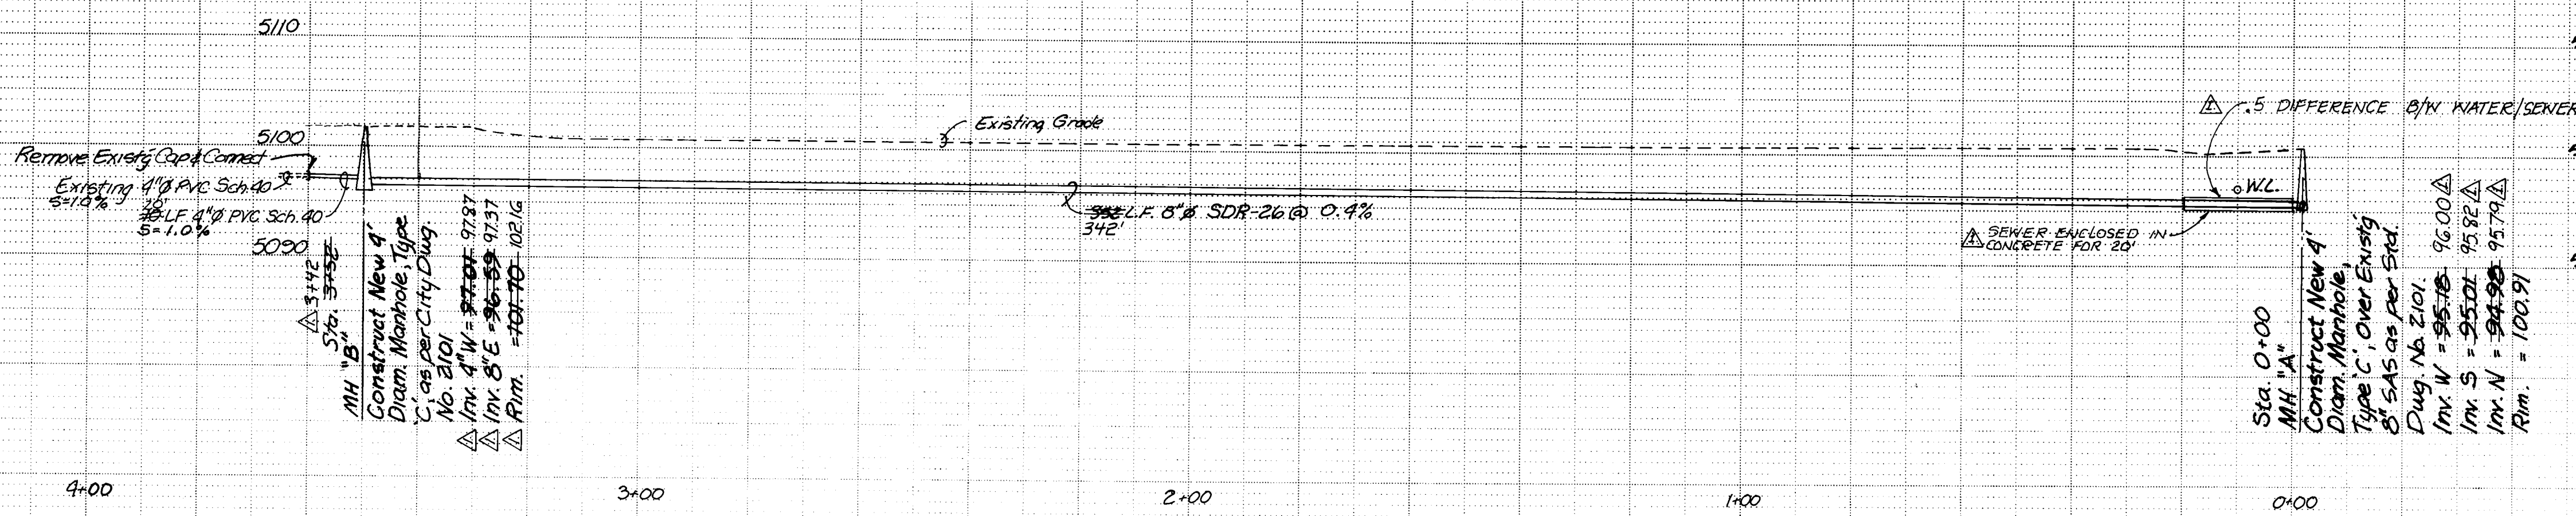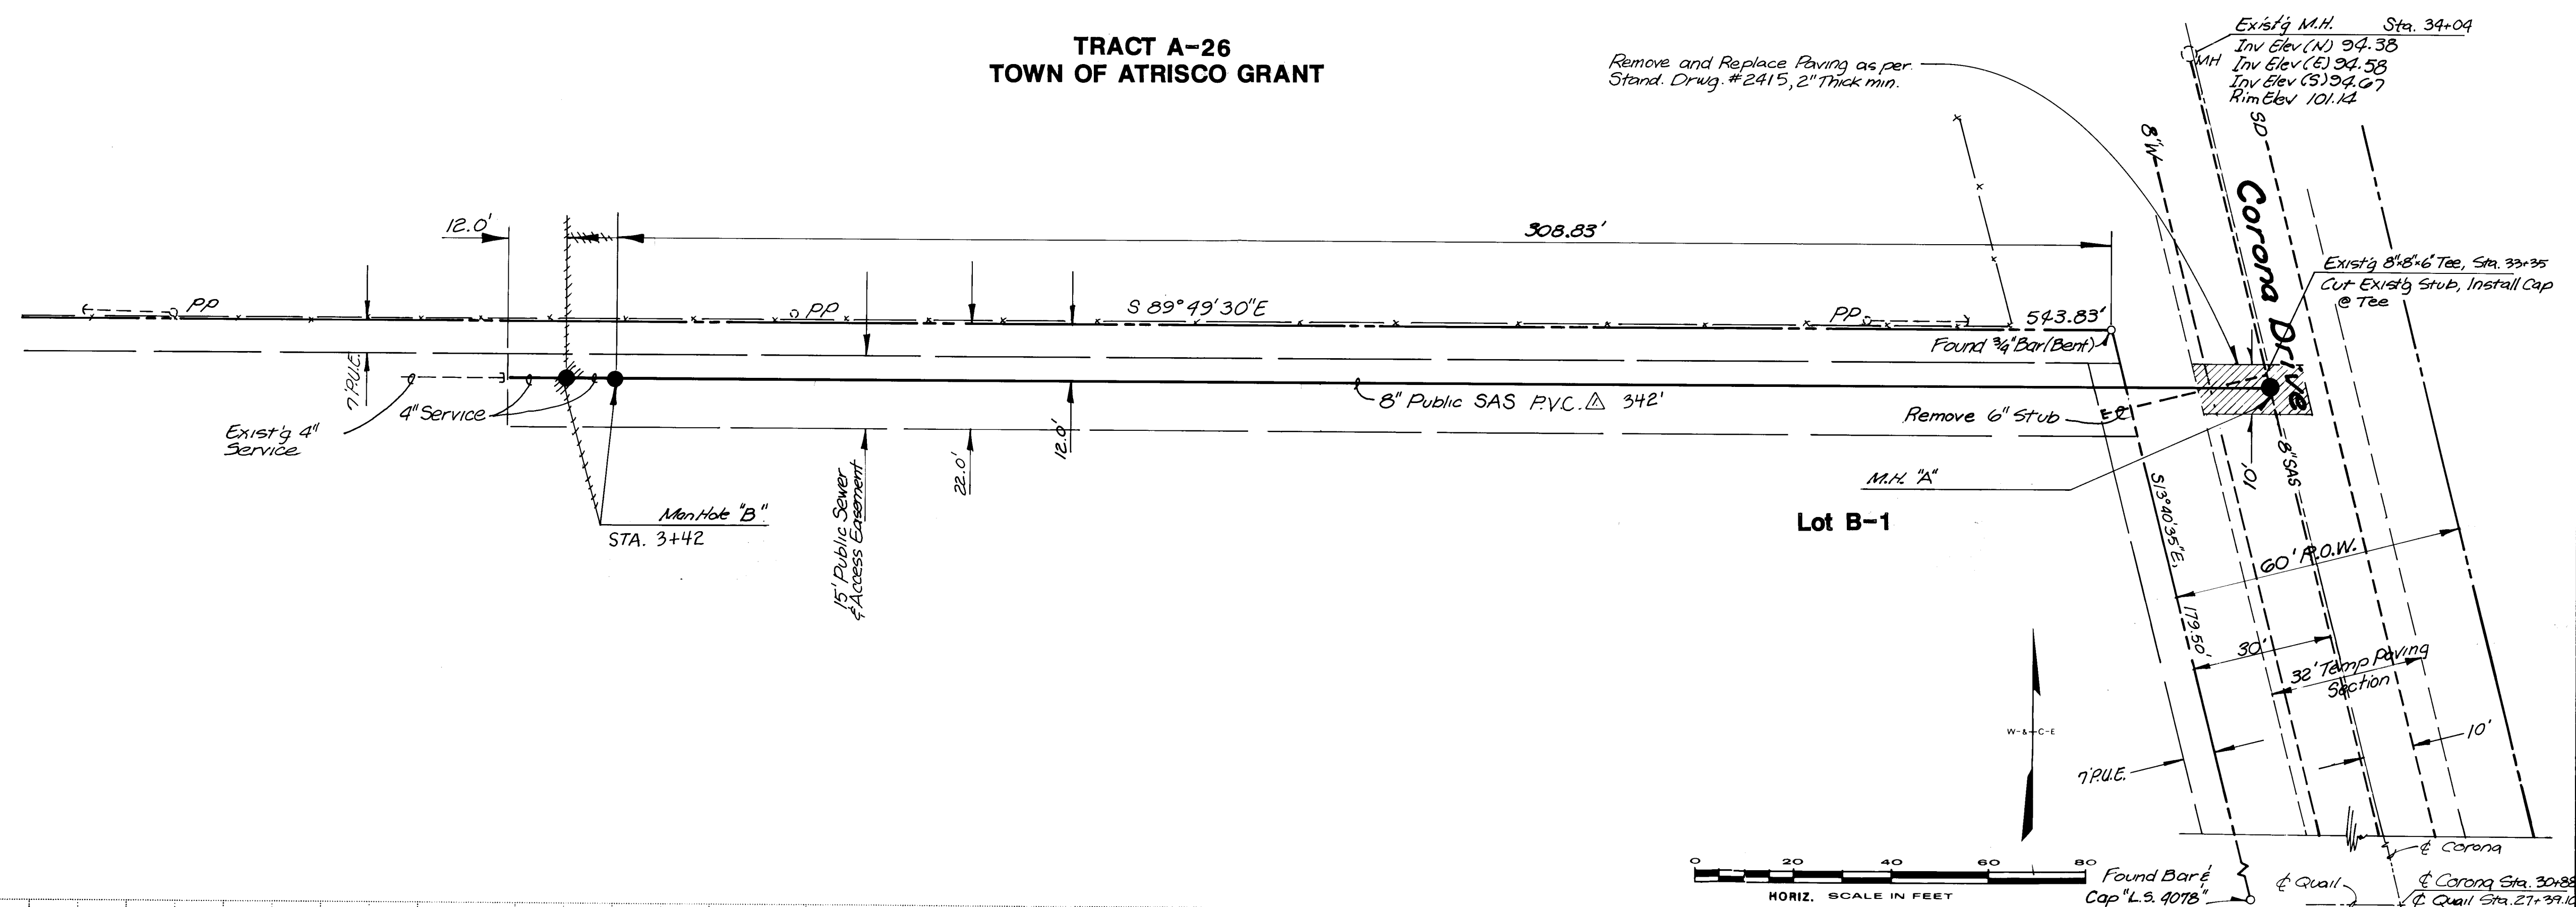

Legend

Plan :

Proposed SAS
---8"--- Existing SAS
x----- Existing Fence
•----- Existing Power Pole's Anchor
● Proposed SAS Manhole
○ Existing SAS Manhole
----- Right of Way
---8"--- Existing Waterline

Profile:

	Proposed MH
	Proposed SAS
	Exist'g Grade
W.L.	Exist'g Waterline

1	2	3	4	5	6	7	8	9	10	11	12
2	6		3	6	5	1	0	3	8	9	

AS BUILT INFORMATION	
CONTRACT NO.	SUNDANCE MECH
WORK ORDER NO.	
INSPECTED BY	CITY
DATE	
ACCEPTED BY	RAY BAICA DATE 2/16/89
FIELD NO.	
VERIFICATION BY	
CORRECTED BY	EN
DATE	DATE 2/89
MICRO-FILM INFORMATION	
RECORDED BY	DATE
NO	

ACS "NM448-N3" BRASS TABLET SET IN
CONCRETE, FLUSH WITH PAVEMENT IN
WEST EDGE OF PARKING LOT AT "WEST
MESA BOWL", ELEV. 5099.527

[illegible][illegible]

CITY OF ALBUQUERQUE
SANITARY SEWER PLAN & PROFILE

GIANT SERVICE STATION # 625
SANITARY SEWER

SANTARY SEWER							
APPROVALS		ENGINEER	DATE	APPROVALS		ENGINEER	DATE
City Engineer		<i>[Signature]</i>	11/9/88	Liquid Waste		<i>[Signature]</i>	11/9/88
A C E - Design		<i>[Signature]</i>	11/9/88	Traffic		<i>[Signature]</i>	11/9/88
A C E - Hydrology		<i>[Signature]</i>	11/9/88	Water		<i>[Signature]</i>	11/9/88

DRAWING NO.	3651	MAP NO.	H-11	SHEET	OF	3	3
-------------	------	---------	------	-------	----	---	---