


RECORD DRAWING
THIS IS A RECORD DRAWING OF THE FACILITIES IDENTIFIED IN THE TITLE BLOCK ONLY AND HAS BEEN PREPARED IN PART ON THE BASIS OF INFORMATION COMPILED AND FURNISHED BY OTHERS. THE ENGINEER/ARCHITECT AND OTHER (S) WILL NOT BE RESPONSIBLE FOR ANY ERROR (S) OR OMISSION (S) WHICH HAVE BEEN INCORPORATED INTO THIS DRAWING. ACTUAL CONDITIONS WILL VARY SOMEWHAT FROM THE CONDITIONS SHOWN HEREON AND AT SOME LOCATIONS THE VARIANCE MAY BE LARGE. IF THE PRECISE LOCATION OF ANY FACILITY IS REQUIRED, THE FACILITY SHOULD BE FIELD LOCATED IN THE PRESENCE OF AN EMPLOYEE OF THE DISTRICT OR THE OWNER (S) OF THE UTILITIES INVOLVED.

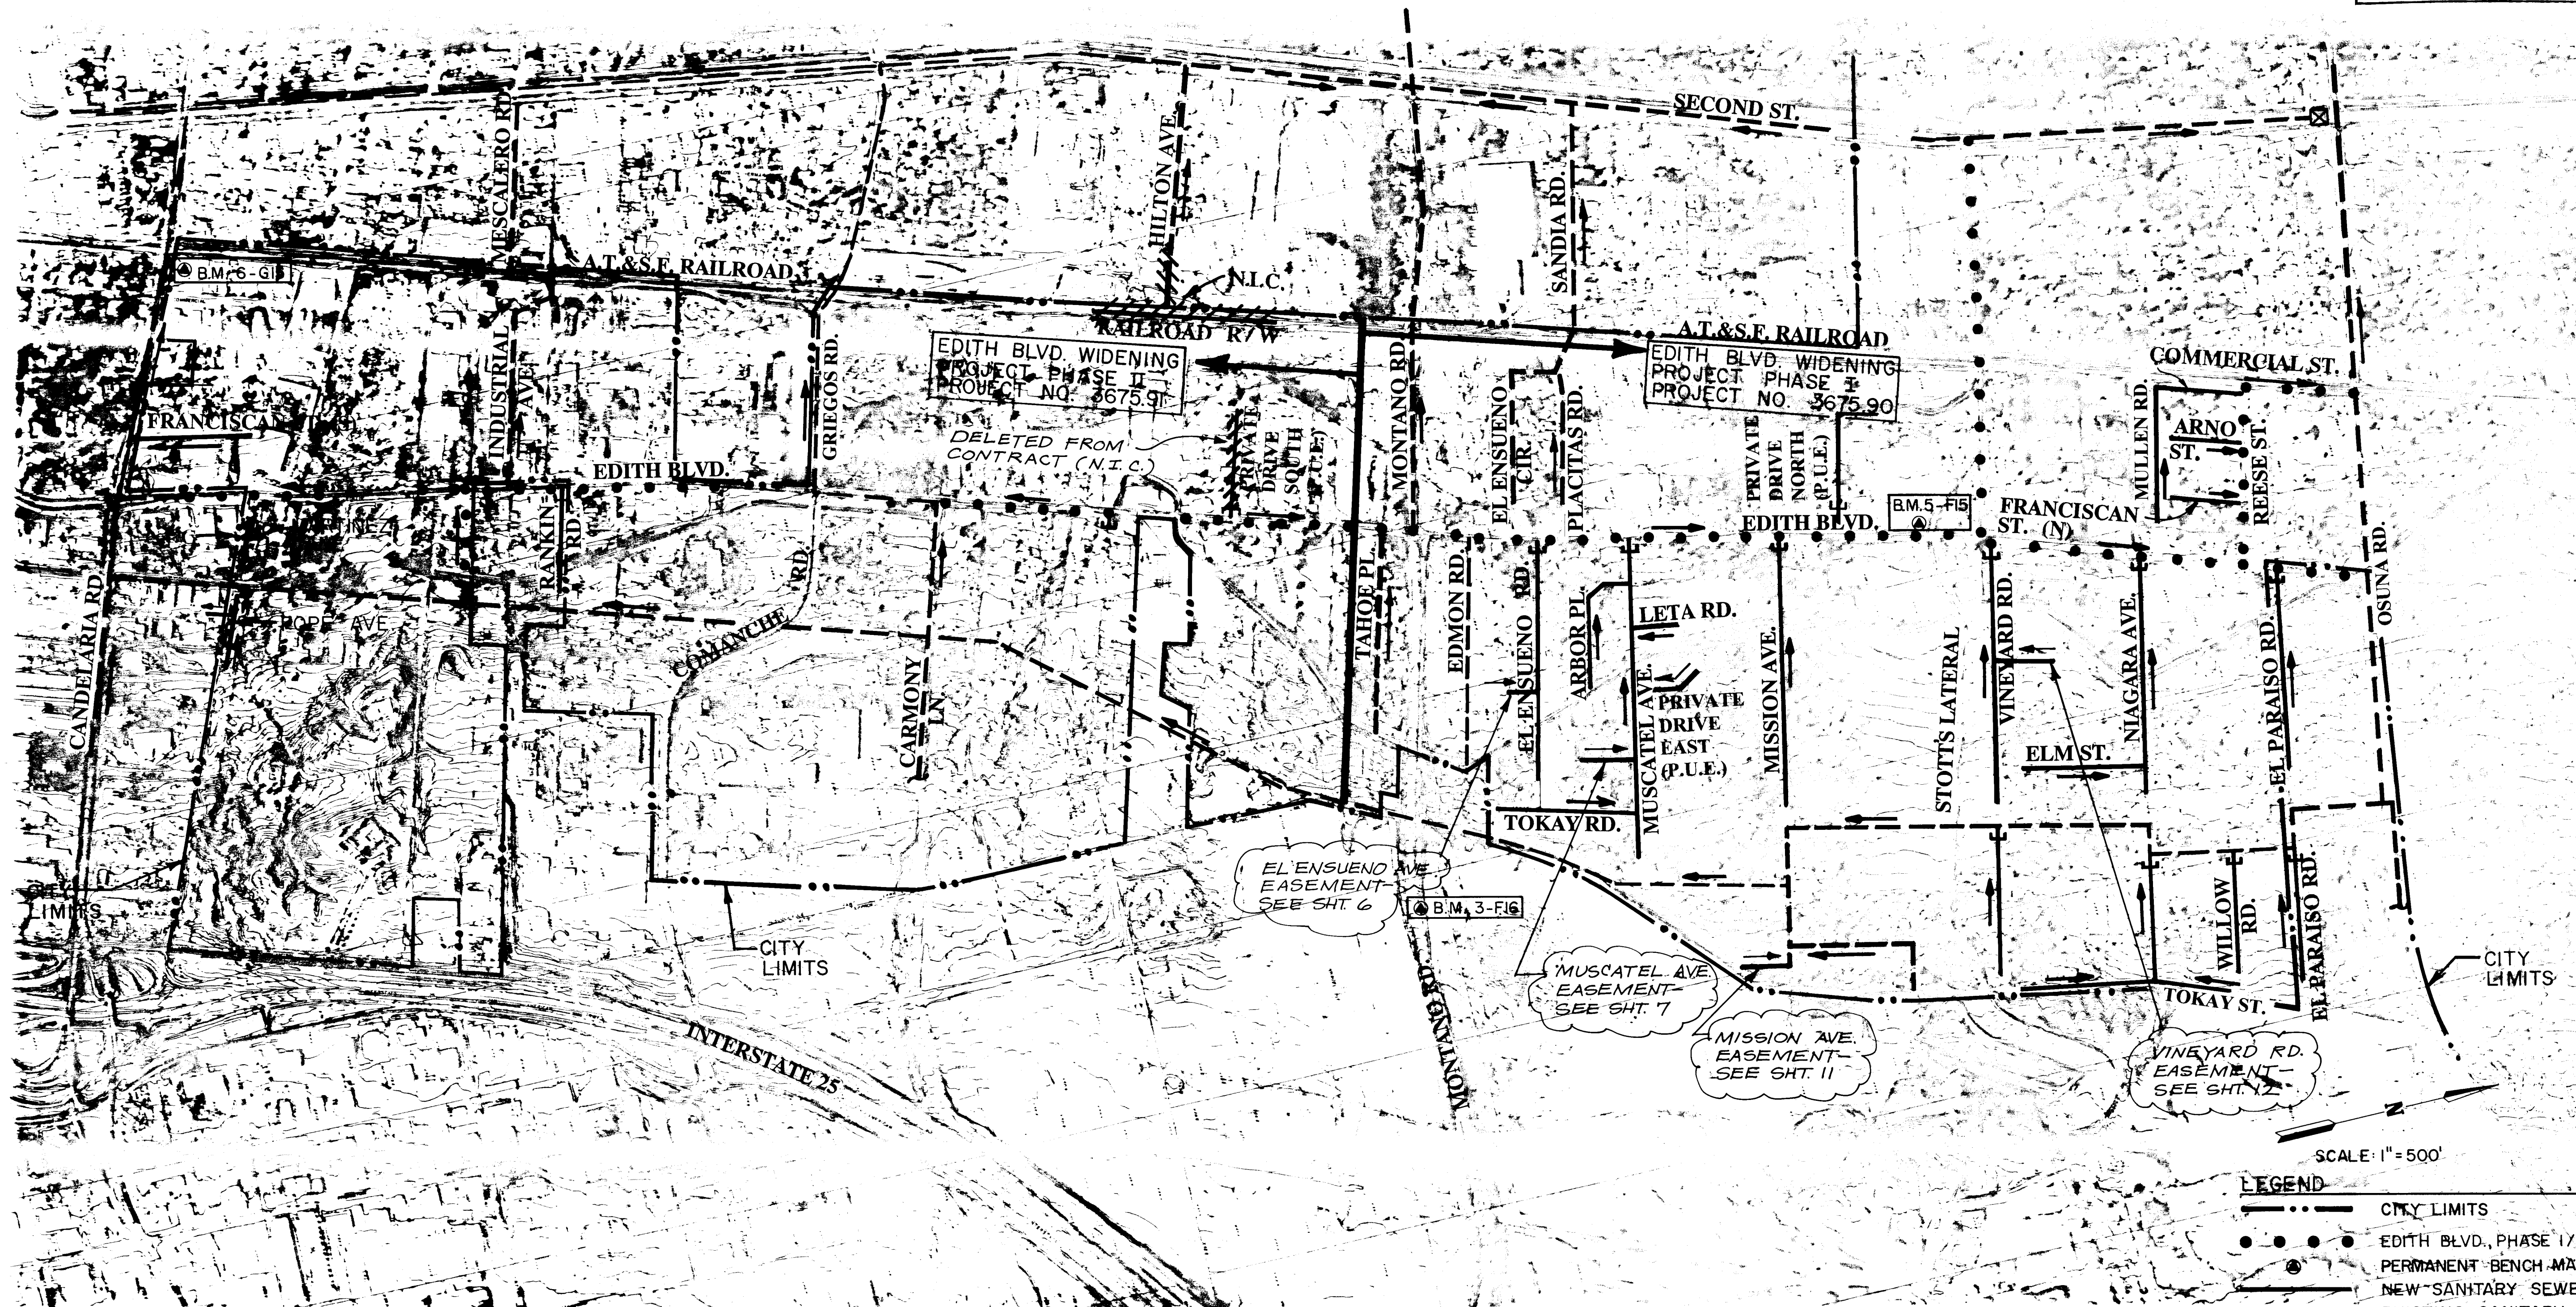

SEWER LINE NOTES

1. THE LOCATION OF EXISTING UNDERGROUND UTILITIES HAS BEEN DETERMINED BY INFORMATION PROVIDED BY OTHERS, AND SHALL BE CONSIDERED APPROXIMATE ONLY. THE CONTRACTOR SHALL DETERMINE THE EXACT LOCATION AND SIZE OF ALL EXISTING UTILITY LINES PRIOR TO CONSTRUCTION AND SHALL BE RESPONSIBLE FOR ANY AND ALL DAMAGES RESULTING FROM FAILURE TO LOCATE ANY AND ALL UTILITIES.
2. ALL ASPECTS OF SEWER LINE CONSTRUCTION ARE TO COMPLY WITH THE CITY OF ALBUQUERQUE STANDARD SPECIFICATIONS FOR PUBLIC WORKS CONSTRUCTION AS MODIFIED BY THE CONTRACT DOCUMENTS. SEE SECTIONS 300 (STREETS & RELATED WORK), 700 (TRENCHING & BACKFILL), 900 (SANITARY & STORM SEWER FACILITIES), 100 (MATERIALS) AND APPLICABLE STANDARD DETAIL DRAWINGS.
3. UNLESS OTHERWISE AUTHORIZED BY THE ENGINEER, WATER AND SANITARY SEWER LINES SHALL BE INSTALLED AT LEAST 10 FEET APART HORIZONTALLY AND THE WATER LINE SHALL BE AT LEAST 18" ABOVE THE SEWER LINE.
4. ALL SEWER LINES LOCATED WITHIN THE AT & SF RAILROAD RIGHT-OF-WAY SHALL BE PLACED WITH CLASS B

BEDDING UNLESS OTHERWISE NOTED. ALL OTHER SEWER LINES WILL BE INSTALLED WITH CLASS C BEDDING, MINIMUM.

5. SERVICE LATERAL LOCATIONS AND INVERT DEPTHS INDICATED ON THE SEWER LINE PROFILES ARE APPROXIMATE ONLY AND ARE SHOWN AT THE STREET RIGHT-OF-WAY, OR THE HIGHEST POINT OF THE LATERAL. ALL SEWER SERVICE LATERALS SHALL SLOPE FROM THE HIGH POINT AT THE R/W TOWARDS THE MAINLINE AT 1/4" PER FOOT (2%) UNLESS OTHERWISE NOTED. THE CONTRACTOR SHALL NOTE THE ADDRESS, STATION, OFFSET, INVERTS AT PROPERTY LINE AND OTHER COMMENTS FOR EACH SEWER SERVICE LATERAL ON THE PLANS.
6. EXCAVATION FOR SANITARY SEWER LINES SHALL NOT ENCROACH BEYOND ESTABLISHED RIGHT-OF-WAY LINES, UTILITY EASEMENT LINES, OR ENDANGER EXISTING IMPROVEMENTS.
7. TRENCH SLOPES AND OTHER PROTECTION SHALL BE IN ACCORDANCE WITH APPLICABLE REGULATIONS SUCH AS THE DEPARTMENT OF LABOR'S, OSHA STANDARDS 29 CFR, PART 1926, SUBPART P OR ANY APPLICABLE AMENDMENTS.

INDEX OF SHEETS

Sheet No.	Description
1	Title Sheet
2	Sanitary Sewer Schematic Layout
3	Plan and Profile - Franciscan Street (South)
4	Plan and Profile - Rankin Road
5	Plan and Profile - Hilton Ave. Railroad R/W (N.I.C.)
6	Plan and Profile - El Ensueno Road
7	Plan and Profile - Muscatel Avenue
8	Plan and Profile - Muscatel Avenue/Tokay Road
9	Plan and Profile - Arbor Place/Leta Road
10-11	Plan and Profile - Mission Avenue
12-13	Plan and Profile - Vineyard Road
14-15	Plan and Profile - Niagara Avenue

Sheet No.	Description
16	Plan and Profile - Tokay Street
17	Plan and Profile - Elm Street
18	Plan and Profile - Willow Road
19	Plan and Profile - Commercial Street
20	Plan and Profile - Mullen Road
21	Plan and Profile - Franciscan Street (North)/Arno Street
22-23	Plan and Profile - El Paraiso Road
24	Plan and Profile - Martinez Lane
25	Plan and Profile - Private Lane South (P.U.E.) (N.I.C.)
26	Plan and Profile - Private Lane East (P.U.E.)
27	Plan and Profile - Private Lane North (P.U.E.)
28	Typical Details

AS BUILT

LEGEND

- CITY LIMITS
- EDITH BLVD., PHASE I/II SEWERS.
- PERMANENT BENCH MARK, SEE SHT. 3
- NEW SANITARY SEWER LINE
- - - EXISTING SANITARY SEWER LINE
- - - EXISTING SEWER STUB-OUT
- DIRECTION OF FLOW
- ☒ SEWAGE LIFT STATION (MANHOLES NOT SHOWN)

CITY OF ALBUQUERQUE PUBLIC WORKS DEPARTMENT ENGINEERING GROUP					
TITLE: SCHEMATIC LAYOUT W/ INDEX					
EDITH BOULEVARD SANITARY SEWER PROJECT					
APPROVALS	ENGINEER	DATE	APPROVALS	ENGINEER	DATE
DRC CHAIRMAN			WATER		
TRANSPORTATION			WASTE WATER		
HYDROLOGY					
PROJECT NO.	3675.92	MAP NO.		SHEET 2	OF 28

