

FILE INFORMATION
D:\B1710102\B1710102







PLOT SCALE
1"=1'

OPERATOR
AL1/CAM

PLOT DATE
07/22/92 08:42

BOYLE
ENGINEERING CORPORATION

F.H.W.A. REGION NO.	STATE	SHEET NO.	TOTAL SHEETS
6	NEW MEXICO	12-7	

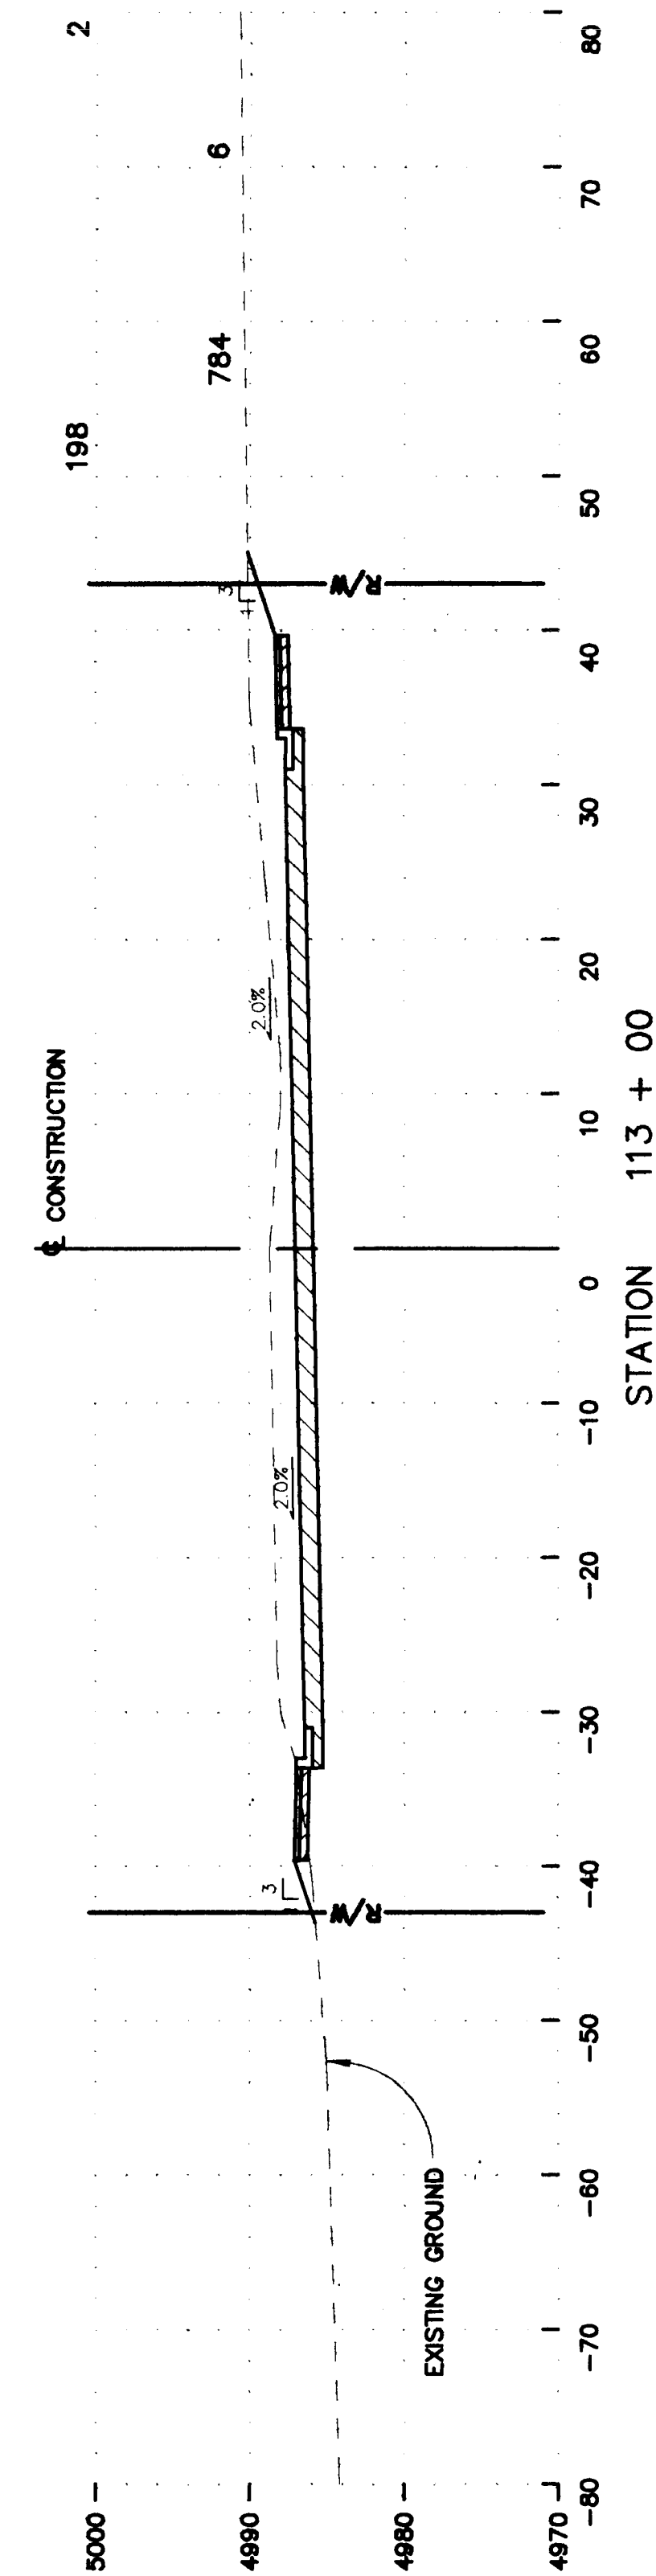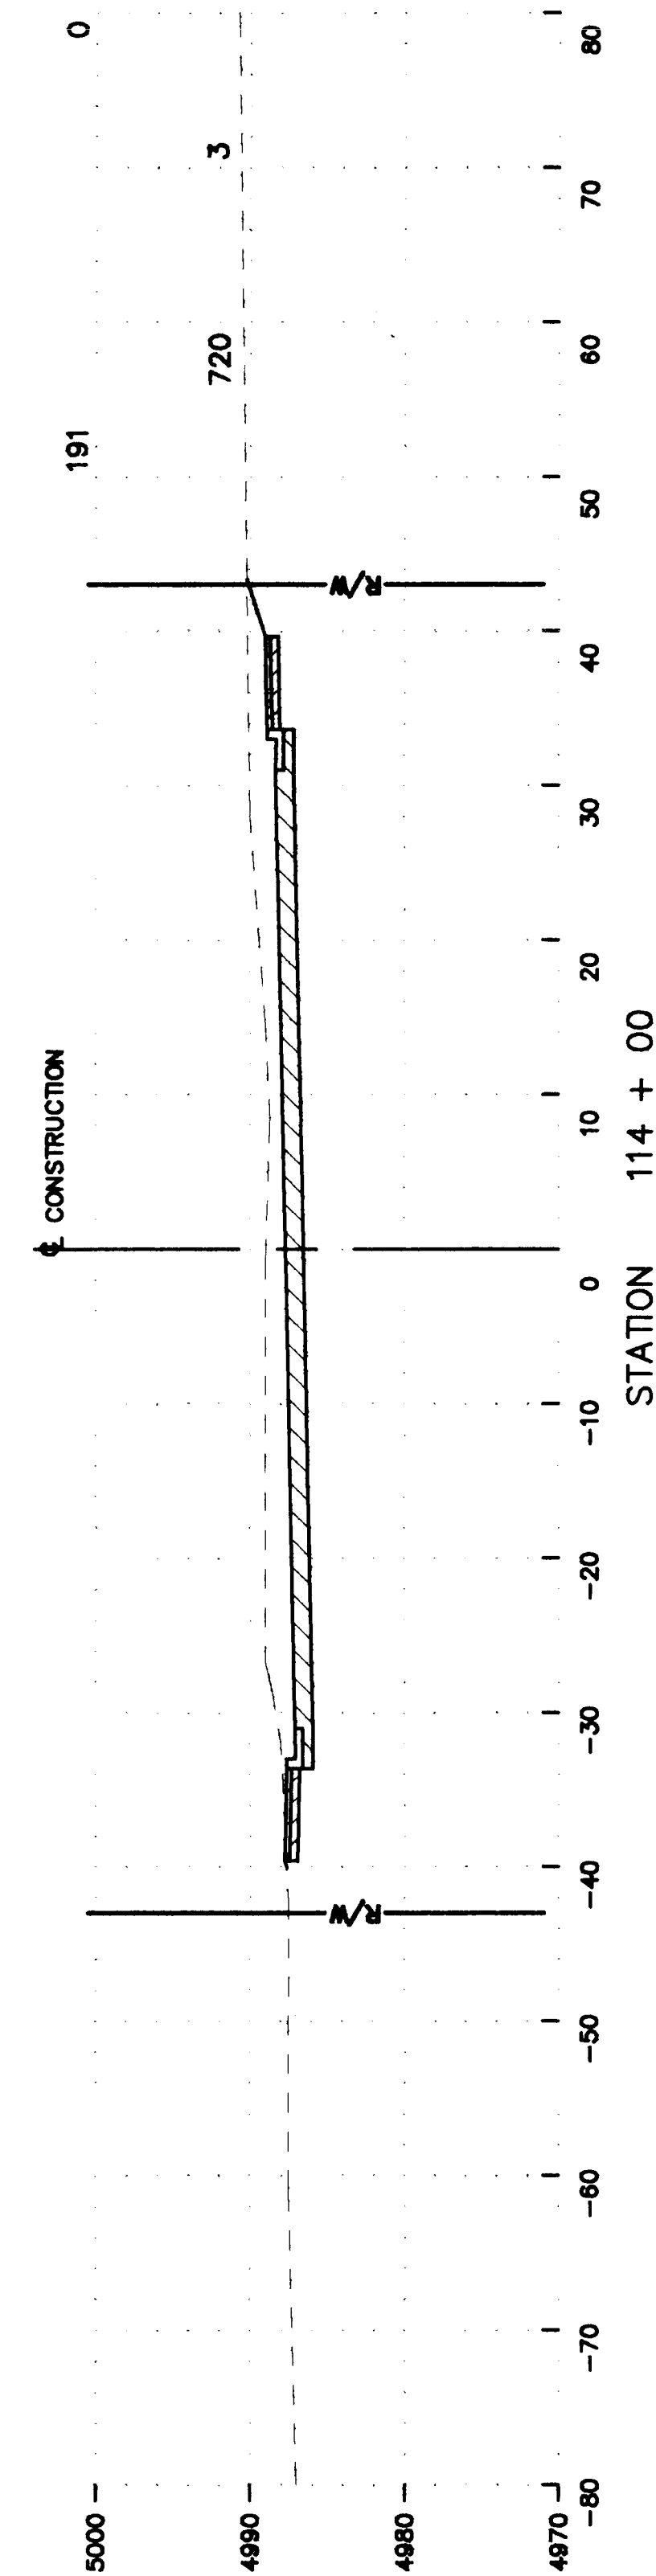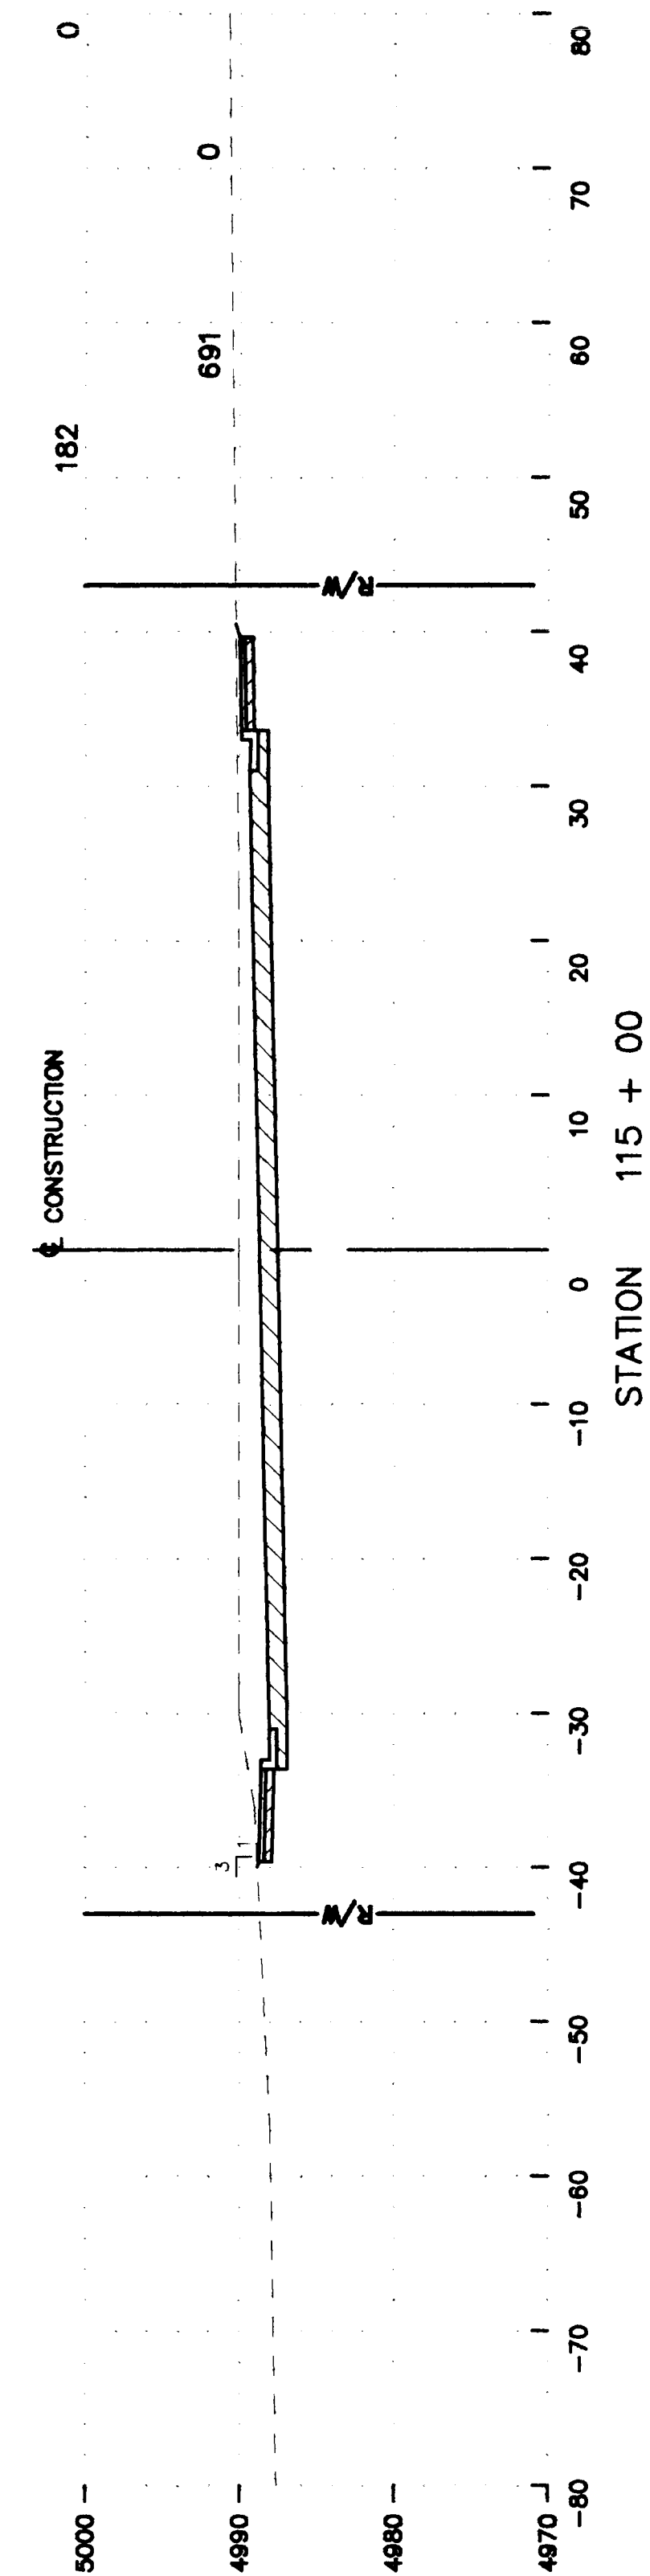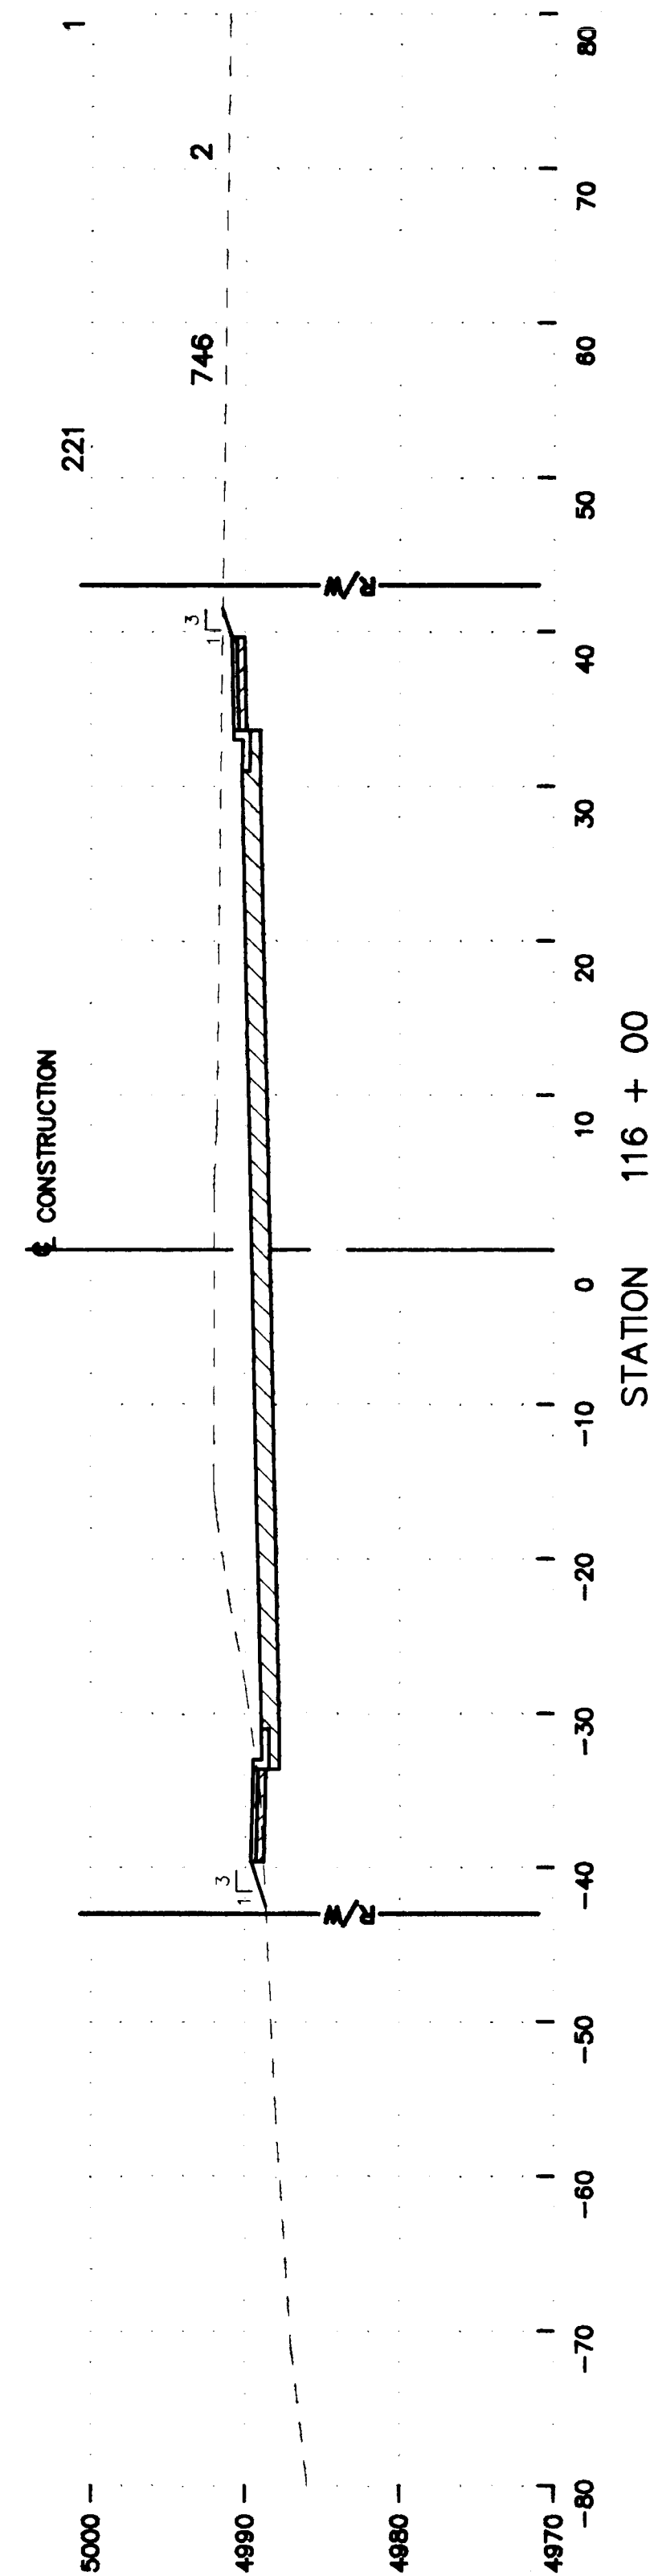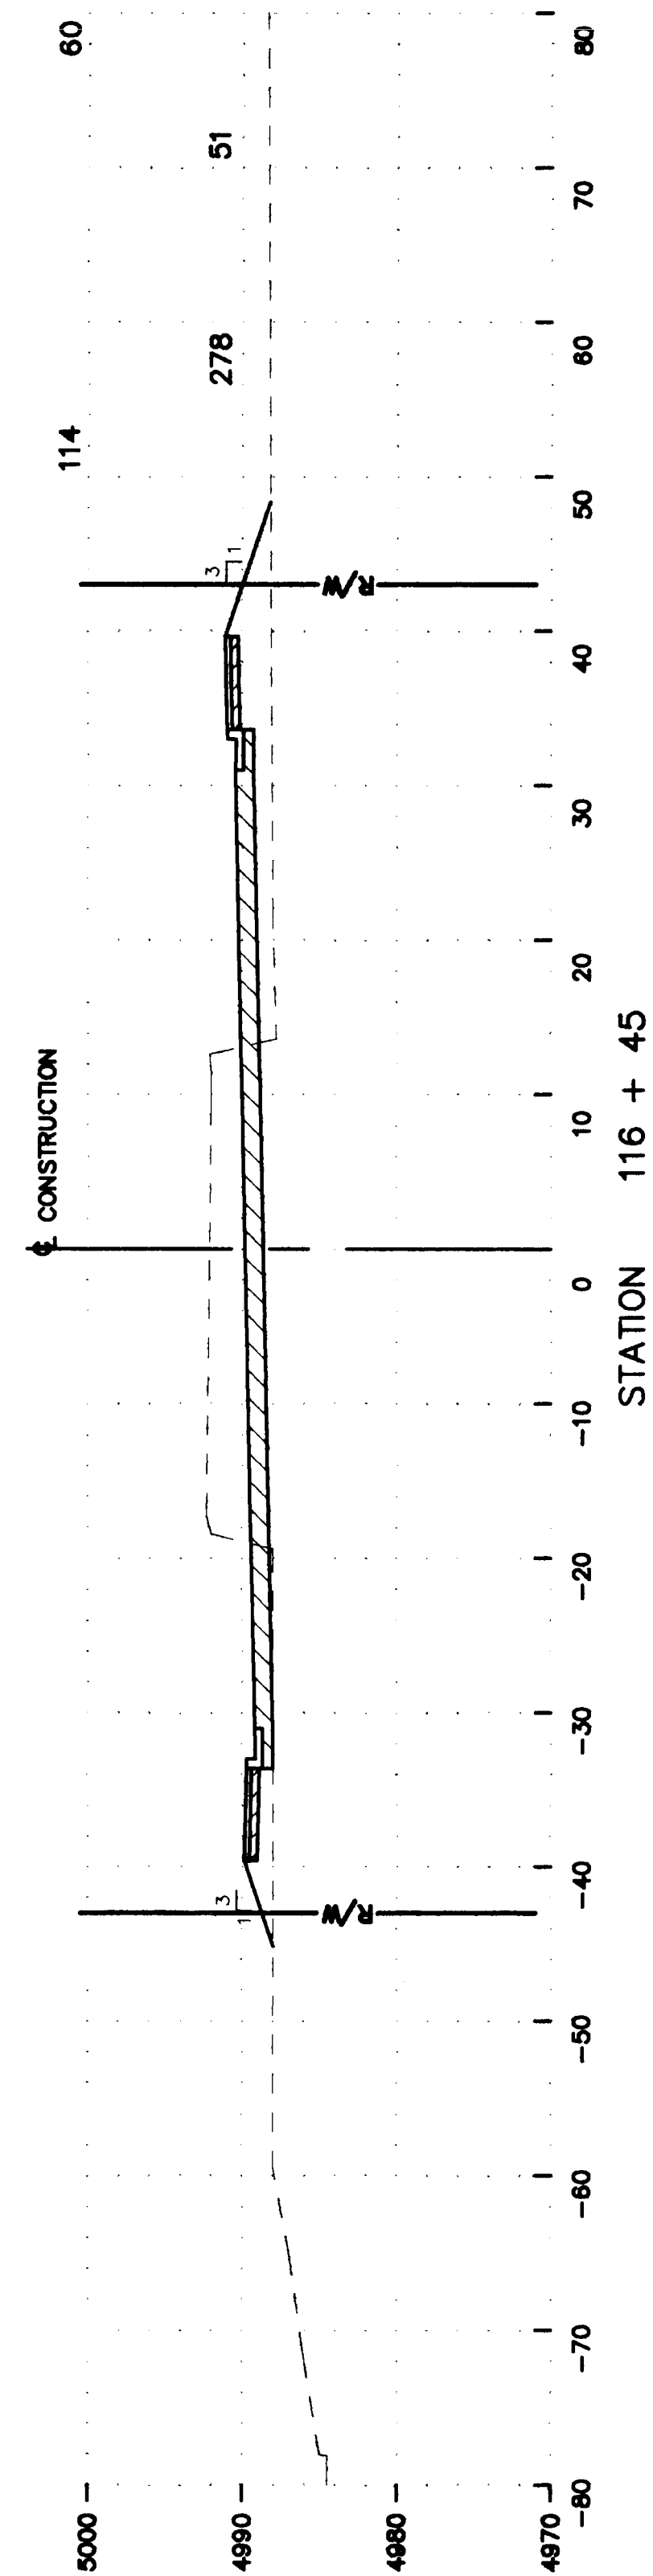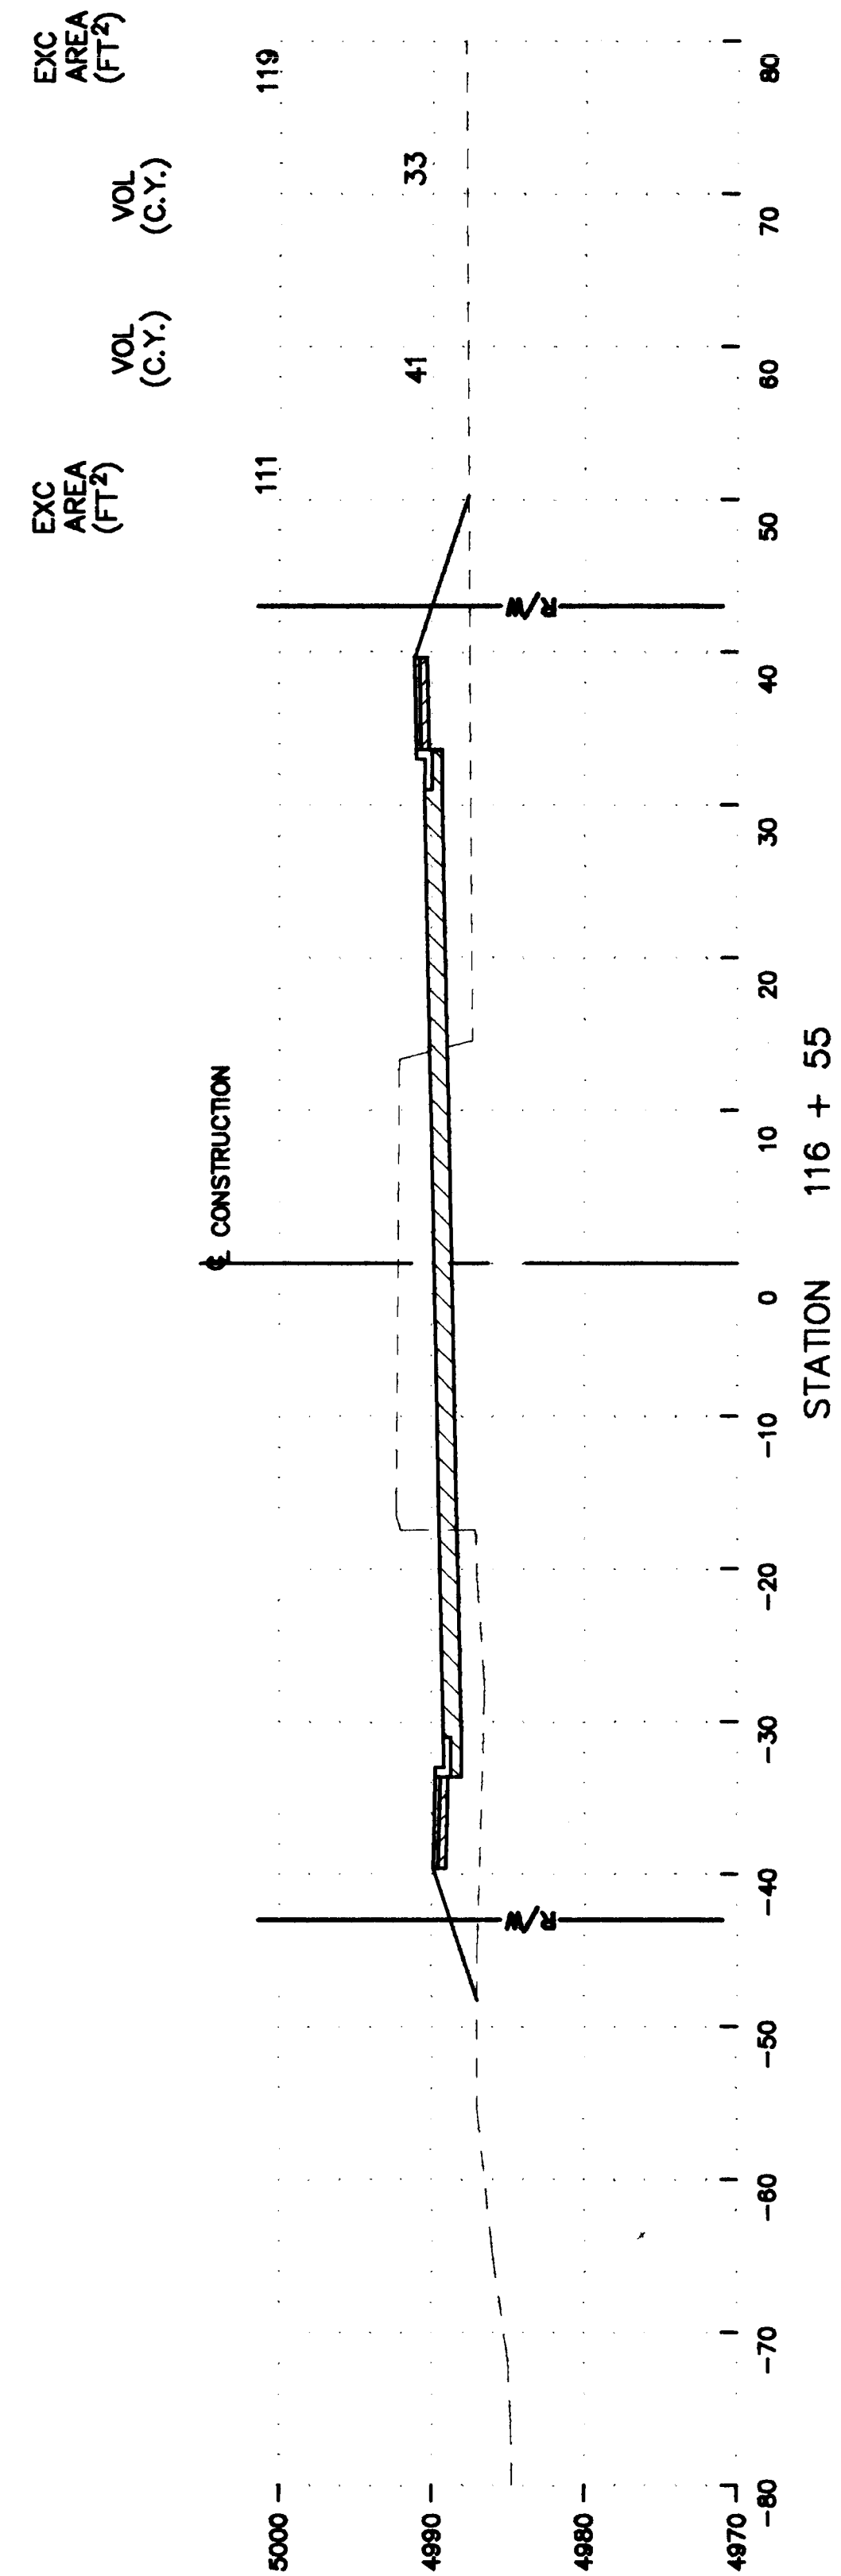


RECORD DRAWING

THIS IS A RECORD DRAWING OF THE FACILITIES IDENTIFIED IN THE TITLE BLOCK ONLY AND HAS BEEN PREPARED IN PART ON THE BASIS OF INFORMATION COMPILED AND FURNISHED BY OTHERS. THE ENGINEER/ARCHITECT AND OTHER (S) WILL NOT BE RESPONSIBLE FOR ANY ERROR (S) OR OMISSION (S) WHICH HAVE BEEN INCORPORATED INTO THIS DRAWING. ACTION TAKEN HEREON AND AT SOME LOCATIONS THE CONDITIONS SHOWN MAY VARY SOMEWHAT FROM THE CONDITIONS MAY BE LARGE. IF THE PRECISE LOCATION OF ANY FACILITY IS REQUIRED, THE FACILITY SHOULD BE FIELD LOCATED IN THE PRESENCE OF AN EMPLOYEE OF THE DISTRICT OR THE OWNER (S) OF THE UTILITIES INVOLVED.

7/21/94

REVISION	DATE	DESCRIPTION	APPV

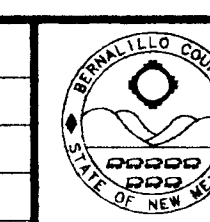

BERNALILLO COUNTY

WIDENING OF EDITH BLVD.

PHASE I

SHEET NO. 12-7

BOYLE
ENGINEERING CORPORATION



COUNTY OF BERNALILLO
NEW MEXICO



F.H.W.A. REGION NO.	STATE	SHEET NO.	TOTAL SHEETS
6	NEW MEXICO	9-12	

CITY OF ALBUQUERQUE PUBLIC WORKS DEPARTMENT ENGINEERING GROUP					
TITLE: SANITARY SEWER SYSTEM PLAN & PROFILE WIDENING OF EDITH BOULEVARD PHASE I					
APPROVALS	ENGINEER	DATE	APPROVALS	ENGINEER	DATE
COA	<i>[Signature]</i>	11/10/93			
WASTE WATER					
BERNALILLO COUNTY					
PROJECT NO.	3675.93	MAP NO.	E-15	SHEET OF	

GENERAL NOTES:

- ALL WORK SHALL CONFORM TO THE CITY OF ALBUQUERQUE STANDARD SPECIFICATIONS FOR PUBLIC WORKS CONSTRUCTION AND ADOPTED AMENDMENTS, REVISED FEBRUARY 16, 1993.
- CONSTRUCT SEWER IN SECOND STREET IN HALF WIDTH WHILE MAINTAINING AT LEAST ONE LANE IN EACH DIRECTION AT ALL TIMES.
- ALL TRAFFIC CONTROL PROCEDURES SHALL CONFORM TO EDITH BOULEVARD PHASE I REQUIREMENTS.
- ANY WORK TO BE PERFORMED WITHIN THE MIDDLE RIO GRANDE CONSERVANCY DISTRICT (M.R.G.C.D.) RIGHT-OF-WAY SHALL BE CLOSELY COORDINATED WITH THE M.R.G.C.D.; CALL 247-0234. NO WORK IS TO BE DONE ON FACILITIES OR STRUCTURES BELONGING TO, OR OPERATED BY, THE M.R.G.C.D. BETWEEN MARCH 1 AND OCTOBER 31 INCLUSIVE. HOWEVER, WORK MAY BE PERMITTED BY THE M.R.G.C.D. IF IT CAN BE SHOWN THAT THE WORK WILL NOT INTERFERE WITH OPERATIONS OF THE M.R.G.C.D. FACILITY. ALL WORK TO BE DONE WITHIN THE M.R.G.C.D. FACILITIES MUST BE APPROVED BY THE M.R.G.C.D. ENGINEER PRIOR TO COMMENCING WORK. THE CONTRACTOR SHALL NOT STORE EQUIPMENT, NEW MATERIAL OR DEBRIS WITHIN DISTRICT RIGHT-OF-WAY WHICH MAY INTERFERE WITH OPERATIONS AND MAINTENANCE OF THE M.R.G.C.D. FACILITY. THE CONTRACTOR SHALL NOT SERVICE VEHICLES OR STORE EQUIPMENT WITHIN DISTRICT RIGHT-OF-WAY.
- STATIONING FOR CONCRETE LINED CHANNEL IS OFFSET FROM SEWER PIPE STATIONING.
- MISCELLANEOUS VEGETATION AND SMALL TREES WITHIN RIGHT-OF-WAY ALONG ENTIRE SEWER PIPE ROUTE SHALL BE CLEARED AND DISPOSED OF BY CONTRACTOR DURING THE CONSTRUCTION PROCESS. LARGE TREE TREATMENT SHALL BE AS NOTED ON SHEETS 9-13 AND 9-14.
- ALL DISTURBED AREAS OUTSIDE THE MAINTENANCE ROAD AND CONCRETE LINED CHANNEL MUST BE RESEEDED WITH NATIVE GRASSES AS PER M.R.G.C.D. SPECIFICATION ATTACHED.
- THE 2" GRAVEL SURFACING FOR THE NEW ACCESS ROAD SHALL BE PROCESSED NATURAL MATERIAL WITH GRADATION REQUIREMENTS CONFORMING TO COA STANDARD SPECIFICATION SECTION 308.

MATCHLINE STA. 4+45.00 SEE SHEET 9-13

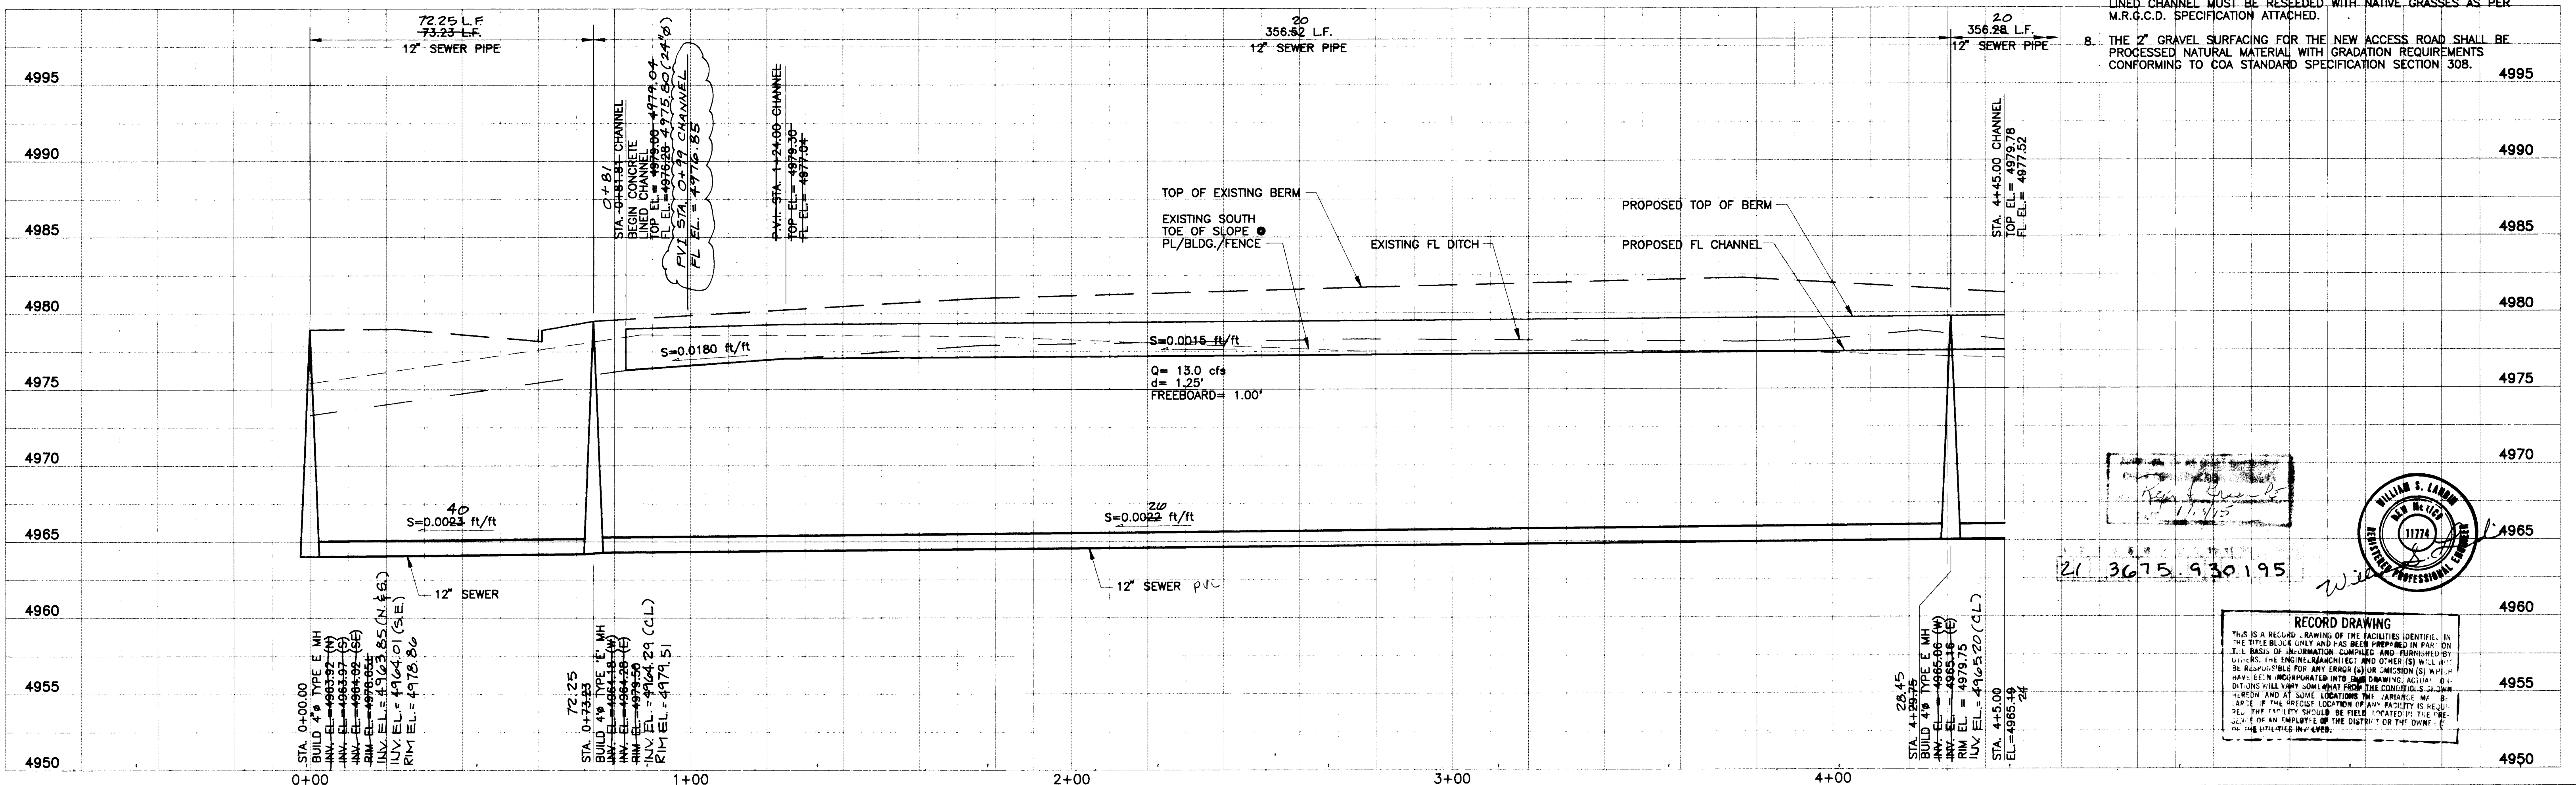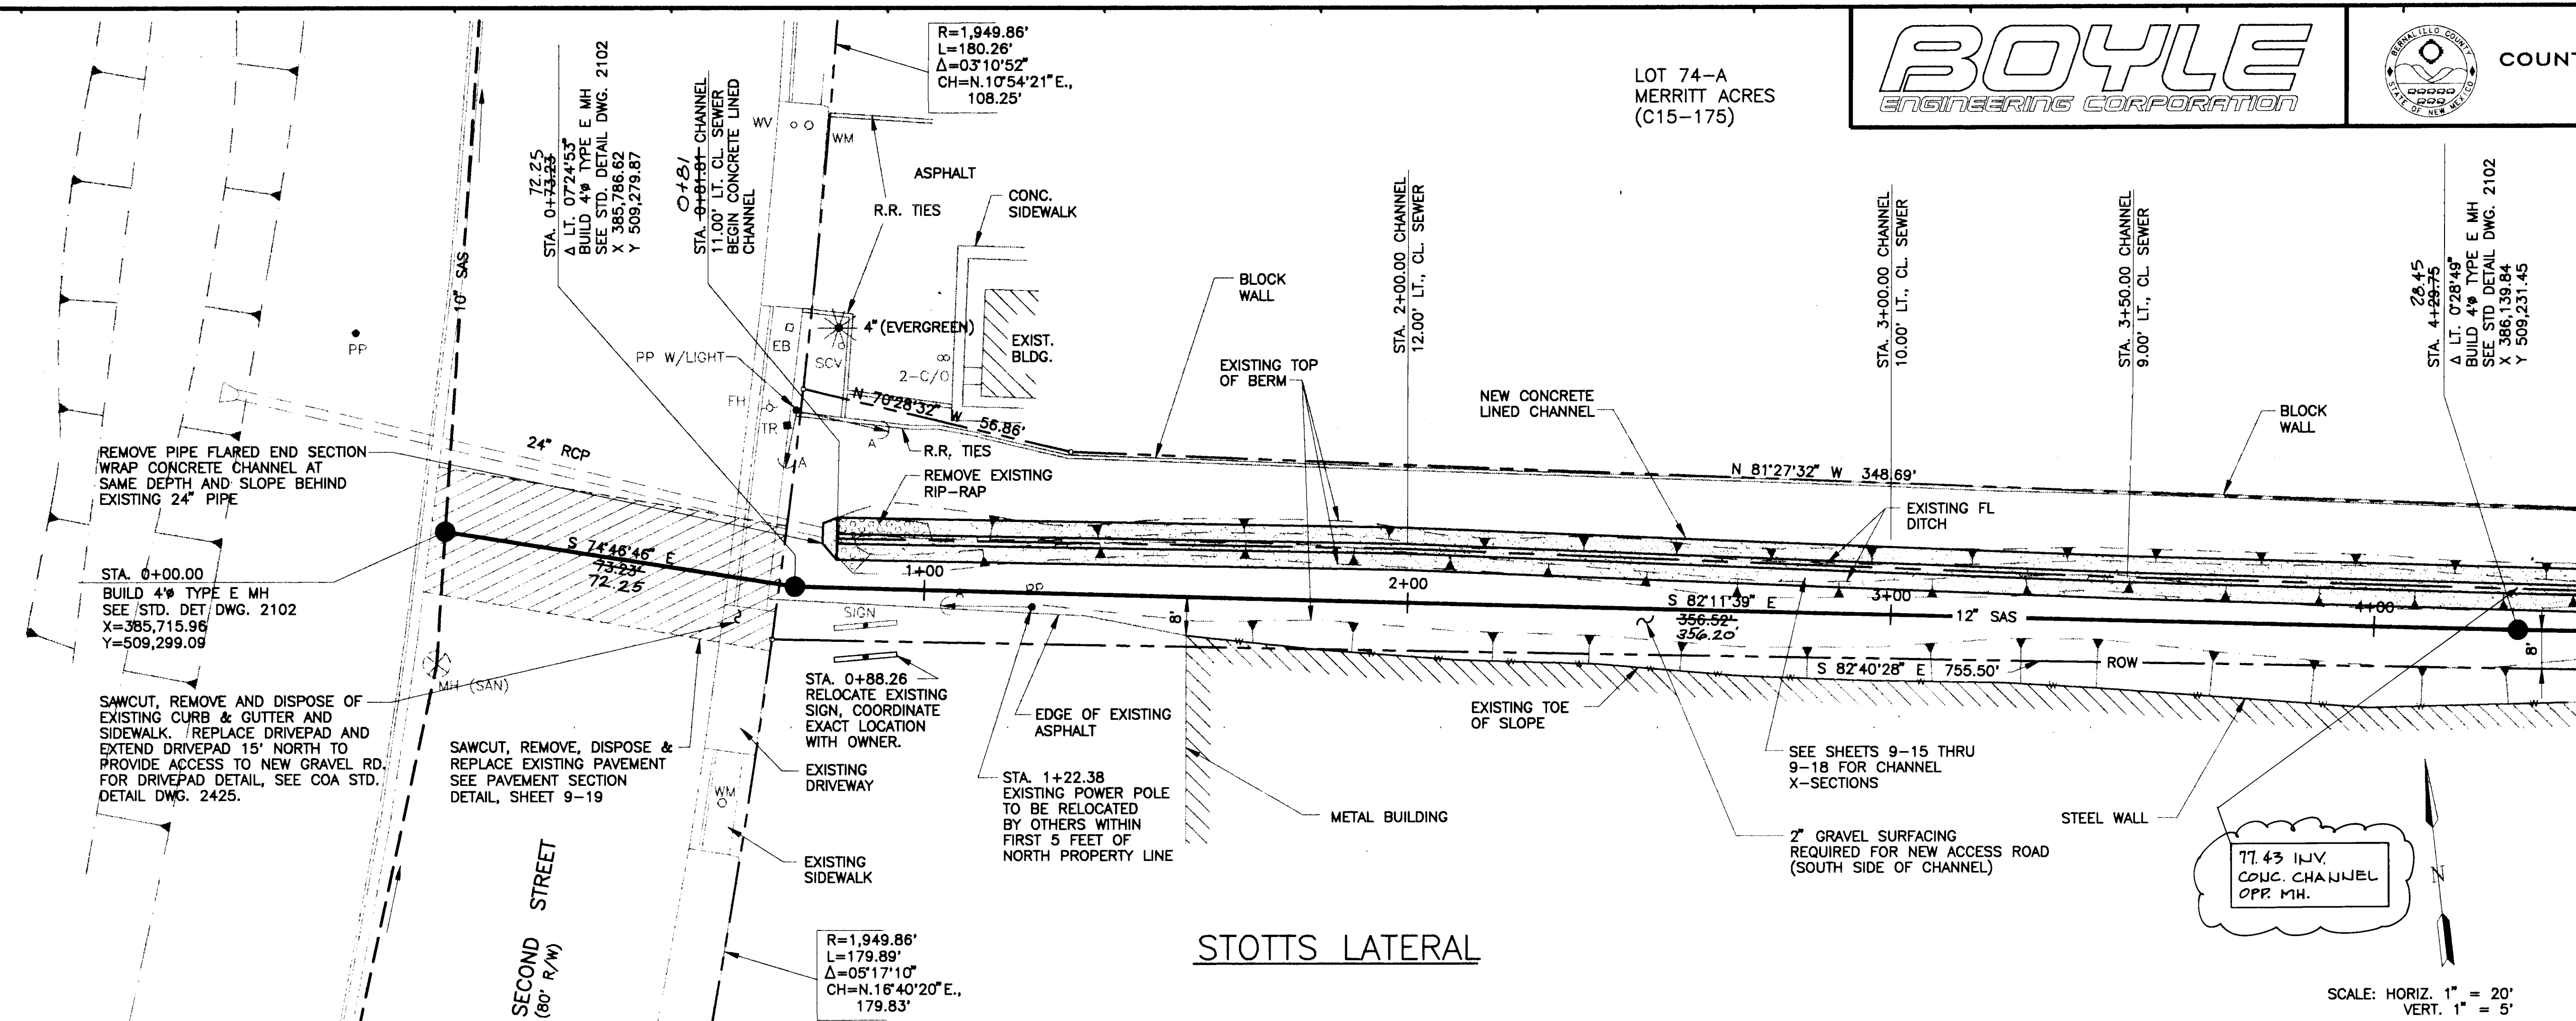

21 3675.930.195

[Signature]

11/10/93





RECORD DRAWING

THIS IS A RECORD DRAWING OF THE FACILITIES IDENTIFIED IN THE TITLE BLOCK ONLY AND HAS BEEN PREPARED IN PART OR IN WHOLE BY THE ENGINEER/ARCHITECT AND OTHER(S) WHO HAVE BEEN RESPONSIBLE FOR ANY LEGAL ACTION (S) WHICH HAVE BEEN INCORPORATED INTO THE DRAWING. ANY CHANGES WILL VARY FROM THE ORIGINALS. THE CONTRACTOR SHALL BE RESPONSIBLE FOR THE LOCATION OF ANY FACILITY IS BEING LOCATED. THE FACILITY SHOULD BE FIELD LOCATED BY THE ENGINEER OR AN EMPLOYEE OF THE DISTRICT OR THE OWNER. THE FACILITY IS NOT TO BE LOCATED BY THE CONTRACTOR.

NOTE:

 TREES TO REMAIN AND BE PROTECTED BY CONTRACTOR DURING CONSTRUCTION.

 TREES TO BE CUT DOWN BY OTHERS PRIOR TO CONSTRUCTION. CONTRACTOR TO REMOVE AND DISPOSE OF TREE STUMPS DURING PROCESS OF CONSTRUCTION.

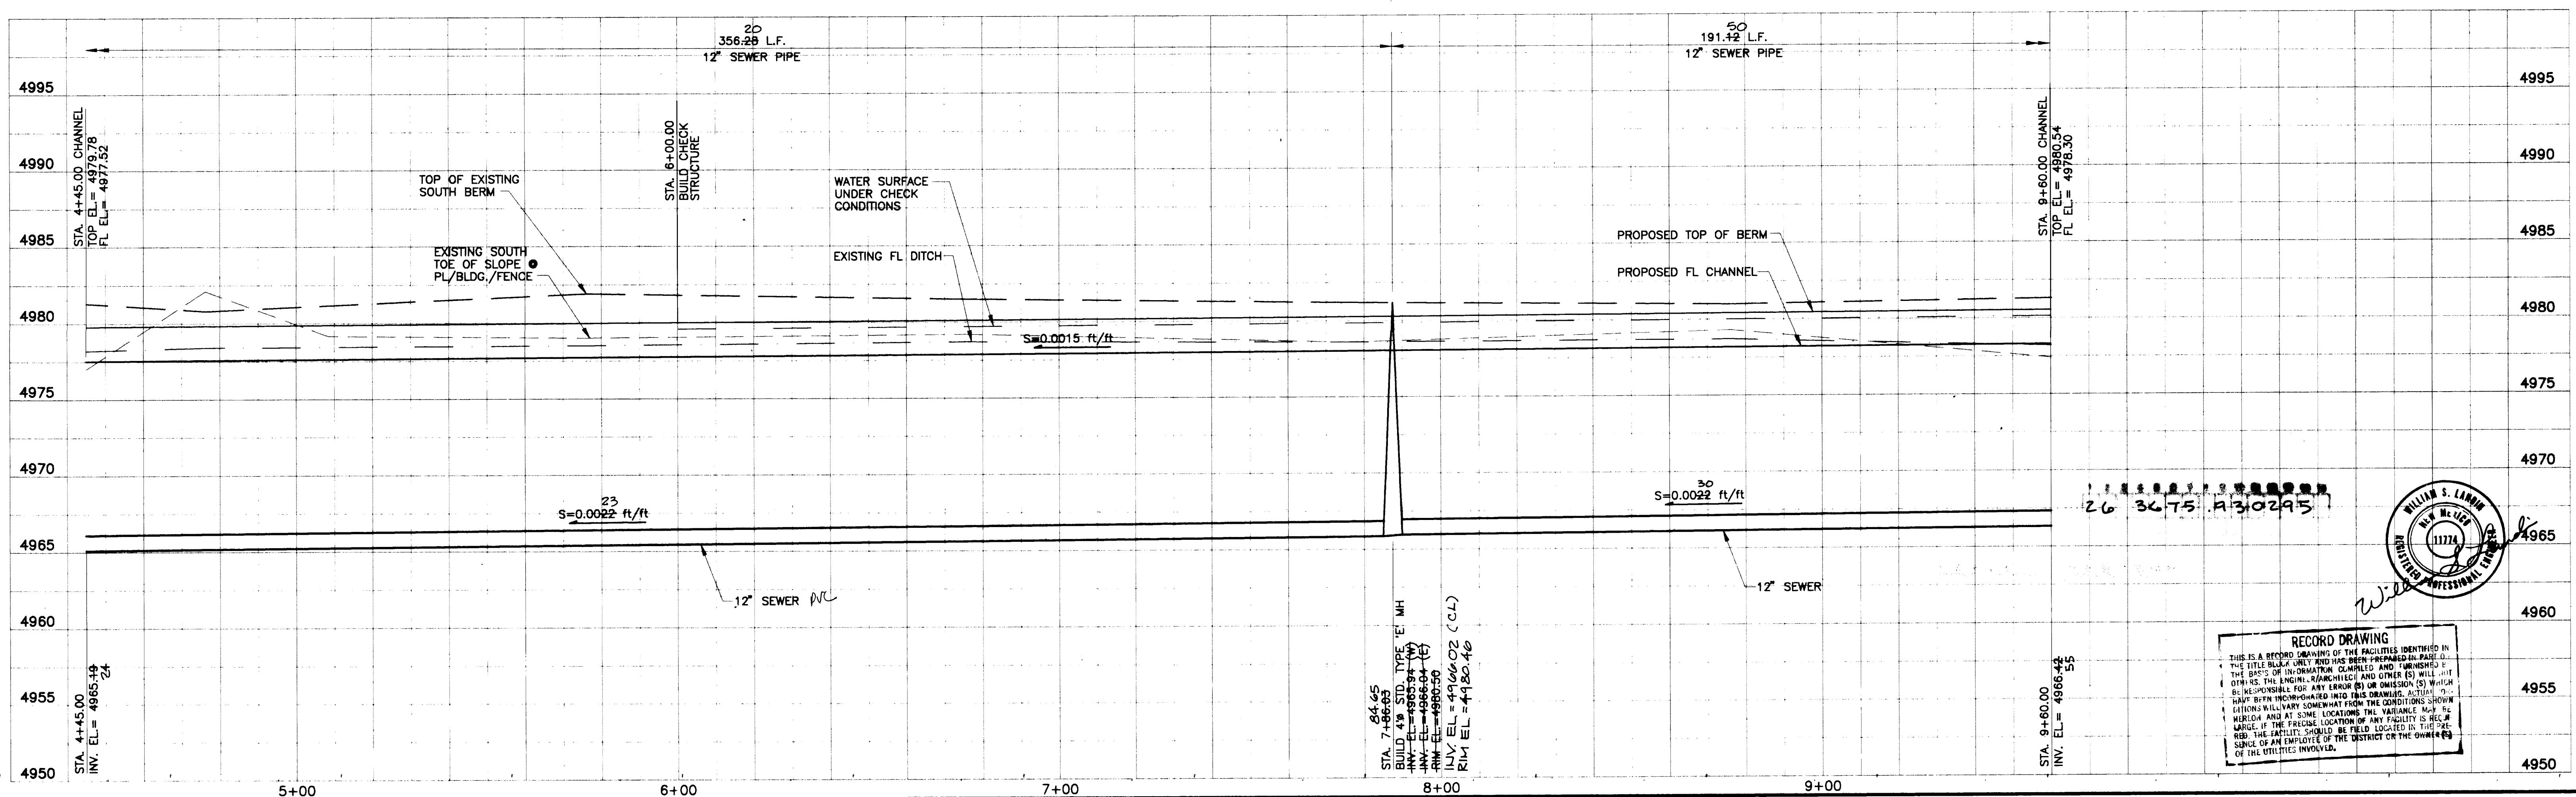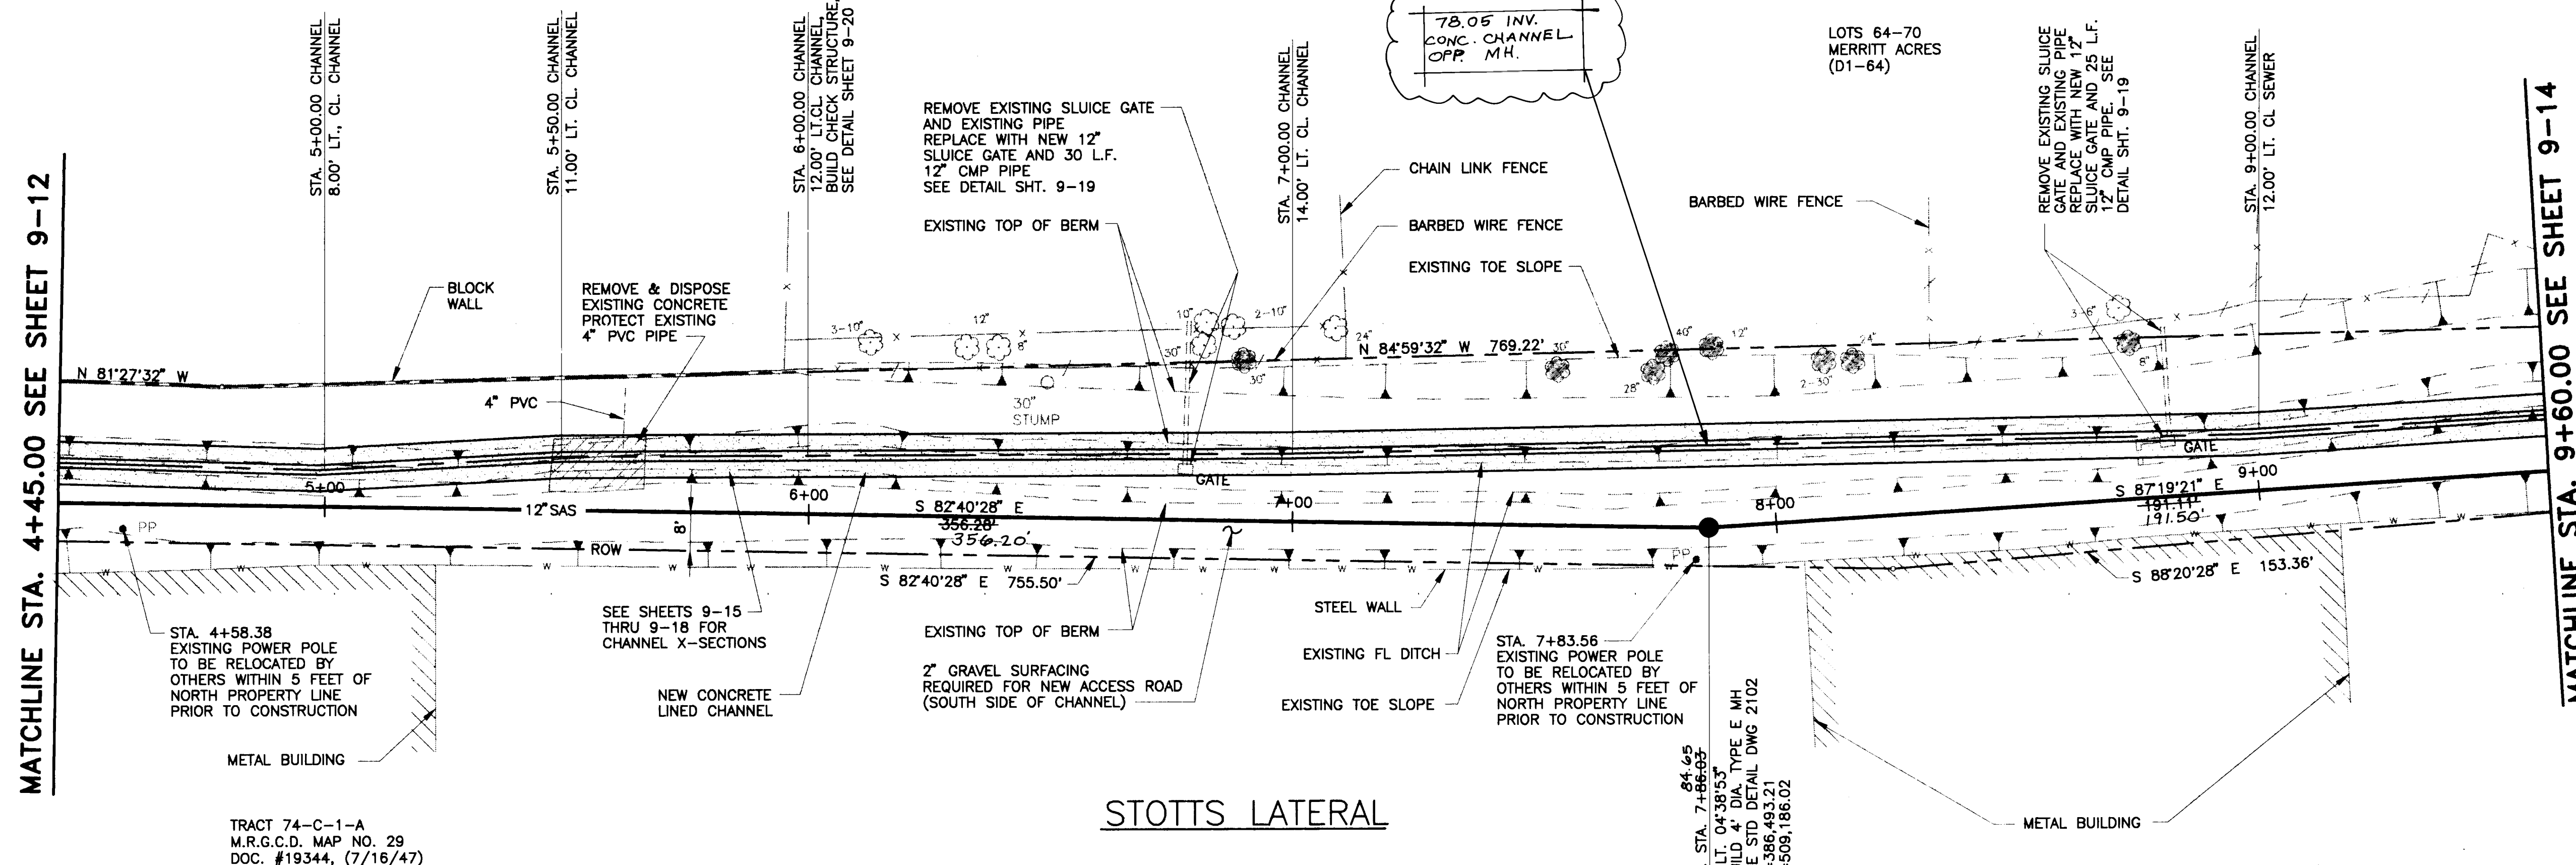


FILE SPECIFICATION
D:\EDITH\STOTTS\EB0914P2









OPERATOR
ALB/MIKEY

PLOT DATE
11/10/93

PLOT SCALE
1"=20'

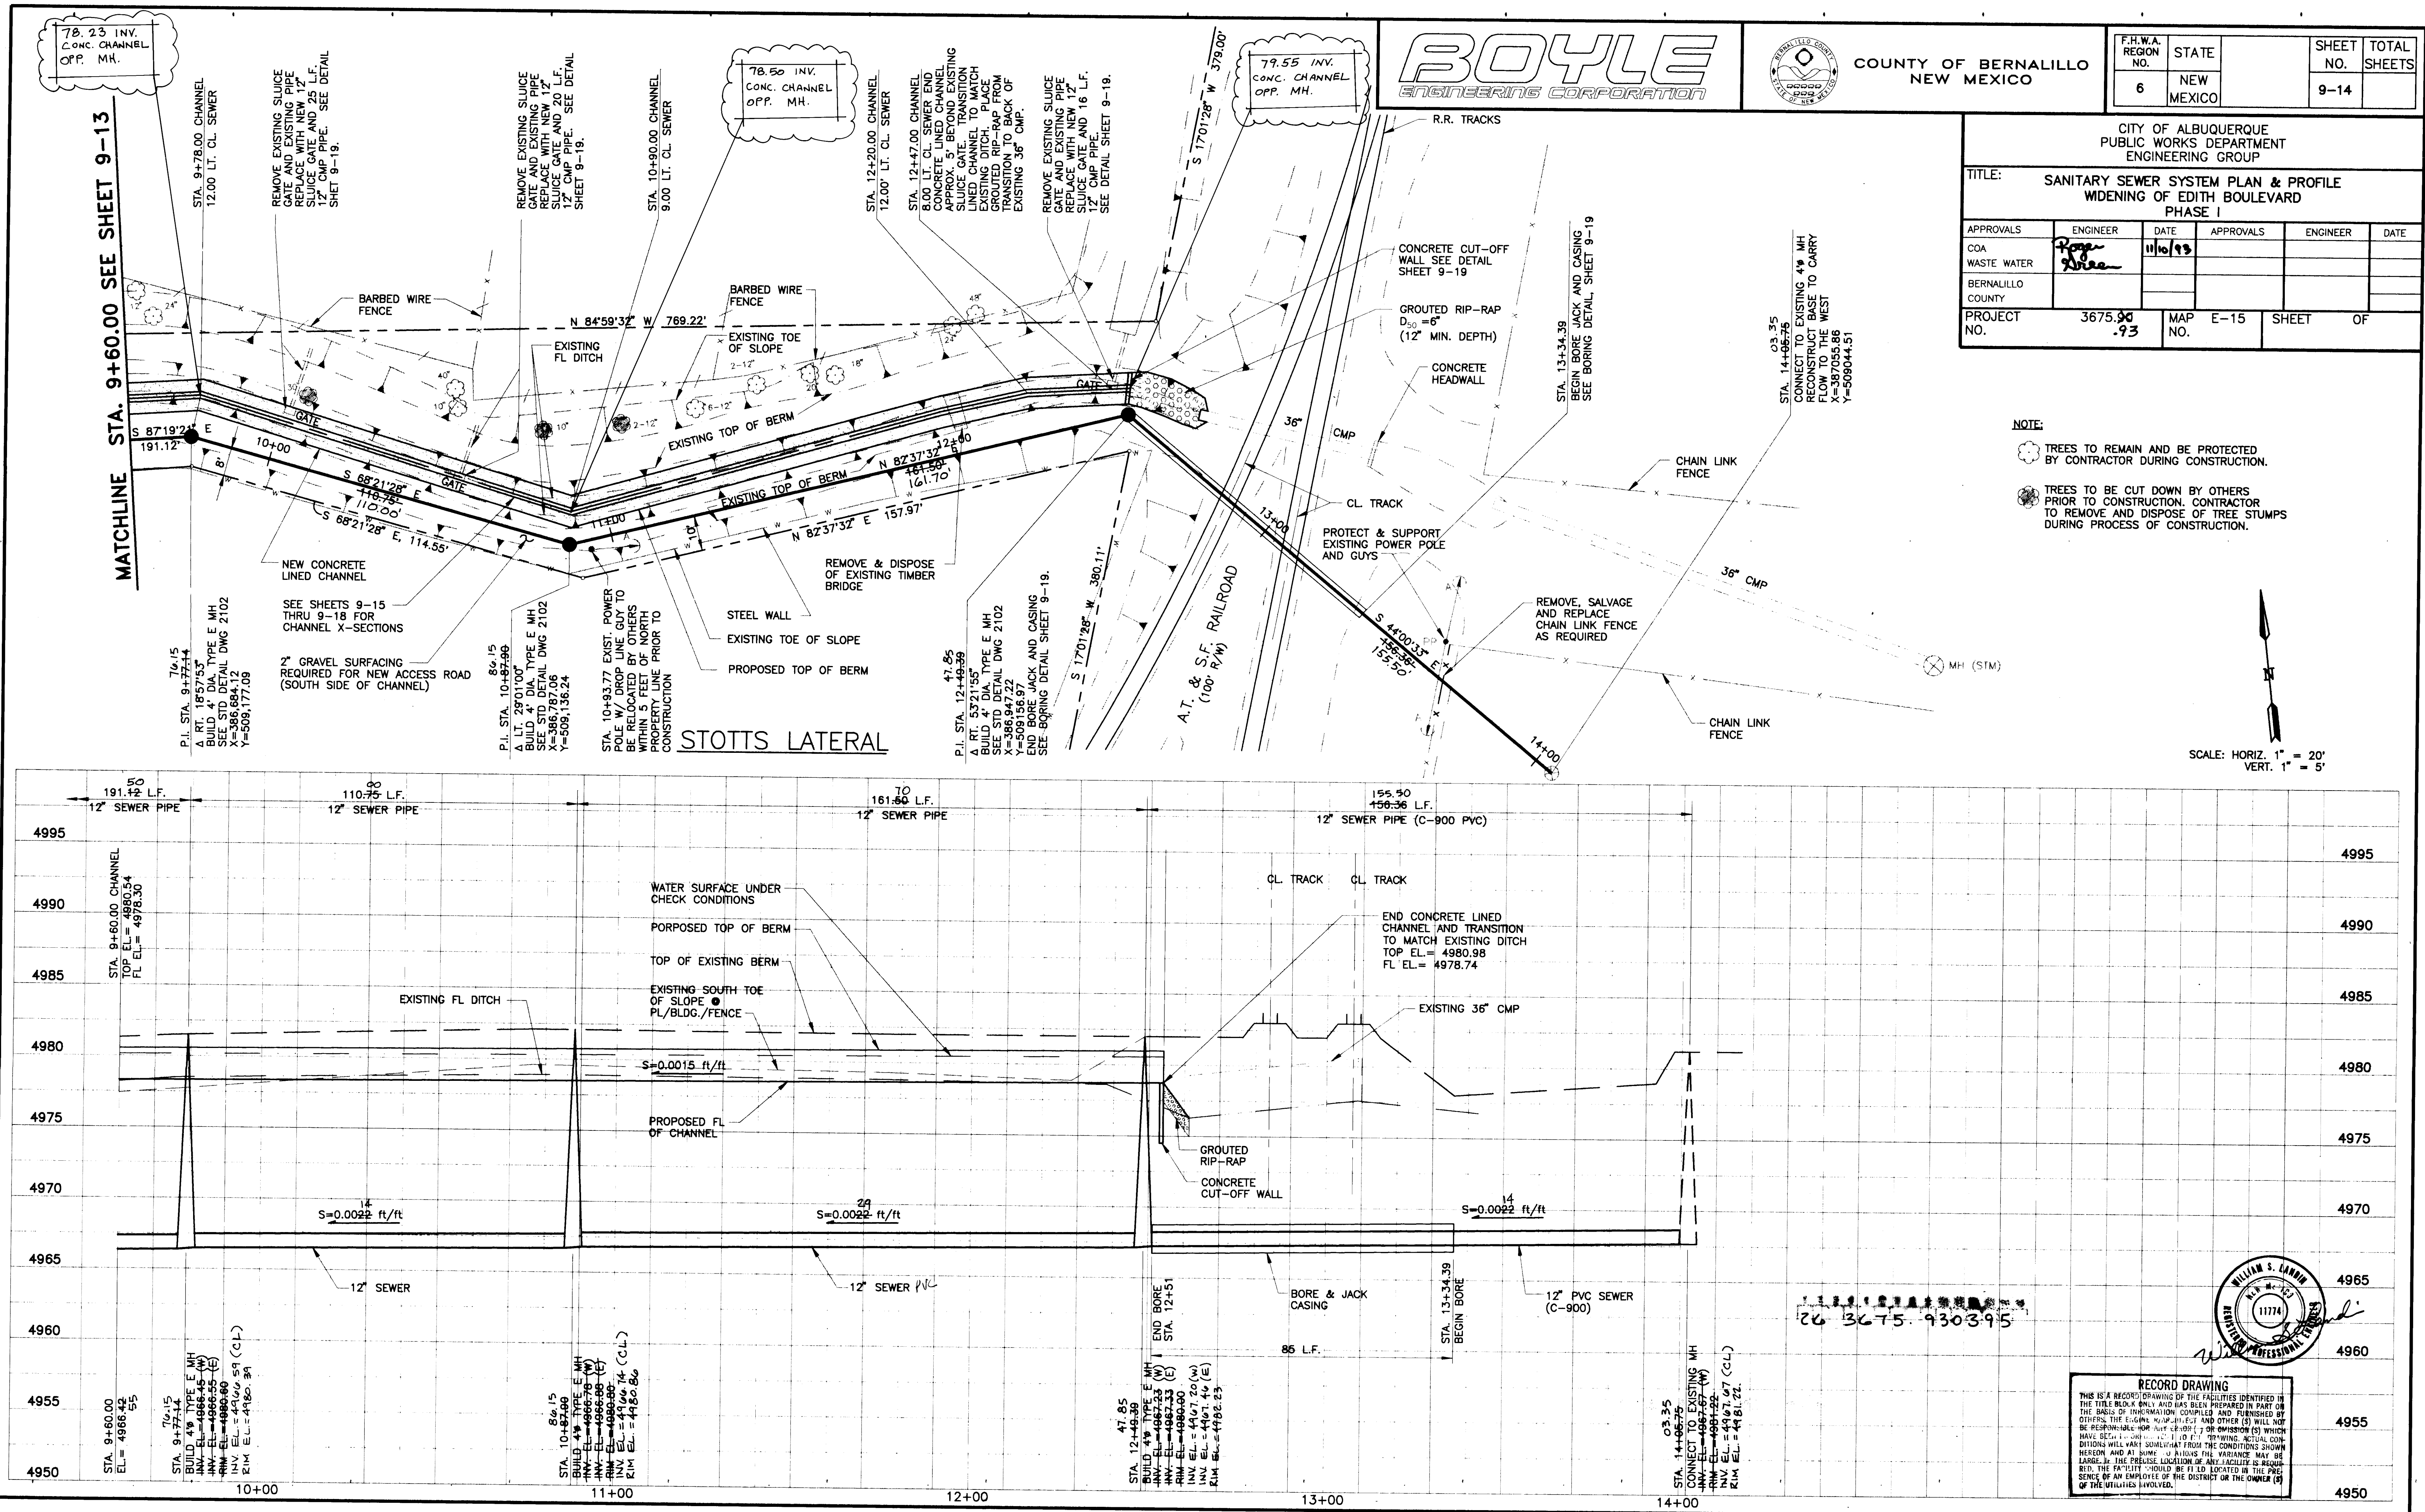


CITY OF ALBUQUERQUE PUBLIC WORKS DEPARTMENT ENGINEERING GROUP					
TITLE: STOTTS LATERAL CROSS SECTIONS WIDENING OF EDITH BOULEVARD PHASE I					
APPROVALS	ENGINEER	DATE	APPROVALS	ENGINEER	DATE
COA WASTE WATER	<i>R. J. [Signature]</i>	11/10/93			
BERNALILLO COUNTY					
PROJECT NO.	3675.93	MAP NO.	E-15	SHEET OF	

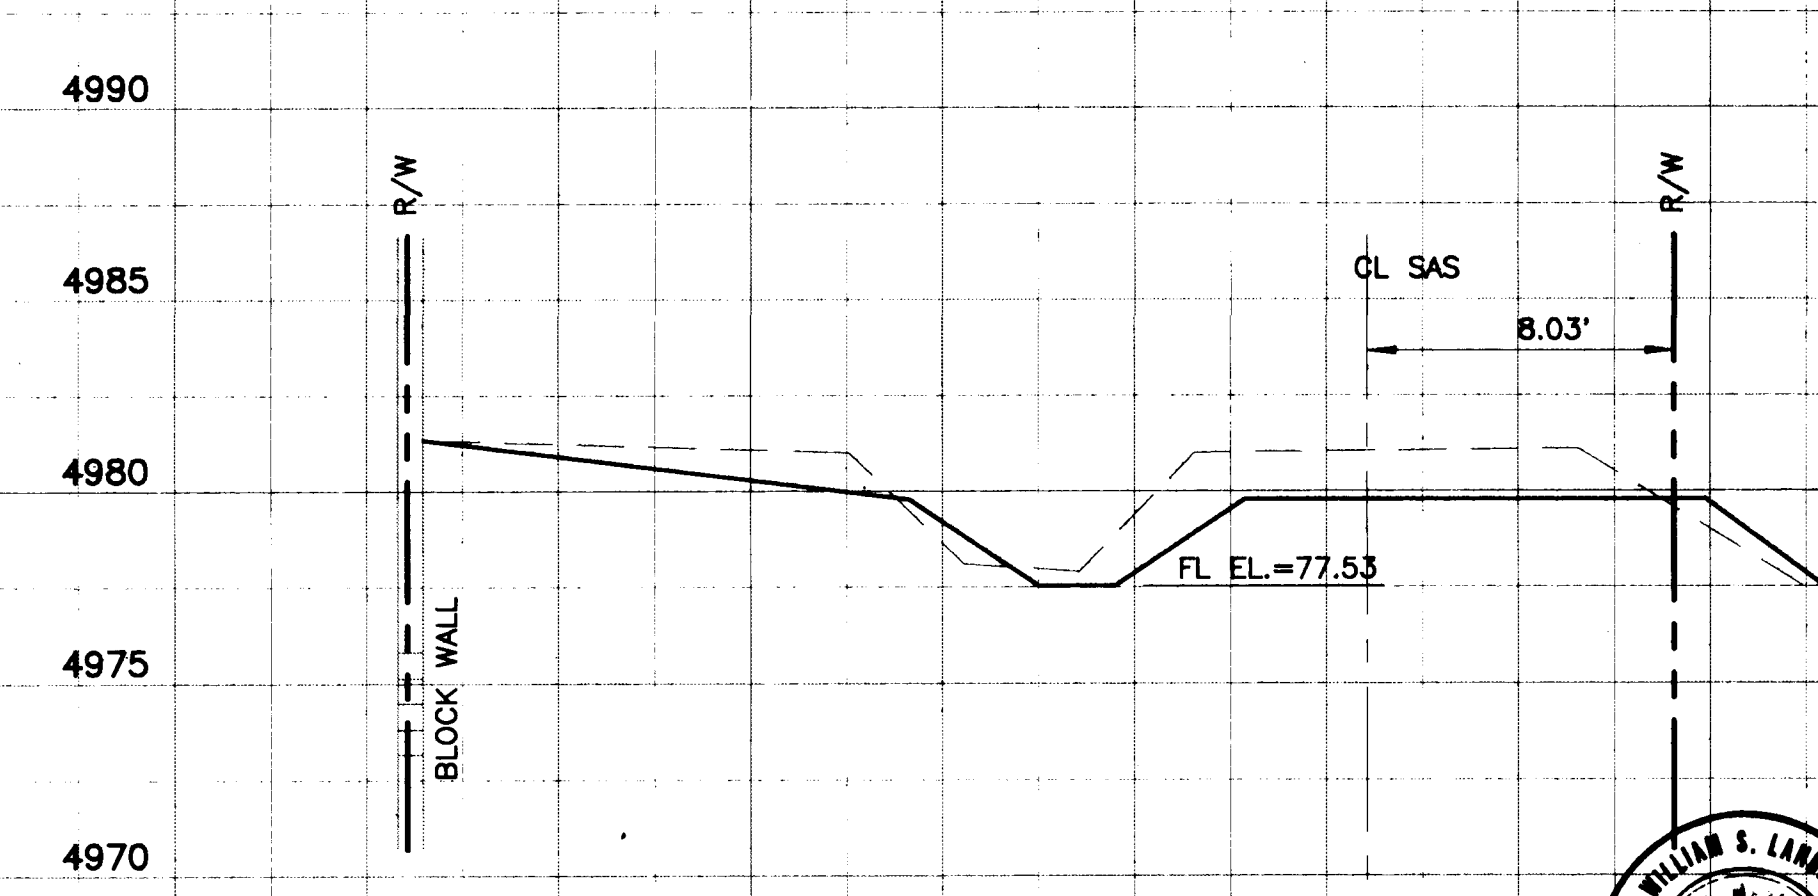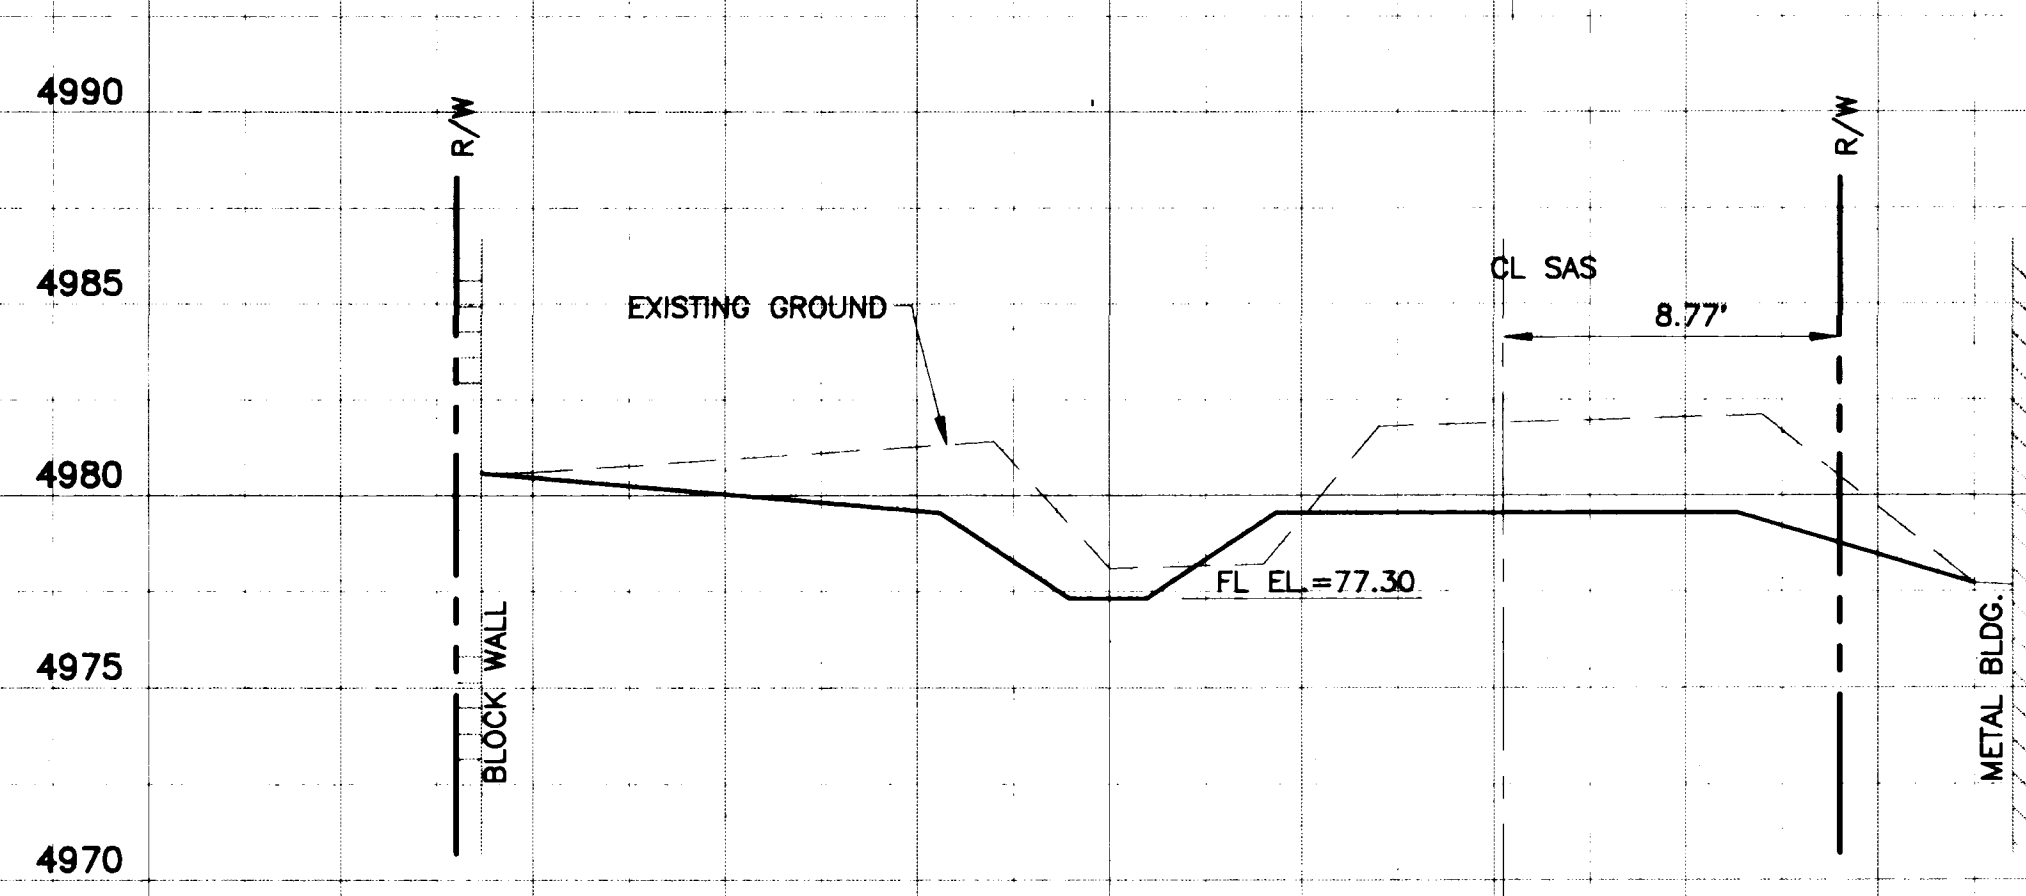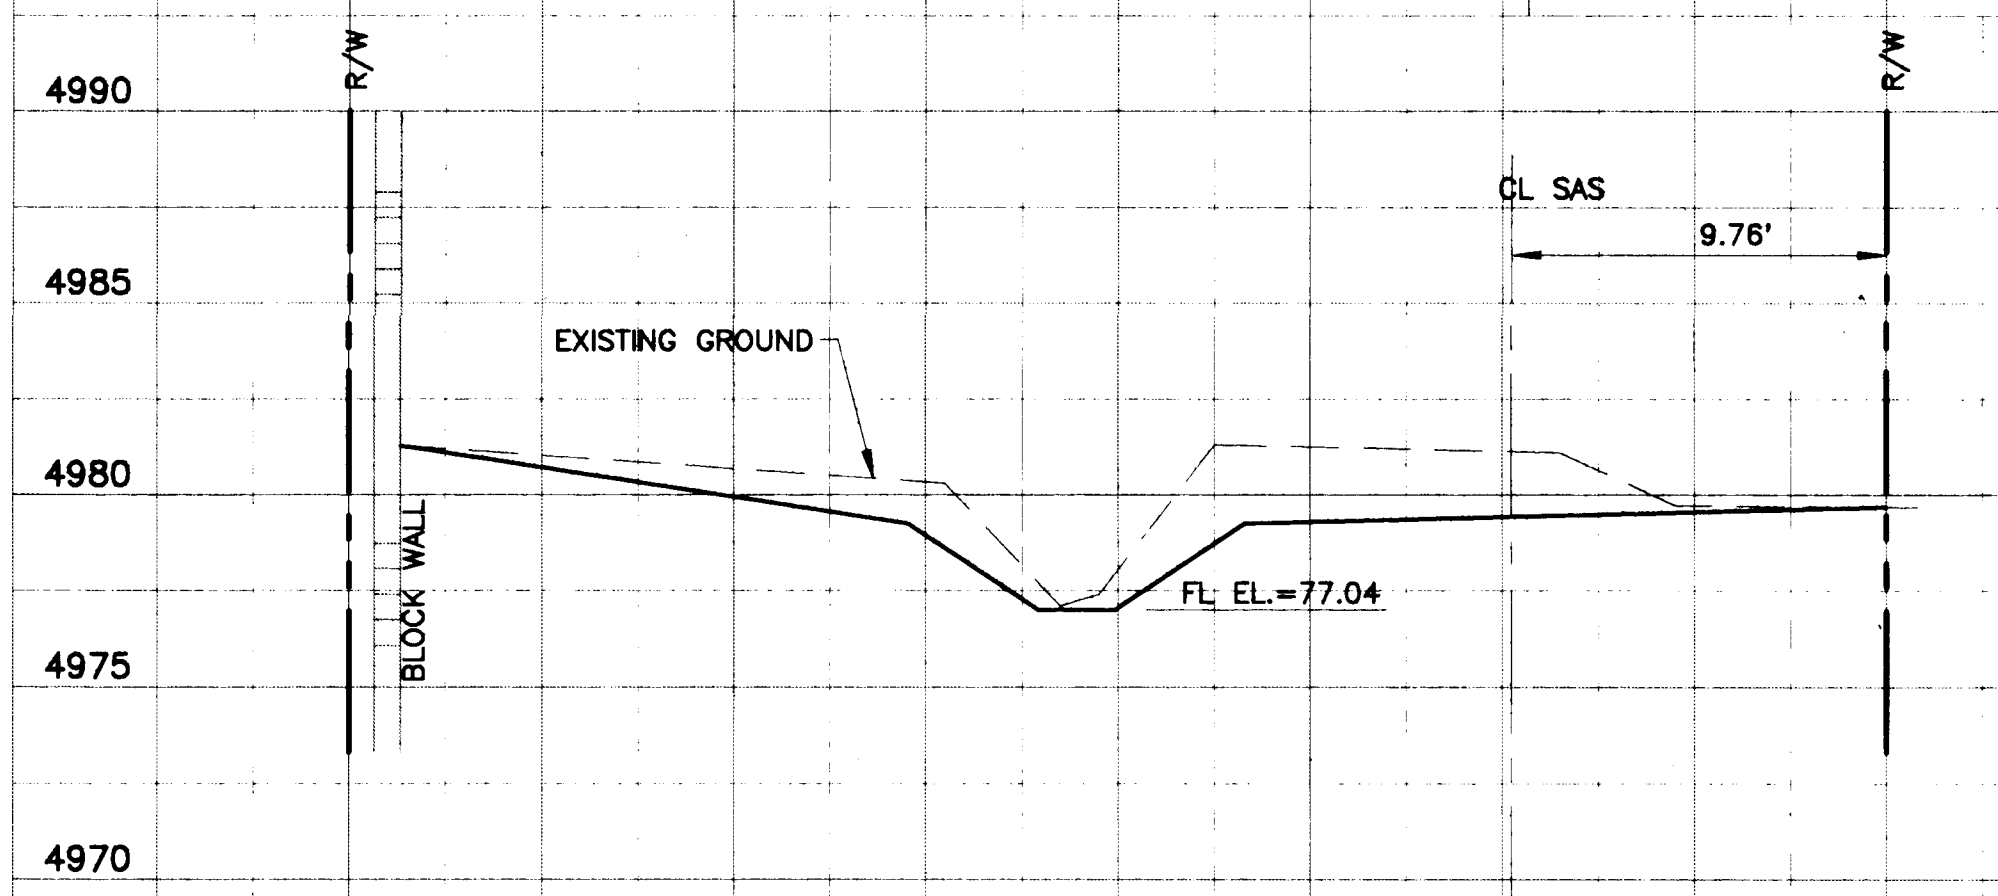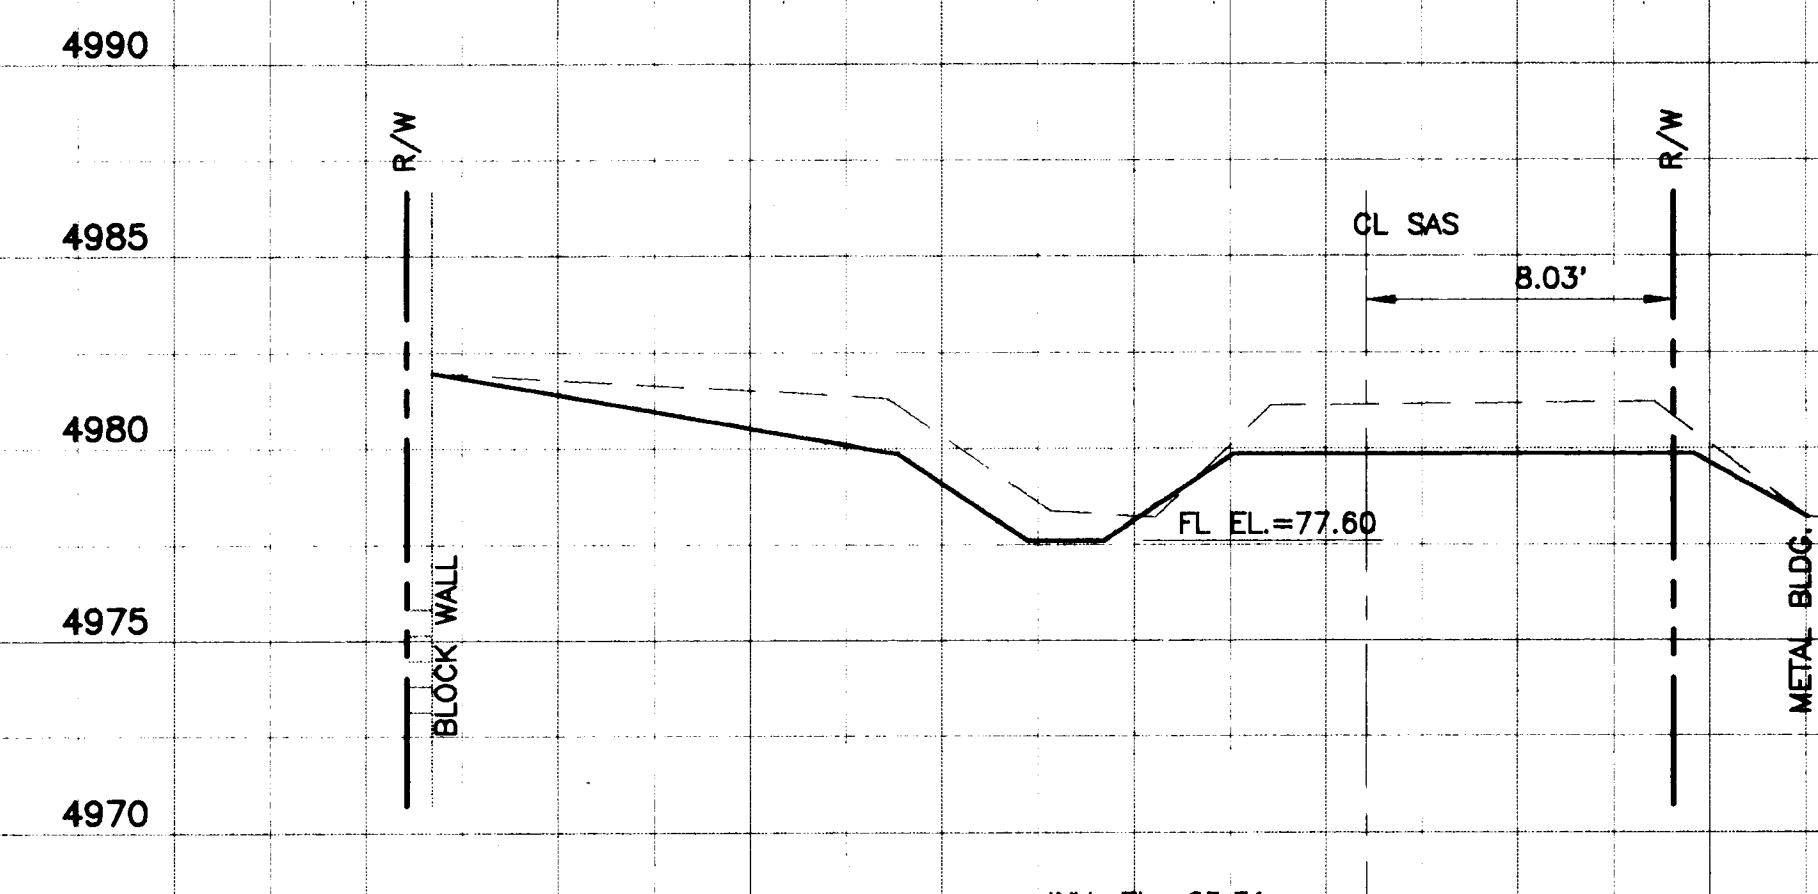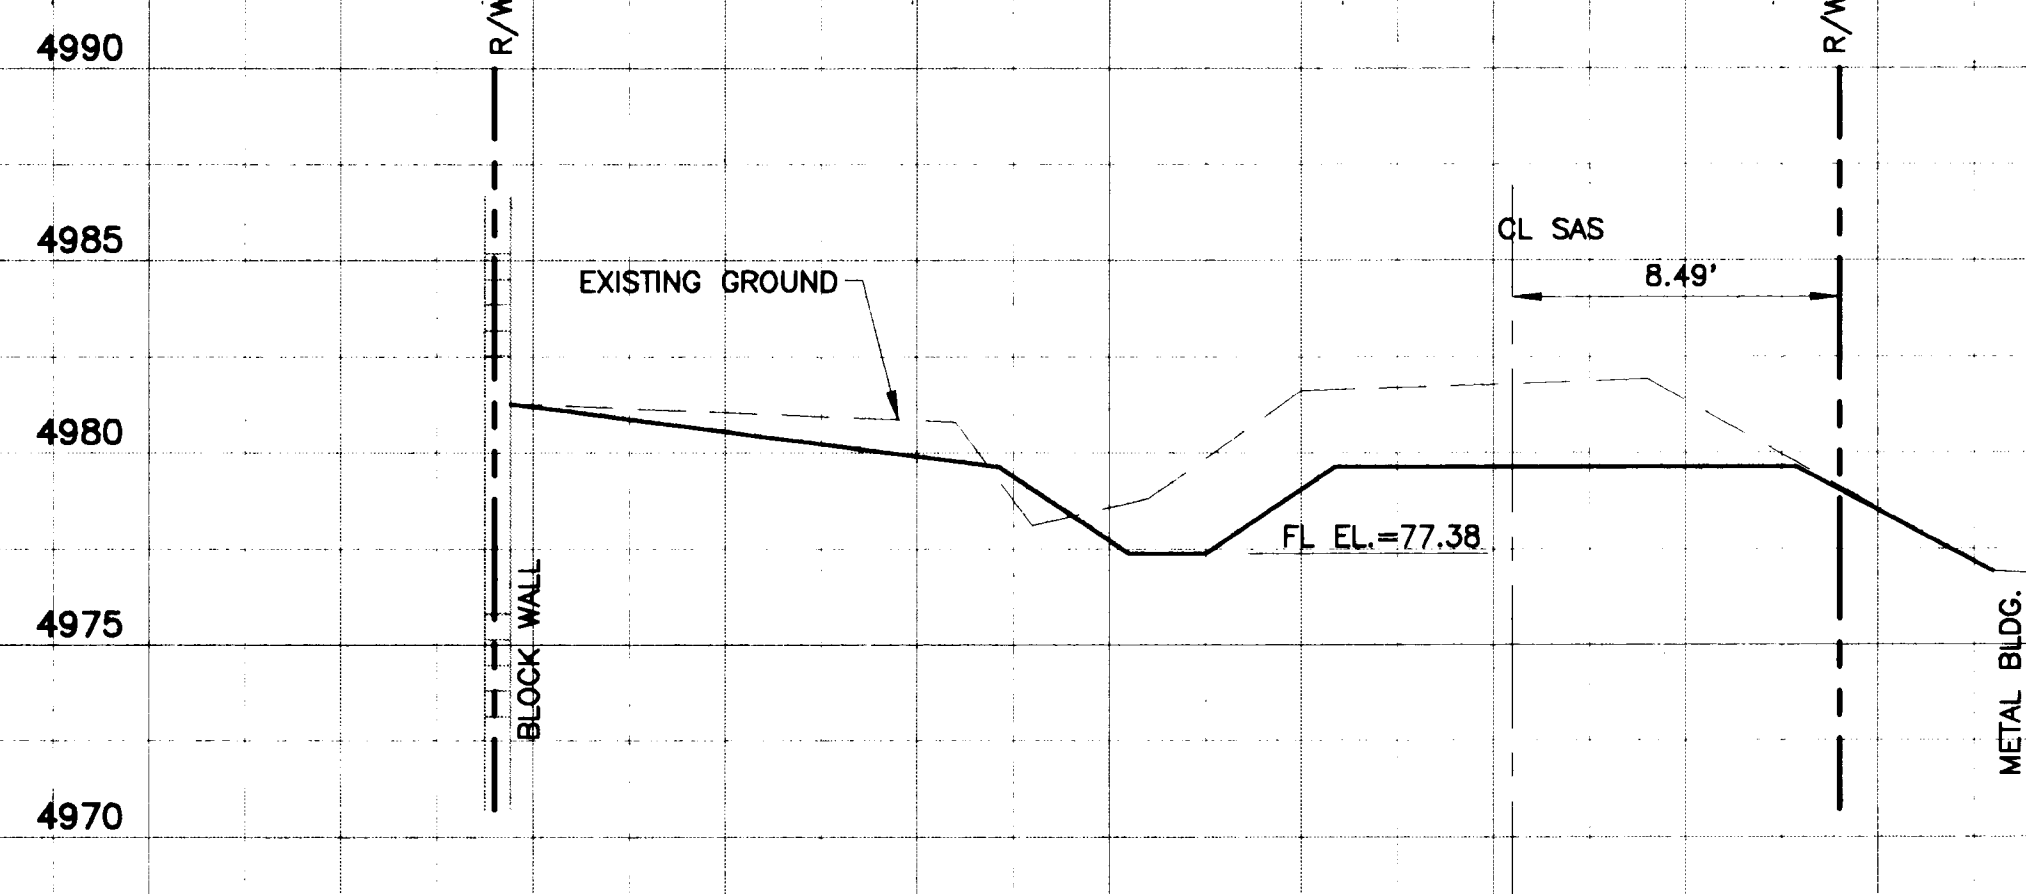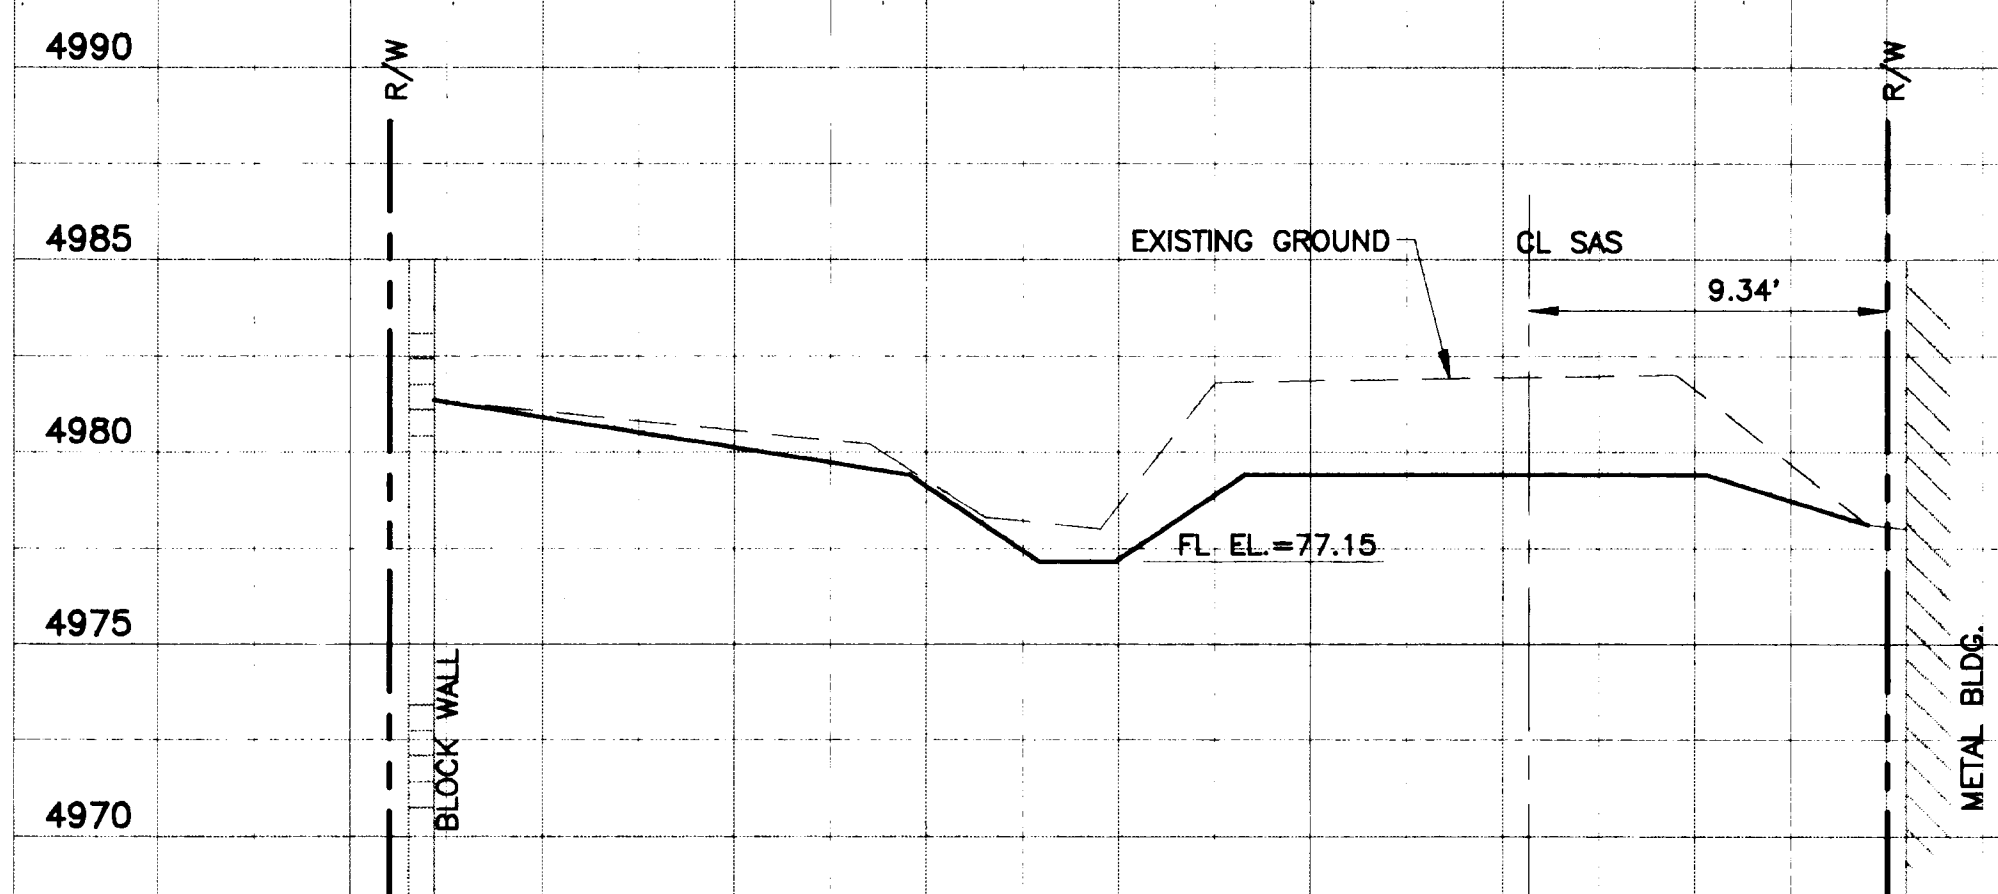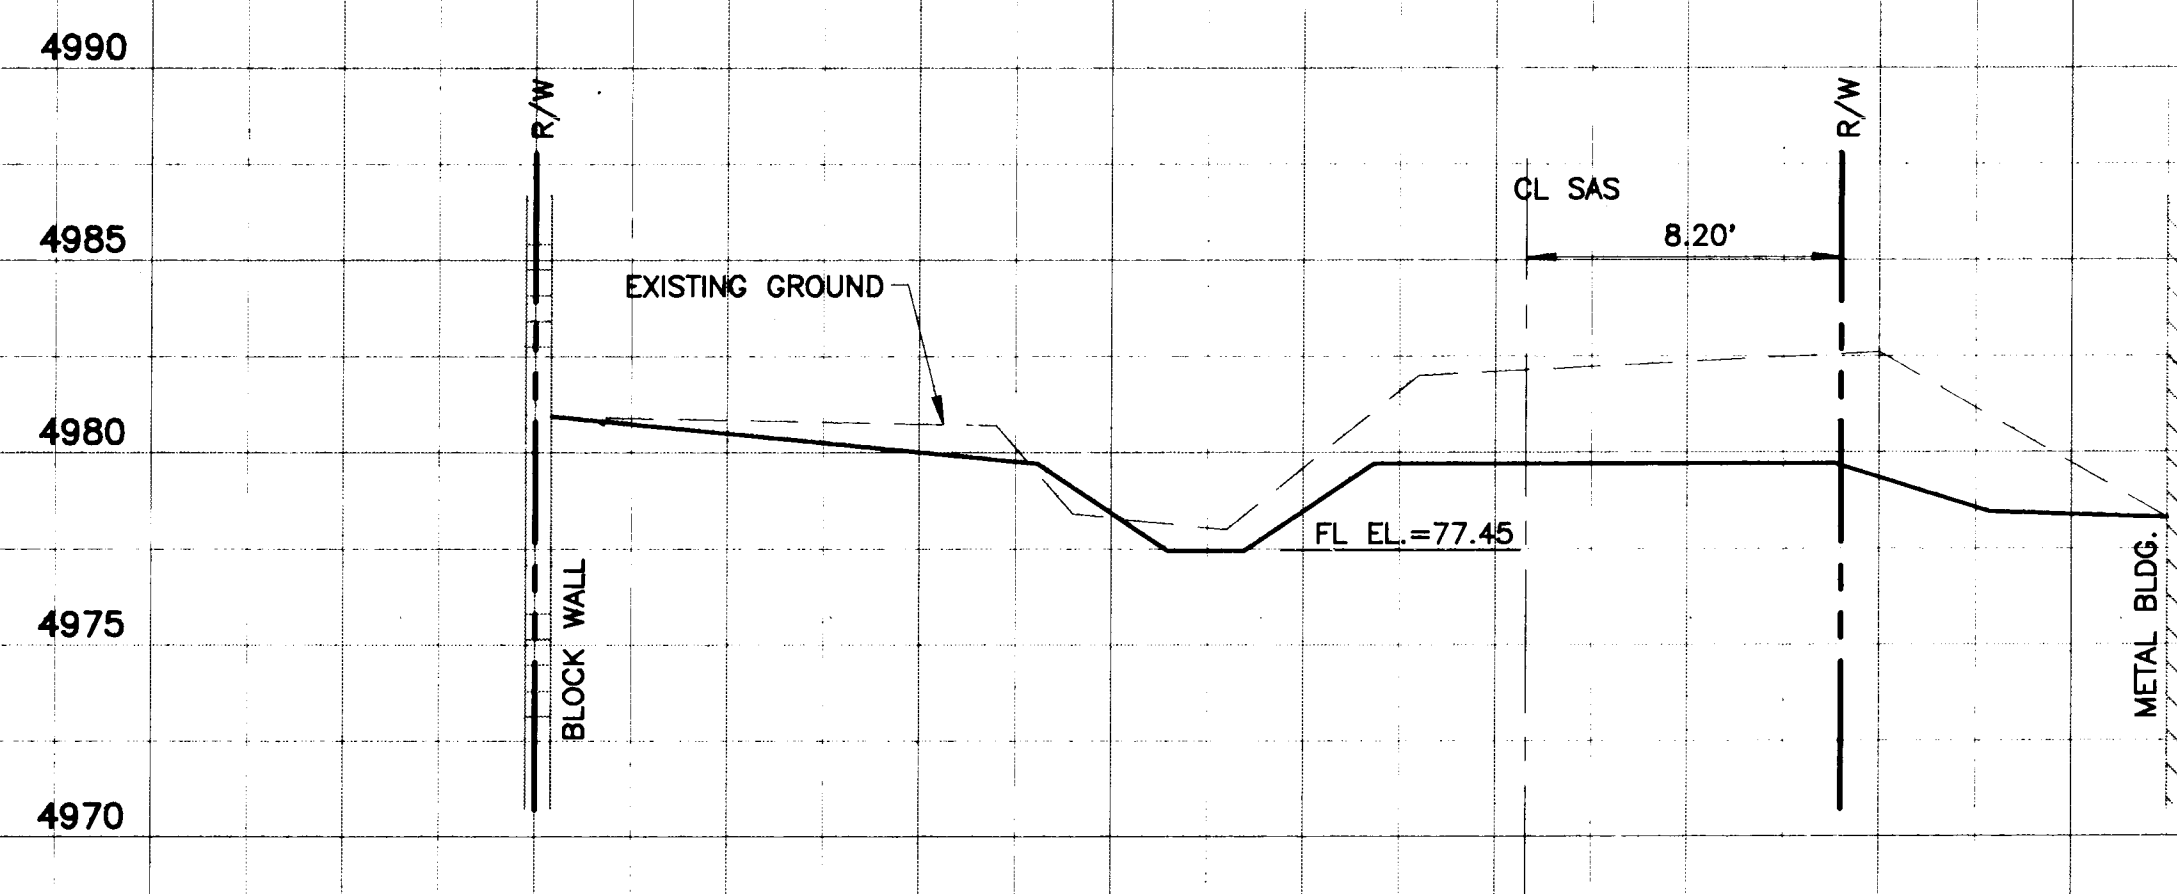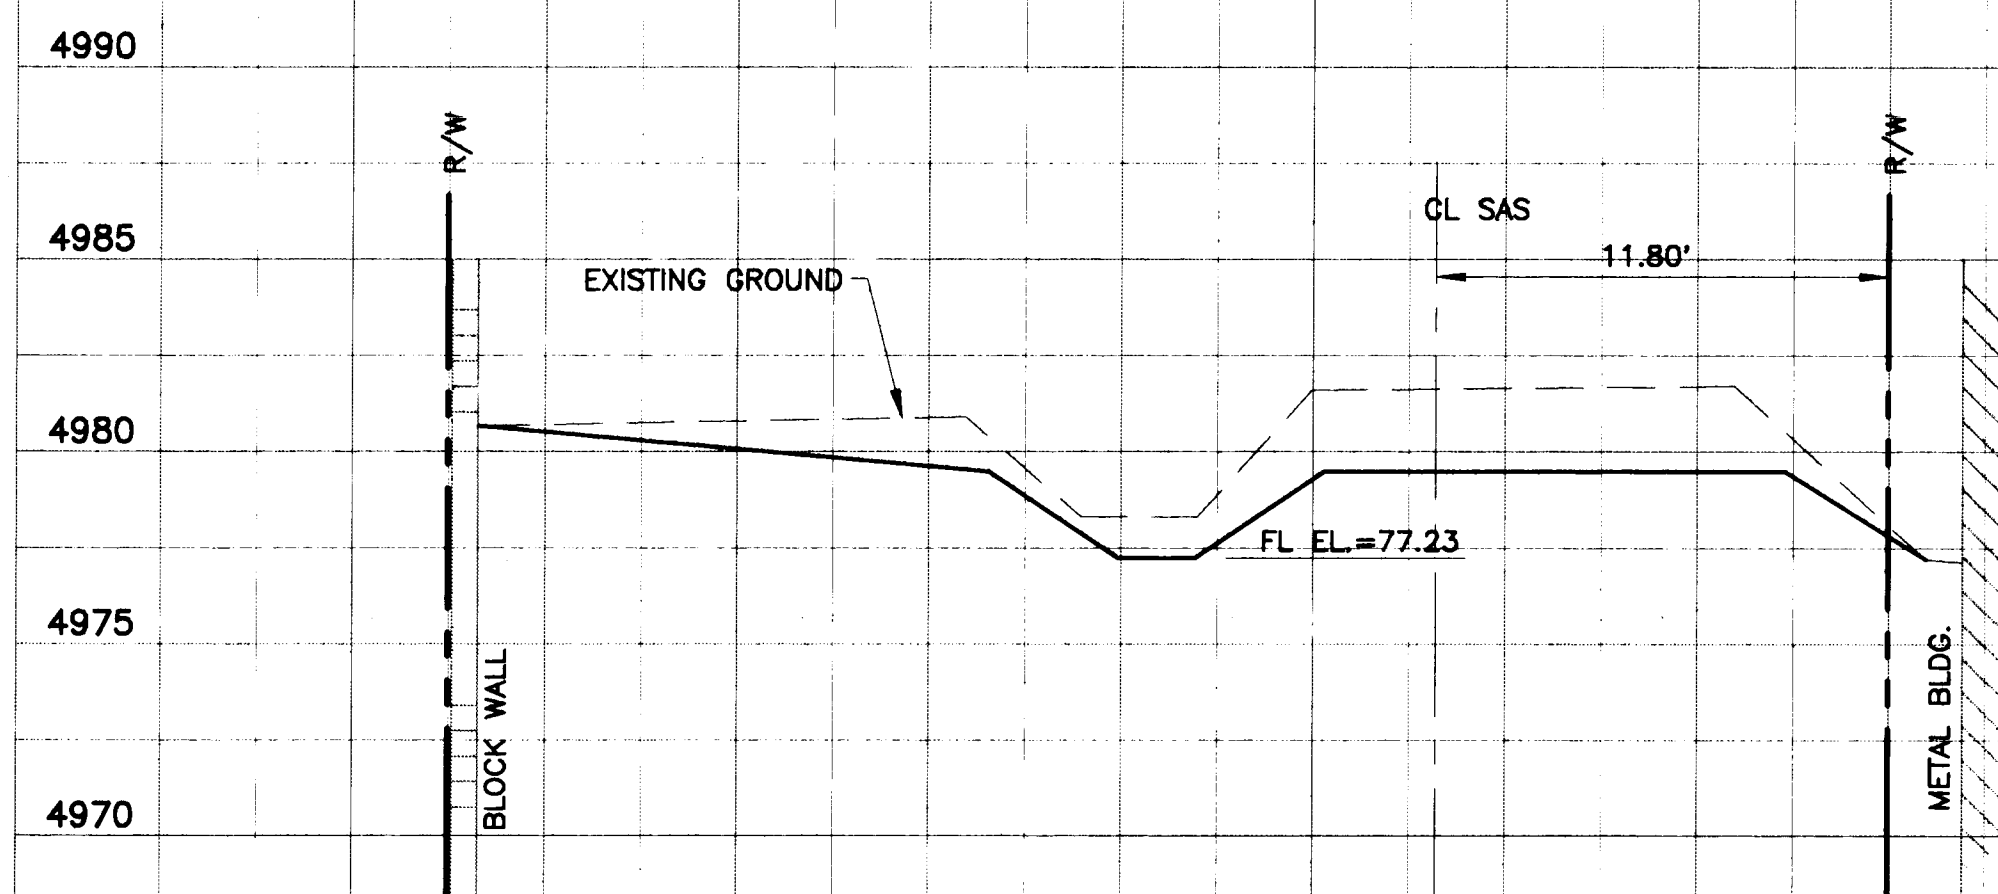

WILLIAM S. LARSEN
NEW MEXICO
11774
REGISTERED PROFESSIONAL ENGINEER

26 3675.930495


RECORD DRAWING
THIS IS A RECORD DRAWING OF THE FACILITIES IDENTIFIED IN THE TITLE BLOCK ONLY AND HAS BEEN PREPARED IN PART ON THE BASIS OF INFORMATION COMPILED AND FURNISHED BY OTHERS. THE ENGINE, SURVEYOR, AND OTHER (S) WILL NOT BE RESPONSIBLE FOR ANY ERROR (S) OR OMISSION (S) WHICH HAVE RESULTED FROM THE INFORMATION FURNISHED. ACTUAL CONDITIONS WILL VARY SOMETIMES FROM THE CONDITIONS SHOWN HEREON AND AS SOME VARIATIONS MAY BE NECESSARY, THE PRELIMINARY LOCATION OF ANY FACILITY IS REQUIRED. THE FACILITY SHOULD BE FIELD LOCATED IN THE PRESENCE OF AN EMPLOYEE OF THE DISTRICT OR THE OWNER (S) OF THE UTILITIES INVOLVED.

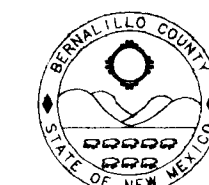


COUNTY OF BERNALILLO
NEW MEXICO

F.H.W.A. REGION NO.	STATE	SHEET NO.	TOTAL SHEETS
6	NEW MEXICO	9-16	


CITY OF ALBUQUERQUE PUBLIC WORKS DEPARTMENT ENGINEERING GROUP					
TITLE: STOTTS LATERAL CROSS SECTIONS WIDENING OF EDITH BOULEVARD PHASE I					
APPROVALS	ENGINEER	DATE	APPROVALS	ENGINEER	DATE
COA	<i>Roger X</i>	11/10/93			
WASTE					
WATER					
BERNALILLO COUNTY					
PROJECT NO.	3675.90	MAP NO.	E-15	SHEET	OF
	.93				

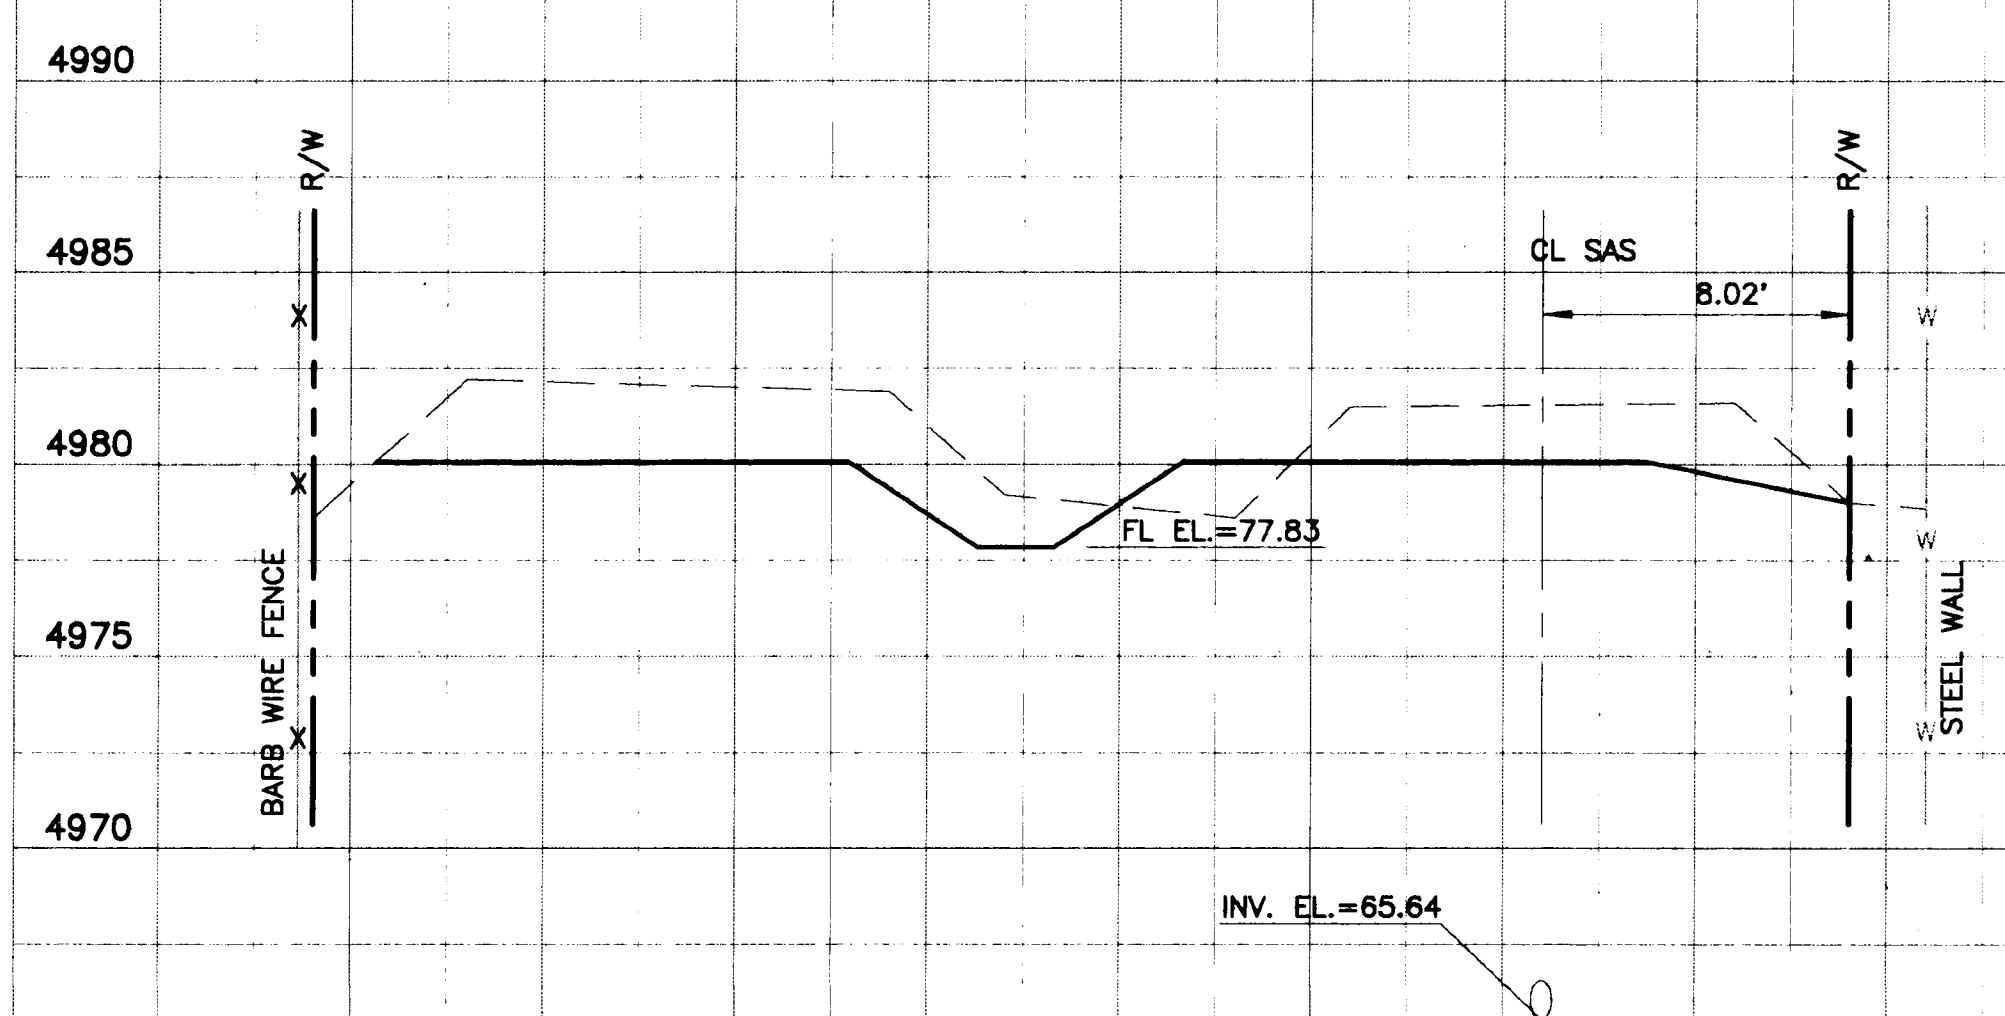


SECTION @ STA. 6+50.00

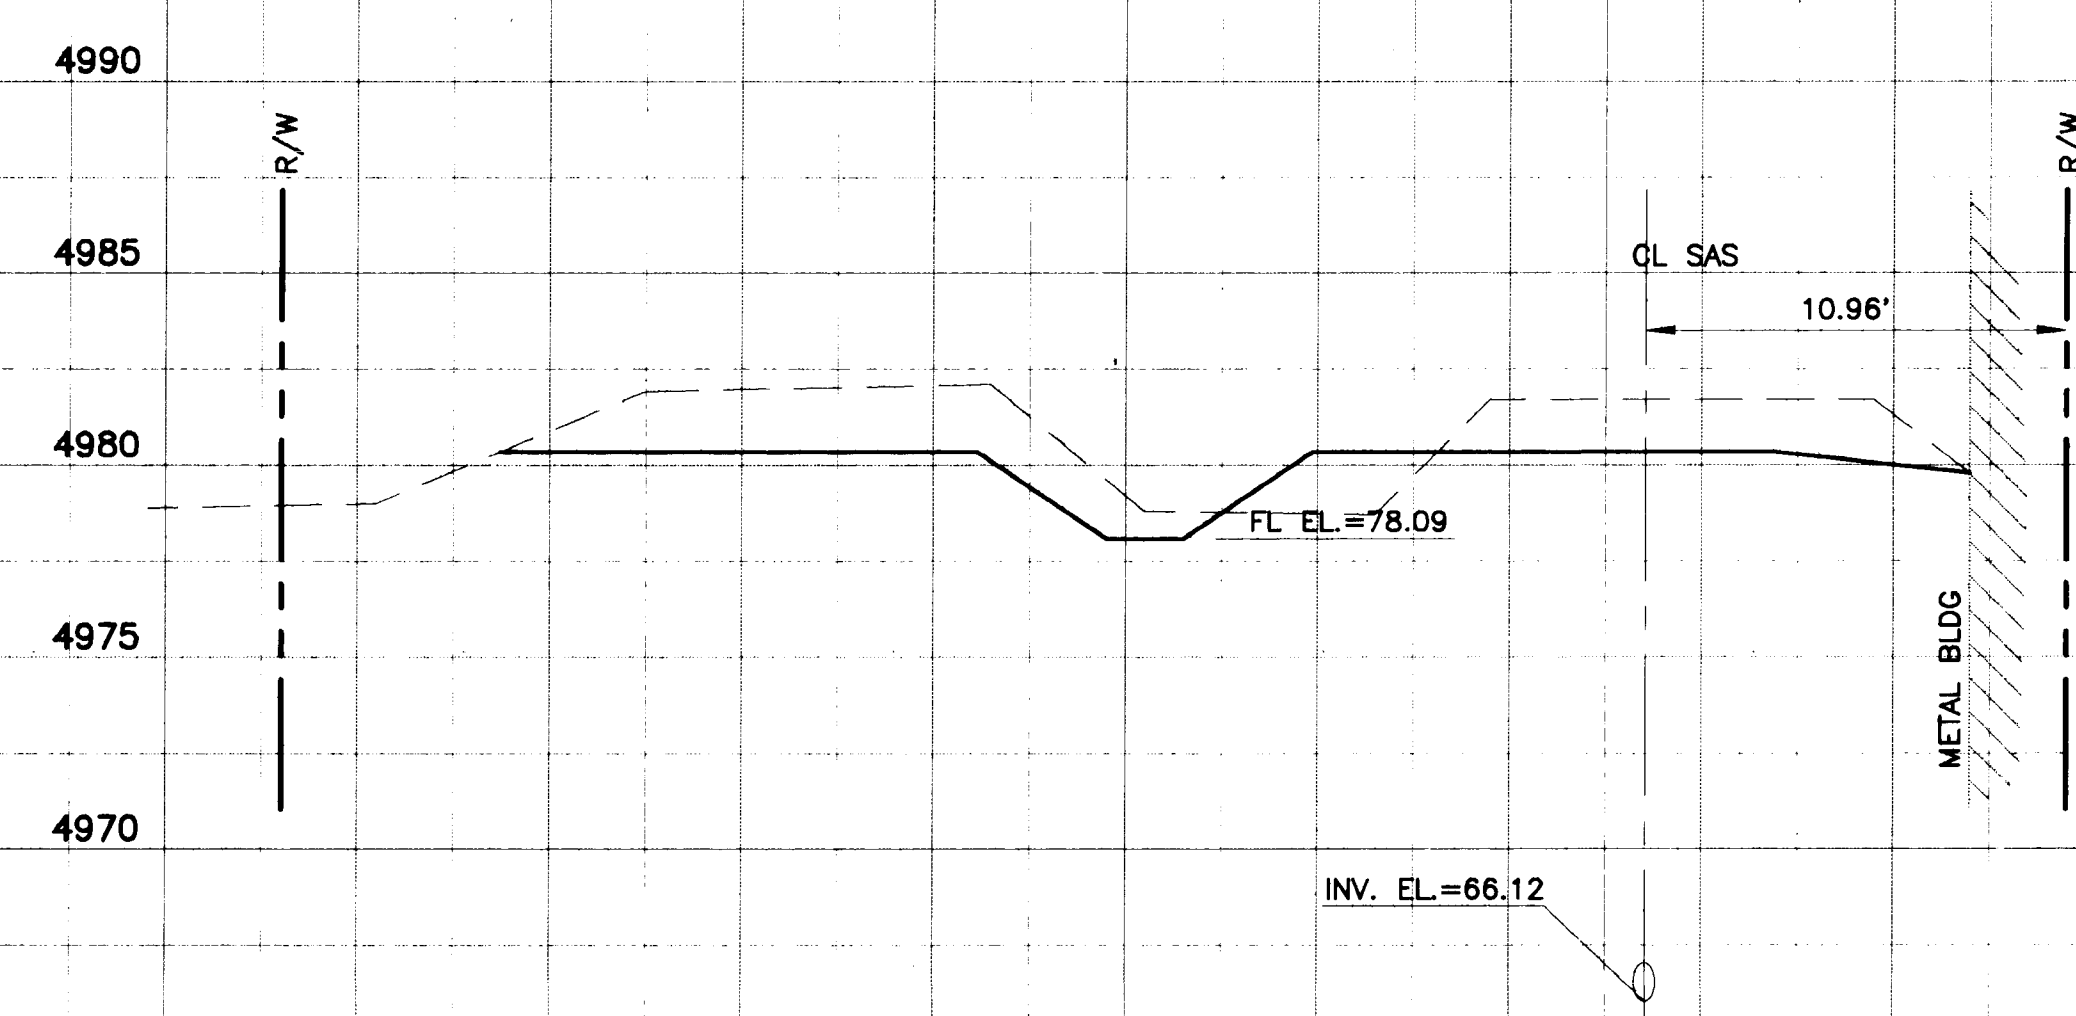


SECTION @ STA. 8+25.00

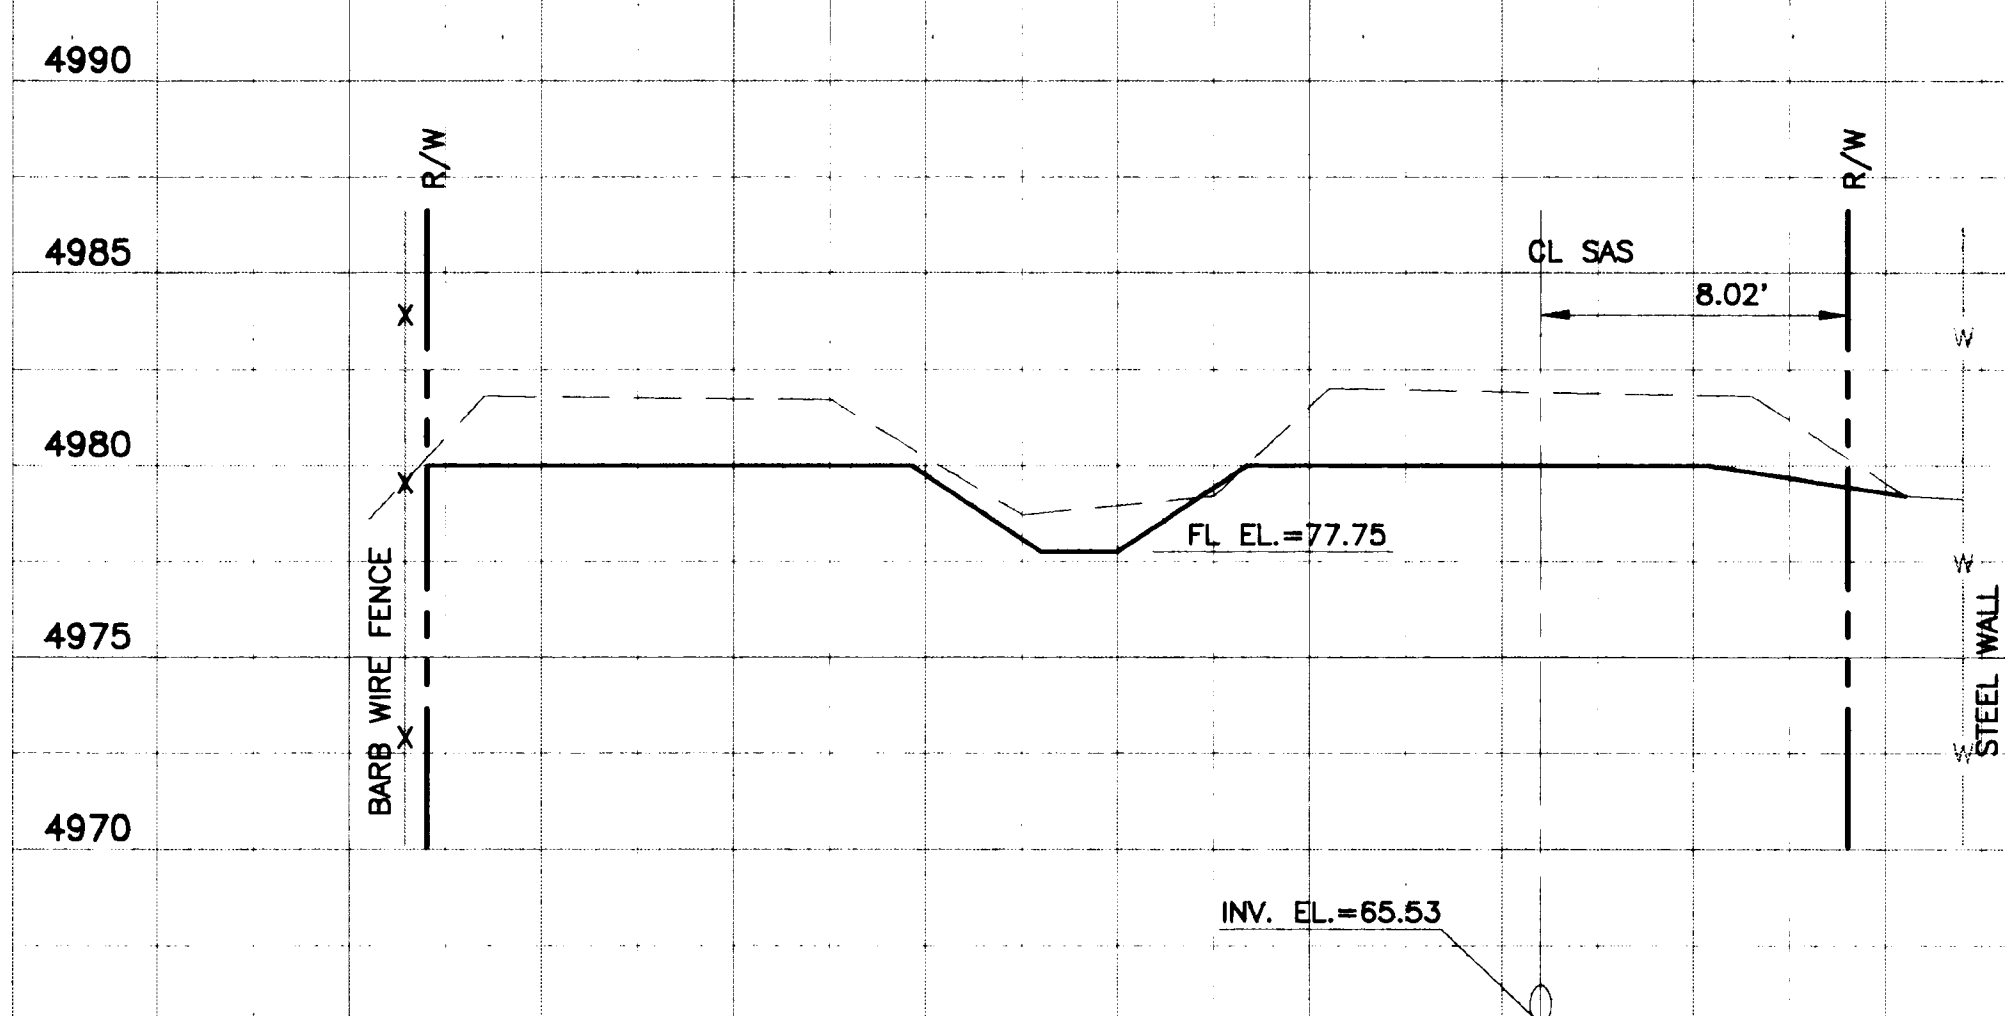


SECTION @ STA. 6+00.00

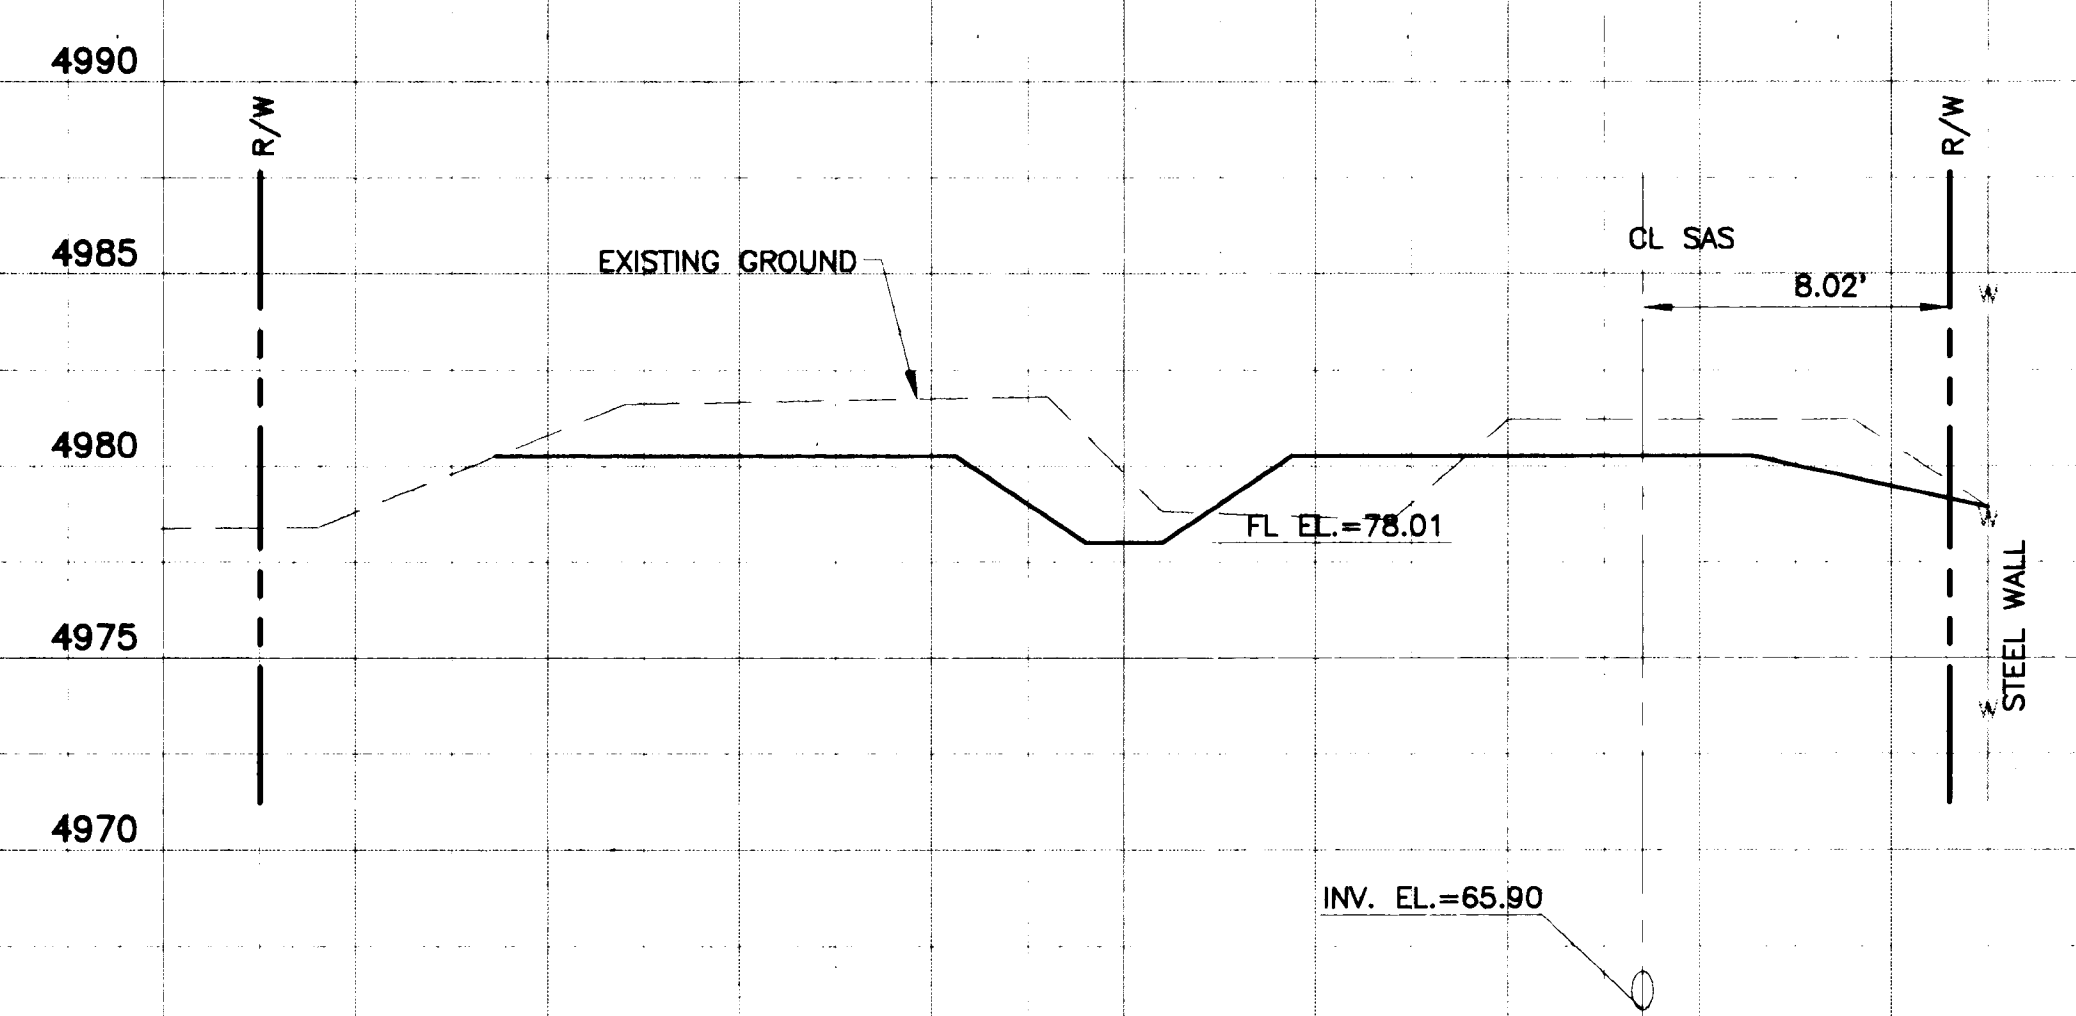


SECTION @ STA. 7+70.00

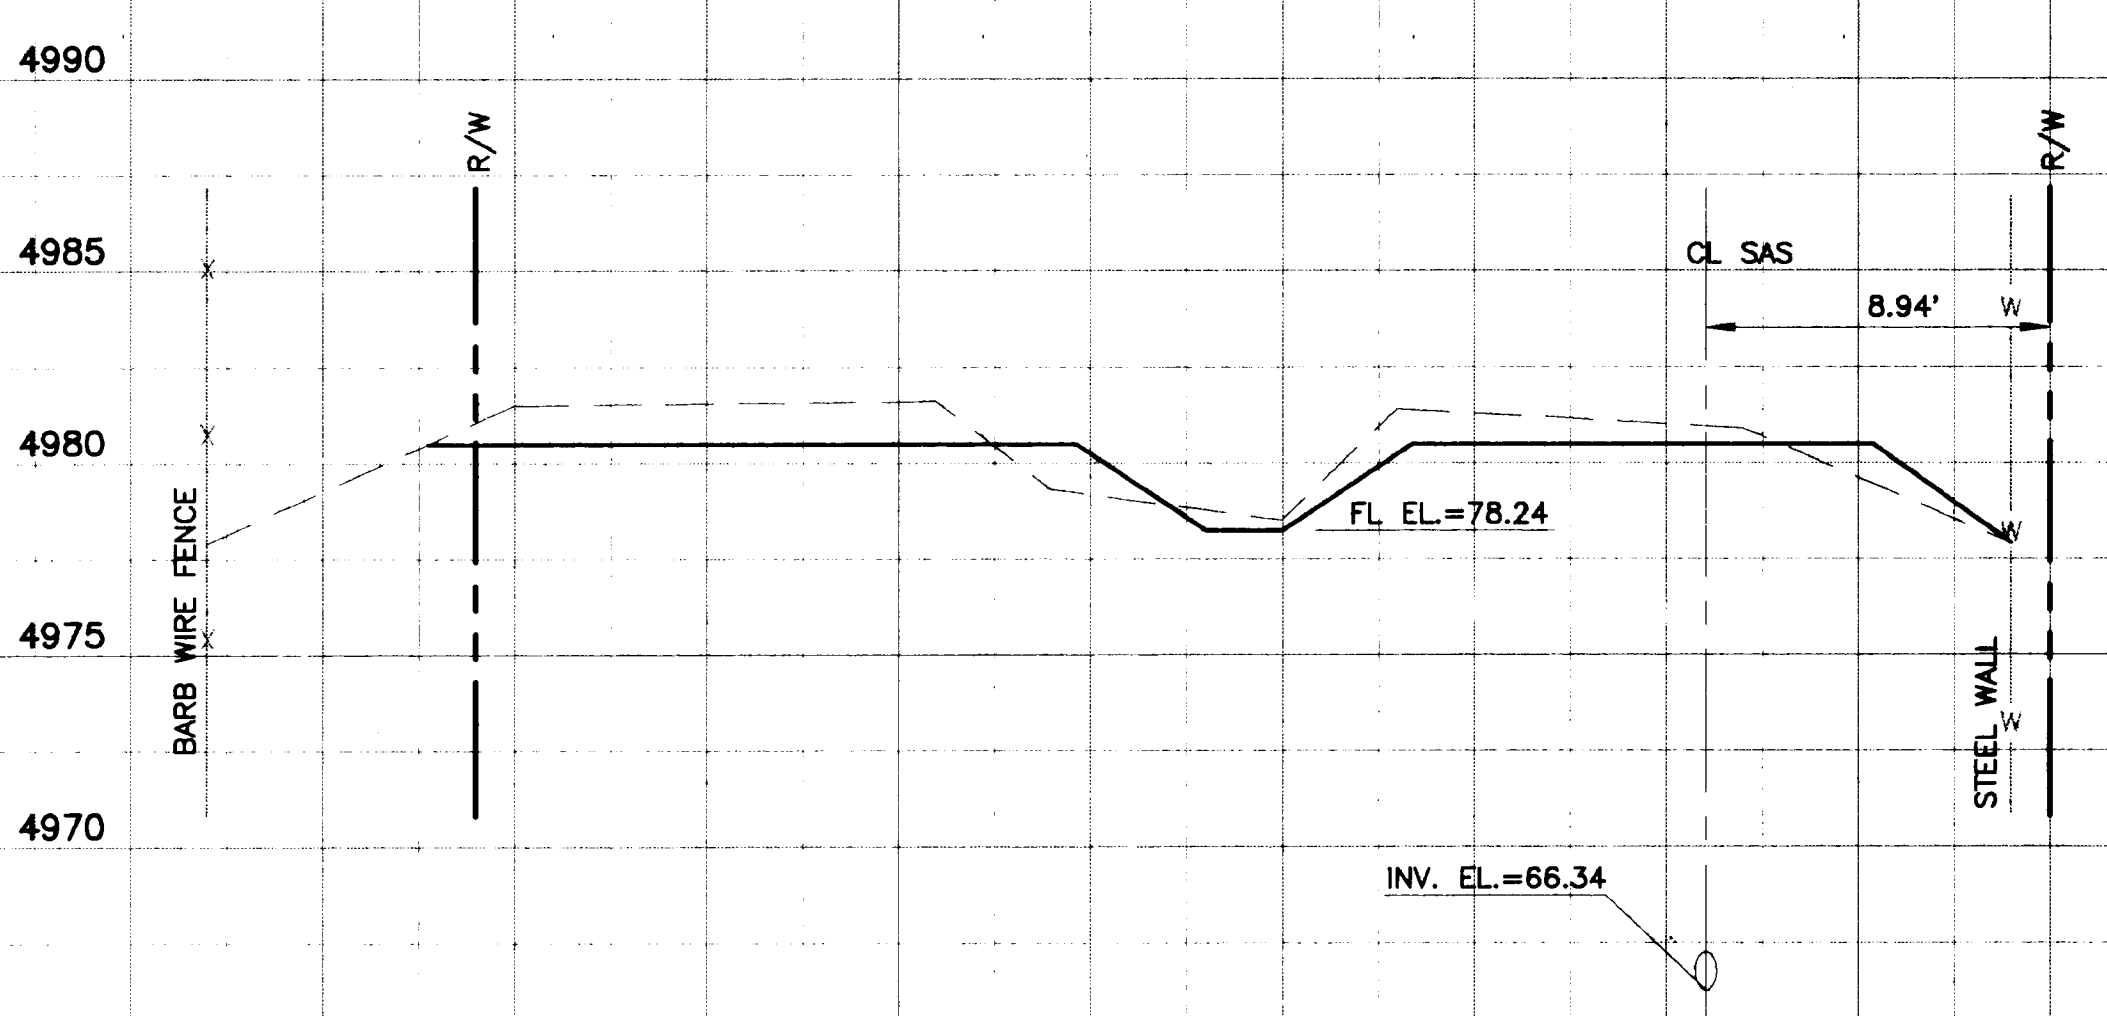


SECTION @ STA. 9+25.00

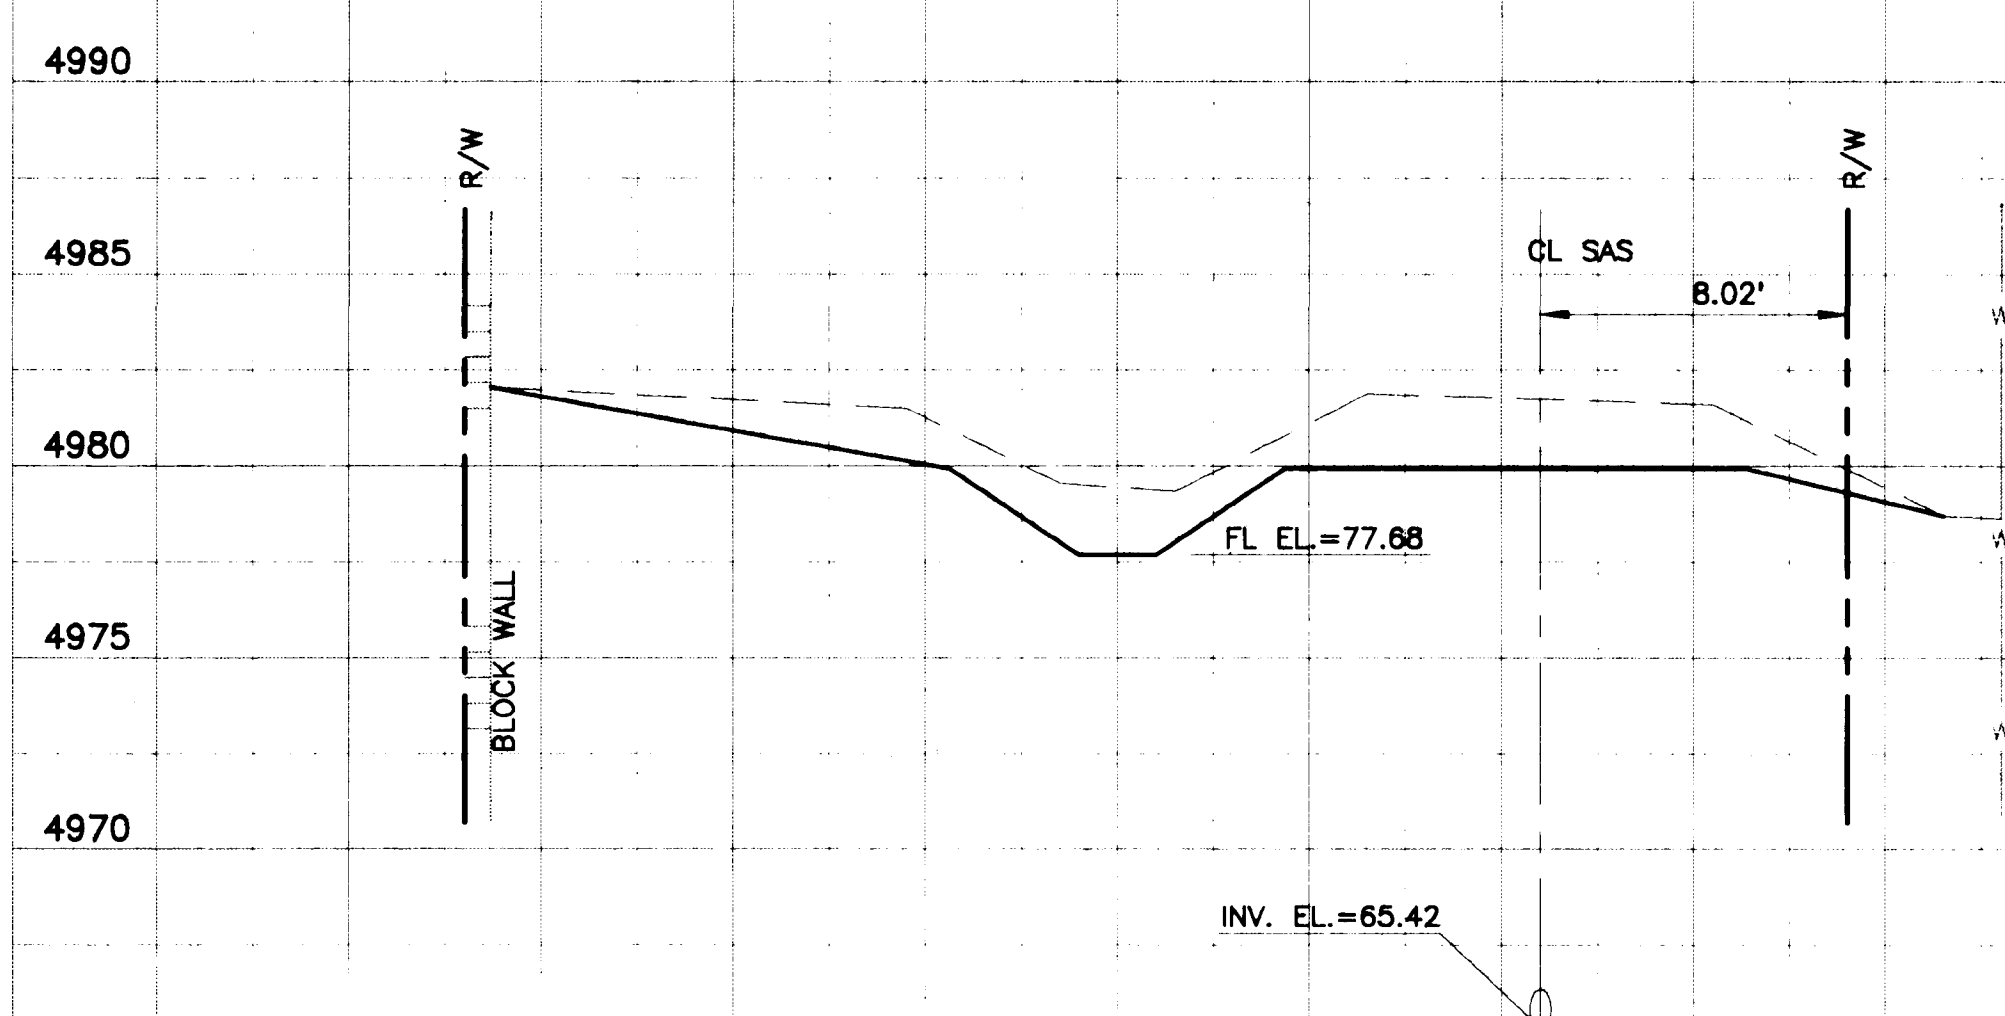

SECTION @ STA. 5+50.00

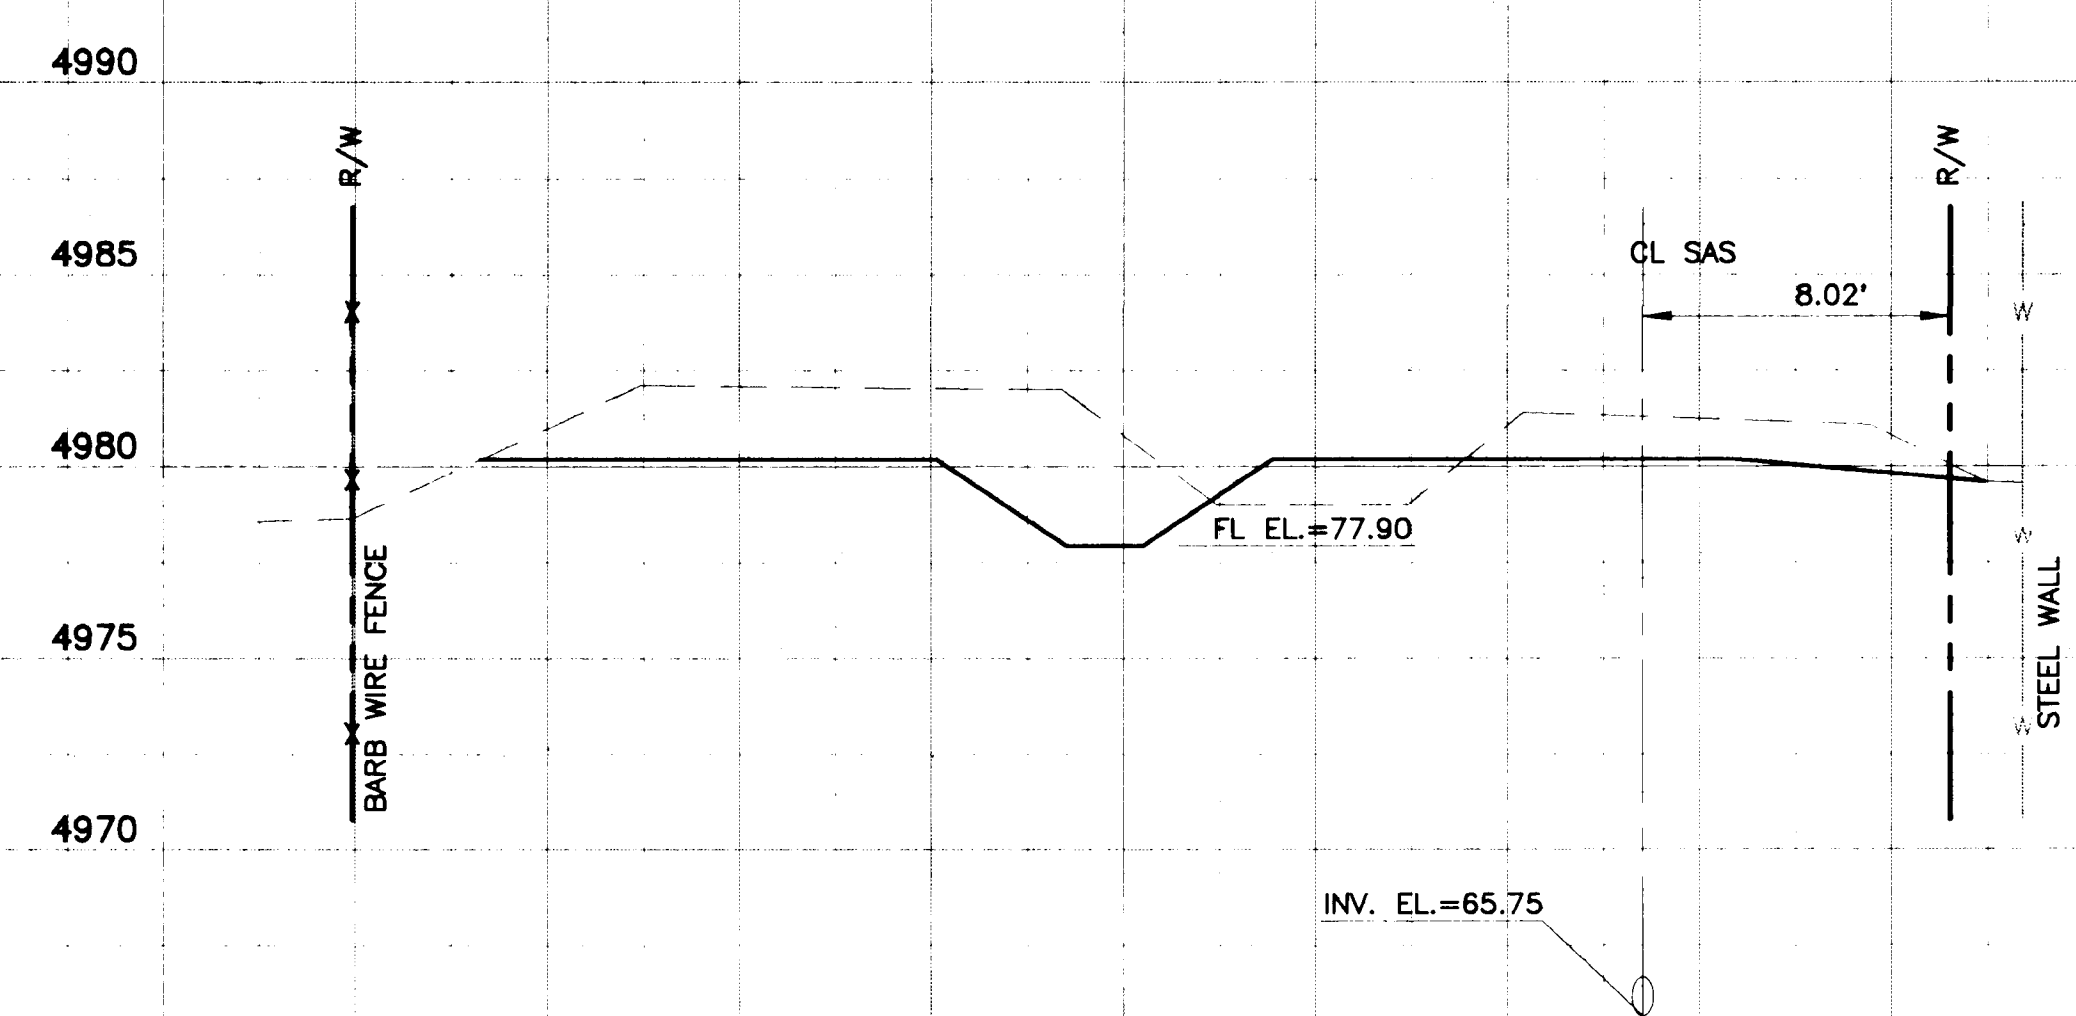

SECTION @ STA. 7+00.00

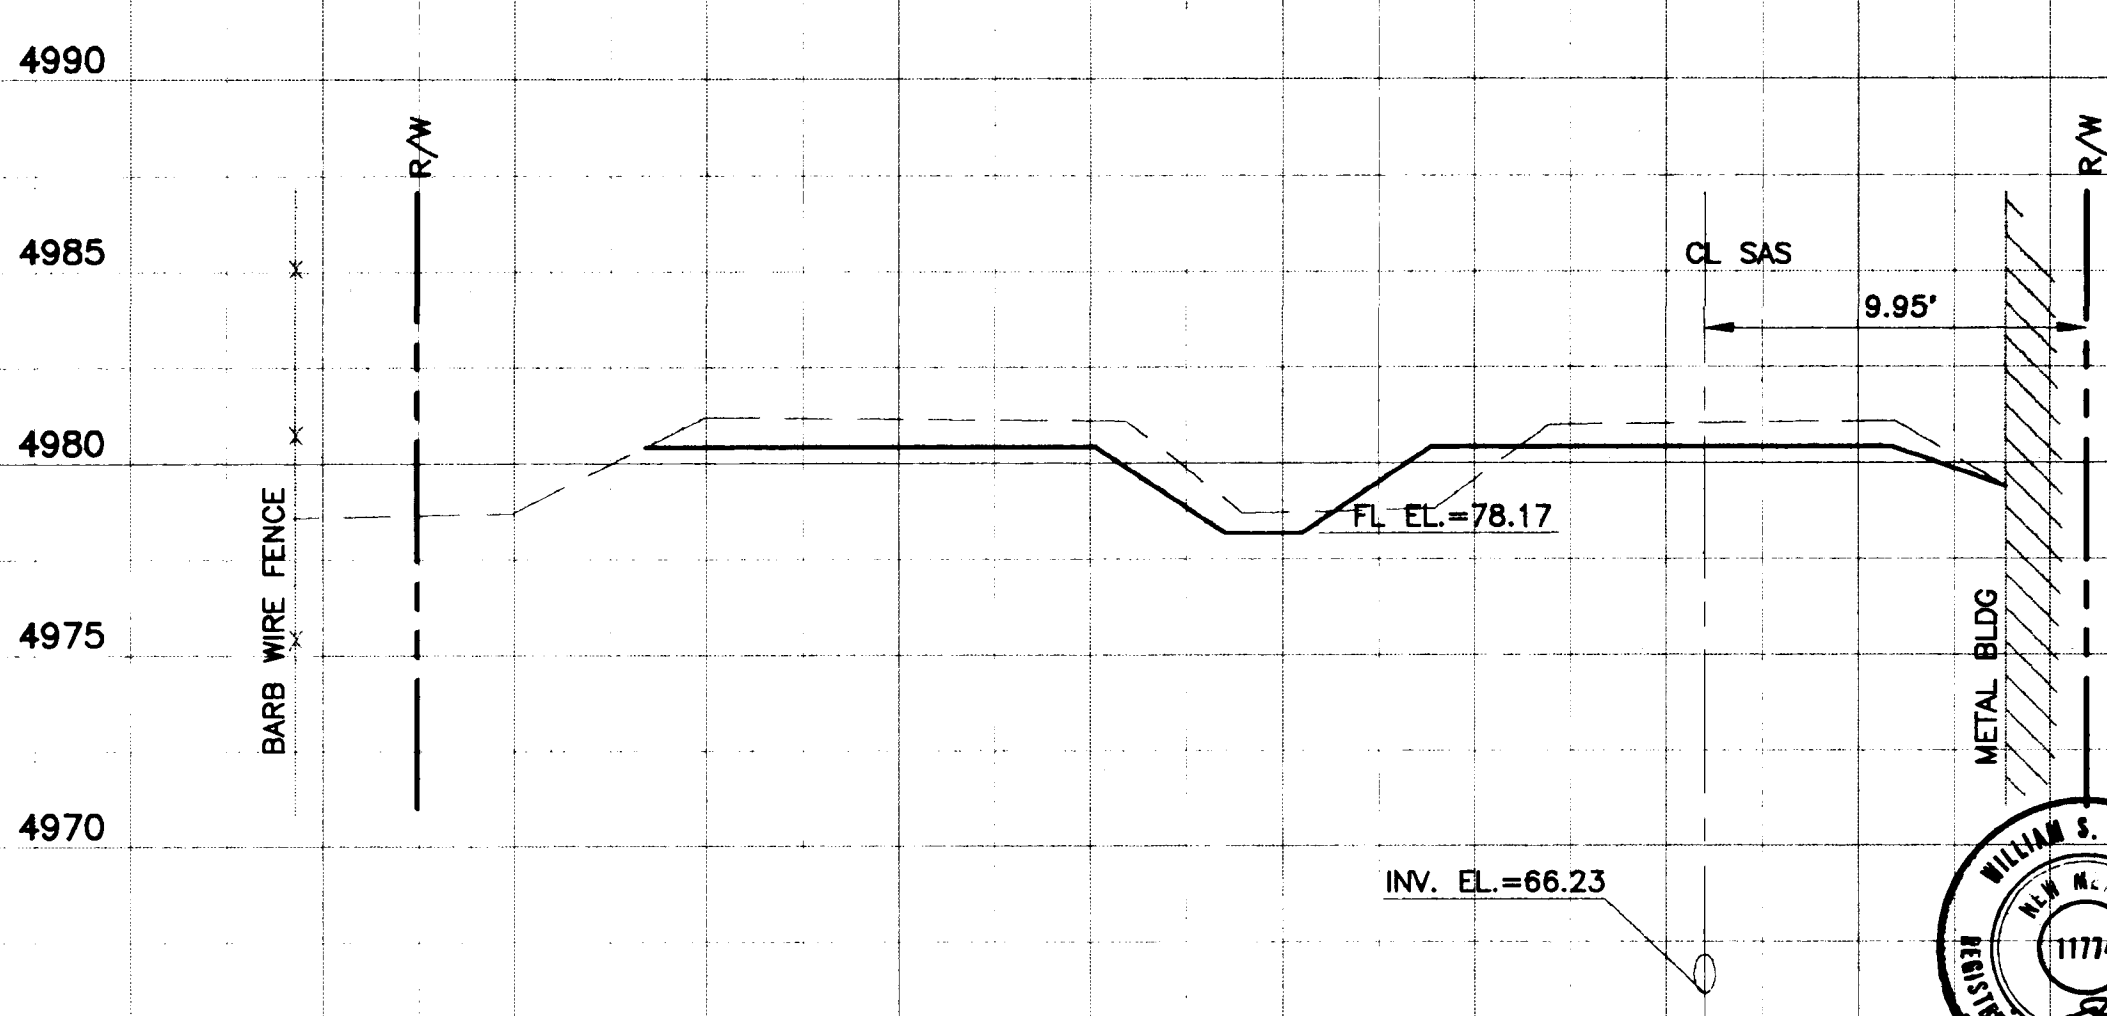






SECTION @ STA. 8+75.00

26 2675.930595

RECORD DRAWING
THIS IS A RECORD DRAWING OF THE FACILITIES IDENTIFIED IN THE TITLE BLOCK ONLY AND HAS BEEN PREPARED IN PART ON THE BASIS OF INFORMATION COMPILED AND FURNISHED BY OTHERS. THE ENGINE, ARCHITECT AND OTHER (S) WILL NOT BE RESPONSIBLE FOR ANY ERROR(S) OR OMISSION(S) WHICH HAVE BEEN IDENTIFIED IN THIS DRAWING. A FINAL COMPARISON WILL BE MADE BETWEEN THE CONDITIONS SHOWN HEREON AND THE PRELIMINARY LOCATION OF ANY FACILITY IS REQUIRED. THE PRELIMINARY LOCATION OF ANY FACILITY IS REQUIRED. THE PRELIMINARY LOCATION OF ANY FACILITY IS REQUIRED. THE PRELIMINARY LOCATION OF ANY FACILITY IS REQUIRED.





CITY OF ALBUQUERQUE PUBLIC WORKS DEPARTMENT ENGINEERING GROUP					
TITLE: STOTTS LATERAL CROSS SECTIONS WIDENING OF EDITH BOULEVARD PHASE I					
APPROVALS	ENGINEER	DATE	APPROVALS	ENGINEER	DATE
COA WASTE WATER	<i>[Signature]</i>	11/10/93			
BERNALILLO COUNTY					
PROJECT NO.	3675.90 .93	MAP NO.	E-15	SHEET OF	

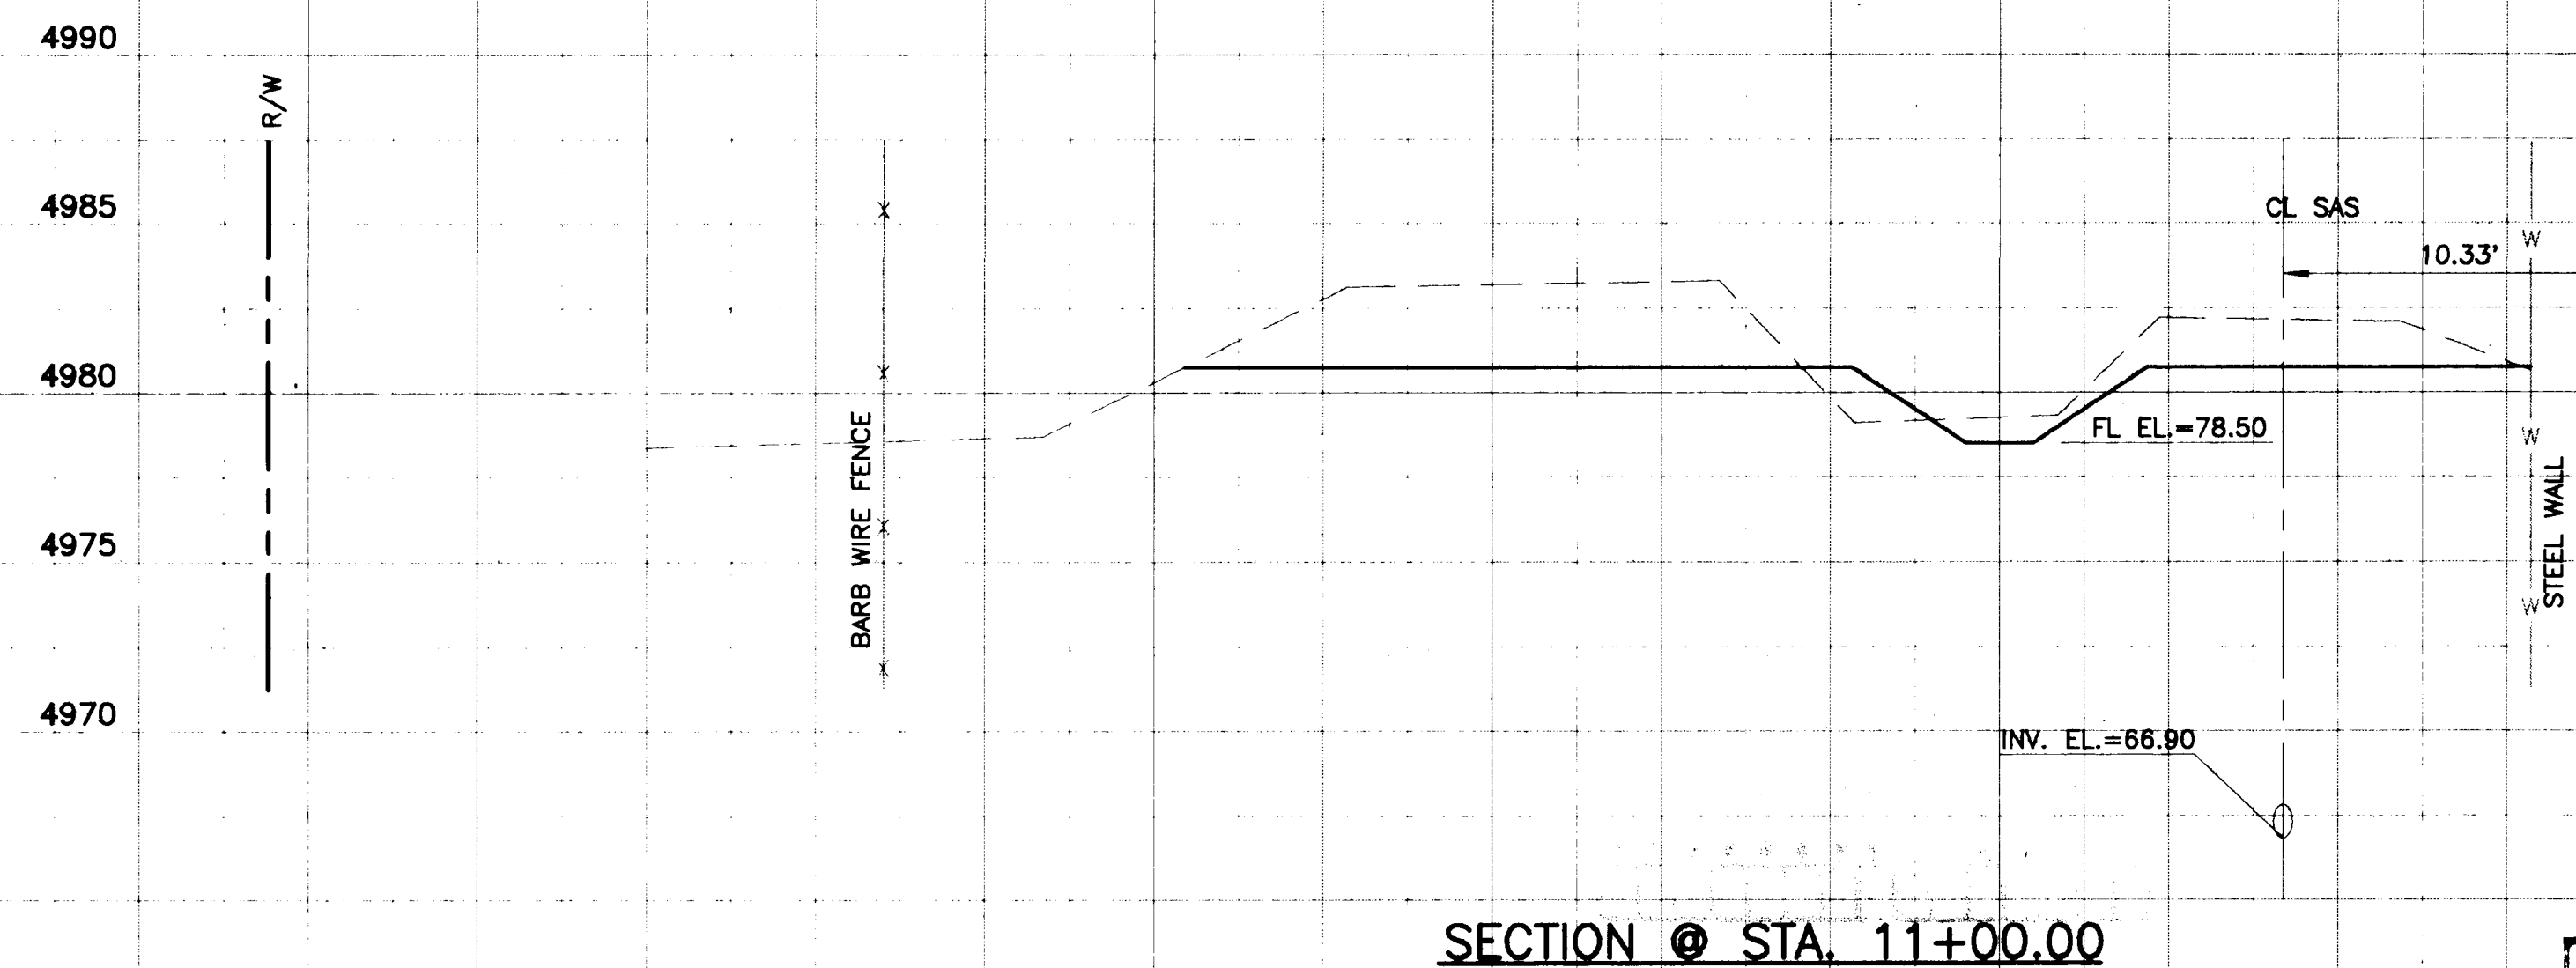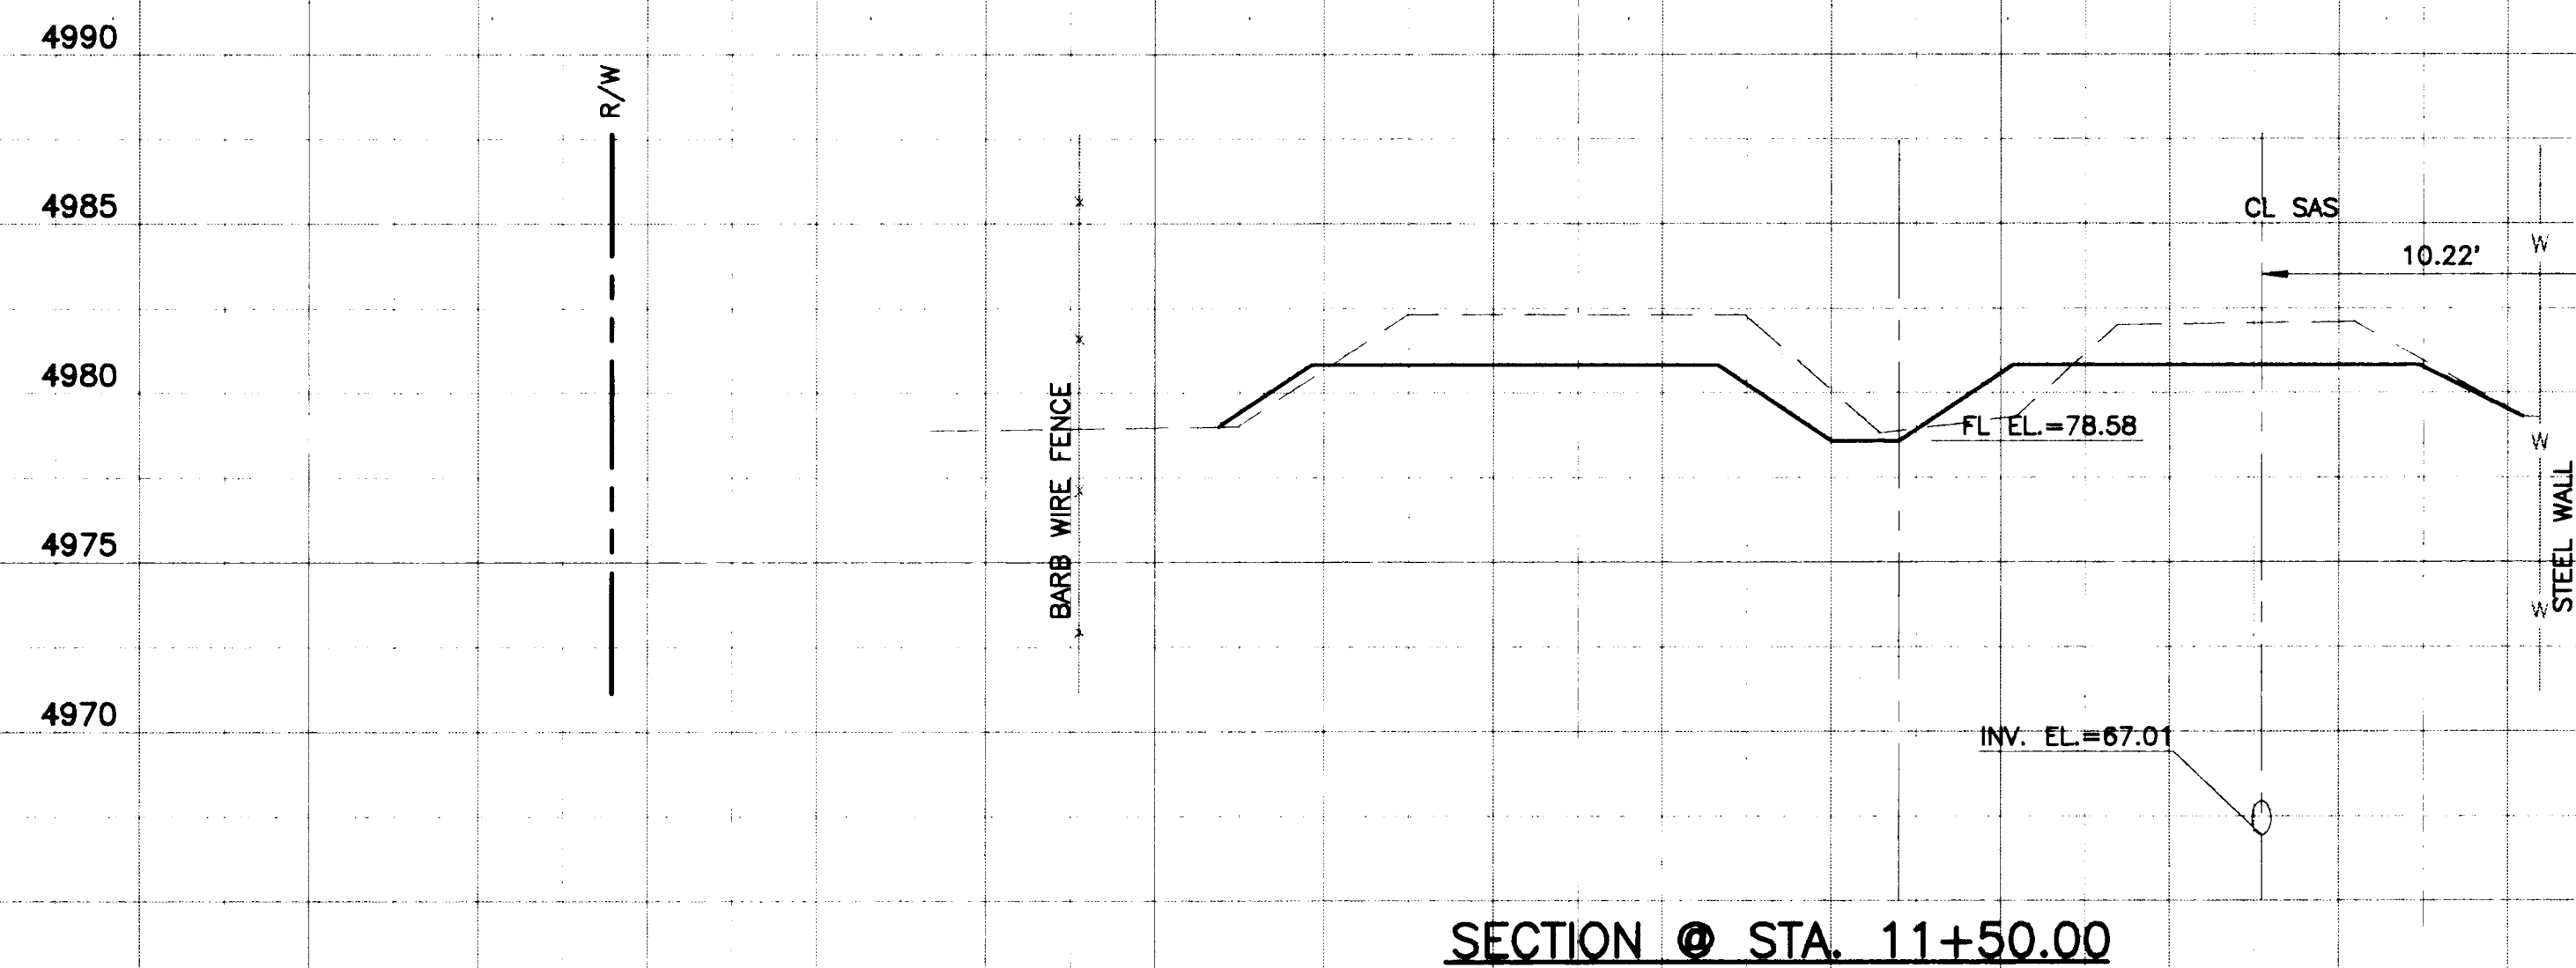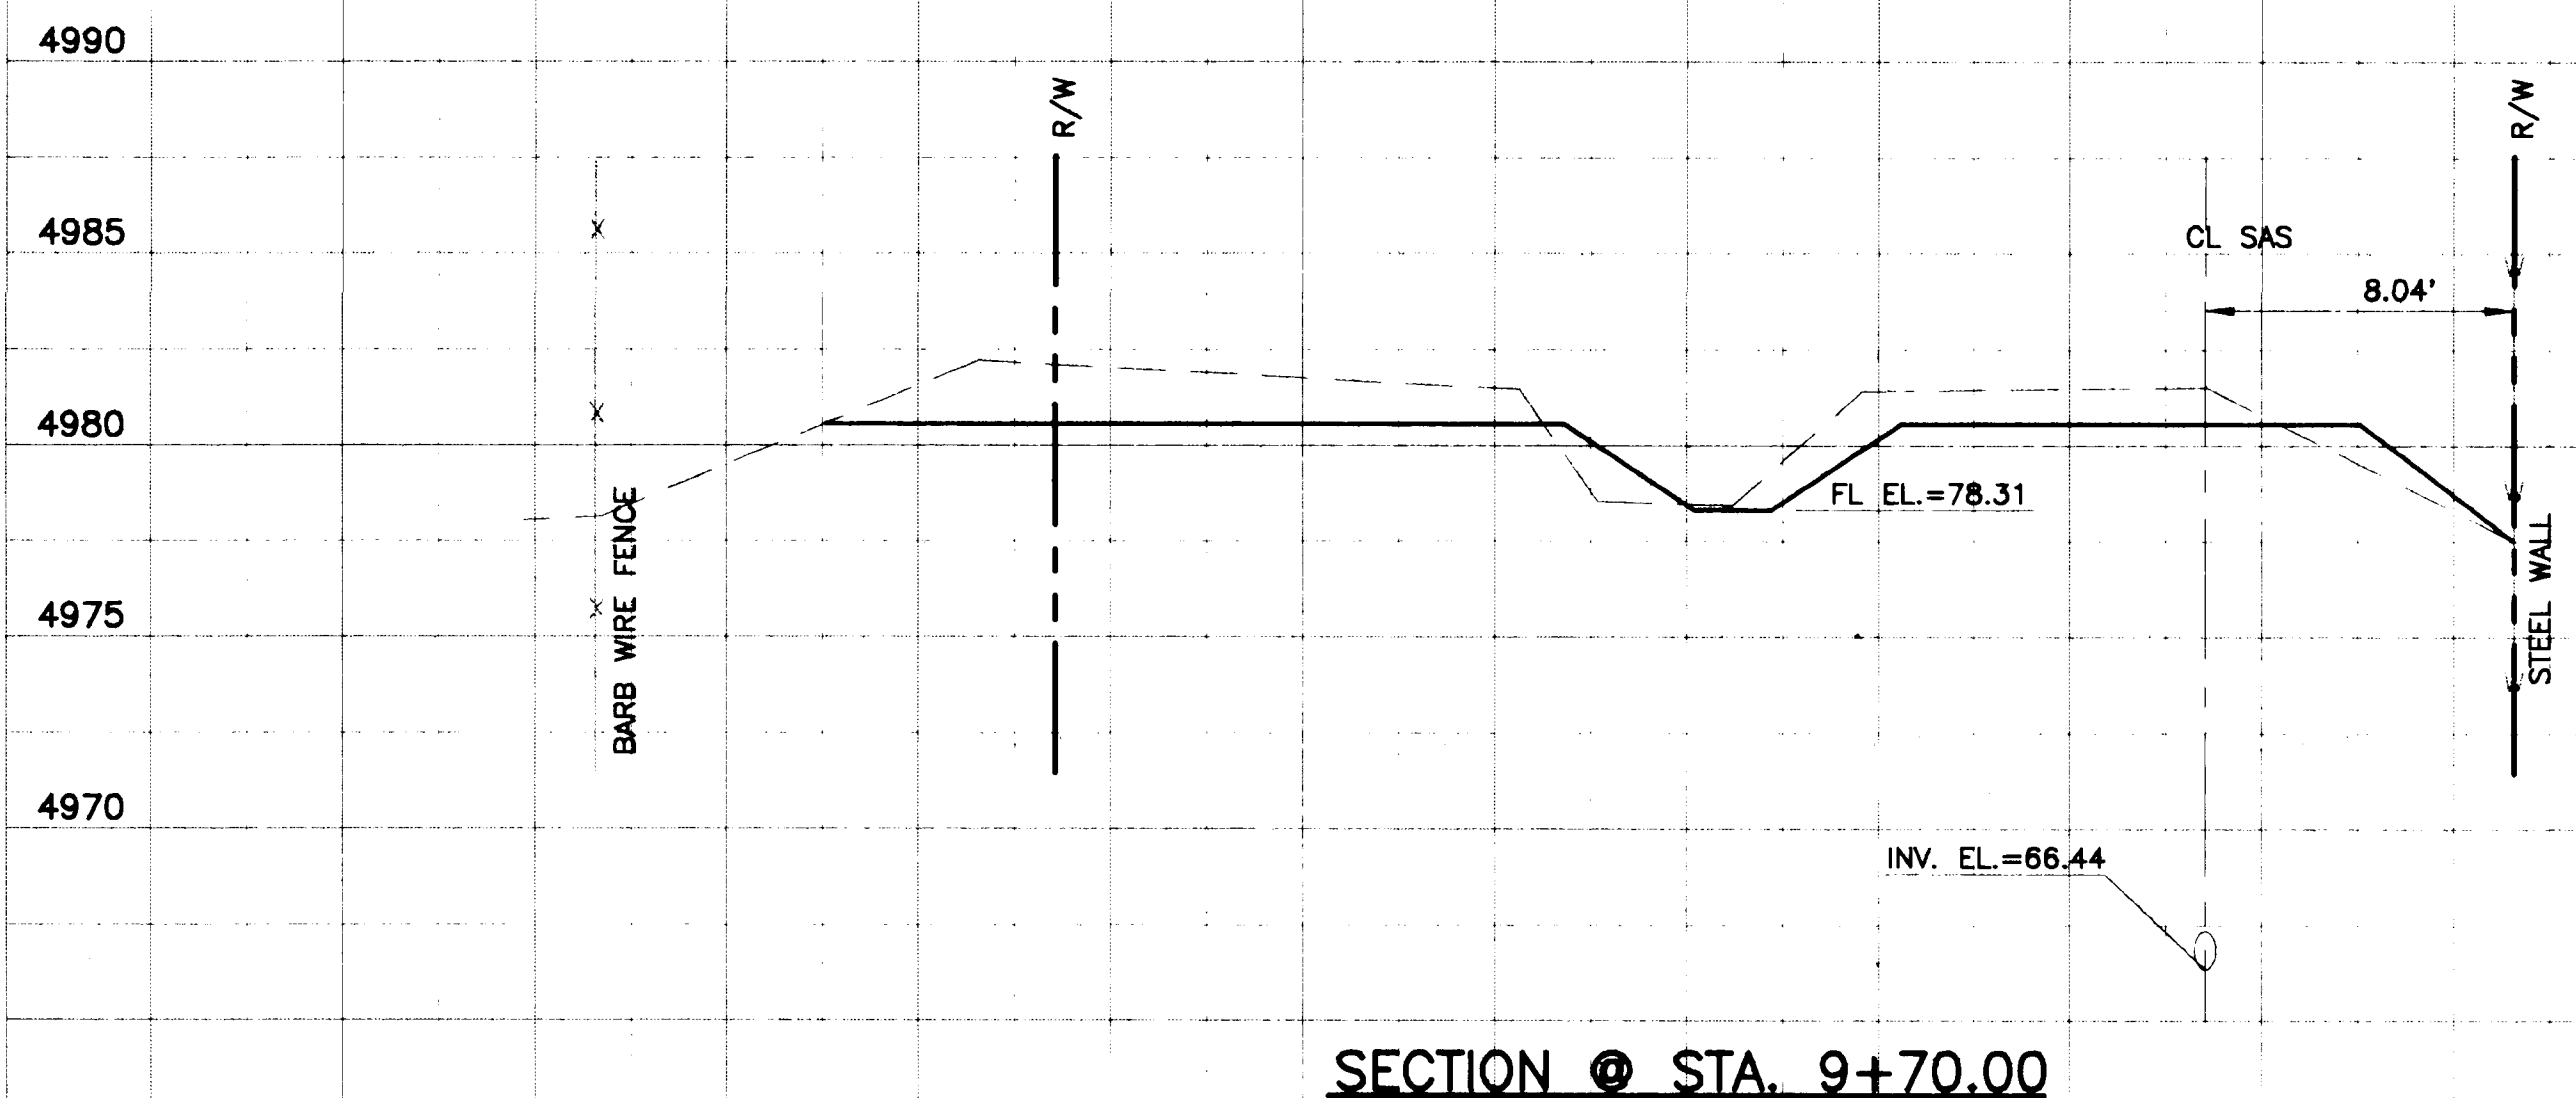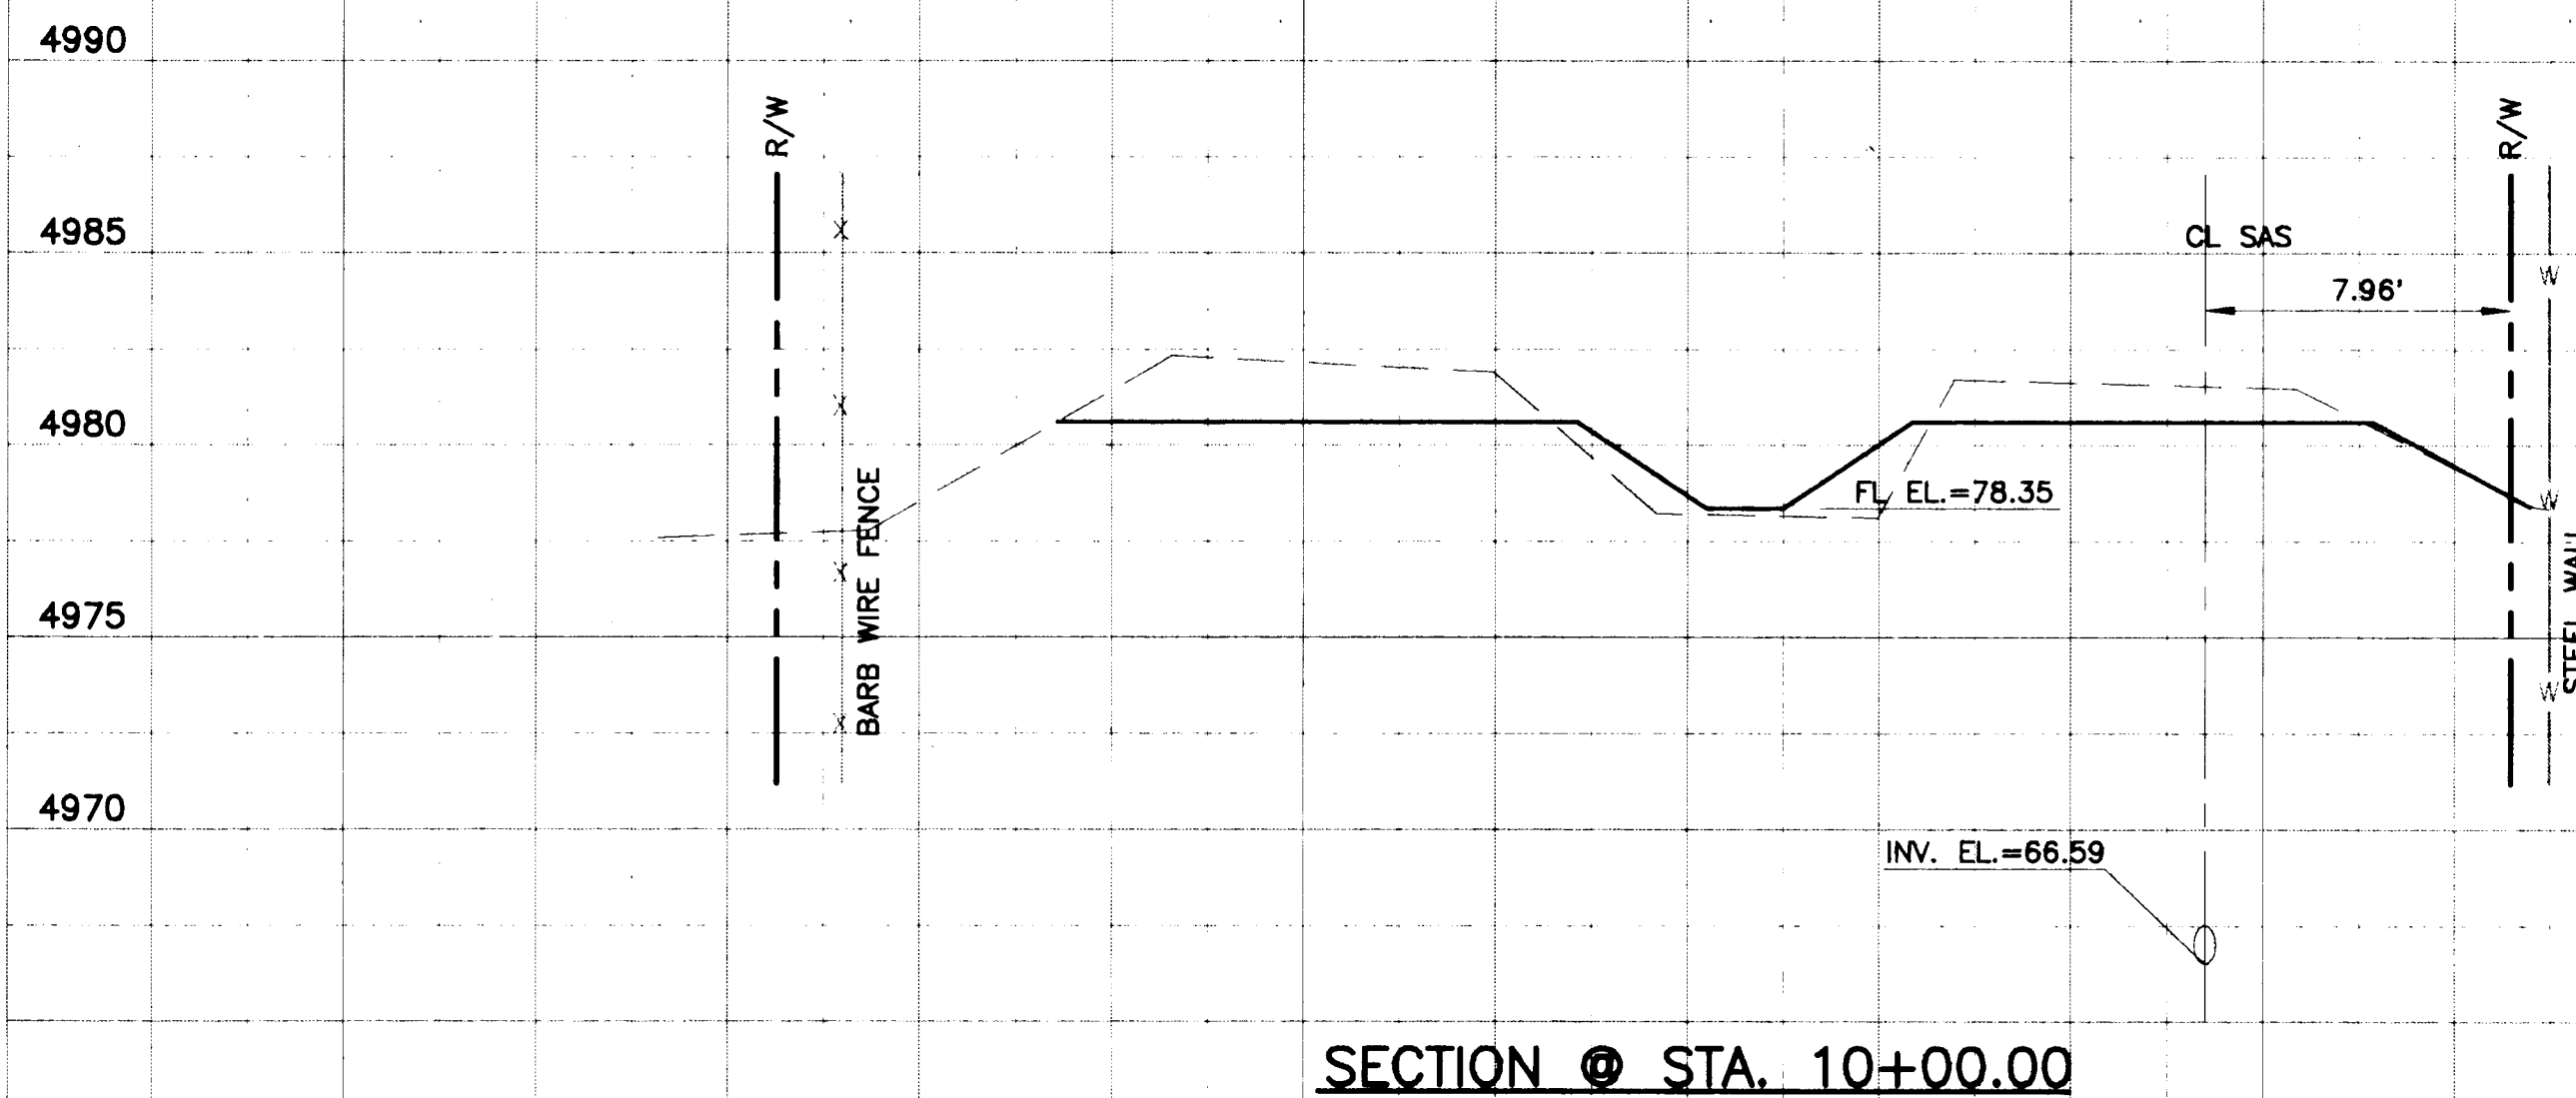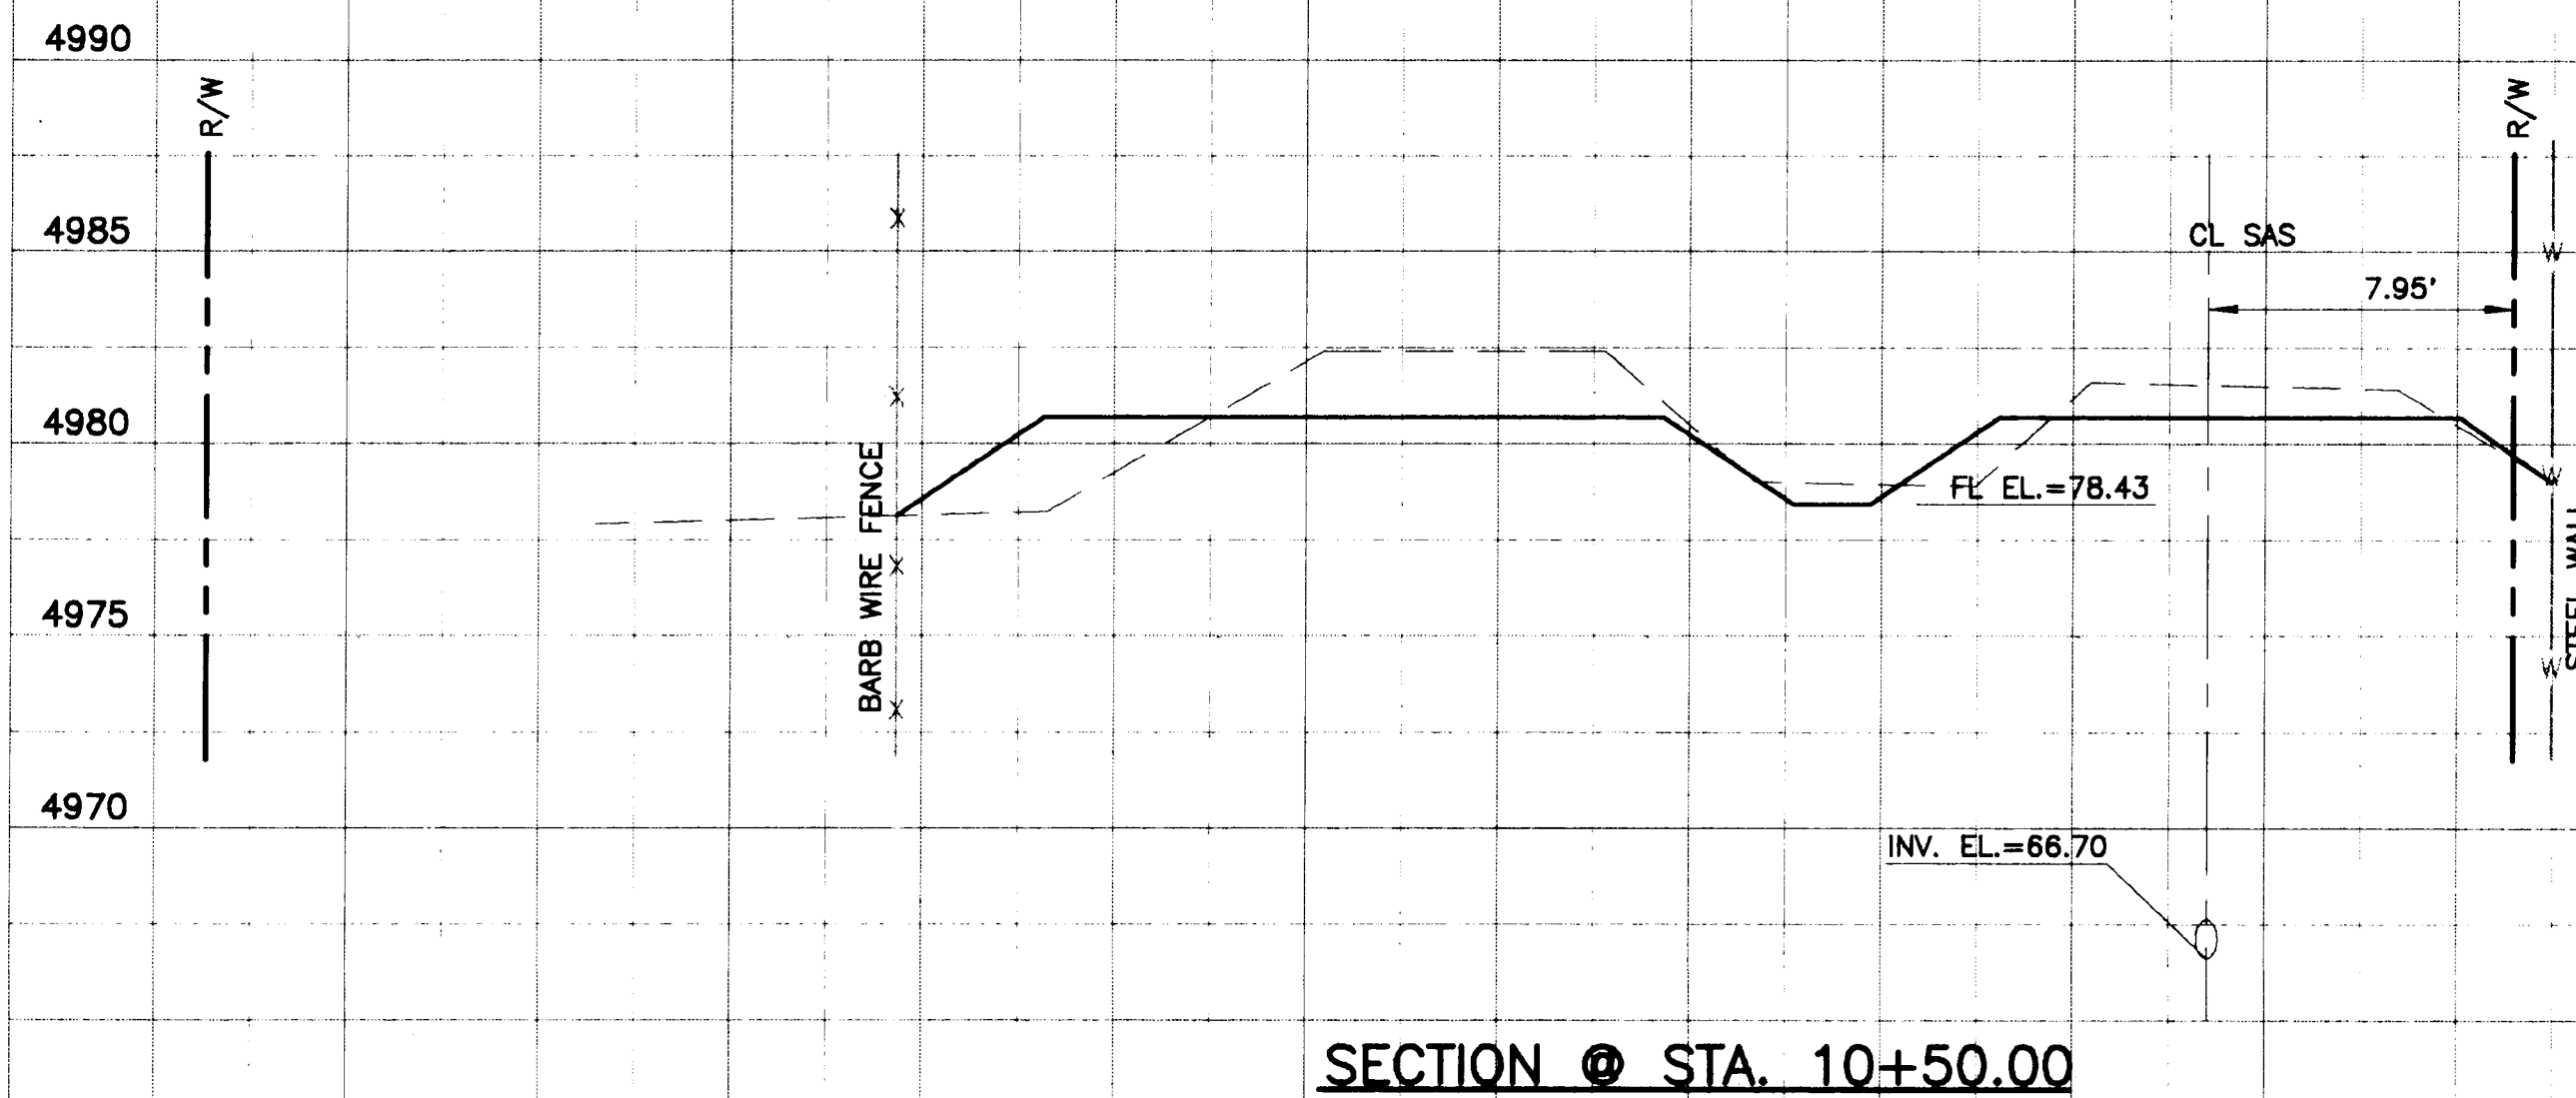


RECORD DRAWING
THIS IS A RECORD DRAWING OF THE FACILITIES IDENTIFIED IN THE TITLE BLOCK ONLY AND HAS BEEN PREPARED BY PART ON THE BASIS OF INFORMATION COMPILED AND FORWARDED BY OTHERS. THE ENGINEER, ARCHITECT AND OTHER (S) WILL NOT BE RESPONSIBLE FOR ANY ERROR (S) OR OMISSION (S) WHICH HAVE BEEN IDENTIFIED IN THIS DRAWING. MATERIAL CONSULTING ALL VARY SOMEWHAT FROM THE CONDITIONS SHOWN HEREIN AND AS SUCH, NO ALIENATION, WARRANTY MAY BE MADE. THE PRESENCE OR ABSENCE OF ANY FACILITY IS REQUIRED TO BE CONFIRMED BY THE FIELD TO THE PRESENCE OF AN EMPLOYEE OF THE DISTRICT OR THE OWNER (S) OF THE UTILITY INVOLVED.

20 3675.93 930693


CITY OF ALBUQUERQUE PUBLIC WORKS DEPARTMENT ENGINEERING GROUP					
TITLE: STOTTS LATERAL CROSS SECTIONS WIDENING OF EDITH BOULEVARD PHASE I					
APPROVALS	ENGINEER	DATE	APPROVALS	ENGINEER	DATE
COA WASTE WATER	<i>Ryan Alan</i>	11/10/93			
BERNALILLO COUNTY					
PROJECT NO.	3675.90 .93	MAP NO.	E-15	SHEET OF	

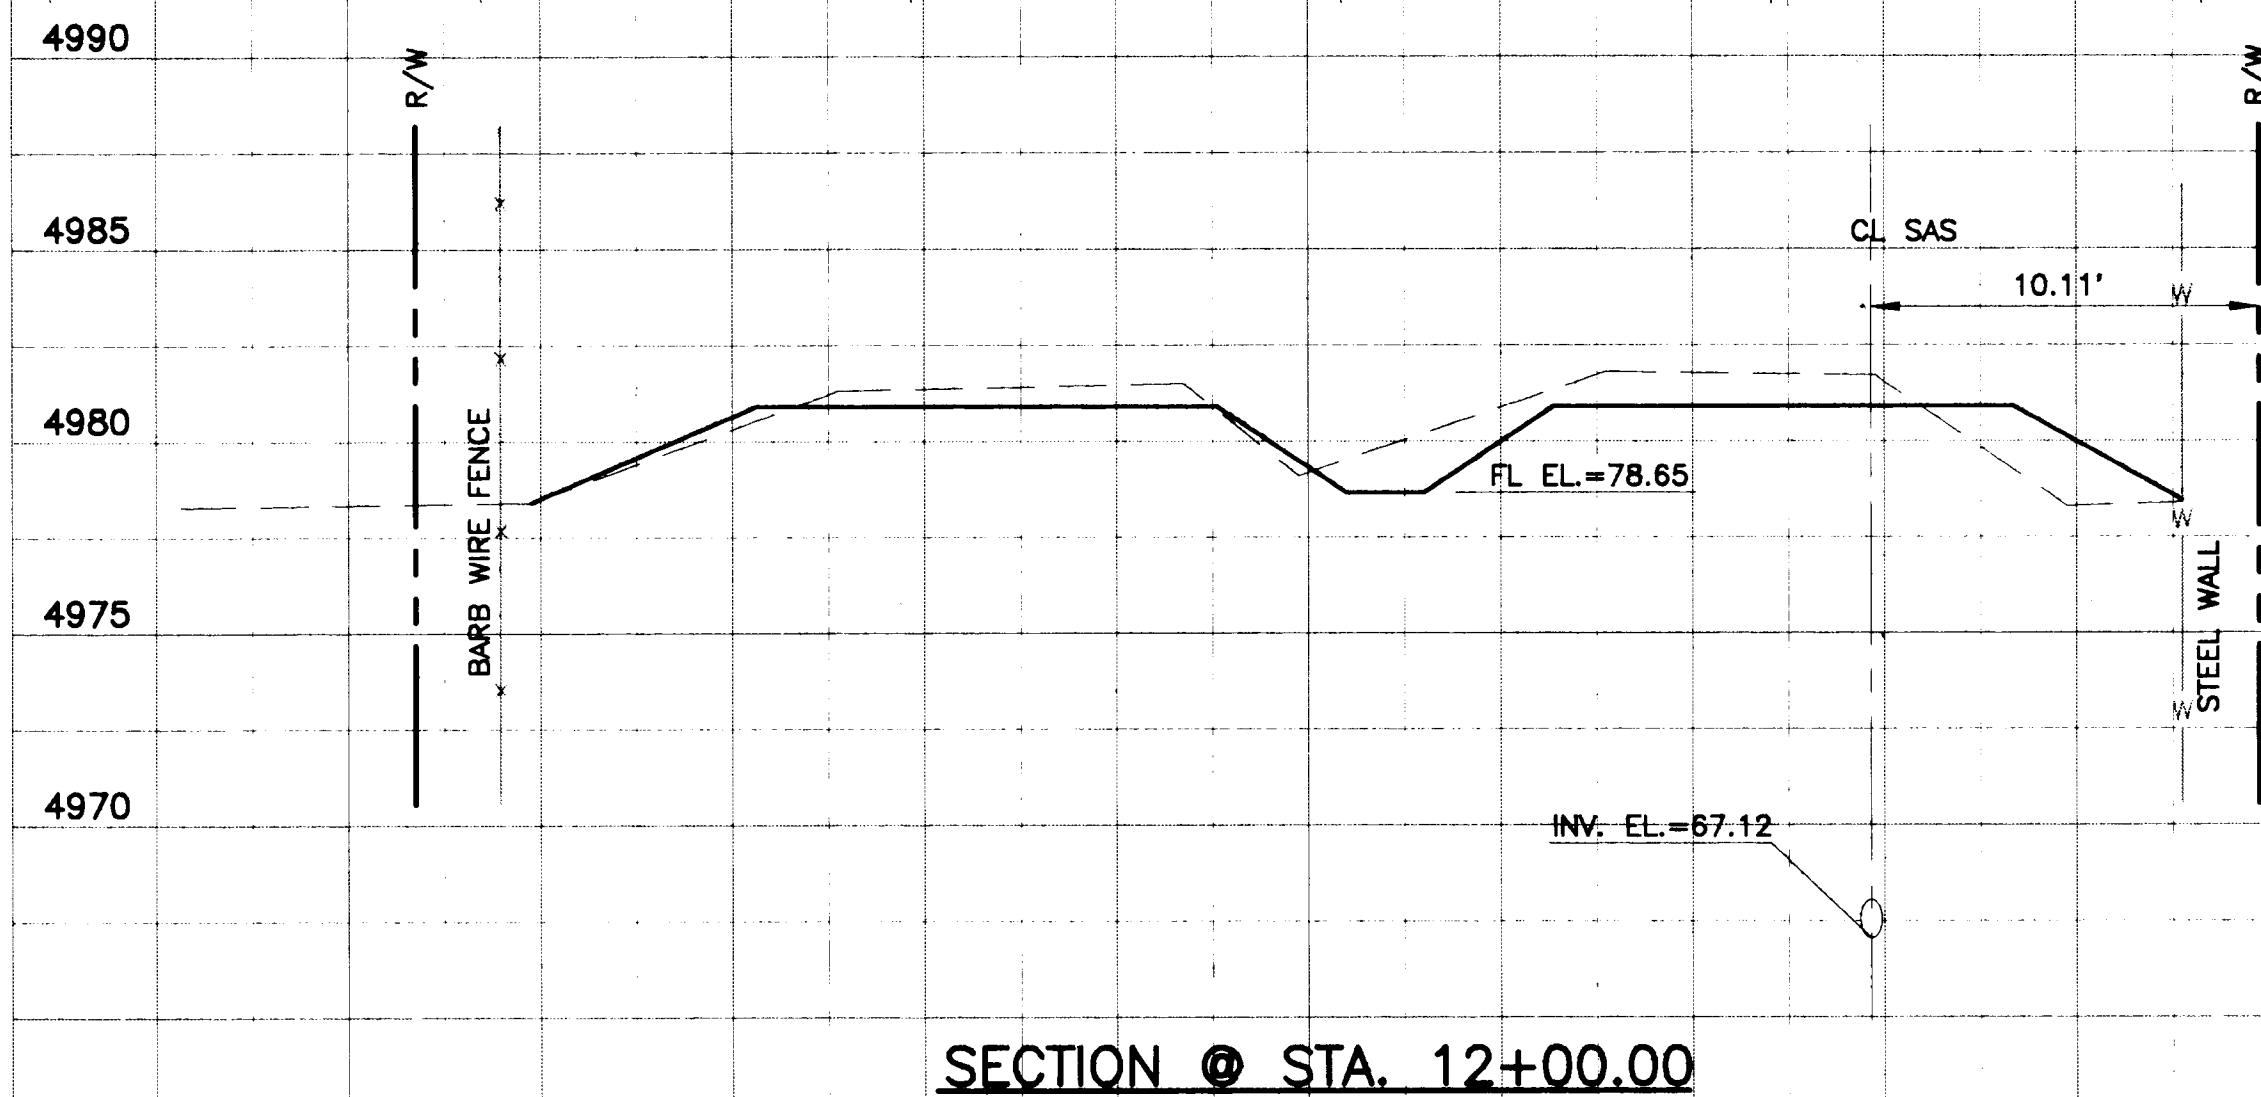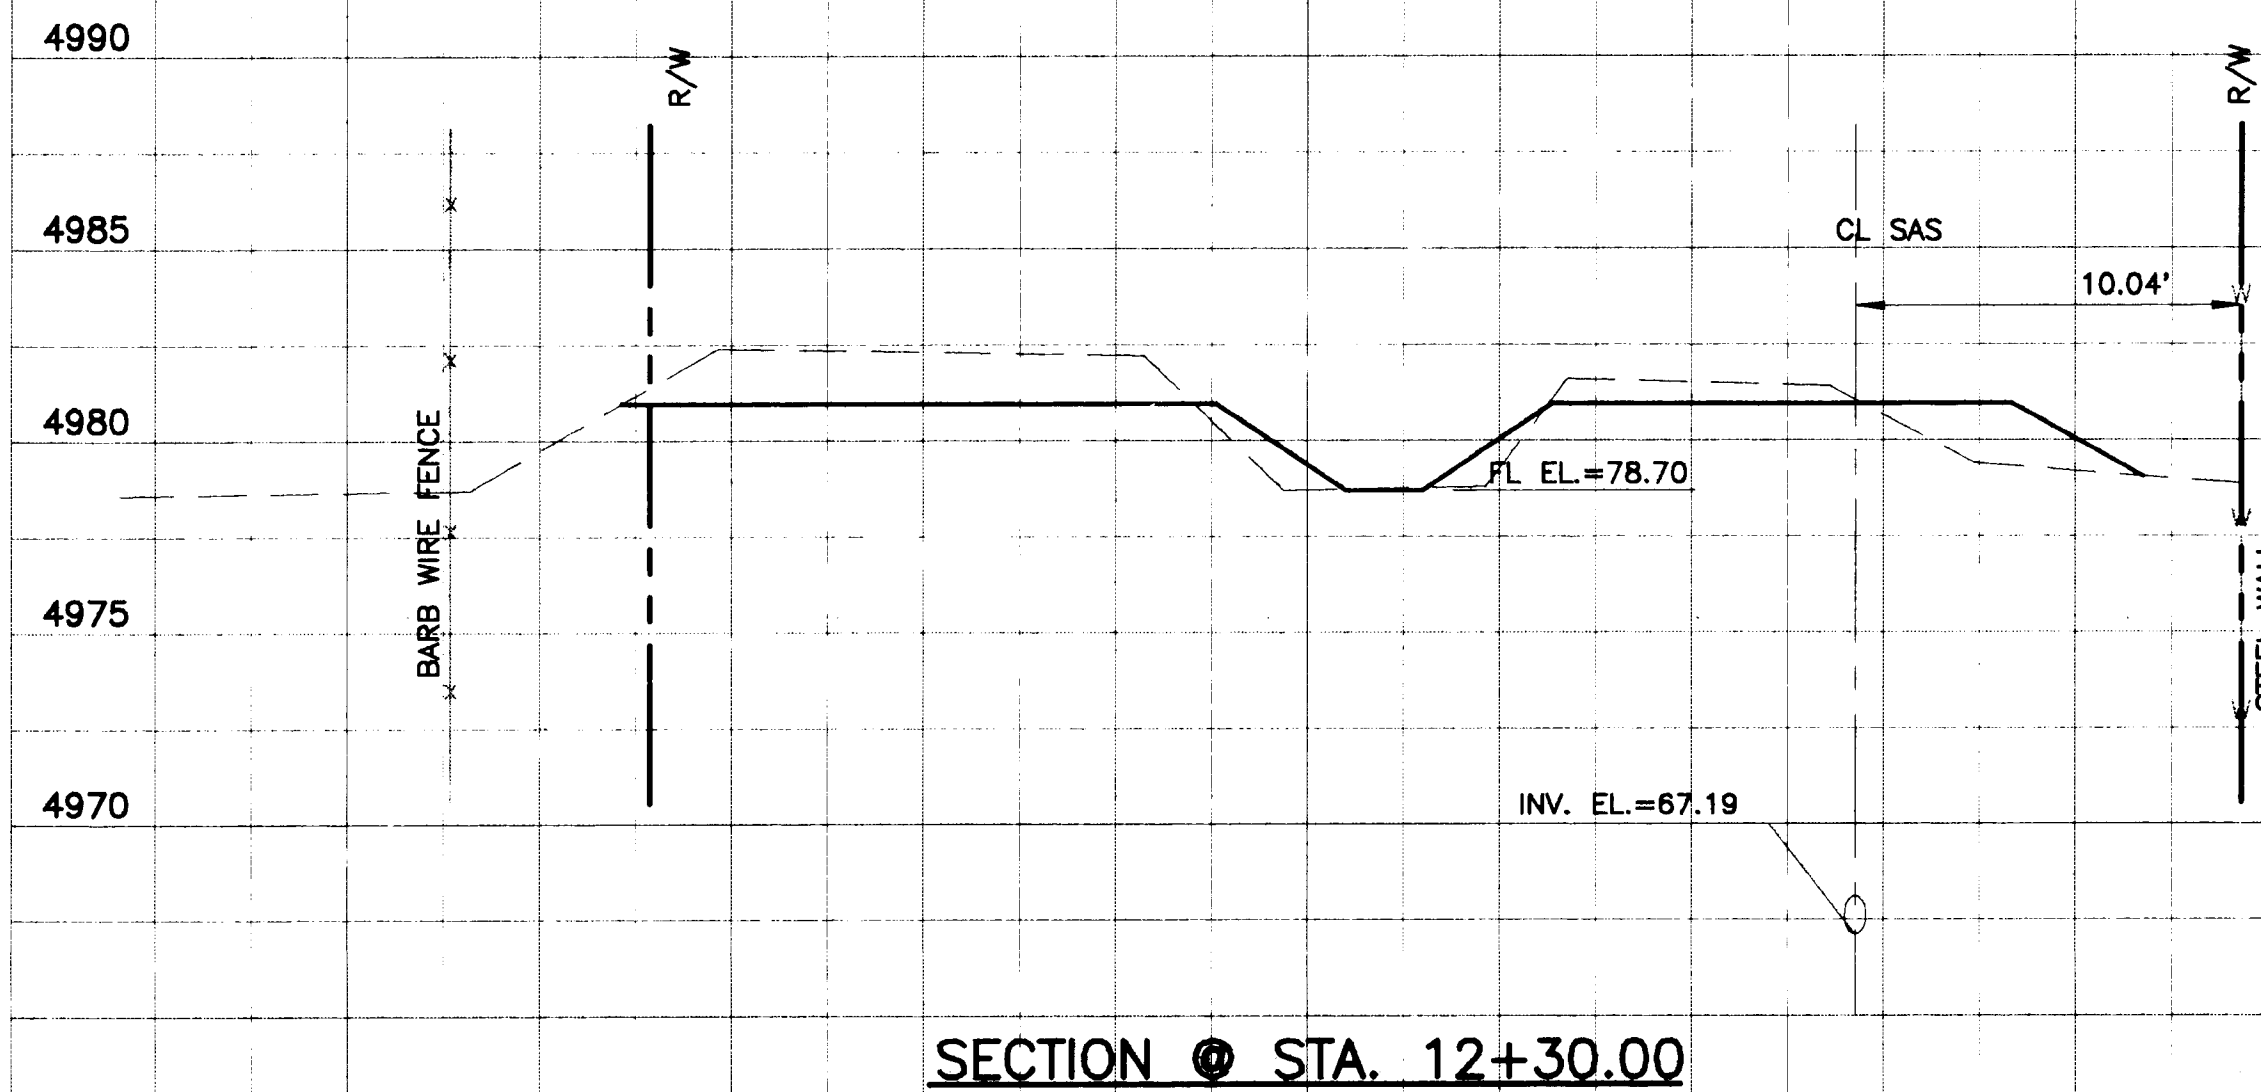


26 3675.90 93

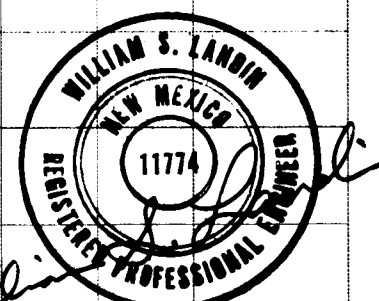


RECORD DRAWING
THIS IS A RECORD DRAWING OF THE FACILITIES IDENTIFIED IN THE TITLE BLOCK ONLY AND HAS BEEN PREPARED IN PART ON THE BASIS OF INFORMATION COMPILED AND FURNISHED BY OTHERS. THE ENGINEER, ARCHITECT AND OTHER (S) WILL NOT BE RESPONSIBLE FOR ANY ERROR (S) OR OMISSION (S) WHICH HAVE BEEN INCORPORATED INTO THIS DRAWING. ACTUAL CONDITIONS WILL VARY SOMEWHAT FROM THE CONDITIONS SHOWN HEREON AND AT SOME LOCATIONS THE VARIANCE MAY BE LARGE. IF THE PRECISE LOCATION OF ANY FACILITY IS REQUIRED, THE FACILITY SHOULD BE FIELD LOCATED IN THE PRESENCE OF AN EMPLOYEE OF THE UTILITY OR THE OWNER OF THE UTILITIES INVOLVED.

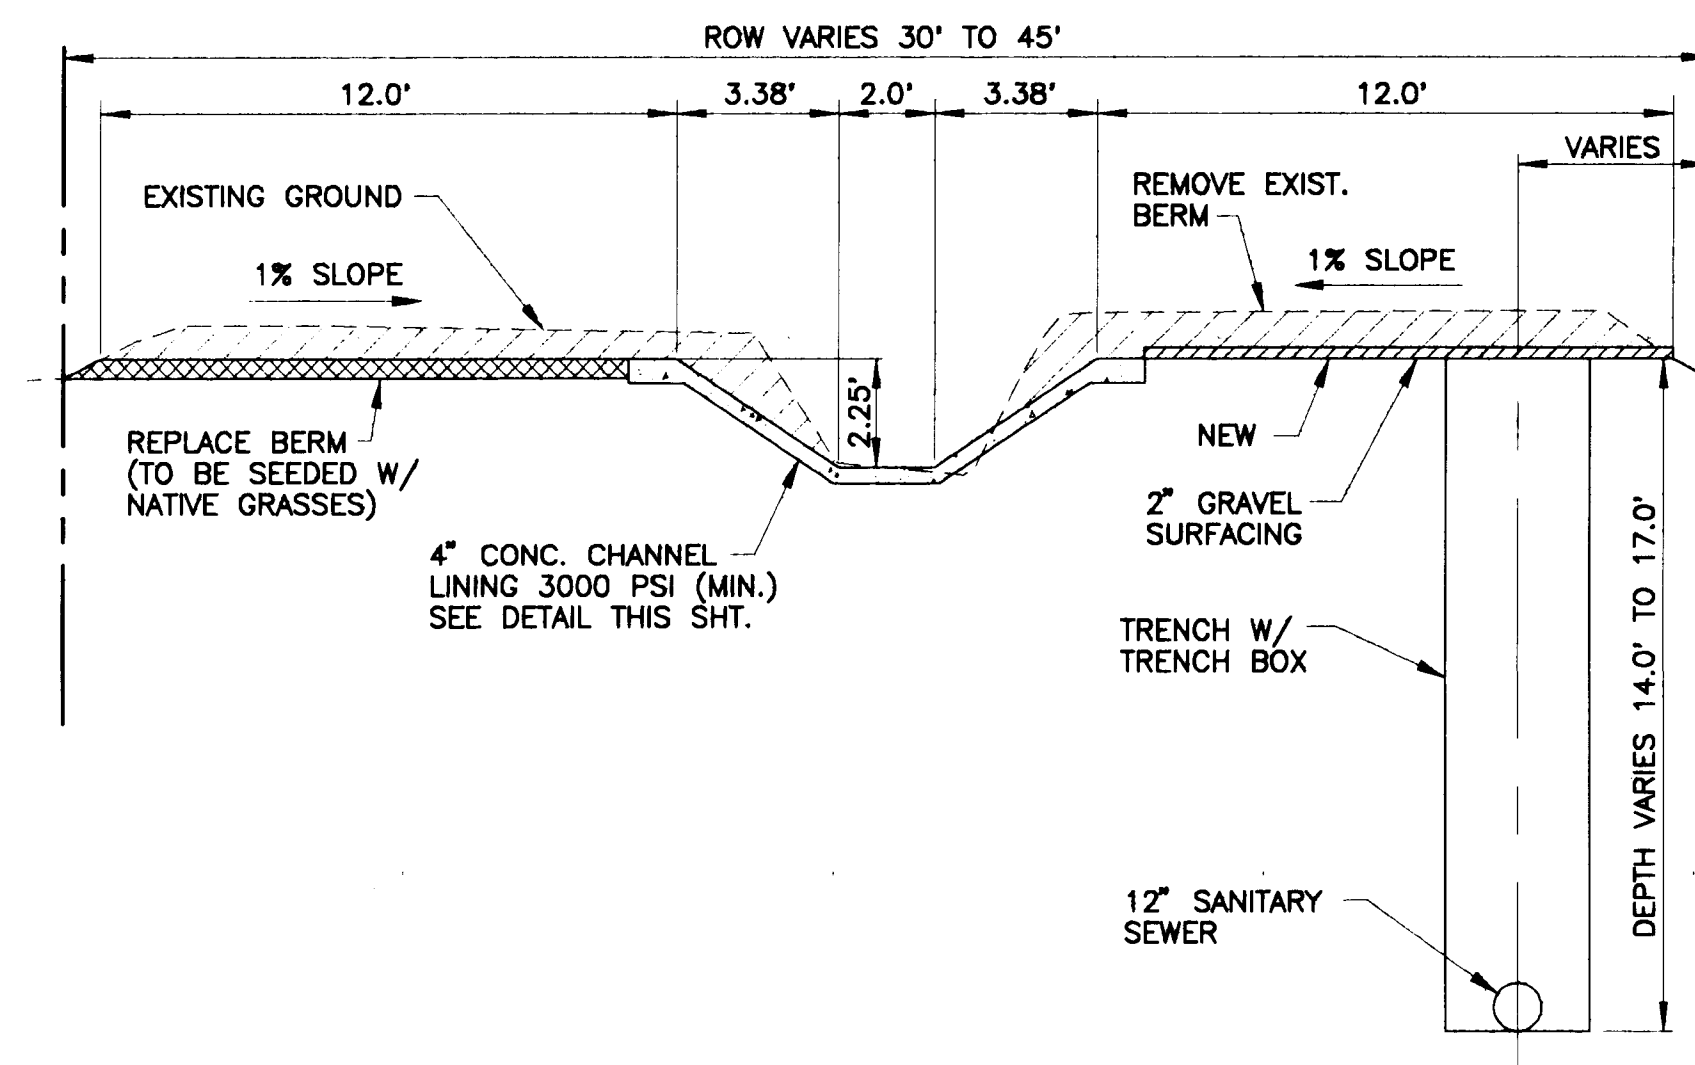


TYPICAL CHANNEL SECTION
N.T.S.

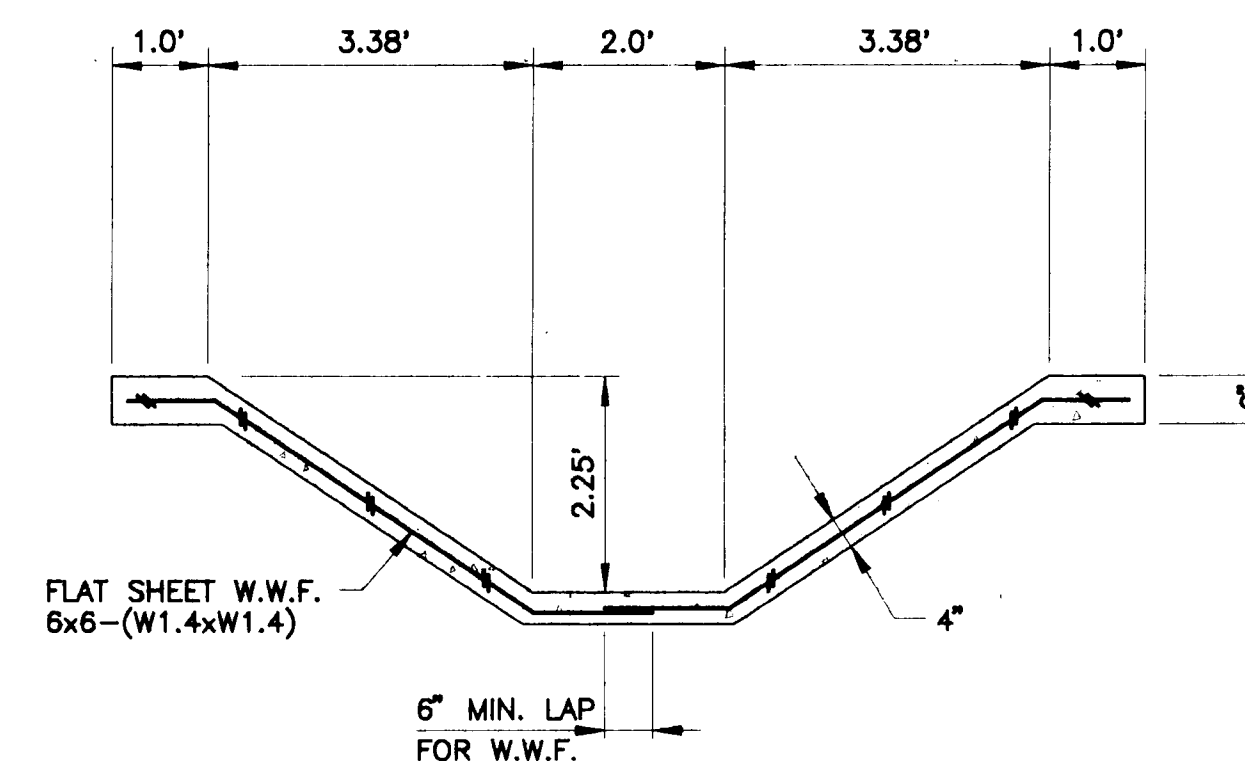


CHANNEL DETAIL
1\"/>

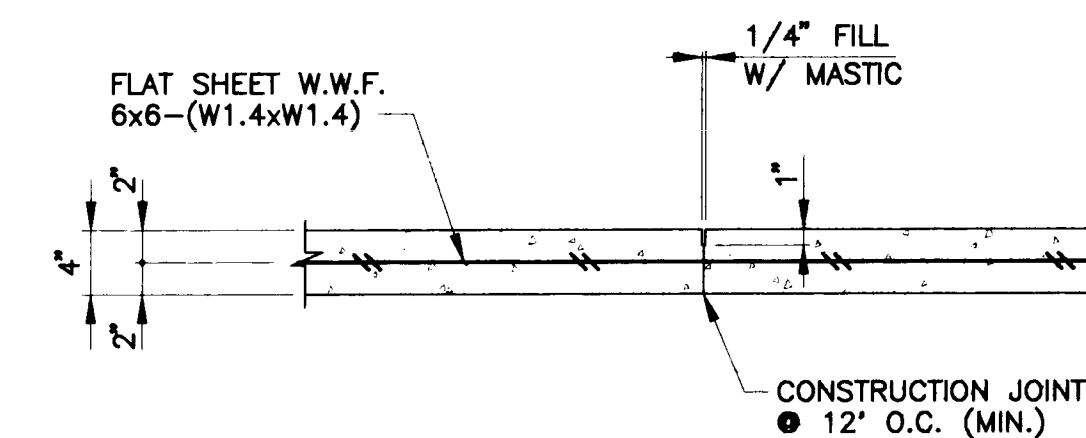


GROOVE JOINT DETAIL
1\"/>

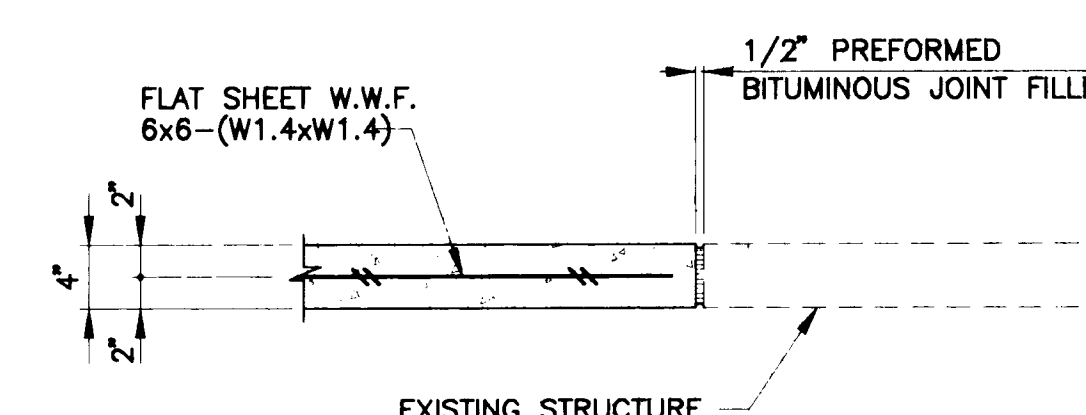


EXPANSION JOINT DETAIL
1\"/>

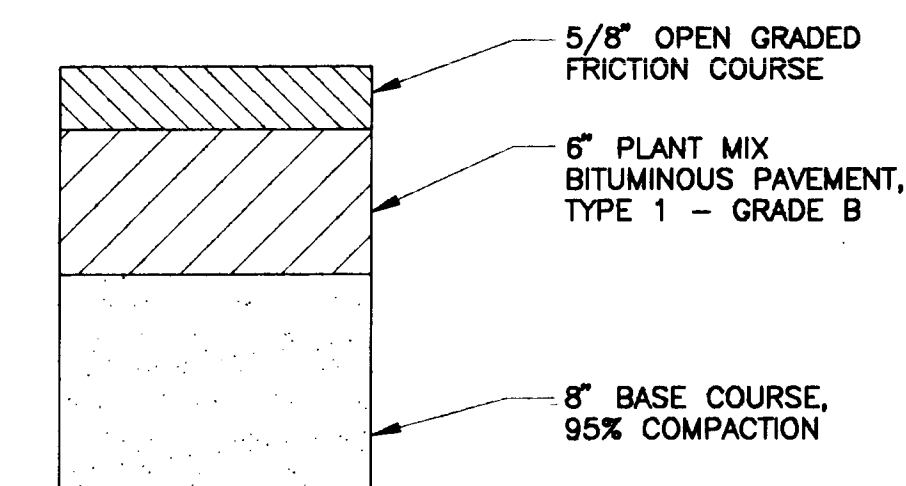


**TYPICAL STREET SECTION FOR PAVEMENT
REPLACEMENT ON 2nd STREET**
N.T.S.

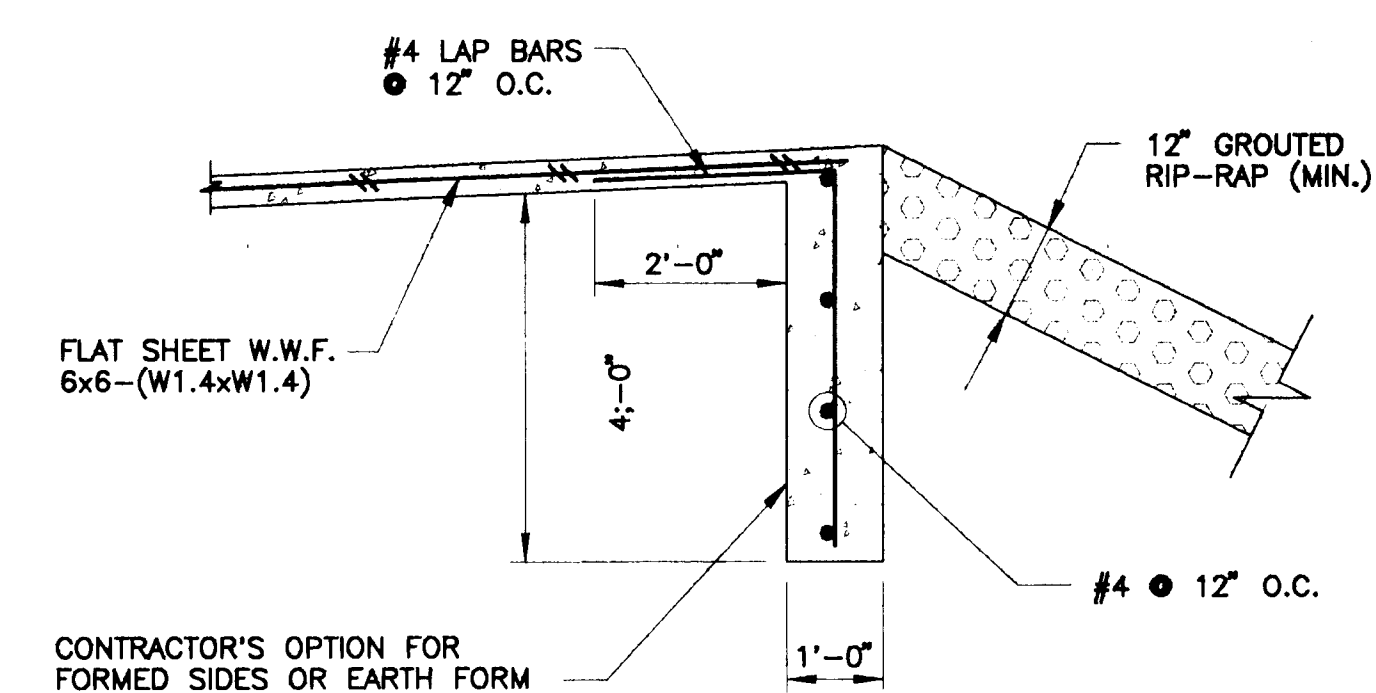


CUT-OFF WALL DETAIL
1/2\"/>

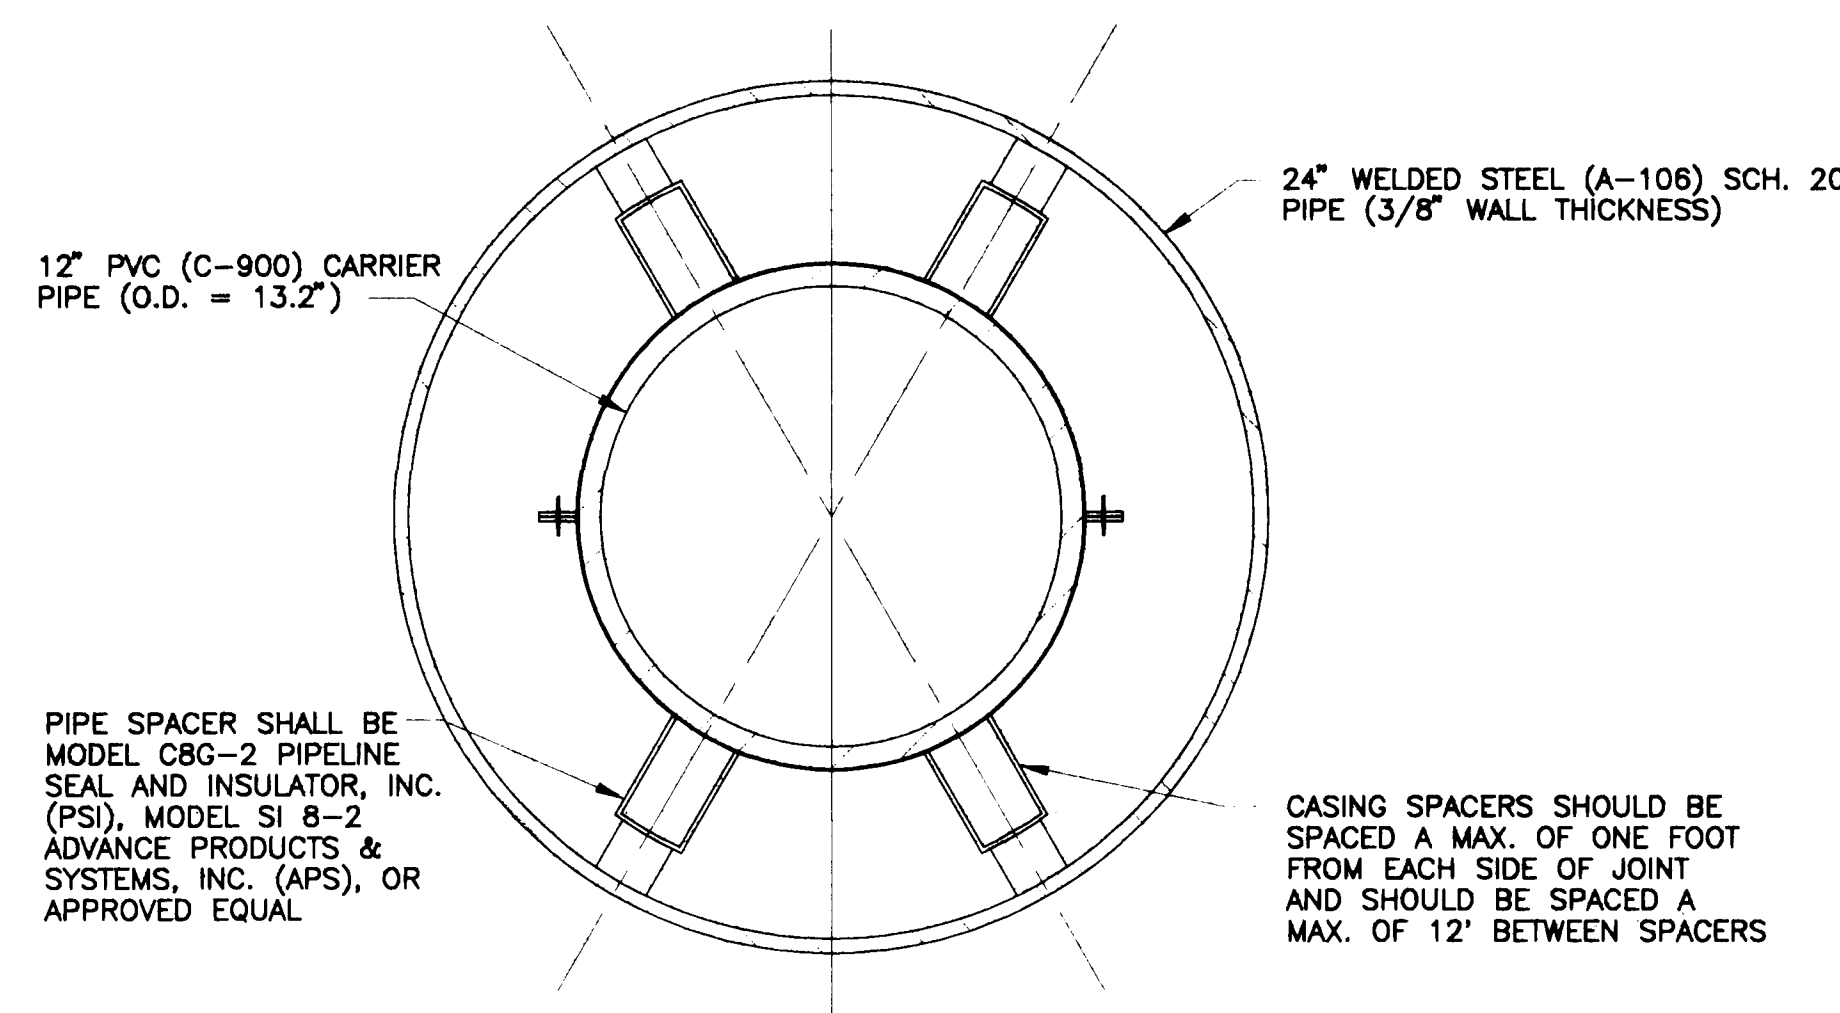


BORING ENCASEMENT DETAIL
1\"/>

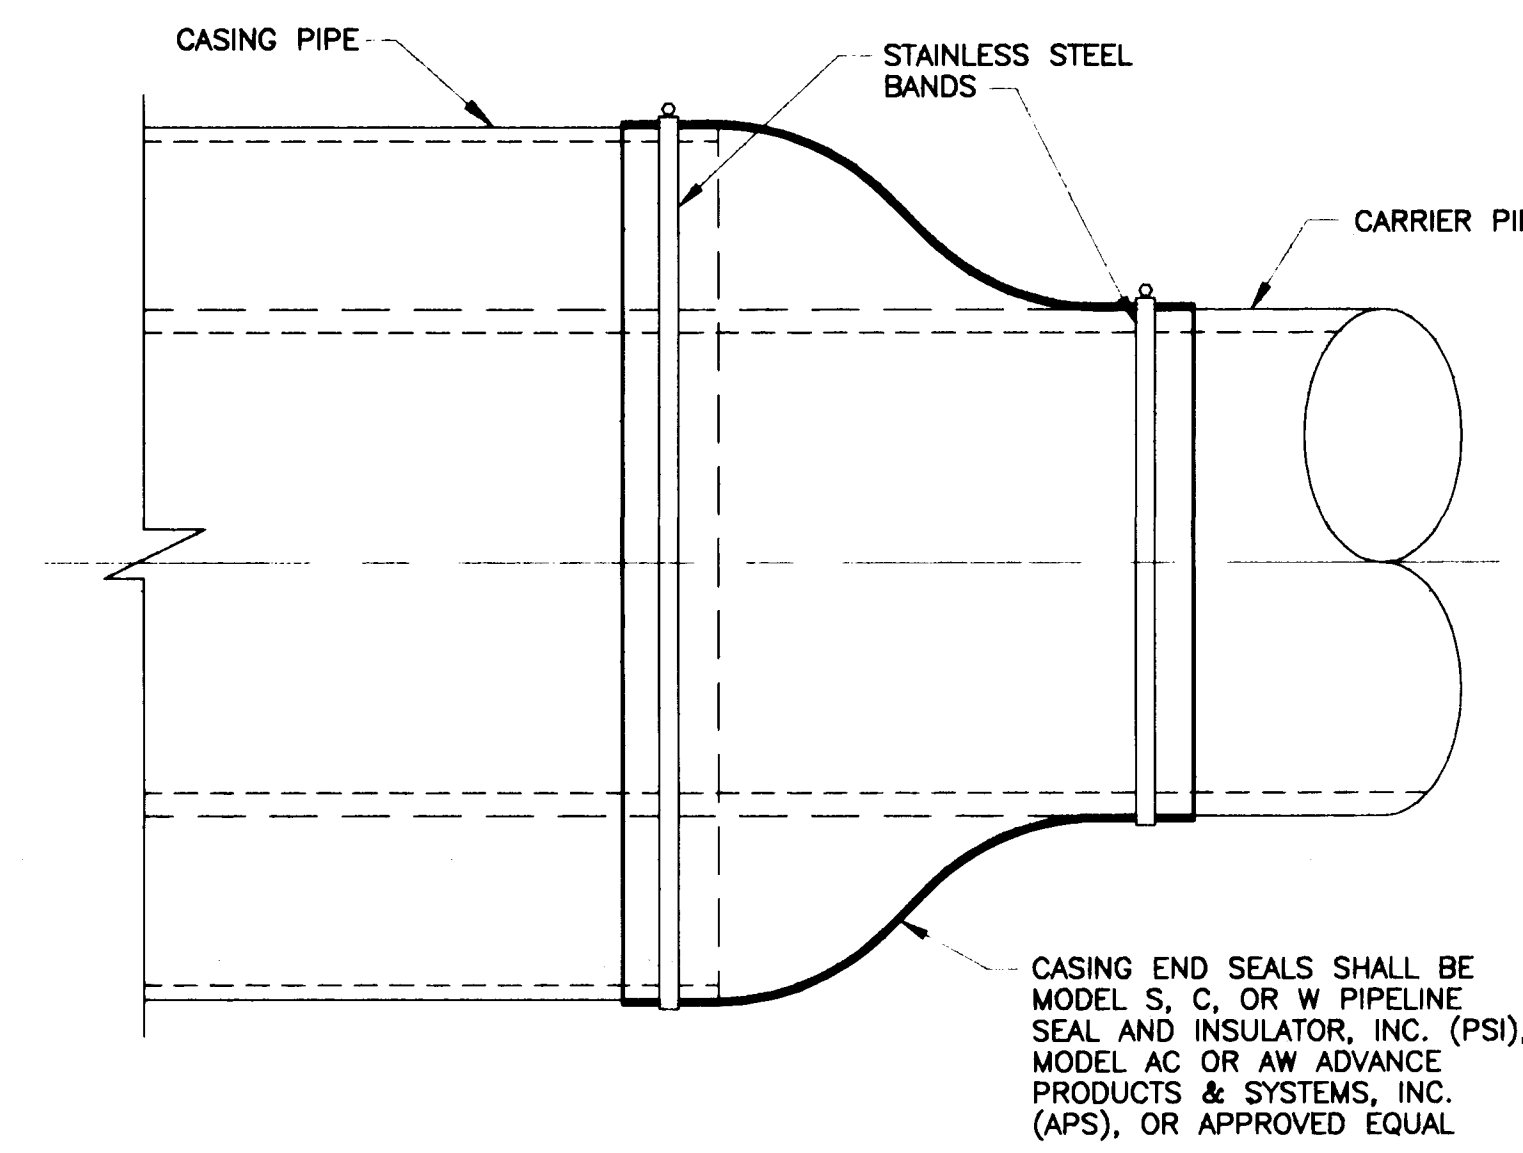

END SEAL DETAIL
N.T.S.

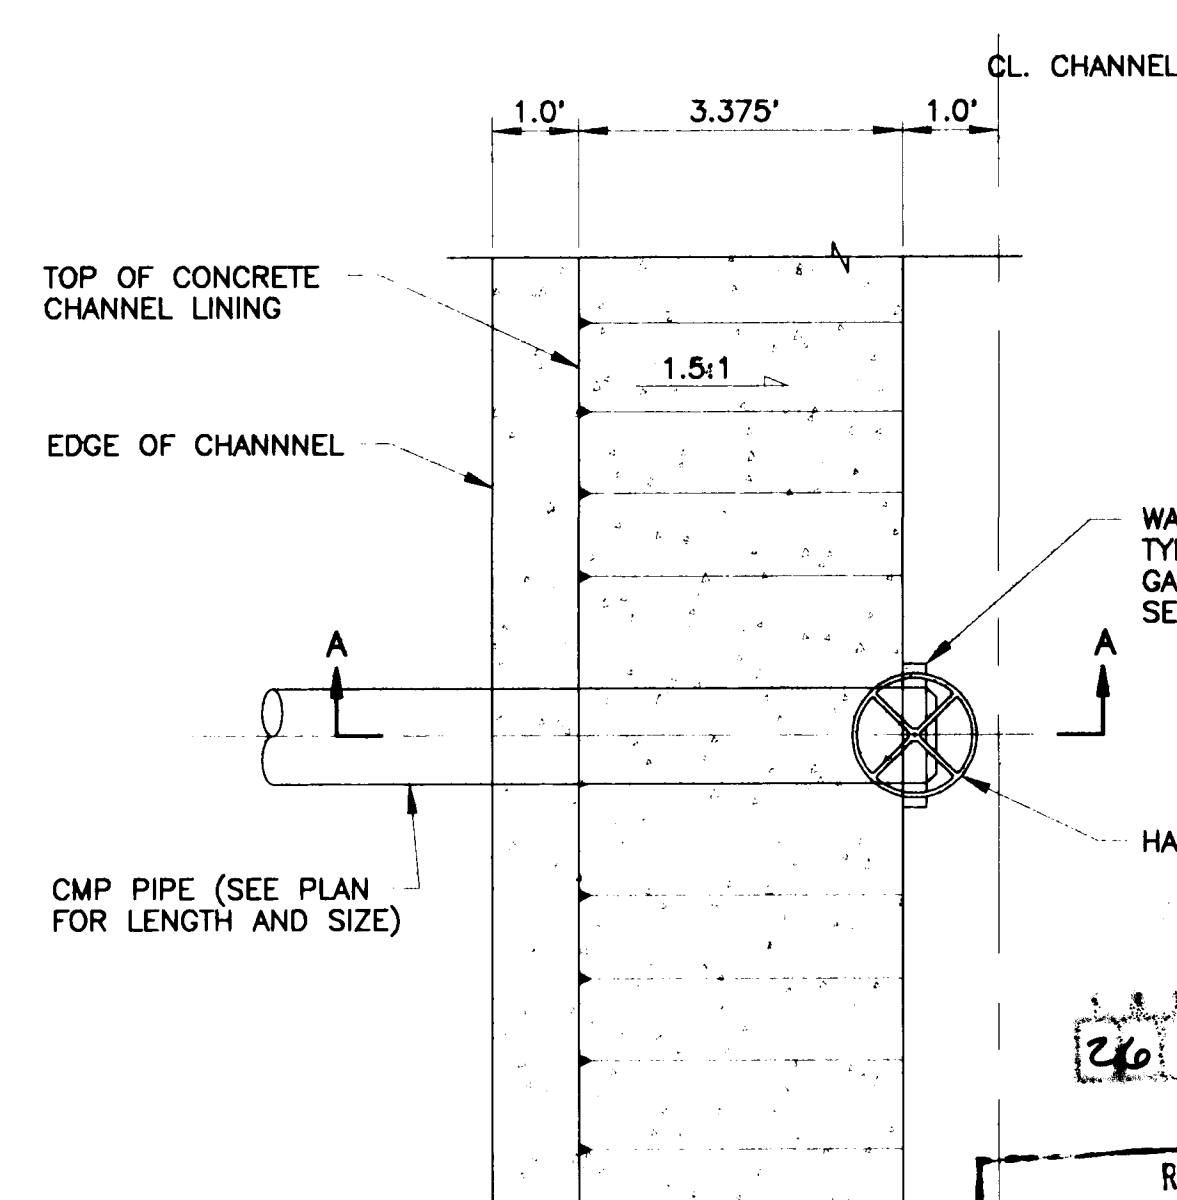

CANAL GATE AND OUTLET PIPE PLAN
1\"/>

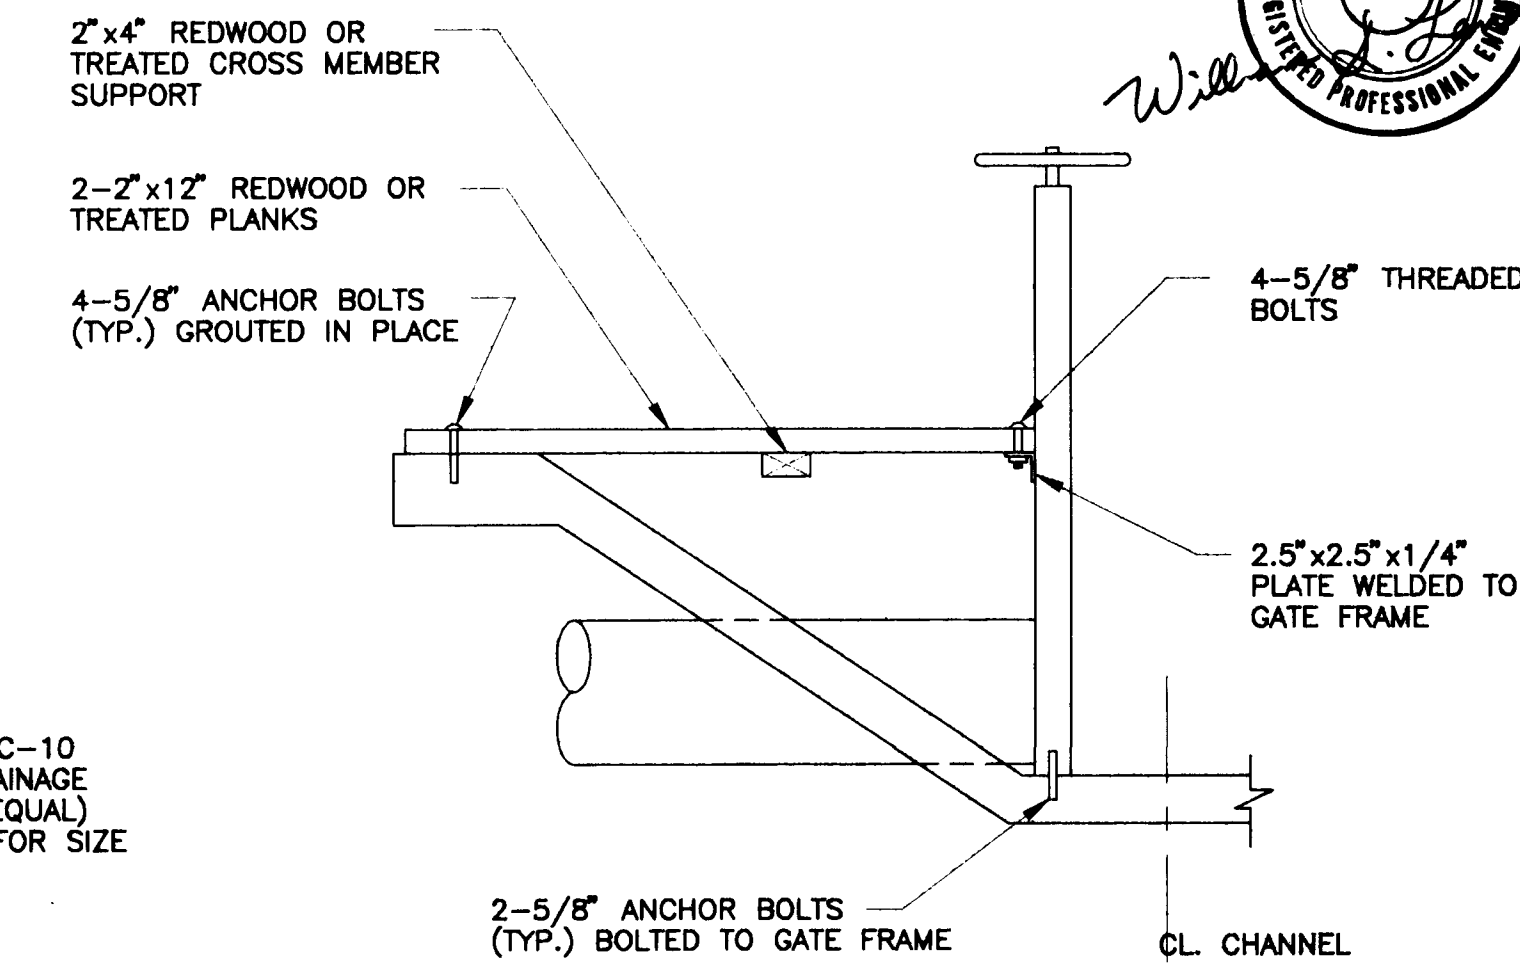


SECTION A-A CANAL GATE AND OUTLET PIPE
3/4\"/>


NOTE:
THE CONTRACTOR SHALL BE RESPONSIBLE FOR LOCATING ANY UNDERGROUND UTILITIES AND FOR ANY DAMAGE RESULTING THERETO. THE CONTRACTOR SHALL BE RESPONSIBLE FOR PRODUCING A SOUND, TIGHT INSTALLATION, TRUE TO LINE AND GRADE. CARRIER PIPE SHALL BE SKIDDED THROUGH THE CASING ON PVC OR EPOXY FUSION COATED STEEL SPACERS. INSTALL SPACERS AND END SEALS IN ACCORDANCE WITH MANUFACTURER'S PRINTED INSTRUCTIONS.

RECORD DRAWING
THIS IS A RECORD DRAWING OF THE FACILITIES IDENTIFIED IN THE TITLE BLOCK ONLY AND HAS BEEN PREPARED IN PART ON THE BASIS OF INFORMATION SUPPLIED AND FURNISHED BY OTHERS. THE ENGINEER HAS NOT AND OTHERS WILL NOT BE RESPONSIBLE FOR ANY ERRORS OR OMISSIONS WHICH MAY BE PRESENT IN ANY INFORMATION. THE ENGINEER'S RESPONSIBILITY IS LIMITED TO THE PREPARED LOCATION OF ANY FACILITY IS REVISED. THE FACILITY SHOULD BE 10 TO 15 FEET IN THE PLACEMENT OF AN EMPLOYEE OF THE DISTRICT OR THE OWNER OR OF THE UTILITIES INVOLVED.


CITY OF ALBUQUERQUE PUBLIC WORKS DEPARTMENT ENGINEERING GROUP					
TITLE: STOTTS LATERAL TYPICAL DETAILS WIDENING OF EDITH BOULEVARD PHASE I					
APPROVALS	ENGINEER	DATE	APPROVALS	ENGINEER	DATE
COA	<i>R. J. [Signature]</i>	11/10/93			
WASTE WATER					
MRGCD			BERNALILLO COUNTY		
PROJECT NO.	3675.96 .93	MAP NO.		SHEET OF	

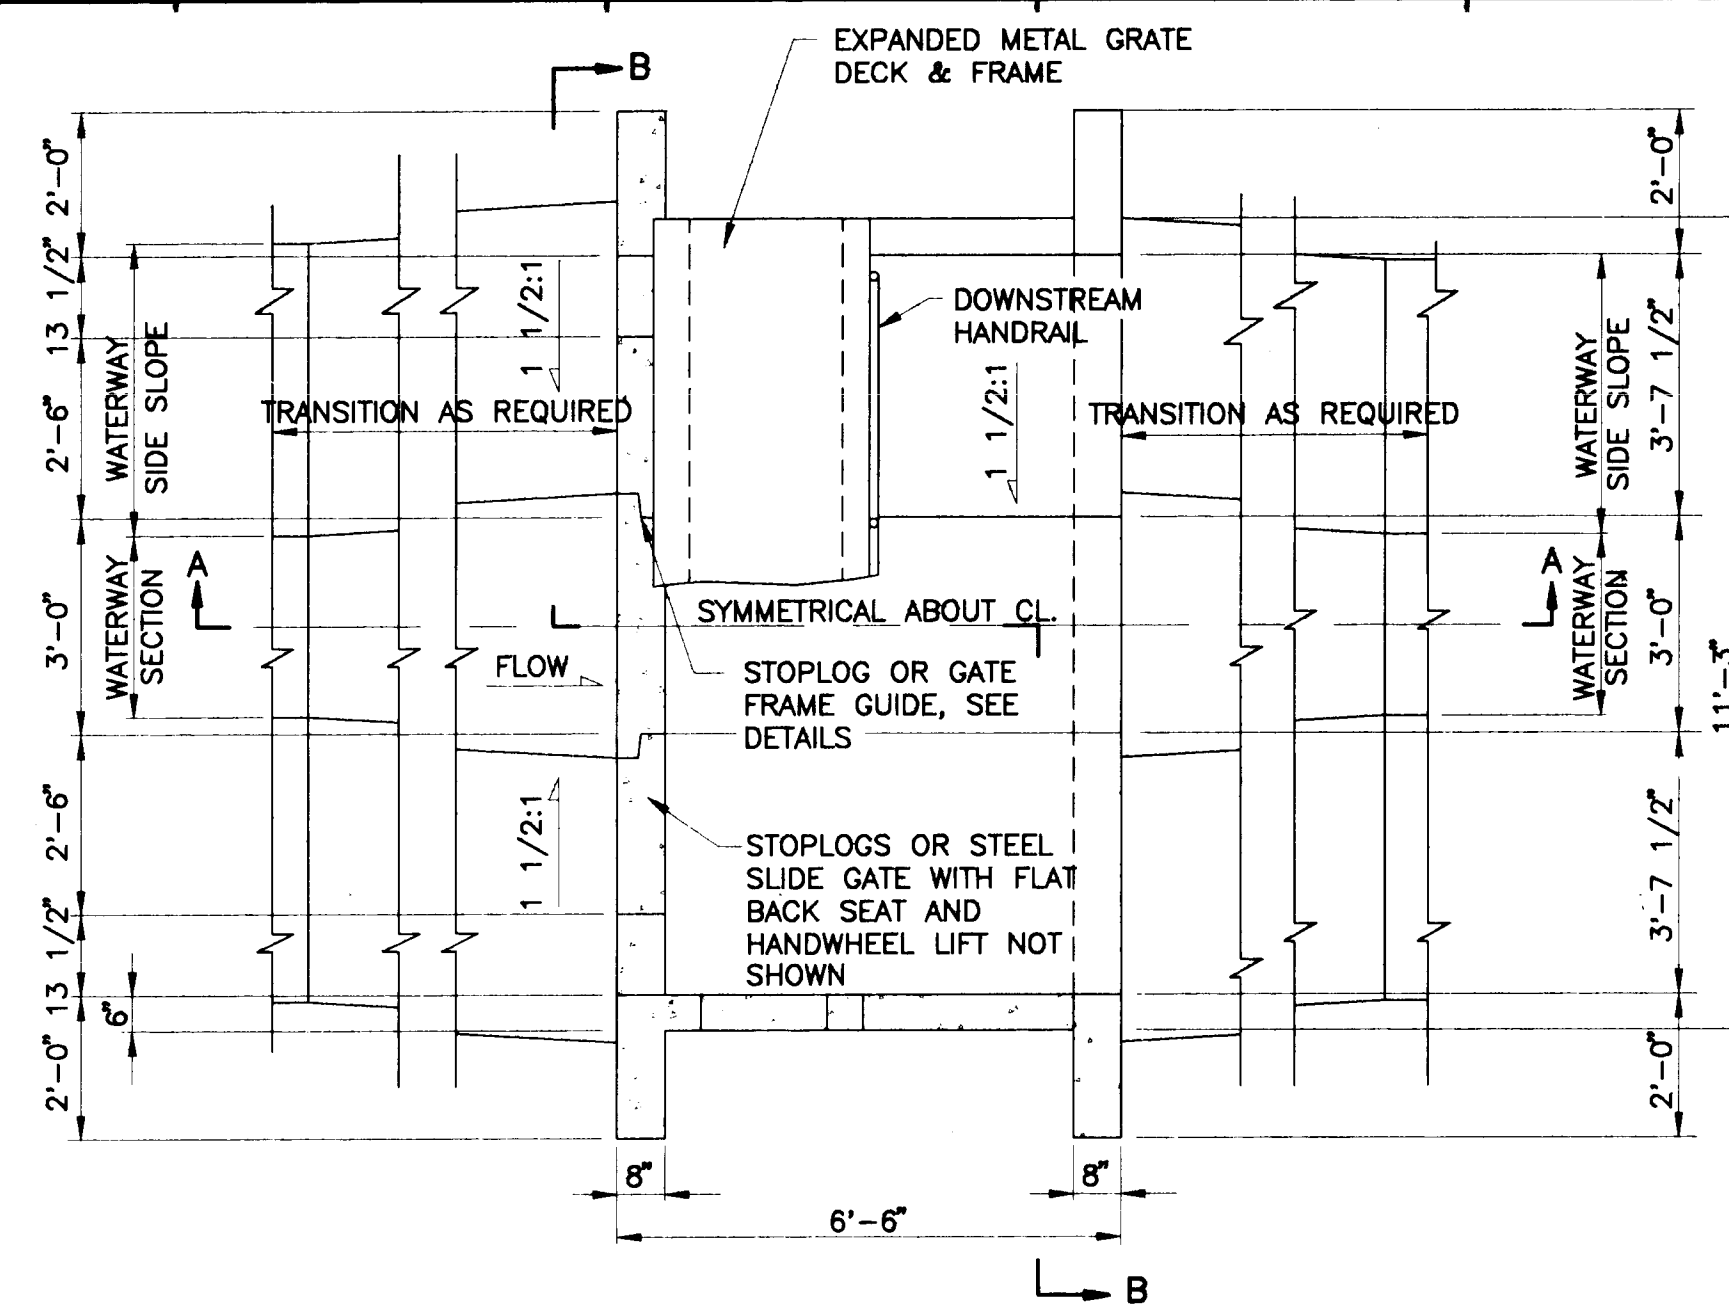


CHECK - STRUCTURE PLAN
3/8" = 1'-0"

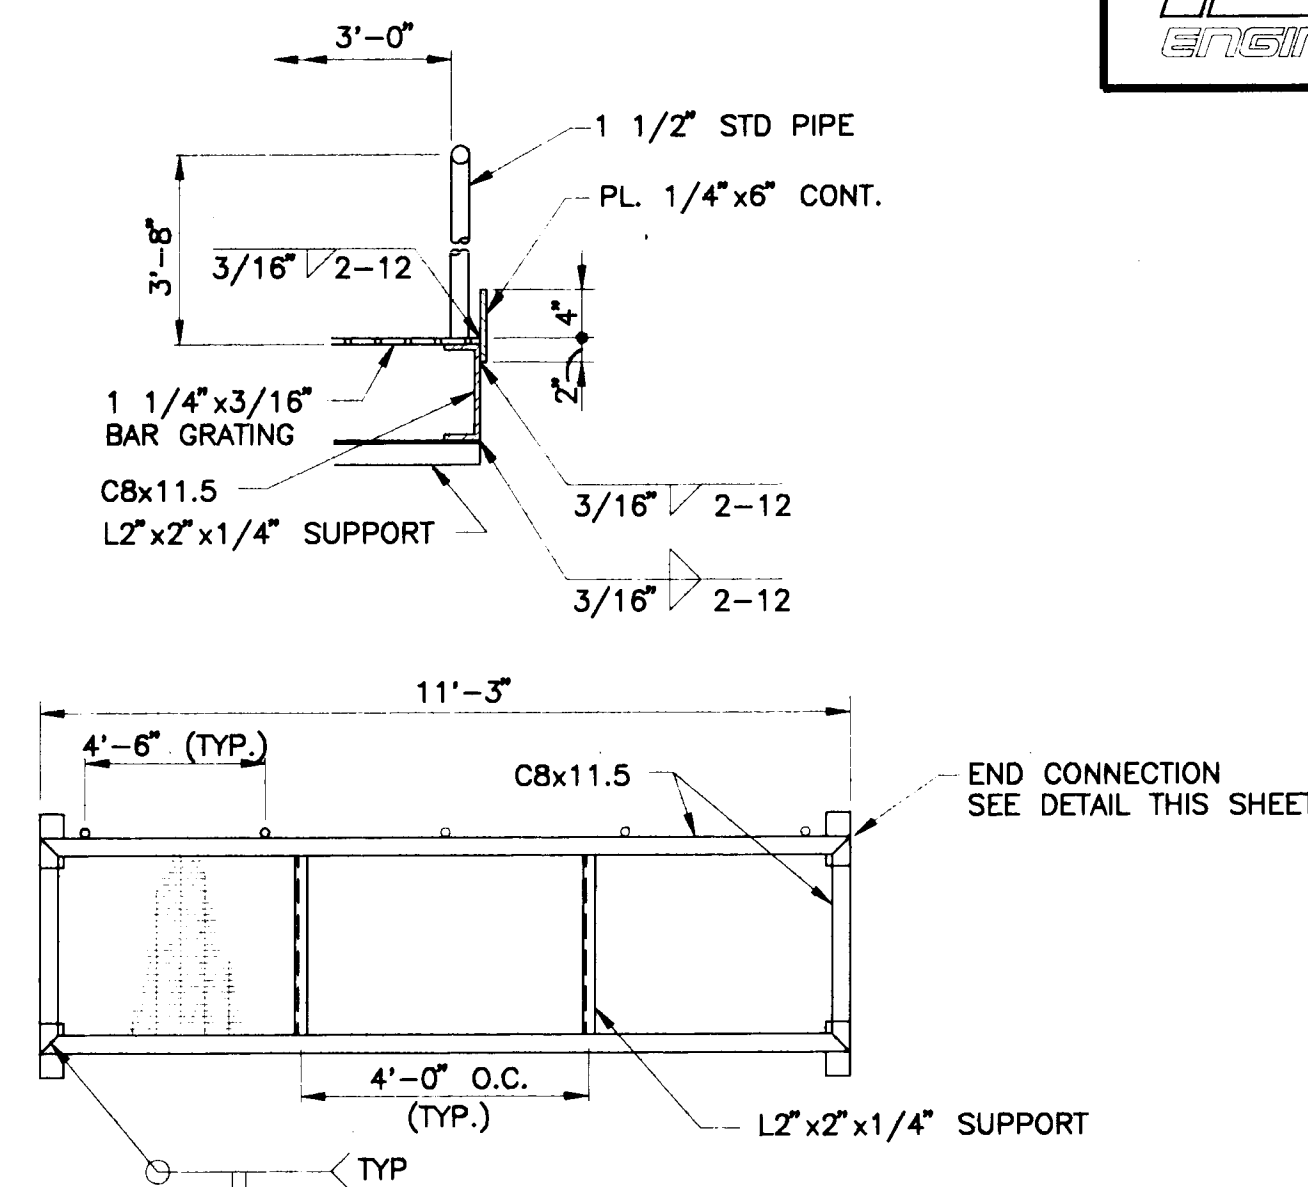


EXPANDED METAL GRATE DECK & FRAME DETAIL
3/4" = 1'-0"

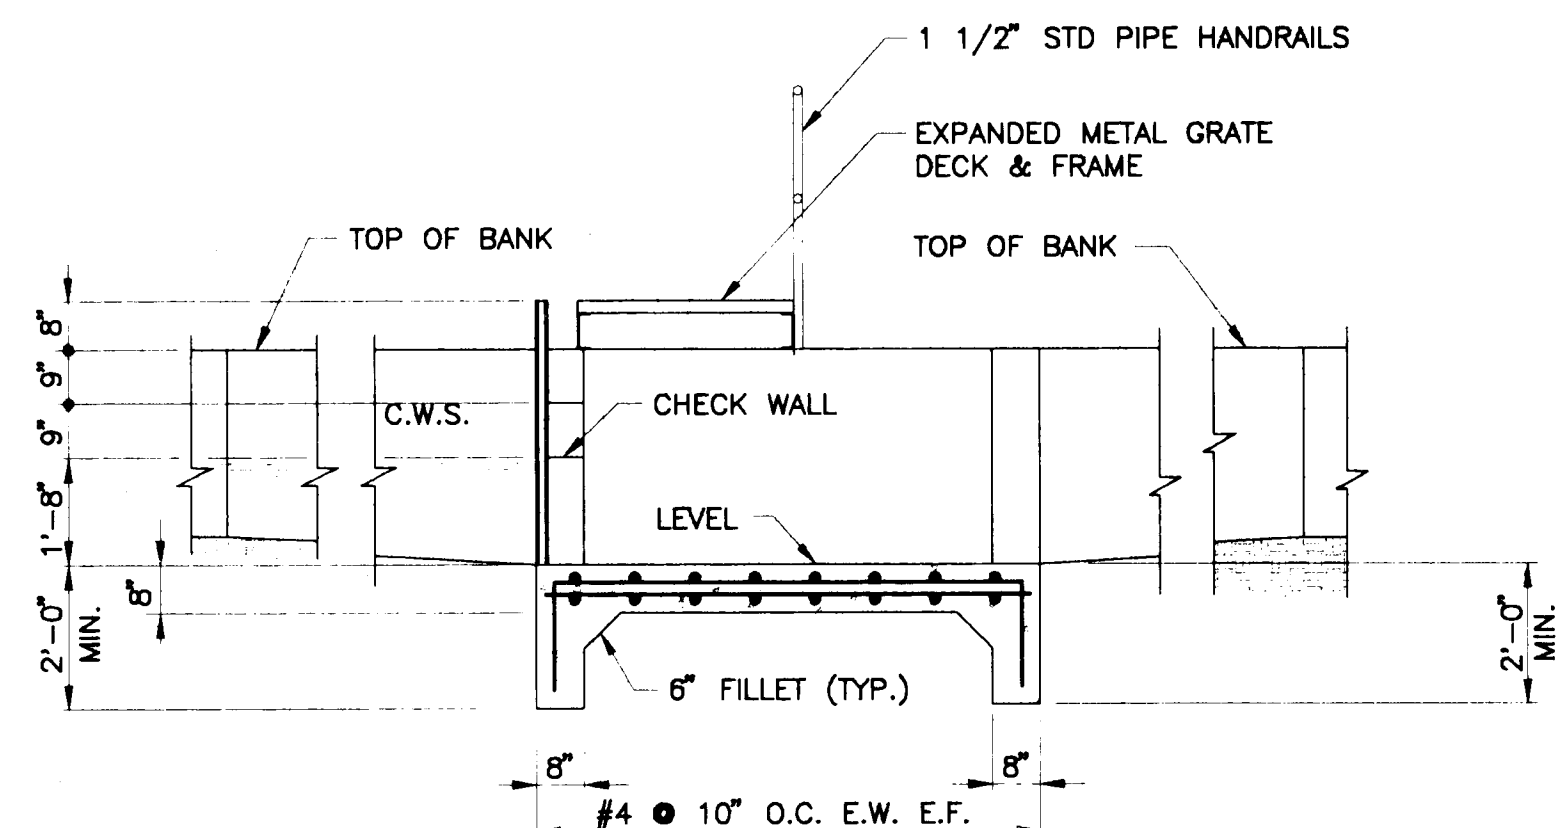


SECTION A-A
3/8" = 1'-0"

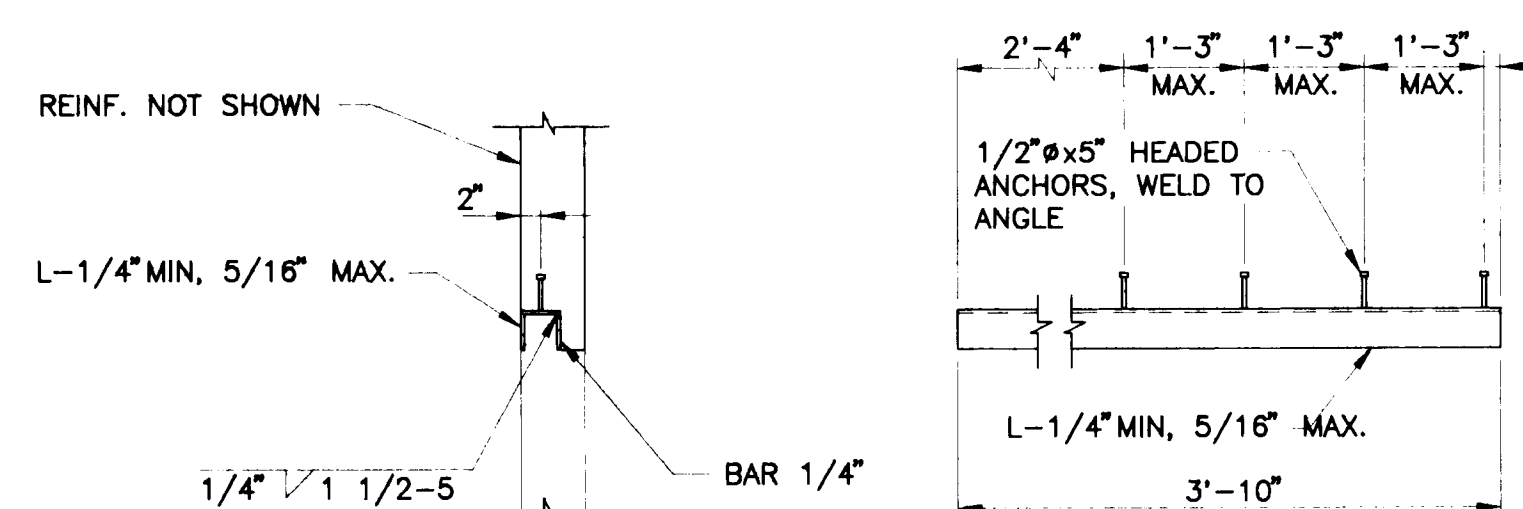

STOPLOG OR GATE FRAME DETAILS
3/4" = 1'-0"

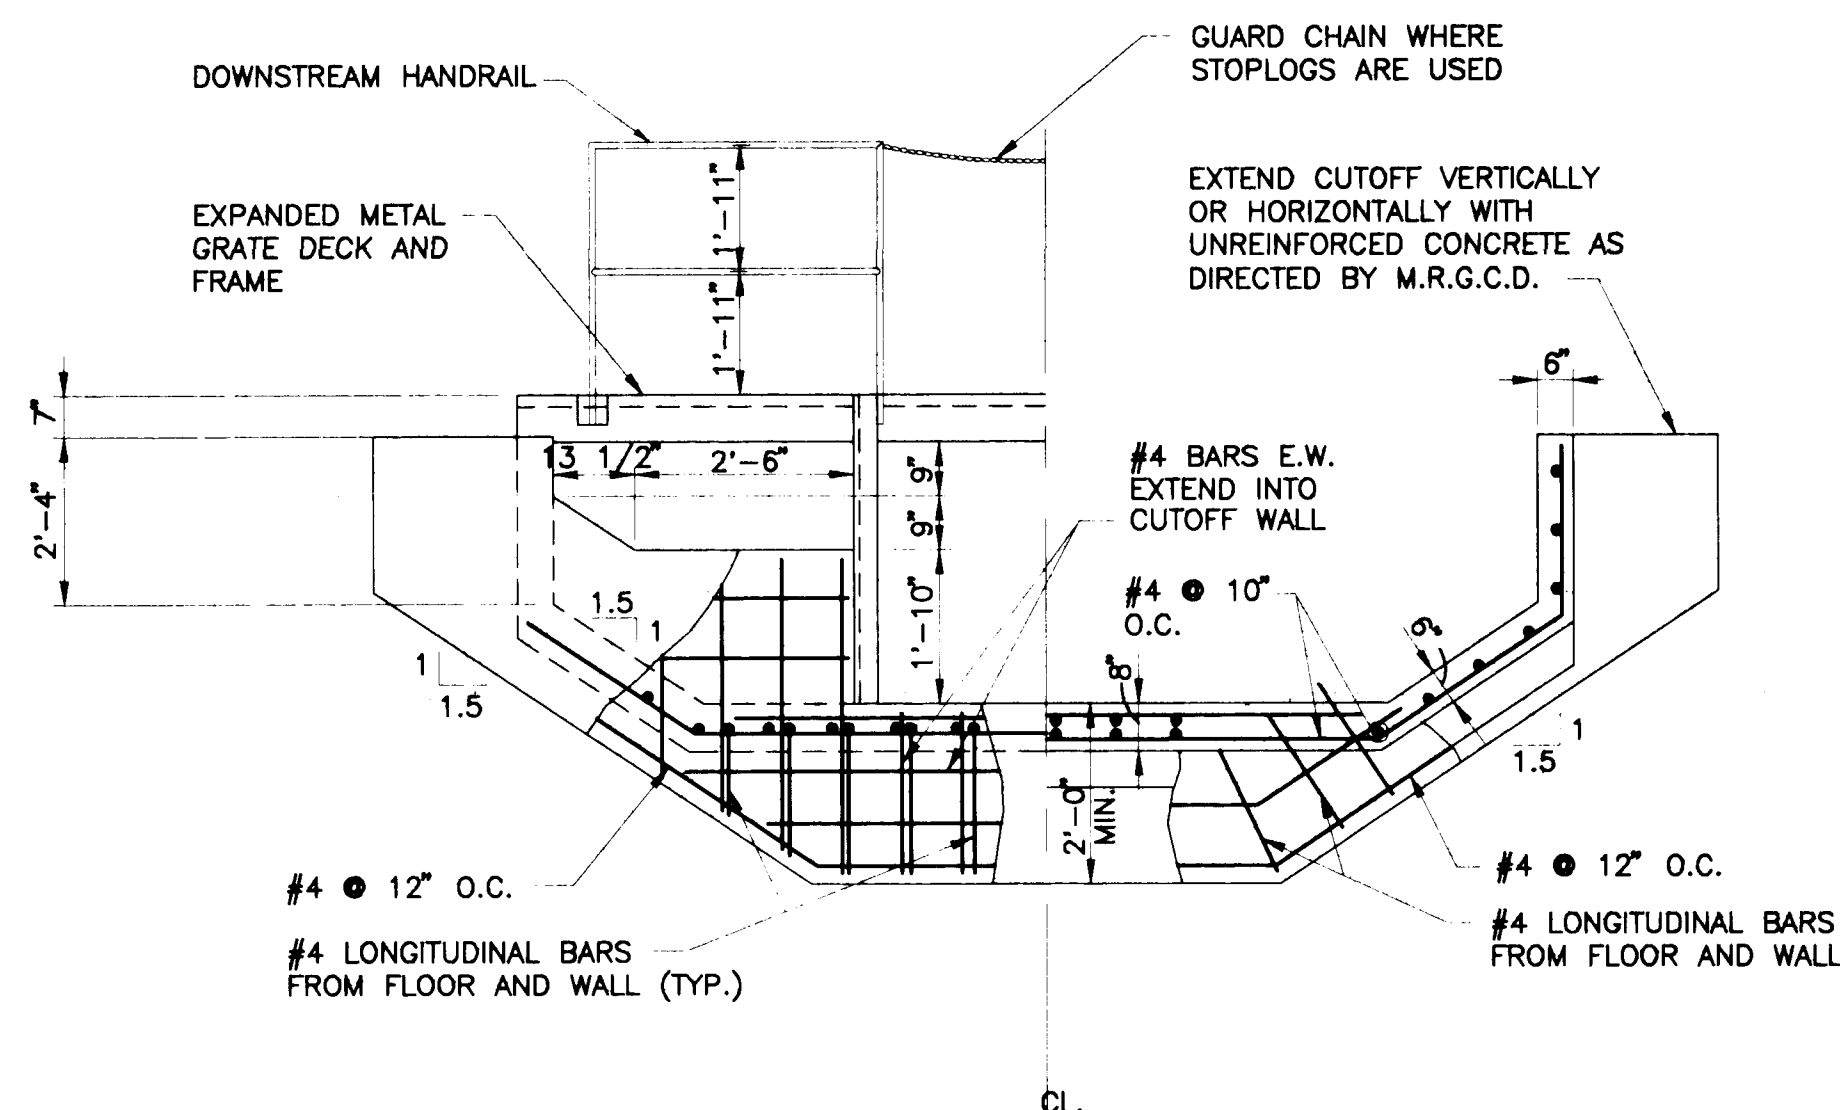


SECTION B-B
3/8" = 1'-0"

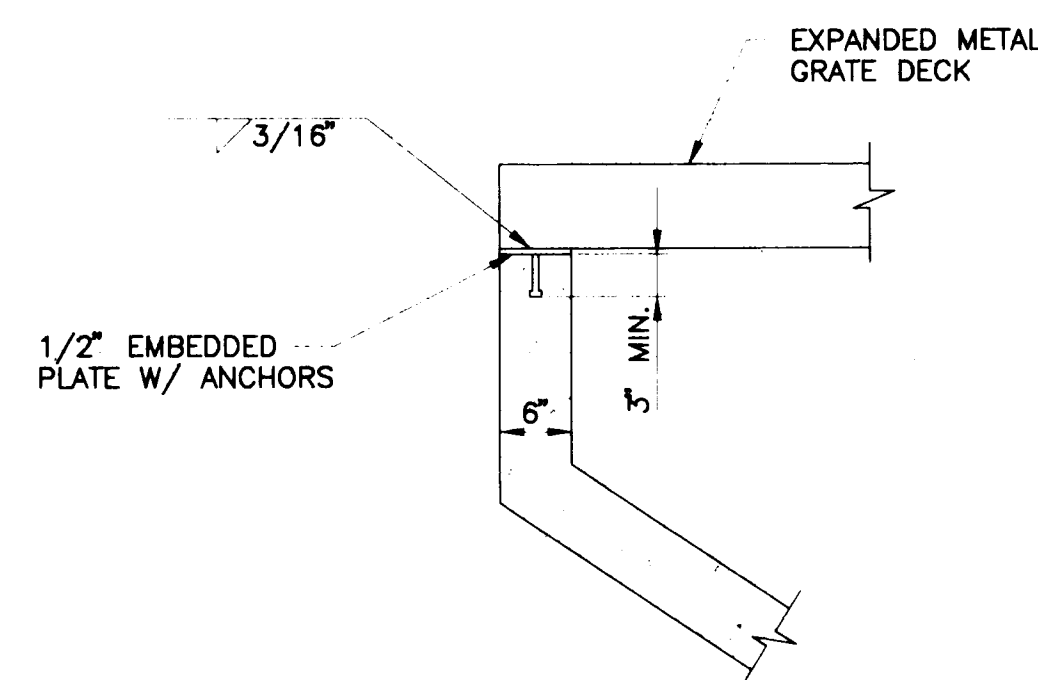

END CONNECTION DETAIL
3/4" = 1'-0"

NOTE:

CHECK STRUCTURE GATE AND FRAME SHALL BE A STEEL SLIDING GATE AND SHALL BE FABRICATED IN THE FIELD TO M.R.G.C.D. SPECIFICATIONS.

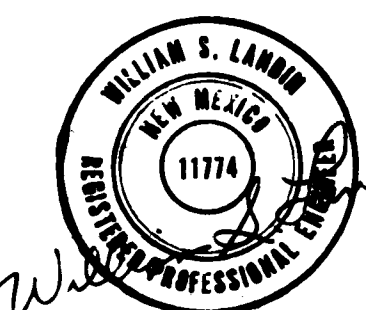

RECORD DRAWING
THIS IS A RECORD DRAWING OF THE FACILITIES IDENTIFIED IN THE TITLE BLOCK ONLY AND HAS BEEN PREPARED IN PART OR IN WHOLE BY THE ENGINEER, ARCHITECT, OR OTHER (S) WHOSE NAME IS SHOWN IN THE TITLE BLOCK. THE ENGINEER, ARCHITECT, OR OTHER (S) WILL NOT BE RESPONSIBLE FOR ANY ERRORS (S) OR OMISSION (S) WHICH MAY BE INDICATED IN THIS DRAWING. A SIGNATURE OF THE ENGINEER WILL VARY SOMEWHAT FROM THE CONDITIONS SHOWN HEREON AND AT SAME LOCATION. THE ENGINEER WILL BE RESPONSIBLE FOR THE PRELIMINARY LOCATION OF ANY FACILITY IS SHOWN ON THE TITLE BLOCK. THE PRELIMINARY LOCATION OF ANY FACILITY SHOULD BE FIELD CHECKED BY THE ENGINEER OR THE OWNER'S SURVEYOR OR AN EMPLOYEE OF THE DISTRICT OR THE OWNER'S SURVEYOR.

26 36 75 93 09 95

CITY OF ALBUQUERQUE PUBLIC WORKS DEPARTMENT ENGINEERING GROUP					
TITLE: STOTTS LATERAL CHECK STRUCTURE WIDENING OF EDITH BOULEVARD PHASE I					
APPROVALS	ENGINEER	DATE	APPROVALS	ENGINEER	DATE
COA WASTE WATER	<i>[Signature]</i>	11/14/95			
BERNALILLO COUNTY					
PROJECT NO.	3675.90 .93	MAP NO.		SHEET OF	9-20