



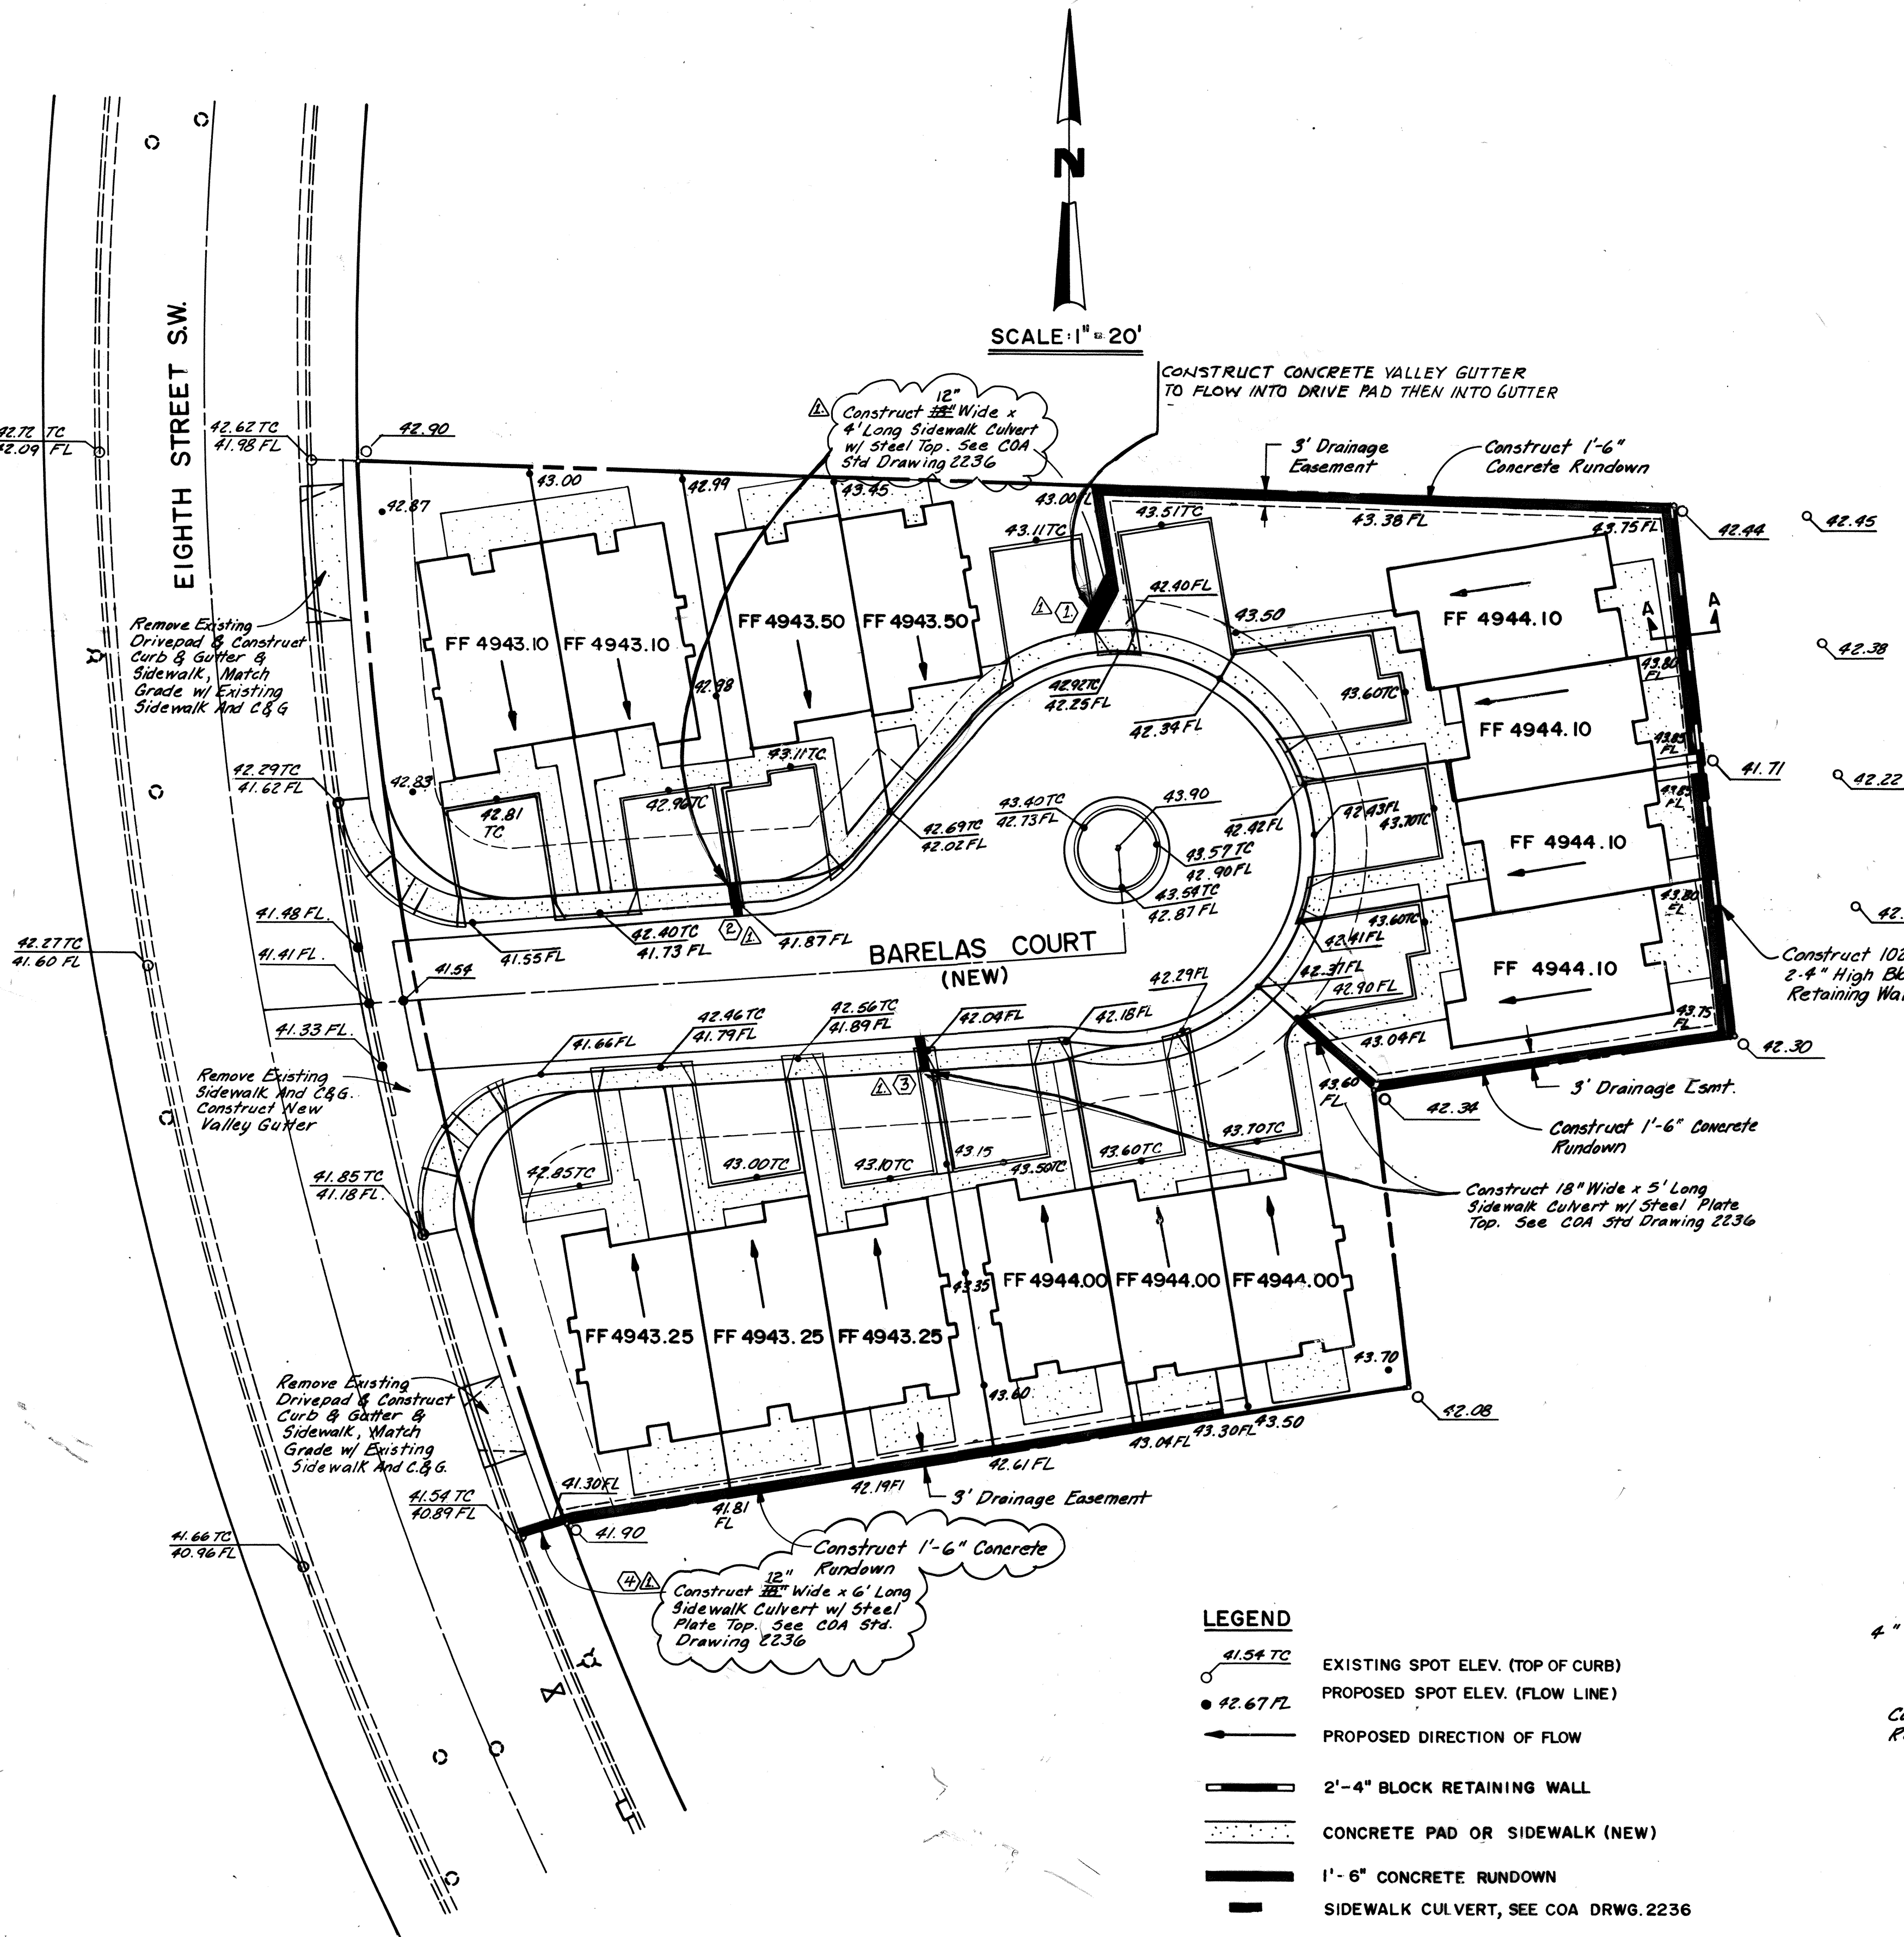

- LEGEND**
- 41.54 TC EXISTING SPOT ELEV. (TOP OF CURB)
 - 42.67 FL PROPOSED SPOT ELEV. (FLOW LINE)
 - PROPOSED DIRECTION OF FLOW
 - ▬ 2'-4" BLOCK RETAINING WALL
 - ▬ CONCRETE PAD OR SIDEWALK (NEW)
 - ▬ 1'-6" CONCRETE RUNDOWN
 - ▬ SIDEWALK CULVERT, SEE COA DRWG. 2236

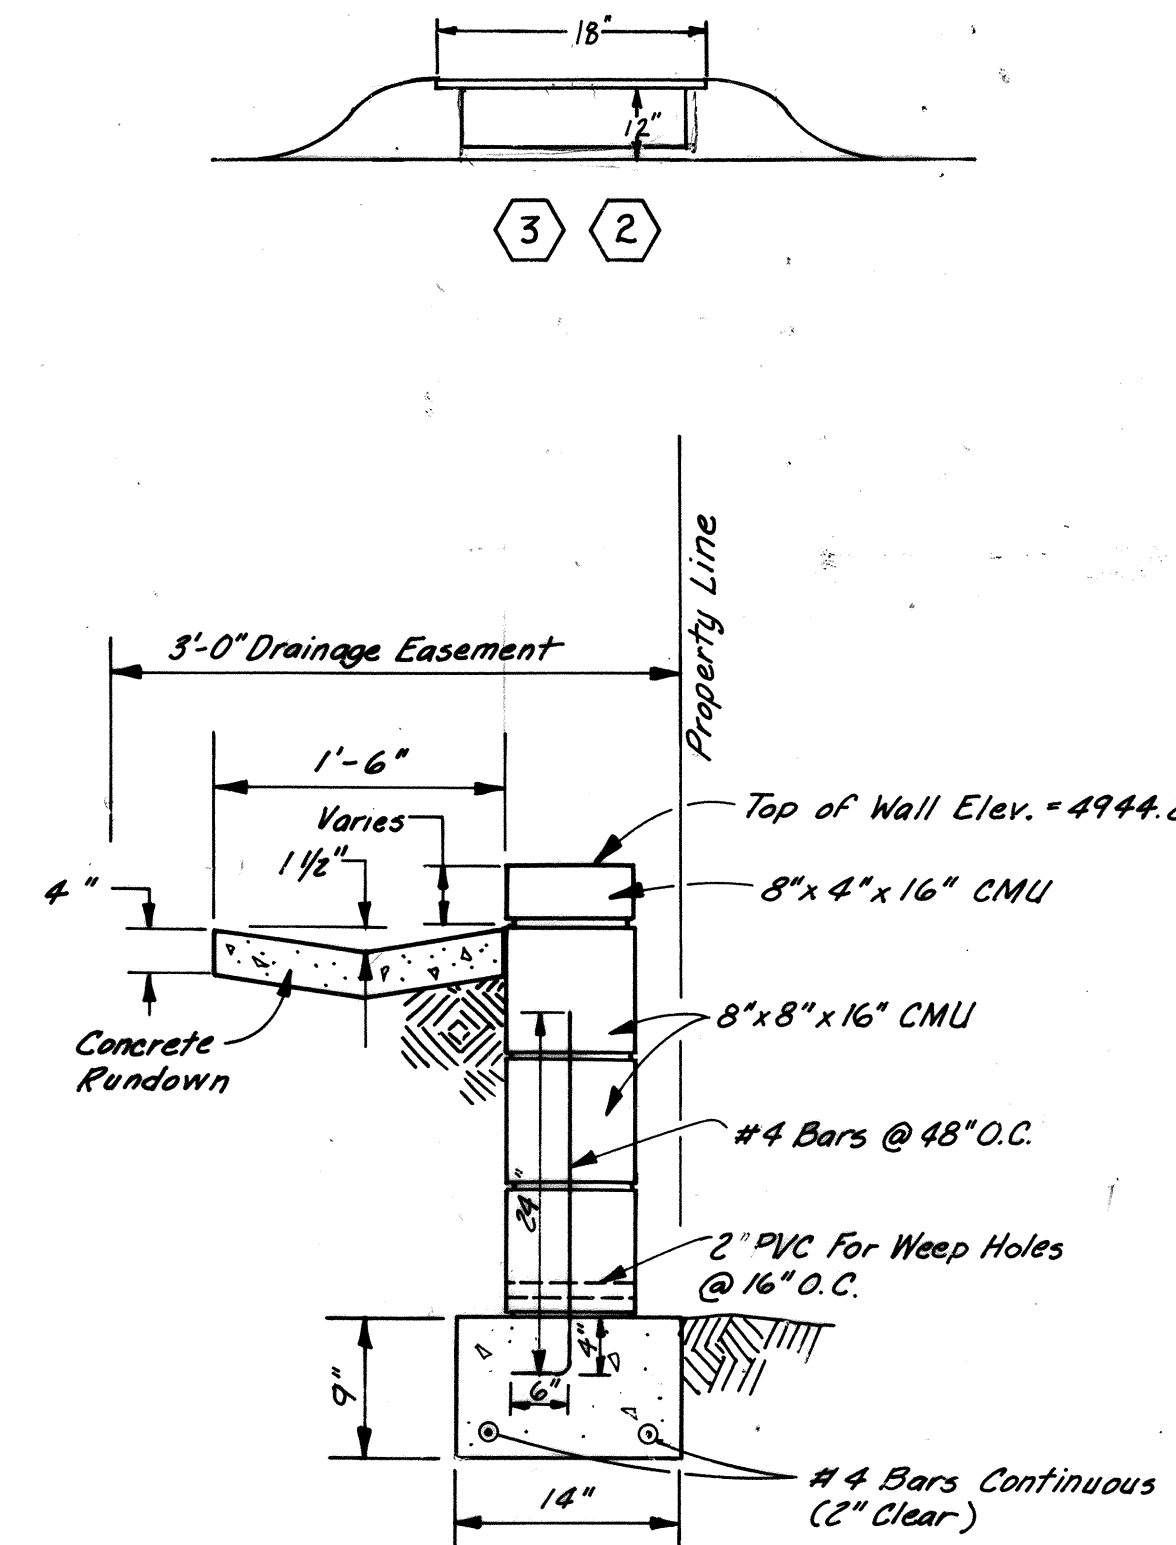

SECTION A-A
BLOCK RETAINING WALL & CONC. RUNDOWN
 NOTE: WHERE THE RUNDOWN CONNECTS TO A SIDEWALK CULVERT, FLATTEN THE INVERT OF THE RUNDOWN TO MATCH THE STANDARD SIDEWALK CULVERT SECTION OVER 5'-0" OF LENGTH. (STD. CULVERT INV. = 1/2")

- ① BUILD ONLY THE TWO (2) SIDEWALK CULVERTS AT THE LOCATION CIRCLED ON THIS PLAN. ALL OTHER MARK SHOWN IS EXISTING.
 - ② Remove and replace existing sidewalk, Rundown and C & G as directed by the Engineer in the field, to accommodate installation of sidewalk culverts specified.
 - ③ Tie existing rundowns to new sidewalk culverts per note below Section A-A, this sheet.
 - ④ Locate sidewalk culvert on Eighth Street about 1'-6" north of SW property corner to avoid conflict with existing sprinkler head. Deflect centerline of rundown section to match center of culvert.
- ① ② ③ ④ Revised sidewalk culverts by GREG OLSEN 3/27/90

NOTE
 INDIVIDUAL BUILDING SLABS, PATIOS, SIDEWALKS AND DRIVEWAYS ARE NOT TO BE CONSTRUCTED UNDER THIS CONTRACT. THESE ELEVATIONS ARE SHOWN FOR THE INFORMATION OF THE CONTRACTOR ONLY.

APPROVAL OF AS-BUILT DRAWINGS
 CHIEF CONSTRUCTION ENGINEER
 DATE 2/19/90

AVID ENGINEERING, INC.
 Civil • Structural • Transportation
 5801 Osuna Rd. NE • Suite 204
 Albuquerque, NM 87109 • (505) 881-5357

CITY OF ALBUQUERQUE
 PUBLIC WORKS DEPARTMENT
 ENGINEERING GROUP

TITLE: BARELAS COURT TOWNHOMES GRADING PLAN					
APPROVALS	ENGINEER	DATE	APPROVALS	ENGINEER	DATE
D.R.C. Chair	<i>[Signature]</i>	4/6/90			
Trans. Dev.					
Utility Dev.	<i>[Signature]</i>	3/24/88			
DRAWING NO.	3683.91	MAP NO.	K-14	SHEET	1 OF 1

ENGINEER'S SEAL		SURVEY INFORMATION		BENCH MARKS		AS BUILT INFORMATION	
		NO.	1	DATE	1988	CONTRACTOR	ELEV. 4944.026
		BY	Gregory Olsen	DATE	1988	WORK STARTED BY	DATE
		REMARKS	Revised from "As-Built" Information				
		NO.	DATE	DESIGNED BY	JVD	DATE	9/88
		DRAWN BY	RB	CHECKED BY	JVD	DATE	9/88