




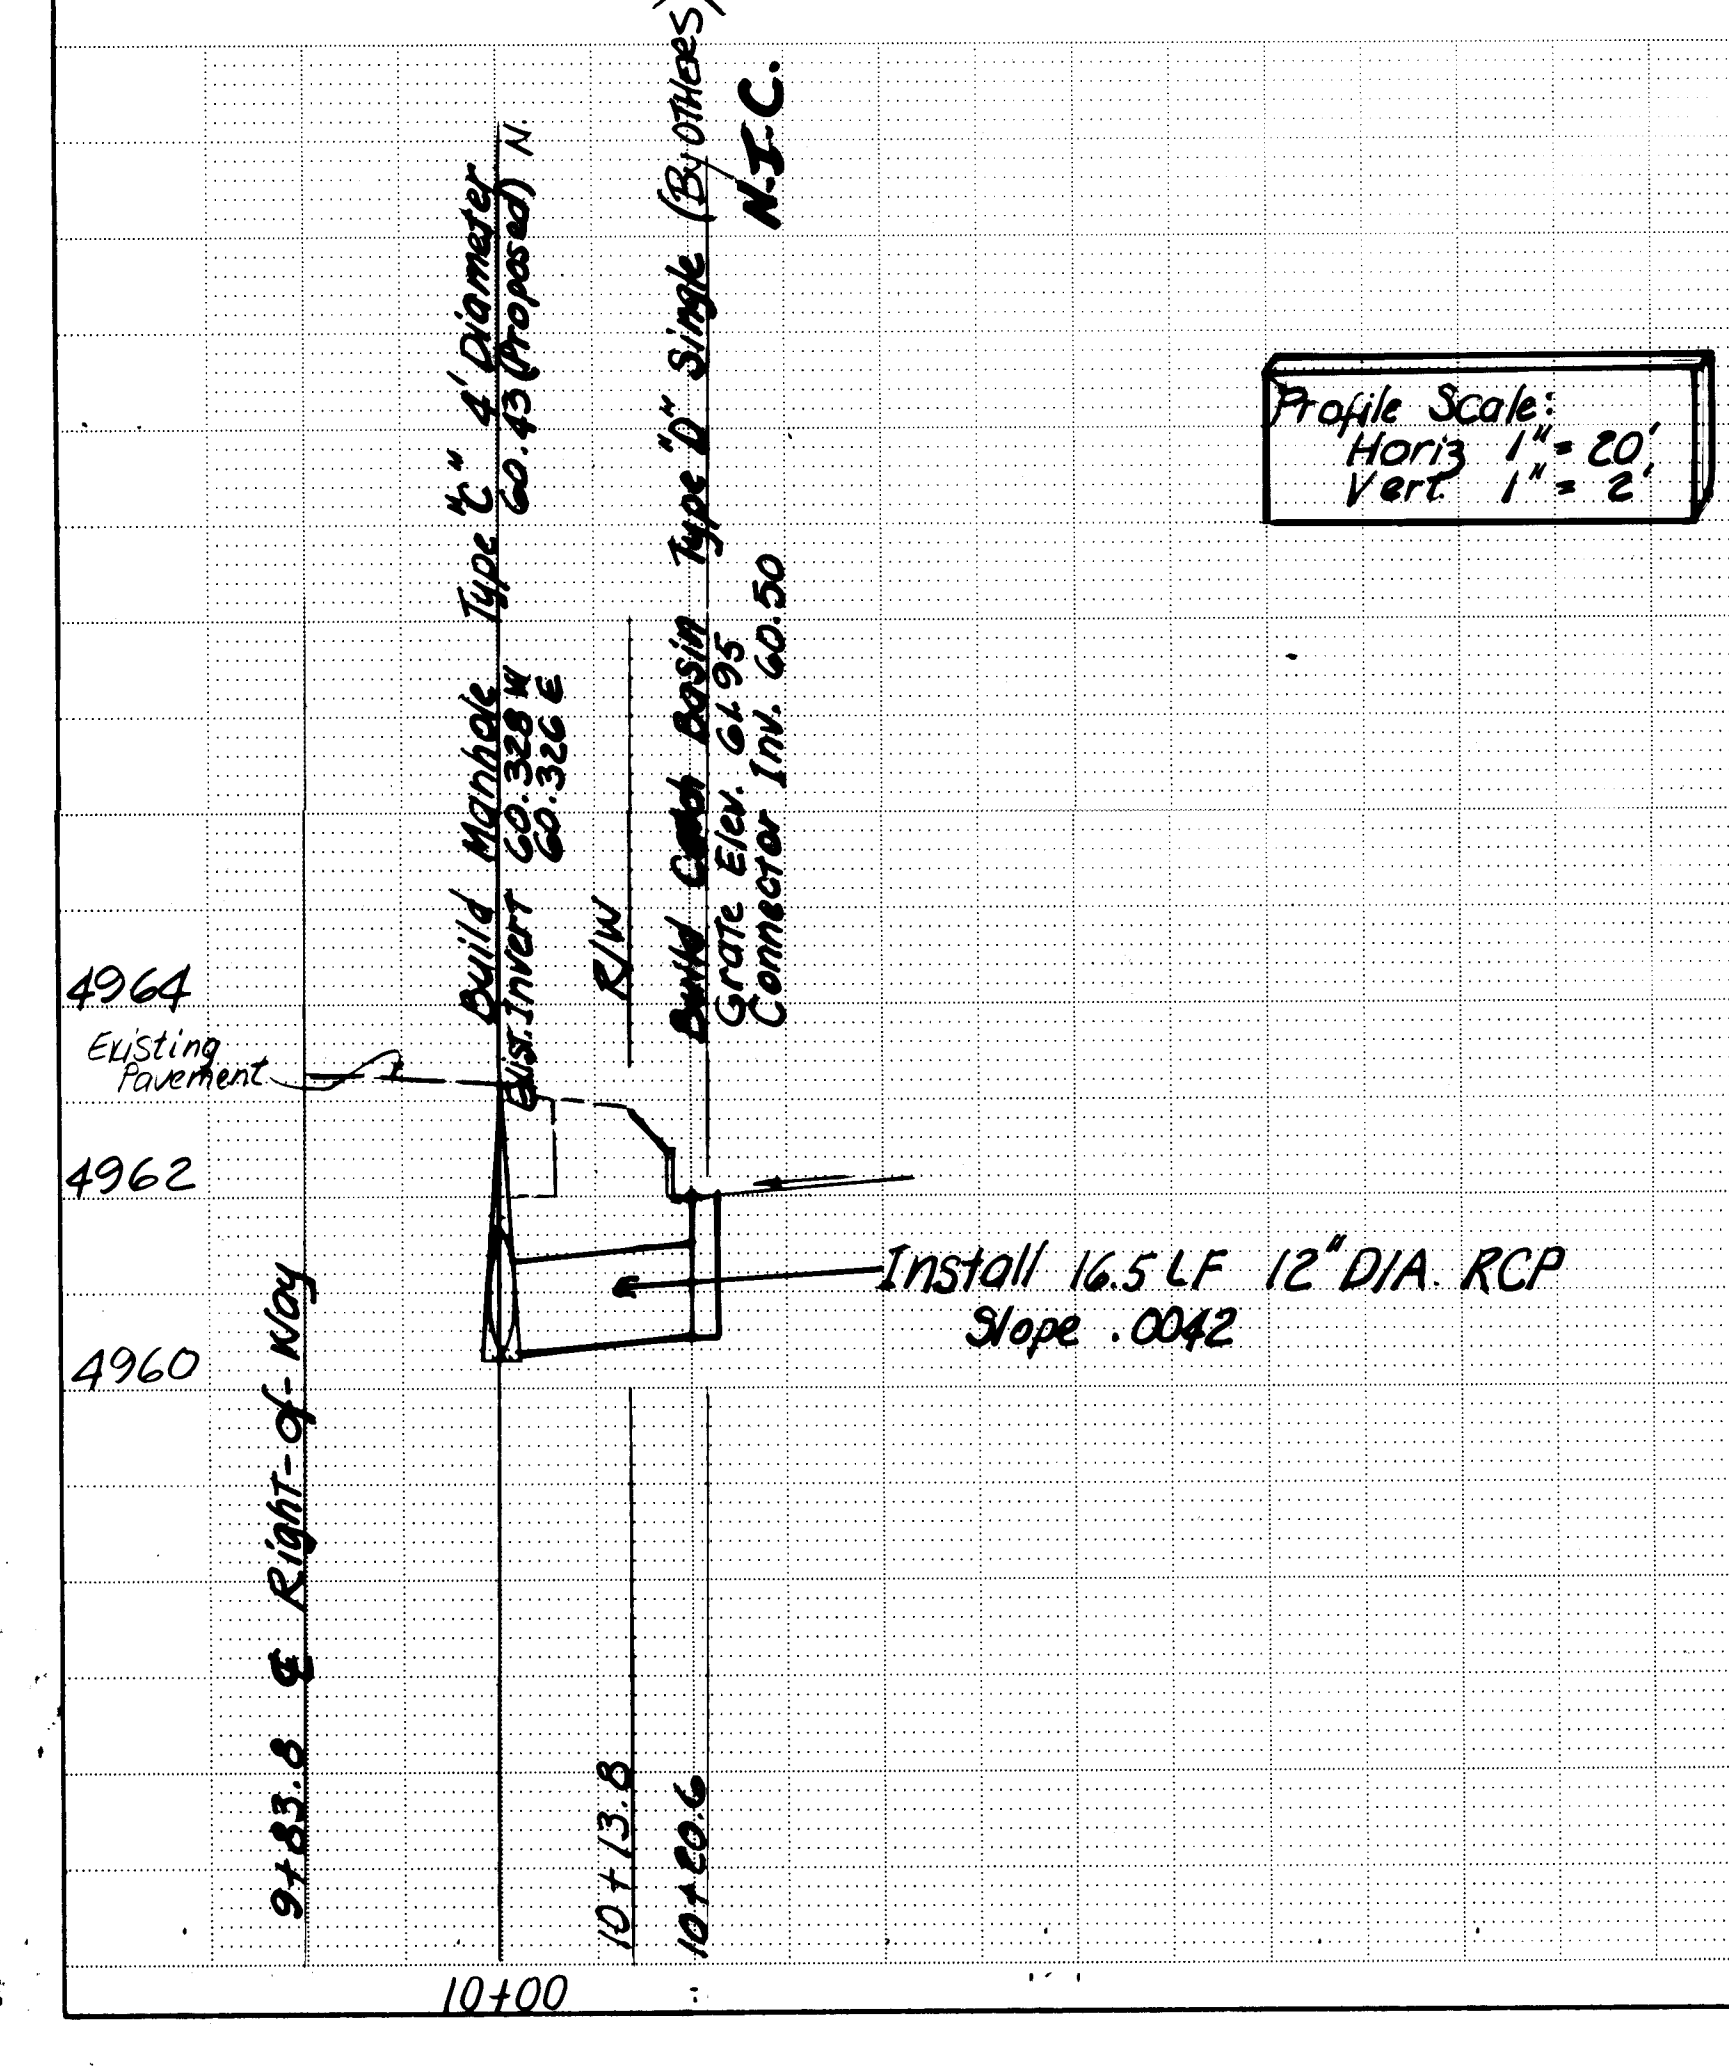

VICINITY MAP
Scale 1" = 800'

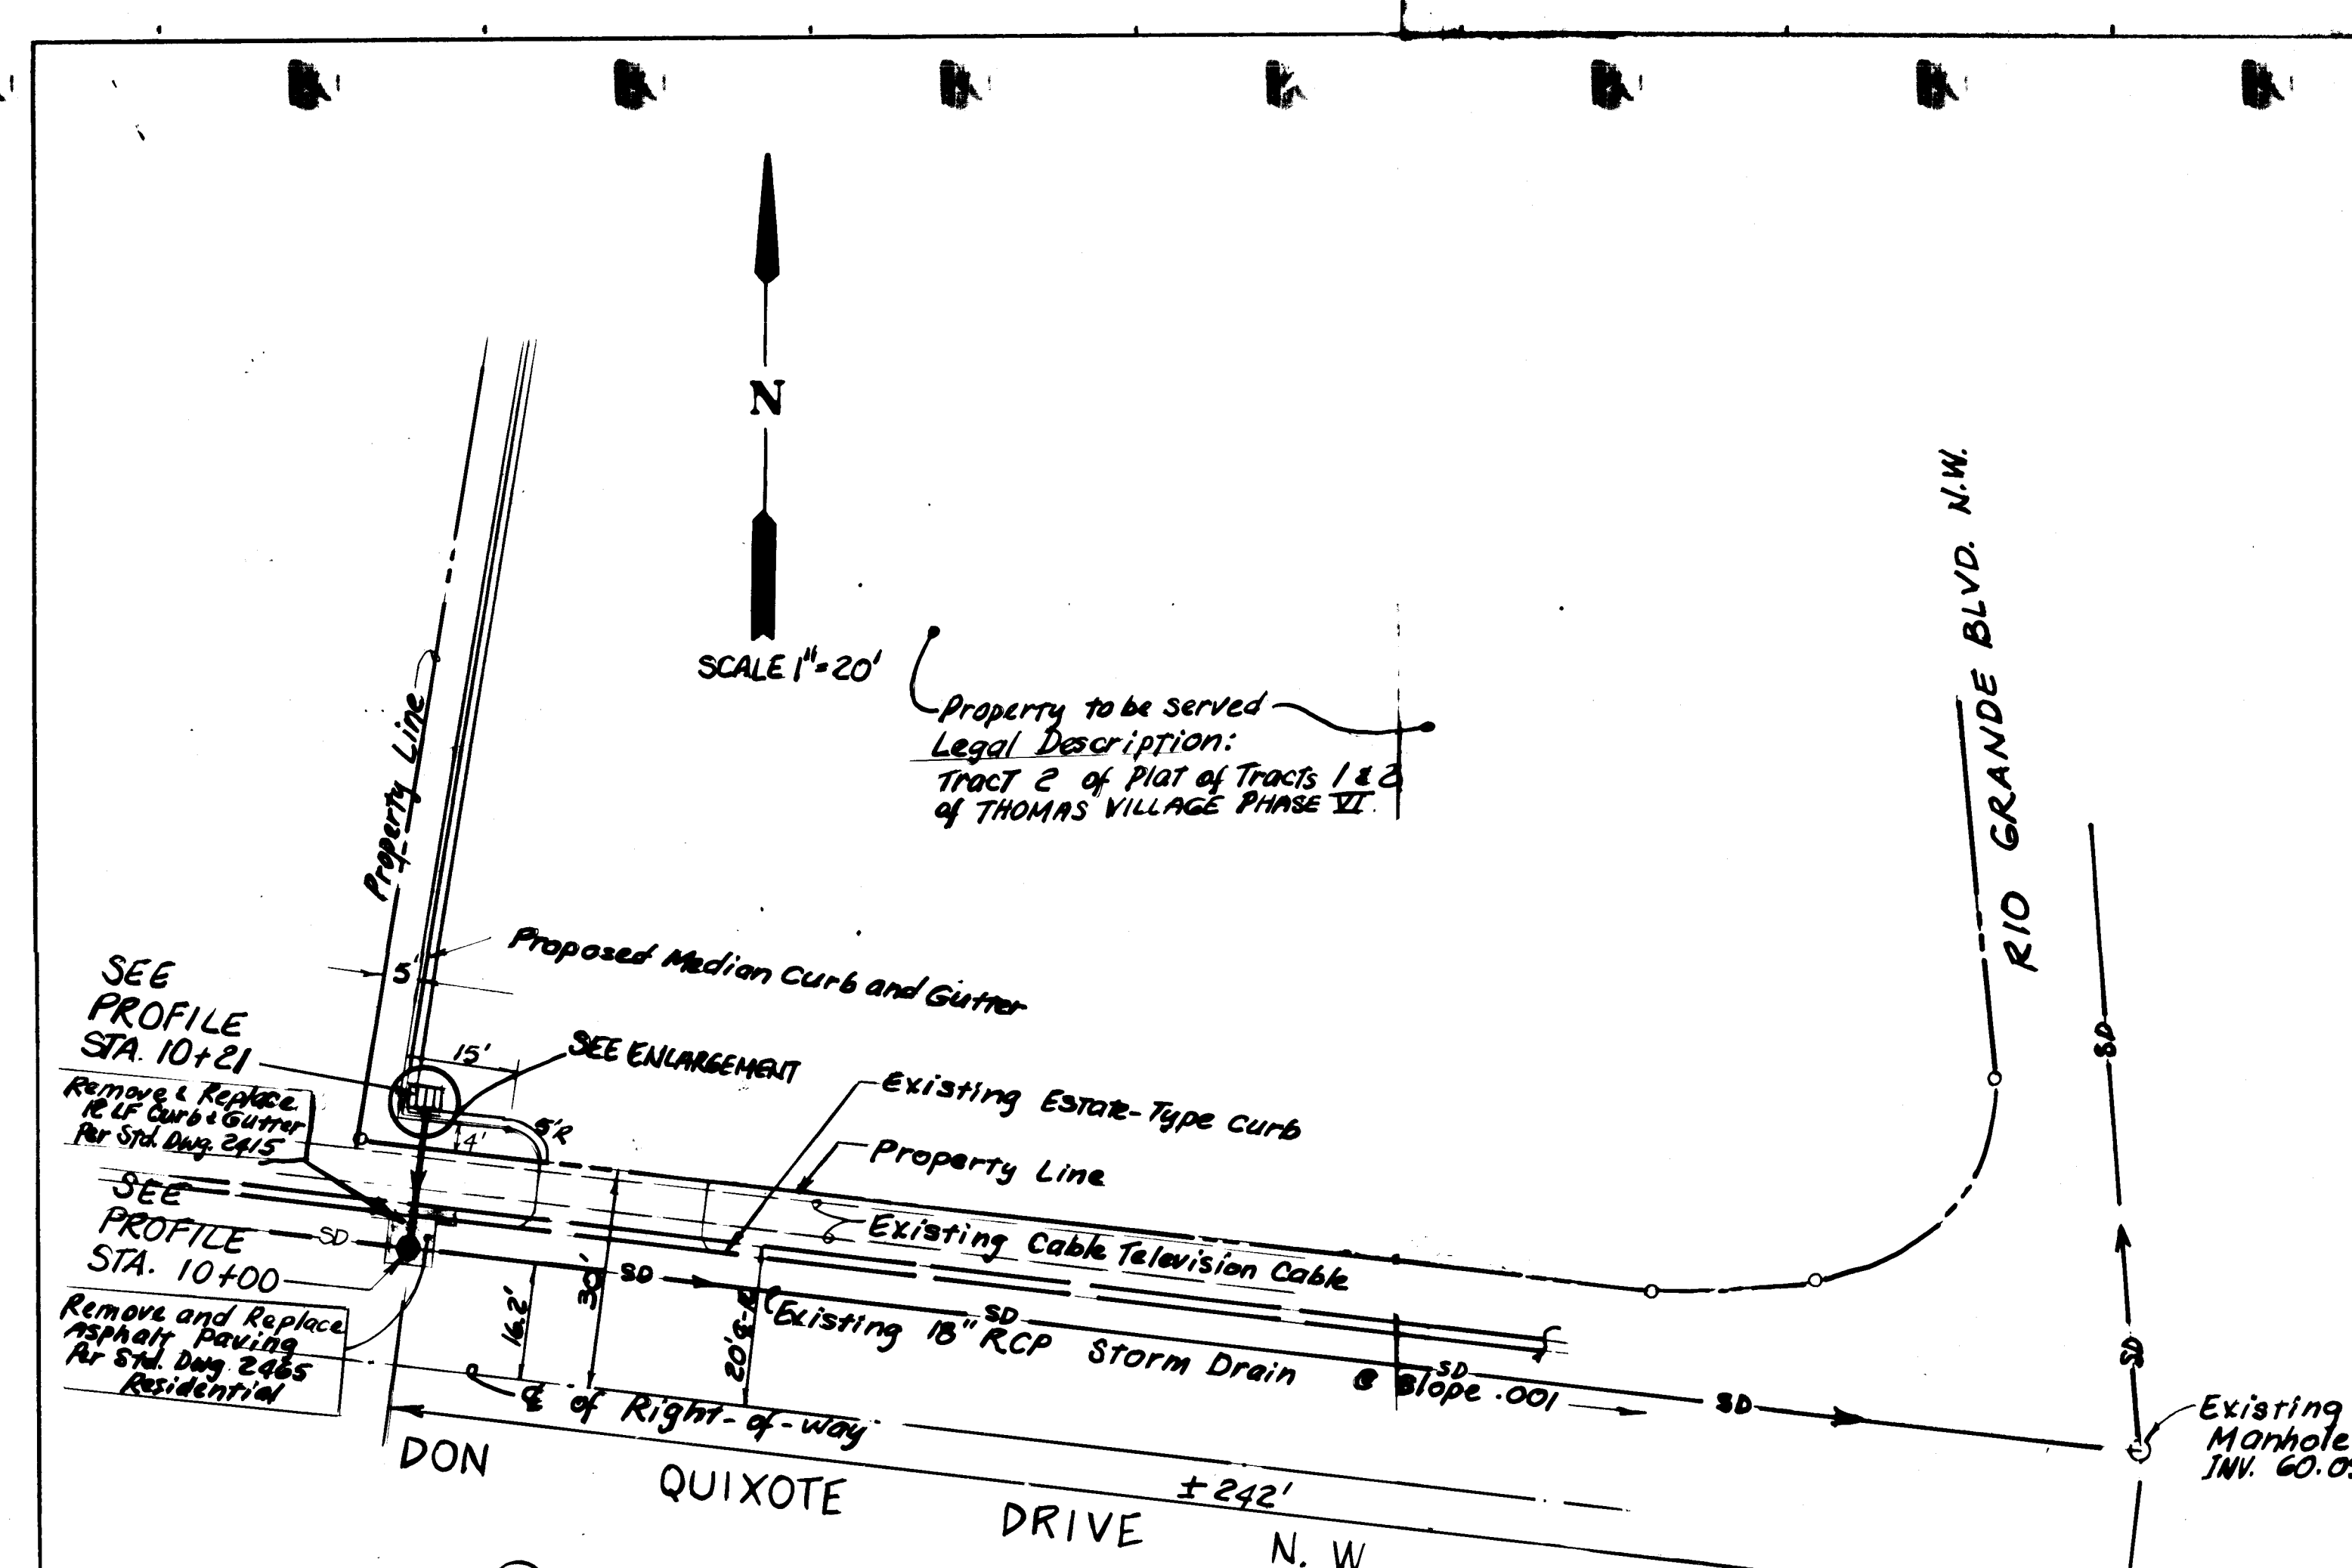

Profile Scale:
Horiz 1" = 20'
Vert 1" = 2'

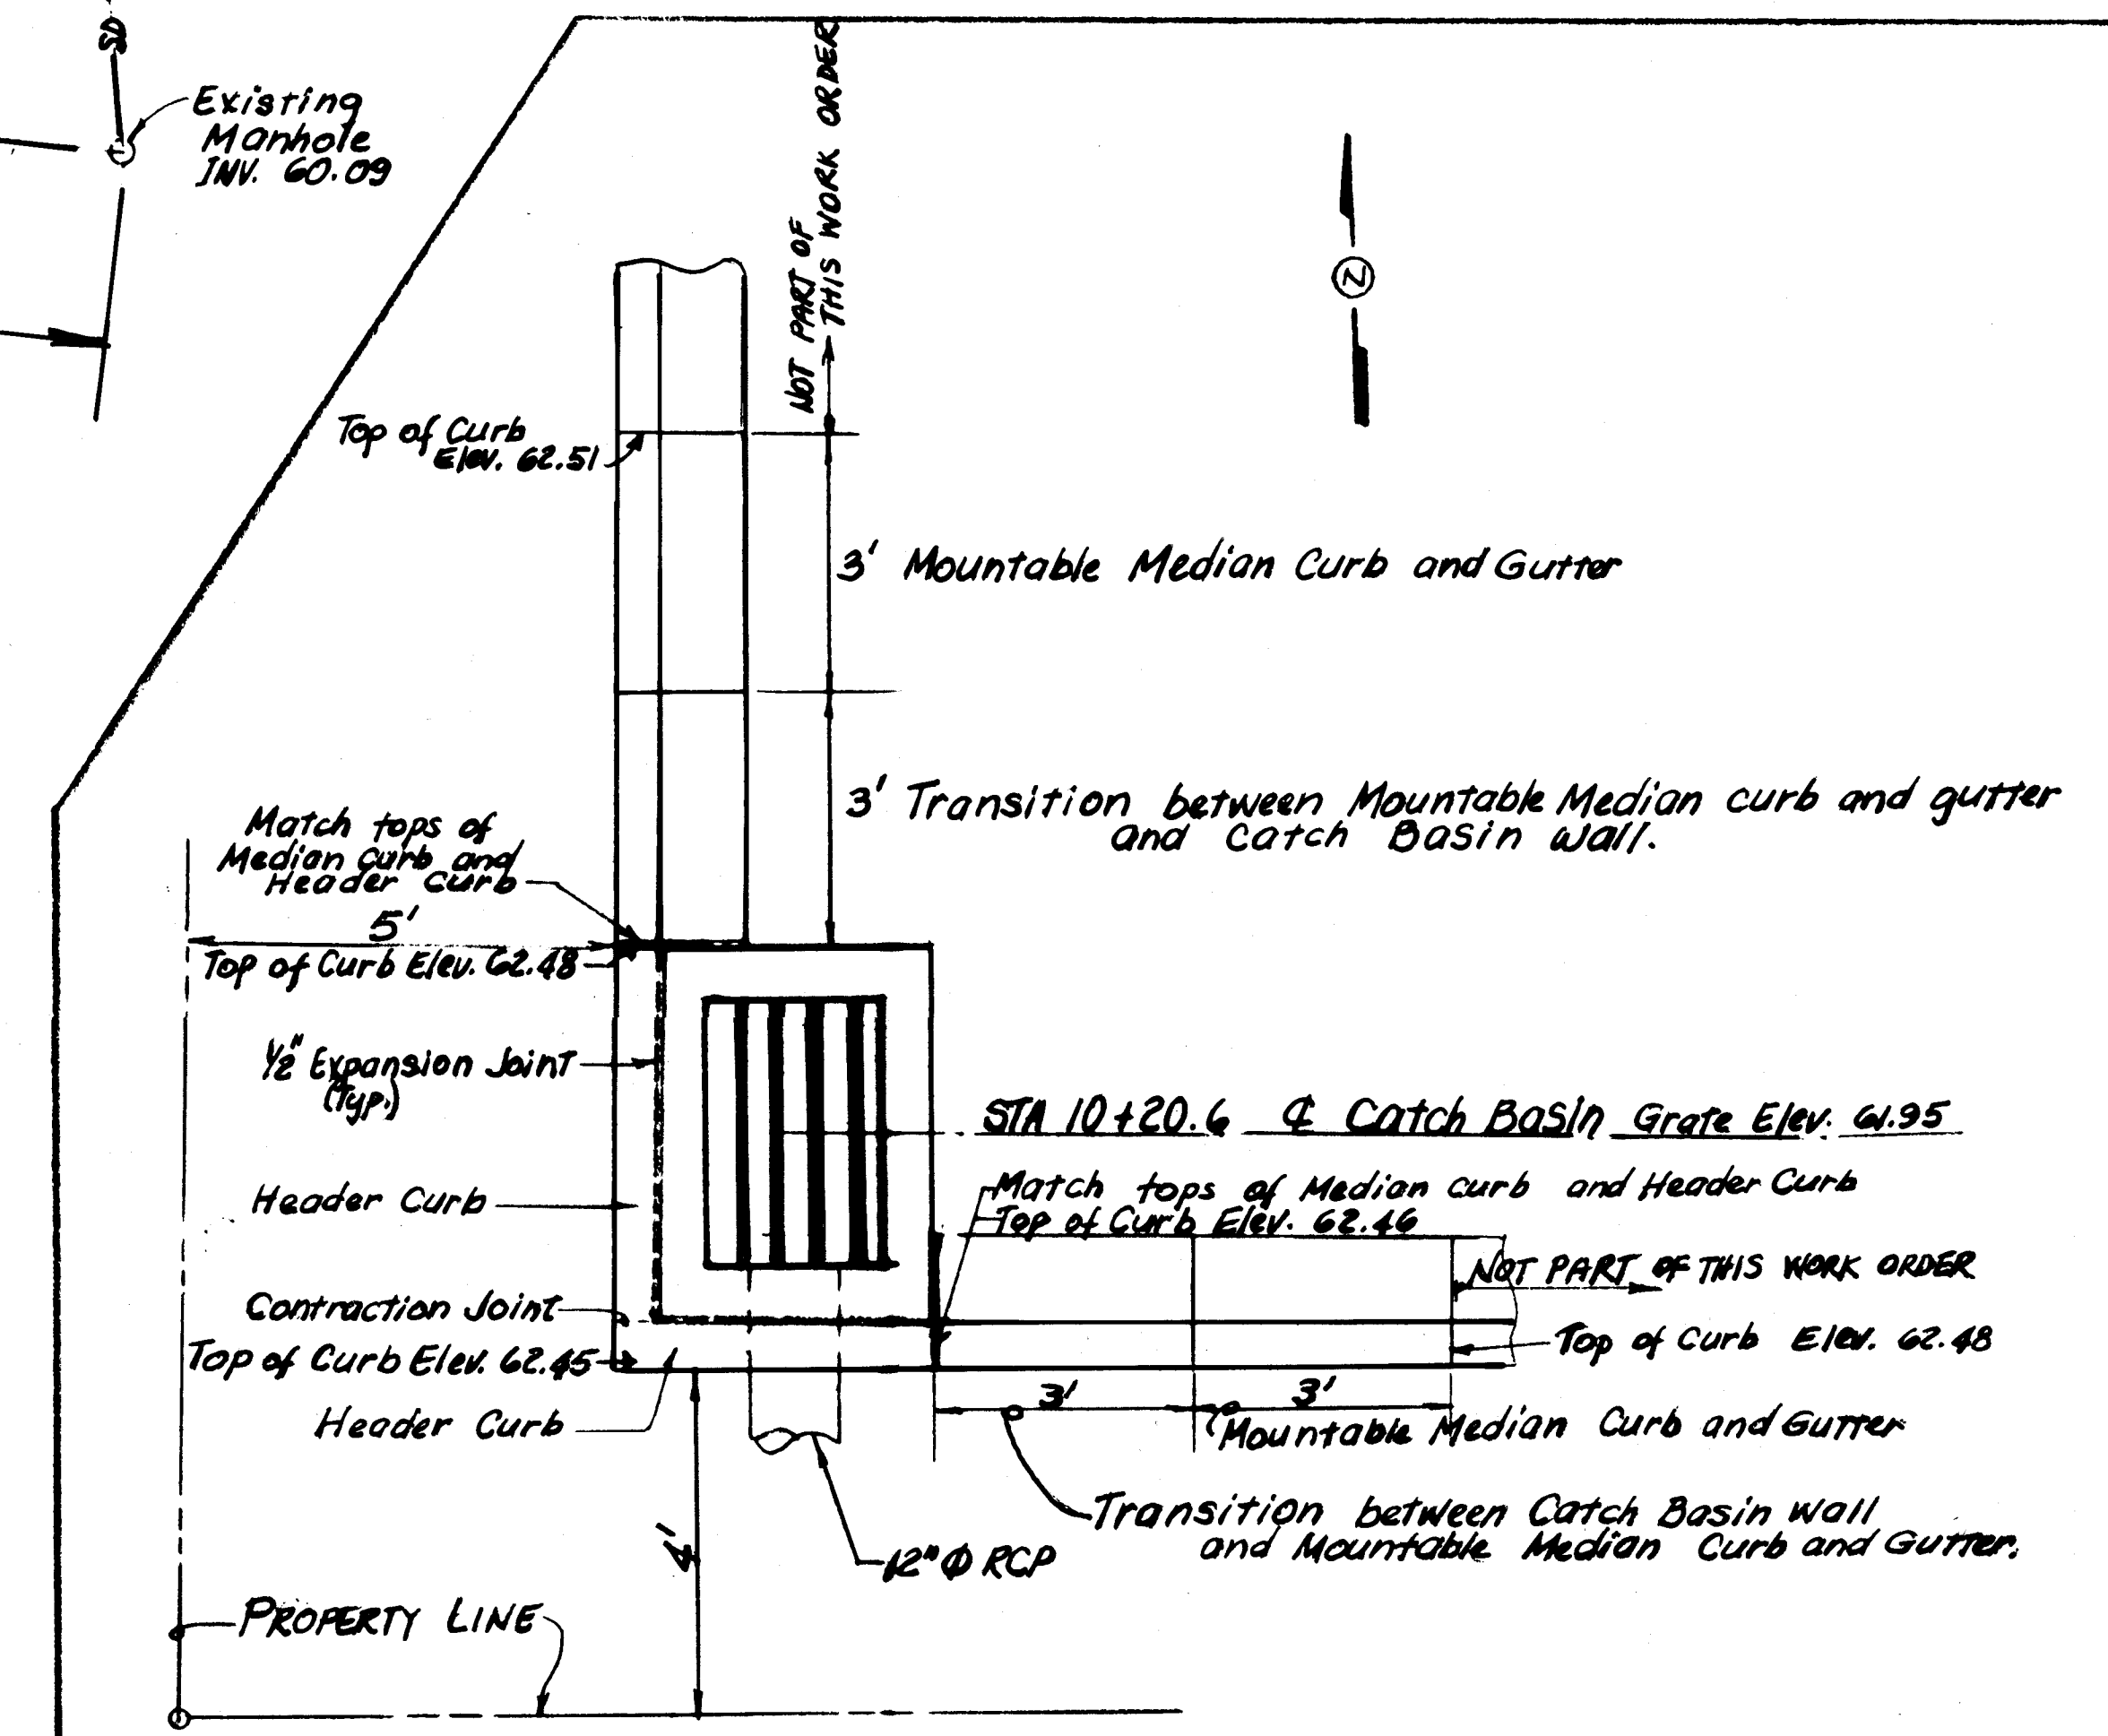

ENLARGEMENT
Scale 1" = 2'

APPROVAL OF AS BUILT DRAWINGS
CHIEF CONSTRUCTION ENGINEER
[Signature]
DATE 6-6-97

GENERAL NOTES:

- All work shall, unless otherwise noted, be in accordance with the City of Albuquerque Standard Specifications for Public Works Construction 1986.
- Two (2) working days prior to any excavation, Contractor must contact Line Locating Service 765-1234 for location of existing utilities. Prior to construction, Contractor shall excavate and verify the horizontal and vertical locations of all structures and shall notify the Engineer or Surveyor so that conflict can be resolved with minimum delay.
- All utilities and utility service lines shall be installed prior to paving.
- Backfill compaction shall be according to specified street use.
- Tack coat requirements shall be determined by the City Engineer.

TRAFFIC NOTES:

- Contractor must submit a construction signing and barricading plan to and receive a barricading permit from Traffic Engineer Operations prior to construction.
- All construction signing and barricading shall comply with Manual on Uniform Traffic Control Devices, 1978 Edition and subsequent editions or revisions.

AS BUILT INFORMATION

CONTRACTOR	DATE	INSPECTOR	DATE	RECORDING	DATE

FIELD NOTES

NO.	DATE	BY

ENGINEER'S SEAL

[Professional Seal: State of New Mexico, No. 4895, Cecilia J. Tomlinson]

REVISIONS

NO.	DATE	REMARKS

DESIGNED BY CT **DATE** 12/6/88 **CHECKED BY** CT **DATE** 12/17/88

CITY OF ALBUQUERQUE
MUNICIPAL DEVELOPMENT DEPARTMENT
ENGINEERING DIVISION

TITLE: 2501 RIO Grande N.W.
Proposed Storm Drain

APPROVALS	ENGINEER	DATE	APPROVALS	ENGINEER	DATE
City Engineer	Rogulshon	2/9/89	Liquid Waste	PEAD	2/9/89
A-G-E-Design	II	II	Traffic	Rogulshon	2/9/89
A-G-E-Hydrology	II	II	Water	PEAD	2/9/89

DRAWING NO. 3699 **MAP NO.** G-12 **SHEET** 1 **OF** 1

APPROVED FOR CONSTRUCTION
[Signature]
CITY ENGINEER **DATE** 01/97

1 2 3 4 5 6 7 8 9 10 11 12 13 14 15
26-3699 01/97