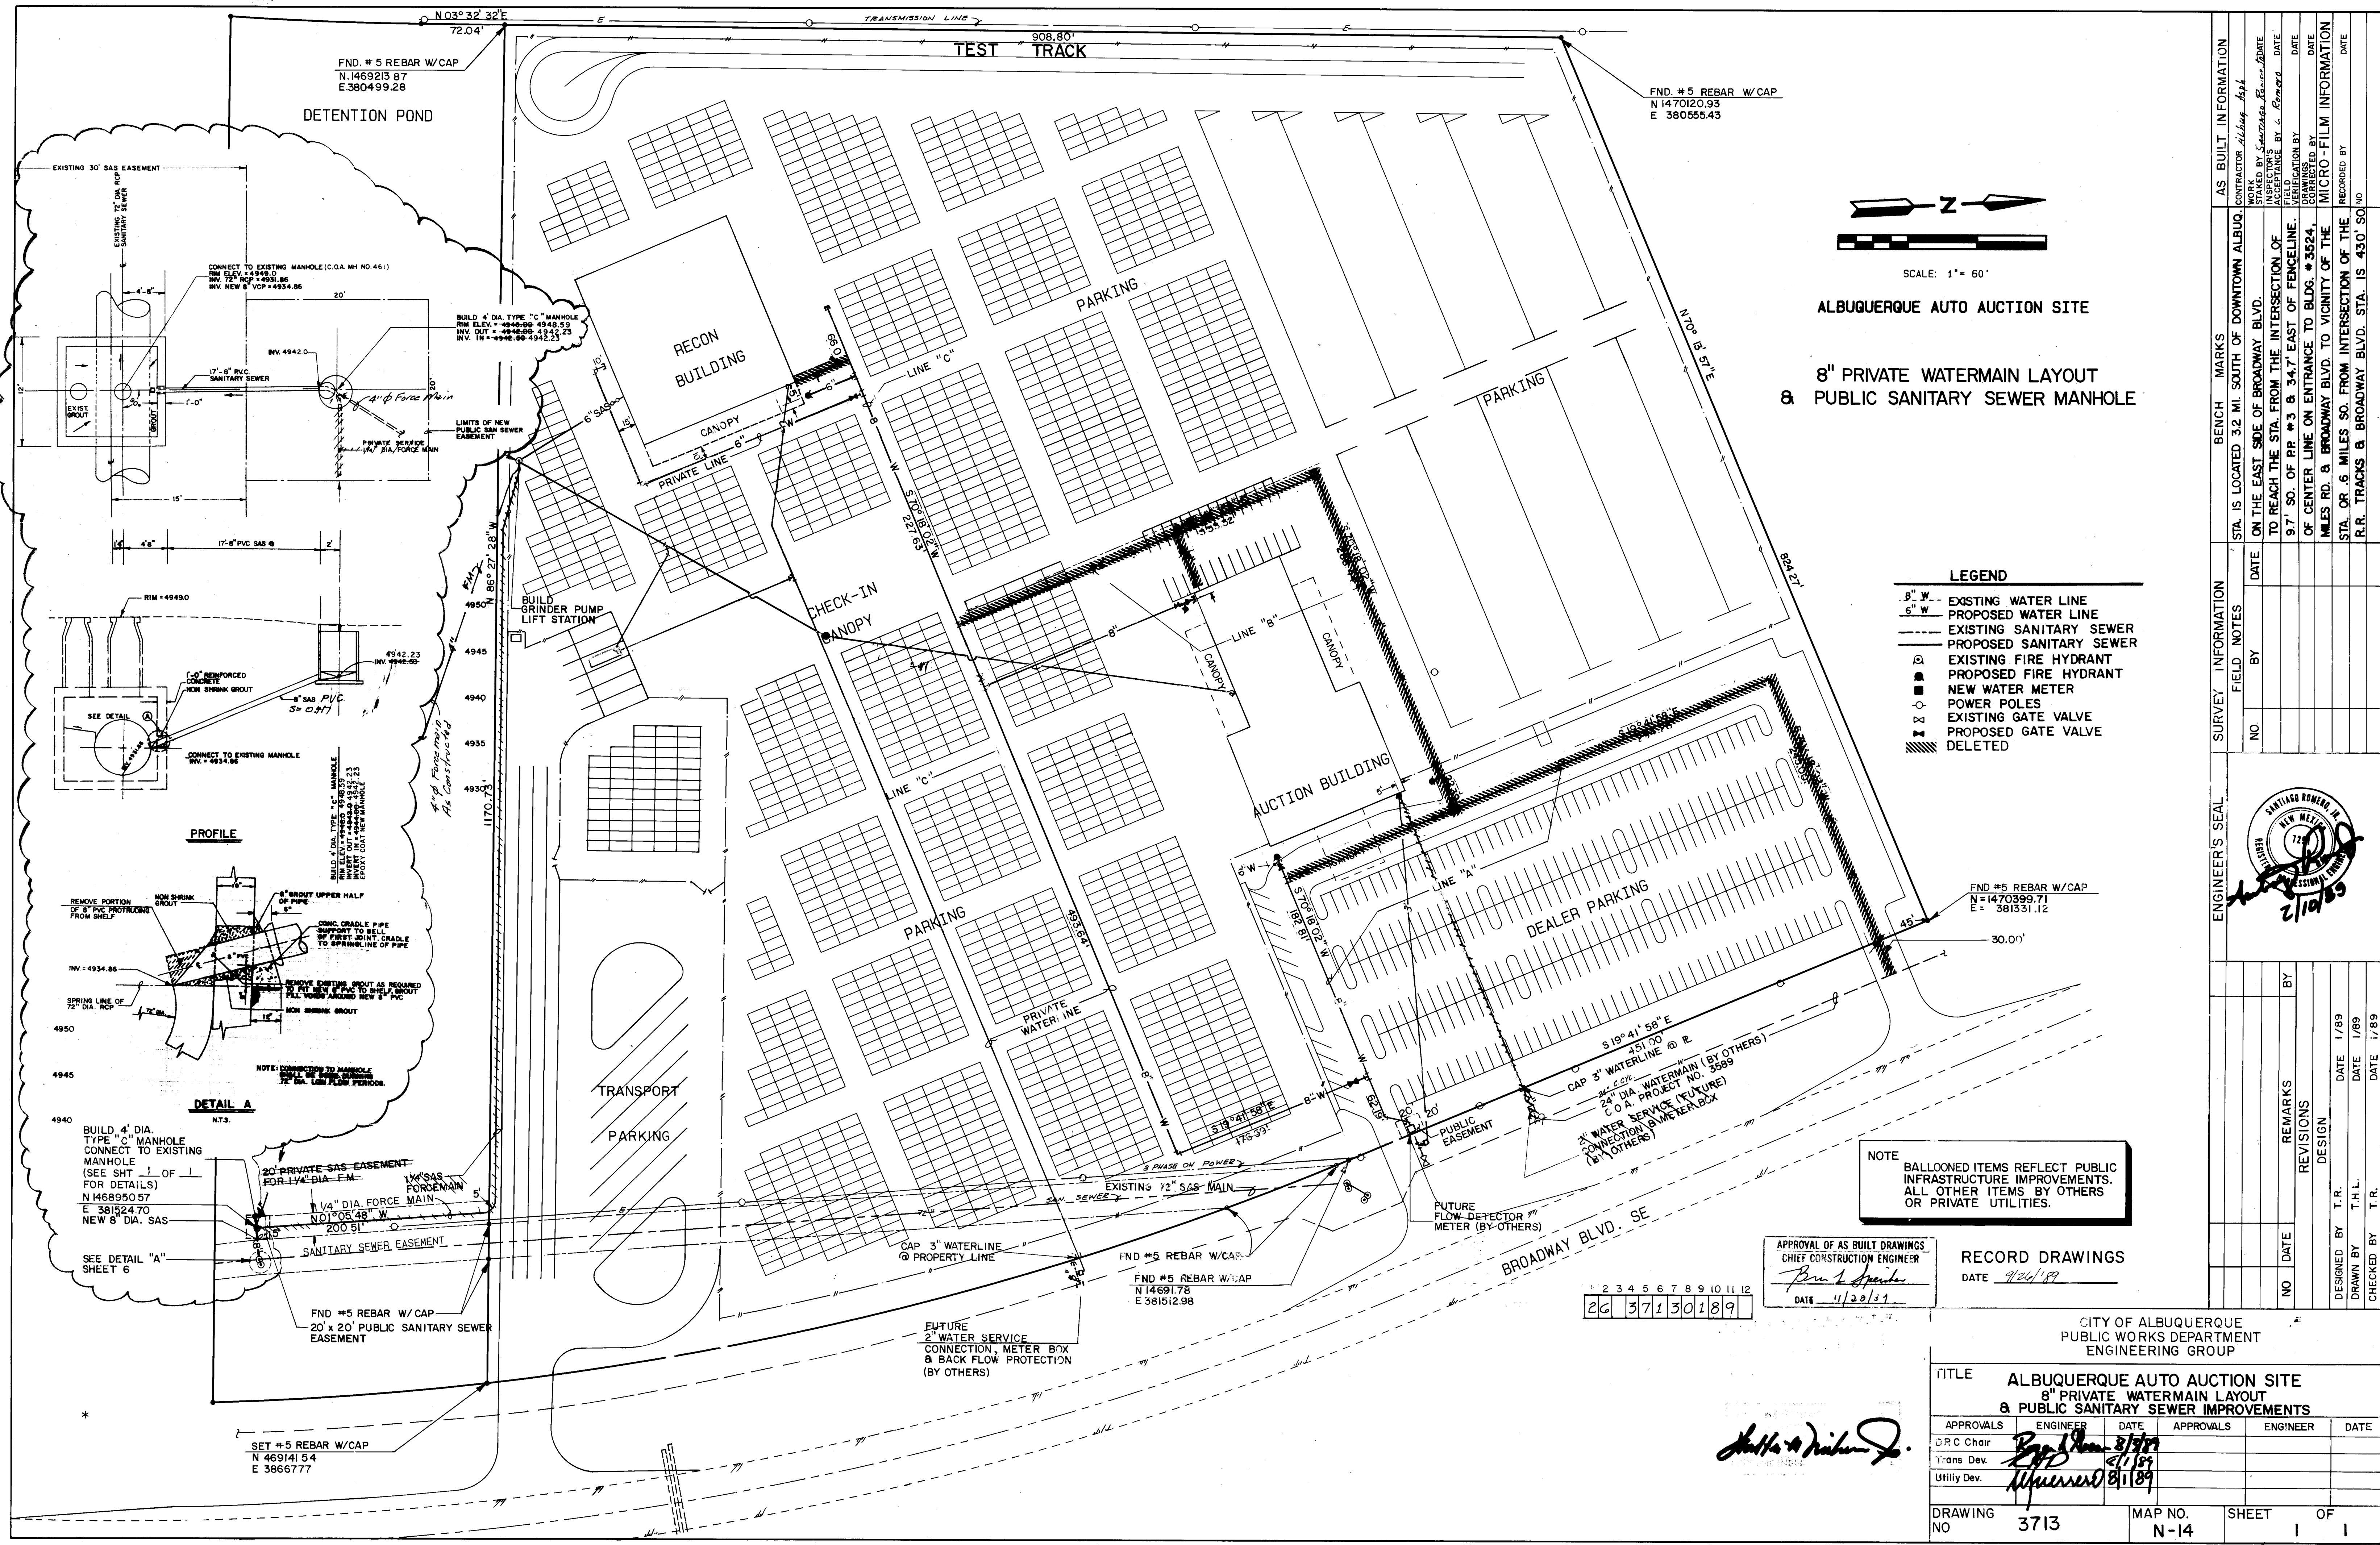


ALBUQUERQUE AUTO AUCTION SITE
8" PRIVATE WATERMAIN LAYOUT
& PUBLIC SANITARY SEWER MANHOLE

- LEGEND**
- 8" W - EXISTING WATER LINE
 - 6" W - PROPOSED WATER LINE
 - 8" S - EXISTING SANITARY SEWER
 - 6" S - PROPOSED SANITARY SEWER
 - ⊙ - EXISTING FIRE HYDRANT
 - ⊙ - PROPOSED FIRE HYDRANT
 - ⊙ - NEW WATER METER
 - ⊙ - POWER POLES
 - ⊙ - EXISTING GATE VALVE
 - ⊙ - PROPOSED GATE VALVE
 - - DELETED

AS BUILT INFORMATION		BENCH MARKS		SURVEY INFORMATION		ENGINEER'S SEAL		REVISIONS		DESIGN		T.R.		T.H.L.		T.R.	
NO.	DATE	NO.	DATE	NO.	DATE	NO.	DATE	NO.	DATE	NO.	DATE	NO.	DATE	NO.	DATE	NO.	DATE
STA. IS LOCATED 3.2 MI. SOUTH OF DOWNTOWN ALBUQUERQUE, ON THE EAST SIDE OF BROADWAY BLVD. TO REACH THE STA. FROM THE INTERSECTION OF 9.7' SO. OF PP #3 & 34.7' EAST OF FENCELINE. OF CENTER LINE ON ENTRANCE TO BLDG. #3524. MILES RD. & BROADWAY BLVD. TO VICINITY OF THE STA. OR 6 MILES SO. FROM INTERSECTION OF THE R.R. TRACKS & BROADWAY BLVD. STA. IS 430' SO.		CONTRACTOR: <i>Albuquerque</i>		WORK BY: <i>Sanchez, Raul</i>				DESIGNED BY: <i>T.R.</i>		DRAWN BY: <i>T.H.L.</i>		CHECKED BY: <i>T.R.</i>		DATE: 1/89		DATE: 1/89	
DATE: 1/89		DATE: 1/89		DATE: 1/89		DATE: 1/89		DATE: 1/89		DATE: 1/89		DATE: 1/89		DATE: 1/89		DATE: 1/89	

APPROVAL OF AS BUILT DRAWINGS
CHIEF CONSTRUCTION ENGINEER
Ben L. Smith
DATE: 11/20/19

RECORD DRAWINGS
DATE: 1/24/19

26 37130189

CITY OF ALBUQUERQUE PUBLIC WORKS DEPARTMENT ENGINEERING GROUP			
TITLE: ALBUQUERQUE AUTO AUCTION SITE 8" PRIVATE WATERMAIN LAYOUT & PUBLIC SANITARY SEWER IMPROVEMENTS			
APPROVALS	ENGINEER	DATE	APPROVALS
D.R.C. Chair	<i>Ben L. Smith</i>	3/1/19	ENGINEER
Trans. Dev.	<i>Ben L. Smith</i>	3/1/19	DATE
Utility Dev.	<i>Ben L. Smith</i>	3/1/19	DATE
DRAWING NO.	3713	MAP NO.	N-14
SHEET	1	OF	1