



SAN ANTONIO CENTER

NORTHWEST CORNER OF WYOMING BLVD & SAN ANTONIO DR, NE

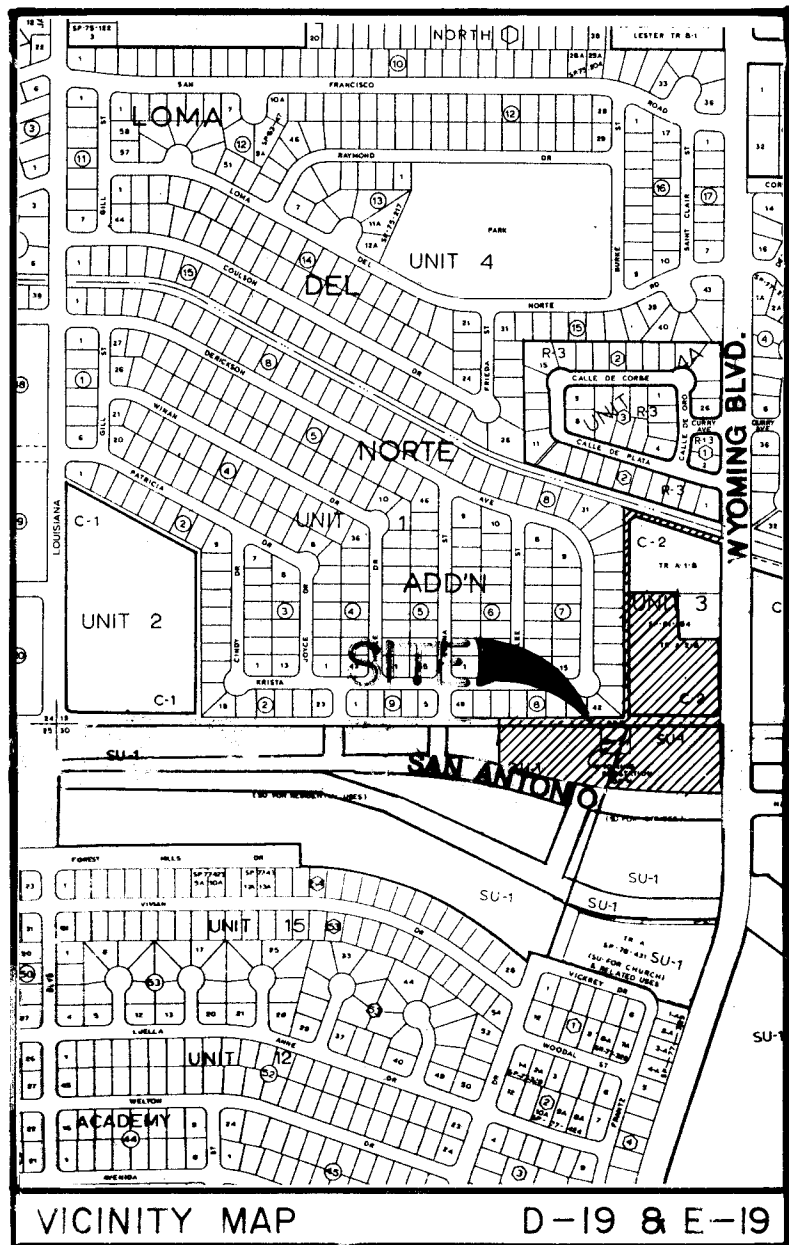


- NEW FIRE HYDRANTS
- RELOCATED FIRE HYDRANTS
- DECELERATION LANES
- MEDIAN MODIFICATIONS
- ALLEY PAVING & GRADES
- DRIVEPADS, CURB & GUTTER, SIDEWALK

INDEX TO SHEETS	
1 of 12	TITLE SHEET
2 of 12	PLAT
3 of 12	GENERAL NOTES AND PROJECT LEGEND
4 of 12	OVERALL UTILITY PLAN , OVERALL PAVING PLAN
5 of 12	OVERALL GRADING PLAN
6 of 12	WATER LINE EXTENSIONS LINE "A" & LINE "B"
7 of 12	SAN ANTONIO DRIVE PAD
8 of 12	SAN ANTONIO DECELERATION LANE & DRIVE PAD
9 of 12	WYOMING DECELERATION LANE, DRIVE PADS & SIDEWALK
10 of 12	WYOMING MEDIAN MODIFICATIONS
11 of 12	ALLEY GRADES & PAVING
12 of 12	BARRICADE PLAN

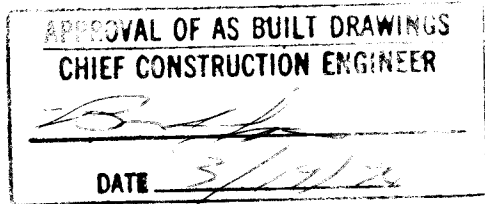

26 37220190

REV.	SHEETS	CITY ENGINEER	DATE	USER DEPARTMENT	DATE	USER DEPARTMENT	DATE
APPROVAL OF REVISIONS							

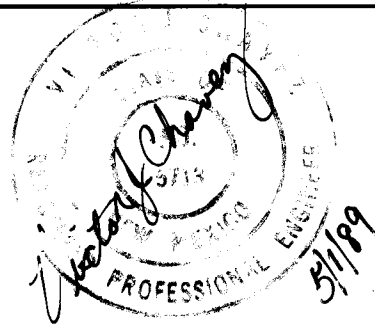

APPROVED FOR CONSTRUCTION
Jeffrey Chavez
P.E.

PROJECT NO. 3722
SHEET 1 OF 12

DRAWING NO.	3722	MAP NO. D-19 & E-19	SHEET 2 OF 12
-------------	------	------------------------	---------------

1. THE CONTRACTOR WILL NOT WILLFULLY INSTALL ITEMS AS SHOWN ON THE PLANS WHEN IT IS OBVIOUS IN THE FIELD THAT CONDITIONS EXIST THAT MIGHT NOT HAVE BEEN CONSIDERED IN THE DESIGN. SUCH CONDITIONS SHOULD BE BROUGHT TO THE ATTENTION OF THE ENGINEER. IN THE EVENT THE CONTRACTOR DOES NOT NOTIFY THE ENGINEER, THE CONTRACTOR ASSUMES FULL RESPONSIBILITY FOR ANY REVISIONS NECESSARY.
2. ALL WORK ON THIS PROJECT SHALL BE PERFORMED IN ACCORDANCE WITH APPLICABLE FEDERAL, STATE AND LOCAL LAWS, RULES AND REGULATIONS CONCERNING CONSTRUCTION SAFETY AND HEALTH.
3. PRIOR TO CONSTRUCTION, THE CONTRACTOR SHALL EXCAVATE AND VERIFY THE HORIZONTAL AND VERTICAL LOCATIONS OF ALL OBSTRUCTIONS. SHOULD A CONFLICT EXIST, THE CONTRACTOR SHALL NOTIFY THE ENGINEER OR SURVEYOR SO THAT THE CONFLICT CAN BE RESOLVED WITH MINIMUM AMOUNT OF DELAY.
4. IF ANY UTILITY LINES, PIPELINES, OR UNDERGROUND UTILITY LINES ARE SHOWN ON THESE DRAWINGS, THEY ARE SHOWN IN AN APPROXIMATE MANNER ONLY, AND SUCH LINES MAY EXIST WHERE NONE ARE SHOWN. IF ANY SUCH EXISTING LINES ARE SHOWN, THE LOCATION IS BASED UPON INFORMATION PROVIDED BY THE OWNER OF SAID UTILITY, AND THE INFORMATION MAY BE INCOMPLETE, OR MAY BE OBSOLETE BY THE TIME CONSTRUCTION COMMENCES. THE CONTRACTOR SHALL INFORM ITSELF OF THE LOCATION OF ANY UTILITY LINE, PIPELINE, OR UNDERGROUND UTILITY LINE IN OR NEAR THE AREA OF THE WORK IN ADVANCE OF AND DURING EXCAVATION WORK. THE CONTRACTOR IS FULLY RESPONSIBLE FOR ANY AND ALL DAMAGE CAUSED BY ITS FAILURE TO LOCATE, IDENTIFY AND PRESERVE ANY AND ALL EXISTING UTILITIES, PIPELINES, AND UNDERGROUND UTILITY LINES. IN PLANNING AND CONDUCTING EXCAVATION, THE CONTRACTOR SHALL COMPLY WITH STATE STATUTES, MUNICIPAL AND LOCAL ORDINANCES, RULES AND REGULATIONS, IF ANY, PERTAINING TO THE LOCATION OF THESE LINES AND FACILITIES.
5. CONTRACTOR IS TO EXERCISE DUE CARE TO AVOID DISTURBING ANY EXISTING UNDERGROUND UTILITIES. IT SHALL BE THE CONTRACTORS RESPONSIBILITY TO COORDINATE WITH THE UTILITY COMPANIES IN ORDER TO PREVENT SERVICE DISRUPTION.
6. TWO (2) WORKING DAYS PRIOR TO ANY EXCAVATION, CONTRACTOR MUST CONTACT LINE LOCATING SERVICE, 765-1234, FOR LOCATION OF EXISTING UTILITIES.
7. CONSTRUCTION WHICH IS EXISTING AND NOT TO BE REMOVED UNDER THE CONTRACT WHICH IS DAMAGED OR DISPLACED BY THE CONTRACTOR SHALL BE REMOVED AND REPLACED BY THE CONTRACTOR AT HIS EXPENSE.

9. THE CONTRACTOR SHALL ENSURE THAT NO SOIL ERODES FROM THE SITE INTO PUBLIC RIGHT-OF-WAY OR ONTO PRIVATE PROPERTY. THIS CAN BE ACHIEVED BY CONSTRUCTING TEMPORARY BERMS AT THE PROPERTY LINES AND WETTING THE SOIL TO KEEP IT FROM BLOWING.
9. THE CONTRACTOR SHALL PROMPTLY CLEAN UP ANY MATERIAL EXCAVATED WITHIN THE PUBLIC RIGHT-OF-WAY SO THAT THE EXCAVATED MATERIAL IS NOT SUSCEPTIBLE TO BEING WASHED DOWN THE STREET.
10. AN EXCAVATION/CONSTRUCTION PERMIT WILL BE REQUIRED BEFORE BEGINNING ANY WORK WITHIN CITY RIGHT-OF-WAY. AN APPROVED COPY OF THESE PLANS MUST BE SUBMITTED AT THE TIME OF APPLICATION FOR THIS PERMIT.
11. CONTRACTOR IS RESPONSIBLE FOR OBTAINING ALL PERMITS TO CONSTRUCT FACILITIES WITHIN CITY RIGHT-OF-WAY.
12. ALL SIGNS, BARRICADES, CHANNELIZATION DEVICES, SIGN FRAMES AND ERECTION OF SUCH DEVICES SHALL CONFORM TO THE REQUIREMENTS OF THE NEW MEXICO MANUAL AND SPECIFICATIONS FOR A UNIFORM SYSTEM OF TRAFFIC CONTROL DEVICES FOR STREETS AND HIGHWAYS; LATEST EDITION. ALL ADVANCE WARNING SIGNS SHALL BE EQUIPPED WITH TYPE A FLASHING WARNING LIGHTS; ALL CHANNELIZING DEVICES SHALL BE EQUIPPED WITH TYPE C STEADY BURN WARNING LIGHTS.
13. CONTRACTOR SHALL CONDUCT OPERATION SO THAT AT NO TIME IS LANE OF TRAFFIC CLOSED. REFER TO SECTION 19 OF SPECIFICATIONS.
14. WHEN CONSTRUCTION UNDER THIS PROJECT CONNECTS TO EXISTING IMPROVEMENTS, THE CONTRACTOR SHALL PROVIDE AN EASY RIDING CONNECTION.
15. ALL WATER VALVE BOXES AND SEWER MANHOLES IN THE CONSTRUCTION AREA ARE TO BE ADJUSTED TO FINISH GRADE.
16. TACK COAT REQUIREMENTS SHALL BE DETERMINED BY THE CITY ENGINEER.
17. CONTRACTOR SHALL PROVIDE 12" SUBGRADE PREPARATION UNDER ALL NEW PAVEMENT, CURBS AND GUTTERS, VALLEY GUTTERS AND CONCRETE FILLETS.
18. SIDEWALKS AND WHEELCHAIR RAMPS WITHIN THE CURB RETURNS SHALL BE CONSTRUCTED WHEREVER A NEW CURB RETURN IS CONSTRUCTED.
19. WHEN ABUTTING NEW PAVEMENT TO EXIST, CUT BACK EXISTING PAVEMENT TO A NEAT, STRAIGHT LINE AS REQUIRED TO REMOVE ANY BROKEN OR CRACKED PAVEMENT, AND MATCH NEW PAVING TO EXISTING.
20. ALL UTILITIES AND UTILITY SERVICE LINES SHALL BE INSTALLED PRIOR TO PAVING.

21. ALL WORK DETAILED ON THESE PLANS TO BE PERFORMED UNDER CONTRACT SHALL, EXCEPT AS OTHERWISE STATED OR PROVIDED FOR HEREON, BE CONSTRUCTED IN ACCORDANCE WITH THE "CITY OF ALBUQUERQUE, STANDARD SPECIFICATIONS FOR PUBLIC WORKS CONSTRUCTION, 1986" (COA STND).
22. REFERENCE MADE TO STANDARD DRAWINGS REFER TO ALBUQUERQUE STANDARD DRAWINGS.
23. WATERING, AS REQUIRED FOR CONSTRUCTION AND DUST CONTROL, SHALL BE CONSIDERED INCIDENTAL TO CONSTRUCTION AND NO MEASUREMENT OR PAYMENT SHALL BE MADE THEREFORE. CONSTRUCTION AREAS SHALL BE WATERED FOR DUST POLLUTION ABATEMENT AS DRECTED BY THE ENGINEER. THE CONTRACTOR SHALL BE RESPONSIBLE FOR LOCATING AND SUPPLYING WATER AS REQUIRED.
24. THE AIR POLLUTION CONTROL REGULATIONS OF THE ALBUQUERQUE-BERNALILLO COUNTY AIR QUALITY CONTROL BOARD LIMIT EMISSION OF PARTICULATE MATTER AND THE USE OF CUT BACK ASPHALT. IT IS THE RESPONSIBILITY OF THE CONTRACTOR TO CLARIFY THESE RESTRICTIONS WITH THE ENVIRONMENTAL HEALTH DEPARTMENT PRIOR TO SUBMITTAL OF BIDS TO AVOID CONFLICTS WITH REGULATIONS."
25. ELECTRONIC MARKER DISCS SHALL BE PLACED IN ACCORDANCE WITH SECTION 170 OF THE CITY OF ALBUQUERQUE, STANDARD SPECIFICATIONS, PUBLIC WORKS CONSTRUCTION.
26. CONTRACTOR SHALL ASSIST THE ENGINEER/INSPECTOR IN THE RECORDING OF DATA ON ALL UTILITY LINES AND ACCESSORIES AS REQUIRED BY THE CITY OF ALBUQUERQUE FOR THE PREPARATION OF "AS CONSTRUCTED" DRAWINGS. CONTRACTOR SHALL NOT COVER UTILITY LINES AND ACCESSORIES UNTIL ALL DATA HAS BEEN RECORDED.
27. CONTRACTOR SHALL COORDINATE WITH WATER SYSTEMS DIVISION (823-4200) THREE WORKING DAYS IN ADVANCE OF ANY WORK THAT MAY AFFECT EXISTING PUBLIC WATER UTILITIES.

DESCRIPTION	NEW	EXISTING
PROPERTY LINE	== .. ==	== .. ==
EASEMENT	== - - - - ==	== - - - - ==
CURB & GUTTER	=====	=====
CURB	=====	=====
VALLEY GUTTER	=====	~
SIDEWALK	=====	== - - - - ==
WATERLINE	== W ==	== W ==
WATER VALVE		
FIRE HYDRANT		
SANITARY SEWER LINE	== SAS ==	== SAS ==
CONC. THRUST BLOCKING		~
CONTOUR	== 50 ==	== 50 ==

TC = TOP OF CURB or CONCRETE
TA = TOP OF ASPHALT
FL = FLOWLINE

Area = 1.4509 acres
I = 2.2 in./hr. Plate 22.2 D-2
6-hour, 100-year rainfall = 2.4 in. Plate 22.2 D-1
 $i = (2.2)(2.4) = 5.28$ in./hr.

EXISTING ON-SITE CONDITIONS: (LANDSCAPE COMPANY SITE)

SURFACE TYPE	"C" VALUE	A (ACRES)	"C"X A	COMPOSITE "C"=CXA/A
Streets, Drives, Walks	0.95	0.2755	0.2617	
Roofs	0.90			
Lawns & Landscaping	0.25			
Undeveloped	0.40	0.2755	0.1102	
TOTAL		0.5510	0.3719	0.68

$$Q(100) = (0.68)(5.28)(0.5510) = 1.96 \text{ cfs}$$

$$Q(10) = (0.657)(1.96) = 1.29 \text{ cfs}$$

EXISTING ON-SITE CONDITIONS: (SKAGGS)

SURFACE TYPE	"C" VALUE	A (ACRES)	"C" X A	COMPOSITE "C"=CXA/A
Streets, Drives, Walks	0.95			
Roofs	0.90			
Lawns & Landscaping	0.25			
Undeveloped	0.40	0.8999	0.3600	

$$\begin{aligned} Q(100) &= (0.40)(5.28)(0.8999) = 1.90 \text{ cfs} \\ Q(10) &= (0.657)(1.90) = 1.25 \text{ cfs} \end{aligned}$$

TOTAL RUNOFF TO ALLEY $1.96 + 1.90 = 3.86$ CFS
TOTAL AREA DRAINING TO ALLEY $= 0.5510 + 0.8999 = 1.4509$ AC

ALLEY CAPACITY:

$$\begin{aligned} S &= 0.0044 \\ A &= 2 (0.5) (10 \times 0.2) = 2 \text{ SF} \\ N &= 0.013 \\ P &= 2 \left(\sqrt{10^2 + 0.2^2} \right) = 20.00 \\ R &= A/P = 2/20 = 0.10 \end{aligned}$$

$$Q = 1.49 R^{2/3} S^{1/2} A$$

$$= \frac{1.49}{0.013} (0.10)^{2/3} (0.0044)^{1/2} (2)$$

PRESENTY RUNOFF EXCEEDS DEVELOPED ALLEY CAPACITY

LIMIT CAPACITY OF SKAGGS SITE TO
 $3.86 - 3.28 = 0.58$
 $1.90 - 0.58 = \underline{1.32 \text{ CFS}}$


ENGINEER'S SEAL		SURVEY INFORMATION		BENCH MARKS		AS BUILT INFORMATION	
		FIELD NOTES		A Standard A.C.S. Brass Tablet Stamped "6-19-1919," Set in Top of Concrete Post Flush with the Ground, Located at the Intersection of Wyoming Blvd, NE and the Vacated San Antonio Drive, NE E (Elev = 5403.84 (M.S.L.D.))		CONTAINED BY J.R. HALE DRAWN BY SURVEYING DATE 1-90 INSPECTED BY DATE FIELD DISTANCE BY L.V. DATE VERIFICATION BY DATE CORRECTED BY DATE MICRO-FILM INFORMATION	
		NO.	BY				
NO.	DATE	REMARKS	BY				
DESIGN							
DESIGNED BY	RGS	DATE	3-89				
DRAWN BY	AJF	DATE	3-89				
CHECKED BY	VJC	DATE					

CITY OF ALBUQUERQUE
PUBLIC WORKS DEPARTMENT
ENGINEERING GROUP


TITLE: SAN ANTONIO CENTER
GENERAL NOTES
AND PROJECT LEGEND

APPROVALS	ENGINEER	DATE	APPROVALS	ENGINEER	DATE
D.R.C. Chair	<i>Royce R. Khan</i>	5/16/89			
Trans. Dev.					
Utility Dev.	<i>M. H. M. Khan</i>	5/16/89			


DRAWING NO.	3722	MAP NO.	D-19 & E-19	SHEET	3	OF	12
-------------	------	---------	-------------	-------	---	----	----

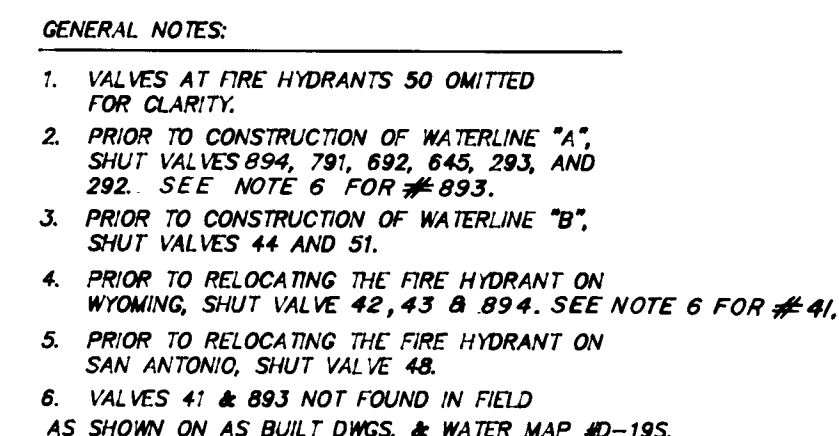


SCALE 1"=100

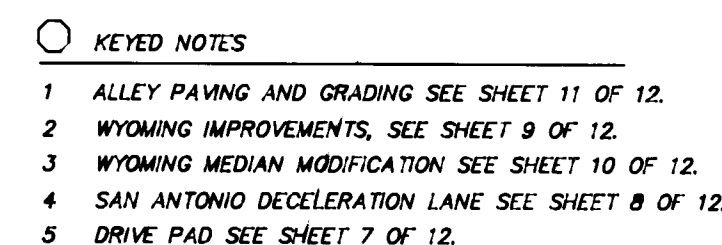


SCALE 1"=100'

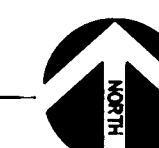


CITY OF ALBUQUERQUE PUBLIC WORKS DEPARTMENT ENGINEERING GROUP						
TITLE:		SAN ANTONIO CENTER OVERALL PAVING PLAN OVERALL UTILITY PLAN				
APPROVALS	ENGINEER	DATE	APPROVALS	ENGINEER	DATE	
D.R.C. CHAIRMAN	<i>Ryan A. Khan</i>	5/16/18				
TRANS. DEV.		5/16/18				
UTILITY DEV.	<i>Alfonso</i>	5/16/18				
DRAWING NO.	3722		MAP NO. D-19 & E-19	SHEET	4 OF 12	

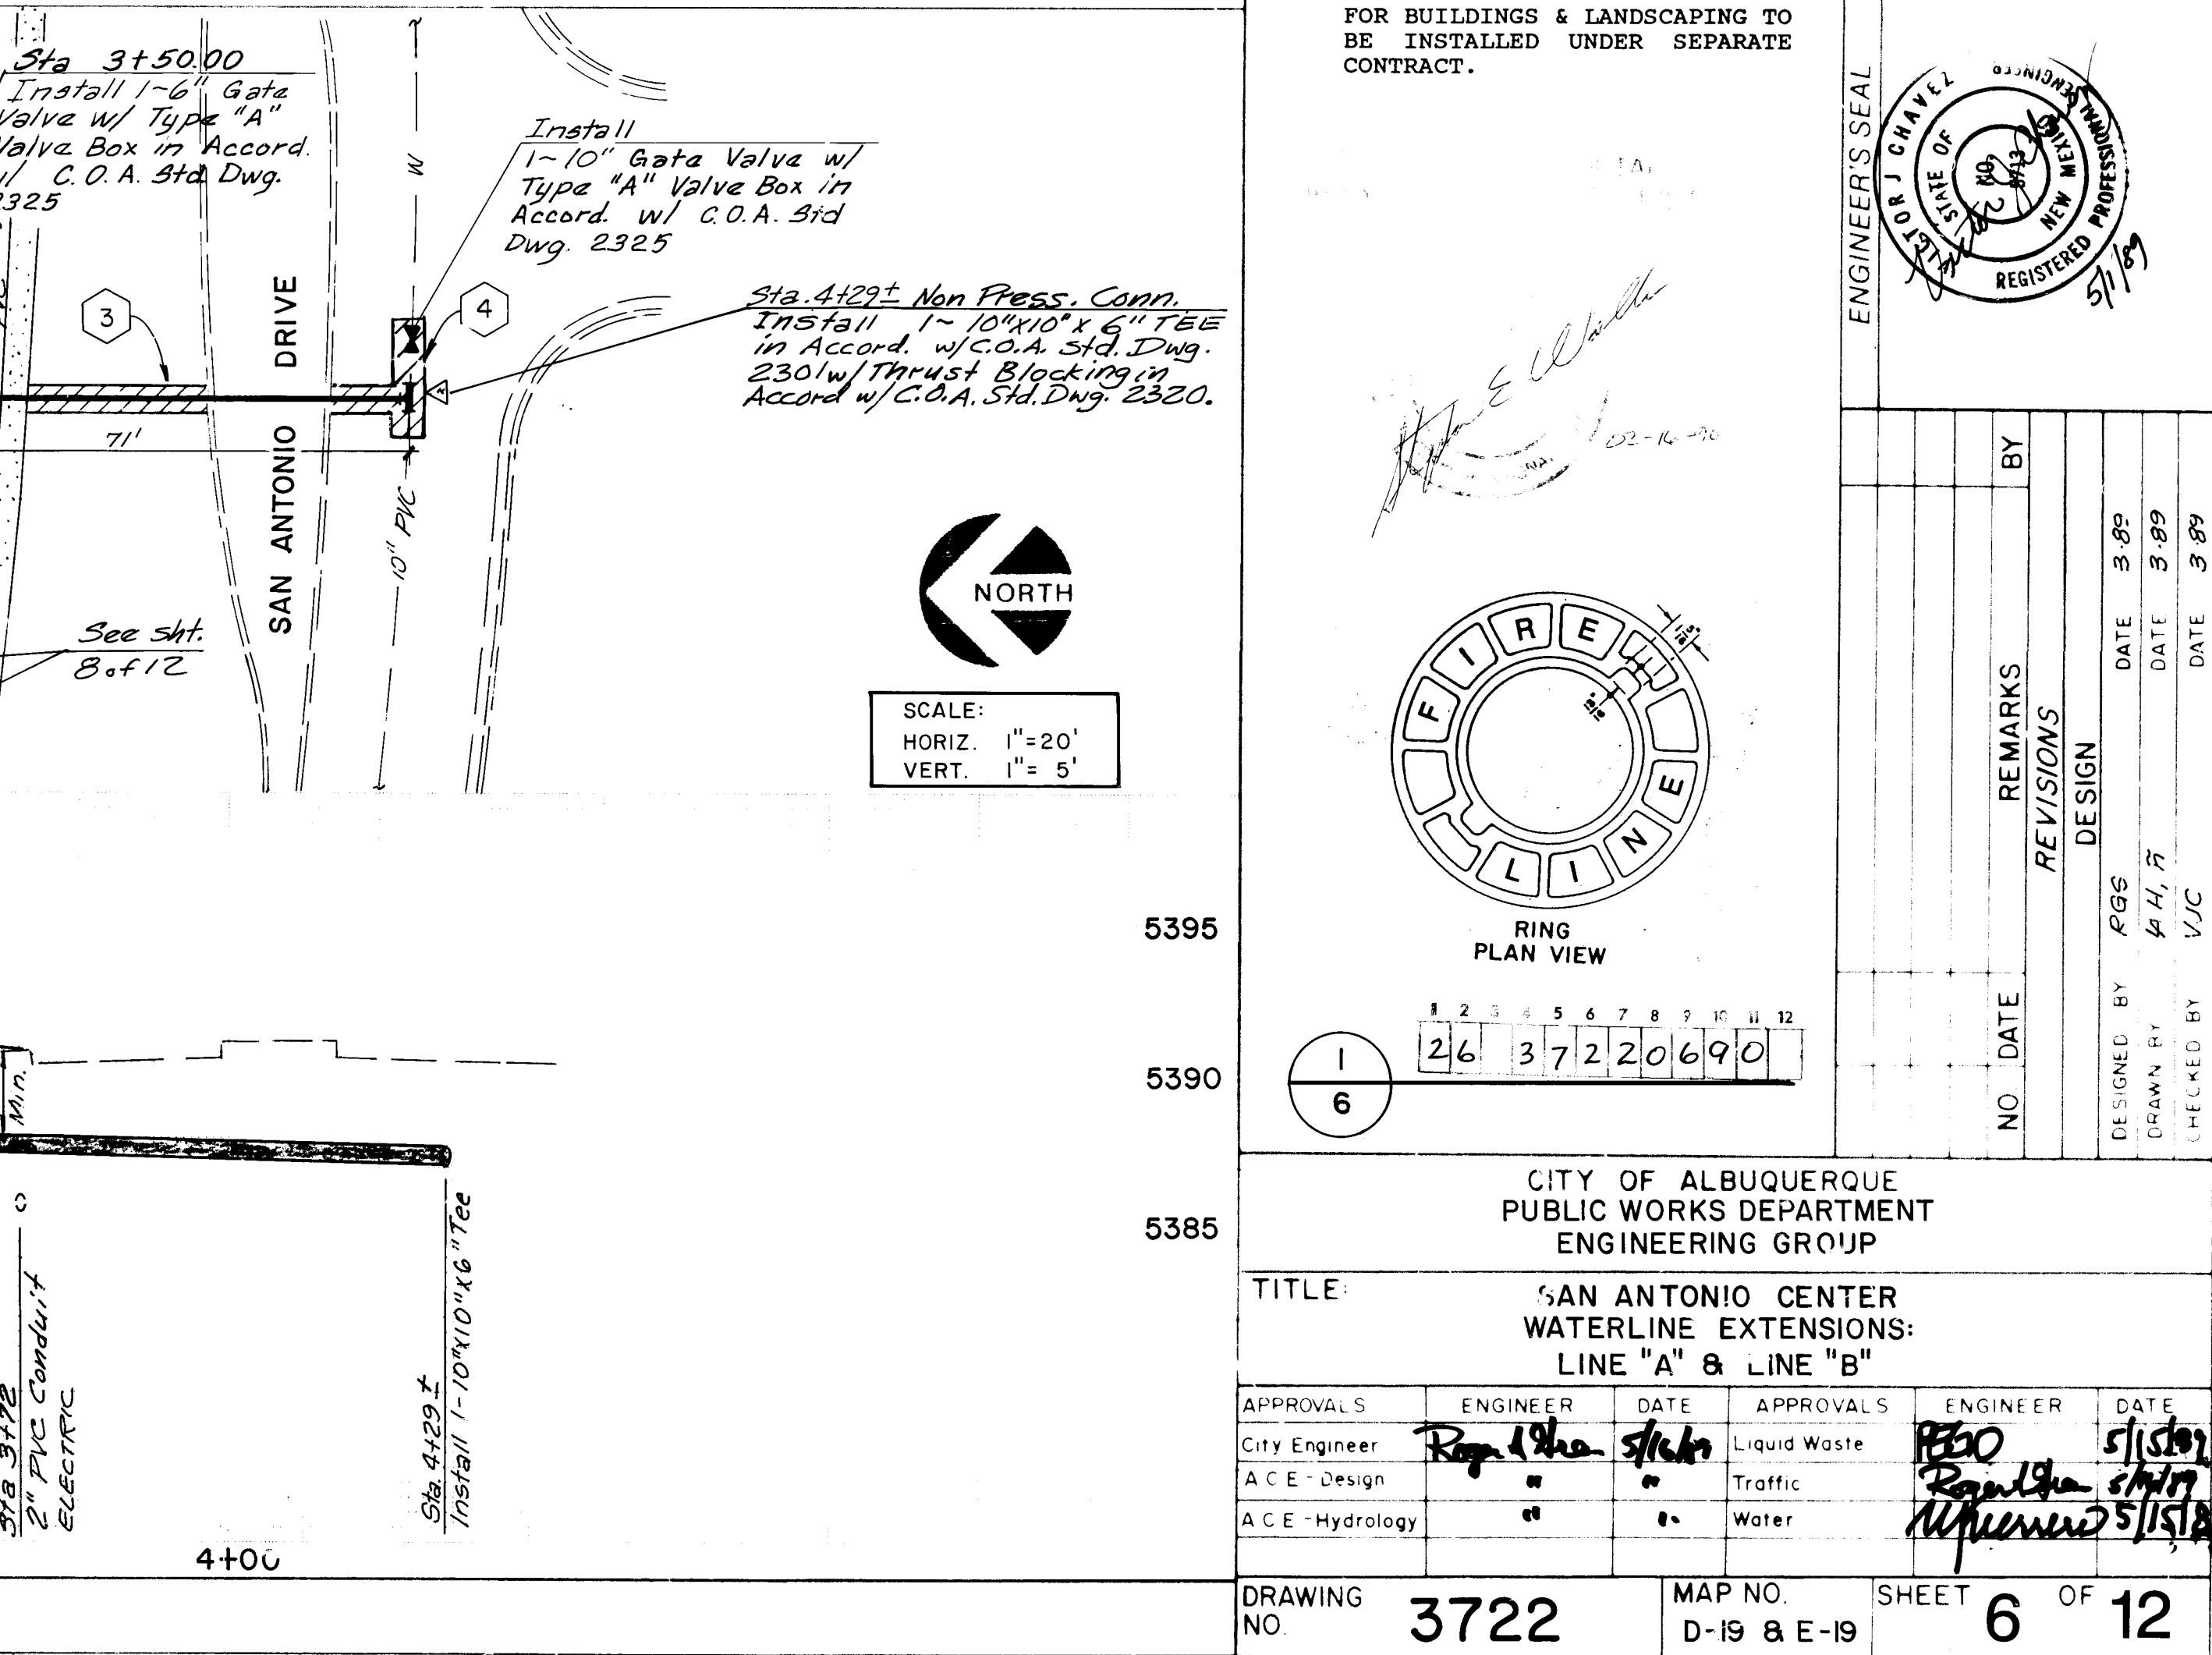

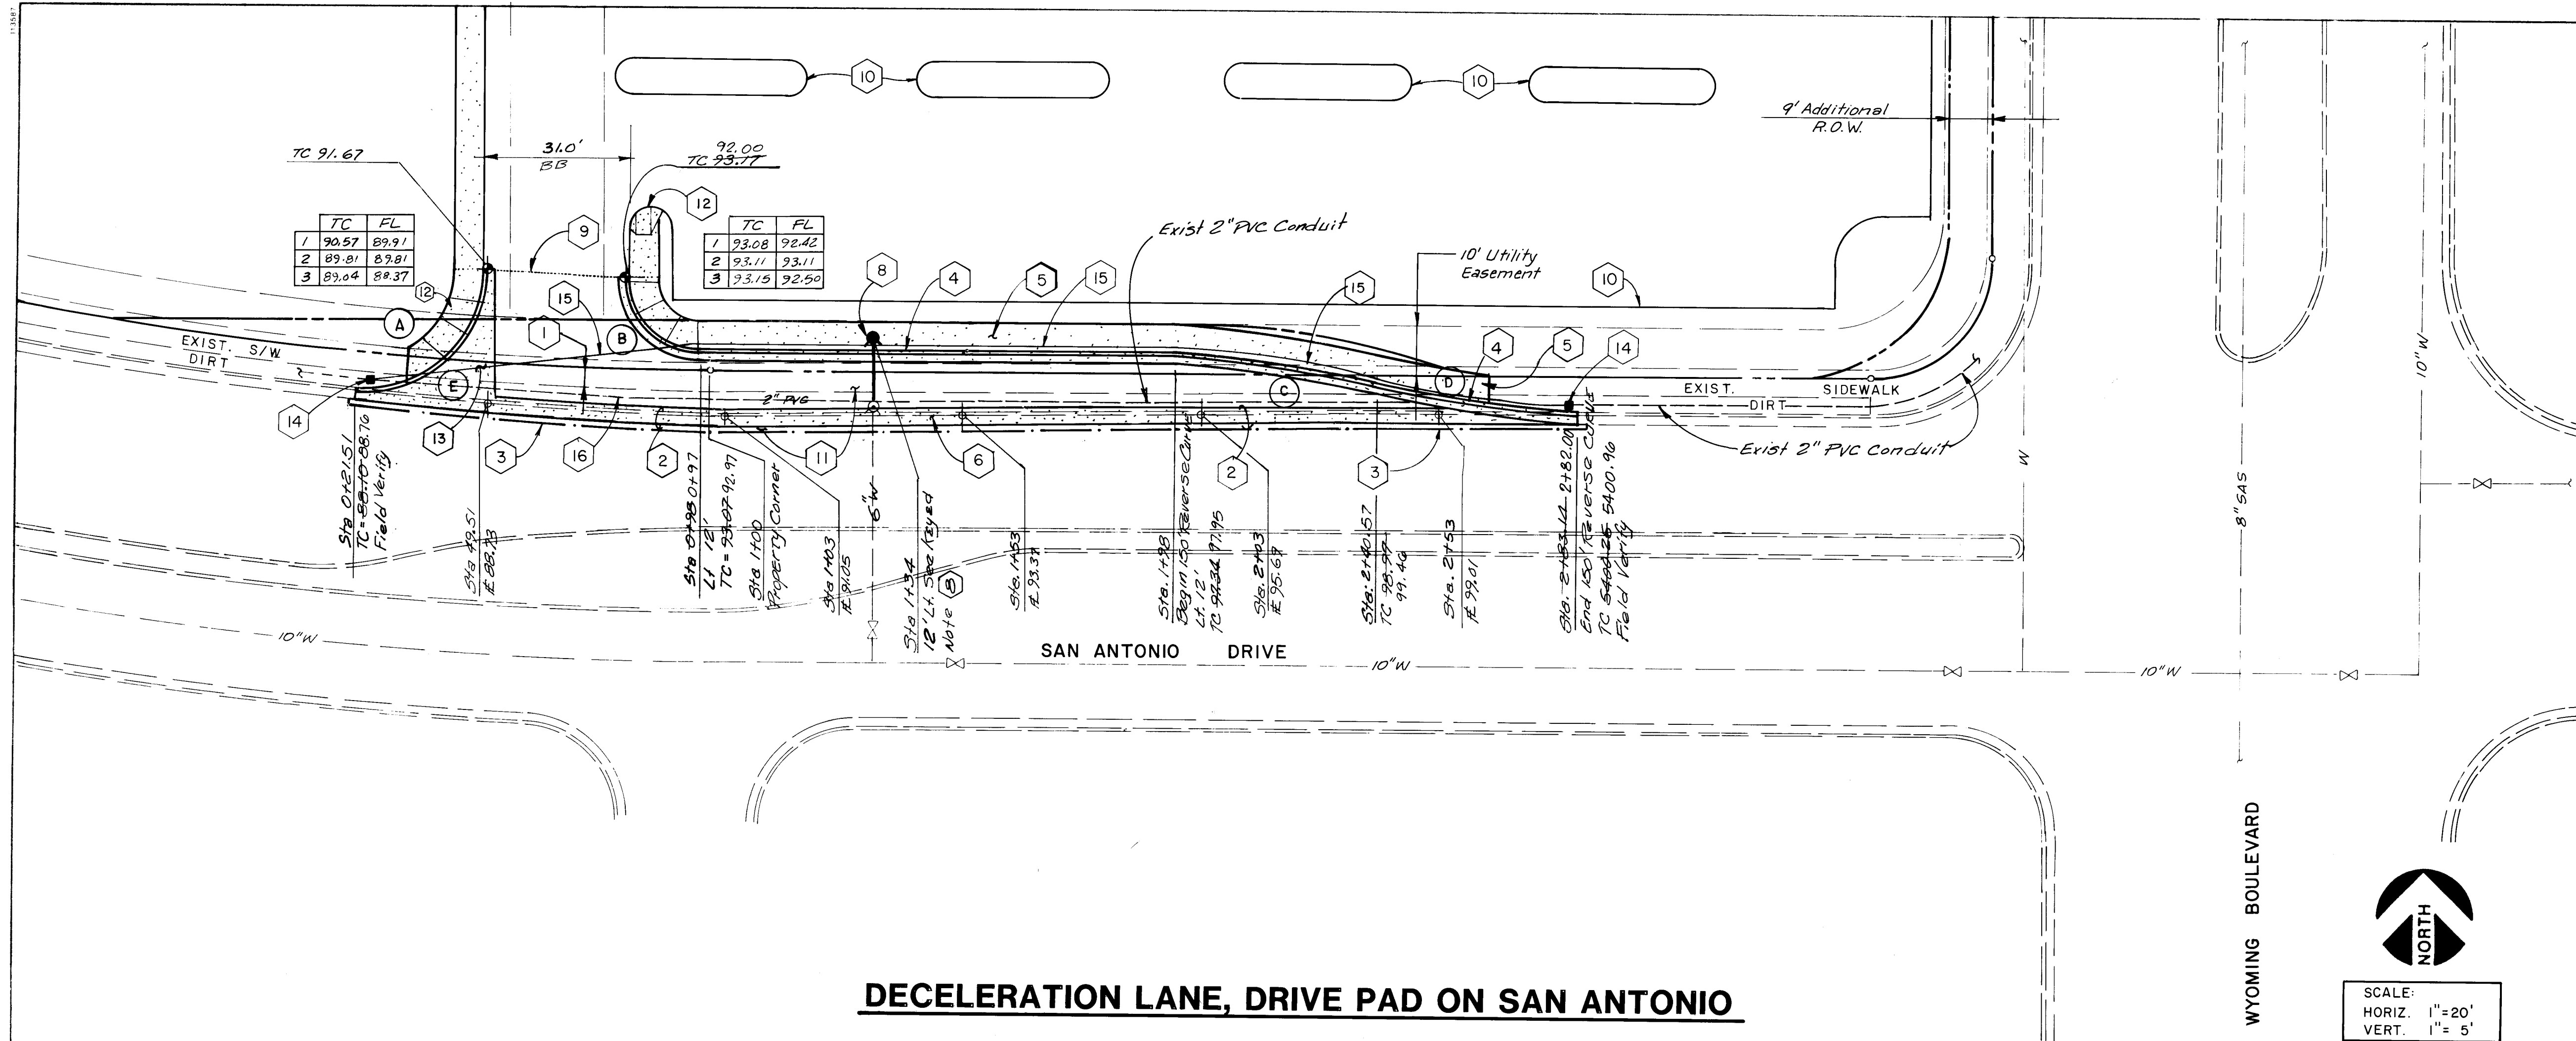

DECELERATION LANE, DRIVE PAD ON SAN ANTONIO

5405
5400
5395
5390
5385

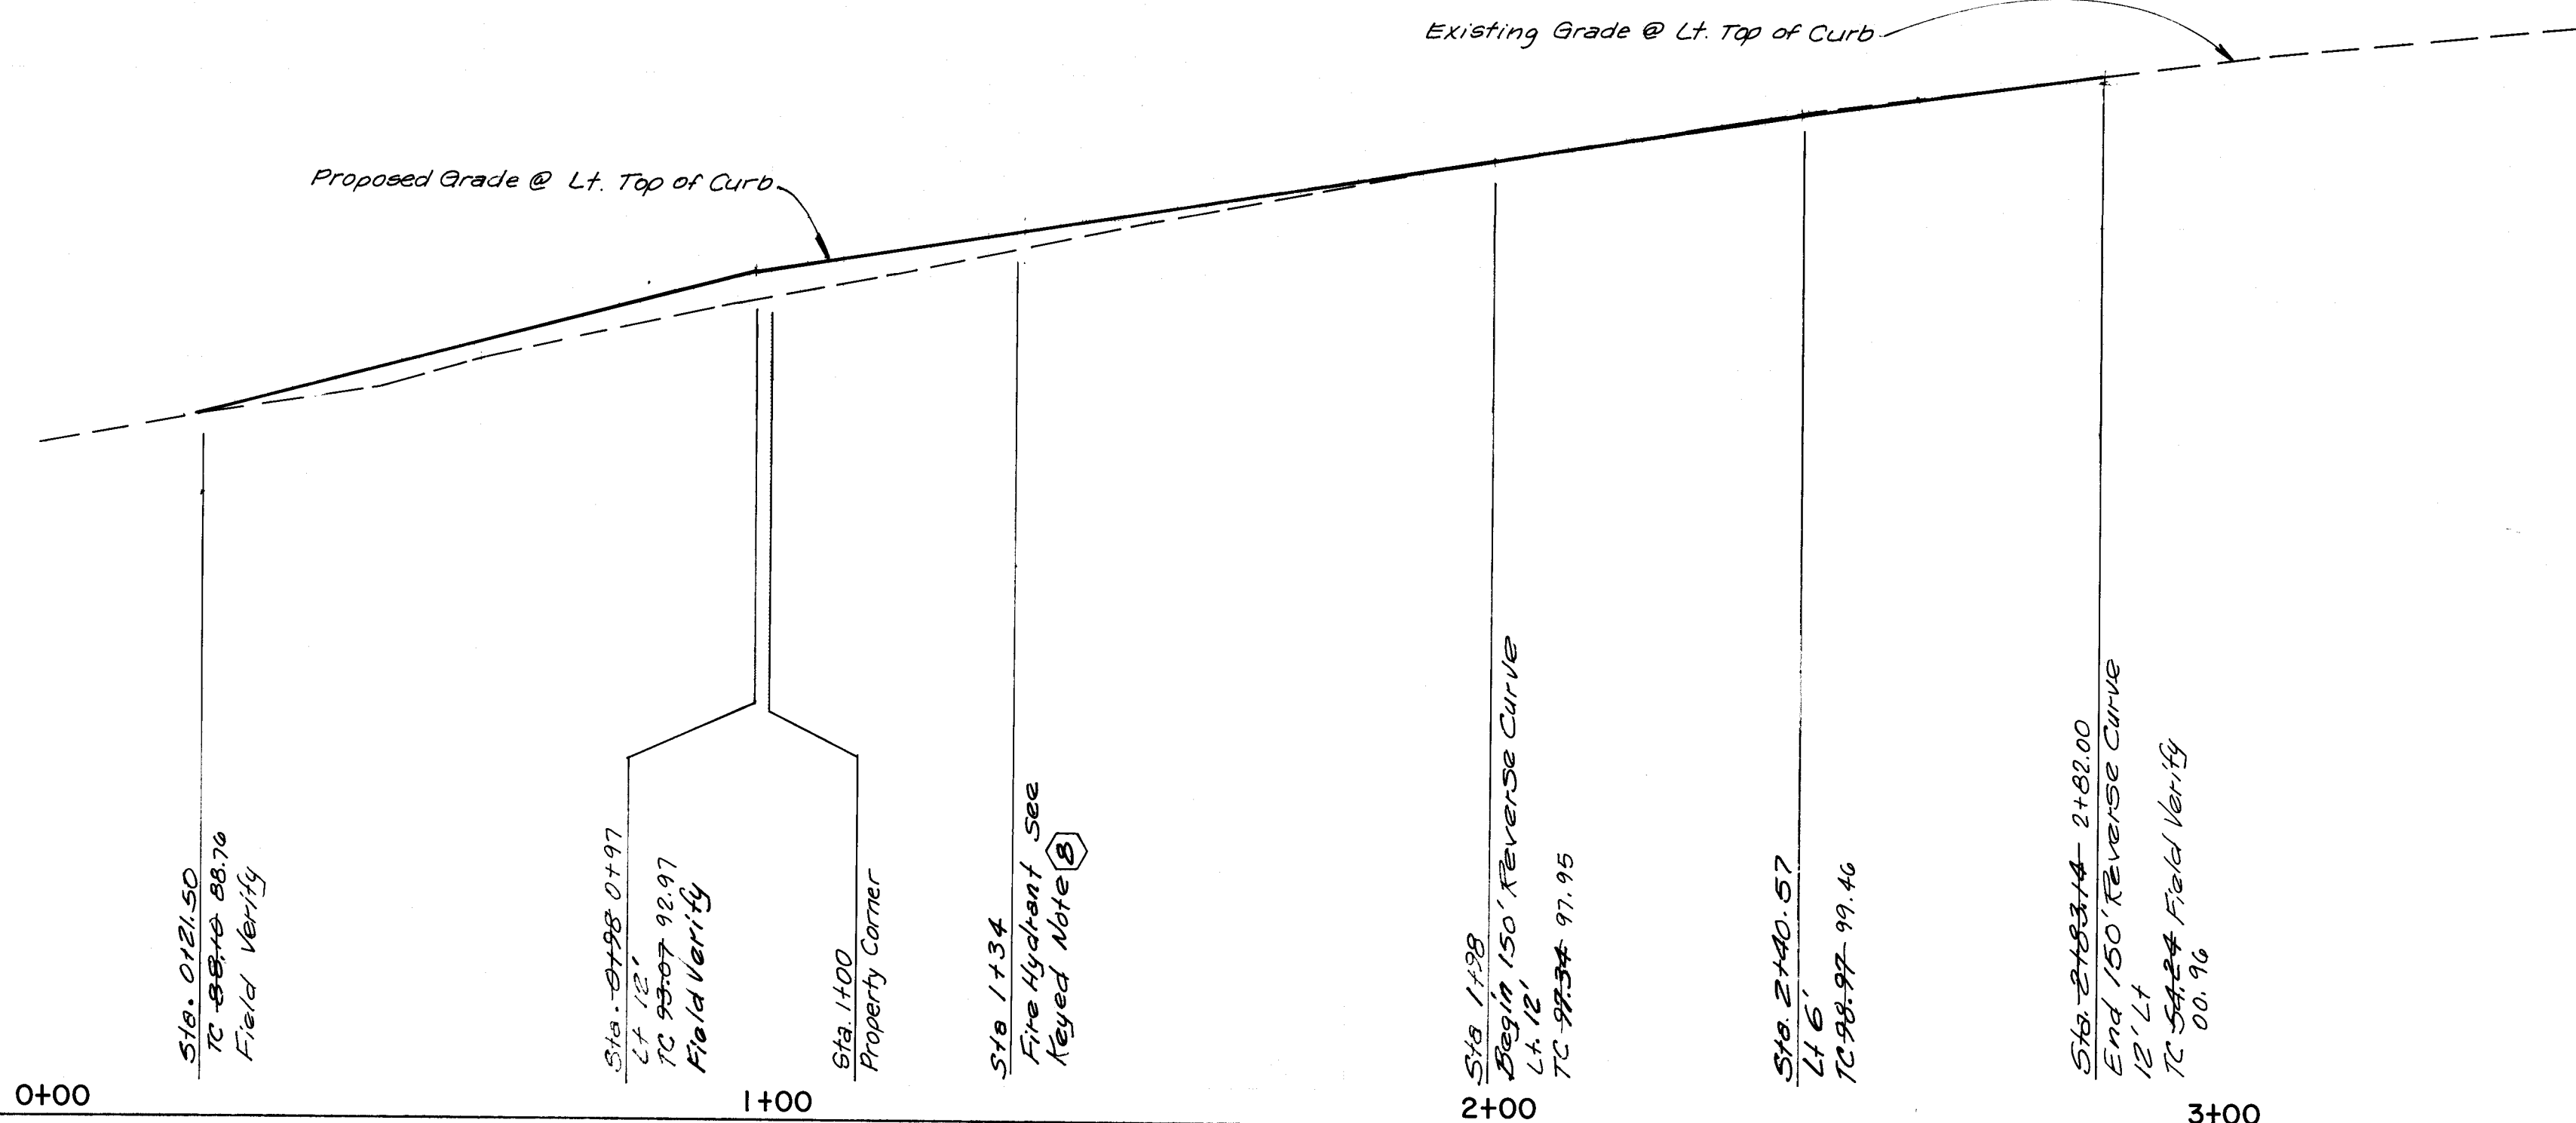

WYOMING BOULEVARD



SCALE:
HORIZ. 1"=20'
VERT. 1"=5'

- KEYED NOTES:**
- REMOVE EXISTING SIDEWALK TO THE NEAREST JOINT.
 - REMOVE EXISTING CURB & GUTTER TO THE NEAREST JOINT.
 - LIMITS OF PAVEMENT REMOVAL.
 - NEW CURB & GUTTER IN ACCORDANCE WITH CITY OF ALBUQUERQUE STANDARD DRAWING 2415.
 - NEW 6' WIDE SIDEWALK IN ACCORDANCE WITH CITY OF ALBUQUERQUE STANDARD DRAWING 2430.
 - NEW 4' WIDE VALLEY GUTTER IN ACCORDANCE WITH CITY OF ALBUQUERQUE STANDARD DRAWING 2421, SECTION A-A. NOT USED
 - STA. 1+34. RELOCATE EXISTING FIRE HYDRANT AND EXTEND 6" WATER LINE APPROXIMATELY 12' NORTH. INSTALL IN ACCORDANCE WITH CITY OF ALBUQUERQUE STANDARD DRAWING 2320. FIRE HYDRANT FLANGE ELEVATION 5395.0 SEE SHEET 4 FOR VALVE SHUT-OFF PLAN.
 - LIMITS OF CONSTRUCTION, THIS CONTRACT.
 - PROPOSED CONSTRUCTION, NOT THIS CONTRACT.
 - ARTERIAL PAVING SECTION. SEE ARTERIAL PAVING DETAIL, SHEET 5.
 - HANDICAPPED RAMPS. TYP.
 - CONSTRUCT CONCRETE VALLEY GUTTER IN ACCORDANCE WITH C.O.A. STD. DWG. 2420.
 - INSTALL 17" X 34" PULL BOXES PER C.O.A. STD. DWG. 2521.
 - INSTALL NEW 2" PVC CONDUIT. 18" MIN. BURY.
 - REMOVE EXISTING 2" PVC CONDUIT.

CURB DATA:

	R	La	D
A	25'	41.78	95°44'45"
B	15'	23.48	89°40'20"
C	150'	42.57	16°15'37"
D	150'	42.57	16°15'37"
E	800'	381.40	27°18'56"

26 3 7 2 2 0 8 9 0


CITY OF ALBUQUERQUE
PUBLIC WORKS DEPARTMENT
ENGINEERING GROUP

TITLE SAN ANTONIO CENTER
SAN ANTONIO DECELERATION LANE & DRIVEPAD

APPROVALS	ENGINEER	DATE	APPROVALS	ENGINEER	DATE
DRC Chair	Rog. A. Khan	5/16/89			
Trans. Dev					
Utility Dev	W. J. J. J.	5/16/89			


DESIGNED BY	DATE	CHECKED BY	DATE
RGS	3/89	W. J. J.	3/89
W. J. J.	3/89	W. J. J.	3/89

DRAWING NO. 3722 MAP NO. D-19 & E-19 SHEET 8 OF 12

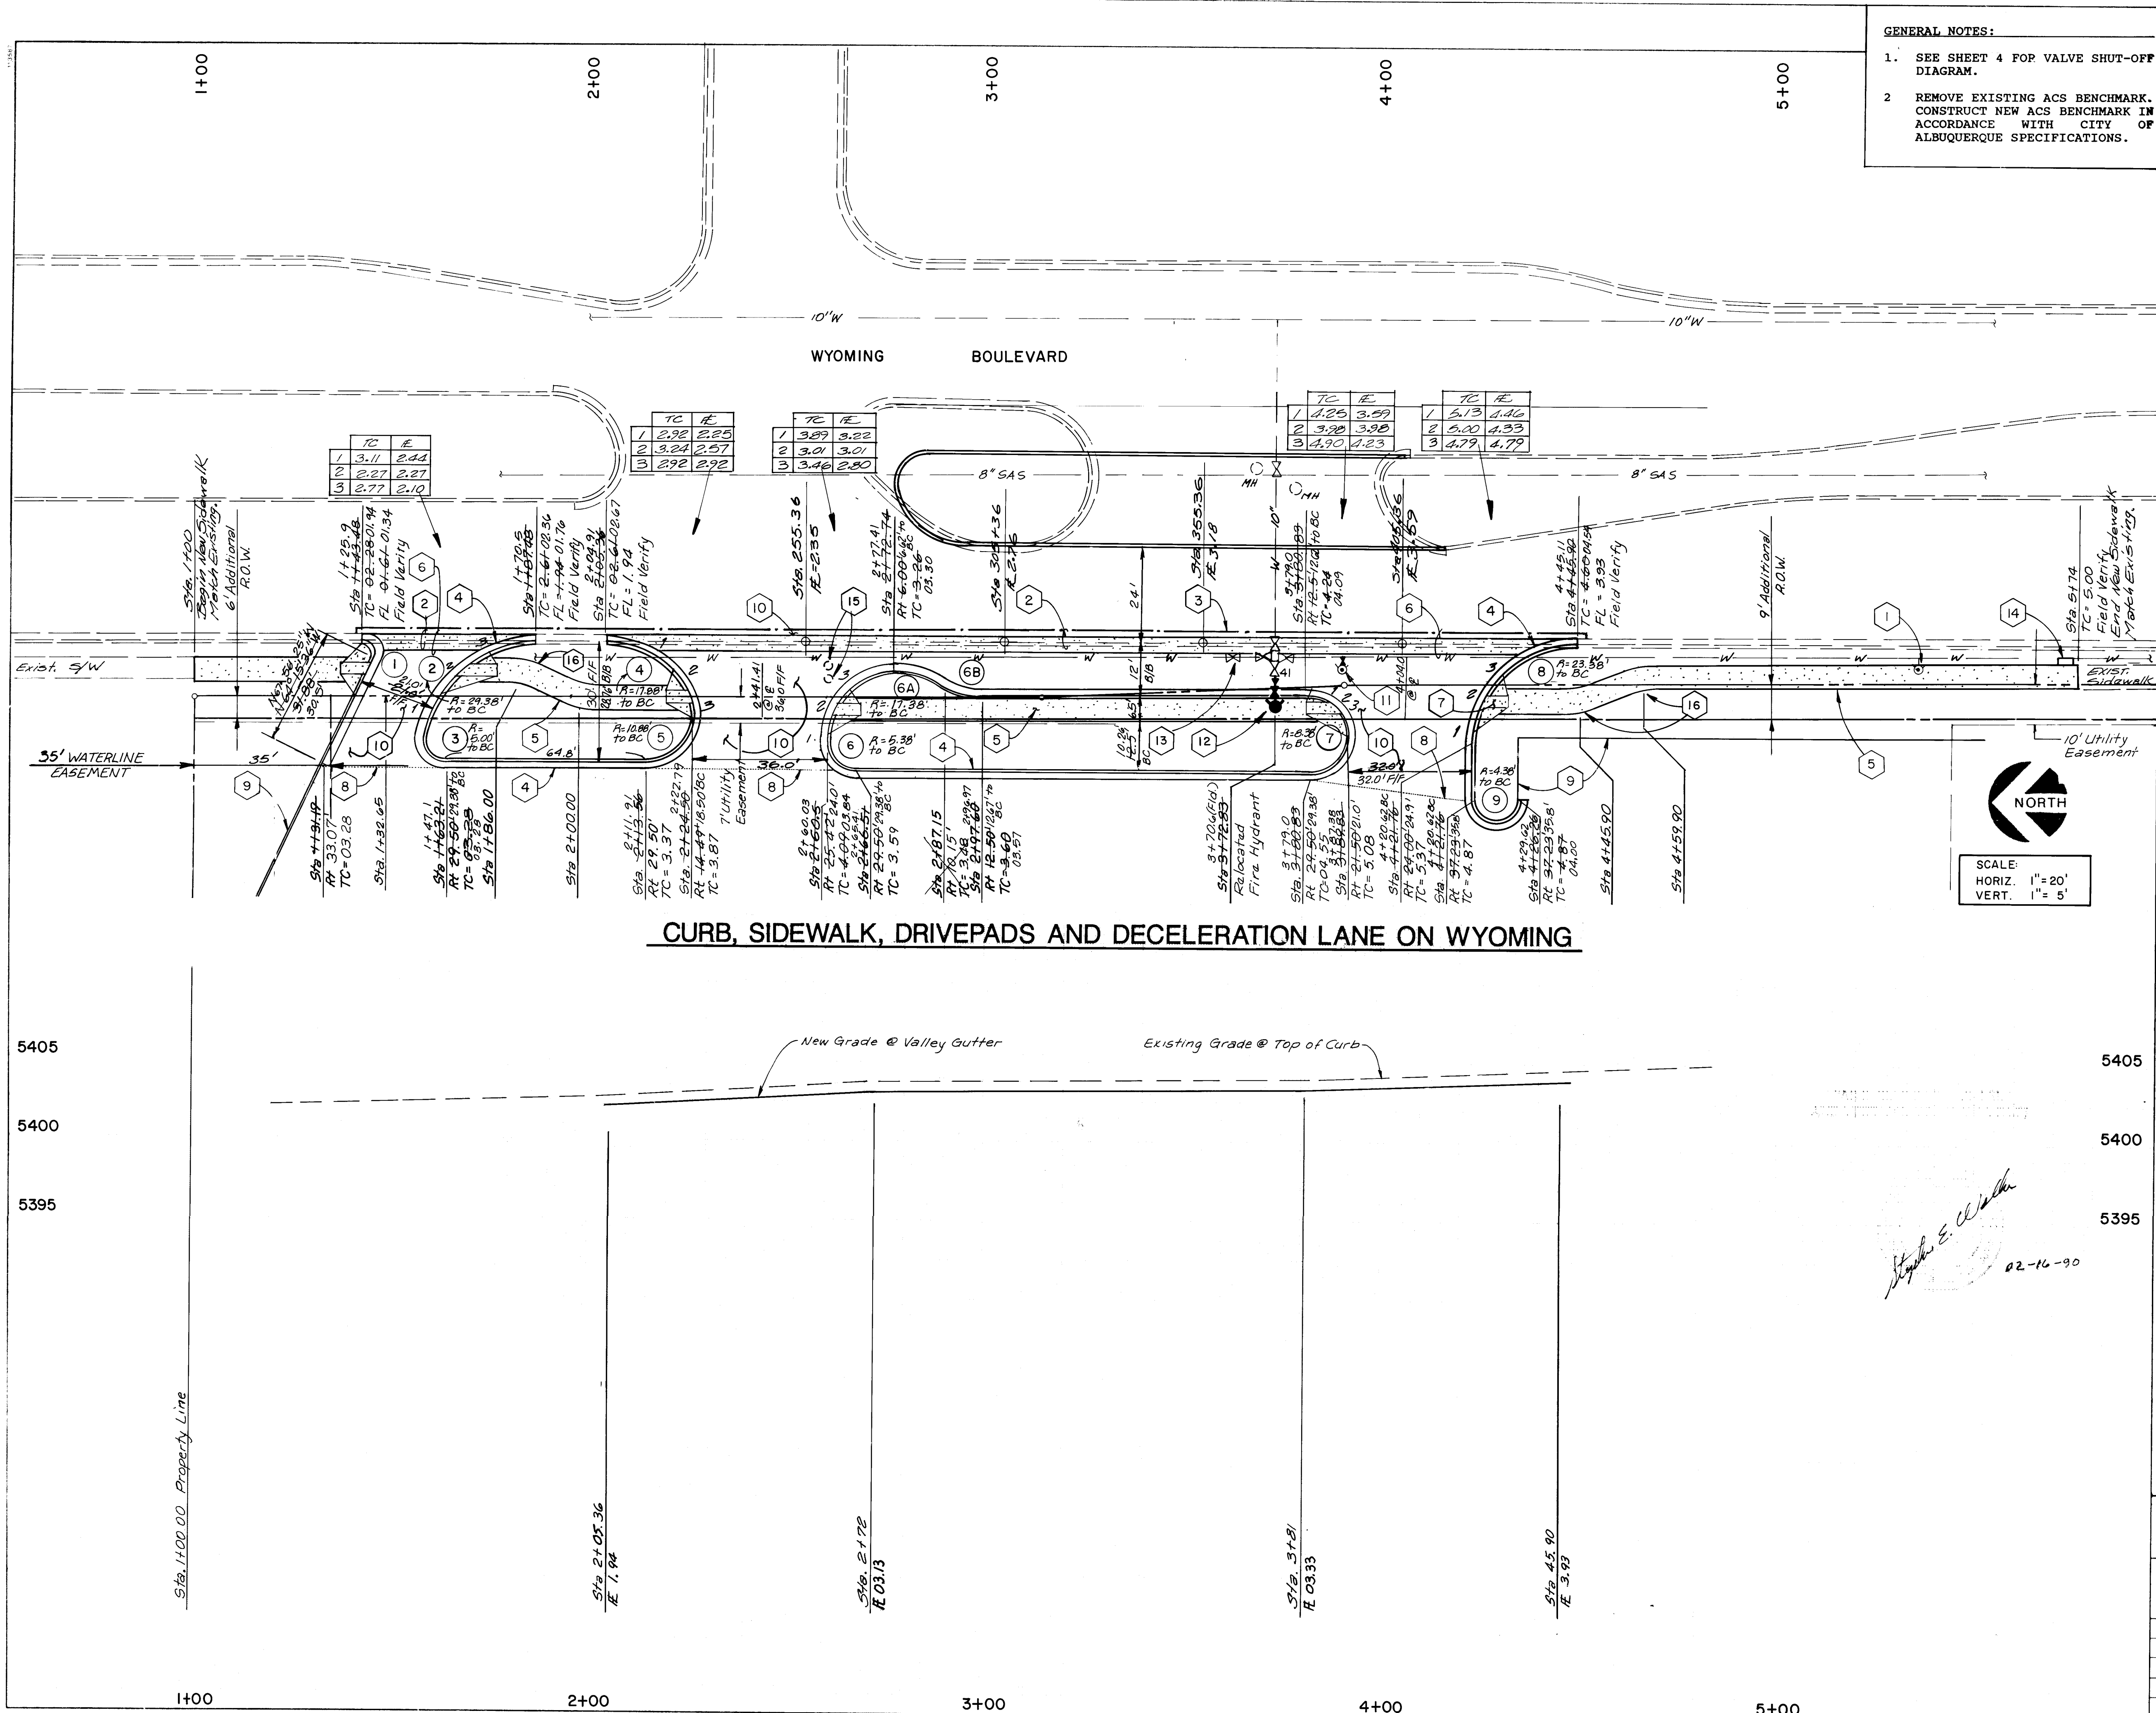

- GENERAL NOTES:**
- SEE SHEET 4 FOR VALVE SHUT-OFF DIAGRAM.
 - REMOVE EXISTING ACS BENCHMARK. CONSTRUCT NEW ACS BENCHMARK IN ACCORDANCE WITH CITY OF ALBUQUERQUE SPECIFICATIONS.

- KEYED NOTES:**
- ADJUST FIRE HYDRANT FLANGE ELEVATION 5405.36 REMOVE & REINSTALL CONCRETE PAD AS REQUIRED.
 - REMOVE EXISTING CURB & GUTTER TO THE NEAREST JOINT.
 - LIMITS OF PAVEMENT REMOVAL.
 - NEW CURB & GUTTER IN ACCORDANCE WITH CITY OF ALBUQUERQUE STANDARD DRAWING 2415.
 - NEW 6' WIDE SIDEWALK IN ACCORDANCE WITH CITY OF ALBUQUERQUE STANDARD DRAWING 2430.
 - NEW 4' WIDE VALLEY GUTTER IN ACCORDANCE WITH CITY OF ALBUQUERQUE STANDARD DRAWING 2415.
 - WHEEL CHAIR RAMP IN ACCORDANCE WITH C.O.A. STD DWG. 2426. TYP OF 6.
 - LIMITS OF NEW ARTERIAL PAVING.
 - PROPOSED CONSTRUCTION, NOT THIS CONTRACT.
 - NEW ARTERIAL PAVING. SEE ARTERIAL PAVING DETAIL, SHEET 5.
 - REMOVE EXISTING FIRE HYDRANT & VALVE. INSTALL FIRE HYDRANT & VALVE AT STATION 3 + 72.83 CAP EXISTING TEE.
 - VALVE #41 NOT LOCATED IN FIELD BY SURVEY. VALVE MAY HAVE BEEN REMOVED UNDER SEPARATE CONTRACT. FOR INSTALLATION OF FIRE HYDRANT THE CONTRACTOR SHALL PERFORM THE FOLLOWING: REMOVE VALVE (IF APPLICABLE AND RETURN TO THE CITY OF ALBUQUERQUE), REMOVE CAP, INSTALL 10" X 6" REDUCER, INSTALL RELOCATED 6" GATE VALVE IN NEW TYPE "A" VALVE BOX, INSTALL APPROXIMATELY 9 L.F. OF 6" WATERLINE & INSTALL RELOCATED FIRE HYDRANT. FIRE HYDRANT SHALL BE INSTALLED IN ACCORDANCE WITH CITY OF ALBUQUERQUE STD. DWG. 2320 VALVE BOX SHALL BE INSTALLED IN ACCORDANCE WITH CITY OF ALBUQUERQUE STD. DWG. 2325 FIRE HYDRANT FLANGE ELEVATION 5404.66.
 - REMOVE EXISTING VALVE BOX. INSTALL NEW TYPE "A" VALVE BOX IN ACCORDANCE WITH CITY OF ALBUQUERQUE STANDARD DRAWING 2325 (TYPICAL OF 4).
 - ADJUST TELEPHONE RISER IN ACCORDANCE WITH TELEPHONE COMPANY STANDARDS.
 - ADJUST TELEPHONE MANHOLES IN ACCORDANCE WITH TELEPHONE COMPANY STANDARDS.
 - CONSTRUCT SIDEWALK TRANSITIONS IN ACCORDANCE WITH C.O.A. STD. DWG. 2432, SECTION A-A.

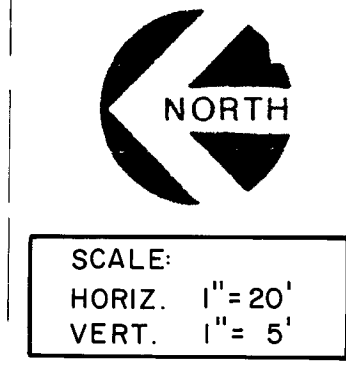

AS BUILT INFORMATION

DATE	BY	NO.

BENCH MARKS

SURVEY INFORMATION

DATE	BY	NO.

FIELD NOTES

ENGINEER'S SEAL

CLAYTON J. CHAVEL
REGISTERED PROFESSIONAL ENGINEER
STATE OF NEW MEXICO
9/1/89

REVISIONS

NO.	DATE	REMARKS

DESIGNED BY RGS
DRAWN BY AH, F, VRC
CHECKED BY KJC

DATE 3-89
DATE 3-89
DATE 3-89

CURB DATA:








R	La	D
1	2.0	4.03
2	30.0	39.87
3	5.0	9.07
4	20.0	25.45
5	11.5	21.50
6	6.0	9.46
6a	18.4	39.90
6b	18.4	11.10
7	9.0	28.17
8	24.0	37.84
9	4.5	14.14

CITY OF ALBUQUERQUE
PUBLIC WORKS DEPARTMENT
ENGINEERING GROUP

TITLE SAN ANTONIO CENTER
WYOMING DECELERATION LANE, DRIVEPADS & SIDEWALK

APPROVALS	ENGINEER	DATE	APPROVALS	ENGINEER	DATE
DRC Chair					
Trans Dev					
Utility Dev					

DRAWING NO. 3722
MAP NO. D-19 & E-19
SHEET 9 **OF** 12

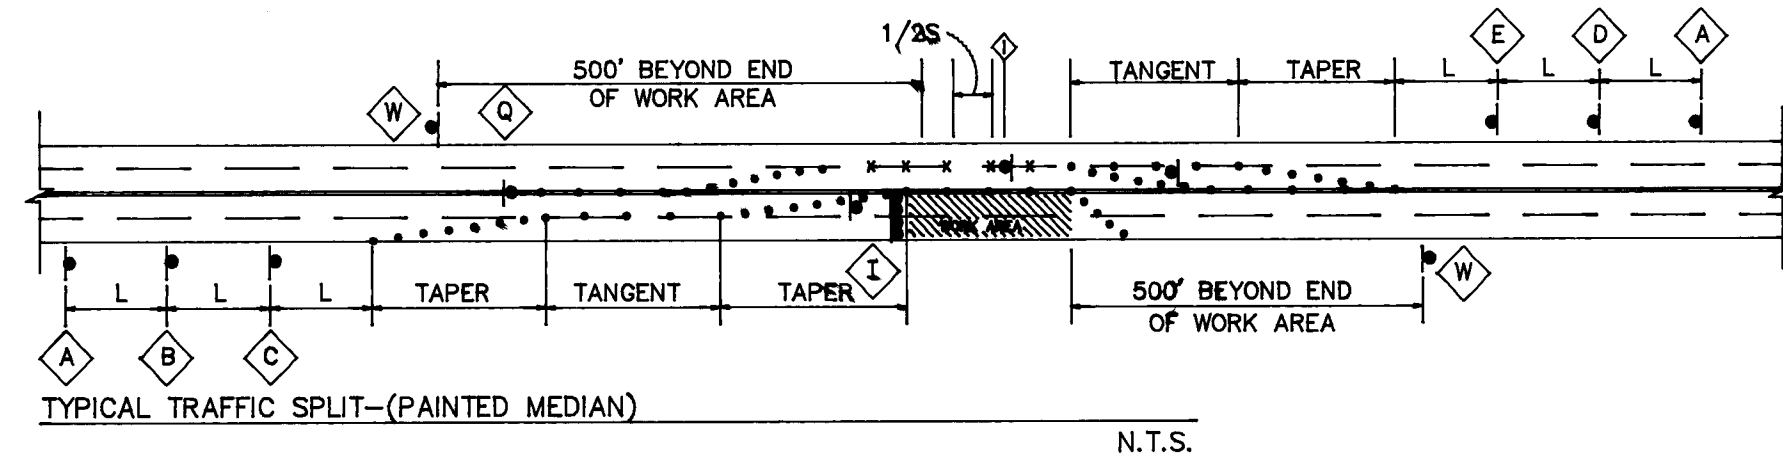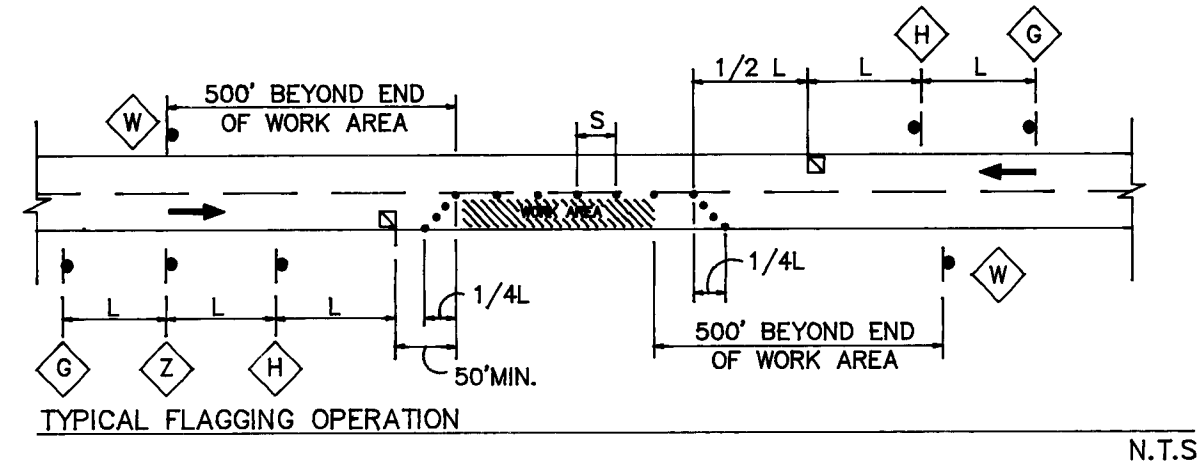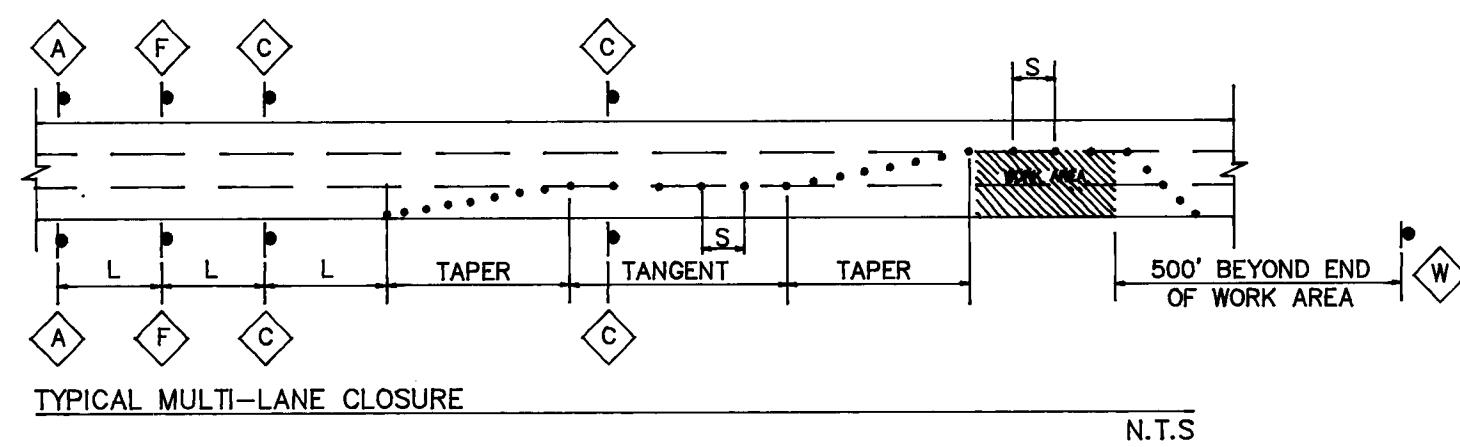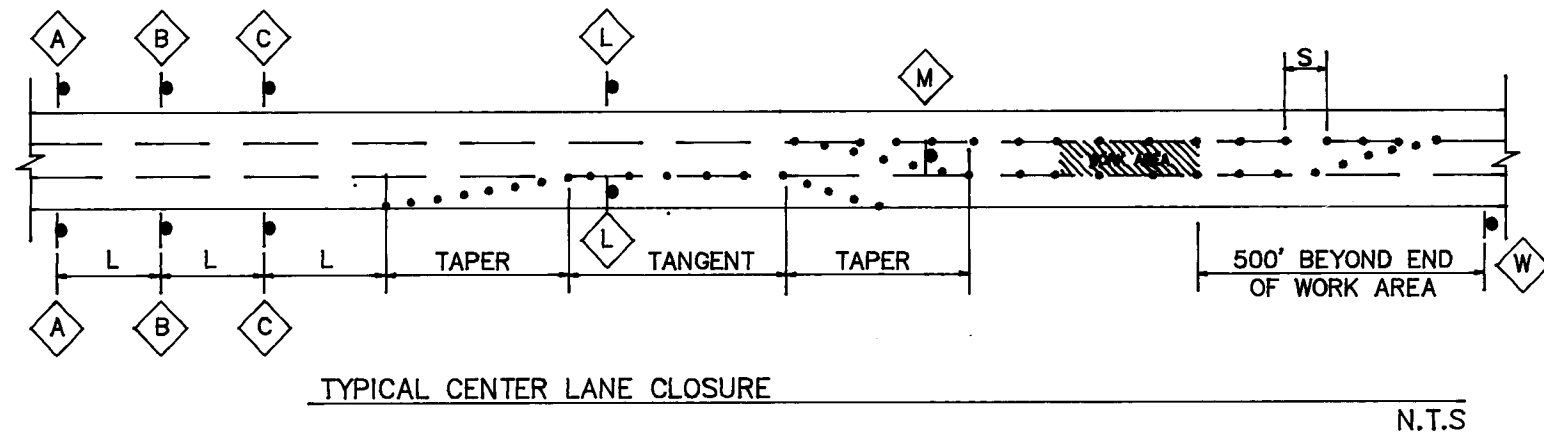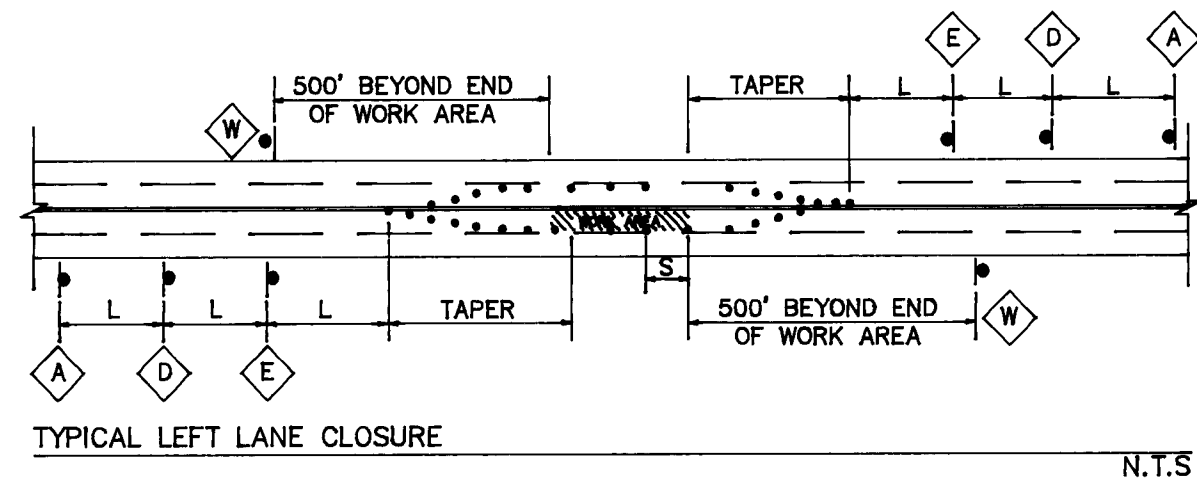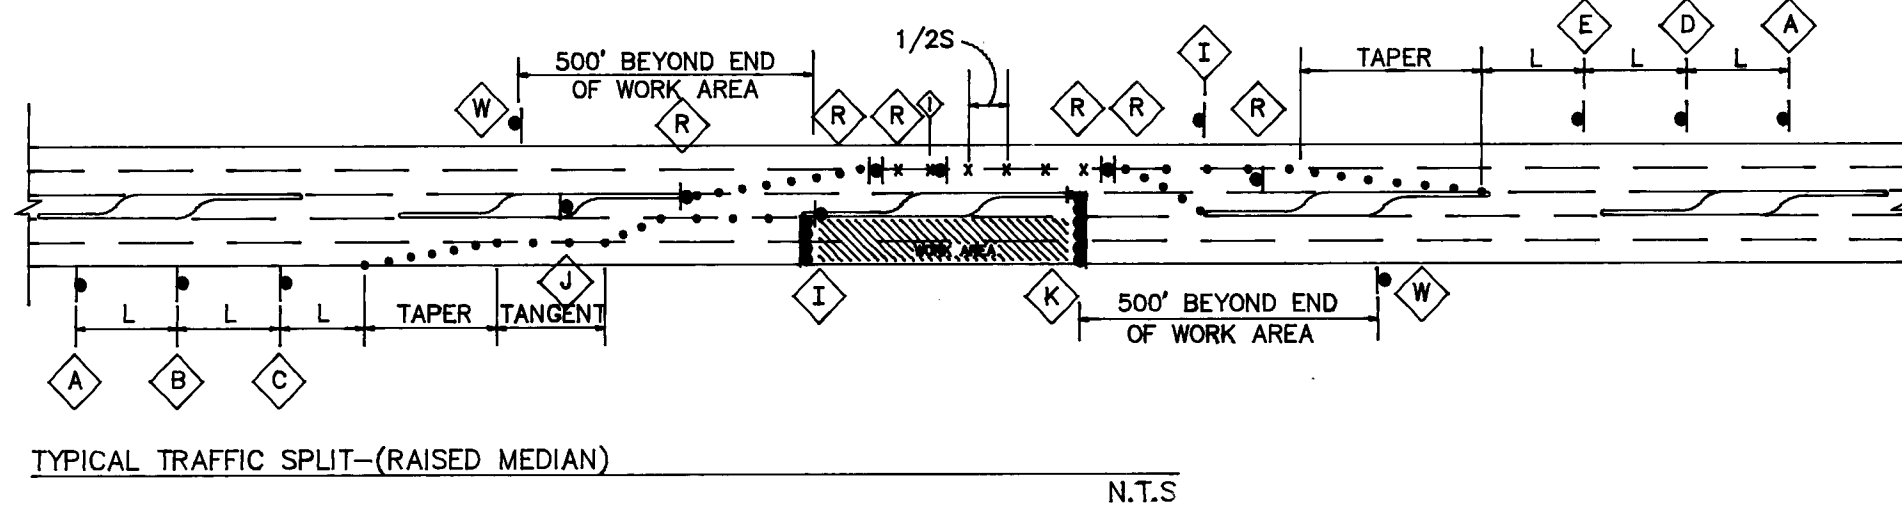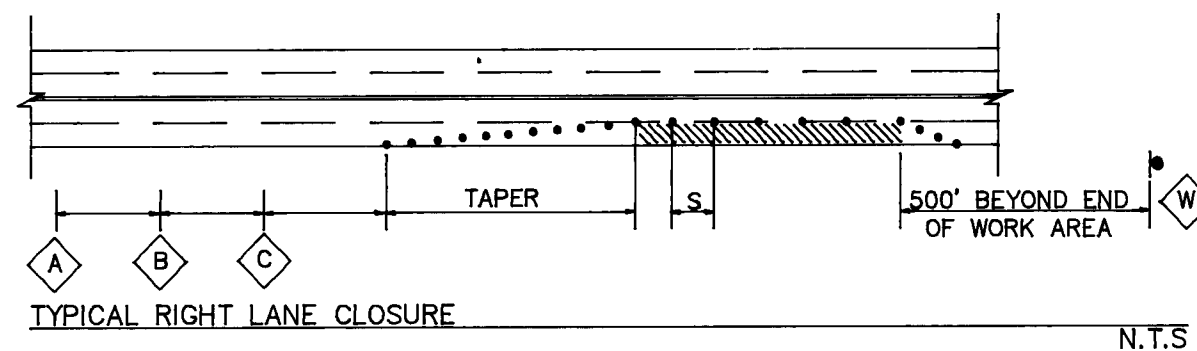

LEGEND



- WORK AREA
- TRAFFIC SIGN (SEE THIS SHEET FOR DESIGNATION)
 - BARRICADE - TYPE I, TYPE II, OR BARREL
 - BARRICADE - TYPE III
 - VERTICAL PANEL
 - WARNING SIGN
 - DISTANCE BETWEEN SIGNS - A DISTANCE MEASURED IN FEET EQUAL TO A VALUE OF TEN TIMES THE SPEED LIMIT OF THE STREET
 - FLAGMAN POSITION
 - SPACING BETWEEN BARRICADES - A DISTANCE MEASURED IN FEET EQUAL TO THE SPEED LIMIT OF THE STREET

TAPER LENGTH - SEE CHART AT LEFT

TANGENT LENGTH - IS EQUAL TO THE TAPER LENGTH FOR A GIVEN STREET

TAPER REQUIREMENTS

SPEED LIMIT (MPH)	TAPER LENGTH (FEET)			MAXIMUM DISTANCE BETWEEN DEVICES (FEET)	MINIMUM NUMBER OF DEVICES REQUIRED
	10' LANE	11' LANE	12' LANE		
25	104	115	125	25	6
30	150	165	185	30	7
35	204	225	245	35	8
40	267	293	320	40	9
45	450	495	540	45	13
50	500	550	600	50	13
55	550	605	660	55	13

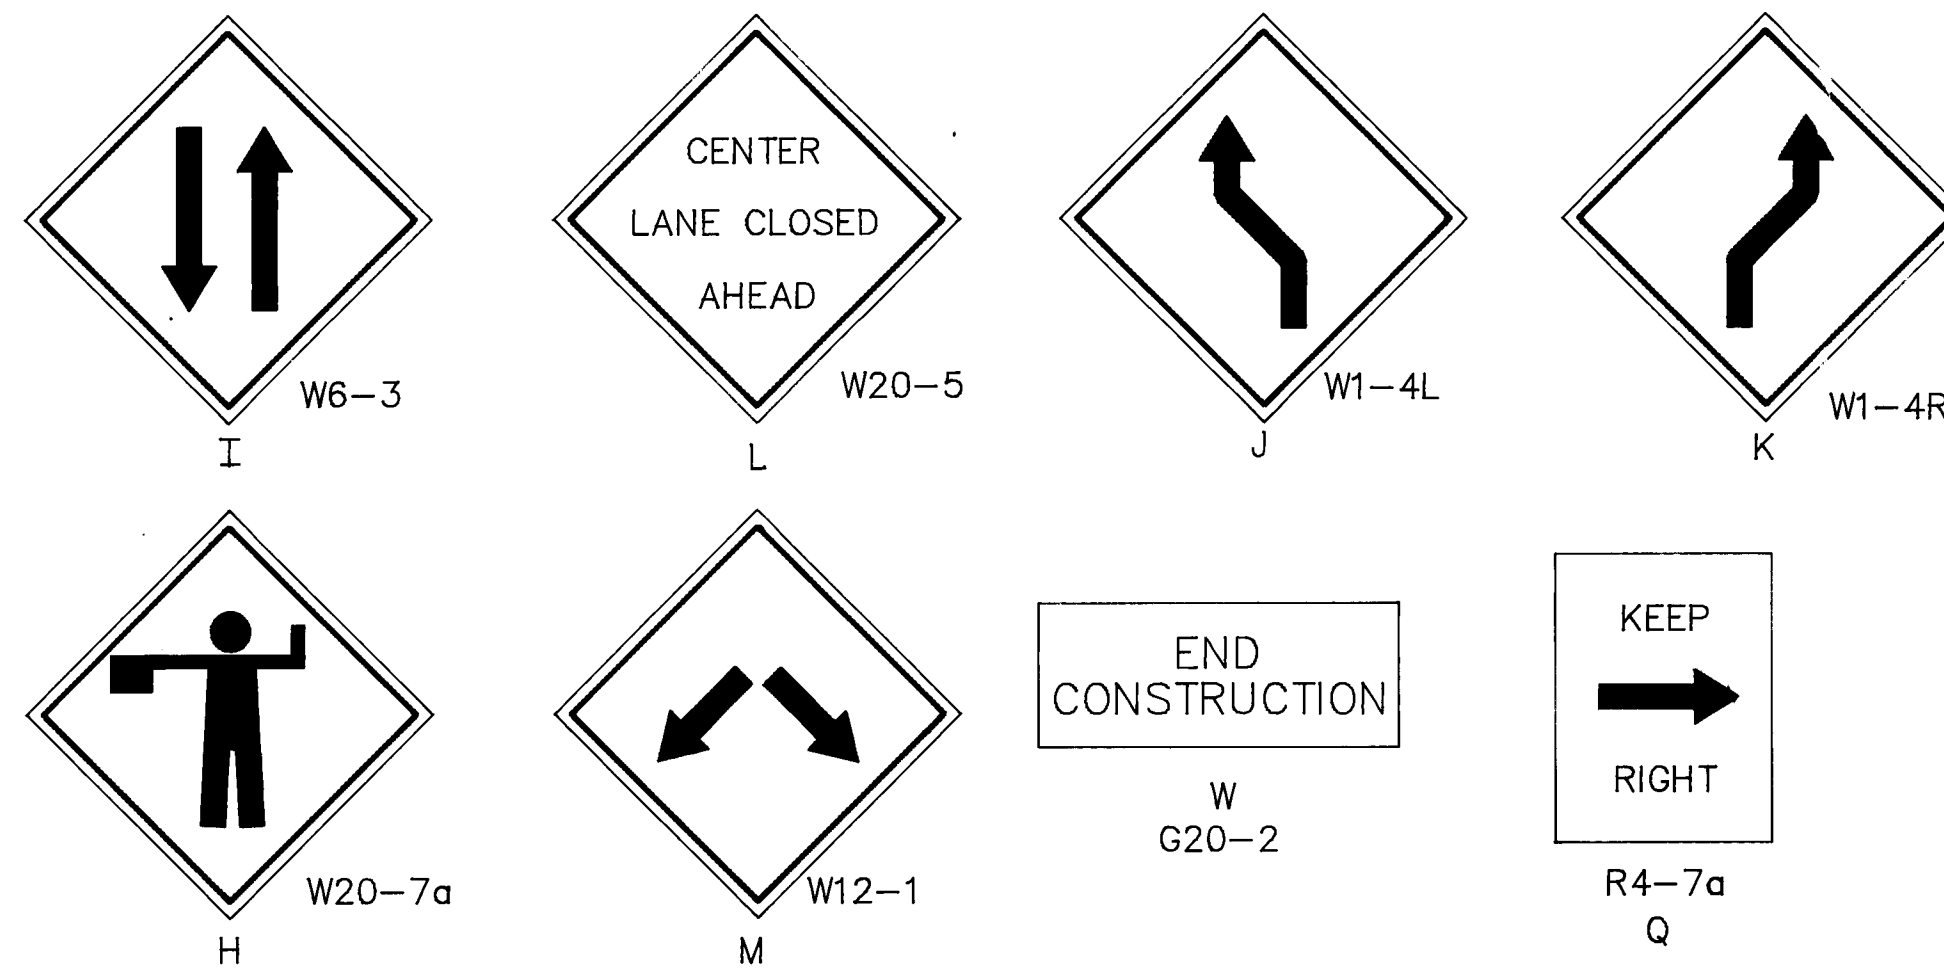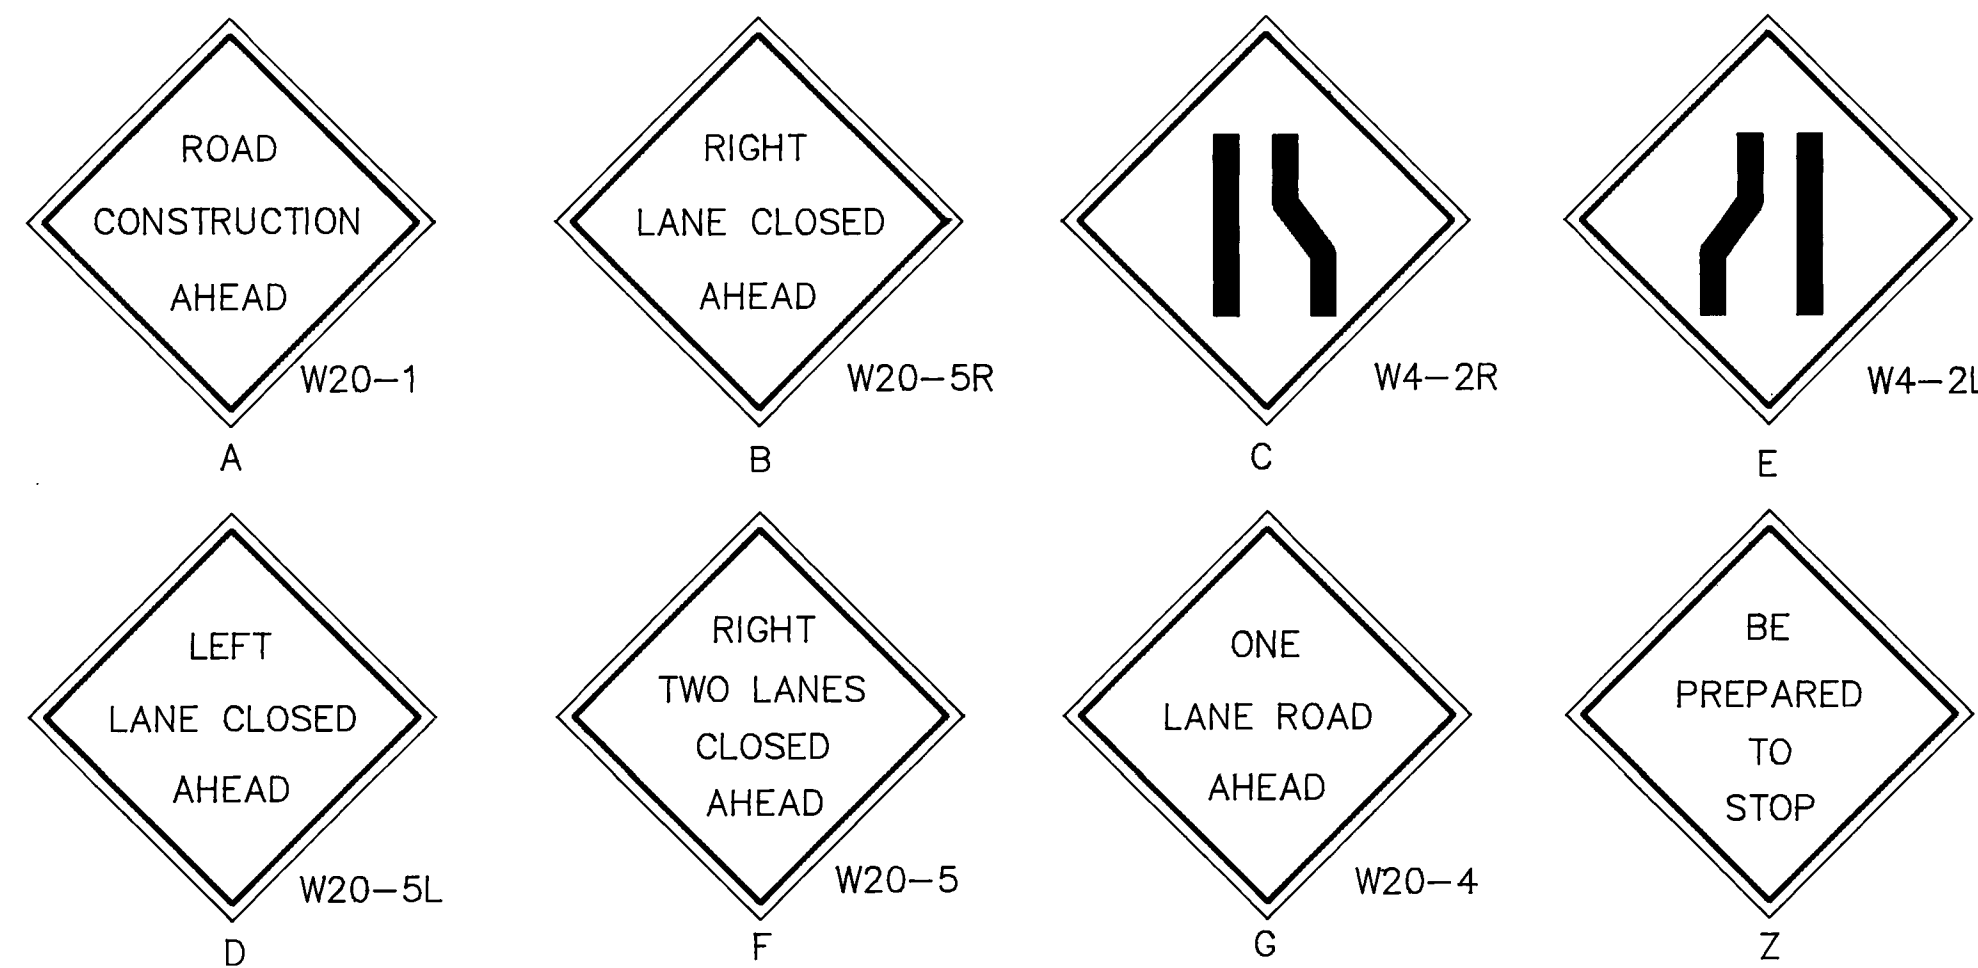

1	2	3	4	5	6	7	8	9	10	11	12
2	6	3	7	2	2	1	2	9	0		

AS BUILT INFORMATION		BENCH MARKS		SURVEY INFORMATION		ENGINEER'S SEAL	
CONTRACT NO.	DATE	DATE	DATE	NO.	BY	REMARKS	REVISIONS
JR HALE	1-90	1-90	1-90				
W. HALE	1-90	1-90	1-90				
INSPECTOR	DATE	DATE	DATE				
W. HALE	1-90	1-90	1-90				
VERIFICATION BY	DATE	DATE	DATE				
W. HALE	1-90	1-90	1-90				
CORRECTED BY	DATE	DATE	DATE				
W. HALE	1-90	1-90	1-90				
MICRO-FILM INFORMATION	DATE	DATE	DATE				
RECORDED BY	DATE	DATE	DATE				
NO.	DATE	DATE	DATE				

CITY OF ALBUQUERQUE PUBLIC WORKS DEPARTMENT ENGINEERING GROUP					
TITLE SAN ANTONIO CENTER BARRICADE PLAN					
APPROVALS	ENGINEER	DATE	APPROVALS	ENGINEER	DATE
City Engineer	R. J. HALE	5/15/89	Liquid Waste	PEBO	5/15/89
A.C.E.-Design			Traffic	R. J. HALE	5/15/89
A.C.E.-Hydrology			Water	PEBO	5/15/89
DRAWING NO.	3722	MAP NO.	SHEET	12	OF 12