


PROFILE	SUNNYED		N	DATE
	PLOTTED			
	GRADES CHECKED			
	B.M.'S NOTED			
	STRUCTURE NOTATIONS CPMO			

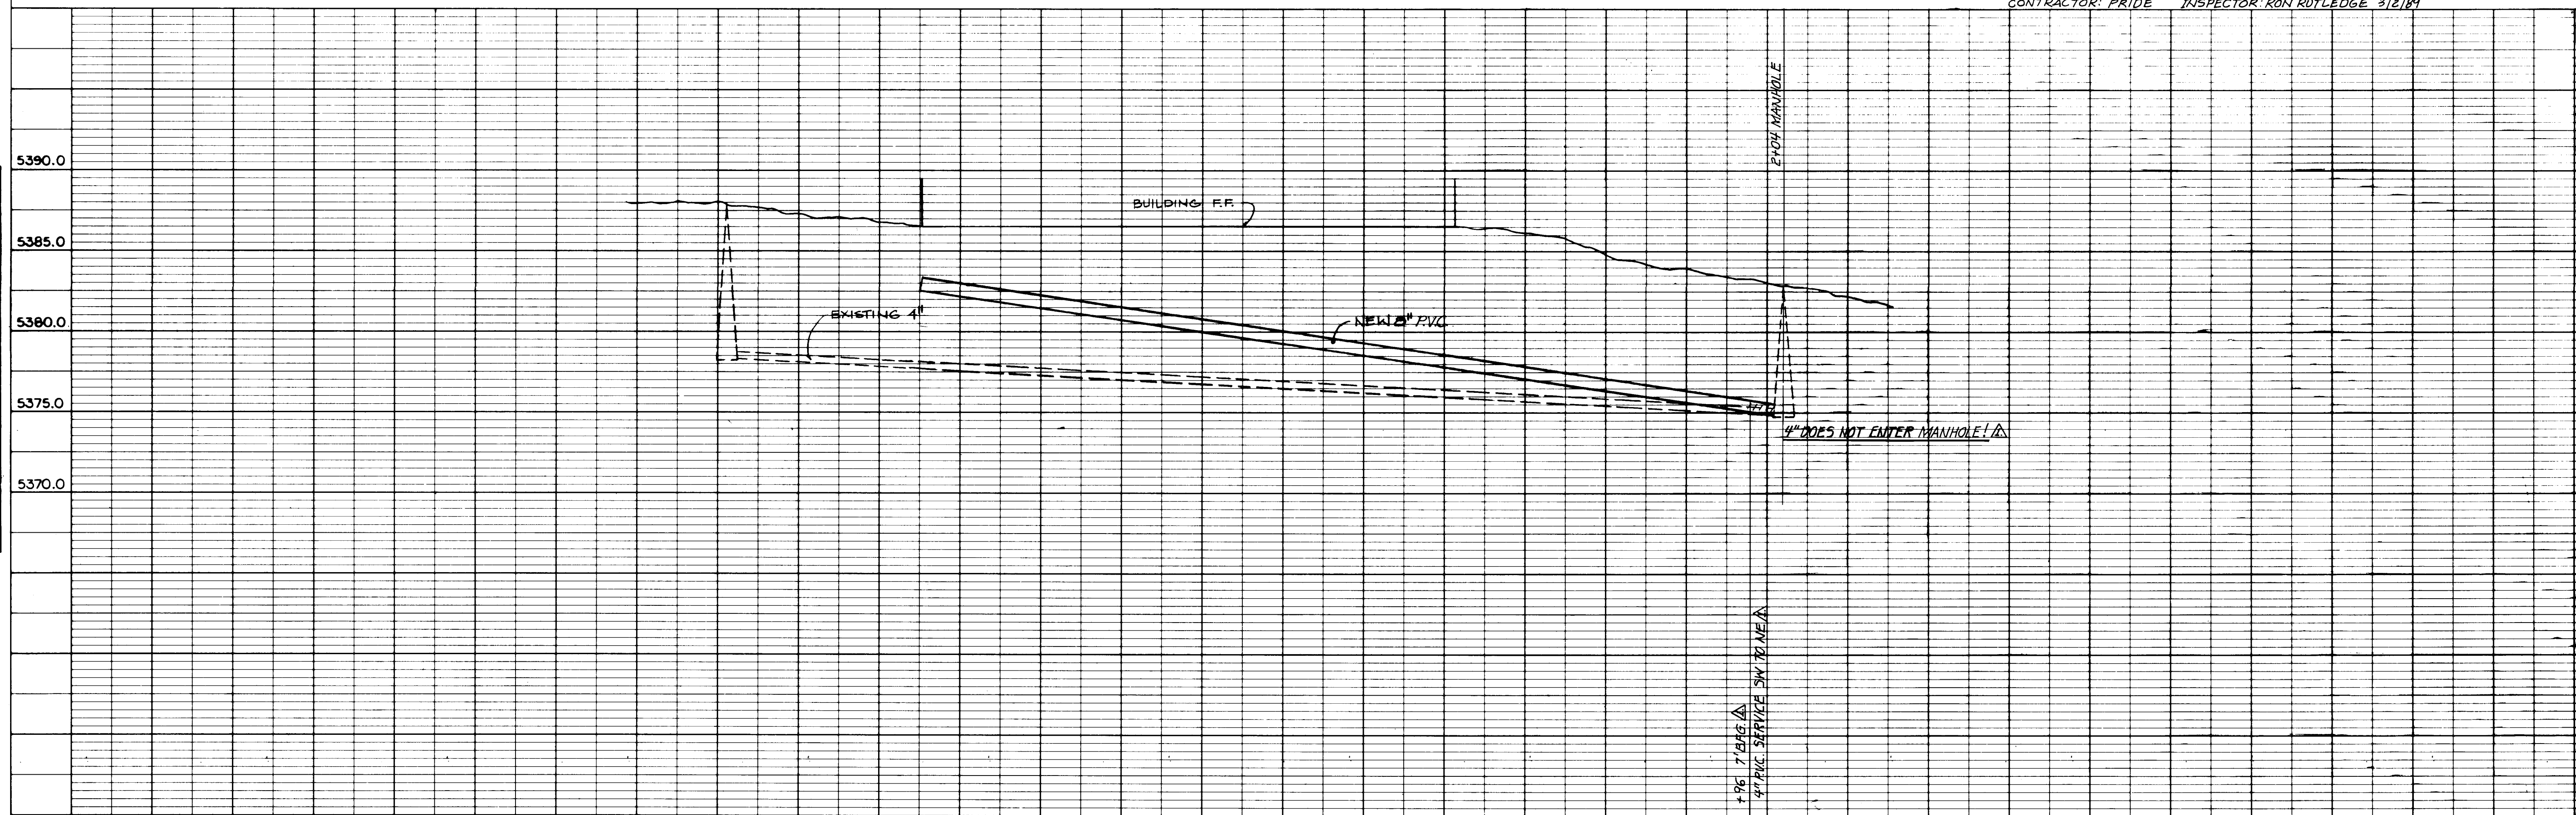

PROJECT: 3737

U1
3-21-88
REVISION
8-25-88

GREGORY T. HICKS & ASSOC., P.C.
The Sunshine Building
112 Second St. S.W.
Albuquerque, New Mexico 87102
(505) 243-7492