



Alley B/L3 San Mateo Blvd  
NE & Madera Dr Homestead  
to City Proj. # 2067  
3774

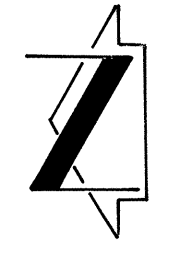

**LEGEND**

	EXISTING SPOT ELEVATION
	PROPOSED SPOT ELEVATION
	EXISTING CONTOUR
	PROPOSED CONCRETE
	PROPOSED ASPHALT

CURVE	ARC	DELTA	RADIUS
1	40.84'	18°30'19"	125.00'
2	24.68'	12°51'23"	110.00'
3	39.65'	20°39'01"	110.00'
4	46.68'	20°34'19"	130.00'
5	43.09'	20°34'19"	120.00'
6	43.25'	20°39'01"	120.00'
7	26.92'	12°51'23"	120.00'

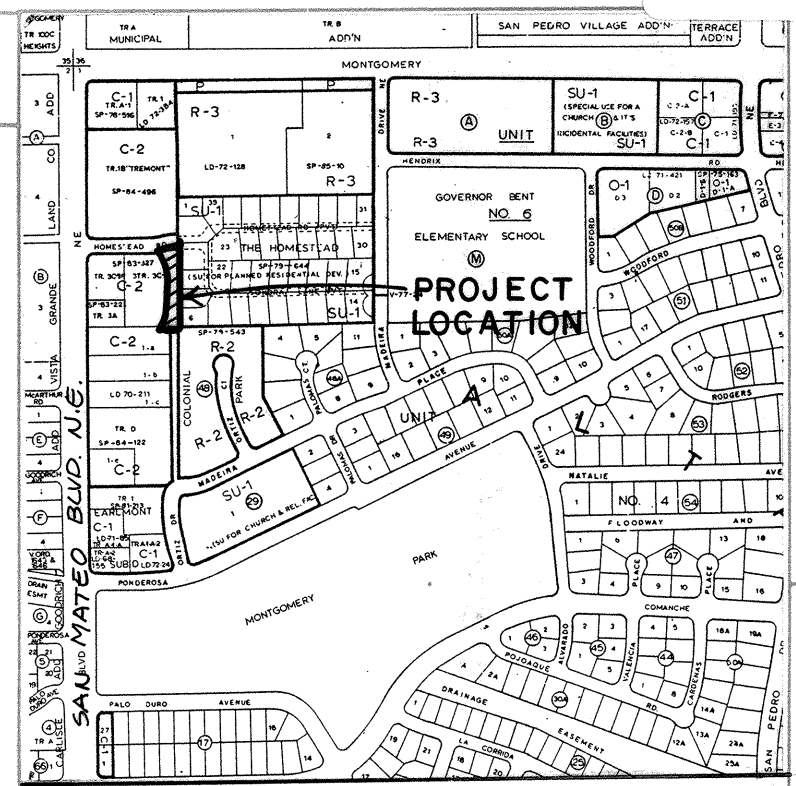

**VICINITY MAP**  
SCALE: 1" = 800'

- GENERAL NOTES:**
- ALL WORK DETAILLED ON THESE PLANS TO BE PERFORMED UNDER CONTRACT SHALL EXCEPT AS OTHERWISE STATED OR PROVIDED FOR HEREON, BE CONSTRUCTED IN ACCORDANCE WITH THE CITY OF ALBUQUERQUE STANDARD SPECIFICATIONS - PUBLIC WORKS CONSTRUCTION - 1986.
  - TWO (2) WORKING DAYS PRIOR TO ANY EXCAVATION, CONTRACTOR MUST CONTACT LINE LOCATING SERVICE, 765-1234, FOR LOCATING OF EXISTING UTILITIES.
  - IF ANY UTILITY LINES, PIPELINES, OR UNDERGROUND UTILITY LINES ARE SHOWN ON THESE DRAWINGS, THEY ARE SHOWN IN AN APPROXIMATE MANNER ONLY, AND SUCH LINES MAY EXIST WHERE NONE ARE SHOWN. IF ANY SUCH EXISTING LINES ARE SHOWN, THE LOCATION IS BASED UPON INFORMATION PROVIDED BY THE OWNER OF SAID UTILITY, AND THE INFORMATION MAY BE INCOMPLETE, OR MAY BE OBSOLETE BY THE TIME CONSTRUCTION COMMENCES. THE ENGINEER HAS UNDERTAKEN NO FIELD VERIFICATION OF THE LOCATION, DEPTH, SIZE, OR TYPE OF EXISTING UTILITY LINES, PIPELINES, OR UNDERGROUND UTILITY LINES, HEREON, AND ASSUMES NO RESPONSIBILITY OR LIABILITY THEREFOR. THE CONTRACTOR SHALL INFORM ITSELF OF THE LOCATION OF ANY UTILITY LINE, PIPELINE, OR UNDERGROUND UTILITY LINE IN OR NEAR THE AREA OF THE WORK IN ADVANCE OF AND DURING EXCAVATION WORK. THE CONTRACTOR IS FULLY RESPONSIBLE FOR ANY AND ALL DAMAGE CAUSED BY ITS FAILURE TO LOCATE, IDENTIFY AND PRESERVE ANY AND ALL EXISTING UTILITIES, PIPELINES, AND UNDERGROUND UTILITY LINES. IN PLANNING AND CONDUCTING EXCAVATION, THE CONTRACTOR SHALL COMPLY WITH STATE STATUTES, MUNICIPAL AND LOCAL ORDINANCES, RULES AND REGULATIONS, IF ANY, PERTAINING TO THE LOCATION OF THESE LINES AND FACILITIES.
  - SHOULD A CONFLICT EXIST BETWEEN THESE PLANS AND ACTUAL FIELD CONDITIONS, THE CONTRACTOR SHALL PROMPTLY NOTIFY THE ENGINEER IN WRITING SO THAT THE CONFLICT CAN BE RESOLVED WITH A MINIMUM AMOUNT OF DELAY FOR ALL PARTIES.
  - THE CONTRACTOR SHALL MAINTAIN ACCESS TO ADJACENT PROPERTIES DURING CONSTRUCTION.
  - ALL WORK ON THIS PROJECT SHALL BE PERFORMED IN ACCORDANCE WITH APPLICABLE FEDERAL, STATE AND LOCAL LAWS, RULES AND REGULATIONS CONCERNING SAFETY AND HEALTH.
  - THE CONTRACTOR MUST SUBMIT A CONSTRUCTION SCHEDULING AND BARRICADING PLAN TO TRAFFIC ENGINEERING TO RECEIVE A BARRICADING PERMIT 48 HOURS PRIOR TO CONSTRUCTION.
  - TACK COAT REQUIREMENTS SHALL BE DETERMINED BY THE CITY ENGINEER.
  - IF CURB IS DEEPENED FOR A DRIVEPAD OR A HANDICAP RAMP, THE DRIVEPAD OR RAMP SHALL BE CONSTRUCTED PRIOR TO ACCEPTANCE OF THE CURB AND GUTTER.
  - CONTRACTOR SHALL PAVE AROUND ALL EXISTING TELEPHONE AND POWER POLES, ONE-HALF INCH EXPANSION JOINTS SHALL BE PROVIDED WHERE PAVING IS CONCRETE.
  - WHERE ALLEY ABUTS PROPOSED ASPHALT PAVING AND NATURAL DIRT, DEEPENED MOUNTABLE CURB AND GUTTER ROLL TYPE WILL BE REQUIRED. THE DEEPENED MOUNTABLE CURB AND GUTTER ROLL TYPE SHALL BE CONSTRUCTED PER STANDARD DRAWING 2415.
  - BACKFILL COMPACTION SHALL BE ACCORDING TO SPECIFIED STREET USE.
  - SUBGRADE PREPARATION IS INCIDENTAL TO "GRADING", THEREFORE NO SEPARATE PAYMENT WILL BE MADE. THIS IS IN ACCORDANCE WITH SECTION 301 OF THE STANDARD SPECIFICATIONS.
  - WHERE WATER METER BOXES ARE ENCOUNTERED WITHIN THE PROPOSED PAVING, THE METER BOX SHALL BE ADJUSTED TO GRADE AND THE COVER REPLACED WITH THE HEAVYWEIGHT COVER AND LID AS PER STANDARD DRAWING 2369.

<b>AS BUILT INFORMATION</b>		<b>CONTRACTOR</b>		<b>DATE</b>	
THE STATION IS A STANDARD ACS BRASS TABLET CONSTRUCTION		G. MARTIN CONSTRUCTION		9/15/89	
<b>MARKS</b>		<b>INSPECTOR</b>		<b>DATE</b>	
CURB THE STATION IS LOCATED 5.1 MILES NORTHEAST OF DOWNTOWN ALBUQUERQUE, AT THE INTERSECTION OF MONTGOMERY BLVD. N.E. AND SAN MATEO BLVD. N.E.		Eddie B. [Signature]		9/15/89	
<b>FIELD NOTES</b>		<b>REVISIONS</b>		<b>DESIGN</b>	
NO. BY DATE		NO. DATE		DATE	
		1		04/89	
		2		04/89	
		3		05/89	
		4		05/89	
		297		05	



