



120276

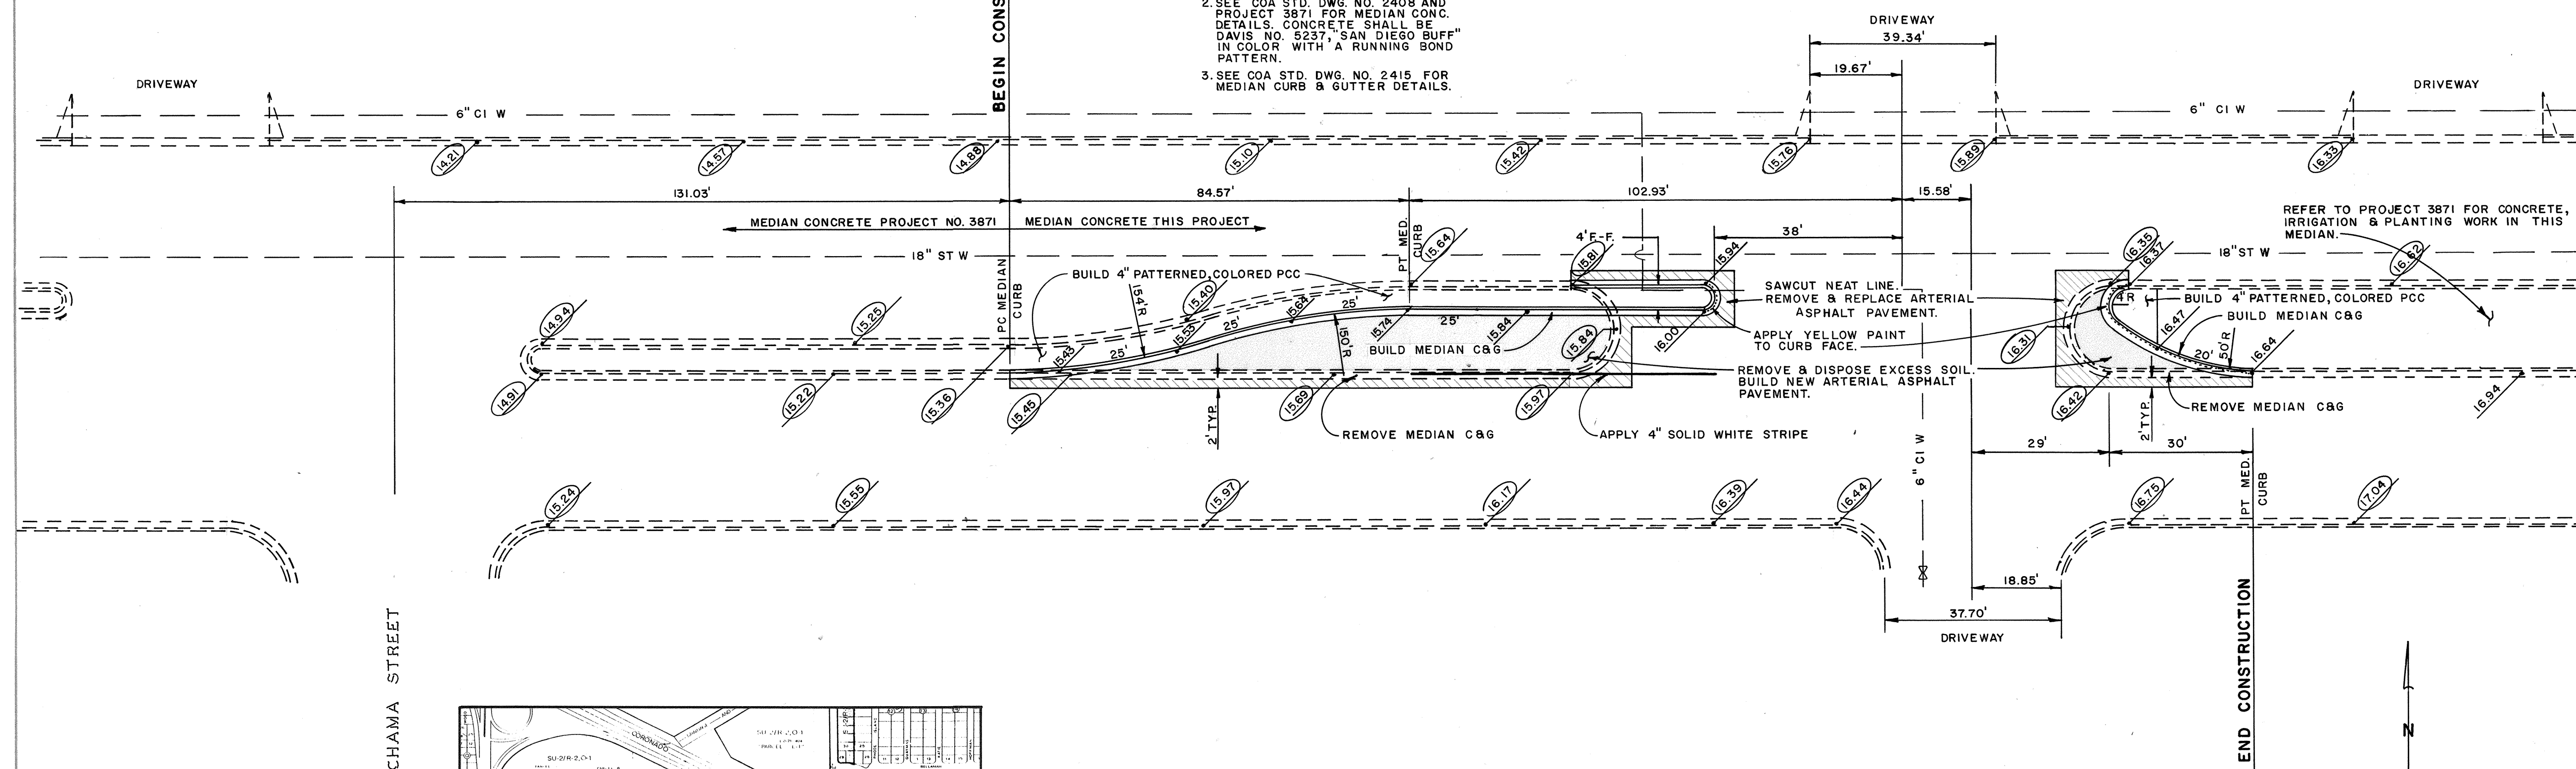


LOMAS BLVD.

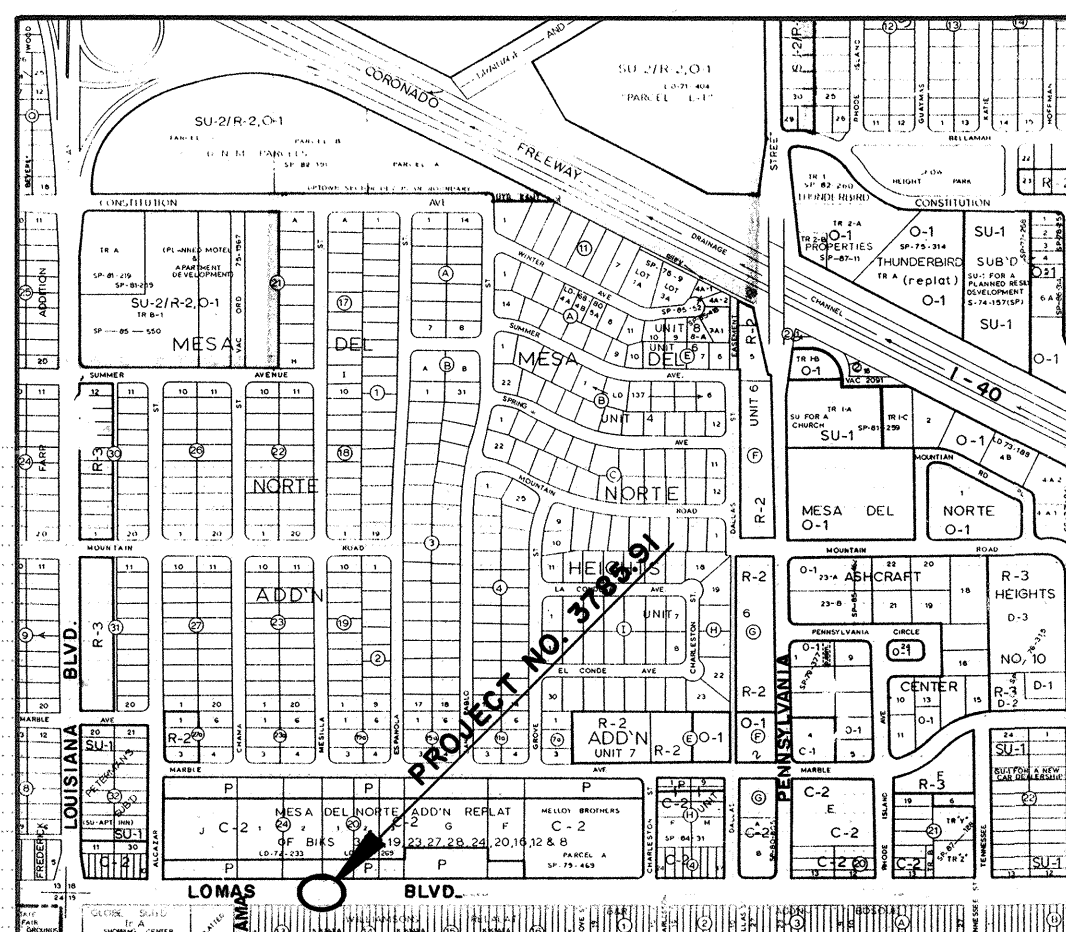

VICINITY MAP

J-19

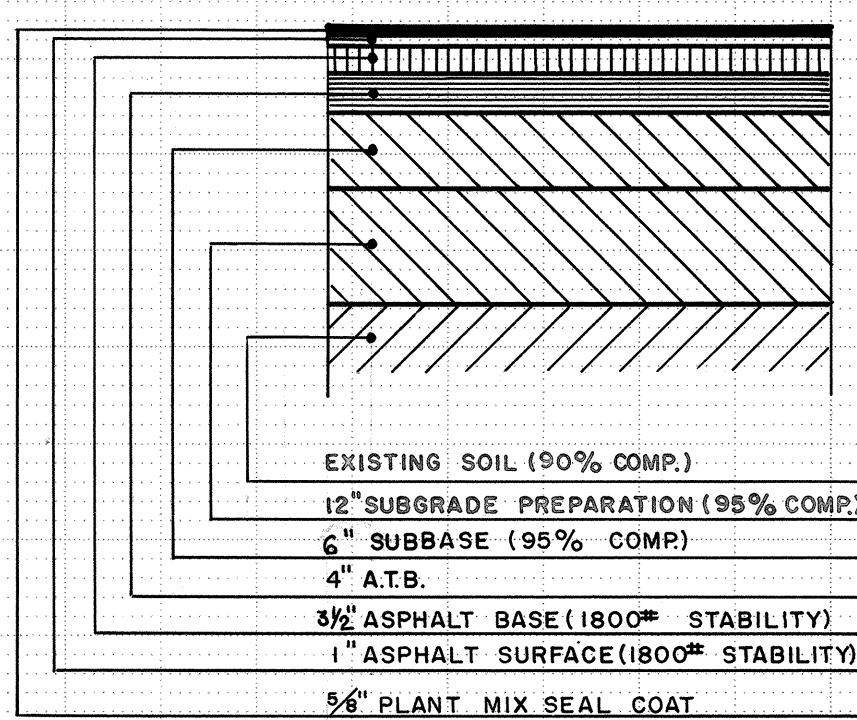

ARTERIAL ASPHALT PAVEMENT

- NOTES
1. SEE COA STD. DWG. NO. 2502 FOR MEDIAN OPENING PLACEMENT AND CONSTRUCTION DIMENSIONS.
 2. SEE COA STD. DWG. NO. 2408 AND PROJECT 3871 FOR MEDIAN CONC. DETAILS. CONCRETE SHALL BE DAVIS NO. 5237, "SAN DIEGO BUFF" IN COLOR WITH A RUNNING BOND PATTERN.
 3. SEE COA STD. DWG. NO. 2415 FOR MEDIAN CURB & GUTTER DETAILS.
 4. HEAVY VIBRATORY COMPACTION CAPABLE OF DAMAGING UNDERGROUND UTILITIES SHALL NOT BE USED ON THIS PROJECT.

NOTE: ALL ELEVATIONS SHOWN ARE AT FLOWLINE OF CURB.
XXX EXISTING ELEVATION
XXX PROPOSED ELEVATION
HORIZONTAL SCALE 1" = 20'

GENERAL NOTES

1. All work detailed on this plan is to be performed, unless otherwise stated or provided for, in accordance with the "City of Albuquerque Standard Specifications for Public Works Construction, 1986".
2. References to Standard Drawings refer to "City of Albuquerque Standard Detail Drawings, 1986".
3. Two working days prior to and excavation, Contractor shall contact New Mexico One Call System, 260-1990, for location of existing lines.
4. Three working days prior to start of construction the Contractor shall submit to the Construction Coordination Division a detailed construction schedule. Two working days prior to construction the Contractor shall obtain a Barricading Permit from the Construction Coordinating Division. Contractor shall notify the Barricade Engineer, 768-2551, prior to occupying an intersection. See Section 19.
5. All street striping altered or destroyed shall be replaced in kind by the Contractor to location and in kind as existing or as indicated by this plan set.
6. Prior to construction, the Contractor shall excavate and verify the vertical and horizontal locations of all obstructions. Should a conflict exist, the Contractor shall notify the Engineer or Surveyor so that the conflict can be resolved with a minimum amount of delay.

AS BUILT INFORMATION		BENCH MARKS		SURVEY INFORMATION		ENGINEER'S SEAL	
CONTRACTOR	DATE	ACR	DATE	NO.	DATE	APPROVED FOR PROFESSIONAL ENGINEERING	
JR HALE	ELEV. 5312.23	ACR 15-K18"	2/26/91	—	2/26/91	[Professional Engineer Seal]	
STAKED BY	DATE	BRASS CAP IN TOP OF CURB AT SE CORNER OF LOMAS BLVD. & LOUISIANA BLVD.	DATE	NO.	DATE	[Professional Engineer Seal]	
INSPECTOR'S	DATE					[Professional Engineer Seal]	
FIELD	DATE					[Professional Engineer Seal]	
VERIFICATION BY	DATE					[Professional Engineer Seal]	
CORRECTED BY	DATE					[Professional Engineer Seal]	
RECORDED BY	DATE					[Professional Engineer Seal]	

APPROVAL OF AS BUILT DRAWINGS
CHIEF CONSTRUCTION ENGINEER
DATE 11/25/91

APPROVED FOR
CITY ENGINEER
4-15-91

CITY OF ALBUQUERQUE
PUBLIC WORKS DEPARTMENT
ENGINEERING GROUP

TITLE: **MEDIAN OPENING REVISION
LOMAS BLVD.**

APPROVALS	ENGINEER	DATE	APPROVALS	ENGINEER	DATE
DRC CHAIRPERSON	Rogel	4-12-91	WASTEWATER	AROMA	4-5-91
TRANSPORTATION	Rogel	4-12-91			
HYDROLOGY	Rogel	4-12-91			
WATER	AROMA	4-5-91			

DRAWING NO. 3785.91 MAP NO. J-19 SHEET 1 OF 1