


FHP MEDICAL OFFICES

(TRACTS A-1 & A-2, MONTGOMERY CROSSING, PHASE III)
CITY OF ALBUQUERQUE, BERNALILLO COUNTY, NEW MEXICO

IMPROVEMENTS FOR PUBLIC WATER SYSTEM
AND OFFSITE DRAINAGE AND PAVING

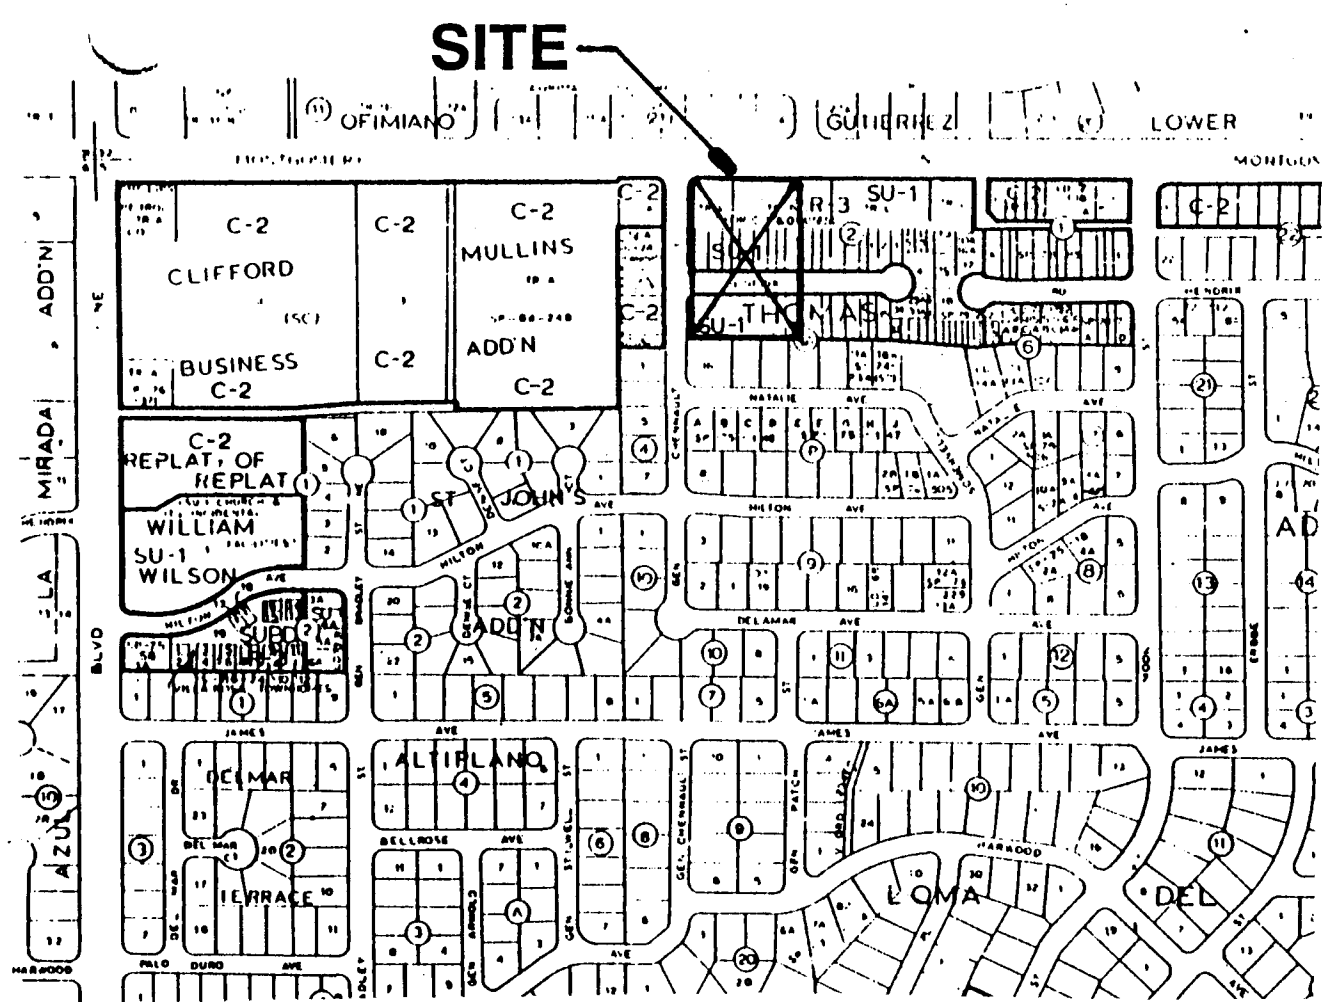


VICINITY MAP - G-20

NO SCALE

INDEX TO DRAWINGS

SHEET NO.		DESCRIPTION
1 of 8	GC.1	CITY WORK ORDER COVER SHEET
2 of 8	GC.2	PLAT OF GEOMETRY
3 of 8	C2.1	GRADING & PAVING PLAN
4 of 8	C2.2	MEDIAN & DRIVEWAY CONSTRUCTION
5 of 8	C3.2	PUBLIC WATERLINE CONSTRUCTION
6 of 8	C3.3	OFFSITE DRAINAGE IMPROVEMENTS
7 of 8	C3.4	OFFSITE PAVING & DRAINAGE CHANNEL
8 of 8	C3.5	DRAINAGE POND DETAILS

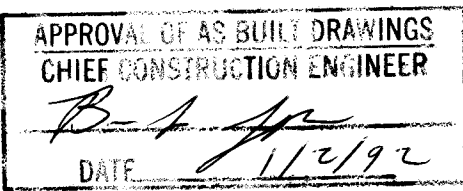

26 3803.910192

REV	SHEETS	CITY ENGR.	DATE	USER DEPT.	DATE	USER DEPT.	DATE
APPROVAL OF REVISIONS							

APPROVED FOR
CONSTRUCTION
[Signature]
1-26-91 C.E.

BPLW

Architects & Engineers, Inc.

2400 Louisiana Blvd. NE
AFC #5 Suite 400
Albuquerque, New Mexico 87110
(505) 851-2759




63 East Main Street
Suite 602
Mesa, Arizona 85201
(602) 827-2759

Designing to Shape the Future

GENERAL NOTES:

- ALL WORK DETAILED ON SHEETS C2.2, C3.2, C3.3 AND C3.4 SHALL BE CONSTRUCTED IN ACCORDANCE WITH THE CITY OF ALBUQUERQUE STANDARD SPECIFICATIONS FOR PUBLIC WORKS CONSTRUCTION, 1986 EXCEPT AS OTHERWISE STATED OR PROVIDED FOR HEREIN.
- TWO (2) WORKING DAYS PRIOR TO ANY EXCAVATION, CONTRACTOR MUST CONTACT THE LINE LOCATING SERVICE AT 260-1990 FOR LOCATION AND BLUESTAKING OF EXISTING UTILITIES.
- CONTRACTOR SHALL NOTIFY THE ENGINEER NOT LESS THAN SEVEN (7) DAYS PRIOR TO STARTING WORK IN ORDER THAT THE ENGINEER MAY TAKE NECESSARY MEASURES TO INSURE THE PRESERVATION OF SURVEY MONUMENTS. CONTRACTOR SHALL NOT DISTURB PERMANENT SURVEY MONUMENTS WITHOUT THE CONSENT OF THE ENGINEER AND SHALL NOTIFY THE ENGINEER AND BEAR THE EXPENSE OF REPLACING ANY THAT MAY BE DISTURBED WITHOUT PERMISSION. REPLACEMENT SHALL BE DONE ONLY BY THE ENGINEER. WHEN A CHANGE IS MADE IN THE FINISHED ELEVATION OF THE PAVEMENT OF ANY ROADWAY IN WHICH A PERMANENT SURVEY MONUMENT IS LOCATED, CONTRACTOR SHALL, AT HIS OWN EXPENSE, ADJUST THE MONUMENT COVER TO THE NEW GRADE UNLESS OTHERWISE SPECIFIED. REFER TO SECTION 4.4 OF THE CITY STANDARD SPECIFICATIONS.
- CONTRACTOR SHALL OBTAIN TRAFFIC BARRICADING PERMITS IN ACCORDANCE WITH THE PROVISIONS OF SECTION 19.1.3 OF THE CITY STANDARD SPECIFICATIONS AT LEAST 2 DAYS IN ADVANCE OF ANY WORK IN PUBLIC TRAFFIC LANES.

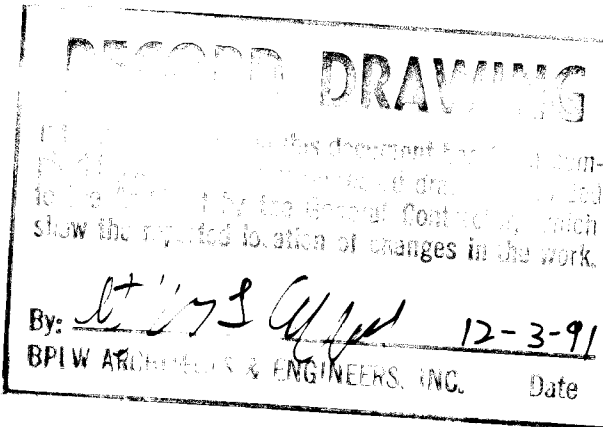

REV.	DESCRIPTION	DATE



ENGINEER 4-1-91

ARCHITECT

FHP MEDICAL OFFICES

MONTGOMERY & GENERAL CHENAULT

ALBUQUERQUE, NEW MEXICO

PROJECT NO. 91001

DATE

CITY: 3803.91

04-01-91


CITY WORK ORDER COVER SHEET

DRAWING NO.

GC.1
SHEET 1 OF 8


BPLW

Designing to Shape the Future

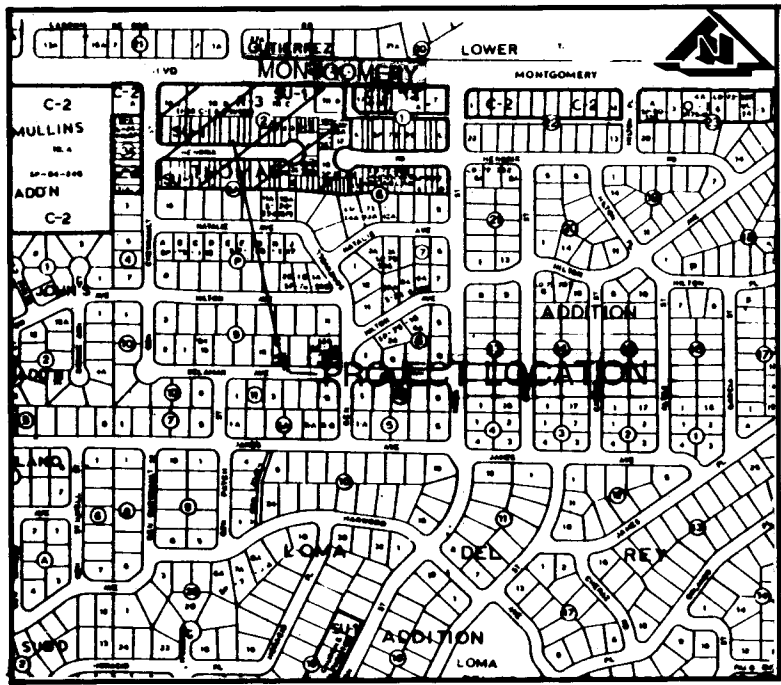

VICINITY MAP G-20
SCALE 1"=800'

TALOS NO. 90091814550243

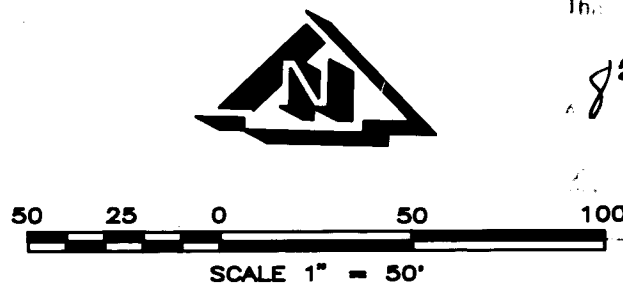

91 1066

PLAT OF
TRACTS A-1 AND A-2
MONTGOMERY CROSSING ADDITION
PHASE III
ALBUQUERQUE, NEW MEXICO
OCTOBER 1990
SP-91-7
4-90-69
DRB-90-392

- NOTES
1. A FIELD SURVEY WAS PERFORMED. ALL CORNERS WERE FOUND OR SET AS SHOWN.
 2. NO STREET MILEAGE WAS CREATED.
 3. ALL DISTANCES ARE GROUND DISTANCES.
 4. THE SITE IS LOCATED WITHIN SECTION 16, T10N, R4E, NMPM.
 5. BEARING BASE IS THE PLAT OF RECORD FILED 1/19/88 C35-52, BEARINGS ARE GRID BEARINGS.
 6. THE PURPOSE OF THE PLAT IS TO CREATE TWO TRACTS FROM A SINGLE TRACT, AND TO VACATE A WATERLINE EASEMENT AND VARIOUS PUBLIC UTILITY EASEMENTS ALL NOTED AS V-90-69.
 7. RECIPROCAL ACCESS AND PARKING EASEMENTS AS SHOWN ON THE APPROVED SITE PLAN, Z-87-B, ARE GRANTED BY THIS PLAT, TRACTS A-1 AND A-2 SHALL SHARE EQUALLY IN THE MAINTENANCE OF THE ACCESS EASEMENTS.
 8. PRIOR TO DEVELOPMENT OF THE ALBUQUERQUE WATER AND SANITARY SEWER SERVICE TO TRACT A-2 MUST BE VERIFIED AND COORDINATED WITH THE PUBLIC WORKS DEPARTMENT, CITY OF ALBUQUERQUE, VIA A REQUEST FOR A WATER AND SANITARY SEWER AVAILABILITY STATEMENT.

PUBLIC UTILITY EASEMENTS

PUBLIC UTILITY EASEMENTS SHOWN ON THIS PLAT ARE GRANTED FOR THE COMMON AND JOINT USE OF:

1. THE PUBLIC SERVICE COMPANY OF NEW MEXICO FOR THE INSTALLATION, MAINTENANCE AND SERVICE OF OVERHEAD AND UNDERGROUND ELECTRICAL LINES, TRANSFORMERS, POLES AND ANY OTHER EQUIPMENT, FIXTURES, STRUCTURES AND RELATED FACILITIES REASONABLY NECESSARY TO PROVIDE ELECTRICAL SERVICE.
2. N/A
3. US WEST FOR THE INSTALLATION, MAINTENANCE AND SERVICE OF ALL BURIED AND AERIAL COMMUNICATION LINES AND OTHER RELATED EQUIPMENT AND FACILITIES REASONABLY NECESSARY TO PROVIDE COMMUNICATION SERVICES, INCLUDING BUT NOT LIMITED TO ABOVE GROUND PEDESTALS AND CLOSURES.
4. JONES INTERCABLE FOR THE INSTALLATION, MAINTENANCE AND SERVICE OF SUCH LINES, CABLE AND OTHER RELATED EQUIPMENT AND FACILITIES REASONABLY NECESSARY TO PROVIDE CABLE TV SERVICE.

INCLUDED, IS THE RIGHT TO BUILD, REBUILD, CONSTRUCT, RECONSTRUCT, LOCATE, RELOCATE, CHANGE, REMOVE, RENEW, OPERATE AND MAINTAIN FACILITIES FOR THE PURPOSES DESCRIBED ABOVE, TOGETHER WITH FREE ACCESS TO, FROM AND OVER SAID EASEMENTS, INCLUDING SUFFICIENT WORKING AREA SPACE FOR ELECTRIC TRANSFORMERS, WITH THE RIGHT AND PRIVILEGE TO TRIM AND REMOVE TREES, SHRUBS OR BUSHES WHICH INTERFERE WITH THE PURPOSES SET FORTH HEREIN, NO BUILDING, SIGN, POOL (ABOVEGROUND OR SUBSURFACE), HOT TUB, CONCRETE OR WOODEN POOL, DECKING OR OTHER STRUCTURE SHALL BE ERRECTED OR CONSTRUCTED ON SAID EASEMENTS, NOR SHALL ANY WELL BE DRILLED OR OPERATED THEREON. PROPERTY OWNERS SHALL BE SOLELY RESPONSIBLE FOR CORRECTING ANY VIOLATIONS OF NATIONAL ELECTRIC SAFETY CODE CAUSED BY CONSTRUCTION OR POOLS, DECKING OR ANY OTHER STRUCTURES ADJACENT TO OR NEAR EASEMENTS SHOWN ON THIS PLAT.

PNM EASEMENT RELEASE APPROVAL

PUBLIC SERVICE COMPANY OF NEW MEXICO DOES HEREBY RELEASE, WAIVE, QUITCLAIM AND DISCHARGE ITS RIGHT, TITLE AND INTEREST IN THE EASEMENTS (GRANTED BY THIS PLAT, REPEAT OR DOCUMENT) SHOWN TO BE VACATED ON THIS PLAT.

PUBLIC SERVICE COMPANY OF NEW MEXICO


BY Rob Roberts

STATE OF NEW MEXICO
COUNTY OF BERNALILLO

THE FOREGOING INSTRUMENT WAS ACKNOWLEDGED BEFORE ME THIS 14TH DAY OF NOV, 1990, BY ROB ROBERTS
OF THE PUBLIC SERVICE COMPANY OF NEW MEXICO, A NEW MEXICO CORPORATION,
ON BEHALF OF SAID CORPORATION.

Robin Phillips
NOTARY PUBLIC

MY COMMISSION EXPIRES 8-7-93

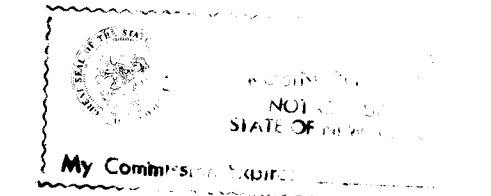

PNM DISCLAIMER

By approving this document, PNM does NOT waive or release any easement or easement rights which may have been granted by prior plat, replat, or document.

U.S. WEST COMMUNICATIONS DISCLAIMER

By approving this document, U.S. West does NOT waive or release any easement or easement rights which may have been granted by prior plat, replat, or document.

FREE CONSENT

THE UNDERSIGNED OWNER(S) OF THE LAND SHOWN HEREON, DO HEREBY CONSENT TO THE SUBDIVISION OF SAID LAND AND THE GRANTING OF EASEMENT(S) IN THE MANNER SHOWN ON THIS PLAT.

Steven J. Johnson GENERAL PARTNER
MONTGOMERY CROSSING, III
A NEW MEXICO GENERAL PARTNERSHIP

ACKNOWLEDGEMENT

STATE OF NEW MEXICO } SS
COUNTY OF BERNALILLO }

THE FOREGOING INSTRUMENT WAS ACKNOWLEDGED BEFORE ME THIS 13TH DAY OF NOVEMBER, 1990.

Sadie P. Mann 04/02/94
NOTARY PUBLIC MY COMMISSION EXPIRES

APPROVALS

Jack Cloud 1-7-91
PLANNING DEPARTMENT DATE
Robert W. Kane 12-18-90
UTILITIES DEVELOPMENT DATE
Frank J. Gagnier 1/4/91
CITY ENGINEER DATE
Frank J. Gagnier 1/4/91
A.M.A.F.C.A.I. DATE
Richard D. Dink 12-18-90
TRANSPORTATION DEVELOPMENT DATE
James M. Stone 12-18-90
PARKS AND RECREATION DATE
Mark Chul 11/3/90
CITY SURVEYOR DATE
Rob Roberts 11-14-90
PROPERTY MANAGEMENT DATE
Donna Berg 10-30-90
GAS COMPANY OF NEW MEXICO DATE
Mattie Weatherly 11-13-90
US WEST DATE
Violet Watson 11/1/90
JONES INTERCABLE, INC. DATE

CERTIFICATION

I, THOMAS T. MANN, JR., A REGISTERED PROFESSIONAL SURVEYOR UNDER THE LAWS OF THE STATE OF NEW MEXICO, DO HEREBY CERTIFY THAT THIS PLAT WAS PREPARED BY ME OR UNDER MY SUPERVISION; SHOWS ALL EASEMENTS NOTED IN A TITLE REPORT PREPARED BY RIO GRANDE TITLE COMPANY # 16-15687-1 MEETS THE MINIMUM REQUIREMENTS OF MONUMENTATION AND SURVEYS OF THE ALBUQUERQUE SUBDIVISION ORDINANCE, AND IS TRUE AND CORRECT TO THE BEST OF MY KNOWLEDGE AND BELIEF.

Thomas T. Mann, Jr. 11/26/90
THOMAS T. MANN, JR., N.M.S. NO. 3792
REGISTERED PROFESSIONAL SURVEYOR
NEW MEXICO
AND LAND SURVEYOR


04/02/94

SHEET 1 OF 2

THE MANN COMPANY, INC.
8200 MOUNTAIN ROAD N.E. SUITE 102
ALBUQUERQUE, NEW MEXICO 87110
(505) 266-3555

91 1066

PLAT OF
TRACTS A-1 AND A-2
MONTGOMERY CROSSING ADDITION
PHASE III
ALBUQUERQUE, NEW MEXICO
OCTOBER 1990

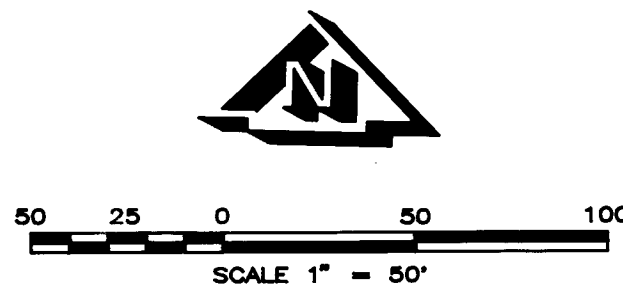

8:55
91C

MONTGOMERY BOULEVARD, NE

GEN. CHENAULT STREET, NE

GEN. CHENAULT STREET, NE

VACATED STREET (1-61-93)

9-F19
ACS BRASS CAP
X = 410.118.95
Y = 1,502.886.01
G-G = 0.9996495
A = -00°10'23"
ELEVATION = 5431.54

LOTS 1 THRU 7
MONTGOMERY CROSSING
PHASE II
FILED: 12-30-87
VOL. C35, FOLIO 106


CURVE	RADIUS	DELTA	ARC	CHORD (BEARING & DISTANCE)
C1	143.38'	03°48'18"	9.52'	S75°08'56"E 9.52'
C2	156.63'	16°15'35"	44.45'	S81°22'39"E 44.30'
C3	20.00'	89°58'58"	31.41'	S44°30'58"E 28.28'
C4	20.00'	56°12'00"	19.62'	N28°35'38"E 18.84'
C5	45.00'	245°47'14"	193.04'	S24°25'47"E 75.57'
C6	25.00'	58°17'14"	25.43'	N61°19'00"E 24.35'
C7	25.00'	89°59'57"	39.27'	N45°29'34"E 35.36'

THOMAS ADDITION
FILED: 1-17-72
VOL. C8, FOLIO 80

THOMAS ADDITION
FILED: 1-28-73
VOL. B7, FOLIO 88

SHEET 2 OF 2

THE MANN COMPANY, INC.
8200 MOUNTAIN ROAD N.E. SUITE 102
ALBUQUERQUE, NEW MEXICO 87110
(505) 266-3555

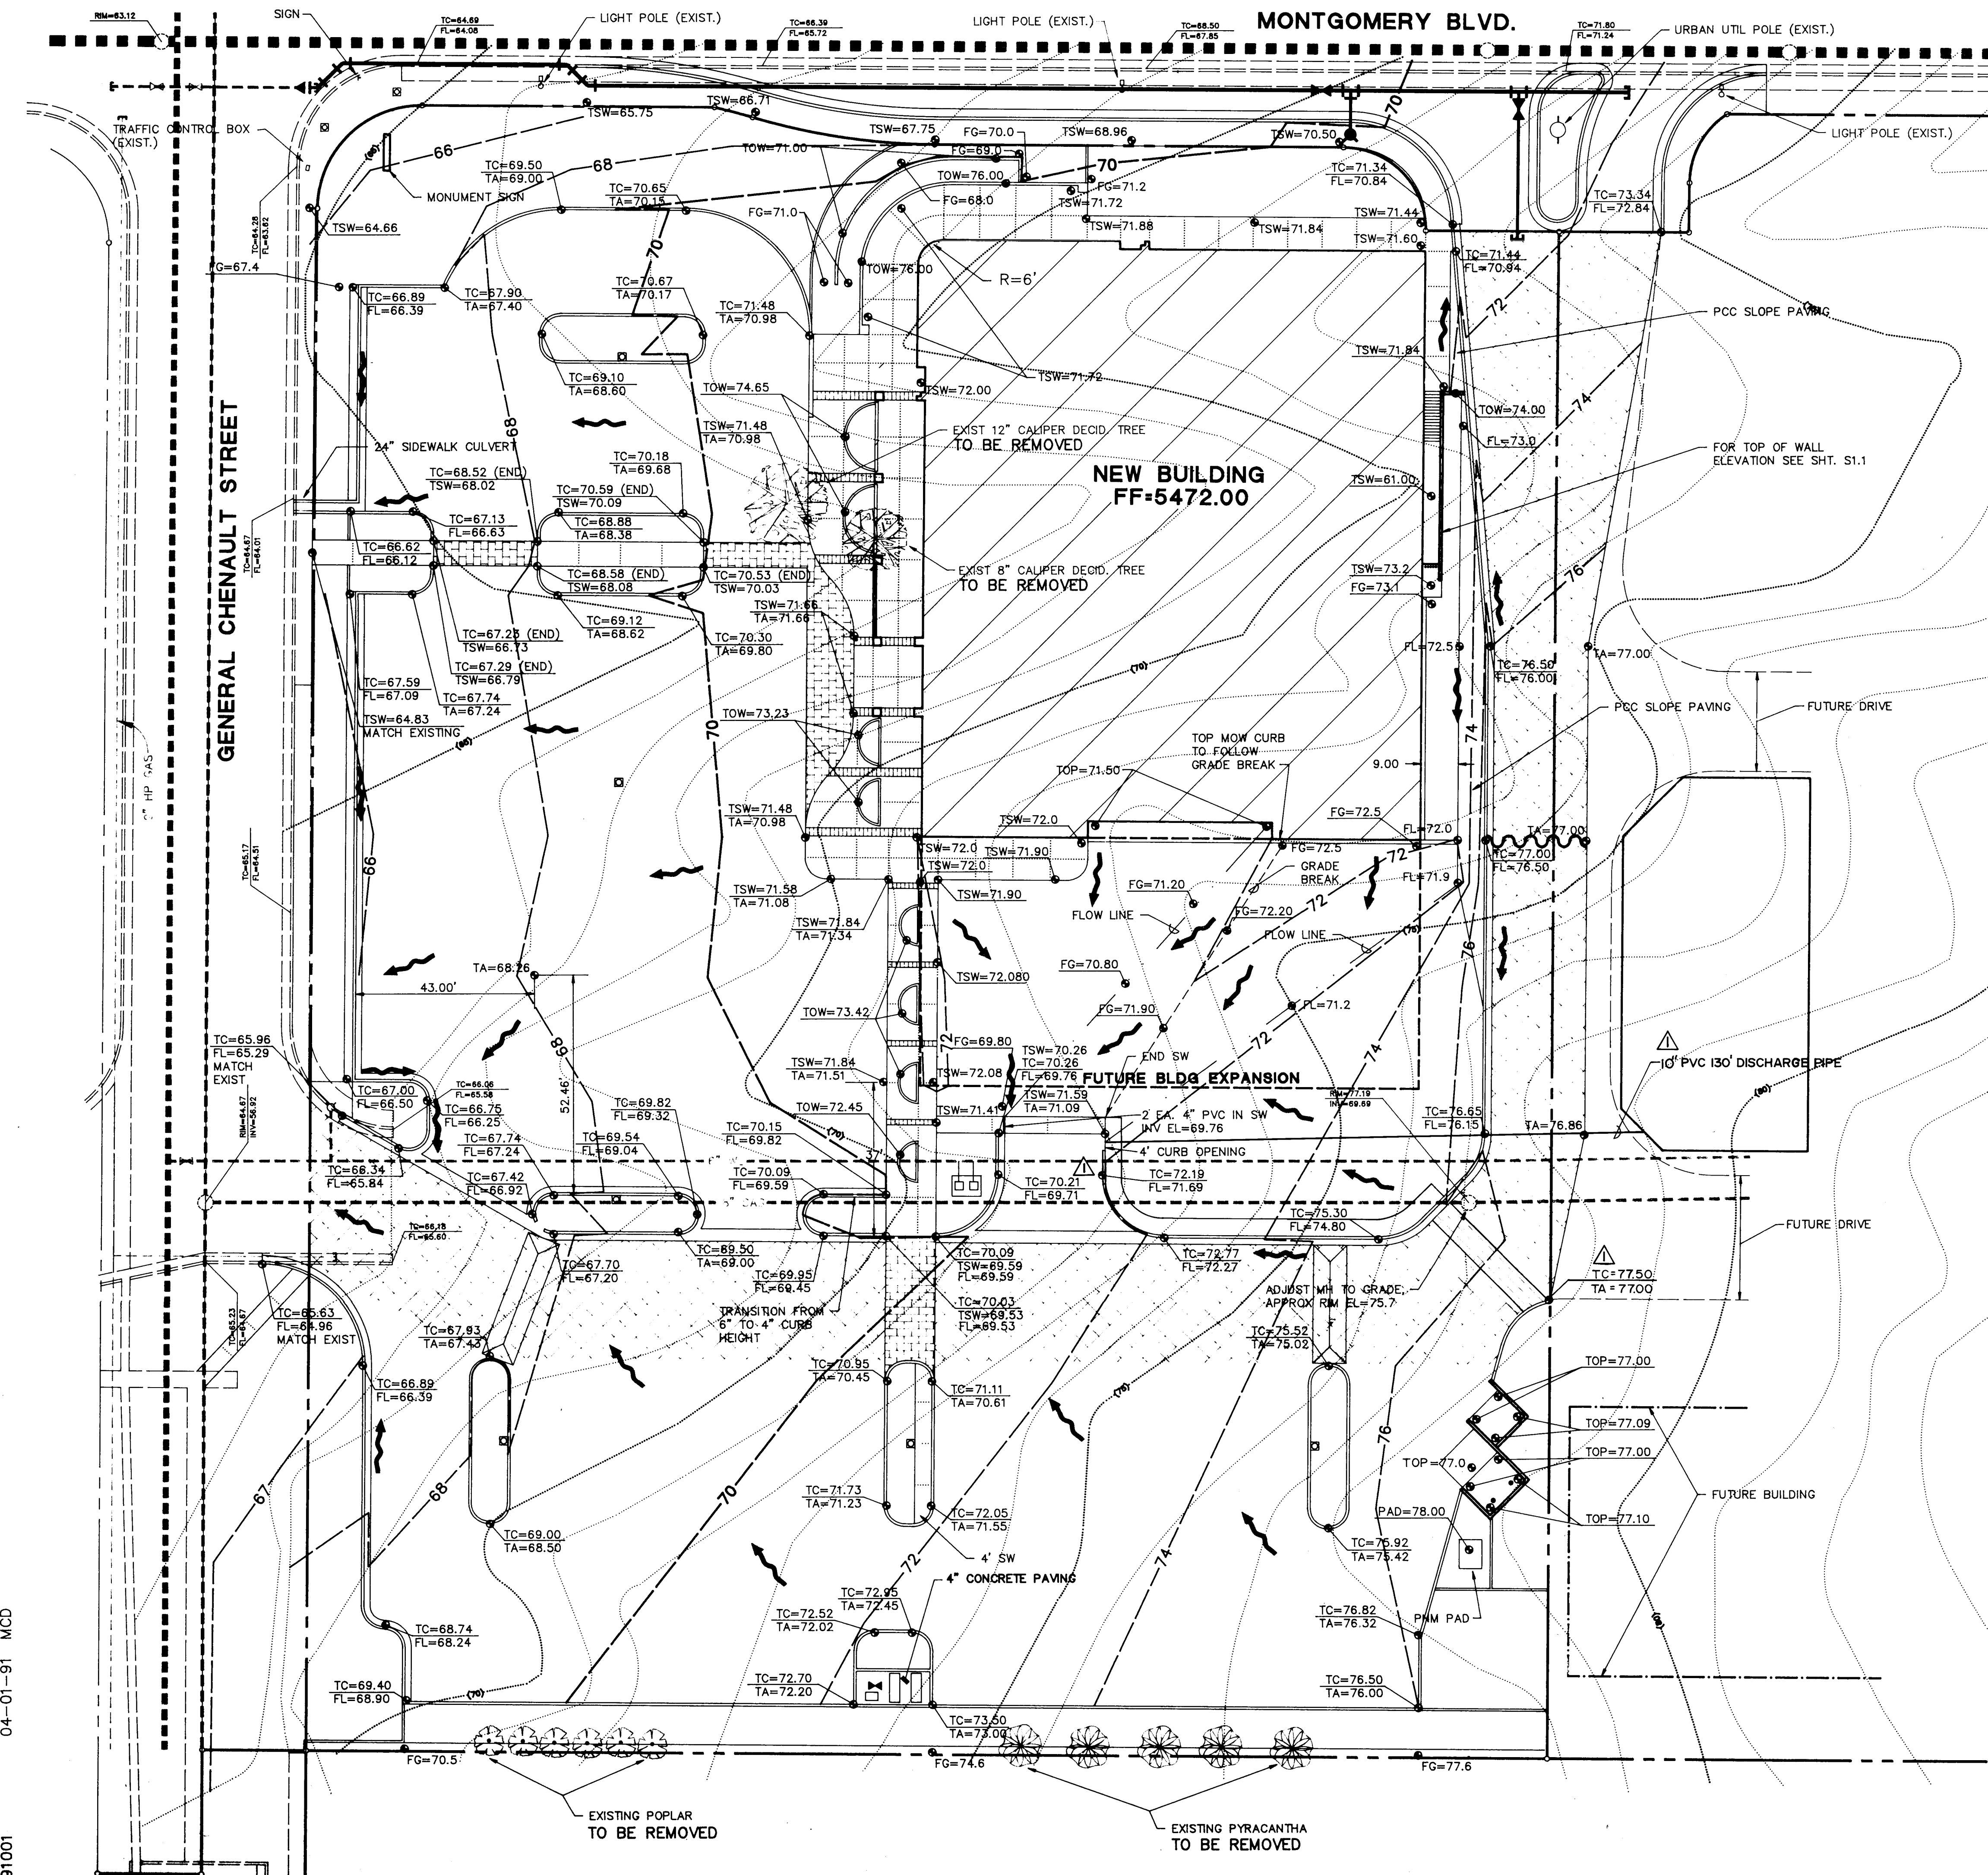

Designing to Shape the Future

BENCHMARK: M-2A, ACS BRASS CAP AT THE INTERSECTION OF MONTGOMERY AND LA BARRANCA ELEVATION = 5460.382

LEGAL DESCRIPTION: TRACT A-1, MONTGOMERY CROSSING ADDITION, PHASE III

NOTES:

1. THE WORK SHOWN ON THIS SHEET IS NOT PART OF THE CITY WORK ORDER.
2. TWO (2) WORKING DAYS PRIOR TO ANY EXCAVATION, CONTRACTOR MUST CONTACT THE LINE LOCATING SERVICE AT 260-1990 FOR LOCATION AND BLUESTAKING OF EXISTING UTILITIES.
3. THE CONTRACTOR MUST SECURE A TOPSOIL DISTURBANCE PERMIT PRIOR TO STARTING CONSTRUCTION.
4. CONTRACTOR SHALL ENSURE THAT NO SOIL ERODES FROM THE SITE INTO PUBLIC ROW OR ONTO PRIVATE PROPERTY. THIS CAN BE ACHIEVED BY CONSTRUCTING TEMPORARY BERMS AT THE PROPERTY LINES AND WETTING THE SOIL TO KEEP IT FROM BLOWING.
5. THE CONTRACTOR SHALL PROMPTLY CLEAN UP ANY MATERIAL EXCAVATED WITHIN THE PUBLIC ROW SO THAT THE EXCAVATED MATERIAL IS NOT SUSCEPTIBLE TO BEING WASHED DOWN THE STREET.
6. SEE DETAIL 25.C5.2 FOR TYPICAL PARKING AREA PAVEMENT SECTION.

LEGEND

- TYPICAL MAIN DRIVE PAVING, SEE DETAIL 24, C5.2 FOR SECTION
- EXIST ELEVATION
- NEW ELEVATION
- FLOW DIRECTION
- WATER BLOCK
- TC TOP OF CURB
- FL FLOW LINE
- TA TOP OF ASPHALT
- FG FINISH GRADE
- TSW TOP OF SIDEWALK
- MH MANHOLE
- TOW TOP OF WALL
- TOP TOP OF PAVING

	10" PVC PRIVATE DISCHARGE PIPE RELOCATED MIN. 5' NORTH OF 6" WATERLINE. CHANGE TO EL. REMOVE 2' CURB OPENING.	4-17-91
REV.	DESCRIPTION	DATE

ENGINEER 4-1-91
ARCHITECT

FHP MEDICAL OFFICES

MONTGOMERY & GENERAL CHENAULT


ALBUQUERQUE, NEW MEXICO

PROJECT NO. 91001 **DATE** 04-01-91
CITY: 3803.91


GRADING & PAVING PLAN

DRAWING NO.
C2.1
SHEET 3 OF 6


NEW PAVING CURVE TABLE			
CURVE	RADIUS	DELTA	ARC LENGTH
A	10.00'	90°00'00"	15.71'
B	2.00'	119°17'55"	04.16'
C	45.00'	29°17'55"	23.01'
D	5.00'	180°00'00"	15.71'
E	25.00'	90°00'00"	39.27'
F	25.00'	90°00'00"	39.27'
G	150.00'	16°15'37"	42.57'
H	150.00'	16°15'37"	42.57'
I	2.00'	180°00'00"	06.28'
J	150.00'	16°15'37"	42.57'
K	150.00'	16°15'37"	42.57'

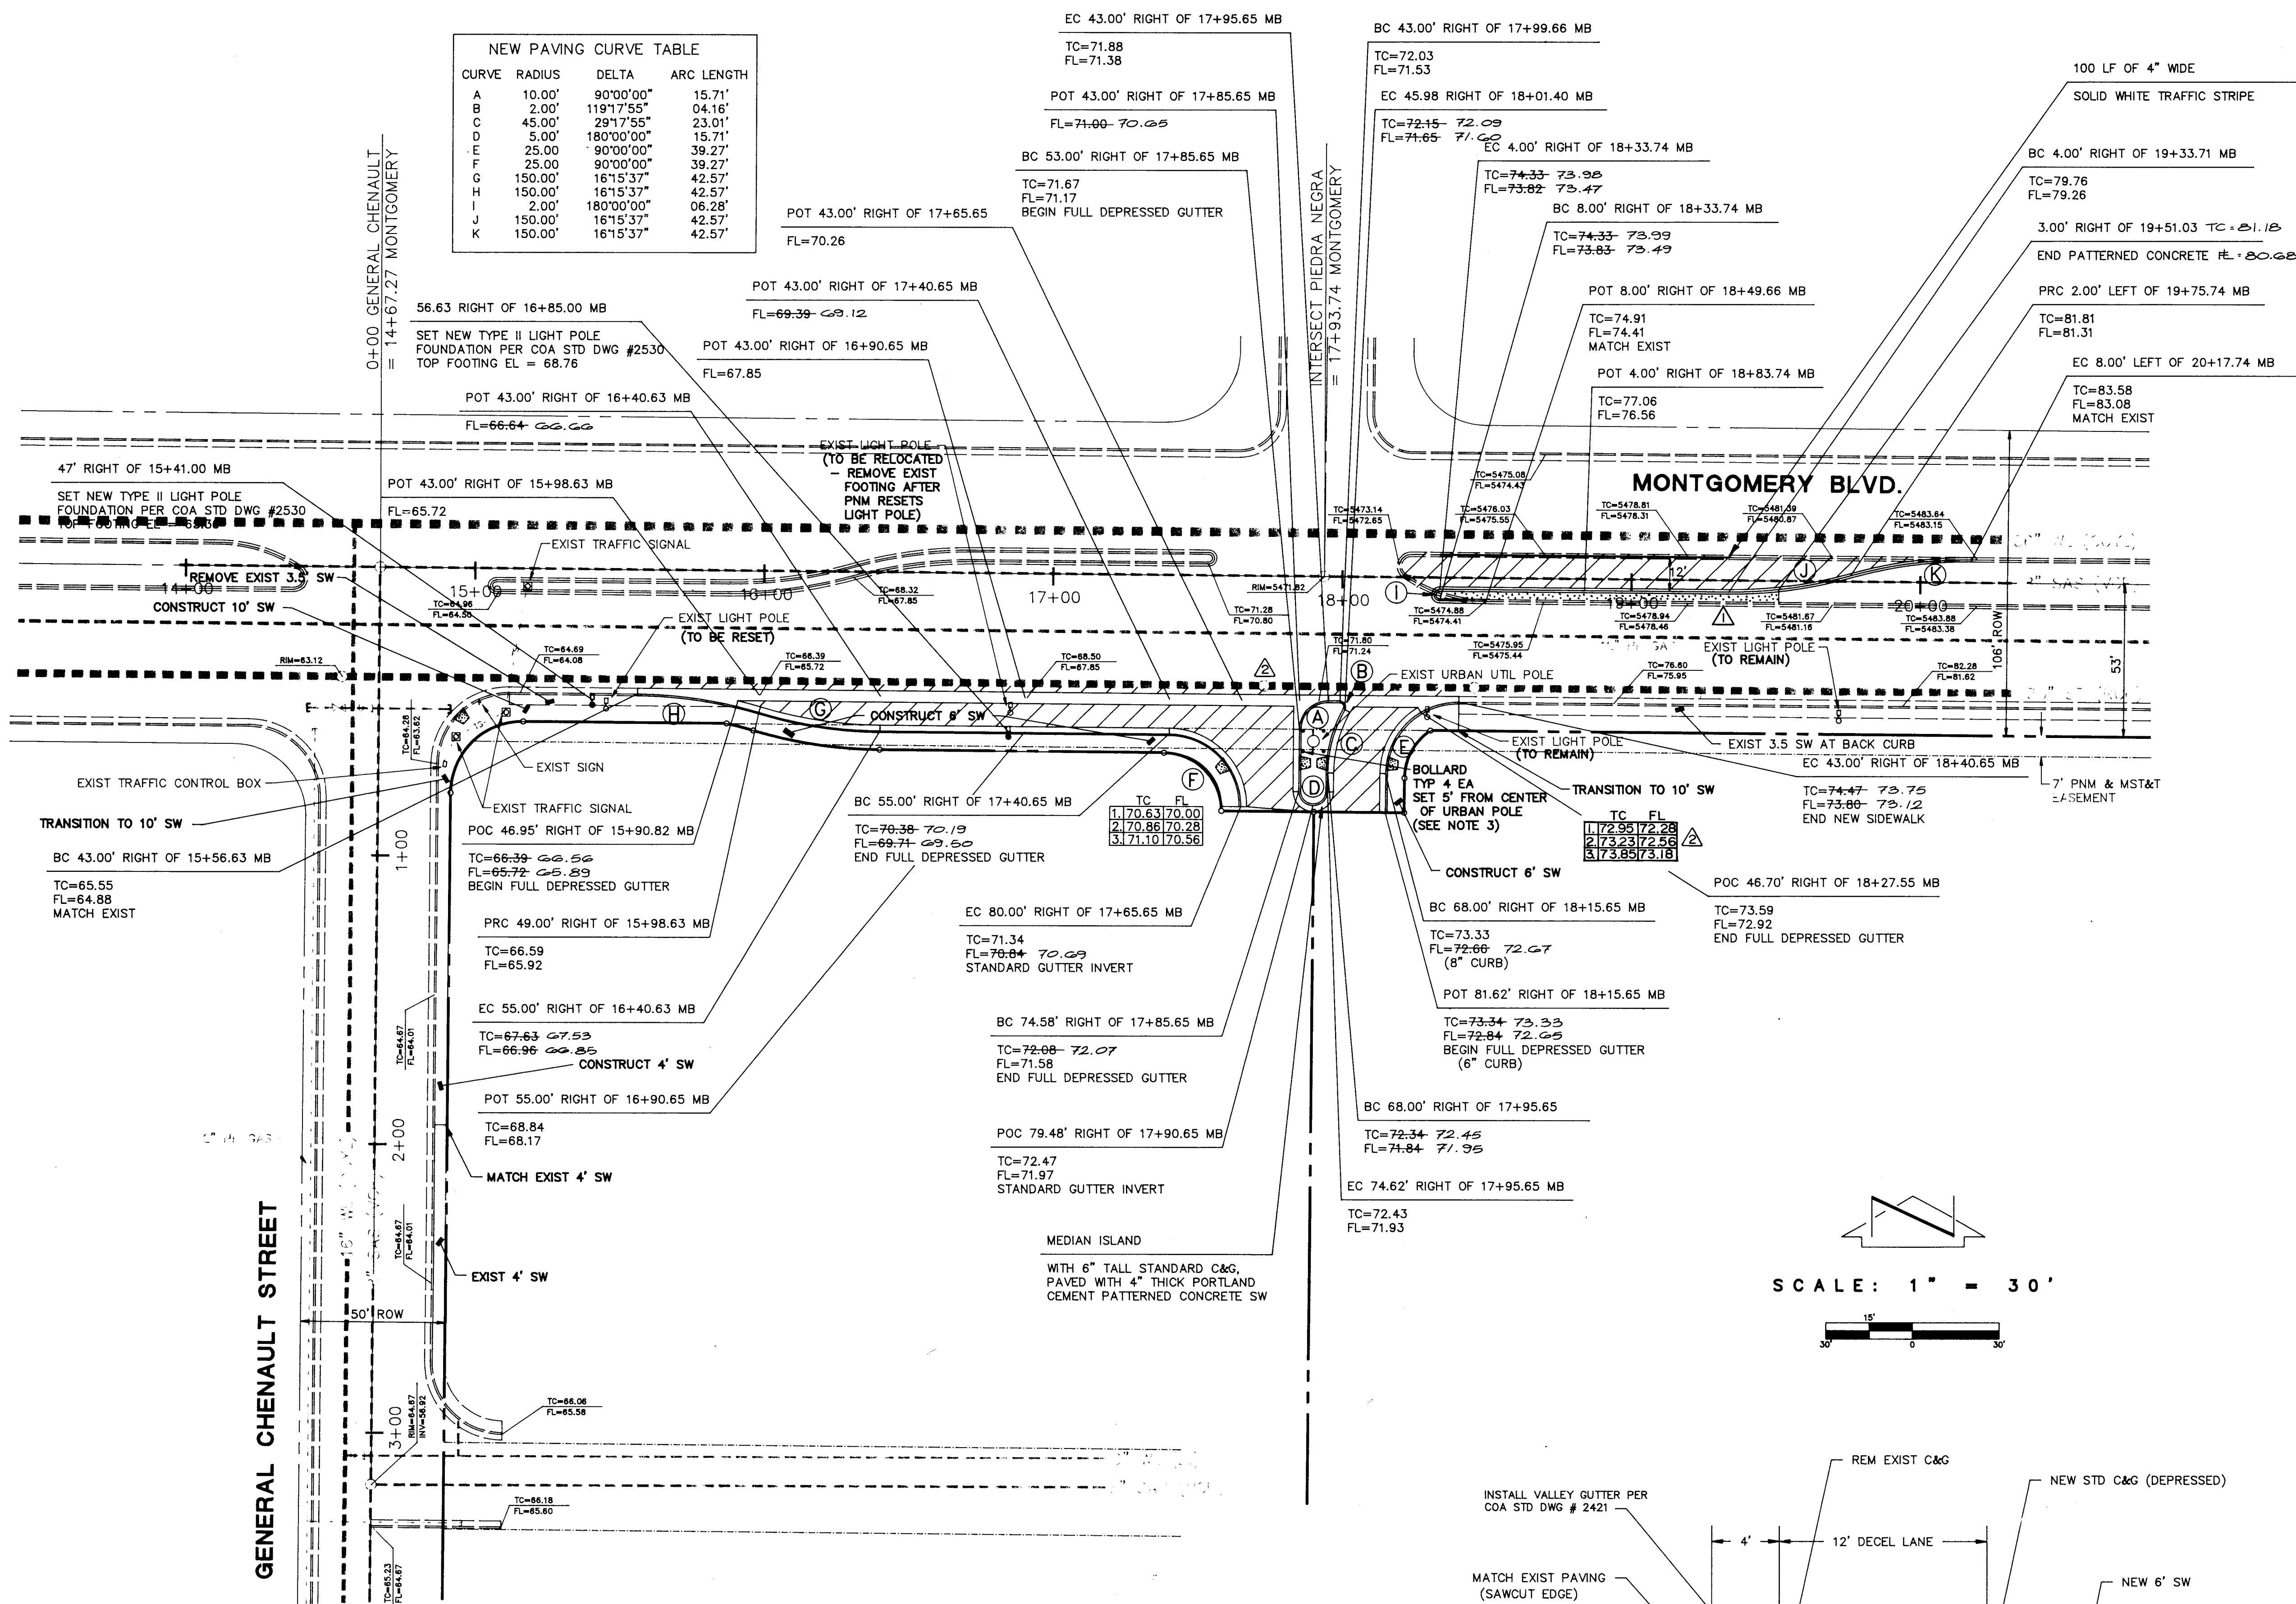

GENERAL CHENAULT STREET

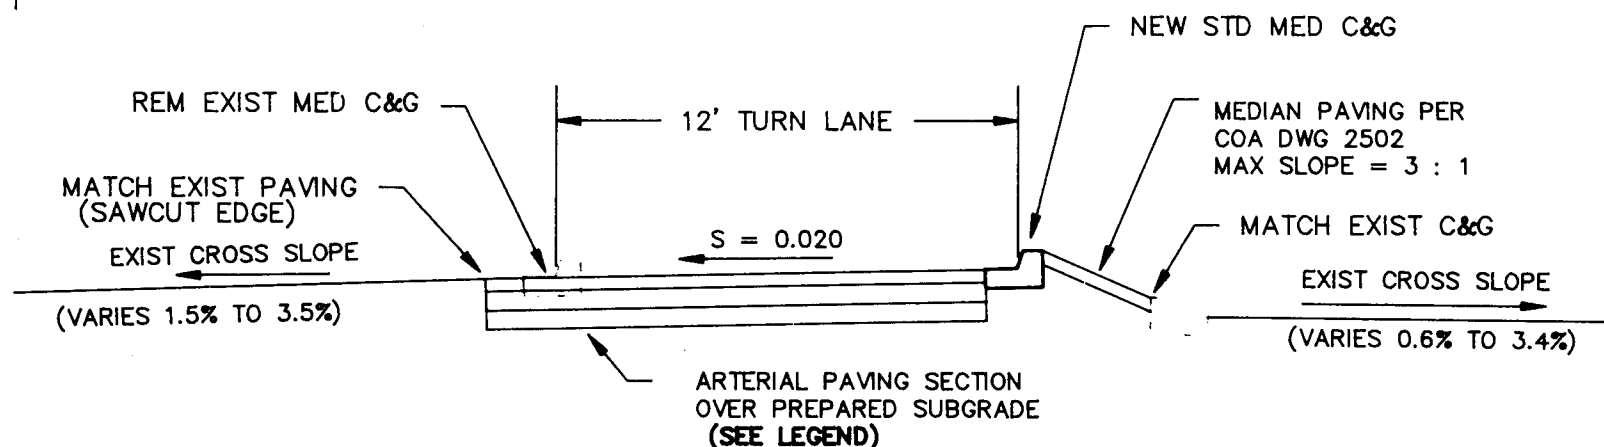


LEFT TURN POCKET SECTION
SCALE: 1" = 5'

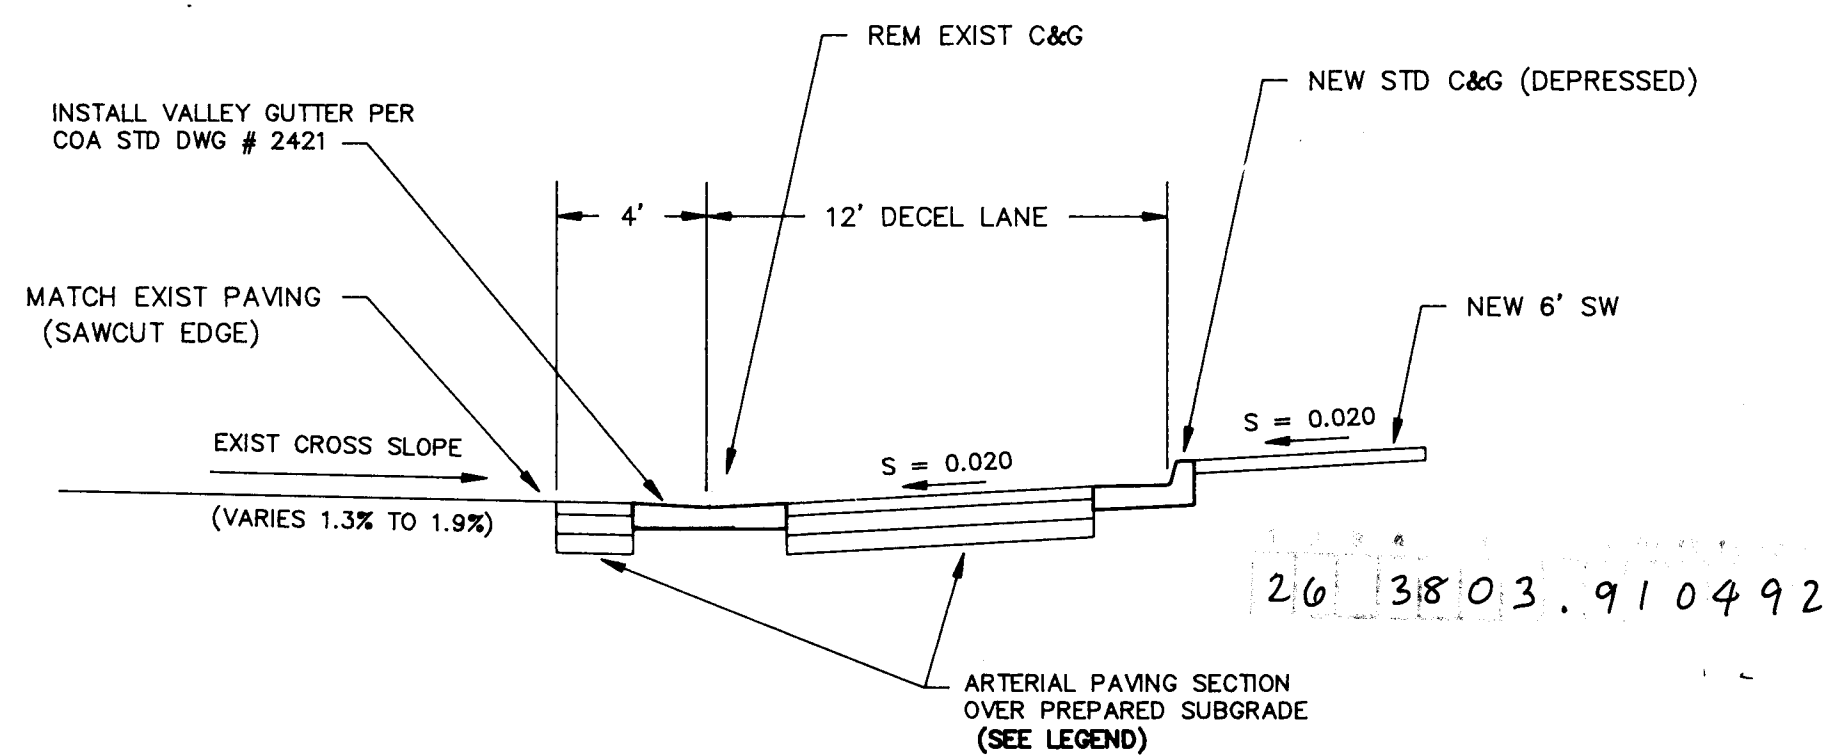

DECEL LANE SECTION
SCALE: 1" = 5'

- NOTES:**
- ALL SW CONSTRUCTION SHALL COMPLY WITH COA STD DWG #2430.
 - CONTRACTOR MUST COORDINATE RESETTING OF STREET LIGHTS (OVERHEAD FEED) WITH PNM AT TIME FOOTINGS ARE POURED. 21 DAYS MIN CURE TIME ON FOOTINGS IS REQUIRED BEFORE LIGHT POLES CAN BE RELOCATED. PNM MUST PERFORM THIS WORK. PNM TO INSTALL CROSS ARM ON EXISTING URBAN POLE SINCE THE HORIZONTAL CLEARANCE TO THE RELOCATED OVERHEAD FEED IS LESS THAN 6 FEET TO THE POLE.
 - SET 4 EACH 6" DIA., 3 FOOT TALL CONCRETE FILLED BOLLARDS (18" DIA. FOOTING, 5' DEEP) AROUND URBAN UTILITY POLE PER PNM REQUIREMENTS AND PAINTED DARK RED.
 - PAVE MEDIAN ISLAND WITH PATTERNED CONCRETE IN ACCORDANCE WITH COA DWG 2502.

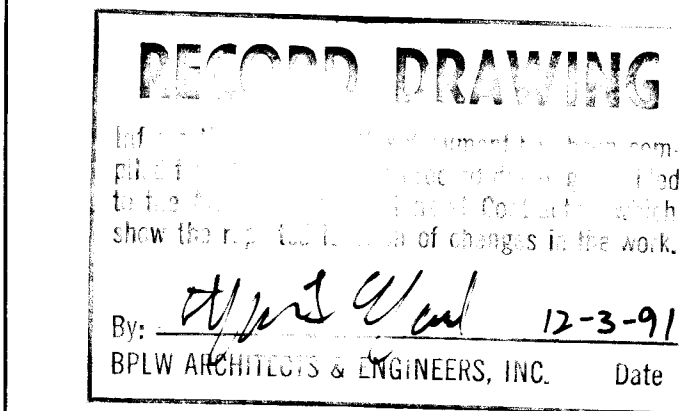

- LEGEND**
- PATTERNED CONCRETE
 - EXIST STREET LIGHT, FOOTING AND LAMP HEAD
 - NEW STREET LIGHT, FOOTING AND LAMP HEAD
 - EXIST ELEVATION
 - TOP OF CURB
 - FLOW LINE
 - BEGINNING OF CURVE
 - END OF CURVE
 - POINT ON CURVE
 - POINT OF REVERSING CURVES
 - POINT OF TANGENT
 - MONTGOMERY BLVD.
 - SIDEWALK
 - CURB & GUTTER
 - NEW ARTERIAL PAVING
12" SUBGRADE PREP
6" SUBBASE
6" ATB
2-1/2" AGS 1500 LB
1-1/2" AC-SF 1800 LB
 - HANDICAP RAMP IN SIDEWALK

(BPLW PROJECT NO. = 91001)

BPLW
Architects & Engineers, Inc.




2400 Louisiana Blvd. NE
AFC #5 Suite 400
Albuquerque, New Mexico 87110
(505) 881-2759

63 East Main Street
Suite 602
Albuquerque, New Mexico 87101
(505) 827-2759


DESIGNED BY BPLW ARCH. & ENGINEERS DATE APRIL 1, 1991
DRAWN BY MICHELE GRANFORD DRAFTING DATE APRIL 1, 1991
CHECKED BY SLC/LAH

CITY OF ALBUQUERQUE PUBLIC WORKS DEPARTMENT ENGINEERING GROUP					
TITLE: FHP MEDICAL OFFICES MONTGOMERY & GENERAL CHENAULT MEDIAN & DRIVEWAY CONSTRUCTION					
APPROVALS	ENGINEER	DATE	APPROVALS	ENGINEER	DATE
DRC Chairman	Royce	5/3/91	Water	Albina	5/10/91
Transportation	Boyle	4-25-91	Waste Water	Albina	
Hydrology	Boyle	4-25-91			
Parks & Rec.	N/A				
DRAWING NO.	3803.91	MAP NO.	G-20	SHEET 4 OF 8	C2.2

ADD. ROW LINES TO ALLEY SECTIONS CHANGED TEMPORARY PAVING TO RESIDENTIAL PAVING CHANGE REFERENCE DRAWING FROM 2405 TO 24H1.		ENGINEER'S SEAL 		SURVEY INFORMATION FIELD NOTES NO. BY DATE DESIGN THE MANN COMPANY NOV '90		BENCH MARKS BENCHMARK: M-2A, ACS BRASS CAP AT THE INTERSECTION OF MONTGOMERY AND LA BARRANCA ELEVATION = 5460.382		AS BUILT INFORMATION CONTRACTOR SUNDANCE MECHANICAL WORK COMMUNITY SERVICES STAKED BY SCIENCES INSPECTOR'S BPLW ARCH 8 FIELD DATES BY ENGINEERS VERIFICATION BY H DATE 11-91 CORRECTED BY H DATE 12-91 MICRO-FILM INFORMATION RECORDED BY DATE NO.	
NO. DATE REMARKS REVISIONS DESIGN		DESIGNED BY BPLW ARCH & ENGINEERS DATE 03-06-91 DRAWN BY MICHELE CRAWFORD DRAFTING DATE 03-06-91 CHECKED BY SLC/LAH DATE 03-06-91		4-29-91 4-1-91					

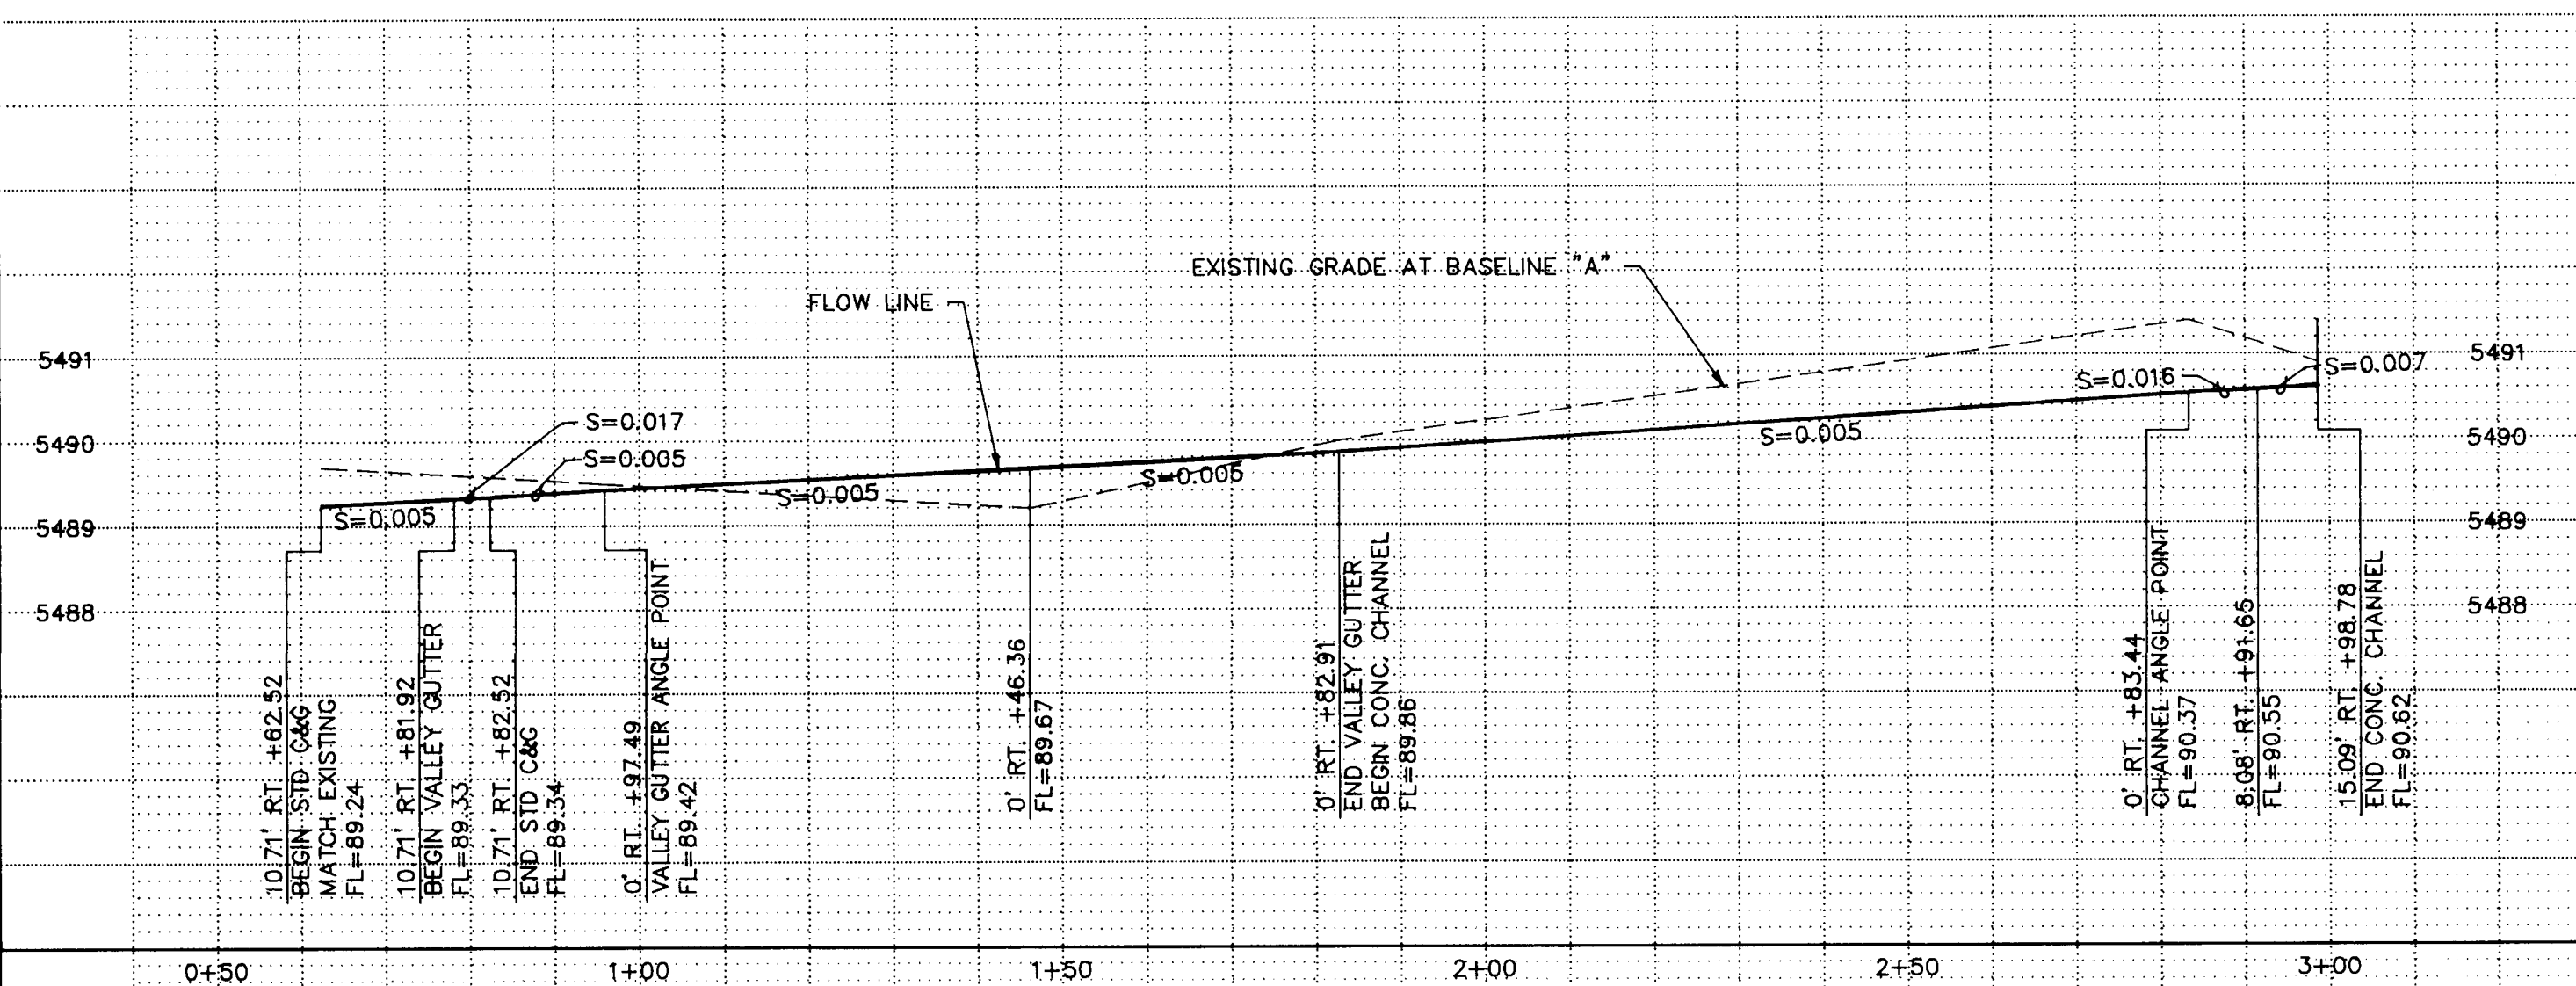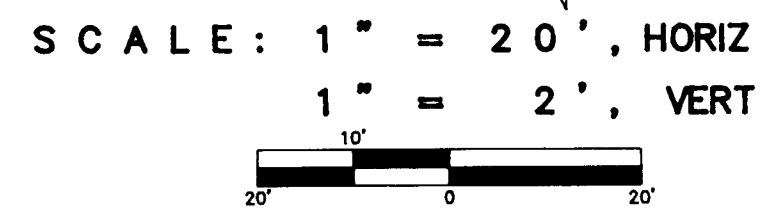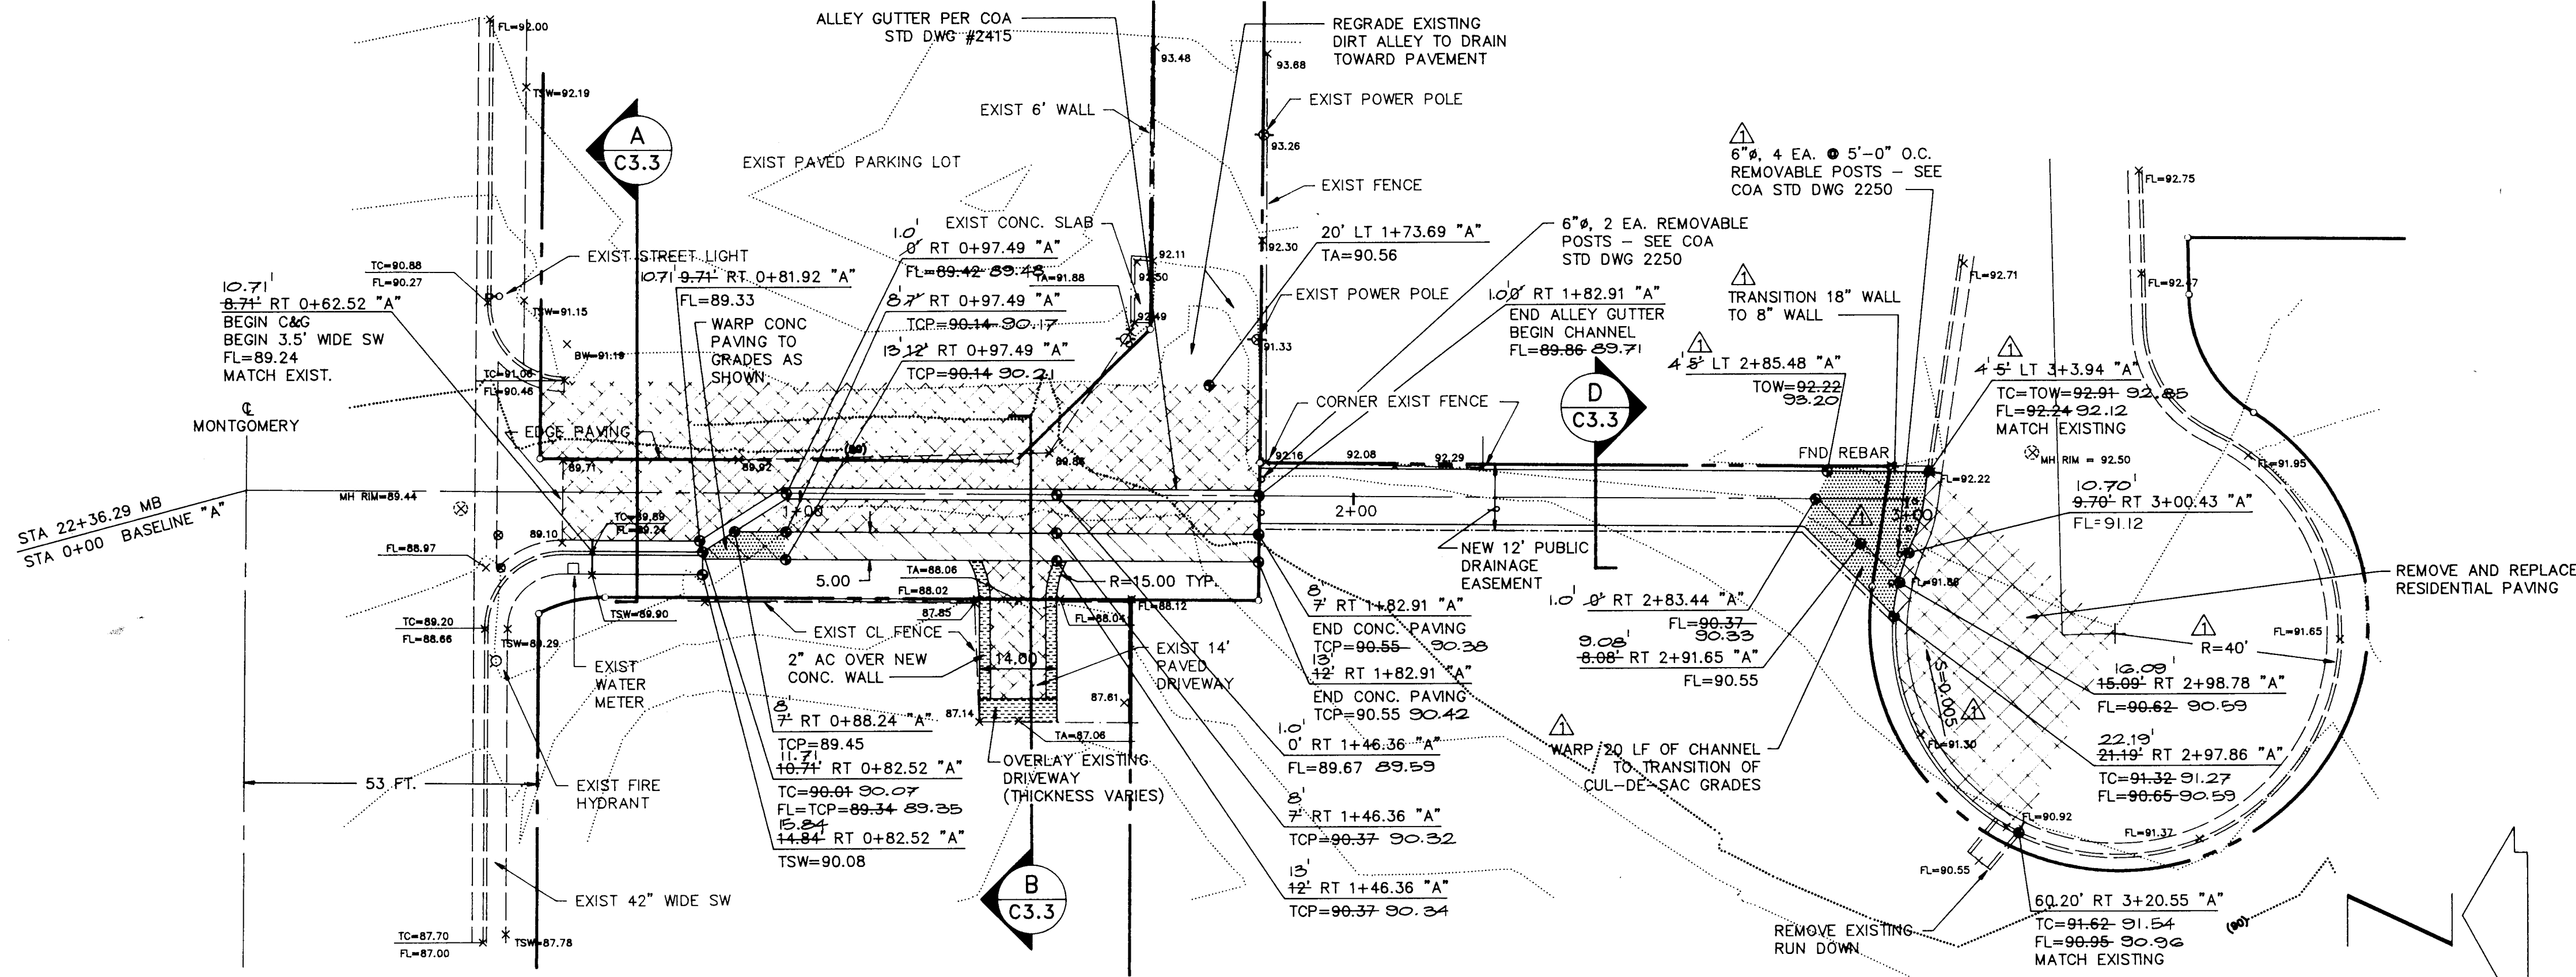

FLOW LINE PROFILE

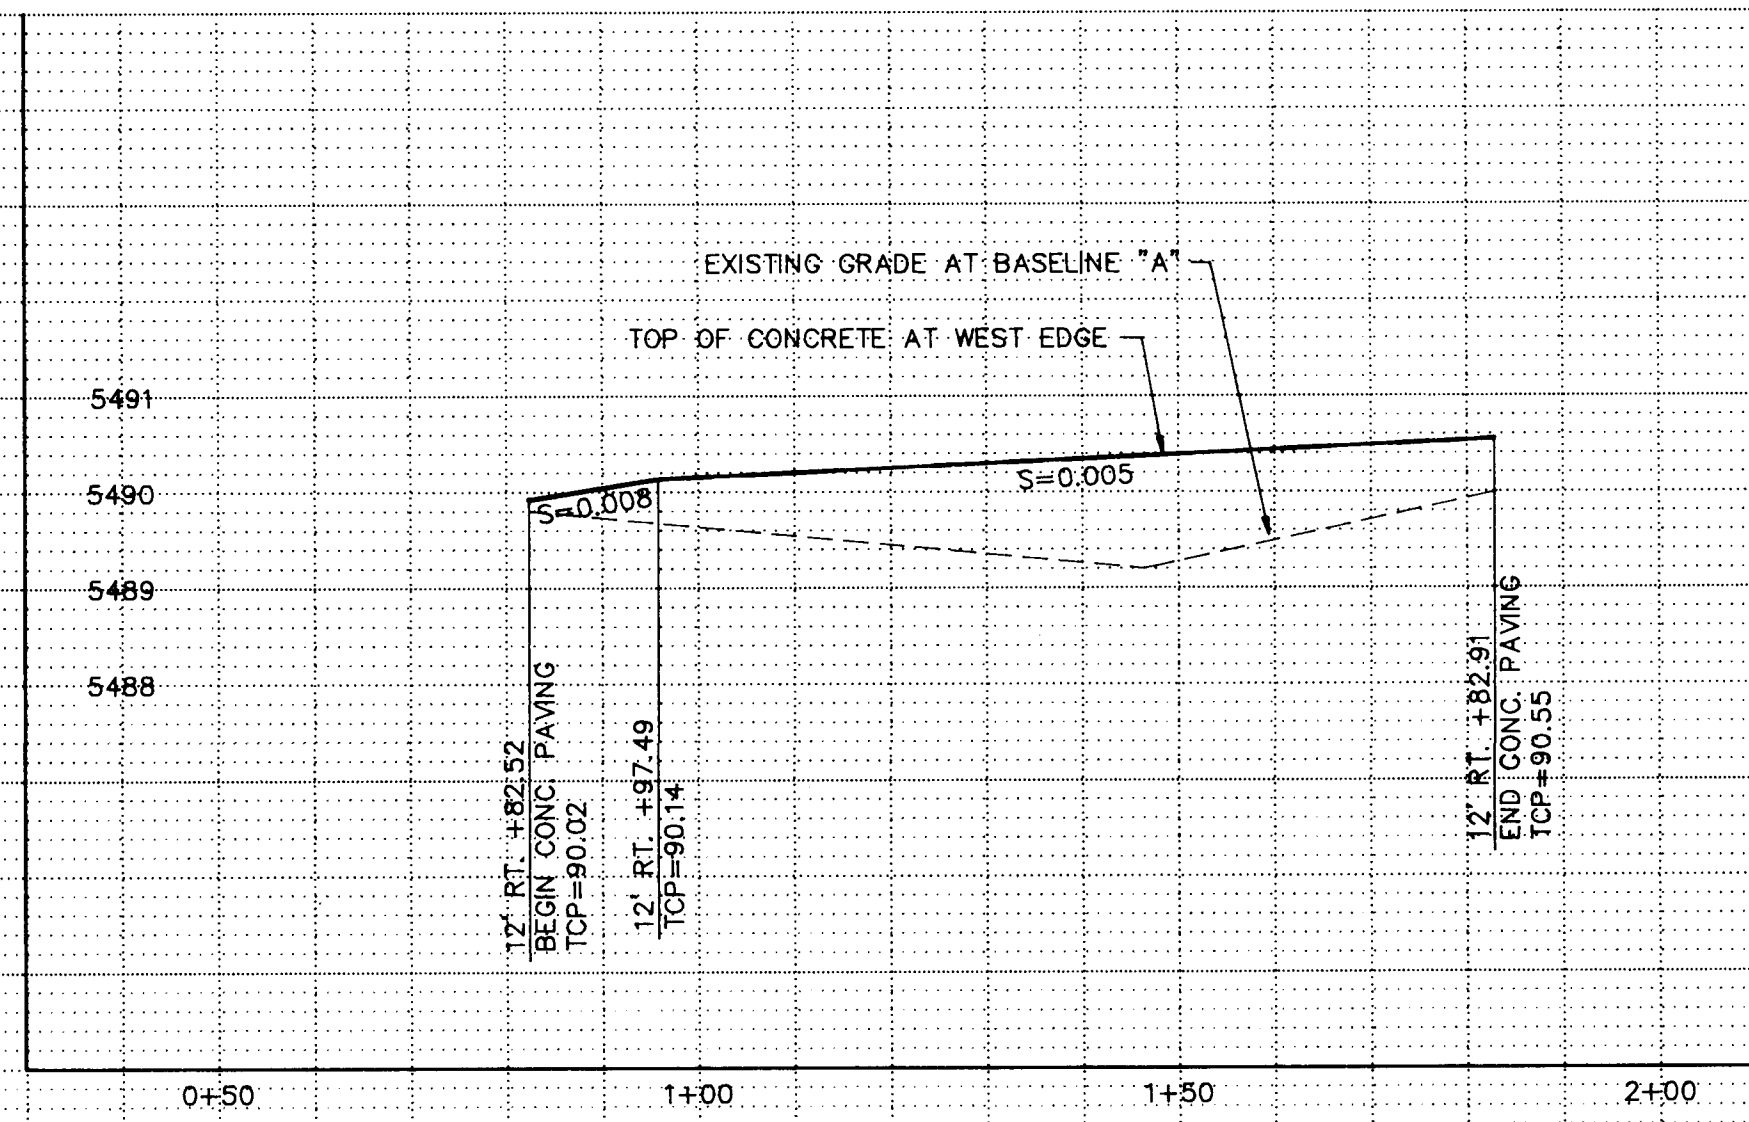

CONCRETE PAVING PROFILE

RECORD DRAWING
Information in this document has been compiled from the record drawing provided to the Architect by the General Contractor, which show the reported location of changes in the work.
By: *[Signature]* 12-3-91
BPLW ARCHITECTS & ENGINEERS, INC. Date

- LEGEND**
- REMOVE AND REPLACE RESIDENTIAL PAVING
 - 6" PCC CONCRETE PAVING
 - RESIDENTIAL ALLEY PAVING PER COA STANDARD 2411
 - EXIST ELEVATION
 - EXIST ELEVATION
 - NEW ELEVATION
 - WATER BLOCK
 - FLOW DIRECTION
 - MB MONTGOMERY BLVD.
 - SW SIDEWALK
 - C&G CURB & GUTTER
 - TA TOP OF ASPHALT
 - TC TOP OF CURB
 - FL FLOW LINE
 - TCP TOP OF CONC. PAVING
 - CL CHAIN LINK
 - TOW TOP OF WALL

(BPLW PROJECT NO. = 91001)

BPLW
Architects & Engineers, Inc.

2400 Louisiana Blvd. NE
AFC #5 Suite 400
Albuquerque, New Mexico 87110
(505) 881-2759

63 East Main Street
Suite 402
Albuquerque, New Mexico 85201
(602) 827-2759

Designing to Shape the Future

CITY OF ALBUQUERQUE PUBLIC WORKS DEPARTMENT ENGINEERING GROUP					
TITLE: FHP MEDICAL OFFICES MONTGOMERY & GENERAL CHENAUULT OFFSITE DRAINAGE IMPROVEMENTS					
APPROVALS	ENGINEER	DATE	APPROVALS	ENGINEER	DATE
DRC Chairman	<i>[Signature]</i>	3/13/94	Water	<i>[Signature]</i>	8-10-91
Transportation	<i>[Signature]</i>	4-26-91	Waste Water	<i>[Signature]</i>	"
Hydrology	<i>[Signature]</i>	4-25-91			
Parks & Rec.	<i>[Signature]</i>				
DRAWING NO. — MAP NO. — SHEET 7 OF 8					
C3.4					

DRAWING NO.

C3.5

SHEET 8 OF 8