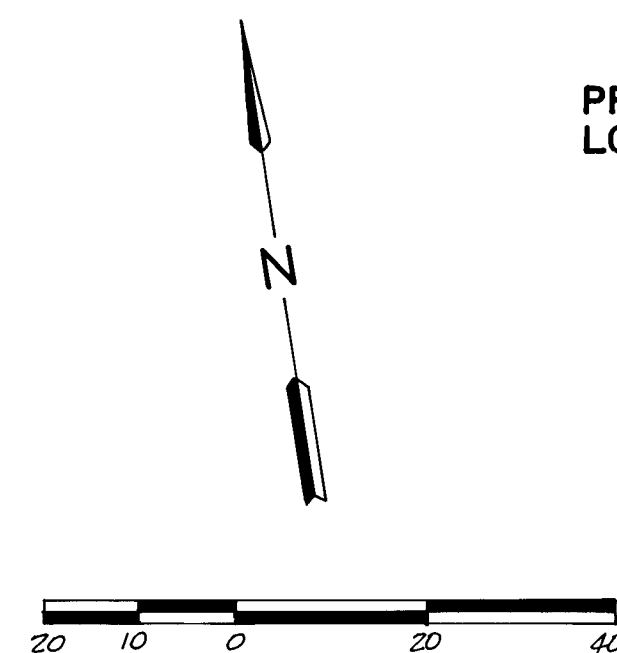
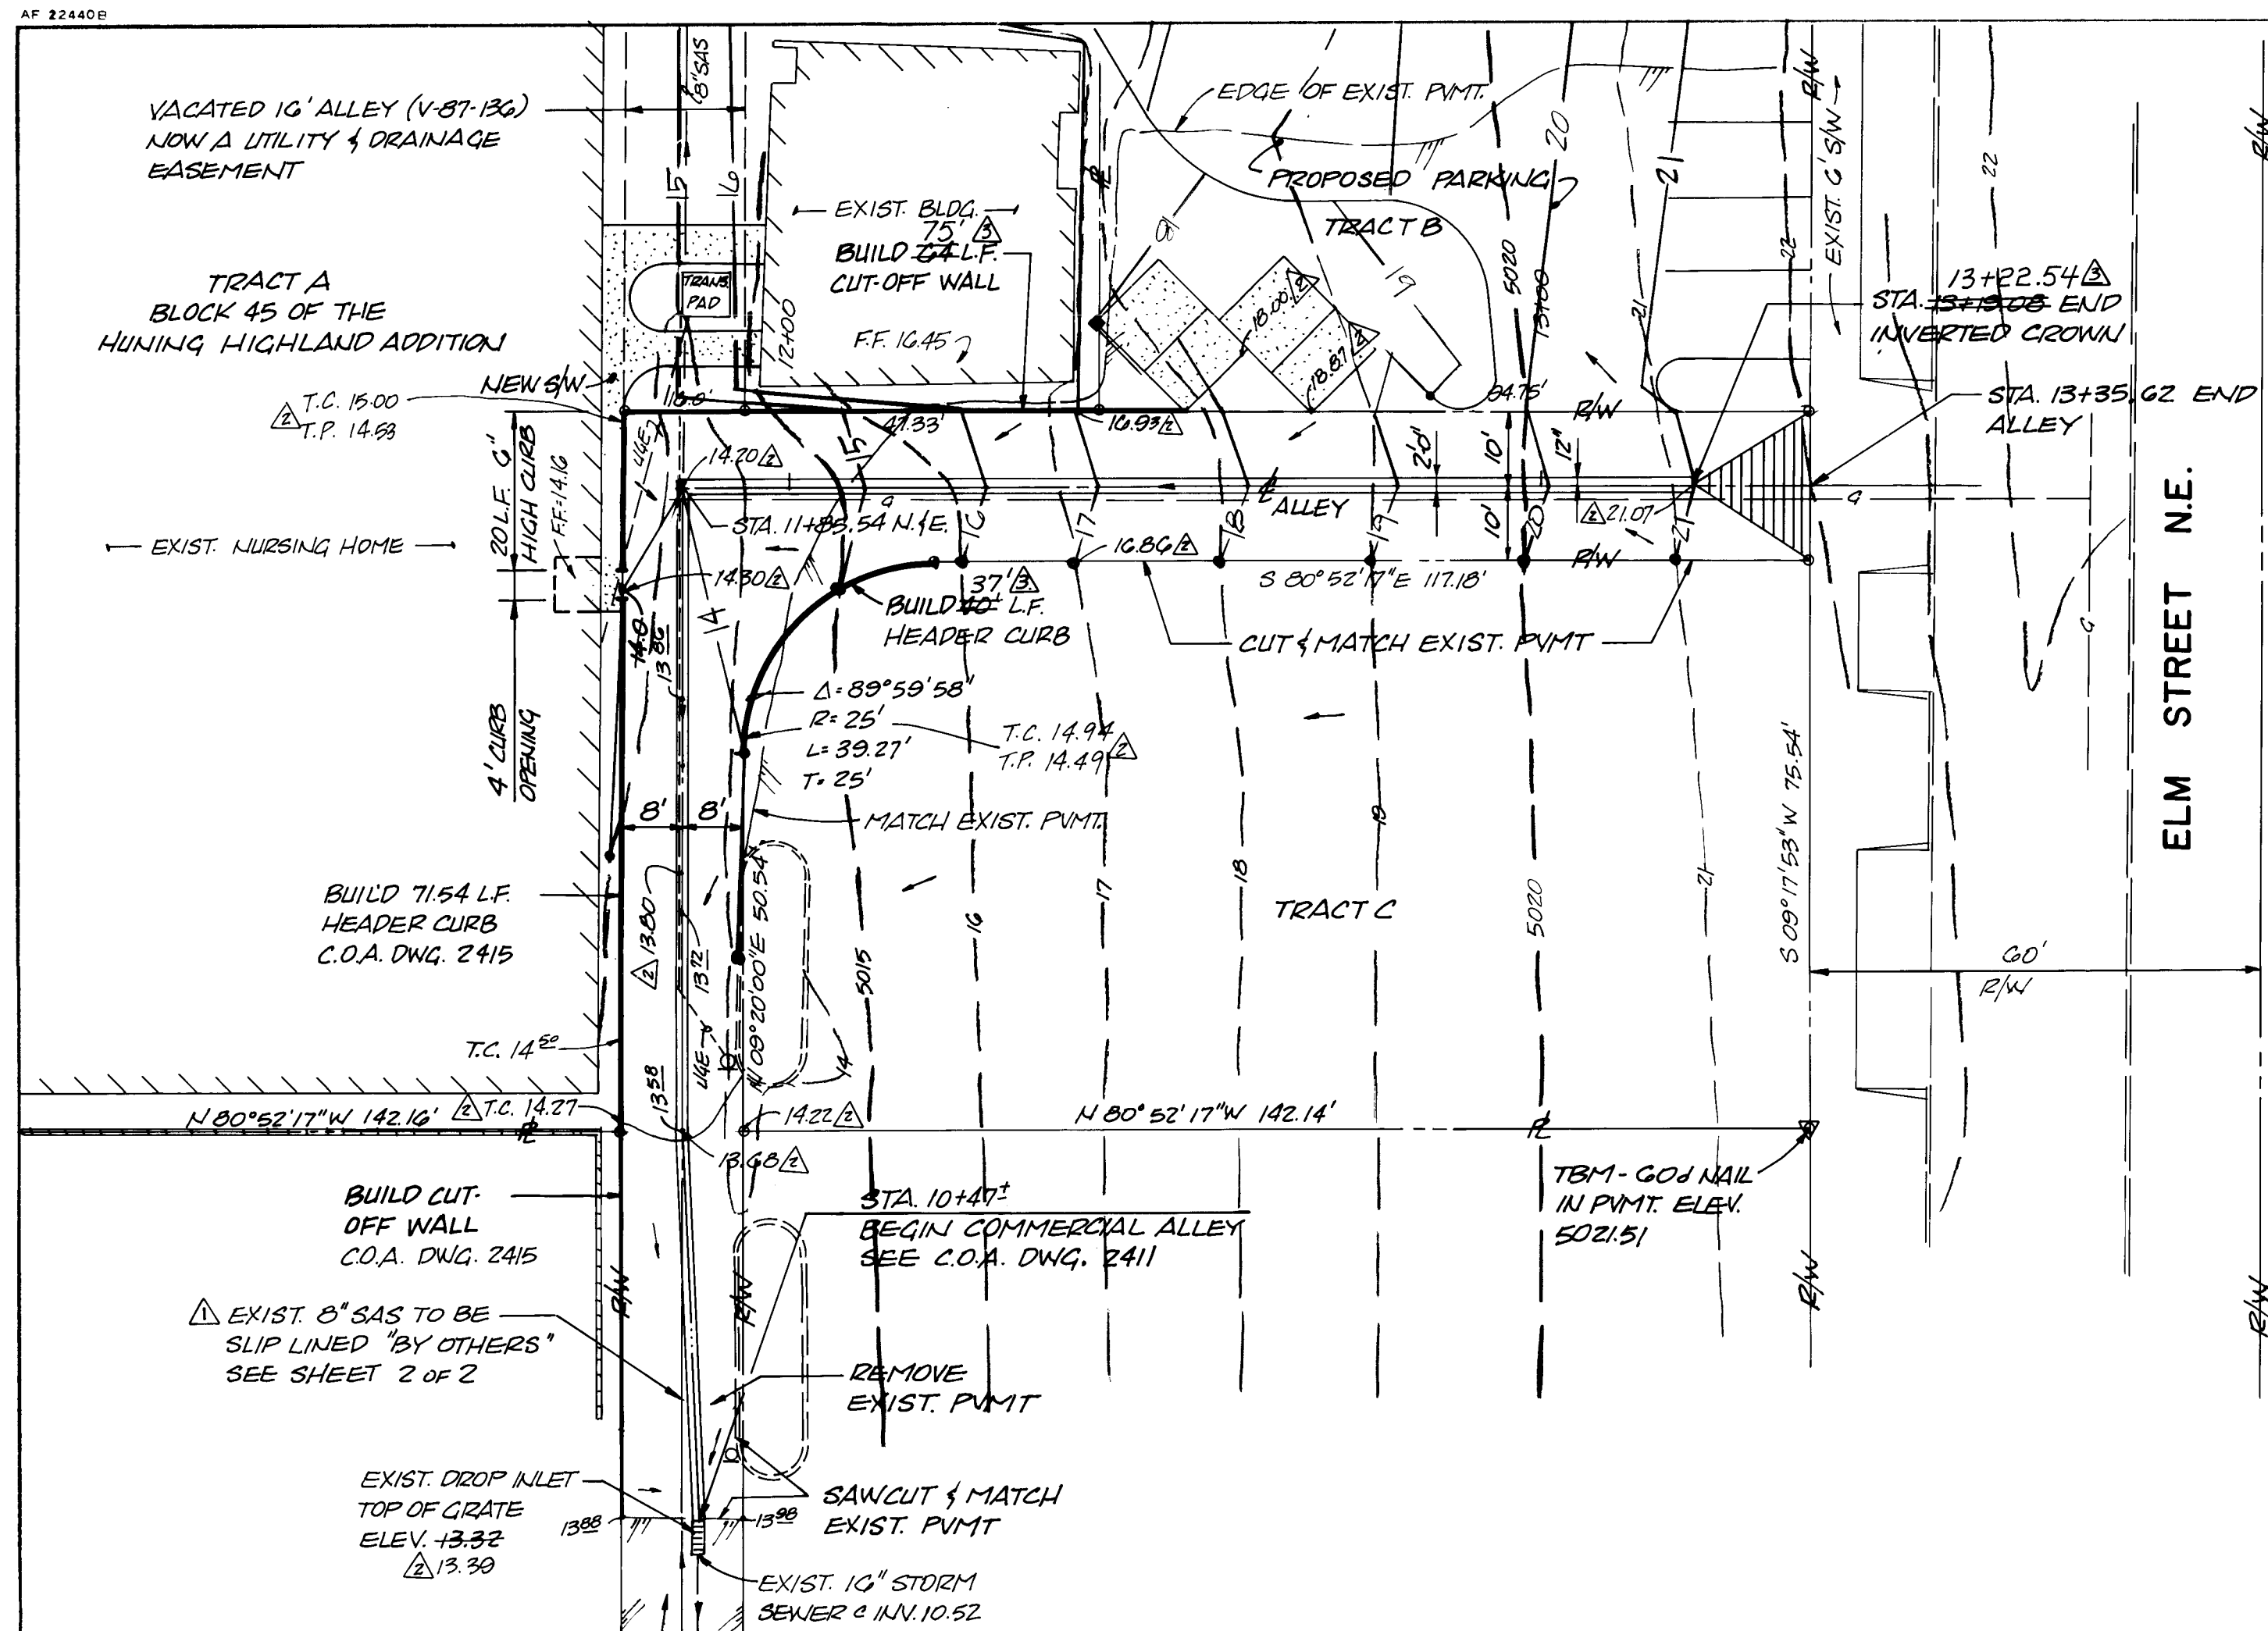
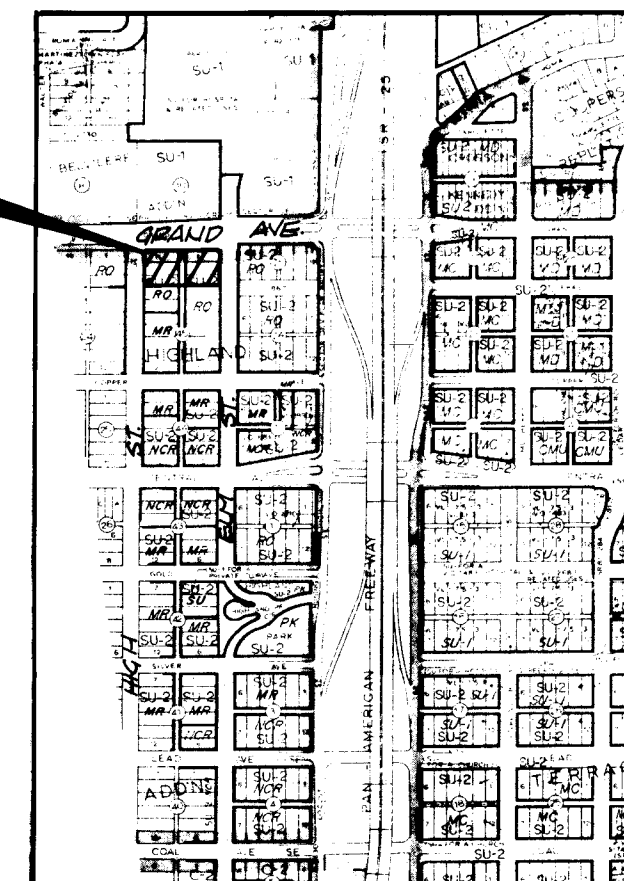



PROJECT
LOCATION

LOCATION MAP K-15

TRAFFIC CONTROL

Three (3) working days prior to beginning construction the Contractor shall submit to Traffic Engineering Division a detailed construction schedule. Two (2) working days prior to construction the Contractor shall obtain a barricading permit from the Traffic Engineering Division. Contractor shall notify Barricade Engineer (768-2551) prior to occupying an intersection.

SCALE: 1"=20' HORIZ, 1"=5' VERT.

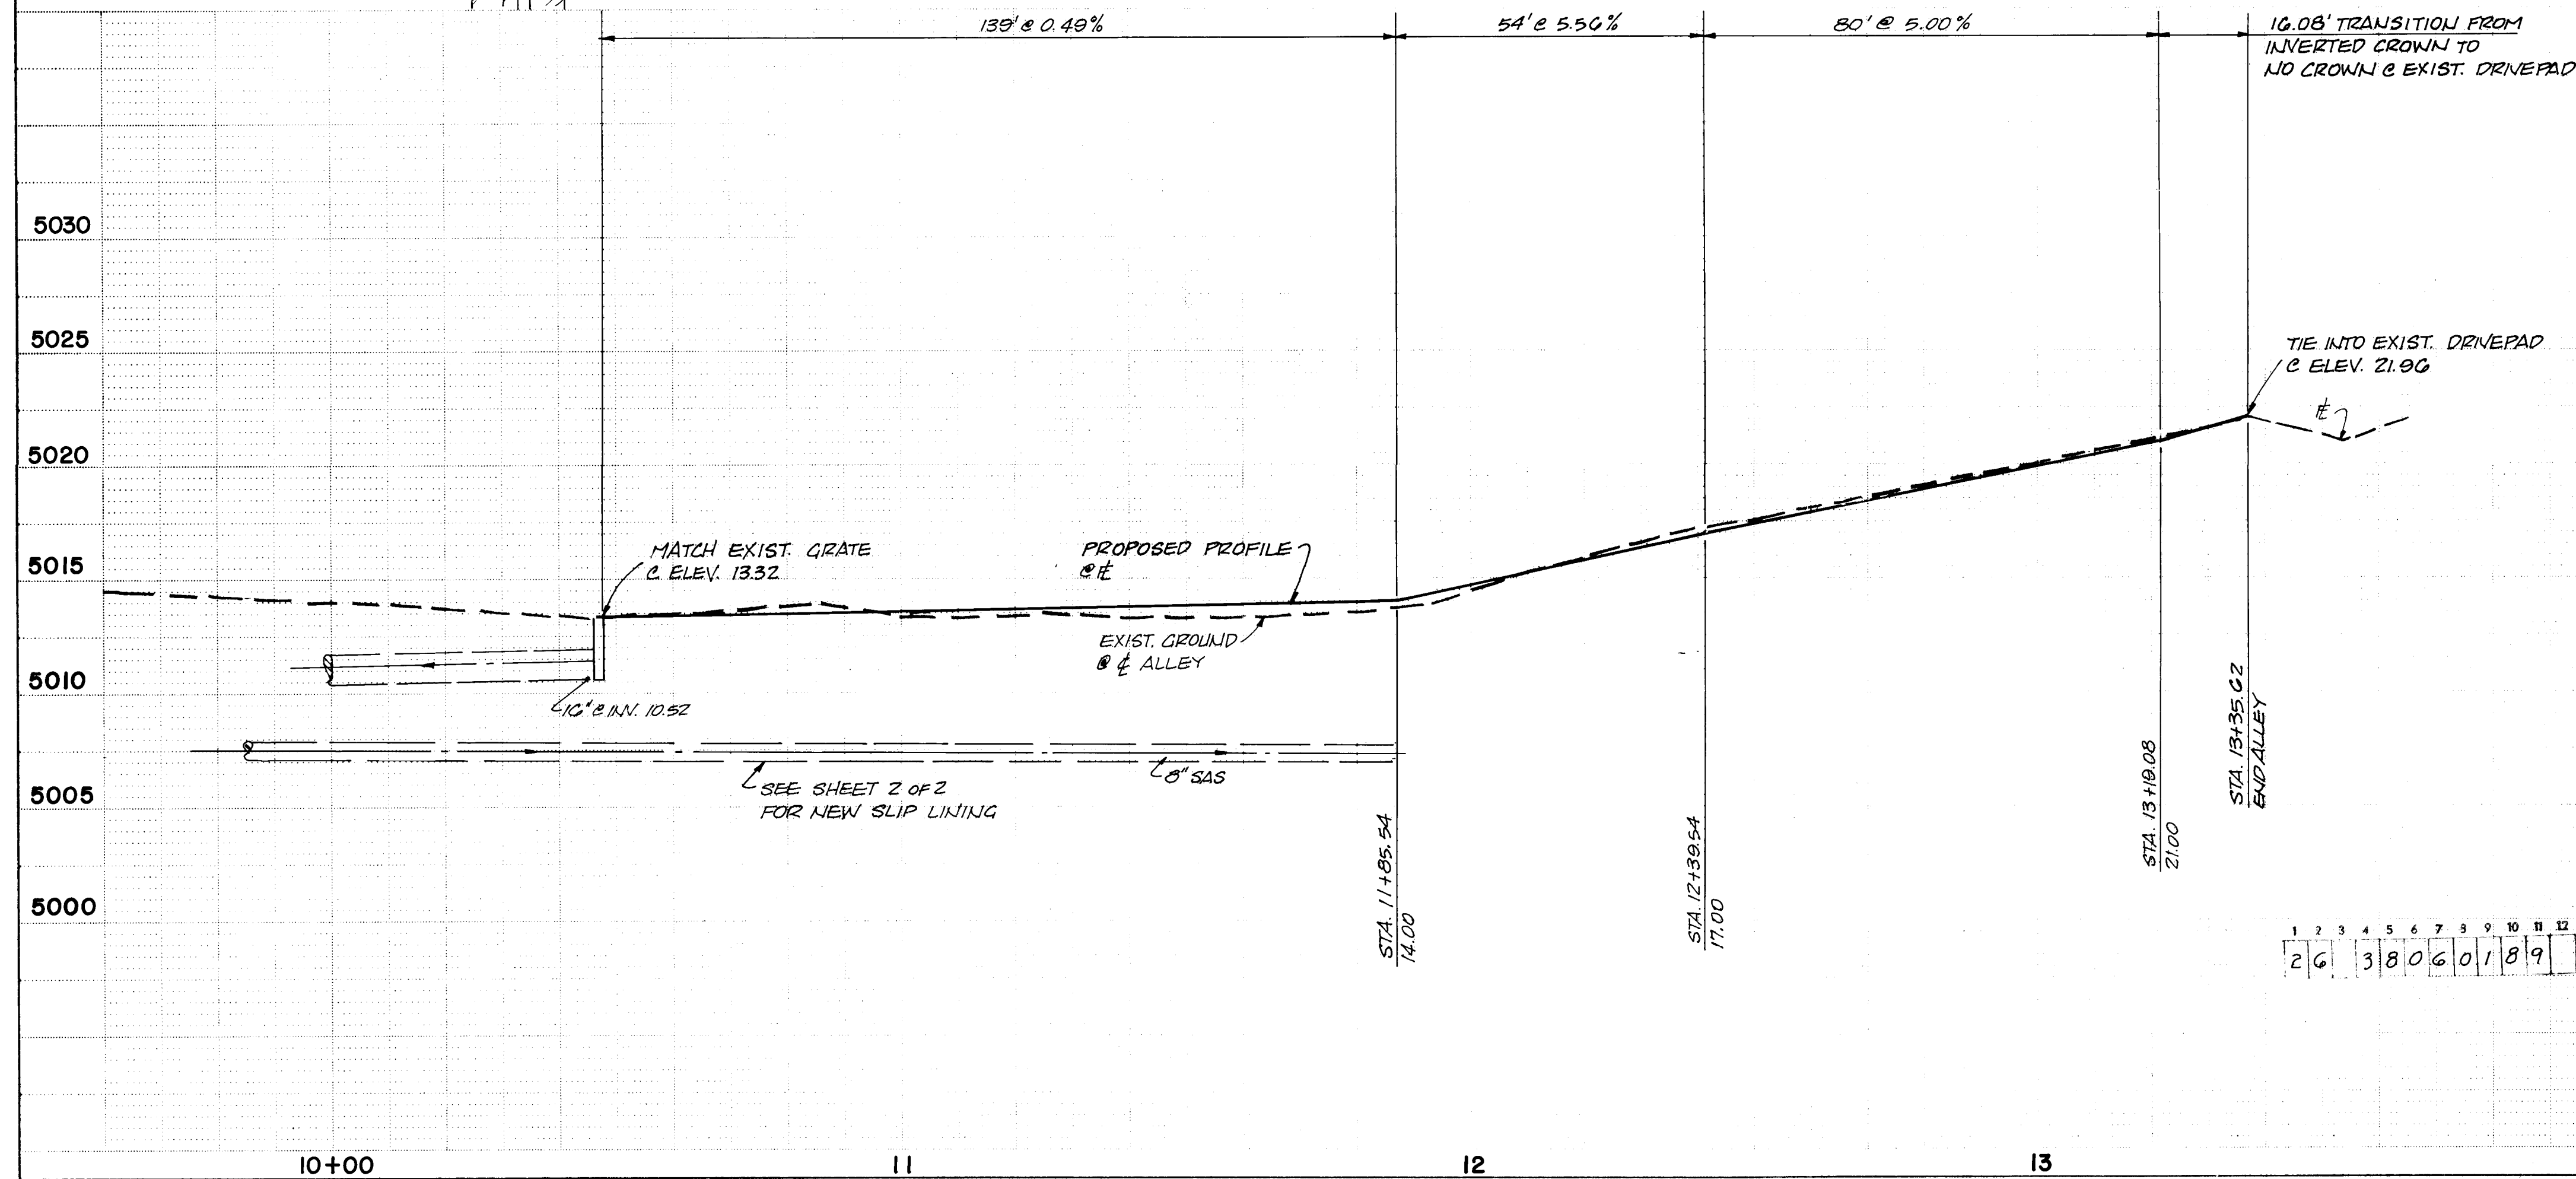APPROVAL OF AS BUILT DRAWINGS
CHIEF CONSTRUCTION ENGINEER
[Signature]
DATE 8-21-89

GENERAL NOTES

- ALL WORK DETAILED ON THESE PLANS TO BE PERFORMED UNDER CONTRACT SHALL, EXCEPT AS OTHERWISE STATED OR PROVIDED FOR HEREON, BE CONSTRUCTED IN ACCORDANCE WITH THE NEW MEXICO STANDARD SPECIFICATIONS FOR PUBLIC WORKS CONSTRUCTION - 1979 EDITION (REFERRED TO HEREIN AS THE STANDARD SPECIFICATIONS) AND THE "CITY OF ALBUQUERQUE STANDARD SPECIFICATIONS FOR PUBLIC WORKS CONSTRUCTION."
- TWO (2) WORKING DAYS PRIOR TO ANY EXCAVATION, CONTRACTOR MUST CONTACT LINE LOCATING SERVICE, 765-1234, FOR LOCATION OF EXISTING UTILITIES.
- PRIOR TO CONSTRUCTION, THE CONTRACTOR SHALL EXCAVATE AND VERIFY THE HORIZONTAL AND VERTICAL LOCATIONS OF ALL OBSTRUCTIONS. SHOULD A CONFLICT EXIST, THE CONTRACTORS SHALL NOTIFY THE ENGINEER OR SURVEYOR SO THAT THE CONFLICT CAN BE RESOLVED WITH MINIMUM AMOUNT OF DELAY.
- THE CONTRACTOR SHALL CLEAN ANY AND ALL DEBRIS WHICH MAY FALL INTO THE EXISTING STORM SEWER SYSTEM DURING CONSTRUCTION.

LEGEND

$\overline{P}$	PROPERTY LINE
R/W	RIGHT OF WAY LINE
S/W	SIDEWALK
DWG.	DRAWING
L.F.	LINEAL FEET
---17---	EXISTING CONTOURS
---17---	PROPOSED CONTOURS
$\overline{E}$	FLOW LINE
$\overline{C}$	CENTER LINE
FF	FINISH FLOOR
C.O.A.	CITY OF ALBUQUERQUE
T.C.	TOP OF CURB
P.V.M.T.	PAVEMENT

RECORD DRAWING

DATE 8/2/89
BY W. E.

REV.	By	Date
1	W. E.	6/26/89

APPROVED FOR CONSTRUCTION

[Signature]
CITY ENGINEER
6/26/89

BOVAY/McGINTY INC.

CITY OF ALBUQUERQUE
PUBLIC WORKS DEPARTMENT
ENGINEERING DIVISIONTITLE: HORIZON NURSING CENTER
ALLEY IMPROVEMENTS
PLAN AND PROFILE

APPROVALS	ENGINEER	DATE	APPROVALS	ENGINEER	DATE
City Engineer	<i>[Signature]</i>	5/31/89	Liquid Waste	PEAO	5/31/89
A C E - Design	"	"	Traffic	<i>[Signature]</i>	5/31/89
A C E - Hydrology	"	"	Water	PEAO	5/31/89

DRAWING NO.	3806	MAP NO.	K-15	SHEET	1	OF	2
-------------	------	---------	------	-------	---	----	---

AS BUILT INFORMATION		BENCH MARKS		SURVEY INFORMATION		ENGINEER'S SEAL		REVISIONS		DESIGN		
CONTRACTOR	GERALD MARTIN CONSULTING			FIELD NOTES								
INSPECTOR	BOVAY/McGINTY INC.	DATE		BY	DATE							
FIELD	AS BUILT BY C. SPENCE	DATE	8/2/89	10283	GEORGE MARQUEZ L.H. 12/89							
VERIFICATION BY	DATE			10283	GEORGE MARQUEZ J.R. 9/3/89							
CORRECTED BY BOVAY/McGINTY		DATE	8/2/89	AND I-25 ELEV. 5008.80								
MICRO-FILM INFORMATION		RECORDED BY										
		DATE										
		NO										

1. ALL SLIP LINING WORK TO BE PERFORMED IN ACCORDANCE WITH STS-3 (PROPOSED CITY OF ALBUQUERQUE STANDARD SPECIFICATION 930, SLIP LINING).
2. ALL PROPOSED ALLEY PAVEMENT IMPROVEMENTS ARE NOT SHOWN, SEE SHEET 1 OF 1 (ALLEY PLAN AND PROFILE).
3. LOCATION OF SERVICE CONNECTIONS WILL BE BY CONTRACTOR AND WILL BE SHOWN ON AS - BUILTS TO BE PROVIDED TO THE CITY OF ALBUQUERQUE.

STATION

STATION
8+81.90
9+18.50
9+29.50
11+14.50
11+33.70
11+65.30
11+97.90
12+08.00
12+10.00
12+15.80
12+45.60
12+74.20

DATE 8/2/89
BY J. N. L.

26 38060289

CITY OF ALBUQUERQUE
PUBLIC WORKS DEPARTMENT
ENGINEERING DIVISION

APPROVALS	ENGINEER	DATE	APPROVALS	ENGINEER	DATE
City Engineer	<i>Page 18</i>	<i>4/27/01</i>	Liquid Waste	<i>W. J. J. J.</i>	<i>6/27/89</i>
A C E - Design	<i>"</i>	<i>"</i>	Traffic	<i>N/A</i>	
A C E - Hydrology	<i>N/A</i>		Water	<i>PCCO</i>	<i>6/27/89</i>

DRAWING NO.	3806	MAP NO.	K-15	SHEET	2	OF	2
-------------	------	---------	------	-------	---	----	---