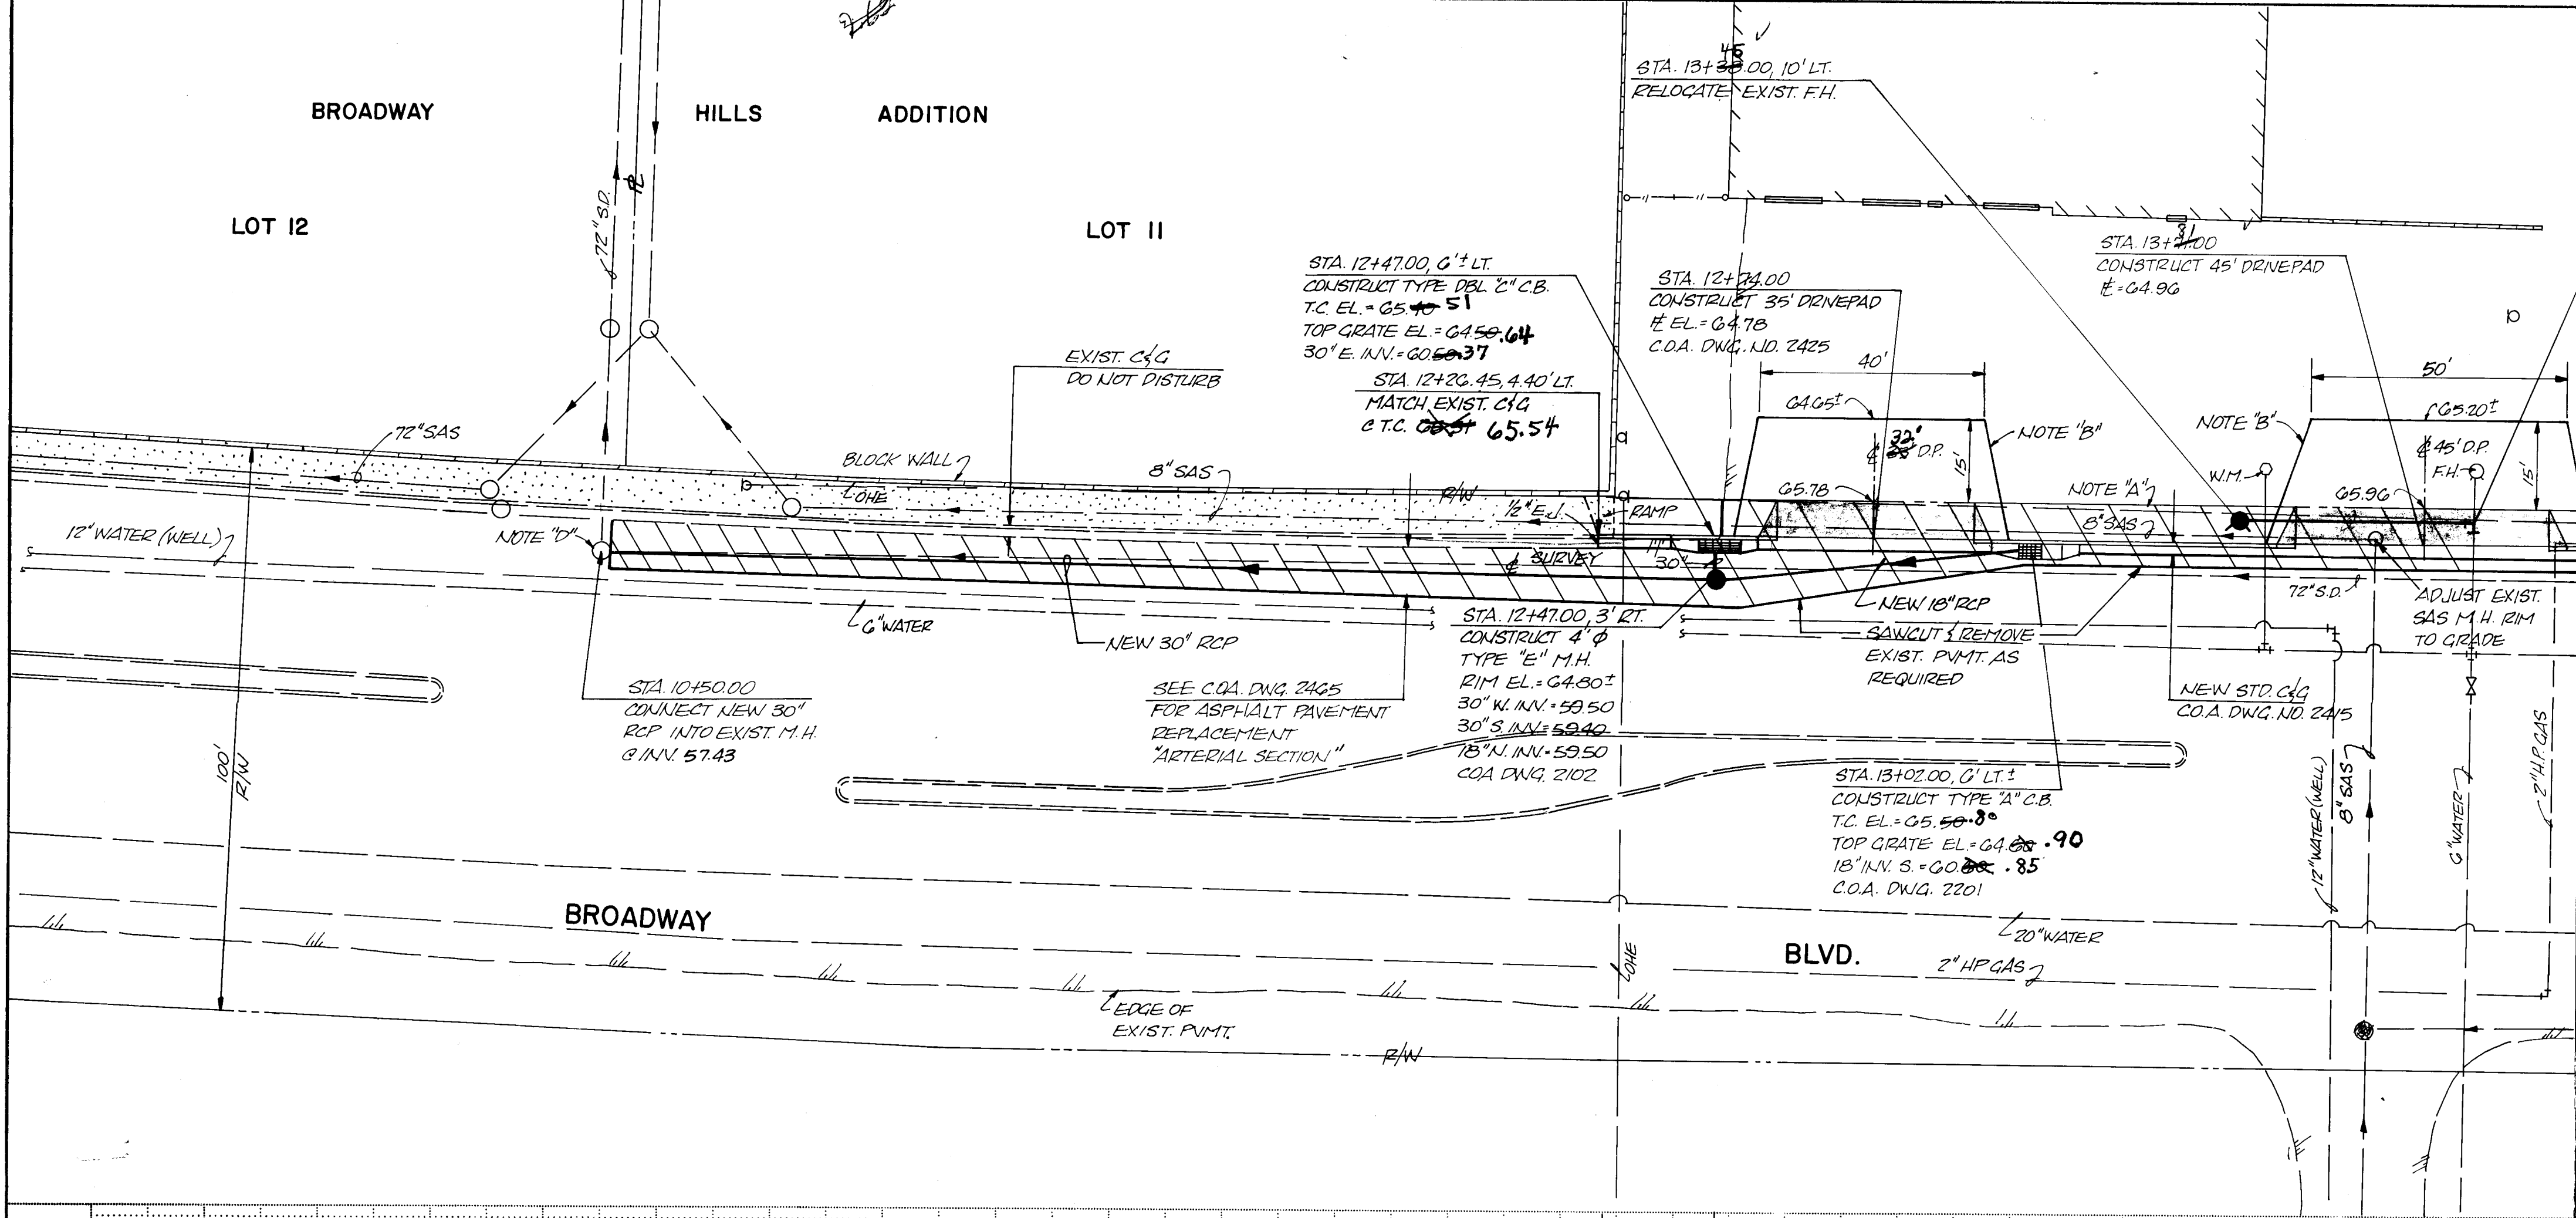


NOTES


- "A" PLACE 2-INCH ASPHALT PAVEMENT TO PROVIDE TRANSITION FROM BACK OF NEW CURB TO TOP OF EXISTING GROUND AT APPARENT R/W LINE.
- "B" PLACE ASPHALT PAVEMENT AS REQUIRED TO PROVIDE TRANSITION FROM BACK OF NEW DRIVEPAD TO EXISTING GROUND AS SHOWN.
- "C" FILL SLOPE TO TRANSITION FROM BACK OF NEW CURB TO EXISTING GROUND AT APPARENT R/W LINE.
- "D" SHOULD THE EXISTING M.H. RING AND COLLAR BE DAMAGED DURING CONSTRUCTION, THE CONTRACTOR WILL REPLACE IT IN ACCORDANCE WITH THE C.O.A. DRAWING 2102.

AS BUILTS

Name: Lenny Fortez
Date: 11-2-87

LR
5-16-91

SCALE: 1"=20' H.C./V.I., 1"=5' VERT.

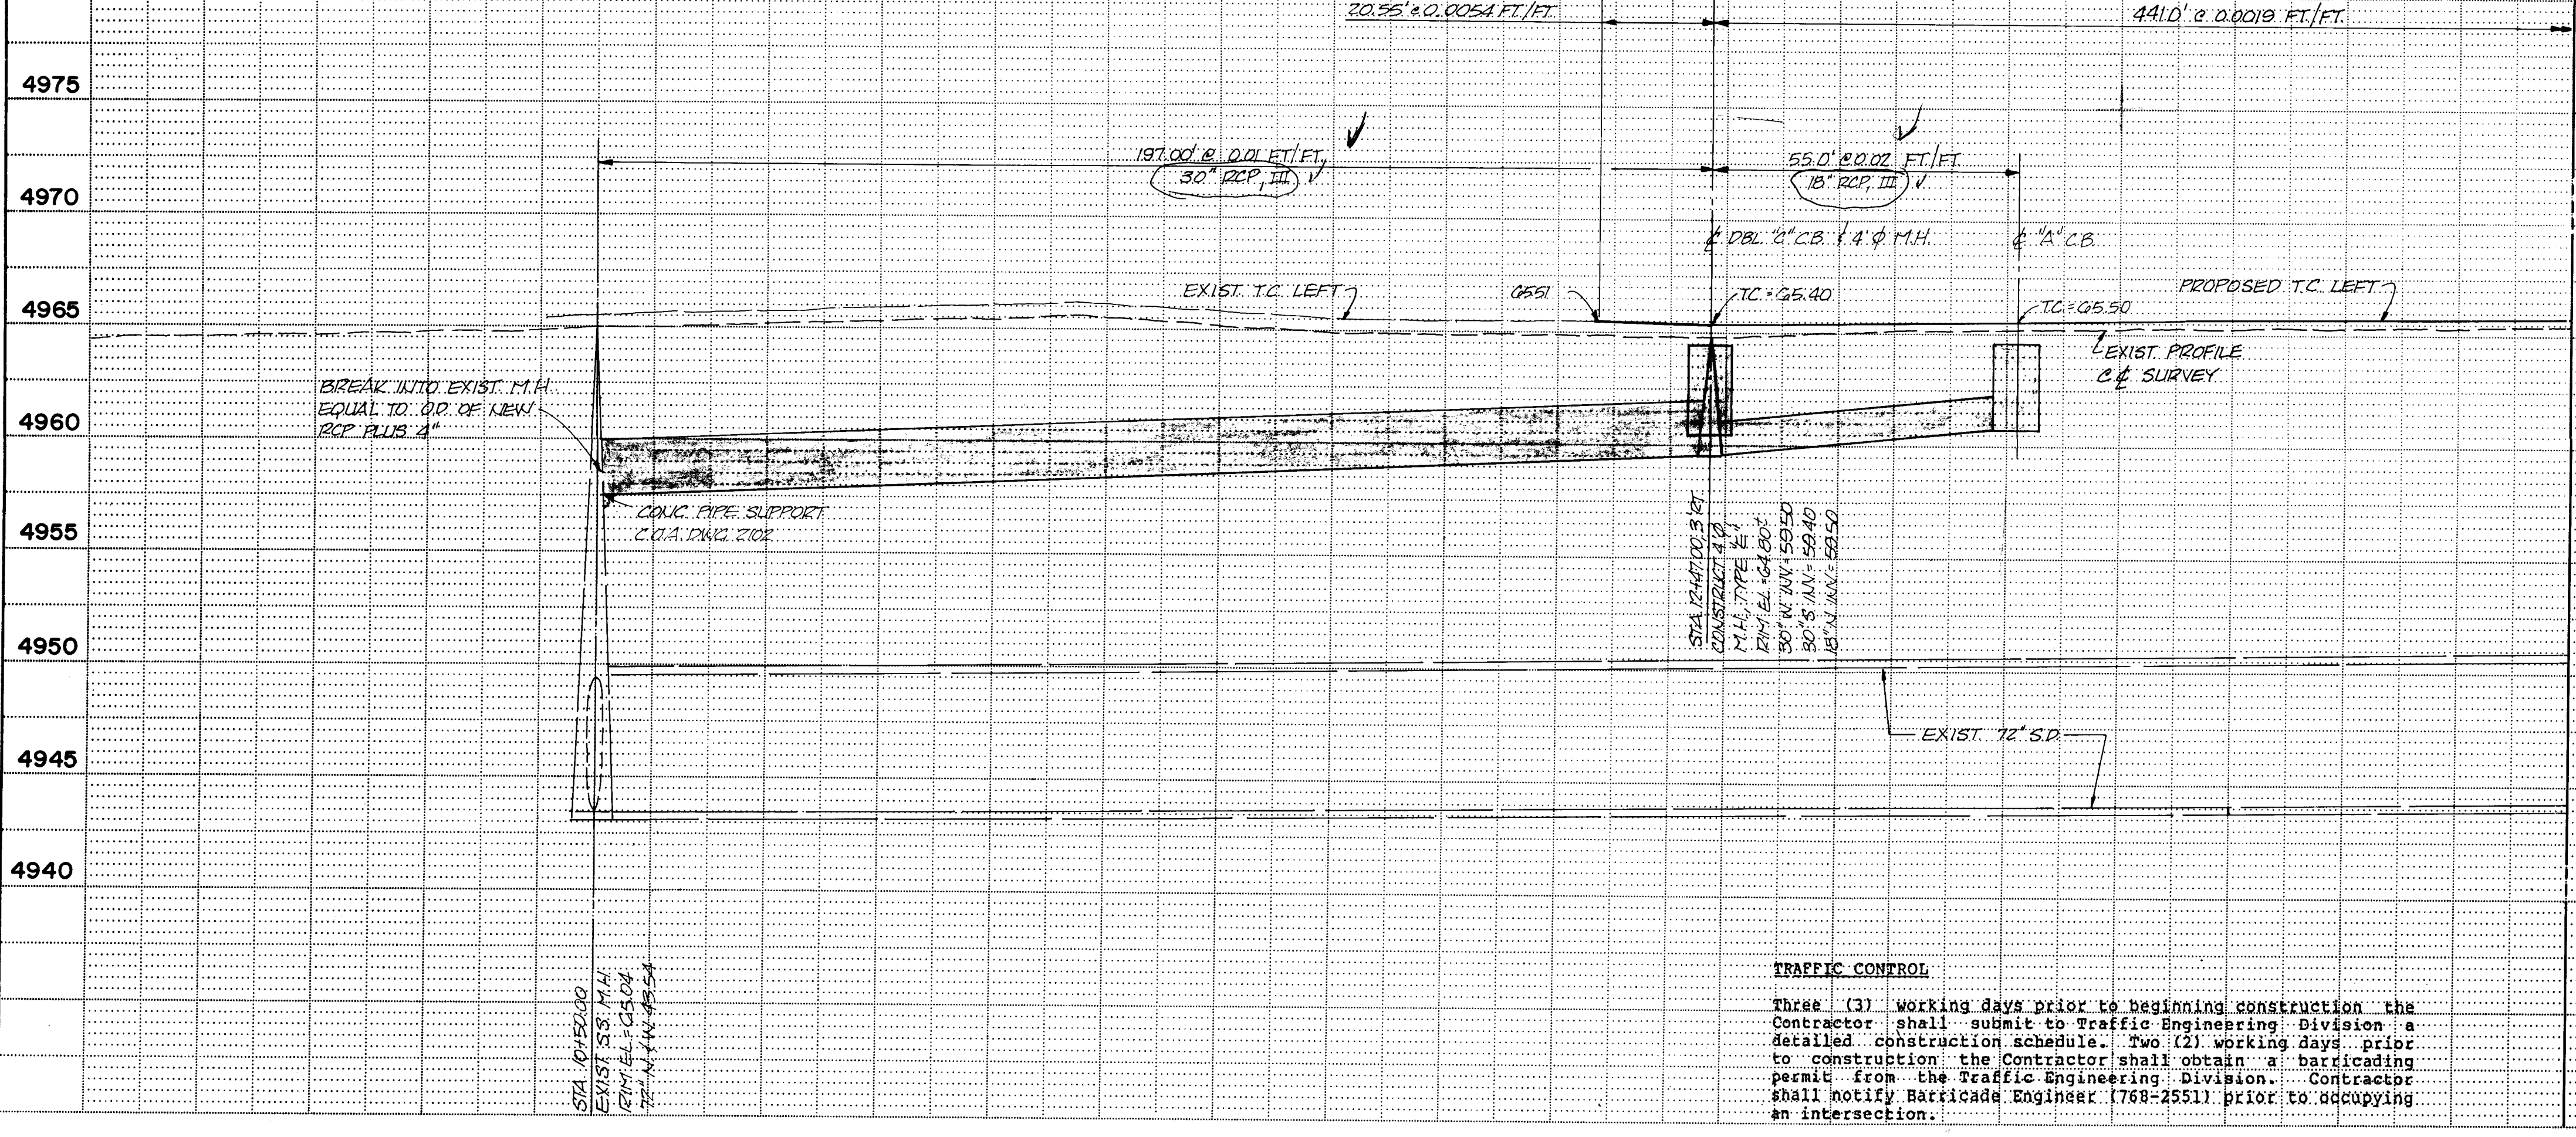


TRAFFIC CONTROL

Three (3) working days prior to beginning construction the Contractor shall submit to Traffic Engineering Division a detailed construction schedule. Two (2) working days prior to construction the Contractor shall obtain a barricading permit from the Traffic Engineering Division. Contractor shall notify Barricade Engineer (768-2551) prior to occupying an intersection.

APPROVAL OF AS BUILT DRAWINGS
CHIEF CONSTRUCTION ENGINEER
DATE: 6/2/91

PROJECT LOCATION

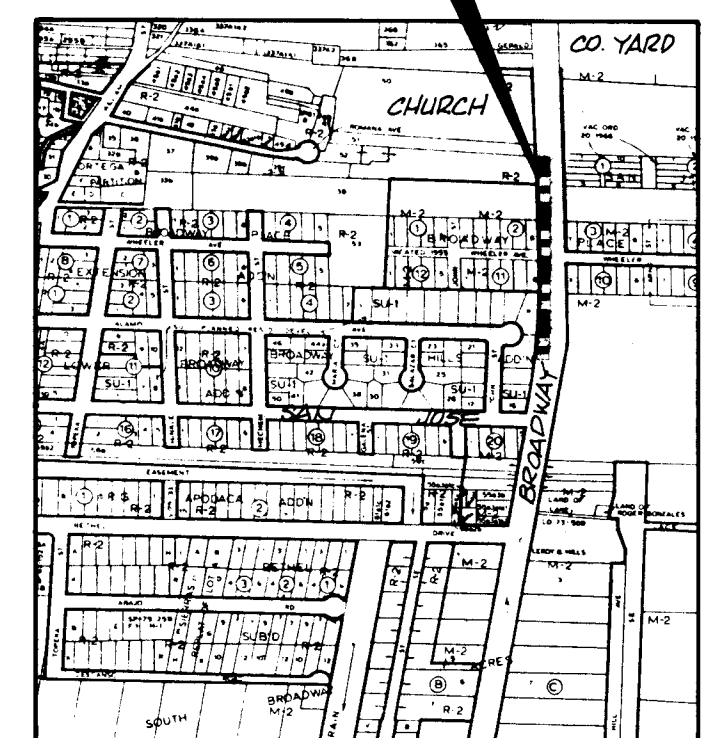

LOCATION MAP M-14

GENERAL NOTES

- THE SPECIFICATIONS USED FOR THIS PROJECT ARE THE "CITY OF ALBUQUERQUE STANDARD SPECIFICATIONS FOR PUBLIC WORKS CONSTRUCTION" AND THE "STANDARD SPECIFICATIONS FOR ROAD AND BRIDGE CONSTRUCTION, NEW MEXICO STATE HIGHWAY AND TRANSPORTATION DEPARTMENT FOR PUBLIC WORKS CONSTRUCTION, 1986 EDITION". SHOULD A CONFLICT ARISE, THE NMSHTD SPECIFICATIONS SHALL GOVERN.
- DISPOSAL OF ALL WASTE MATERIALS SHALL BE IN CITY APPROVED WASTE AREAS SECURED BY AND AT THE EXPENSE OF THE CONTRACTOR.
- ALL EXCAVATIONS FOR THE STORM DRAIN SHALL BE GOVERNED BY FEDERAL, STATE AND LOCAL LAWS, RULES, AND REGULATIONS CONCERNING CONSTRUCTION SAFETY AND HEALTH.
- ALL SIGNS AND CODING WILL BE IN ACCORDANCE WITH THE "MANUAL OF UNIFORM TRAFFIC CONTROL DEVICES FOR STREETS AND HIGHWAYS."
- THE CONTRACTOR IS TO EXERCISE CARE WHEN REMOVING EXISTING PAVEMENT TO AVOID DISTURBING ANY EXISTING UNDERGROUND UTILITIES. IT SHALL BE HIS RESPONSIBILITY TO COORDINATE WITH THE UTILITY COMPANIES IN ORDER TO PREVENT ANY SERVICE DISRUPTION.
- ALL DRAINAGE FACILITIES SHALL REMAIN OPERATIONAL THROUGHOUT THE DURATION OF THE PROJECT.
- IT SHALL BE THE CONTRACTOR'S RESPONSIBILITY TO COORDINATE WITH THE GAS COMPANY OF NEW MEXICO FOR THE POSSIBLE RELOCATION OF THE EXISTING 2-INCH GAS LINE.
- THE EXISTING UTILITIES ARE SHOWN IN THEIR APPROXIMATE LOCATIONS ONLY. IT IS THE CONTRACTOR'S RESPONSIBILITY TO VERIFY THE LOCATIONS OF ALL UTILITIES.
- THE CONTRACTOR WILL CLEAN ANY AND ALL DEBRIS WHICH MAY FALL INTO THE EXISTING STORM SEWER SYSTEM DURING CONSTRUCTION.

1 2 3 4 5 6 7 8 9 10 11 12
26 38 30 19 11

APPROVED FOR CONSTRUCTION
CITY ENGINEER DATE: 9/13/89

BOVAY/McGINTY INC.

CITY OF ALBUQUERQUE
MUNICIPAL DEVELOPMENT DEPARTMENT
ENGINEERING DIVISION

TITLE: SOUTH BROADWAY DRAINAGE IMPROVEMENTS
PLAN & PROFILE STA. 10+00 TO STA. 14+00


APPROVALS	ENGINEER	DATE	APPROVALS	ENGINEER	DATE
City Engineer	<u>Lenny Fortez</u>	<u>9/14/89</u>	Liquid Waste	<u>N/A RWK</u>	<u>9-14-89</u>
A.C.E. - Design	<u>C.H.M.</u>	<u>9/14/89</u>	Traffic	<u>N/A RWK</u>	<u>9-14-89</u>
A.C.E. - Hydrology	<u>Lenny Fortez</u>	<u>9/14/89</u>	Water	<u>N/A RWK</u>	<u>9-14-89</u>

DRAWING NO. 3813 PWC MAP NO. M-14 SHEET 1 OF 2


John M. Moya, P.E.
Hydrology Engineering
965-276
Rm 301

BROADWAY TOWING INC.

SAN JOSE CHURCH

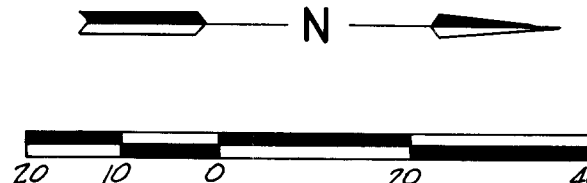

MATCH LINE STA. 14+00

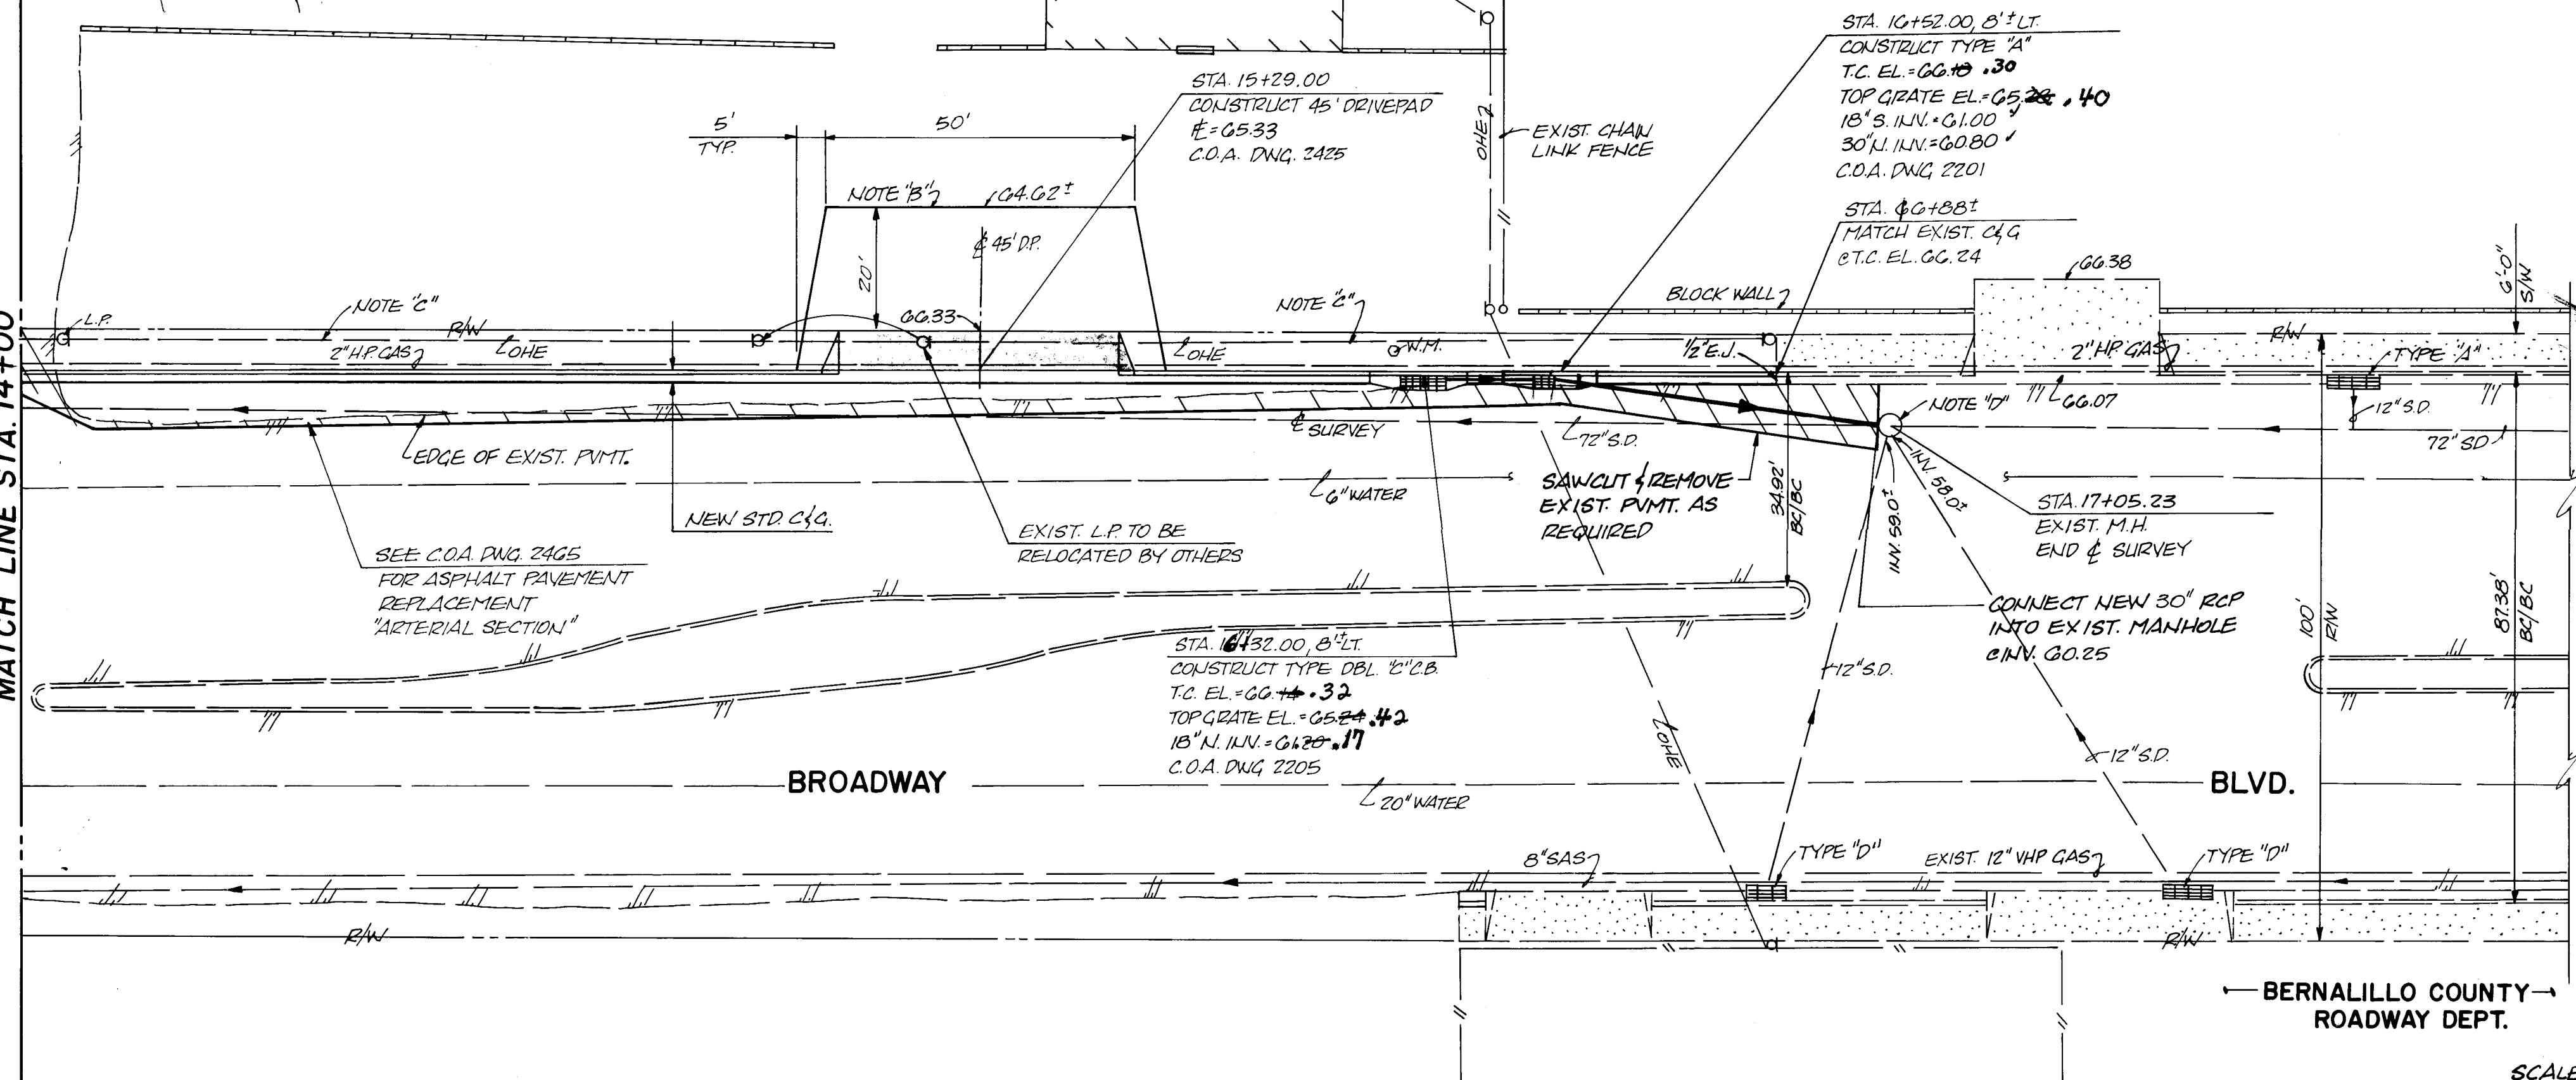

AS BUILTS


Name: Danny Pimentel
Date: 11-2-89

BENCH MARK
"M3612"

- NOTES**
- "A" PLACE 2-INCH ASPHALT PAVEMENT TO PROVIDE TRANSITION FROM BACK OF NEW CURB TO TOP OF EXISTING GROUND AT APPARENT R/W LINE.
 - "B" PLACE ASPHALT PAVEMENT AS REQUIRED TO PROVIDE TRANSITION FROM BACK OF NEW DRIVEPAD TO EXISTING GROUND AS SHOWN.
 - "C" FILL SLOPE TO TRANSITION FROM BACK OF NEW CURB TO EXISTING GROUND AT APPARENT R/W LINE.
 - "D" SHOULD THE EXISTING M.H. RING AND COLLAR BE DAMAGED DURING CONSTRUCTION, THE CONTRACTOR WILL REPLACE IT IN ACCORDANCE WITH THE C.O.A. DRAWING 2102.

LEGEND

- W.M. WATER METER
- F.H. FIRE HYDRANT
- D.P. DRIVE PAD
- FL FLOWLINE
- T.C. TOP OF CURB
- SAS SANITARY OF SEWER
- C.B. CATCH BASIN
- P.P. POWER POLE
- L.P. LIGHT POLE
- R/W APPARENT RIGHT OF WAY
- S.D. STORM DRAIN
- OHE OVERHEAD ELECTRICAL

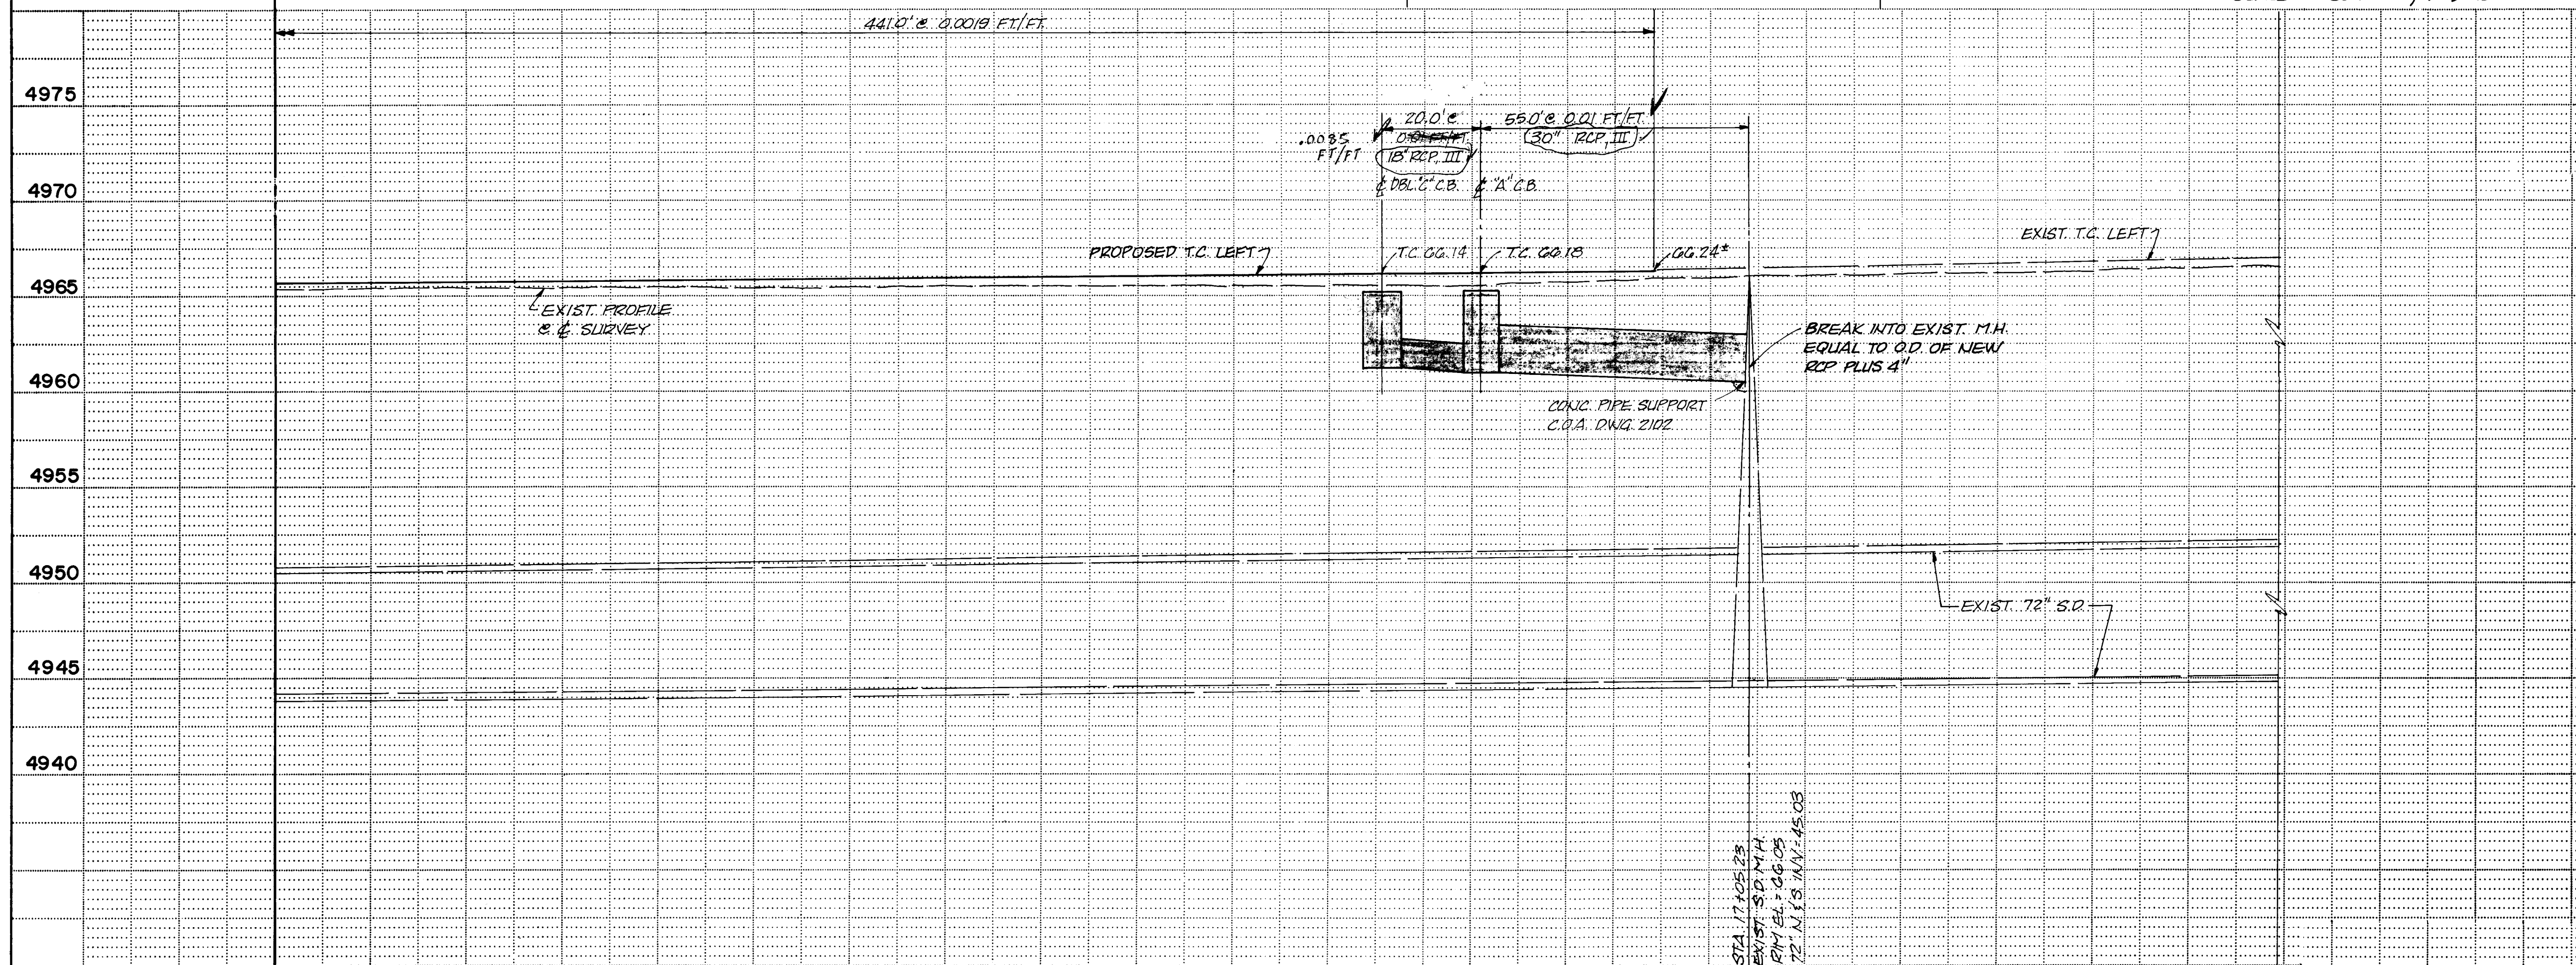

1 2 3 4 5 6 7 8 9 10 11 12
21 32 13 02 9 11

BOVAY/McGINTY INC.

CITY OF ALBUQUERQUE MUNICIPAL DEVELOPMENT DEPARTMENT ENGINEERING DIVISION					
TITLE: SOUTH BROADWAY DRAINAGE IMPROVEMENTS PLAN & PROFILE STA. 14+00 TO STA. 17+05.23					
APPROVALS	ENGINEER	DATE	APPROVALS	ENGINEER	DATE
City Engineer	John M. Moya	9/14/89	Liquid Waste	N/A	RWK 9-14-89
A.C.E. - Design	John M. Moya	9/14/89	Traffic	N/A	RWK 9-14-89
A.C.E. - Hydrology	John M. Moya	9/14/89	Water	N/A	RWK 9-14-89

DRAWING NO.	3813	MAP NO.	M-14	SHEET	2	OF	2
-------------	------	---------	------	-------	---	----	---

SURVEY INFORMATION		BENCH MARKS		AS BUILT INFORMATION	
NO.	5993	FIELD NOTES	ACS BRASS CAP NO. 1113612 LOCATED IN THE CENTER OF THE MEDIAN IN FRONT OF THE BERNALILLO COUNTY ROAD DEPT. YARD	CONTRACTOR	Private Construction
BY	CLINT SHEARILL	DATE	5/89	WORKS BY	C.O.A.
REMARKS		DATE		INSPECTORS	
REVISIONS		DATE		ACCEPTANCE BY	L. 12/12/89
DESIGNED BY	RA	DATE	8/89	VERIFICATION BY	
DRAWN BY	RA	DATE	8/89	DATE	
CHECKED BY	R/C	DATE	8/89	MICRO-FILM INFORMATION	
				RECORDED BY	
				NO	

