


ALLEY IMPROVEMENTS BLOCK 8 ARMIJO BROTHERS ADDITION ALBUQUERQUE, NEW MEXICO

INDEX

SHEET NO.	DESCRIPTION
1	TITLE
2	16' ALLEY PLAN & PROFILE

APPROVAL OF AS BUILT DRAWINGS
CHIEF CONSTRUCTION ENGINEER
James W. Lane
DATE 10-24-96

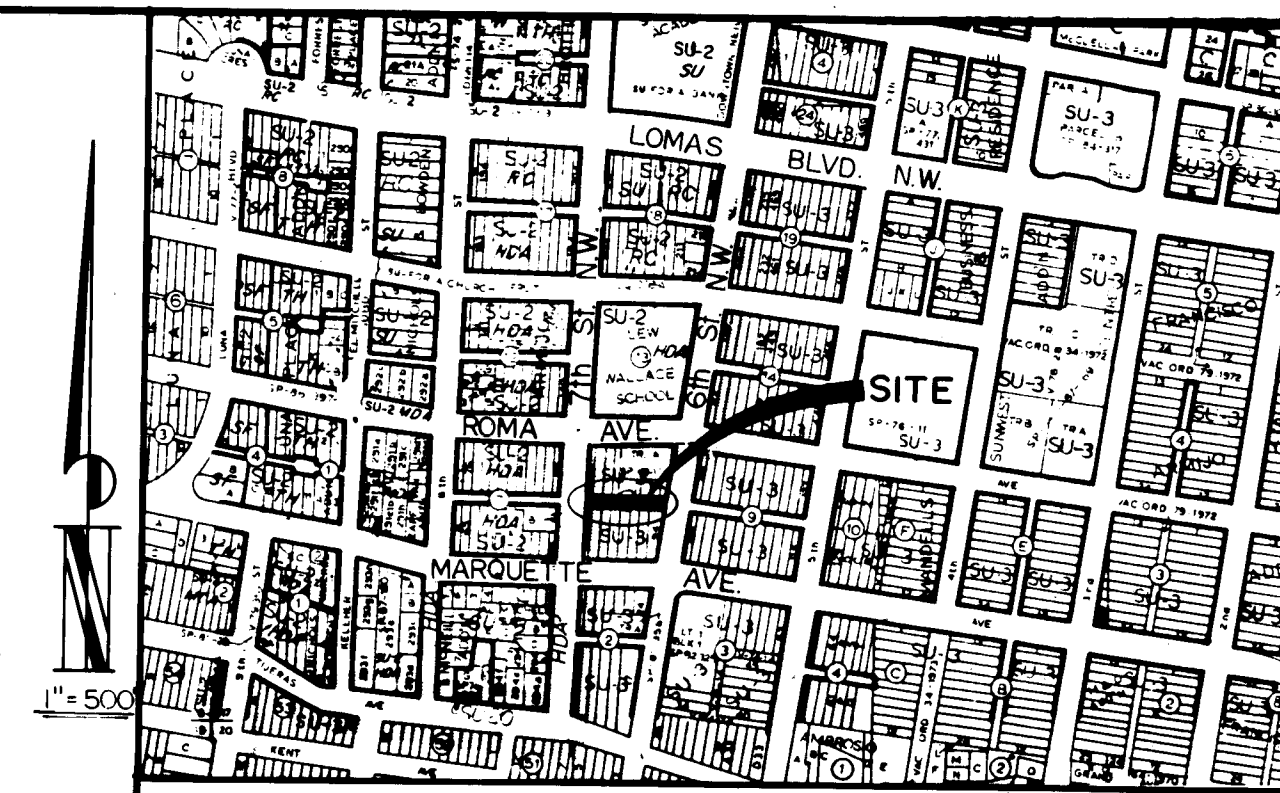

ZONE MAP NO. J-14
VICINITY MAP


GENERAL NOTES

- TWO (2) working days prior to any excavation, contractor must contact Line Locating Service at 765-1234.
- All items shall be constructed in accordance with City of Albuquerque Standard Specifications for Public Works Construction, 1986 (Amendments 1, 2 & 3).
- Contractor shall conform to the City of Albuquerque Standard Dvgs. 2411, 2415 & 2428.
- Contractor shall obtain Barricading Permit from Construction Co-ordination and submit a Traffic Control Plan Three (3) days in advance of starting construction.
- Contractor shall adhere to Section 19 of The City of Albuquerque Standard Specifications for Public Works, 1986. (Amendments 1, 2 & 3)
- Contractor must allow one lane open on Sixth and Seventh Streets N. W. during construction.

26-3824 79196

REV.	SHEETS	CITY ENGINEER	DATE	USER	DEPARTMENT	DATE	USER	DEPARTMENT	DATE
APPROVAL OF REVISIONS									


<i>James W. Lane</i> 2/20/90	LOUIS GROSS & ASSOC., INC. Consulting Civil Engineers 925 6th Street N.W., Suite 3 Albuquerque, N. Mex. 87102 (505) 243-6353	APPROVED FOR CONSTRUCTION
	Built w/ 3824.90 PROJECT NO. 4025.90	C.E. SHEET 1 OF 2

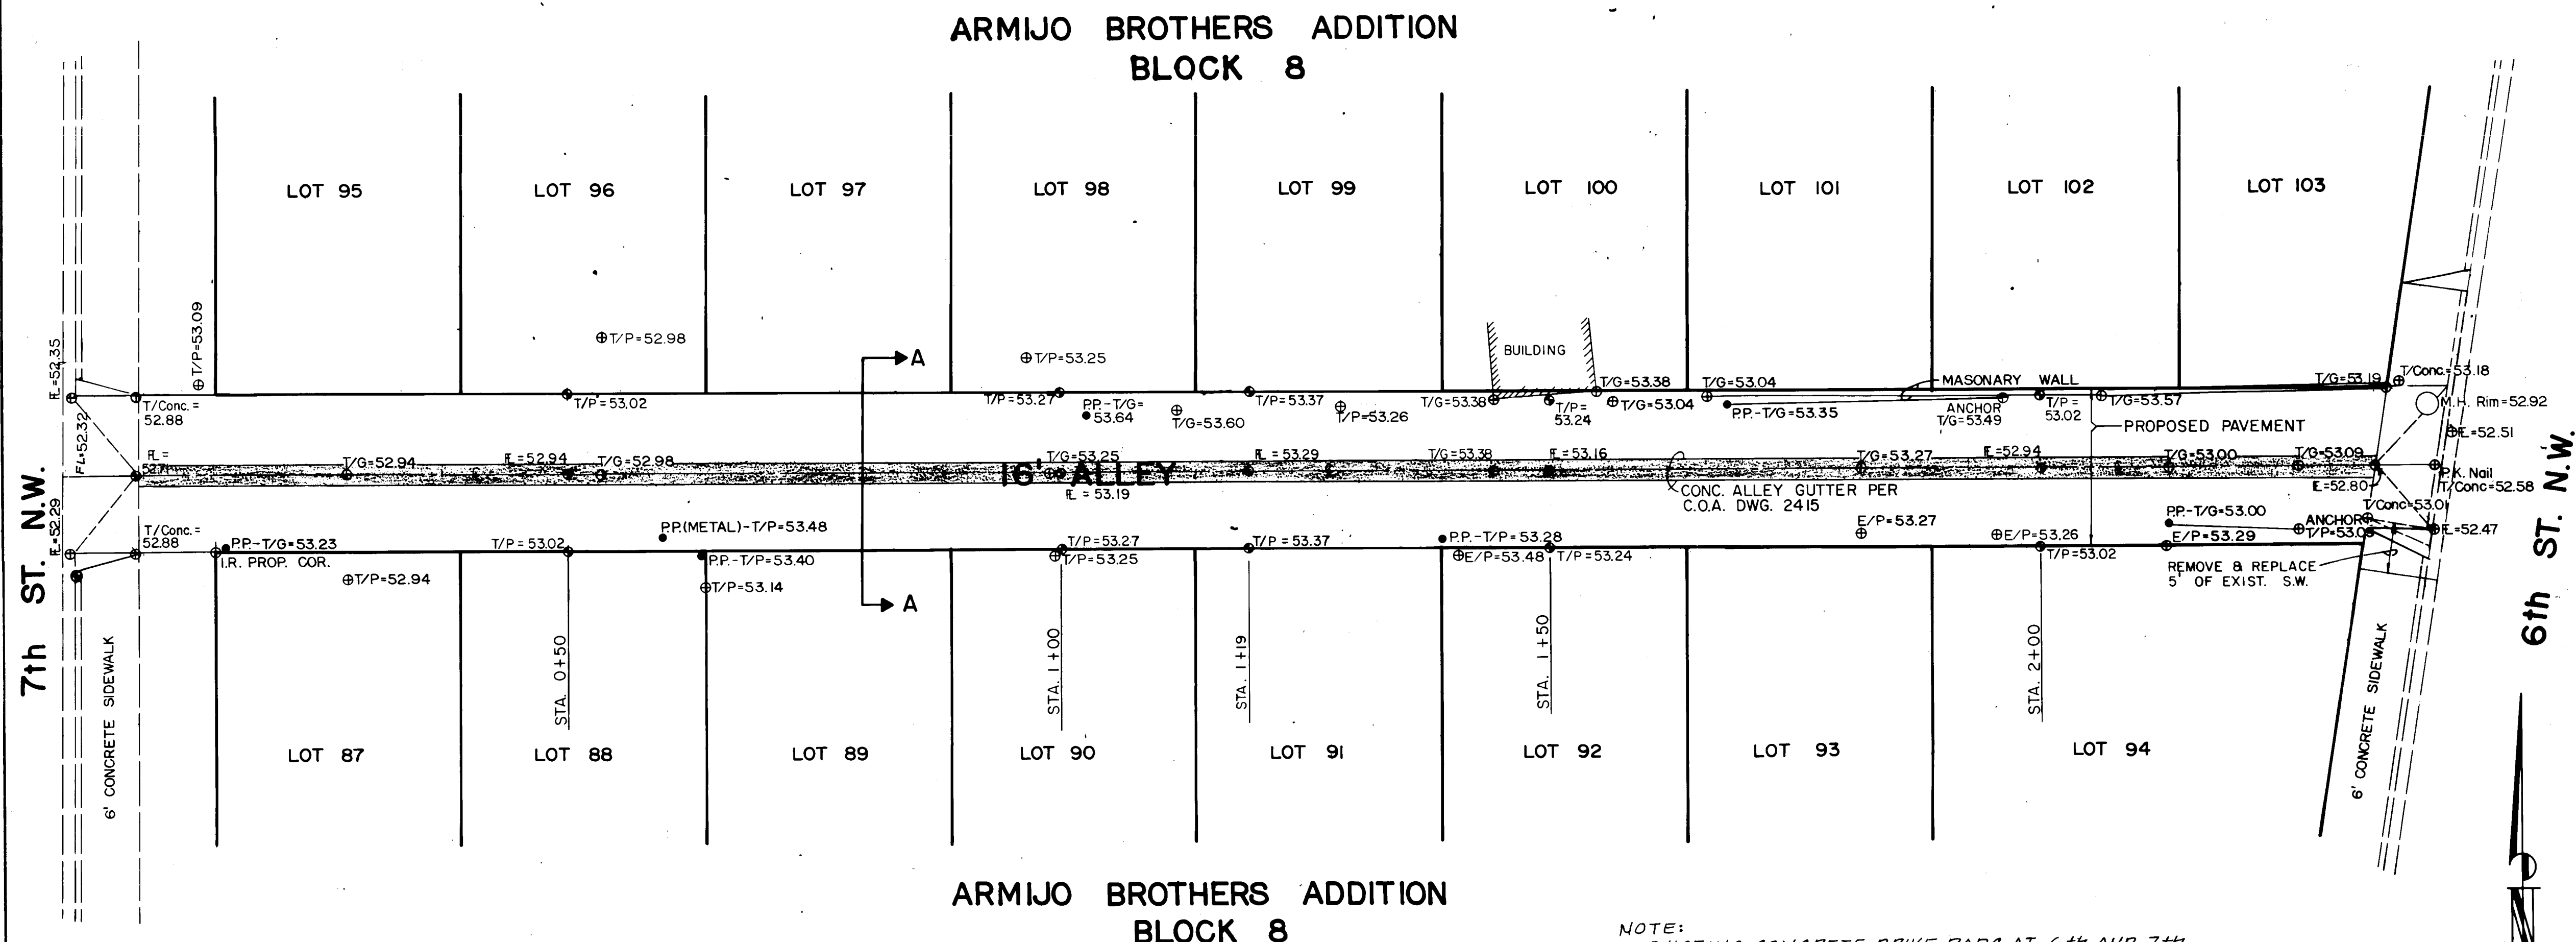


ARMIJO BROTHERS ADDITION
BLOCK 8

ARMIJO BROTHERS ADDITION
BLOCK 8


NOTE:
1. EXISTING CONCRETE DRIVE PADS AT 6TH AND 7TH STREET R & R TO DRAIN ALLEY AND TO MATCH DESIGN ELEVATIONS.
2. RICHARD E. ONEILL, GAS SYSTEM SENIOR TECH FOR FNM GAS SERVICE ON SITE FULL TIME DURING ALLEY CONSTRUCTION DUE TO GAS INFRASTRUCTURE BURIED WITHIN ALLEY RIGHT OF WAY.

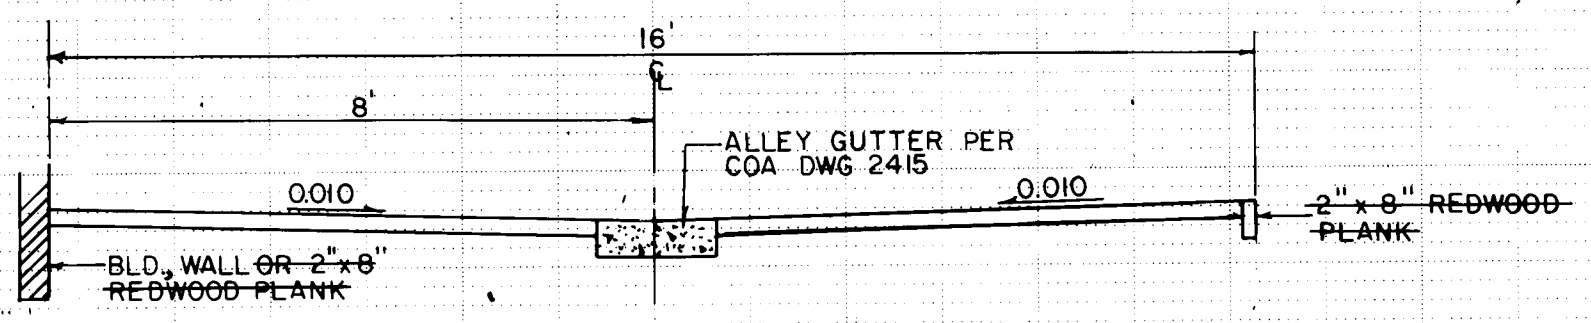

ALLEY SECTION A-A
N.T.S.

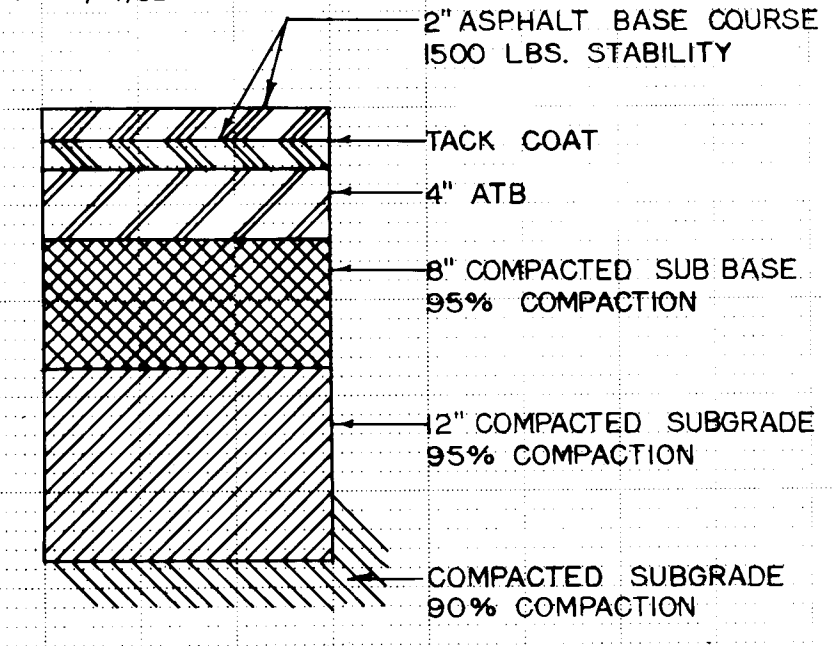

PAVEMENT SECTION
N.T.S.

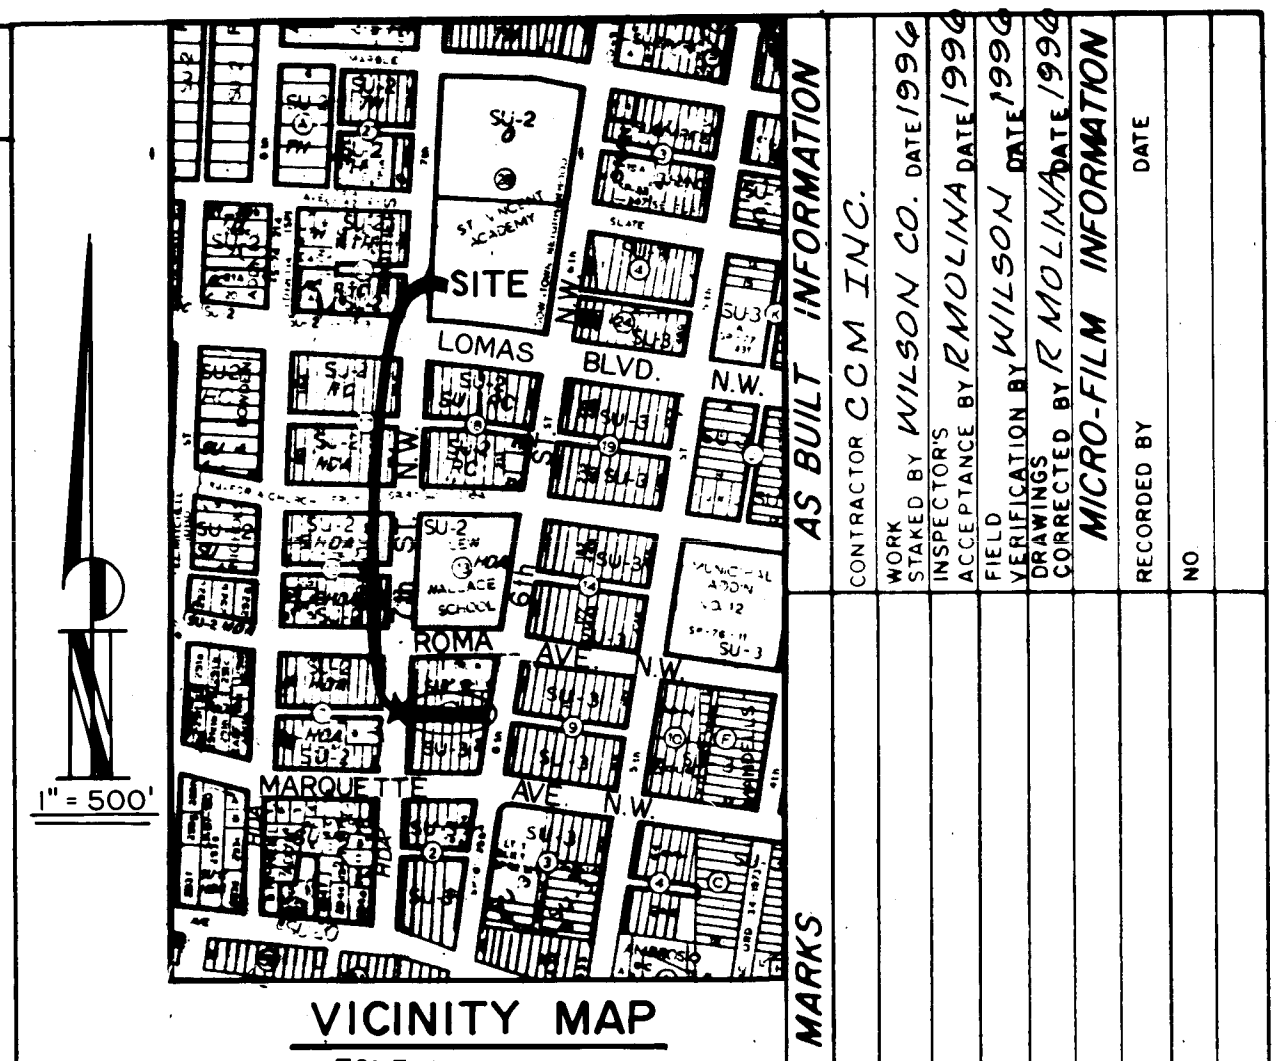


LEGEND

---	EXIST. CURB & GUTTER
---	PROPOSED CURB & GUTTER
---	EXIST. SAS
○	EXIST. MANHOLE
●	EXIST. SPOT ELEVATIONS
●	PROPOSED SPOT ELEVATIONS
T/G	TOP OF GROUND
T/P	TOP OF PAVEMENT
E/P	EDGE OF PAVEMENT
T/Conc.	TOP OF CONCRETE
T/C	TOP OF CURB
E	FLOWLINE GUTTER OR SWALE

GENERAL NOTES

- TWO (2) working days prior to any excavation, contractor must contact Line Locating Service at 765-1234.
- All items shall be constructed in accordance with City of Albuquerque Standard Specifications for Public Works Construction, 1986 (Amendments 1, 2 & 3).
- Contractor shall conform to the City of Albuquerque Standard Dvgs. 2411, 2415 & 2428.
- Contractor shall obtain Barricading Permit from Construction Co-ordination and submit a Traffic Control Plan Three (3) days in advance of starting construction.
- Contractor shall adhere to Section 19 of The City of Albuquerque Standard Specifications for Public Works, 1986. (Amendments 1, 2 & 3)
- Contractor must allow one lane open on Sixth and Seventh Streets N. W. during construction.

AS BUILT INFORMATION		BENCH MARKS		SURVEY INFORMATION		FIELD NOTES		ENGINEER'S SEAL	
CONTRACTOR	DATE	INSPECTOR	DATE	NO.	BY	NO.	BY	NO.	BY
WILSON CO.	1990	WILSON CO.	1990						
WILSON CO.	1990	WILSON CO.	1990						
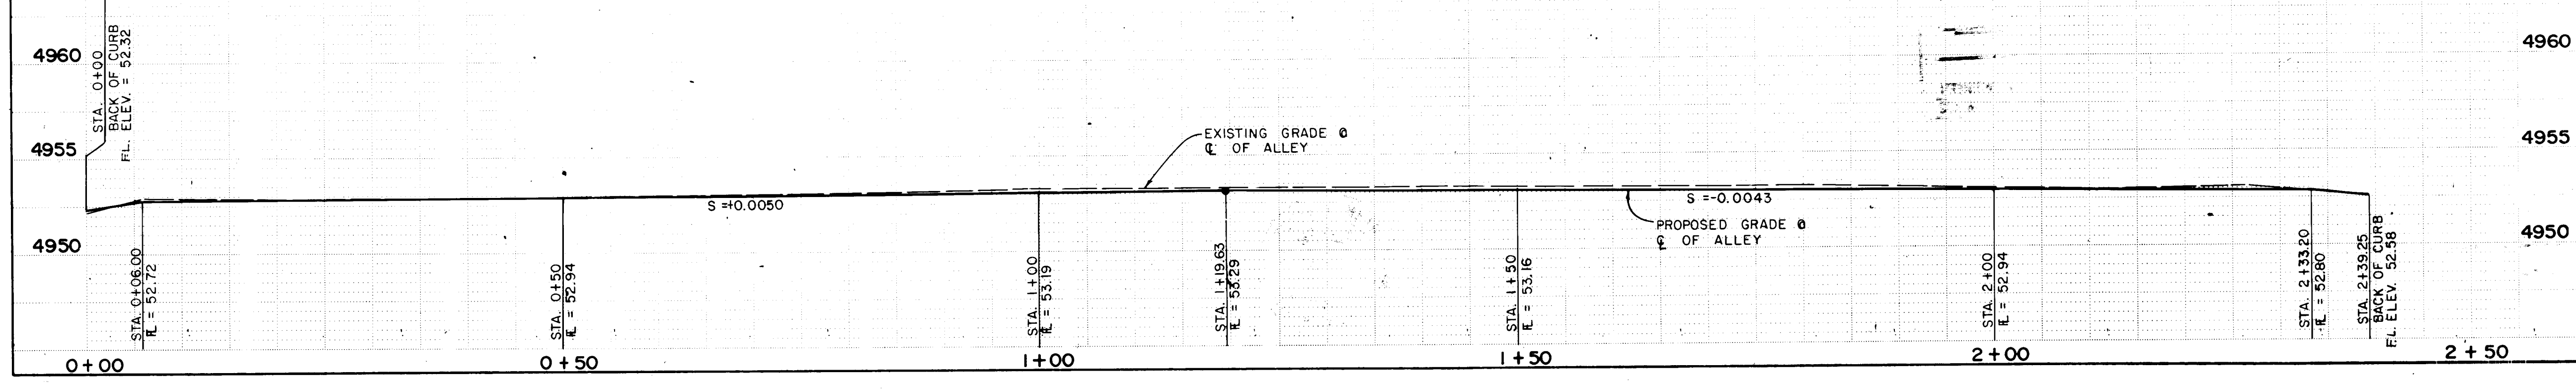

CITY OF ALBUQUERQUE
PUBLIC WORKS DEPARTMENT
ENGINEERING GROUP

TITLE: ALLEY IMPROVEMENTS
BLOCK 8, ARMIJO BROTHERS ADDITION

APPROVALS	ENGINEER	DATE	APPROVALS	ENGINEER	DATE
DRC GHAIK	3/1/90	3/1/90	WATER	R.W. Kane	2-27-90
TRANSPORT	2-27-90	2-27-90	WASTE WATER	R.W. Kane	2-27-90
HYDROLOGY	2-27-90	2-27-90			

PROJECT NO. 4025-90
MAP NO. J-14
SHEET 2 OF 2

DESIGNED BY L.W.G. DATE FEB. 1990
DRAWN BY C.L.L. / C.L.B. DATE FEB. 1990
CHECKED BY L.W.G. DATE FEB. 1990

24-3824 810916

NW ALLEY

SHEET 80 OF 80