


CONSTRUCTION PLANS
FOR
PHASE I
MARKET CENTER WEST
SITE UTILITY EXTENSIONS
ALBUQUERQUE, NEW MEXICO

SHEET NO.	DESCRIPTION
1	TITLE SHEET
2	PLAT
3	WATER DISTRIBUTION AND SANITARY SEWER LAYOUT SHEET
4-6	WATERLINE "A" PLAN AND PROFILE SHEETS
7-9	WATERLINE "C" PLAN AND PROFILE SHEETS
10	WATERLINE "D" AND STORM DRAIN LINE "A"
11-12	SANITARY SEWER LINE "A" PLAN AND PROFILE SHEETS
13	SANITARY SEWER LINE "B" WATERLINE "B" AND STORM DRAIN LINE "B" PLAN AND PROFILE SHEET
14	DETAIL SHEET

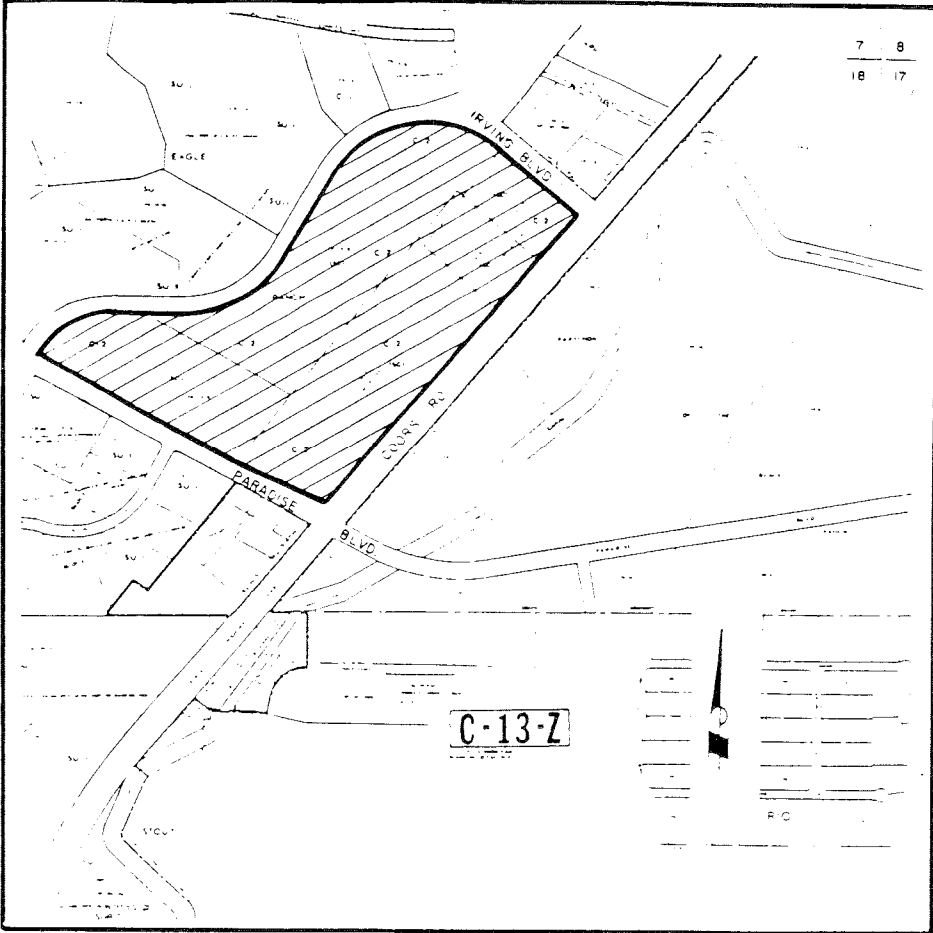

VICINITY MAP
NOT TO SCALE

GENERAL NOTES

NOTICE TO CONTRACTORS

- ALL WORK DETAILED ON THESE PLANS TO BE PERFORMED UNDER CONTRACT SHALL, EXCEPT AS OTHERWISE STATED OR PROVIDED FOR HEREON, BE CONSTRUCTED IN ACCORDANCE WITH CITY OF ALBUQUERQUE INTERIM STANDARD SPECIFICATIONS PUBLIC WORKS CONSTRUCTION, 1985 EDITION.
- TWO WORKING DAYS PRIOR TO ANY EXCAVATION, CONTRACTOR MUST CONTACT LINE LOCATING SERVICE, 765-1234, FOR LOCATION OF EXISTING UTILITIES.
- PRIOR TO CONSTRUCTION, THE CONTRACTOR SHALL EXCAVATE AND VERIFY THE HORIZONTAL AND VERTICAL LOCATIONS OF ALL OBSTRUCTIONS. SHOULD A CONFLICT EXIST, THE CONTRACTOR SHALL NOTIFY THE ENGINEER OR SURVEYOR SO THAT THE CONFLICT CAN BE RESOLVED WITH A MINIMUM AMOUNT OF DELAY.
- THE CONTRACTOR SHALL BE RESPONSIBLE FOR ANY CONSTRUCTION AFFECTING EXISTING WATER AND SEWER FACILITIES.

THE FOLLOWING NOTES ALSO APPLY WHEN CHECKED


- ☒ ALL UTILITIES AND UTILITY SERVICE LINES SHALL BE INSTALLED PRIOR TO PAVING.
- ☐ BACKFILL COMPACTION SHALL BE ACCORDING TO SPECIFIED STREET USE.
- ☐ TACK COAT REQUIREMENTS SHALL BE DETERMINED BY THE CITY ENGINEER.
- ☐ SIDEWALKS AND WHEELCHAIR RAMPS WITHIN THE CURB RETURNS SHALL BE CONSTRUCTED WHEREVER A NEW CURB RETURN IS CONSTRUCTED.
- ☐ IF CURB IS DEPRESSED FOR A DRIVEPAD, THE DRIVEPAD SHALL BE CONSTRUCTED PRIOR TO ACCEPTANCE OF CURB AND GUTTER.
- ☒ ALL STORM DRAINAGE FACILITIES SHALL BE COMPLETED PRIOR TO FINAL ACCEPTANCE.
- ☐ THE REQUESTOR OR DEVELOPER SHALL BE RESPONSIBLE FOR REPAIR OR REPLACEMENT OF ALL CURB AND GUTTER OR SIDEWALK DAMAGED AFTER APPROVAL BY THE CITY ENGINEER OF WORK COMPLETED BY THE CONTRACTOR.

ALL "AS-BUILT" INFORMATION ON THIS SHEET WAS PROVIDED BY WALKER SURVEYING COMPANY. BOHANNAN-HUSTON, INC. IS NOT RESPONSIBLE FOR THE ACCURACY OF THE AS-BUILT INFORMATION PROVIDED ON THIS SHEET.

Rich Sullivan
5/24/90

5-24-90

REV	SHEETS	FOR CITY ENGINEER	DATE	N.M. UTILITIES	DATE	USER	DEPT.	DATE
1	3, 5, 6, 8, 13	Roger A. Hannon	7-11-89		7-11-89	CKD-PB		7-11-89
2	3, 7, 8, 10, 11	Roger A. Hannon	7-11-89		7-11-89	CKD-W/W		7-11-89

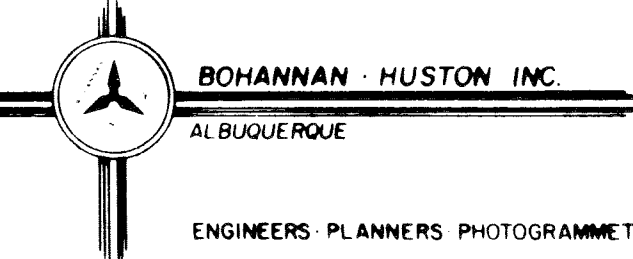

David R. Davis
5/24/90

PROJECT NUMBER
3825

APPROVED FOR
CONSTRUCTION

C.E.

SHEET 1 OF 14

8866356

FACTS 1 & 1-1

TRACTS 1 & L-1
PARADISE HILLS INDUSTRIAL PARK

AND
TRACTS 2 - A & 2 - B

EAGLE RANCH

C37 MARKET CENTRE WEST
12
NOW COMPRISING
1, D'HAUVERGUE NEW MEXICO


ERQUE, NEW M
FEBRUARY 1988

CURVE DATA

NUMBER	APC	RADIUS	DELTA	CHORD	CHORD BEARING	TANGENT
C1	102.17	197.00	29.42° 56'	101.03	355° 48' 15.7"	52.26
C2	139.27	25.00	90° 00' 00"	100.00	355° 48' 15.7"	52.26
C3	139.27	25.00	90° 00' 00"	475.16	359° 49' 49.7"	376.35
C4	734.80	688.00	60° 31' 53"	691.66	N60° 31' 53"	400.11
C5	634.55	664.03	55° 31' 53"	618.75	N57° 56' 53.52"	349.38
C6	498.24	531.08	90° 02' 01"	495.30	S04° 02' 01"	245.02
C7	28.23	465.15	3° 18' 41"	38.23	N30° 50' 33.7"	25.01
C8	130.40	448.15	17° 14' 55"	139.47	N41° 12' 55"	170.52
C9	340.47	452.15	4° 31' 31"	339.99	N47° 16' 13.5"	26.01
C10	400.00	456.05	5° 01' 31"	399.99	N49° 48' 58.20"	26.01
C11	259.69	688.00	21° 37' 36"	268.15	N73° 35' 05.5"	131.41
C12	140.00	688.00	90° 00' 00"	268.15	N73° 35' 05.5"	131.41
C13	259.69	688.00	68° 39' 56"	79.99	N53° 35' 34.0"	40.06
C14	248.58	664.03	2° 26' 55"	247.13	N40° 54' 24.9"	125.76
C15	140.00	664.03	12° 04' 48"	339.94	N24° 50' 00.0"	120.68
C16	240.00	655.03	2° 29' 56"	239.94	N55° 02' 54.9"	20.01
C17	400.00	655.03	3° 24' 56"	399.94	N60° 17' 47.9"	20.01
C18	400.00	900.00	90° 00' 00"	400.00	N60° 17' 47.9"	20.01
C19	91.23	38.00	92° 4' 55"	45.86	N85° 54' 33.0"	30.00
C20	58.09	38.00	87° 4' 05"	54.86	N85° 15' 41.4"	39.64
C21	61.29	38.00	92° 4' 55"	52.60	N84° 44' 19.9"	36.43
C22	61.29	38.00	92° 4' 55"	52.60	N85° 15' 41.4"	36.43
C23	58.09	38.00	92° 4' 55"	54.86	N85° 15' 41.4"	39.64
C24	58.09	38.00	87° 4' 05"	52.60	N84° 44' 19.9"	36.43
C25	133.57	85.00	90° 00' 00"	131.85	N85° 43' 00.0"	46.03
C26	121.29	631.08	1° 56' 60"	21.29	S00° 02' 23.2"	10.65
C27	631.08	1° 56' 60"	31° 17' 39"	39.99	S85° 33' 14.4"	20.01
C28	697.00	31° 17' 39"	31° 17' 39"	39.99	S85° 33' 14.4"	20.01
C29	400.00	686.00	20° 4' 15"	243.78	S10° 38' 34.9"	25.92
C30	400.00	686.00	20° 4' 15"	243.78	S10° 38' 34.9"	25.92
C31	35.15	30.00	81° 14' 11"	35.15	N81° 14' 50.9"	59.99
C32	35.15	30.00	81° 14' 11"	35.15	N81° 14' 50.9"	59.99
C33	42.75	30.00	58° 16' 47"	228.37	N61° 14' 50.9"	429.07
C34	42.75	30.00	58° 16' 47"	228.37	N61° 14' 50.9"	429.07
C35	46.64	30.00	58° 16' 47"	228.37	N61° 14' 50.9"	429.07
C36	46.64	30.00	58° 16' 47"	228.37	N61° 14' 50.9"	429.07
TANGENT DATA

NUMBER	BEARING	DISTANCE	NUMBER	BEARING	DISTANCE
11	N60°52'41"W	240.68	127	N40°56'48"E	52.23
13	N65°17'48"E	200.87	128	N40°56'48"E	52.23
14	N65°17'48"E	200.87	129	N40°56'48"E	52.23
15	S48°47'40"E	12.00	130	N40°56'48"E	52.23
16	N41°12'58"E	22.00	131	N40°56'48"E	52.00
17	N2°06'55"E	20.87	132	S49°03'14"E	12.00
18	N68°31'37"W	22.64	133	N40°56'48"E	52.00
19	N68°31'37"W	22.64	134	N40°56'48"E	52.00
20	N68°31'37"W	22.64	135	N40°56'48"E	52.00
21	S25°04'46"E	20.00	136	N38°36'19"E	60.23
22	S25°04'46"E	20.00	137	N40°56'48"E	60.23
23	S34°42'08"W	22.64	138	N40°56'48"E	60.23
24	S34°42'08"W	22.64	139	N40°56'48"E	60.23
25	S34°42'08"W	22.64	140	S49°05'27"E	68.64
26	S34°42'08"W	22.64	141	S49°05'27"E	68.64
27	S34°42'08"W	22.64	142	S49°05'27"E	68.64
193	S34°42'08"W	22.64	308	S49°05'27"E	68.64
194	S34°42'08"W	22.64	309	S49°0	


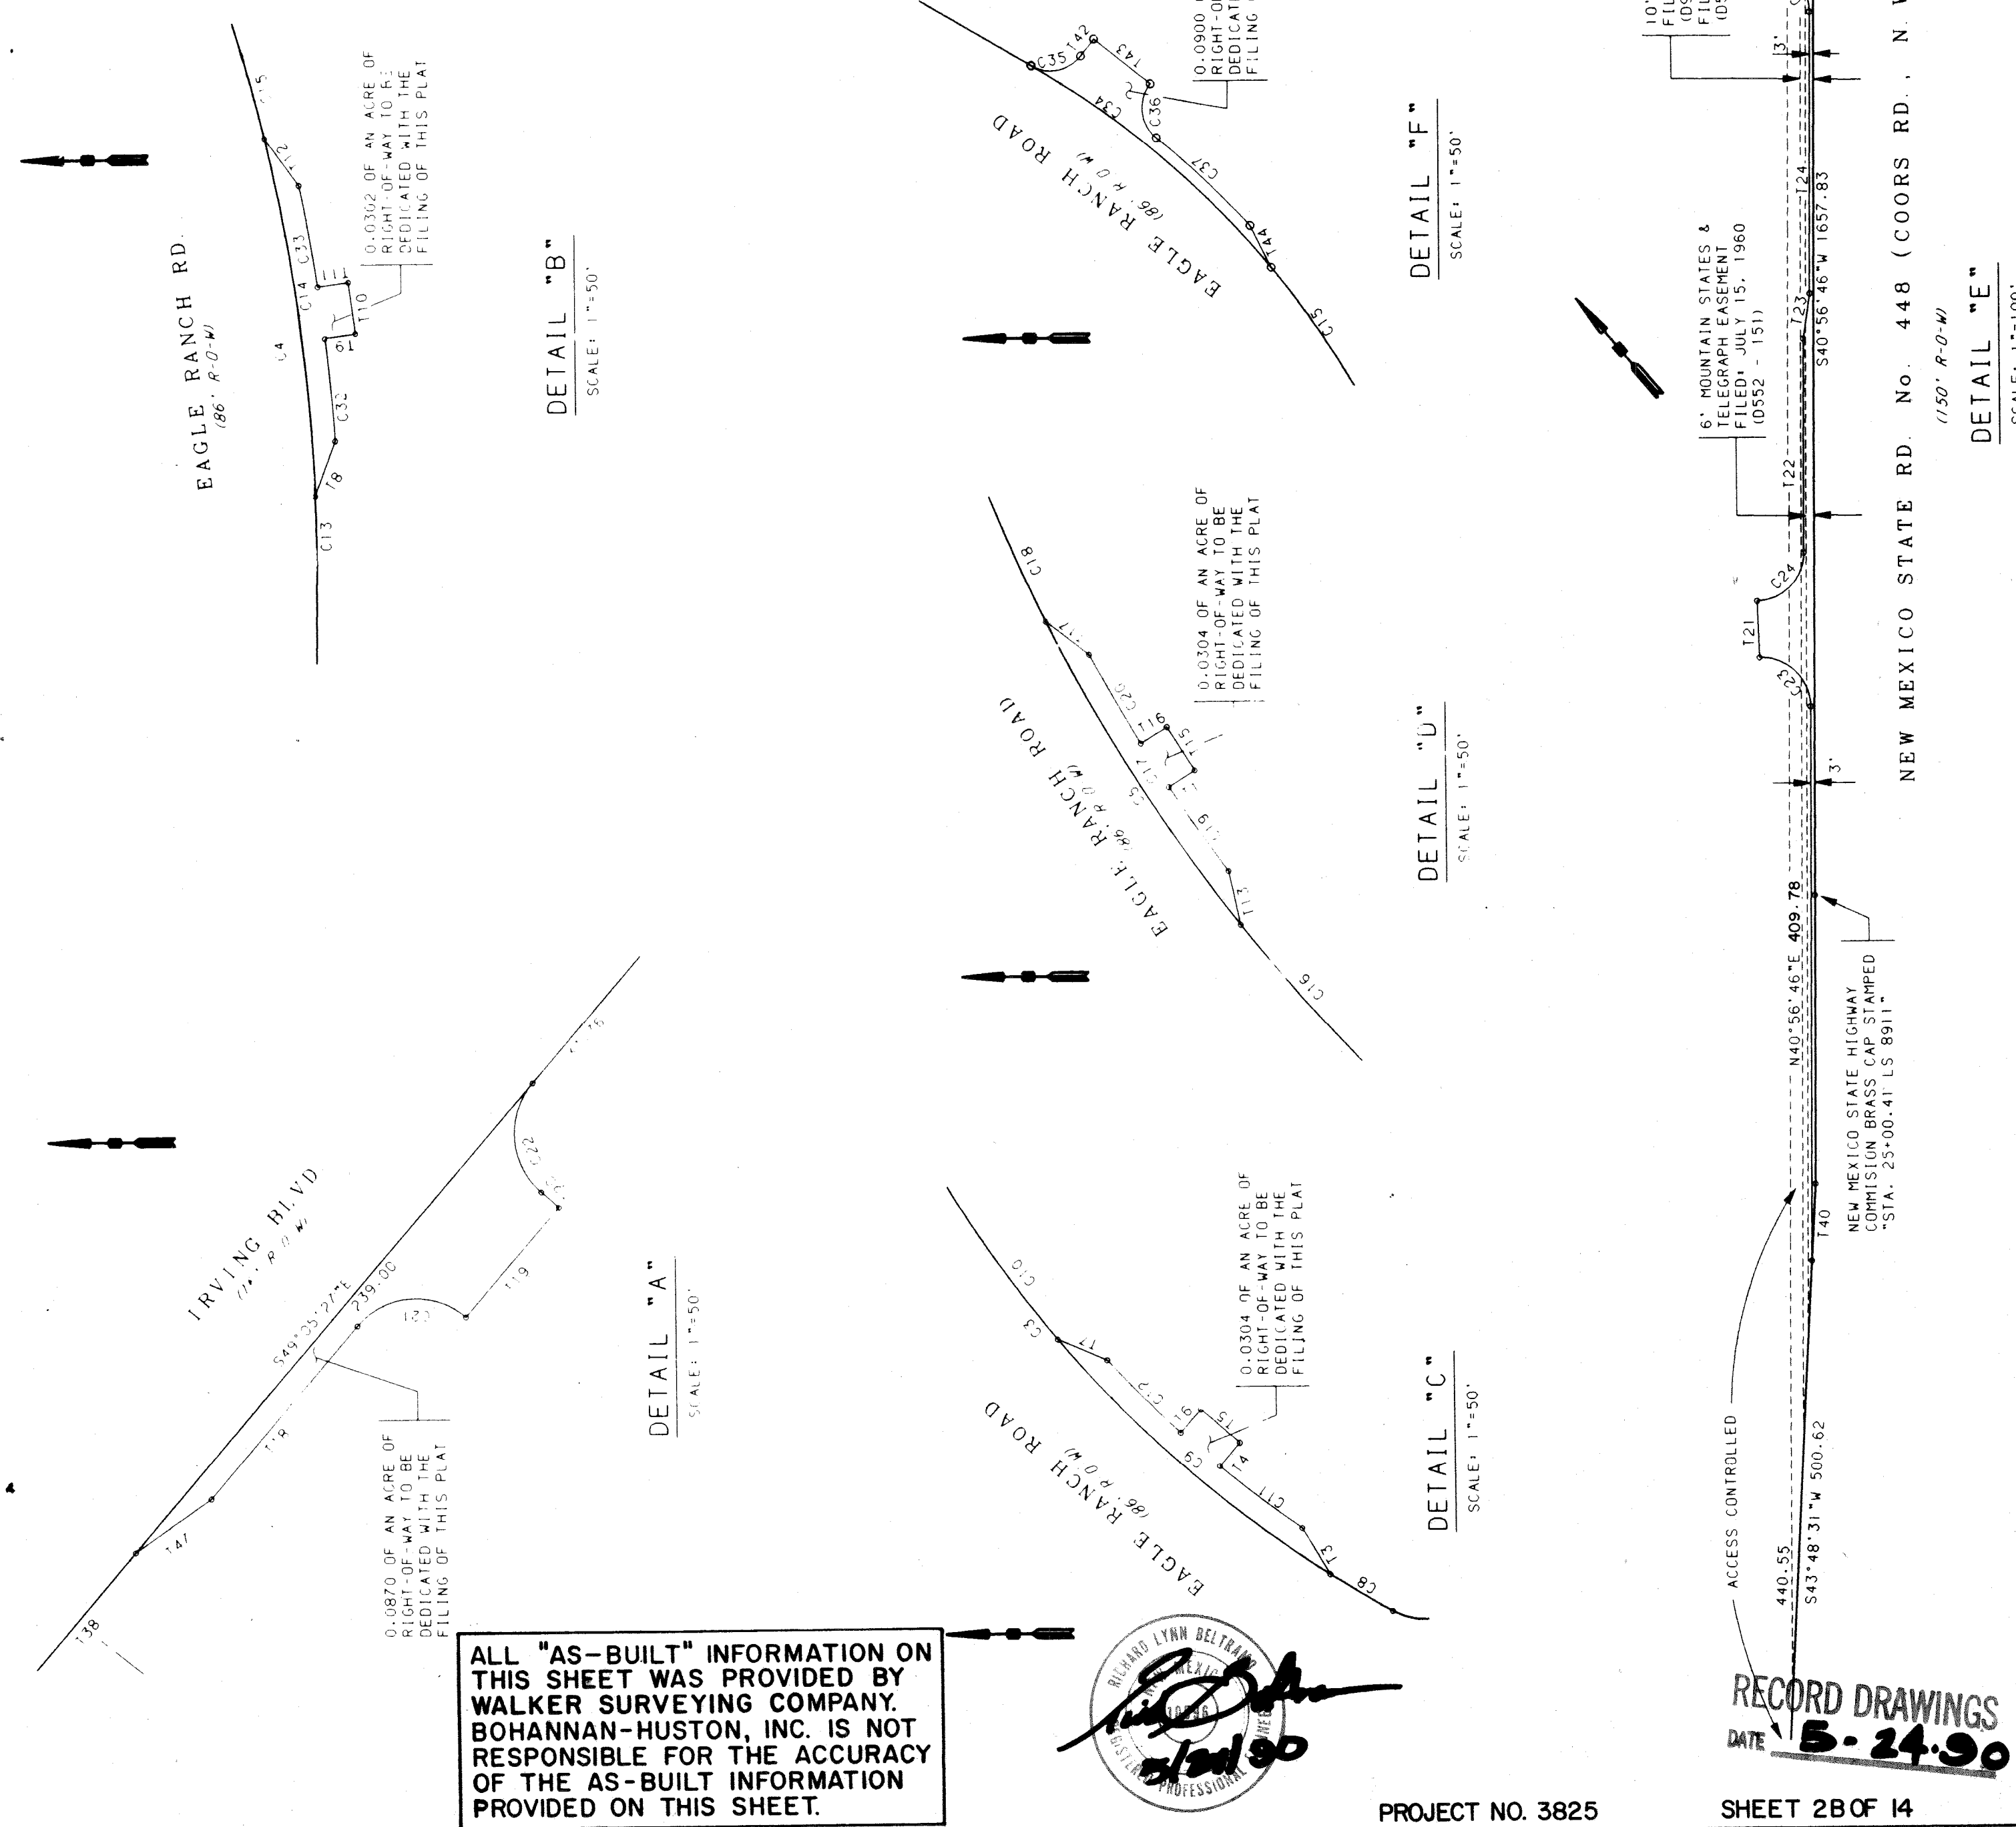


DEDICATED WITH THE
FILING OF THIS PLAY

SHEET 3 OF 3 SHEETS

C37-12

JOB NO. 8742902

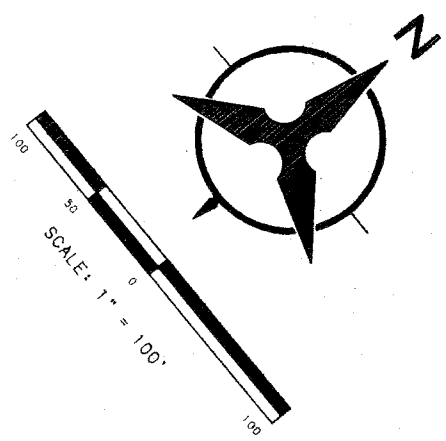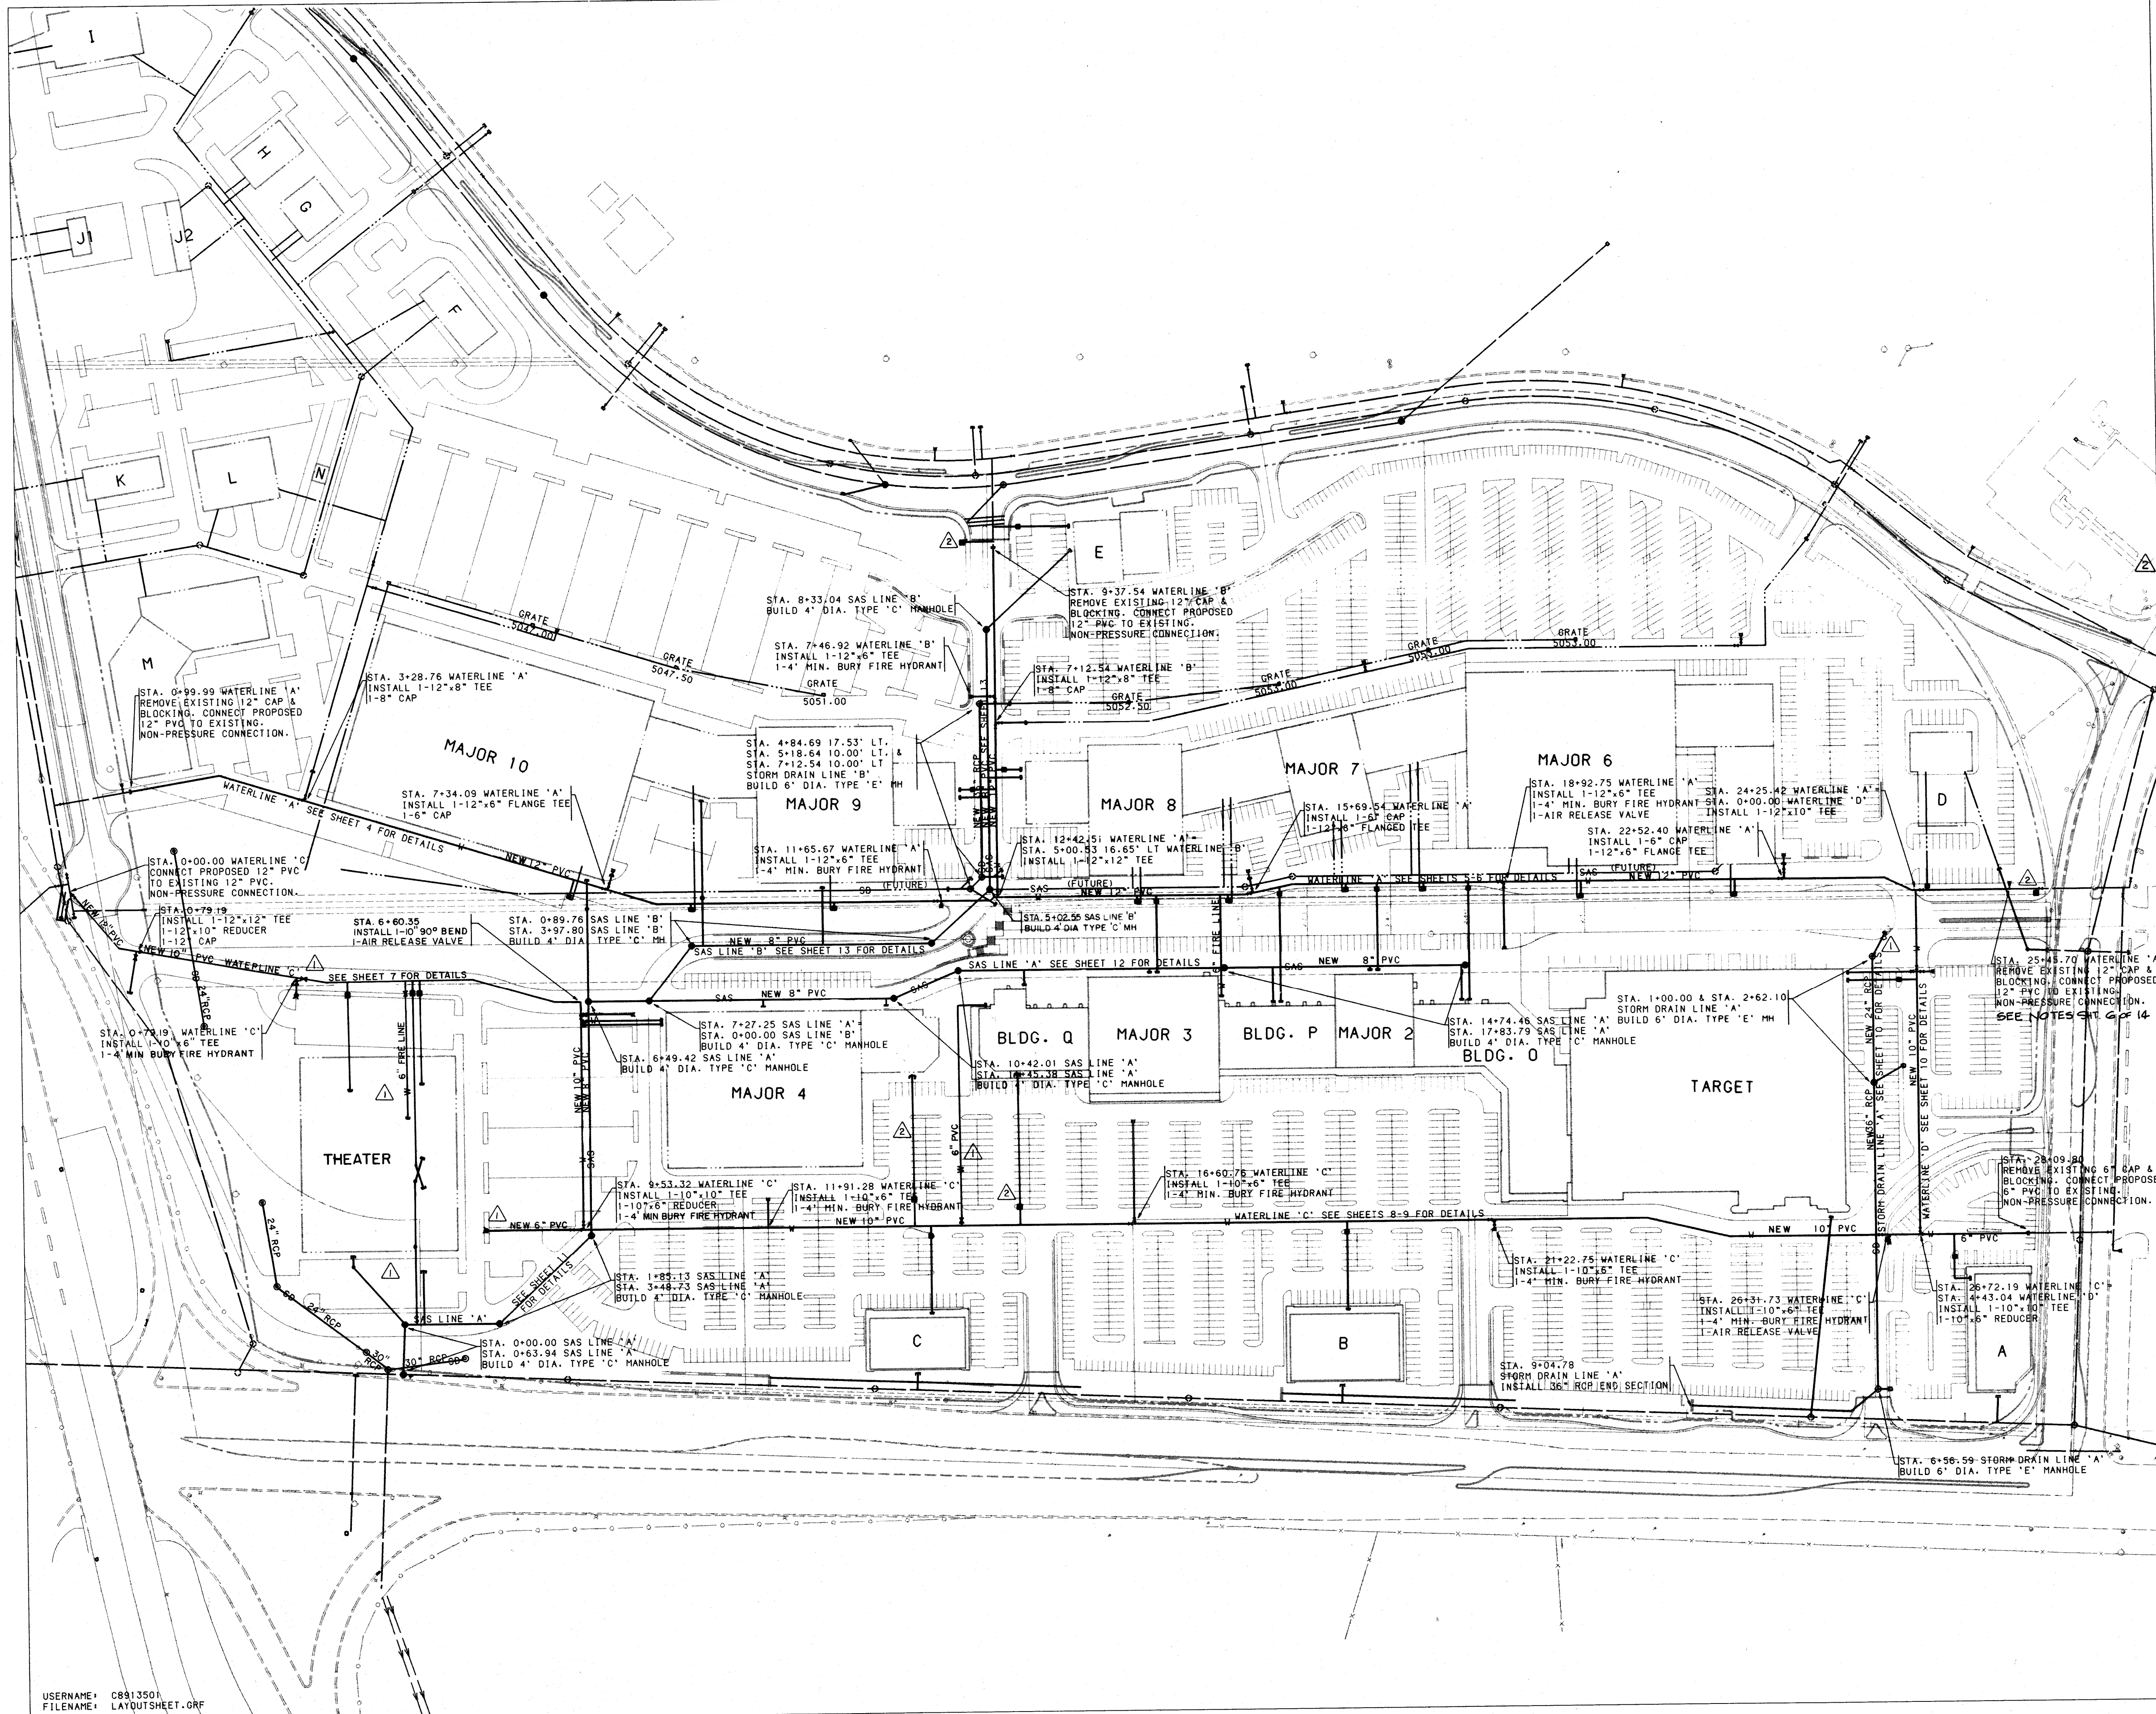

NOTES

1. CONSTRUCTION WITHIN THE PARADISE BLVD. RIGHT-OF-WAY SHALL BE DONE ON A SATURDAY WITH TWO WEEKS PRIOR NOTICE REQUIRED.
2. THE CONCRETE COLLAR FOR ALL VALVE BOX 'S' WILL BE BUILT BY THE PAVING CONTRACTOR.
3. VALVE BOX LIDS FOR FIRE LINES AND FOR FIRE HYDRANTS SHALL HAVE SPECIAL CASTING IDENTIFYING A FIRE LINE ON THE LID AS PER C.O.A. STD. DETAIL 2328.
4. THE MAXIMUM DEFLECTION PER JOINT FOR VERTICAL CURVES ON WATER LINES SHALL BE 0.39"/JOINT FOR 10" PVC AND 0.32"/JOINT FOR 12" PVC.

BENCH MARKS		AS BUILT INFORMATION	
USC & GS BRASS TABLE "R" ALAMEDA A-3" NEW MEXICO	DATE	STATE PLANE COORDINATES (CENTRAL ZONE)	
X = 377,094.67 Y = 1,523,108.34	BY	GROUND TO GRID FACTOR = 0.99967685	
A 00+ 00' 14' 13"		ELEV. = 5027.05	
MICRO-FILM INFORMATION			

SURVEY INFORMATION		FIELD NOTES	
NO.	DATE	NO.	DATE


ENGINEER'S SEAL		REVISIONS	
KLD	DATE	BY	DATE
KLD	4/89		
	4/89		
	4/89		

Robert B. Smith
5/24/90
REGISTERED PROFESSIONAL ENGINEER
STATE OF NEW MEXICO
No. 10732

ALL "AS-BUILT" INFORMATION ON THIS SHEET WAS PROVIDED BY WALKER SURVEYING COMPANY. BOHANNAN-HUSTON, INC. IS NOT RESPONSIBLE FOR THE ACCURACY OF THE AS-BUILT INFORMATION PROVIDED ON THIS SHEET.

RECORD DRAWINGS
DATE: 5-24-90




BHT JOB NO. 89135.01

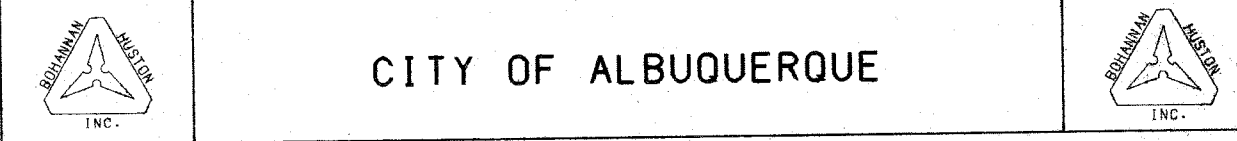

**MARKET CENTER WEST SITE UTILITY EXTENSIONS
WATER DISTRIBUTION AND SANITARY SEWER LAYOUT**

APPROVALS	ENGINEER	DATE	APPROVALS	ENGINEER	DATE
City Engineer	Roy A. Nunez	4/89	Liquid Waste	ckd. Peto	6/2/89
A.C.E.-Design			Traffic		
A.C.E.-Hydrology	N/A		Water	ckd. Peto	6/2/89
			N.M. Utilities		

DRAWING NO. 3825 MAP NO. C-13 SHEET 3 OF 14

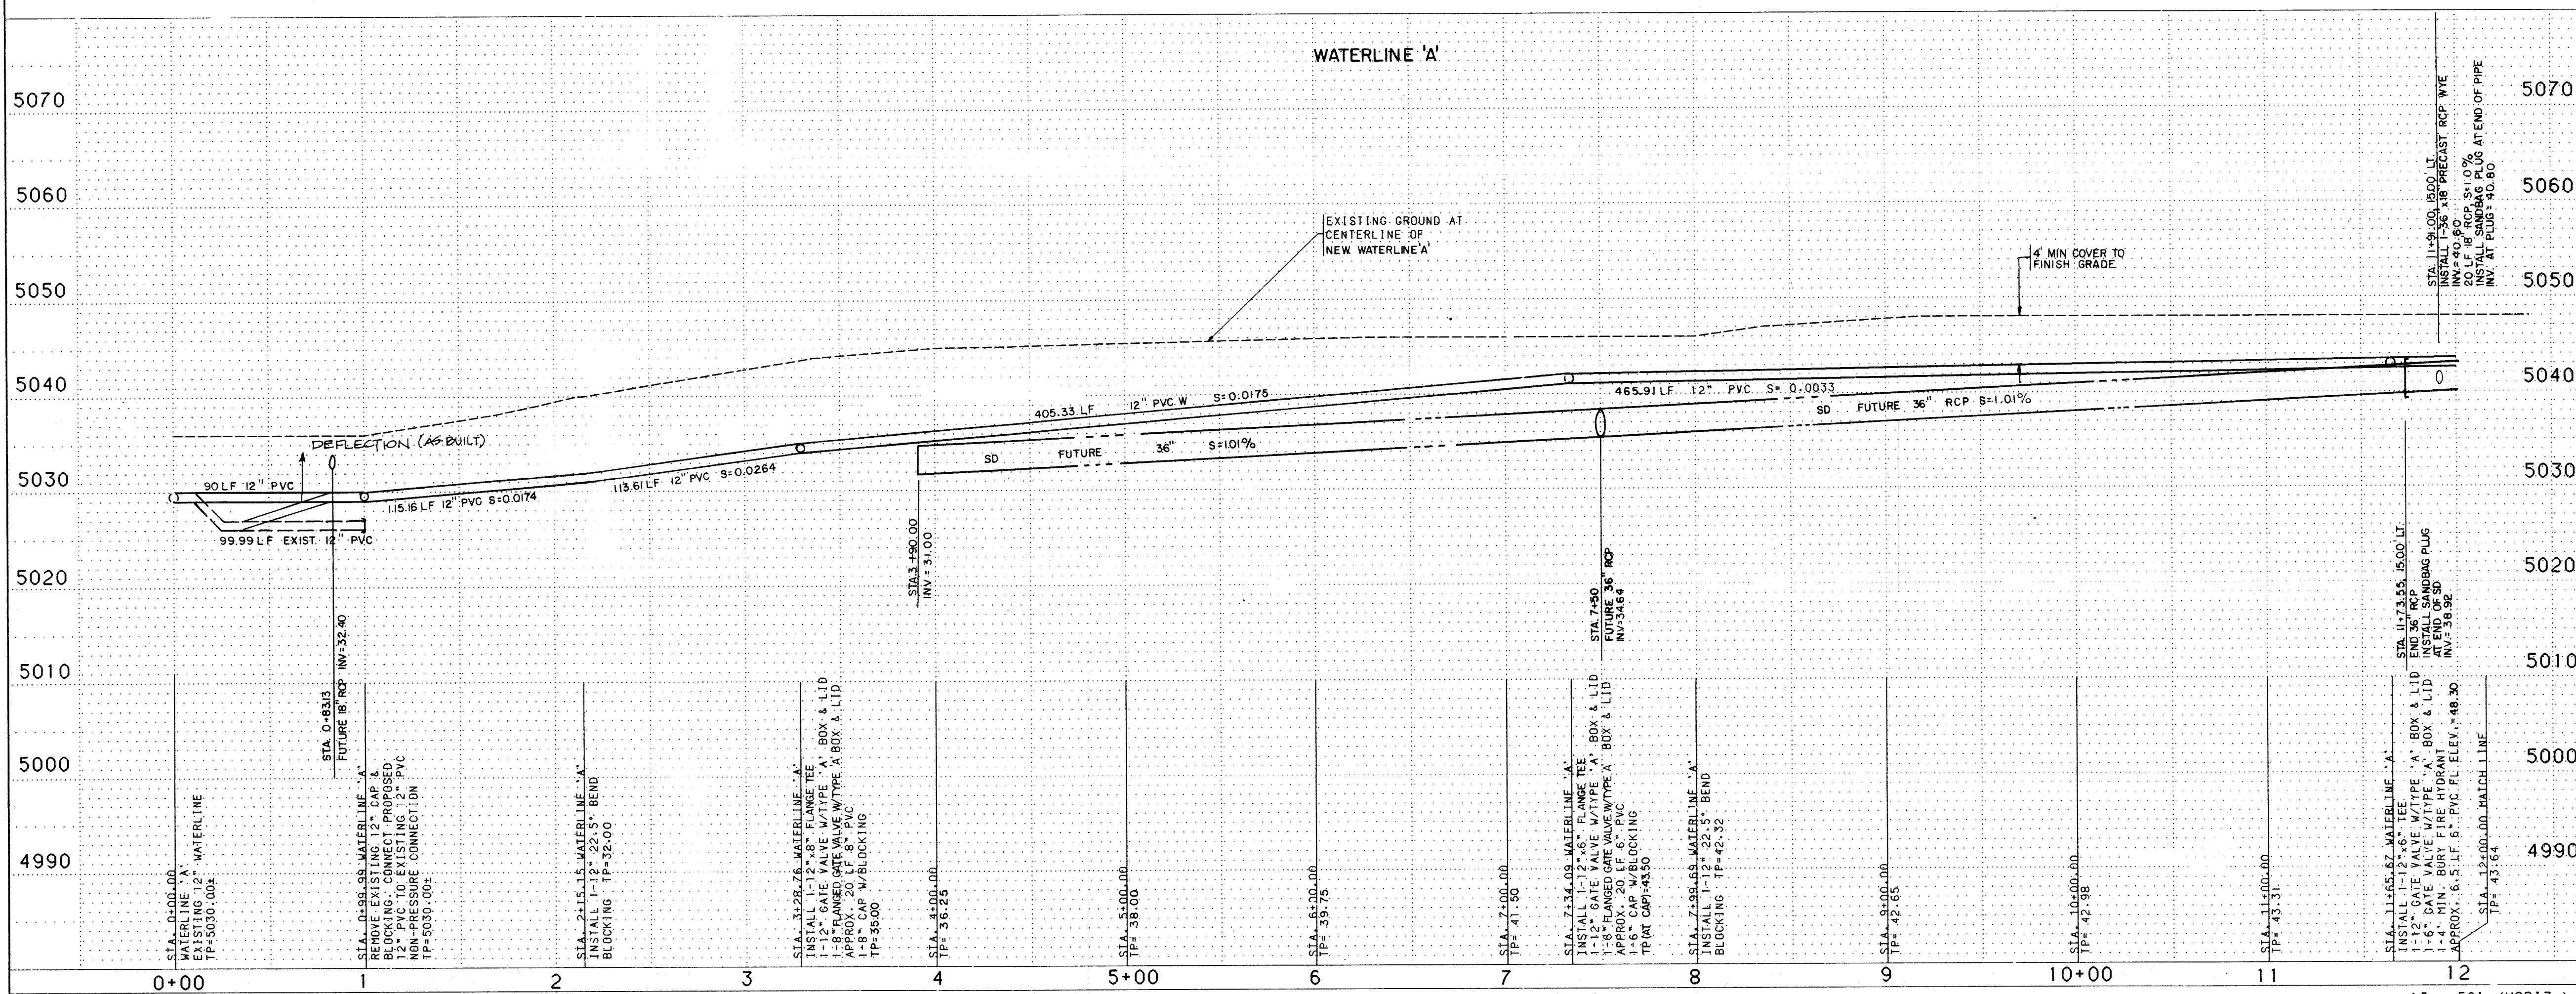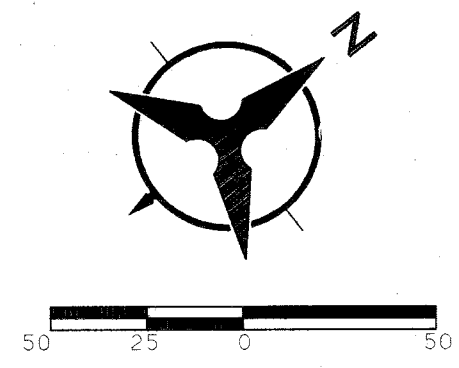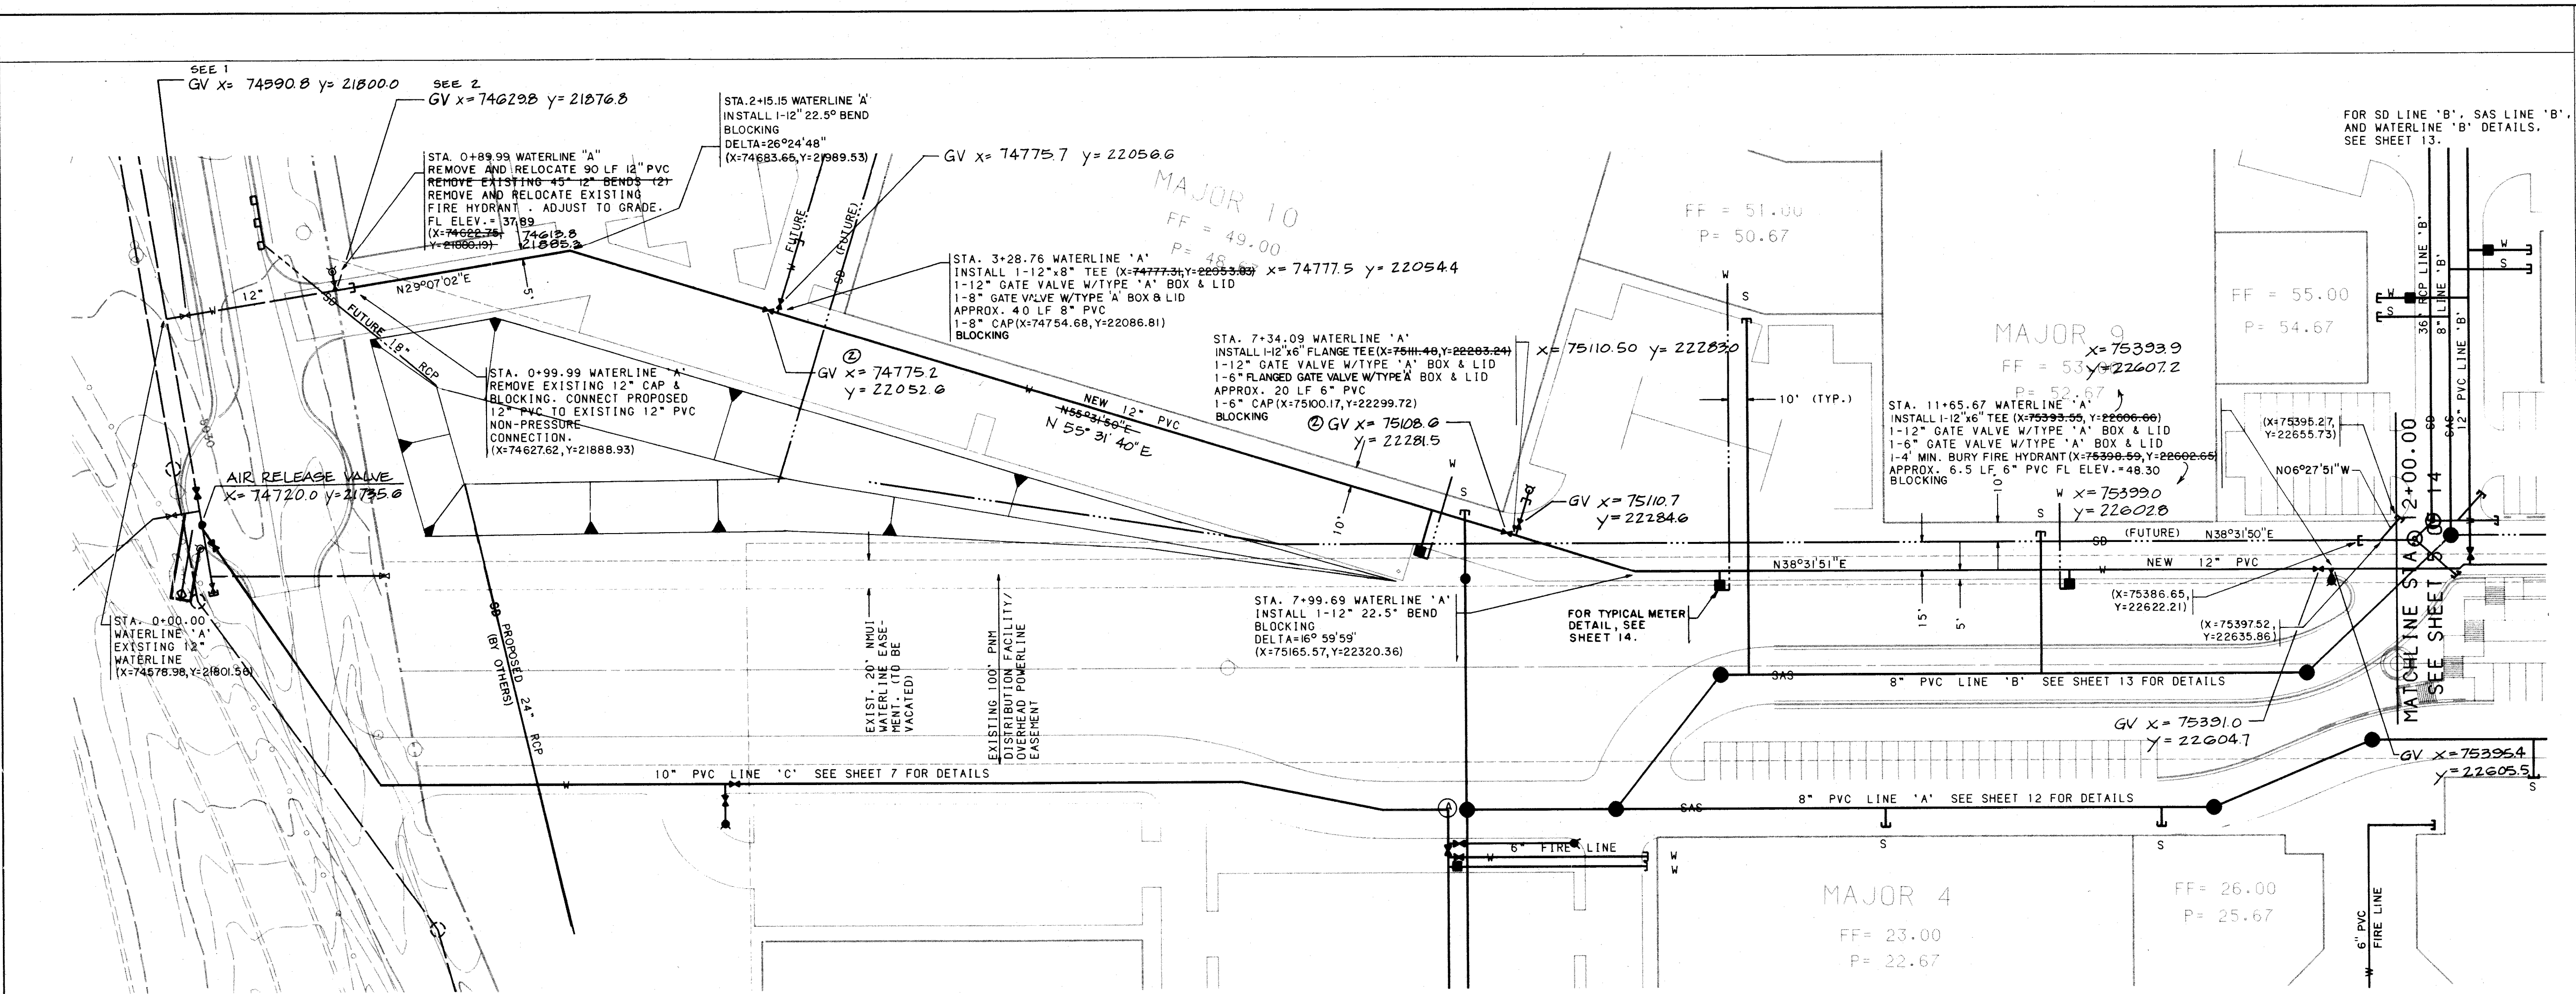

WATERLINE STATION	WL TYPE	WL SIZE	WL LGTH.	
6+88.17 RT. SINGL.	2"	15'	MAJOR 10	
8+44.08 RT. SINGL.	1"	15'	SHOPS	
10+28.02 RT. SINGL.	1.5"	15'	MAJOR 9	

* SEE METER DETAIL SHEET 14



ALL "AS-BUILT" INFORMATION ON THIS SHEET WAS PROVIDED BY WALKER SURVEYING COMPANY. BOHANNAN-HUSTON, INC. IS NOT RESPONSIBLE FOR THE ACCURACY OF THE AS-BUILT INFORMATION PROVIDED ON THIS SHEET.

RECORD
DATE 5-24-90

BHI JOB NO. 89135-01




CITY OF ALBUQUERQUE

MARKET CENTER WEST SITE UTILITY EXTENSIONS
WATERLINE 'A'

APPROVALS	ENGINEER	DATE	APPROVALS	ENGINEER	DATE
City Engineer	Robert R. Smith	4/5/90	Liquid Waste	CKA PEGO	6/2/89
A.C.E.-Design			Traffic	N/A	
A.C.E.-Hydrology	N/A		Water	CKA PEGO	6/2/89
			N.M. Utilities	John A. Smith	6/2/89

DRAWING NO. 3825 MAP NO. C-13 SHEET 4 OF 14

FOR STORM DRAIN LINE 'B', SAS LINE 'B',
AND WATERLINE 'B' DETAILS.
SEE SHEET 13.

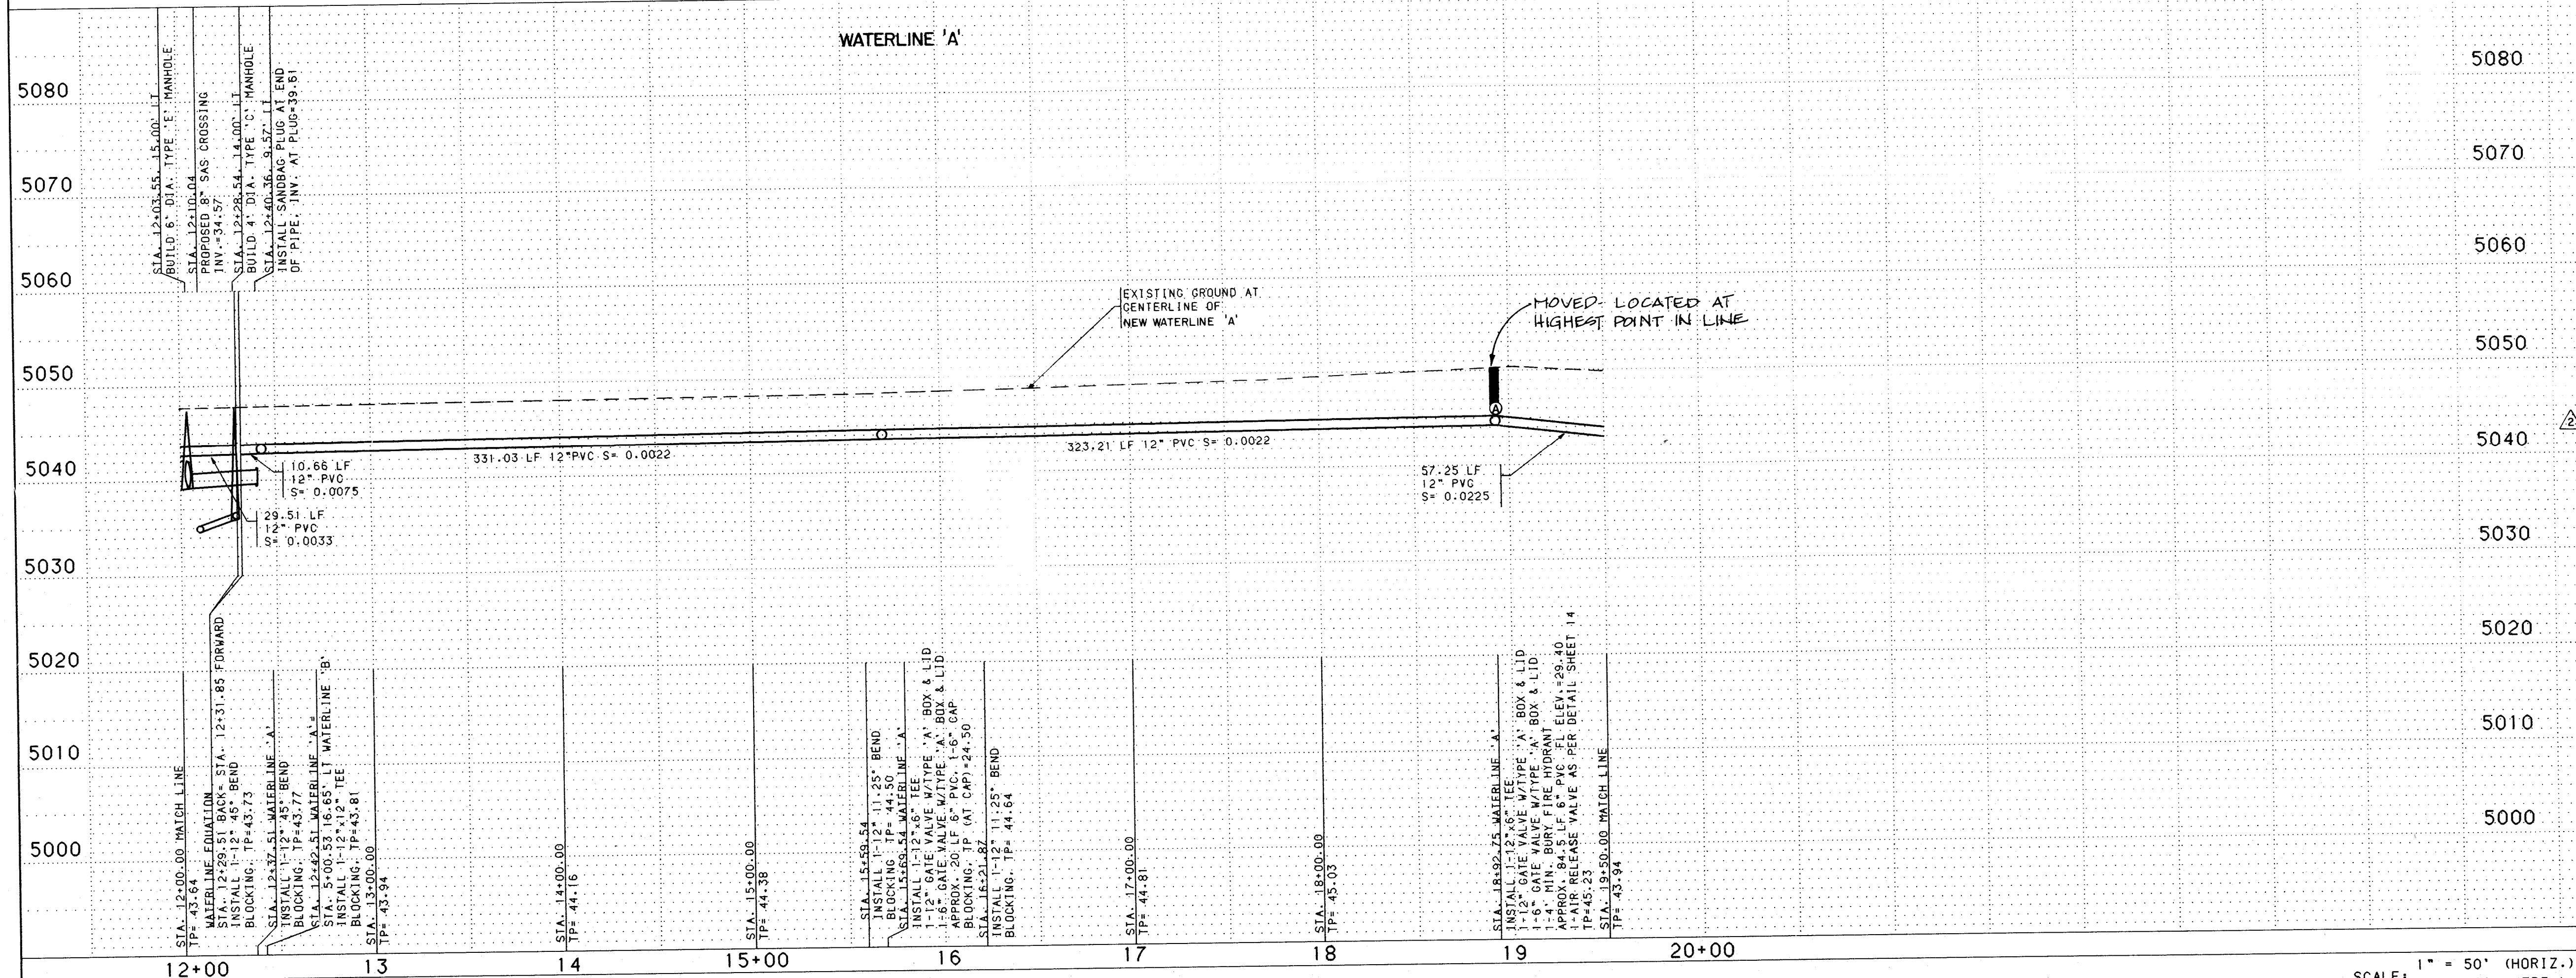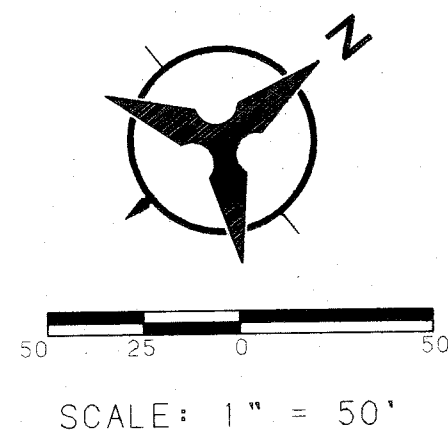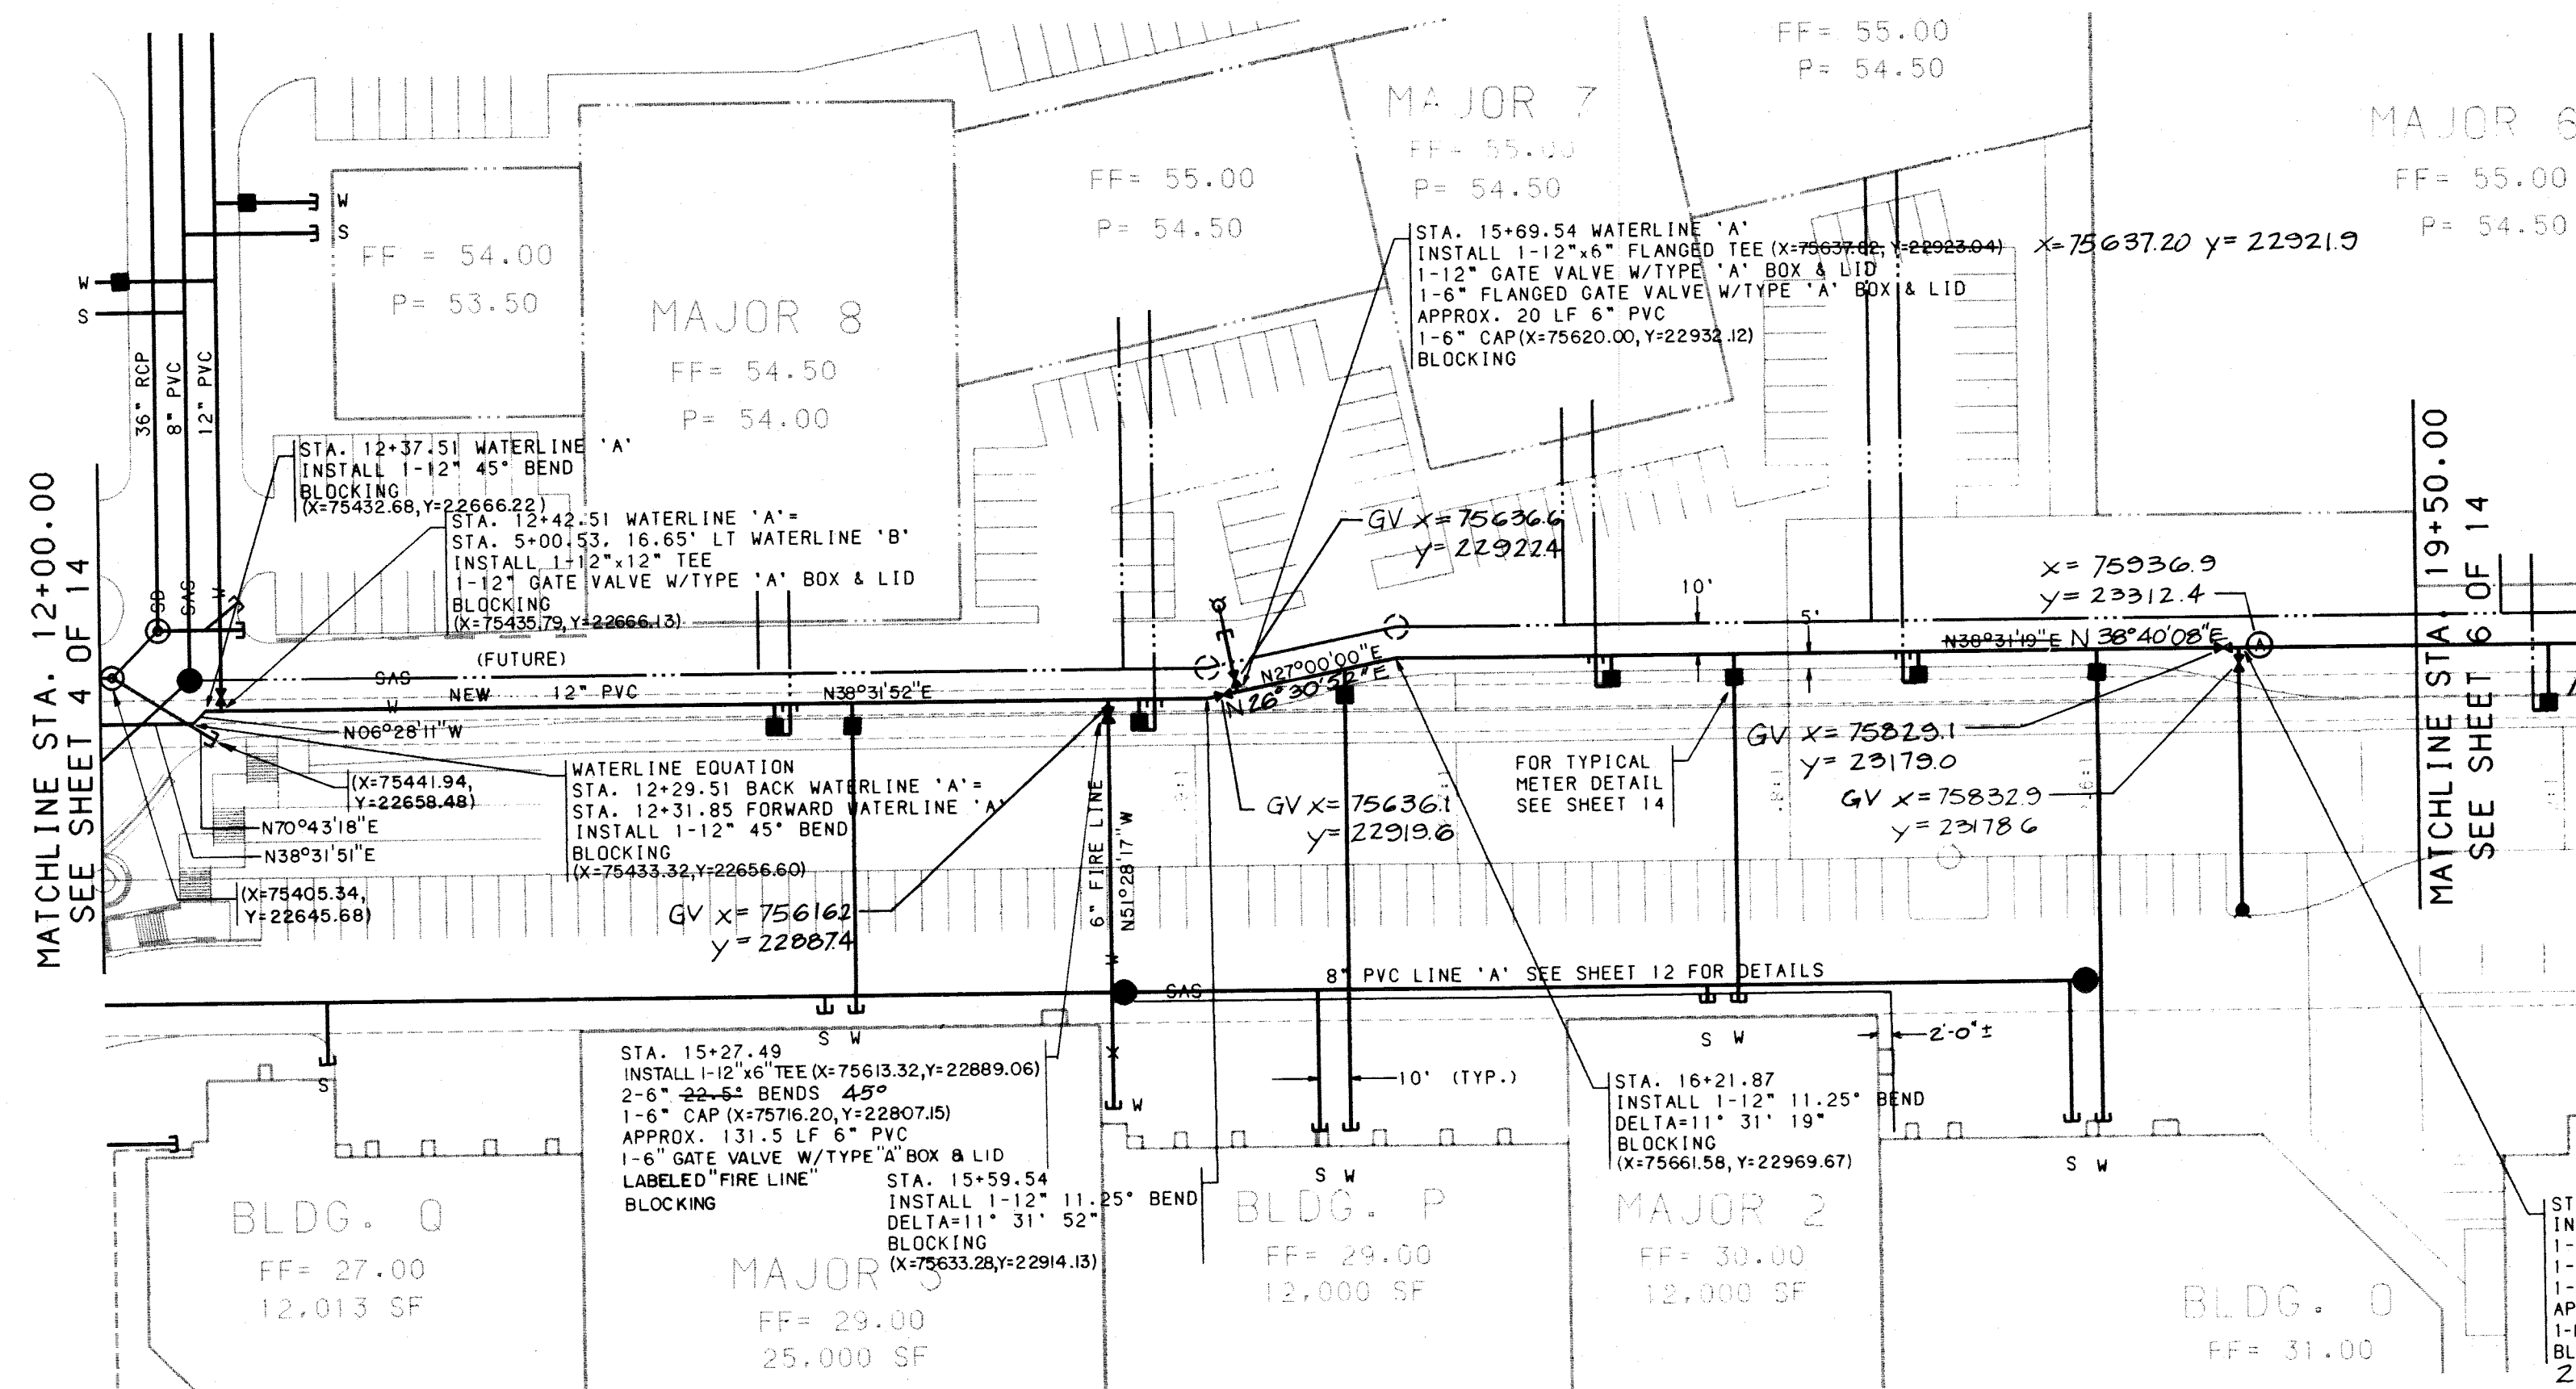

USERNAME: C8913501
FILENAME: WATER2.GRF

SCALE: 1" = 50' (HORIZ.)
1" = 10' (VERT.)


ALL "AS-BUILT" INFORMATION ON
THIS SHEET WAS PROVIDED BY
WALKER SURVEYING COMPANY.
BOHANNAN-HUSTON, INC. IS NOT
RESPONSIBLE FOR THE ACCURACY
OF THE AS-BUILT INFORMATION
PROVIDED ON THIS SHEET.

RECORD DRAWINGS
DATE 5-24-90

WATERLINE STATION	WL TYPE	WL SIZE	WL LGTH.	
14+16.03 RT. SNGL.	2"	105'		SHOPS
14+20.52 RT. SNGL.	1.5"	26'		MAJOR 8
14+45.41 RT. SNGL.	2"	99.5'		MAJOR 3
15+27.49 RT. SNGL.	6"	331.5'		6" FIRE LINE
15+37.52 RT. SNGL.	1"	26'		SHOPS
16+04.83 RT. SNGL.	1"	148.5'		SHOP P
16+90.80 RT. SNGL.	1.5"	25'		MAJOR 7
17+30.33 RT. SNGL.	1.5"	112'		MAJOR 2
17+89.86 RT. SNGL.	1"	25'		SHOPS
18+47.09 RT. SNGL.	1"	152'		SHOP D

*SEE METER DETAIL SHEET 14

BHI JOB NO. 89135.01

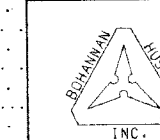

CITY OF ALBUQUERQUE



MARKET CENTER WEST SITE UTILITY EXTENSIONS
WATERLINE 'A'

APPROVALS	ENGINEER	DATE	APPROVALS	ENGINEER	DATE
City Engineer	Robert A. Smith	6/1/89	Liquid Waste	CHD. PEGO	6/1/89
A.C.E.-Design	N/A		Traffic	N/A	
A.C.E.Hydrology	N/A		Water	CHD. PEGO	6/1/89
			N.M. Utilities	PLU. V. C.	6/1/89




DRAWING
NO. 3825

MAP NO. C-13
SHEET 5 OF 14

SURVEY INFORMATION		BENCH MARKS		AS BUILT INFORMATION	
NO.	BY	DATE	STATE PLANE COORDINATES (CENTRAL ZONE)	USC & GS BRASS TABLE "R" ALAMEDA A-3" NEW MEXICO	MICRO-FILM INFORMATION
			X= 377,094.67 Y= 1,523,108.34		
			GROUND TO GRID FACTOR= 0.99967685		
			A OC= 00° 14' 13"		
			ELEV.= 5027.05		

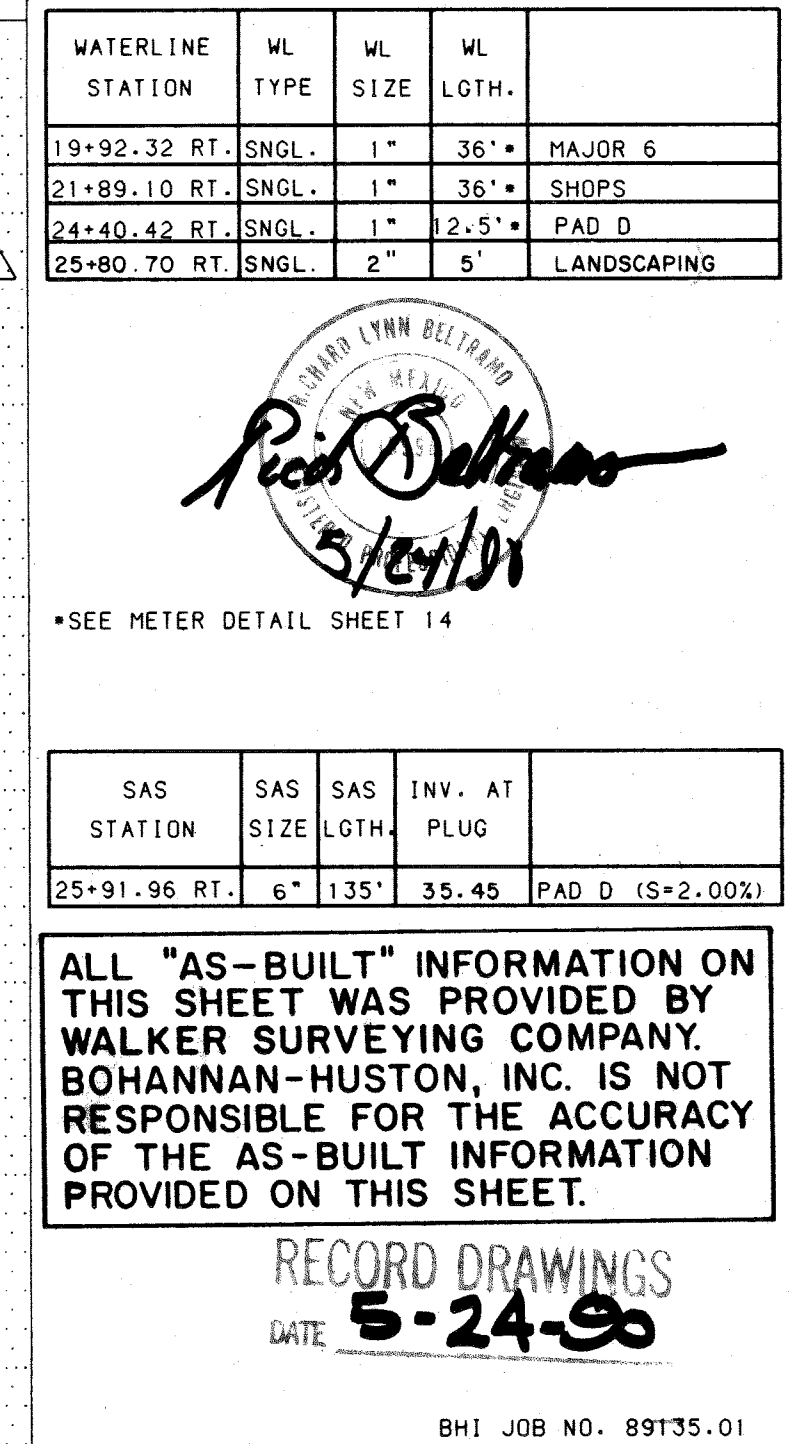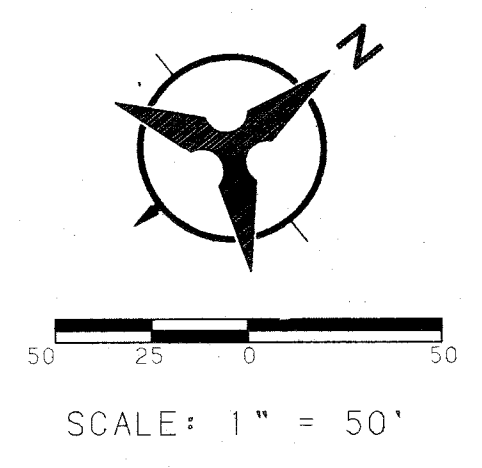

		CITY OF ALBUQUERQUE			
MARKET CENTER WEST SITE UTILITY EXTENSIONS					
WATERLINE 'A'					
APPROVALS	ENGINEER	DATE	APPROVALS	ENGINEER	DATE
City Engineer	<i>Page Allen</i>	<i>6/5/97</i>	Liquid Waste	<i>CKD, PEGO</i>	<i>6/2/97</i>
A.C.E.-Design	"	"	Traffic	<i>NA</i>	
A.C.E.-Hydrology	<i>n/a</i>		Water	<i>CKD, PEGO</i>	<i>6/2/97</i>
			N.M. Utilities	<i>John</i>	<i>6/2/97</i>
DRAWING NO. 3825		MAP NO. C-13		SHEET 6 OF 14	

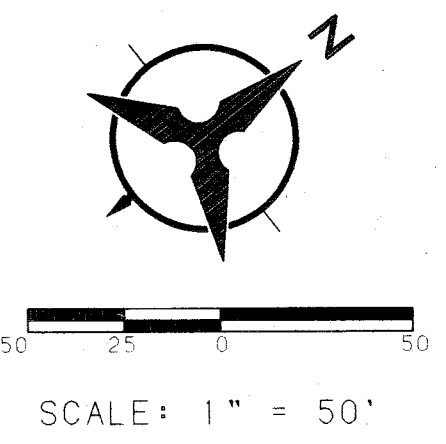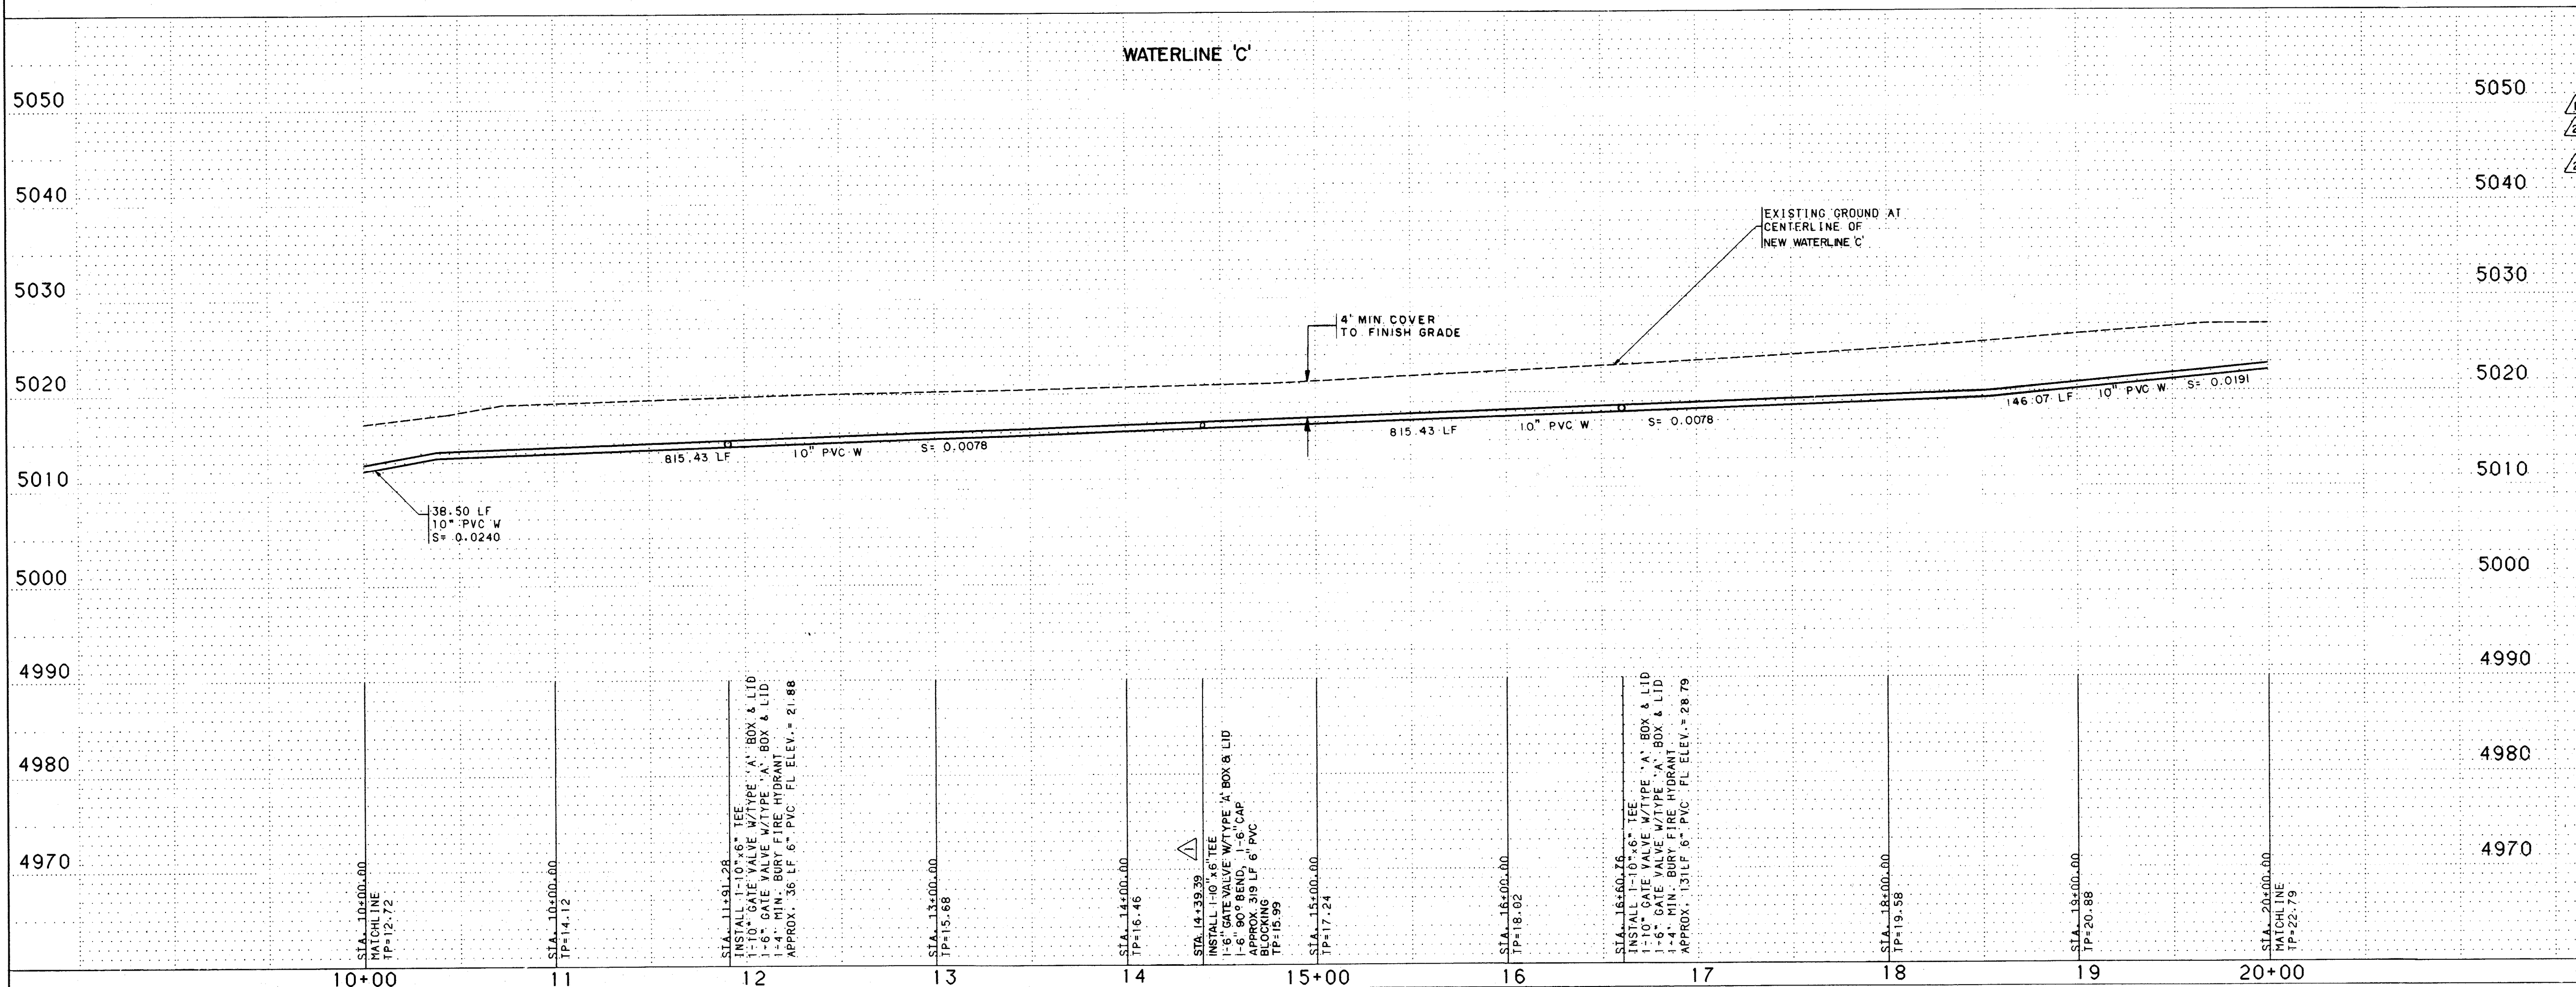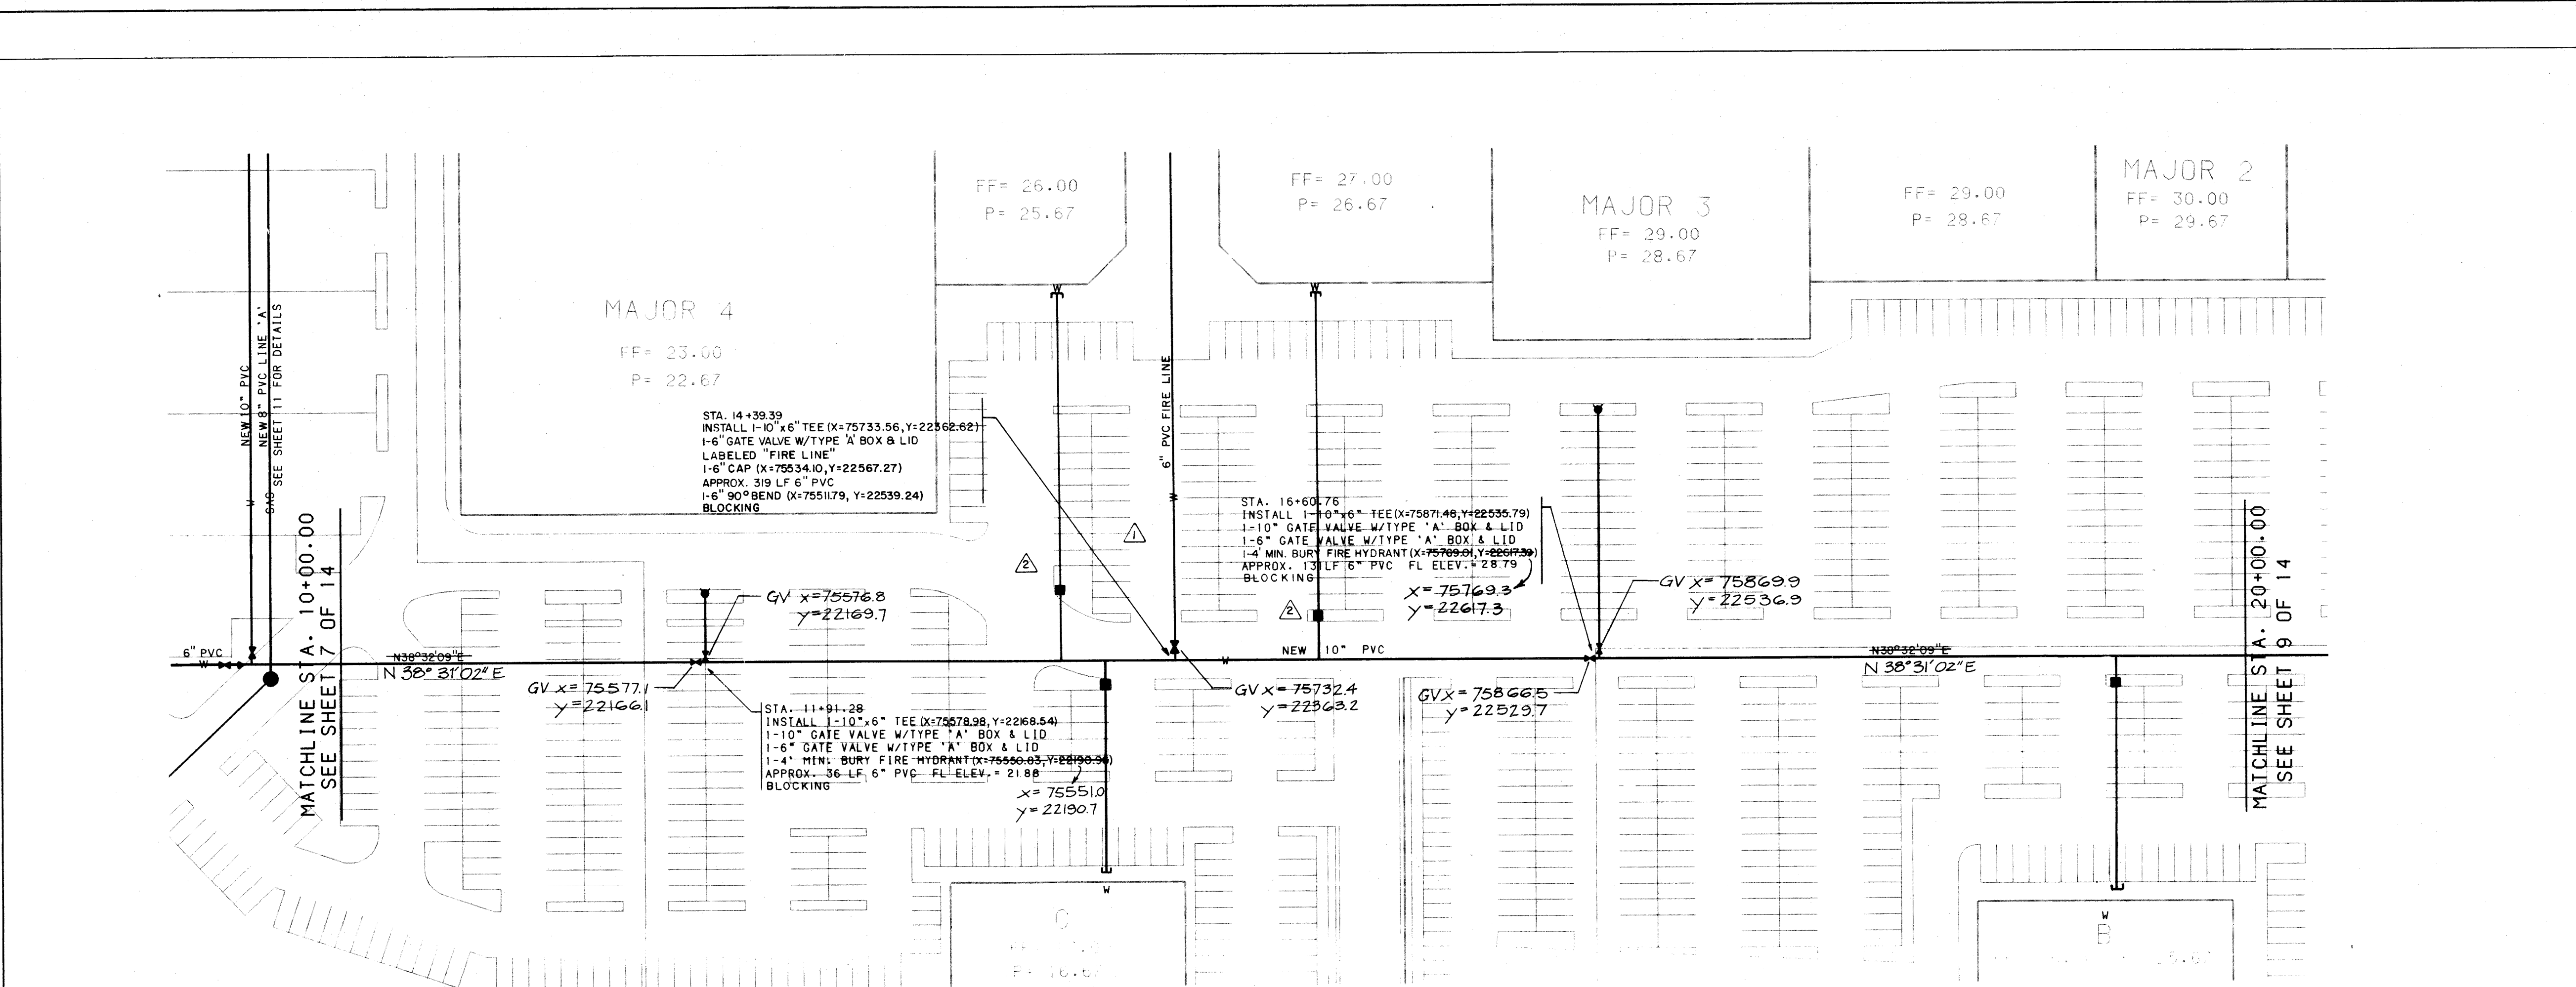

WATERLINE STATION	WL TYPE	WL SIZE	WL LGTH.	
14+01.28 RT.	SINGL.	1"	111'	PAD C
19+34.27 RT.	SINGL.	1"	114.5'	PAD B
14+39.39 LT.	SINGL.	6"	319'	6" FIRE LINE
13+78.70 LT.	SINGL.	1-1/2"	193'	SHOPS
5+14.07 LT.	SINGL.	1-1/2"	193'	SHOPS Q




ALL "AS-BUILT" INFORMATION ON THIS SHEET WAS PROVIDED BY WALKER SURVEYING COMPANY. BOHANNAN-HUSTON, INC. IS NOT RESPONSIBLE FOR THE ACCURACY OF THE AS-BUILT INFORMATION PROVIDED ON THIS SHEET.

RECORD DRAWINGS
DATE 5.24.90

BHI JOB NO. 89135.01

CITY OF ALBUQUERQUE					
MARKET CENTER WEST SITE UTILITY EXTENSIONS WATERLINE 'C'					
APPROVALS	ENGINEER	DATE	APPROVALS	ENGINEER	DATE
City Engineer	Roy L. B...	6/12/89	Liquid Waste	...	6/12/89
A.C.E.-Design			Traffic		
A.C.E.-Hydrology			Water		
			N.M. Utilities		

ENGINEER'S SEAL		BENCH MARKS		AS BUILT INFORMATION	
KLD		USC & GS BRASS TABLE "R ALAMEDA A-3" NEW MEXICO		DATE	
BY		STATE PLANE COORDINATES (CENTRAL ZONE)		NO.	
REMARKS		X= 377.094.67 Y= 1,523.108.34		BY	
NO. DATE		GROUND TO GRID FACTOR= 0.99867685		NO.	
DESIGNED BY		A.D.C. 00' 14' 13"		NO.	
DRAWN BY		ELEV.= 5027.05		NO.	
CHECKED BY				NO.	
DATE 4/89				NO.	
DATE 4/89				NO.	
DATE 4/89				NO.	

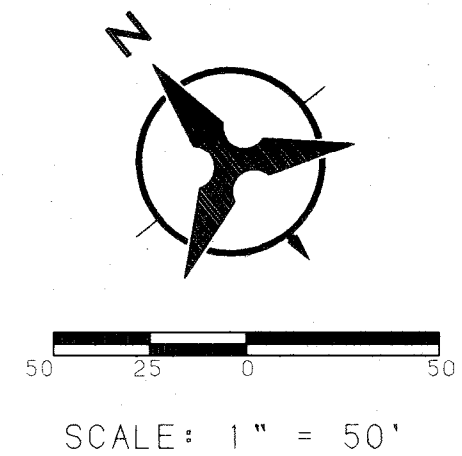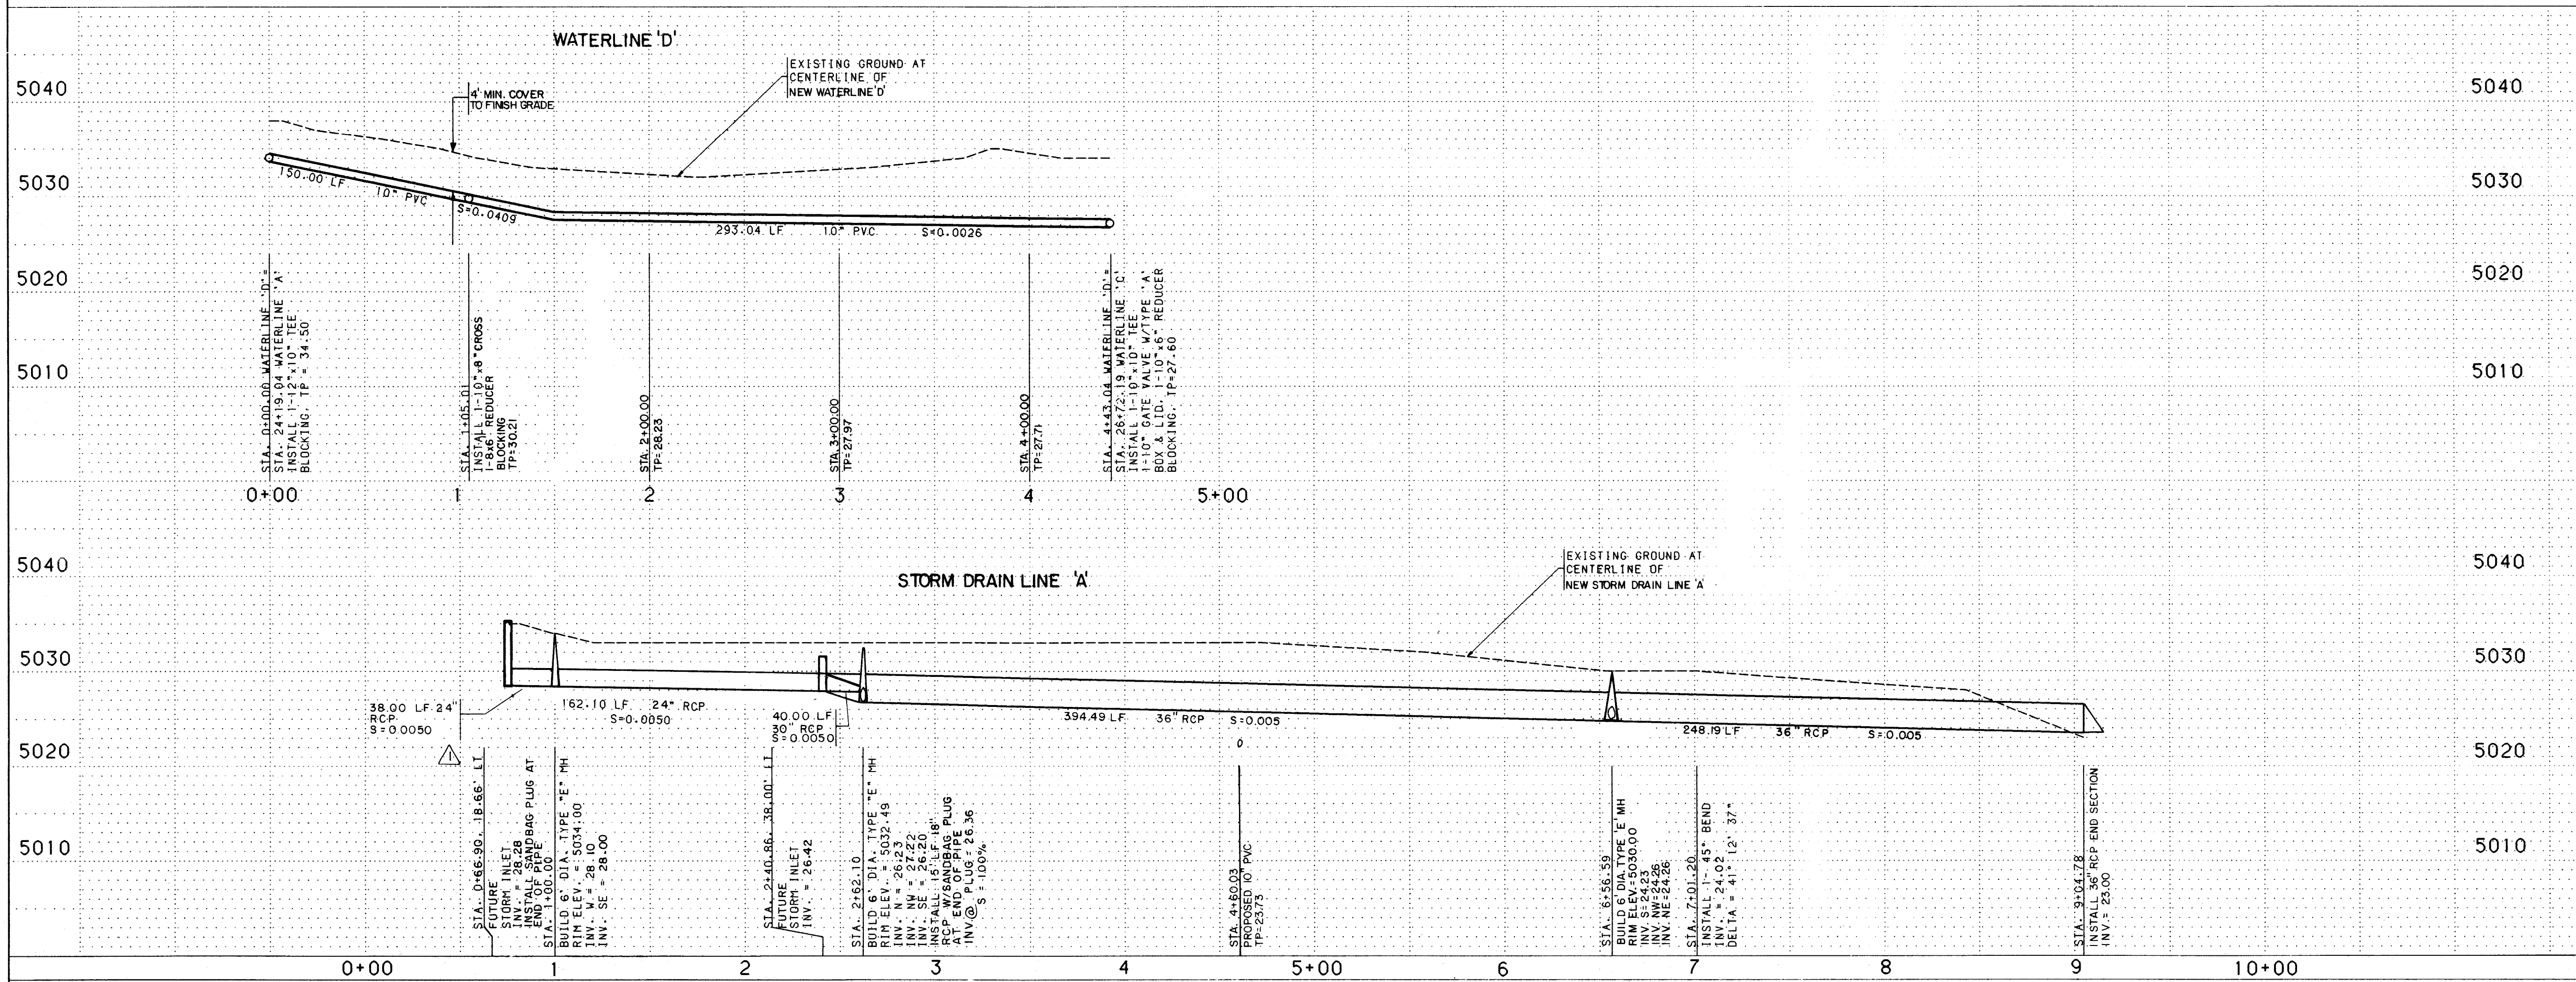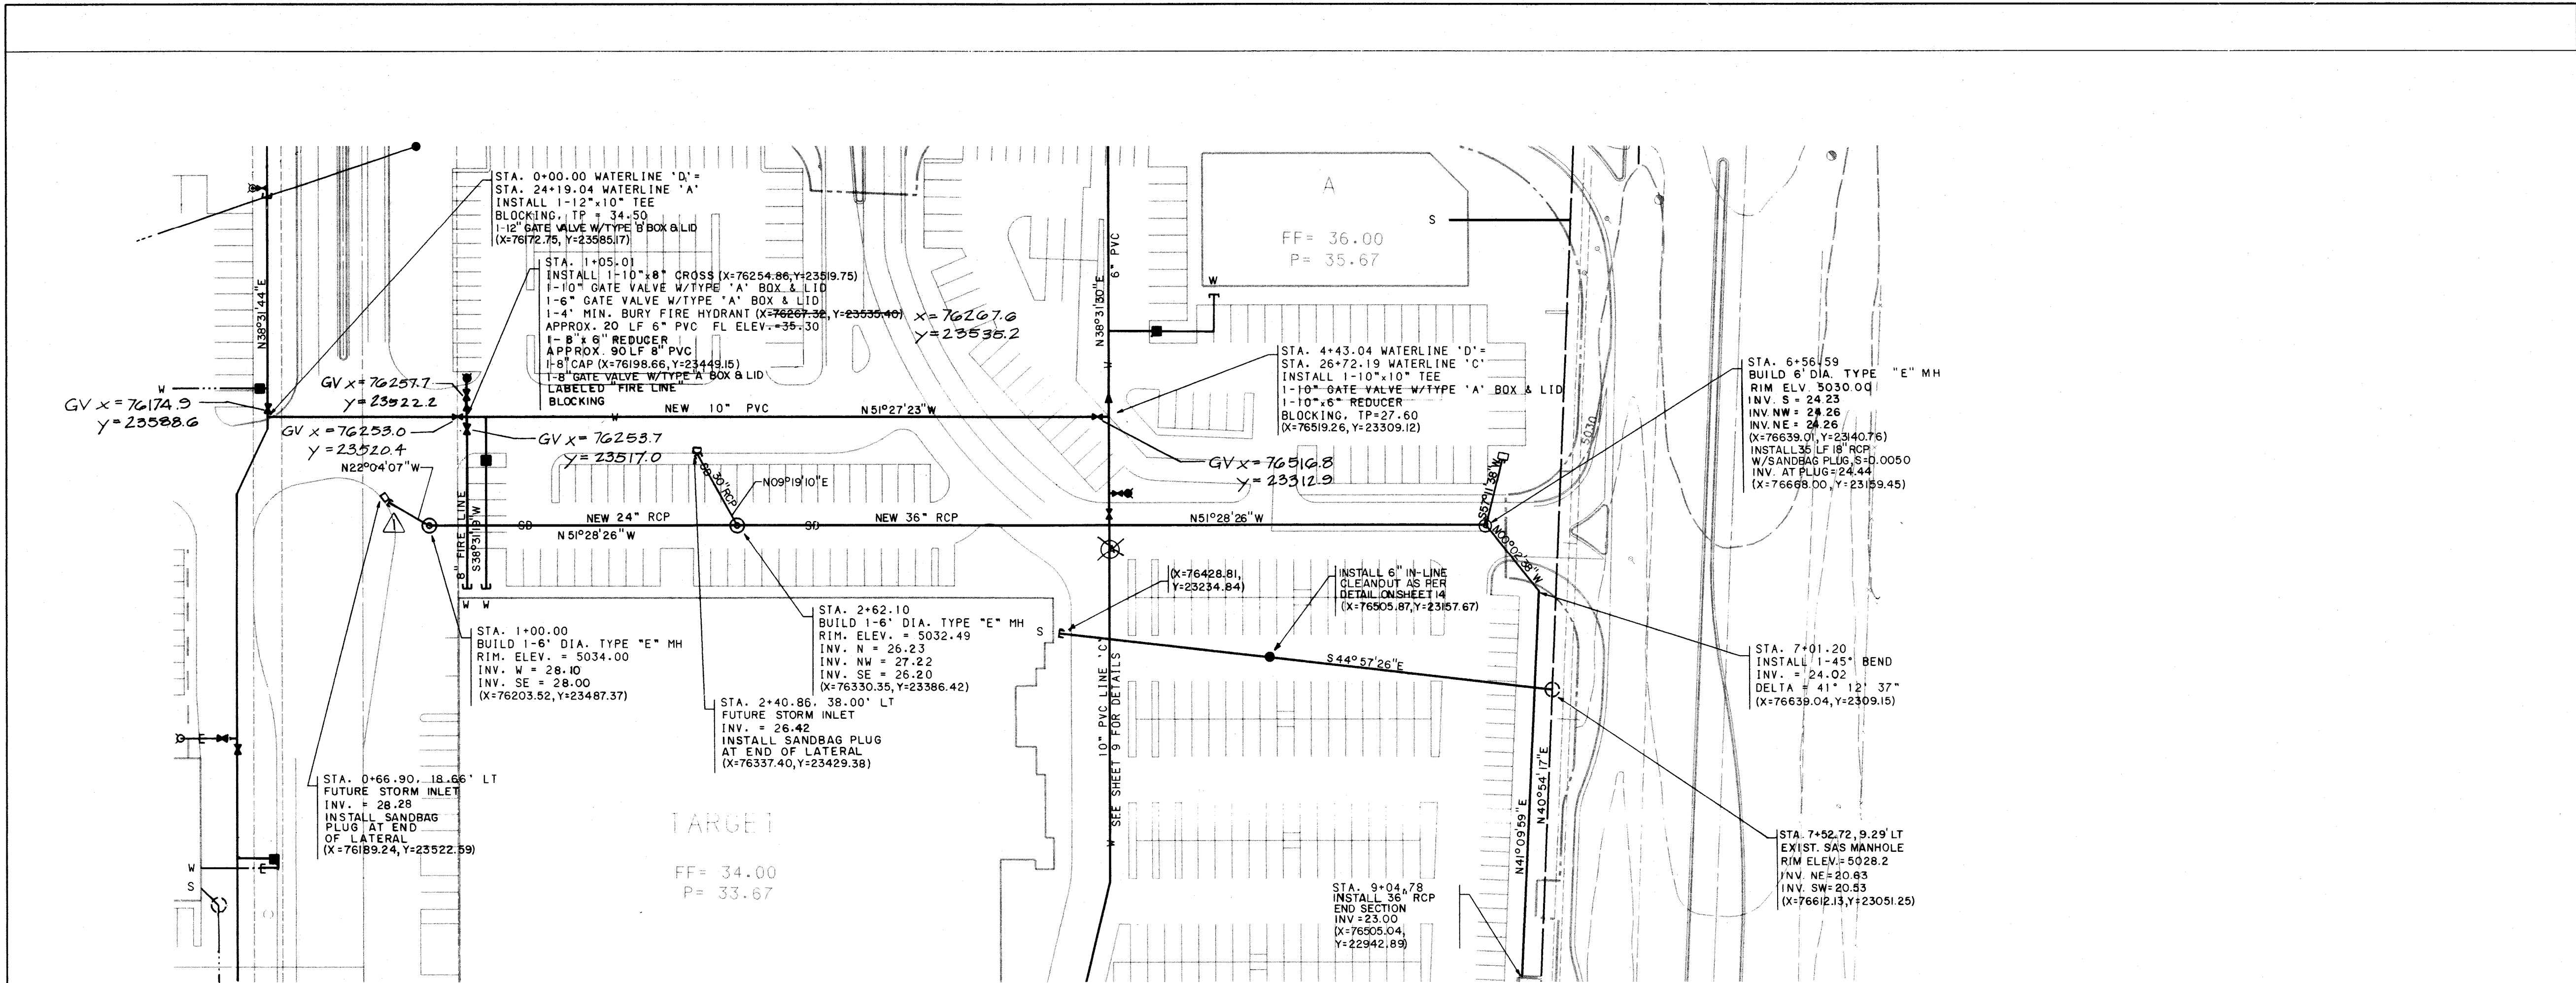

WATERLINE STATION	WL TYPE	WL SIZE	WL LGTH.	
1+05.01 RT. SNGL.	8"	90.5'	TARGET FIRE LINE	
1+15.01 RT. SNGL.	2"	90.5'	TARGET	



SAS STATION	SAS SIZE	SAS LGTH.	INV. AT PLUG	
00+00.00 RT. 6"	260'	25.65	TARGET (SLOPE=2.0%)	

ALL "AS-BUILT" INFORMATION ON THIS SHEET WAS PROVIDED BY WALKER SURVEYING COMPANY. BOHANNAN-HUSTON, INC. IS NOT RESPONSIBLE FOR THE ACCURACY OF THE AS-BUILT INFORMATION PROVIDED ON THIS SHEET.

RECORD DRAWINGS
DATE 5-24-90

BHI JOB NO. 89135.01

CITY OF ALBUQUERQUE



MARKET CENTER WEST SITE UTILITY EXTENSIONS
WATERLINE 'D' & STORM DRAIN LINE 'A'

APPROVALS	ENGINEER	DATE	APPROVALS	ENGINEER	DATE
City Engineer	Roger L. Shaw	6/5/90	Liquid Waste	CLD. PECO	6/2/89
A.C.E.-Design			Traffic	N/A	
A.C.E.-Hydrology	N/A		Water	CLD. PECO	6/2/89
			N.M. Utilities	CLD. PECO	6/2/89

DRAWING NO. 3825 MAP NO. C-13 SHEET 10 OF 14

USERNAME: C8913501
FILENAME: WATER-STORM.GRF

SCALE: 1" = 50' (HORIZ.)
1" = 10' (VERT.)

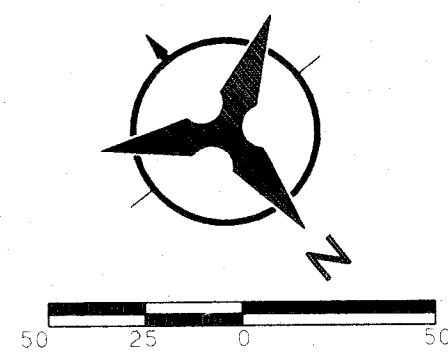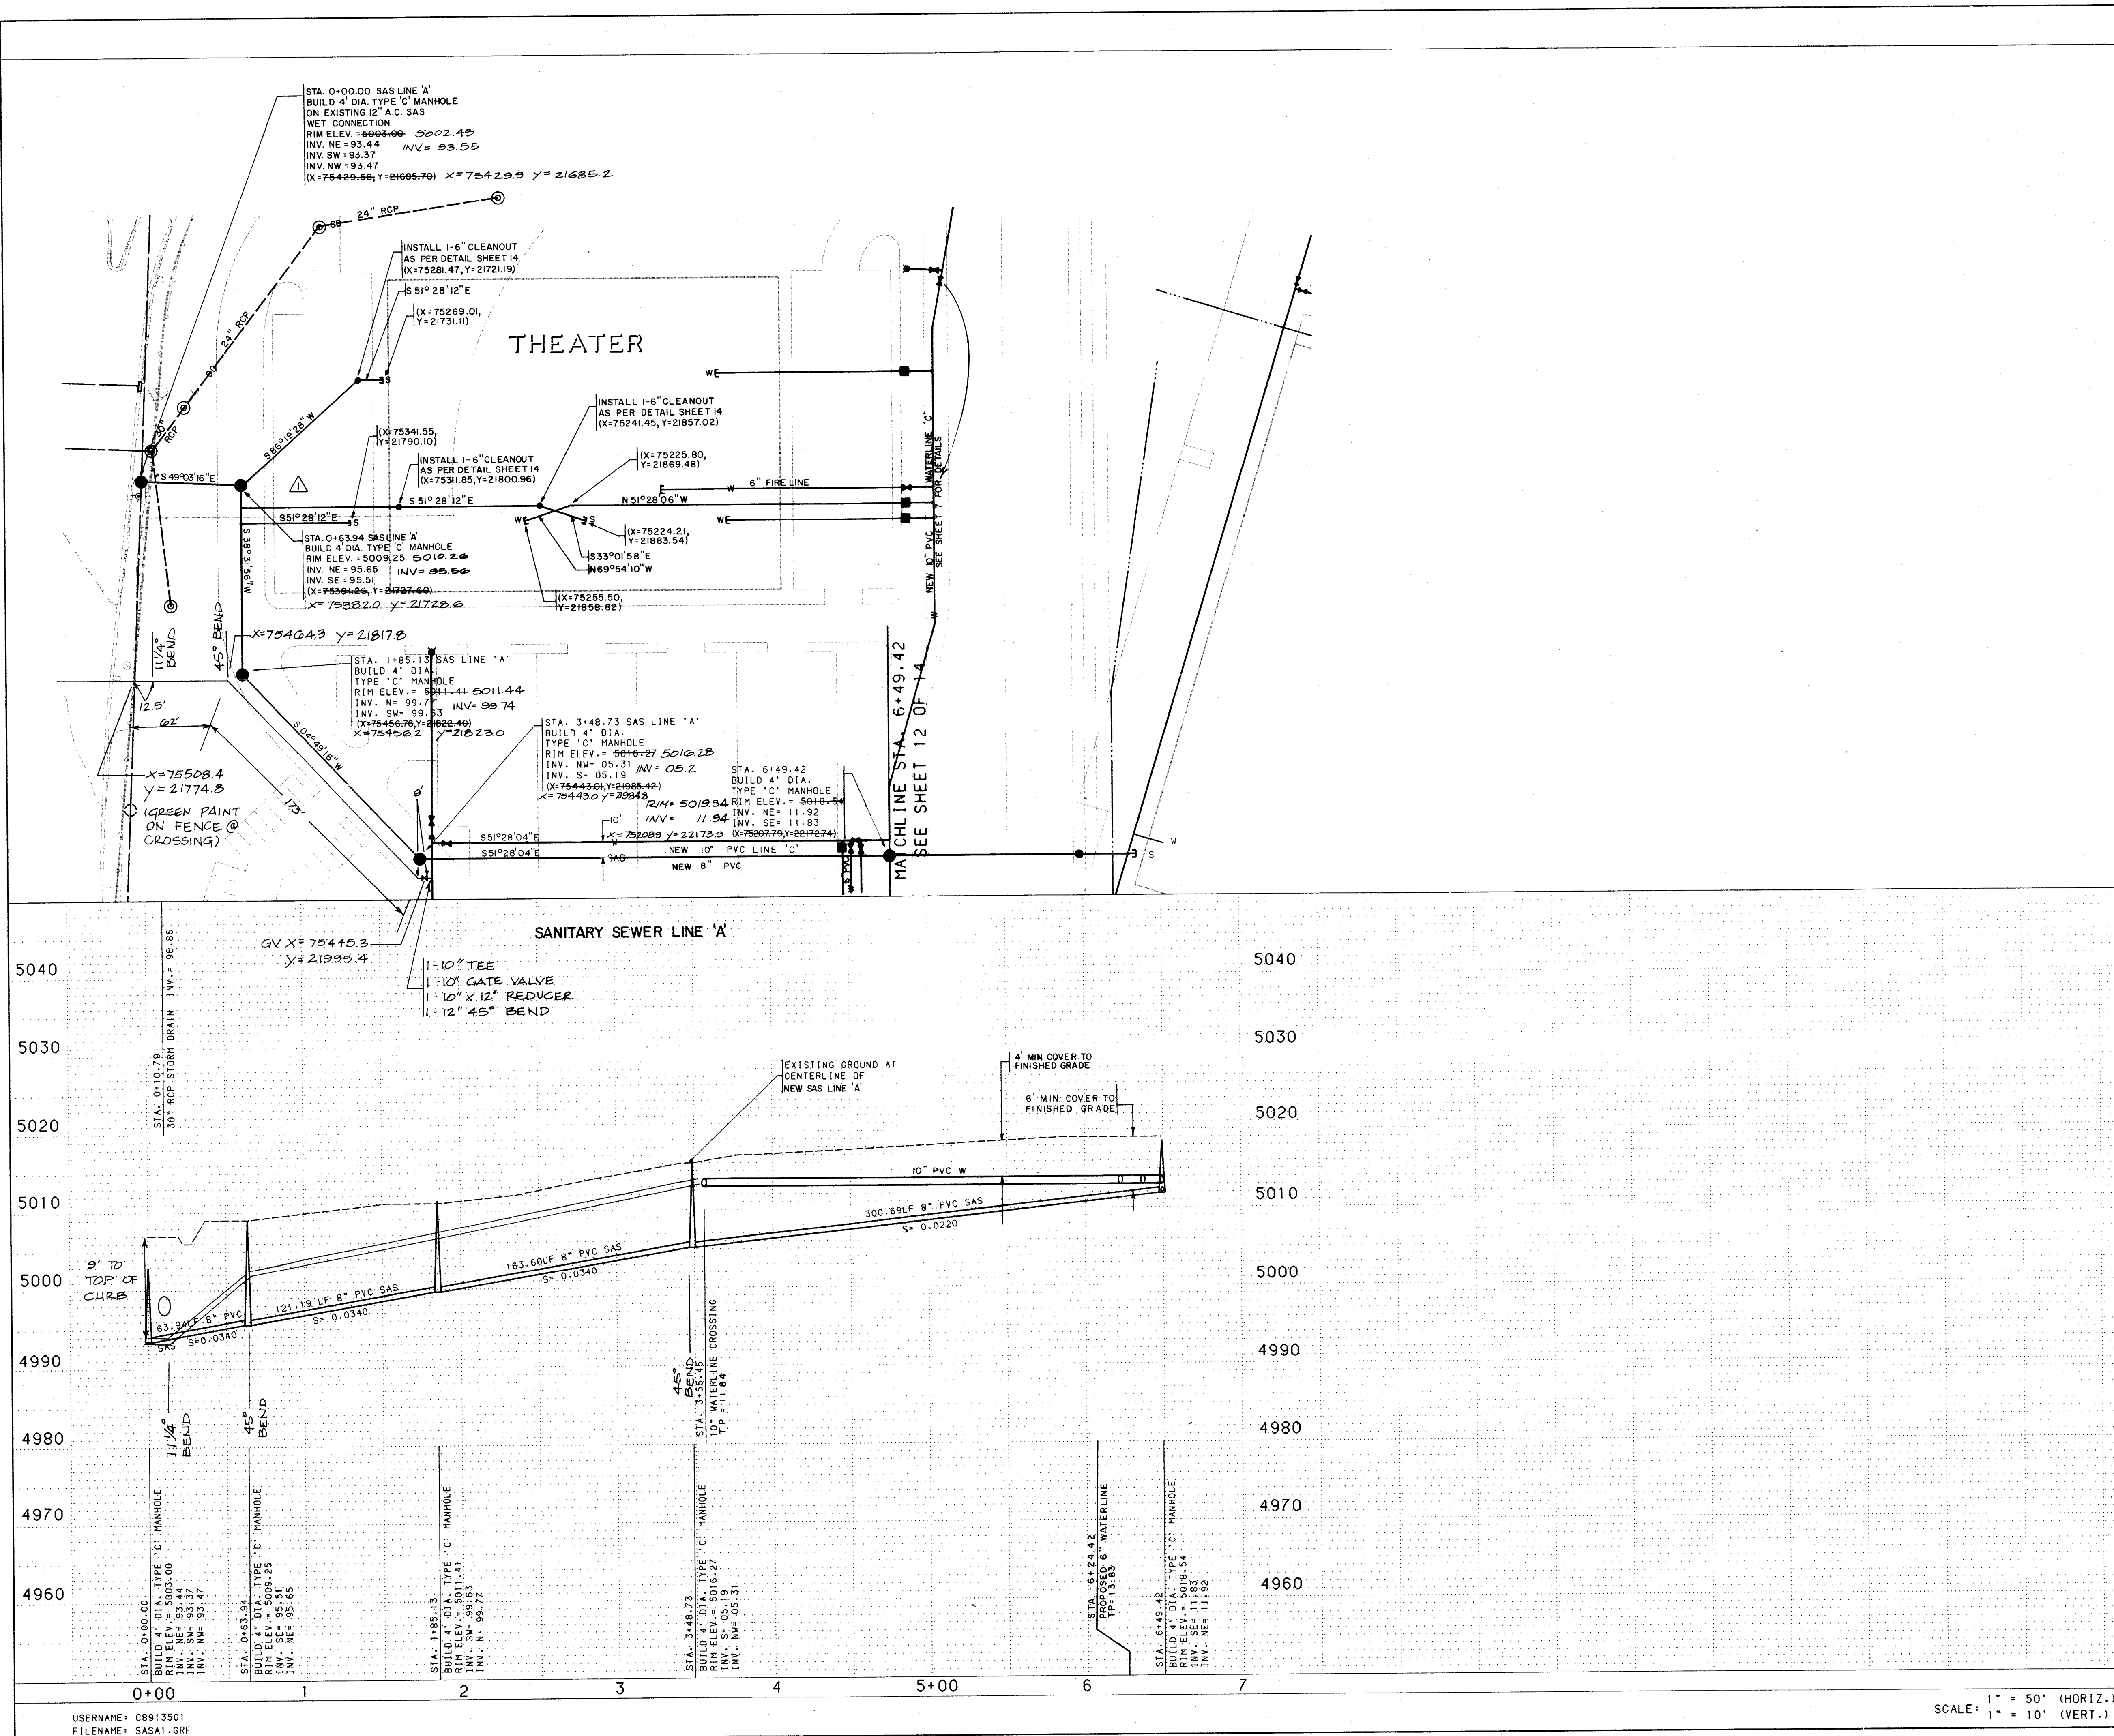

ALL "AS-BUILT" INFORMATION ON THIS SHEET WAS PROVIDED BY WALKER SURVEYING COMPANY. BOHANNAN-HUSTON, INC. IS NOT RESPONSIBLE FOR THE ACCURACY OF THE AS-BUILT INFORMATION PROVIDED ON THIS SHEET.




SAS STATION	SAS SIZE	SAS LGTH.	INV. AT PLUG	
0+63.94 LT.	6"	116'	07.25	THEATER
0+78.09 LT.	6"	222'	06.75	SHOPS "S"
0+88.09 LT.	6"	70'	06.25	SHOPS "T"

* DENOTES RISER NEEDED

RECORD DRAWINGS
DATE 5-24-90

CITY OF ALBUQUERQUE			
MARKET CENTER WEST SITE UTILITY EXTENSIONS SANITARY SEWER LINE 'A'			
APPROVALS	ENGINEER	DATE	APPROVALS
City Engineer	Regina	4/5/90	Liquid Waste
A.C.E.-Design			Traffic
A.C.E.Hydrology	N/A		Water
			N.M. Utilities
DRAWING NO. 3825		MAP NO. C-13	
SHEET 11		OF 14	

ENGINEER'S SEAL		SURVEY INFORMATION		BENCH MARKS		AS-BUILT INFORMATION	
NO. DATE		FIELD NOTES		USC & GS BRASS TABLET "R" ALAMEDA A-3" NEW MEXICO		STATE PLANE COORDINATES (CENTRAL ZONE)	
KLD BY		NO. DATE		X= 377,094.67 Y= 1,523,108.34		GROUND TO GRID FACTOR= 0.99967685	
DESIGNED BY JLP		NO. DATE		A GC= 00' 14" 13"		ELEV.= 5027.05	
DRAWN BY SAH		NO. DATE				MICRO-FILM INFORMATION	
CHECKED BY KLD		NO. DATE					

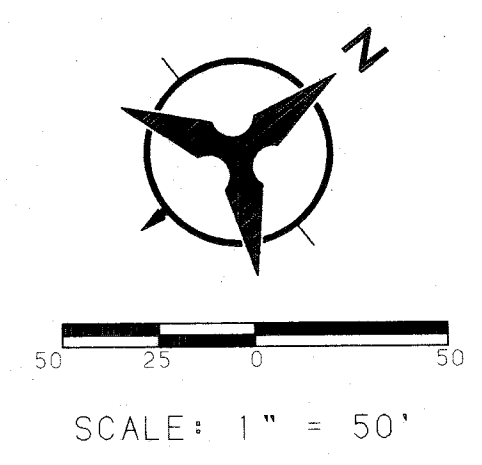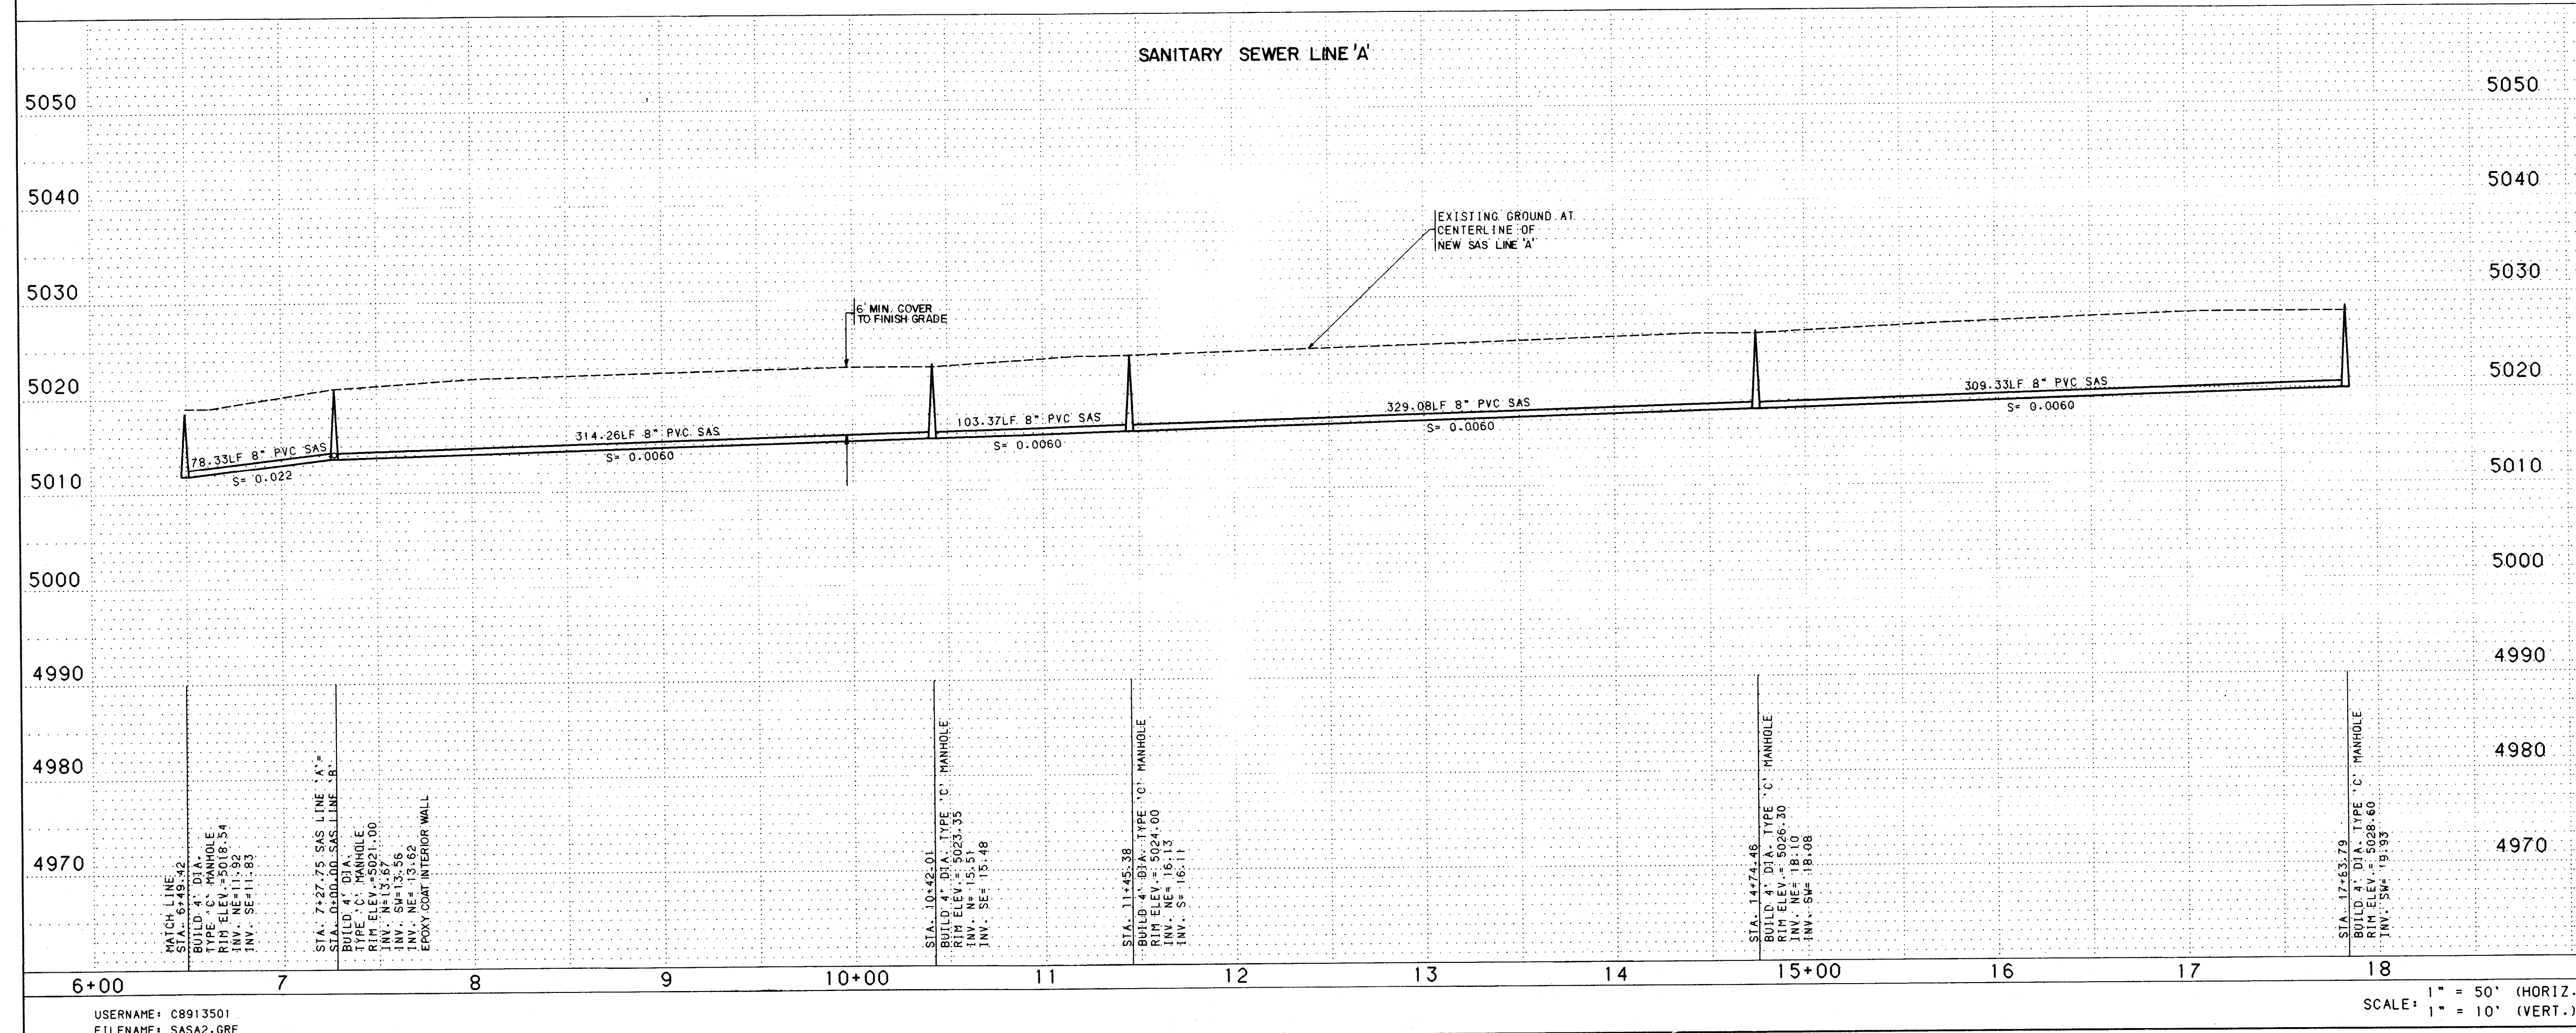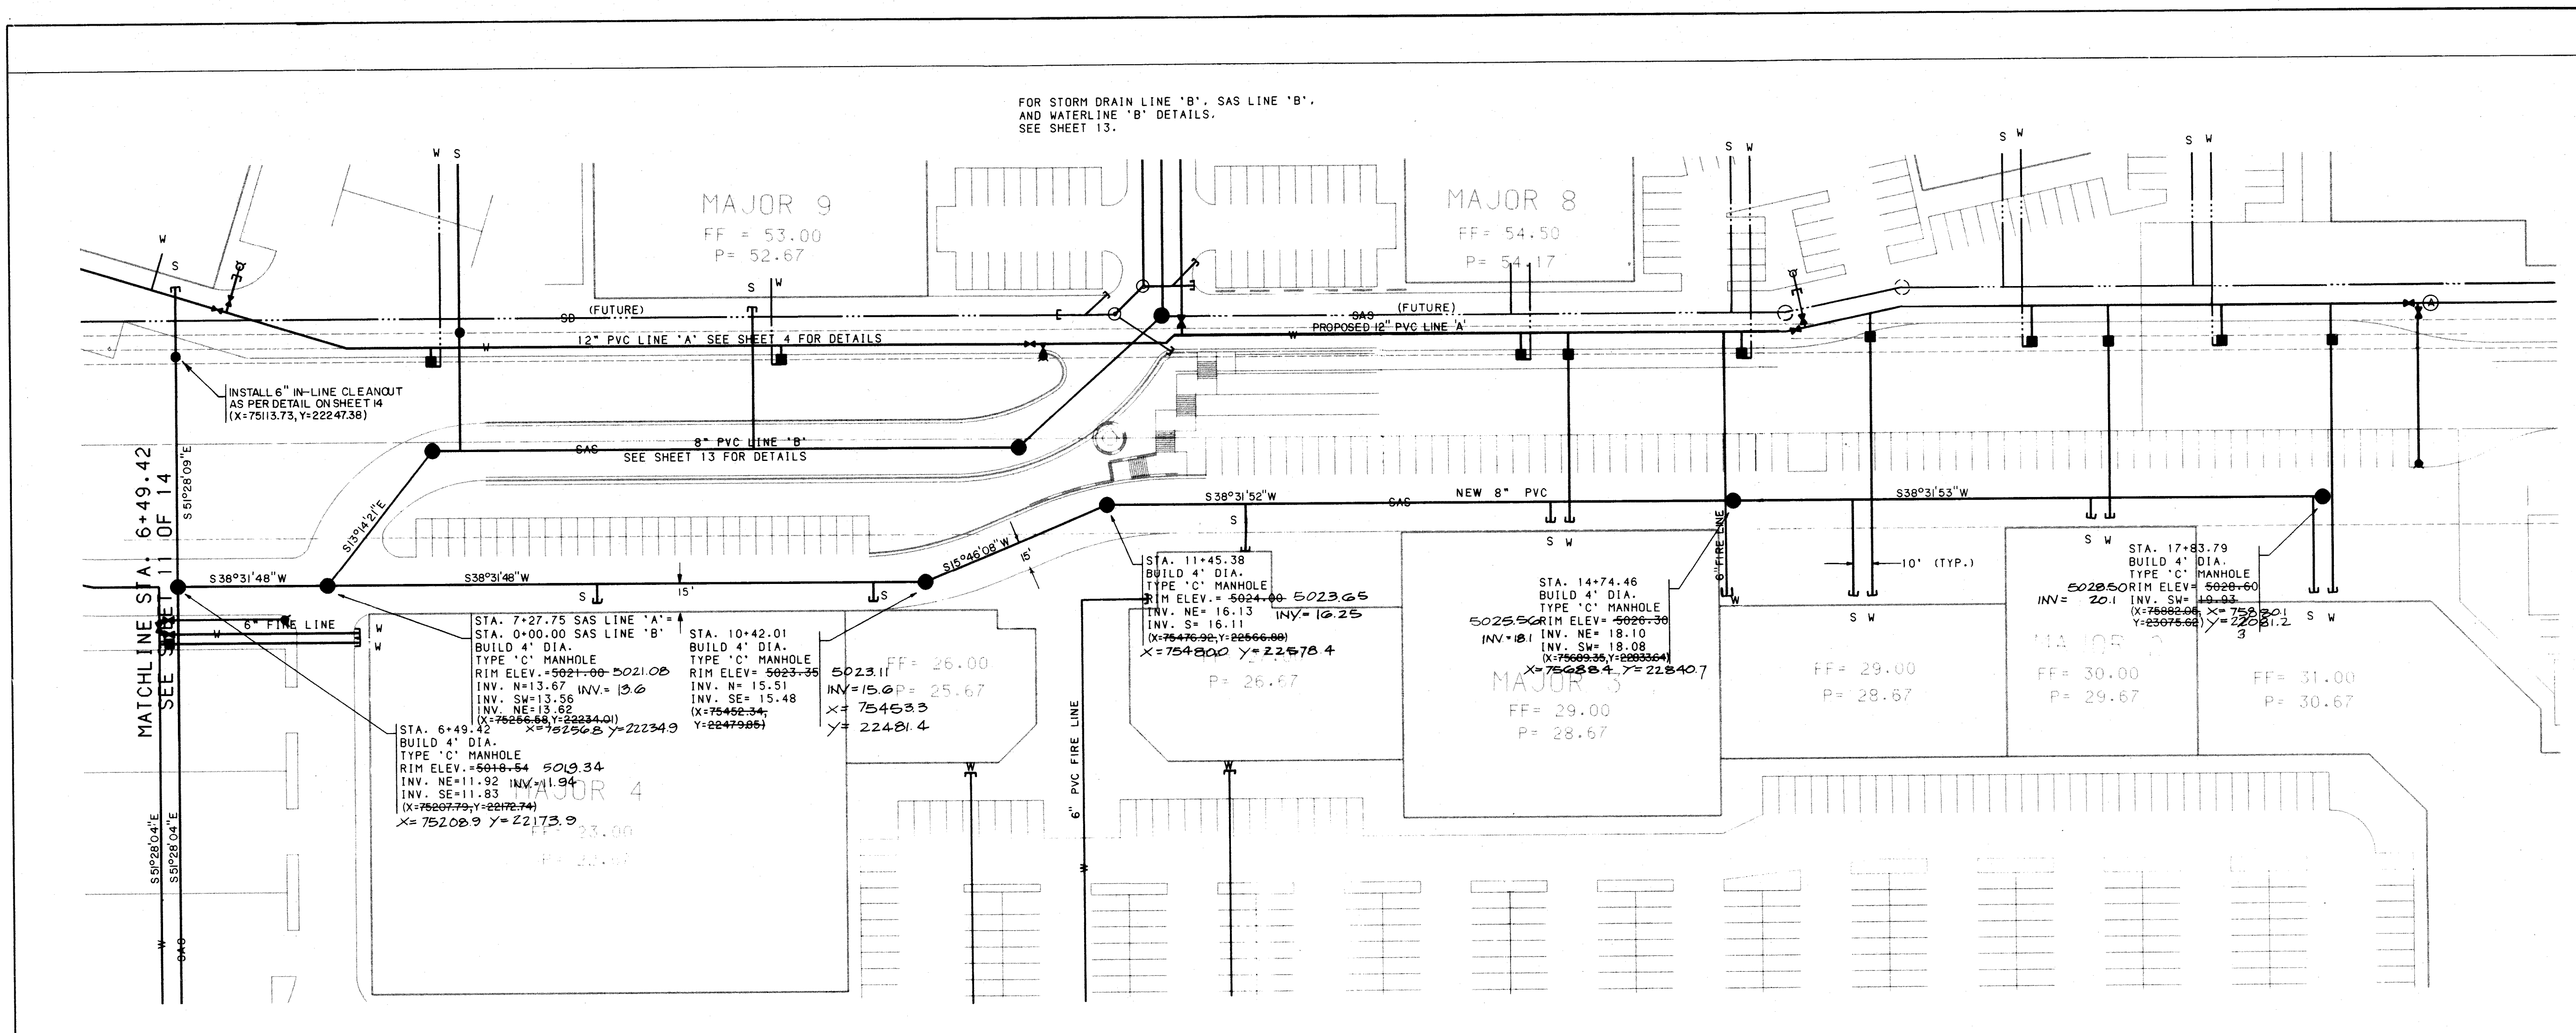

ALL "AS-BUILT" INFORMATION ON THIS SHEET WAS PROVIDED BY WALKER SURVEYING COMPANY. BOHANNAN-HUSTON, INC. IS NOT RESPONSIBLE FOR THE ACCURACY OF THE AS-BUILT INFORMATION PROVIDED ON THIS SHEET.

SAS STATION	SAS SIZE	SAS LGTH	INV. AT PLUG	
8+69.42 RT.	6"	10'	15.32	MAJOR 4
10+14.42 RT.	6"	10'	16.19	SHOPS R
12+18.20 RT.	6"	10'	17.42	SHOPS Q
13+78.37 RT.	6"	10'	18.38	MAJOR 3
15+36.87 RT.	6"	50.5'	20.14	SHOPS P
16+62.03 RT.	6"	10.5'	20.09	MAJOR 2
17+78.79 RT.	6"	50.5'	21.59	SHOPS O
6+49.42 LT.	6"	57.5'	39.00	MAJOR 10

RECORD DRAWINGS
DATE 5-24-90
BHI JOB NO. 89135.01

APPROVALS			APPROVALS		
City Engineer		DATE	Engineer		DATE
A.C.E.-Design		5/24/90	Robert L. Bailey		5/24/90
A.C.E.-Hydrology		N/A	Traffic		chkd. 5/24/90
			Water		chkd. 5/24/90
			N.M. Utilities		chkd. 5/24/90

DRAWING NO. 3825	MAP NO. C-13	SHEET 12 OF 14
------------------	--------------	----------------

MATCHLINE STA. 00+00.00= STA. 7+27.75 SHEET 12

STA. 0+89.76
BUILD 4" DIA.
TYPE 'C' MANHOLE
RIM ELEV. = 5025.24
INV. = 16.83
INV. NE = 13.67
(X=75266.09, Y=22321.99)

STA. 0+00.00 SAS LINE 'B'
STA. 7+27.75 SAS LINE 'A'
BUILD 4" DIA.
TYPE 'C' MANHOLE
RIM ELEV. = 5021.00
INV. = 13.67
INV. NE = 13.62
(X=75256.56, Y=22234.01)

INSTALL
1-6" IN-LINE CLEANOUT
AS PER DETAIL ON
SHEET 14

MAJOR 9
FF = 53.00
P = 52.67

STA. 3+97.80
BUILD 4" DIA.
TYPE 'C' MANHOLE
RIM ELEV. = 5043.74
INV. = 30.70
INV. SW = 30.51
(X=75427.96, Y=22562.36)

STA. 4+84.69 17.53' LT.
BUILD 6" DIA.
TYPE 'E' MANHOLE
RIM ELEV. = 5047.40
INV. SW = 39.11
INV. N = 39.17
INV. NE = 39.25
(X=75405.34, Y=22645.68)

STA. 5+02.55
BUILD 4" DIA.
TYPE 'C' MANHOLE
RIM ELEV. = 5047.74
INV. = 35.94
INV. S = 35.74
(X=75420.12, Y=22693.01)

STA. 7+37.59
10.00' LT.
BUILD 6" DIA.
TYPE 'E' MANHOLE
RIM ELEV. = 5058.00
INV. = 41.51
(X=75228.92, Y=22805.32)

STA. 5+18.64 10.00' LT.
BUILD 6" DIA. TYPE 'E' MANHOLE
RIM ELEV. = 5048.00
INV. S = 39.32
INV. W = 39.38
INV. NE = 39.45
(X=75402.35, Y=22666.78)


STA. 7+12.54 10.00' RT.
INSTALL 1-12" 18" TEE (X=75260.98, Y=22805.35)
1-12" GATE VALVE W/TYPE 'A' BOX & LID
1-8" GATE VALVE W/TYPE 'A' BOX & LID
1-8" CAP APPROX 40LF 8" PVC (X=75285.91, Y=22836.64)
BLOCKING

STA. 7+46.92 10.00' RT.
INSTALL 1-12" 6" TEE (X=75234.09, Y=22828.78)
1-12" GATE VALVE W/TYPE 'A' BOX & LID
1-6" GATE VALVE W/TYPE 'A' BOX & LID
1-4" MIN. BURY FIRE HYDRANT (X=75244.88, Y=22830.66)
APPROX. 31LF 6" PVC FL ELEV. = 5059.48

STA. 8+33.04
BUILD 4" DIA.
TYPE 'C' MANHOLE
RIM ELEV. = 5064.00
INV. = 52.26
(X=75460.40, Y=22875.1)

STA. 9+37.64 10.00' RT.
REMOVE EXISTING 12" CAP &
BLOCKING. CONNECT PROPOSED
12" PVC TO EXISTING 12" PVC
NON-PRESSURE CONNECTION. TP=66.50
(X=75084.90, Y=22845.58)

SANITARY SEWER LINE 'B', WATERLINE 'B', STORM DRAIN LINE 'B'

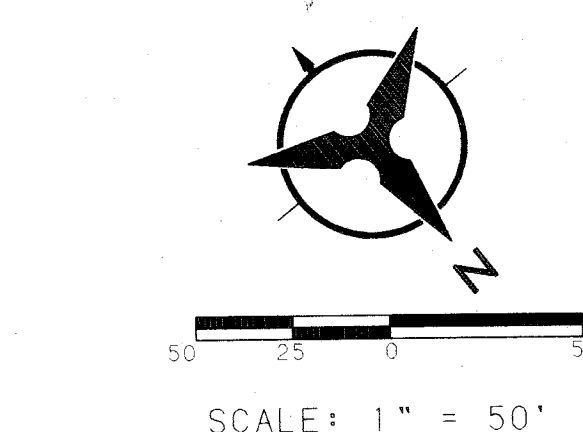


WATERLINE	STATION	WL	WL	WL
TYPE	SIZE	LGTH.		
6+27.52 LT. SNGL.	1"	48'	SHOPS S	
6+52.55 RT. SNGL.	1"	33'	SHOPS N	
9+64.93 RT. SNGL.	1"	103'	PAD E	
9+47.64 LT. SNGL.	2"	38'	LANDSCAPING	

ALL "AS-BUILT" INFORMATION ON THIS SHEET WAS PROVIDED BY WALKER SURVEYING COMPANY. BOHANNAN-HUSTON, INC. IS NOT RESPONSIBLE FOR THE ACCURACY OF THE AS-BUILT INFORMATION PROVIDED ON THIS SHEET.

SAS	SAS	SAS	INV. AT	
STATION	SIZE	LGTH.	PLUG	
1+04.47 LT.	6"	187'	47.20	SHOPS
2+58.40 LT.	6"	74.5'	47.10	MAJOR 9
6+17.53 LT.	8"	38'	43.01	SHOPS
8+42.54 RT.	6"	43'	44.37	SHOPS
8+33.04 RT.	6"	156'	56.15	PAD E

RECORD DRAWINGS
DATE 5-24-90
BHI JOB NO. 89135.01


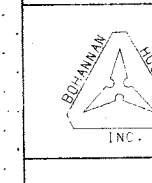


CITY OF ALBUQUERQUE

MARKET CENTER WEST SITE UTILITY EXTENSIONS
SAS LINE 'B', WATERLINE 'B', & SD LINE 'B'

APPROVALS	ENGINEER	DATE	APPROVALS	ENGINEER	DATE
City Engineer	Roger I. Brown	5/24/90	Liquid Waste	ckd. PEGO	6/2/89
A.C.E.-Design	"	"	Traffic	N/A	
A.C.E.-Hydrology	"	"	Water	ckd. PEGO	6/2/89
			N.M. Utilities	ckd. PEGO	6/2/89

DRAWING NO. 3825
MAP NO. C-13
SHEET 13 OF 14

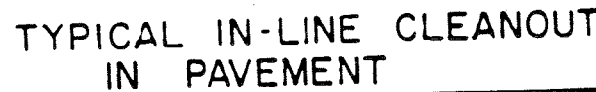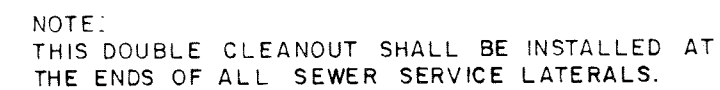

3/4" METER INSTALLATION DETAIL

1 1/2" - 2" INSTALLATIONS SHALL USE APPROPRIATE SIZE FITTINGS WITH METER FLANGES AND BRONZE CLOSE NIPPLES REPLACING-METER COUPLINGS.

*Variable Length, depending on size
of thrust reaction blocking.
Minimum Length 18"



- GENERAL NOTES:**
1. ALL PIPING AND FITTINGS SHALL BE SCH. 40, THREADED GALV. IRON.
 2. USE STANDARD C.I. MH RING AND COVER, SEE DWG 2110 COVER MARKED "WATER"
 3. FOR FUTURE ADJUSTMENT OF MH FRAME TO PAVEMENT GRADE ADD ADJUSTMENT RINGS OR GRADE MS BRICK AS SHOWN ON STANDARD MH DETAILS, SEE DWGS 2101 AND 2102.
 4. USE AS REQUIRED AND APPROVED BY WATER RESOURCES DEPT.

- CONSTRUCTION NOTES:**

- A. ASPHALT PAVING.
- B. USE CONC. COLLAR IN ALL AREAS.
- C. AIR RELEASE VALVE.
- D. GATE VALVE
- E. AIR DISCHARGE CONNECTION.
- F. TEE.
- G. KIPPLE FOR VENT AND HOSE CONNECTION.
- H. 90° ELBOW.
- J. KIPPLE.
- L 2" DIA. PIPE, VARIABLE LENGTH.
- M TAPPING SADDLE FOR PVC OR DI. PIPE
THREADED OUTLET FOR CONC CYL. PIPE.
- N. WATER MAIN
- O 1 CU YD. GRAVEL.

NEW MEXICO UTILITIES, INC., REQUIREMENTS FOR WATER FACILITIES

Use City of Albuquerque specifications with the following exceptions

1. Fire Hydrants shall be limited to Mueller A-42 Centurian, Watertown Pace 100 or Kennedy Model 185BIA. All other hydrant requirements shall meet City of Albuquerque specifications.
2. Valves 4" in size and larger shall have a 2" operating nut. This includes both gate and butterfly valves.
3. Service lines shall be of at least 1" in diameter. Smaller sizes will not be accepted.
4. Tapping saddles shall be of the double strap type. All single strap saddles must be approved by New Mexico Utilities, Inc..
5. Service fittings are detailed in exhibit "A".
6. Meter boxes for 3/4" services shall be pre-cast concrete. They will be furnished by New Mexico Utilities, Inc. Meter boxes for 1" New Mexico Utilities, Inc. yard. Meter boxes will be billed to contractor. Number of boxes required shall be furnished by New Mexico Utilities, Inc., by contractor no later than 60 days before the pick-up date.
7. Meter boxes for 1" and larger meter services shall be determined by New Mexico Utilities, Inc., and contractor on each individual job.
8. Dead end lines shall require a plug & blow-off. See exhibit "B".
9. All fire hydrant legs shall be valved.
10. Brass gate valves shall be used. Brass or bronze valves series 100.

All materials and application thereof shall be subject to approval of New Mexico Utilities, Inc.

See exhibits A through D for details required by New Mexico Utilities, Inc.

NEW MEXICO UTILITIES, INC., REQUIREMENTS FOR SEWER FACILITIES

Use City of Albuquerque specifications with the following exceptions

1. Where P.V.C. pipe is used for sewer mains, the same shall also be used for service laterals. The pipe shall be SDR-35.
2. All manholes, regardless of depth, shall be of pre-cast concrete and must comply with City of Albuquerque specifications for pre-cast manholes. Manholes must also be equipped with steps, regardless of depth. Steps shall comply with City of Albuquerque specifications for manhole steps.

See exhibits A through D for details required by New Mexico Utilities, Inc.

All materials and application thereof shall be subject to approval by New Mexico Utilities, Inc.

SURVEY INFORMATION		BENCH MARKS		AS-BUILT INFORMATION	
FIELD NOTES				CONTRACTOR	
NO.	BY	DATE		WORK STARTED BY	DATE
				INSPECTOR'S PERFORMANCE BY	DATE
				VERIFICATION BY	DATE
				CORRECTED BY	DATE
				MICRO-FILM INFORMATION	
				RECORDED BY	DATE
				NO.	

ENGINEER'S SEAL

NO.		DATE	REMARKS	BY
REVISIONS				
DESIGN				
DESIGNED BY		DATE		
DRAWN BY		DATE		
		DATE		

ALL "AS-BUILT" INFORMATION ON THIS SHEET WAS PROVIDED BY WALKER SURVEYING COMPANY. BOHANNAN-HUSTON, INC. IS NOT RESPONSIBLE FOR THE ACCURACY OF THE AS-BUILT INFORMATION PROVIDED ON THIS SHEET.

RECORD DRAWINGS
DATE **5-24-90**

CITY OF ALBUQUERQUE

TITLE:
MARKET CENTER WEST SITE UTILITY EXTENSIONS
DETAIL SHEET

APPROVALS	ENGINEER	DATE	APPROVALS	ENGINEER	DATE
City Engineer	<i>Reginald H.</i>	<i>6/5/18</i>	Liquid Waste	<i>chkd. P. GAO</i>	<i>6/2/18</i>
A.C.E. - Design	"	"	Traffic	<i>N/A</i>	
A.C.E. - Hydrology	<i>n/a</i>		Water	<i>chkd. P. GAO</i>	<i>6/2/18</i>
			N.M. Utilities	<i>N/A</i>	<i>6/2/18</i>

DRAWING NO.	3825	MAP NO.	C-13	SHEET	14	OF	14
-------------	------	---------	------	-------	----	----	----