


REV.	OF 1	CITY ENGINEER	DATE	USER DEPT.	DATE	USER DEPT.	DATE
		Roger L. Green	11/16/89	Robert W. Kane	11/16/89	N/A	
APPROVAL OF REVISIONS							

KEYED NOTES

- REMOVE EXISTING TEMPORARY CLEANOUT INCLUDING BLOCKING. CONNECT NEW 8" PVC SAS TO EXISTING 8" PVC SAS.
- INSTALL 4" SEWER SERVICE LINE PER C.O.A. STANDARD DETAIL DRAWING NO. 2125.
- CONSTRUCT NEW TEMPORARY CLEANOUT PER DETAIL. FINISH GRADE = 5110.20.

SCALE: HORIZ. 1" = 50'
VERT. 1" = 10'

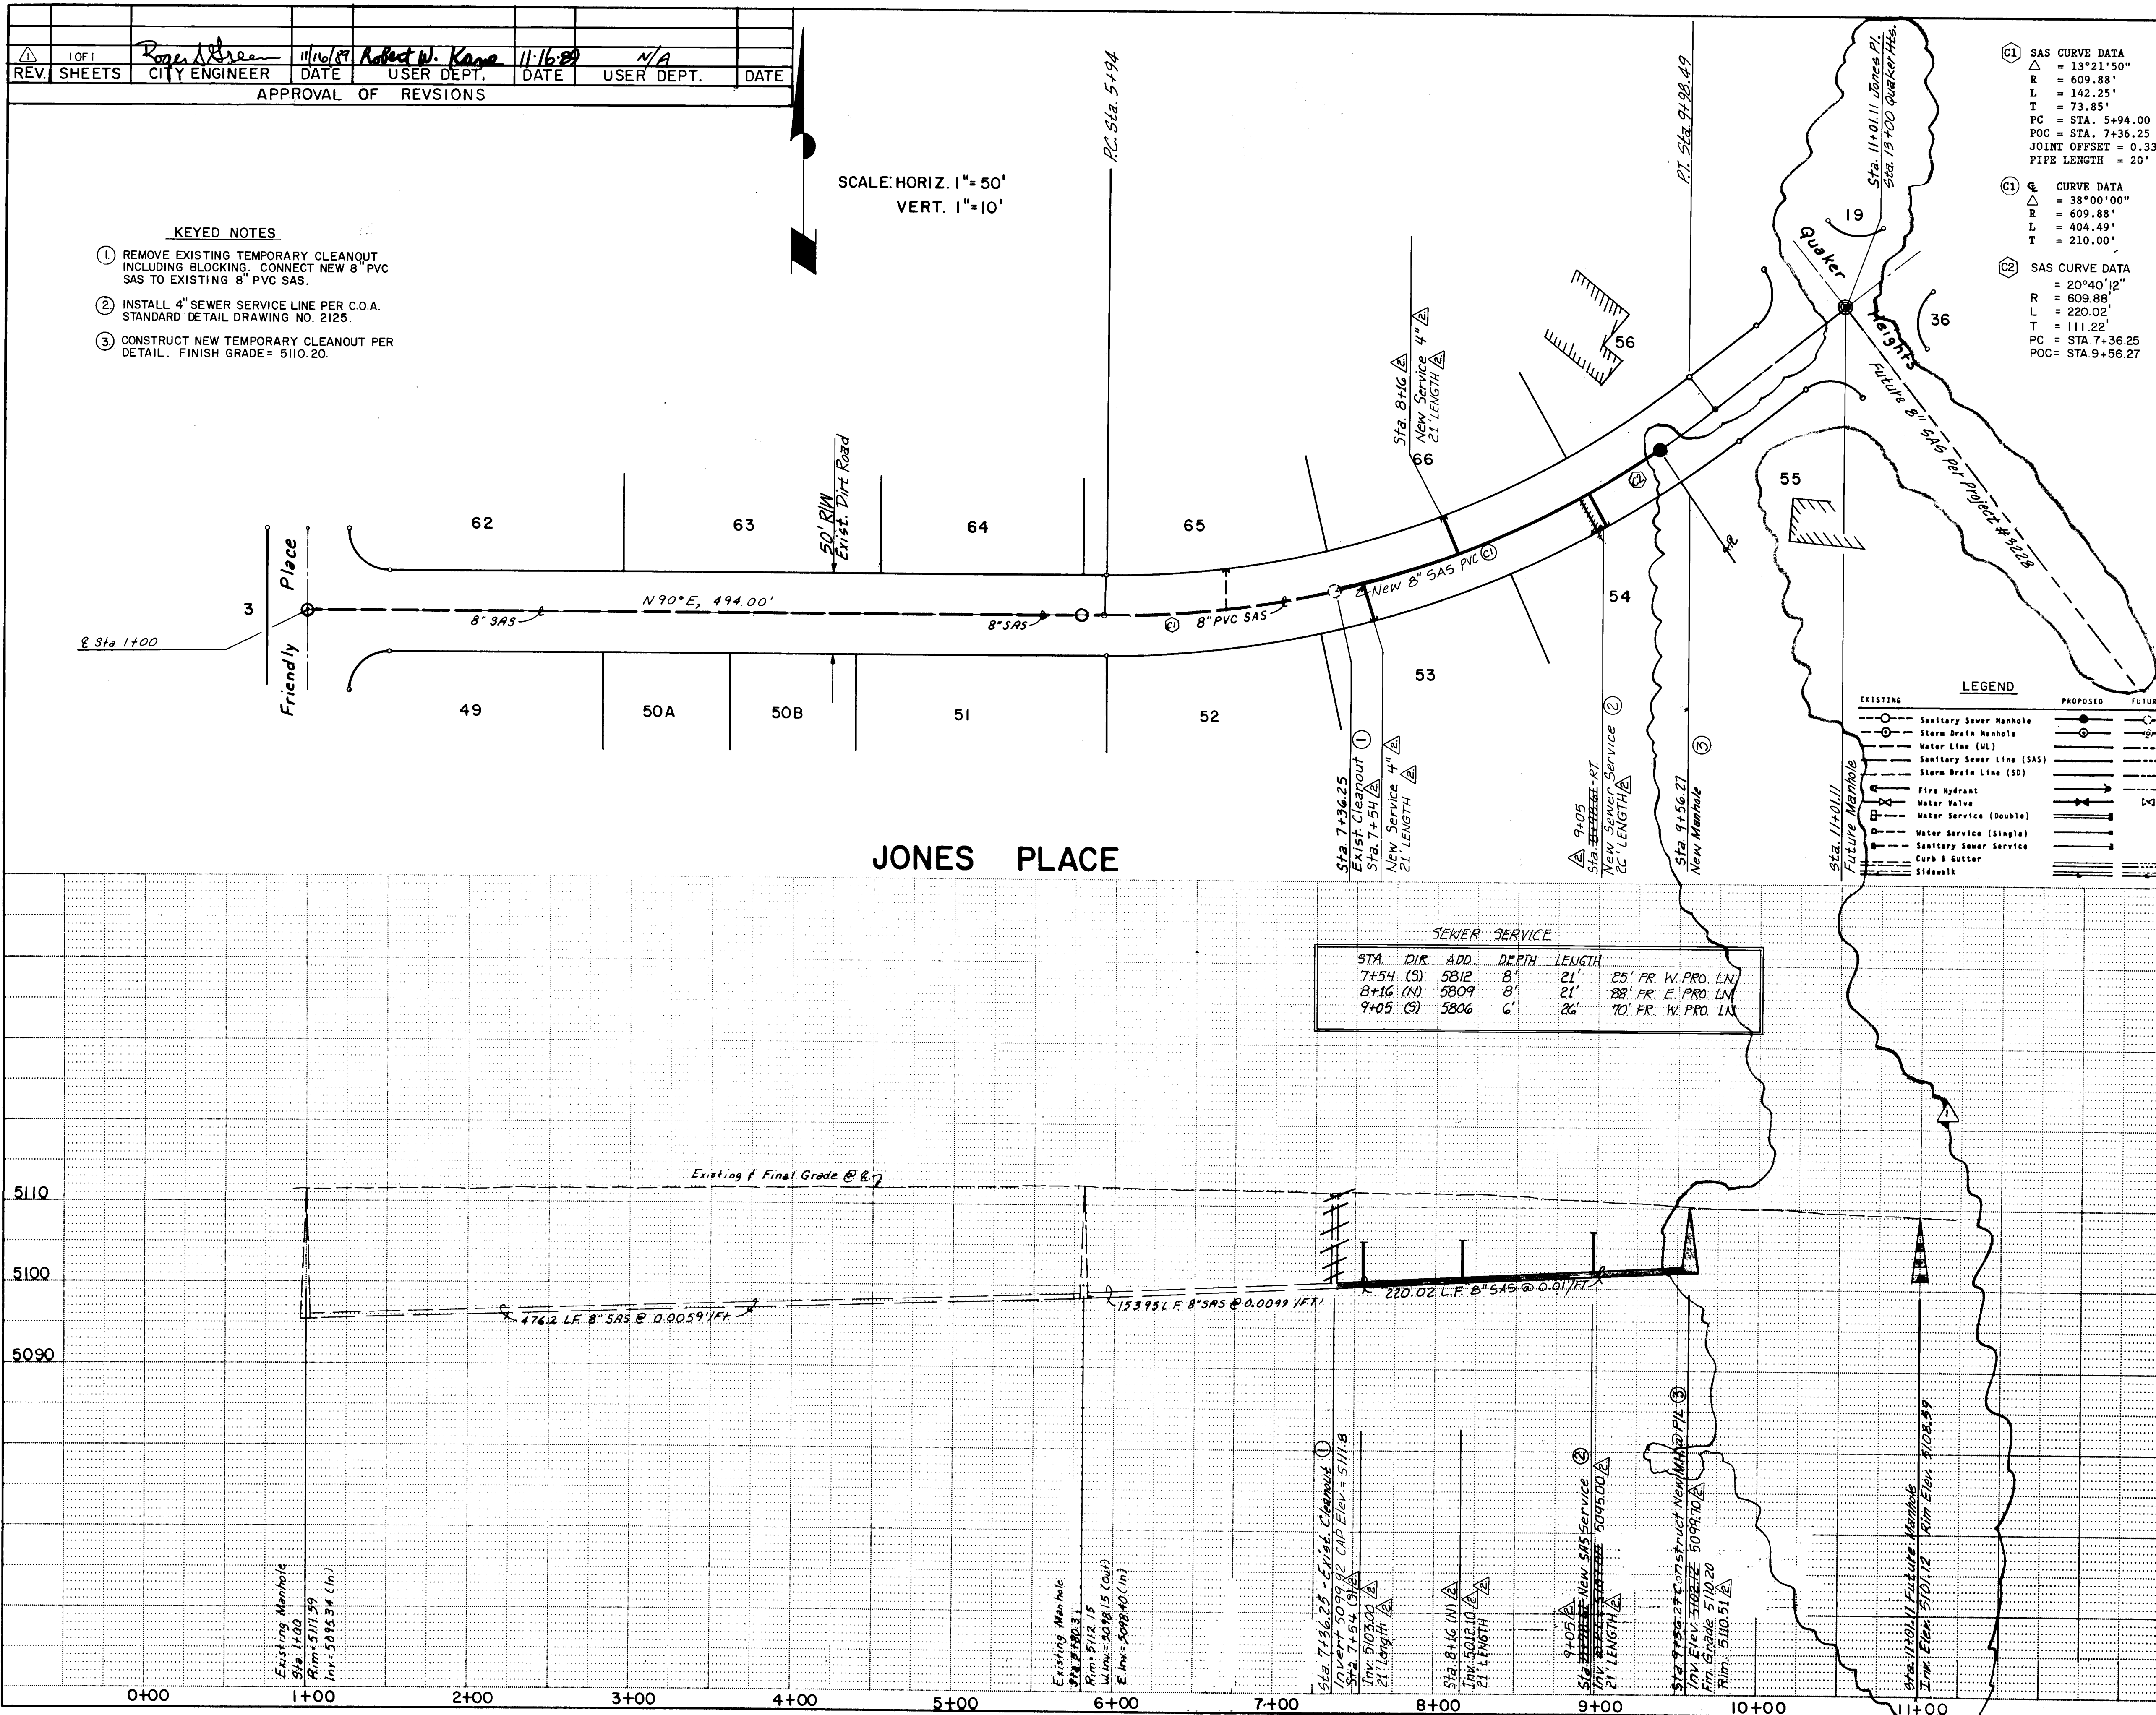

SEWER SERVICE					
STA.	DIR.	ADD.	DEPTH	LENGTH	
7+54	(S)	5812	8'	21'	25' FR. W. PRO. LN.
8+16	(N)	5809	8'	21'	28' FR. E. PRO. LN.
9+05	(S)	5806	6'	26'	10' FR. W. PRO. LN.

NOTICE TO CONTRACTORS

- ALL WORK DETAILED ON THESE PLANS TO BE PERFORMED UNDER CONTRACT SHALL, EXCEPT AS OTHERWISE STATED OR PROVIDED FOR HEREBY, BE CONSTRUCTED IN ACCORDANCE WITH THE CITY OF ALBUQUERQUE STANDARD SPECIFICATIONS FOR PUBLIC WORKS CONSTRUCTION 1986.
- TWO (2) WORKING DAYS PRIOR TO ANY EXCAVATION, THE CONTRACTOR MUST CONTACT LINE LOCATING SERVICE 765-1234, FOR LOCATION OF EXISTING UTILITIES.
- PRIOR TO CONSTRUCTION, THE CONTRACTOR SHALL EXCAVATE AND VERIFY THE HORIZONTAL AND VERTICAL LOCATIONS OF ALL OBSTRUCTIONS. SHOULD A CONFLICT EXIST, THE CONTRACTOR SHALL NOTIFY THE ENGINEER OR SURVEYOR SO THAT THE CONFLICT CAN BE RESOLVED WITH MINIMUM AMOUNT OF DELAY.
- TWO (2) WORKING DAYS PRIOR TO CONSTRUCTION, CONTRACTOR SHALL OBTAIN A BARRICADING PLAN AND PERMIT THROUGH TRAFFIC ENGINEER DIVISION AT 768-2552.
- BACKFILL COMPACTION SHALL BE ACCORDING TO SPECIFIED STREET USE. (RESIDENTIAL)

AS BUILT INFORMATION

CONTRACTOR: NEW CONCEPTS

WORK STARTED BY: CITY

DATE: 11/16/89

ACCEPTANCE BY: N/A

DATE: 12/1/89

FIELD CHECK BY: N/A

DATE: 12/1/89

REVISIONS

NO. DATE

DESIGNED BY: JOHN CURTIN

DRAWN BY: JOHN CURTIN

CHECKED BY: JOHN CURTIN

ENGINEER'S SEAL

APPROVAL OF AS BUILT DRAWINGS

CHIEF CONSTRUCTION ENGINEER

DATE: 12/15/91

26 3851 0189

APPROVAL OF AS BUILT DRAWINGS

CHIEF CONSTRUCTION ENGINEER

DATE: 12/15/91

26 3851 0189

APPROVAL OF AS BUILT DRAWINGS

CHIEF CONSTRUCTION ENGINEER

DATE: 12/15/91

26 3851 0189

CITY OF ALBUQUERQUE

PUBLIC WORKS DEPARTMENT

ENGINEERING GROUP

TITLE: SANITARY SEWER LINE EXTENSION ON JONES PLACE FOR LOT 54

APPROVALS

ENGINEER: Roger L. Green

DATE: 11/16/89

TRANS. DEV. R.W. Kane

UTILITY DEV. R.W. Kane

DATE: 11/16/89

DATE: 11/16/89

DATE: 11/16/89

DRAWING NO. 3851

MAP NO. F-11

SHEET 1 OF 1