




HIGH RIDGE SHOPPING CENTER
NW CORNER OF TRAMWAY BLVD
&
INDIAN SCHOOL RD NE

NEW SANITARY SEWER LINE
DECELERATION LANES
MEDIAN REVISIONS
NEW WATERLINES
NEW FIRE HYDRANT

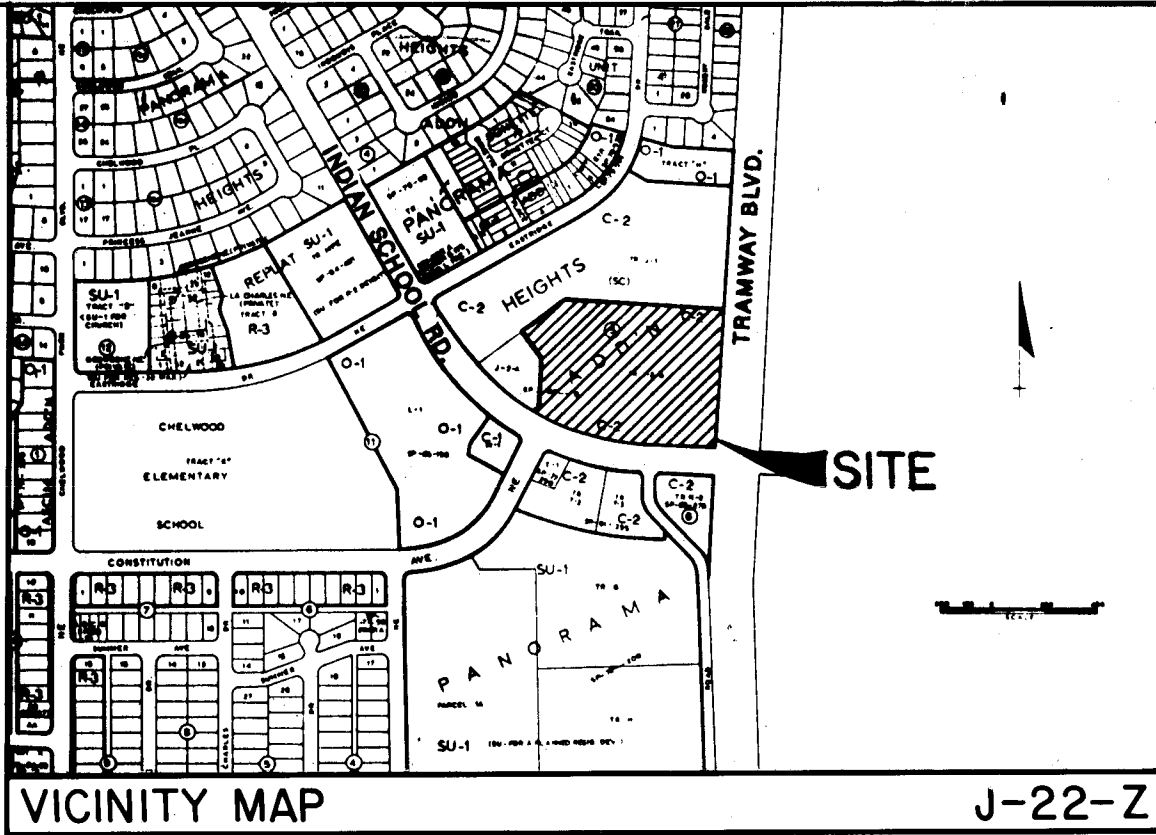


INDEX TO SHEETS

- 1 OF 10 TITLE SHEET
- 2 OF 10 PLAT
- 3 OF 10 GENERAL NOTES AND PROJECT LEGEND
- 4 OF 10 OVERALL UTILITY PLAN, OVERALL GRADING PLAN
- 5 OF 10 OVERALL PAVING PLAN
- 6 OF 10 WATER LINE - FIRE HYDRANT
- 7 OF 10 WATER LINE & SANITARY SEWER LINE
- 8 OF 10 INDIAN SCHOOL ROAD DECELERATION LANES
- 9 OF 10 INDIAN SCHOOL ROAD MEDIAN REVISIONS
- 10 OF 10 BARRICADE PLAN

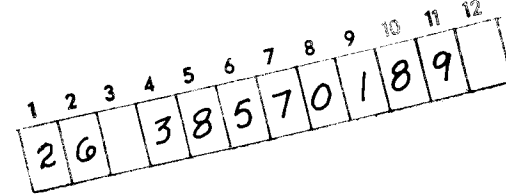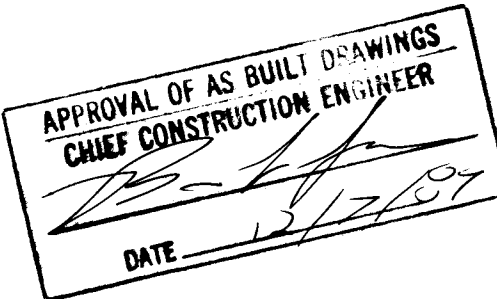

REV.	SHEETS	CITY ENGINEER	DATE	USER DEPARTMENT	DATE	USER DEPARTMENT	DATE
APPROVAL OF REVISIONS							
PROJECT NO. 3857				APPROVED FOR CONSTRUCTION 6/15/89 C.E.			
SHEET 1 OF 10							

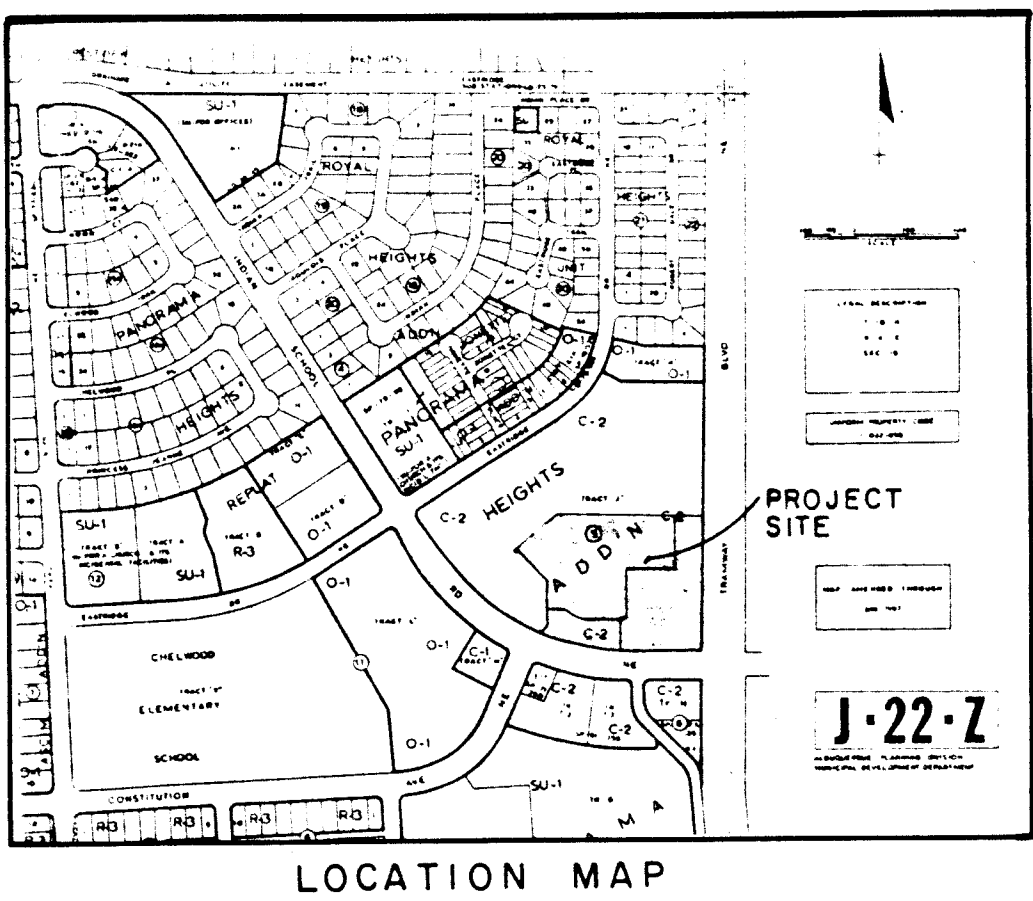

LOCATION MAP

SUBDIVISION DATA

- DRB No. 89-212
- Zone Atlas Index No. J-22-Z
- Gross Subdivision Acreage: 8.4222
- Total Number of Tracts Created: Three (3) Tracts
- No street mileage created with the filing of this plat.
- This plat shows existing easements.
- The purpose of this plat is to divide Tract J-2-B into three tracts (Tracts J-2-B-1, J-2-B-2 and J-2-B-3) and also to grant the twenty foot (20') Public Waterline Easement.
- This plat was prepared from Plats of Record and field work previously performed by A & E Engineering, Inc.

NOTES:

- Unless otherwise indicated, all corners are 4 rebar w/ plastic cap stamped LS 5949.
- Bearings shown hereon are based on bearings shown on 'Corrected Redivision Plat of Tracts J-1 and J-2, Block 5, Panorama Heights, as the same is shown on the plat of record filed in the Office of the County Clerk of Bernalillo County, New Mexico on December 27, 1985, in Book C29, Page 43.
- All distances shown hereon are ground distances.
- There is a rotation factor of 00°06'48" clockwise to obtain New Mexico State Plane Grid Bearings (Central Zone).
- Maintenance of 24' Private Access and Drainage Easement to be responsibility of owners of Tracts J-2-A, J-2-B-1, J-2-B-2 and J-2-B-3.
- Cross Access and Parking Easements in accordance with the approved Site Development Plan is granted by this plat to serve Tract J-2-A, J-2-B-1, J-2-B-2 and J-2-B-3. Reciprocal Cross Private Drainage Easements in accordance with the approved Drainage Report and Plan is granted by this plat to serve Tracts J-2-A, J-2-B-1, J-2-B-2 and J-2-B-3. The maintenance of these drainage facilities will be at the owners cost in accordance with the approved Drainage Report. Furthermore the owner(s) and/or proprietor(s) and beneficiary's of Tracts J-2-A, J-2-B-1, J-2-B-2 and J-2-B-3, will be responsible for the construction and maintenance of these facilities.
- Prior to development, City of Albuquerque Water and Sanitary Sewer Service to Tract J-2-B-1, J-2-B-2 and J-2-B-3 must be verified and coordinated with the Water Utilities Department, City of Albuquerque, via a request for a water and sanitary sewer availability statement.

Legal Description

A certain tract of land situate within Section 15, Township 10 North, Range 4 East, New Mexico Principal Meridian, City of Albuquerque, Bernalillo County, New Mexico, said tract of land being designated as Tract J-2-B, Block 5, Panorama Heights, as the same is shown and designated on the plat of record filed in the office of the County Clerk of Bernalillo County, New Mexico on March 09, 1988, in Book C-36, Page 10, and being more particularly described by metes and bounds as follows:

Beginning at the Southwest corner of the tract herein described, said point being at the intersection of Indian School Road, N.E. and Tramway Boulevard, N.E., whence a found City of Albuquerque Brass Cap stamped "J-23-A" bears N 40°32'09" E, a distance of 161.85 feet; Thence leaving said point of beginning and running along the North right of way line of Indian School Road N.E. on a bearing of N 87°40'25" W, a distance of 156.43 feet to a point of curvature; Thence running along said curve to the right, said being on the North right-of-way line of Indian School Road, N.E., having a radius of 143.38 feet, a Delta of 03°47'41", an arc length of 9.50 feet and a chord bearing of N 73°18'40", a distance of 9.49 feet to a point of reverse curvature; Thence running along said curve to the left, said curve being on the North Right-of-way line of Indian School Road, N.E., having a Radius of 156.62 feet, a Delta of 16°15'37", an arc length of 44.45 feet and a chord bearing of N 79°32'36" W, a distance of 44.30 feet to a point of tangency; Thence continuing along the North right-of-way line of Indian School Road, N.E., on a bearing of N 87°40'25" W, a distance of 75.00 feet to a point of curvature; Thence running along said curve to the right, said curve being on the North Right-of-way line of Indian School Road, N.E., having a Radius of 893.31 feet, a Delta of 02°49'02", an arc length of 43.92 feet and a chord bearing of N 86°15'54" W, a distance of 43.92 feet to a point on said curve; Thence running on a bearing of S 02°04'55" W, a distance of 6.63 feet to a point on a curve; Thence running along said curve to the right, said curve being on the North Right-of-way line of Indian School Road, N.E., having a Radius of 901.93 feet, a Delta of 11°50'07", an arc length of 186.31 feet and a chord bearing of N 78°58'05" W, a distance of 185.98 feet to a point of compound curvature; Thence running along said curve to the right, said curve being on the North right-of-way line of Indian School Road, N.E., having a Radius of 143.38 feet, a Delta of 05°35'12", an arc length of 13.98 feet and a chord bearing of N 58°48'57" W, a distance of 13.97 feet to a point on a reverse curve; Thence running along said curve to the left, said curve being on the North right-of-way line of Indian School Road, N.E., having a radius of 156.62 feet, a Delta of 13°47'03", an arc length of 37.68 feet and a chord bearing of N 62°54'52" W, a distance of 37.59 feet to a point on a reverse curve; Thence running along said curve to the right, said curve being on the North right-of-way line of Indian School Road, N.E., having a Radius of 893.31 feet, a Delta of 06°49'59", an arc length of 106.54 feet and a chord bearing of N 66°23'24" W, a distance of 106.47 feet to a point on said curve; Thence running on a bearing of S 02°04'54" W, a distance of 9.50 feet to a point on a curve; Thence running along said curve to the right, said curve being on the North right-of-way line of Indian School Road, N.E., having a Radius of 901.93 feet, a Delta of 03°31'35", an arc length of 55.51 feet and a chord bearing of N 61°27'54" W, a distance of 55.50 feet to the Southwest corner of said tract; said point being on a point of intersection on a curve; Thence leaving said North right-of-way line of Indian School Road, N.E., and running along said curve to the left, having a radius of 35.00 feet, a Delta of 74°34'24", an arc length of 45.55 feet and a chord bearing of N 39°22'07" E, a distance of 42.41 feet to a point of tangency; Thence running on a bearing of N 02°04'55" E, a distance of 175.30 feet to a point; Thence running on a bearing of N 37°55'05" W, a distance of 130.53 feet to a point on west boundary of said tract; Thence running on a bearing of N 52°04'55" E, a distance of 212.17 feet to the northwest corner of said tract; Thence running on a bearing of S 87°55'05" E, a distance of 602.74 feet to the Northeast corner at said tract, said point being on the west right-of-way line of Tramway Blvd., N.E.; Thence running along the west right-of-way line of Tramway Blvd., N.E. on a bearing of S 02°04'55" W, a distance of 553.80 feet to the point and place of beginning, containing an area of 366,371.8922 sq. ft. or 8.4222 acres more or less.

8914813

PLAT

SHOWING

TRACTS J-2-B-1, J-2-B-2
AND J-2-B-3
FORMERLY BEING TRACT J-2-B
BLOCK 5, PANORAMA HEIGHTS
ALBUQUERQUE, BERNALILLO COUNTY, NEW MEXICO
APRIL, 1989

Dedication and Free Consent:

Replatted and now being Tracts J-2-B-1, J-2-B-2 and J-2-B-3, Block 5, Panorama Heights, City of Albuquerque, Bernalillo County, New Mexico, is with the free consent of and in accordance with the wishes and desires of the undersigned owner(s) and/or proprietor(s) thereof. Said owner(s) and/or proprietor(s) do also grant any easement shown (for the purpose shown). The 20' Public Waterline Easement, including power and communication easements, and including rights of ingress for construction and maintenance, and the right to trim interfering trees; and hereby certify that this redivision is their free act and deed.

HIGH RIDGE PARTNERS LTD.
A NEW MEXICO LIMITED PARTNERSHIP

GENE E. HINKLE, GENERAL PARTNER

ROBERT B. KEERAN, GENERAL PARTNER

STATE OF NEW MEXICO }
COUNTY OF BERNALILLO } SS:

ON THIS 14th DAY OF April, 1989

BEFORE ME A NOTARY PUBLIC IN AND FOR SAID COUNTY AND STATE, THE FOREGOING INSTRUMENT WAS ACKNOWLEDGED BEFORE ME, BY GENE E. HINKLE

NOTARY PUBLIC: Kelly R. Anderson

MY COMMISSION EXPIRES: 7-18-92

STATE OF NEW MEXICO }
COUNTY OF BERNALILLO } SS:

ON THIS 14th DAY OF April, 1989

BEFORE ME A NOTARY PUBLIC IN AND FOR SAID COUNTY AND STATE, THE FOREGOING INSTRUMENT WAS ACKNOWLEDGED BEFORE ME, BY ROBERT B. KEERAN.

NOTARY PUBLIC: Kelly R. Anderson

MY COMMISSION EXPIRES: 7-18-92

SURVEYOR'S CERTIFICATION

I, JOHN F. ESQUIBEL, NEW MEXICO REGISTERED LAND SURVEYOR NO. 5949, do hereby certify that this plat was prepared by me or under my direct supervision, shows accurate dimensions, land areas and all easements of record made readily available to me by the land owner and/or utility companies, meets the minimum requirements for monumentation and surveys set forth by the Albuquerque Subdivision ordinance and is true and correct to the best of my knowledge and belief.

JOHN F. ESQUIBEL, N.M.R.S. NO. 5949

ACKNOWLEDGEMENT

STATE OF NEW MEXICO)

COUNTY OF BERNALILLO)

The foregoing Surveyor's Certificate was acknowledged before me on

this 14th day of April, 1989, by John F.

Esquibel, LS No. 5949.


By G. C. Payet

Notary Public

My commission expires 12-6-89



A & E ENGINEERING INC.
CIVIL ENGINEERING, LAND PLANNING AND SURVEYING
ALBUQUERQUE • LAS CRUCES

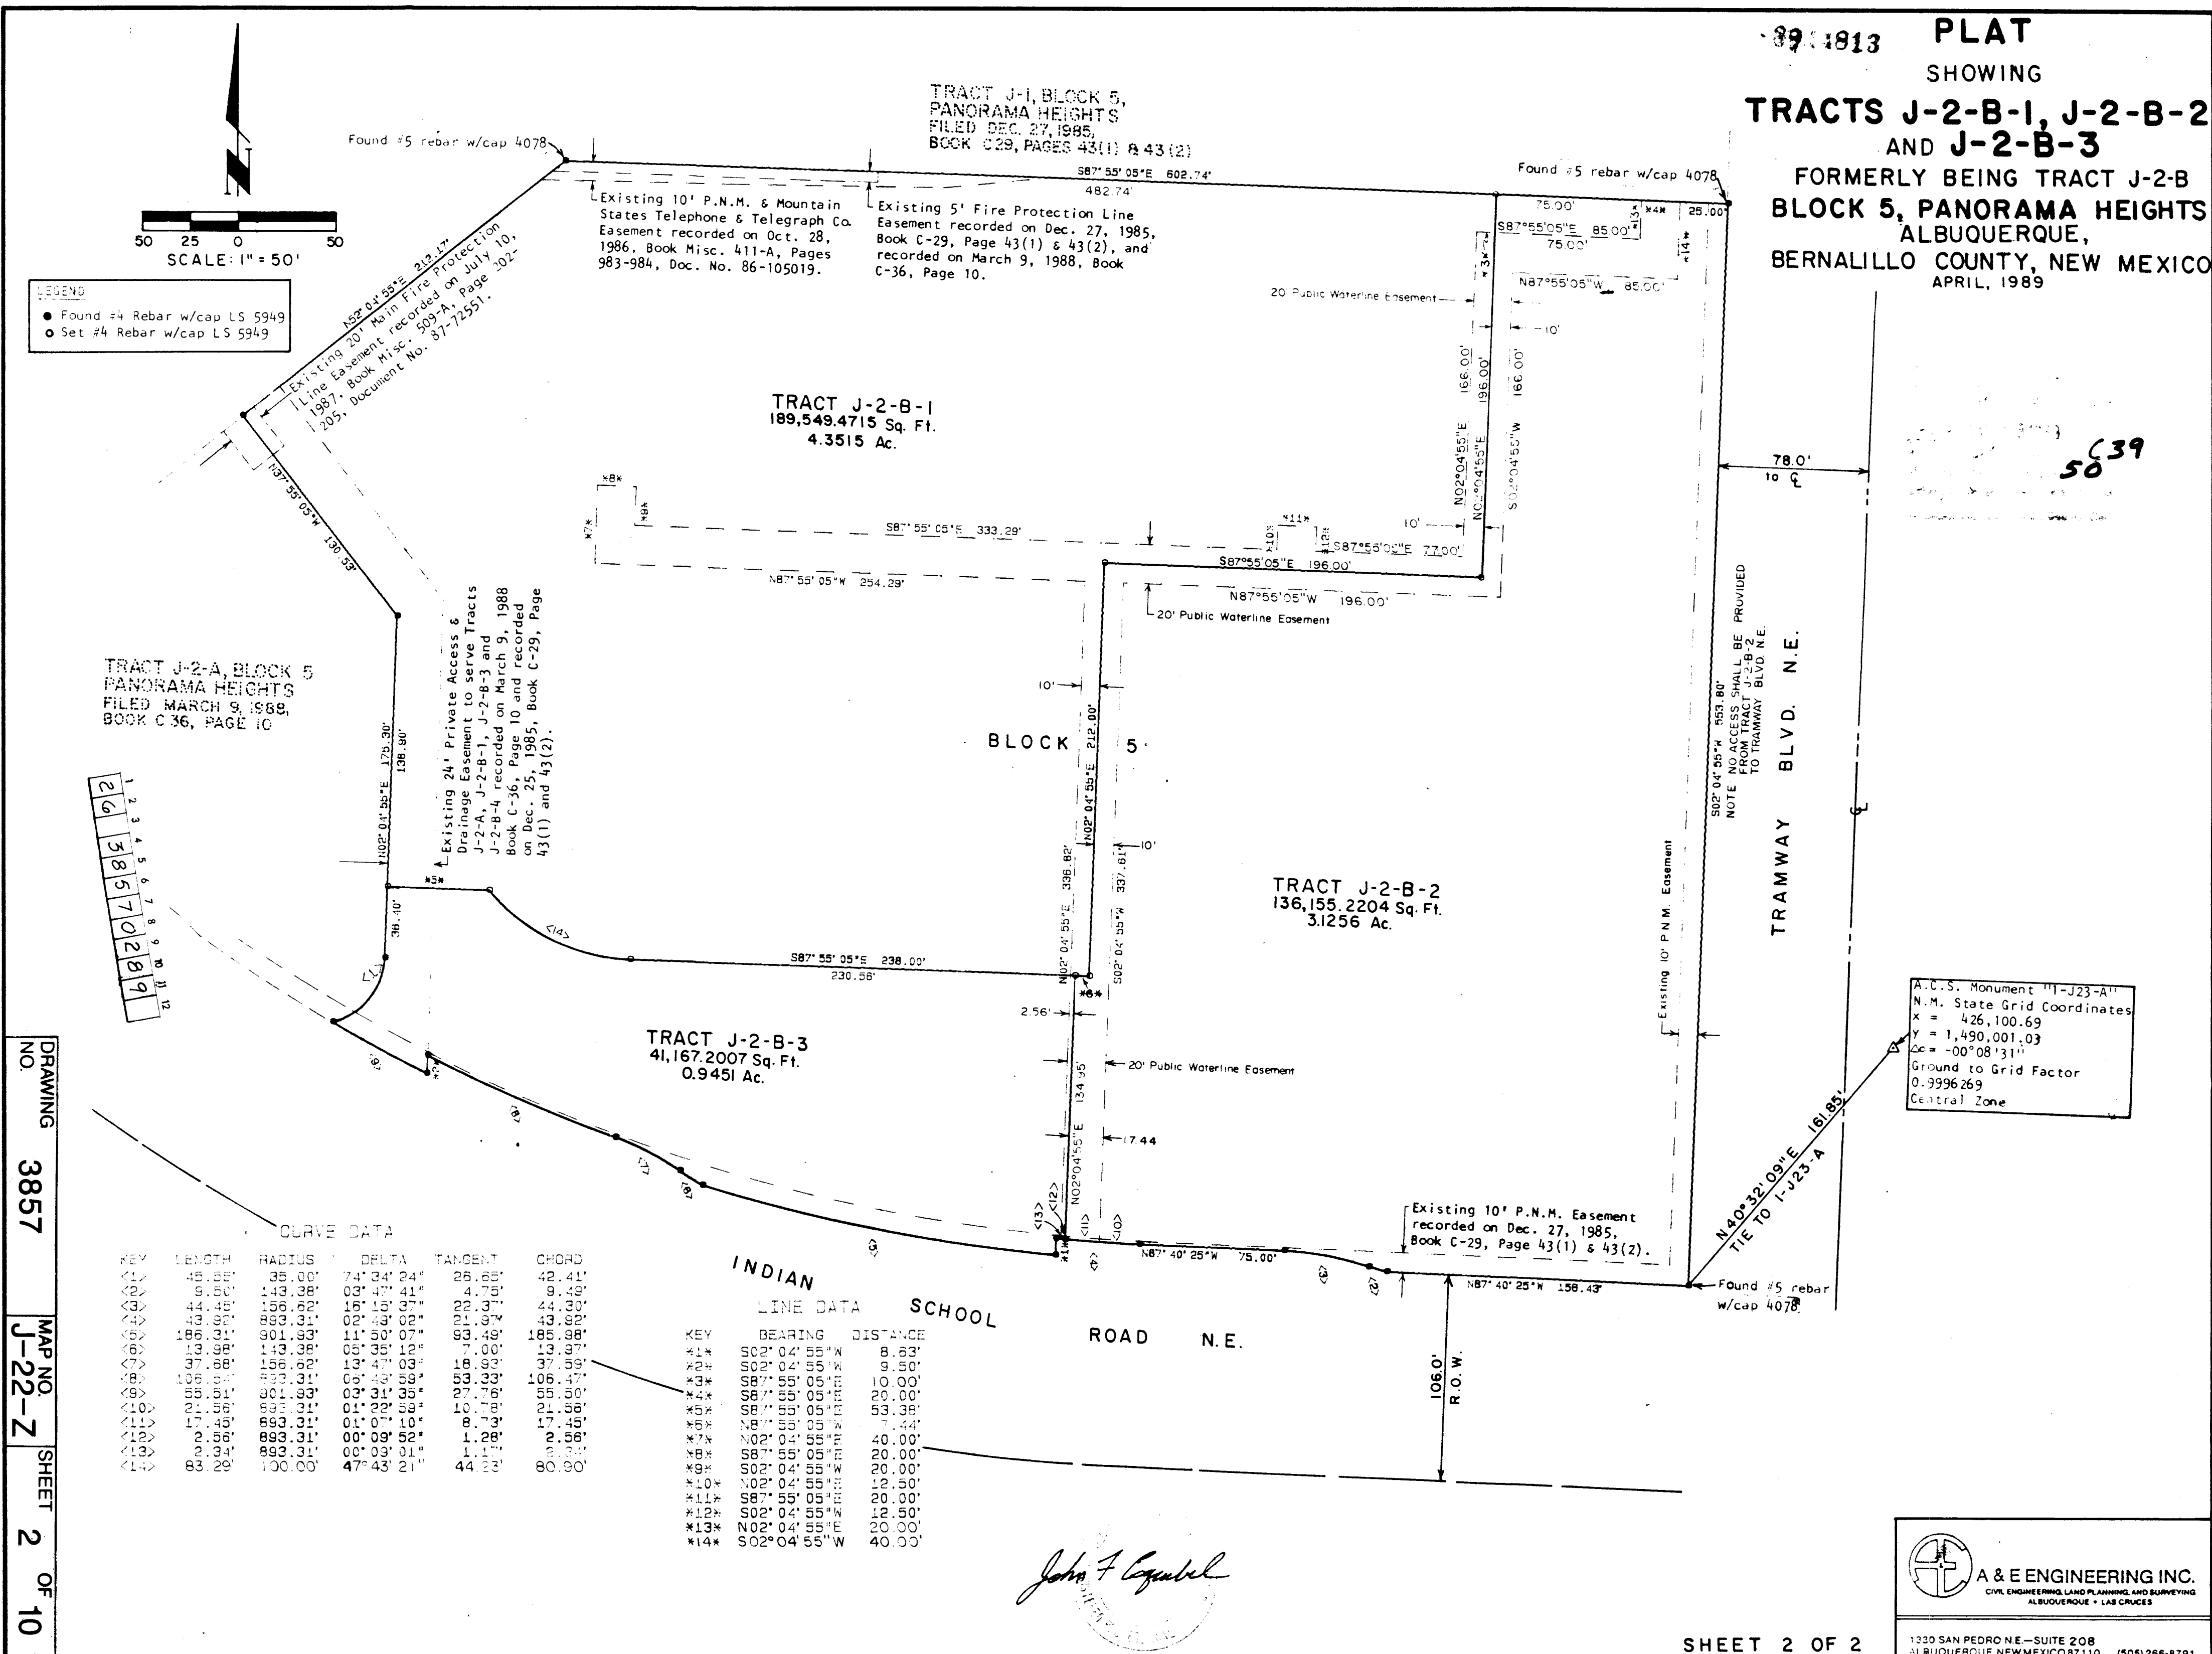

A & E ENGINEERING INC.
CIVIL ENGINEERING, LAND PLANNING AND SURVEYING
ALBUQUERQUE • LAS CRUCES

NOTICE TO CONTRACTOR

1. THE CONTRACTOR WILL NOT WILLFULLY INSTALL ITEMS AS SHOWN ON THE PLANS WHEN IT IS OBVIOUS IN THE FIELD THAT CONDITIONS EXIST THAT MIGHT NOT HAVE BEEN CONSIDERED IN THE DESIGN. SUCH CONDITIONS SHOULD BE BROUGHT TO THE ATTENTION OF THE ENGINEER. IN THE EVENT THE CONTRACTOR DOES NOT NOTIFY THE ENGINEER, THE CONTRACTOR ASSUMES FULL RESPONSIBILITY & EXPENSE FOR ANY REVISIONS NECESSARY.
2. ALL WORK ON THIS PROJECT SHALL BE PERFORMED IN ACCORDANCE WITH APPLICABLE FEDERAL, STATE AND LOCAL LAWS, RULES AND REGULATIONS CONCERNING CONSTRUCTION SAFETY AND HEALTH.
3. PRIOR TO CONSTRUCTION, THE CONTRACTOR SHALL EXCAVATE AND VERIFY THE HORIZONTAL AND VERTICAL LOCATIONS OF ALL CONSTRUCTION. SHOULD A CONFLICT EXIST, THE CONTRACTOR SHALL NOTIFY THE ENGINEER SO THAT THE CONFLICT CAN BE RESOLVED WITH MINIMUM AMOUNT OF DELAY.
4. ALL WORK DETAILED ON THESE PLANS TO BE PERFORMED UNDER CONTRACT SHALL, EXCEPT AS OTHERWISE STATED OR PROVIDED FOR HEREON, BE CONSTRUCTED IN ACCORDANCE WITH THE "CITY OF ALBUQUERQUE, STANDARD SPECIFICATIONS FOR PUBLIC WORKS CONSTRUCTION, 1986" (COA STD).
5. WATERING, AS REQUIRED FOR CONSTRUCTION AND DUST CONTROL, SHALL BE CONSIDERED INCIDENTAL TO CONSTRUCTION AND NO MEASUREMENT OR PAYMENT SHALL BE MADE THEREFORE. CONSTRUCTION AREAS SHALL BE WATERED FOR DUST POLLUTION ABATEMENT AS DIRECTED BY THE ENGINEER. THE CONTRACTOR SHALL BE RESPONSIBLE FOR LOCATING AND SUPPLYING WATER AS REQUIRED.
6. THE AIR POLLUTION CONTROL REGULATIONS OF THE ALBUQUERQUE-BERNALILLO COUNTY AIR QUALITY CONTROL BOARD LIMIT EMISSION OF PARTICULATE MATTER AND THE USE OF CUT BACK ASPHALT. IT IS THE RESPONSIBILITY OF THE CONTRACTOR TO CLARIFY THESE RESTRICTIONS WITH THE ENVIRONMENTAL HEALTH DEPARTMENT PRIOR TO SUBMITTAL OF BIDS TO AVOID CONFLICTS WITH REGULATIONS."
7. IF ANY UTILITY LINES, PIPELINES, OR UNDERGROUND UTILITY LINES ARE SHOWN ON THESE DRAWINGS, THEY ARE SHOWN IN AN APPROXIMATE MANNER ONLY, AND SUCH LINES MAY EXIST WHERE NONE ARE SHOWN. IF ANY SUCH EXISTING LINES ARE SHOWN, THE LOCATION IS BASED UPON INFORMATION PROVIDED BY THE OWNER OF SAID UTILITY, AND THE INFORMATION MAY BE INCOMPLETE, OR MAY BE OBSOLETE BY THE TIME CONSTRUCTION COMMENCES. THE CONTRACTOR SHALL INFORM ITSELF OF THE LOCATION OF ANY UTILITY LINE, PIPELINE, OR UNDERGROUND UTILITY LINE IN OR NEAR THE AREA OF THE WORK IN ADVANCE OF AND DURING EXCAVATION WORK. THE CONTRACTOR IS FULLY RESPONSIBLE

- FOR ANY AND ALL DAMAGE CAUSED BY ITS FAILURE TO LOCATE, IDENTIFY AND PRESERVE ANY AND ALL EXISTING UTILITIES, PIPELINES, AND UNDERGROUND UTILITY LINES. IN PLANNING AND CONDUCTION EXCAVATION, THE CONTRACTOR SHALL COMPLY WITH STATE STATUTES, MUNICIPAL AND LOCAL ORDINANCES, RULES AND REGULATIONS, IF ANY, PERTAINING TO THE LOCATION OF THESE LINES AND FACILITIES.
8. TWO (2) WORKING DAYS PRIOR TO ANY EXCAVATION, CONTRACTOR MUST CONTACT LINE LOCATING SERVICE, 765-1234, FOR LOCATION OF EXISTING UTILITIES.
9. CONTRACTOR IS TO EXERCISE DUE CARE TO AVOID DISTURBING ANY EXISTING UNDERGROUND UTILITIES. IT SHALL BE THE CONTRACTORS RESPONSIBILITY TO COORDINATE WITH THE UTILITY COMPANIES IN ORDER TO PREVENT SERVICE DISRUPTION.
10. CONSTRUCTION WHICH IS EXISTING AND NOT TO BE REMOVED UNDER THE CONTRACT WHICH IS DAMAGED OR DISPLACED BY THE CONTRACTOR SHALL BE REMOVED AND REPLACED BY THE CONTRACTOR AT HIS EXPENSE.
11. THE CONTRACTOR SHALL PROMPTLY CLEAN UP ANY MATERIAL EXCAVATED WITHIN THE PUBLIC RIGHT-OF-WAY SO THAT THE EXCAVATED MATERIAL IS NOT SUSCEPTIBLE TO BEING WASHED DOWN THE STREET.
12. CONTRACTOR IS RESPONSIBLE FOR OBTAINING ALL PERMITS TO CONSTRUCT FACILITIES WITHIN CITY RIGHT-OF-WAY.
13. WHEN ABUTTING NEW PAVEMENT TO EXIST, CUT BACK EXISTING PAVEMENT TO A NEAT, STRAIGHT LINE AS REQUIRED TO REMOVE ANY BROKEN OR CRACKED PAVEMENT, AND MATCH NEW PAVING TO EXISTING.
14. WHEN CONSTRUCTION UNDER THIS PROJECT CONNECTS TO EXISTING IMPROVEMENTS, THE CONTRACTOR SHALL PROVIDE AN EASY RIDING CONNECTION.
15. ALL WATER VALVE BOXES AND ELECTRICAL, TELEPHONE, TV & SEWER MANHOLES IN THE CONSTRUCTION AREA ARE TO BE ADJUSTED TO FINISH GRADE.
16. CONTRACTOR SHALL PROVIDE 12" SUBGRADE PREPARATION UNDER ALL NEW PAVEMENT, CURBS AND GUTTERS, VALLEY GUTTERS AND CONCRETE FILLETS.
17. SIDEWALKS AND WHEELCHAIR RAMPS WITHIN THE CURB RETURNS SHALL BE CONSTRUCTED WHEREVER A NEW CURB RETURN IS CONSTRUCTED.
18. ALL UTILITIES AND UTILITY SERVICE LINES SHALL BE INSTALLED PRIOR TO PAVING.

19. ELECTRONIC MARKER DISCS SHALL BE PLACED IN ACCORDANCE WITH SECTION 170 OF THE CITY OF ALBUQUERQUE, STANDARD SPECIFICATIONS, PUBLIC WORKS CONSTRUCTION.
20. BACKFILL COMPACTION SHALL BE ACCORDING TO ARTERIAL STREET USE.
21. CONTRACTOR SHALL COORDINATE WITH WATER SYSTEMS DIVISION (823-4200) THREE WORKING DAYS IN ADVANCE OF ANY WORK THAT MAY AFFECT EXISTING PUBLIC WATER UTILITIES.
22. MAXIMUM DEFLECTION FOR 10" PVC WATERLINE IS 3-1/2 DEGREES PER LENGTH OF PIPE JOINT.

PROJECT LEGEND			
DESCRIPTION	NEW	EXISTING	FUTURE
PROPERTY LINE	~	---	~
EASEMENT	~	---	~
BUILDING		~	
CURB & GUTTER			~
HEADER CURB		---	~
SIDEWALK / CONC. / SLAB		---	~
WATER VALVE			~
FIRE HYDRANT			~
WATER METER	WM	~	~
SANITARY SEWER MANHOLE	~		~
SANITARY SEWER LINE	—SAS—	—SAS—	~
WATER LINE	— W —	— W —	~
CONTOUR	—50—	—50—	~
SPOT ELEV.	TC 50.00 FL 50.00	~	~
GAS LINE	~	— G —	~

ABBREVIATIONS

TC = TOP OF CURB or CONCRETE
TA = TOP OF ASPHALT
FL = FLOWLINE

AS BUILT INFORMATION			
CONTRACT NO.	DATE	SCALE	DATE
WORK ORDER NO.	DATE	SCALE	DATE
AS BUILT BY	DATE	SCALE	DATE
FIELD AS BUILT BY	DATE	SCALE	DATE
REVISIONS	DATE	SCALE	DATE
CORRECTED BY	DATE	SCALE	DATE
RECORDED BY	DATE	SCALE	DATE
NO	DATE	SCALE	DATE


BENCH MARKS			
ACG Benchmark "1-123-A" is a Standard	DATE	SCALE	DATE
Brass Tablet Stamped "1-123, 1982"	DATE	SCALE	DATE
Located at Indian School Rd and	DATE	SCALE	DATE
Tramway N.E. in The Median. Elev. in	DATE	SCALE	DATE
FT = 5840.98 (SLD 1929)	DATE	SCALE	DATE

SURVEY INFORMATION			
FIELD NOTES	DATE	SCALE	DATE
BY	DATE	SCALE	DATE
NO.	DATE	SCALE	DATE

ENGINEER'S SEAL			
NO.	DATE	SCALE	DATE
REVISIONS	DATE	SCALE	DATE
DESIGN	DATE	SCALE	DATE
DESIGNED BY BT	DATE 6/19/89	SCALE	DATE
DRAWN BY C.G.	DATE 6/19/89	SCALE	DATE
CHECKED BY R.G.	DATE 6/19/89	SCALE	DATE



CITY OF ALBUQUERQUE PUBLIC WORKS DEPARTMENT ENGINEERING GROUP					
TITLE: HIGH RIDGE SHOPPING CENTER GENERAL NOTES AND PROJECT LEGEND					
APPROVALS	ENGINEER	DATE	APPROVALS	ENGINEER	DATE
D.R.C. Chair	Reg. A. B. 6/23/89				
Trans. Dev	"	"			
Utility Dev	M. J. 6/27/89				
DRAWING NO.	3857	MAP NO.	J-22-Z	SHEET	3 OF 10

1 2 3 4 5 6 7 8 9 10 11 12
26 38570389

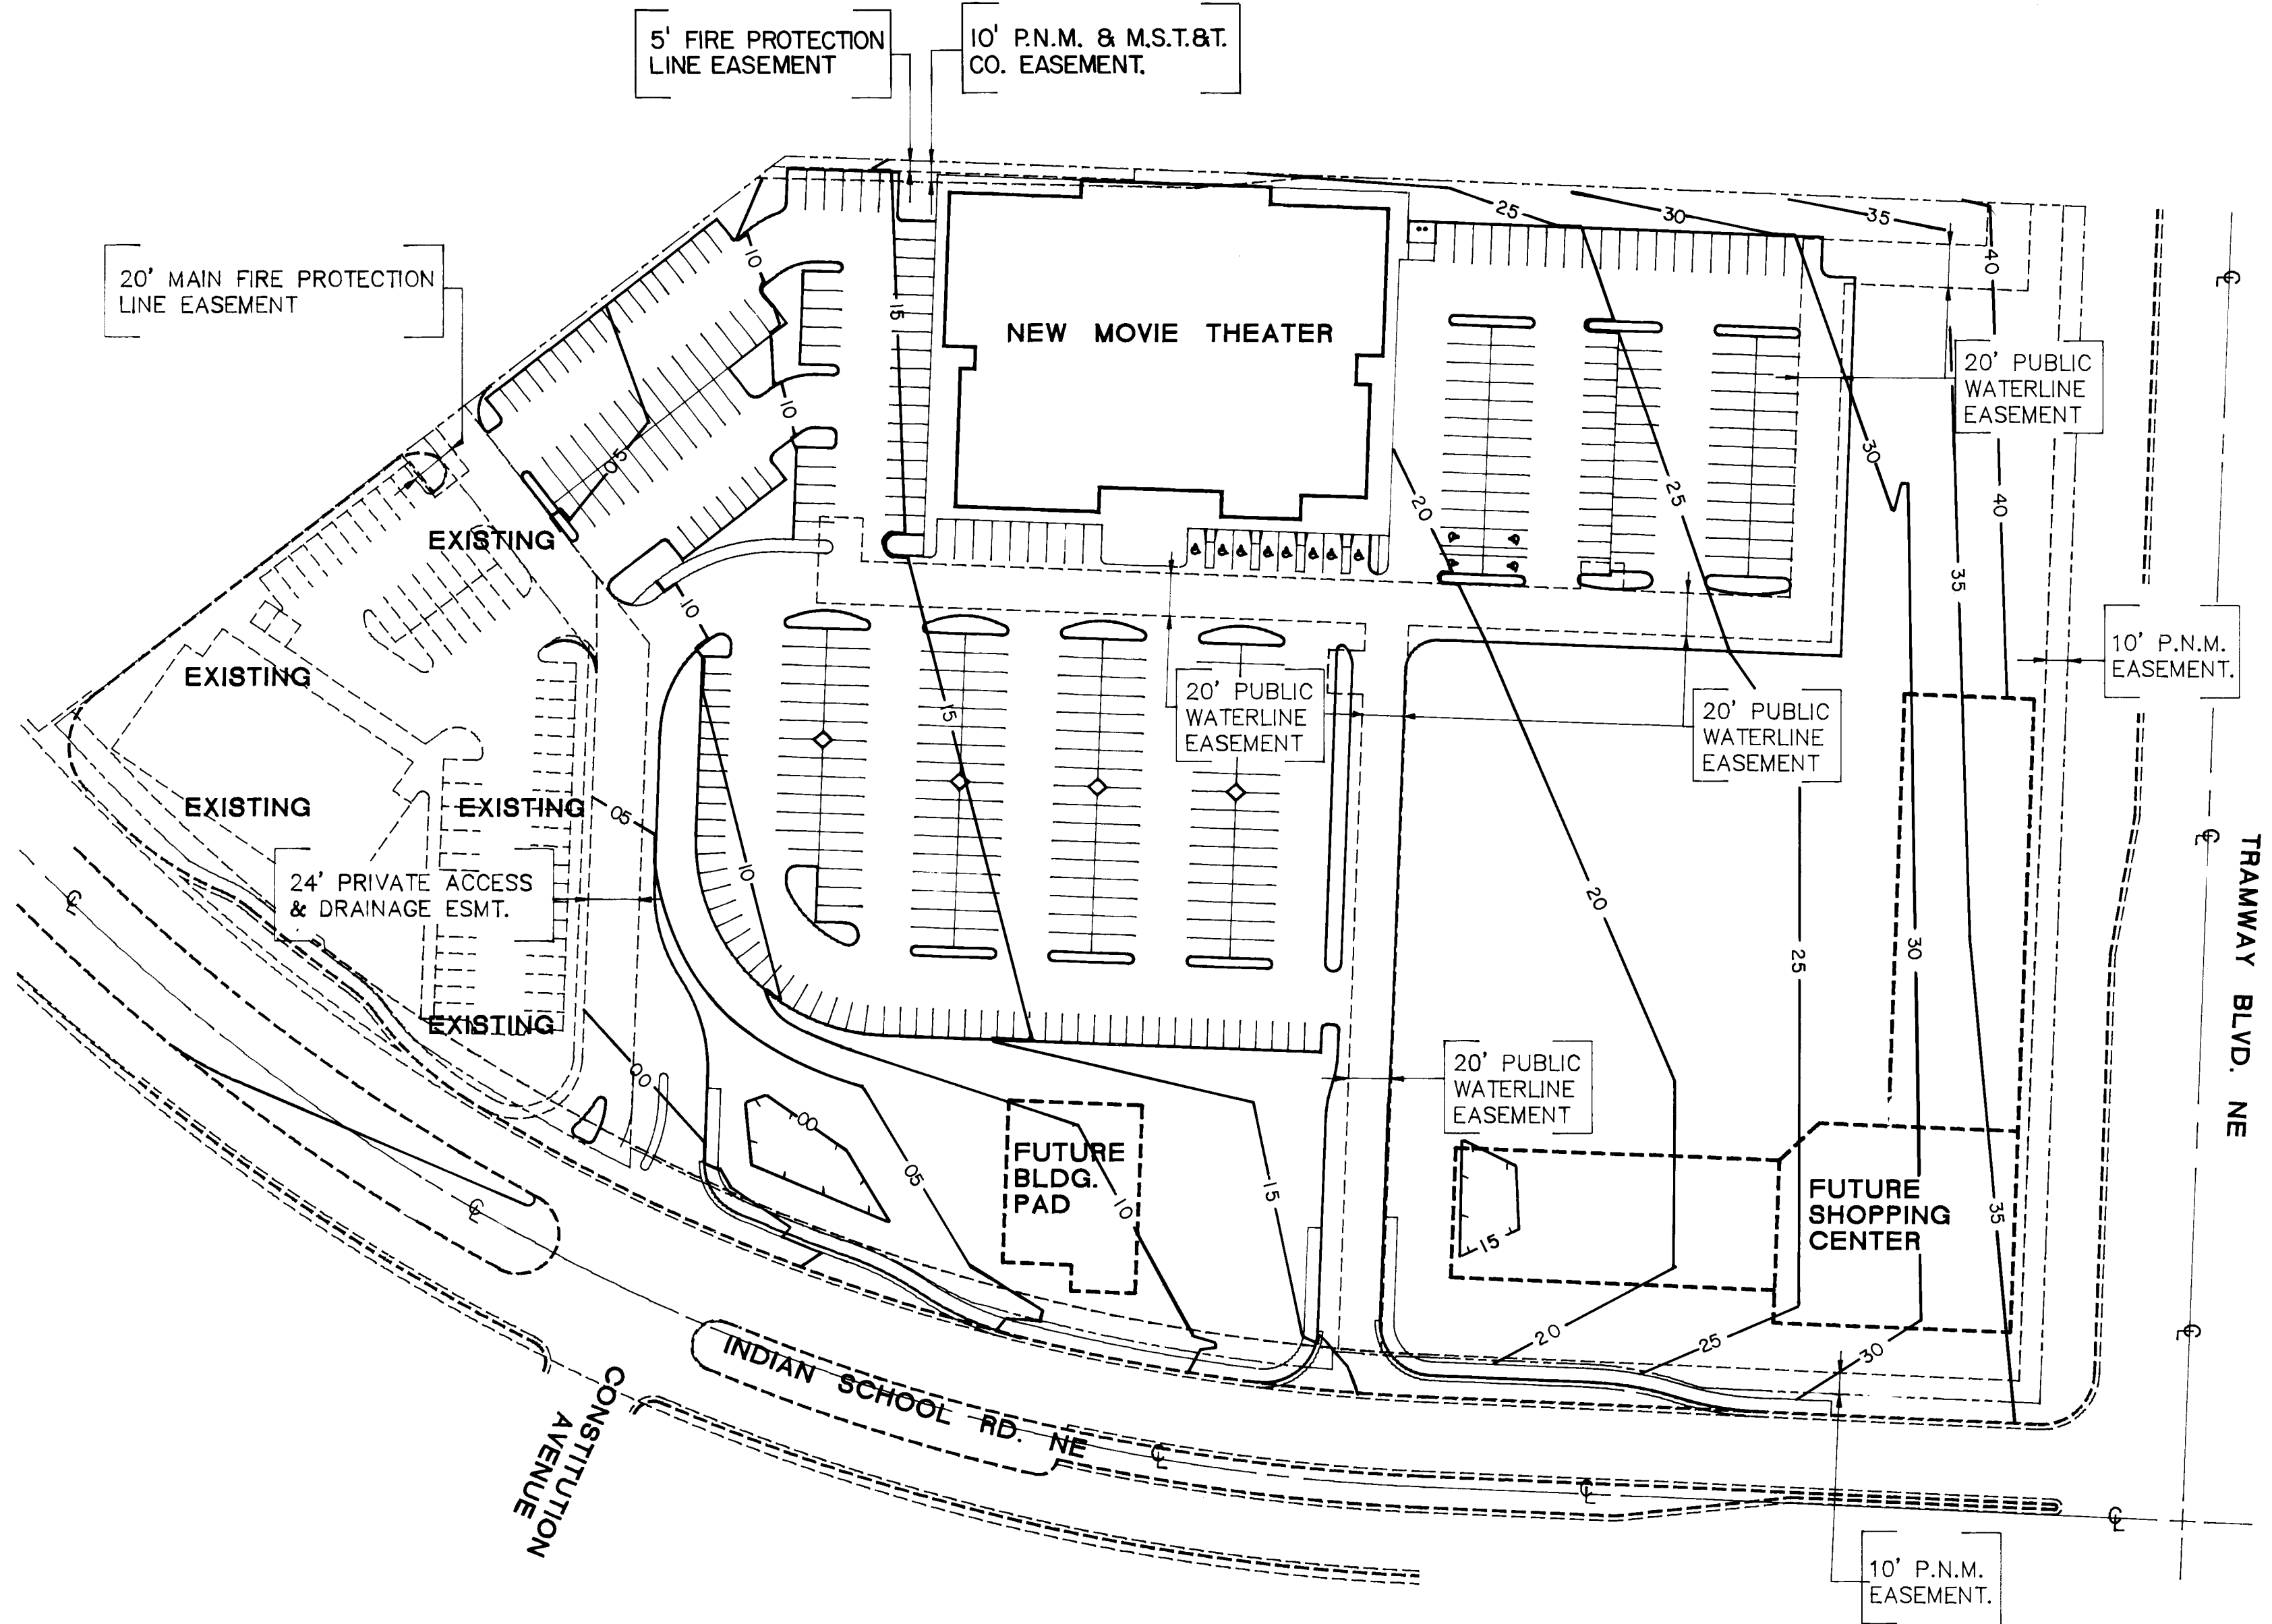


OVERALL GRADING PLAN

SCALE 1"=60'-0"

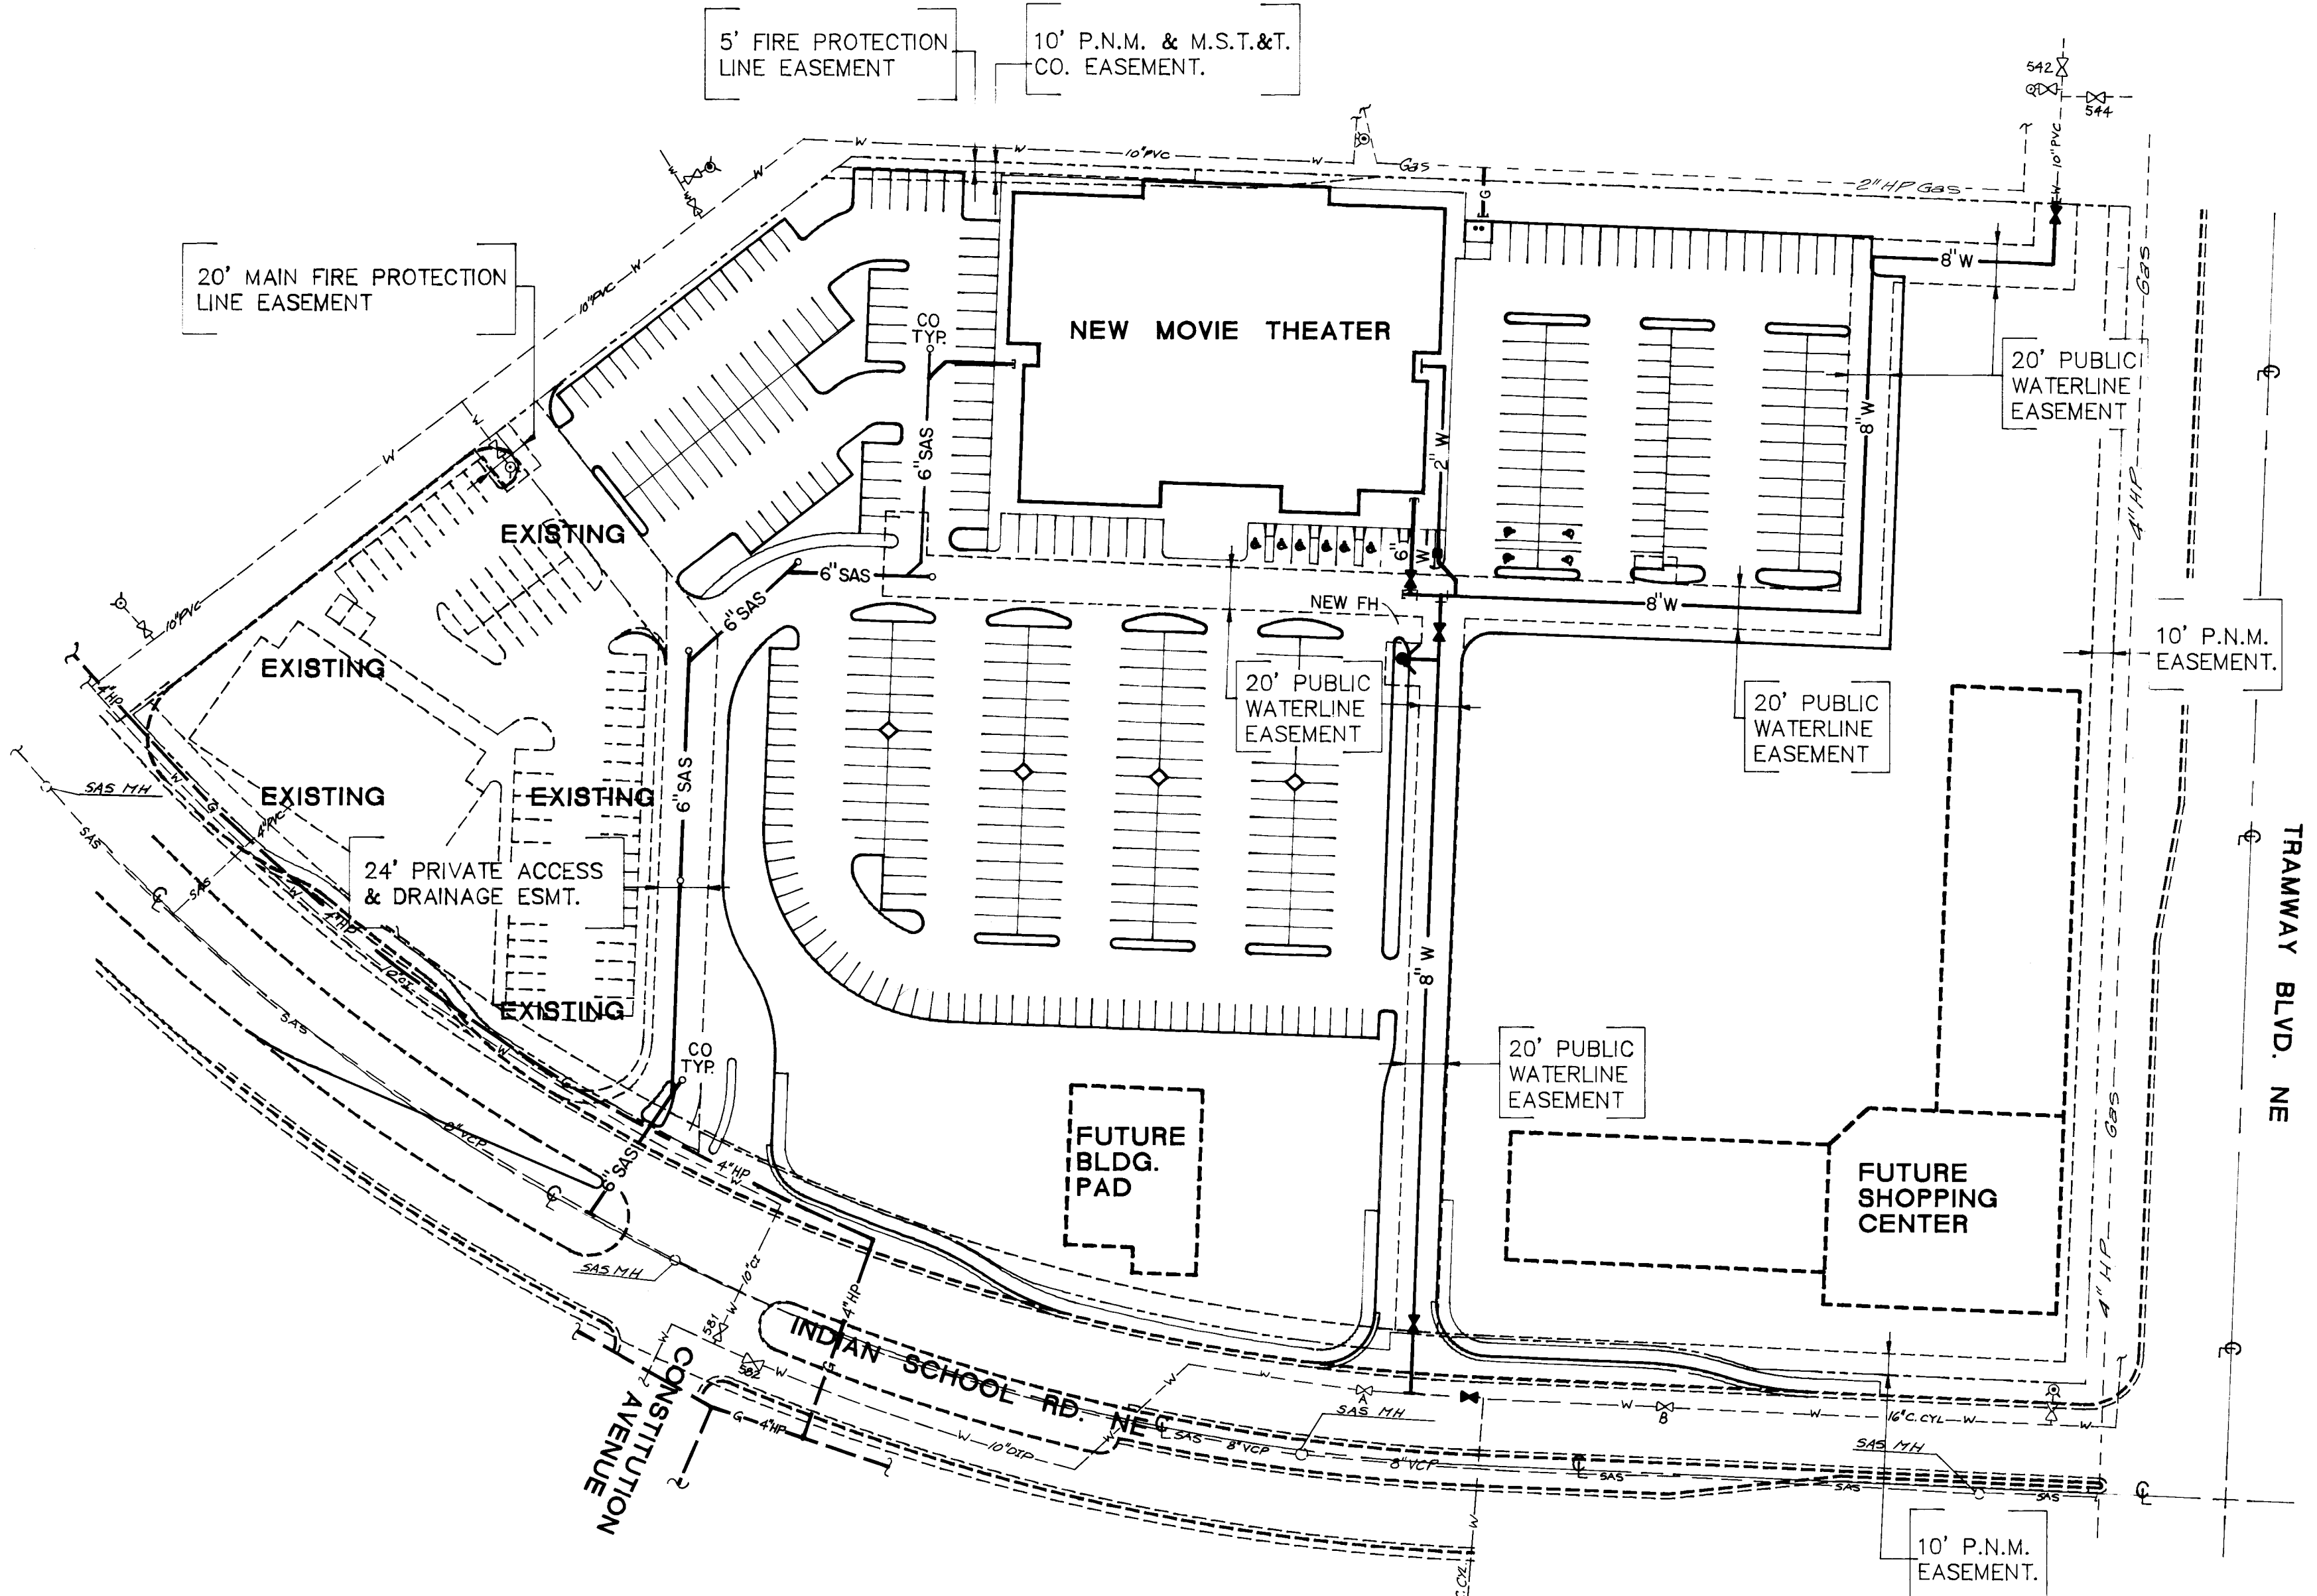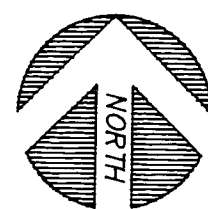

OVERALL UTILITY PLAN


SCALE 1"=60'-0"

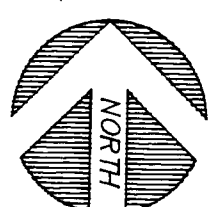

NOTE:
PRIOR TO INSTALLING
WATERLINE, SHUT VALVES
A,B, 542 & 544

CITY OF ALBUQUERQUE PUBLIC WORKS DEPARTMENT ENGINEERING GROUP			
TITLE: HIGH RIDGE SHOPPING CENTER OVERALL UTILITY PLAN, OVERALL GRADING PLAN			
APPROVALS	ENGINEER	DATE	APPROVALS
D.R.C. Chair	6/19/89		
Trans. Dev.			
Utility Dev.			
DRAWING NO.	3857	MAP NO.	J-22-Z
		SHEET	4 OF 10


ENGINEER'S SEAL			SURVEY INFORMATION		BENCH MARKS		AS BUILT INFORMATION	
			FIELD NOTES		AC3 Benchmark "1-J23-A" is a standard Brass Tablet Stamped "1-J23, 1982" Located at Indian School Rd. and Tramway N.E. in The Median. Elev. in FT = 5840.58 (SLD 1929)		CONTRACTOR	
			NO.	BY	DATE	DATE	WORK STATED BY	DATE
							INSPECTOR'S ACCEPTANCE BY	DATE
							FIELD VERIFICATION BY	DATE
							DRAWINGS CORRECTED BY	DATE
							MICRO-FILM INFORMATION	
							RECORDED BY	DATE
							NO	

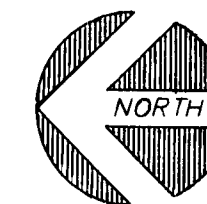


OVERALL PAVING PLAN


SCALE 1"=60'-0"

CITY OF ALBUQUERQUE PUBLIC WORKS DEPARTMENT ENGINEERING GROUP					
TITLE: HIGH RIDGE SHOPPING CENTER OVERALL PAVING PLAN					
APPROVALS	ENGINEER	DATE	APPROVALS	ENGINEER	DATE
D.R.C. Chair	<i>Page 1 of 2</i>	<i>6/27/89</i>			
Trans. Dev					
Utility Dev	<i>PEBID</i>	<i>6/27/89</i>			
DRAWING NO. 3857		MAP NO. J-22-Z		SHEET 5 OF 10	

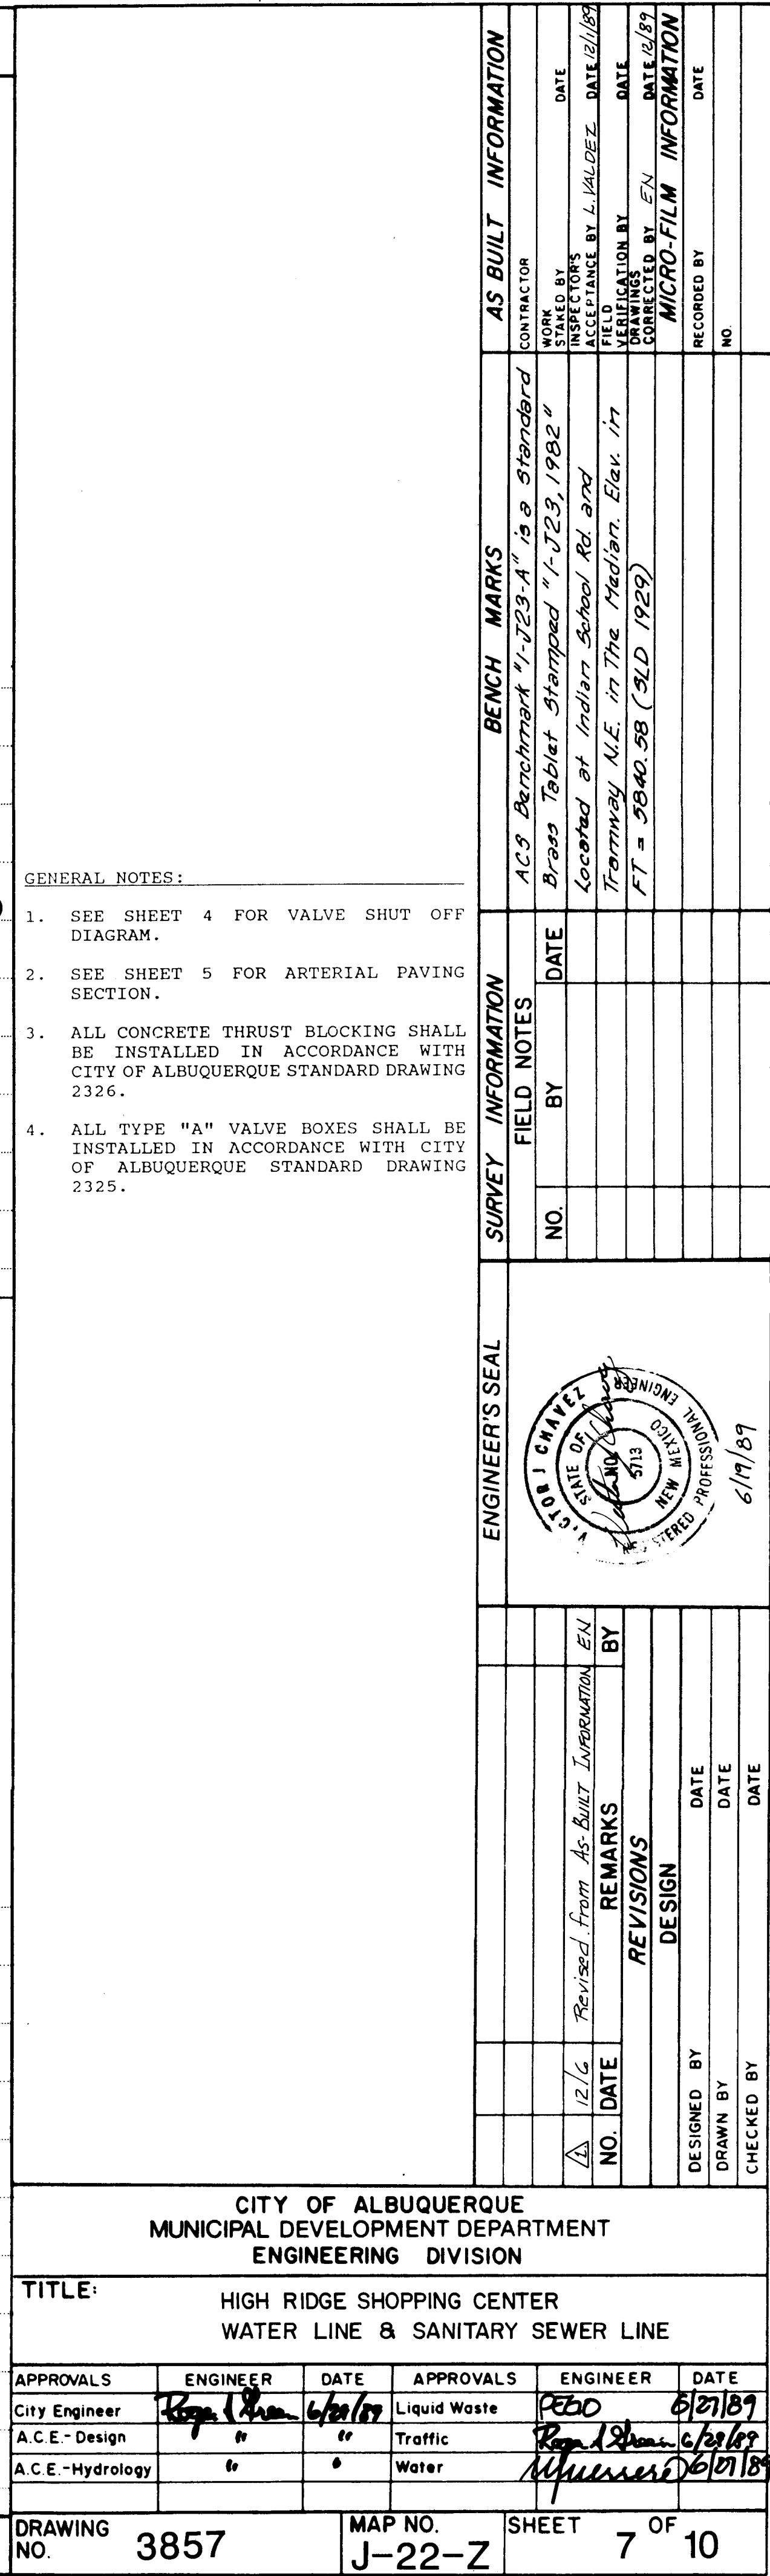

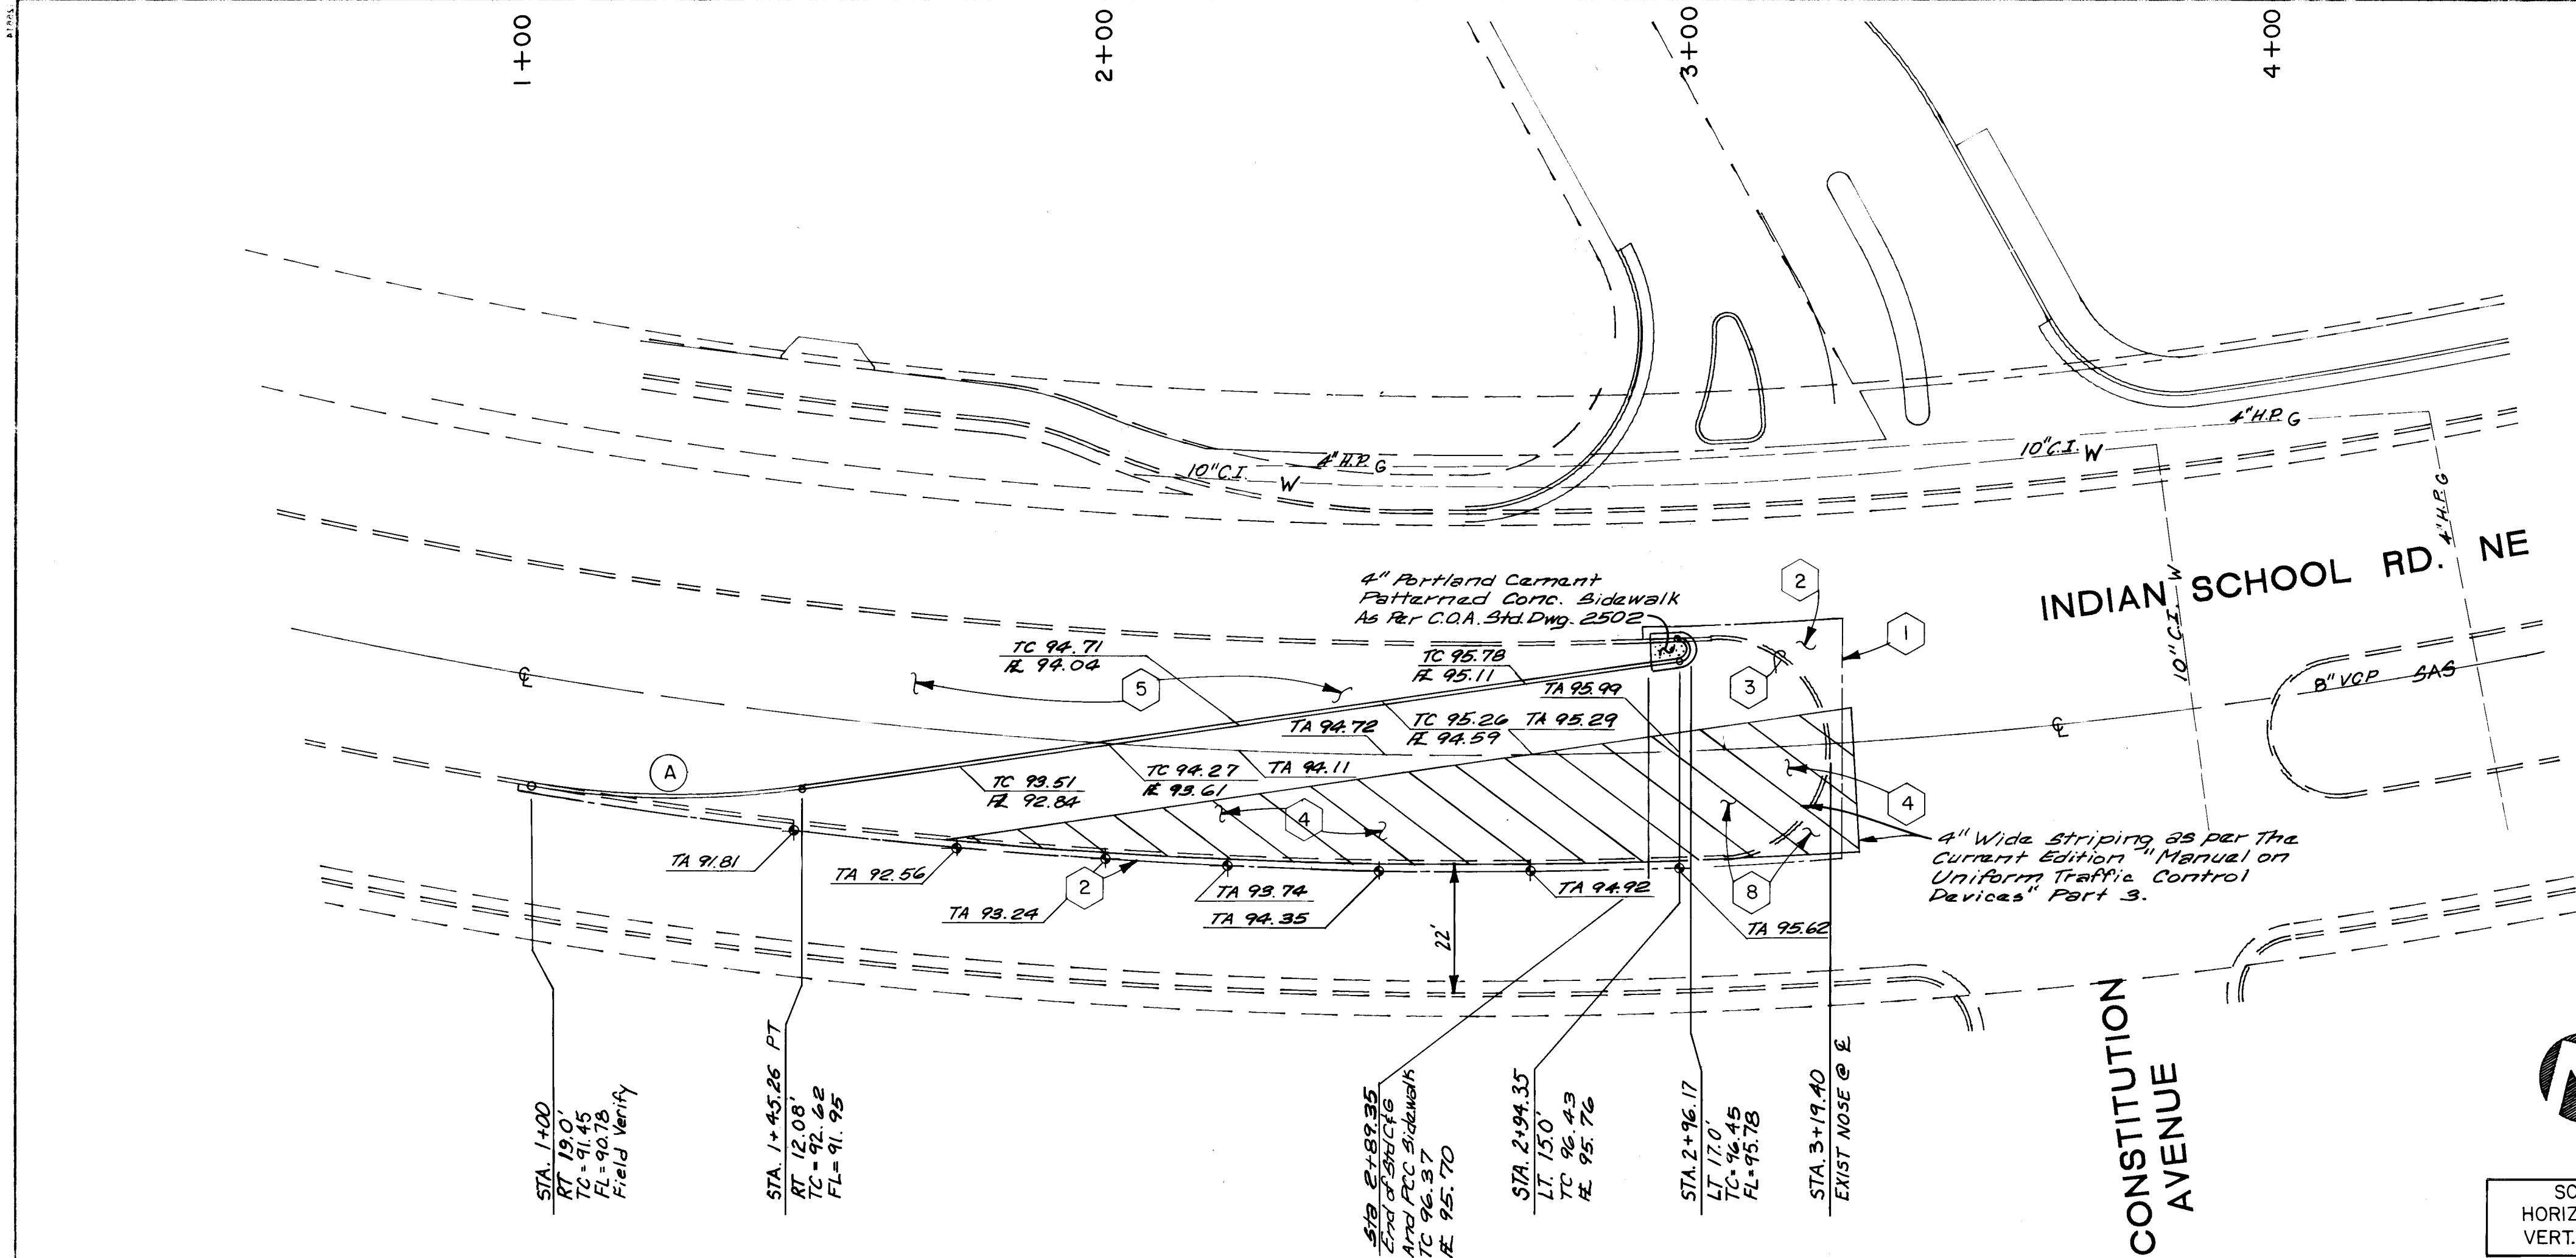

MEDIAN REVISIONS

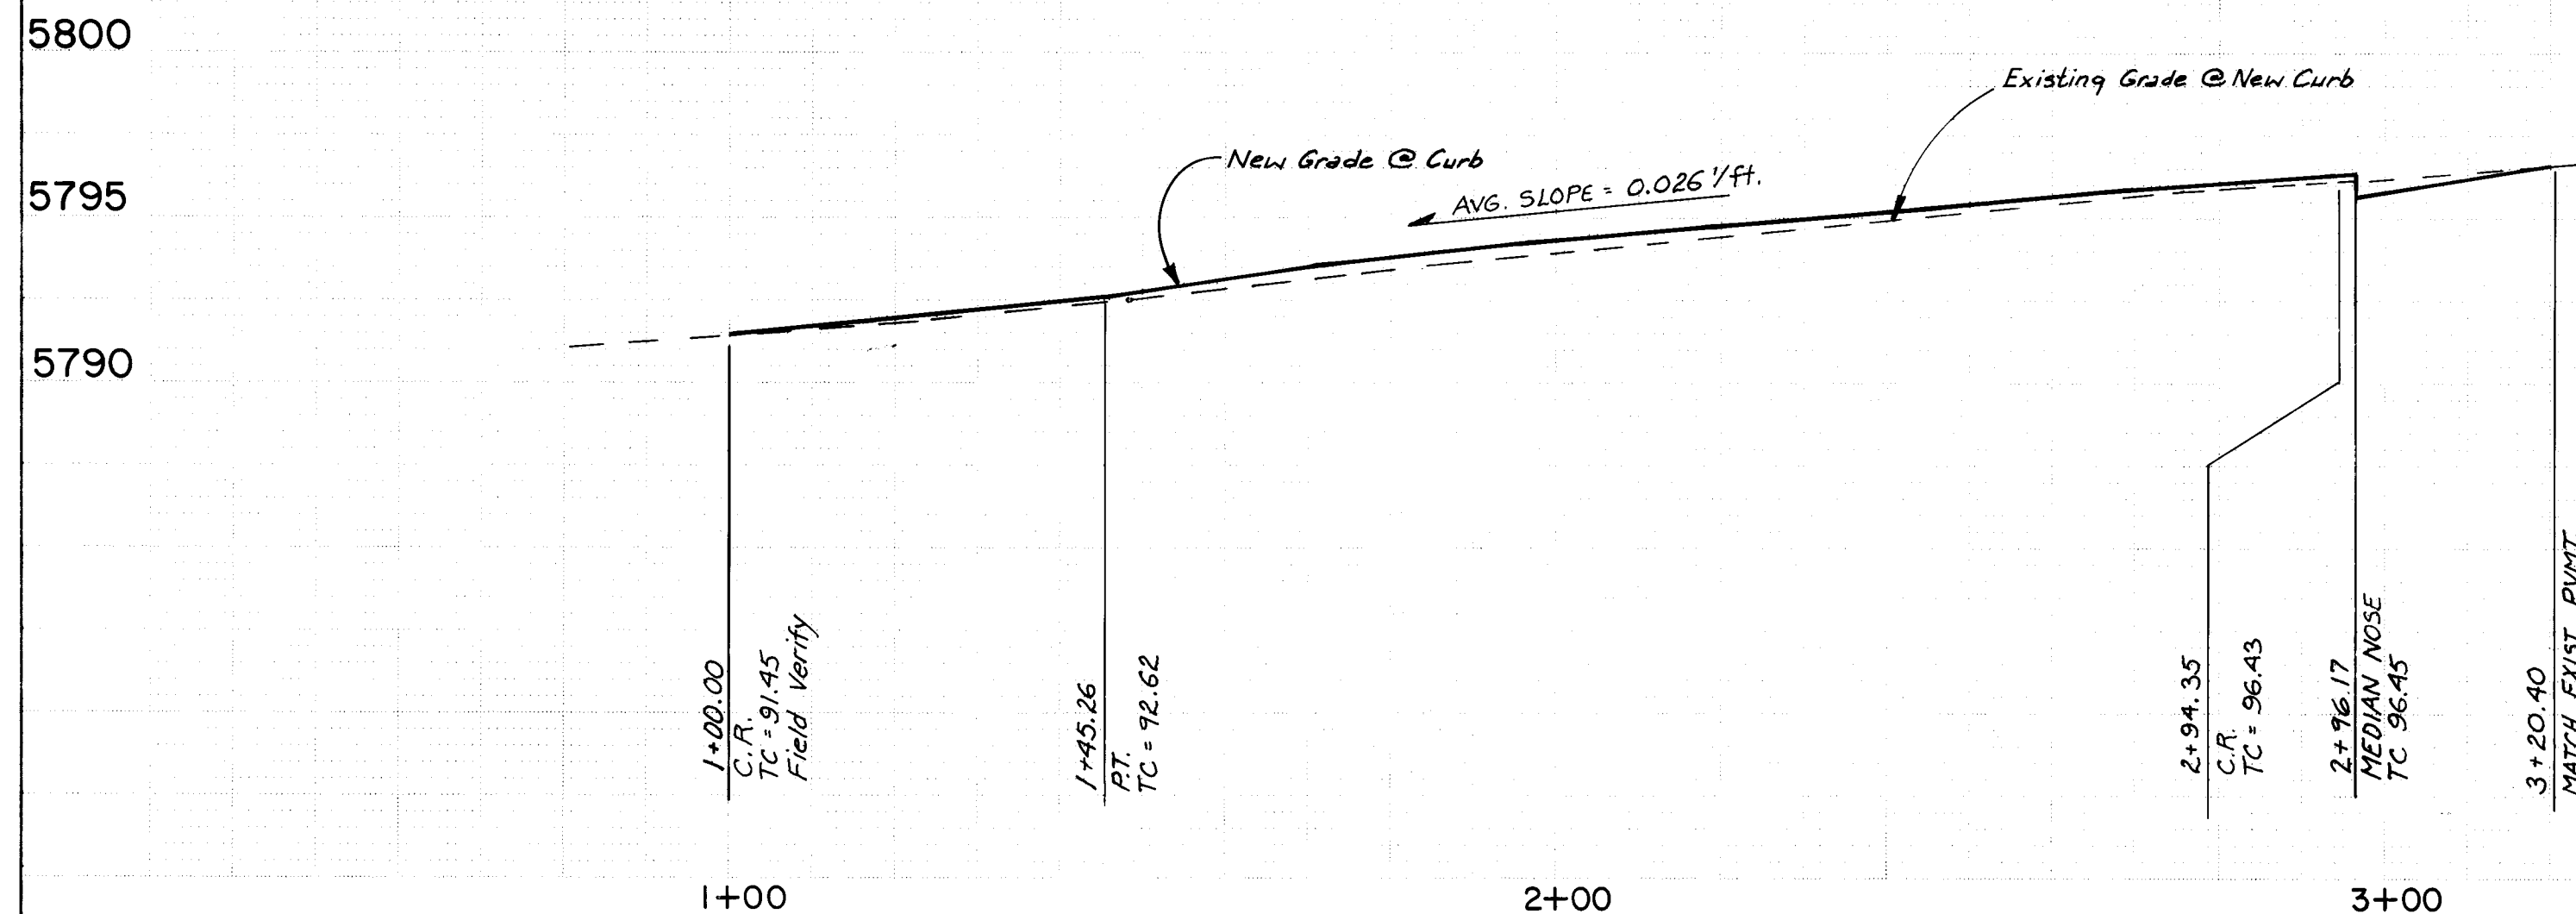

- KEYED NOTES
- 1 SAW CUT EXISTING PAVEMENT.
 - 2 REMOVE EXISTING PAVEMENT.
 - 3 REMOVE EXISTING ASPHALT MEDIAN.
 - 4 REMOVE EXISTING MEDIAN BACKFILL.
 - 5 REGRADE MEDIAN WITH 2% CROWN AT CENTERLINE OF REVISED MEDIAN.
 - 6 CONSTRUCT MEDIAN CONCRETE CURB AND GUTTER IN ACCORDANCE WITH CITY OF ALBUQUERQUE STANDARD DRAWING 2415 (MEDIAN CURB AND GUTTER).
 - 7 CONSTRUCT EXTRUDED ASPHALT CURB IN ACCORDANCE WITH CITY OF ALBUQUERQUE STANDARD DRAWING 2415 (ASPHALT CURB).
 - 8 NEW ARTERIAL PAVING. SEE ARTERIAL PAVING DETAIL, SHEET 5.

GENERAL NOTES:
1. STATIONING BASED ON CENTERLINE OF ROAD.

CURVE DATA


	R	LA	D
A	150.00'	49.66'	18° 58' 10"
B	150.00'	36.47'	13° 55' 44"








CITY OF ALBUQUERQUE
PUBLIC WORKS DEPARTMENT
ENGINEERING GROUP

TITLE: HIGH RIDGE SHOPPING CENTER
INDIAN SCHOOL ROAD MEDIAN REVISIONS

APPROVALS	ENGINEER	DATE	APPROVALS	ENGINEER	DATE
D.R.C. Chair	Rep. J. [Signature]	6/27/89			
Trans. Dev					
Utility Dev					

DRAWING NO. 3857 MAP NO. J-22-Z SHEET 9 OF 10

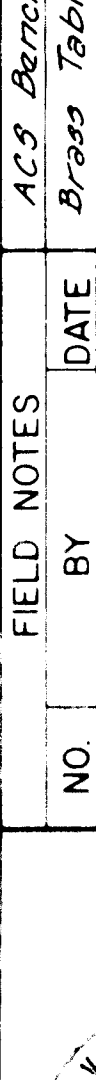ENGINEER'S SEAL		SURVEY INFORMATION		BENCH MARKS		AS BUILT INFORMATION	
		FIELD NOTES		AC9 Benchmark "1-123-A" is a standard		CONTRACT TIME	
		BY		DATE		WORK	
		NO.		DATE		INSPECTORS	
		NO.		DATE		FIELD	
REMARKS		BY		FIELD		DATE	
NO		DATE		FIELD		DATE	
REVISIONS		BY		FIELD		DATE	
DESIGN		BY		FIELD		DATE	
DESIGNED BY BT, RES		DATE June 1989		FIELD		DATE	
DRAWN BY C-8		DATE June 1989		FIELD		DATE	
CHECKED BY RGS		DATE June 1989		FIELD		DATE	
MICRO-FILM INFORMATION		RECORDED BY		NO		DATE	

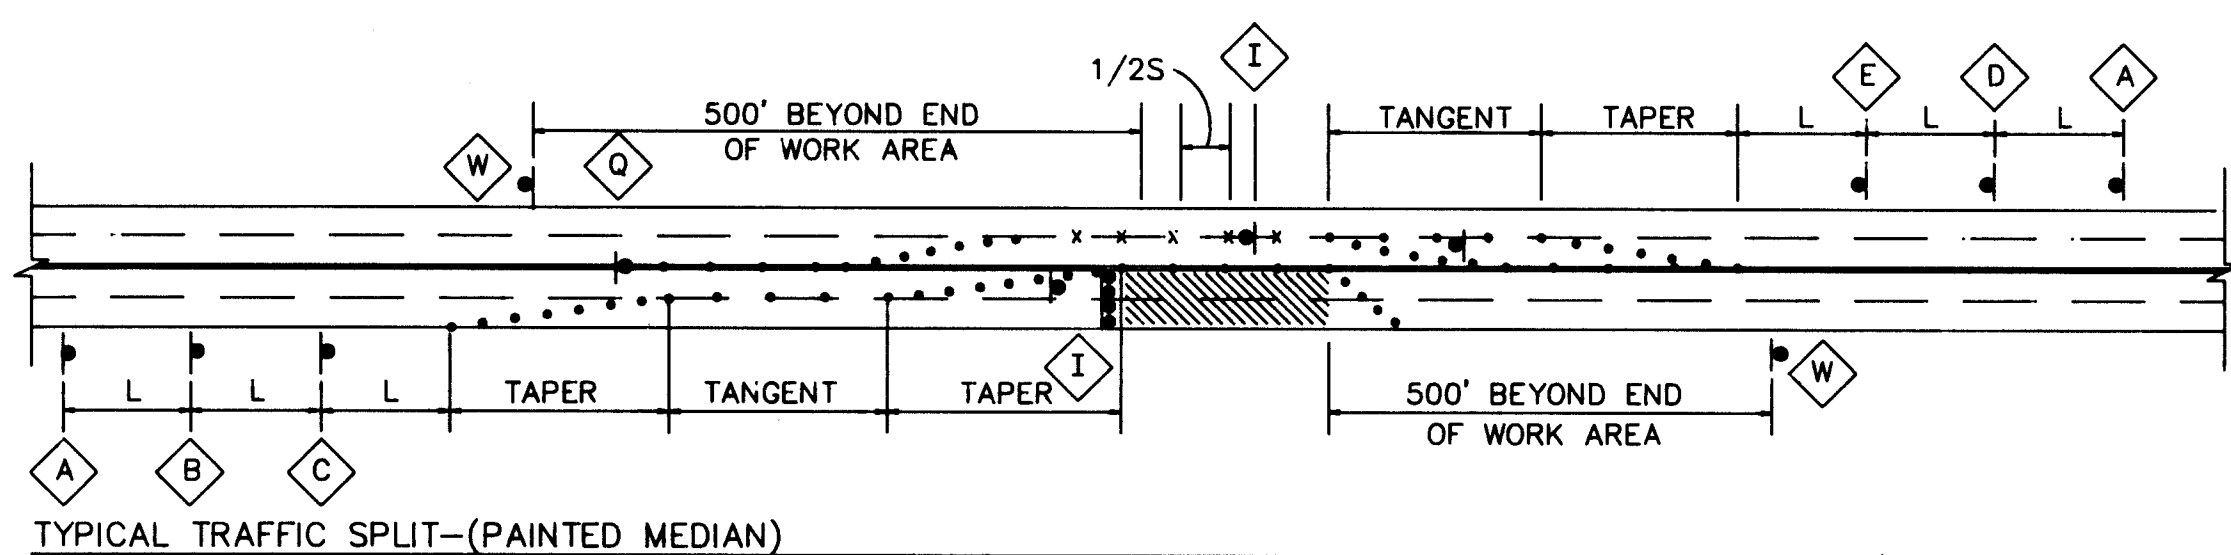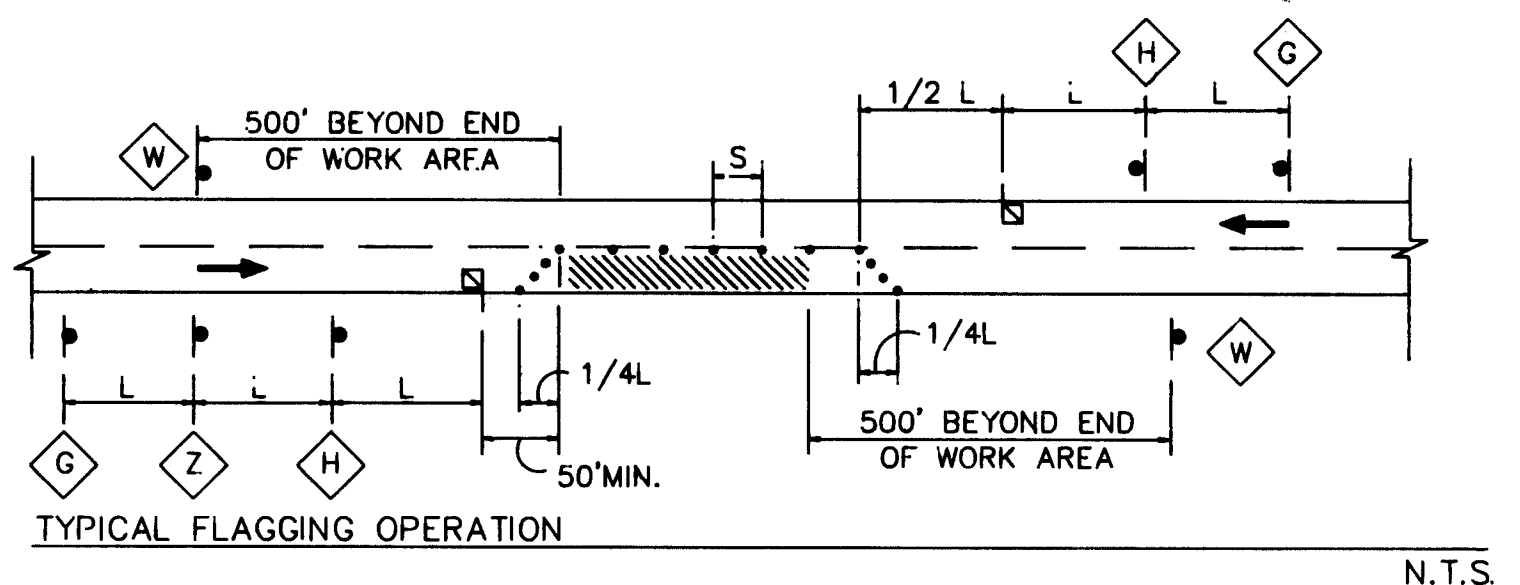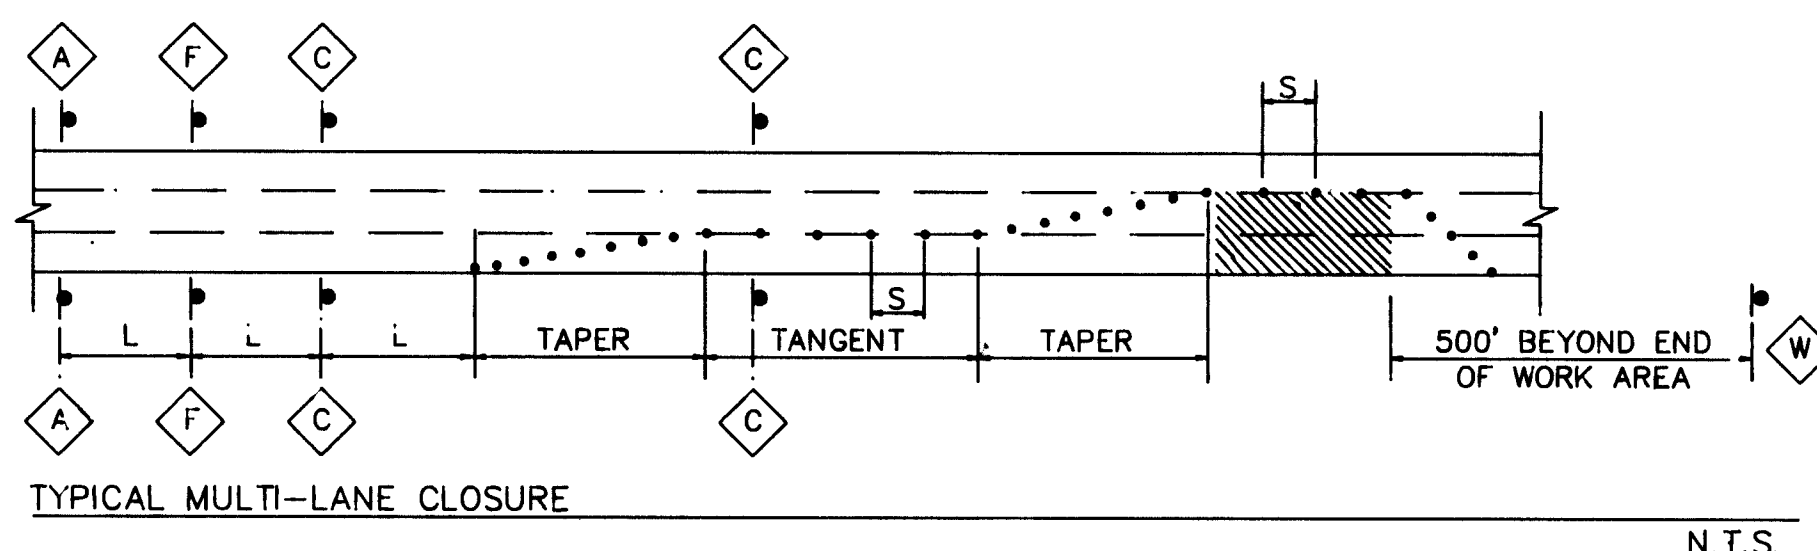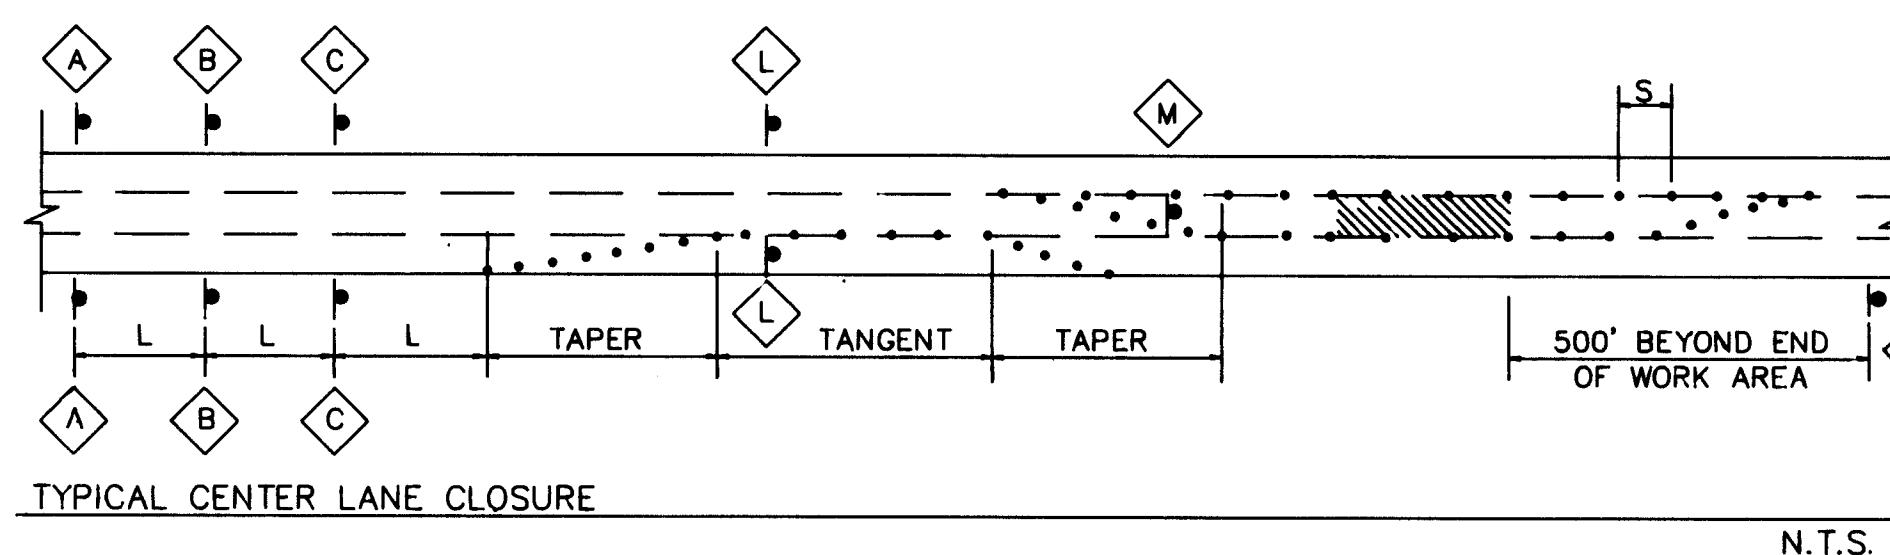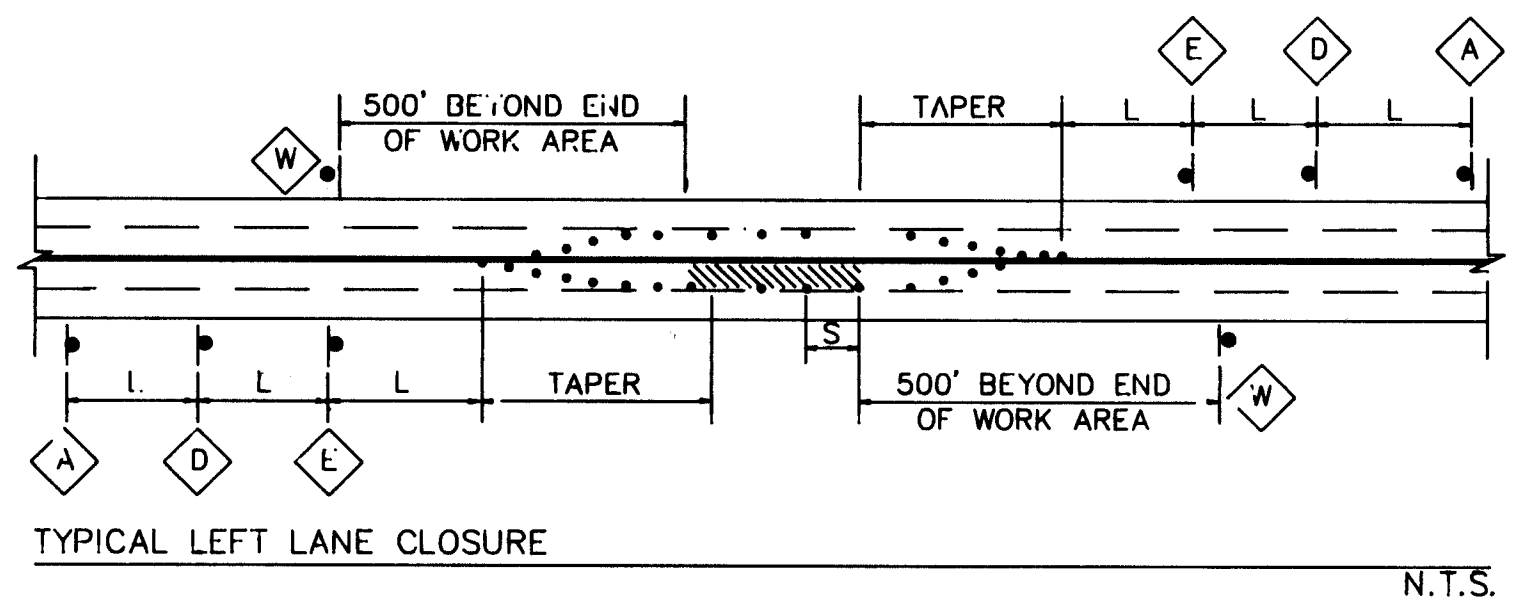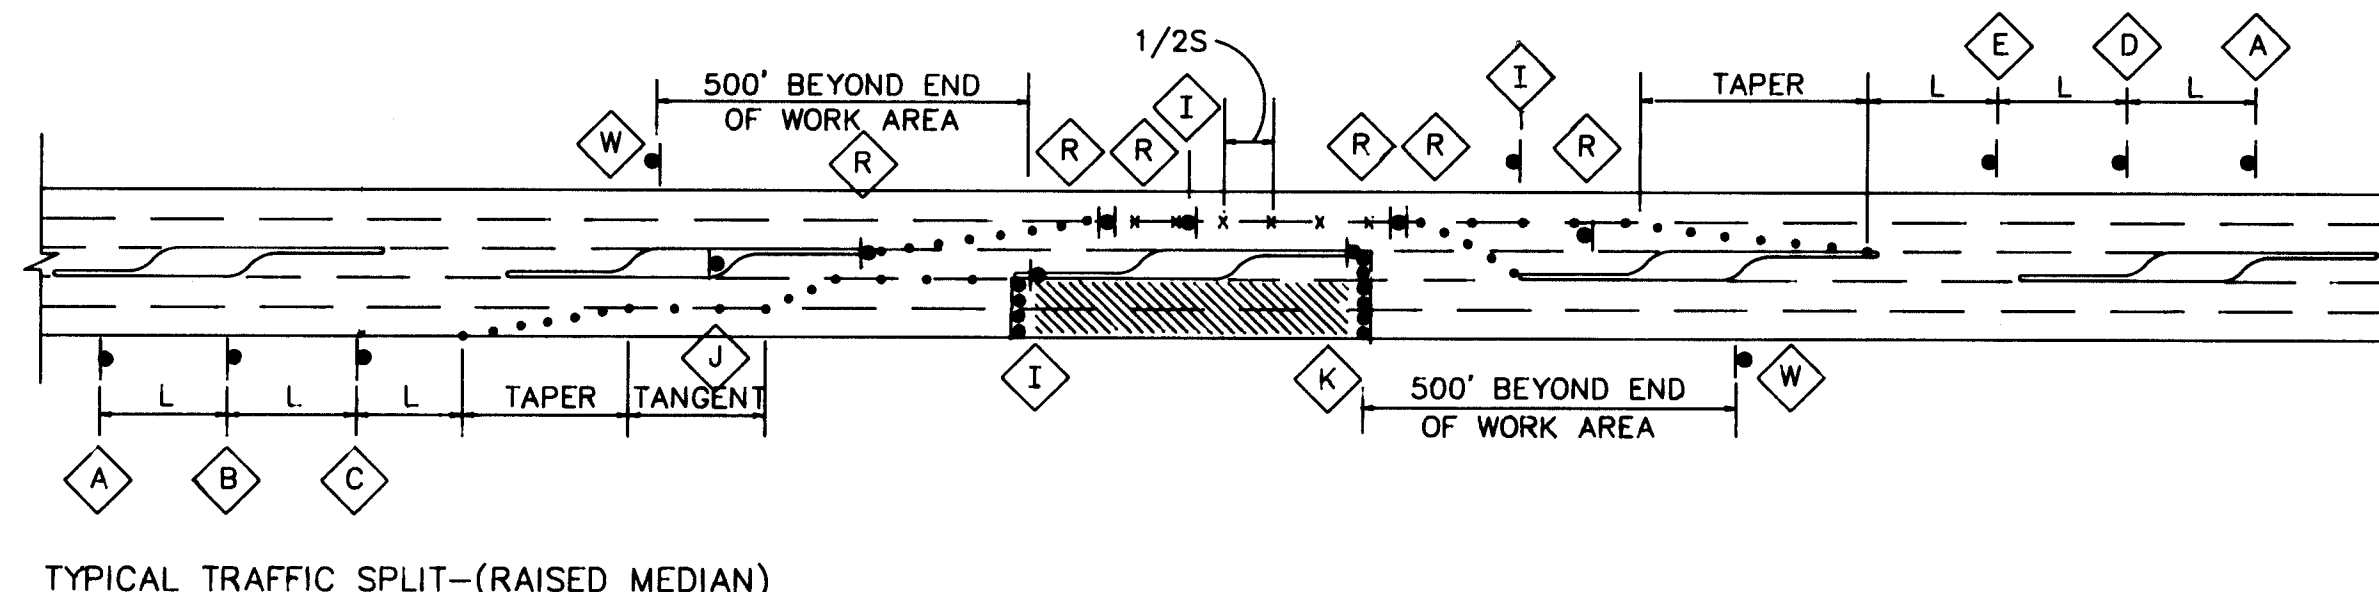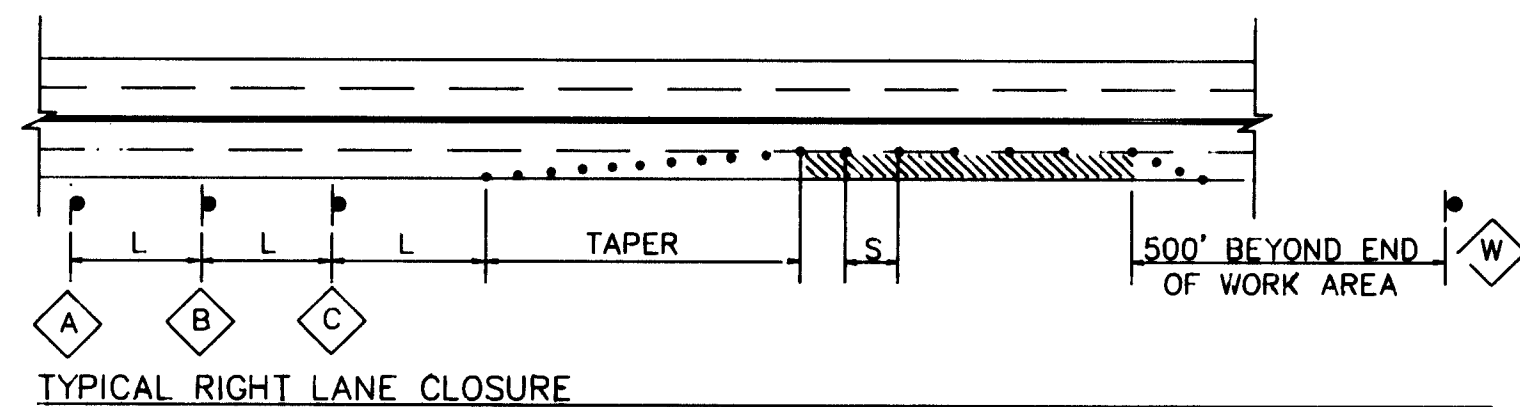

LEGEND


- WORK AREA
- TRAFFIC SIGN (SEE THIS SHEET FOR DESIGNATION)
 - BARRICADE - TYPE I, TYPE II, OR BARREL
 - BARRICADE - TYPE III
 - VERTICAL PANEL
 - WARNING SIGN
 - DISTANCE BETWEEN SIGNS - A DISTANCE MEASURED IN FEET EQUAL TO A VALUE OF TEN TIMES THE SPEED LIMIT OF THE STREET
 - FLAGMAN POSITION
 - SPACING BETWEEN BARRICADES - A DISTANCE MEASURED IN FEET EQUAL TO THE SPEED LIMIT OF THE STREET
- TAPER LENGTH - SEE CHART BELOW
- TANGENT LENGTH - IS EQUAL TO THE TAPER LENGTH FOR A GIVEN STREET

TAPER REQUIREMENTS

SPEED LIMIT (MPH)	TAPER LENGTH (FEET)			MAXIMUM DISTANCE BETWEEN DEVICES (FEET)	MINIMUM NUMBER OF DEVICES REQUIRED
	10' LANE	11' LANE	12' LANE		
25	104	115	125	25	6
30	150	165	185	30	7
35	204	225	245	35	8
40	267	293	320	40	9
45	450	495	540	45	13
50	500	550	600	50	13
55	550	605	660	55	13

TRAFFIC CONTROL

Three (3) working days prior to beginning construction the Contractor shall submit to Traffic Engineering Division a detailed construction schedule. Two (2) working days prior to construction the Contractor shall obtain a barricading permit from the Traffic Engineering Division. Contractor shall notify Barricade Engineer (768-2551) prior to occupying an intersection.

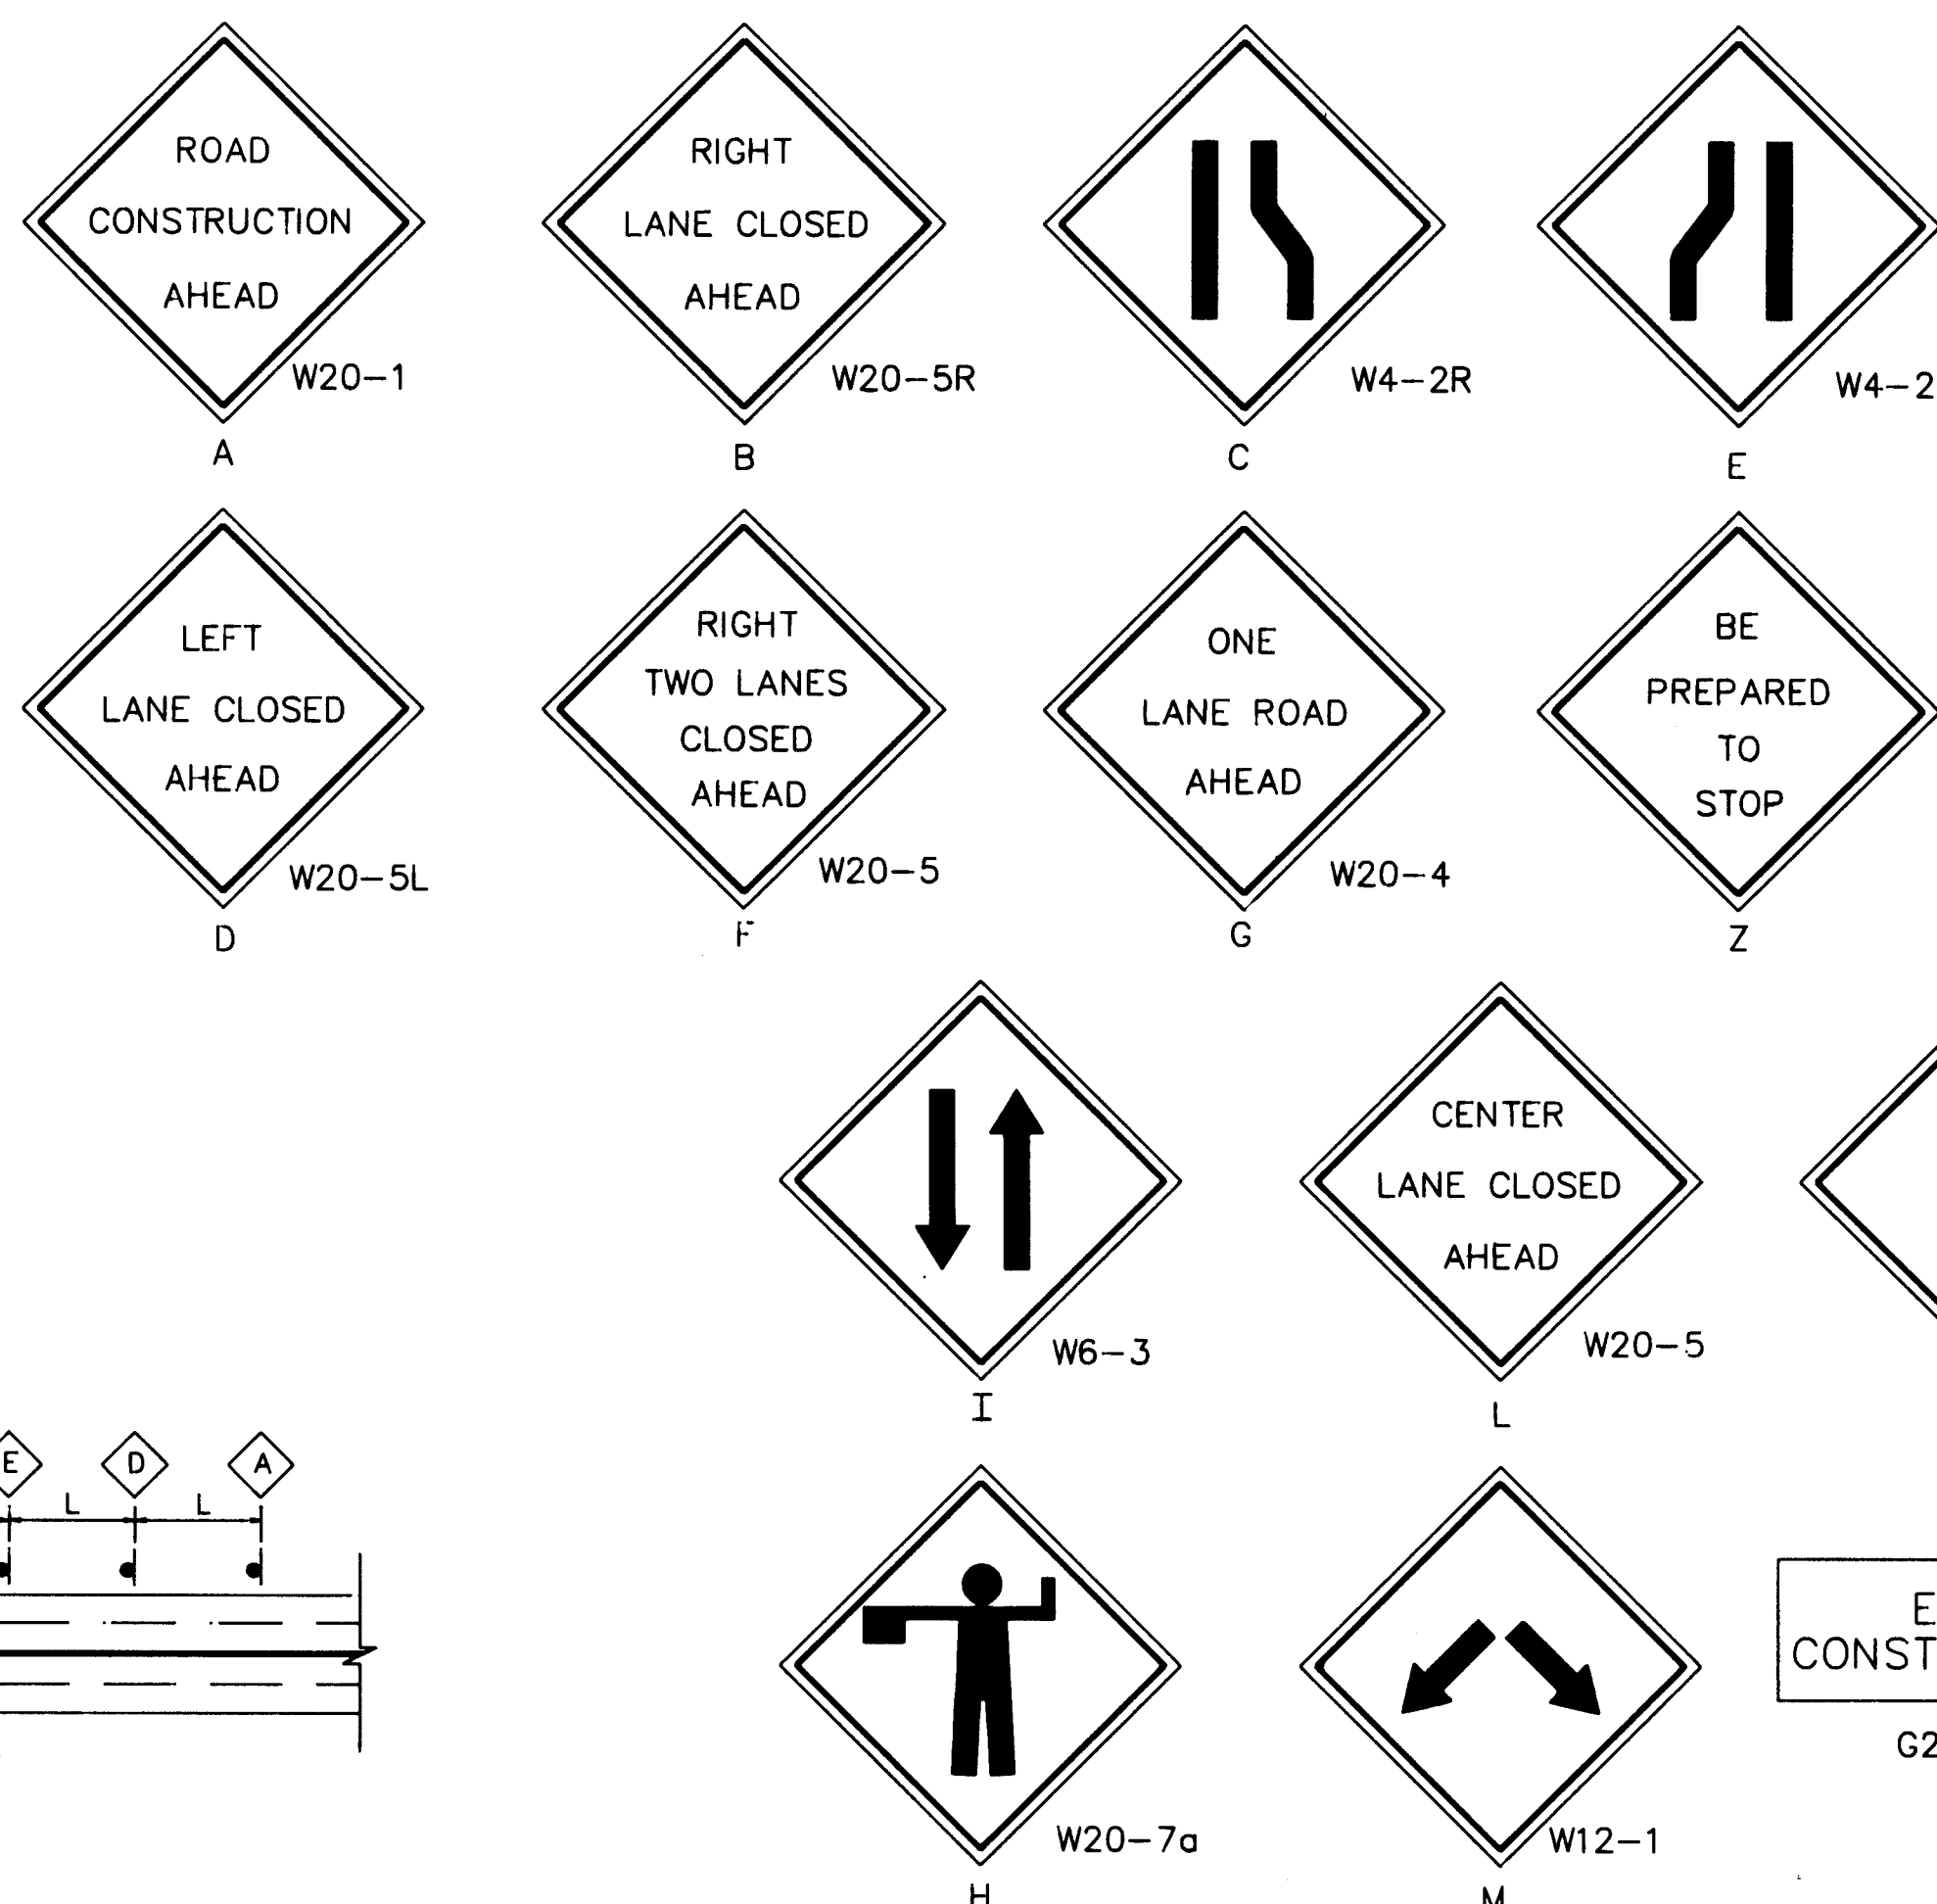

END
CONSTRUCTION
G20-2
W

KEEP
RIGHT
R4-7a
Q

R3-2L
R

AS BUILT INFORMATION		BENCH MARKS		SURVEY INFORMATION		ENGINEER'S SEAL	
CONTRACT NO.	DATE	NO.	DATE	NO.	DATE	NO.	DATE
WORK ORDER NO.	DATE	BY	DATE	REMARKS	BY	DATE	DATE
DESIGNED BY	DATE	DESIGNED BY	DATE	DESIGNED BY	DATE	DESIGNED BY	DATE
FIELD CHECKED BY	DATE	FIELD CHECKED BY	DATE	FIELD CHECKED BY	DATE	FIELD CHECKED BY	DATE
APPROVED BY	DATE	APPROVED BY	DATE	APPROVED BY	DATE	APPROVED BY	DATE
CORRECTED BY	DATE	CORRECTED BY	DATE	CORRECTED BY	DATE	CORRECTED BY	DATE
RECORDED BY	DATE	RECORDED BY	DATE	RECORDED BY	DATE	RECORDED BY	DATE
NO.	DATE	NO.	DATE	NO.	DATE	NO.	DATE

CITY OF ALBUQUERQUE PUBLIC WORKS DEPARTMENT ENGINEERING GROUP					
TITLE: HIGH RIDGE SHOPPING CENTER BARRICADE PLAN					
APPROVALS	ENGINEER	DATE	APPROVALS	ENGINEER	DATE
D.R.C. Chair	Rep. 18m	6/27/07			
Trans. Dev					
Utility Dev	REBO	6/27/07			
DRAWING NO.	3857	MAP NO.	J-22-Z	SHEET	10 OF 10