


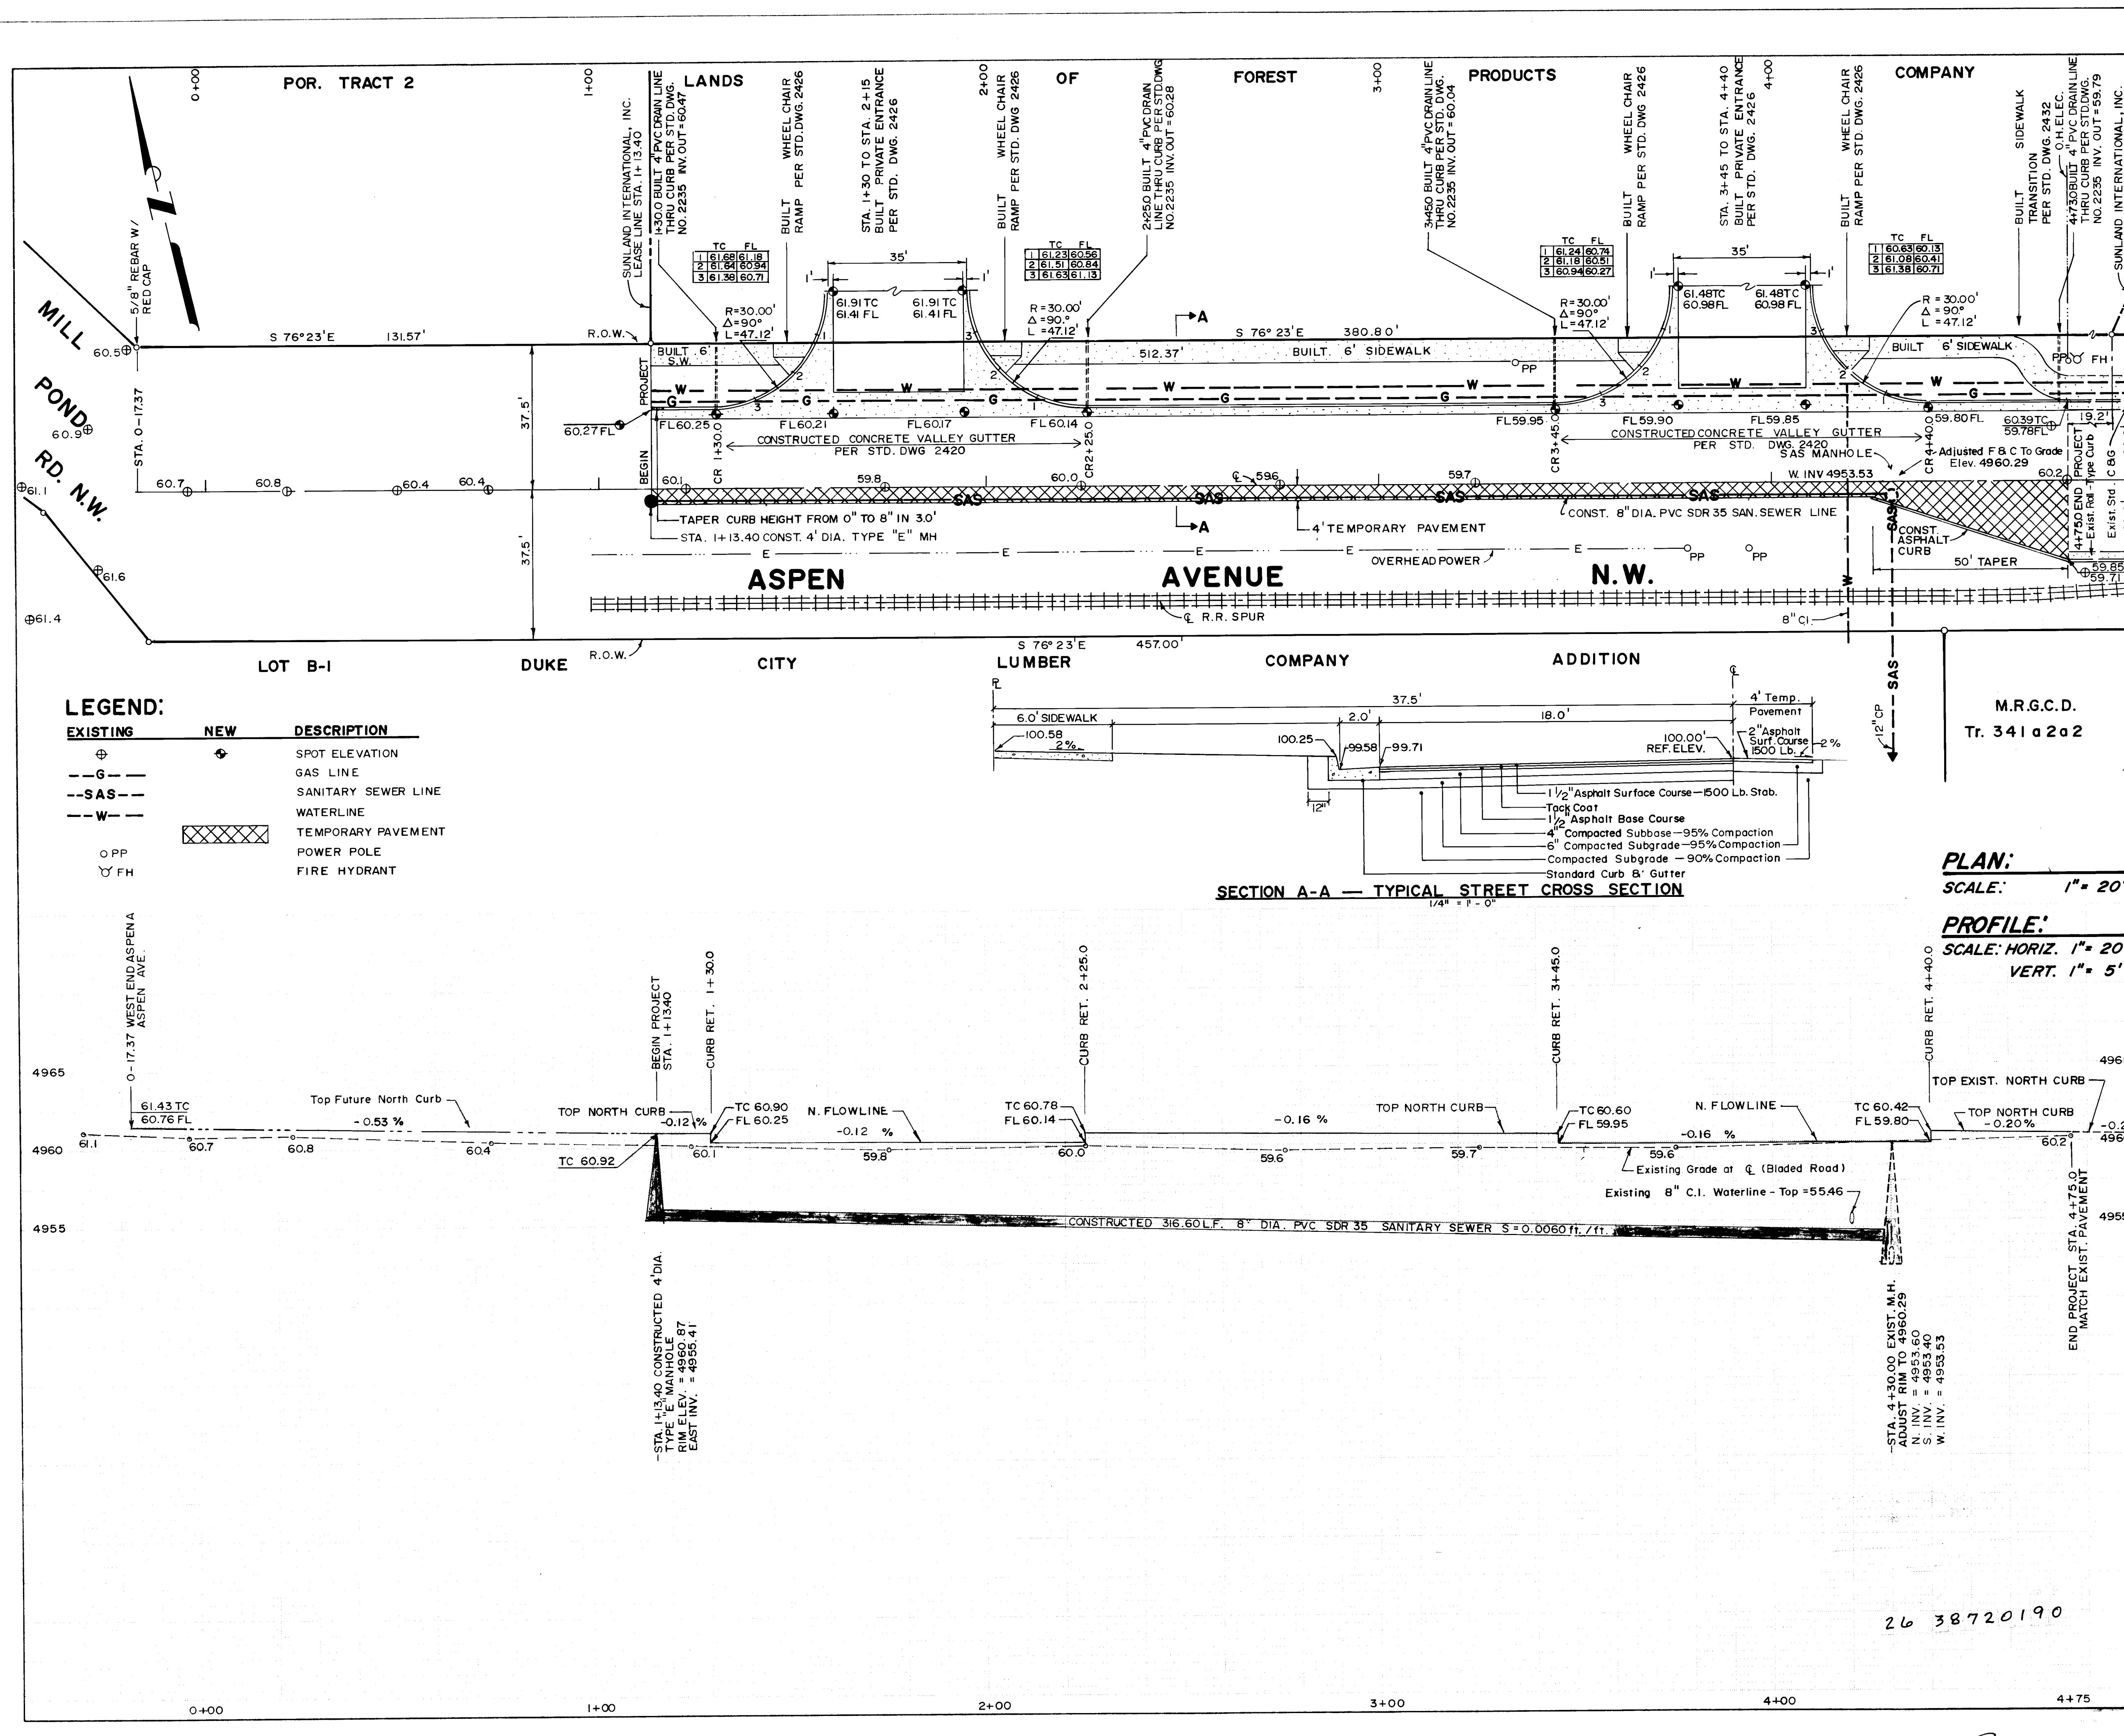

NOTICE TO CONTRACTOR

1. All work detailed on these plans to be performed under contract shall, except as otherwise stated or provided for herein, be constructed in accordance with the City of Albuquerque Standard Specifications for Public Works Construction, 1986.

2. Two (2) working days prior to any excavation, contractor must contact Line Locating Service, 765-1234, for location of existing utilities.

3. Prior to construction, the contractor shall excavate and verify the horizontal and vertical locations of all obstructions. Should a conflict exist, the contractor shall notify the engineer or surveyor so that the conflict can be resolved with a minimum amount of delay.

THE FOLLOWING NOTES ALSO APPLY WHEN CHECKED

☒ All utilities and utility service lines shall be installed prior to paving.

☒ Backfill compaction shall be according to specific street use.

☒ Tack coat requirements shall be determined by the City Engineer.

☒ Sidewalks and wheelchair ramps within the curb returns shall be constructed wherever a new curb return is constructed.

☒ If curb is depressed for a driveway or a handicap ramp, the driveway or ramp shall be constructed prior to acceptance of the curb and gutter.

☒ All storm drainage facilities shall be completed prior to final acceptance.

☒ 72 hours prior to construction, contractor shall contact Water Systems (823-4200) for a valve shut-off plan.

TRAFFIC CONTROL

Three (3) working days prior to beginning construction the Contractor shall submit to the Construction Co-ordination Division a detailed construction schedule. Two (2) working days prior to construction the Contractor shall obtain a barricading permit from the Construction Co-ordination Division. Contractor shall notify Barricading Engineer (768-2551) prior to occupying an intersection.

AS BUILT INFORMATION

DATE: 11/14/89
BY: R.W. Kane
DATE: 11/14/89
BY: R.W. Kane

ENGINEER'S SEAL

SEAL OF R. W. KANE, PROFESSIONAL ENGINEER, STATE OF NEW MEXICO, NO. 12345

OCTOBER 25, 1989

CITY OF ALBUQUERQUE
PUBLIC WORKS DEPARTMENT
ENGINEERING GROUP

TITLE PAVEMENT, CURB & GUTTER & SAS EXTENSION
ASPEN AVENUE, N.W.
(FROM 130'± E. OF MILL POND ROAD TO 925'± W. OF 12TH ST.)

APPROVALS
ENGINEER: R. W. Kane, 11/14/89
DATE: 11/14/89
TRANSPORTATION: R. W. Kane, 11/14/89
DATE: 11/14/89
HYDROLOGY: R. W. Kane, 11/14/89
DATE: 11/14/89

DESIGN
DESIGNED BY: F. D. LOVELADY, DATE: JUNE 19, 1989
DRAWN BY: F. D. LOVELADY, DATE: JUNE 20, 1989
CHECKED BY: F. D. LOVELADY, DATE: JUNE 21, 1989

DRAWING NO. 3872
MAP NO. H-13
SHEET 1 OF 1

26 38720190

R. W. Kane 11-14-89