
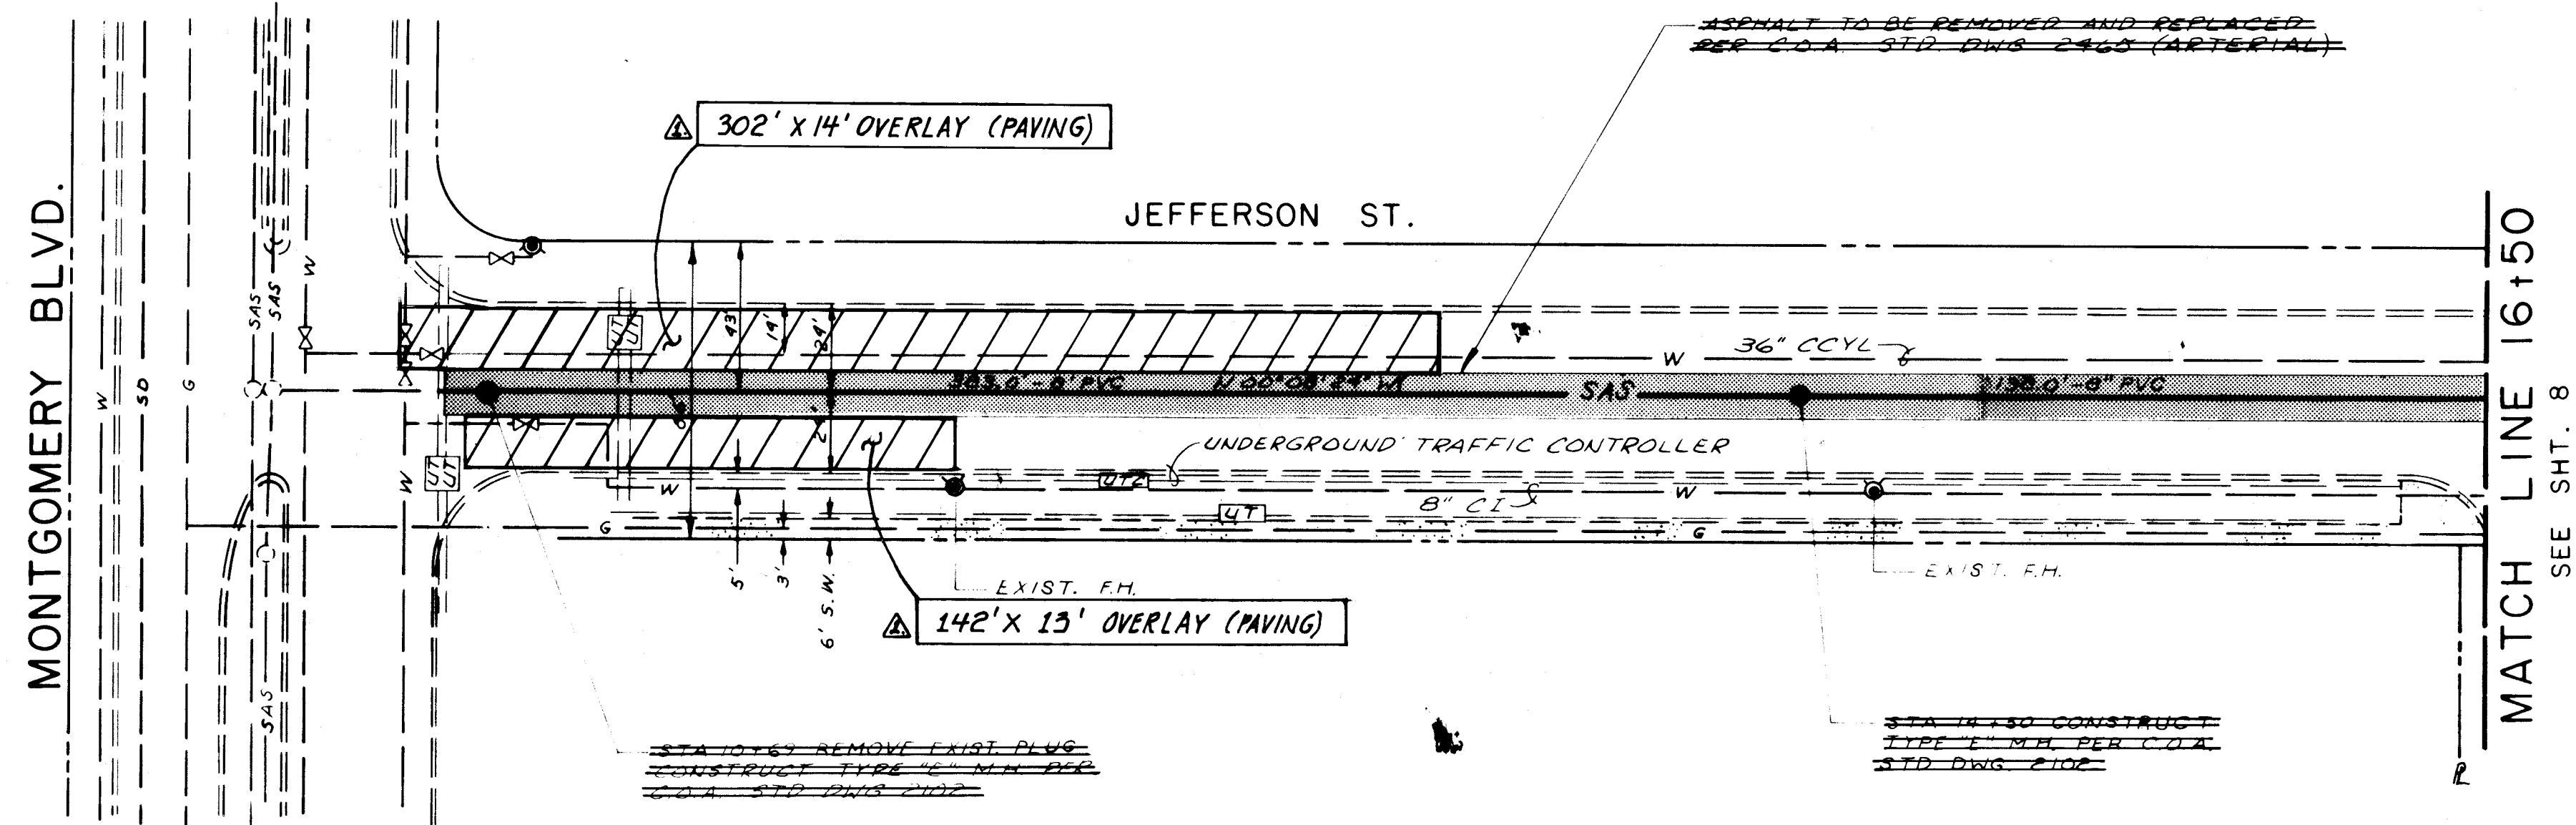


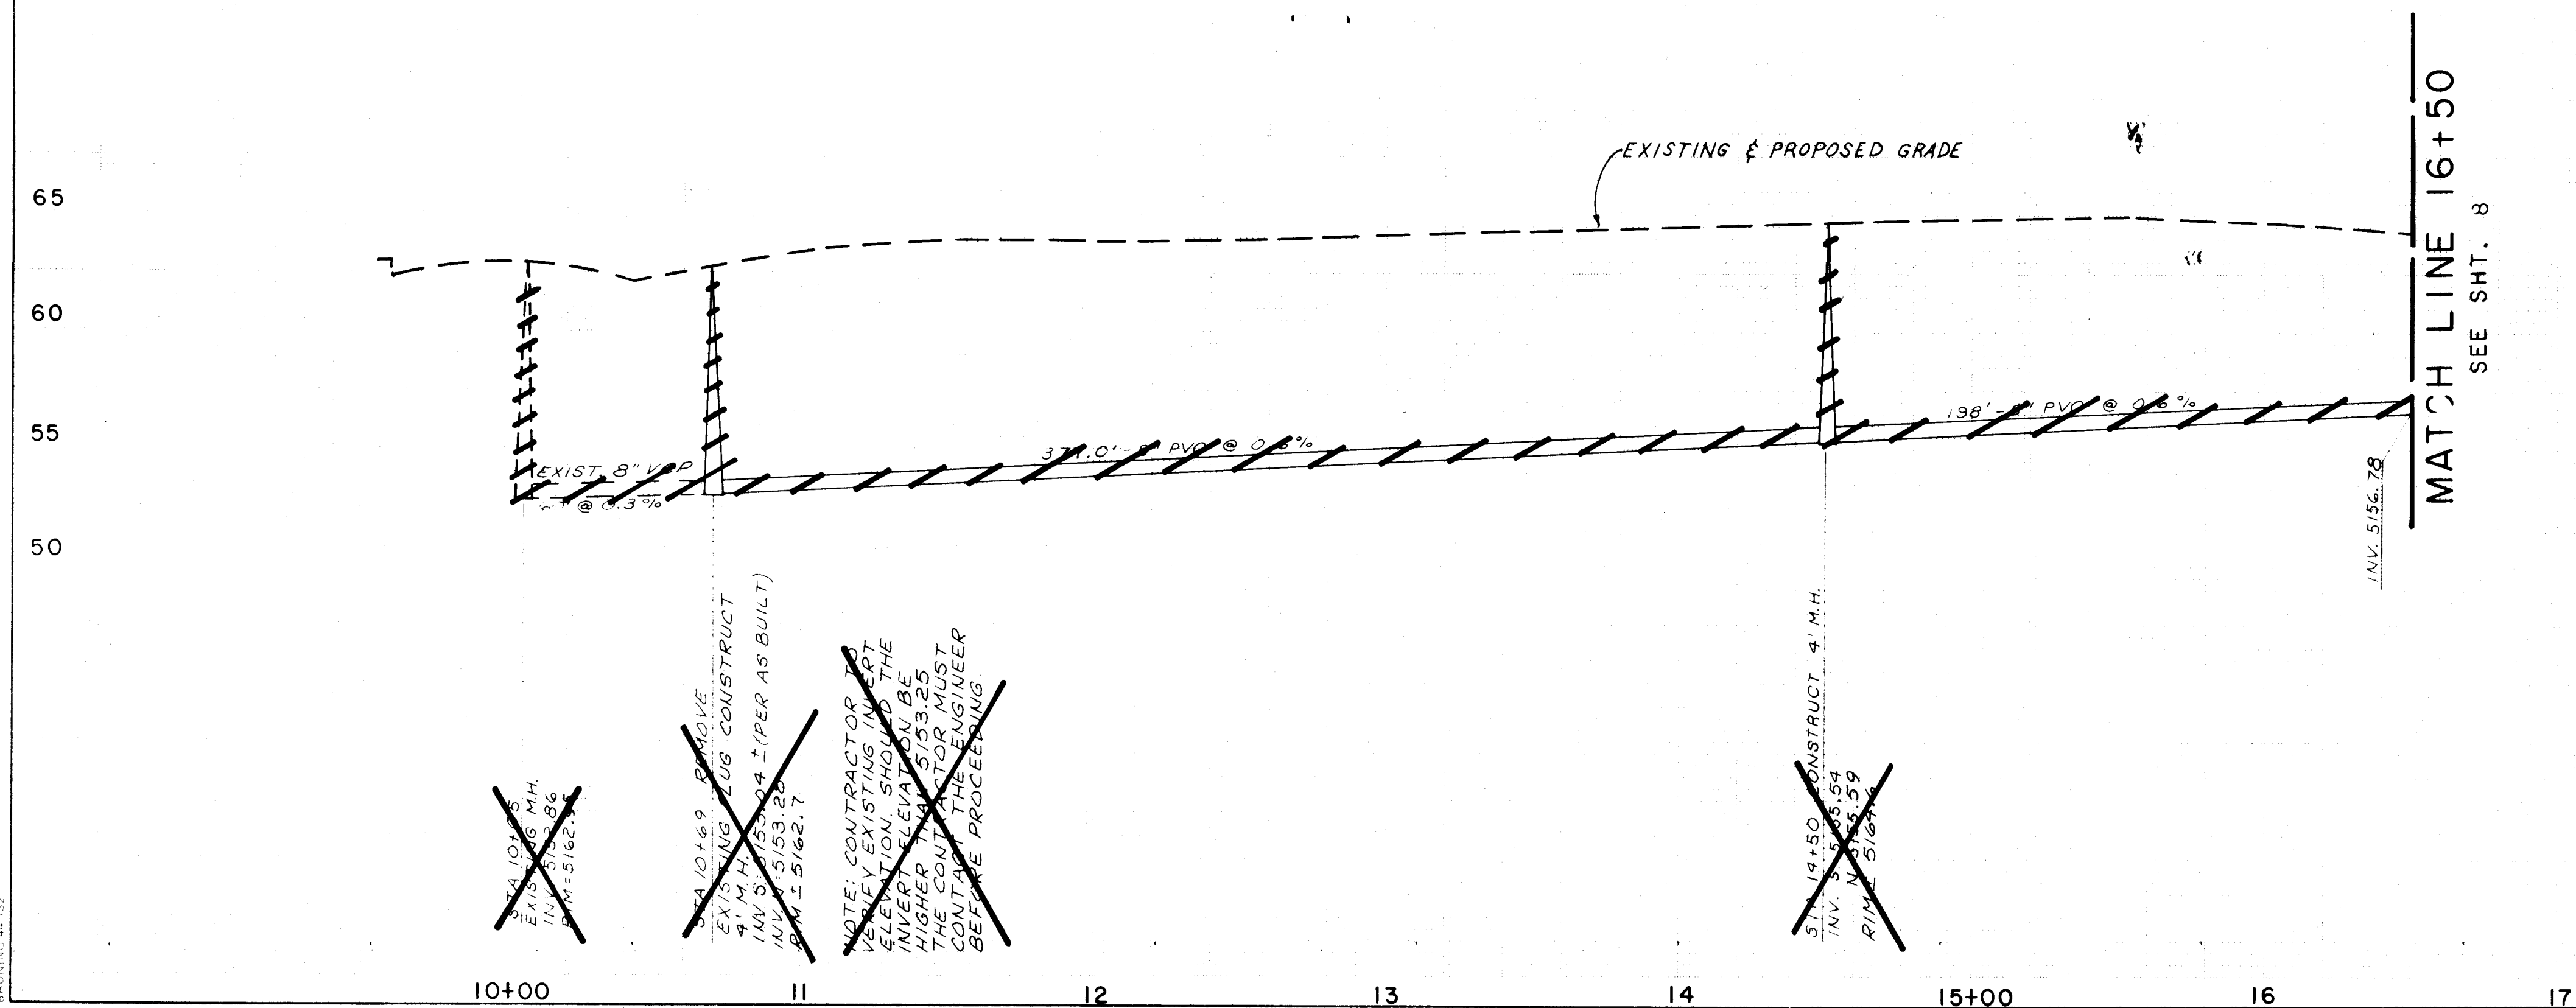

NOTE:
CAUTION TO CONTRACTOR-
EXISTING UTILITIES PARALLEL
MONTGOMERY BETWEEN NORTH
CURB LINE & R/W LINE.
USE CARE IN EXCAVATING.

**THIS DRAWING IS FOR EMERGENCY PAVING
OVERLAY INFORMATION ONLY.**

[illegible]

PROJECT NO. 0690651

APPROVAL OF AS BUILT DRAWINGS
CHIEF CONSTRUCTION ENGINEER
Kenneth B. Smith
DATE 8-3-59

1	2	3	4	5	6	7	8	9	10	11	12
1	2	3	4	5	6	7	8	9	10	11	12

CITY OF ALBUQUERQUE
PUBLIC WORKS DEPARTMENT
ENGINEERING DIVISION

TITLE: JEFFERSON ST OVERLAY

APPROVALS	ENGINEER	DATE	APPROVALS	ENGINEER	DATE
For City Engineer	<i>Robert J. [Signature]</i>	3-13-89	Liquid Waste	<i>[Signature]</i>	2/28/89
AGE - Design	"	"	Traffic	<i>Robert J. [Signature]</i>	3-13-89
AGE - Hydrology	"	"	Water	<i>[Signature]</i>	2/28/89

DRAWING NO.	3881	MAP NO.	F-17	SHEET	1	OF	1
-------------	------	---------	------	-------	---	----	---