

LEGEND

MATERIALS

CONCRETE
RIP-RAP

LINES

RIGHT-OF-WAY
PROPERTY LINE (PLAN)
RIGHT-OF-WAY (SECTION)
CENTERLINE
EASEMENT LINE
MATCHLINE

SECTION CUT LINE

EARTHWORK

CONTOUR LINE
SPOT ELEVATION
PROJECT/PHASE
BOUNDARY
SWALE/DIRECT. OF FLOW

MISCELLANEOUS UTILITIES

GAS LINE
UNDERGROUND TELEPHONE
UNDERGROUND ELECTRICAL
STORM DRAIN
STORM DRAIN MANHOLE
STORM DRAIN INLET

SANITARY SEWER (SAS)

SANITARY LINE
SANITARY MANHOLE
SERVICE CONNECTIONS
CAP OR PLUG
ENCASEMENT

WATER

CAPS AND PLUGS
SERVICE CONNECTIONS
GATE VALVE
FIRE HYDRANT
BUTTERFLY VALVE
REDUCER
PRESSURE ZONE BOUNDARY
ELBOW
CROSS
TEE

MISCELLANEOUS

EDGE OF ASPHALT
FIELD FENCE
CHAINLINK FENCE
YARD/BLOCK WALL
RETAINING WALL
POWER OR TELE. POLE
TREE
TRAFFIC SIGN

PAVING IMPROVEMENTS
AND
NEW STORM DRAIN
FOR
AVENIDA LOS GRIEGOS

INDEX OF DRAWINGS

1 OF 7

TITLE SHEET

2 OF 7

ROADWAY EASEMENT

3 OF 7

STORM DRAIN
STA. 10+00 to 13+05.58

4 OF 7

STORM DRAIN
STA. 12+67.52 to 16+18.82

5 OF 7


PAVING PLAN & PROFILE
STA. 10+00 to 13+05.58

6 OF 7

PAVING PLAN & PROFILE
STA. 12+67.52 to 16+18.82

7 OF 7

CROSS SECTIONS & DETAILS

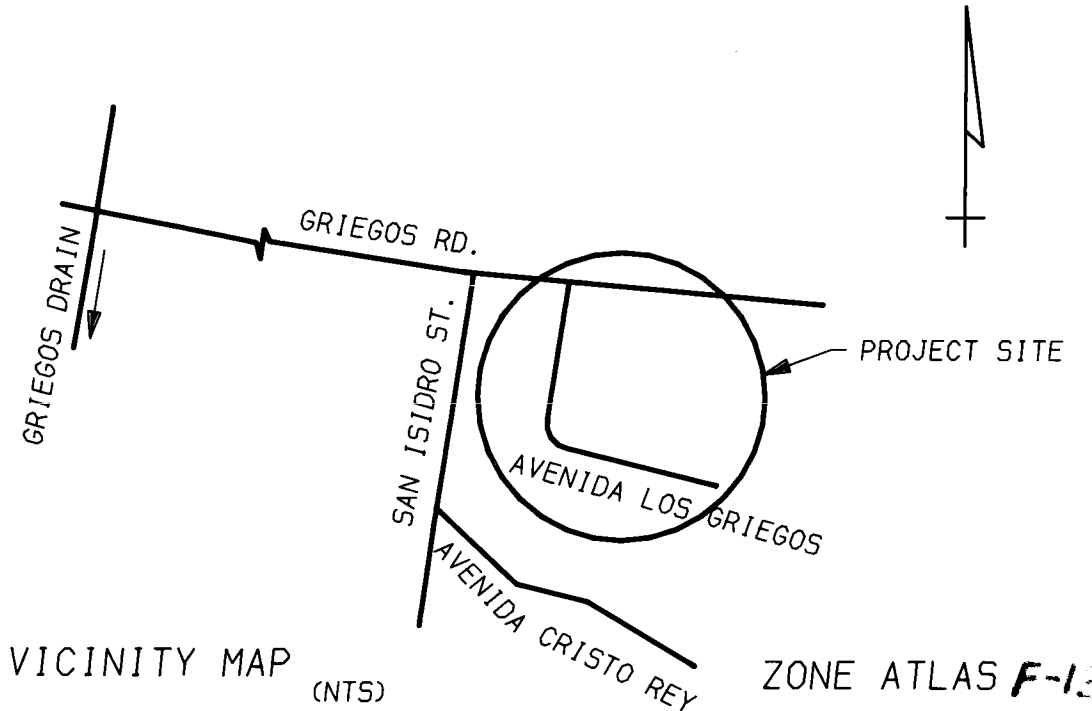

GENERAL NOTES

- ALL WORK DETAILED ON THESE PLANS TO BE PERFORMED UNDER CONTRACT SHALL, EXCEPT AS OTHERWISE STATED OR PROVIDED FOR HEREON, BE CONSTRUCTED IN ACCORDANCE WITH THE CITY OF ALBUQUERQUE STANDARD SPECIFICATIONS - PUBLIC WORKS CONSTRUCTION - 1986.
- TWO (2) WORKING DAYS PRIOR TO ANY EXCAVATION, CONTRACTOR MUST CONTACT NEW MEXICO ONE-CALL SYSTEM 260-1990, FOR LOCATION OF EXISTING UTILITIES.
- CONTRACTOR SHALL NOTIFY THE ENGINEER NOT LESS THAN SEVEN (7) DAYS PRIOR TO STARTING WORK IN ORDER THAT THE ENGINEER MAY TAKE NECESSARY MEASURES TO INSURE THE PRESERVATION OF SURVEY MONUMENTS. CONTRACTOR SHALL NOT DISTURB PERMANENT SURVEY MONUMENTS WITHOUT THE CONSENT OF THE ENGINEER AND SHALL NOTIFY THE ENGINEER AND BEAR THE EXPENSE OF REPLACING ANY THAT MAY BE DISTURBED WITHOUT PERMISSION. REPLACEMENT SHALL BE DONE ONLY BY THE ENGINEER. WHEN A CHANGE IS MADE IN THE FINISHED ELEVATION OF THE PAVEMENT OF ANY ROADWAY IN WHICH A PERMANENT SURVEY MONUMENT IS LOCATED, CONTRACTOR SHALL, AT HIS OWN EXPENSE, ADJUST THE MONUMENT COVER TO THE NEW GRADE UNLESS OTHERWISE SPECIFIED.
- SHOULD A CONFLICT EXIST BETWEEN THESE PLANS AND ACTUAL FIELD CONDITIONS, THE CONTRACTOR SHALL PROMPTLY NOTIFY THE ENGINEER IN WRITING SO THAT THE CONFLICT CAN BE RESOLVED WITH A MINIMUM AMOUNT OF DELAY FOR ALL PARTIES.
- THE CONTRACTOR SHALL MAINTAIN ACCESS TO ADJACENT PROPERTIES DURING CONSTRUCTION.
- ALL WORK ON THIS PROJECT SHALL BE PERFORMED IN ACCORDANCE WITH APPLICABLE FEDERAL, STATE AND LOCAL LAWS, RULES AND REGULATIONS CONCERNING CONSTRUCTION SAFETY AND HEALTH.
- TWO (2) WORKING DAYS PRIOR TO BEGINNING CONSTRUCTION, CONTRACTOR SHALL OBTAIN A BARRICADING PLAN AND PERMIT THROUGH CONSTRUCTION COORDINATION DIVISION AT 768-2552.
- ALL UTILITIES AND UTILITY SERVICE LINES SHALL BE INSTALLED PRIOR TO PAVING.
- BACKFILL COMPACTION SHALL BE ACCORDING TO SPECIFIED STREET USE. (RESIDENTIAL)
- TACK COAT REQUIREMENTS SHALL BE DETERMINED BY THE CITY ENGINEER.
- ALL STORM DRAINAGE FACILITIES SHALL BE COMPLETED PRIOR TO FINAL ACCEPTANCE.
- ALL STATIONING SHALL BE BASED ON CONSTRUCTION CENTERLINE.


APPROVAL OF AS BUILT DRAWINGS
CHIEF CONSTRUCTION ENGINEER
Philip J. Miller
DATE 6-27-91

AS BUILTS

Name _____
Date _____

C of A PWD Maps & Records
1 2 3 4 5 6 7 8 9 10 11 12
26 37 45 01 91

CITY OF ALBUQUERQUE		APPROVED FOR CONSTRUCTION	
		CITY ENGINEER	
PROJECT NO.	MAP NO.	SHEET OF	
3965	F-13	1 7	

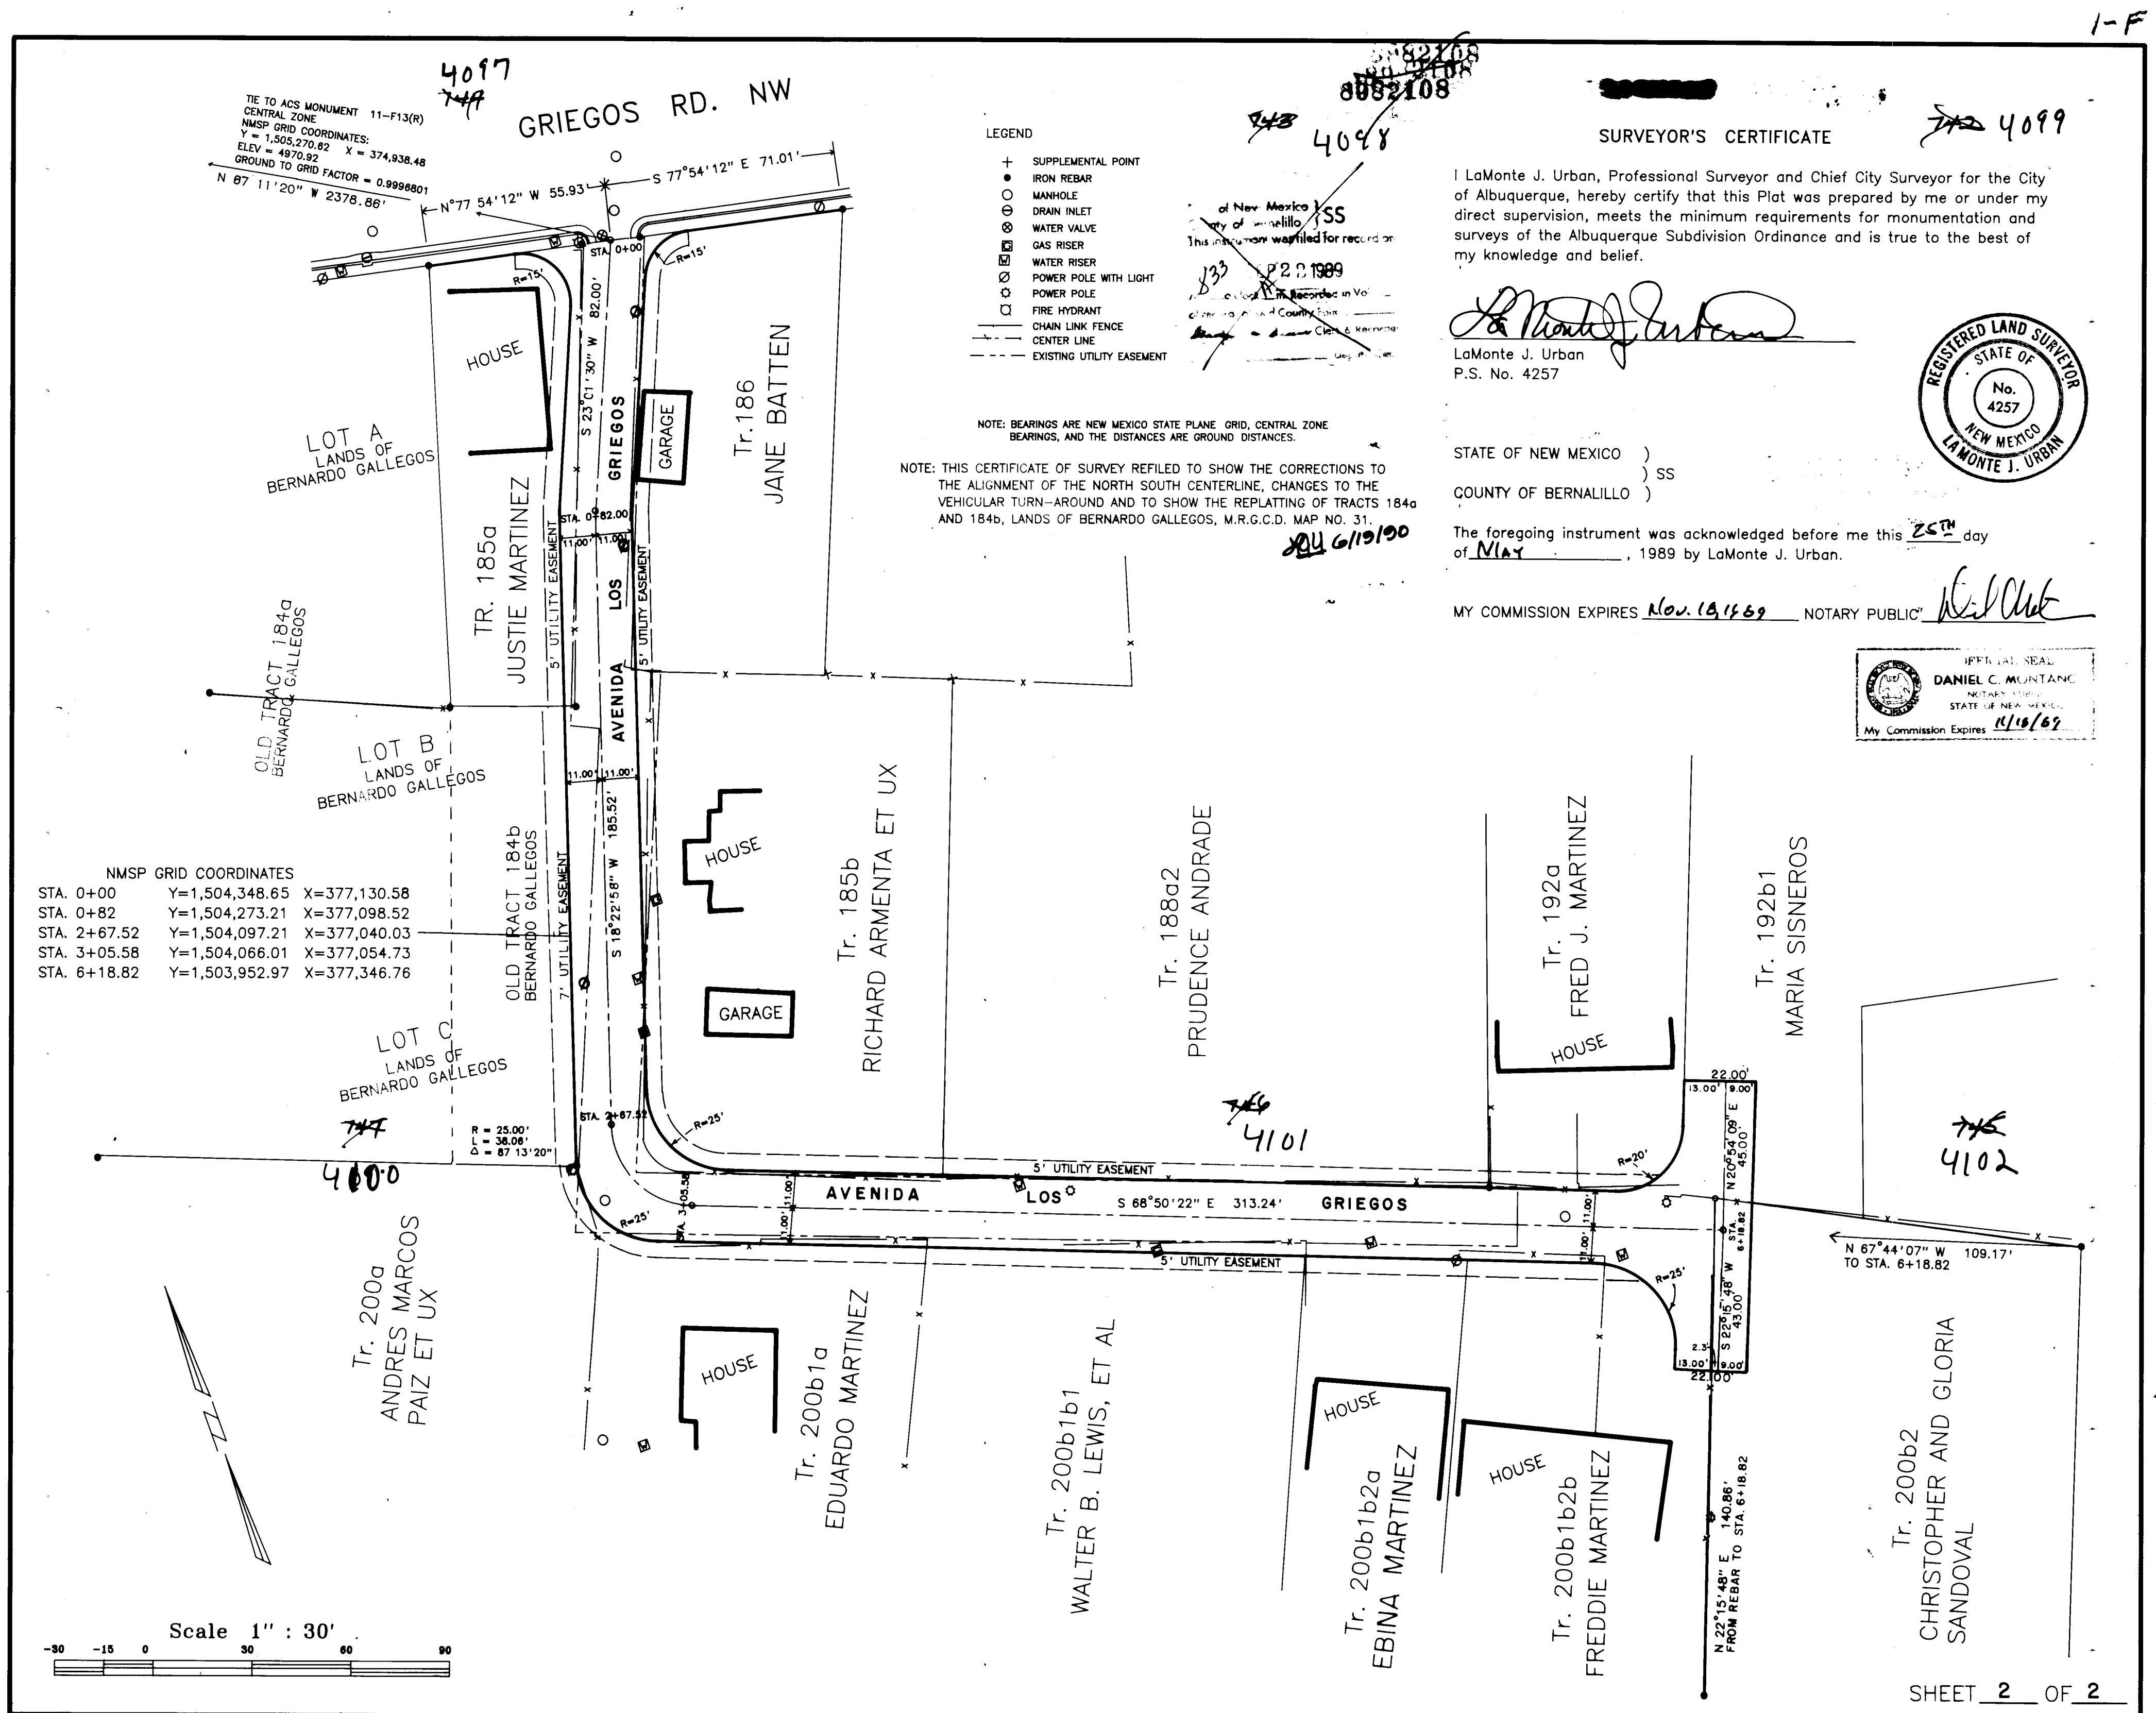

FOR INFORMATION PURPOSES ONLY

738 4091
GRANTS OF EASEMENT
FOR
ROADWAY PURPOSES

THIS INDENTURE made and executed this 31st day of July, 1989 by and between the undersigned property owners in the County of Bernalillo and the State of New Mexico hereinafter called the Grantors and THE CITY OF ALBUQUERQUE, NEW MEXICO, a municipal corporation.

WITNESSETH, that for good and valuable consideration the receipt of which is hereby acknowledged, the Grantors have this day bargained and sold and by these presents do sell, convey and deliver unto the City of Albuquerque a permanent easement as Right-of-Way including the permanent right to enter upon the real estate hereinafter described at any time that it may see fit and construct, maintain and repair roadway through and under the lands hereinafter described and the further right to remove trees, bushes, undergrowth and obstructions interfering with the location, construction and maintenance of said roadway.

The land affected by the grant and of this easement and Right-of-Way is located within the Municipal Limits of the City of Albuquerque, County of Bernalillo, State of New Mexico and is more particularly described as follows:

Said land being situate within the Southeast 1/4 of Section 31, Township 11 North, Range 3 East of the New Mexico Principal Meridian and being further described as portions of Tracts 184b, 185a, 185b, 186, 188a2, 192a, 192b1, 200a, 200b1a, 200b1b1, 200b1b2a, 200b1b2b, and Tract 200b2 all as shown on the Middle Rio Grande Conservancy District Property Map No. 31.

Beginning at Albuquerque Control Survey Monument 11-F13(R) having
thence State Plane Coordinate values of X=374,938.48 and Y=1,505,270.62
thence S 67°11'20" E a distance of 2,378.86 feet to the true point of
Beginning, said point being the point of intersection of the Southerly
Right-of-Way line of Griegos Road NW and Station 0+00 of the centerline
being described, from which point the Northeast corner of said Tract 186
bears S 77°54'12" E a distance of 77.01 feet;

Thence, S 23°01' 30" W, a distance of 82.00 feet to an angle point and Station 0+82.00;

Thence, S 18°22'58" W, a distance of 185.52 feet to Station 2+67.52 and the point of curve;

Thence, Southeasterly along said curve on said centerline (said curve being concave to the Northeast, having a radius of 25.00 feet and a chord which bears S 25°13'42" E, a distance of 34.49 feet) a distance of 38.06 feet to the point of tangent and station 3+05.58.

Thence, S 68°50'22" E, a distance of 313.24 feet to the end of the centerline being described and station 6+18.82 having New Mexico State Plane Coordinates of X= 377,346.76 and Y=1,503,952.97.

Also a roadway easement to be used for Vehicular turn-around purposes, said easement being 13 feet on the west side and 9.00 feet on the east side of the following described line;

Beginning at said Station 6+18.82 thence, N 20°54'09" E, a distance of 45.00 feet and the end of the centerline being described.

Together with a Roadway Easement to be used for Vehicular turn-around purposes. Said Easement being 13 feet on the west side and 9.00 feet on the east side of the following described line;

Beginning at said Station 6+18.82 thence, S 22°15'48" W, a distance of 43.00 feet to the end of the centerline being described.

The above roadway easement is to include a 15 foot Right-of-Way return at the Northwest corner of said Tract 185a; a 15 foot Right-of-Way return at the Northwest corner of Tract 185a; a 25.00 foot Right-of-Way return at the Southwest corner of said Tract 185b; a 25.00' Right-of-Way return at the Northeast corner of said Tract 200a; a 25.00' Right-of-Way return at the Northeast corner of said Tract 200b1b2b; and a 20.00 foot Right-of-Way return at the Southeast corner of Tract 192a.

TO HAVE AND HOLD the said Right-of-Way and Easement for the uses and purposes aforesaid, unto Grantee its successors and assigns for so long as said shall not be abandoned for use as a Right-of-Way for aforesaid roadway.

The Grantors do hereby covenant with Grantee that they are lawfully seized and possessed of the real estate above described and that they a good and lawful right to convey it or any part thereof, that it is free from all encumbrances except those of record and taxes due and owing the Treasurer of Bernalillo County and that they will forever warrant and defend the title thereto against the lawful claims of all persons whomsoever.

As part of the consideration for this Grant, the Grantors do hereby release any and all claims for damages for whatsoever cause incidental to the exercise of the rights herein granted provided, however, that the Grantee agrees to save Grantors harmless from any and all liability that may arise as a result of the construction and use of the easement for the purposes set forth.

UTILITY EASEMENT

Together with a 5' Utility Easement located parallel to and continuous with the Right-of-Way perimeter as delineated above.

IN WITNESS WHEREOF, the parties have set their hands and seals this 31st day of July, 1989.

Tr. 184b	<u>Bernardo Velasco (Pastor Attorney)</u>	
Tr. 185a	<u>Justo J. Masferrer</u> ^{JCM}	
Tr. 185b	<u>Antonio Manuel Lora</u>	
Tr. 186	<u>of Jose Ratter</u>	
Tr. 188a2	<u>Andres Andrade</u>	
Tr. 192a	<u>Fred M. Taylor</u> ^{PM}	
Tr. 192b1	<u>Octaviano Lucero</u> ^{Oct} <u>Elmer Lucero</u> ^{Elmer}	
Tr. 200a	<u>W. Andrew</u> ^{W. Andrew}	
Tr. 200b1a	<u>Edward Westing</u>	
Tr. 200b1b1	<u>Walter A. Lewis</u>	
Tr. 200b1b2a	<u>Elvira Martinez</u>	
Tr. 200b1b2b	<u>Paul H. Taylor</u> ^{Paul H. Taylor}	
Tr. 200b2	<u>Ulpia Manzanera Solorzano</u>	

[illegible]

The foregoing instrument was acknowledged before me this 31st day of July, 1989 by the above signed Owners/Proprietors thereof.

MY COMMISSION EXPIRES 6/2/93 NOTARY PUBLIC Opocella J. Ruble

SURVEYOR'S CERTIFICATE


I, LaMonte J. Urban, Professional Surveyor and Chief City Surveyor for the City of Albuquerque, hereby certify that this Plat was prepared by me or under my direct supervision, meets the minimum requirements for monumentation and surveys of the Albuquerque Subdivision Ordinance and is true to the best of my knowledge and belief.

LaMonte J. Urban
P.S. No. 4257

STATE OF NEW MEXICO)
) SS
COUNTY OF BERNALILLO)

The foregoing instrument was acknowledged before me this 25TH day of MAY, 1989 by LaMonte J. Urban.

MY COMMISSION EXPIRES Nov. 18, 1969 NOTARY PUBLIC [Signature]

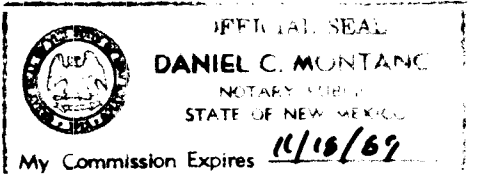

CORRECT AT OF

AVENIDA LOS GRIEGOS
PUBLIC WORKS DEPARTMENT
ENGINEERING GROUP
ALBUQUERQUE, NEW MEXICO
JANUARY 31, 1989
ZONE ATLAS MAP F-13

SURVEYOR'S CERTIFICATE


I LaMonte Urban, Professional Land Surveyor and Chief City Surveyor for the City of Albuquerque, hereby certify that this Plat was prepared by me or under my direct supervision, meets the minimum requirements for monumentation and surveys of the Albuquerque Subdivision Ordinance and is true to the best of my knowledge and belief.

LaMonte Urban
P.S. No. 4257

[illegible]



The foregoing instrument was acknowledged before me this 2nd day of February, 1989 by LaMonte Urban.

MY COMMISSION EXPIRES Nov. 18, 1969 NOTARY PUBLIC [Signature]

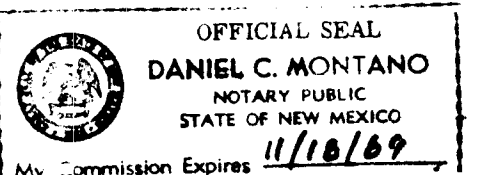

NOTE: THIS CERTIFICATE OF SURVEY REFILED TO SHOW THE CORRECTIONS TO THE ALIGNMENT OF THE NORTH SOUTH CENTERLINE, CHANGES TO THE VEHICULAR TURN-AROUND AND TO SHOW THE REPLATTING OF TRACTS 184a AND 184b, LANDS OF BERNARDO GALLEGOS, M.R.G.C.D. MAP NO. 31

SHEET 1 OF 2

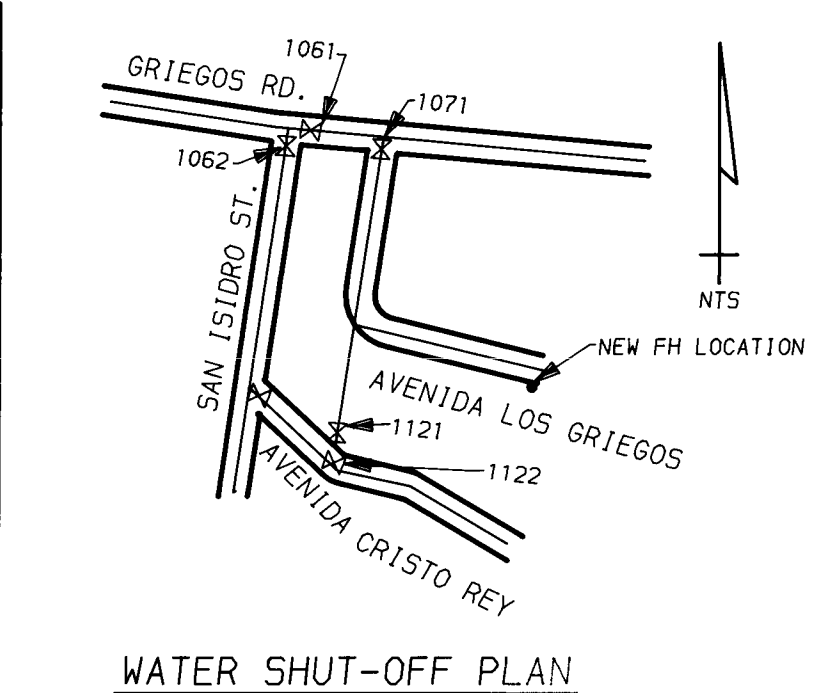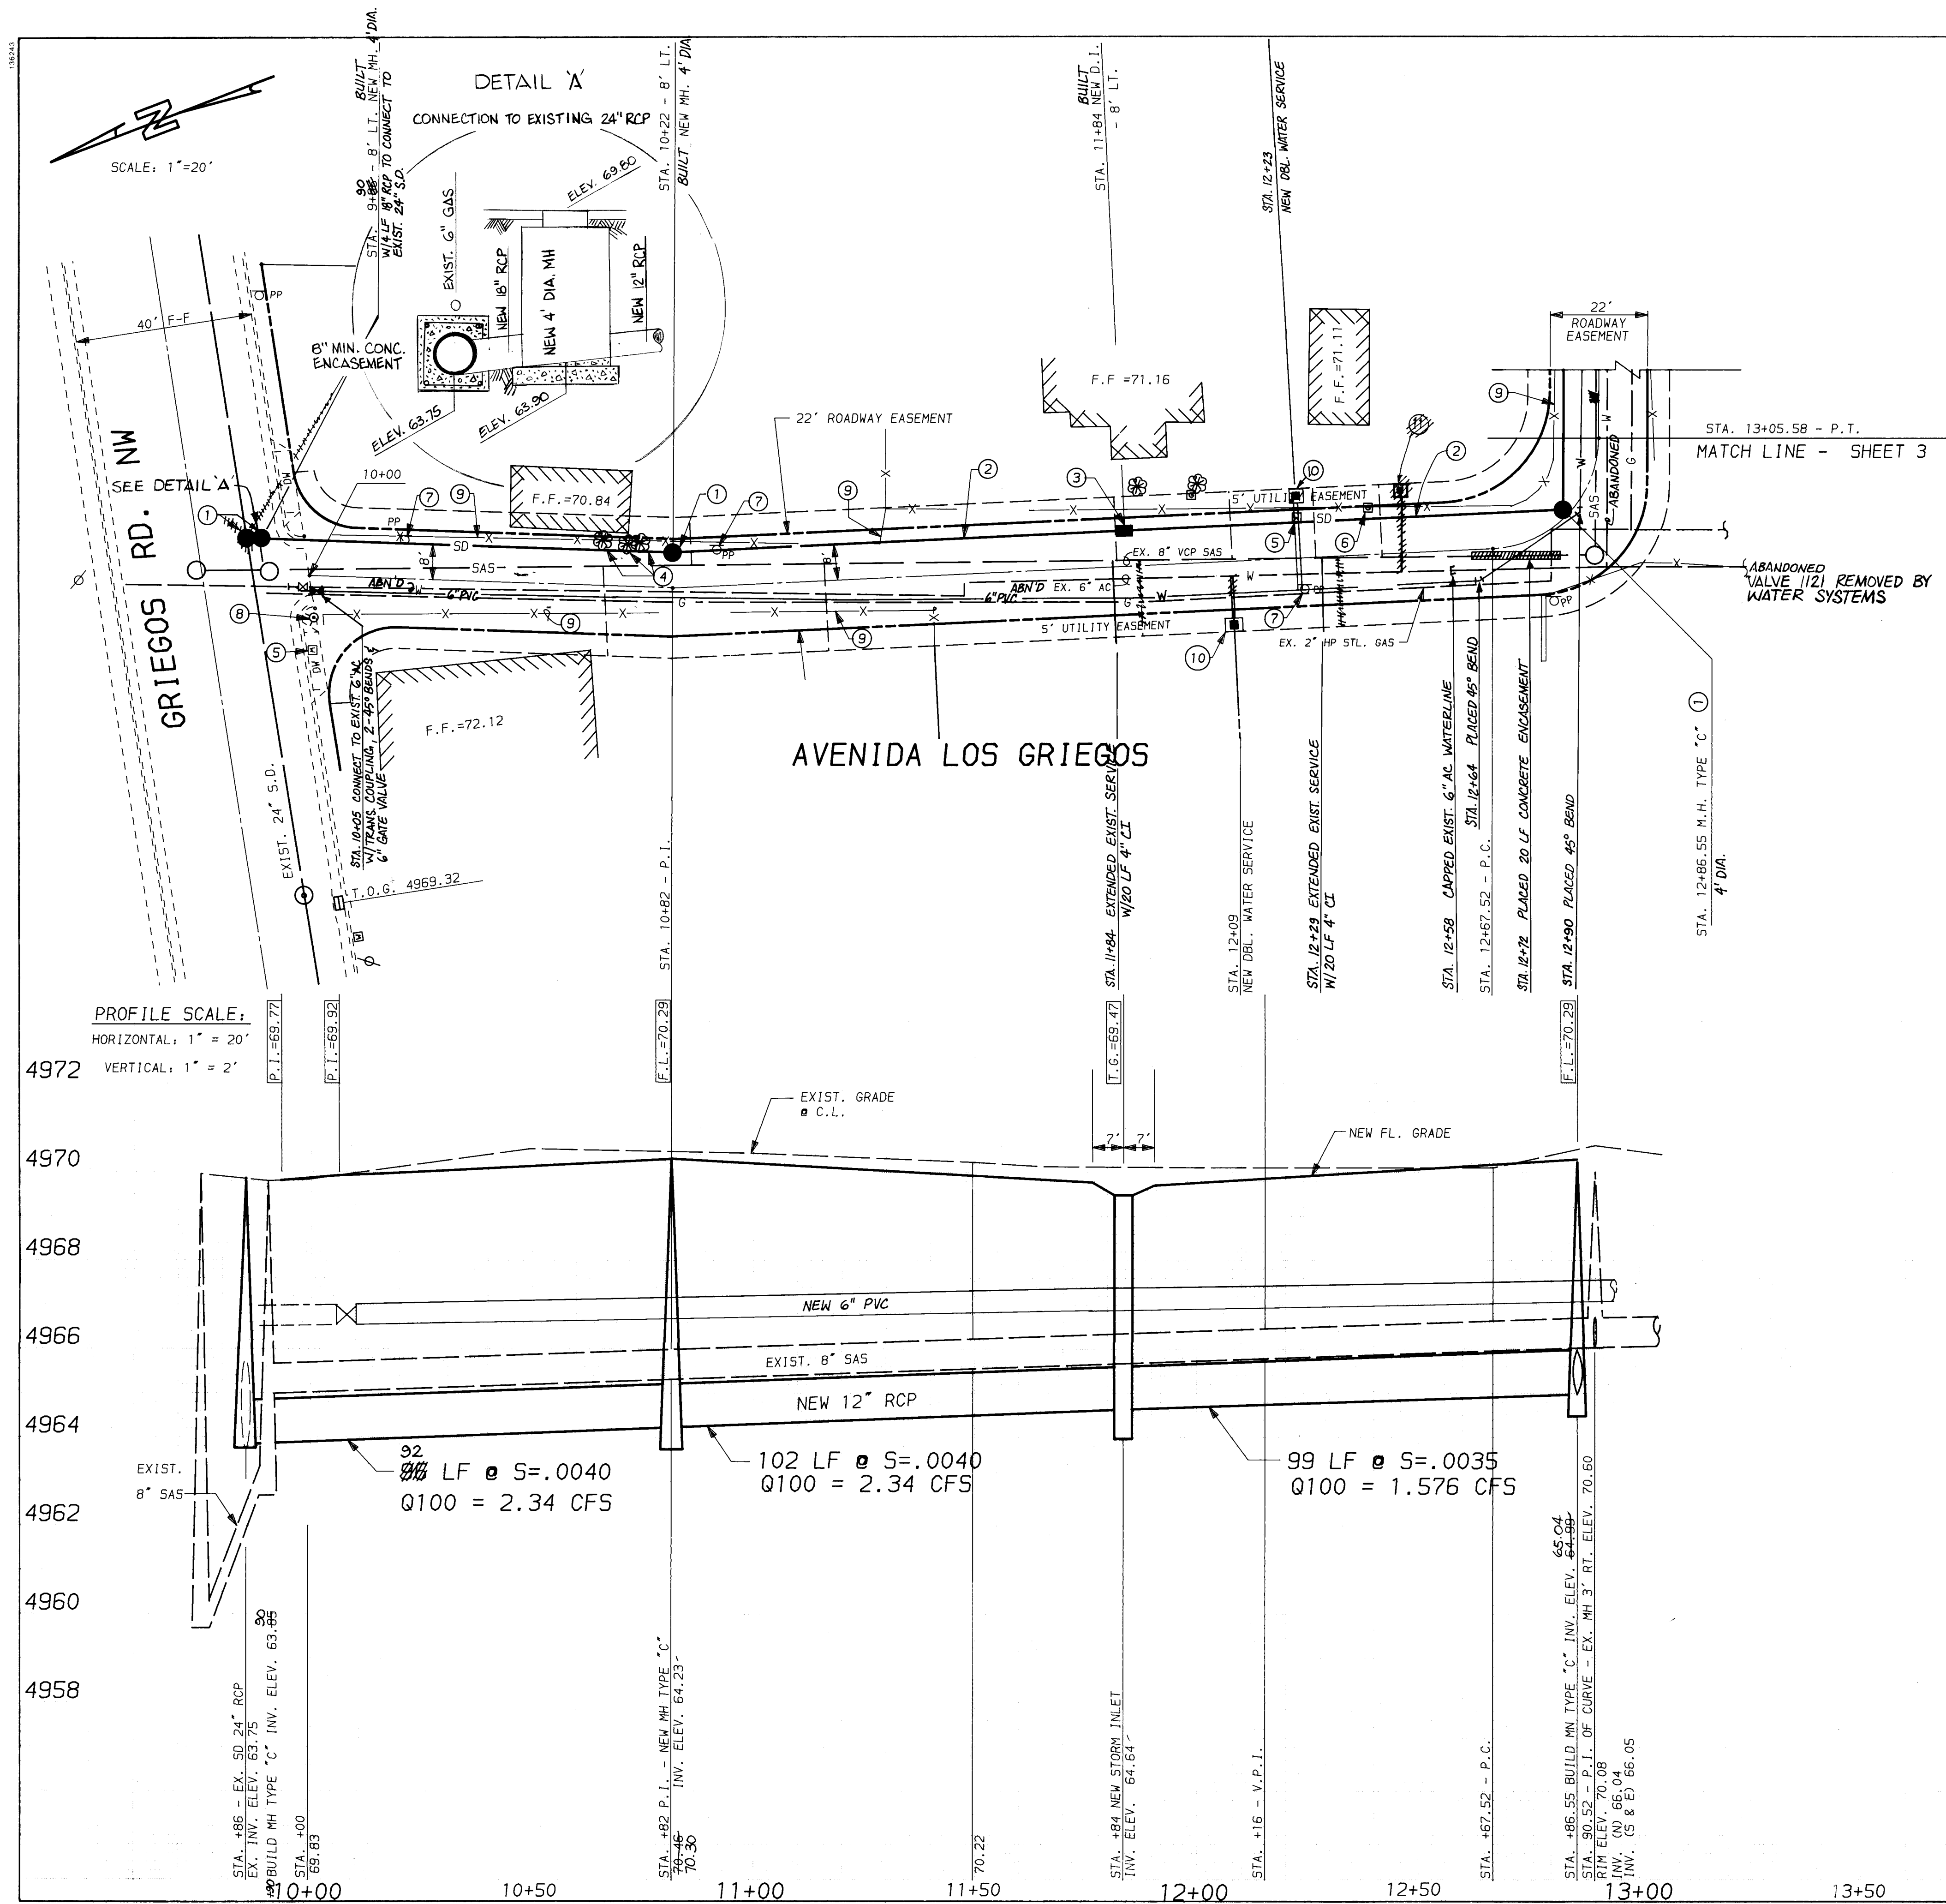

- NOTES:
1. SHUT OFF VALVES 1071 & 1121 PRIOR TO CONSTRUCTION TO ISOLATE WATER MAIN.
 2. CONTRACTOR RESPONSIBLE FOR CONTACTING WATER SYSTEMS DIVISION 823-4044, AT LEAST 3 DAYS PRIOR TO ANY WORK ON EXISTING PUBLIC WATER LINES.

- KEYED NOTES:
1. BUILD TYPE "C" M.H., 4' DIA, AS PER C.O.A. STD. DWG. 2101.
 2. BUILD NEW 12" RCP, CLASS IV, STORM DRAIN LINE, MAX TRENCH WIDTH = 12".
 3. BUILD TYPE "D" CATCH BASIN, SINGLE GRATE, AS PER DETAIL ON SHEET 7 AND C.O.A. STD. DWG. 2206.
 4. REMOVE AND DISPOSE OF TREES.
 5. RELOCATE WATER METER IN 5' UTILITY EASEMENT.
 6. GAS METER RELOCATED IN 5' UTILITY EASEMENT, BY OTHERS PRIOR TO CONSTRUCTION.
 7. POWER OR LIGHT POLE RELOCATED BY OTHERS PRIOR TO CONSTRUCTION.
 8. REMOVE AND DISPOSE F.H. REPLACE WITH F.H. ON SHEET 4.
 9. RELOCATE EXISTING FENCE AS SHOWN ON SHEET 5.
 10. INSTALL NEW 3/4" WATER SERVICE LINE, DOUBLE SERVICE CONNECTION, PER C.O.A. STD. 2362.
 11. INSTALL NEW 3/4" WATER SERVICE LINE, SINGLE SERVICE CONNECTION, PER C.O.A. STD. 2362.

LEGEND

98.51 EXISTING ELEVATION
[98.31] NEW ELEVATION

BUILDING

ABBREVIATIONS

C.L. CENTER LINE
F.L. FLOW LINE
T.C. TOP OF CURB
T.G. TOP OF GRATE

CITY OF ALBUQUERQUE
PUBLIC WORKS DEPARTMENT
ENGINEERING GROUP


TITLE: AVENIDA LOS GRIEGOS
WATER & STORM DRAIN: STA. 10+00 TO STA. 1305.58

APPROVALS	ENGINEER	DATE	APPROVALS	ENGINEER	DATE
D.R.C. Chair					
Trans. Dev					
Utility Dev					

Hydrology

DRAWING NO. 3965 MAP NO. F-13 SHEET 3 OF 7

AS BUILT INFORMATION		BENCH MARKS		SURVEY INFORMATION		ENGINEER'S SEAL		REVISIONS	
DATE	BY	DATE	BY	NO.	DATE			NO.	DATE
3-91	COA	2-90	M. GONZALES					1	4/90
6-91	ROR							2	6/90
6-91	COA							3	7/90
6-91	ROR							4	
6-91	COA							5	
6-91	ROR							6	
6-91	COA							7	
6-91	ROR							8	
6-91	COA							9	
6-91	ROR							10	
6-91	COA							11	
6-91	ROR							12	
6-91	COA							13	
6-91	ROR							14	
6-91	COA							15	
6-91	ROR							16	
6-91	COA							17	
6-91	ROR							18	
6-91	COA							19	
6-91	ROR							20	

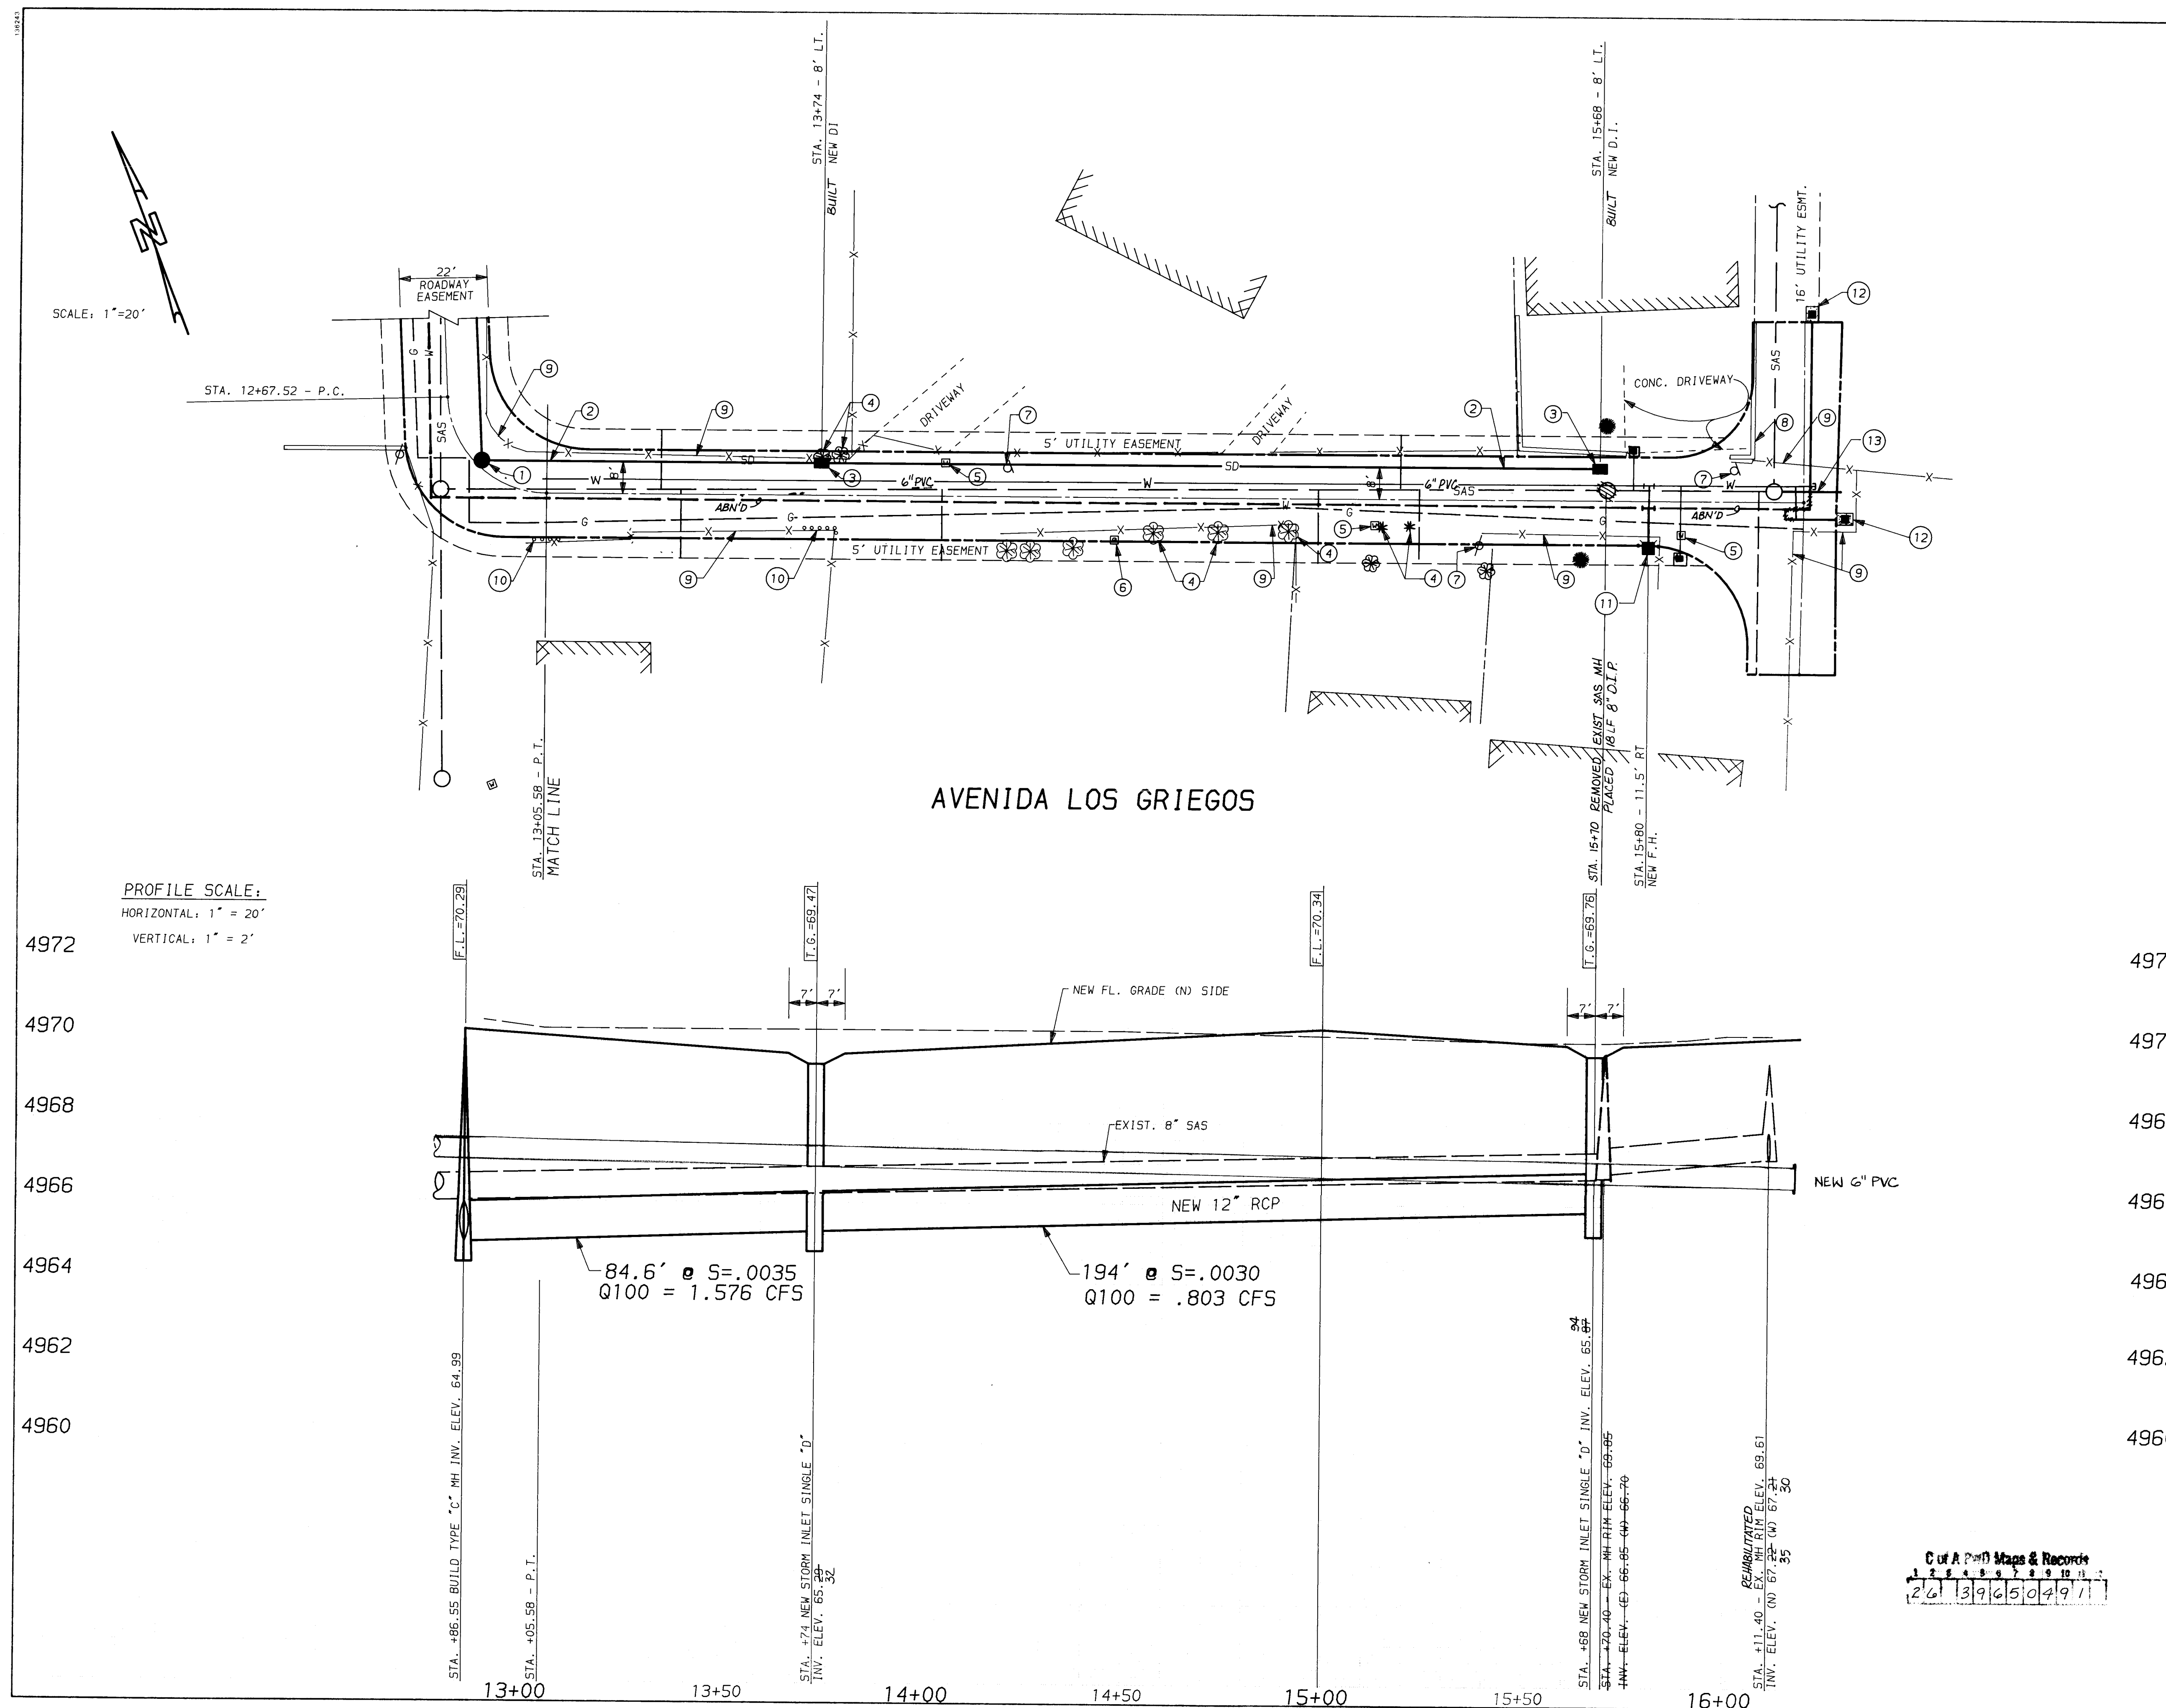

- ## KEYED NOTES
- ① BUILD TYPE "C" M.H., 4' DIA, A5 PER C.O.A. STD. DETAIL DRWG. 2101.
 - ② BUILD NEW 12" RCP, CLASS IV, STORM DRAIN LINE, MAX TRENCH WIDTH = 12".
 - ③ BUILD TYPE "D" CATCH BASIN, SINGLE GRATE, A5 PER DETAIL ON SHEET 7 AND C.O.A. STD DWG 2206.
 - ④ REMOVE AND DISPOSE OF TREES.
 - ⑤ RELOCATE WATER METER IN 5' UTILITY EASEMENT.
 - ⑥ RELOCATE GAS METER IN 5' UTILITY EASEMENT.
 - ⑦ POWER OR LIGHT POLE RELOCATED BY OTHERS PRIOR TO CONSTRUCTION.
 - ⑧ RELOCATE CONCRETE BLOCK WALL. SEE SHEET 6 FOR NEW LOCATION.
 - ⑨ RELOCATE EXISTING FENCE TO NEW LOCATION SHOWN ON SHEET 6.
 - ⑩ RELOCATE EXISTING BOLLARDS TO NEW LOCATIONS ON SHEET 6.
 - ⑪ STA. 15+80 - INSTALL NEW FIRE HYDRANT PER C.O.A. STD. DWG. 2340. RESTRAIN ALL JOINTS.
 - 1 - FH 4"x12" BURY FLANGE ELEV. = 4970.59
 - 1 - 6"x6"x6" TEE
 - 1 - TEE INSERTION
 - 1 - NON PRESS CONN.
 - 10 LF 6" PVC PIPE
 - 3"x3" FH CONC. PAD
 - 2 - STATIONARY BOLLARDS PER COA STD. DWG. 2250.
 - ⑫ INSTALL NEW 3/4" WATER SERVICE LINE, SINGLE SERVICE CONNECTION, PER C.O.A. STD. DRWG. 2362.
 - ⑬ INSTALL NEW SANITARY SEWER SERV. STUB PER C.O.A. STD. DRWG. 2118 AND 2125.

LEGEND

98.51 EXISTING ELEVATION

98.31 NEW ELEVATION

 BUILDING

ABBREVIATIONS


C.L.	CENTER LINE
F.L.	FLOW LINE
T.C.	TOP OF CURB
T.G.	TOP OF GRATE

CITY OF ALBUQUERQUE
PUBLIC WORKS DEPARTMENT
ENGINEERING GROUP

TITLE	AVENIDA LOS GRIEGOS
WATER & STORM DRAIN:	STA. 12+67.52 TO STA. 16+18.82

APPROVALS	ENGINEER	DATE	APPROVALS	ENGINEER	DATE
D.R.C. Chair					
Trans. Div.					
Utility Div.					
Hydrology					

DRAWING NO.	3965	MAP NO.	F-13	SHEET	4	OF	7
-------------	------	---------	------	-------	---	----	---

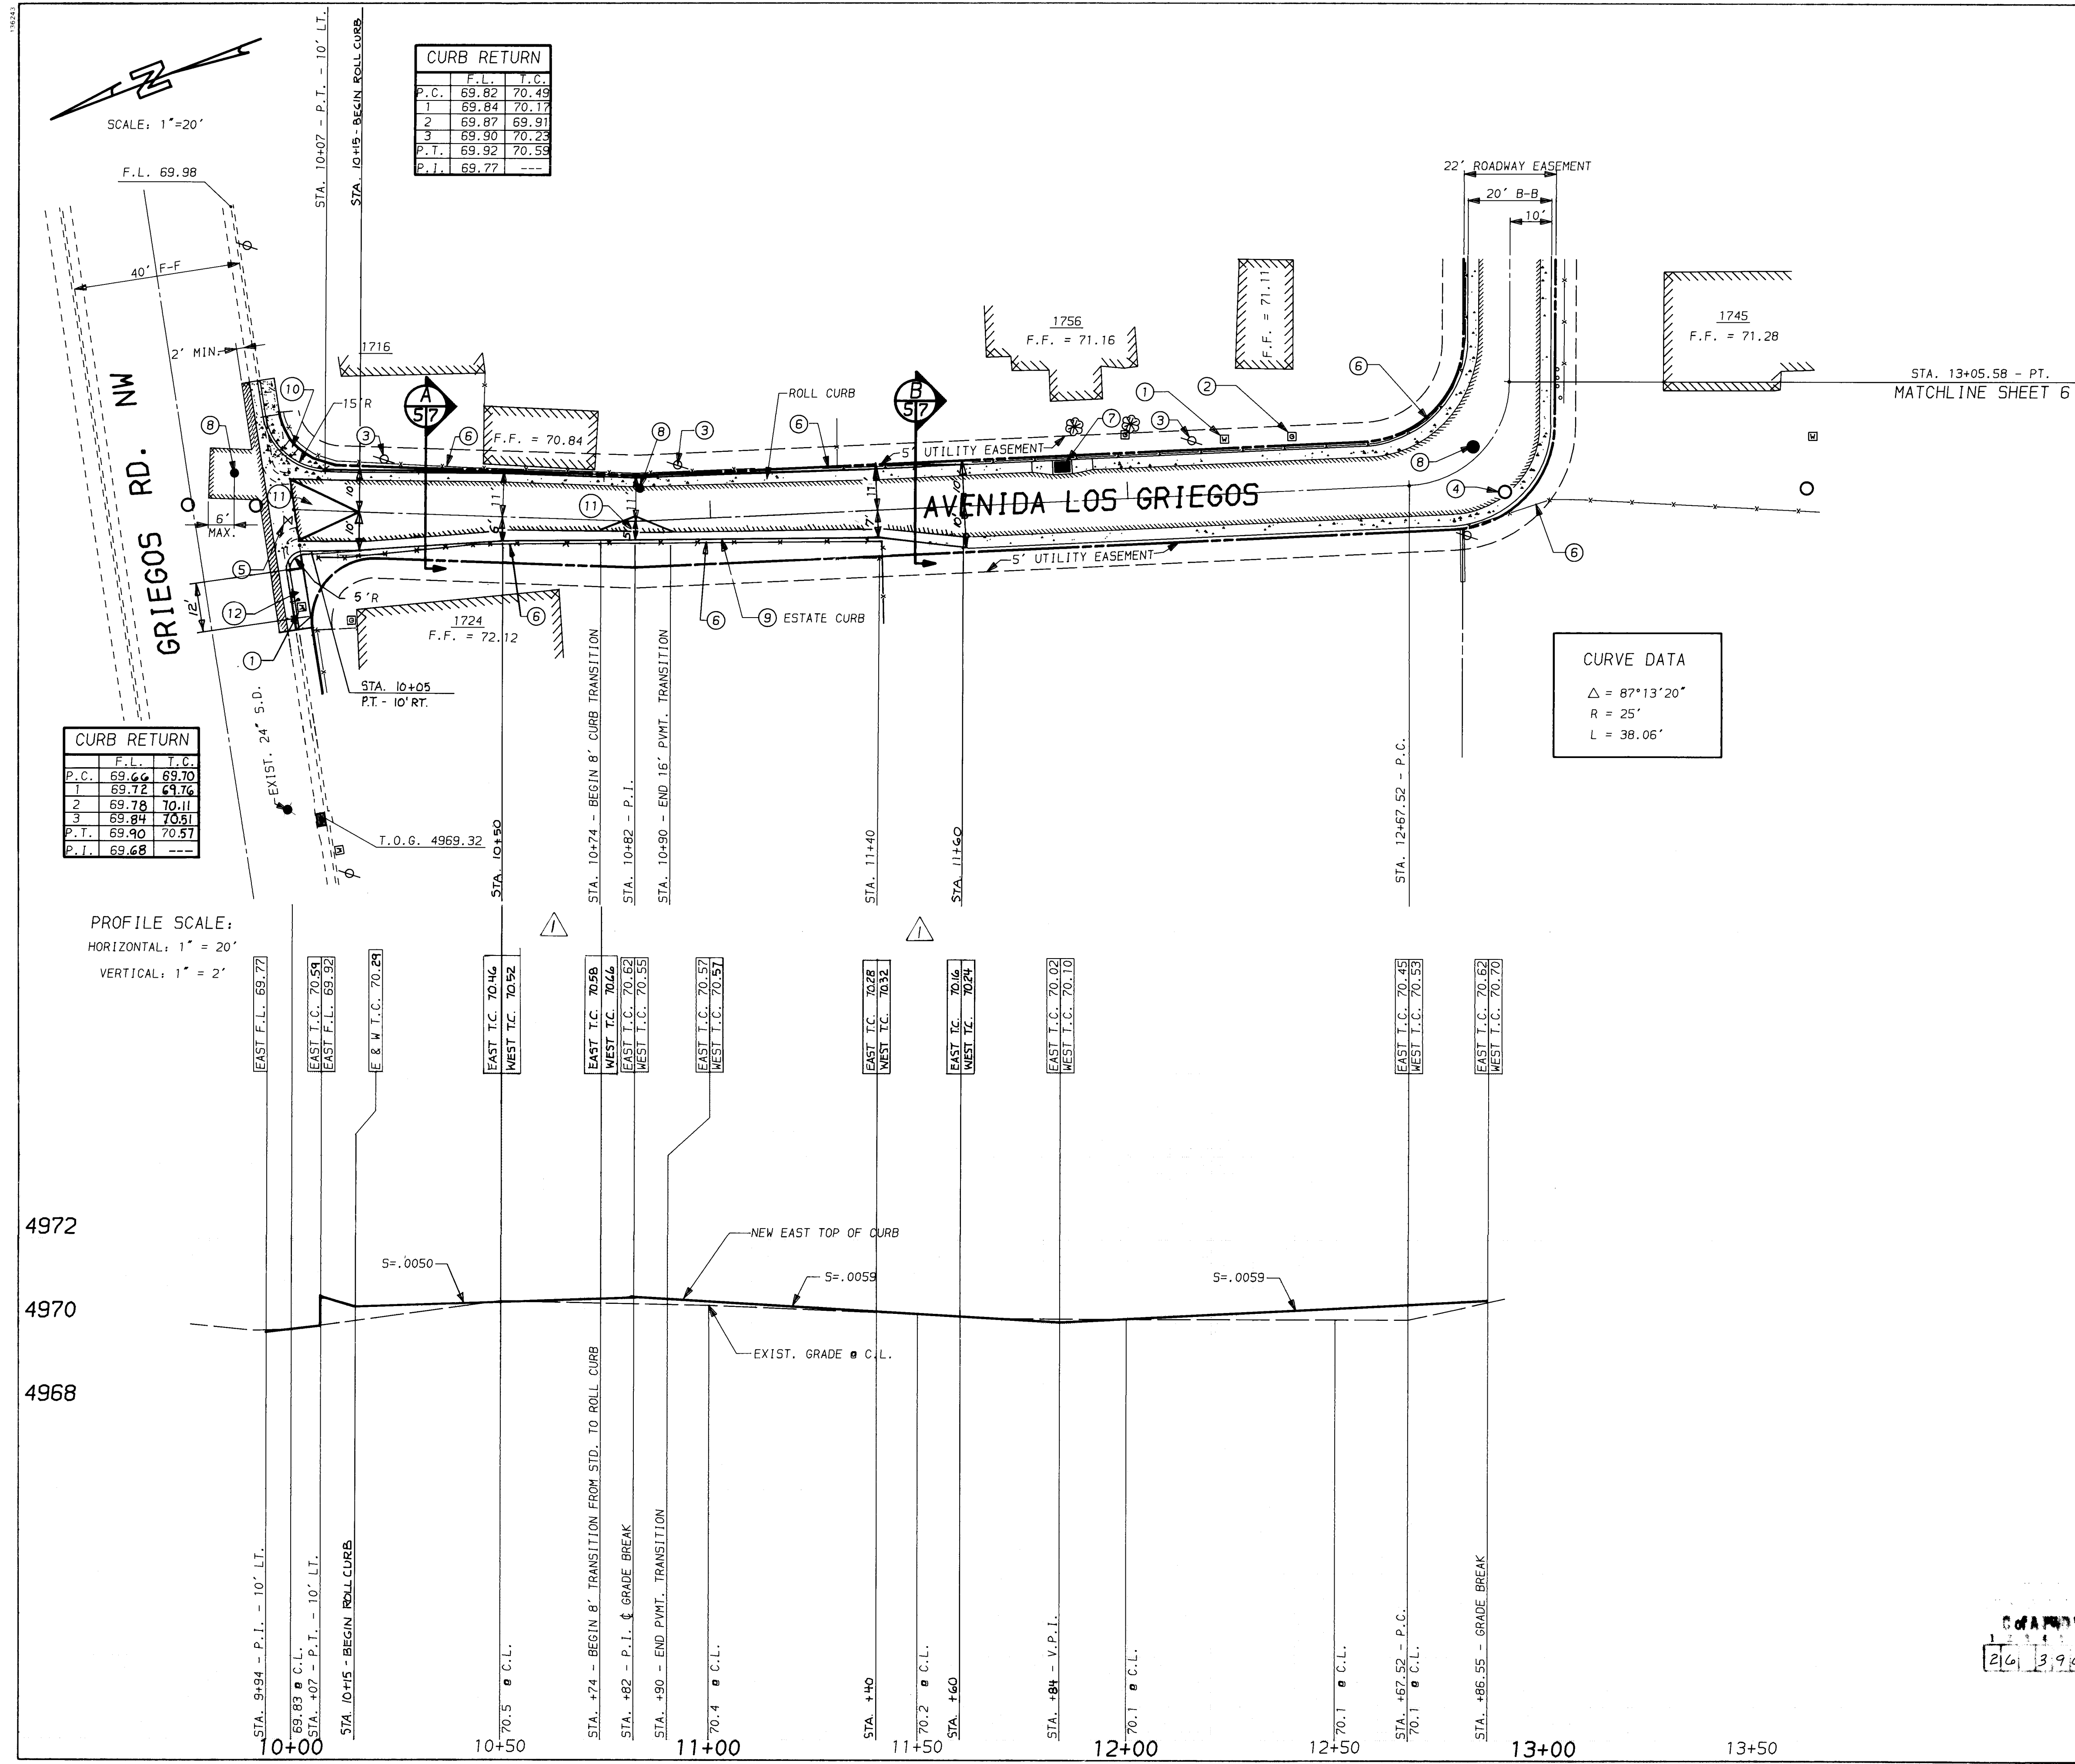

CURB RETURN		
	F.L.	T.C.
P.C.	69.82	70.49
1	69.84	70.17
2	69.87	69.91
3	69.90	70.23
P.T.	69.92	70.59
P.T.	69.77	---

CURB RETURN		
	F.L.	T.C.
P.C.	69.66	69.70
1	69.72	69.76
2	69.78	70.11
3	69.84	70.51
P.T.	69.90	70.57
P.T.	69.68	---

CURVE DATA		
$\Delta = 87^{\circ}13'20''$		
$R = 25'$		
$L = 38.06'$		


- KEYED NOTES**
- NEW LOCATION OF WATER METER IN 5' UTILITY EASEMENT.
 - NEW LOCATION OF GAS METER IN 5' UTILITY EASEMENT.
 - NEW LOCATION OF POWER OR LIGHT POLE.
 - ADJUST EXISTING MANHOLE FRAME AND COVER TO NEW GRADE PER C.O.A. STD. DWG. 2460.
 - ADJUST WATER VALVE BOX PER C.O.A. STD. DWG. 2460.
 - NEW LOCATION OF FENCE.
 - NEW D.I. SEE SHEET 3.
 - NEW MANHOLE SEE SHEET 3.
 - NEW ESTATE CURB, SEE DETAIL SHEET 7.
 - REMOVE AND DISPOSE OF EXISTING P.C.C. DRIVEPAD, SIDEWALK AND CURB & GUTTER. CONSTRUCT NEW HANDICAPPED RAMP WITH INTERGRAL CURB PER C.O.A. STD. DWG. NO. 2441, CASE 1.
 - TRANSITION PAVEMENT FROM CROWN SECTION TO CROSS SLOPE SECTION.
 - REMOVE AND DISPOSE OF EXISTING P.C.C. DRIVEPAD, SIDEWALK AND CURB & GUTTER. CONSTRUCT NEW P.C.C. DRIVEPAD PER C.O.A. STD. DWG. NO. 2425.

LEGEND

98.51	EXISTING ELEVATION
98.31	NEW ELEVATION
[Hatched Box]	EXISTING BUILDING

CITY OF ALBUQUERQUE PUBLIC WORKS DEPARTMENT ENGINEERING GROUP				
TITLE AVENIDA LOS GRIEGOS PAVING: STA. 10+00 TO STA. 13+05.58				
APPROVALS	ENGINEER	DATE	APPROVALS	ENGINEER
D.R.C. Chair				
Trans. Dev				
Utility Dev				
Hydrology				
DRAWING NO.	3965	MAP NO.	F-13	SHEET 5 OF 7

AS BUILT INFORMATION		BENCH MARKS		SURVEY INFORMATION		ENGINEER'S SEAL		REVISIONS	
DATE	DATE	DATE	DATE	NO.	BY	NO.	BY	NO.	DATE
12-18-80	12-18-80	12-18-80	12-18-80	1	M. GONZALES	1	BY	1	4-90
12-18-80	12-18-80	12-18-80	12-18-80	2	M. GONZALES	2	BY	2	6-90
12-18-80	12-18-80	12-18-80	12-18-80	3	M. GONZALES	3	BY	3	9-90

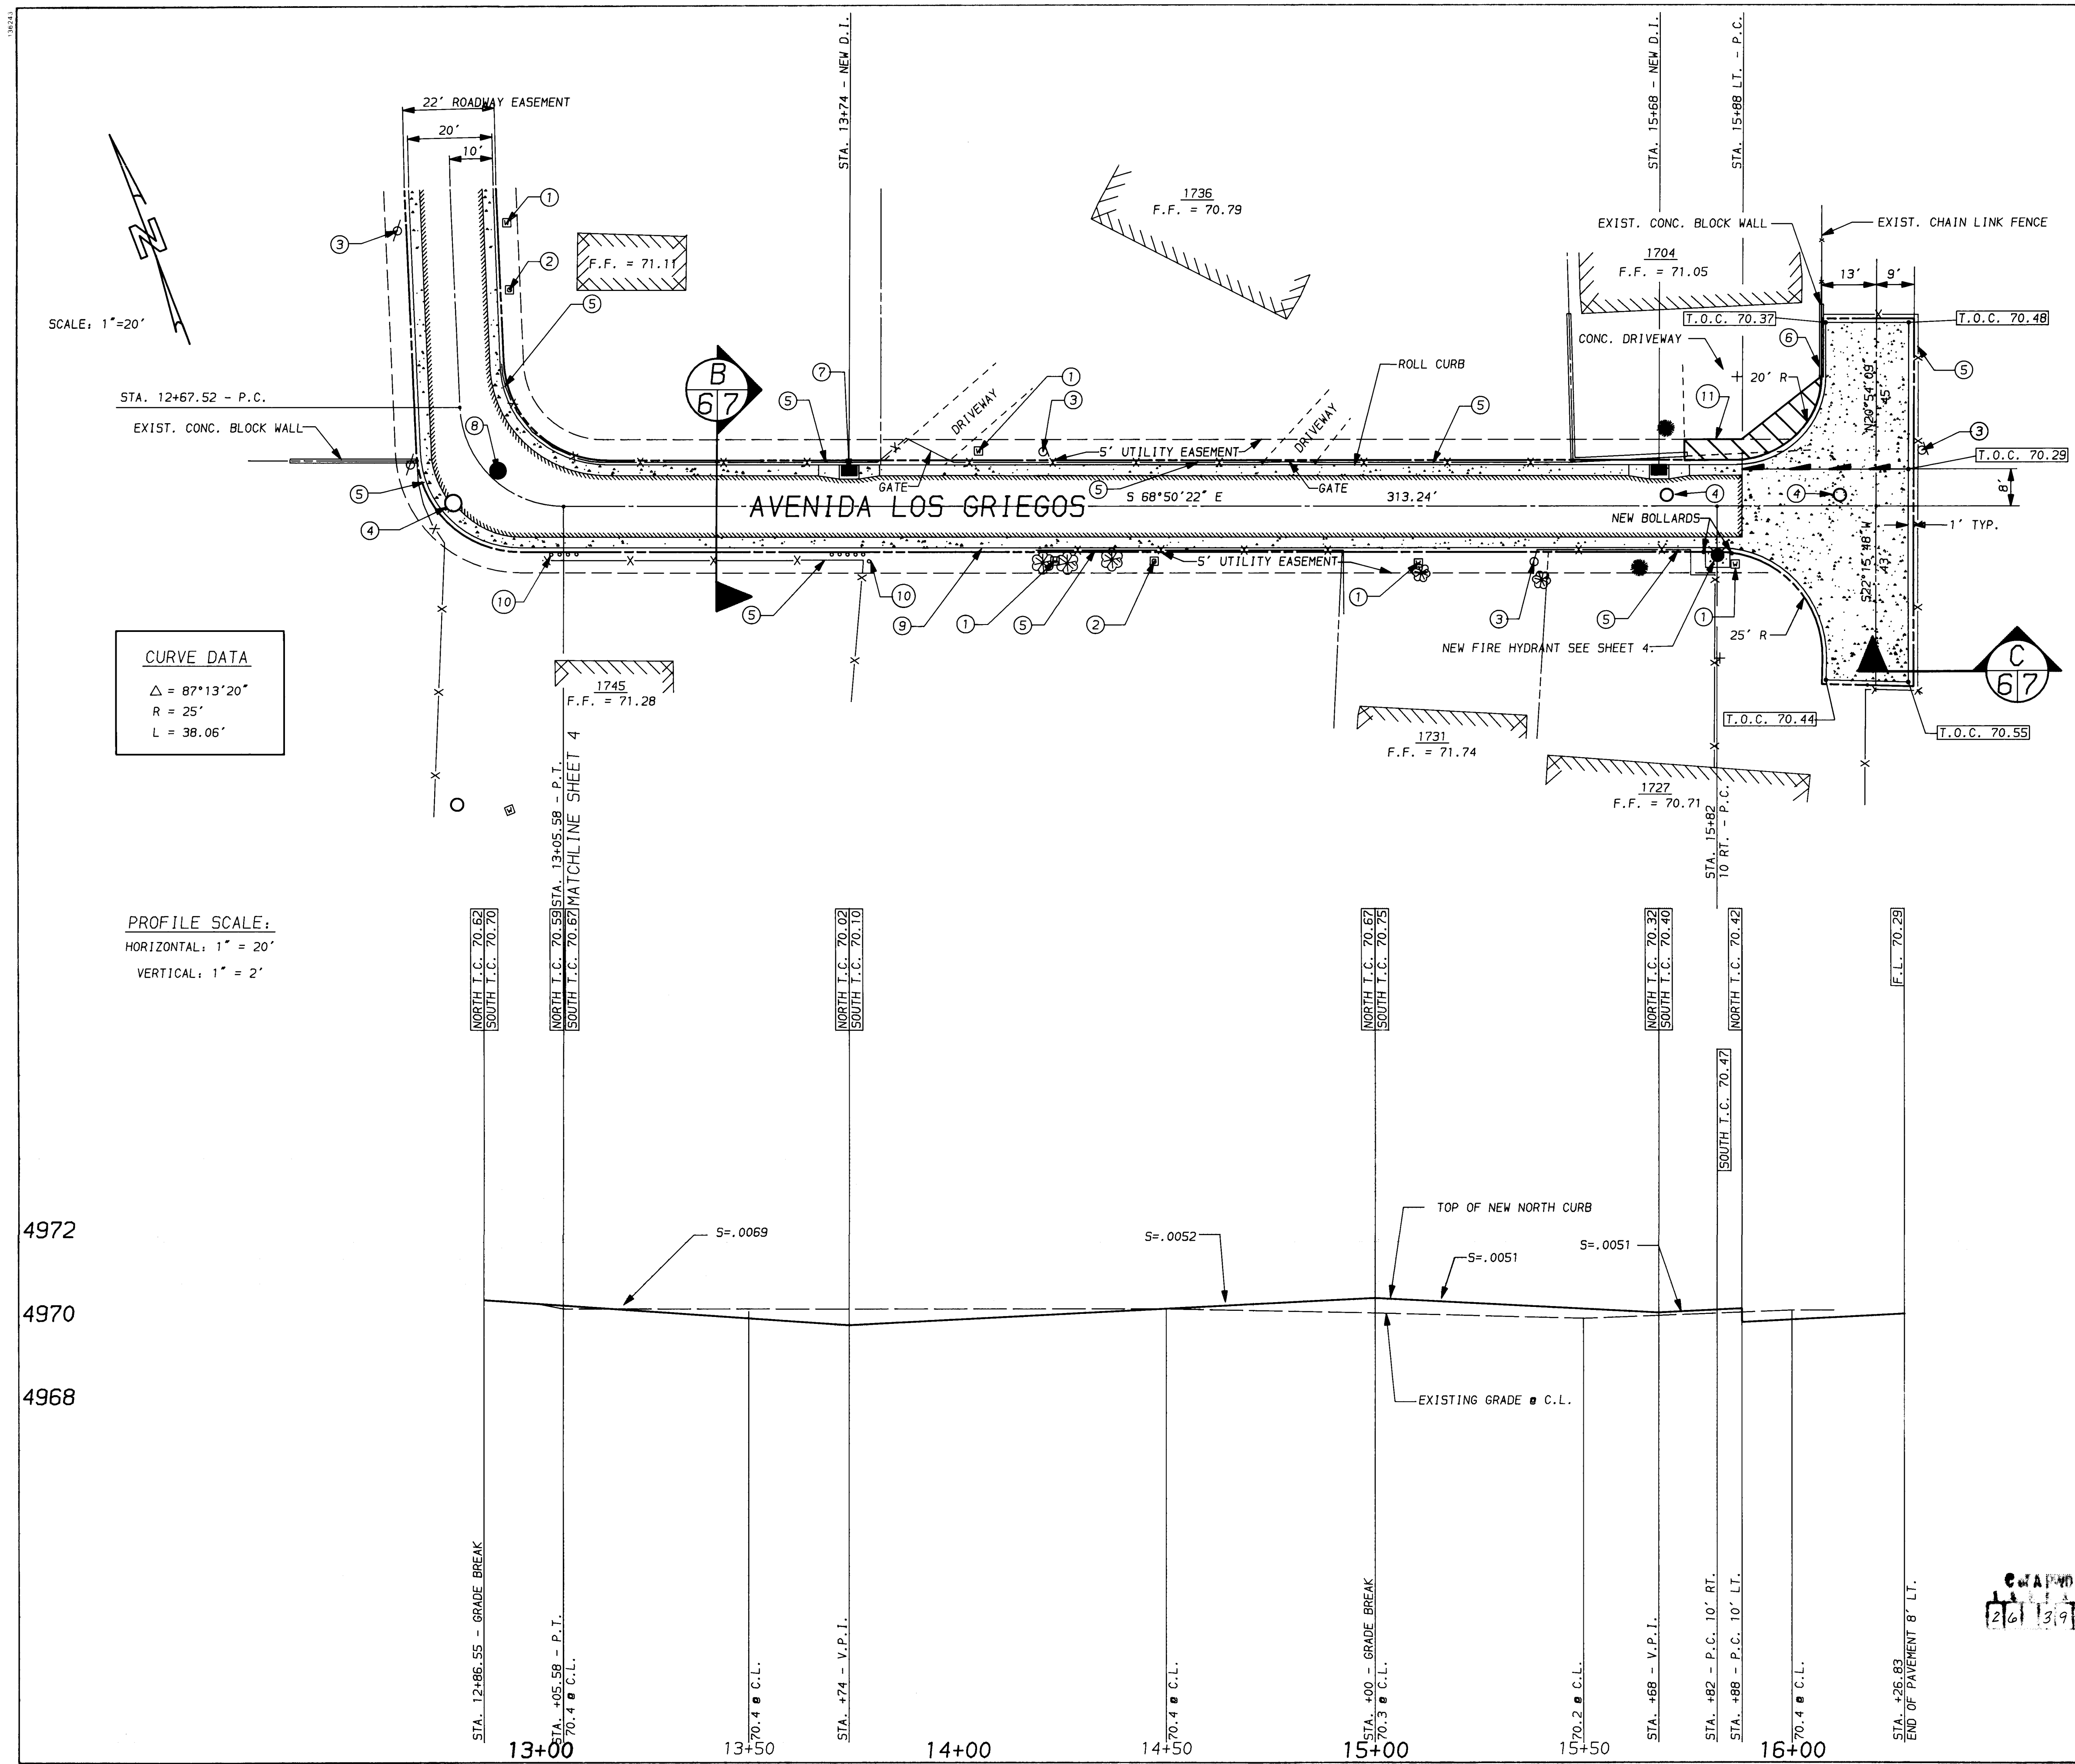


KEYED NOTES

- 1 NEW LOCATION OF WATER METER IN 5' UTILITY EASEMENT.
- 2 NEW LOCATION OF GAS METER IN 5' UTILITY EASEMENT.
- 3 NEW LOCATION OF POWER OR LIGHT POLE.
- 4 ADJUST EXISTING MANHOLE FRAME AND COVER TO NEW GRADE PER C.O.A. STD. 2460.
- 5 NEW LOCATION OF FENCE.
- 6 NEW LOCATION OF CONCRETE BLOCK WALL.
- 7 NEW D.I. SEE SHEET 4.
- 8 NEW MANHOLE SEE SHEET 4.
- 9 NEW CURB SEE DETAIL SHEET 7.
- 10 NEW LOCATION OF EXISTING BOLLARDS.
- 11 REMOVE AND REPLACE EXISTING CONCRETE DRIVEWAY. INSTALL 1/2" EXPANSION JOINT BETWEEN CURB AND DRIVEWAY.

NOTE TO CONTRACTOR

CONTRACTOR SHALL MINIMIZE DAMAGE TO EXISTING TREES AND OTHER IMPROVEMENTS WITHIN THE 5' UTILITY EASEMENT.

LEGEND

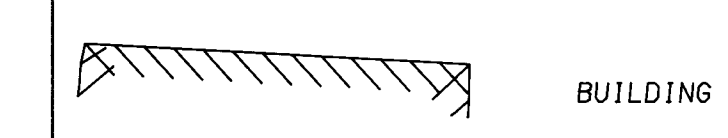



















BUILDING

ABBREVIATIONS

- C.L. CENTER LINE
- F.L. FLOW LINE
- T.C. TOP OF CURB
- T.G. TOP OF GRATE

AS BUILT INFORMATION		BENCH MARKS		SURVEY INFORMATION		ENGINEER'S SEAL		REVISIONS	
DATE	BY	DATE	BY	NO.	BY			NO.	DATE
12/31/91	COA	ON GRIEGOS RD. & APPROX. 1/4 OF AVENIDA DE LOS GRIEGOS A SQUARE CUT ON TOP OF THE NORTH CURB.	DATE 2/15/90		BY M. GONZALES			1	3-1-90
12/31/91	COA							2	3-1-90
12/31/91	COA							3	3-1-90
12/31/91	COA							4	3-1-90
12/31/91	COA							5	3-1-90
12/31/91	COA							6	3-1-90
12/31/91	COA							7	3-1-90
12/31/91	COA							8	3-1-90
12/31/91	COA							9	3-1-90
12/31/91	COA							10	3-1-90
12/31/91	COA							11	3-1-90

CITY OF ALBUQUERQUE PUBLIC WORKS DEPARTMENT ENGINEERING GROUP			
TITLE AVENIDA LOS GRIEGOS PAVING STA. 12+67.52 TO STA. 16+18.82			
APPROVALS	ENGINEER	DATE	APPROVALS
D.R.C. Chair			ENGINEER
Trans. Dev			
Utility Dev			
DRAWING NO.	3965	MAP NO.	F-13
SHEET	6	OF	7

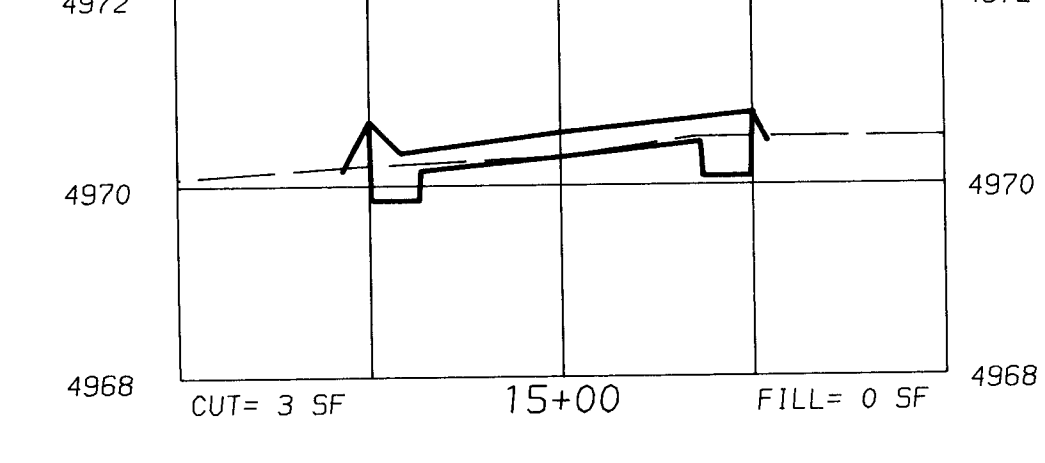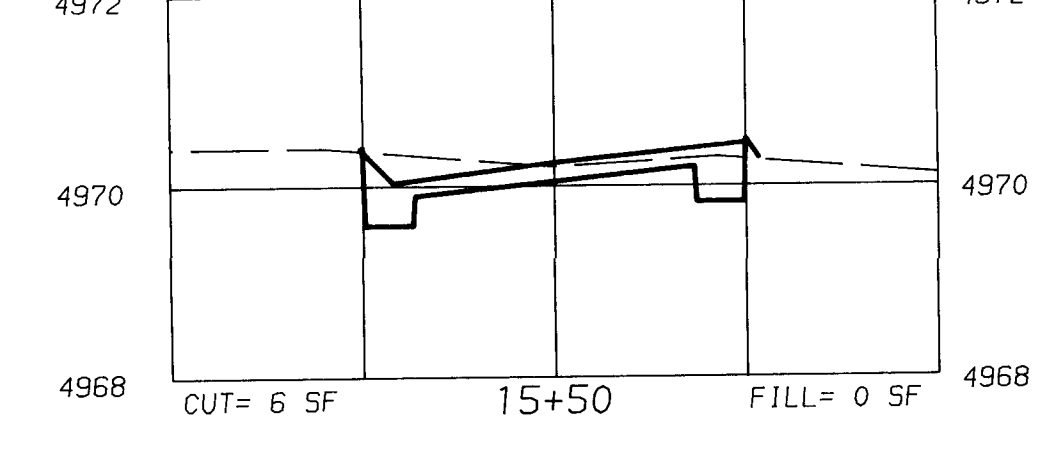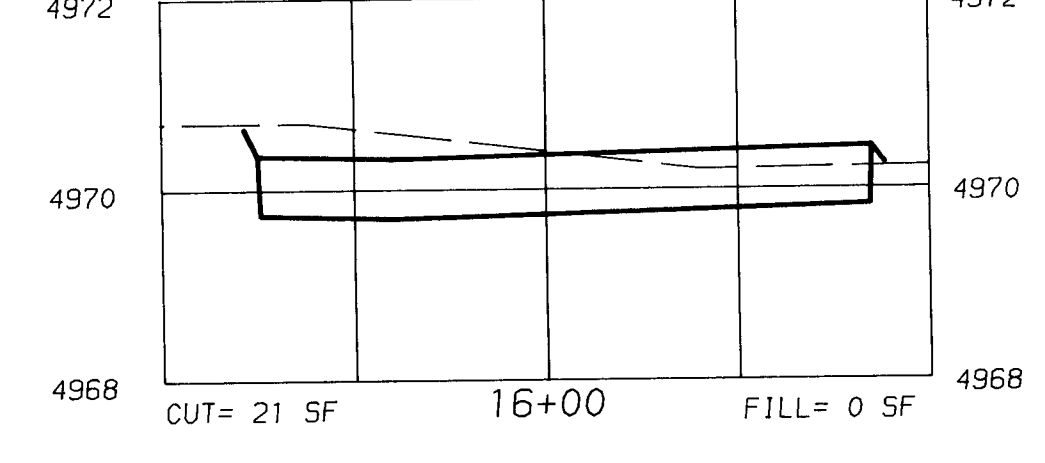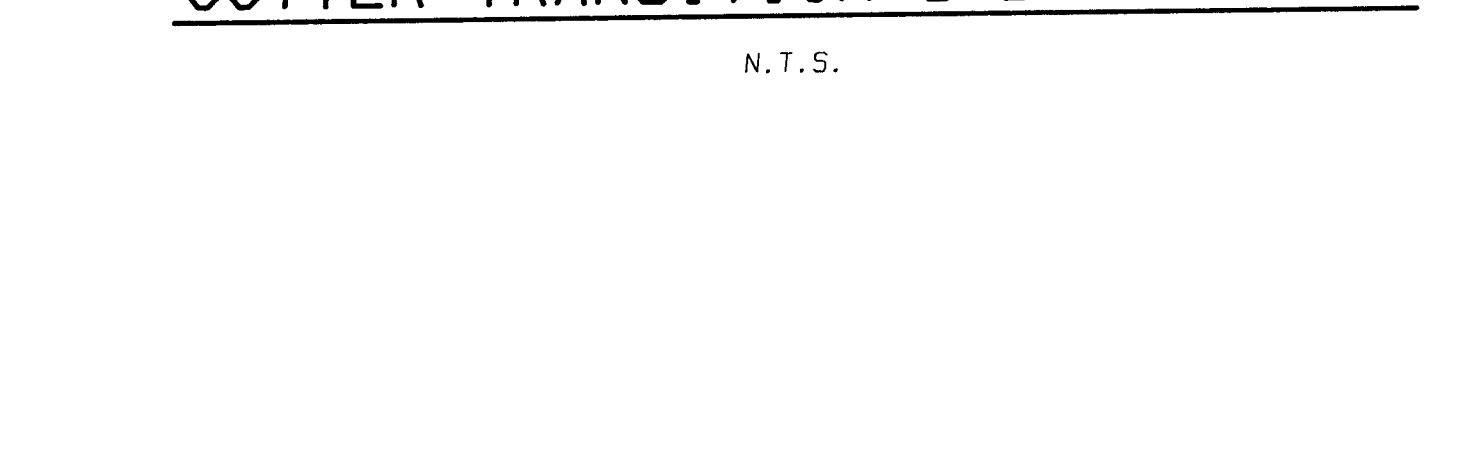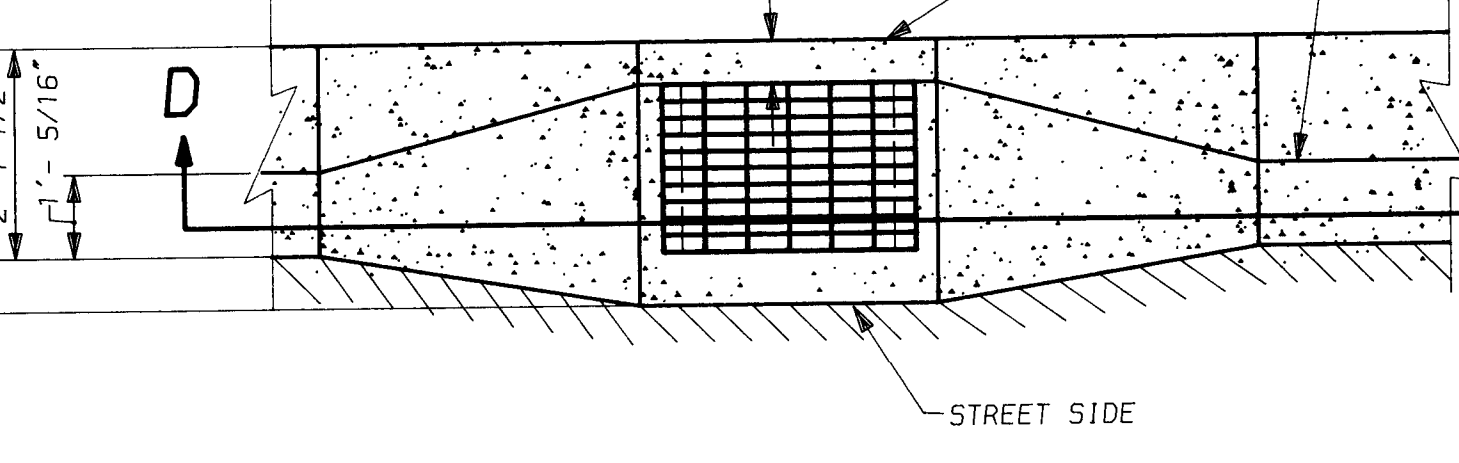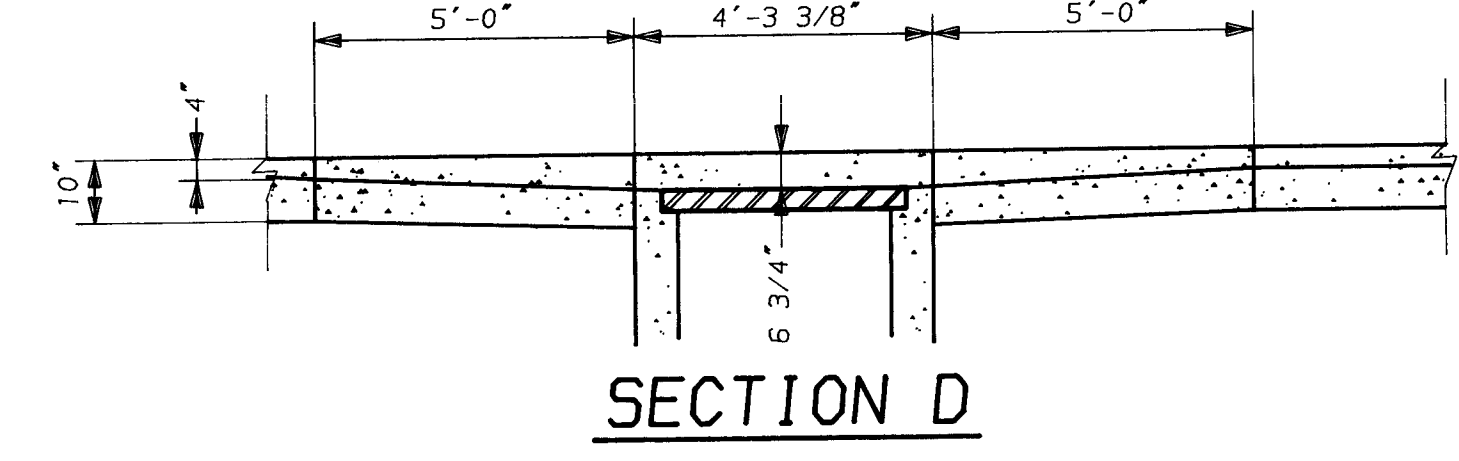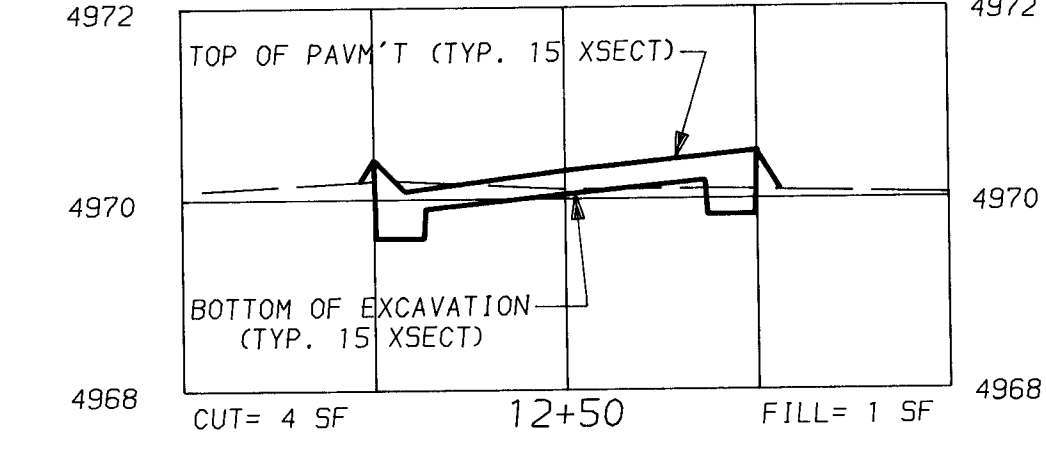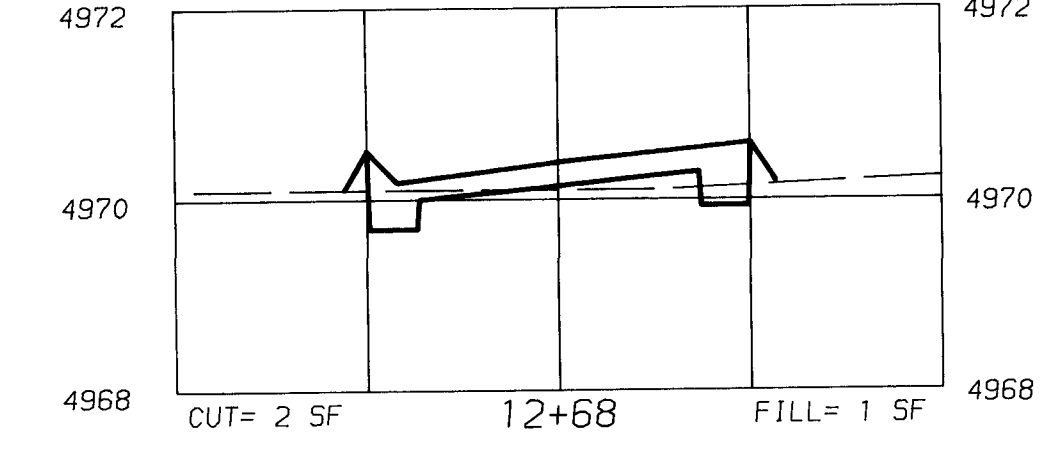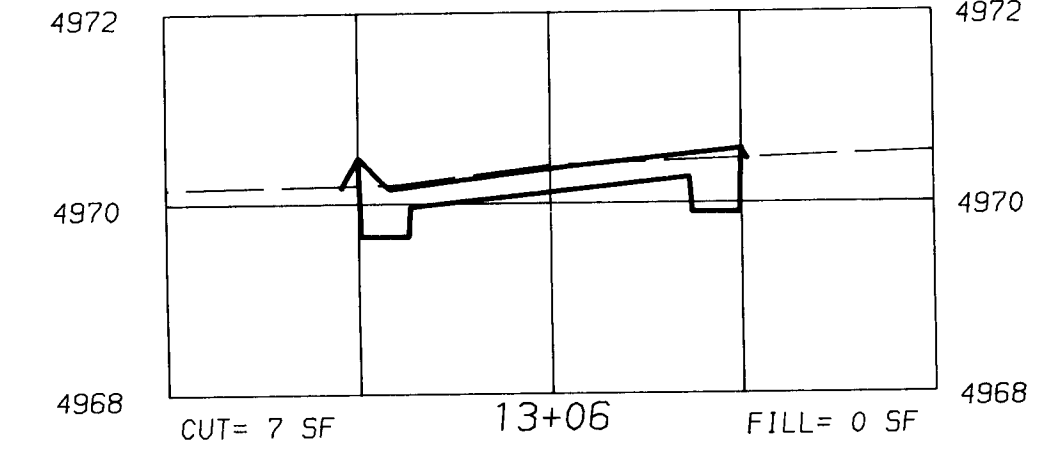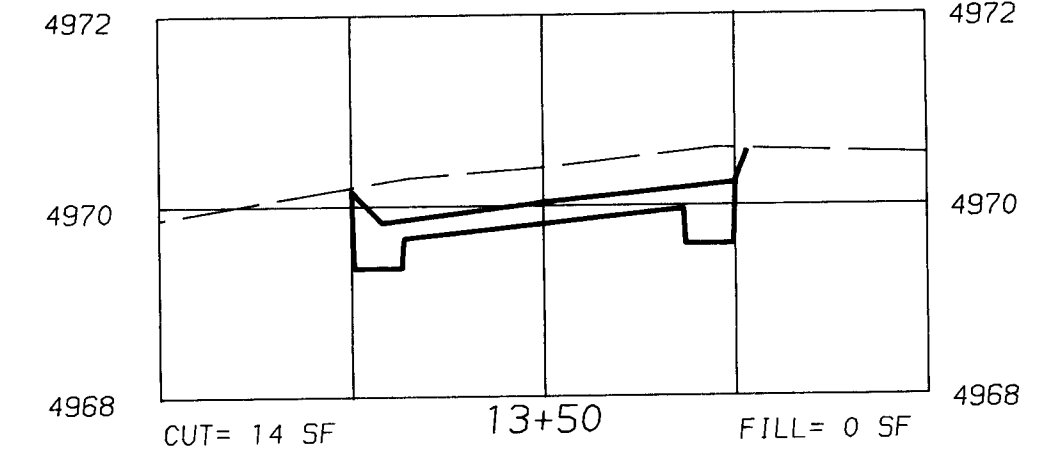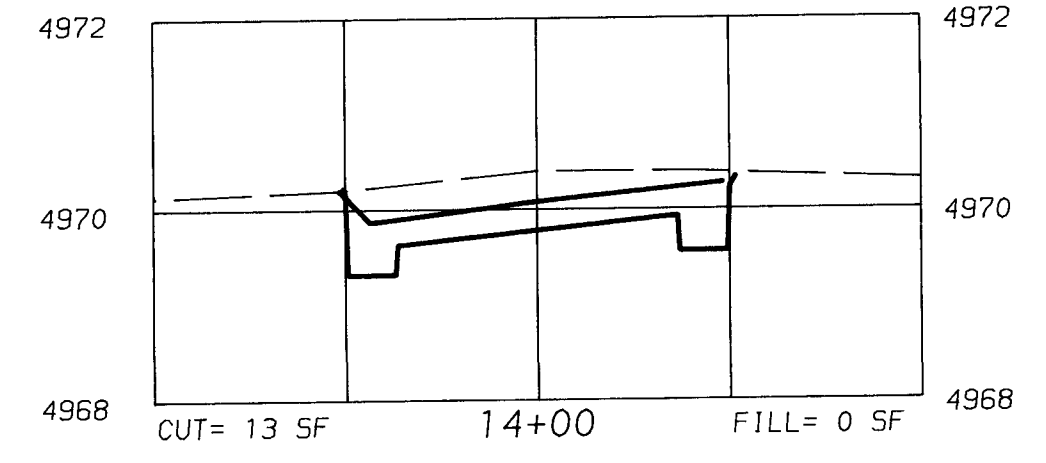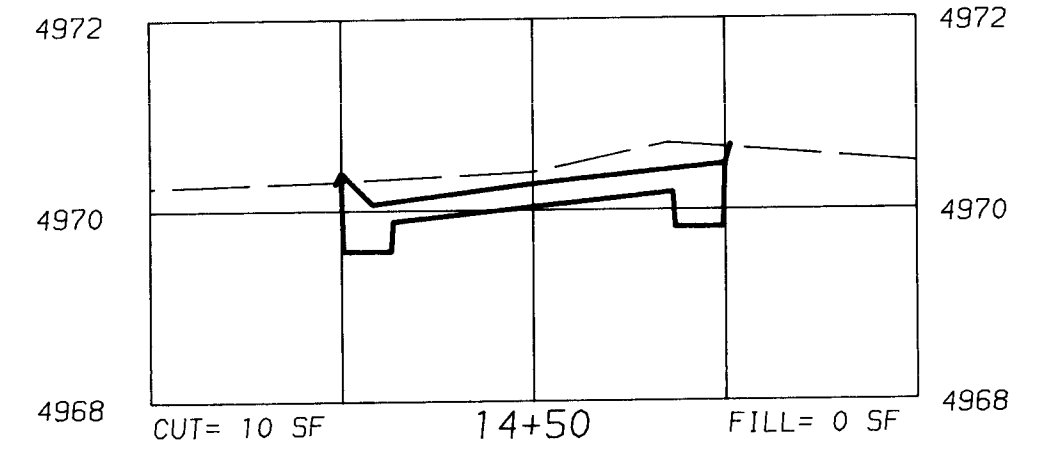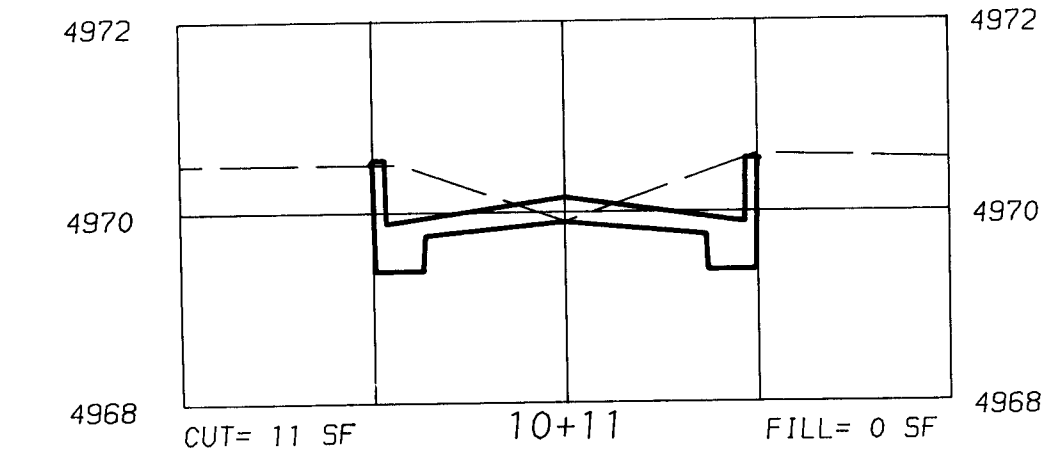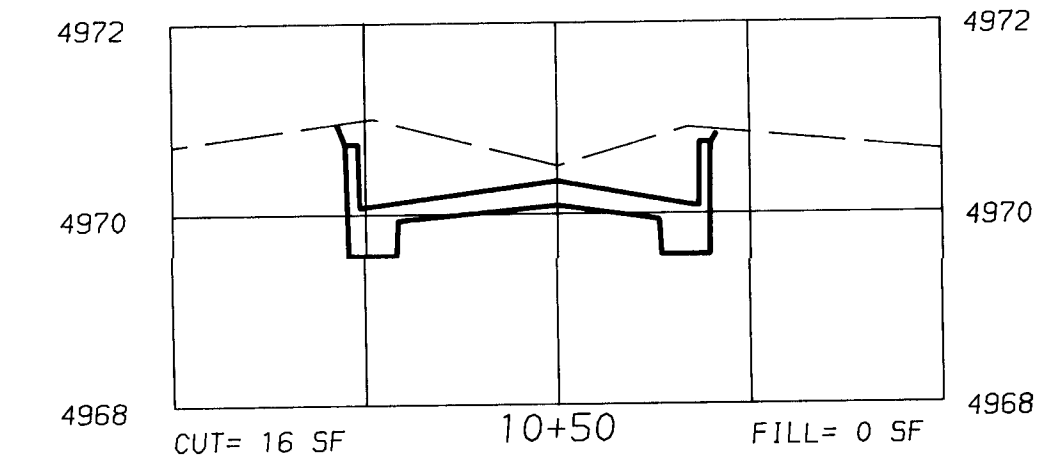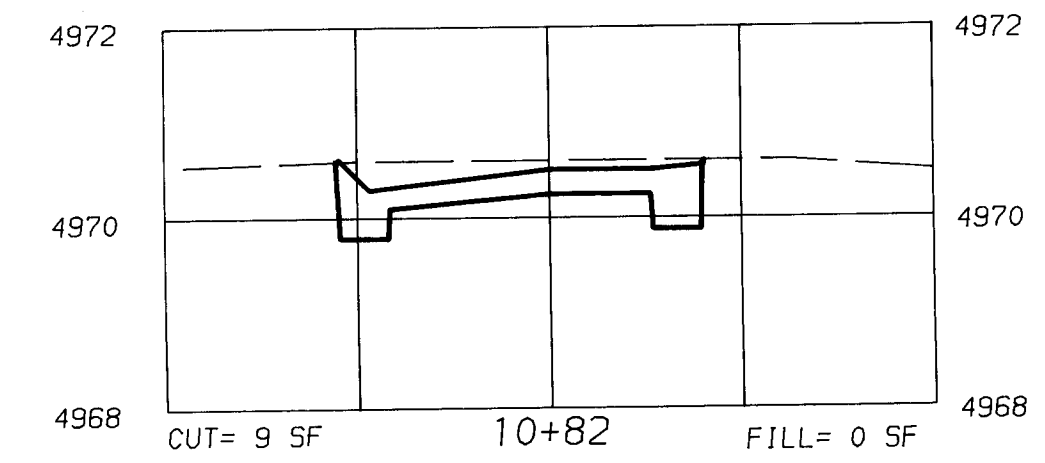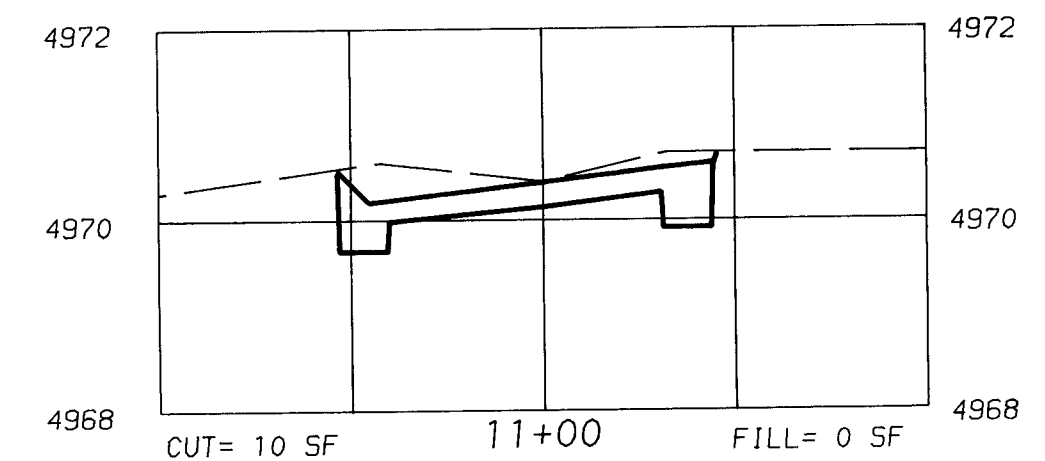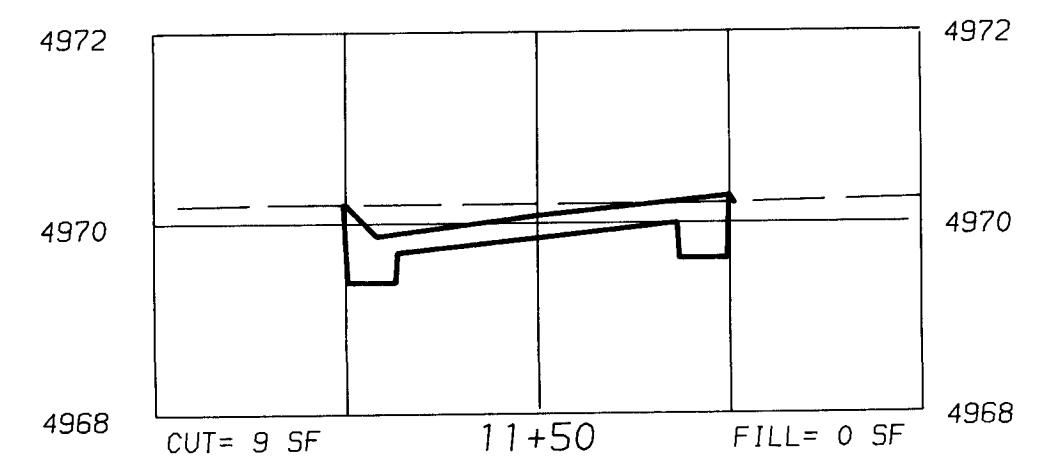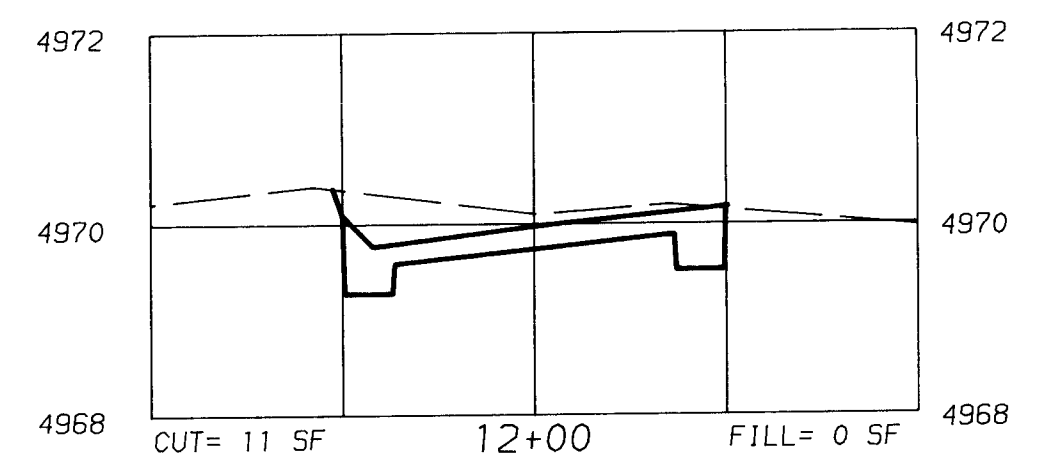

GUTTER TRANSITION & DROP INLET

SECTION D

RESIDENTIAL PAVEMENT SECTION

MODIFIED ESTATE CURB

SECTION C 67

SECTION B 57 B 67

SECTION A 57

KEYED NOTES

- A.C. PAVEMENT.
- 4" COMPACTED SUBBASE 95% COMPACTION.
- 6" COMPACTED SUBGRADE 95% COMPACTION.
- MOUNTABLE ROLL TYPE CURB.
- COMPACTED SUBGRADE 90% COMPACTION.
- 1-1/2" ASPHALT CONCRETE SURFACE COURSE, 1500 LBS. STABILITY.
- TACK COAT.
- 1-1/2" ASPHALT CONCRETE BASE COURSE, 1500 LBS. STABILITY.
- VALLEY GUTTER WITH 6"x6" NO. 6 GA. WIRE MESH.
- MODIFIED ESTATE CURB.

ABBREVIATION

B.C. = BACK OF CURB.

AS BUILT INFORMATION

CONTRACTOR	DATE	BY	DATE	BY
CONTRACTOR	DATE	BY	DATE	BY

SURVEY INFORMATION

FIELD NOTES	DATE	BY
ON GRIEGOS RD. AND APPROX. 1/2 OF	DATE	BY
AVENIDA DE LOS GRIEGOS A	DATE	BY
SQUARE CUT ON TOP OF THE NORTH CURB.	DATE	BY
ELEVATION = 4970.42	DATE	BY

ENGINEER'S SEAL

12-18-94 Entrance Narrowed

REVISIONS

NO.	DATE	REMARKS	DESIGN
1	DATE	REMARKS	DESIGN

DESIGNED BY

JOHN CURTIN

CHECKED BY

JOHN CURTIN

PROJECT NO.

3965

MAP NO.

F-13

SHEET

7 OF 7

20 10 0 10 20

20 10 0 10 20

20 10 0 10 20