




LEGAL DESCRIPTION:
TRACTS 19 & 26 OF CORONA DEL SOL, ALBUQUERQUE, BERNALILLO COUNTY, NEW MEXICO.

SURVEY DATA:
SURVEY DATA PROVIDED BY FRED SANCHEZ, NEW MEXICO PROFESSIONAL SURVEYOR NO. 4078. OCTOBER 20, 1989.

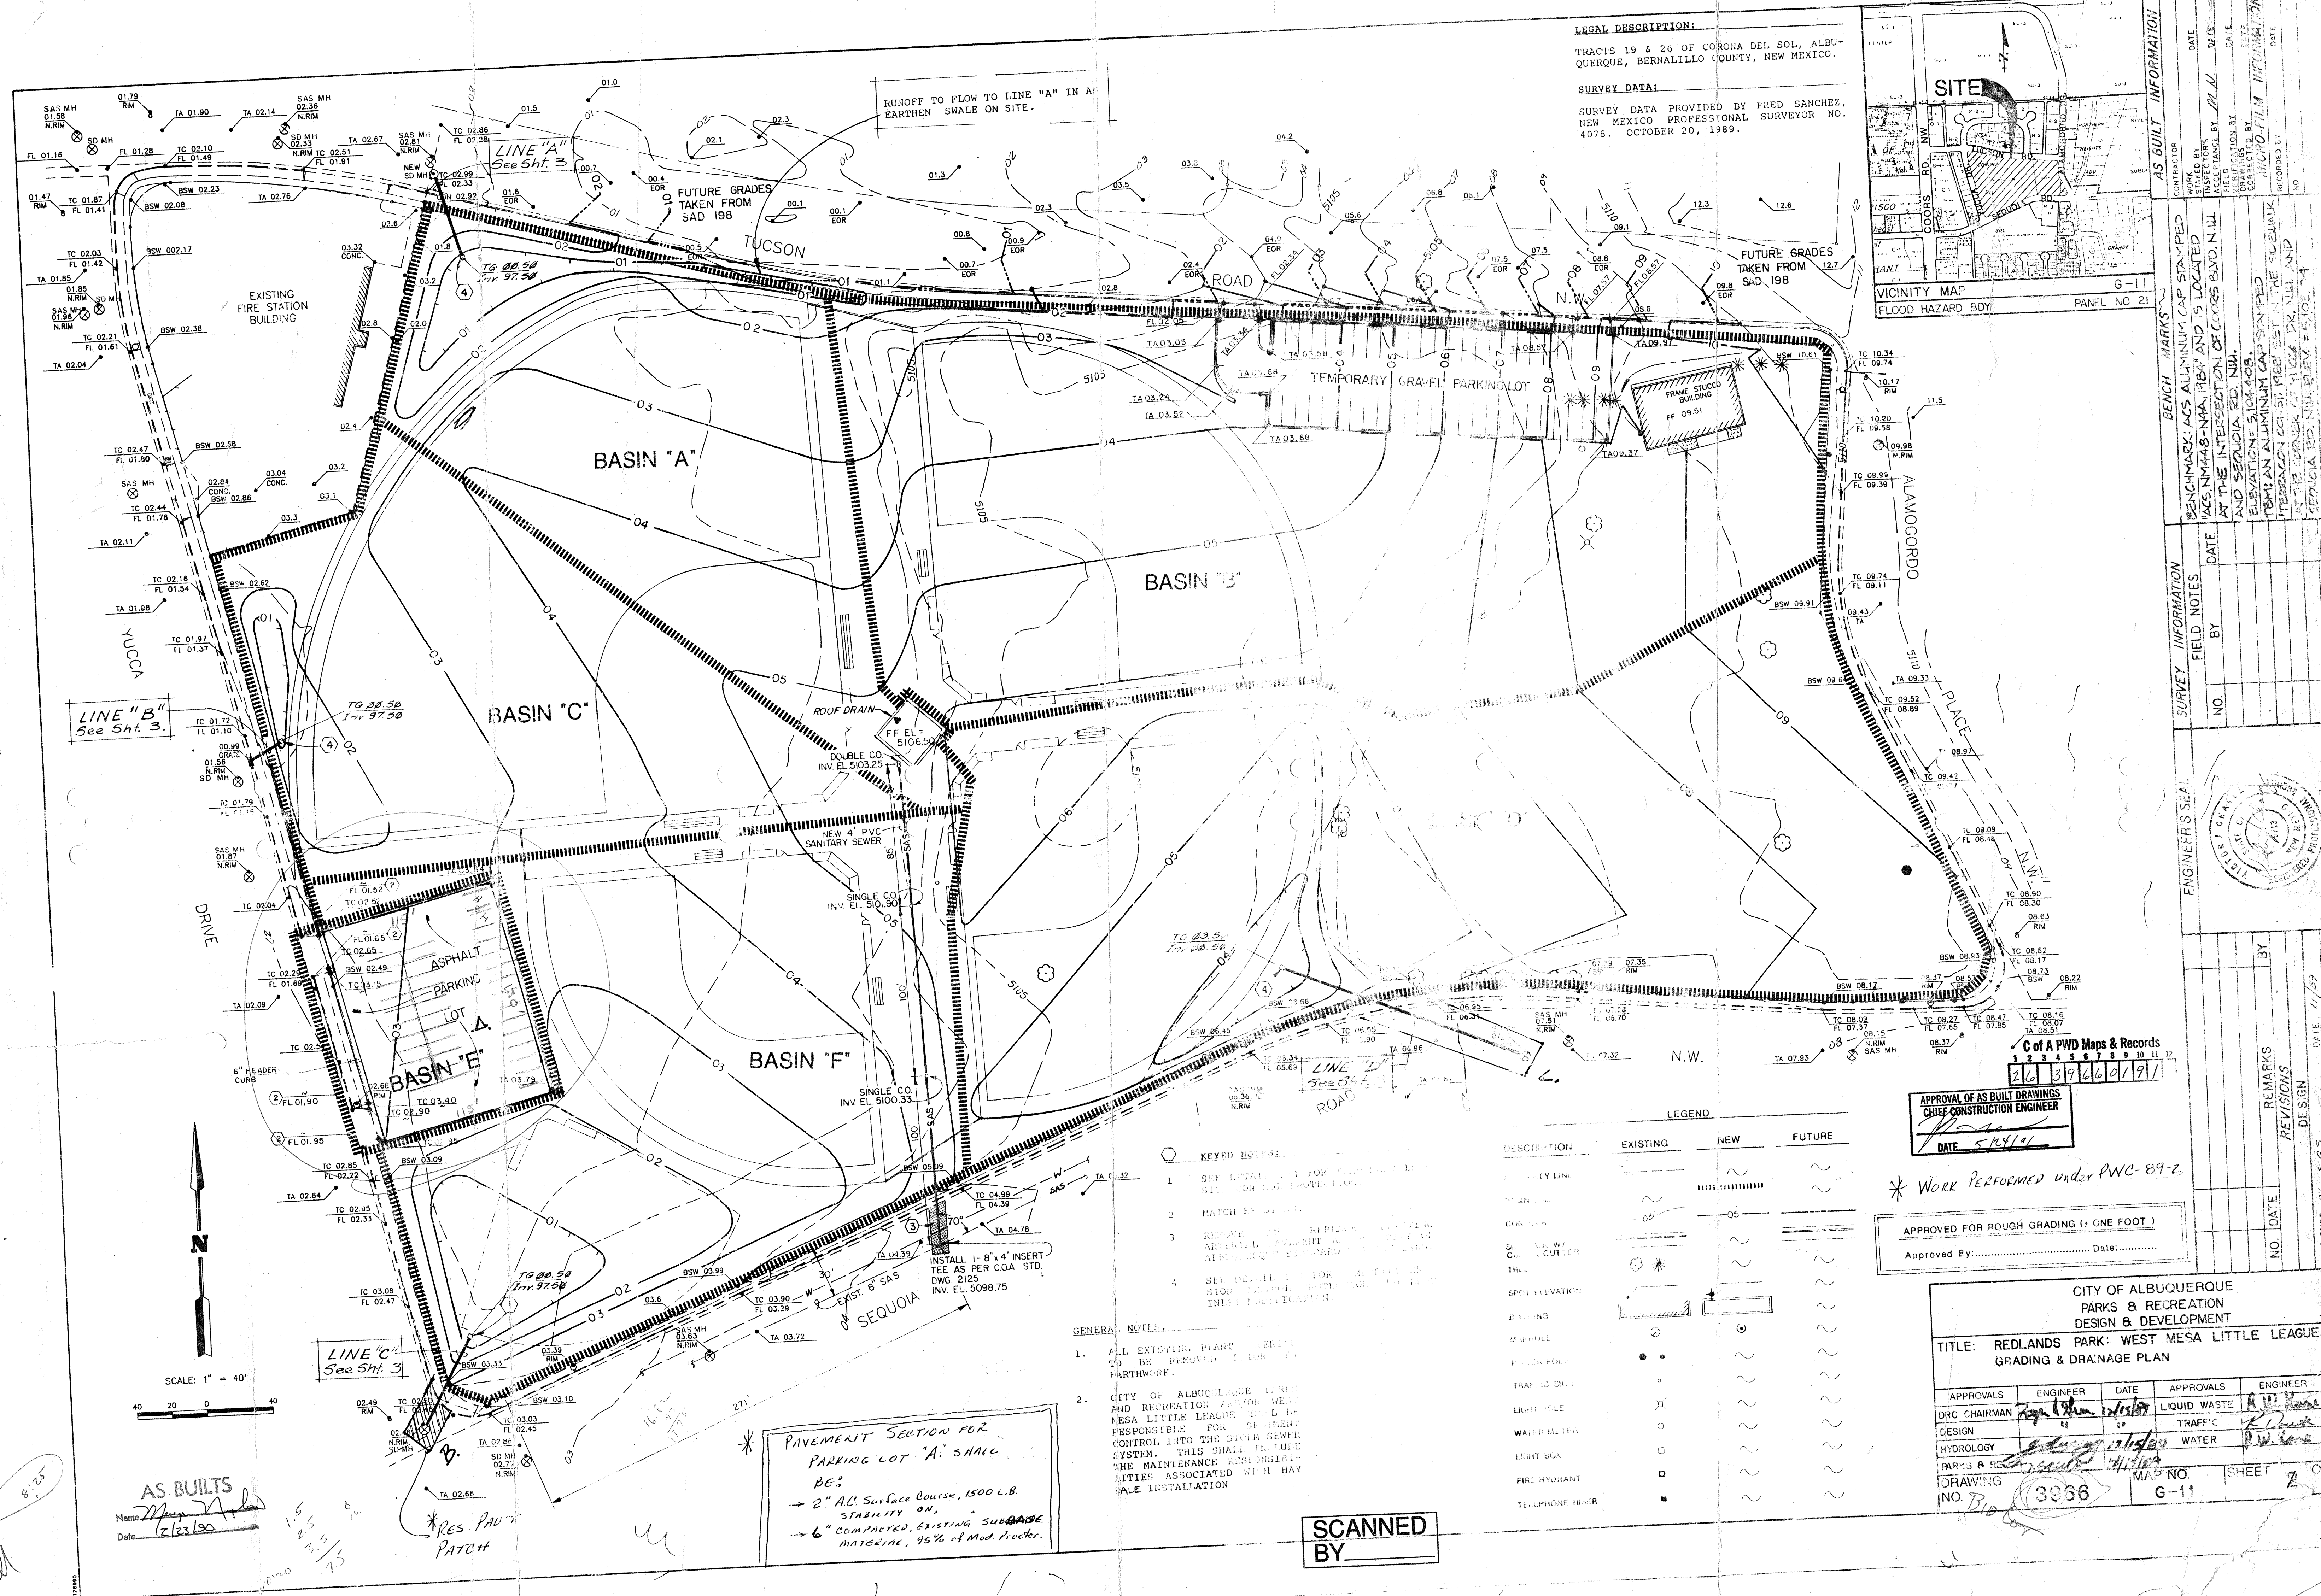

AS BUILT INFORMATION			
CONTRACTOR	DATE	DATE	DATE
INSPECTED BY	DATE	DATE	DATE
FIELD BY	DATE	DATE	DATE
REVISIONS	DATE	DATE	DATE
NO.	DATE	DATE	DATE
BY	DATE	DATE	DATE
REMARKS	DATE	DATE	DATE
DESIGNED BY	DATE	DATE	DATE

- KEYED NOTES:**
- SEE DETAIL FOR REPAIRS TO EXISTING SIDEWALKS AND DRIVEWAYS.
 - MATCH EXISTING.
 - REMOVE EXISTING CURB AND REPLACE WITH NEW 4" P.V.C. SANITARY SEWER.
 - SEE DETAIL FOR REPAIRS TO EXISTING SIDEWALKS AND DRIVEWAYS.

- GENERAL NOTES:**
- ALL EXISTING PLANT MATERIAL TO BE REMOVED PRIOR TO FATHWORK.
 - CITY OF ALBUQUERQUE PARKS AND RECREATION DEPARTMENT WILL BE RESPONSIBLE FOR SPHERICAL CONTROL INTO THE GROUND SYSTEM. THIS SHALL BE THE MAINTENANCE RESPONSIBILITIES ASSOCIATED WITH HAY BALE INSTALLATION.

PAVEMENT SECTION FOR PARKING LOT "A" SHALL BE:

- 2" AC Surface Course, 1500 L.B. STABILITY ON.
- 6" COMPACTED, EXISTING SUBGRADE MATERIAL, 45% of Mod. Proctor.

LEGEND			
DESCRIPTION	EXISTING	NEW	FUTURE
PROPERTY LINE	---	---	---
SEWER	---	---	---
CONCRETE	---	---	---
SPOT ELEVATION	---	---	---
MANHOLE	---	---	---
TRAFFIC SIGN	---	---	---
WATER METER	---	---	---
LIGHT BOX	---	---	---
FIRE HYDRANT	---	---	---
TELEPHONE HUB	---	---	---

C of A PWD Maps & Records
1 2 3 4 5 6 7 8 9 10 11 12
26 39 46 47 91

APPROVAL OF AS BUILT DRAWINGS
CHIEF CONSTRUCTION ENGINEER
DATE 5/24/94

APPROVED FOR ROUGH GRADING (+ ONE FOOT)
Approved By: _____ Date: _____

CITY OF ALBUQUERQUE PARKS & RECREATION DESIGN & DEVELOPMENT			
TITLE: REDLANDS PARK: WEST MESA LITTLE LEAGUE GRADING & DRAINAGE PLAN			
APPROVALS	ENGINEER	DATE	APPROVALS
DRC CHAIRMAN	DATE	DATE	LIQUID WASTE
DESIGN	DATE	DATE	TRAFFIC
HYDROLOGY	DATE	DATE	WATER
PARKS & RECREATION	DATE	DATE	DATE
DRAWING NO. 3936	MAP NO. G-11	SHEET 2 OF 2	

SCANNED BY